

**ANCHOR BOLT** AMERICAN CONCRETE INSTITUTE ADJM<sup>\*</sup> ADJUSTMENT ADDITIONAL **ADDTL** ADH. ADHESIVE ANCH. ANCHOR ARCH. **ARCHITECTURA** AMERICAN SOCIETY FOR ASTM TESTING AND MATERIALS BLDG. BUILDING BLKG. BLOCKING BM BEAM BOT. BOTTOM **BASEPLATE** BPL. BRCG. BRACING BRG. **BEARING** BRK. BRICK BRKT. **BRACKET** B.S. BOTH SIDE (USED W/ REINF) B.S. BRICK SHELF BSMT **BASEMENT** BTWN. BETWEEN B.W. **BOTH WAYS COMPONENTS & CLADDING** C&C CANT. **CANTILEVER CONCRETE BEAM COLD FORMED METAL FRAMING** CFMF C.J. CONTROL JOINT CL. **CENTERLINE** CLR. CLEAR CMU CONCRETE MASONRY UNIT COL. COLUMN COMP COMPRESSIBLE CONC CONCRETE CONN. CONNECTION CONST CONSTRUCTION CONT. CONTINUOUS CONTR CONTRACTOR COORD. COORDINATE COR CONTRACTING OFFICER'S **REPRESENTATIVE** CRIPPLED DBL. DOUBLE DET. DETAIL DEV. DEVELOP, DEVELOPMENT DIAG. DIAGONAL DIST. DISTANCE DISCONT DISCONTINUOUS DK. DECK D.L. DEAD LOAD DN. DOWN DWG. DRAWING DWL. DOWEL

EA.

E.F.

ELEC.

ELEV.

EMB.

EQ.

ETC.

E.W.

E-W

EXP. JT.

FCTD.

FDN.

FIN.

FLG.

FLR.

F.S.

FTG.

GA.

GB

G.C.

HK.

H.P.

I.E.

I.F.

HORIZ.

GRAN.

GALV.

FRMG

E.O.R.

EL.

**EACH** 

EACH END

**EACH FACE** 

**ELEVATION** 

ELECTRICAL

ELEVATOR

EQUAL

EXIST., (E) EXISTING

ETCETERA

EACH WAY

**EAST-WEST** 

**EXPANSION** 

FOUNDATION

**FINISH** 

FLANGE

FLOOR

**FRAMING** 

FAR SIDE

FOOTING

GALVANIZED

GRADE BEAM

GRANULAR

HORIZONTAL

HIGH POINT

INSIDE FACE

INVERT ELEVATION

GENERAL CONTRACTOR

GAGE

HOOK

EXPANSION JOINT

FACTORED

EMBED, EMBEDMENT

ENGINEER OF RECORD

INCLUSIVE INCL. INFO. INFORMATION INS. INSULATION JST. JOIST JOINT KIPS (1000 LB.) KSF KSI L.L. LIVE LOAD LLH LLV LSH LSV

KIPS PER SQUARE FOOT KIPS PER SQUARE INCH LONG LEG HORIZONTAL LONG LEG VERTICAL LONG SIDE HORIZONTAL LONG SIDE VERTICAL L.P. LOW POINT LIGHT WEIGHT LW MAS. MASONRY MAX. MAXIMUM MECH. **MECHANICAL** 

MTL. METAL MANUFACTURER MINIMUM **NEUTRAL AXIS** NUMBER NEAR SIDE NORTH-SOUTH NORMAL WEIGHT ON CENTER OUTSIDE FACE OPENING

MFR.

MIN.

N.A.

NO.

N.S.

N-S

STL.

T.O.S.

T.O.W.

U.N.O.

VERT.

V.I.F.

WD.

W.P.

TYP.

O.C. O.F. OPNG. OPP.HD. OPPOSITE HAND ORIENT ORIENTATION PC. PRECAST P.C. PRECAST CONCRETE PCF POUNDS PER CUBIC FOOT PED. PEDESTAL PENET PENETRATION PERIM. PERIMETER PLATE **PLUMB** PLUMBING PW. PLYWOOD PNL. PANEL PREM. PREMOLDED

PSF POUNDS PER SQUARE FOOT PSI POUNDS PER SQUARE INCH REINF. REINFORCING REQD. REQUIRED RET. RETAINING REV. REVISION ROOF R.O. ROUGH OPENING SCHED. SCHEDULE SECT. SECTION SIM SIMILAR SLOTTED SPAN. SPANDREL

SPEC. SPECIFICATIONS STAGG. STAGGERED STD. STANDARD STIFF. STIFFENER STEEL STRU. STRUCTURAL SUPP. SUPPORT T.&B. TOP AND BOTTOM TEMP. **TEMPORARY** THK. THICK, THICKNESS T.O.C. TOP OF CONCRETE TOL. TOLERANCE T.O.P.

TOP OF PEDESTA TOP OF STEEL TOP OF WALL TYPICAL UNLESS NOTED OTHERWISE VERTICAL (USED W/ REINF.) VERTICAL VERIFY IN FIELD

WOOD **WORK POINT** WATER STOP WELDED WIRE FABRIC

W.S. WWF HORIZONTAL (USED W/ REINF.)

**GENERAL NOTES** 

GENERAL NOTES

1. VERIFY ALL EXISTING CONDITIONS AND DIMENSIONS AT THE SITE BEFORE ORDERING ANY MATERIALS AND BEGINNING ANY WORK. FIELD SURVEY AND ESTABLISH THE EXISTING BUILDING DIMENSIONS WHERE NEW CONSTRUCTION ABUTS EXISTING BUILDINGS. THIS FIELD SURVEY MUST INCLUDE, BUT MUST NOT BE LIMITED TO THE FOLLOWING: DIMENSIONS OF EXISTING BUILDING FACE INCLUDING ALL FENESTRATIONS, PROJECTIONS, ETC, PLUMBNESS OF WALLS, FLOOR AND ROOF ELEVATIONS, AND ALL OTHER PERTINENT DIMENSIONS. SUBMIT THE SURVEY TO THE COR FOR INFORMATION ONLY AND MAKE THE SURVEY AVAILABLE TO SUBCONTRACTORS.

2. THE CONTRACTOR MUST BE RESPONSIBLE FOR ALL WORK AND COORDINATION INVOLVED TO PROVIDE ALL OPENINGS SHOWN ON THE ARCHITECTURAL, STRUCTURAL, MECHANICAL, PLUMBING, AND ELECTRICAL DRAWINGS. PROVIDE FRAMING AND ALL CONNECTIONS AND COORDINATE THE SIZE AND LOCATION OF ALL OPENINGS. (NOTE - NOT ALL OPENINGS ARE SHOWN ON THE STRUCTURAL

ALL CONTRACTORS MUST BE RESPONSIBLE TO ENSURE PROPER STORAGE OF MATERIAL IS MAINTAINED SO AS NOT TO CAUSE OVERLOADING OF THE EXISTING OR NEW STRUCTURE DURING PERFORMANCE OF THIS WORK. GENERAL CONTRACTOR TO COORDINATE.

4. ALL CONTRACTORS MUST VERIFY AND/OR ESTABLISH ALL EXISTING CONDITIONS AND DIMENSIONS AT THE SITE BEFORE ORDERING ANY MATERIAL AND COMMENCEMENT OF ANY WORK.

5. IF THE EXISTING CONDITIONS DO NOT PERMIT THE INSTALLATION OF THE WORK IN ACCORDANCE WITH THE DETAILS AS SHOWN, NOTIFY THE COR IMMEDIATELY AND PROVIDE A SKETCH OF THE CONDITION WITH A PROPOSED MODIFICATION TO THE DETAILS GIVEN ON THE CONTRACT DOCUMENTS. THE FINAL INSTALLATION MUST BE DONE AS REQUIRED BY THE ARCHITECT AS DIRECTED BY THE COR.

6. WHERE ALTERATIONS INVOLVE THE EXISTING SUPPORTING STRUCTURE, PROVIDE ALL SHORING, BRACING, GUYS AND PROTECTION REQUIRED TO ENSURE THE STRUCTURAL INTEGRITY OF THE

7. COORDINATE ALL RELATED TRADE ACTIVITY REGARDING SHUT DOWNS, RE-ROUTING, TEMPORARY INSTALLATION, ETC. NECESSARY FOR THIS INSTALLATION WITH THE COR.

8. ESTABLISH SPECIFIC MEANS AND METHODS FOR INSTALLATION AND COORDINATE THE WORK FOR ALL CONTRACTORS AND COMPLY WITH THE GOVERNMENT'S GENERAL REQUIREMENTS.

9. COORDINATE THE LOCATION AND DIMENSIONS OF ELEVATOR PITS, WALLS, POSTS, HOISTWAY AND OPENINGS WITH ELEVATOR MANUFACTURER.

10. COORDINATE WITH EQUIPMENT MANUFACTURERS FOR EXACT SIZE, LOCATION, ETC. OF PITS, CAST-IN ITEMS, WALLS, ETC. BEFORE LAYOUT, ORDERING ANY MATERIAL OR COMMENCEMENT OF ANY WORK.

FOUNDATION NOTES

1. FOUNDATIONS LOCATED OUTSIDE THE FOOTPRINT OF THE BUILDING MUST BEAR ON SUBGRADE HAVING A MINIMUM ALLOWABLE BEARING PRESSURE OF 3,000 PSF. FOUNDATIONS LOCATED WITHIN THE FOOTPRINT OF THE BUILDING MUST BEAR ON BEDROCK HAVING A MINIMUM ALLOWABLE BEARING PRESSURE OF 10,000 PSF. BEARING CAPACITY MUST BE VERIFIED IN THE FIELD BY A LICENSED GEOTECHNICAL INSPECTOR HIRED BY THE CONTRACTOR. ROCK RECEIVING FOUNDATIONS MUST BE SOUND, FREE OF SHATTERED OR SPLINTERED FRAGMENTS, AND APPROXIMATELY LEVEL. CONCRETE-ROCK SLIDING COEFFICIENT OF 0.5 SHALL BE USED.

BASED ON EXISTING BUILDING INFORMATION AND GEOTECHNICAL INVESTIGATION, IT IS ASSUMED THAT EXISTING BUILDING FOUNDATIONS BEAR ON BEDROCK. CONTRACTOR MUST FIELD VERIFY THIS PRESUMPTION. IF ROCK IS NOT ENCOUNTERED WHEN EXCAVATIONS REACH THE BOTTOM ELEVATION OF EXISTING ADJACENT FOOTINGS, THE EXISTING FOOTINGS MUST BE REINFORCED BY AN UNDERPINNING METHOD, TO A DEPTH DETERMINED BY THE GEOTECHNICAL ENGINEER, NECESSARY TO PROVIDE THE DESIGN BEARING CAPACITY OF 10,000 PSF. IN THE EVENT THIS CONDITION IS FOUND, THE CONTRACTOR SHALL FOLLOW THE CONTRACT REQUIREMENTS FOR SEEKING DIRECTION AND RESOLUTION OF THIS CONDITION AND ANY ASSOCIATED REMEDIES. CONTRACTOR IS NOT PERMITTED TO EXCAVATE LOWER THAN EXISTING FOOTINGS OR PROCEEDING FURTHER WITHOUT APPROVAL OF CONTRACTING OFFICER.

3. ALL COLUMN FOOTINGS MUST BE CENTERED ON THE COLUMN CENTERLINES, UNLESS OTHERWISE

PROVIDE DEWATERING DURING EARTHWORK OPERATIONS INCLUDING PREVENTIVE MEASURES RELATED TO EXCAVATION STABILITY, DEWATER TO PREVENT SLOUGHING OF EXCAVATION SLOPES AND WALLS BOILS LIPLIET AND HEAVE IN THE EXCAVATION AND TO ELIMINATE INTEREFRENCE WITH ORDERLY PROGRESS OF CONSTRUCTION. CONTROL MEASURES MUST BE TAKEN TO MAINTAIN THE INTEGRITY OF THE IN SITU MATERIAL. THE DEWATERING SYSTEM MUST BE CONTINUOUSLY OPERATED UNTIL CONSTRUCTION WORK BELOW EXISTING WATER LEVEL IS COMPLETE. CONTRACTOR TO SUBMIT WEEKLY PERFORMANCE RECORDS. CARE MUST BE TAKEN TO IMMEDIATELY CONTROL ANY WATER SEEPAGE TO PREVENT SATURATION OF THE SUBGRADE.

5. BOTTOM OF FOOTING GIVEN IN THE FOUNDATION PLAN MARKED THUS (...) ARE APPROXIMATE AND MUST BE VERIFIED IN THE FIELD IN ACCORDANCE WITH NOTES ABOVE. IT IS ASSUMED THAT EXISTING BUILDING FOOTINGS BEAR ON BEDROCK. IF EXCAVATION OF A NEW FOOTING REACHES THE BOTTOM OF AN ADJACENT EXISTING FOOTING AND NO ROCK IS ENCOUNTERED, STOP EXCAVATING AND NOTIFY THE COR IMMEDIATELY.

ALL EXISTING UNDERGROUND UTILITIES IN THE AREA OF THE NEW CONSTRUCTION MUST BE RELOCATED UNLESS OTHERWISE NOTED ON THE DRAWINGS BEFORE ANY NEW FOUNDATION WORK IS STARTED. PROVIDE PROTECTION FOR NEW AND EXISTING UTILITIES, ACCESS HOLES, CATCH BASINS, ETC. USING SHEETING AND SHORING DESIGNED BY THE CONTRACTOR'S DELEGATED REGISTERED PROFESSIONAL ENGINEER LICENSED IN THE STATE OF NEW YORK.

COORDINATE ALL FOUNDATION WORK WITH ALL UNDERGROUND UTILITIES. DO NOT PLACE UTILITIES BELOW SPREAD FOOTINGS UNLESS APPROVED BY THE ARCHITECT. IF ANY SUCH CONDITION OCCURS, THE CONTRACTOR MUST NOTIFY THE COR AND DROP THE BOTTOM OF FOOTING.

8. COORDINATE ALL FOUNDATION WORK WITH ALL UNDERGROUND UTILITIES. EXTREME CARE MUST BE TAKEN DURING EXCAVATION AND CONSTRUCTION OF NEW FOUNDATION WORK SO AS NOT TO DISTURB THE EXISTING CONSTRUCTION AND UTILITIES.

BACKFILL AGAINST WALLS MUST FOLLOW THE CRITERIA NOTED. AS A MINIMUM, WALLS MUST HAVE REACHED THEIR 28 DAY DESIGN STRENGTH OR BE IN PLACE 14 DAYS, WHICHEVER IS LONGER. EQUIPMENT USED TO COMPACT THE BACKFILL WILL BE SUCH AS TO LIMIT PRESSURES ON THE WALLS TO THE DESIGN VALUES AND TO BE REVIEWED AND ACCEPTED BY THE GEOTECHNICAL ENGINEER. BACKFILL EVENLY ON BOTH SIDES OF FOUNDATION WALLS FOR GREATEST HEIGHT

10. PROVIDE STANDARD STEEL PIPE SLEEVES FOR PIPES PASSING THROUGH CONCRETE WALLS AND NEATLY CORED HOLES A MINIMUM OF ONE PIPE SIZE LARGER THAN PIPE THROUGH EXISTING CONCRETE WALLS WHERE SHOWN ON THE DRAWINGS. COORDINATE CORED HOLES WITH SEALANT, ETC., REQUIREMENTS WITH RELATED SPECIFICATIONS. SEE TYPICAL DETAIL ON DRAWING S-501.

11. WHERE EXCAVATION FOR UTILITY TRENCHES IS LOWER THAN AND CLOSER THAN A 1.5H:1V SLOPE TO THE BOTTOM OF A NEW OR EXISTING COLUMN OR WALL FOOTING, BACKFILL THE EXCAVATION WITH LEAN MIX CONCRETE. TOP OF FILL TO BE ON A 1.5H:1V SLOPE FROM BOTTOM OF ADJACENT FOUNDATIONS.

12. FOUNDATION DESIGN IS BASED ON THE GEOTECHNICAL REPORT BY TERRACON CONSULTANTS -GEOCONCEPTS ENGINEERING, INC. DATED JUNE 16, 2020 (& OCTOBER 26, 2020 ADDENDUM).

TERRACON CONSULTANTS-GEOCONCEPTS ENGINEERING, INC. 19955 HIGHLAND VISTA DRIVE

SUITE 170 ASHBURN, VA 20147

A COPY OF THE SOILS AND FOUNDATION INVESTIGATION ANALYSIS REPORT IS INCLUDED IN THE SPECIFICATION FOR INFORMATION ONLY.

13. FOR ADDITIONAL REQUIREMENTS SEE TYPICAL DETAILS AND THE SPECIFICATIONS.

CONCRETE NOTES

1. CONCRETE MUST HAVE THE FOLLOWING MINIMUM COMPRESSIVE STRENGTH AT 28 DAYS:

INTERIOR FOUNDATIONS, PIERS AND PEDESTALS 4000 PSI **EXTERIOR SLAB ON GRADE** 4500 PSI INTERIOR SLAB ON GRADE (NOTED S1 IN PLAN) 4000 PSI INTERIOR SLAB ON GRADE (NOTED S2 IN PLAN) 3000 PSI LIGHTWEIGHT SLAB ON METAL DECK 3000 PSI NORMAL WEIGHT SLAB ON METAL DECK 3500 PSI **EXTERIOR EQUIPMENT PADS** 4500 PSI EXTERIOR CONCRETE AND FOUNDATIONS 4500 PSI TERRACE LIGHTWEIGHT SLAB ON METAL DECK 4500 PSI EXTERIOR LIGHTWEIGHT TOPPING SLAB 4500 PSI ALL CONCRETE EXPOSED TO FREEZE-THAW CONDITIONS 4500 PSI ALL OTHER CONCRETE 4000 PSI

2. REINFORCING TO BE ASTM A615 GRADE 60. ALL MESH SHALL BE ASTM A1064. ALL REINFORCING STEEL PLACED IN CONCRETE LOCATED WITHIN OR BELOW THE WATER TABLE MUST BE EPOXY COATED.

PROVIDE SYNTHETIC POLYPROPYLENE FIBERS (FIBERMESH) IN ALL CONCRETE SLABS ON GRADE AND ELEVATED CONCRETE SLABS. FIBERS WILL CONFORM TO ASTM C1116, TYPE III AND ICC ES AC32 SECTIONS 3.1.1 AND 3.1.2.

4. ALL CONCRETE WORK MUST BE CURED FOR A MINIMUM OF 7 DAYS IN ACCORDANCE WITH ACI

CONTRACTOR MUST VERIFY THE DIMENSIONS OF AND INSTALL IN THE FORMS ALL SLOTS, SLEEVES, ANCHOR BOLTS, MASONRY ANCHORS, POCKETS, ETC. AS REQUIRED FOR OTHER

6. SEE MECHANICAL AND ELECTRICAL DRAWINGS FOR CONCRETE EQUIPMENT PADS AND FOUNDATIONS REQUIRED.

ALL SHORING AND/OR RESHORING FOR SUPPORTED CONCRETE SLABS MUST BE LEFT IN PLACE UNTIL THE CONCRETE HAS REACHED ITS 28 DAY STRENGTH AND A MINIMUM OF 14

8. SEE SECTIONS AND DETAILS FOR ALL EQUIPMENT OPENINGS, DEPRESSIONS, ETC. CONTRACTOR MUST COORDINATE EQUIPMENT REQUIREMENTS WITH ARCHITECTURAL MECHANICAL, ELECTRICAL, AND PLUMBING CONTRACTORS.

9. FOR ADDITIONAL REQUIREMENTS, SEE TYPICAL DETAILS AND THE SPECIFICATIONS

STRUCTURAL STEEL NOTES

1. STRUCTURAL STEEL MUST CONFORM TO THE FOLLOWING ASTM SPECIFICATIONS.

WIDE FLANGE AND WT SHAPES ASTM A992/A992M GRADE 50 BASE PLATES, COLUMN CAPS, MOMENT PLATES, GUSSET PLATES, WEB PLATES, AND SPLICE PLATES ASTM A572/A572M GRADE 50 HOLLOW STRUCTURAL STEEL MEMBERS ASTM A500/A500M GRADE B STEEL PIPES ASTM A53/A53M GRADE B ANGLES, CHANNELS, AND PLATES ASTM A36/A36M

VERIFY IN THE FIELD, BY A SURVEY, ALL EXISTING CONDITIONS CONNECTED WITH STRUCTURAL STEEL WORK INCLUDING ANCHOR BOLT LOCATIONS PRIOR TO ORDERING ANY MATERIAL OR COMMENCEMENT OF ANY WORK.

3. PROVIDE SATISFACTORY BRACING OF THE EXISTING AND NEW STEEL FRAME UNTIL ALL NEW FRAMING AND THE METAL DECK IS ERECTED AND FINAL CONNECTIONS ARE COMPLETE AND THE CONCRETE SLABS ON METAL DECK ARE PLACED.

4. ALL STRUCTURAL STEEL DIRECTLY EXPOSED TO THE WEATHER MUST BE HOT DIPPED GALVANIZED AND TOUCHED UP WITH TWO COATS OF HIGH SOLIDS ZINC RICH PRIMER WHERE ABRADED OR AFTER WELDING (SEE SPECIFICATIONS).

5. MAIN SUPPORT MEMBERS FOR THE METAL DECK ARE SHOWN ON THE CONTRACT DRAWINGS PROVIDE ADDITIONAL SECONDARY FRAMING AS REQUIRED AT NO ADDITIONAL COST TO THE GOVERNMENT.

WHERE WELDING STAINLESS STEEL COMPONENTS, CONTRACTOR MUST COMPLY WITH REQUIREMENTS OF AWS D1.6. WELDER QUALIFICATIONS FOR STAINLESS STEEL ARE REQUIRED.

BEAM TO BEAM AND/OR BEAM TO COLUMN CONNECTIONS MARKED Mc MUST BE DETAILED TO DEVELOP FULL MOMENT CAPACITY AT THE CONNECTION IN ADDITION TO STANDARD SHEAR CONNECTION. THESE MOMENT CONNECTIONS ARE TO BE MADE BY FULL PENETRATION WELDS OF BOTH BEAM FLANGES. COORDINATE THESE DETAILS WITH OTHER FRAMING ELEMENTS AS REQUIRED.

7. SEQUENCE OF ERECTION FOR STRUCTURAL STEEL TO BE COORDINATED AS REQUIRED FOR AREAS SUPPORTED BY CANTILEVERS. ALL MOMENT CONNECTIONS AND/OR OTHER CONNECTIONS FOR CANTILEVERED FRAMING MUST HAVE TEMPORARY BRACING AND SUPPORT OF CANTILEVER FRAMING UNTIL ALL FINAL CONNECTIONS ARE COMPLETED AND INSPECTED BY THE TESTING AND INSPECTION AGENCY, AND THE RESULTS ACCEPTED PRIOR TO ERECTING FRAMING SUPPORTED BY THE CANTILEVER ENDS.

8. ANY FIELD WELDING TO ANY EXISTING THIN MEMBER MUST BE PERFORMED WITH EXTREME CARE SO AS TO AVOID EXCESSIVE DAMAGE TO THE BASE METAL.

9. EQUALLY SPACE BEAMS BETWEEN COLUMNS/GIRDERS UNLESS OTHERWISE NOTED.

10. FOR ADDITIONAL REQUIREMENTS, SEE TYPICAL DETAILS AND THE SPECIFICATIONS.

METAL DECK NOTES

METAL DECK MUST CONFORM TO THE REQUIREMENTS OF THE STEEL DECK INSTITUTE (SDI)

2. COMPOSITE METAL FLOOR DECK SUPPORTING LIGHT WEIGHT CONCRETE SLAB MUST BE CONTINUOUS OVER A MINIMUM OF TWO OR MORE SPANS UNLESS INDICATED OTHERWISE.

3. FOR ADDITIONAL INFORMATION SEE THE SPECIFICATIONS.

STRUCTURAL DRAWING INDEX

		100% SET 12/22/2020	RTA SET 02/11/2021	AMENDMENT 04/07/2021	
S-001	STRUCTURAL NOTES AND INDEX SHEET	Х	Х	Х	T
S-002	STRUCTURAL NOTES	Х	Х		
S-003	WIND AND LIVE LOAD DIAGRAMS	Х	Х		
SD-100	LEVEL B3 / FOUNDATION DEMOLITION PLAN	Х	Х	Х	
SD-101	LEVEL B2 STRUCTURAL DEMOLITION PLAN	Х	Х		
SD-102	LEVEL B1 STRUCTURAL DEMOLITION PLAN	Х	Х		
SD-110	LEVEL 1 STRUCTURAL DEMOLITION PLAN	Х	Х		
SD-120	LEVEL 2 STRUCTURAL DEMOLITION PLAN	Х	Х		
SD-130	ATTIC LEVEL STRUCTURAL DEMOLITION PLAN	Х	Х		
S-100	LEVEL B3 + B2 ARCHIVE / FOUNDATION PLAN	Х	Х		
S-100.1	UNDERSLAB DRAINAGE PLAN	Х	Х		
S-101	LEVEL B2 FLOOR FRAMING PLAN	Х	Х		
S-102	LEVEL B1 FLOOR FRAMING PLAN	Х	Х		
S-110	LEVEL 1 FLOOR FRAMING PLAN	Х	Х		
S-120	LEVEL 2 FLOOR AND STAGE FRAMING PLAN	Х	Х		
S-130	ATTIC LEVEL FRAMING PLANS	Х	Х	Х	
S-140	ROOF FRAMING PLAN AND ADD ALT NO. 1 ROOF REPLACEMENT	Х	Х		
S-301	SECTIONS	Х	Х		
S-302	SECTIONS	Х	Х		
S-303	SECTIONS	Х	Х		
S-304	SECTIONS	Х	Х		
S-305	SECTIONS	Х	Х		
S-306	SECTIONS	Х	Х		
S-307	SECTIONS	Х	Х		
S-401	BEARING WALL ELEVATIONS	Х	Х		
S-402	BEARING WALL ELEVATIONS	Х	Х		
S-403	BEARING WALL ELEVATIONS	X	Х		
S-404	SCREEN WALL ELEVATIONS	X	Х		
S-501	TYPICAL DETAILS	Х	Х		
S-502	TYPICAL DETAILS	X	Х		
S-503	TYPICAL DETAILS	Х	Х		
S-504	TYPICAL DETAILS	Х	Х		
S-601	COLUMN SCHEDULE AND DETAILS	X	Х	Х	

ELOOP DESIGN LIVE LOADS (SEE DIACRAMS ON S 00)

FLOOR DESIGN LIVE LOADS (SEE DIAGRAMS ON S-003)	
CATWALKS / DUNNAGE PLATFORMS (AROUND EQUIPMENT)	40 PSF
OFFICE PLUS PARTITIONS	50 PSF+20 PSF
CORRIDOR	80 PSF
LIBRARY STACK ROOMS	150 PSF
BALCONY / TERRACE	100 PSF
MECHANICAL / ELECTRICAL ROOMS (TYPICAL)	150 PSF*
MECHANICAL / ELECTRICAL ROOMS (HEAVY)	250 PSF*
STAIRS	100 PSF
HIGH DENSITY STORAGE	300 PSF
ASSEMBLY AREAS	100 PSF
BALLROOM STAGE	150 PSF
*LIVE LOADS INCLUDE EQUIPMENT WEIGHT. LOCALIZED PRESSURES BE	NEATH EQUIPMEN

EXCEED THE STATED LIVE LOAD, BUT THE OVERALL FRAMING SYSTEM IS ADEQUATE

COLLATERAL LOADS (SUPERIMPOSED DEAD LOADS)*	
BALCONY/TERRACE	125 PSF
LIBRARY STACK ROOMS	15 PSF
EXISTING FLOORS	15 PSF
CATWALKS	5 PSF
DUNNAGE PLATFORMS	15 PSF
MECHANICAL / ELECTRICAL ROOMS	20 PSF
HIGH DENSITY STORAGE	35 PSF
ASSEMBLY AREAS	15 PSF
*COLLATERAL LOADS DO NOT INCLUDE SELF WEIGHT OF SLAB, DECK	, OR FRAMING ELEMENTS.

ROOF DESIGN LIVE LOADS ROOF

**DEFLECTION CRITERIA** 

DEAD LOAD: EXISTING BUILDING DEAD LOAD DEFLECTIONS HAVE BEEN FULLY EXPERIENCED AND HAVE NOT BEEN CONSIDERED FOR DESIGN. NEW FLOOR FRAMING IS DESIGNED FOR L/240. LIVE LOAD: IT IS ASSUMED THAT EXISTING FRAMING WAS DESIGNED FOR LIVE LOAD DEFLECTIONS OF L/360. NEW FLOOR FRAMING IS DESIGNED FOR L/360. HIGH-DENSITY STORAGE COMPONENTS MUST BE COORDINATED WITH THE SCOPE OF WORK FOR THOSE AREAS WHERE THEY ARE TO BE INSTALLED.

## SNOW LOADS (CRITERIA IDENTIFIED IN STRUCTURAL LOAD DATA TOOL, HOSTED ON WHOLE BUILDING DESIGN GUIDE WEBSITE (https://www.wbdg.org/additional-resources/tools/ufcsIdt))

 ,	
GROUND SNOW LOAD,	Pg=30 PS
FLAT ROOF SNOW LOAD (USED FOR DESIGN)	Pf=30 PS
MAXIMUM DRIFT LOAD (FOR AREAS OF SNOW BUILD UP)*	80 PSF
SNOW EXPOSURE FACTOR,	Ce=0.9
SNOW LOAD IMPORTANCE FACTOR	I=1.10
THERMAL FACTOR,	Ct=1.00
DEPTH TO FROST	54 INCHI

## ATERAL LOADS WIND CONTONA IDENTIFIED IN STRUCTURAL LOAD DATA TOOL LICETED ON

<u>LATERAL LOADS - WIND</u> (CRITERIA IDENTIFIED IN STRUCTURAL LOAD DATA TOOL, F	
WHOLE BUILDING DESIGN GUIDE WEBSITE (https://www.wbdg.org/additional-resource	s/tools/ufcsId
WIND LOAD DESIGN PARAMETERS	
BASIC WIND SPEED,	V=122 MPH
WIND EXPOSURE	D
INTERNAL PRESSURE COEFFICIENT,	GCpi=±0.18
WIND LOAD ON MAIN WIND FORCE RESISTING SYSTEM (FACTORED) - SEE DIAGRAMS	ON S-003
WIND LOADS ON COMPONENTS AND CLADDING (FACTORED) - SEE DIAGRAMS ON S-0	03

## <u>LATERAL LOADS - SEISMIC</u> (CRITERIA IDENTIFIED IN STRUCTURAL LOAD DATA TOOL, HOSTED ON WHOLE BUILDING DESIGN GUIDE WEBSITE (https://www.wbdg.org/additional-resources/tools/ufcsldt))

	111
	I=1.25
ACCELERATION	Ss=0.26g
ELERATION	S <sub>1</sub> =0.06g
	TL=6
	С
CIENT	Sps=0.226
FICIENT	S <sub>D1</sub> =0.059
	В
EQUIV.	LAT. FORCE
ORDINARY PLAIN MASONRY S	HEAR WALLS
	R=1.5
	EACCELERATION ELERATION  CIENT FFICIENT  EQUIV.  ORDINARY PLAIN MASONRY S





10


			5/21/2021	4/7/2021	2/11/2021	DATE
			AMENDMENT 7	AMENDMENT 1	RTA SUBMISSION	DESCRIPTION
,			2	_	0	MARK


										L
ISSUE DATE:	02/11/2021	SOLICITATION NO.:	W912DS-19-K-0014	CONTRACT NO.:	W912DS-19-C0031	- CIA FOLI COO	PROJECT NO:	20190494		
DESIGNED BY:	KMK	DRAWN BY:	ZBW	CHECKED BY:	PC	OLIDIVITATION DV.	SUBIMILIEU BT.	Ca	. IZE:	ANOI D
STATE OF ENGINEERS									COLE A Joint Venture SIZE.	


SHEET ID

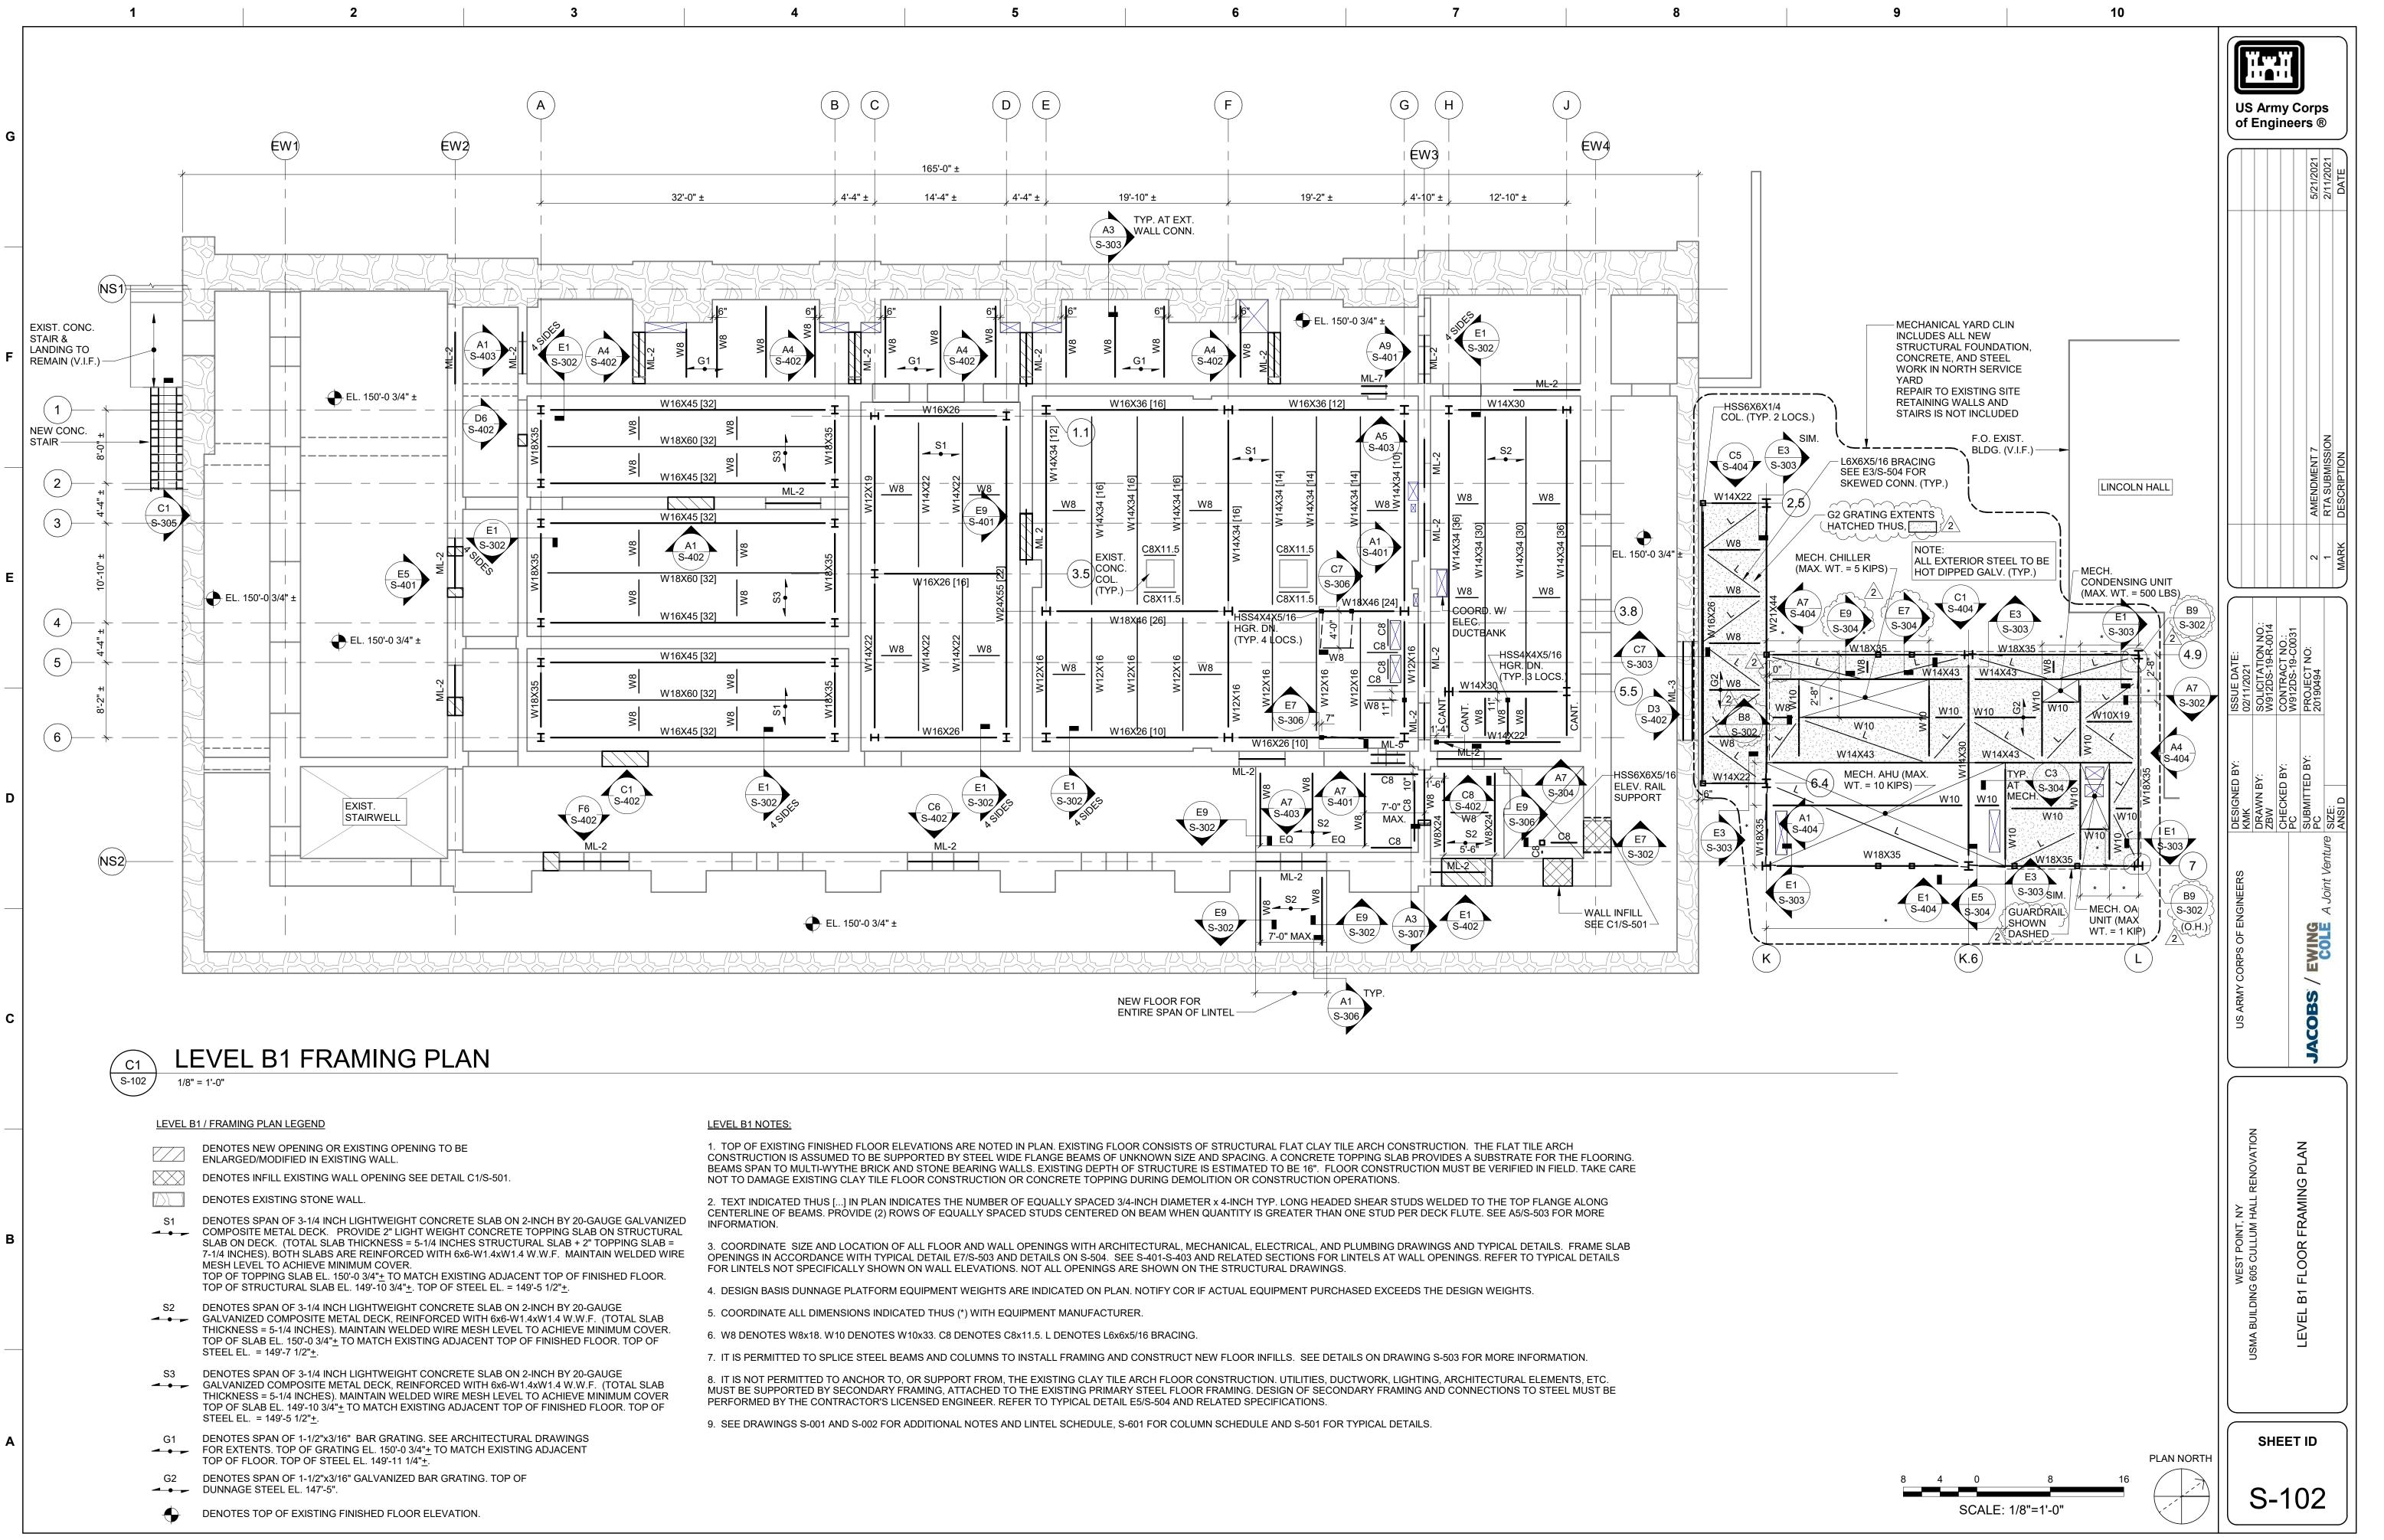


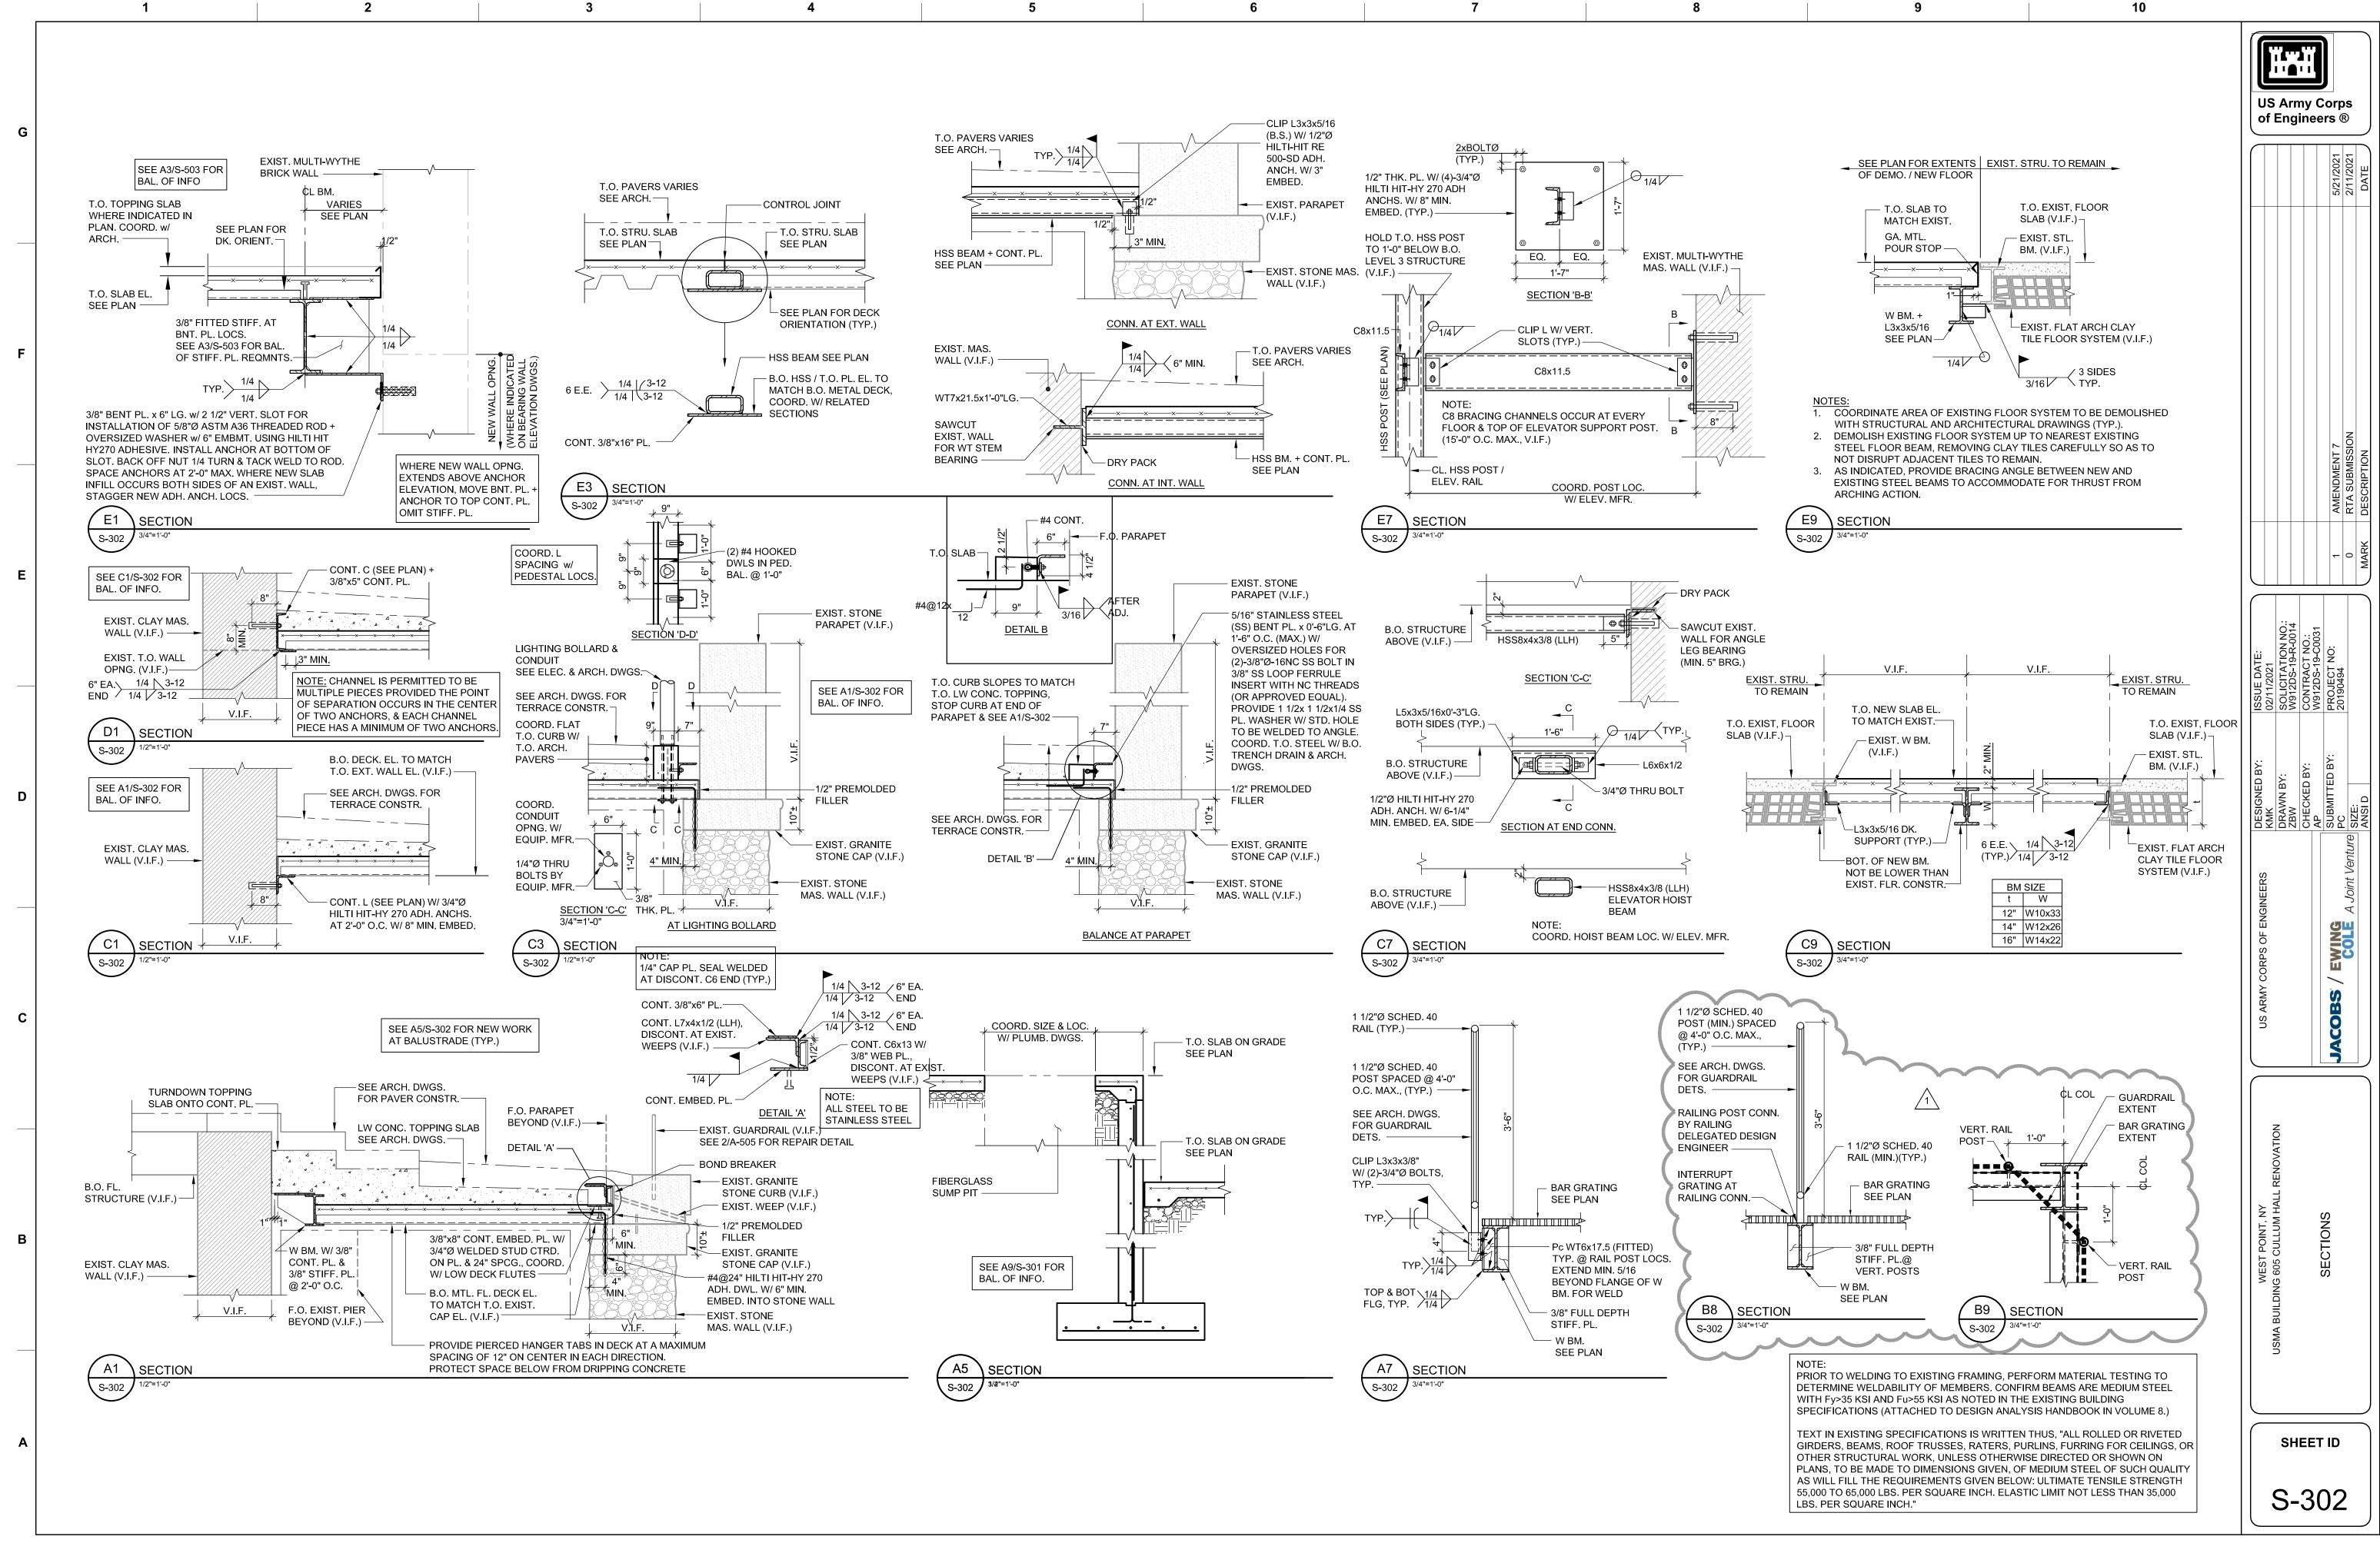


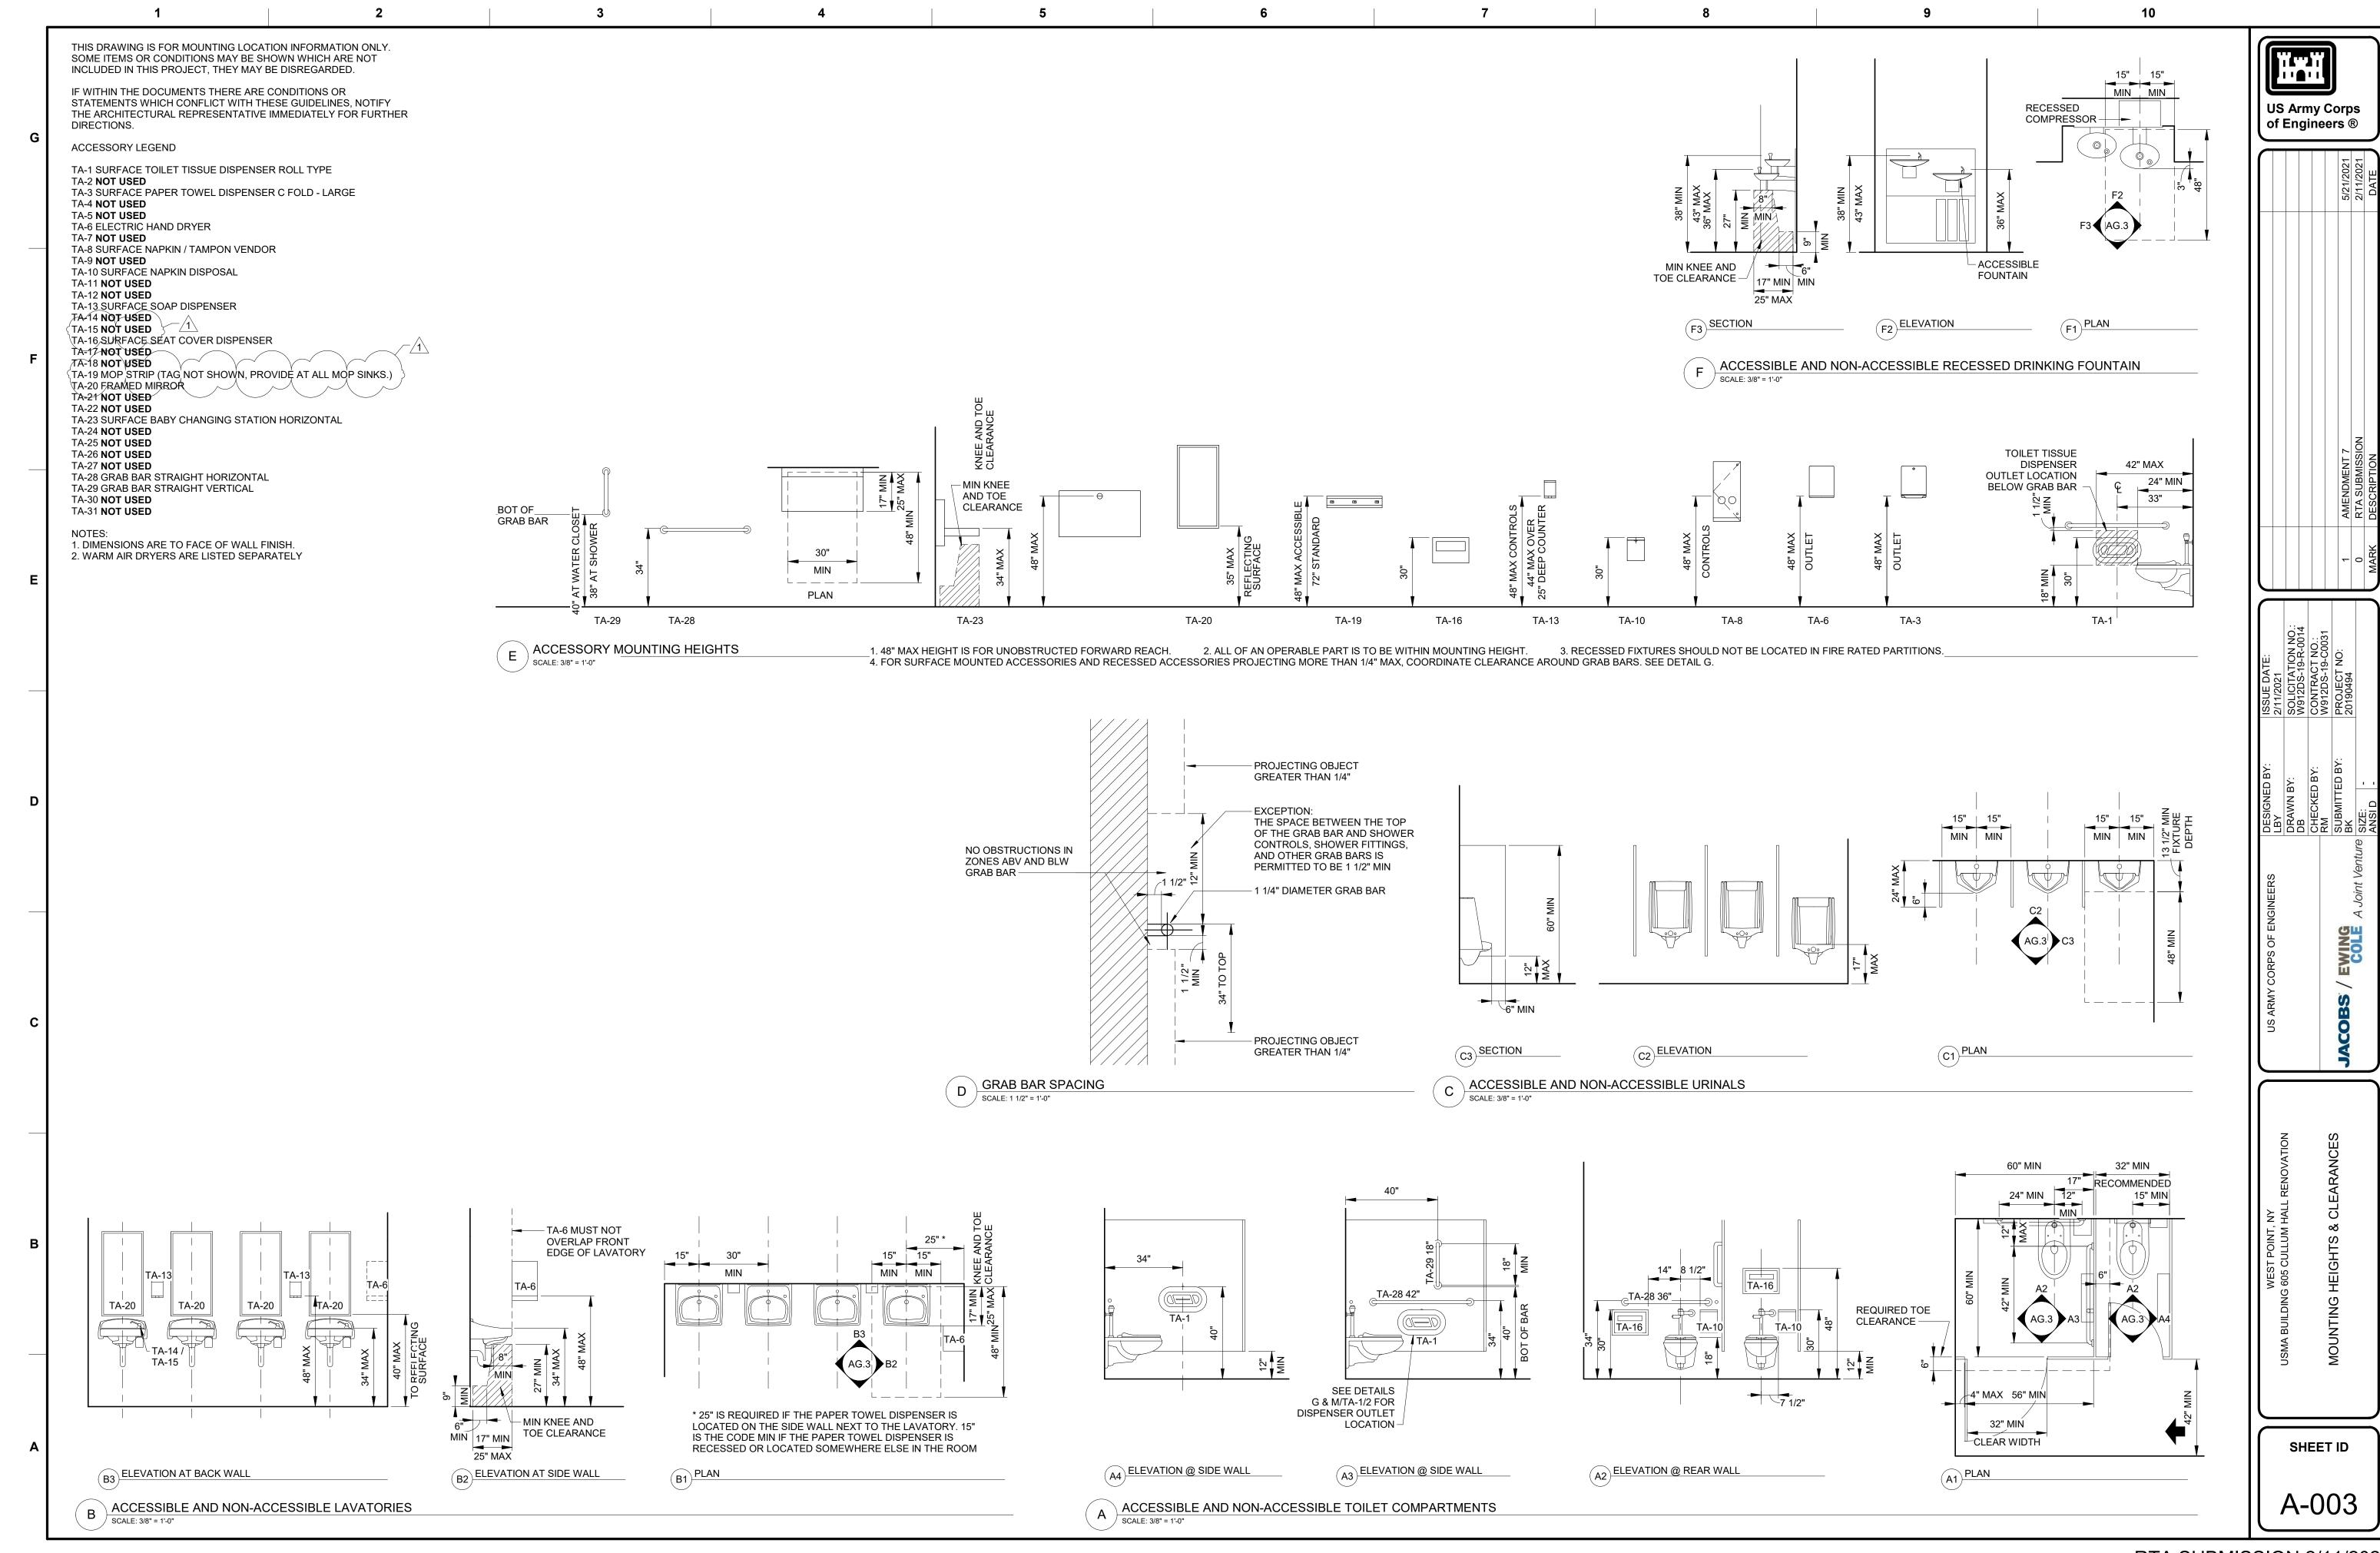


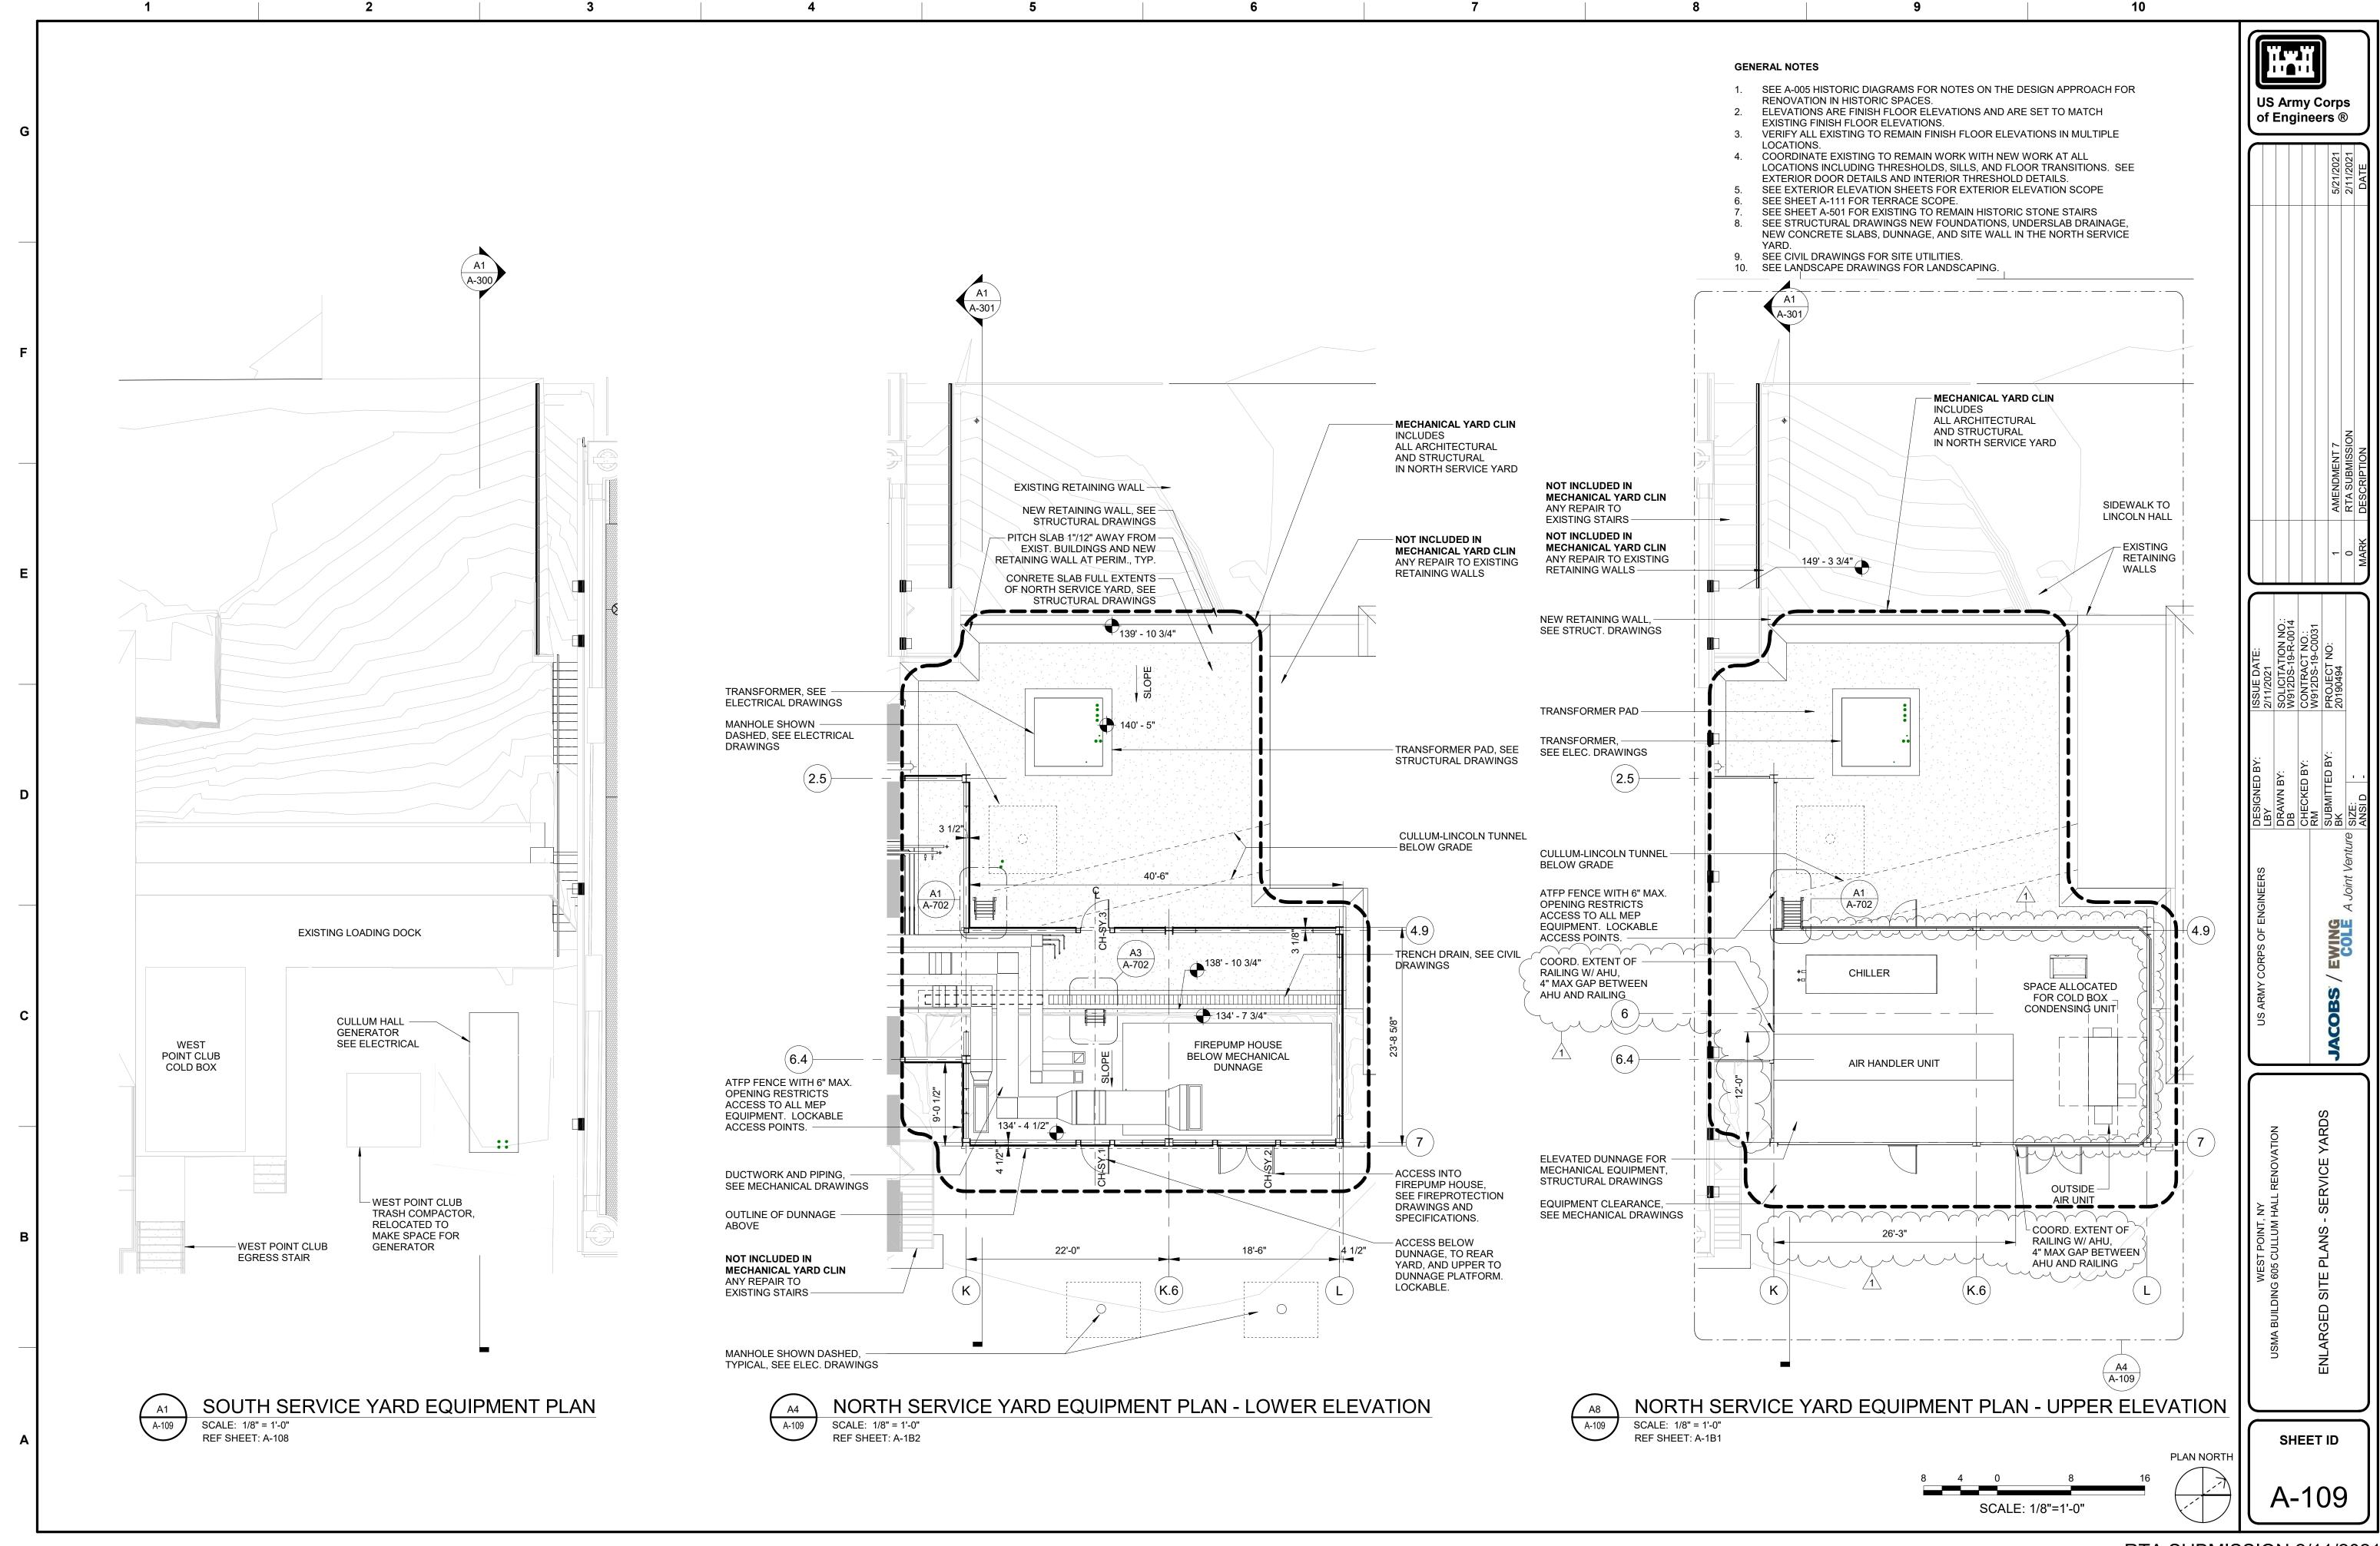

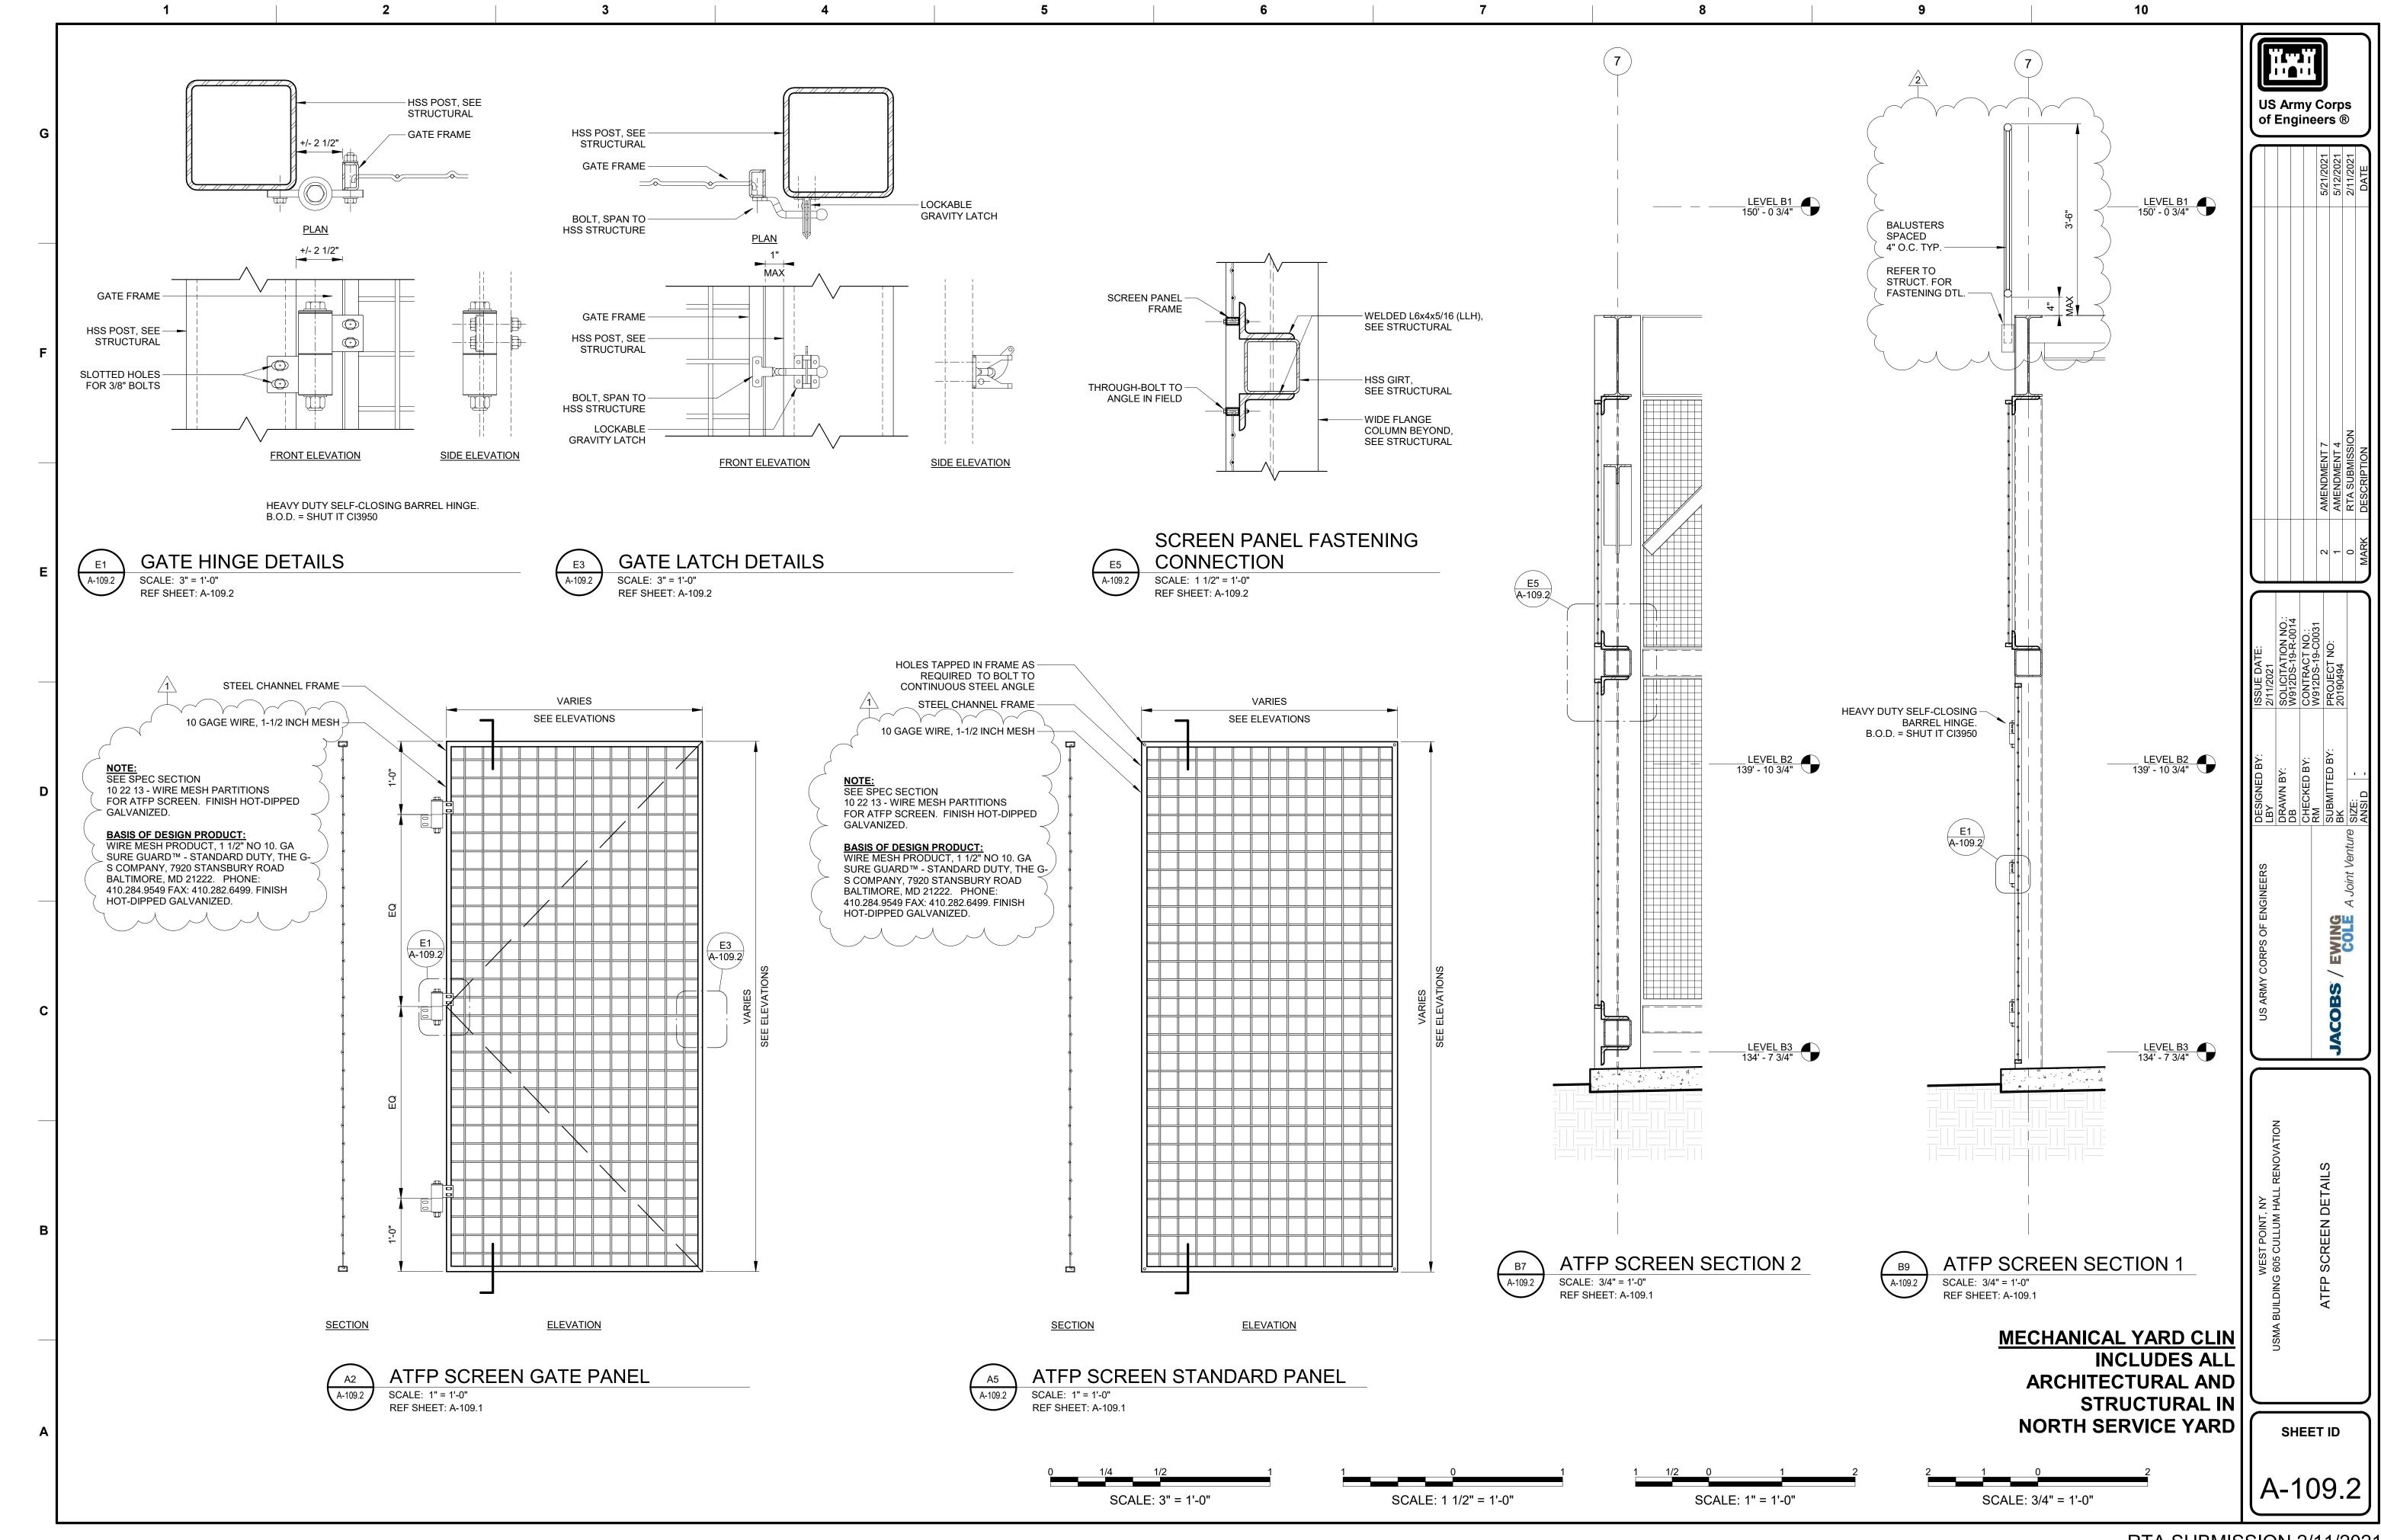

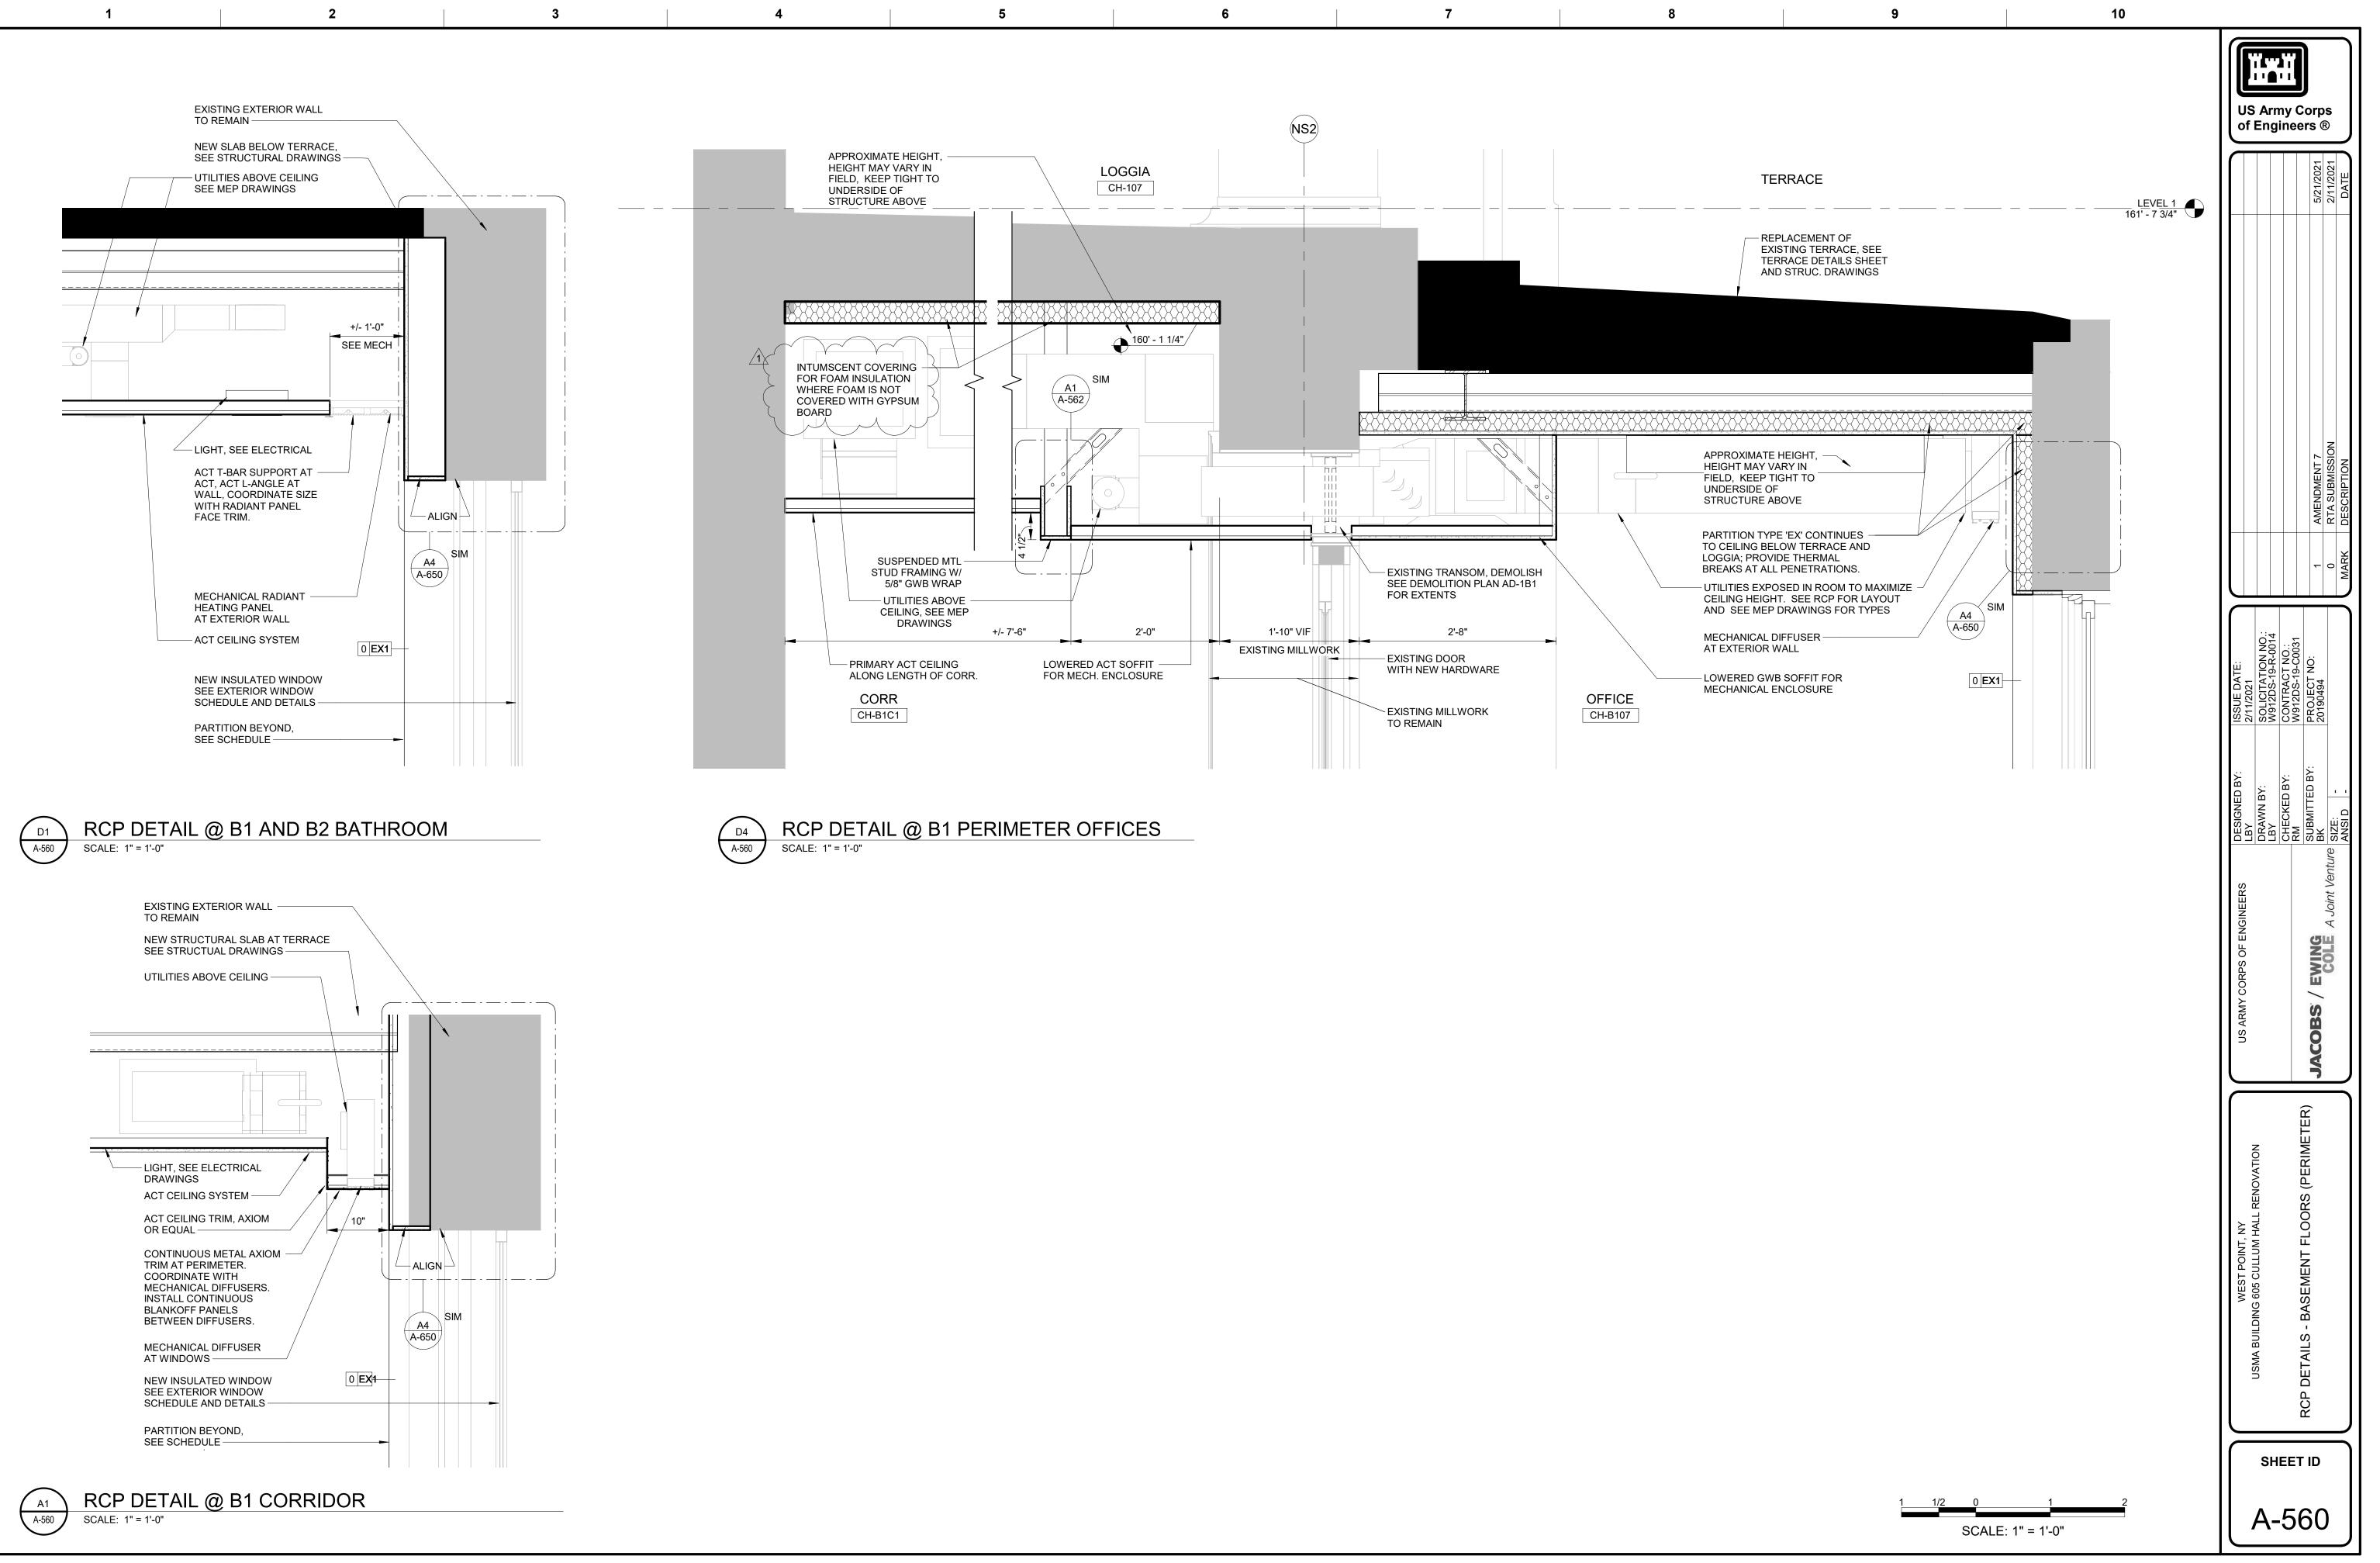

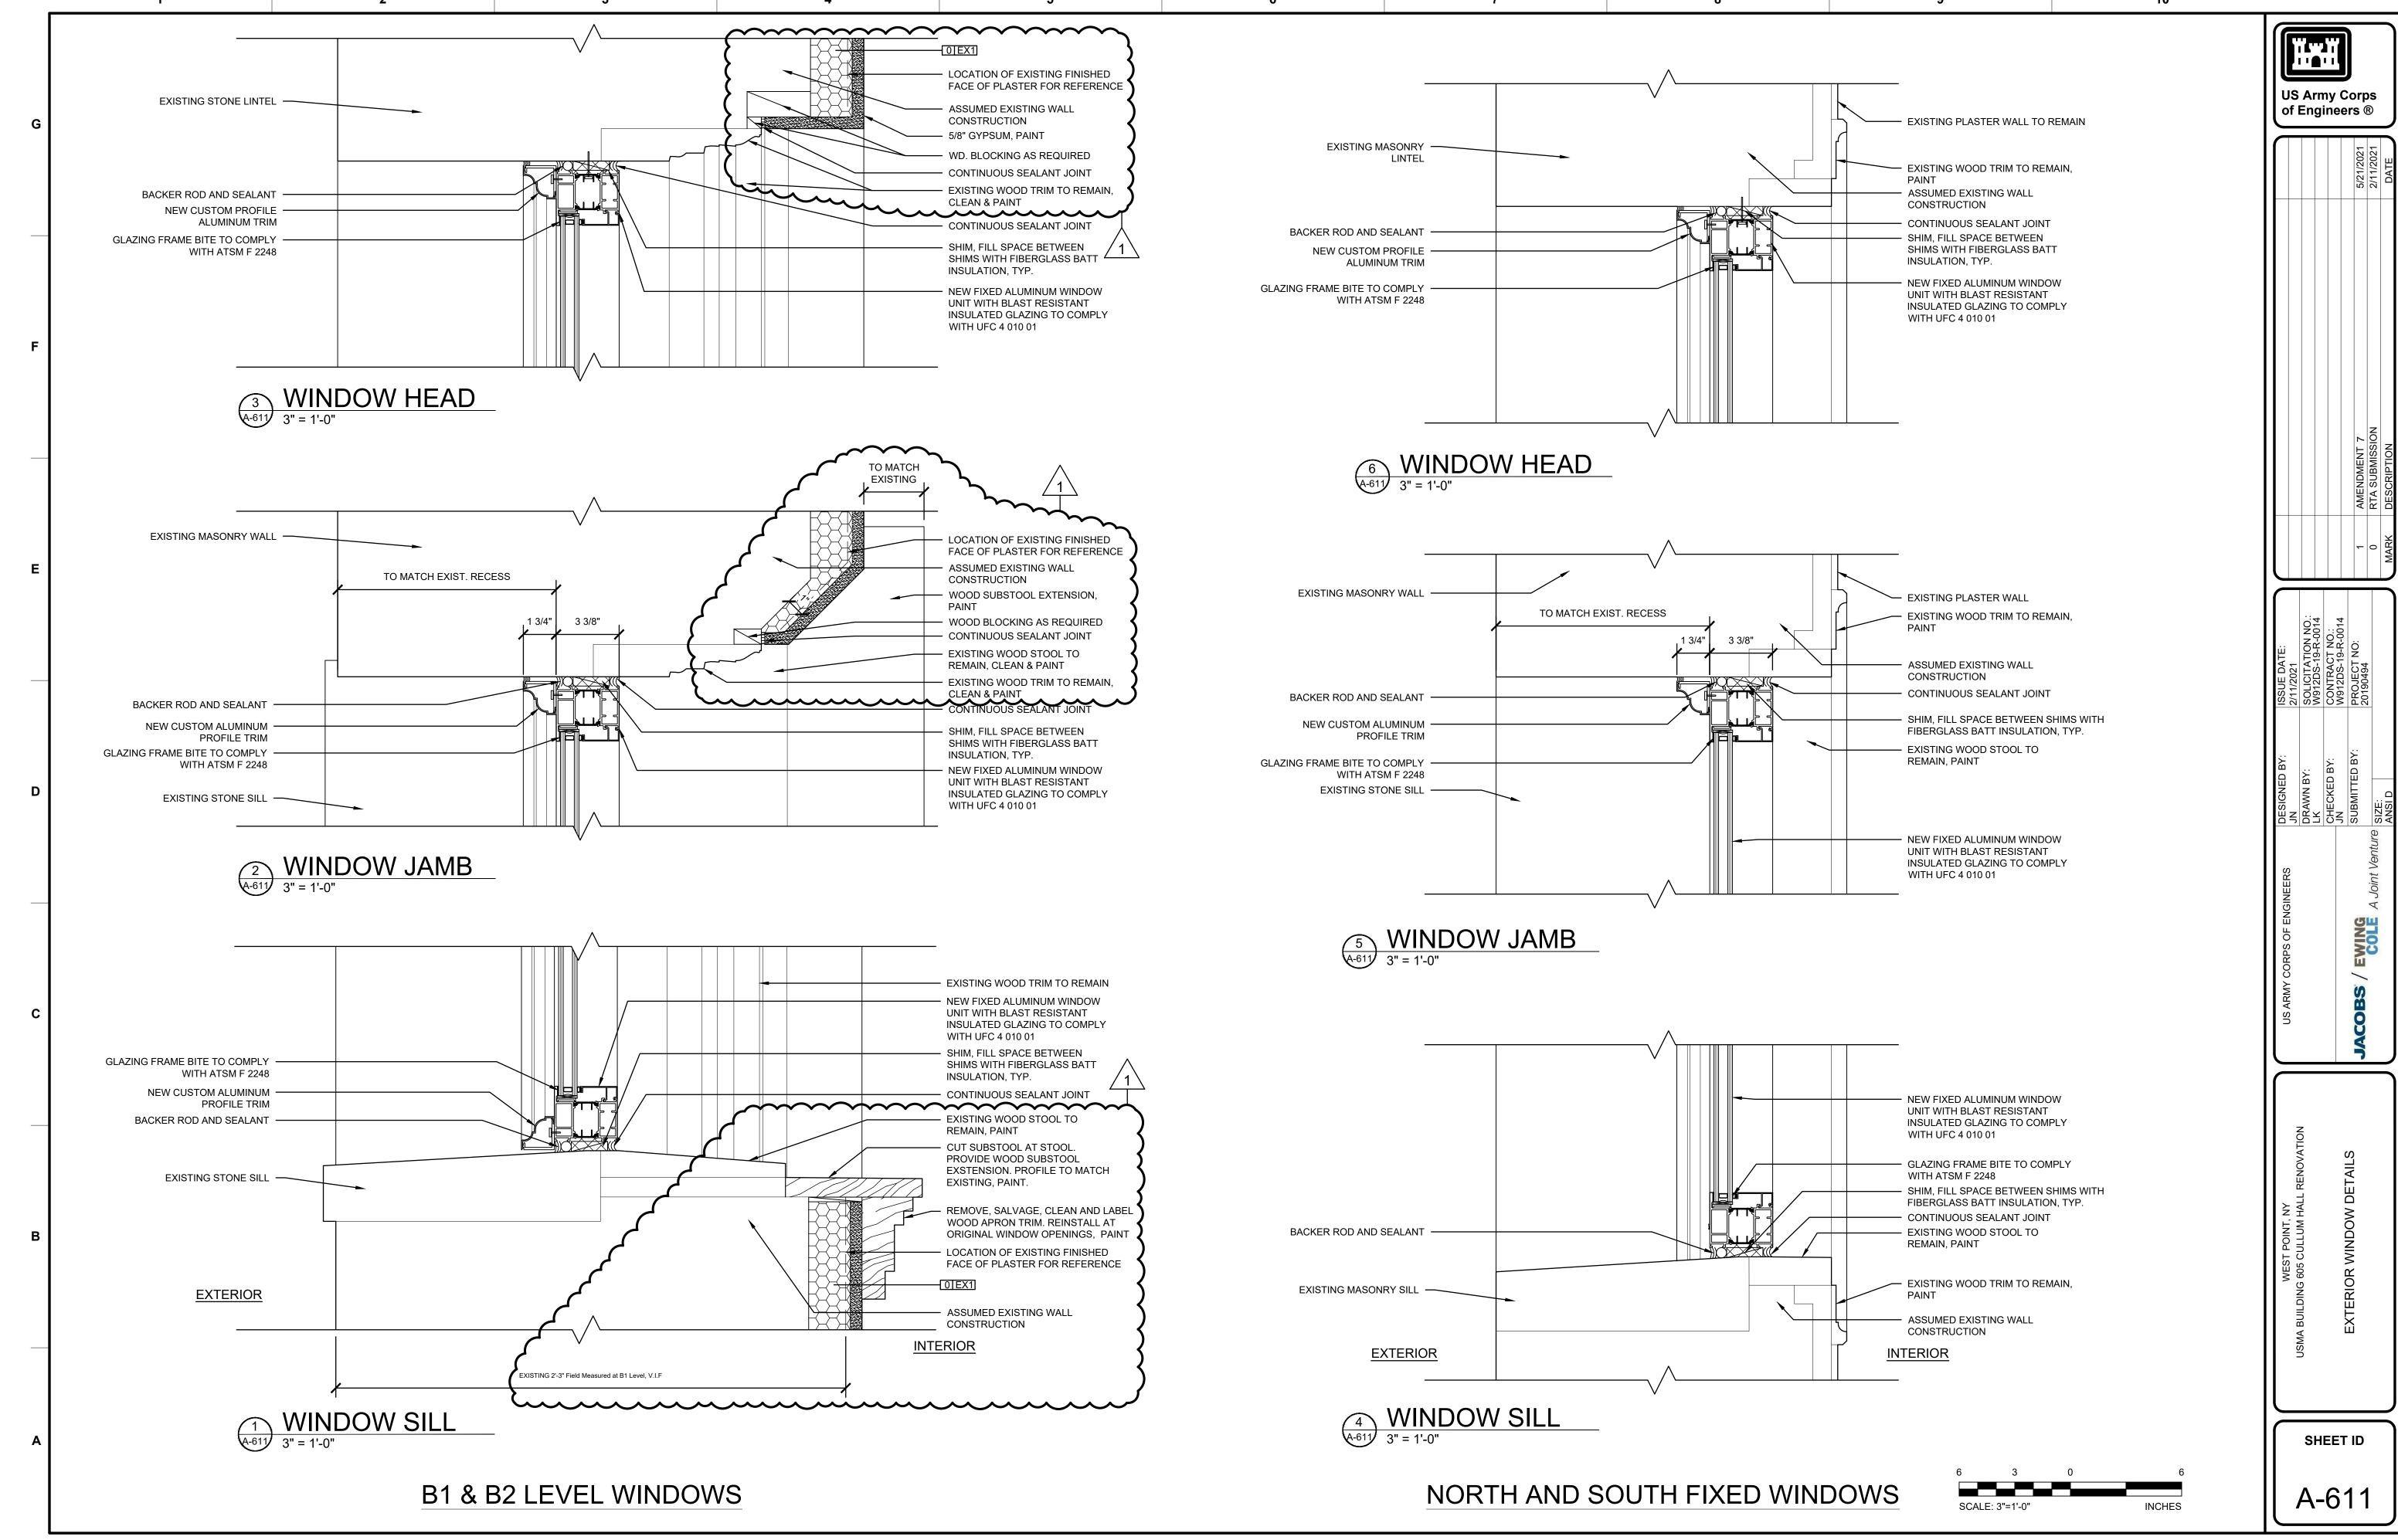

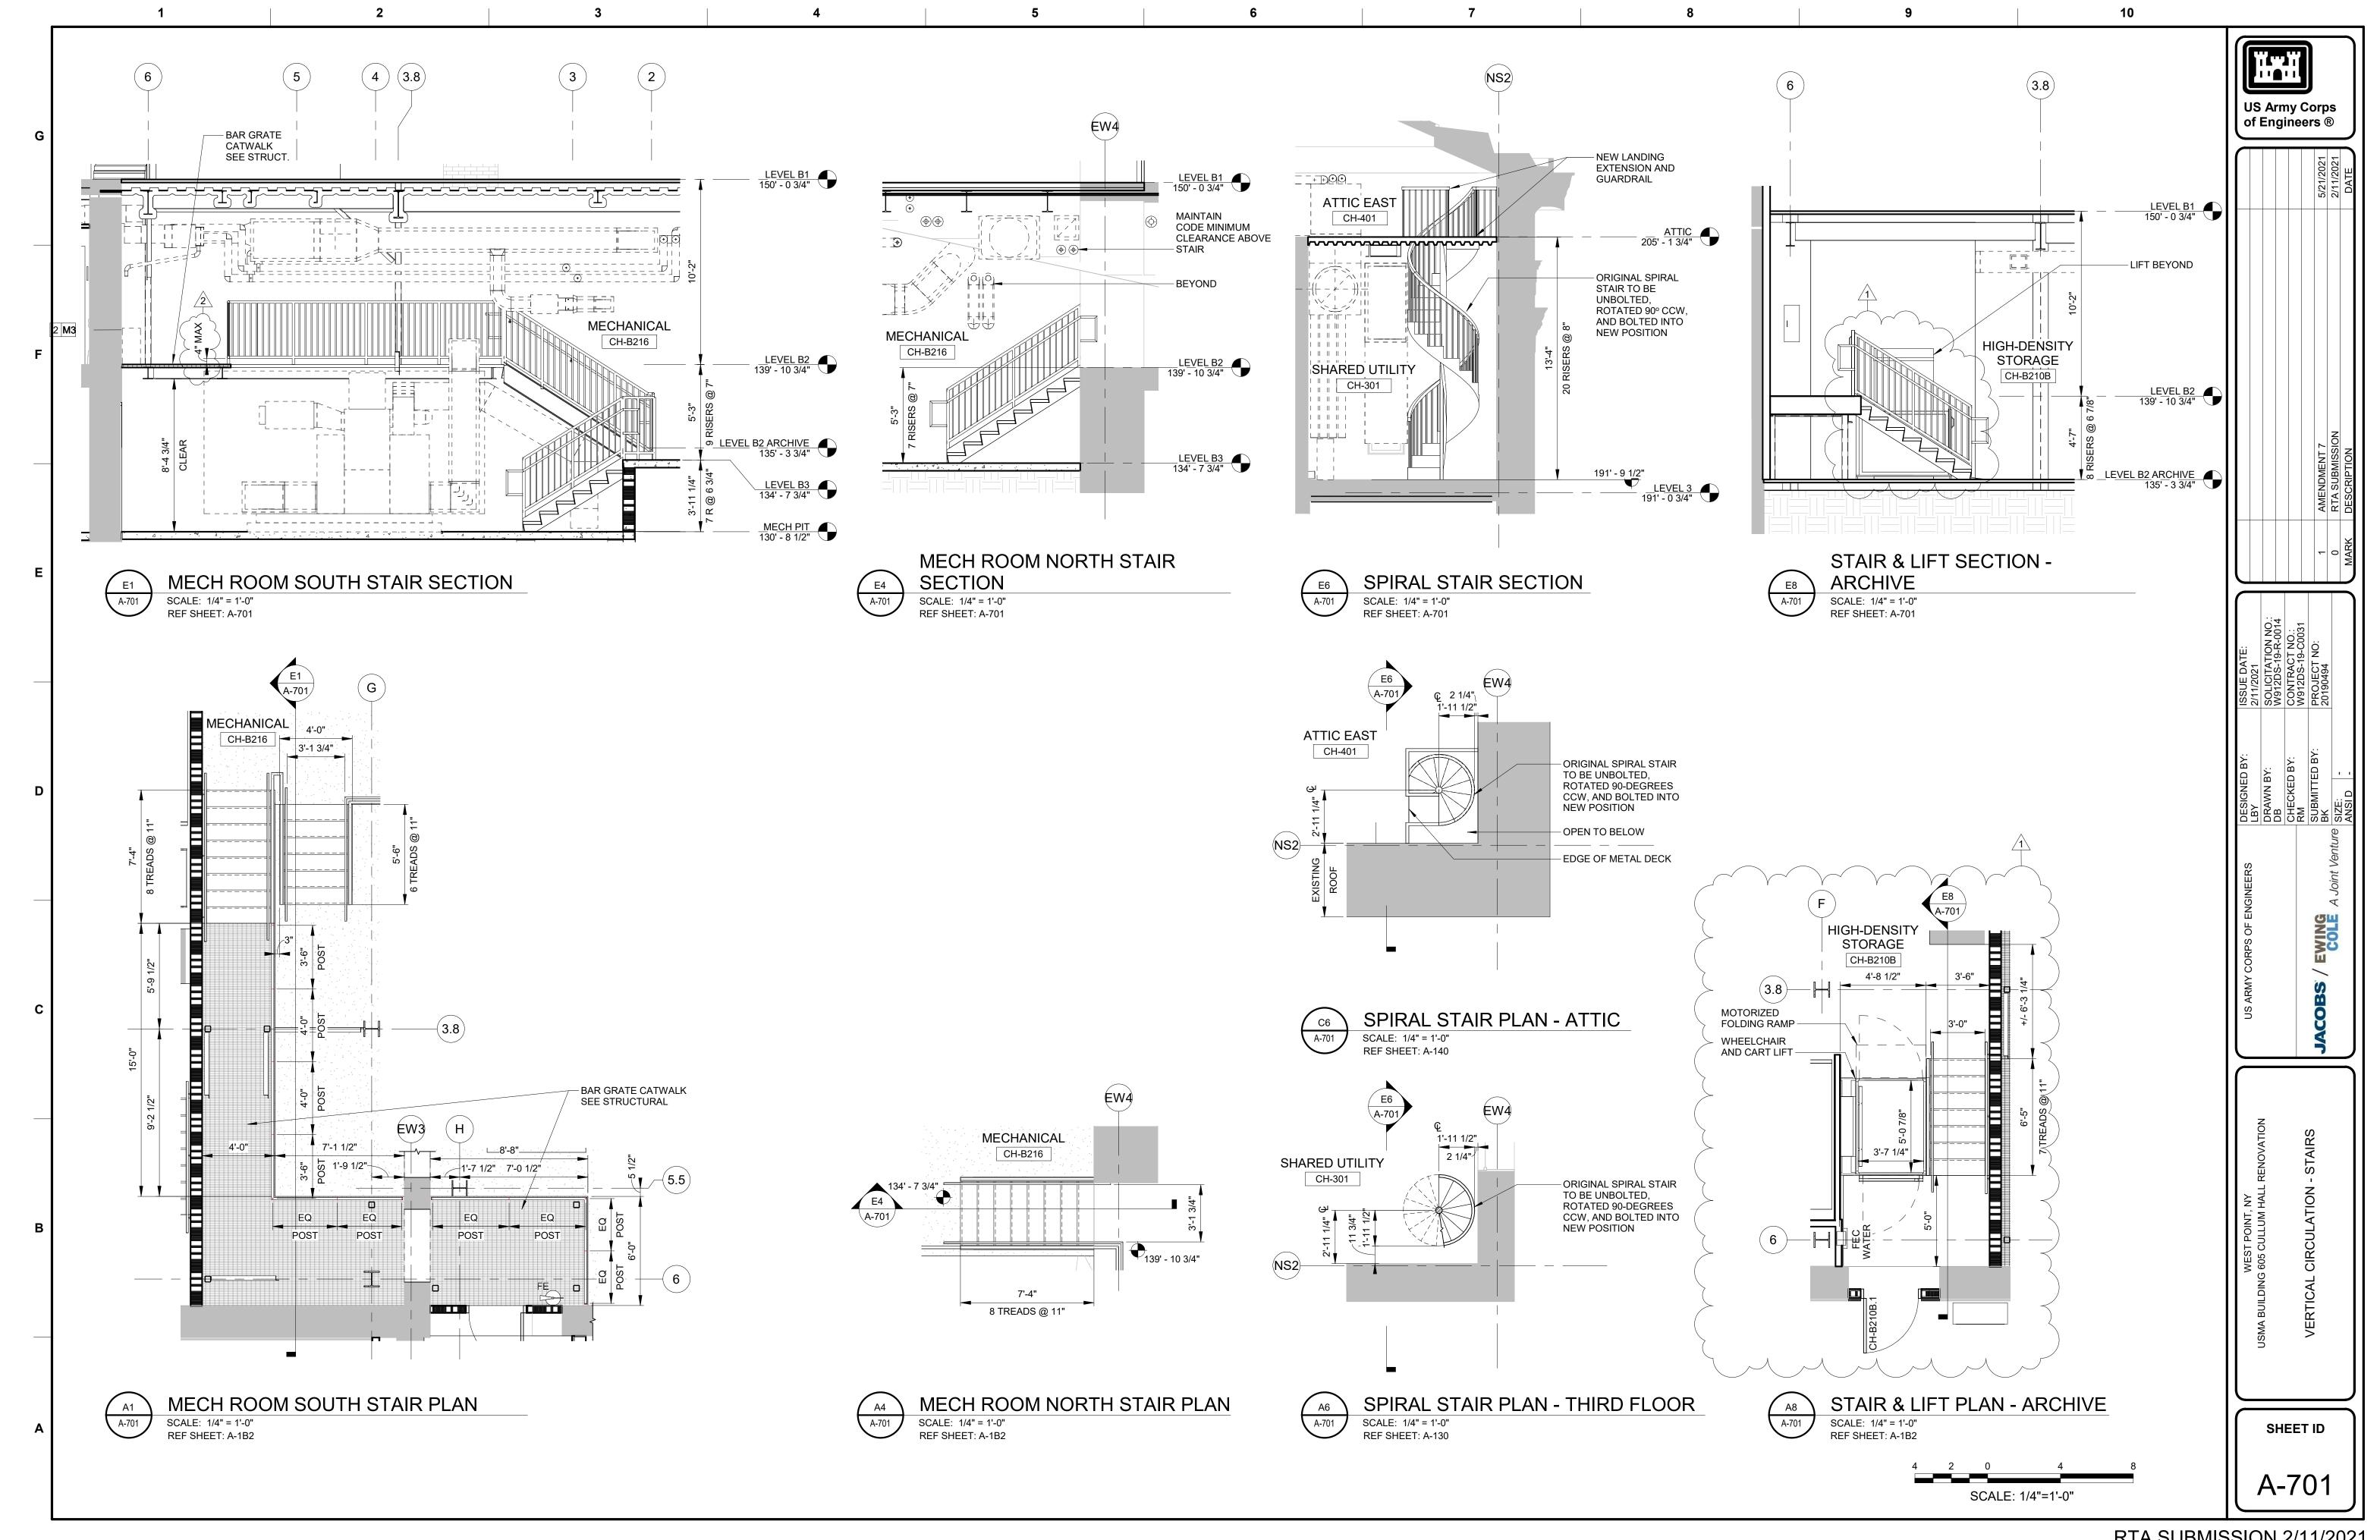

SHEET ID

||HPE-801|

				MECHAN	ICAL / PLI	<u>UMBI</u> NG	<b>EQUIPM</b>	ENT COOF	RDINATIO	N SCHEDULE										
		EQUIPMENT IDENTIFICATION							LOCAL D											
QUIPMENT TAG	DESCRIPTION	PHYSICAL LOCATION	AREA / SPACE SERVED	ELECTRICAL PANEL/SOURCE	HP FI	LA KW	VOLTS-Ø	UNFUSED SWITCH	FUSED SWITCH	FHP MAN. Motor Switch	PROVIDED BY	MAN. MAG.		MCP	NATION SW NF FU	ON/OFF SW		SSORIES HOA SW PILOT	PROVIDED BY	REMARKS (E.G. SKID MOUNTED, PACKAGED, ETC.)
AHU-1	SUPPLY FANS	BASEMENT MER	LEVELS B1 & B2 - ARCHIVES	DP-OS	(4) 5 3	30	460/3	1					X						DIV 23	EMERGENCY POWER
AHU-2	SUPPLY FANS	NORTH SERVICE YARD	LEVELS B1 & B2 - BUFFER ZONES	DP-M-1	(4) 5 3		460/3						Х						DIV 23	
	RETURN FANS	NORTH SERVICE YARD	LEVELS B1 & B2 - BUFFER ZONES	DP-M-1	(4) 3 1		460/3						Х						DIV 23	
AHU-3	SUPPLY FANS	ABOVE STAGE	LEVELS 1 & 2 - BALL ROOM & MEMORIAL ROOM	DP-M-2	(4) 7.5 4	14	460/3						X						DIV 23	
B-1	BOILER	BASEMENT MER	EMERGENCY HEATING	AP-OS-B1		1.7	120/1													EMERGENCY POWER / CP BY DIV 23
	20.21.			711 00 21			120/1													
CH-1	AIR-COOLED CHILLER	NORTH SERVICE YARD	EMERGENCY COOLING	DP-OS		31.86	460/3						Х						DIV 23	EMERGENCY POWER
					1															
CP-1	CONDENSATE PUMP	SEE DRAWINGS	FCU 2M-1 & FCU B3-1 & FCU B3-2		1/5	0.6	120/1	_							_		+			
CUH-1-1	CABINET UNIT HEATER	CH-103A	CH-103A	AP-M-B2	0.25	0.48	120/1	Х			DIV 23									
CUH-1-2	CABINET UNIT HEATER	CH-105	CH-105	AP-M-B2	0.25	0.48	120/1	Х			DIV 23									
CUH-B2-1	CABINET UNIT HEATER	B205	B205	AP-M-B2	0.13	0.3	120/1	Х			DIV 23									
CUH-B2-2	CABINET UNIT HEATER	B217	B217	AP-M-B2	0.13	0.3	120/1	Х			DIV 23									
CUH-B1-1	CABINET UNIT HEATER	B100	B100	AP-M-B2	0.13	0.3	120/1	X			DIV 23									
CUH-B1-2	CABINET UNIT HEATER	B122	B122	AP-M-B2	0.13	0.3	120/1	X			DIV 23									
CUH-B1-3	CABINET UNIT HEATER	NW STAIR	NW STAIR	AP-M-B2	0.13	0.3	120/1	<b>X</b>			DIV 23				_					
CR-1	CONDENSATE RECEIVER	BASEMENT MER	CULLUM CONDENSATE RETURN	DP-M-1	(2) 0.5	2	460/3	Х			DIV 23	Х						X	DIV 23	CP BY DIV 23
CR-2	CONDENSATE RECEIVER	TUNNEL	CULLUM/LINCOLN CONDENSATE RETURN	DP-M-1	(2) 0.5	2	460/3				DW 23	Х						Х	DIV 23	CP BY DIV 23
CDII D4 4	COMPUTED DOOM UNIT	MAIN TELECOM	MAINTELECOM	AD 00 D4	<del>                                     </del>	00	200/4		T Y	Ψ	T DIV 96		<del>                                     </del>							EMERGENCY POWER
CRU-B1-1 CRU-B1-2	COMPUTER ROOM UNIT	MAIN TELECOM MAIN TELECOM	MAIN TELECOM  MAIN TELECOM	AP-OS-B1 AP-OS-B1		30 30	208/1 208/1	X Y			DIV 26 4		+ +	-	+					EMERGENCY POWER  EMERGENCY POWER
OKO-D1-2		IIIAIN I LLLUUNI	MAIN ILLLOOM				200/1													LINEROLITOTI FOWER
DHU-1	DEHUMIDIFIER	BASEMENT MER	ARCHIVES	DP-OS		5	460/3	Х			DIV 26									EMERGENCY POWER
DHU-2	DEHUMIDIFIER	BASEMENT MER	COLD STORAGE	AP-OS-B1		2.35	208/1	Х			DIV 26	4	$\prod$							EMERGENCY POWER
EF-1	EXHAUST FAN	TUNNEL (EAST)	GENERAL EXHAUST	DP-M-1	1.5	3	460/3				DIV 23	1	+ +		+					
L1-1	LAHAGOTTAN	TORREE (EAST)	OLIVLINAL EXTINUOT	D1 -101-1	1.5	<b>,</b>	400/3				DIV 23									
EWH-1	ELECTRIC WATER HEATER	SEE DRAWINGS	RESTROOM SINKS	AP-M-B2		3.5	120/1													
EWH-2	ELECTRIC WATER HEATER	SEE DRAWINGS	GENERAL HOT WATER	AP-M-B2		1.5	120/1			Х	DIV 26									
FCU-B3-1	FAN COIL UNIT	TUNNEL NE	TUNNEL NE	AP-M-B2	0.03	0.5	208/1	Y			DIV 23									
FCU-B3-1	FAN COIL UNIT	TUNNEL SE	TUNNEL NE	AP-M-B2	0.03	0.5	208/1	<u>^</u> х			DIV 23				_		+			
FCU-B2-1	FAN COIL UNIT	B219	B219	AP-M-B2	0.23	0.6	208/1	X			DIV 23									
FCU-B1-1	FAN COIL UNIT	B120	B120	AP-M-B2	0.16	0.6	208/1	Х			DIV 23									
FCU-B1-2	FAN COIL UNIT	B118	B118	AP-M-B2	0.23	0.6	208/1	Х			DIV 23									
FCU-B1-3	FAN COIL UNIT	B118	B118	AP-M-B2	0.23	0.6	208/1	Х			DIV 23									
FCU-1-1	FAN COIL UNIT	CH-100	CH-100	AP-M-B2	0.16	0.6	208/1	X			DIV 23									
FCU-1-2	FAN COIL UNIT	CH-1S1	CH-1S1	AP-M-B2	0.04	0.3	208/1	X			DIV 23									
FCU-1-3 FCU-1-4	FAN COIL UNIT FAN COIL UNIT	CH-1S1 CH-102A	CH-1S1 CH-102A	AP-M-B2	0.04	0.3	208/1 208/1	X v			DIV 23 DIV 23									
FCU-1-5	FAN COIL UNIT	CH-102B	CH-102B	AP-M-B2	0.22	0.6	208/1	X			DIV 23									
FCU-1-6	FAN COIL UNIT	CH-104B	CH-104B, CH-106B	AP-M-B2	0.24	0.6	208/1	X			DIV 23							+ +		
FCU-1-7	FAN COIL UNIT	CH-103A	CH-101	AP-M-B2	0.09	0.6	208/1	Х			DIV 23									
FCU-2-1	FAN COIL UNIT	ATTIC SOUTH	CH-2S1, CH-3S1	AP-M-B2	0.32	0.6	208/1	Х			DIV 23									
FCU-2M-1	FAN COIL UNIT	ATTIC SOUTH	CH-300	AP-M-B2	0.24	0.6	208/1	Х			DIV 23									
FCU-3-1	FAN COIL UNIT	CH-301	CH-301	AP-M-B2	0.08	0.6	208/1	Х			DIV 23									
FCU-3-2	FAN COIL UNIT	CH-302	CH-302	AP-M-B2	0.16	0.6	208/1	X			DIV 23						+			
FZP-2A	CHW FREEZE PROTECTION PUMP	AHU-2 SERVICE VESTIBULE	AHU-2 SYSTEM	DP-M-1	1.5	3	460/3	1					+ +							
FZP-2B	HW FREEZE PROTECTION PUMP	AHU-2 SERVICE VESTIBULE	AHU-2 SYSTEM	AP-M-B2	0.5	4	120/1													
FZP-3	HW FREEZE PROTECTION PUMP	ATTIC NORTH	AHU-3 SYSTEM	AP-M-B2	0.5	4	120/1													
OFT 4	ALVANI EUL ATATION	DAGGUEUT MED	EMEDOCALON AUTH LED MATER AVAILA	DD 00	0/4		40010	v							<u> </u>					PMEDAENAY DAVIED
GFT-1	GLYCOL FILL STATION	BASEMENT MER	EMERGENCY CHILLED WATER SYSTEM	DP-OS	3/4	4	460/3	\ \ \ \ \ \ \ \ \ \ \ \ \ \ \ \ \ \ \					+ +		+		+			EMERGENCY POWER
HUM-1-1	HUMIDIFIER	BASEMENT MER	AHU-1 SYSTEM	DP-OS		56.1	460/3		Х		DIV 23									EMERGENCY POWER
HUM-2-1	HUMIDIFIER	BASEMENT MER	VAV 2-2	DP-M-1		3.7	460/1		Х		DIV 23									
HUM-2-2	HUMIDIFIER	TUNNEL	VAV 2-5	DP-M-1		7.5	460/3		Х		DIV 23									
HUM-2-3	HUMIDIFIER	TUNNEL	VAV 2-17	DP-M-1		7.5	460/3		Х		DIV 23									
OAU-1	OUTSIDE AIR UNIT	NORTH SERVICE YARD	AHU-1 SYSTEM	DP-OS	9	.5	460/3	Х			DIV 23			$\overline{}$	+					EMERGENCY POWER
											<u>-</u>									
P-1	CHILLED WATER PUMP	BASEMENT MER	CHILLED WATER SYSTEM	DP-OS	7.5 1	_	460/3	1					X						DIV 23	EMERGENCY POWER
P-2	CHILLED WATER PUMP	BASEMENT MER	CHILLED WATER SYSTEM	DP-OS	7.5 1		460/3	-					X				-		DIV 23	EMERGENCY POWER
P-3 P-4	HOT WATER PUMP HOT WATER PUMP	BASEMENT MER BASEMENT MER	HOT WATER SYSTEM HOT WATER SYSTEM	DP-OS DP-OS	5 5		460/3 460/3	-					X Y				+		DIV 23 DIV 23	EMERGENCY POWER EMERGENCY POWER
F ***	IIVI WATER FUMF	DAGENIEN I NIEK	HOI WATER STRIEM	DF-03			+00/3						_ ^			<u>L</u> _			חוא לא	LINILIGENCI FOWER
SP-1	SUMP PUMP	ELEVATOR PIT	ELEVATOR	AP-OS-B1	3/10	1.2	120/1													EMERGENCY POWER
SP-2	DUPLEX SUMP PUMP	MECH SERVICE																		
RF-1	RETURN FAN (AHU-1)	BASEMENT MER	AHU-1 SYSTEM	DP-OS	7.5	1	460/3						v		<del>-   -</del>		1		DIV 23	EMERGENCY POWER
RF-3A	RETURN FAN (AHU-1) RETURN FAN (AHU-3)	CH-302	AHU-1 SYSTEM AHU-3 SYSTEM	DP-OS DP-M-2	7.5 1 7.5 1		460/3	1				1	^     Y	_	+		+		DIV 23 DIV 23	EMERGENUT POWER
RF-3B	RETURN FAN (AHU-3)	CH-301	AHU-3 SYSTEM	DP-M-2	7.5		460/3	1	1				X		+				DIV 23	
	,																		<b>=v</b>	
III Da 4	UNIT HEATER	BASEMENT MER	BASEMENT MER	AP-M-B2		16W	120/1	X			DIV 23									
UH-B2-1	UNIT HEATER	AHU-2 SERVICE VESTIBULE	AHU-2 SERVICE VESTIBULE	AP-M-B2		16W	120/1	Х			DIV 23									
UH-B1-1	UNITHEATER		1	ii .	ı 1		1	1	1			a I		1	1	1	1	1	l l	
UH-B1-1		DEEED TO DDAWINGS	DELED TO UDYMINGS			Λ1	120/4						+ +							
	VARIABLE AIR VOLUME CONTROL BOX	REFER TO DRAWINGS	REFER TO DRAWINGS			0.1	120/1													
UH-B1-1		REFER TO DRAWINGS TUNNEL (NORTH)	REFER TO DRAWINGS TUNNEL (NORTH)	AP-M-B2	0.5	0.1	120/1	Х			DIV 23									