



4 REFERENCE PHOTO
A100 SCALE: NTS




5 REFERENCE PHOTO
A100 SCALE: NTS

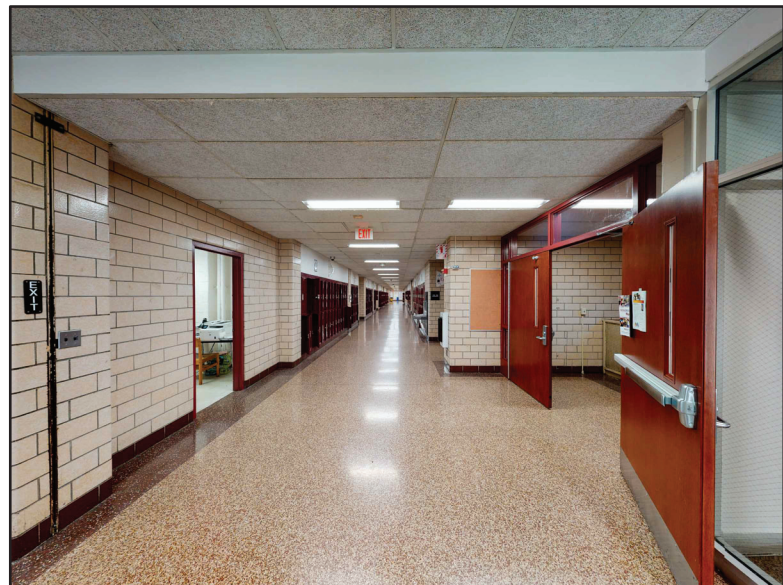

6 REFERENCE PHOTO
A100 SCALE: NTS

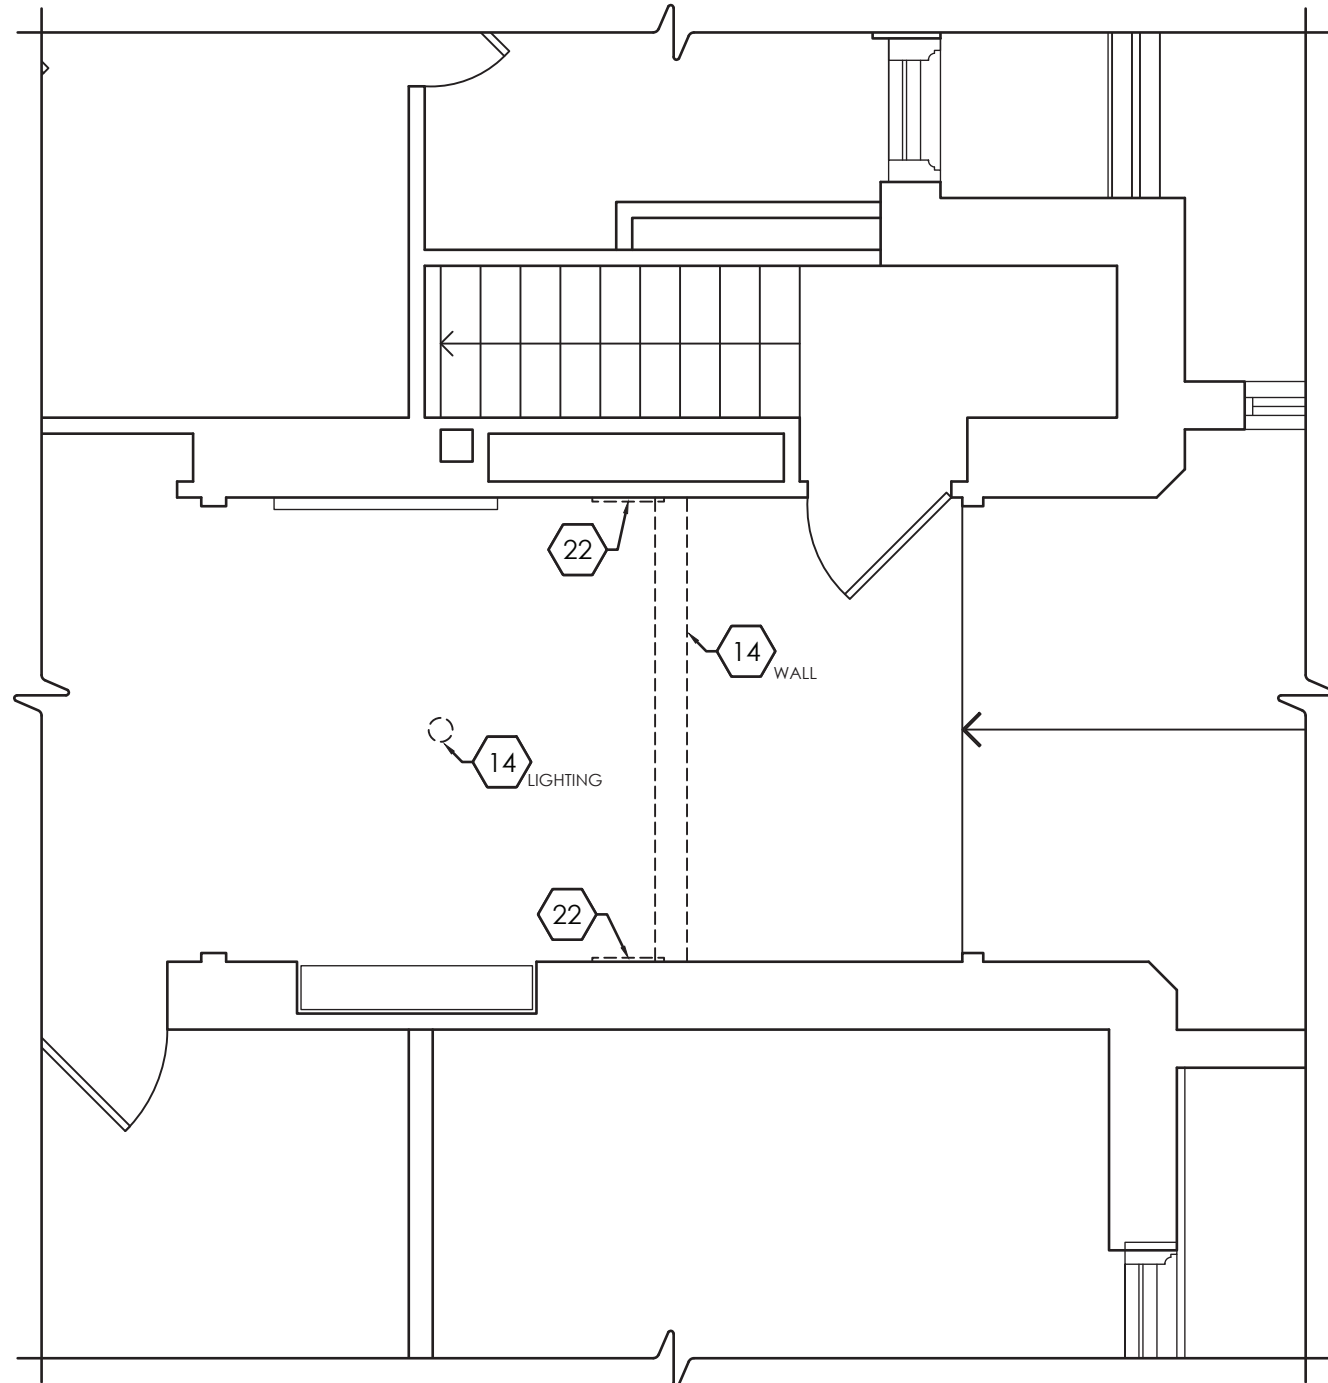

2 ENLARGED DEMOLITION PLAN
A100 SCALE: 1/4" = 1'-0"

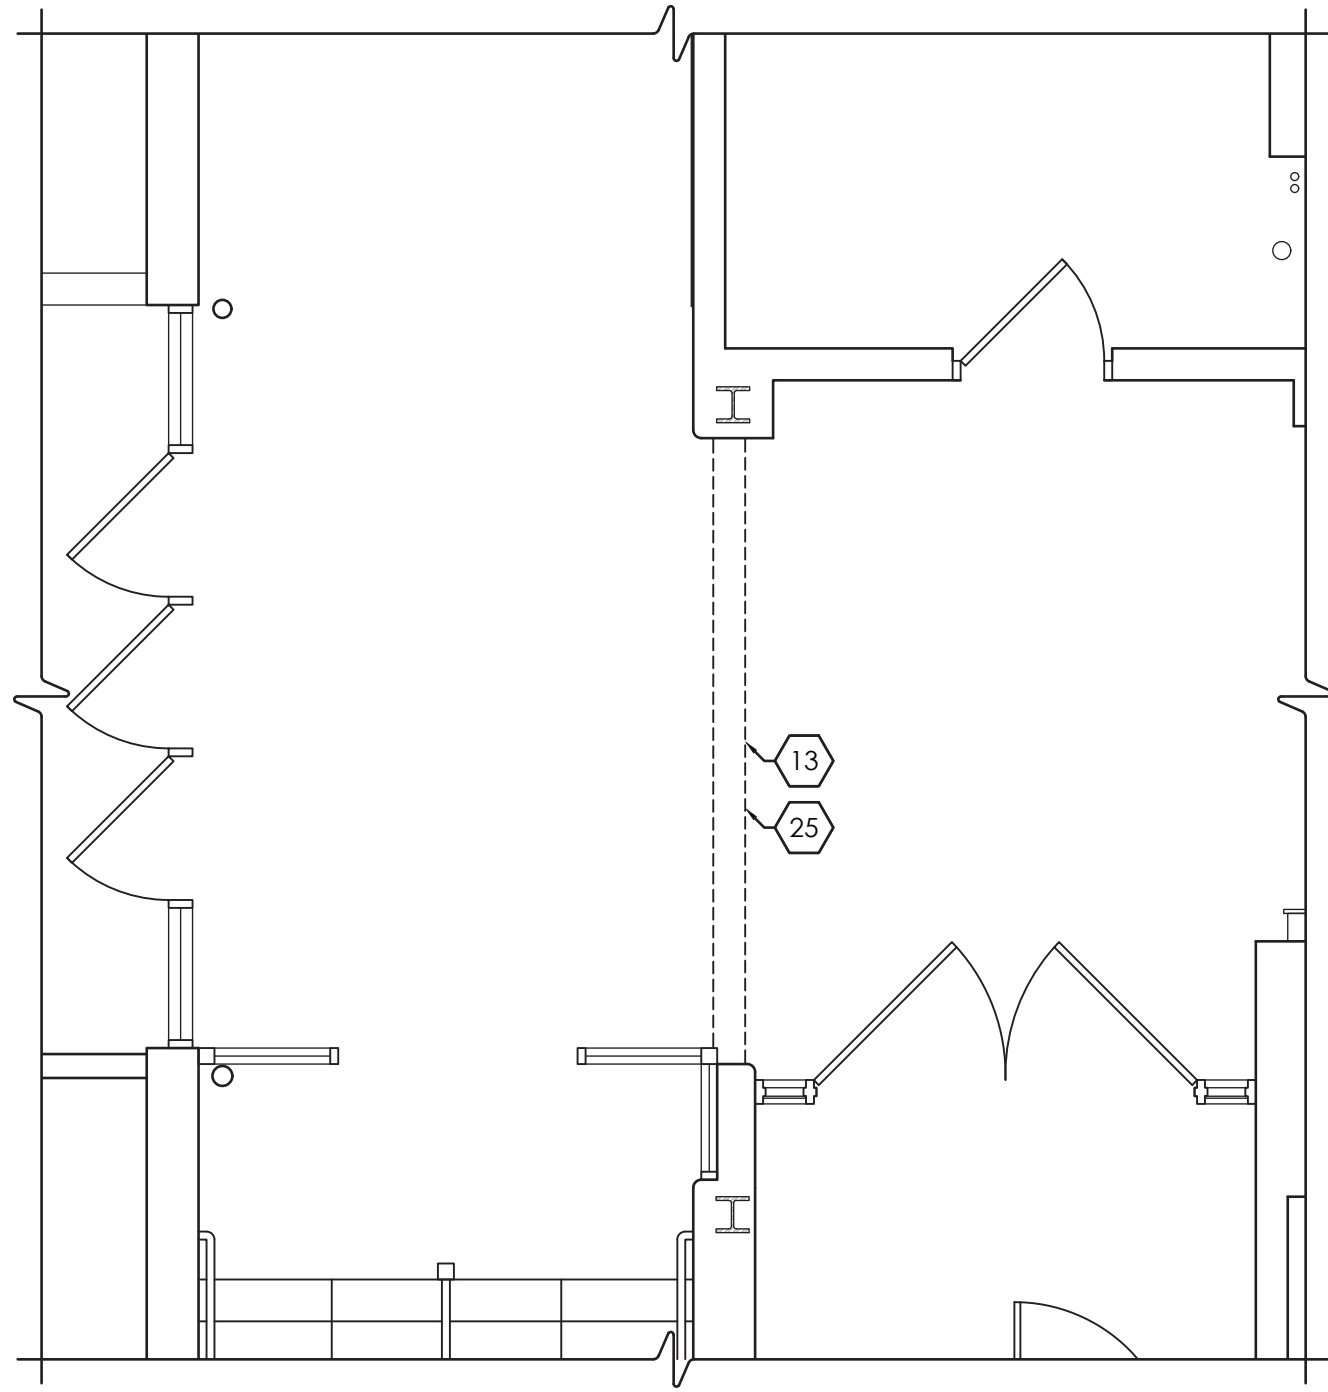


3 ENLARGED DEMOLITION PLAN
A100 SCALE: 1/4" = 1'-0"

GENERAL DEMOLITION NOTES:

- IT IS THE CONTRACTOR'S RESPONSIBILITY TO FAMILIARIZE THEMSELVES WITH ALL EXISTING CONDITIONS AND DETAILS INVOLVED IN THE DEMOLITION WORK.
- THE OWNER SHALL PROVIDE THE CONTRACTOR WITH A LIST OF ALL ITEMS TO BE SALVAGED PRIOR TO CONSTRUCTION.
- THE CONTRACTOR SHALL PROTECT ADJACENT SURFACES AND FINISHES NOT SCHEDULED FOR DEMOLITION WORK AND SHALL REPAIR ANY DAMAGED AREAS AS A RESULT OF CONTRACTED WORK AT NO ADDITIONAL COST TO THE OWNER.
- THE CONTRACTOR SHALL COORDINATE THE DEMOLITION WORK WITH THE OVERALL PROJECT PHASING.
- THE CONTRACTOR SHALL MAINTAIN AND CONTINUE SAFE ACCESS TO ALL EXITS FOR THE BUILDING OCCUPANTS DURING CONSTRUCTION.

DEMOLITION NOTES:

- REMOVE EXISTING WINDOW & FRAME IN ITS ENTIRETY.
- REMOVE EXISTING WALL IN ITS ENTIRETY. PATCH ADJACENT AREAS WITH LIKE CONSTRUCTION AS NECESSARY. PREPARE AREA TO ACCOMMODATE NEW WORK.
- REMOVE EXISTING DOOR AND FRAME. PREPARE AREA TO ACCOMMODATE NEW WORK.
- REMOVE EXISTING LOCKERS IN THEIR ENTIRETY. PATCH ADJACENT AREAS WITH LIKE CONSTRUCTION AS NECESSARY.
- REMOVE EXISTING CHALKBOARD, TACKBOARD IN ITS ENTIRETY. PREPARE AREA TO ACCOMMODATE NEW WORK.
- REMOVE UNIT VENTILATOR IN ITS ENTIRETY (BY HVAC CONTRACTOR). PREPARE AREA TO ACCOMMODATE NEW WORK.
- REMOVE EXISTING CHAIR RAIL IN ITS ENTIRETY. PREPARE FOR NEW WORK. PATCH AS NECESSARY.
- REMOVE EXISTING VINYL FLOORING AS NEEDED TO ACCOMMODATE FOR NEW WORK. PATCH TO MATCH EXISTING.
- REMOVE EXISTING WALL BASE IN ITS ENTIRETY. PREPARE FOR NEW WORK.
- REMOVE EXISTING SUSPENDED CEILING SYSTEM IN ITS ENTIRETY, INCLUDING ALL ASSOCIATED ITEMS SUCH AS HANGERS, CLIPS, ETC. REMOVE ALL ITEMS AS REQUIRED TO ALLOW ACCESS TO UNDERSIDE OF CONCRETE DECK, INCLUDING ABANDONED FORMWORK. PREPARE FOR NEW WORK, INCLUDING PREPARING UNDERSIDE OF CONCRETE DECK TO INTERNATIONAL CONCRETE REPAIR INSTITUTE (ICRI) CONCRETE SURFACE PROFILE CSP-3. PATCH CONCRETE DECK AS NEEDED TO ACCOMMODATE NEW WORK.
- REMOVE EXISTING MECHANICAL FIN TUBE AND COVER IN ITS ENTIRETY TO ACCOMMODATE FOR NEW WORK.
- REMOVE EXISTING UNIT VENTILATOR IN ITS ENTIRETY TO ACCOMMODATE FOR NEW WORK.
- REMOVE EXISTING CEILING SYSTEM IN ITS ENTIRETY TO ACCOMMODATE FOR NEW WORK.
- REMOVE/CUT AWAY EXISTING PLASTER CEILING TO ACCOMMODATE FOR NEW WORK. PATCH NEARBY AREAS AS NECESSARY.
- REMOVE EXISTING ROOF DRAIN TO ACCOMMODATE FOR NEW WORK. REFERENCE PLUMBING DRAWINGS.
- REMOVE EXISTING ROOF IN ITS ENTIRETY (MEMBRANE, INSULATION, FLASHING, & STRUCTURAL FRAMING (ABOVE ROOF SLAB), ETC.), TO ACCOMMODATE FOR NEW WORK.
- REMOVE PORTION OF WALL TO ACCOMMODATE FOR NEW WORK. PATCH AS NECESSARY.
- CUT OFF CANTILEVER OF EXISTING CONCRETE FLOOR/ROOF SLAB. SEE STRUCTURAL.
- REMOVE PORTION OF EXISTING SOFFIT TO ACCOMMODATE NEW WORK. PATCH NEARBY AREAS AS NEEDED.
- REMOVE EXISTING CONSTRUCTION DOWN TO TOP OF EXISTING BRICK PATCH AS NECESSARY.
- REMOVE BUILDING'S ORIGINAL SIGNAGE IN ITS ENTIRETY TO ACCOMMODATE NEW WORK.
- REMOVE AND RELOCATE PLAQUES AS DIRECTED BY OWNER.
- REMOVE AND REINSTALL EXISTING SUSPENDED CEILING AS NEEDED TO ACCOMMODATE ABATEMENT, HVAC, & ELECTRICAL WORK.
- MODIFY EXISTING GYPSUM BOARD CEILING AS REQUIRED TO ACCOMMODATE NEW WORK.
- REMOVE EXISTING OVERHEAD COILING DOOR FROM ABOVE CEILING TO ACCOMMODATE FOR NEW WORK.
- MODIFY EXISTING DROP CEILING SYSTEM TO ACCOMMODATE NEW WORK.
- REMOVE AND REPLACE EXISTING GYPSUM BOARD CEILING AS NEEDED TO ACCOMMODATE ABATEMENT, HVAC & ELECTRICAL WORK.
- REMOVE AND REPLACE EXISTING GYPSUM BOARD CEILING IN ITS ENTIRETY. PROVIDE WORK OF KEY NOTE 10 ALSO (CONCRETE DECK PREPARATION, ETC.).
- REMOVE EXISTING CEILING SYSTEM IN ITS ENTIRETY.

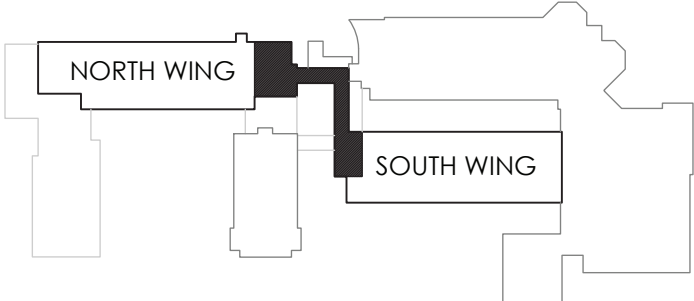

KEY PLAN
OSSINING HIGH SCHOOL
NOT TO SCALE



CPLteam.com
ARCHITECTURE • ENGINEERING • PLANNING

50 FRONT STREET, SUITE 202
NEWBURGH, NEW YORK 12550
TEL (800) 274-9000
FAX (845) 567-9614

REVISIONS	NO.	DATE	BY	DESCRIPTION
	1	12/2/2021		BID ADDENDUM 01

OSSINING UFSD
OSSINING HIGH SCHOOL
THIRD FLOOR CONNECTOR
29 SOUTH HIGHLAND AVENUE, OSSINING, NY 10562
SED #: 66-14-01-03-0-003-040

DATE	DRAWN	CHECKED
3/12/2021	NWH	MJ
SCALE AS NOTED		
SHEET TITLE		
FIRST FLOOR DEMOLITION PLAN		


PROJECT NUMBER
14428.13
OHS
A100
DRAWING NUMBER

Plotted By: Mark Johnson


Date last plotted: 12/2/2021 11:52 AM

Date last accessed: 12/1/2021 5:39 PM


Drawing Name: S:\Projects\Ossining UFSD\OHS 3rd Flr Connector\06 CAD\AutoCAD\ARCH\A1\OHS A100.dwg

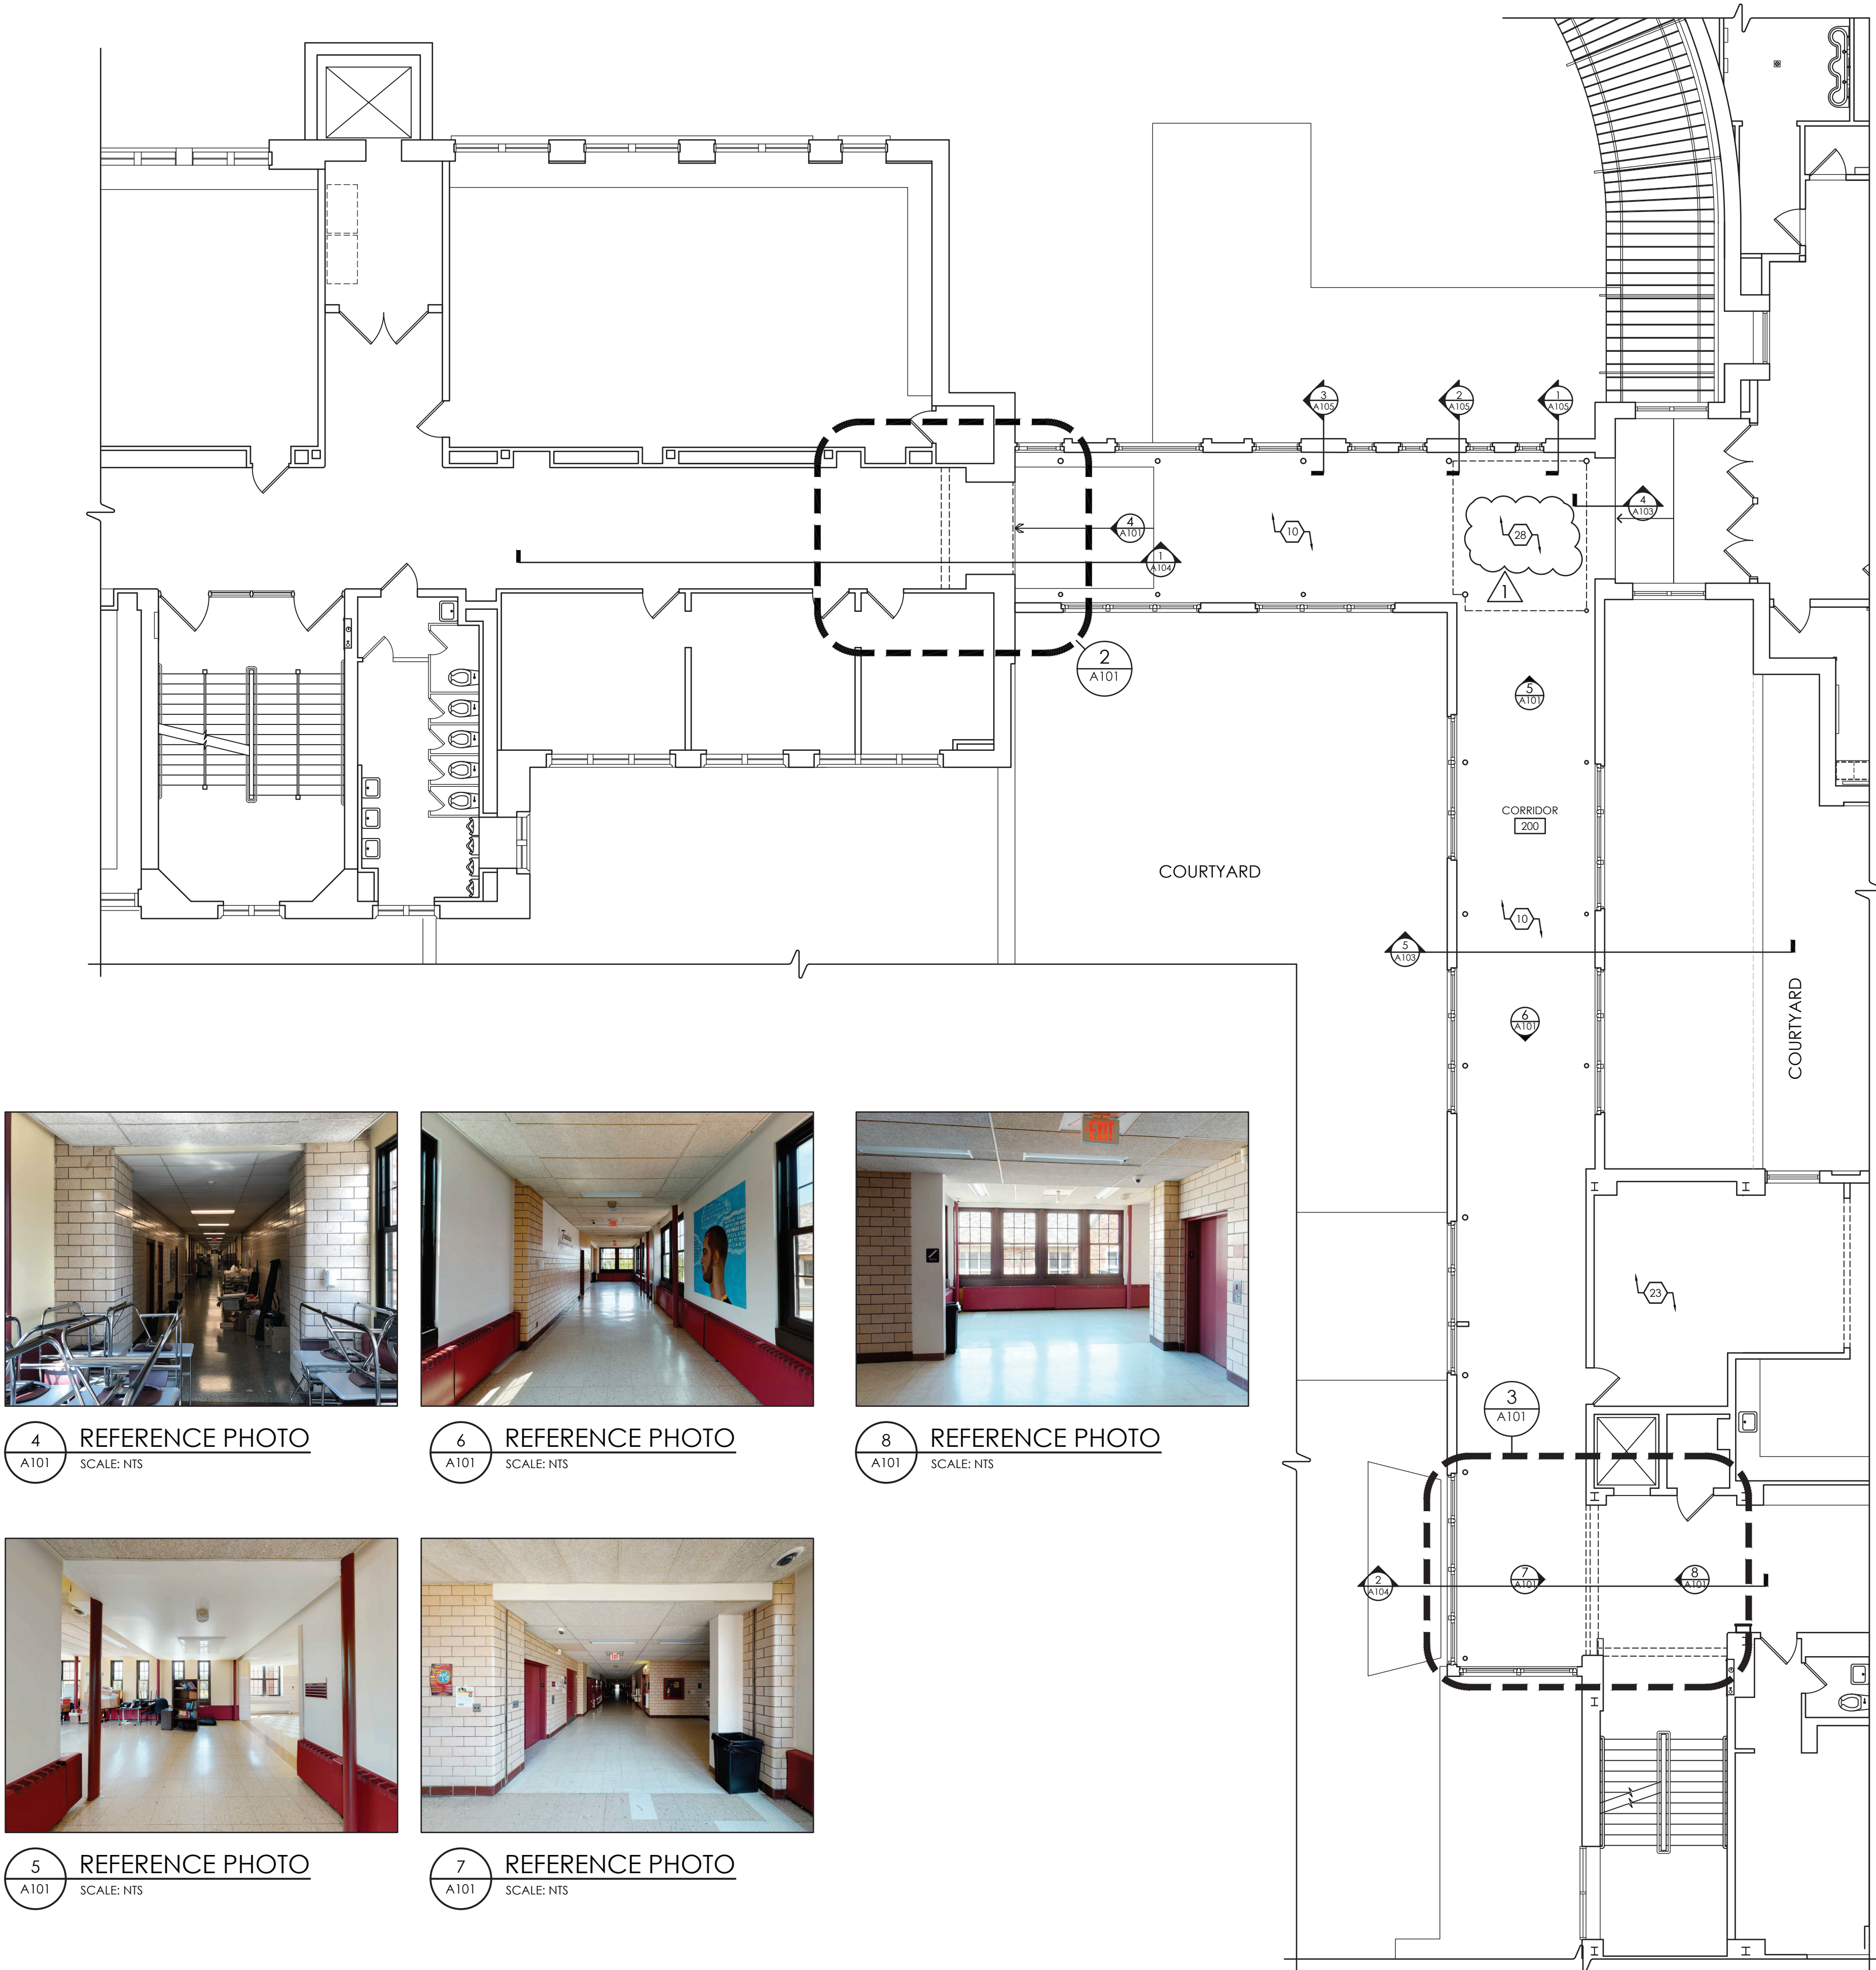


4 REFERENCE PHOTO
A101 SCALE: NTS

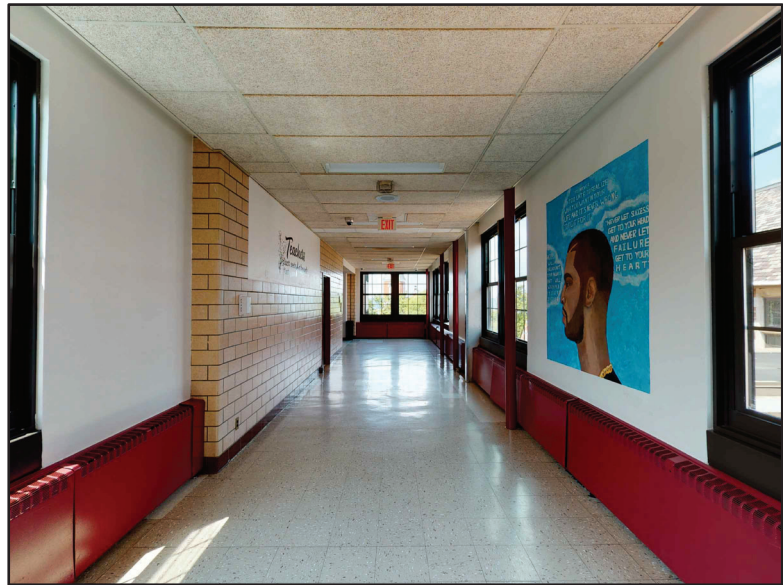


6 REFERENCE PHOTO
A101 SCALE: NTS

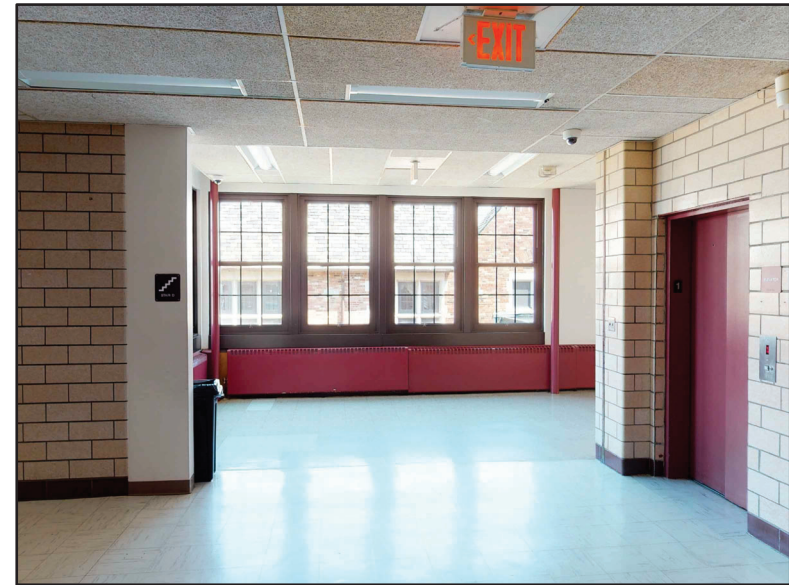

8 REFERENCE PHOTO
A101 SCALE: NTS

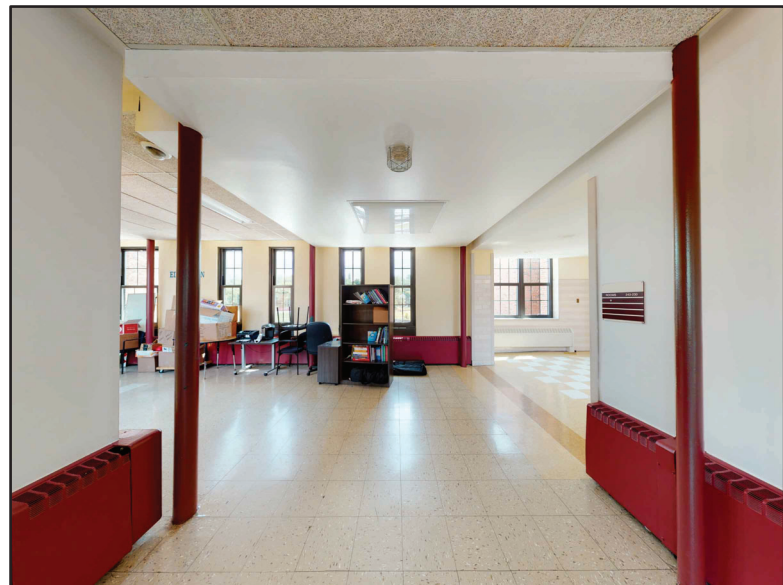

5 REFERENCE PHOTO
A101 SCALE: NTS

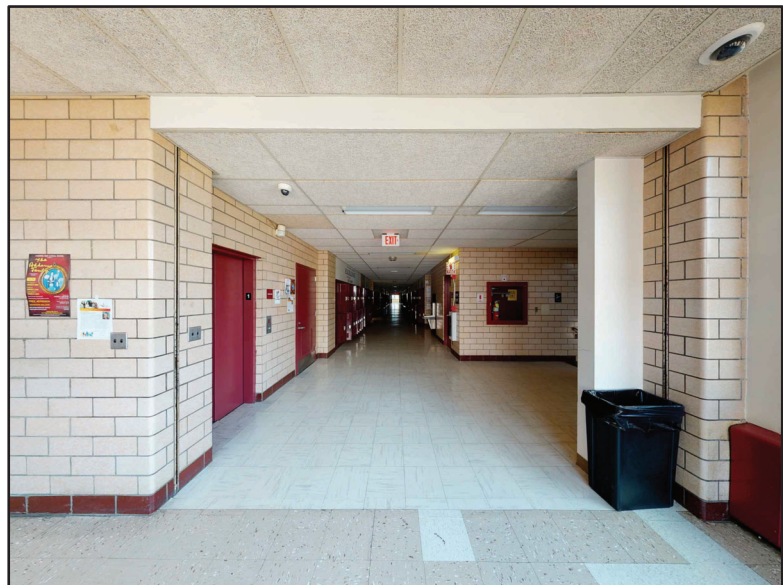


7 REFERENCE PHOTO
A101 SCALE: NTS

GENERAL DEMOLITION NOTES:

- IT IS THE CONTRACTOR'S RESPONSIBILITY TO FAMILIARIZE THEMSELVES WITH ALL EXISTING CONDITIONS AND DETAILS INVOLVED IN THE DEMOLITION WORK.
- THE OWNER SHALL PROVIDE THE CONTRACTOR WITH A LIST OF ALL ITEMS TO BE SALVAGED PRIOR TO CONSTRUCTION.
- THE CONTRACTOR SHALL PROTECT ADJACENT SURFACES AND FINISHES NOT SCHEDULED FOR DEMOLITION WORK AND SHALL REPAIR ANY DAMAGED AREAS AS A RESULT OF CONTRACTED WORK AT NO ADDITIONAL COST TO THE OWNER.
- THE CONTRACTOR SHALL COORDINATE THE DEMOLITION WORK WITH THE OVERALL PROJECT PHASING.
- THE CONTRACTOR SHALL MAINTAIN AND CONTINUE SAFE ACCESS TO ALL EXITS FOR THE BUILDING OCCUPANTS DURING CONSTRUCTION.

DEMOLITION NOTES:

- REMOVE EXISTING WINDOW & FRAME IN ITS ENTIRETY.
- REMOVE EXISTING WALL IN ITS ENTIRETY. PATCH ADJACENT AREAS WITH LIKE CONSTRUCTION AS NECESSARY. PREPARE AREA TO ACCOMMODATE NEW WORK.
- REMOVE EXISTING DOOR AND FRAME. PREPARE AREA TO ACCOMMODATE NEW WORK.
- REMOVE EXISTING LOCKERS IN THEIR ENTIRETY. PATCH ADJACENT AREAS WITH LIKE CONSTRUCTION AS NECESSARY.
- REMOVE EXISTING CHALKBOARD, TACKBOARD IN ITS ENTIRETY. PREPARE AREA TO ACCOMMODATE NEW WORK.
- REMOVE UNIT VENTILATOR IN ITS ENTIRETY (BY HVAC CONTRACTOR). PREPARE AREA TO ACCOMMODATE NEW WORK.
- REMOVE EXISTING CHAIR RAIL IN ITS ENTIRETY. PREPARE FOR NEW WORK. PATCH AS NECESSARY.
- REMOVE EXISTING VINYL FLOORING AS NEEDED TO ACCOMMODATE FOR NEW WORK. PATCH TO MATCH EXISTING.
- REMOVE EXISTING WALL BASE IN ITS ENTIRETY. PREPARE FOR NEW WORK.
- REMOVE EXISTING SUSPENDED CEILING SYSTEM IN ITS ENTIRETY, INCLUDING ALL ASSOCIATED ITEMS SUCH AS HANGERS, CLIPS, ETC. REMOVE ALL ITEMS AS REQUIRED TO ALLOW ACCESS TO UNDERSIDE OF CONCRETE DECK, INCLUDING ABANDONED FORMWORK. PREPARE FOR NEW WORK, INCLUDING PREPARING UNDERSIDE OF CONCRETE DECK TO INTERNATIONAL CONCRETE REPAIR INSTITUTE (ICRI) CONCRETE SURFACE PROFILE CSP-3. PATCH CONCRETE DECK AS NEEDED TO ACCOMMODATE NEW WORK.
- REMOVE EXISTING MECHANICAL FIN TUBE AND COVER IN ITS ENTIRETY TO ACCOMMODATE FOR NEW WORK.
- REMOVE EXISTING UNIT VENTILATOR IN ITS ENTIRETY TO ACCOMMODATE FOR NEW WORK.
- REMOVE EXISTING CEILING SYSTEM IN ITS ENTIRETY TO ACCOMMODATE FOR NEW WORK.
- REMOVE/CUT AWAY EXISTING PLASTER CEILING TO ACCOMMODATE FOR NEW WORK. PATCH NEARBY AREAS AS NECESSARY.
- REMOVE EXISTING ROOF DRAIN TO ACCOMMODATE FOR NEW WORK. REFERENCE PLUMBING DRAWINGS.
- REMOVE EXISTING ROOF IN ITS ENTIRETY (MEMBRANE, INSULATION, FLASHING, & STEEL FRAMING (ABOVE ROOF SLAB), ETC.), TO ACCOMMODATE FOR NEW WORK.
- REMOVE PORTION OF WALL TO ACCOMMODATE FOR NEW WORK. PATCH AS NECESSARY.
- CUT OFF CANTILEVER OF EXISTING CONCRETE FLOOR/ROOF SLAB. SEE STRUCTURAL.
- REMOVE PORTION OF EXISTING SOFFIT TO ACCOMMODATE NEW WORK. PATCH NEARBY AREAS AS NEEDED.
- REMOVE EXISTING CONSTRUCTION DOWN TO TOP OF EXISTING BRICK PATCH AS NECESSARY.
- REMOVE BUILDING'S ORIGINAL SIGNAGE IN ITS ENTIRETY TO ACCOMMODATE NEW WORK.
- REMOVE AND RELOCATE PLAQUES AS DIRECTED BY OWNER.
- REMOVE AND REINSTALL EXISTING SUSPENDED CEILING AS NEEDED TO ACCOMMODATE ABATEMENT, HVAC, & ELECTRICAL WORK.
- MODIFY EXISTING GYPSUM BOARD CEILING AS REQUIRED TO ACCOMMODATE NEW WORK.
- REMOVE EXISTING OVERHEAD COILING DOOR FROM ABOVE CEILING TO ACCOMMODATE FOR NEW WORK.
- MODIFY EXISTING DROP CEILING SYSTEM TO ACCOMMODATE NEW WORK.
- REMOVE AND REPLACE EXISTING GYPSUM BOARD CEILING AS NEEDED TO ACCOMMODATE ABATEMENT, HVAC & ELECTRICAL WORK.
- REMOVE AND REPLACE EXISTING GYPSUM BOARD CEILING IN ITS ENTIRETY. PROVIDE WORK OF KEY NOTE 10 ALSO (CONCRETE DECK PREPARATION, ETC.).
- REMOVE EXISTING CEILING SYSTEM IN ITS ENTIRETY.

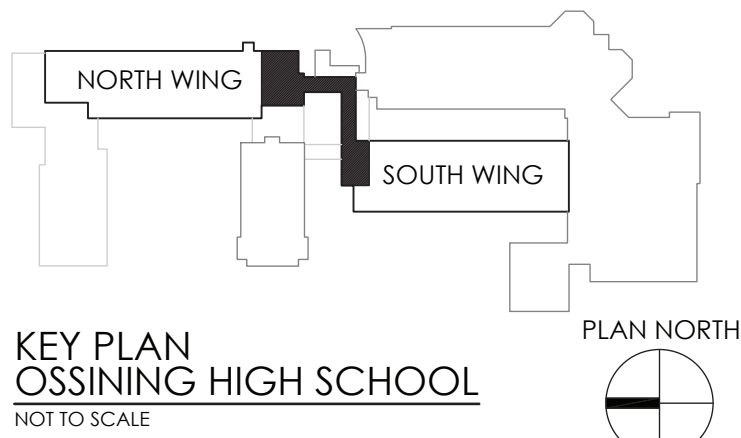

CPLteam.com
ARCHITECTURE • ENGINEERING • PLANNING





50 FRONT STREET, SUITE 202
NEWBURGH, NEW YORK 12550
TEL (800) 274-9000
FAX (845) 567-9614

REVISIONS	NO.	DATE	BY	DESCRIPTION
	1	06/03/2021	NWH	SED ADDENDUM 01
	2	12/2/2021		BID ADDENDUM 01

OSSINING UFSD
OSSINING HIGH SCHOOL
THIRD FLOOR CONNECTOR
29 SOUTH HIGHLAND AVENUE, OSSINING, NY 10562
SED #: 66-14-01-03-0-003-040

DATE	DRAWN	CHECKED
3/12/2021	NWH	MJ
SCALE AS NOTED		
SHEET TITLE		
SECOND FLOOR DEMOLITION PLAN		

PROJECT NUMBER
14428.13
OHS
A101
DRAWING NUMBER

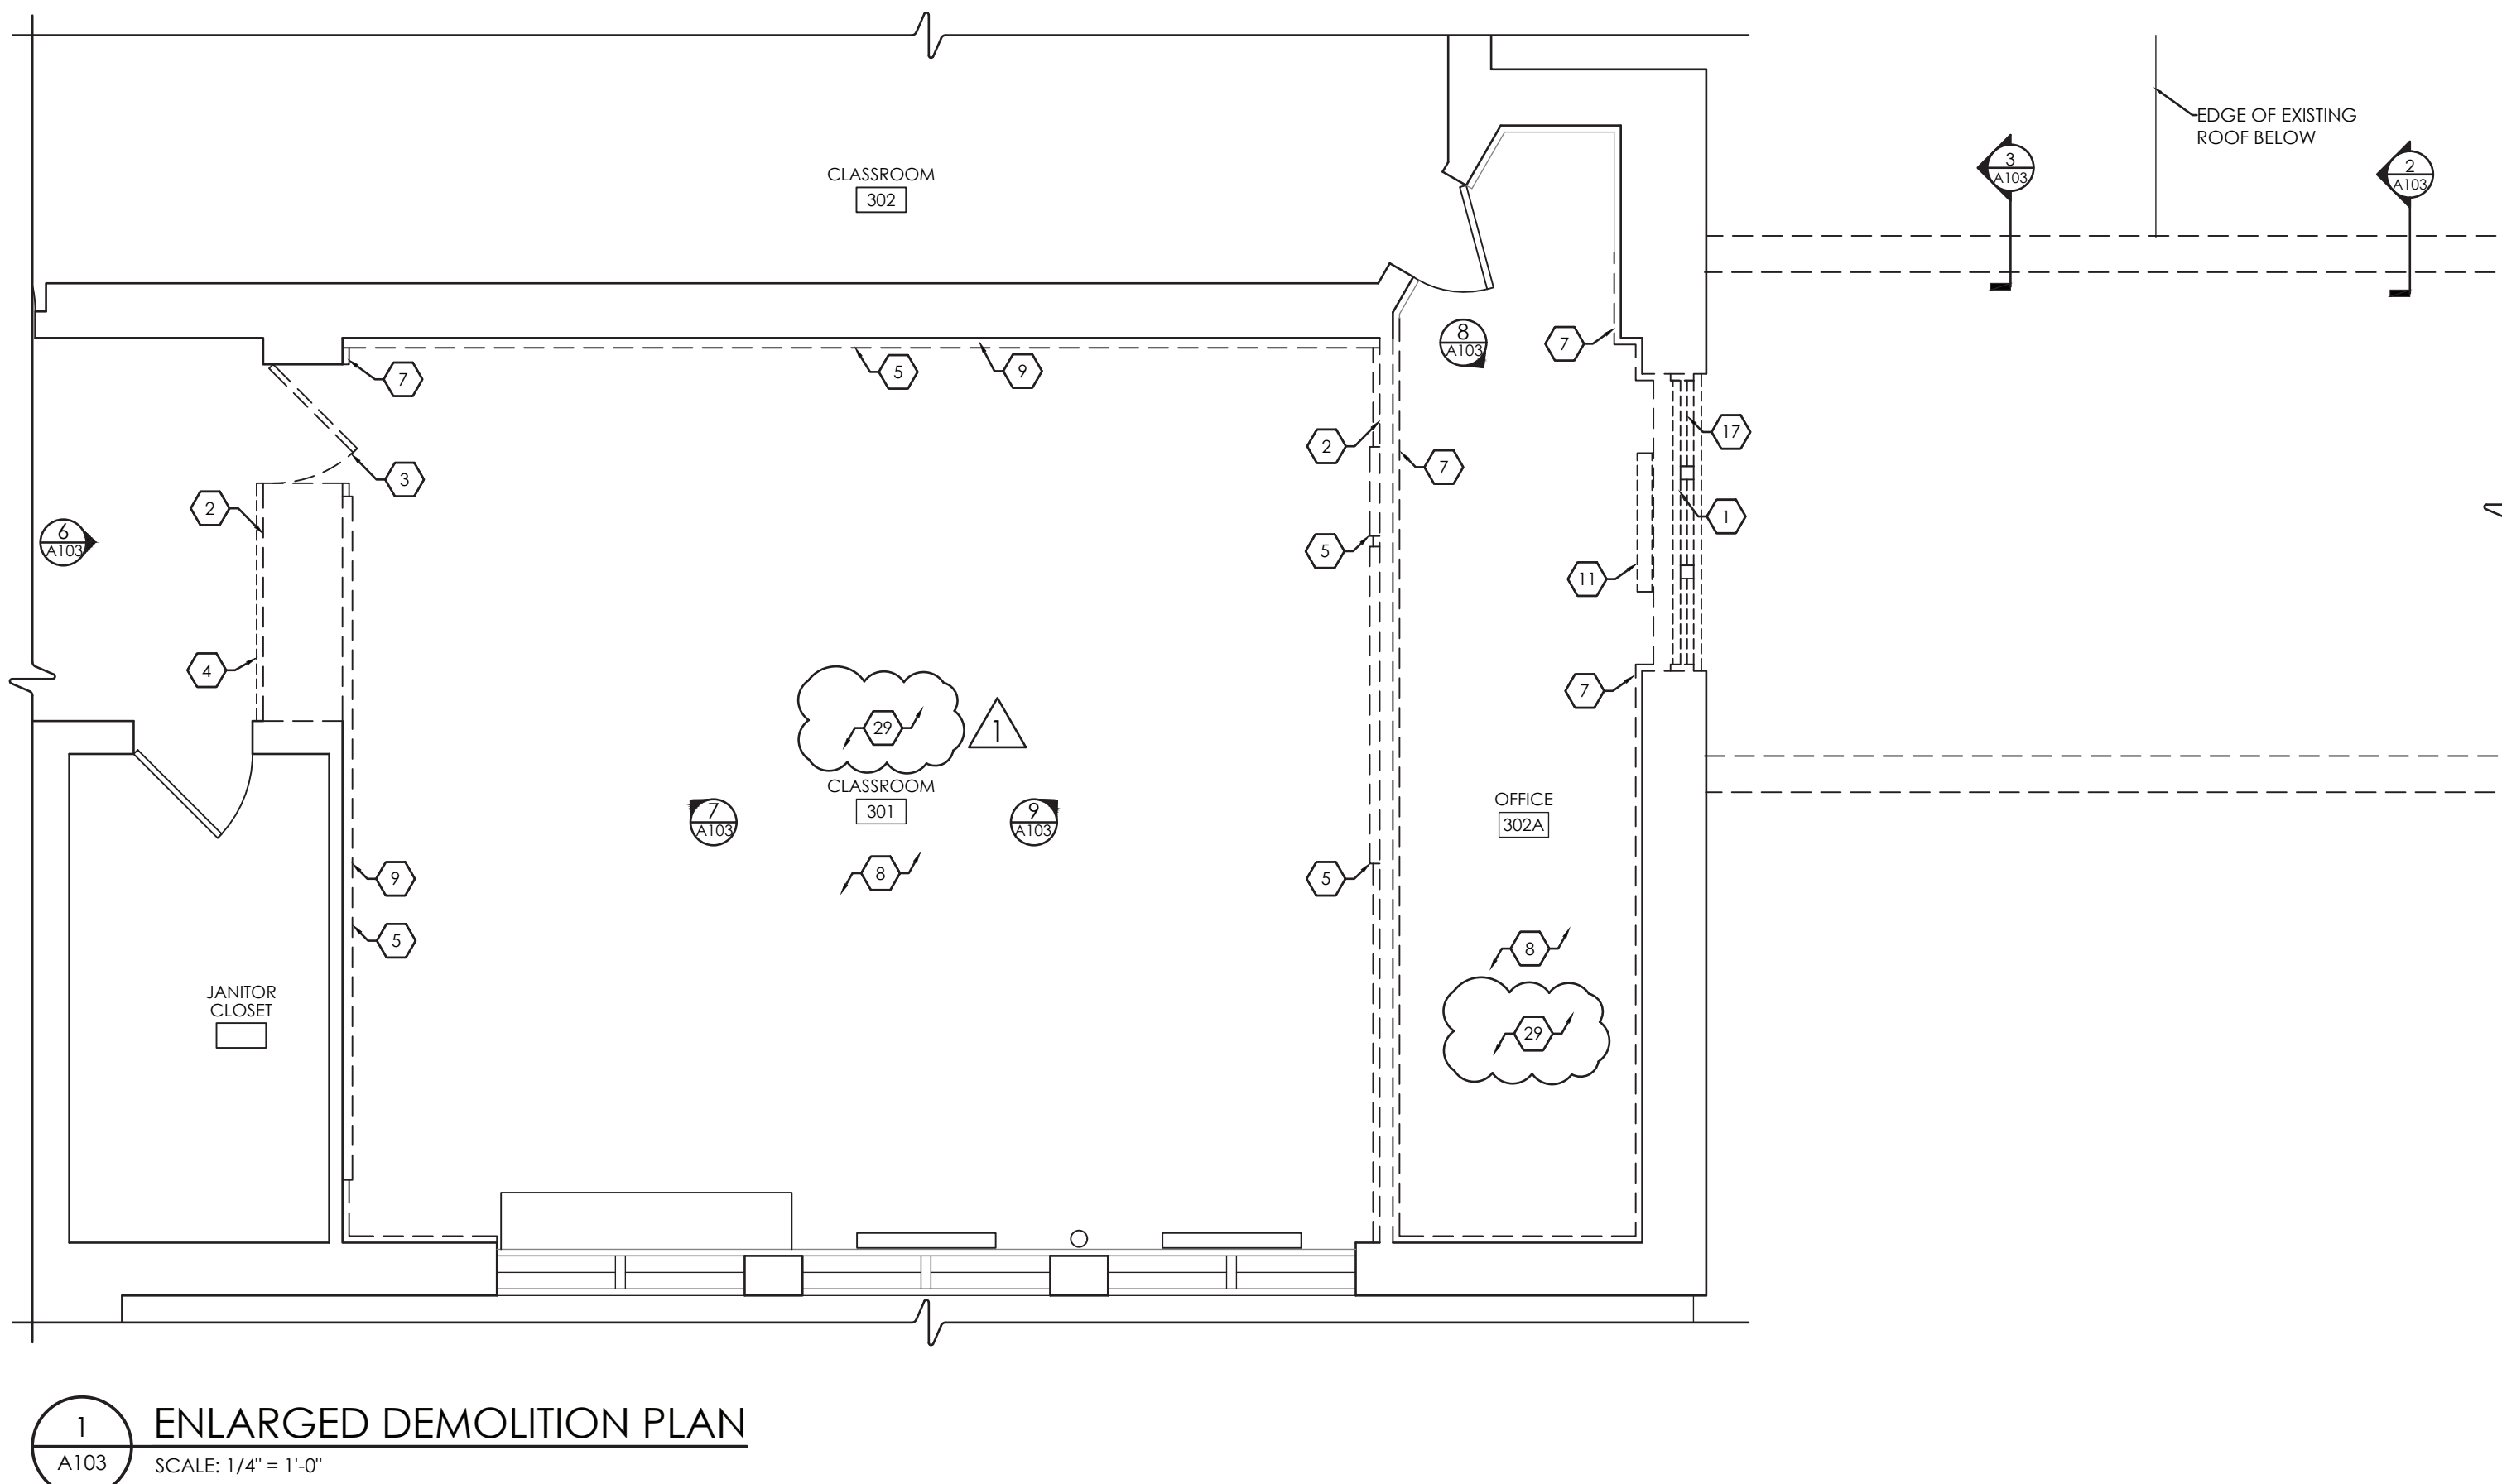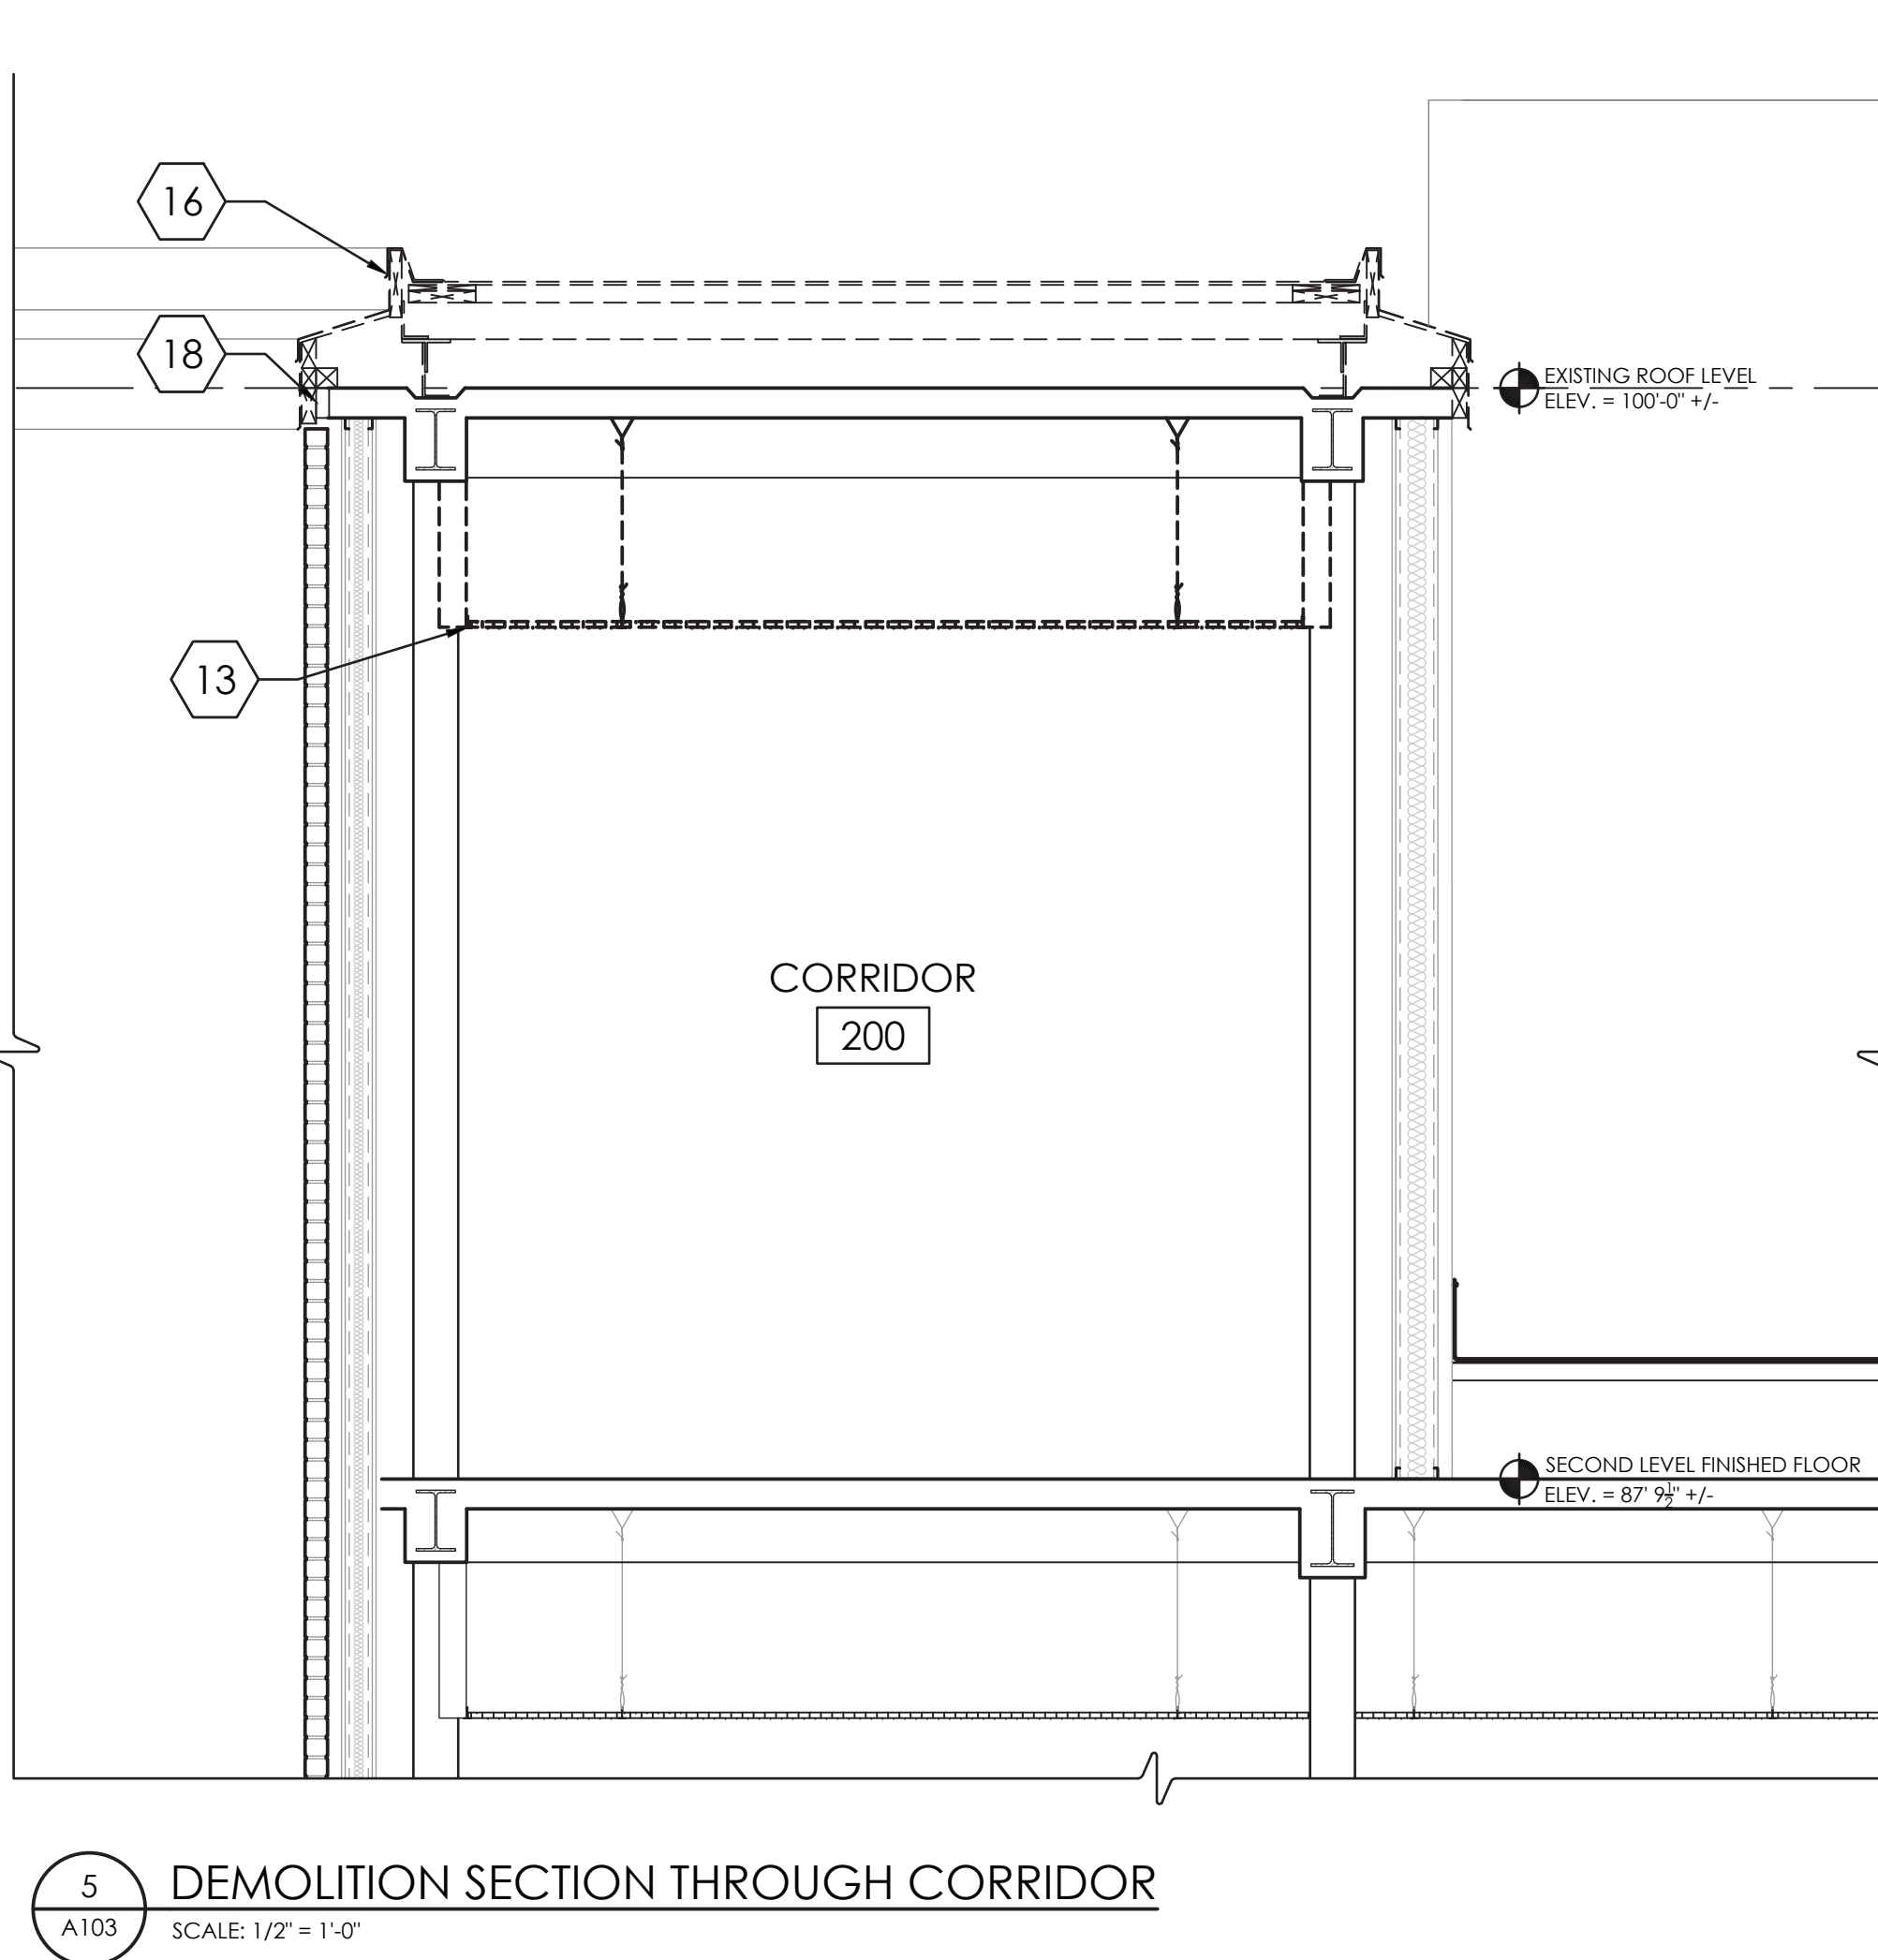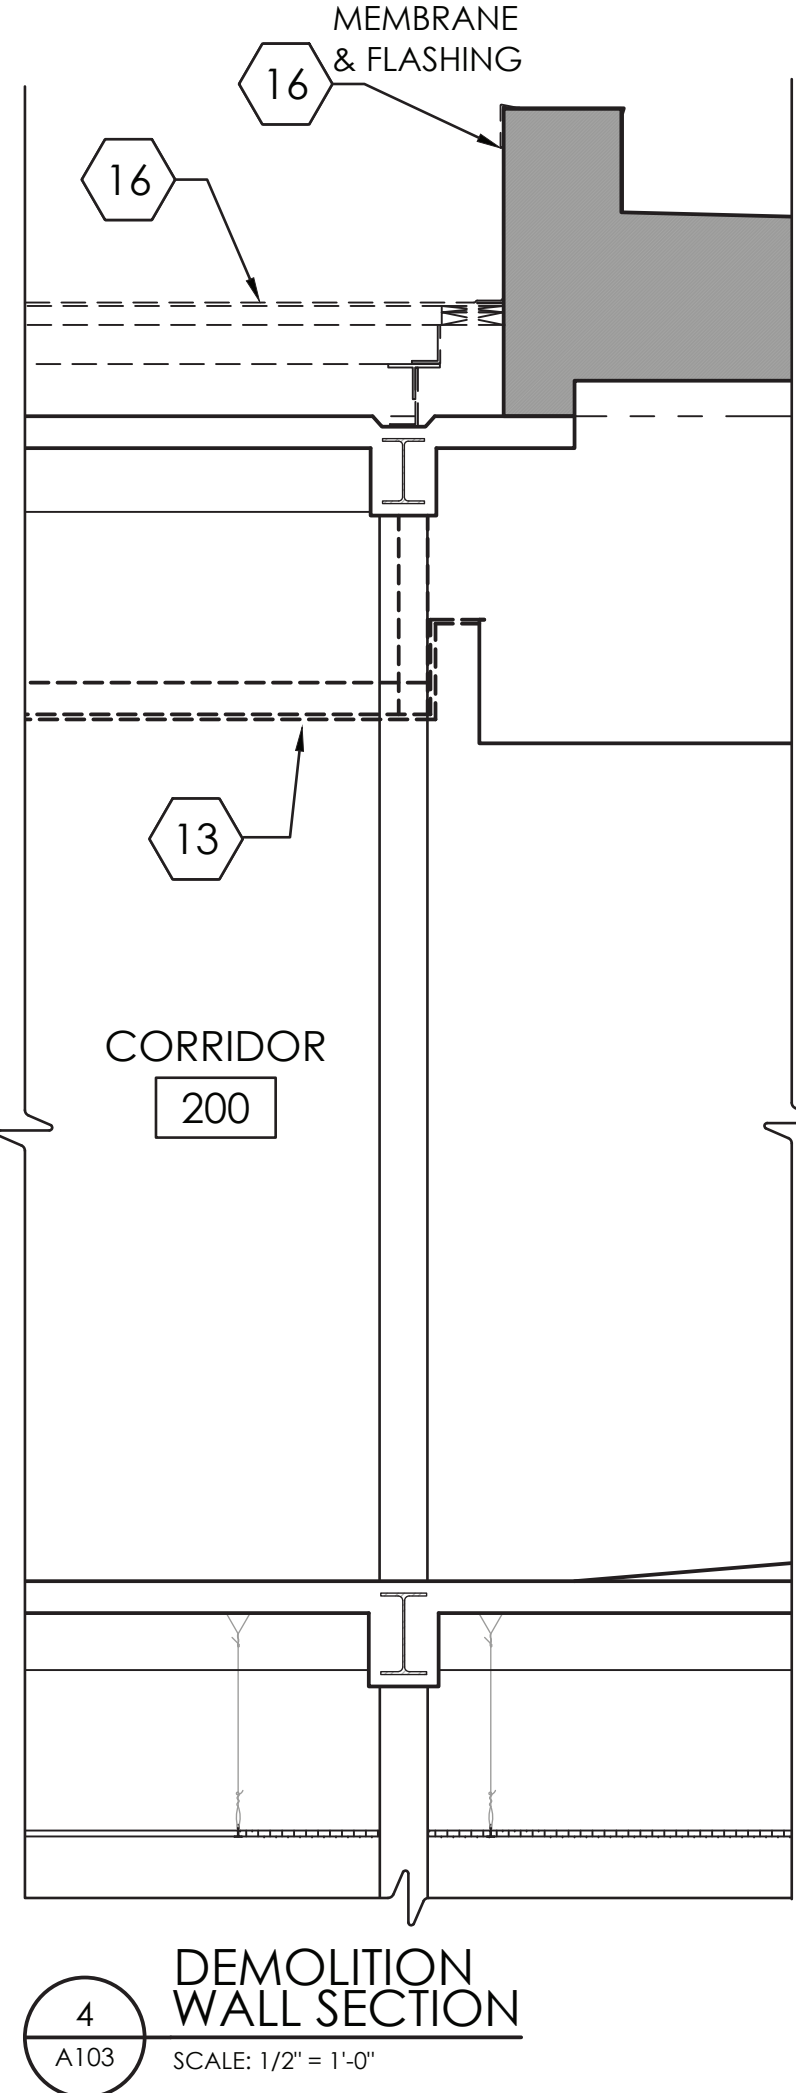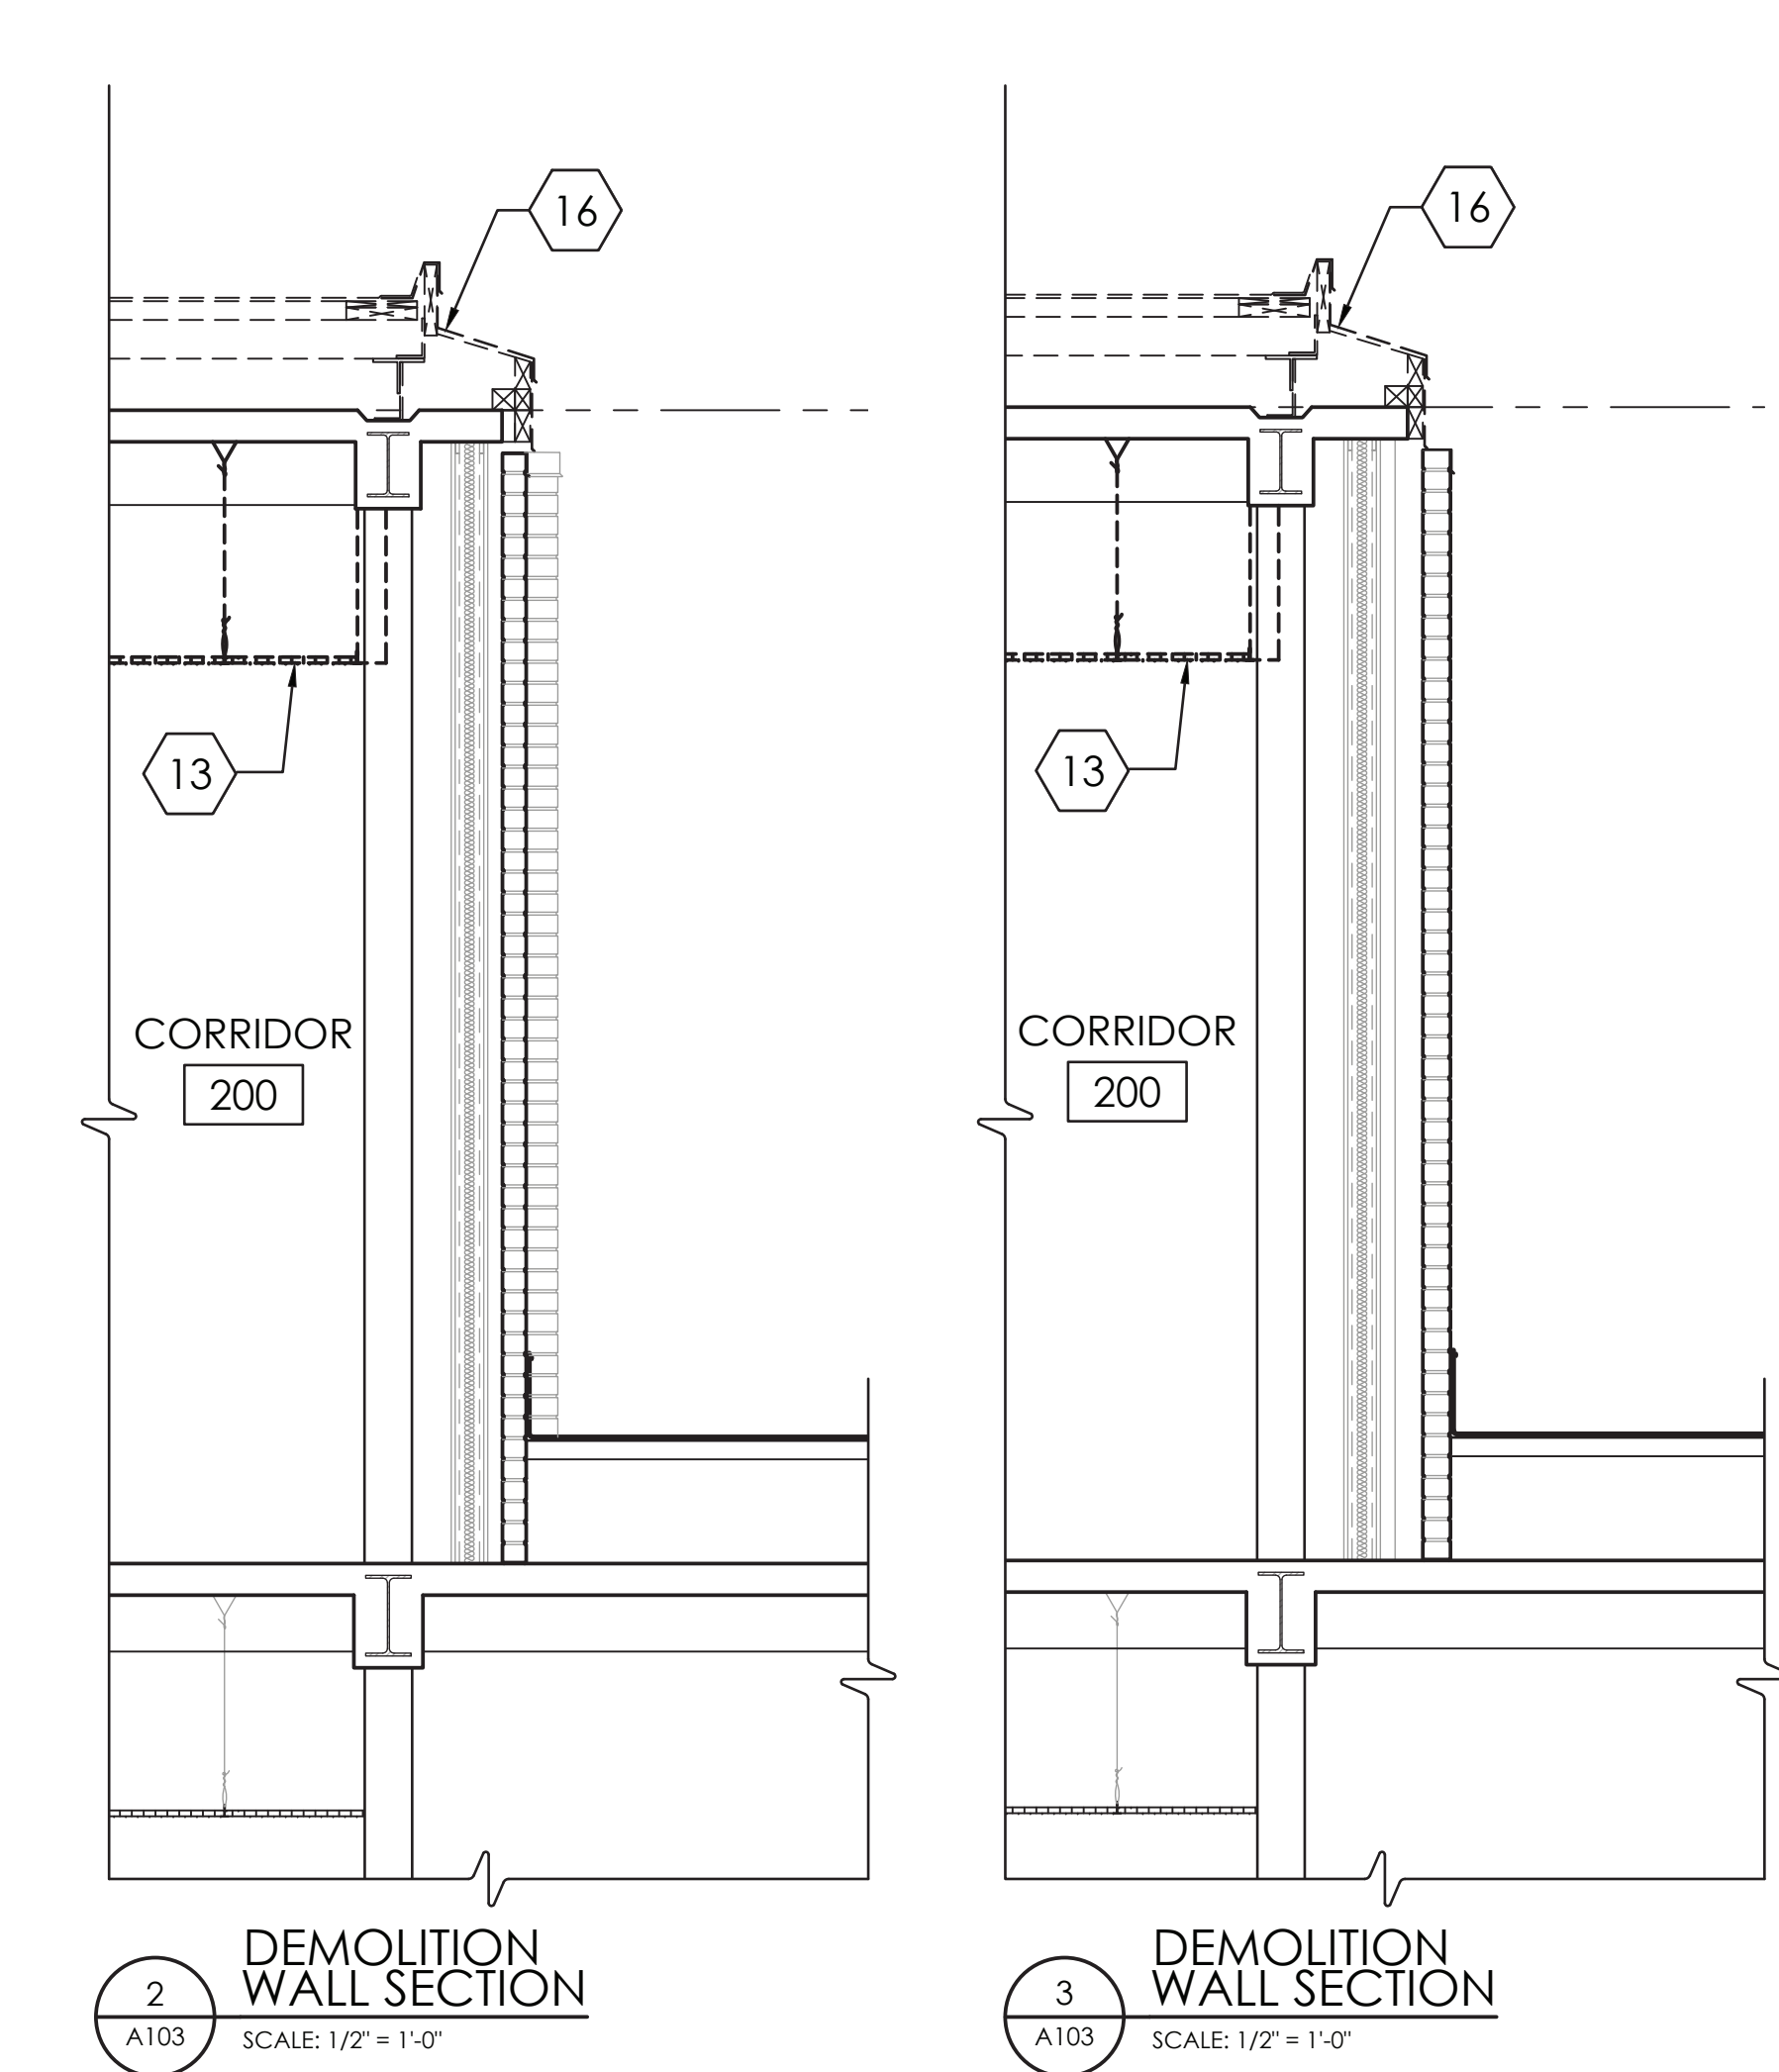


GENERAL DEMOLITION NOTES:

- IT IS THE CONTRACTOR'S RESPONSIBILITY TO FAMILIARIZE THEMSELVES WITH ALL EXISTING CONDITIONS AND DETAILS INVOLVED IN THE DEMOLITION WORK.
- THE OWNER SHALL PROVIDE THE CONTRACTOR WITH A LIST OF ALL ITEMS TO BE SALVAGED PRIOR TO CONSTRUCTION.
- THE CONTRACTOR SHALL PROTECT ADJACENT SURFACES AND FINISHES NOT SCHEDULED FOR DEMOLITION WORK AND SHALL REPAIR ANY DAMAGED AREAS AS A RESULT OF CONTRACTED WORK AT NO ADDITIONAL COST TO THE OWNER.
- THE CONTRACTOR SHALL COORDINATE THE DEMOLITION WORK WITH THE OVERALL PROJECT PHASING.
- THE CONTRACTOR SHALL MAINTAIN AND CONTINUE SAFE ACCESS TO ALL EXITS FOR THE BUILDING OCCUPANTS DURING CONSTRUCTION.



DEMOLITION NOTES:

- REMOVE EXISTING WINDOW & FRAME IN ITS ENTIRETY.
- REMOVE EXISTING WALL IN ITS ENTIRETY. PATCH ADJACENT AREAS WITH LIKE CONSTRUCTION AS NECESSARY. PREPARE AREA TO ACCOMMODATE NEW WORK.
- REMOVE EXISTING DOOR AND FRAME. PREPARE AREA TO ACCOMMODATE NEW WORK.
- REMOVE EXISTING LOCKERS IN THEIR ENTIRETY. PATCH ADJACENT AREAS WITH LIKE CONSTRUCTION AS NECESSARY.
- REMOVE EXISTING CHALKBOARD, TACKBOARD IN ITS ENTIRETY. PREPARE AREA TO ACCOMMODATE NEW WORK.
- REMOVE UNIT VENTILATOR IN ITS ENTIRETY (BY HVAC CONTRACTOR). PREPARE AREA TO ACCOMMODATE NEW WORK.
- REMOVE EXISTING CHAIR RAIL IN ITS ENTIRETY. PREPARE FOR NEW WORK. PATCH AS NECESSARY.
- REMOVE EXISTING VINYL FLOORING AS NEEDED TO ACCOMMODATE FOR NEW WORK. PATCH TO MATCH EXISTING.
- REMOVE EXISTING WALL BASE IN ITS ENTIRETY. PREPARE FOR NEW WORK.
- REMOVE EXISTING SUSPENDED CEILING SYSTEM IN ITS ENTIRETY, INCLUDING ALL ASSOCIATED ITEMS SUCH AS HANGERS, CLIPS, ETC. REMOVE ALL ITEMS AS REQUIRED TO ALLOW ACCESS TO UNDERSIDE OF CONCRETE DECK, INCLUDING ABANDONED FORMWORK. PREPARE FOR NEW WORK, INCLUDING PREPARING UNDERSIDE OF CONCRETE DECK TO INTERNATIONAL CONCRETE REPAIR INSTITUTE (ICRI) CONCRETE SURFACE PROFILE CSP-3. PATCH CONCRETE DECK AS NEEDED TO ACCOMMODATE NEW WORK.
- REMOVE EXISTING MECHANICAL FIN TUBE AND COVER IN ITS ENTIRETY TO ACCOMMODATE FOR NEW WORK.
- REMOVE EXISTING UNIT VENTILATOR IN ITS ENTIRETY TO ACCOMMODATE FOR NEW WORK.
- REMOVE EXISTING CEILING SYSTEM IN ITS ENTIRETY TO ACCOMMODATE FOR NEW WORK.
- REMOVE/CUT AWAY EXISTING PLASTER CEILING TO ACCOMMODATE FOR NEW WORK. PATCH NEARBY AREAS AS NECESSARY.
- REMOVE EXISTING ROOF DRAIN TO ACCOMMODATE FOR NEW WORK. REFERENCE PLUMBING DRAWINGS.
- REMOVE EXISTING ROOF IN ITS ENTIRETY (MEMBRANE, INSULATION, FLASHING, & STEEL FRAMING ABOVE ROOF SLAB), ETC.). TO ACCOMMODATE FOR NEW WORK.
- REMOVE PORTION OF WALL TO ACCOMMODATE FOR NEW WORK. PATCH AS NECESSARY.
- CUT OFF CANTILEVER OF EXISTING CONCRETE FLOOR/ROOF SLAB. SEE STRUCTURAL.
- REMOVE PORTION OF EXISTING SOFFIT TO ACCOMMODATE NEW WORK. PATCH NEARBY AREAS AS NEEDED.
- REMOVE EXISTING CONSTRUCTION DOWN TO TOP OF EXISTING BRICK PATCH AS NECESSARY.
- REMOVE BUILDING'S ORIGINAL SIGNAGE IN ITS ENTIRETY TO ACCOMMODATE NEW WORK.
- REMOVE AND RELOCATE PLAQUES AS DIRECTED BY OWNER.
- REMOVE AND REINSTALL EXISTING SUSPENDED CEILING AS NEEDED TO ACCOMMODATE ABATEMENT, HVAC, & ELECTRICAL WORK.
- MODIFY EXISTING GYPSUM BOARD CEILING AS REQUIRED TO ACCOMMODATE NEW WORK.
- REMOVE EXISTING OVERHEAD COILING DOOR FROM ABOVE CEILING TO ACCOMMODATE FOR NEW WORK.
- MODIFY EXISTING DROP CEILING SYSTEM TO ACCOMMODATE NEW WORK.
- REMOVE AND REPLACE EXISTING GYPSUM BOARD CEILING AS NEEDED TO ACCOMMODATE ABATEMENT, HVAC & ELECTRICAL WORK.
- REMOVE AND REPLACE EXISTING GYPSUM BOARD CEILING IN ITS ENTIRETY. PROVIDE WORK OF KEY NOTE 10 ALSO (CONCRETE DECK PREPARATION, ETC.).
- REMOVE EXISTING CEILING SYSTEM IN ITS ENTIRETY.

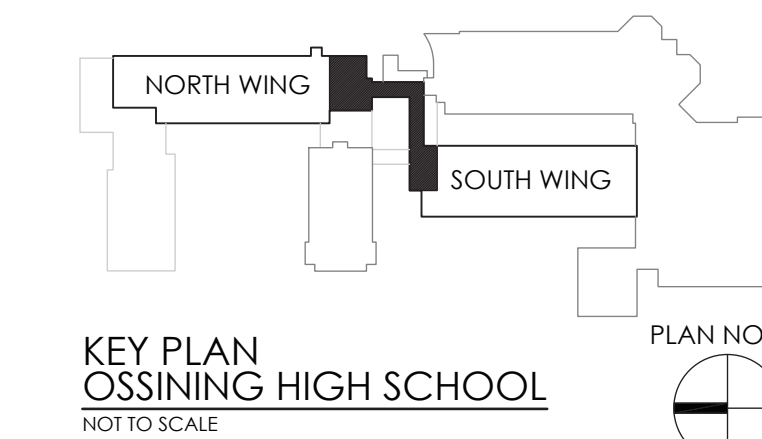

50 FRONT STREET, SUITE 202
NEWBURGH, NEW YORK 12550
TEL (800) 274-9000
FAX (845) 567-9614

REVISONS	NO.	DATE	BY	DESCRIPTION
	1	12/2/2021		BID ADDENDUM 01

  


OSSINING UFSD
OSSINING HIGH SCHOOL
THIRD FLOOR CONNECTOR
29 SOUTH HIGHLAND AVENUE, OSSINING, NY 10562
SED #: 66-14-01-03-0-003-040


DATE	DRAWN	CHECKED
3/12/2021	NWH	MJ
SCALE AS NOTED		
SHEET TITLE		
THIRD FLOOR DEMOLITION PLAN & SECTIONS		

PROJECT NUMBER
14428.13
OHS
A103
DRAWING NUMBER

Drawing Name: S:\Projects\Ossining UFSD\OHS 3rd Flr Connector\06 CAD\AutoCAD\ARCH\A6\OHS A600.dwg Date last accessed: 12/2/2021 11:40 AM Date last plotted: 12/2/2021 11:49 AM Plotted By: Mark Johnson

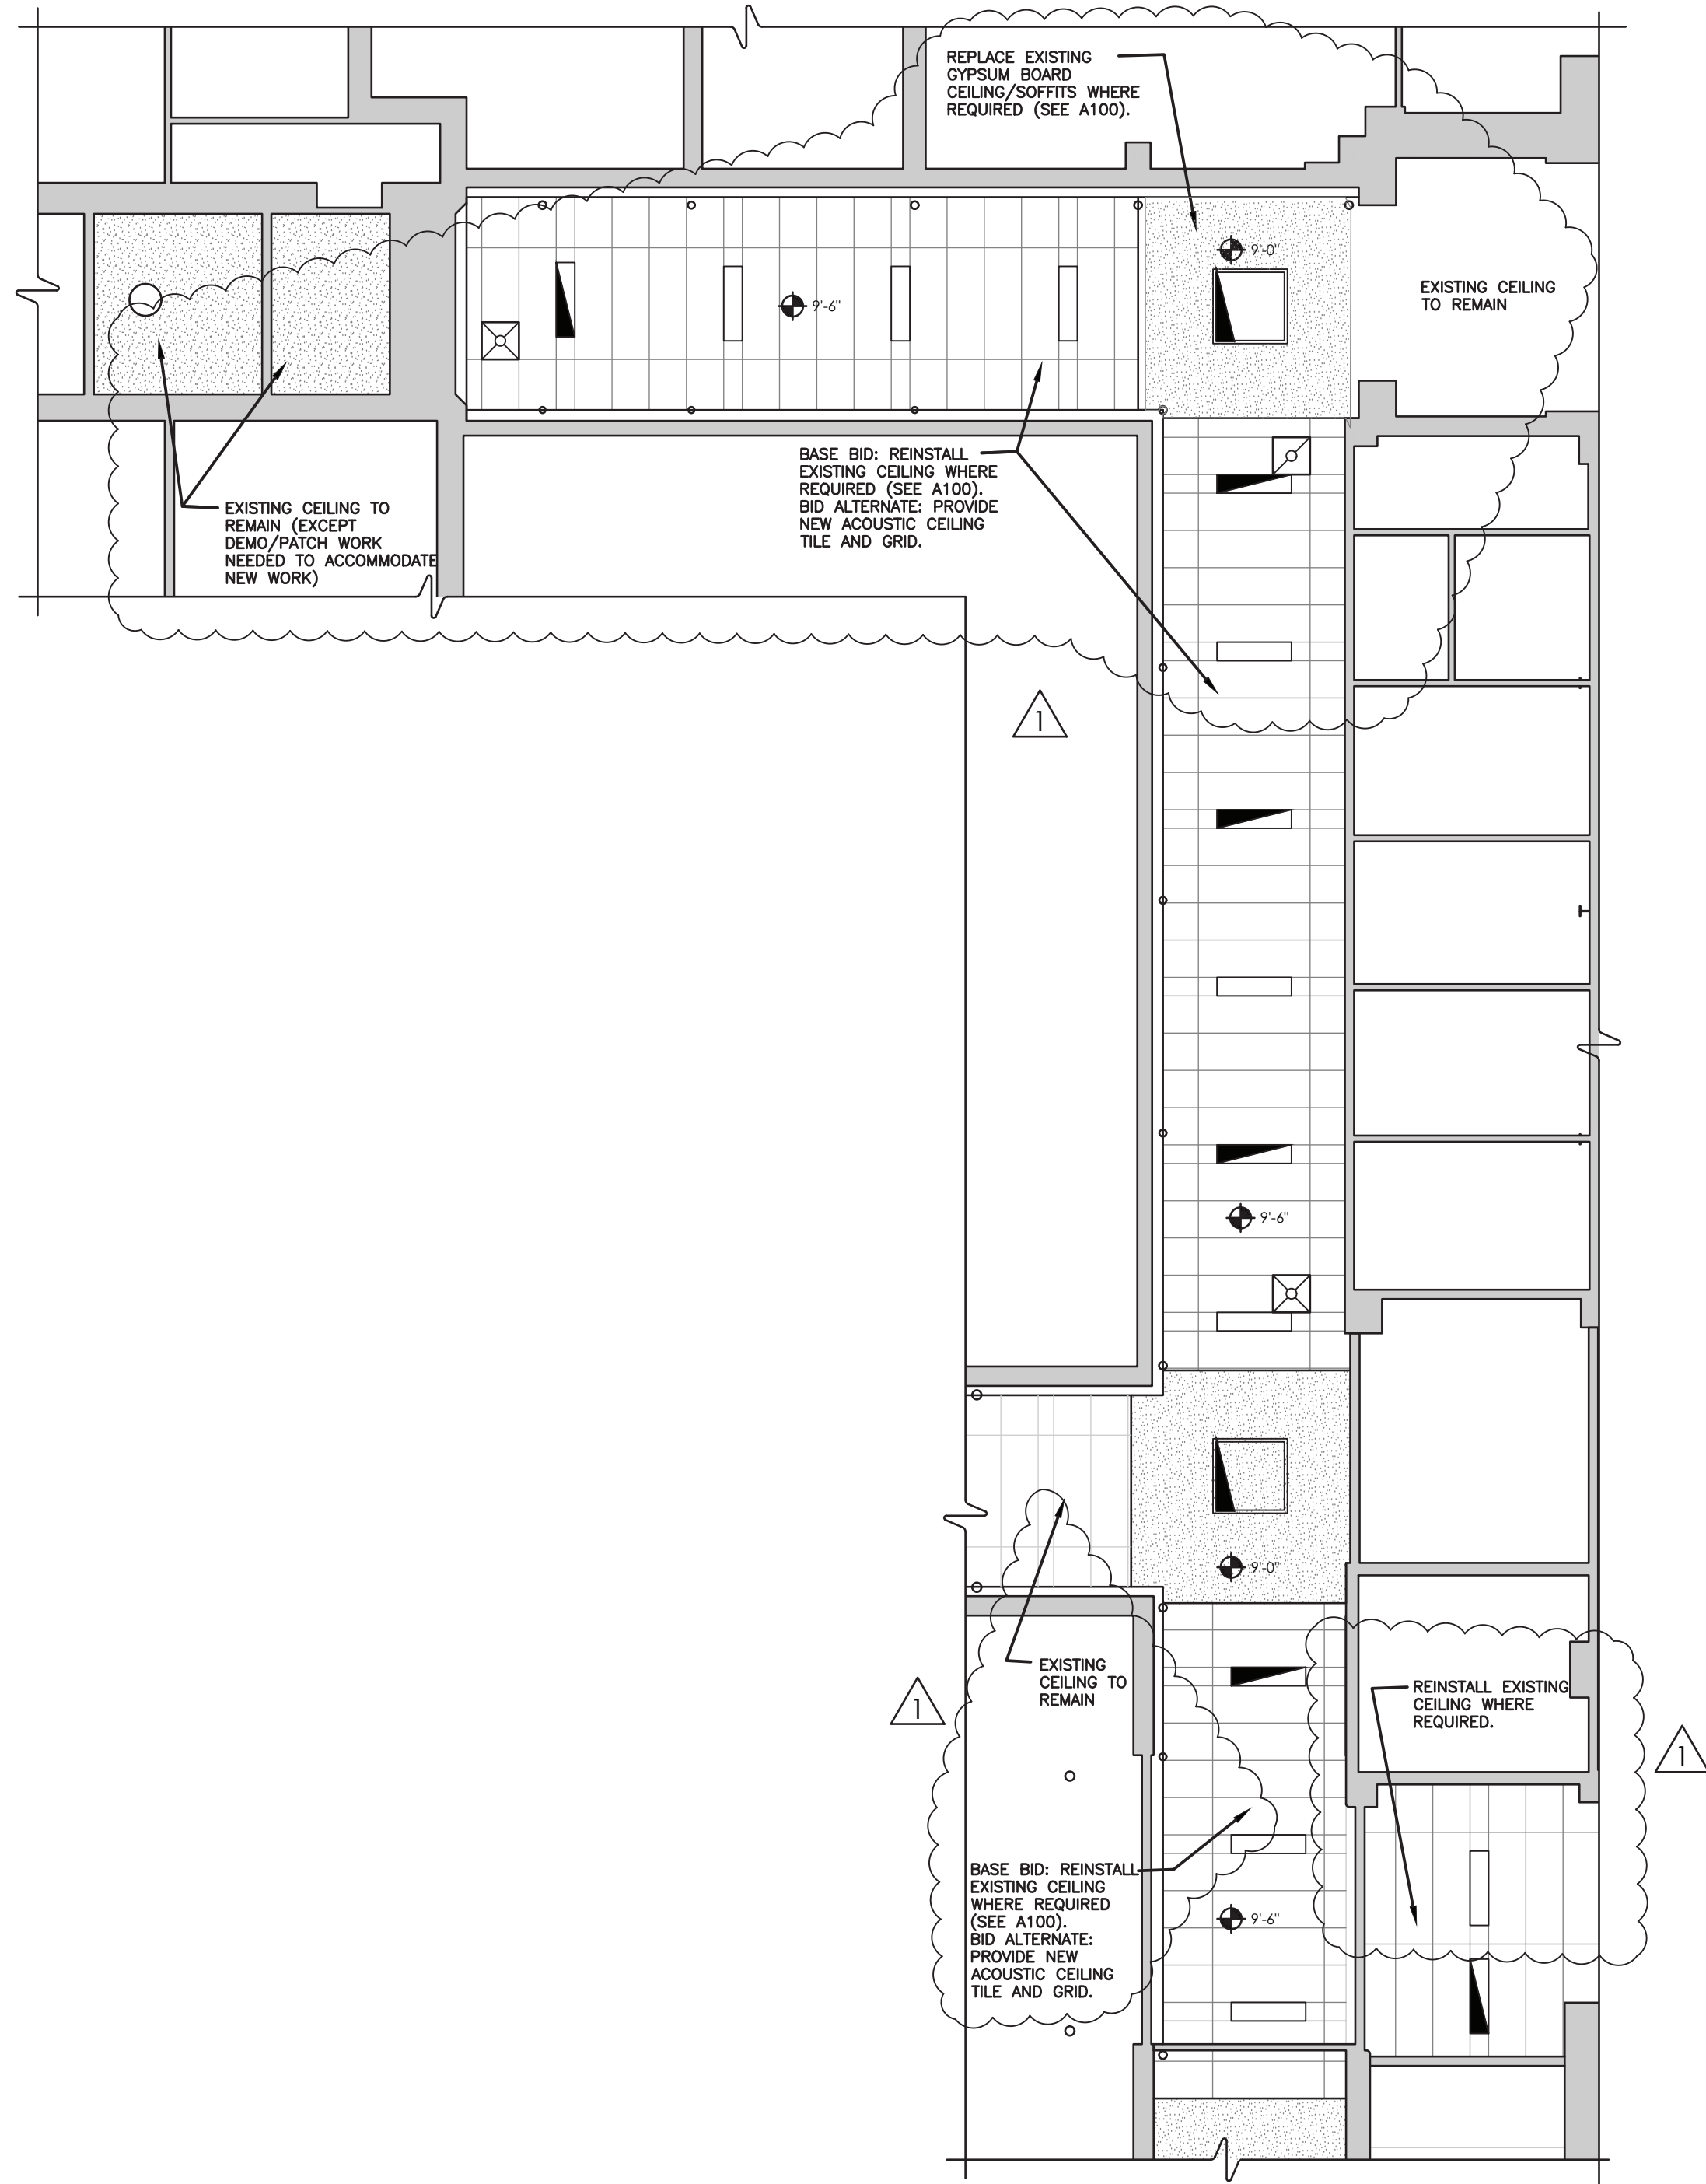

1 FIRST FLOOR NEW WORK REFLECTED CEILING PLAN
A600 SCALE: 1/8" = 1'-0"

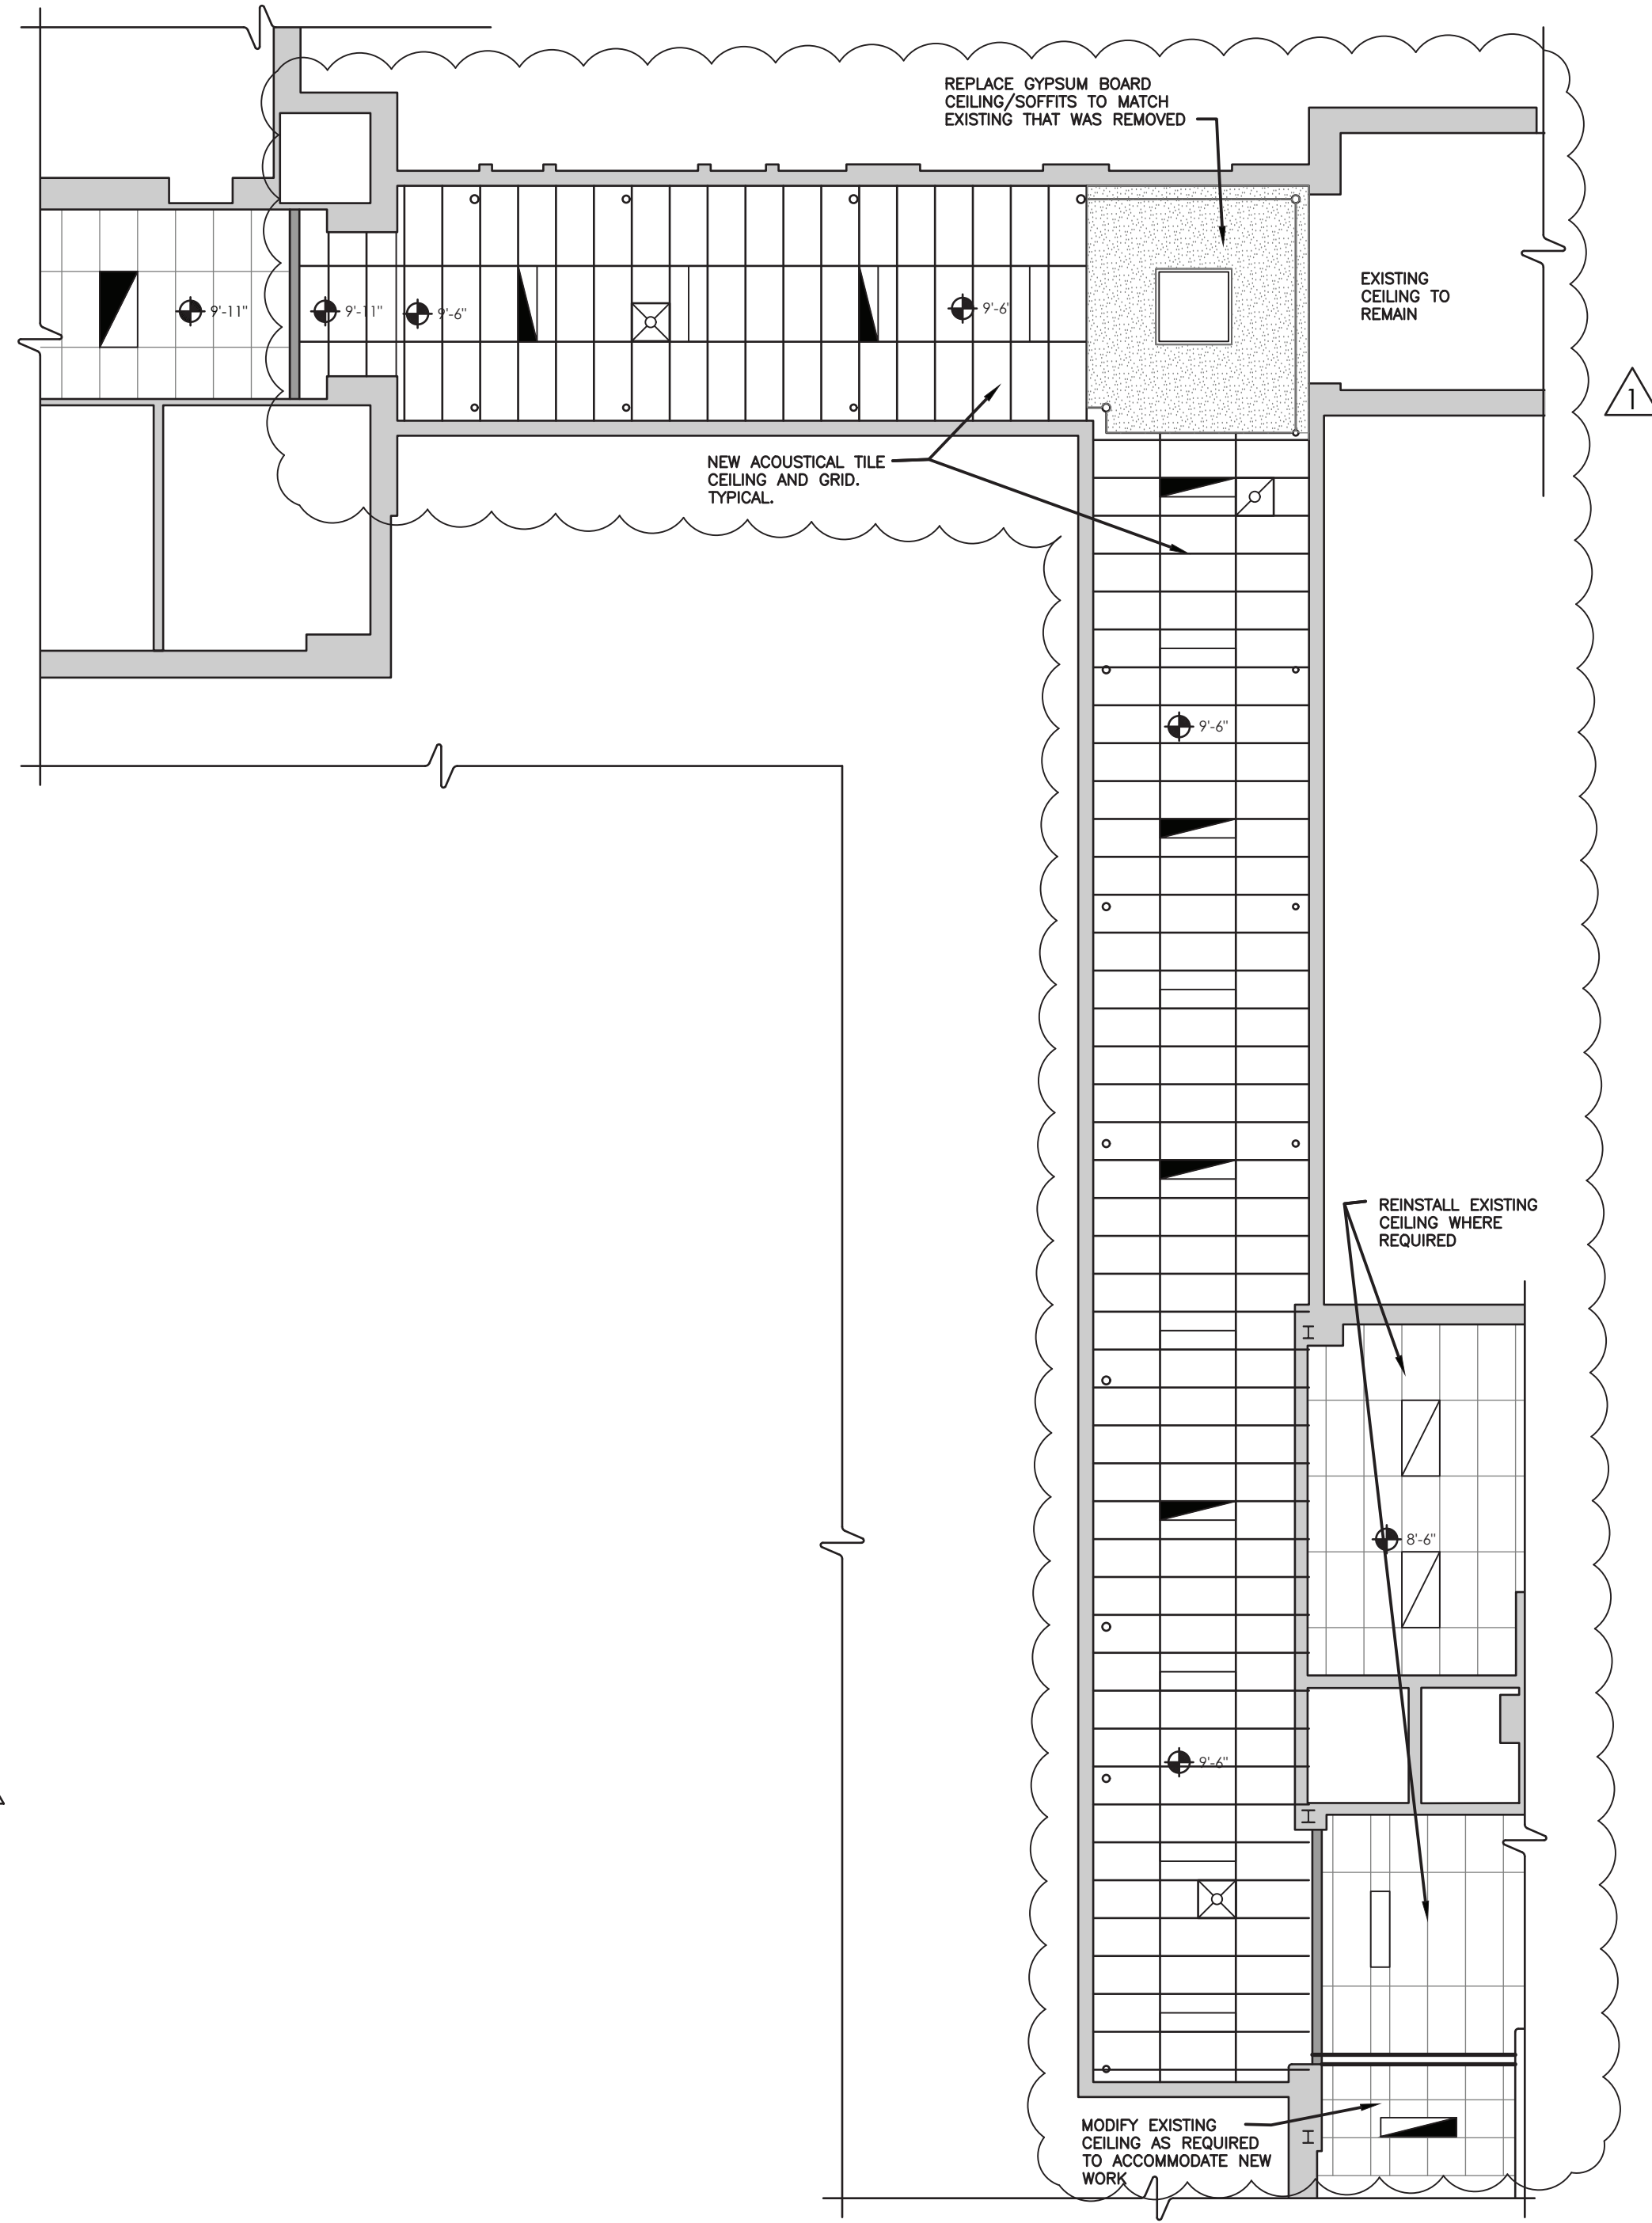

2 SECOND FLOOR NEW WORK REFLECTED CEILING PLAN
A600 SCALE: 1/8" = 1'-0"


LEGEND:

- X'-X" CEILING HEIGHT
- EXIT LIGHTING FIXTURE
- WALL MOUNTED LIGHT FIXTURE
- BATTERY POWERED EMERGENCY LIGHT
- DOUBLE REMOTE HEAD EMERGENCY LIGHT
- CEILING MOUNTED OCCUPANCY SENSOR
- CEILING MOUNTED VACANCY SENSOR
- DIFFUSER
- RETURN GRILLE
- LIGHT FIXTURE
- EMERGENCY AND/OR NIGHT LIGHT LIGHTING FIXTURE
- AD ACCESS DOOR
- CABINET UNIT HEATER, SEE H203

NOTE: REFER TO MECH & ELEC FOR COMPLETE SYMBOLS LIST

NOTE: ACOUSTIC CEILING TILE: PROVIDE CLASS (A) FINISH UNITS NOT LESS THAN 5/8" THICK, WITH FLAME SPREAD OF 25 OR LESS COMPLYING WITH ASTM E-84.

- SUSPENDED CEILING SYSTEM
- GYPSUM BOARD CEILING
- BARREL VAULTED PLASTER CEILING

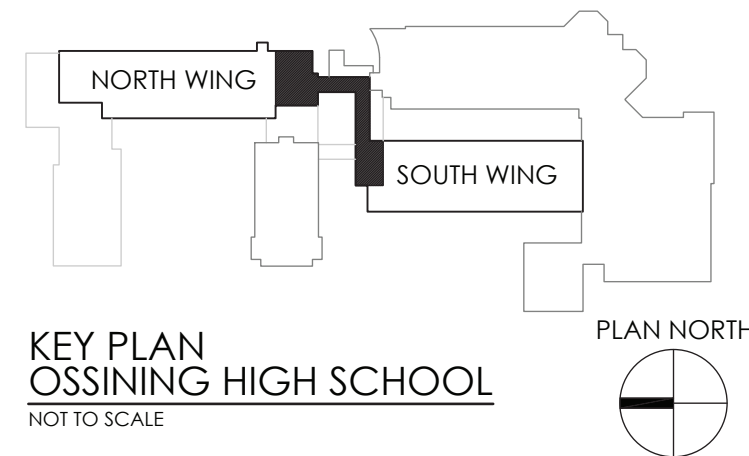

CPLteam.com
ARCHITECTURE • ENGINEERING • PLANNING

50 FRONT STREET, SUITE 202
NEWBURGH, NEW YORK 12550
TEL (800) 274-9000
FAX (845) 567-9614

REVISIONS	NO.	DATE	BY	DESCRIPTION
	1	12/2/2021		BID ADDENDUM 01




OSSINING UFSD
OSSINING HIGH SCHOOL
THIRD FLOOR CONNECTOR
29 SOUTH HIGHLAND AVENUE, OSSINING, NY 10562
SED #: 66-14-01-03-0-003-040


DATE	DRAWN	CHECKED
3/12/2021	NWH	MJ
SCALE	AS NOTED	
SHEET TITLE	SECOND FLOOR NEW WORK REFLECTED CEILING PLAN	

PROJECT NUMBER
14428.13
OHS
A600
DRAWING NUMBER

Drawing Name: S:\Projects\Ossining UFSD\OHS 3rd Flr Connector\06 CAD\AutoCAD\ARCH\A6\OHS A600.dwg Date last accessed: 12/2/2021 11:40 AM Date last plotted: 12/2/2021 11:50 AM Plotted By: Mark Johnson

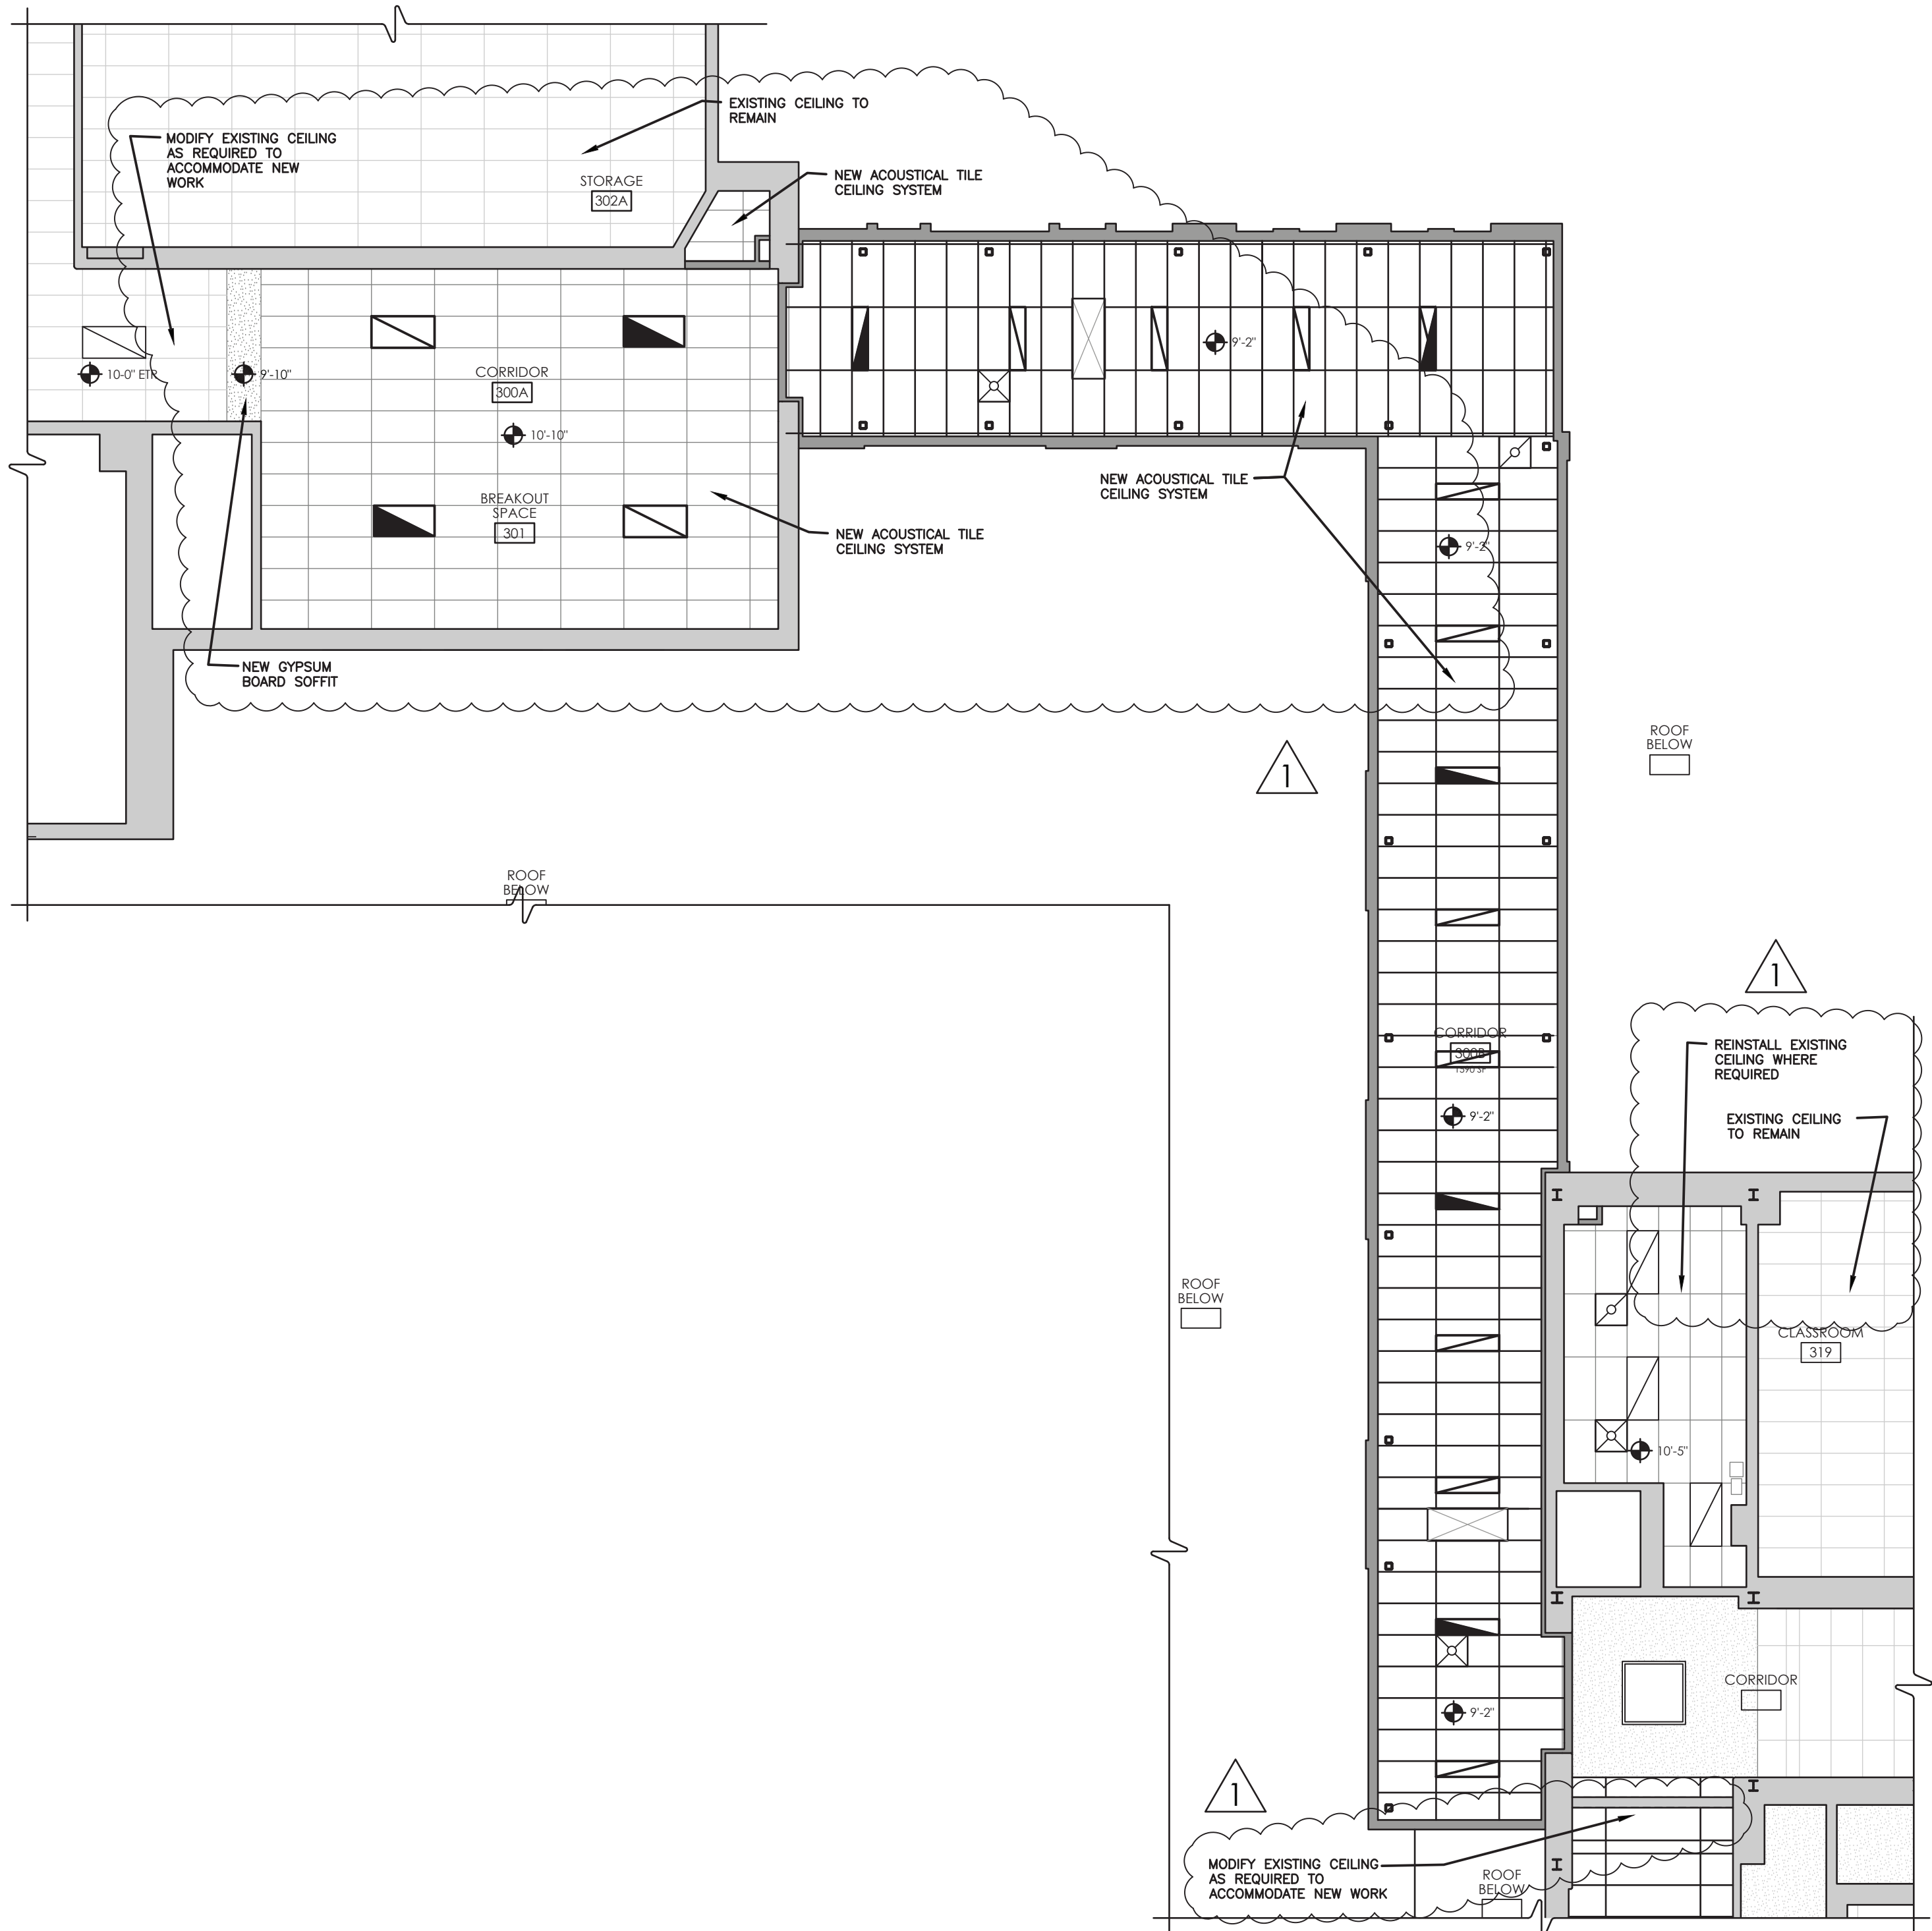

1 THIRD FLOOR NEW WORK REFLECTED CEILING PLAN
A601 SCALE: 1/8" = 1'-0"

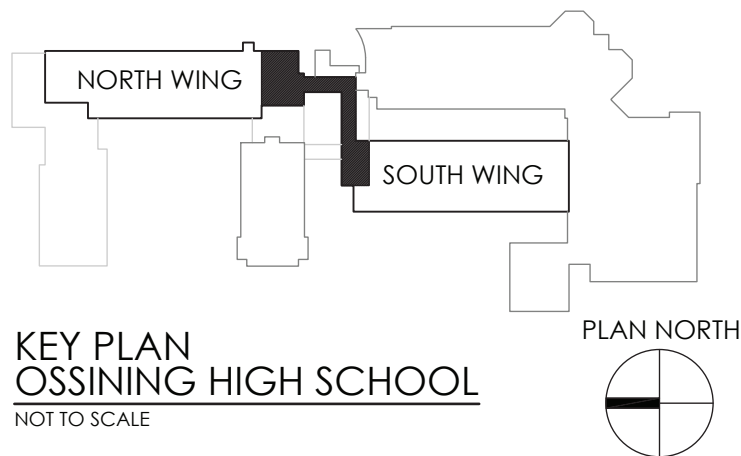

REVISIONS		NO.	DATE	BY	DESCRIPTION
1		12/2/2021			BID ADDENDUM 01




**OSSINING UFSD
OSSINING HIGH SCHOOL**

THIRD FLOOR CONNECTOR

29 SOUTH HIGHLAND AVENUE, OSSINING, NY 10562
SED #: 66-14-01-03-0-003-040

DATE	DRAWN	CHECKED
3/12/2021	NWH	MJ
SCALE	AS NOTED	
SHEET TITLE		
THIRD FLOOR NEW WORK REFLECTED CEILING PLAN		

PROJECT NUMBER
14428.13
OHS A601
DRAWING NUMBER

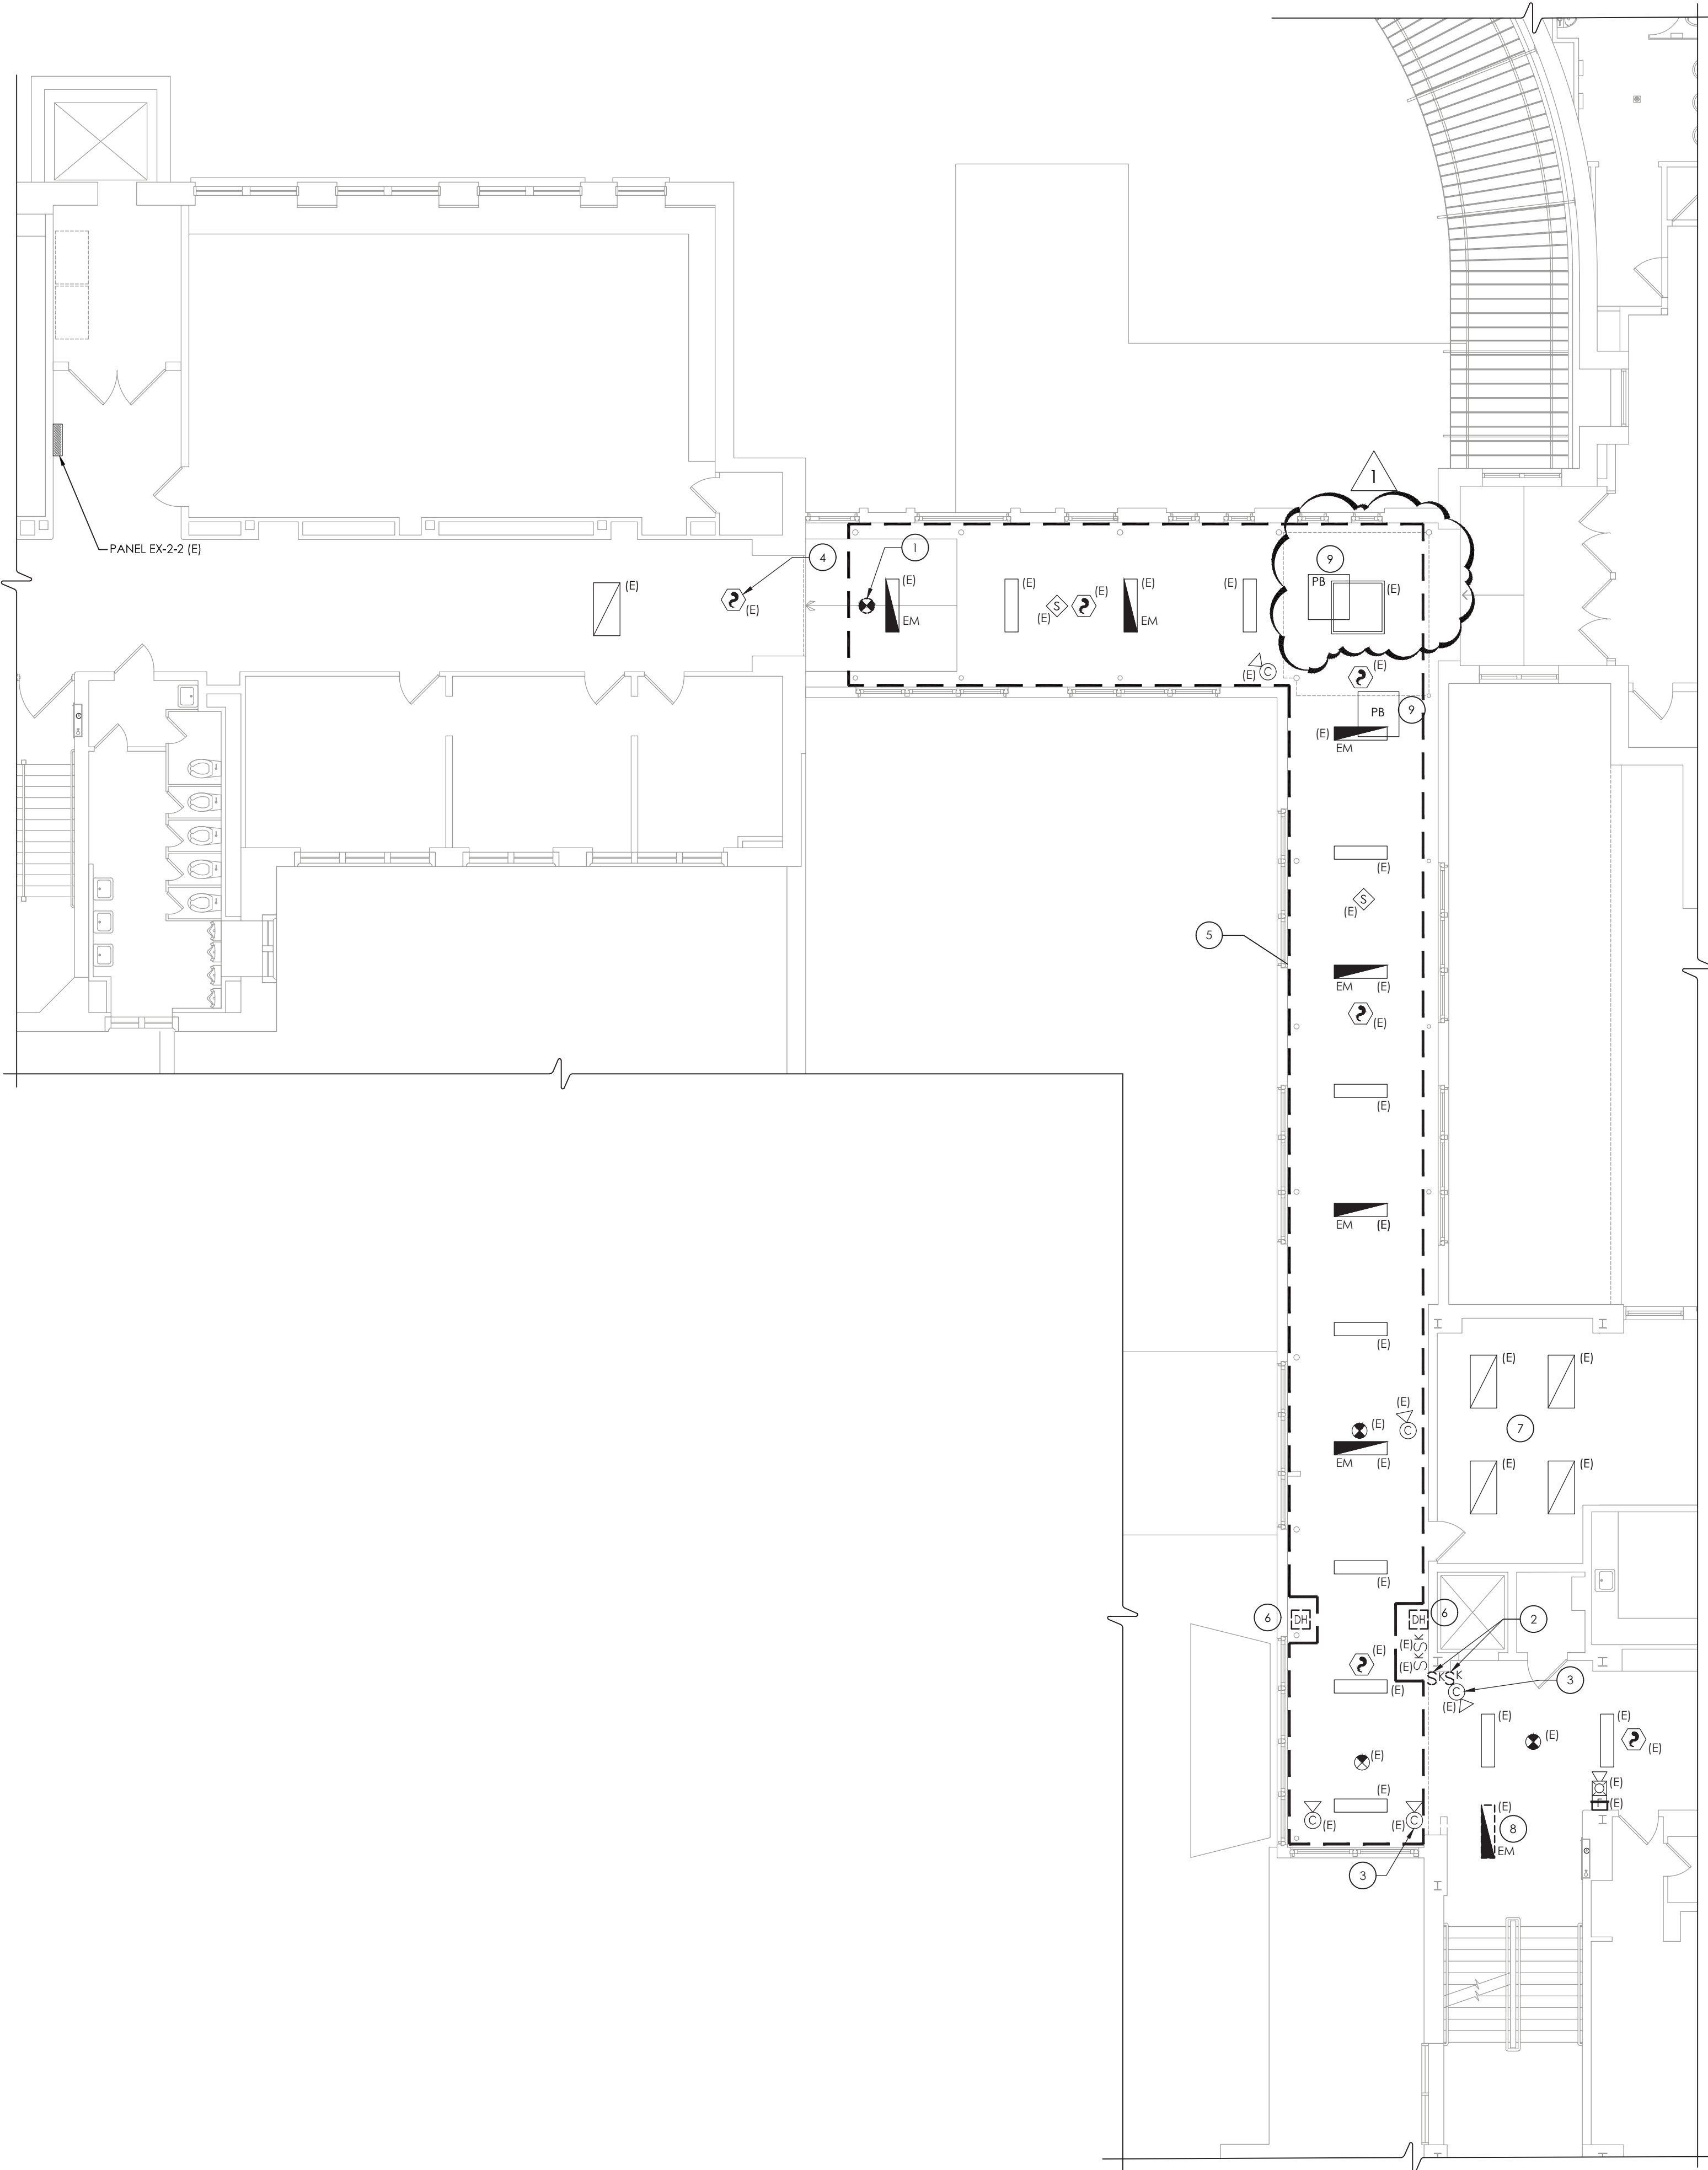

1
E101

SECOND FLOOR ELECTRICAL DEMOLITION PLAN
SCALE: 1/8" = 1'-0"


GENERAL NOTES:


- A. ALL ITEMS SHOWN ARE TO BE REMOVED UNLESS LABELED AS (E) EXISTING TO REMAIN. ANY DEVICE, AS WELL AS ITS ASSOCIATED CIRCUITING, AND CONDUIT, LABELED "(E)" SHALL REMAIN, UNLESS OTHERWISE NOTED.
- B. INFORMATION ON DRAWINGS WAS OBTAINED THROUGH FIELD OBSERVATION AND AS-BUILT DOCUMENTATION. THE CONTRACTOR IS RESPONSIBLE FOR THE REMOVAL AND REPLACEMENT OF ANY DEVICES AND CABLING THAT MAY NOT BE SHOWN ON DRAWING AT NO ADDITIONAL COST TO OWNER.
- C. DRAWINGS ARE GRAPHICAL REPRESENTATIONS OF APPROXIMATE EQUIPMENT AND DEVICE LOCATIONS. CONTRACTOR SHALL VISIT THE SITE TO DETERMINE THE EXACT EXTENT OF ELECTRICAL WORK REQUIRED TO COMPLETE THE PROJECT. EXISTING CONDITIONS ARE TAKEN FROM FIELD OBSERVATION AND EXISTING BUILDING DOCUMENTS. OTHER ELECTRICAL ITEMS MAY EXIST FOR WHICH THE CONTRACTOR IS RESPONSIBLE AT NO ADDITIONAL COST.
- D. THE CONTRACTOR SHALL REMOVE THE EXISTING ELECTRIC IN AREAS OF NEW RENOVATIONS TO ACCOMMODATE NEW CONSTRUCTION. REROUTING OF EXISTING MAY BE REQUIRED AT NEW OPENINGS IN EXISTING CONSTRUCTION OR INTERFERENCE WITH OTHER NEW WORK AS NOTED IN THE FOLLOWING NOTES.
- E. DRAWINGS INDICATE SPECIFIC ITEMS TO BE REMOVED AND/OR RELOCATED IN ORDER TO INDICATE GENERAL SCOPE. ADDITIONAL ITEMS NOT INDICATED, BUT NECESSARY FOR PROJECT RENOVATIONS, SHALL BE REMOVED, RELOCATED AND/OR REROUTED AS REQUIRED TO ACCOMMODATE THE NEW CONSTRUCTION.
- F. COORDINATE DEMOLITION OF EQUIPMENT, DEVICES, ETC. WITH OTHER DISCIPLINES AS APPLICABLE. REFER TO ARCHITECTURAL DEMOLITION DRAWINGS AND NOTES FOR COORDINATION.
- G. ALL ITEMS (DEVICES, FIXTURES, ETC.) SHOWN ARE TO BE REMOVED UNLESS LABELED AS EXISTING TO REMAIN - (E). THESE ITEMS AND THEIR RELATED WIRING/CONDUIT SHALL BE REMOVED BACK TO THE SOURCE CONTROL PANEL/PANELBOARD UNLESS OTHERWISE NOTED. ON CIRCUITS WHERE OTHER DEVICES, FIXTURES, ETC. ARE FOUND THAT MUST REMAIN, MAINTAIN CIRCUIT CONTINUITY BY PROVIDING ADDITIONAL WIRING, TO FEED THROUGH TO THESE REMAINING ITEMS. RELOCATE ANY CIRCUITS THAT REMAIN, TO AVOID CONFLICT WITH NEW CONSTRUCTION AS REQUIRED. PROPERLY TERMINATE ALL WIRING.
- H. CONTRACTOR SHALL PROPERLY DISPOSE OF ALL ITEMS AND/OR EQUIPMENT BEING REMOVED AS PART OF THE PROJECT. THE OWNER SHALL HAVE THE RIGHT OF RETAINING ANY ITEMS BEING REMOVED.
- I. CONTRACTOR SHALL PROVIDE NEW COVERPLATES ON ALL UNUSED FLUSH MOUNT DEVICE BOXES UPON COMPLETION OF PROJECT.
- J. FIREPROOFING AND/OR FIRE STOP MATERIALS REMOVED FROM FIRE RATED WALLS AND CEILINGS AS A RESULT OF DEMOLITION SHALL BE RE-INSTALLED USING AN APPROVED METHOD AS DESCRIBED IN ASSOCIATED PROJECT SPECIFICATIONS.

KEY NOTES:

- ① DISCONNECT AND REMOVE EXIT SIGN. CONDUIT AND WIRING TO REMAIN FOR EXISTING CIRCUIT CONTINUITY.
- ② DISCONNECT AND REMOVE LIGHT SWITCH AND BACKBOX. EXISTING WIRING TO BE REMOVED BACK TO ACCESSIBLE CEILING AREA AND TAGGED FOR EXTENSION AND CONNECTION TO REPLACEMENT DEVICE IN NEW LOCATION. REFER TO DRAWING OHS-E301.
- ③ DISCONNECT, REMOVE AND STORE EXISTING CEILING MOUNTED CAMERA FOR DURATION OF DOORWAY CONSTRUCTION. TAG EXISTING WIRING AND KEEP CLEAR OF CONSTRUCTION.
- ④ DISCONNECT, REMOVE AND STORE EXISTING SMOKE DETECTOR FOR REUSE. MAINTAIN WIRING AND TAG FOR REUSE. REFER TO DRAWING OHS-E201 FOR REINSTALLATION.
- ⑤ DISCONNECT, REMOVE AND STORE EXISTING LIGHTING FIXTURES, EXIT SIGNS, PA SYSTEM SPEAKERS, CAMERAS AND SMOKE DETECTORS, ETC. INSIDE DASHED LINED AREA TO ALLOW REMOVAL OF EXISTING CEILING, UNLESS OTHERWISE NOTED. MAINTAIN WIRING AND TAG FOR REUSE. REFER TO DRAWINGS OHS-E201 AND OHS-E301 FOR REINSTALLATION.
- ⑥ DISCONNECT AND REMOVED ABANDONED FIRE ALARM MAGNETIC DOOR HOLD OPEN DEVICES AT FLOOR AND REMOVE WIRING TO EXTEND POSSIBLE. PATCH FLOOR PENETRATION.
- ⑦ DISCONNECT AND REMOVE LIGHTING FIXTURES IN THIS ROOM TO ALLOW PARTIAL CEILING REMOVAL TO ACCOMMODATE HVAC WORK. MAINTAIN EXISTING LIGHTING BRANCH CIRCUITRY AND TAG FOR REUSE.
- ⑧ DISCONNECT AND REMOVE LIGHTING FIXTURE AND STORE FOR REINSTALLATION. MAINTAIN EXISTING BRANCH CIRCUIT FOR EXTENSION TO RELOCATED LIGHT FIXTURE.
- ⑨ TEMPORARILY REMOVE LARGE METAL PULLBOX FROM UNDERSIDE OF CONCRETE DECKING TO ALLOW REINFORCING OF DECK. REMOVE (4) THREADED RODS ATTACHMENTS TO DECKING. REMOVE AND/OR LOWER AS REQUIRED (4) INCOMING AND OUTGOING FEEDER CONDUITS WITH CONDUCTORS TO ALLOW FOR REMOVAL OF PULLBOX. COORDINATE ALL WORK WITH GC FOR REQUIRED ADEQUATE WORKING ROOM.

⑩ NOT USED.

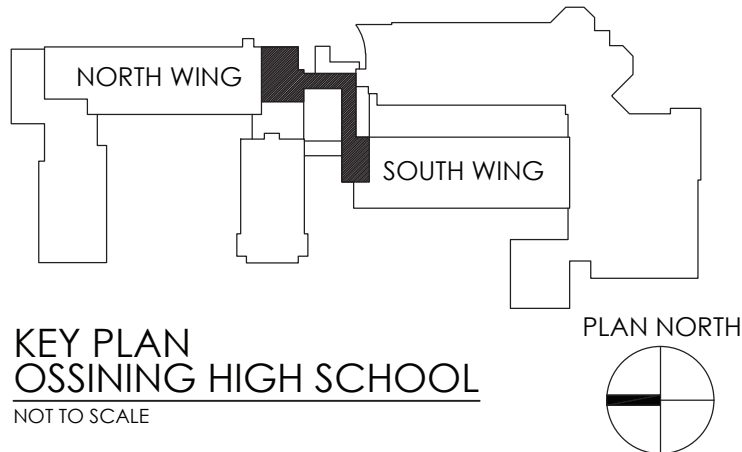



CPLteam.com
ARCHITECTURE • ENGINEERING • PLANNING

50 FRONT STREET, SUITE 202
NEWBURGH, NEW YORK 12550
TEL (800) 274-9000
FAX (845) 567-9614

REVISIONS		DESCRIPTION	BID ADDENDUM
NO.	DATE	BY	MJ
1	12/02/2021	NWH	

OSSINING UFSD
OSSINING HIGH SCHOOL

THIRD FLOOR CONNECTOR
29 SOUTH HIGHLAND AVENUE, OSSINING, NY 10542
SED #: 66-14-01-03-0-003-040

DATE	DRAWN	CHECKED
3/12/2021	MAY	JAS


SCALE	AS NOTED
SHEET TITLE	
SECOND FLOOR ELECTRICAL DEMOLITION PLAN	

PROJECT NUMBER

14428.13

OHS
E101

DRAWING NUMBER

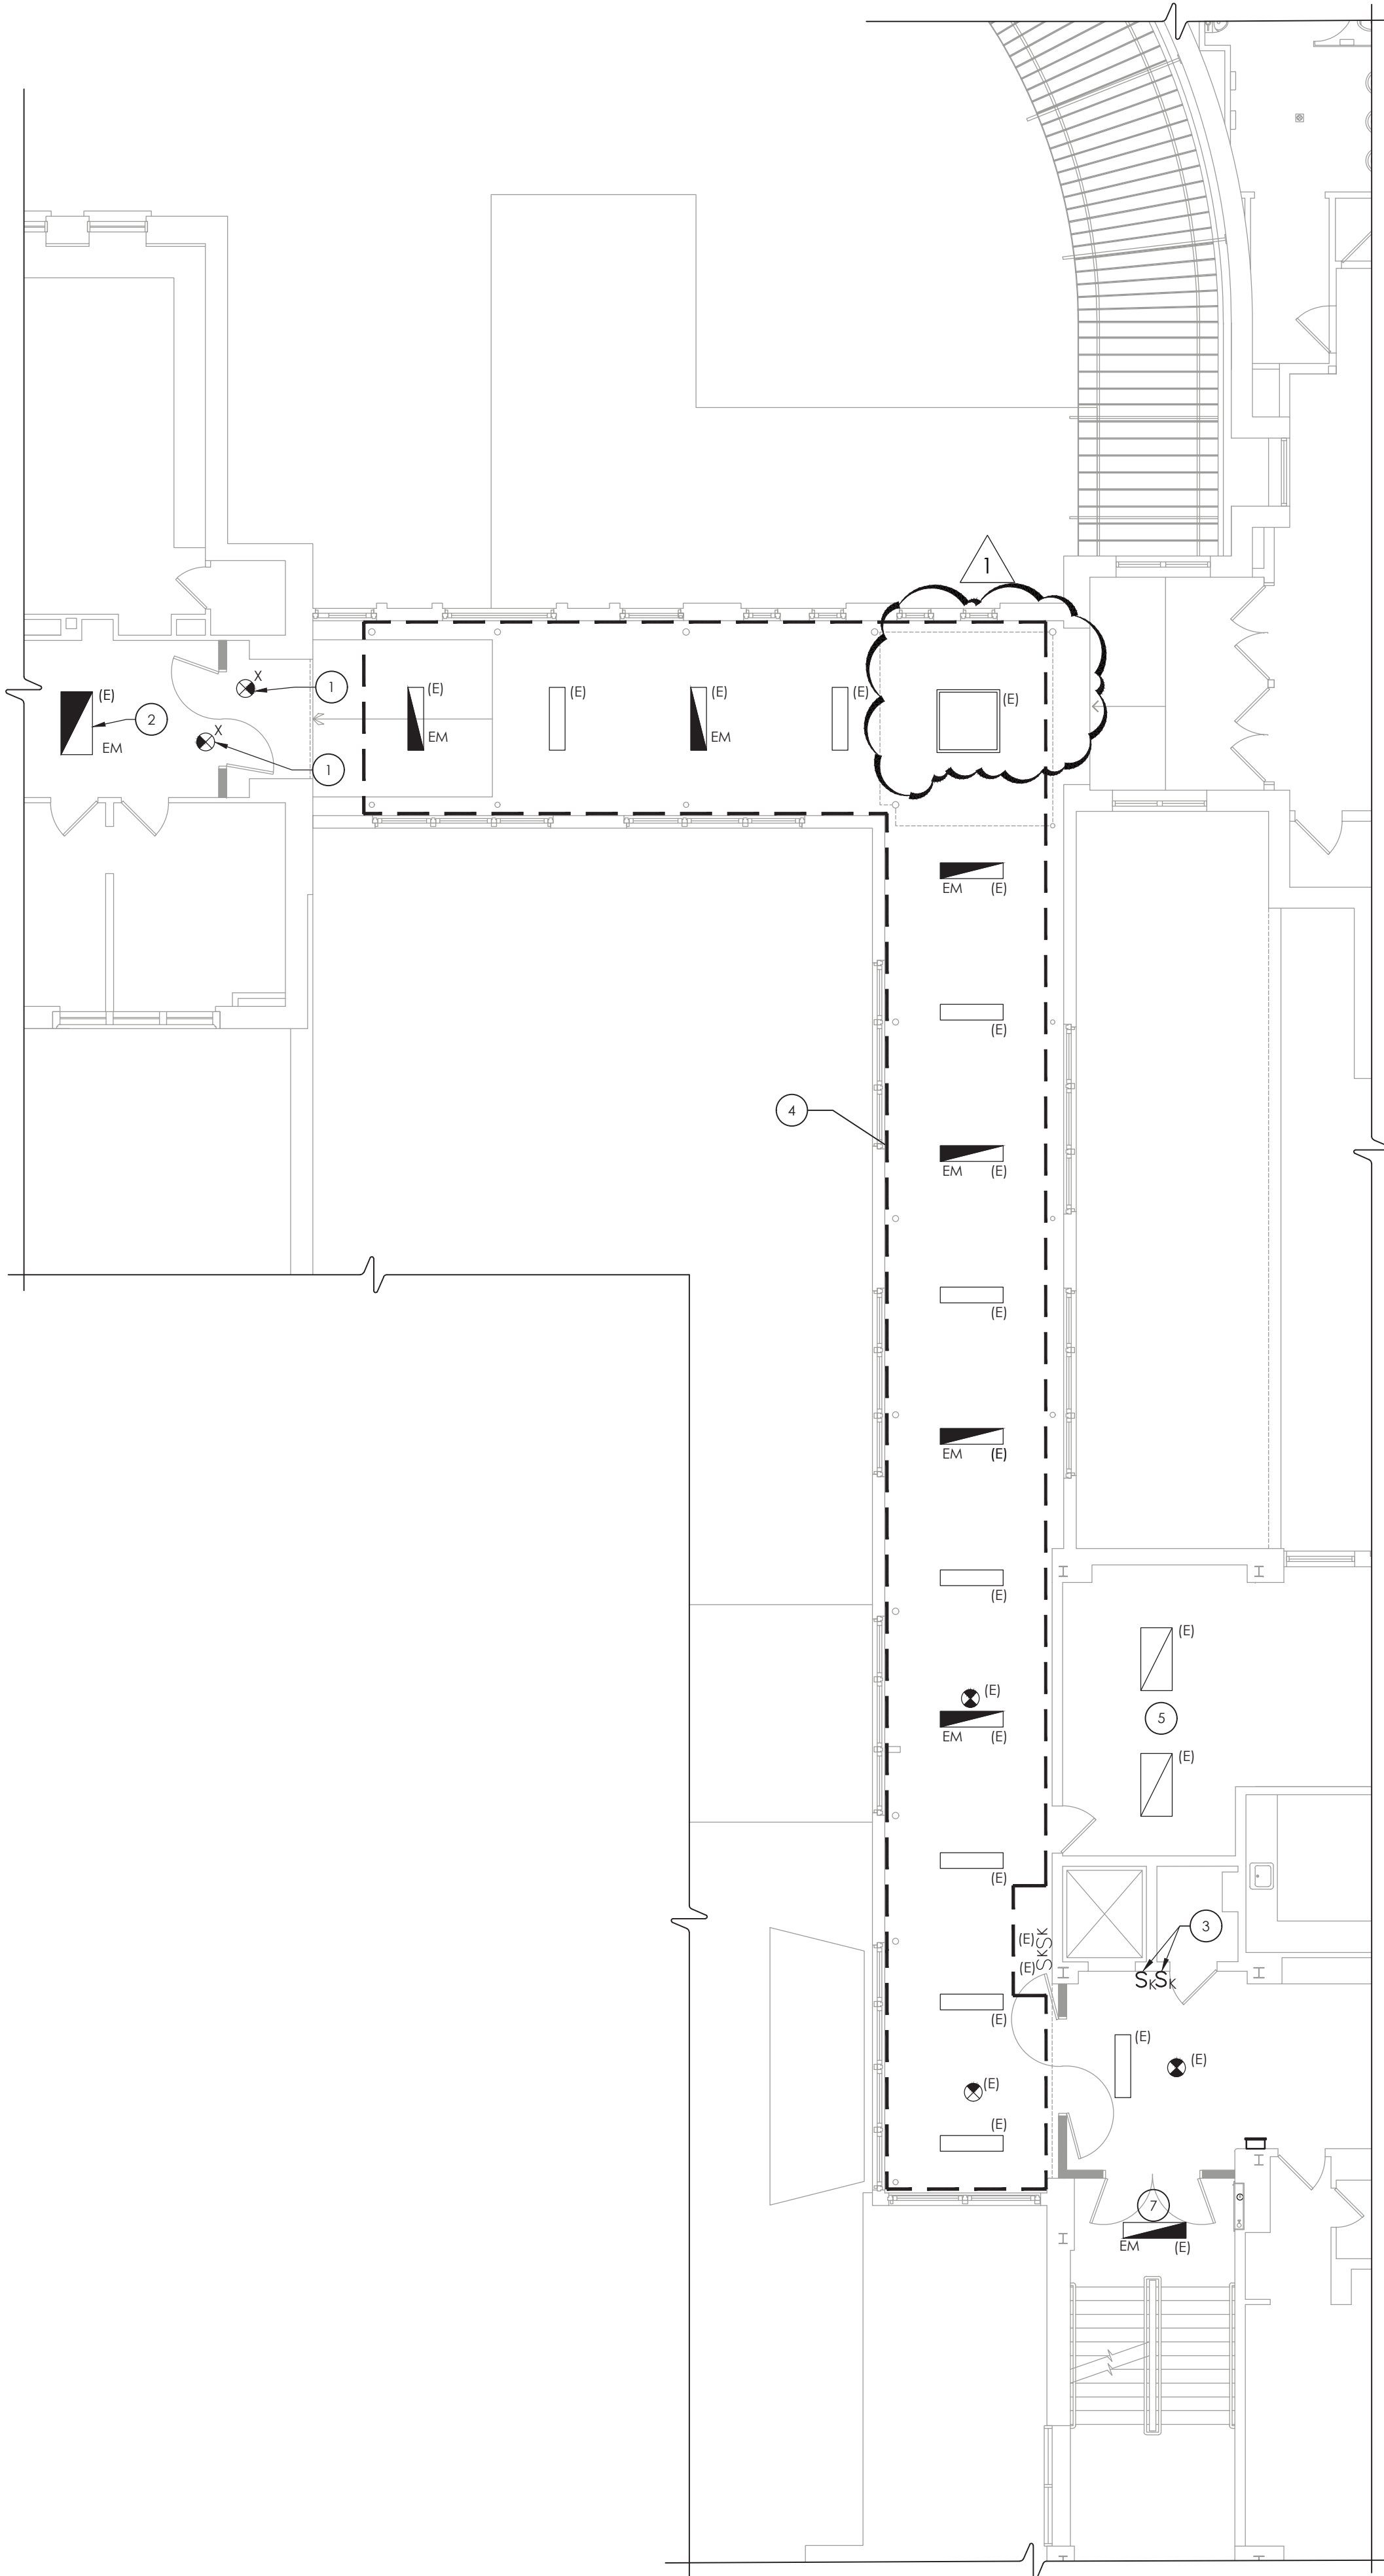


1 SECOND FLOOR LIGHTING PLAN
E301 SCALE: 1/8" = 1'-0"

GENERAL NOTES:

- A. FIXTURE TYPE MARK IS INDICATED ADJACENT TO NEW LIGHT FIXTURES. REFER TO LUMINAIRE SCHEDULE ON SHEET OHS-E900 FOR FIXTURE DESCRIPTIONS, NOTES, AND SPECIFICATIONS.
- B. FIXTURES INDICATED WITH (E) ARE EXISTING TO REMAIN UNLESS OTHERWISE NOTED.

KEY NOTES:

- 1 PROVIDE EXIT SIGN AND CONNECT TO EACH RESPECTIVE SIDE OF CORRIDOR UNSWITCHED LIGHTING BRANCH CIRCUIT, TYPICAL UNLESS OTHERWISE NOTED.
- 2 PROVIDE (1) BODINE BSL LED SERIES OR EQUAL 90 MINUTE EMERGENCY BATTERY DRIVER CONNECTED TO LINE SIDE OF FIXTURE POWER FOR THIS FIXTURE ONLY. PROVIDE UNSWITCHED HOT WIRE TO DRIVER FROM CORRIDOR LIGHTING CIRCUIT FOR CHARGING. INSTALL DRIVER INTO OR ADJACENT TO EXISTING FIXTURE.
- 3 PROVIDE REPLACEMENT LIGHTING KEYED SWITCHES (VERIFY IN FIELD 2-WAY OR 3-WAY) AT THIS LOCATION. EXTEND AND CONNECT EACH EXISTING CORRIDOR LIGHTING BRANCH CIRCUIT SWITCH LEG CIRCUITS PREVIOUSLY TAGGED WIRING.
- 4 REINSTALL EXISTING LIGHTING FIXTURES AND EXIT SIGNS INSIDE DASHED LINED AREA INTO REPLACEMENT CEILING. RECONNECT TO EXISTING TAGGED WIRING.
- 5 REINSTALL EXISTING LIGHTING FIXTURES AND CONNECT TO EXISTING TAGGED LIGHTING BRANCH CIRCUITRY.
- 6 NOT USED.
- 7 REINSTALL STORED SURFACE MOUNTED LIGHTING FIXTURE IN THIS LOCATION. EXTEND EXISTING BRANCH CIRCUIT FROM EXISTING LOCATON AND CONNECT TO RESINTALLED FIXTURE.

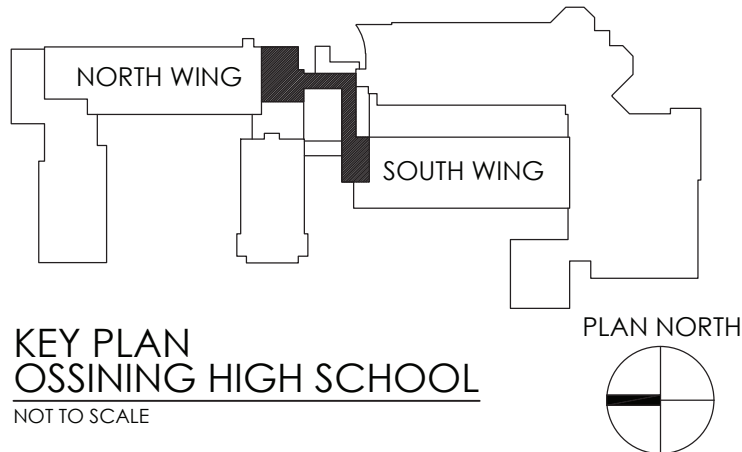

CPLteam.com
ARCHITECTURE • ENGINEERING • PLANNING

50 FRONT STREET, SUITE 202
NEWBURGH, NEW YORK 12550
TEL (800) 274-9000
FAX (845) 567-9614

REVISIONS	NO.	DATE	BY	DESCRIPTION
	1	12/02/2021	NWH	BID ADDENDUM 01



OSSINING UFSD
OSSINING HIGH SCHOOL
THIRD FLOOR CONNECTOR
29 SOUTH HIGHLAND AVENUE, OSSINING, NY 10562
SED #: 66-14-01-03-0-003-040

DATE 3/12/2021	DRAWN MAY	CHECKED JAS
SCALE AS NOTED		
SHEET TITLE SECOND FLOOR LIGHTING PLAN		

PROJECT NUMBER
14428.13

OHS
E301

DRAWING NUMBER