


Drawing Name: G:\Savin\Autocad\2060\25-Playland-Mega-2\1\COE-1006.dwg
Project Name: Playland
Comments: All inquiries regarding this drawing(s) or project should be directed to the Project Engineer, David G. Savin, at (914) 261-1006.
Printed On: 11/11/2021 10:00:00 AM
Plotter: HP DesignJet T110
Scale: 1/8" = 1'-0"

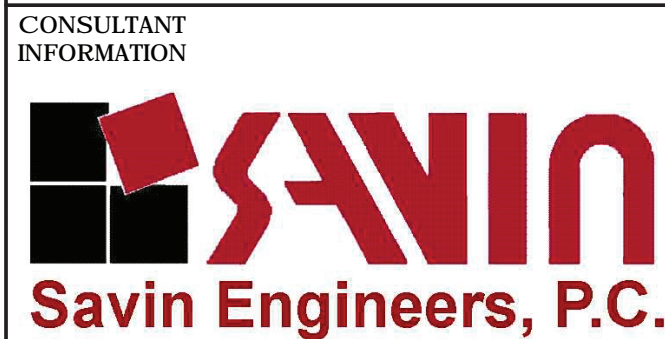

1	07/02/2021	RKC	DF	BID ADDENDUM #3
REVISION NUMBER	DATE	MADE BY	APP'D BY	REVISION

WEST COLONNADE — ROOF PLAN
SCALE: 1/8" = 1'-0"

RECORD DRAWING CERTIFICATION			
<input type="checkbox"/> AS BUILT - CHANGES AS NOTED		<input type="checkbox"/> AS BUILT - NO CHANGES	
CONTRACTOR		PROJECT COORDINATOR	
NAME		NAME	
SIGNATURE		SIGNATURE	
TITLE		TITLE	

WESTCHESTER COUNTY, NEW YORK
DEPARTMENT OF PUBLIC WORKS AND TRANSPORTATION
DIVISION OF ENGINEERING
INFRASTRUCTURE REHABILITATION - PHASE 2
PLAYLAND PARK, RYE, NEW YORK
COLONNADE RECONSTRUCTION
WEST COLONNADE ROOF LIGHTING PLAN



CONTRACT NUMBER 20-530	SHEET NUMBER AD-COL-E-05
DWG NO.: Page 67 of 290	
SCALE: AS SHOWN	
DATE: MAY 26, 2021	
DPW FILE NUMBER 1-118-E-454	REV. NO. 0

NOTES:

- FOR ADDITIONAL NOTES, ABBREVIATIONS AND SYMBOLS, SEE DRAWING GE-E-01.
- BEFORE ANY LIGHT FIXTURES AND/OR CONTROLS ARE PURCHASED, CONTRACTOR SHALL SUBMIT, FOR APPROVAL BY THE ENGINEER, A COMPLETE SET OF DRAWINGS SHOWING ALL CONTROL COMPONENTS AND WIRING DIAGRAMS.
- FOR ADDITIONAL INFORMATION, SEE LIGHTING FIXTURE SCHEDULE ON DRAWING GE-E-03 AND PANEL SCHEDULE ON DRAWING COL-E-11.
- NEW CABLE AND CONDUIT SHALL BE INSTALLED CONCEALED.
- REFER TO DRAWING COL-E-02 FOR ONE LINE DIAGRAM.
- REFER TO DRAWING COL-E-01 FOR SITE PLAN.
- NUMBER DESIGNATIONS NEXT TO FIXTURES AND/OR CONTROLS INDICATE CIRCUIT NUMBERS ASSOCIATED WITH RELAY PANEL.
- ALL LIGHTING CONTROL COMPONENTS SHALL BE FROM A SINGLE MANUFACTURER, AND MUST BE FROM THE SAME MANUFACTURER AS ALL BUILDINGS WITHIN THE CONTRACT. EQUIPMENT INCLUDES BUT NOT LIMITED TO OCCUPANCY SENSOR, RELAY/POWER PACKS, SWITCHES, RELAY PANELS, PHOTOSENSOR, ETC.
- LIGHTING CONTROLS SELECTED SHALL HAVE THE CAPABILITY TO BE CONNECTED TO A MASTER HEAD-END SYSTEM (FUTURE CONTRACT).
- ALL OUTDOOR LIGHTING SHALL BE POWERED VIA RELAY PANEL WC-RP AS INDICATED ON THE DRAWINGS. RELAY PANEL SHALL BE EQUIPPED WITH BOTH A BUILT-IN TIME CLOCK AND A PHOTOSENSOR CONTROL. EACH RELAY SHALL BE ACUITY BRANDS: ARP-INTENC08NLT-32SR-MVOLT-1VB-HLK-SM-DTC OR APPROVED EQUAL.
- PHOTOCELL SHALL BE SUITABLE FOR OUTDOOR APPLICATIONS AND SHALL BE ACUITY BRANDS: LSA-APS-OL OR APPROVED EQUAL. FINAL LOCATION OF PHOTOCELL SHALL BE DETERMINED DURING CONSTRUCTION BY THE LIGHTING MANUFACTURER.
- SEE DRAWING DT-E-01 FOR WEST COLONNADE WIRING DETAIL.
- ALL LIGHTING SPLICE BOXES SHALL BE NEMA 4X TYPE 316 STAINLESS STEEL.
- CONTRACTOR SHALL INSTALL 2" RIGID GALVANIZED STEEL CONDUITS (WITH INTERNAL PULL ROPE) FOR FUTURE AUDIO USE.
- CONTRACTOR SHALL INSTALL 4-2" RIGID GALVANIZED STEEL CONDUITS WITH INTERNAL PULL ROPE FOR FUTURE USE. TERMINATE BOTH CONDUITS IN A NEMA 4X JUNCTION BOX (STAINLESS STEEL) AT EACH END (TOWER ATTIC LOCATIONS). (SEE KEY NOTE 1).
- INSTALL 1-2" RIGID GALVANIZED STEEL CONDUIT WITH INTEGRAL PULL ROPE FOR FUTURE AUDIO USE.

KEY NOTES:


- ① STUB AND CAP CONDUIT 6" INTO ATTIC SPACE FOR FUTURE USE. PROVIDE WATERTIGHT SEAL FOR ALL CONDUIT PENETRATIONS.

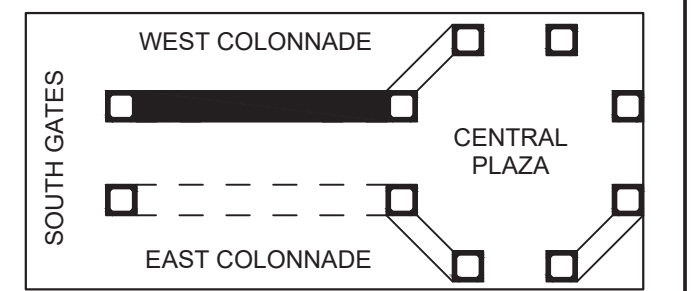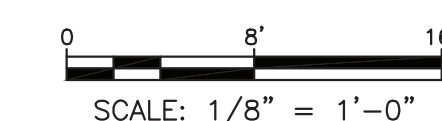

KEY PLAN
KEY MAP

Drawing Name: G:\Savin\Autocad\2060\25-Playland-Mega-2\1\COE-1011.dwg
Project Name: Playland Mega-2
Comments: All inquiries regarding this drawing(s) or project should be directed to the Designer.
Printed On: 07/02/2021 12:27:30 PM
Path: G:\Savin\Autocad\2060\25-Playland-Mega-2\1\COE-1011.dwg
Scale: 1/8" = 1'-0"

CONSULTANT
INFORMATION

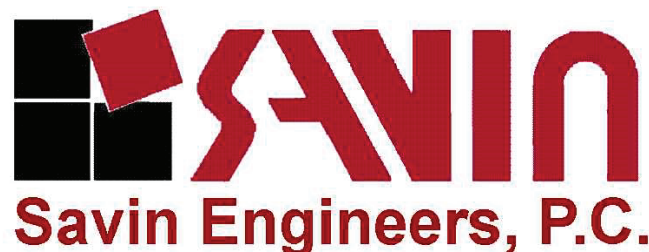

CONSULTANT SEAL



REVISION NUMBER	DATE	MADE BY	APP'D BY	REVISION
1	07/02/2021	RKC	DF	BID ADDENDUM #3

RECORD DRAWING CERTIFICATION

☐ AS BUILT - CHANGES AS NOTED ☐ AS BUILT - NO CHANGES

CONTRACTOR

NAME _____
SIGNATURE _____
TITLE _____ DATE _____

PROJECT COORDINATOR

NAME _____
SIGNATURE _____
TITLE _____ DATE _____

WESTCHESTER COUNTY, NEW YORK
DEPARTMENT OF PUBLIC WORKS AND TRANSPORTATION
DIVISION OF ENGINEERING

INFRASTRUCTURE REHABILITATION - PHASE 2
PLAYLAND PARK, RYE, NEW YORK
COLONNADE RECONSTRUCTION
EAST COLONNADE ROOF LIGHTING PLAN

CONTRACT
NUMBER

20-530

SHEET
NUMBER

AD-COL-E-09

DWG NO.: Page 71 of 290

SCALE: AS SHOWN

DATE: MAY 26, 2021

DPW FILE NUMBER 1-118-E-458



REV. NO. 0

NOTES:

- FOR ADDITIONAL NOTES, ABBREVIATIONS AND SYMBOLS, SEE DRAWING GE-E-01.
- BEFORE ANY LIGHT FIXTURES AND/OR CONTROLS ARE PURCHASED, CONTRACTOR SHALL SUBMIT, FOR APPROVAL BY THE ENGINEER, A COMPLETE SET OF DRAWINGS SHOWING ALL CONTROL COMPONENTS AND WIRING DIAGRAMS.
- FOR ADDITIONAL INFORMATION, SEE LIGHTING FIXTURE SCHEDULE ON DRAWING GE-E-03 AND PANEL SCHEDULE ON DRAWING COL-E-11.
- NEW CABLE AND CONDUIT SHALL BE INSTALLED CONCEALED.
- REFER TO DRAWING COL-E-02 FOR ONE LINE DIAGRAM.
- REFER TO DRAWING COL-E-01 FOR SITE PLAN.
- NUMBER DESIGNATIONS NEXT TO FIXTURES AND/OR CONTROLS INDICATE CIRCUIT NUMBERS ASSOCIATED WITH RELAY PANEL.
- ALL LIGHTING CONTROL COMPONENTS SHALL BE FROM A SINGLE MANUFACTURER, AND MUST BE FROM THE SAME MANUFACTURER AS ALL BUILDINGS WITHIN THE CONTRACT. EQUIPMENT INCLUDES BUT NOT LIMITED TO OCCUPANCY SENSOR, RELAY/POWER PACKS, SWITCHES, RELAY PANELS, PHOTOSENSOR, ETC.
- LIGHTING CONTROLS SELECTED SHALL HAVE THE CAPABILITY TO BE CONNECTED TO A MASTER HEAD-END SYSTEM (FUTURE CONTRACT).
- ALL OUTDOOR LIGHTING SHALL BE POWERED VIA RELAY PANEL WC-RP AS INDICATED ON THE DRAWINGS. RELAY PANEL SHALL BE EQUIPPED WITH BOTH A BUILT-IN TIME CLOCK AND A PHOTOSENSOR CONTROL. EACH RELAY SHALL BE ACQUITY BRANDS: ARP-INTENC08NLT-32SR-MVOLT-1VB-HLK-SM-DTC OR APPROVED EQUAL.
- PHOTOCELL SHALL BE SUITABLE FOR OUTDOOR APPLICATIONS AND SHALL BE ACQUITY BRANDS: LSA-APS-OL OR APPROVED EQUAL. FINAL LOCATION OF PHOTOCELL SHALL BE DETERMINED DURING CONSTRUCTION BY THE LIGHTING MANUFACTURER.
- SEE DRAWING DT-E-01 FOR EAST COLONNADE WIRING DETAIL.
- ALL LIGHTING SPLICE BOXES SHALL BE NEMA 4X TYPE 316 STAINLESS STEEL.
- CONTRACTOR SHALL INSTALL 1-2" RIGID GALVANIZED STEEL CONDUIT (WITH INTERNAL PULL ROPE) FOR FUTURE AUDIO USE.
- CONTRACTOR SHALL INSTALL 4-2" RIGID GALVANIZED STEEL CONDUITS WITH INTERNAL PULL ROPE FOR FUTURE USE. TERMINATE CONDUITS AS SHOWN.
- INSTALL 2-2" RIGID GALVANIZED STEEL CONDUITS WITH INTERNAL PULL ROPE FOR FUTURE AUDIO USE. CONTRACTOR IS ADVISED, ONE CONDUIT SHALL RUN CONCEALED DOWN A SUPPORT POST AND RUN UNDERGROUND TO NEW HANDHOLE AS SHOWN. PLACE NEW HANDHOLE 6' OUT FROM THE SUPPORT COLUMN. TERMINATE CONDUIT IN HANDHOLE. CONDUIT SHALL RUN UNDERGROUND AT 24" MINIMUM.


KEY NOTES:

- ① STUB AND CAP CONDUIT 6" INTO THE ATTIC SPACE FOR FUTURE USE. PROVIDE WATERTIGHT SEAL FOR ALL CONDUIT PENETRATIONS.

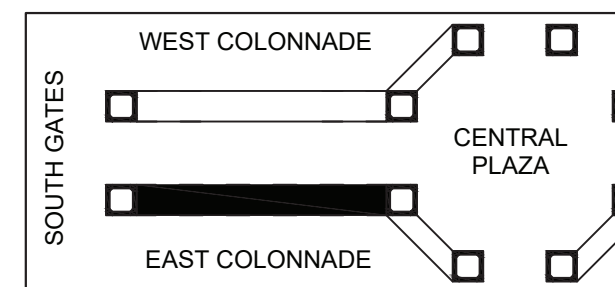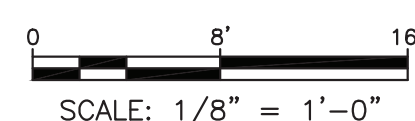

KEY MAP


Drawing Name: G:\Savin\Autocad\2060\25-Playland-Mega-2\1\PRE-1001.dwg
Created by: David G. Fredricks
Printed by: David G. Fredricks
Date: 2 July 2021 10:40 AM
Designed by: David G. Fredricks
Xrefs: [TB_24X36_WestchesterCo_3.dwg] [TSG-SVLOGO.dwg] [PR-A-11.dwg] [PR-E-1001.dwg]

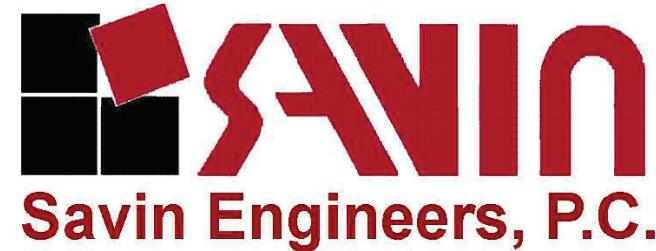

1	07/02/2021	RKC	DF	BID ADDENDUM #3	
REVISION NUMBER	DATE	MADE BY	APP'D BY	REVISION	

RECORD DRAWING CERTIFICATION					
<input type="checkbox"/> AS BUILT - CHANGES AS NOTED			<input type="checkbox"/> AS BUILT - NO CHANGES		
CONTRACTOR			PROJECT COORDINATOR		
NAME			NAME		
SIGNATURE			SIGNATURE		
TITLE			TITLE		
DATE			DATE		


WESTCHESTER COUNTY, NEW YORK DEPARTMENT OF PUBLIC WORKS AND TRANSPORTATION DIVISION OF ENGINEERING		CONTRACT NUMBER 20-530	SHEET NUMBER AD-PR-E-07
INFRASTRUCTURE REHABILITATION - PHASE 2 PLAYLAND PARK, RYE, NEW YORK PLAZA RESTAURANT GROUND FLOOR POWER PLAN		DWG NO.: Page 162 of 290	
		SCALE: AS SHOWN	
		DATE: MAY 26, 2021	
		DPW FILE NUMBER 1-118-E-549	REV. NO. 0

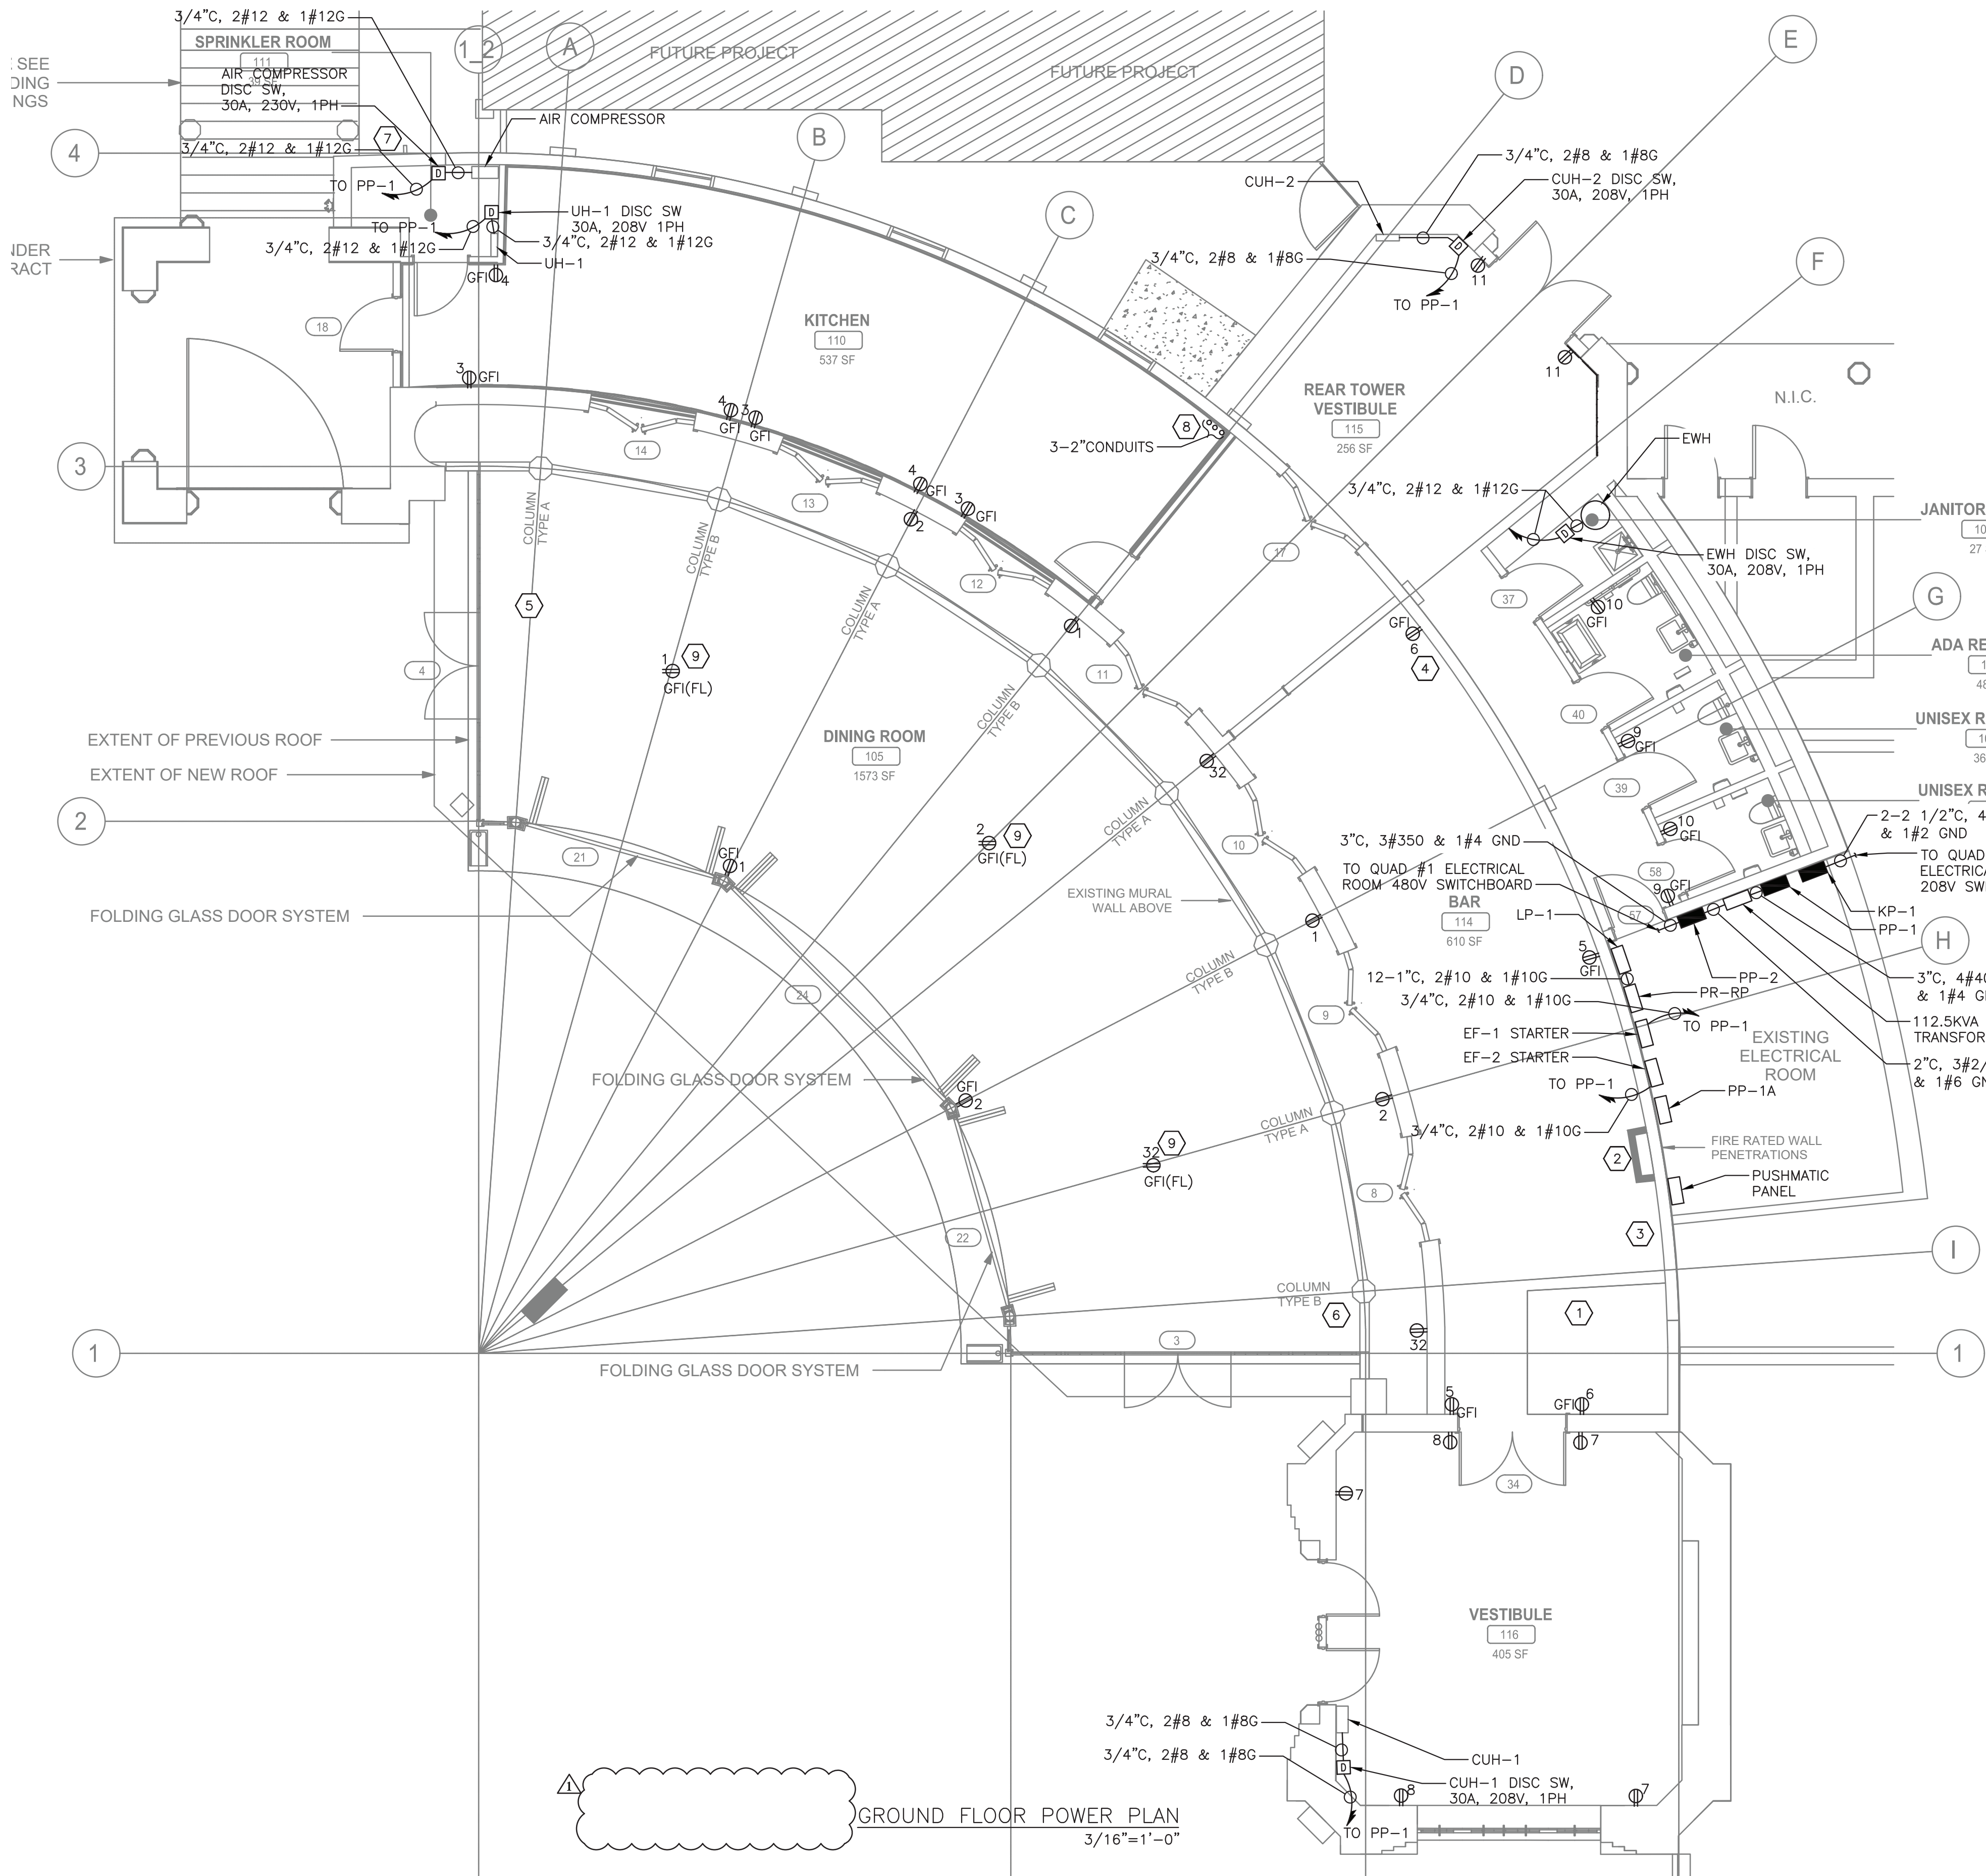

- NOTES:
- FOR ADDITIONAL NOTES, ABBREVIATIONS AND SYMBOLS, SEE DRAWING GE-E-01.
 - ALL RECEPTACLES DESIGNATORS ARE POWERED VIA PANEL PP-1, UNLESS OTHERWISE NOTED.
 - ALL CIRCUITS SHOWN ON THE DRAWING BUT NOT SPECIFICALLY CALLED OUT ON THE CABLE AND CONDUIT SCHEDULE SHALL BE 3/4" CONDUIT 2#12, 1#12G AWG.
 - ALL HVAC LOW VOLTAGE WIRING SHALL BE PERFORMED BY THE HVAC CONTRACTOR, INCLUDING BUT NOT LIMITED TO LOW VOLTAGE THERMOSTAT WIRING.
 - EXHAUST FAN STARTERS SHALL BE FURNISHED BY THE EXHAUST FAN MANUFACTURER. FOR EXHAUST FAN STARTER REQUIREMENTS, SEE HVAC CONTRACT DRAWINGS AND SPECIFICATIONS.
 - DISCONNECT SWITCHES OUTDOORS, IN RESTROOMS AND/OR IN JANITORS CLOSETS SHALL BE IN A NEMA 3R ENCLOSURE.
 - FOR PANEL SCHEDULE, SEE DRAWINGS PR-E-11 AND PR-E-12.

- KEY NOTES:
- CONTRACTOR SHALL SPLICE AND EXTEND THE CIRCUITS FROM EXISTING DEC LIGHTING PANEL TO LP-1 LIGHTING PANEL LOCATED IN EXISTING ELECTRICAL ROOM. ASSUME 8-3/4"C WITH 2#10 AND 1#10 GND EACH. FOR MORE INFORMATION, SEE PANEL SCHEDULE LP-1 ON DRAWING PR-E-12.
 - FOR ASTHETICS ALL CONDUIT EXITING THE ELECTRICAL ROOM SHALL BE INSTALLED IN THE SHADE (SEE ARCHITECTURAL DRAWINGS FOR DETAILS).
 - CONTRACTOR SHALL SPLICE AND EXTEND THE CIRCUITS FROM KITCHEN PANEL 2 TO PP-1A PANEL LOCATED IN EXISTING ELECTRICAL ROOM. ASSUME 6-3/4"C WITH 2#10 AND 1#10 GND EACH. FOR MORE INFORMATION, SEE PANEL SCHEDULE PP-1A ON PR-E-11.
 - CONTRACTOR SHALL SPLICE AND EXTEND THE CIRCUITS FROM EXISTING KITCHEN PANEL 1 TO PP-1A PANEL LOCATED IN EXISTING ELECTRICAL ROOM. ASSUME 16-3/4"C WITH 2#10 AND 1#10 GND EACH. FOR MORE INFORMATION, SEE PANEL SCHEDULE PP-1A ON PR-E-11.
 - CONTRACTOR SHALL SPLICE AND EXTEND THE CIRCUITS FROM EXISTING TICKET BOOTH PANEL TO PP-1A PANEL LOCATED IN EXISTING ELECTRICAL ROOM. ASSUME 5-3/4"C WITH 2#10 AND 1#10 GND EACH. FOR MORE INFORMATION, SEE PANEL SCHEDULE PP-1A ON PR-E-11.
 - CONTRACTOR SHALL RELOCATE THE EXISTING PUSHMATIC PANEL TO EXISTING ELECTRICAL ROOM. SPLICE AND EXTEND EXISTING BRANCH CIRCUITRY AS REQUIRED. NEW POWER SHALL BE FROM PANEL PP-1A, ASSUME 1 1/2"C, 3#2 & 1#6G.
 - EXISTING COMMUNICATION BOX SHALL REMAIN OPERATIONAL DURING CONSTRUCTION. CONTRACTOR SHALL PROTECT AND SUPPORT EXISTING DEVICE AND ASSOCIATED CABLE AND CONDUIT DURING CONSTRUCTION.
 - PROVIDE CONDUIT WITH PULL ROPE FOR FUTURE USE. CONDUIT SHALL RUN IN FLOOR SLAB TO NEW ELECTRICAL ROOM. STUB AND CAP CONDUIT 6" AFF. CONDUIT SHALL TERMINATE IN PANEL PP-1.
 - CONTRACTOR SHALL PROVIDE FLUSH MOUNTED ELECTRICAL FLOOR BOXES FOR RECEPTACLES. INSTALL ALL CONDUIT IN FLOOR SLAB.


0 4' 8'
SCALE: 3/16" = 1'-0"

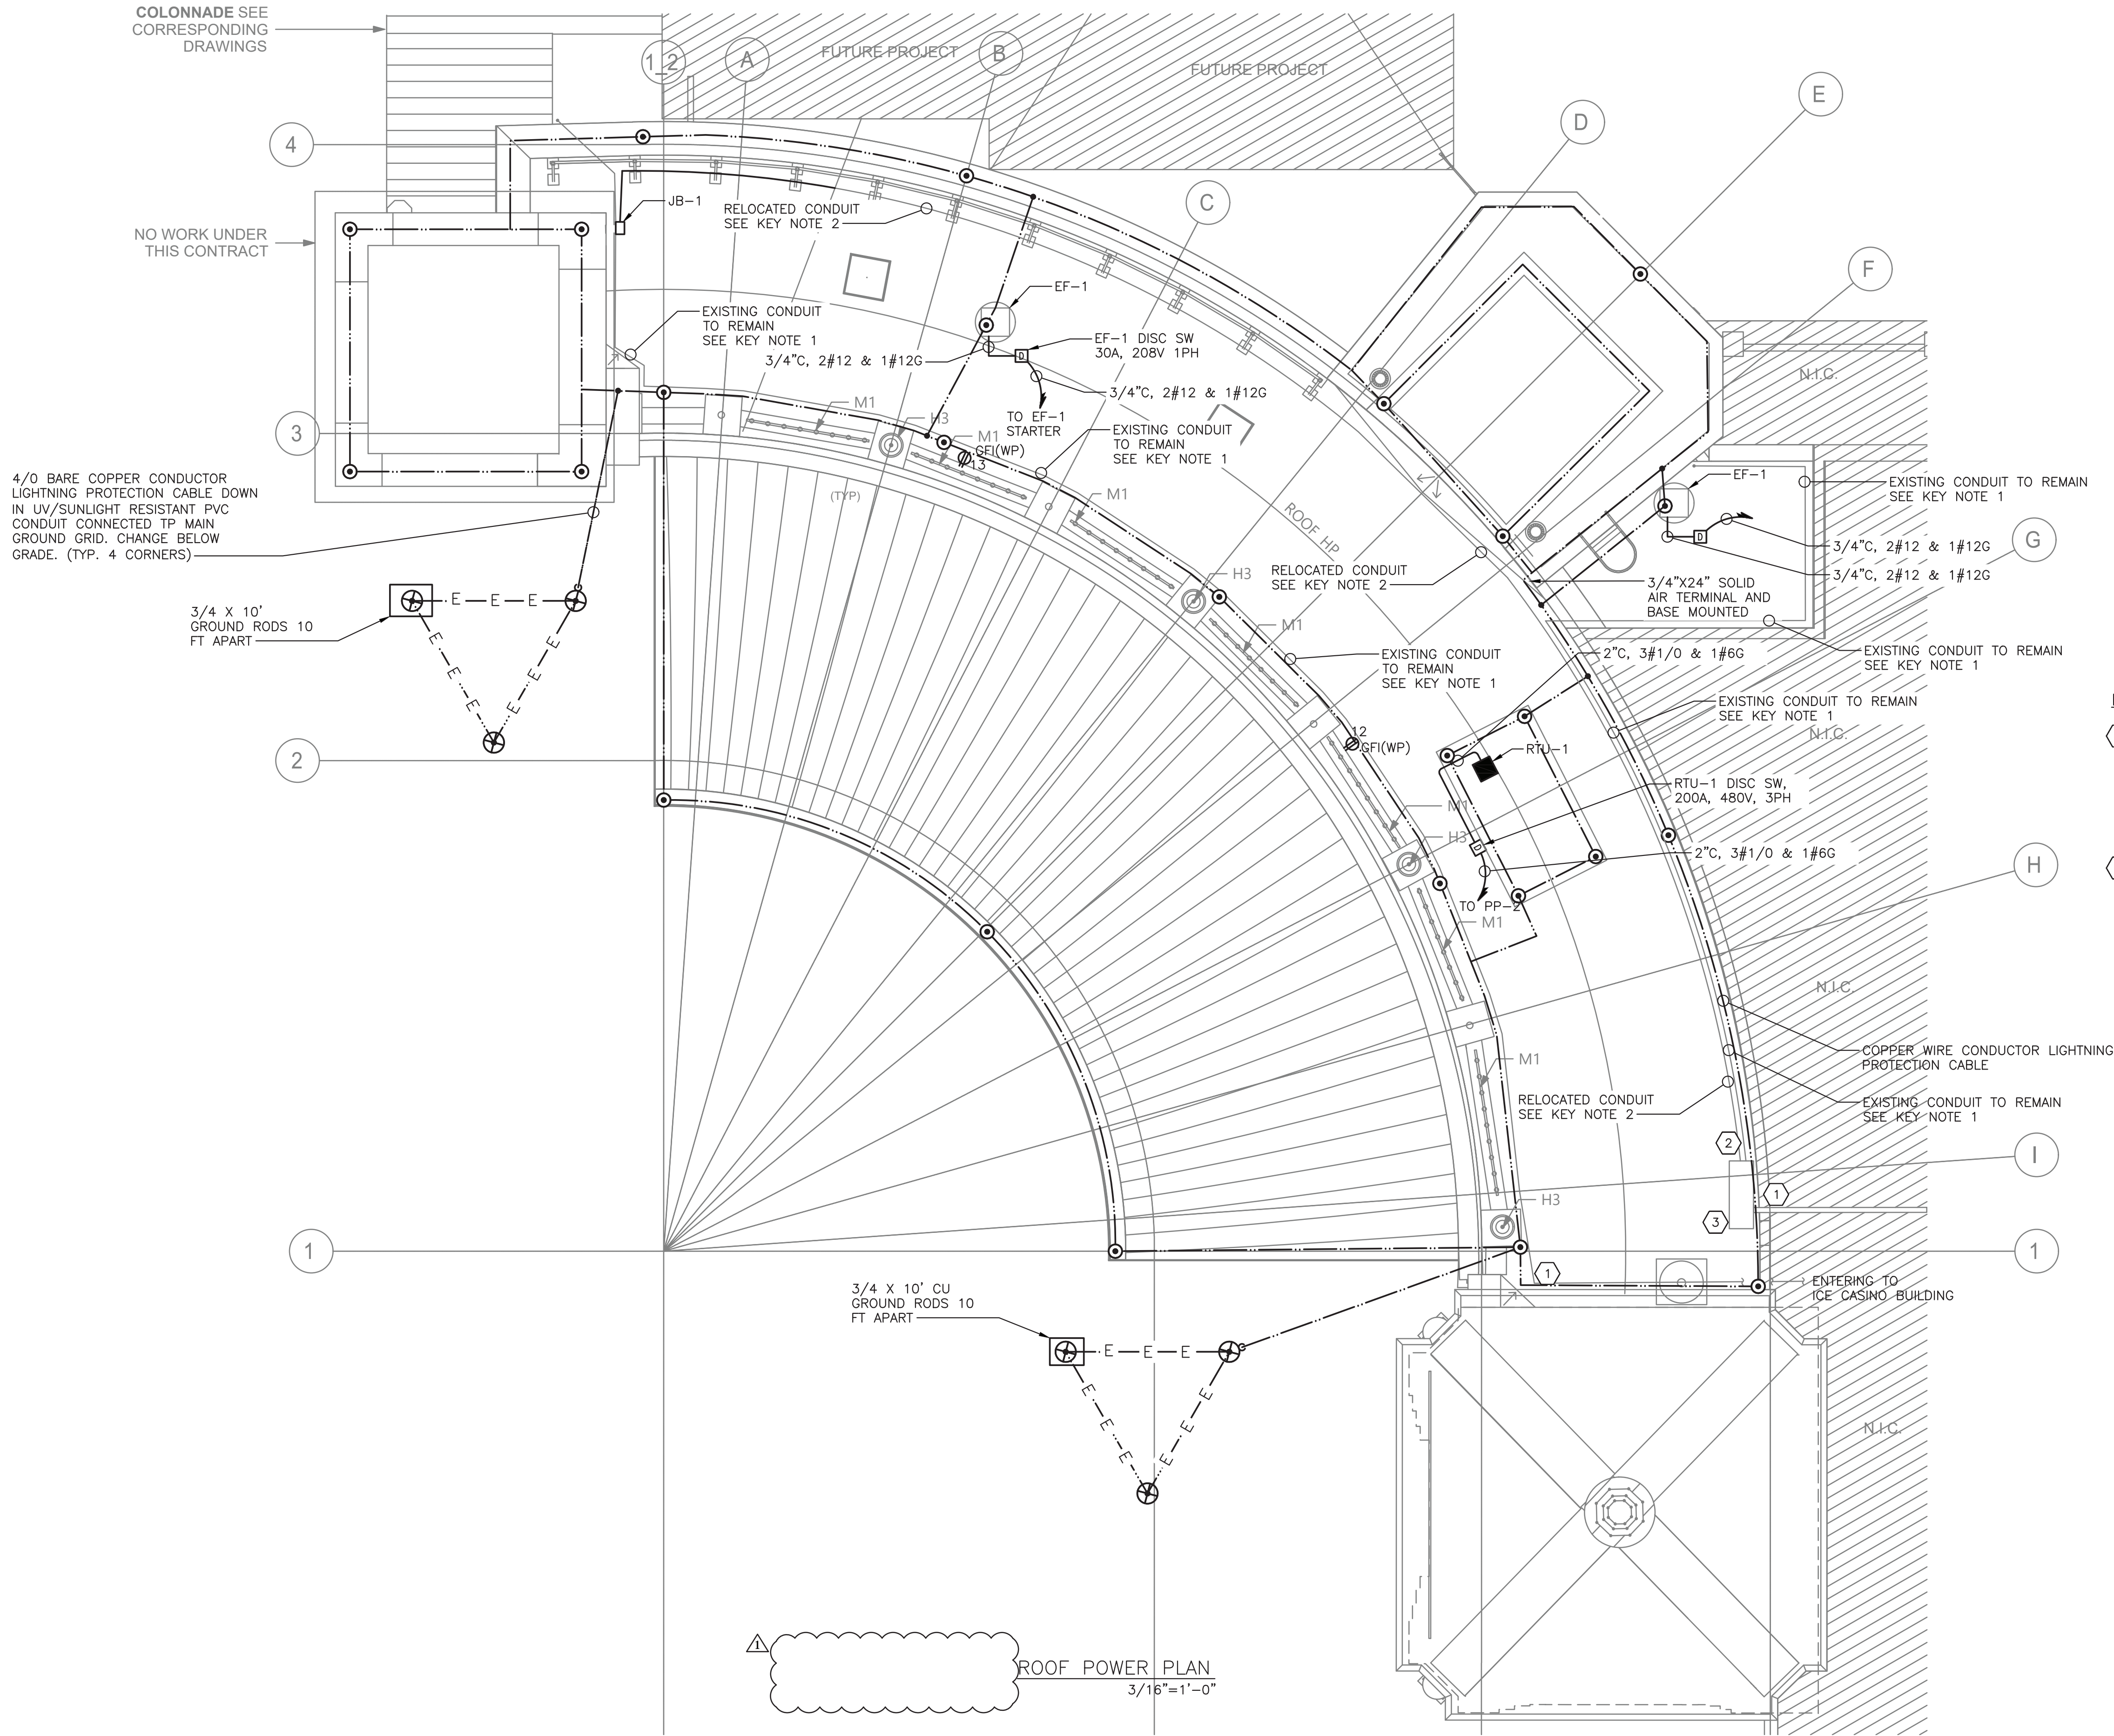

- NOTES:
1. FOR ADDITIONAL NOTES, ABBREVIATIONS AND SYMBOLS, SEE DRAWING GE-E-01.
 2. LIGHTNING PROTECTION SYSTEM SHALL BE DESIGNED BY A CERTIFIED LIGHTNING PROTECTION SYSTEM DESIGNER/INSTALLER. DRAWINGS ARE PROVIDED FOR BIDDING PURPOSES ONLY.
 3. CONTRACTOR SHALL PROVIDE UL96A MASTER LABEL FOR ENTIRE LPS SYSTEM.
 4. ALL CONDUITS SHOWN ON DRAWINGS ARE SHOWN DIAGRAMMATICALLY. CONTRACTOR SHALL FINALIZE ROUTING IN THE FIELD.
 5. ALL RECEPTACLES SHALL HOMERUN TO PANEL PP-1, UNLESS OTHERWISE NOTED.
 6. ALL HVAC LOW VOLTAGE WIRING SHALL BE PERFORMED BY THE HVAC CONTRACTOR, INCLUDING BUT NOT LIMITED TO LOW VOLTAGE THERMOSTATIC WIRING.
 7. ALL CIRCUITS SHOWN ON THE DRAWING BUT NOT SPECIFICALLY CALLED OUT ON THE CABLE & CONDUIT SCHEDULE SHALL BE 3/4" CONDUIT WITH 2#12 & 1#12G AWG. CIRCUITS SHALL INCLUDE BUT ARE NOT LIMITED TO RECEPTACLES.
 8. EXHAUST FAN STARTERS SHALL BE FURNISHED BY THE EXHAUST FAN MANUFACTURER. FOR EXHAUST FAN STARTER REQUIREMENTS, SEE HVAC CONTRACT DRAWINGS AND SPECIFICATIONS.
 9. DISCONNECT SWITCHES OUTDOORS, IN RESTROOMS AND/OR IN JANITORS CLOSETS SHALL BE IN A NEMA 3R ENCLOSURE.
 10. FOR PANEL SCHEDULE, SEE DRAWINGS PR-E-11 AND PR-E-12.

- KEY NOTES:
- 1 EXISTING CONDUIT TO REMAIN. CONTRACTOR SHALL TEMPORARILY SUPPORT THE CONDUIT DURING CONSTRUCTION AND REINSTALL WHEN THE ROOF WORK IS DONE. ASSUME 1" CONDUIT WITH 3#10 AND 1#10 GROUND.
- RELOCATED CONDUIT.
- 3 RELOCATED PULL BOX

Drawing Name: G:\Savin\Autocad\2060\25-Playland-Mega-2\PR-E-1002.dwg
Printed by: B. Killebrew Date: 2 July 2021 10:40 AM Designed by: ---
Xrefs: [TB-24X3E-WestchesterCo_3.dwg] [TS6-SVLOGO.dwg] [PR-A-13.dwg] [PR-E-1002.dwg]

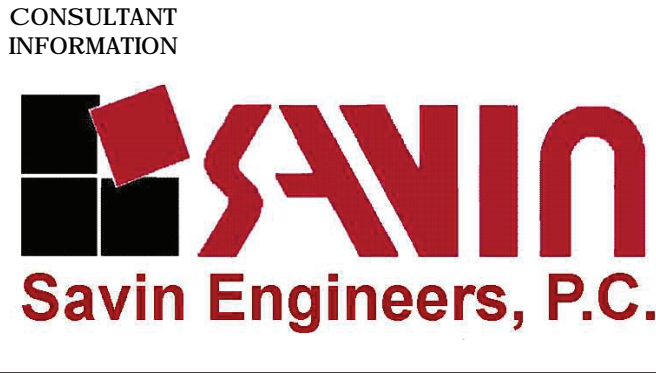

REVISION NUMBER	DATE	MADE BY	APP'D BY	REVISION
1	07/02/2021	RKC	DF	BID ADDENDUM #3


RECORD DRAWING CERTIFICATION			
<input type="checkbox"/> AS BUILT - CHANGES AS NOTED		<input type="checkbox"/> AS BUILT - NO CHANGES	
CONTRACTOR		PROJECT COORDINATOR	
NAME _____	NAME _____	NAME _____	NAME _____
SIGNATURE _____	SIGNATURE _____	SIGNATURE _____	SIGNATURE _____
TITLE _____	TITLE _____	TITLE _____	TITLE _____

WESTCHESTER COUNTY, NEW YORK
DEPARTMENT OF PUBLIC WORKS AND TRANSPORTATION
DIVISION OF ENGINEERING

INFRASTRUCTURE REHABILITATION - PHASE 2
PLAYLAND PARK, RYE, NEW YORK
PLAZA RESTAURANT
ROOF POWER PLAN

CONTRACT NUMBER	SHEET NUMBER
20-530	AD-PR-E-08
DWG NO.: Page 163 of 290	
SCALE: AS SHOWN	
DATE: MAY 26, 2021	
DPW FILE NUMBER	REV. NO.
1-118-E-550	0


Drawing Name: G:\Savin\Autocad\2060\25-Playland-Mega-2\PRE-1004.dwg
User: C:\Users\David.Fredricks\Documents\Autocad\2060\25-Playland-Mega-2\PRE-1004.dwg
Printed by: David.Fredricks Date: 2 July 2021 10:40 AM Designed by: David.Fredricks
Xrefs: [TB_24X36_WestchesterCo_3.dwg] [TS6-SU050.dwg] [PR-A-1.dwg] [PR-E-1005.dwg]

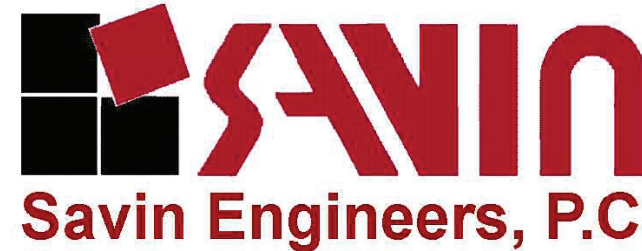

REVISION NUMBER	DATE	MADE BY	APP'D BY	REVISION
1	07/02/2021	RKC	DF	BID ADDENDUM #3

RECORD DRAWING CERTIFICATION			
<input type="checkbox"/> AS BUILT - CHANGES AS NOTED		<input type="checkbox"/> AS BUILT - NO CHANGES	
CONTRACTOR		PROJECT COORDINATOR	
NAME _____	NAME _____		
SIGNATURE _____	SIGNATURE _____		
TITLE _____	TITLE _____		
DATE _____	DATE _____		

WESTCHESTER COUNTY, NEW YORK DEPARTMENT OF PUBLIC WORKS AND TRANSPORTATION DIVISION OF ENGINEERING	
INFRASTRUCTURE REHABILITATION - PHASE 2 PLAYLAND PARK, RYE, NEW YORK PLAZA RESTAURANT ROOF LIGHTING PLAN	
CONTRACT NUMBER 20-530	SHEET NUMBER AD-PR-E-10
DWG NO.: Page 165 of 290	
SCALE: AS SHOWN	
DATE: MAY 26, 2021	
DPW FILE NUMBER 1-118-E-552	REV. NO. 0

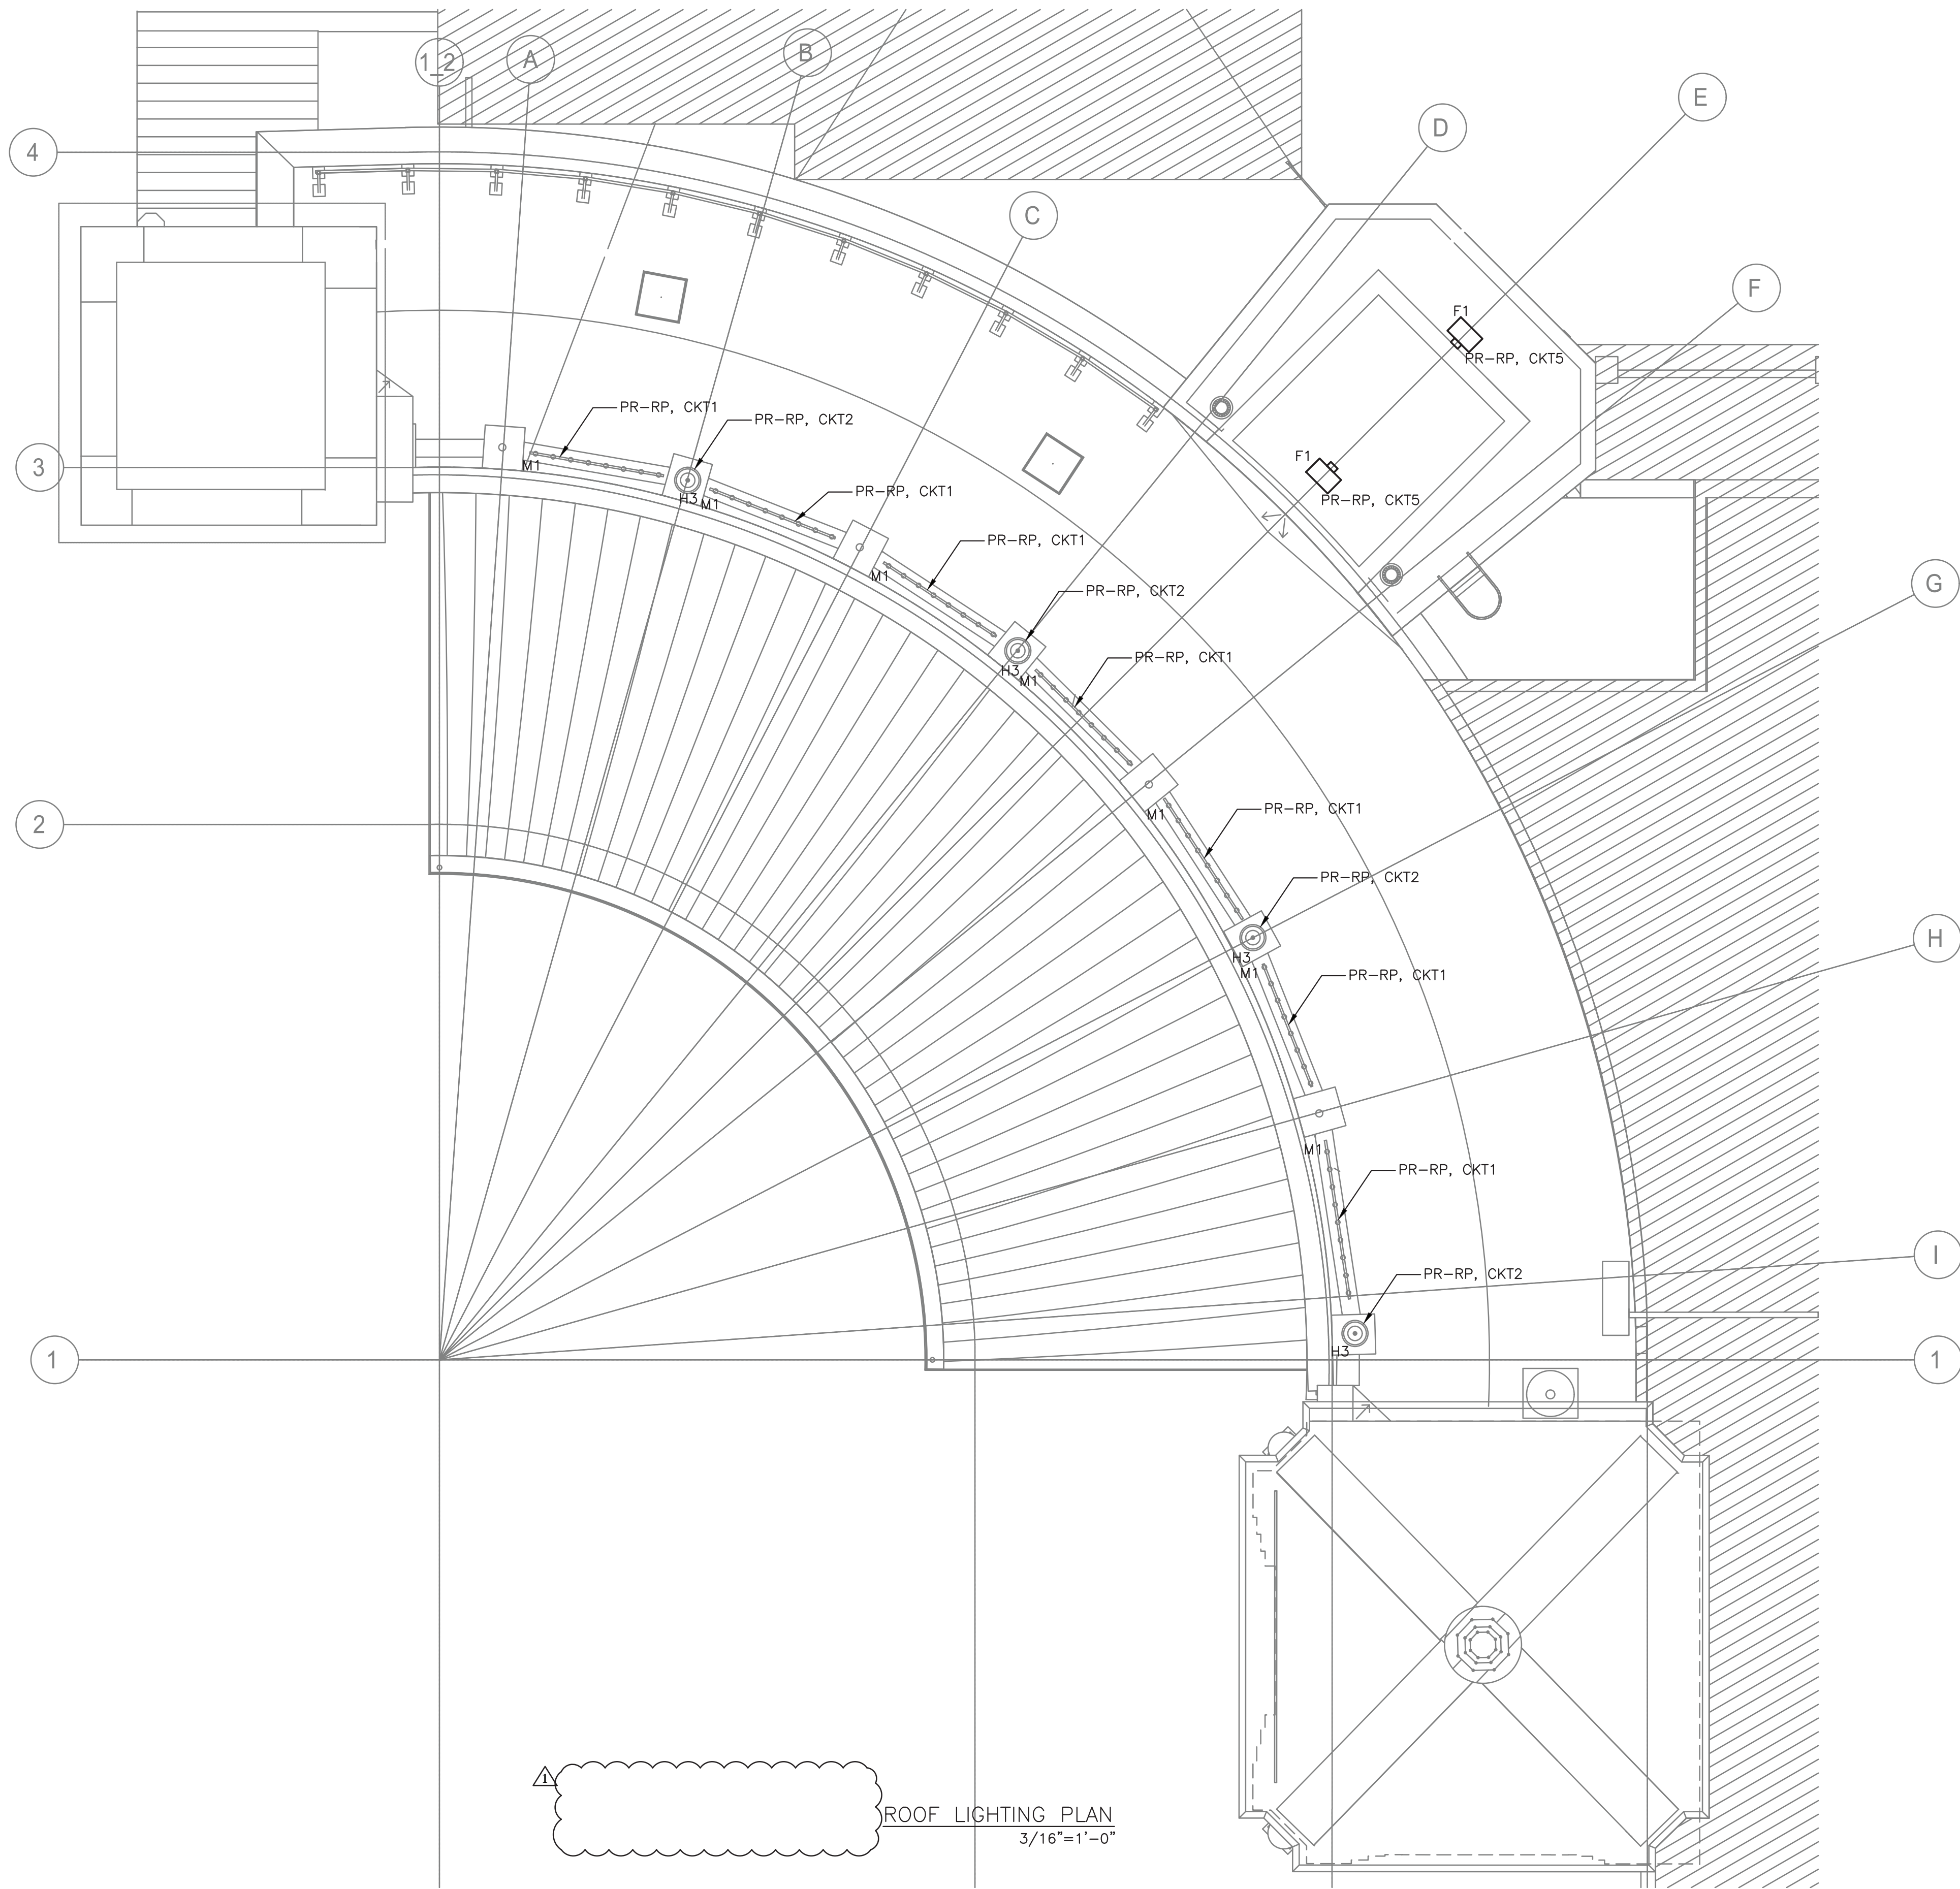

- NOTES:
1. FOR ADDITIONAL NOTES, ABBREVIATIONS AND SYMBOLS, SEE DRAWING GE-E-01.
 2. ALL EXTERIOR LIGHTING SHALL BE CIRCUITED TO RELAY PANEL PR-RP. CONTRACTOR SHALL CIRCUIT LIGHTING FIXTURES WITH 3/4" CONDUIT, WITH 2#10 & 1#10G AWG, UNLESS NOTED OTHERWISE. CONTRACTOR SHALL DAISY-CHAIN ALL EXTERIOR LIGHT FIXTURES WITH SAME CIRCUIT NUMBER BACK TO LIGHTING PANEL PR-RP.
 3. FOR ADDITIONAL INFORMATION, SEE LIGHTING FIXTURE SCHEDULE ON DRAWING GE-E-03 AND PANEL SCHEDULE ON DWG PR-E-12.
 4. ALL OUTDOOR LIGHTING SHALL BE POWERED VIA RELAY PANEL PR-RP AS INDICATED ON THE DRAWINGS. RELAY PANEL SHALL BE EQUIPPED WITH BOTH A BUILT-IN TIME CLOCK AND A PHOTOSENSOR CONTROL. EACH RELAY SHALL BE ACUITY BRANDS: ARP-INTENC08NLT-16SR-MVOLT-1VB-HLK-SM-DTC-OR APPROVED EQUAL.

0 4' 8'
SCALE: 3/16" = 1'-0"