

COUNTY OF WESTCHESTER
NEW YORK

DIVISION OF ENGINEERING

ADDENDUM NO. 2

CONTRACT NO. 19-514

Low Rise Building Renovations and HVAC Improvements
110 Dr. Martin Luther King Jr. Boulevard
White Plains, New York

The attention of the bidders is directed to the following changes, additions, and/or substitutions affecting the above referenced contract.

I. RE: GENERAL CONTRACT INFORMATION:

A. Construction Access Revised: The window removals allowed per drawing DM-006 issued with Addendum 1 are revised. The windows at the "Bridge" area where access to be provided for deliveries and removals are ribbon windows, not individual windows as previously assumed. The contractor may remove up to 6 windows in the one bay shown in the photos attached. As note previously, any opening created for material access shall be provided with a weather tight temporary enclosure and sealed when not in use. Any removed windows must be stored and re-installed before completion of the project.

B. Drawing revision number update. We have attached the drawings listed below, which were issued under Addendum #1. The only change to these drawings is that the Revision No. in the lower right corner of the sheets has been changed from 0 to 1. There have been no other changes made to these drawings. We apologize for any confusion this might have caused.

DM-002, DM-003; DM-004; DM-006; A-114.

Please DELETE the previous copies of these drawings and REPLACE them with the attached drawings.

C. DPW Drawing number update. We have attached the drawings listed below, which were new drawings issued under Addendum #1. The only change to these drawings is that the DPW file number has been added. There have been no other changes made to these drawings. We apologize for any confusion this might have caused.

T-001; T-002; T-101; T-102; T-103; T-104; T-300; T-301; T-400; T-401.

Please DELETE the previous copies of these drawings and REPLACE them with the attached drawings.

D. Corridor Lighting Circuiting Drawing: We have attached drawings E-040 and E-203 to show lighting circuiting at the North section of the corridor. The architectural Reflected Ceiling Plan A-114 showing this lighting and ceiling conditions was issued under Addendum #1.

Please DELETE the previous copies of these drawings and REPLACE them with the attached drawings.

E. Emergency Electric Circuiting. We have attached the following New Electrical drawings to show the design of Emergency Power to the Communications Rooms.

E-104: Emergency power feeder provided from Main Office Building Computer Room to serve Low Rise IT Room panels. Added emergency panel and circuits in each low rise IT room to serve network equipment

E-105: Emergency power feeder provided from Main Office Building Computer Room to serve Low Rise IT Room panels. Added emergency panel and circuits in each low rise IT room to serve network equipment

These drawings are shown on the attached updated Drawing List, and the work shown on these drawings is part of the contract work.

F. Plumbing Fixture Schedule Update: We have attached revised drawings A-141 and A-142. The Plumbing Fixture Schedule and Restroom Accessory Schedule on A-141 have been revised per the first Architectural question below. The Schedules have been removed from A-142 to avoid conflicts. No changes have been made to the plans, etc. on these drawings.

Please DELETE the previous copies of these drawings and REPLACE them with the attached drawings.

G. Work at 2nd Floor Ceiling: As shown and scheduled on the engineering drawings, work will be required in the ceiling of the 2nd Floor below the 3rd Floor area of work. The contractor is responsible for any ceiling removals, protection and restoration of the areas affected on the floor below. We have attached an Existing Plan/RCP of the 2nd Floor for reference.

All provisions of the contract not affected by the foregoing shall remain in full force and effect.

COUNTY OF WESTCHESTER
DEPARTMENT OF PUBLIC WORKS AND TRANSPORTATION

By: Hugh J. Greechan Jr., P.E.
Commissioner

Dated: Monday, June 28, 2021

WHITE PLAINS, NEW YORK

BIDDERS QUESTIONS AND RESPONSES

WESTCHESTER COUNTY DEPARTMENT OF PUBLIC WORKS
AND TRANSPORTATION
DIVISION OF ENGINEERING

CONTRACT NO. 19-514
LOW RISE BUILDING RENOVATIONS AND HVAC IMPROVEMENTS
110 DR. MARTIN LUTHER KING JR. BOULEVARD
WHITE PLAINS, NEW YORK

The attention of all bidders is directed to the following responses to questions with regards to the above referenced Contract. These responses are presented for information purposes only and are not intended to modify the Contract. All provisions of the contract remain in full force and effect. Where modification is required, the bidder's attention is directed to the addenda.

#	QUESTION	RESPONSE
	<u>ADMINISTRATIVE / CONTRACTUAL</u>	
1	Would we be able to remove the mullions in between the windows at the staging area, in order to be able to handle larger material etc.?	As noted in item A. above, we have attached photos of the windows at the "Bridge" where construction access will be provided. The contractor may remove up to 6 windows in the bay pictured for use for loading and refuse removal.
2	Will we be able to use the elevators for personnel outside the hours of 7:00 and 9:00 am?	Yes, personnel may use the elevator outside the 7:00 – 9:00 AM delivery window.
	<u>ARCHITECTURAL</u>	
3	<p>Regarding the Plumbing Fixture Schedule: We need to confirm the following with makes, models & quantities.</p> <ul style="list-style-type: none">Confirming that they are looking for AER-DEC 84000 – 120" long sink that includes the faucet/ soap dispenser / deck mounted hand dryer ORDSG 84000 which is also 120" but would only have the faucet and soap dispenser	<p>Please see revised Plumbing Fixture and Restroom Accessory Schedules on revised A-141, attached, which addresses these questions. We have also revised A-142, with the schedules removed so that the schedule only appears on A-141.</p>

	<ul style="list-style-type: none"> • Qty of sinks ? • Material (Corian - solid surface, Corian Quartz, Caesarstone, Silestone etc) and Color as this drives the pricing. I assume they are looking at Corian solid surface? • Faucets – schedule shows EFX-200 which is hardwired – assume they want the plug in power supply version? • Mixer for above faucet? Below deck thermostatic mixer, below deck manual mixer, integrated side mixer (ISM) or no mixer • Soap dispenser – the ESD 400 (hardwired) is only version that will work due to size • Dryer – only option is hardwired • Angled ADA stainless enclosure to be included • Edge – 3 styles – all same price - bevel, straight (eased) or rounded – most go with “straight” 	<p>Please note that in addition to clarifying the plumbing fixtures, we have revised the specification for the TP Toilet Paper Dispenser.</p> <p>Quantities are by the contractor.</p>
4	Please confirm that the pantry cabinets and counter tops are to be by the furniture vendor.	The pantry cabinets and countertops will be provided by the furniture vendor. The contractor is responsible for installing any sinks, electric and all other fixtures and utilities. The contractor shall modify the countertops, splashes, etc. as needed.
5	Please provide clarification as to what the furniture vendor is providing and what the millworker is responsible for. For example, elevation 7 on A405 shows base cabinets called out as furniture. Are we to assume that the SS2 top and the SS1 backsplash is also by the furniture vendor?	This was clarified in Addendum 1. The SS2 top and SS1 backsplash is by the furniture vendor. Please see the question above for contractor’s responsibilities.
6	Please provide plastic laminate selections for the millwork.	Laminate has not been selected. It will be a Wilsonart, Laminart, Formica or similar major plastic laminate brand. It will not be metallic.

7	Openings 15 & 16 / Comments Column on door schedule say: Sound Rated. Is there a specific STC rating?	Please see specification section 083473.13; Sound-Control Door Assemblies.
8	<p>The following questions were submitted by the Office Front vendor Metro Wall, in relation to the GF-2 Office Front system, and is included because we believe it may be of general interest to bidders:</p> <ul style="list-style-type: none"> a. Can you please confirm the finish of the wood doors? b. Can you please confirm the finish/RAL of the aluminum entrances and store fronts for us to match? c. Detail 9 on A-222 is showing vertical mullions on the glass partitions, but all other elevations showing GL-2 are butt-glazed. Can you please confirm if this area is to receive mullions, or if this should be butt glazed like the rest? d. Spec section 102219-4, 3.1 E. – please confirm there is no electrical device integration in the MetroWall scope. Any mag locks or electronic lock sets will be included, but all wiring and integration will be by others. e. Please confirm hardware finish is brushed stainless. If not, please advise. f. We are assuming MetroWall standard for hardware set K requiring a surface mounted closer for closing behind card access. Assuming all other doors without card readers just have butt hinges? g. 9/A-203 shows a transom above the door. The Vetro system standard details can't accommodate a transom, are we ok if we price full height doors there? 	<ul style="list-style-type: none"> a. See spec section 081416 b. To be selected from GF-1 manufacturer's selection of standard baked-on finishes. It will most likely be a metallic silver finish. c. The GF-2 tag on elevation 9/A-222 is not correct. It is GF-1 as labeled on the plan. The GF-2 uses butt glazing. d. Coordinate with GC, finish hardware spec 087100, hardware schedule, etc. e. See finish hardware spec 087100. f. Coordinate with finish hardware spec, hardware schedule, etc. g. That elevation is drawn incorrectly. The GF-2 office front should be the nominal 8'-2" overall height with a gyp header to the ceiling, as shown on the typical GF-2 detail 22/A-501.
	<u>MECHANICAL</u>	

9	Please provide details for #EBB electric baseboard schedule On Drawing M-011	Please see Mechanical sketch DSK-M-01, attached.
10	Hydronic Specialties In regards to the “Hydronic Specialties, Chemical Treatment & HVAC Water Treatment” <ul style="list-style-type: none"> - 3.6 F. is calling for a “chemical feeder where indicated”. - None are shown on the drawing. - Will this be required? 	Bypass chemical feeder not required per design drawings. Chemical treatment equipment is part of base building system. Coordinate with building as required.
11	Chemical Treatment. 3.8 A 4 “Modify this value if closed system contains glycol”. <ul style="list-style-type: none"> - Will this require glycol to be added to the system? - Is this a closed system? - If it is can we reuse the existing and add back to the system once all equipment piping is complete? 	Analysis to be performed by approved vendor as per specification section 232113 3.8. Yes it is a closed system. Per section 232113 3.8B, system is to be filled with fresh water after circulating emulsifying agents and detergents.
12	HVAC Water Treatment 1.5 SUBMITTALS A 1, 2, 3,4 &5 <ul style="list-style-type: none"> - Is all this equipment required for this project? - There is nothing listed on the equipment schedule or shown on the drawings. 	Listed equipment in this section is only intended to indicate the types of equipment that would require submitted product data if used. The intent of the section is that water treatment is to be performed on the system after modification. The intent is not to install new water treatment equipment to the base building system. The water treatment/testing equipment and methods are to be determined by the water testing/treatment provider and are to follow the requirements listed in specification section 232500.

	<ul style="list-style-type: none"> - There is also other equipment listed in this section that's not on the schedule or the drawings. 	The intent of the section is that water treatment is to be perform on the system after modification. The intent is not to install new water treatment equipment to the base building system. The water treatment/testing equipment and methods are to be determined by the water testing/treatment provider, and are to follow the requirements listed in specification section 232500.

CONTRACT DRAWINGS:

CONTRACT NUMBER 19-514

ADDENDUM #2; JUNE 28, 2021

The Design Drawings, as listed on the Contract Drawing Index, herewith made a part of these Specifications, shows in general and/or in detail the work to be done under this Contract and/or the various Contracts forming the entire work for the Project, as described herein.

After sending the executed contract to the County and prior to the first job meeting, the Contractor is responsible for obtaining from Public Works, Division of Engineering, Michaelian Office Building, White Plains, a maximum of five gratis copies of the Contract Drawings and Specifications; for the Contractor's permanent possession. Additional sets, requested by the Contractor, beyond the permitted number and time limit, will be furnished by Public Works; but at the Contractor's expense.

Note: New and revised drawings issued with the Addendum are shown in bold type. The DPW Drawing No. suffix has been changed from 0 to 1 on the Revised drawings.

<u>DRAWING NO.</u>	<u>TITLE</u>	<u>SHEET NO.</u>
52-01-T-445-0	TITLE SHEET	T-001
52-01-T-446-0	DRAWING LIST	T-002
52-01-A-447-0	CODE ANALYSIS	G-001
52-01-A-448-0	OCCUPANCY ANALYSIS	G-002
52-01-A-449-0	EGRESS AND FIRE RATING PLAN	G-003
52-01-A-450-0	PHASING PLAN - PHASES I	G-004
52-01-A-451-0	PHASING PLAN - PHASES II	G-005
52-01-A-452-0	PHASING PLAN - PHASES III	G-006
52-01-A-453-0	PHASING PLAN - PHASES IV	G-007
52-01-A-454-0	PHASING PLAN - PHASES V	G-008
52-01-A-455-0	PHASING PLAN - PHASES VI	G-009
52-01-A-456-0	PHASING PLAN - PHASES VII	G-010
52-01-A-457-0	PERSPECTIVE VIEWS	G-011
52-01-A-458-0	PERSPECTIVE VIEWS	G-012
52-01-A-459-0	PERSPECTIVE VIEWS	G-013
52-01-A-460-0	PERSPECTIVE VIEWS	G-014
52-01-A-461-0	PERSPECTIVE VIEWS	G-015
52-01-A-462-0	PERSPECTIVE VIEWS	G-016
52-01-A-463-0	DEMOLITION PLAN - 3RD FLOOR OVERALL	DM-001
52-01-A-464-1	PARTIAL DEMOLITION PLAN - 3RD FLOOR WEST WING	DM-002
52-01-A-465-1	PARTIAL DEMOLITION PLAN - 3RD FLOOR	DM-003

	CENTRAL WING	
52-01-A-466-1	PARTIAL DEMOLITION PLAN - 3RD FLOOR NORTH WING	DM-004
52-01-A-467-0	PARTIAL DEMOLITION PLAN - 3RD FLOOR BRIDGE TO DPW	DM-005
52-01-A-468-1	DEMOLITION REFLECTED CEILING PLAN - 3RD FLOOR OVERALL	DM-006
52-01-A-469-0	PARTIAL DEMOLITION REFLECTED CEILING PLAN - 3RD FLOOR CENTRAL WING	DM-007
52-01-A-470-0	PARTIAL DEMOLITION REFLECTED CEILING PLAN - 3RD FLOOR CENTRAL WING	DM-008
52-01-A-471-0	PARTIAL DEMOLITION REFLECTED CEILING PLAN - 3RD FLOOR NORTH WING	DM-009
52-01-A-472-0	CONSTRUCTION PLAN - 3RD FLOOR OVERALL	A-101
52-01-A-473-0	CONSTRUCTION PLAN - 3RD FLOOR WEST WING	A-102
52-01-A-474-0	CONSTRUCTION PLAN - 3RD FLOOR CENTRAL WING	A-103
52-01-A-475-0	CONSTRUCTION PLAN - 3RD FLOOR NORTH WING	A-104
52-01-A-476-0	CONSTRUCTION PLAN - ROOF OVERALL	A-105
52-01-A-477-0	REFLECTIVE CEILING PLAN - 3RD FLOOR OVERALL	A-111
52-01-A-478-0	REFLECTIVE CEILING PLAN - 3RD FLOOR WEST WING	A-112
52-01-A-479-0	REFLECTIVE CEILING PLAN - 3RD FLOOR CENTRAL WING	A-113
52-01-A-480-1	REFLECTIVE CEILING PLAN - 3RD FLOOR NORTH WING	A-114
52-01-A-481-0	POWER AND COMMUNICATION PLAN - 3RD FLOOR WEST WING	A-121
52-01-A-482-0	POWER AND COMMUNICATION PLAN - 3RD FLOOR CENTRAL WING	A-122
52-01-A-483-0	POWER AND COMMUNICATION PLAN - 3RD FLOOR NORTH WING	A-123
52-01-A-484-0	FINISH PLAN - 3RD FLOOR WEST WING	A-131
52-01-A-485-0	FINISH PLAN - 3RD FLOOR CENTRAL WING	A-132
52-01-A-486-0	FINISH PLAN - 3RD FLOOR NORTH WING	A-133
52-01-A-487-0	FINISH PLAN - 3RD FLOOR BRIDGE TO DPW	A-134
52-01-A-488-1	PLUMBING PLAN - PUBLIC RESTROOMS AND UNISEX BATH	A-141
52-01-A-489-1	PLUMBING PLAN - STAFF RESTROOMS / LUNCH BREAK / JANITOR	A-142
52-01-A-490-0	WET ROOMS ELEVATIONS	A-143
52-01-A-491-0	WET ROOMS ELEVATIONS	A-144
52-01-A-492-0	FURNITURE PLAN - 3RD FLOOR OVERALL	A-151
52-01-A-493-0	FURNITURE PLAN - 3RD FLOOR WEST WING	A-152
52-01-A-494-0	FURNITURE PLAN - 3RD FLOOR CENTRAL WING	A-153
52-01-A-495-0	FURNITURE PLAN - 3RD FLOOR NORTH WING	A-154
52-01-A-496-0	SIGNAGE PLAN - 3RD FLOOR WEST WING	A-161
52-01-A-497-0	SIGNAGE PLAN - 3RD FLOOR CENTRAL WING	A-162

Contract Drawings 2

52-01-A-498-0	SIGNAGE PLAN - 3RD FLOOR NORTH WING	A-163
52-01-A-499-0	INTERIOR ELEVATIONS - WEST WING	A-201
52-01-A-500-0	INTERIOR ELEVATIONS - WEST WING	A-202
52-01-A-501-0	INTERIOR ELEVATIONS - WEST WING	A-203
52-01-A-502-0	INTERIOR ELEVATIONS - WEST WING	A-204
52-01-A-503-0	INTERIOR ELEVATIONS - WEST WING	A-205
52-01-A-504-0	INTERIOR ELEVATIONS - WEST & CENTRAL WING	A-206
52-01-A-505-0	INTERIOR ELEVATIONS - CENTRAL WING	A-207
52-01-A-506-0	INTERIOR ELEVATIONS - CENTRAL WING	A-208
52-01-A-507-0	INTERIOR ELEVATIONS - CENTRAL WING	A-209
52-01-A-508-0	INTERIOR ELEVATIONS - CENTRAL WING	A-210
52-01-A-509-0	INTERIOR ELEVATIONS - CENTRAL WING	A-211
52-01-A-510-0	INTERIOR ELEVATIONS - CENTRAL WING	A-212
52-01-A-511-0	INTERIOR ELEVATIONS - CENTRAL & NORTH WING	A-213
52-01-A-512-0	INTERIOR ELEVATIONS - CENTRAL & NORTH WING	A-214
52-01-A-513-0	INTERIOR ELEVATIONS - CENTRAL & NORTH WING	A-215
52-01-A-514-0	INTERIOR ELEVATIONS - CENTRAL & NORTH WING	A-216
52-01-A-515-0	INTERIOR ELEVATIONS - CENTRAL & NORTH WING	A-217
52-01-A-516-0	INTERIOR ELEVATIONS - CENTRAL & NORTH WING	A-218
52-01-A-517-0	INTERIOR ELEVATIONS - CENTRAL & NORTH WING	A-219
52-01-A-518-0	INTERIOR ELEVATIONS - NORTH WING	A-220
52-01-A-519-0	INTERIOR ELEVATIONS - NORTH WING	A-221
52-01-A-520-0	INTERIOR ELEVATIONS - NORTH WING	A-222
52-01-A-521-0	INTERIOR ELEVATIONS - NORTH WING	A-223
52-01-A-522-0	SECTIONS - WEST WING	A-301
52-01-A-523-0	SECTIONS - WEST & CENTRAL WING	A-302
52-01-A-524-0	MILLWORK DETAILS	A-401
52-01-A-525-0	MILLWORK DETAILS	A-402
52-01-A-526-0	MILLWORK DETAILS	A-403
52-01-A-527-0	MILLWORK DETAILS	A-404
52-01-A-528-0	MILLWORK DETAILS	A-405
52-01-A-529-0	MILLWORK DETAILS	A-406
52-01-A-530-0	MILLWORK DETAILS	A-407
52-01-A-531-0	MILLWORK DETAILS	A-408
52-01-A-532-0	MILLWORK DETAILS	A-409
52-01-A-533-0	MILLWORK DETAILS	A-410
52-01-A-534-0	MILLWORK DETAILS	A-411
52-01-A-535-0	DETAILS	A-430
52-01-A-536-0	DETAILS	A-431
52-01-A-537-0	DETAILS	A-432
52-01-A-538-0	DETAILS	A-433
52-01-A-539-0	DETAILS	A-434
52-01-A-540-0	ROOF DETAILS	A-435
52-01-A-541-0	FIRESTOPPING DETAILS	A-436

Contract Drawings 3

52-01-A-542-0	WALL TYPES	A-501
52-01-A-543-0	LIGHT FIXTURES SCHEDULE	A-502
52-01-A-544-0	DOOR SCHEDULE	A-503
52-01-A-545-0	HEAD, JAMB, AND SILL DETAILS	A-504
52-01-A-546-0	FURNITURE & FINISHES SCHEDULES	A-505
52-01-A-547-0	SIGN SCHEDULE & DETAILS	A-506
52-01-A-548-0	SIGN DETAILS	A-507
52-01-A-549-0	SIGN DETAILS	A-508
	STRUCTURAL	
52-01-S-550-0	STRUCTURAL ROOF FRAMING & DETAILS	S-101
	MECHANICAL	
52-01-HV-551-0	SYMBOLS, ABBREVIATIONS, SCHEDULES, AND NOTES	M-010
52-01-HV-552-0	SCHEDULES	M-011
52-01-HV-553-0	DETAILS	M-020
52-01-HV-554-0	DETAILS	M-021
52-01-HV-555-0	AIR RISER DIAGRAM	M-030
52-01-HV-556-0	GROUND FLOOR KEY PLAN	M-098
52-01-HV-557-0	GROUND FLOOR MECHANICAL ROOM	M-099
52-01-HV-558-0	MECHANICAL PLAN – 3 RD FLOOR WEST WING	M-101
52-01-HV-559-0	MECHANICAL PLAN – 3 RD FLOOR CENTRAL WING	M-102
52-01-HV-560-0	MECHANICAL PLAN – 3 RD FLOOR NORTH WING	M-103
52-01-HV-561-0	MECHANICAL PLAN – ROOF	M-104
52-01-HV-562-0	MECHANICAL PIPING PLAN – 3 RD FLOOR WEST WING	M-201
52-01-HV-563-0	MECHANICAL PIPING PLAN – 3 RD FLOOR CENTRAL WING	M-202
52-01-HV-564-0	MECHANICAL PIPING PLAN – 3 RD FLOOR NORTH WING	M-203
52-01-HV-565-0	MECHANICAL DEMOLITION PLAN – 3 RD FLOOR WEST WING	M-901
52-01-HV-566-0	MECHANICAL DEMOLITION PLAN – 3 RD FLOOR CENTRAL WING	M-902
52-01-HV-567-0	MECHANICAL DEMOLITION PLAN – 3 RD FLOOR NORTH WING	M-903
	PLUMBING	
52-01-P-568-0	SYMBOLS, ABBREVIATIONS AND SCHEDULES	P-010
52-01-P-569-0	DETAILS	P-020
52-01-P-570-0	SANITARY RISER DIAGRAMS	P-030
52-01-P-571-0	DOMESTIC WATER RISER DIAGRAMS	P-031
52-01-P-572-0	PLUMBING PLAN – 2 ND FLOOR CENTRAL WING	P-098
52-01-P-573-0	PLUMBING PLAN – 2 ND FLOOR NORTH WING	P-099
52-01-P-574-0	PLUMBING PLAN – 3 RD FLOOR OVERALL	P-100

Contract Drawings 4


52-01-P-575-0	PLUMBING PLAN - 3RD FLOOR WEST WING	P-101
52-01-P-576-0	PLUMBING PLAN – 3 RD FLOOR CENTRAL WING	P-102
52-01-P-577-0	PLUMBING PLAN – 3 RD FLOOR NORTH WING	P-103
52-01-P-578-0	PLUMBING DEMOLITION PLAN – 3 RD FLOOR WEST WING	P-901
52-01-P-579-0	PLUMBING DEMOLITION PLAN – 3 RD FLOOR CENTRAL WING	P-902
52-01-P-580-0	PLUMBING DEMOLITION PLAN – 3 RD FLOOR NORTH WING	P-903
	FIRE PROTECTION	
52-01-SP-581-0	SYMBOLS, ABBREVIATIONS, SCHEDULES, AND DETAILS	FP-010
52-01-SP-582-0	COMBINATION SPRINKLER/STANDPIPE RISER DIAGRAM	FP-030
52-01-SP-583-0	2 ND SUB-GRADE, 1 ST , AND 2 ND FLOOR FIRE PROTECTION PART PLANS	FP-100
52-01-SP-584-0	STANDPIPE AND SPRINKLER PLAN – 3 RD FLOOR OVERALL	FP-101A
52-01-SP-585-0	STANDPIPE AND SPRINKLER PLAN – 3 RD FLOOR WEST WING	FP-101
52-01-SP-586-0	STANDPIPE AND SPRINKLER PLAN – 3 RD FLOOR CENTRAL WING	FP-102
52-01-SP-587-0	STANDPIPE AND SPRINKLER PLAN – 3 RD FLOOR NORTH WING	FP-103
	ELECTRICAL	
52-01-E-588-0	SYMBOLS, ABBREVIATIONS, SCHEDULES, AND NOTES	E-010
52-01-E-589-0	DETAILS AND NOTES	E-020
52-01-E-590-0	ELECTRICAL RISER DIAGRAM AND PART PLANS	E-030
52-01-E-591-1	LOAD CALCULATION	E-040
52-01-E-592-0	ELECTRICAL PLAN – 3 RD FLOOR WEST WING	E-101
52-01-E-593-0	ELECTRICAL PLAN – 3 RD FLOOR CENTRAL WING	E-102
52-01-E-594-0	ELECTRICAL PLAN – 3 RD FLOOR NORTH WING	E-103
52-01-E-594A-0	ELECTRICAL – IT ROOMS PART PLANS	E-104
52-01-E-594B-0	EMERGENCY POWER RISER DIAGRAMS AND SCHEDULES	E-105
52-01-E-595-0	LIGHTING CONTROL ONE LINE DIAGRAM	E-199
52-01-E-596-0	LIGHTING PLAN – 3 RD FLOOR WEST WING	E-201
52-01-E-597-0	LIGHTING PLAN – 3 RD FLOOR CENTRAL WING	E-202
52-01-E-598-1	LIGHTING PLAN – 3RD FLOOR NORTH WING	E-203
52-01-E-599-0	ELECTRICAL PLAN – 3 RD FLOOR WEST WING - MECHANICAL	E-301
52-01-E-600-0	ELECTRICAL PLAN – 3 RD FLOOR CENTRAL WING - MECHANICAL	E-302

Contract Drawings 5

52-01-E-601-0	ELECTRICAL PLAN – 3 RD FLOOR NORTH WING - MECHANICAL	E-303
52-01-E-602-0	ELECTRICAL PLAN – ROOF	E-304
	FIRE ALARM	
52-01-FP-603-0	FIRE ALARM SYMBOLS, ABBREVIATIONS, SCHEDULES, AND NOTES	FA-010
52-01-FP-604-0	FIRE ALARM MATRIX	FA-020
52-01-FP-605-0	FIRE ALARM RISER DIAGRAM	FA-030
52-01-FP-606-0	2 ND FLOOR FIRE ALARM PLAN	FA-098
52-01-FP-607-0	FIRE ALARM PLAN – 3 RD FLOOR CENTRAL WING	FA-099
52-01-FP-608-0	FIRE ALARM PLAN – 3 RD FLOOR WEST WING	FA-101
52-01-FP-609-0	FIRE ALARM PLAN – 3 RD FLOOR CENTRAL WING	FA-102
52-01-FP-610-0	FIRE ALARM PLAN – 3 RD FLOOR NORTH WING	FA-103
52-01-FP-611-0	FIRE ALARM DEMOLITION PLAN – 3 RD FLOOR WEST WING	FA-901
52-01-FP-612-0	FIRE ALARM DEMOLITION PLAN – 3 RD FLOOR CENTRAL WING	FA-902
52-01-FP-613-0	FIRE ALARM DEMOLITION PLAN – 3 RD FLOOR NORTH WING	FA-903
	AUDIO VISUAL	
52-01-AV-614-0	AV EQUIPMENT AND ELECTRICAL REQUIREMENTS	AV-1
52-01-AV-615-0	AV ELEVATIONS AND SECTIONS	AV-2
52-01-AV-616-0	AV ONE-LINE DIAGRAM AND EQUIPMENT LIST	AV-3
	LOW VOLTAGE	
52-01-T-617-0	TELECOMMUNICATIONS ABBREVIATIONS, LEGEND AND NOTES	T-001
52-01-T-618-0	TELECOMMUNICATIONS GENERAL NOTES	T-002
52-01-T-619-0	TELECOMMUNICATIONS PLAN – 3RD FLOOR WEST WING	T-101
52-01-T-620-0	TELECOMMUNICATIONS PLAN – 3RD FLOOR CENTRAL WING	T-102
52-01-T-621-0	TELECOMMUNICATIONS PLAN – 3RD FLOOR NORTH WING	T-103
52-01-T-622-0	TELECOMMUNICATIONS PART PLANS	T-104
52-01-T-623-0	TELECOMMUNICATIONS RISER DIAGRAM	T-300
52-01-T-624-0	TELECOMMUNICATIONS RISER DIAGRAM	T-301
52-01-T-625-0	TELECOMMUNICATIONS INSTALLATION DETAILS	T-400
52-01-T-626-0	TELECOMMUNICATIONS INSTALLATION DETAILS	T-401
	<i>Note: Telecommunications drawings are issued under Addendum 2 only to add the DPW Drawing Numbers. They remain Revision 0.</i>	

Photos of Windows at “Bridge” Location where Material and Refuse Access is Provided.



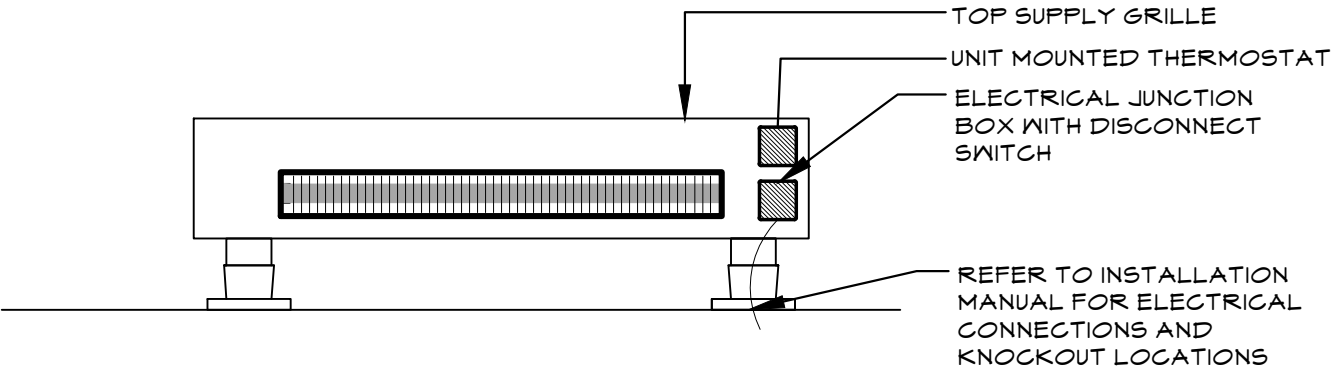



1
DSK-M-01

ELECTRIC BASEBOARD DETAIL


NTS

PROJECT	PROJECT No.	DATE
110 MARTIN LUTHER KING	19020	06/22/2021
TITLE	SCALE	DRAWING No.
ELECTRIC BASEBOARD DETAIL	NTS	DSK-M-01

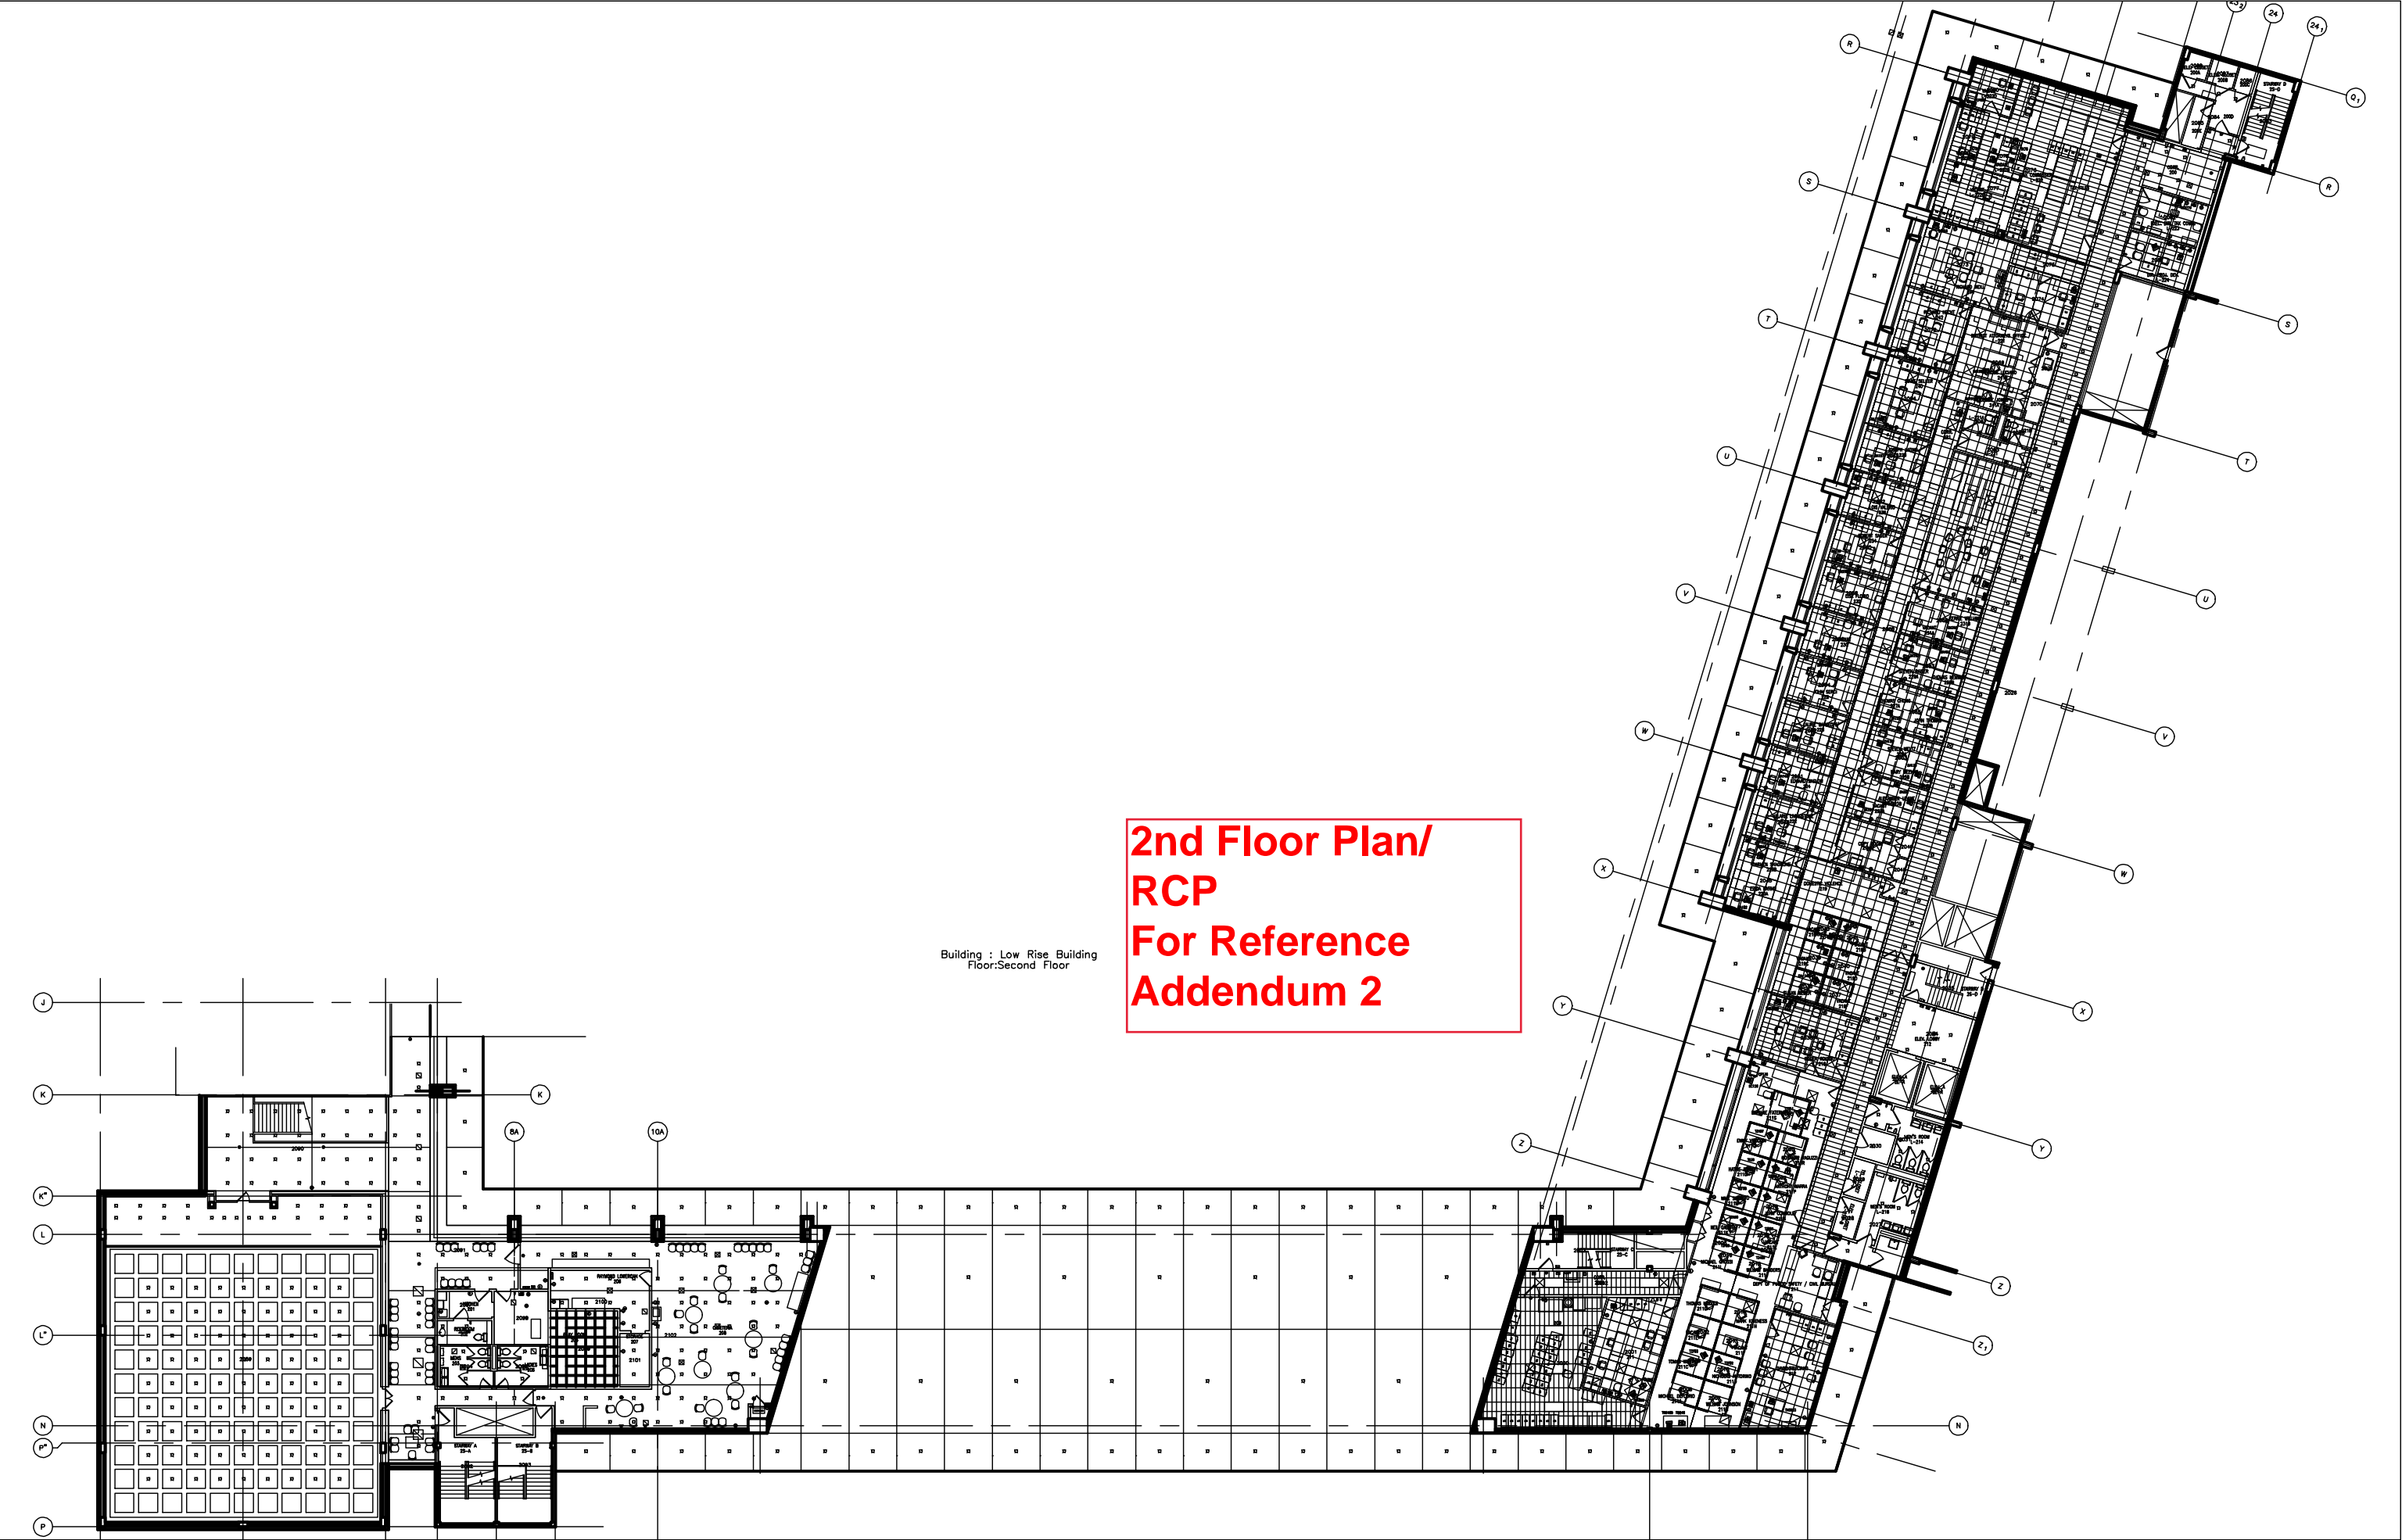

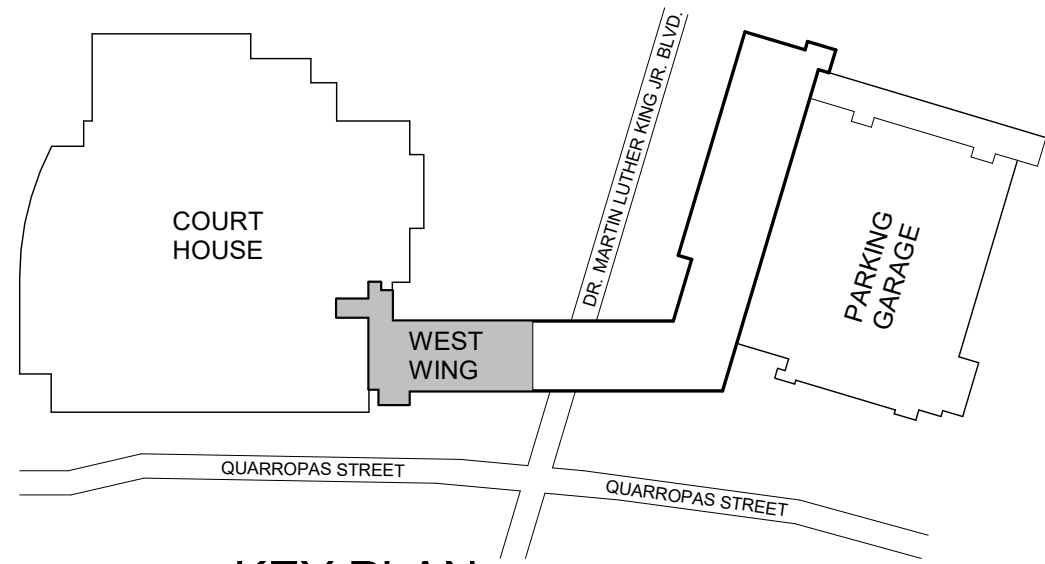

K KEY PLAN
N.T.S.

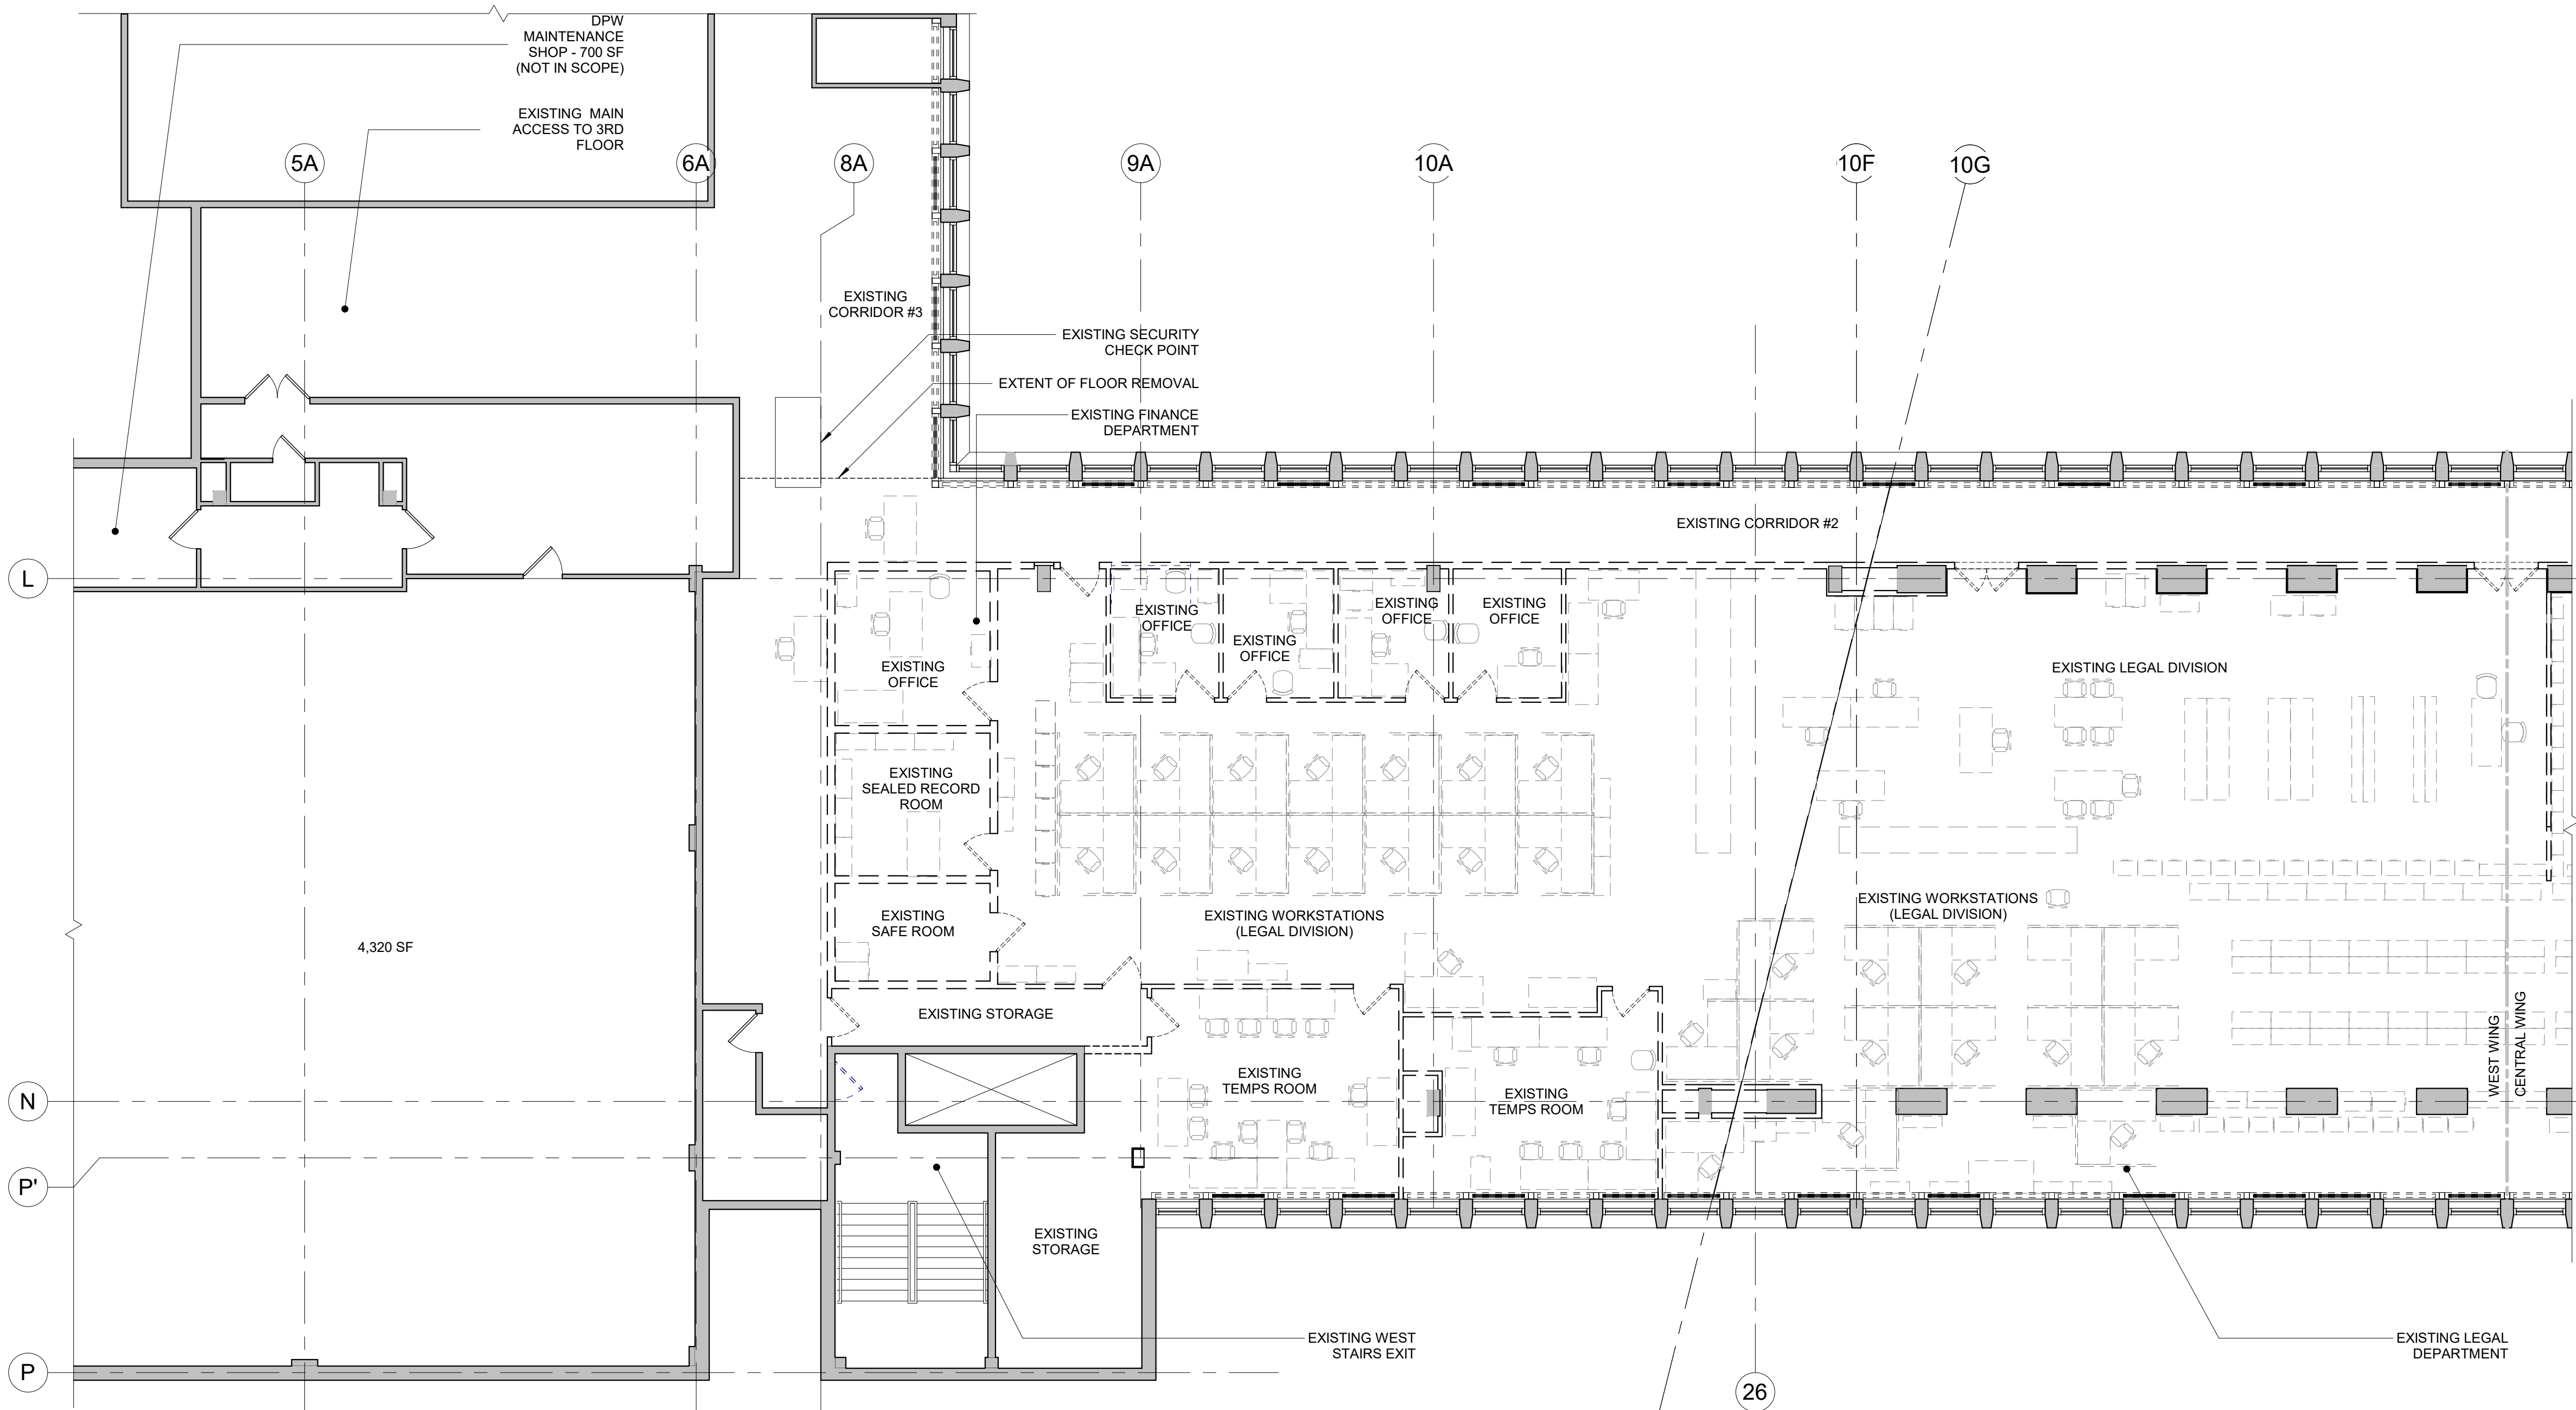

1 DEMO PLAN - 3RD FLOOR WEST WING
1/8" = 1'-0"

DEMOLITION PLAN LEGEND	
SYMBOL	DESCRIPTION
	EXIST. WALL/ PARTITION TO REMAIN
	EXISTING COLUMN TO REMAIN
	EXISTING WALL / PARTITION TO BE REMOVED
	EXISTING DOOR TO REMAIN
	EXISTING DOOR FRAME TO BE REMOVED
	EXISTING SINK, FAUCET, COUNTER, AND CABINETS TO BE REMOVED
	EXISTING FAN COIL UNITS COVERS AT EXTERIOR WALLS TO REMAIN. PREPARE AND PAINT AFTER COMPLETION OF NEW FAN COIL INSTALLATION

- DEMOLITION NOTES:**
1. REMOVE ALL FLOOR FINISHES AND ALL EXISTING WALL BASES IN AREA OF WORK, DOWN TO THE CONCRETE FLOOR.
 2. ALL EXISTING EQUIPMENT, CASEWORK, COUNTERTOPS, ETC. TO BE REMOVED EXCEPT WHERE NOTED FOR RELOCATION.
 3. ALL ACOUSTIC TILE CEILING, LIGHT FIXTURES, SPEAKERS, ELECTRICAL DEVICES, PLUMBING, FIXTURES, ETC. TO BE REMOVED. ALSO REMOVE ALL RELATED ACCESSORIES AND SUPPORTING CONSTRUCTION.
 4. COORDINATE DISPOSAL OF FURNITURE AND EQUIPMENT WITH WCDPW FOR POSSIBLE SALVAGING OF USEFUL ITEMS.
 5. CONTRACTOR TO TURN OVER ALL EXISTING DOOR HARDWARE TO WCDPW.
 6. ALL ACCESSORY CONSTRUCTION, BLOCKING, CLIPS, TRIM-WORK, AND ALL MISCELLANEOUS ITEMS SHALL BE REMOVED.
 7. ALL EXISTING CONDUITS, WIREMOLD AND ELECTRICAL OUTLETS TO BE REMOVED OR AS NOTED.
 8. REMOVE ALL SURFACE MOUNTED OUTLETS, DEVICE, ETC.
 9. ALL EXISTING WALLS, PARTITIONS, FLOORS, AND CEILINGS TO REMAIN THAT ARE DAMAGED DUE TO DEMOLITION WORK ARE TO BE PATCHED AS REQUIRED. SEE GENERAL NOTE NO. 1 ON CONSTRUCTION PLANS.
 10. CONTRACTOR MUST COORDINATE ALL DEMOLITION WORK WITH ASBESTOS ABATEMENT REQUIREMENTS.
 11. SEE ENGINEERING DRAWINGS FOR ADDITIONAL DEMOLITION INFORMATION.
 12. ALL ITEMS INDICATED TO BE REMOVED ARE TO GIVE THE CONTRACTOR A SENSE OF THE QUANTITIES. REMOVE ALL ITEMS REGARDLESS OF THE EXACT QUANTITIES.
 13. FLOOR REMOVAL TO BE COORDINATED WITH ASBESTOS ABATEMENT PROCEDURES.
 14. ALL FURNITURE AND MILLWORK IS TO BE REMOVED. THE DRAWINGS ARE INTENDED TO SHOW THE GENERAL SCOPE OF THE FURNITURE, BUT DO NOT NECESSARILY SHOW ALL FURNITURE ITEMS THAT ARE TO BE REMOVED.

		CONSULTANT INFORMATION	
		Graf & Lewent Architects LLP	
		90-30 161st Street, Jamaica, NY 11432 P: 718-651-6200 F: 718-251-6989	
	06/28/21		ADDENDUM # 2
	06/21/21		ADDENDUM # 1
REVISION NUMBER	DATE	MADE BY	APP'D BY
RECORD DRAWING CERTIFICATION			
<input type="checkbox"/> AS BUILT - CHANGES AS NOTED			
<input type="checkbox"/> AS BUILT - NO CHANGES			
CONTRACTOR		CONTRACTOR	
NAME: _____		NAME: _____	
SIGNATURE: _____		SIGNATURE: _____	
TITLE: _____		TITLE: _____	
DATE: _____		DATE: _____	
WESTCHESTER COUNTY, NEW YORK		CONTRACT NUMBER	SHEET NUMBER
DEPARTMENT OF PUBLIC WORKS AND TRANSPORTATION		19-514	DM-002
DIVISION OF ENGINEERING		SHEET NO.	OF
LOW RISE BUILDING RENOVATIONS AND HVAC IMPROVEMENTS		SCALE: 1/8" = 1'-0"	
110 DR. MARTIN LUTHER KING, JR. BOULEVARD		DATE: May 20, 2021	Issue Date
WHITE PLAINS, NEW YORK		DPW FILE NO.	REV NO.
PARTIAL DEMOLITION PLAN - WEST WING		52-01-T-464	1


6/24/2021 11:30:01 AM




DEMOLITION NOTES:

1. REMOVE ALL FLOOR FINISHES AND ALL EXISTING WALL BASES IN AREA OF WORK, DOWN TO THE CONCRETE FLOOR.
2. ALL EXISTING EQUIPMENT, CASEWORK, COUNTERTOPS, ETC. TO BE REMOVED EXCEPT WHERE NOTED FOR RELOCATION.
3. ALL ACOUSTIC TILE CEILING, LIGHT FIXTURES, SPEAKERS, ELECTRICAL DEVICES, PLUMBING, FIXTURES , ETC. TO BE REMOVED. ALSO REMOVE ALL RELATED ACCESSORIES AND SUPPORTING CONSTRUCTION.
4. COORDINATE DISPOSAL OF FURNITURE AND EQUIPMENT WITH WCDPW FOR POSSIBLE SALVAGING OF USEFUL ITEMS.
5. CONTRACTOR TO TURN OVER ALL EXISTING DOOR HARDWARE TO WCDPW.
6. ALL ACCESSORY CONSTRUCTION, BLOCKING, CLIPS, TRIM-WORK, AND ALL MISCELLANEOUS ITEMS SHALL BE REMOVED.
7. ALL EXISTING CONDUITS, WIREMOLD AND ELECTRICAL OUTLETS TO BE REMOVED OR AS NOTED.
8. REMOVE ALL SURFACE MOUNTED OUTLETS, DEVICE, ETC.
9. ALL EXISTING WALLS, PARTITIONS, FLOORS, AND CEILINGS TO REMAIN THAT ARE DAMAGED DUE TO DEMOLITION WORK ARE TO BE PATCHED AS REQUIRED. SEE GENERAL NOTE NO. 1 ON CONSTRUCTION PLANS.
10. CONTRACTOR MUST COORDINATE ALL DEMOLITION WORK WITH ASBESTOS ABATEMENT REQUIREMENTS.
11. SEE ENGINEERING DRAWINGS FOR ADDITIONAL DEMOLITION INFORMATION.
12. ALL ITEMS INDICATED TO BE REMOVED ARE TO GIVE THE CONTRACTOR A SENSE OF THE QUANTITIES. REMOVE ALL ITEMS REGARDLESS OF THE EXACT QUANTITIES.
13. FLOOR REMOVAL TO BE COORDINATED WITH ASBESTOS ABATEMENT PROCEDURES.
14. ALL FURNITURE AND MILLWORK IS TO BE REMOVED. THE DRAWINGS ARE INTENDED TO SHOW THE GENERAL SCOPE OF THE FURNITURE, BUT DO NOT NECESSARILY SHOW ALL FURNITURE ITEMS THAT ARE TO BE REMOVED.


6/24/2021 11:30:54 AM

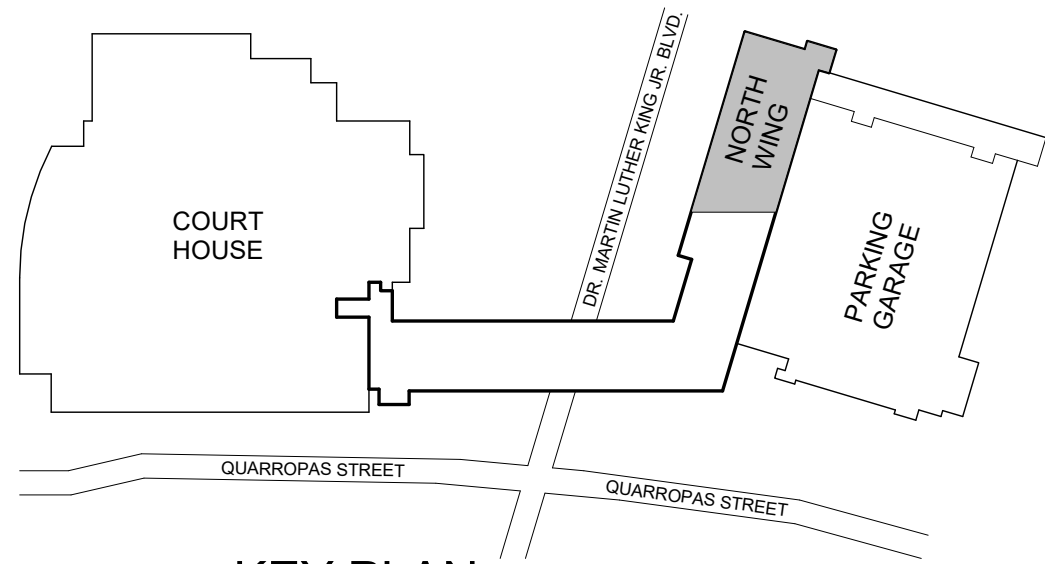

K KEY PLAN
N.T.S.

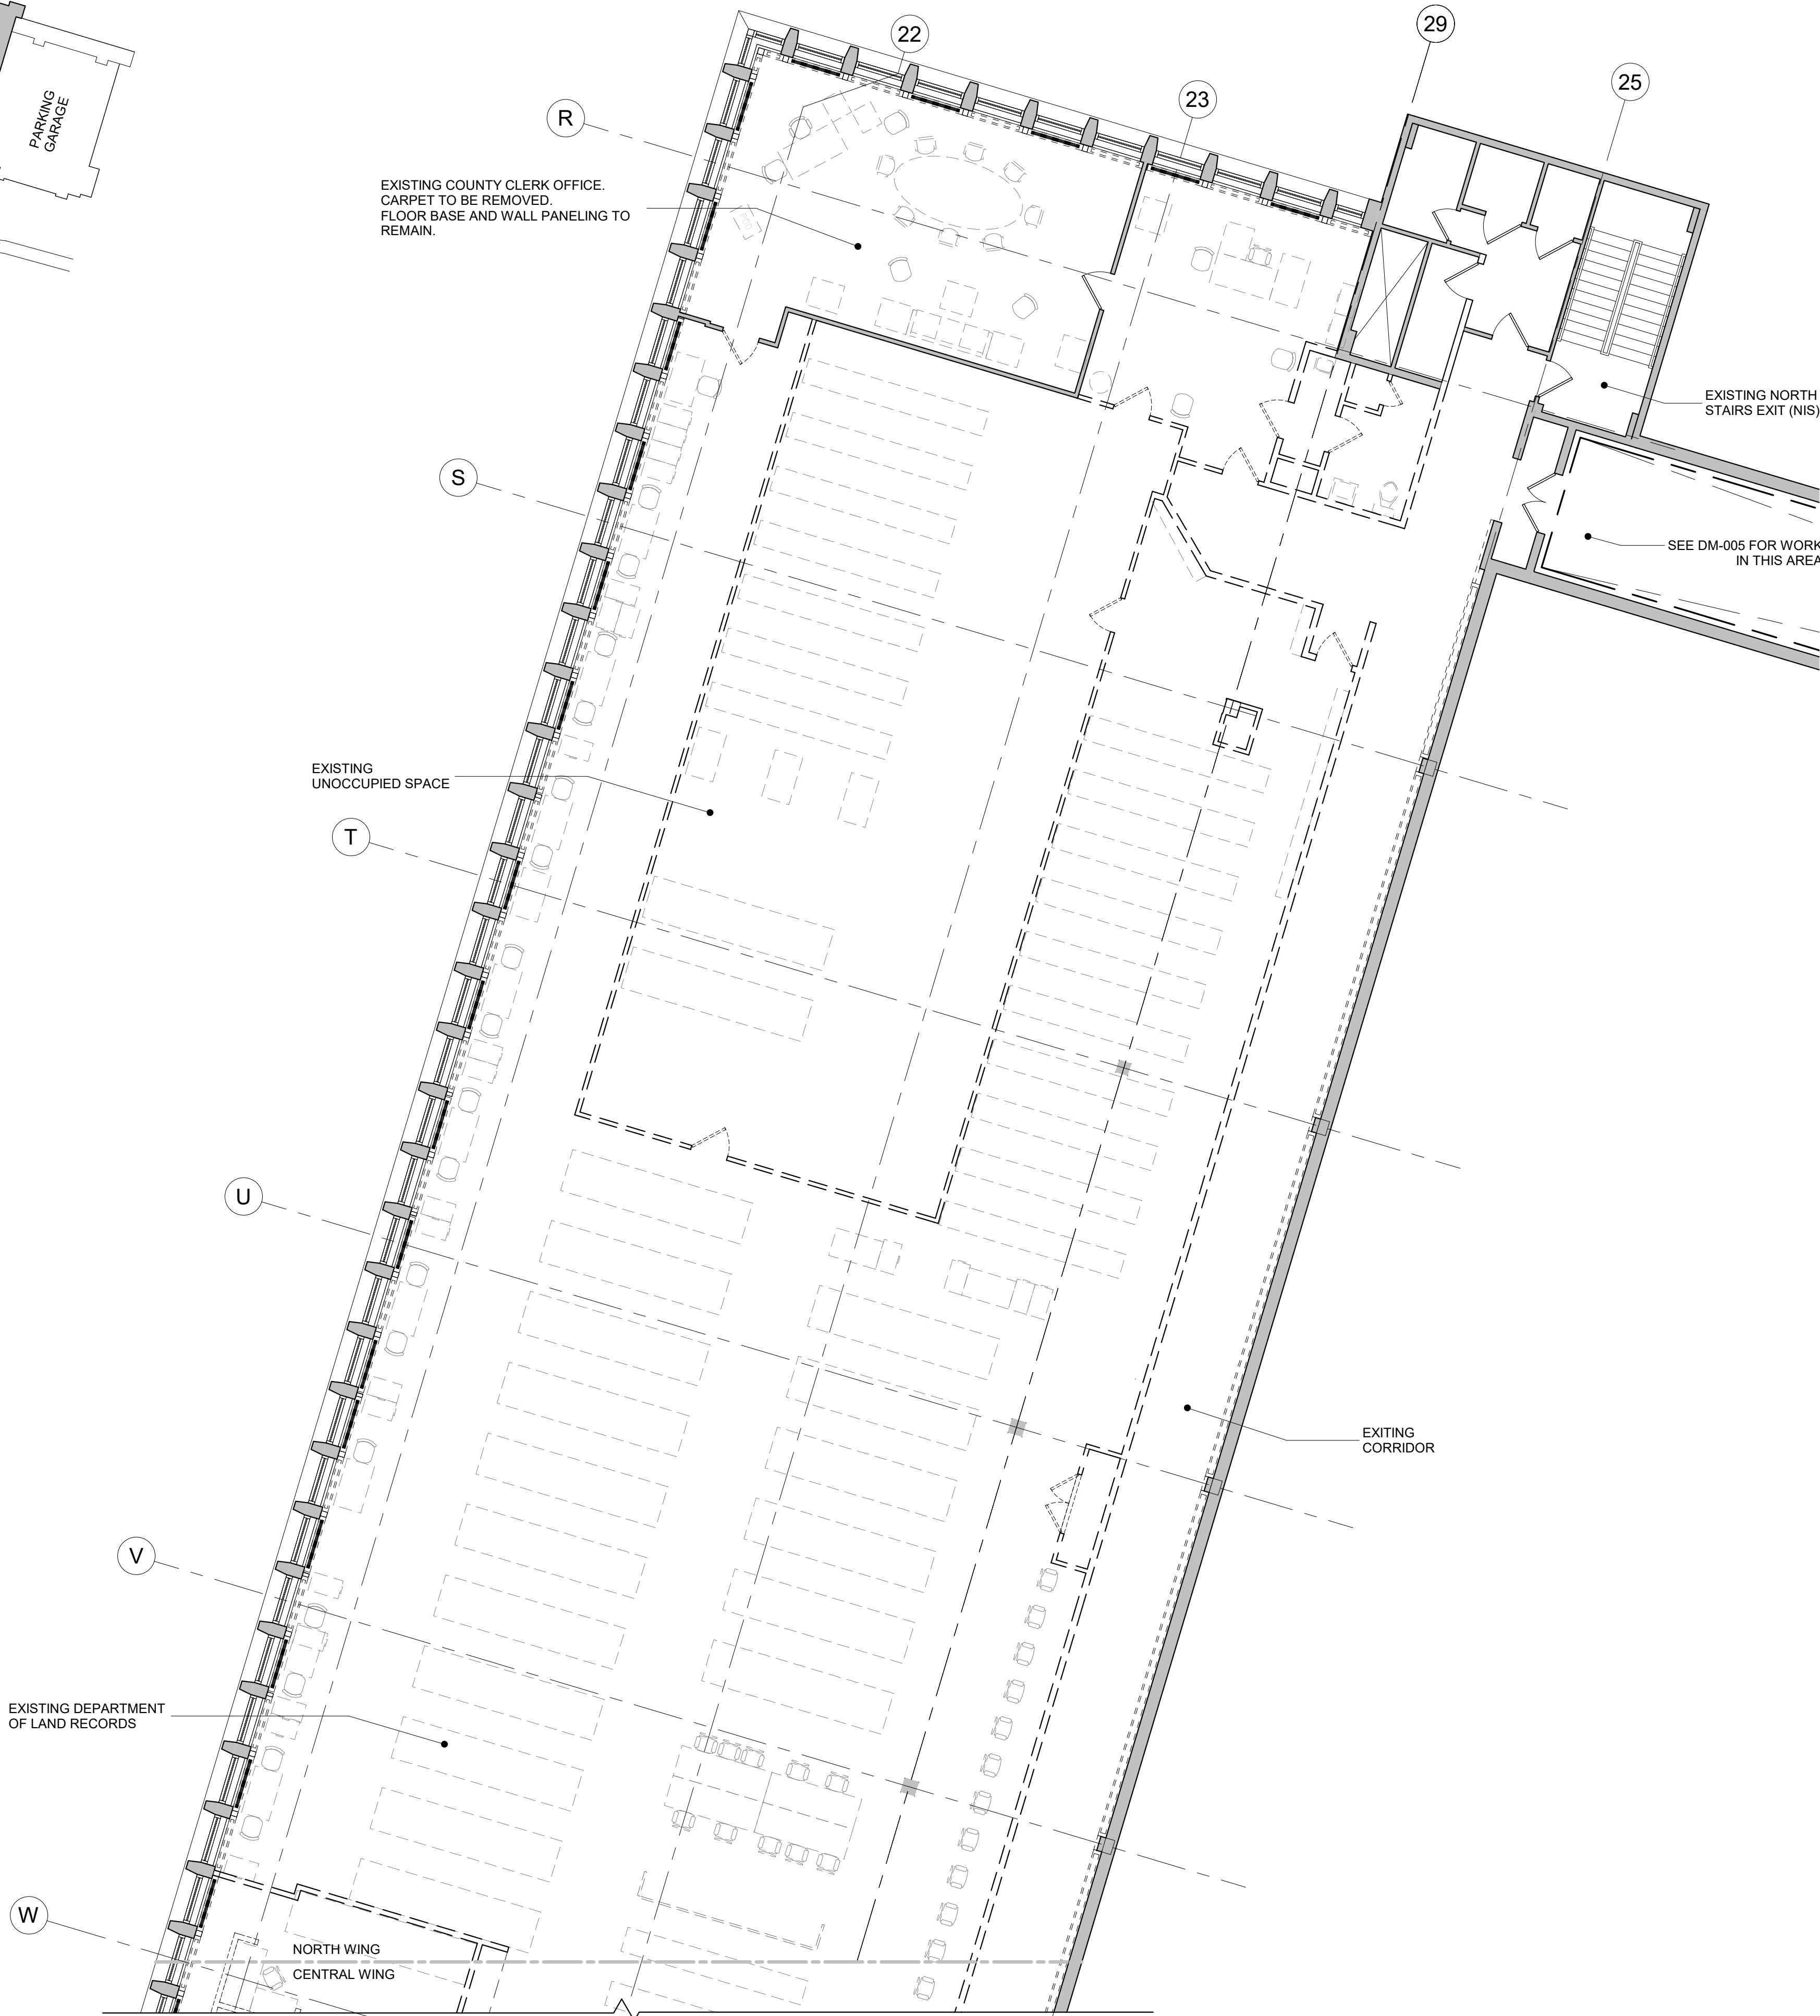

1 DEMO PLAN - 3RD FLOOR NORTH WING
1/8" = 1'-0"

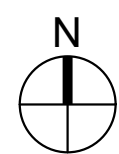


DEMOLITION PLAN LEGEND	
SYMBOL	DESCRIPTION
	EXIST. WALL / PARTITION TO REMAIN
	EXISTING COLUMN TO REMAIN
	EXISTING WALL / PARTITION TO BE REMOVED
	EXISTING DOOR TO REMAIN
	EXISTING DOOR FRAME TO BE REMOVED
	EXISTING SINK, FAUCET, COUNTER, AND CABINETS TO BE REMOVED
	EXISTING FAN COIL UNITS COVERS AT EXTERIOR WALLS TO REMAIN. PREPARE AND PAINT AFTER COMPLETION OF NEW FAN COIL INSTALLATION

- DEMOLITION NOTES:**
1. REMOVE ALL FLOOR FINISHES AND ALL EXISTING WALL BASES IN AREA OF WORK, DOWN TO THE CONCRETE FLOOR.
 2. ALL EXISTING EQUIPMENT, CASEWORK, COUNTERTOPS, ETC. TO BE REMOVED EXCEPT WHERE NOTED FOR RELOCATION.
 3. ALL ACOUSTIC TILE CEILING, LIGHT FIXTURES, SPEAKERS, ELECTRICAL DEVICES, PLUMBING, FIXTURES, ETC. TO BE REMOVED. ALSO REMOVE ALL RELATED ACCESSORIES AND SUPPORTING CONSTRUCTION.
 4. COORDINATE DISPOSAL OF FURNITURE AND EQUIPMENT WITH WCDPW FOR POSSIBLE SALVAGING OF USEFUL ITEMS.
 5. CONTRACTOR TO TURN OVER ALL EXISTING DOOR HARDWARE TO WCDPW.
 6. ALL ACCESSORY CONSTRUCTION, BLOCKING, CLIPS, TRIM-WORK, AND ALL MISCELLANEOUS ITEMS SHALL BE REMOVED.
 7. ALL EXISTING CONDUITS, WIREMOLD AND ELECTRICAL OUTLETS TO BE REMOVED OR AS NOTED.
 8. REMOVE ALL SURFACE MOUNTED OUTLETS, DEVICE, ETC.
 9. ALL EXISTING WALLS, PARTITIONS, FLOORS, AND CEILINGS TO REMAIN THAT ARE DAMAGED DUE TO DEMOLITION WORK ARE TO BE PATCHED AS REQUIRED. SEE GENERAL NOTE NO. 1 ON CONSTRUCTION PLANS.
 10. CONTRACTOR MUST COORDINATE ALL DEMOLITION WORK WITH ASBESTOS ABATEMENT REQUIREMENTS.
 11. SEE ENGINEERING DRAWINGS FOR ADDITIONAL DEMOLITION INFORMATION.
 12. ALL ITEMS INDICATED TO BE REMOVED ARE TO GIVE THE CONTRACTOR A SENSE OF THE QUANTITIES. REMOVE ALL ITEMS REGARDLESS OF THE EXACT QUANTITIES.
 13. FLOOR REMOVAL TO BE COORDINATED WITH ASBESTOS ABATEMENT PROCEDURES.
 14. ALL FURNITURE AND MILLWORK IS TO BE REMOVED. THE DRAWINGS ARE INTENDED TO SHOW THE GENERAL SCOPE OF THE FURNITURE, BUT DO NOT NECESSARILY SHOW ALL FURNITURE ITEMS THAT ARE TO BE REMOVED.

		CONSULTANT INFORMATION	
		Graf & Lewent Architects LLP	
90-30 161st Street, Jamaica, NY 11432 P: 718-651-6200 F: 718-251-6989			
	06/28/21		ADDENDUM # 2
	06/21/21		ADDENDUM # 1
REVISION NUMBER	DATE	MADE BY	APP'D BY
			REVISION
RECORD DRAWING CERTIFICATION			
<input type="checkbox"/> AS BUILT - CHANGES AS NOTED			
<input type="checkbox"/> AS BUILT - NO CHANGES			
CONTRACTOR		CONTRACTOR	
NAME: _____		NAME: _____	
SIGNATURE: _____		SIGNATURE: _____	
TITLE: _____		TITLE: _____	
DATE: _____		DATE: _____	
WESTCHESTER COUNTY, NEW YORK		CONTRACT NUMBER	SHEET NUMBER
DEPARTMENT OF PUBLIC WORKS AND TRANSPORTATION		19-514	DM-004
DIVISION OF ENGINEERING		SHEET NO.	OF
LOW RISE BUILDING RENOVATIONS AND HVAC IMPROVEMENTS		SCALE:	1/8" = 1'-0"
110 DR. MARTIN LUTHER KING, JR. BOULEVARD		DATE: May 20, 2021	Issue Date
WHITE PLAINS, NEW YORK		DPW FILE NO.	REV NO.
PARTIAL DEMOLITION PLAN - NORTH WING		52-01-T-466	1

6/24/2021 11:32:09 AM

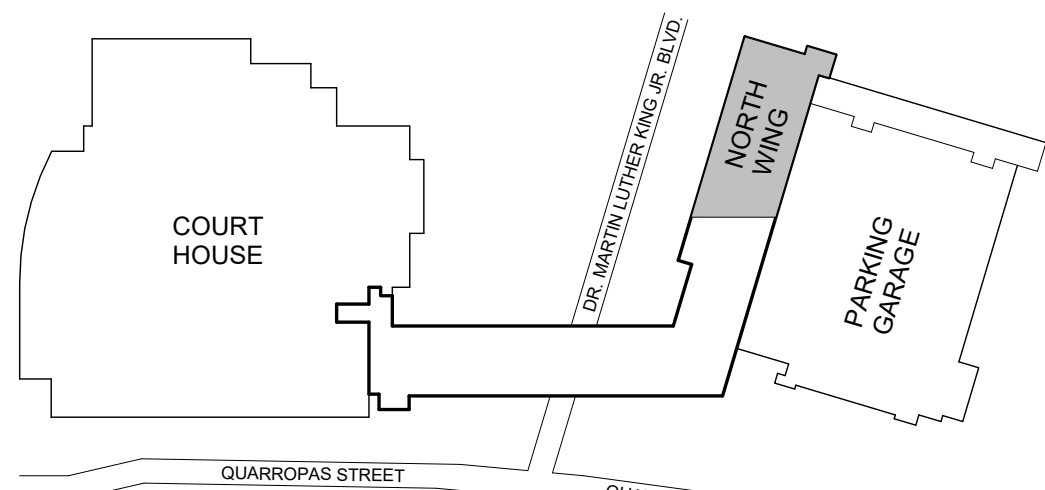

KEY PLAN

N.T.S.

ABBREVIATIONS LIST OF DEPARTMENTS AND GENERAL AREAS :

DEPARTMENT OF PUBLIC SAFETY (DPS)
DEPARTMENT OF TRANSPORTATION (DOT)
DEPARTMENT OF LEGAL SERVICES (DLS)
DEPARTMENT OF LICENSING AND NATURALIZATION (DLN)
DEPARTMENT OF LAND RECORDS (DLR)
PROCESSING UNIT (PU)
DEPARTMENT OF FINANCES (DOF)
WESTCHESTER COUNTY CLERK OFFICES (WCC)
I.T. ROOMS (IT)
LOUNGE AND ELEVATOR LOBBY (LOU)
LUNCH/BREAK, RESTROOMS, AND JANITOR (WET)
HALLWAYS AND CORRIDORS (HLL)


(DPS)
(DOT)
(DLS)
(DLN)
(DLR)
(PU)
(DOF)
(WCC)
(IT)
(LOU)
(WET)
(HLL)



1 REFLECTED CEILING PLAN - 3RD FLOOR NORTH WING
1/8" = 1'-0"

GENERAL NOTES:

1. ALL DEVICES SUCH AS SMOKE DETECTORS, OCCUPANCY SENSORS, CEILING MOUNTED CAMERA, MIC, SPEAKER, ETC. ARE TO BE LOCATED IN THE CENTER OF THE CEILING TILES
2. ALL SUSPENDED CEILINGS TO BE AT 8'-11" UNLESS OTHERWISE NOTED
3. ALL GYPSUM BOARD CEILING TO BE PAINTED P-1
4. THE CONTRACTOR IS TO PROVIDE AN 8' WIDE MOCK UP OF THE FULL CONSTRUCTION OF THE PLEXIGLASS SHIELD AT THE SITE BEFORE FINAL PRODUCTION. ADJUSTMENTS MAY BE MADE TO THE DESIGN BASED ON THE MOCK UP.

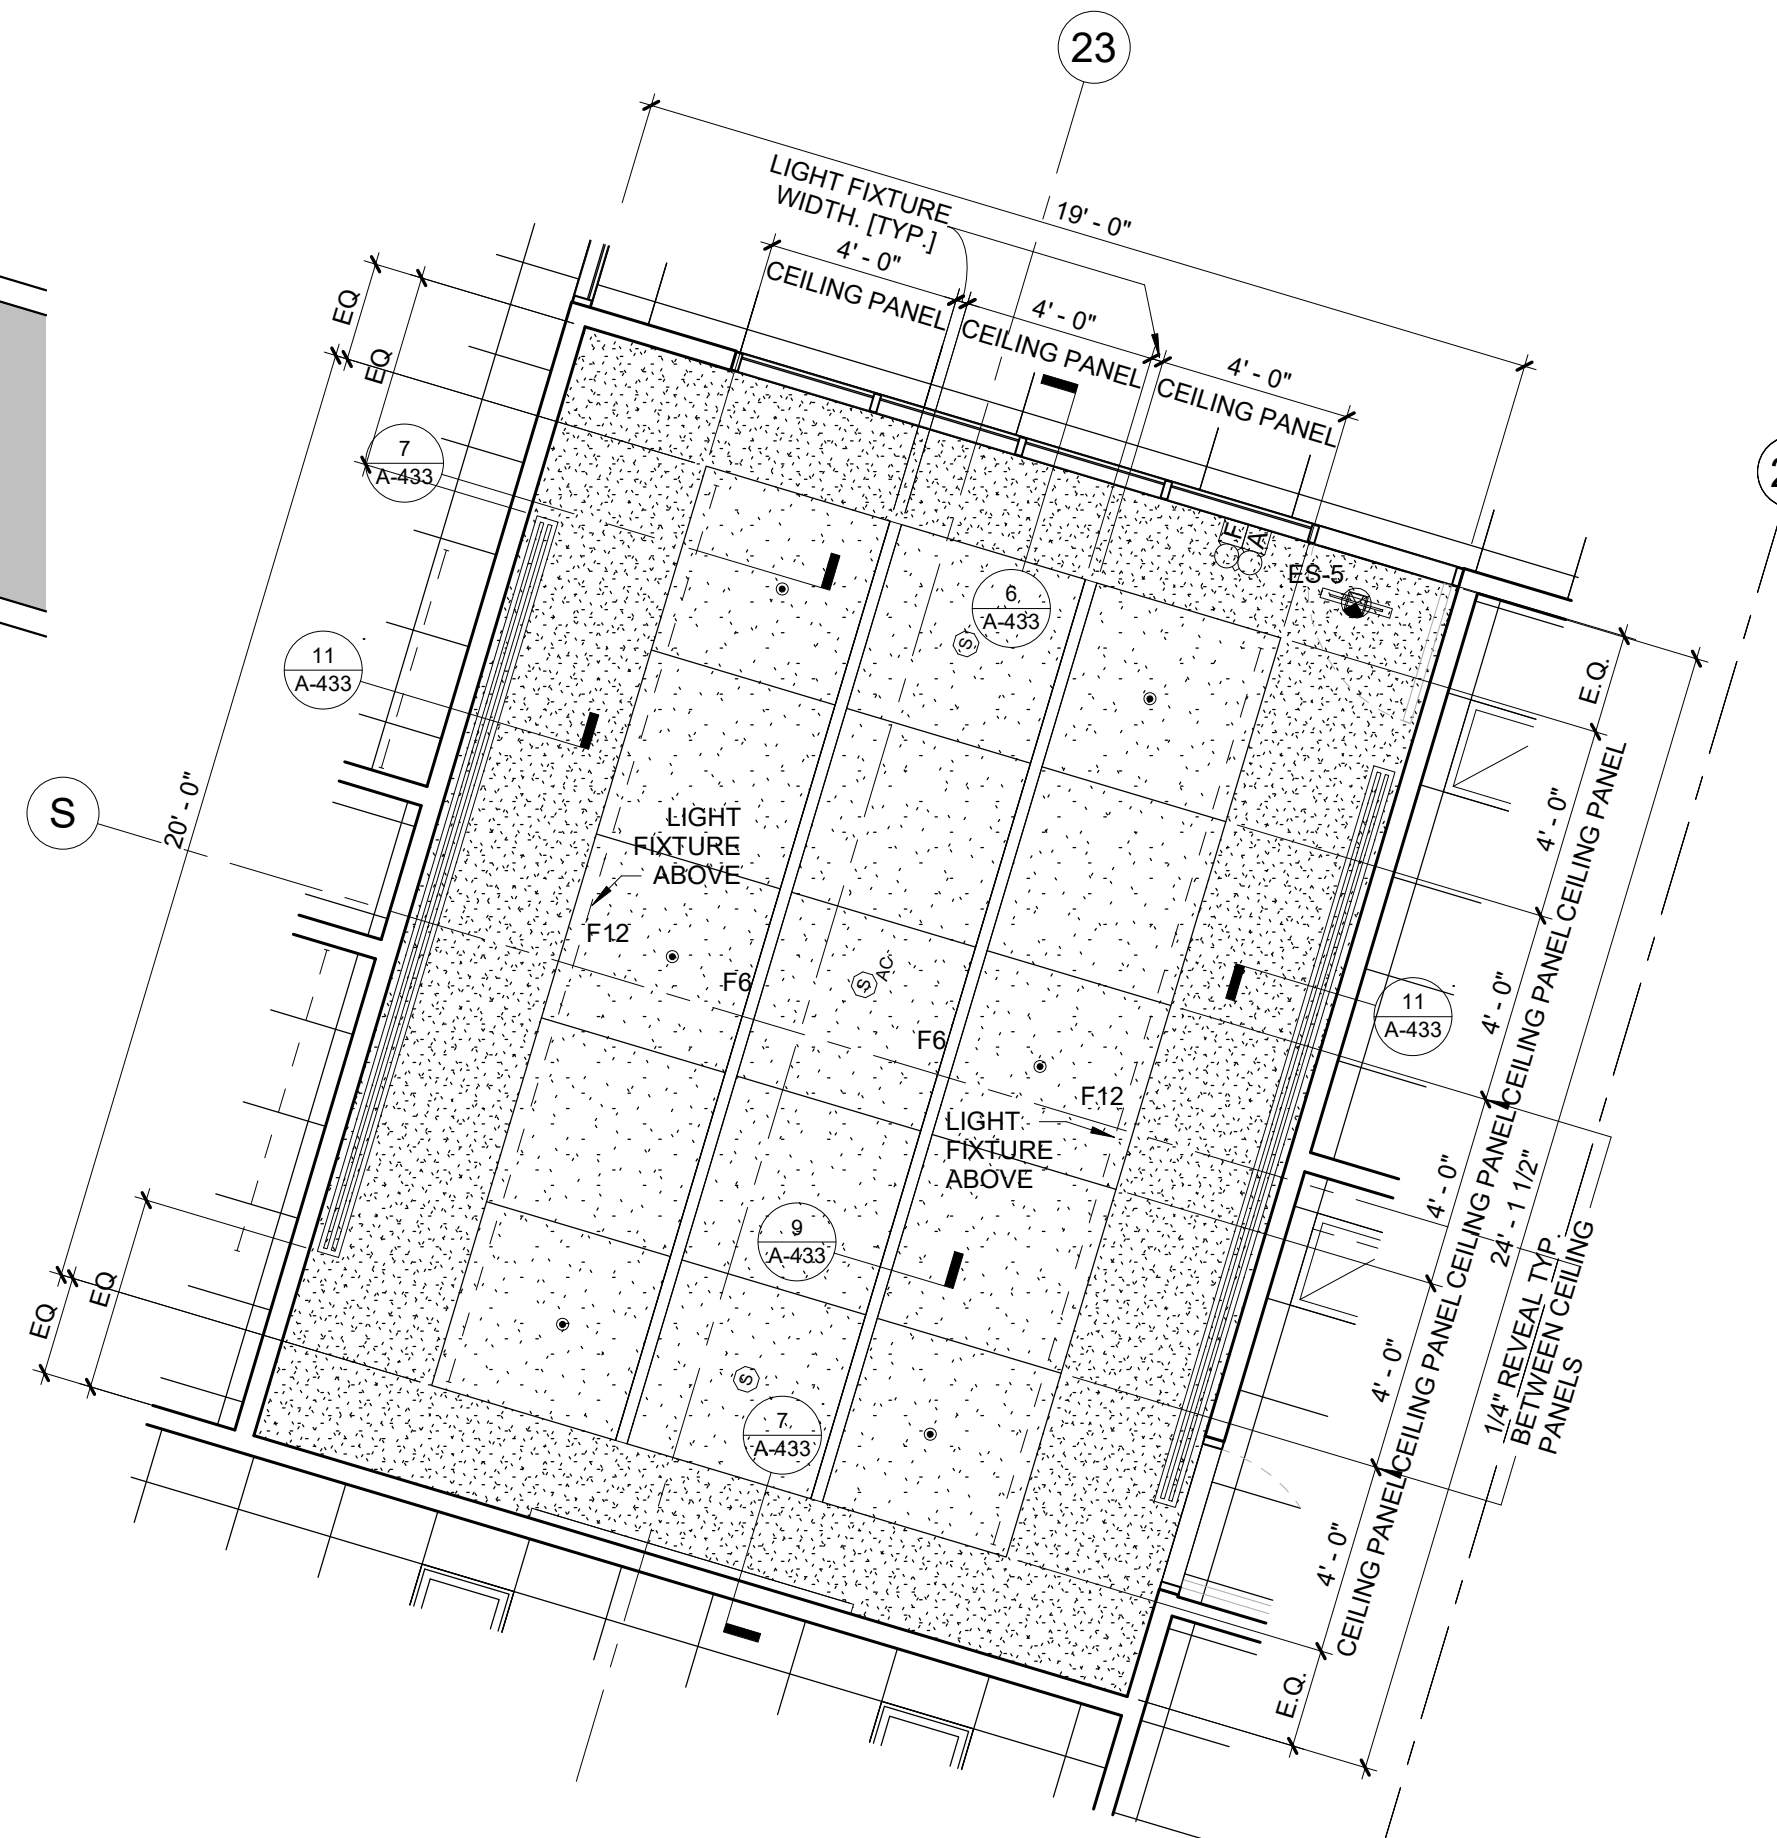

2 REFLECTED CEILING PLAN - WCC MAIN CONFERENCE ROOM
1/4" = 1'-0"

REFLECTIVE CEILING PLAN LEGEND

SYMBOL	DESCRIPTION
	2'x2' ACOUSTICAL CEILING SYSTEM CEILING TYPE 1
	4'x4' AND 1'x4' PATTERN ACOUSTICAL CEILING SYSTEM CEILING TYPE 2
	2'x4' AND 2'x2' PATTERN ACOUSTICAL CEILING SYSTEM CEILING TYPE 3
	TECH STYLE CEILING SYSTEM CEILING TYPE 4
	GYPSUM BOARD CEILING AND SOFFITS CEILING TYPE 5
	EXISTING 2'x2' ACOUSTICAL CEILING SYSTEM ABUTTING AREA OF WORK
	OTHER EXISTING CEILINGS NOT IN SCOPE
	CEILING DIFFUSER
	CEILING RETURN
	LINEAR CEILING DIFFUSER
	SMOKE DETECTOR
	SMOKE DETECTOR ABOVE CEILING
	OCCUPANCY SENSOR
	VACANCY SENSOR
	ALERT STROBE LIGHT ONLY
	ALERT STROBE LIGHT & SPEAKER
	FIRE ALARM SPEAKER / STROBE
	FIRE ALARM PULL STATION
	EXIT SIGN - WALL MOUNTED, ARROW INDICATES DIRECTION OF TRAVEL
	EXIT SIGN - CEILING MOUNTED, ARROW INDICATES DIRECTION OF TRAVEL
	EXISTING SKYLIGHT ADAPT CEILING TRIM TO EXISTING SKYLIGHT FRAMING
	WIRED DAYLIGHT SAVING
	WIRED QUANTUM SENSOR MODULE
	WIRED 360 DEGREE CEILING MOUNTED OCCUPANCY/VACANCY SENSOR
	SPRINKLER HEAD
	SPEAKER - CEILING MOUNTED
	SHADE - SEE DETAIL X/A-XXX
	EJ - C (CEILING EXPANSION JOINT)
	PLEXIGLASS SHIELD



CONSULTANT INFORMATION

Graf & Lewent
Architects LLP

90-30 161st Street, Jamaica, NY 11432
P: 718-651-6200 F: 718-251-6989

	06/28/21			ADDENDUM # 2
	06/21/21			ADDENDUM # 1
REVISION NUMBER	DATE	MADE BY	APP'D BY	REVISION

RECORD DRAWING CERTIFICATION

- ☐ AS BUILT - CHANGES AS NOTED
☐ AS BUILT - NO CHANGES

CONTRACTOR	CONTRACTOR
NAME: _____	NAME: _____
SIGNATURE: _____	SIGNATURE: _____
TITLE: _____	TITLE: _____
DATE: _____	DATE: _____

WESTCHESTER COUNTY, NEW YORK DEPARTMENT OF PUBLIC WORKS AND TRANSPORTATION	CONTRACT NUMBER 19-514	SHEET NUMBER A-114
DIVISION OF ENGINEERING LOW RISE BUILDING RENOVATIONS AND HVAC IMPROVEMENTS 110 DR. MARTIN LUTHER KING, JR. BOULEVARD WHITE PLAINS, NEW YORK	SCALE: As indicated DATE: May 20, 2021 DPW FILE NO.	Issue Date REV NO. 1
REFLECTED CEILING PLAN - 3RD FLOOR NORTH WING	52-01-A-480	

6/24/2021 11:33:36 AM



CONSULTANT SEAL


CONSULTANT INFORMATION

Graf & Lewent

Architects LLP

90-30 161st Street, Jamaica, NY 11432
P : 718-651-6200 F : 718-251-6989



06/28/21

ADDENDUM # 2

06/21/21

ADDENDUM # 1

REVISION NUMBER	DATE	MADE BY	APP'D BY		REVISION
-----------------	------	---------	----------	--	----------

RECORD DRAWING CERTIFICATION

☐ AS BUILT - CHANGES AS NOTED
☐ AS BUILT - NO CHANGES

CONTRACTOR	CONTRACTOR
NAME: _____	NAME: _____
SIGNATURE: _____	SIGNATURE: _____
TITLE: _____ DATE: _____	TITLE: _____ DATE: _____


WESTCHESTER COUNTY, NEW YORK
DEPARTMENT OF PUBLIC WORKS AND TRANSPORTATION

DIVISION OF ENGINEERING

 LOW RISE BUILDING RENOVATIONS AND HVAC IMPROVEMENTS
 110 DR. MARTIN LUTHER KING, JR. BOULEVARD
 WHITE PLAINS, NEW YORK

CONTRACT NUMBER 19-514	SHEET NUMBER A-141
SHEET NO. OF	
SCALE: As indicated	
DATE: May 20, 2021 Issue Date	
DPW FILE NO. 52-01-A-488	
	REV. NO.


PLUMBING PLAN - PUBLIC RESTROOMS AND UNISEX BATH

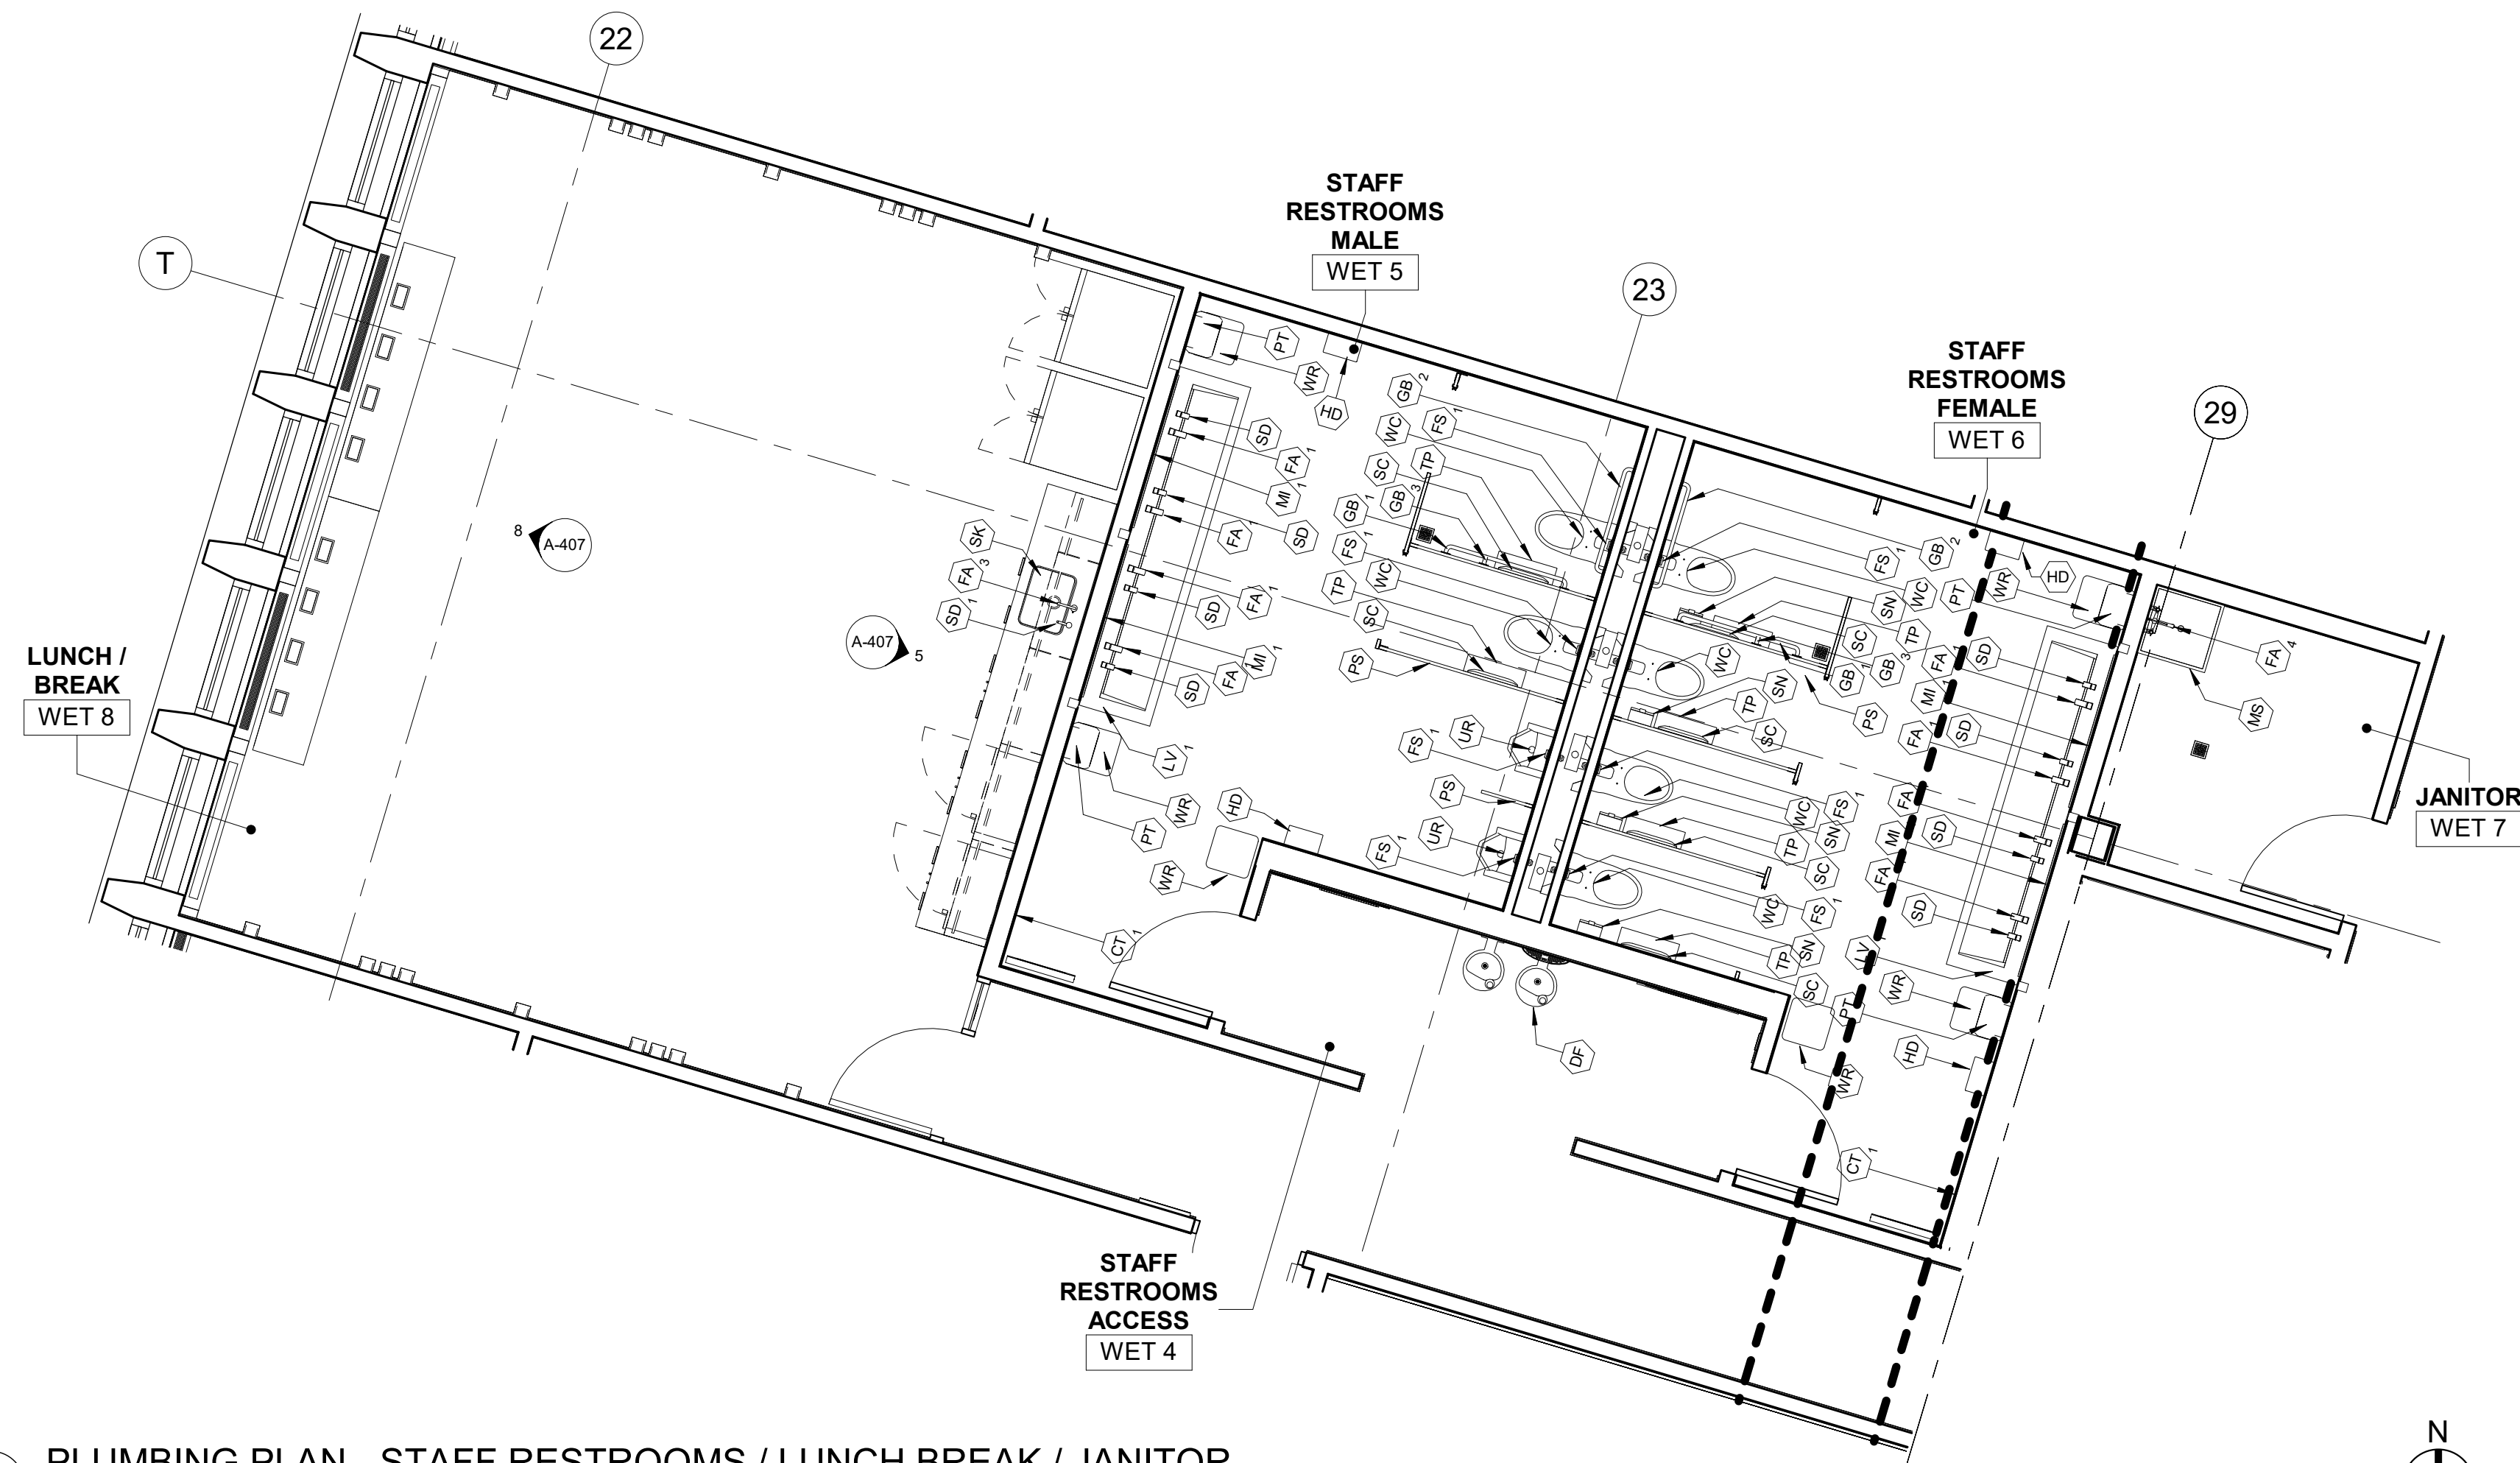


NOTE: DIMENSIONED TO FACE OF WALL WITHOUT TILE FINISH

PLAN DETAIL - STAFF RESTROOMS / LUNCH BREAK / JANITOR


CONSULTANT SEAL 	CONSULTANT INFORMATION <h2 style="text-align: center; margin: 0;">Graf & Lewent</h2> <h3 style="text-align: center; margin: 0;">Architects LLP</h3> <p style="text-align: center; font-weight: bold;">90-30 161st Street, Jamaica, NY 11432 P: 718-651-6200 F: 718-251-6989</p>			
	06/28/21			ADDENDUM # 2
	06/21/21			ADDENDUM # 1
REVISION NUMBER	DATE	MADE BY	APP'D BY	REVISION
RECORD DRAWING CERTIFICATION				
<input type="checkbox"/> AS BUILT - CHANGES AS NOTED <input type="checkbox"/> AS BUILT - NO CHANGES				
CONTRACTOR			CONTRACTOR	
NAME: _____			NAME: _____	
SIGNATURE: _____			SIGNATURE: _____	
TITLE: _____ DATE: _____			TITLE: _____ DATE: _____	
WESTCHESTER COUNTY, NEW YORK				SHEET NUMBER A-142
DEPARTMENT OF PUBLIC WORKS AND TRANSPORTATION				
DIVISION OF ENGINEERING				SHEET NO. OF
LOW RISE BUILDING RENOVATIONS AND HVAC IMPROVEMENTS 110 DR. MARTIN LUTHER KING, JR. BOULEVARD WHITE PLAINS, NEW YORK				SCALE: 1/4" = 1'-0" DATE: May 20, 2021 DPW FILE NO.
PLUMBING PLAN - STAFF RESTROOMS / LUNCH BREAK / JANITOR				Issue Date REV NO. 1
				52-01-A-489

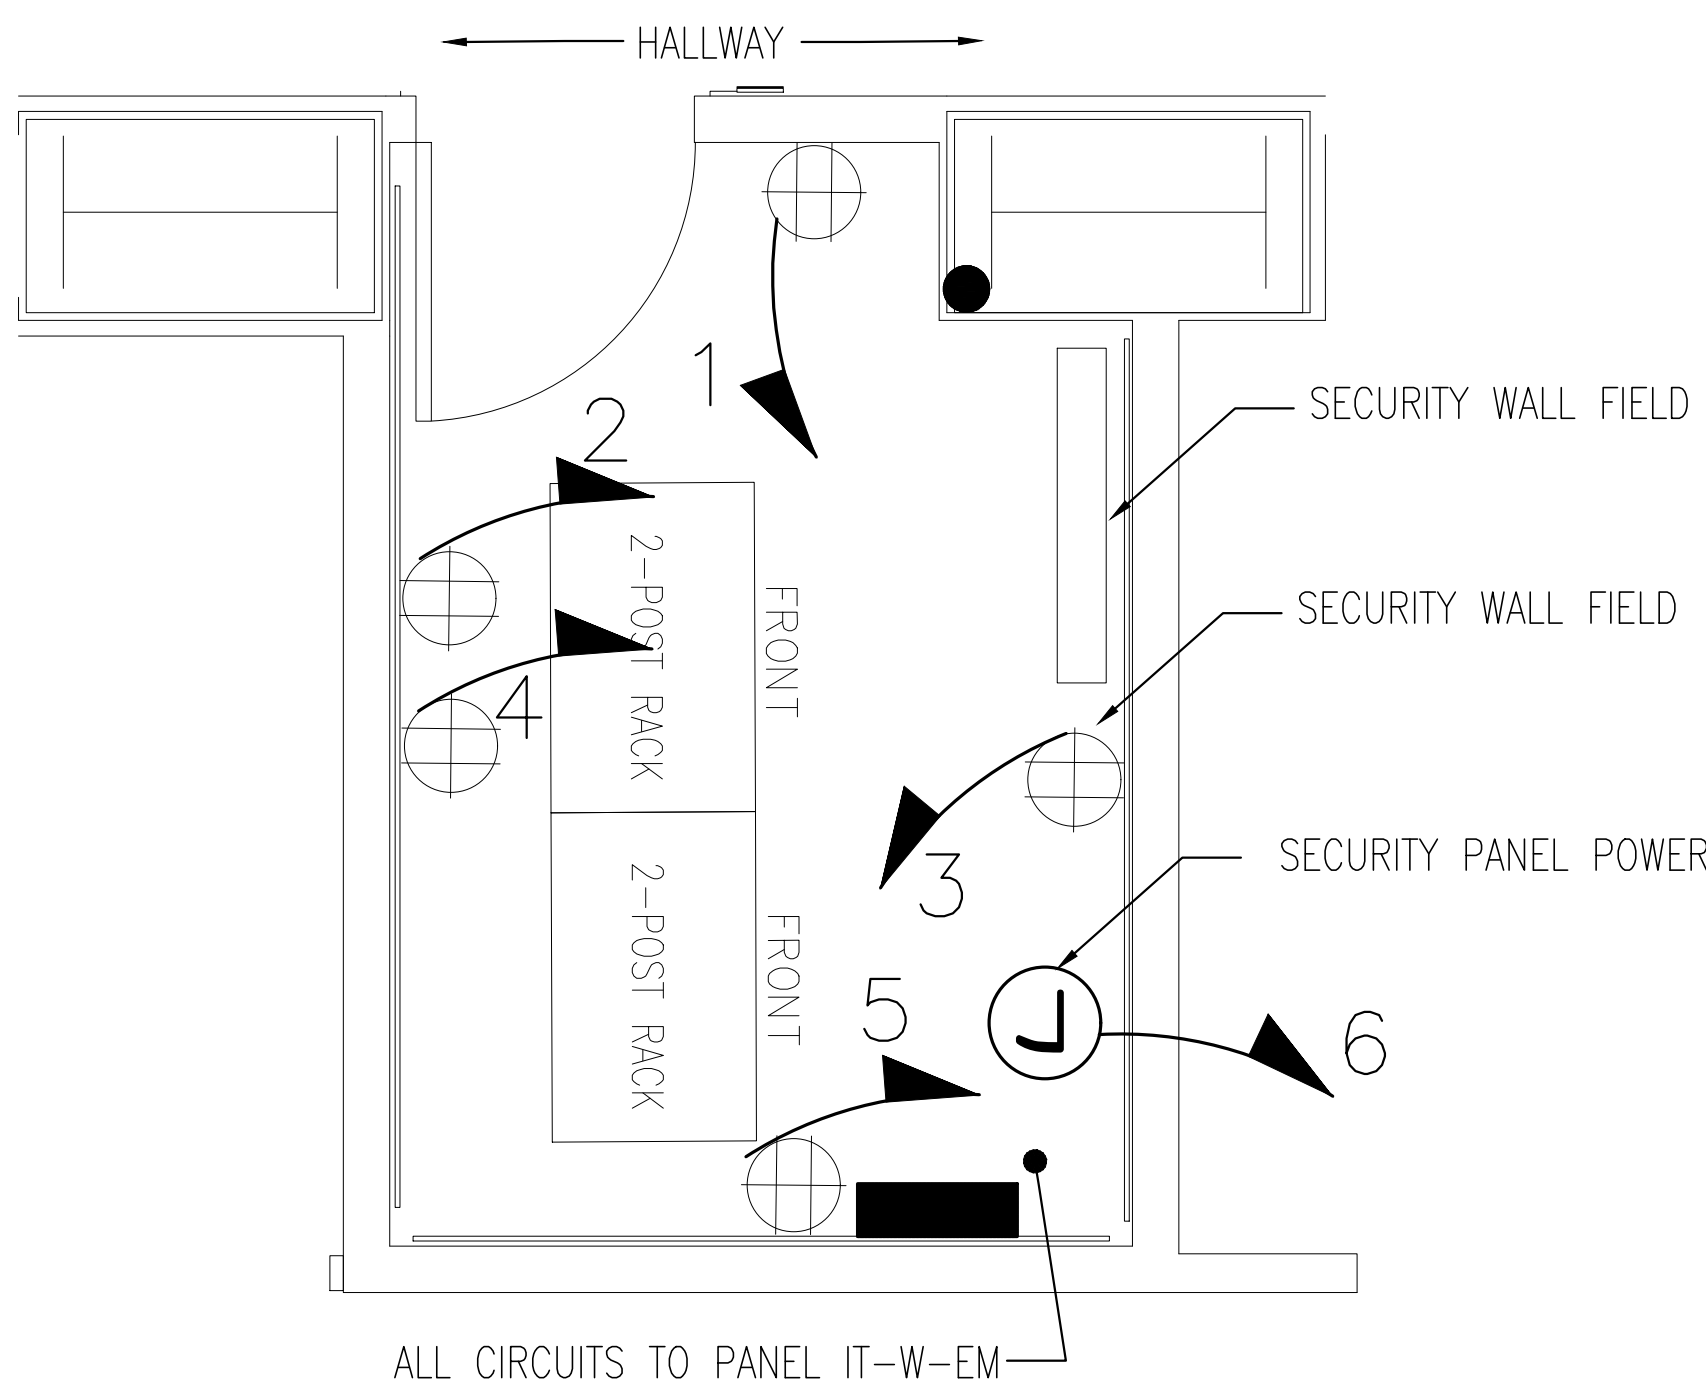


1 IT ROOM PART PLAN - WEST WING
E.104 1/2"=1'-0"

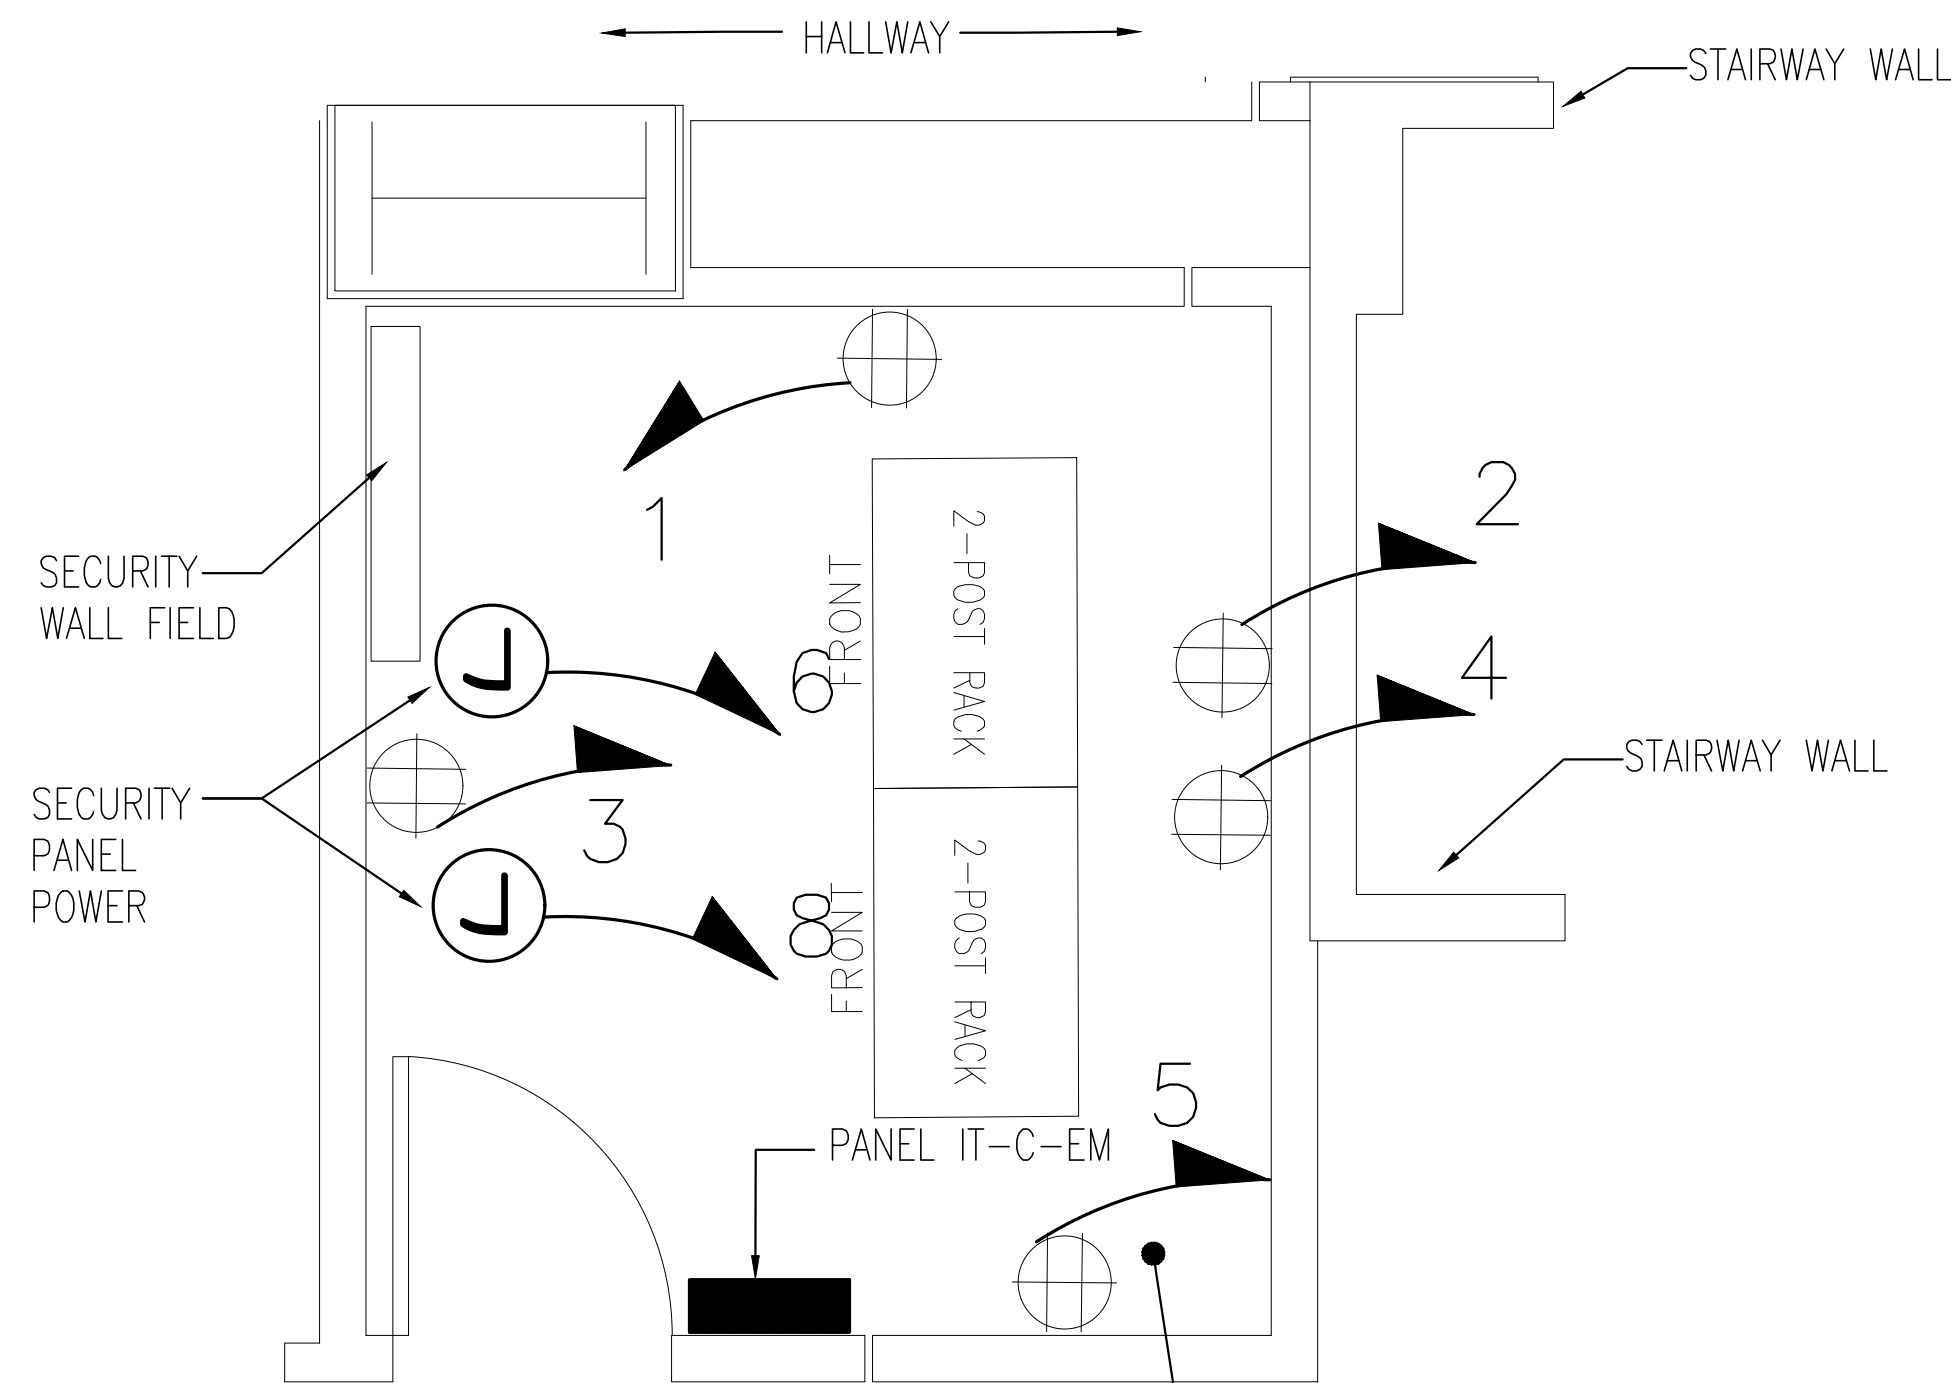


2 IT ROOM PART PLAN - CENTRAL WING
E.104 1/2"=1'-0"

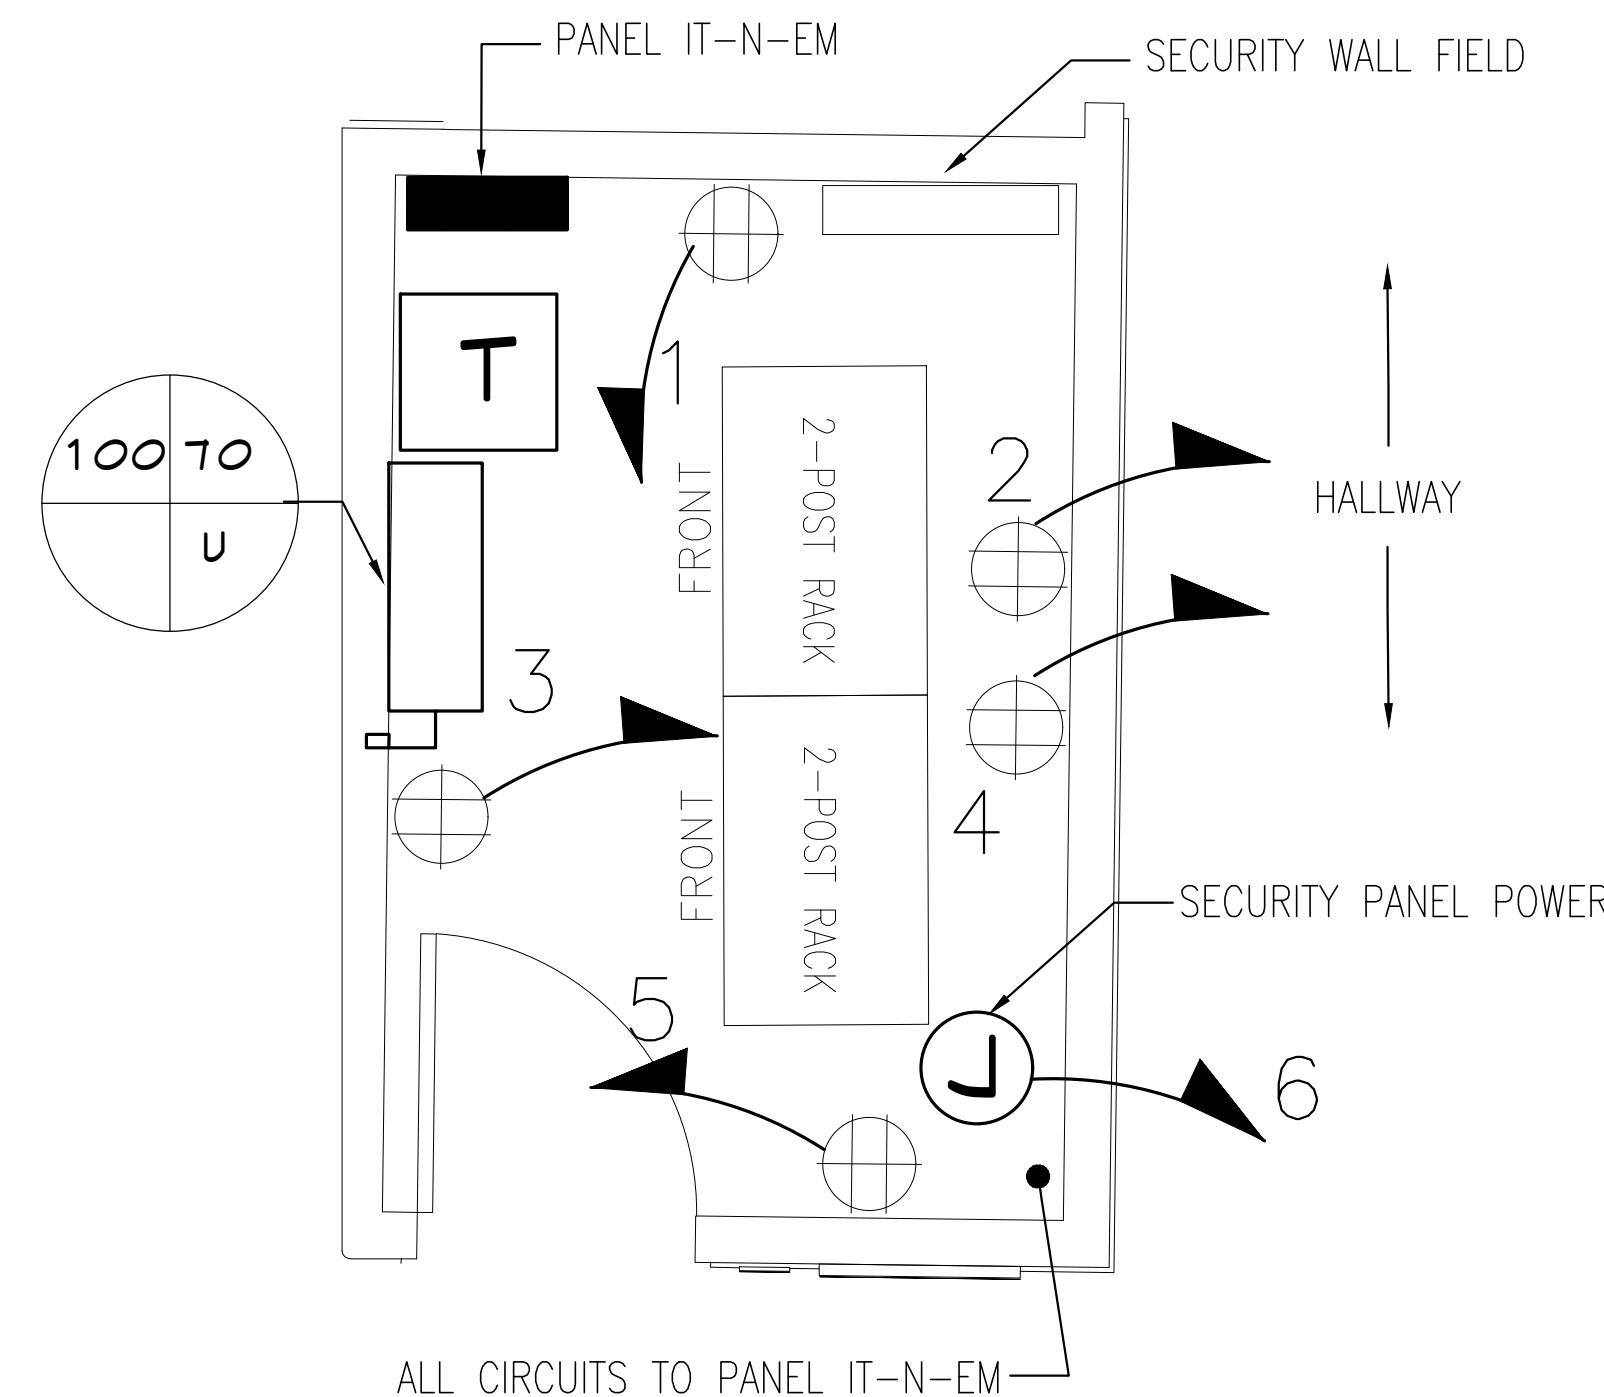

3 IT ROOM PART PLAN - NORTH WING
E.104 1/2"=1'-0"

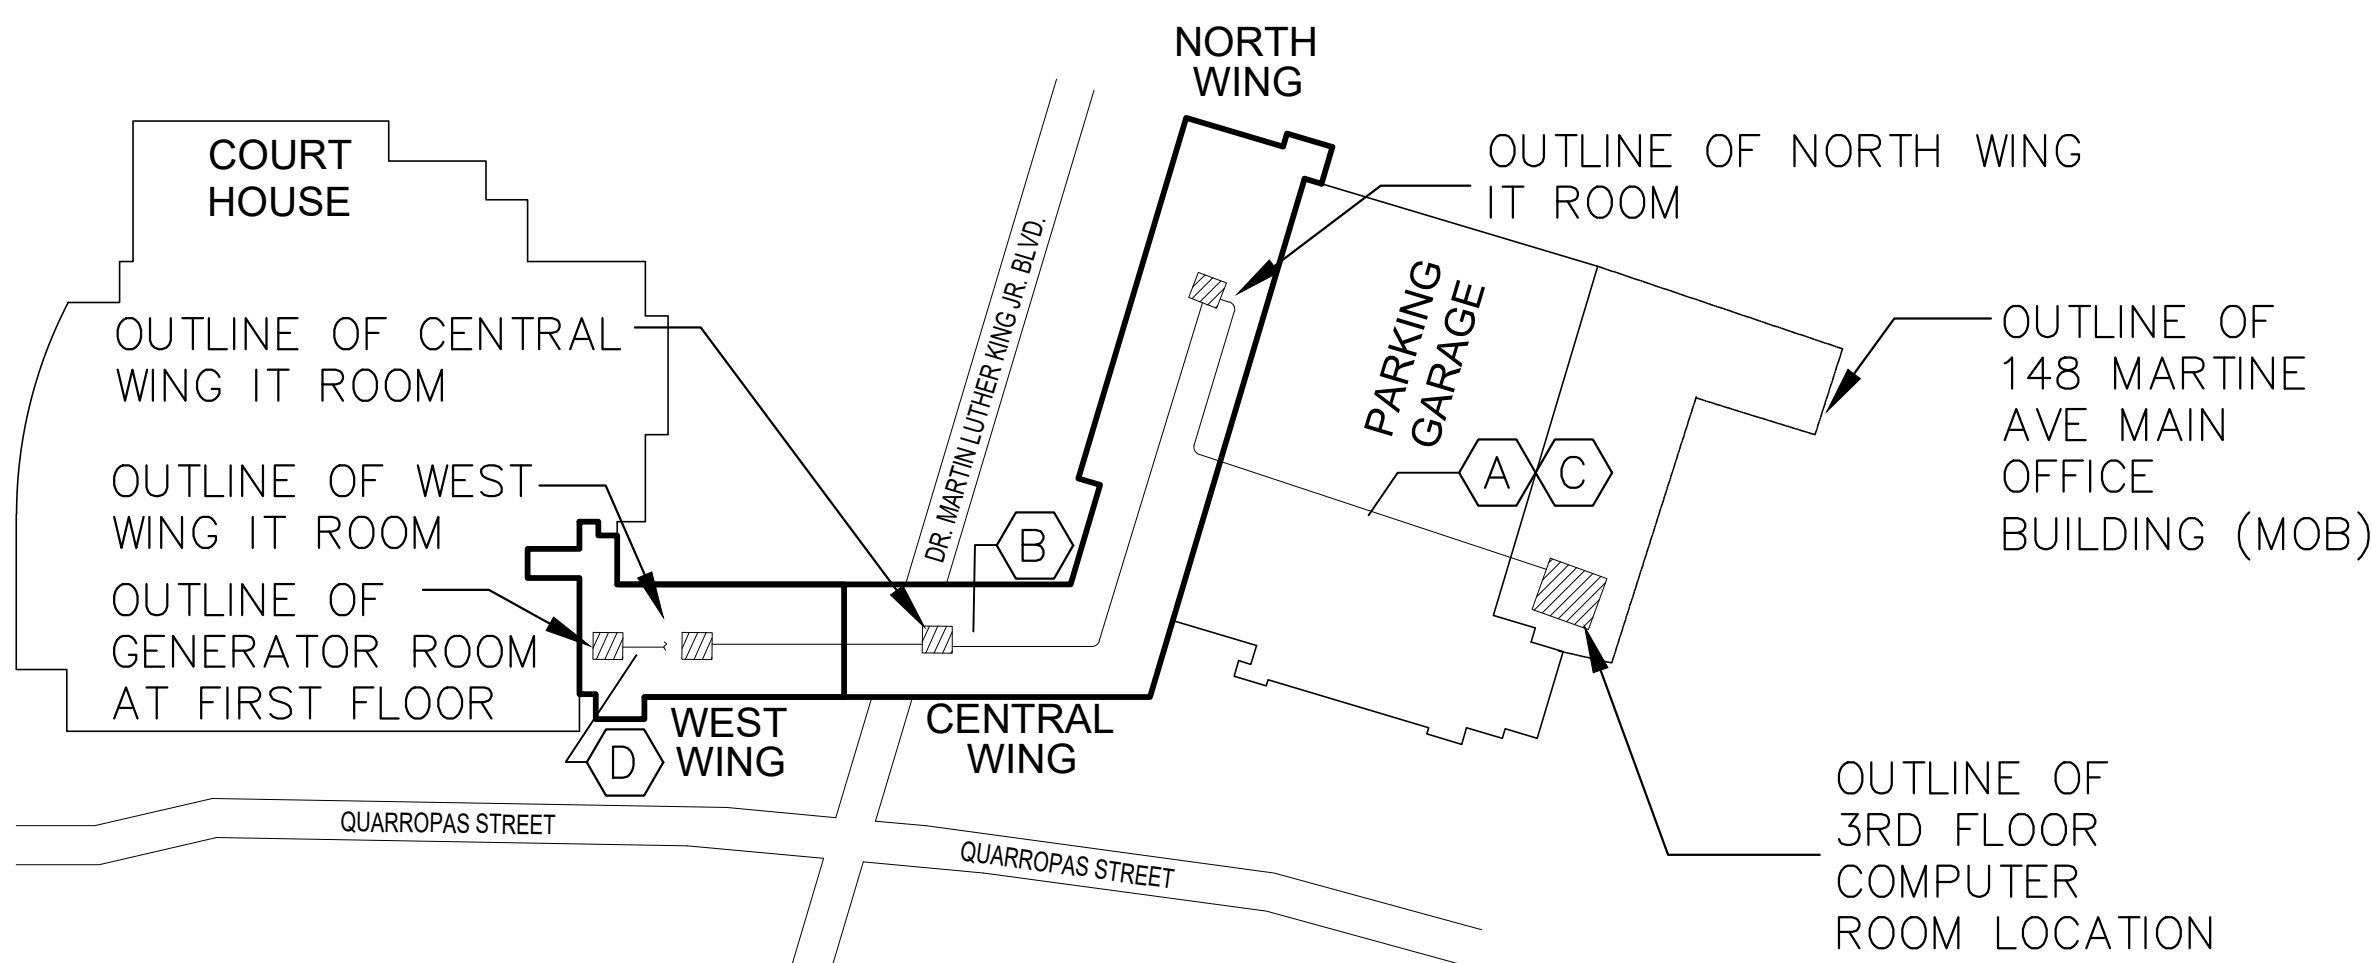

4 OVERALL BACKBONE CONDUIT KEY PLAN
E.104 NTS

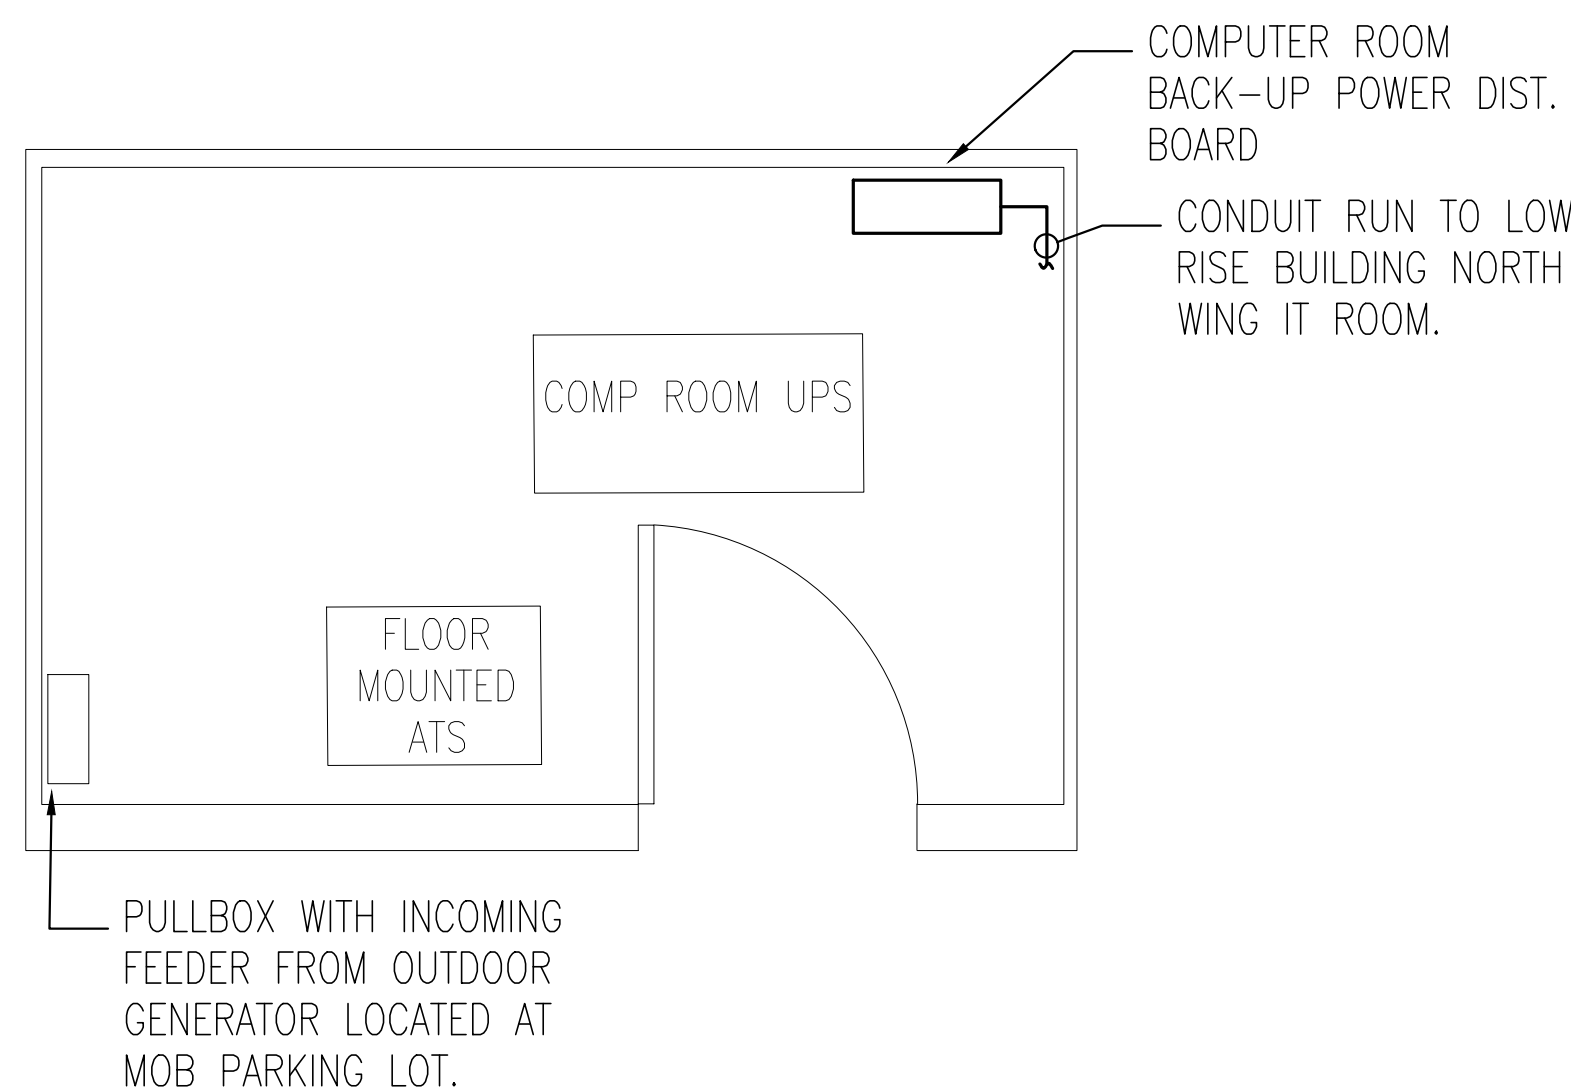

5 3RD FLOOR COMPUTER ROOM PART PLAN
E.104 NTS


KEY NOTES

- A** PROVIDE CONDUIT RUN TO NORTH WING IT ROOM, APPROX. 350 FEET. FINAL CONDUIT RUN SHALL BE VERIFIED IN FIELD.
- B** PROVIDE CONDUIT RUN FROM NORTH WING IT ROOM TO CENTRAL WING AND WEST WING IT ROOM PANELS. VERIFY RUNS IN FIELD. SEE RISER FOR INFORMATION.
- C** PROVIDE SHOP DRAWING WITH CONDUIT PATH FOR ENGINEER APPROVAL PRIOR TO WORK COMMENCING.
- D** ADD/ALTERNATE: PROVIDE FEEDER TO GENERATOR NEAR COURTHOUSE AT APPROXIMATE LOCATION SHOWN. ESTIMATE FEEDER LENGTH AT 100 FEET FOR PRICING PURPOSES.

THESE PLANS ARE APPROVED ONLY FOR THE WORK INDICATED ON THE APPLICATION SPECIFICATION SHEET. ALL OTHER MATTERS SHOWN ARE NOT TO BE RELIED UPON OR TO BE CONSIDERED AS EITHER BEING APPROVED OR IN ACCORDANCE WITH APPLICABLE CODES.

POLISE
CONSULTING ENGINEERS, D.P.C.
133 WEST 19TH STREET
NEW YORK, NY 10011
TEL 212.645.1102
WWW.POLISEDC.COM

CONSULTANT SEAL		CONSULTANT INFORMATION	
		Graf & Lewent Architects LLP 90-30 161st Street, Jamaica, NY 11432 P: 718-651-6200 F: 718-251-6989	
1	06/28/2021	MADE BY	ADDENDUM #2
REVISION NUMBER	DATE	APP'D BY	REVISION
RECORD DRAWING CERTIFICATION			
<input type="checkbox"/> AS BUILT - CHANGES AS NOTED <input type="checkbox"/> AS BUILT - NO CHANGES			
CONTRACTOR		CONTRACTOR	
NAME:		NAME:	
SIGNATURE:		SIGNATURE:	
TITLE:	DATE:	TITLE:	DATE:
WESTCHESTER COUNTY, NEW YORK		CONTRACT NUMBER	SHEET NUMBER
DEPARTMENT OF PUBLIC WORKS AND TRANSPORTATION		19-514	E-104
DIVISION OF ENGINEERING		SCALE: AS NOTED	OF: 17
LOW RISE BUILDING RENOVATIONS AND HVAC IMPROVEMENTS		DATE: MAY 20, 2021	
110 DR. MARTIN LUTHER KING, JR. BOULEVARD		DPW FILE NO.	REV NO. 0
WHITE PLAINS, NEW YORK 10601		52-01-E-594A	
ELECTRICAL IT ROOM PART PLANS			

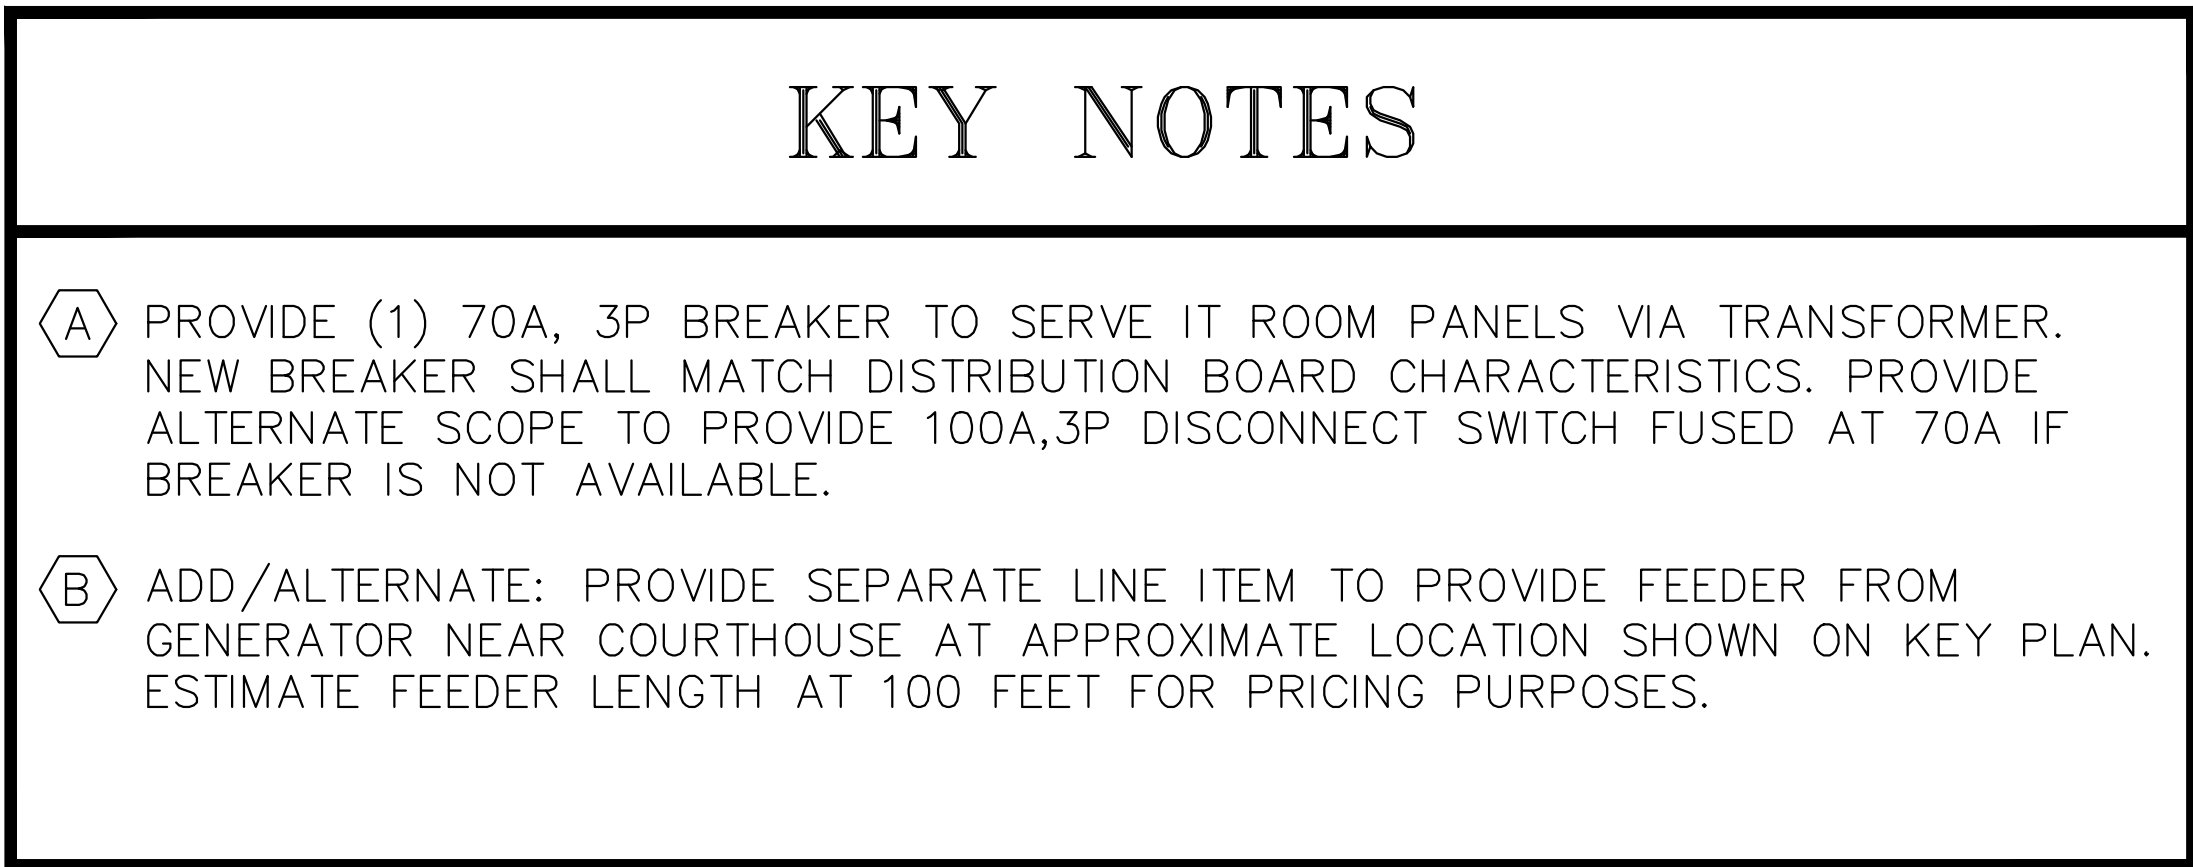


PANEL SCHEDULE				IT-W-EM				PANEL: 208/120V, 3PH, 4W, 225A BUS, 200AM.C.B												
VOLTS L-N 120 V								FEEDER: SEE RISER												
VOLTS PH. 208 V																				
PHASE 3																				
CKT.	NUM.	POLE	C.B. AMP	LOAD CON.	LOAD TYPE	FEEDER SIZE	VA	VA B	VA C	DESCRIPTION	CKT. NUM.	C.B. POLE	C.B. AMP	FEEDER SIZE	VA	VA B	VA C	DESCRIPTION	LOAD CON.	LOAD TYPE
3	1	20	1500	2		2#12+1#12G	1500			IT RECEPTACLE	2	1	20	2#12+1#12G	1500			IT RECEPTACLE	1500	2
3	1	20	1500	2		2#12+1#12G		1500		IT RECEPTACLE	4	1	20	2#12+1#12G		1500		IT RECEPTACLE	1500	2
5	1	20	1500	2		2#12+1#12G			1500	IT RECEPTACLE	6	1	20	2#12+1#12G			500	SECURITY PANEL	500	2
7	1	20					0			SPARE	8	1	20		0			SPARE	-	-
9	1	20	-	-	-	-		0		SPARE	10	1	20	-		0		SPARE	-	-
11	1	20	-	-	-	-			0	SPARE	12	1	20	-			0	SPARE	-	-
13	1	20	-	-	-	-		0		SPARE	14	1	20	-	0			SPARE	-	-
15	1	20	-	-	-	-			0	SPARE	16	1	20	-			0	SPARE	-	-
17	1	20	-	-	-	-			0	SPARE	18	1	20	-			0	SPARE	-	-
19	1	20	-	-	-	-		0		SPARE	20	1	20	-	0			SPARE	-	-
21	1	20	-	-	-	-			0	SPARE	22	1	20	-		0		SPARE	-	-
23	1	20	-	-	-	-			0	SPARE	24	1	20	-			0	SPARE	-	-
							CONNECTED				DEMAND									
1). LIGHTING							0			100	0									
2). RECEPTACLES											8000	ACTUAL CONNECTED LOAD 8000 VA								
a. First 10,000 Watts @ 100%										100	8000	TOTAL ESTIMATED DEMAND LOAD 8000 VA								
b. Load greater than 10,000 Watts @ 50%										50	0	ACTUAL CONNECTED LOAD 22.21 AMPS								
Receptacle total load							8000				8000									
3). MISCELLANEOUS							0			100	0									
4). HEAT							0			100	0									
5). KITCHEN							0			100	0	TOTAL ESTIMATED DEMAND LOAD 22.21 AMPS								
6). MOTORS																				
a. Largest motor load @ 125%										125	-	SPARE BREAKER CAPACITY 42.86%								
b. Additional loads at @ 100%							0			100	0	NOTE:								
Total Motor load							0				0	ALL LOAD CALCULATION ARE BASED ON CURRENT NEC VERSION AND ASSOCIATED LOCAL AMENDMENTS.								
7). HVAC							0			100	0									

THESE PLANS ARE APPROVED ONLY FOR THE WORK INDICATED ON THE APPLICATION SPECIFICATION SHEET. ALL OTHER MATTERS SHOWN ARE NOT TO BE RELIED UPON OR TO BE CONSIDERED AS EITHER BEING APPROVED OR IN ACCORDANCE WITH APPLICABLE CODES.

POLISE
CONSULTING ENGINEERS OPC

133 WEST 19TH STREET
NEW YORK, NY 10011
TEL 212.645.1002
www.POLISECE.COM

CONSULTANT SEAL		<div style="text-align: center;"> <div style="display: flex; justify-content: space-between; align-items: center;"> <div> <p>CONSULTANT INFORMATION</p> <p style="font-size: 2em; font-weight: bold; margin: 10px 0;">Graf & Lewent</p> <p style="font-weight: bold; margin: 0;">Architects LLP</p> </div> <div style="text-align: right;"> </div> </div> <p style="margin-top: 20px;">90-30 161st Street, Jamaica, NY 11432 P: 718-651-6200 F: 718-251-6989</p> </div>			
1	06/28/2021			ADDENDUM #2	
REVISION NUMBER	DATE	MADE BY	APP'D BY	REVISION	
RECORD DRAWING CERTIFICATION					
<div style="display: flex; justify-content: space-between;"> <div style="width: 45%;"> <input type="checkbox"/> AS BUILT - CHANGES AS NOTED <input type="checkbox"/> AS BUILT - NO CHANGES </div> <div style="width: 50%;"></div> </div>					
CONTRACTOR			CONTRACTOR		
NAME: _____			NAME: _____		
SIGNATURE: _____			SIGNATURE: _____		
TITLE: _____ DATE: _____			TITLE: _____ DATE: _____		
WESTCHESTER COUNTY, NEW YORK DEPARTMENT OF PUBLIC WORKS AND TRANSPORTATION DIVISION OF ENGINEERING				CONTRACT NUMBER 19-514	SHEET NUMBER <div style="font-size: 2em; font-weight: bold; border: 1px solid black; padding: 5px; display: inline-block;">E-105</div>
LOW RISE BUILDING RENOVATIONS AND HVAC IMPROVEMENTS 110 DR. MARTIN LUTHER KING, JR. BOULEVARD WHITE PLAINS, NEW YORK 10601				SHEET NO. 17 OF 17	
EMERGENCY POWER RISER DIAGRAM AND PANEL SCHEDULES				SCALE: AS NOTED DATE: MAY 20, 2021 DPW FILE NO. 52-01-E-594B	
				REV NO. 0	

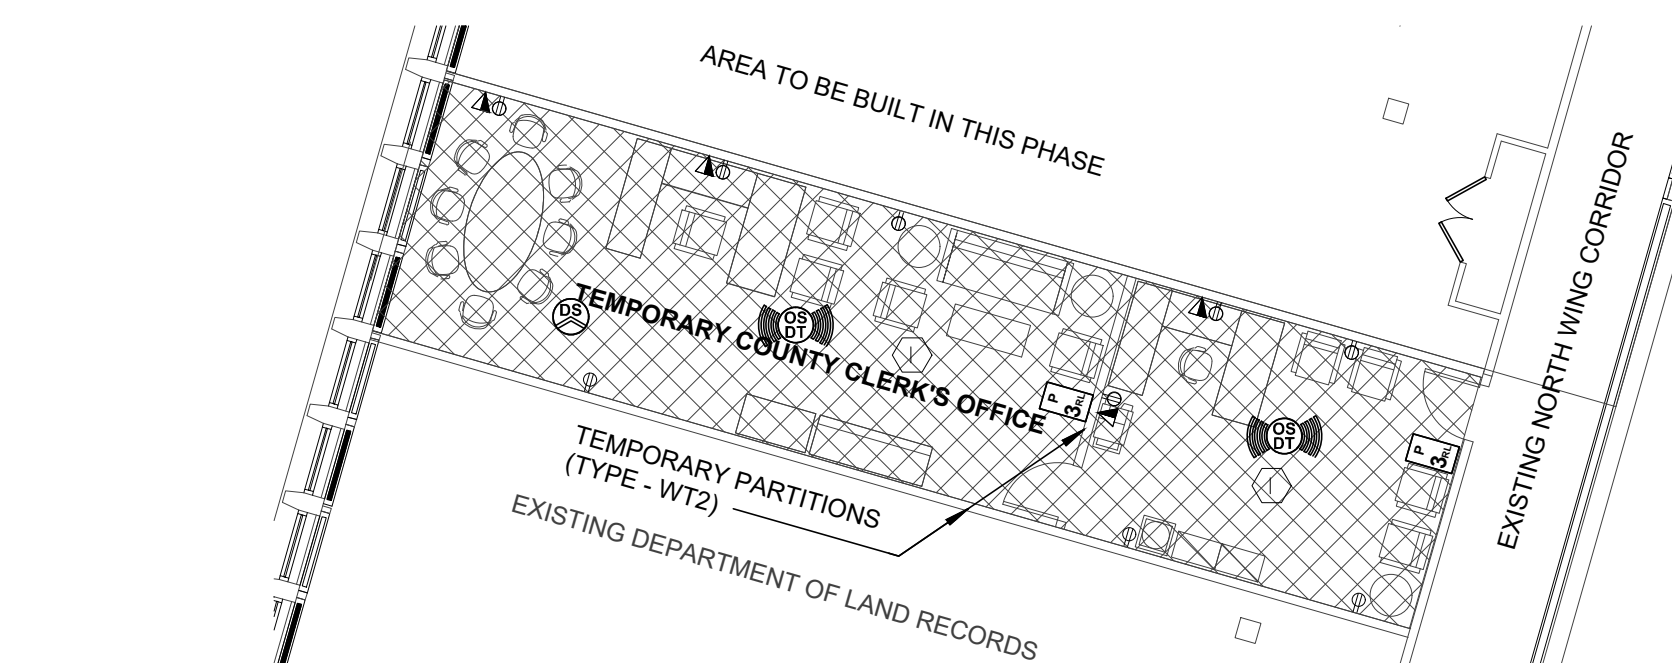

A detailed floor plan of the temporary legal offices. The plan shows a rectangular building with a cross-hatched interior. The building is divided into several rooms, numbered 1 through 6. Room 1 is a large central area, and rooms 2 through 6 are smaller rooms along the perimeter. A central area is labeled 'TEMP. PARTITION (TYPE - WT3)'. A callout box labeled 'TEMPORARY LEGAL OFFICES' points to the building. The building is situated on a street corner, with a sidewalk and a road visible. A north arrow is located in the upper right corner of the plan.

WCC COUNTY CLERK
WCC 7

DOF WAITING
DOF 1

WCC OFFICE 3
WCC 3

DOF COATS
DOF 5

DOF PANTRY
DOF 2

DOF WORK STATIONS
DOF 3

DOF STORAGE
DOF 4

LUNCH / BREAK
WET 8

STAFF RESTROOMS MALE
WET 5

N WING HALLW. 2
HLL 3

PU WORK STATIONS
PU 2

PU OFFICE
PU 4

DLR CORRIDOR
DLR 12

WCC OFFICE 2
WCC 2

PU PANTRY
PU 3

DLR OFFICE 1
DLR 5

DLR OFFICE 3
DLR 7

DLR STORAGE
DLR 9

DLR WORK STATIONS
DLR 3

DLR COATS
DLR 11

DLR PANTRY
DLR 4

WCC RECEPTION
WCC 6

WCC BATH ACCESS
WET 9

WCC UNISEX BATH
WET 10

EXISTING UTILITIES CLOSETS
EXT 5

EXISTING COATS STR 4

WCC COATS
WCC 12

N WING HALLW. 3
HLL 4

WCC OFFICE 4
WCC 4

WCC PANTRY
WCC 11

WCC MAIN CONFERENCE ROOM
WCC 8

WCC OFFICE 5
WCC 5

JANITOR
WET 7

STAFF RESTROOMS FEMALE
WET 6

STAFF RESTROOMS ACCESS
WET 4

PU MAILING & PARCELS
PU 1

PU COATS
PU 5

WCC MAIN STORAGE
WCC 10

DLR SCAN/MAP
DLR 8

N WING HALLW. 1
HLL 2

PHASE 2 PU STORAGE
PU 6

PHASE 1 WCC PANTRY
WCC 11

EXISTING NORTH WING CORRIDOR

CONSULTANT

1
REVISION
NUMBER

NAME

GENERAL NOTES

1. REFER TO ARCHITECTURAL PLANS FOR ALL LIGHTING FIXTURE LOCATIONS AND LIGHTING FIXTURE SWITCHES.
2. ALL EMERGENCY LIGHTING SHOWN ON E-202 TO BE CIRCUITED TO 1 POLE 20A CIRCUIT BREAKER IN EXISTING EMERGENCY PANEL LP-TS-E3 LOCATED WITHIN COURTHOUSE BUILDING. SEE E-030 DETAIL #4 FOR APPROXIMATE LOCATION OF PANEL.
3. REFER TO ELECTRICAL PHASING NOTES ON E-010 FOR ALL PHASING DETAILS.
4. LIGHTING FIXTURES ARE TO BE TAKEN AT 277V V.O.N.
5. WIRE ALL EXIT SIGN TO EXISTING CIRCUIT SERVING EXISTING EXIT SIGNS.
6. DESIGN INTENT IS FOR ALL ENS, GSM AND ATHENA HUBS ARE TO BE LOCATED WITHIN CEILING ABOVE. ENS AND GSM DEVICES ARE SHOWN FOR CIRCUITING INTENT ONLY.

KEY NOTES

① WIRE TEMPORARY LIGHTING FIXTURES AND LIGHTING CONTROLS SERVING SPACE TO 1 POLE 20A CIRCUIT IN PANEL DB-3-1 WITH 2#12#126-3/4".










CONSULTANT SEAL		CONSULTANT INFORMATION		
		<h1 style="margin: 0;">Graf & Lewent</h1> <h2 style="margin: 0;">Architects LLP</h2>		
				
		90-30 161st Street, Jamaica, NY 11432 P: 718-651-6200 F: 718-251-6989		
1	06/28/2021			ADDENDUM #2 
REVISION NUMBER	DATE	MADE BY	APP'D BY	REVISION
RECORD DRAWING CERTIFICATION				
<div style="display: flex; justify-content: space-between; align-items: flex-start;"> <div style="width: 40%;"> <input style="width: 40px; height: 20px; margin-bottom: 5px;" type="checkbox"/> AS BUILT - CHANGES AS NOTED <input style="width: 40px; height: 20px;" type="checkbox"/> AS BUILT - NO CHANGES </div> <div style="width: 60%;"></div> </div>				
CONTRACTOR			CONTRACTOR	
NAME: _____			NAME: _____	
SIGNATURE: _____			SIGNATURE: _____	
TITLE: _____ DATE: _____			TITLE: _____ DATE: _____	
WESTCHESTER COUNTY, NEW YORK DEPARTMENT OF PUBLIC WORKS AND TRANSPORTATION DIVISION OF ENGINEERING				
LOW RISE BUILDING RENOVATIONS AND HVAC IMPROVEMENTS 110 DR. MARTIN LUTHER KING, JR. BOULEVARD WHITE PLAINS, NEW YORK 10601 LIGHTING PLAN - 3RD FLOOR NORTH WING			CONTRACT NUMBER 19-514	SHEET NUMBER <div style="font-size: 2em; font-weight: bold; margin-top: 10px;">E-203</div>
			SHEET NO. 11 OF 15	
			SCALE: AS NOTED DATE: MAY 20, 2021 DPW FILE NO. 52-01-F-598	
			REV NO. 1	








GENERAL NOTES
1. ALL MATERIALS AND WORKMANSHIP SHALL CONFORM TO THE NATIONAL ELECTRICAL CODE, ALL APPLICABLE LOCAL CODES AND REGULATIONS, TIA/EIA TELECOMMUNICATIONS STANDARDS, BICSI STANDARDS, AND CONSTRUCTION STANDARDS.
2. THE TELECOM AND ELECTRICAL CONTRACTORS SHALL BE RESPONSIBLE FOR REPORTING TO THE TELECOM CONSULTANT, IN A TIMELY MANNER, ANY DISCREPANCIES BETWEEN THESE BID DOCUMENTS AND ACTUAL FIELD CONDITIONS OR OTHER TRADE DRAWINGS.
3. ELECTRICAL POWER LOCATIONS ARE SHOWN FOR REFERENCE ONLY.
4. IN CASE OF DISCREPANCY, THE TELECOM BACKGROUNDS CONFLICT WITH THE ARCHITECTURAL BACKGROUNDS, THE CONTRACTOR SHALL OBTAIN DIRECTION FROM THE ARCHITECT.













TELECOM CONTRACTOR NOTES:
1. TELECOMMUNICATIONS CONTRACTOR IS RESPONSIBLE FOR ALL WORK DESCRIBED IN THE BID DOCUMENTS UNLESS OTHERWISE NOTED AND HE/SHE SHALL BE REFERRED TO THROUGHOUT THESE DOCUMENTS AS THE "TELECOM CONTRACTOR". THE BID DOCUMENTS INCLUDE THE CONTRACT DRAWINGS, SPECIFICATION AND THE ARCHITECTS AND THE CONTRACTOR'S GENERAL TERMS AND CONDITIONS.
2. TELECOMMUNICATIONS CONTRACTOR SHALL INSTALL ALL EQUIPMENT IDENTIFIED ON THE DRAWINGS UNLESS OTHERWISE NOTED.
3. TELECOMMUNICATIONS CONTRACTOR SHALL RUN ALL CABLING IN DEDICATED PATHWAYS OR THOSE PATHWAYS IDENTIFIED FOR LOW VOLTAGE SYSTEMS.
4. ALL CABLE PATHWAYS SHALL BE CONCEALED IN WALL AND CEILING SPACES WHERE POSSIBLE UNLESS OTHERWISE NOTED.
5. ALL CABLE PATHWAYS SHALL BE RUN PARALLEL OR ORTHOGONAL TO WALLS, FLOORS, AND CEILINGS.
6. CABLE DISTRIBUTION ABOVE ACCESSIBLE CEILINGS SHALL BE RUN USING J-HOOKS AT NO MORE THAN 5'-0" SPACINGS PROVIDED BY THE COMMUNICATIONS CONTRACTOR. UNLESS OTHERWISE NOTED.
7. TELECOMMUNICATIONS CONTRACTOR SHALL BE RESPONSIBLE FOR COORDINATING WITH OTHER TRADE DRAWINGS. FURTHERMORE, HE/SHE SHALL BE RESPONSIBLE FOR SURVEYING THE FACILITY TO LOCATE ALL BACKBOXES, CONDUITS, STUB-UPS, CABLE TRAYS, AND OTHER WIREWAYS PROVIDED BY OTHERS AND DESIGNATED FOR CABLES AS SHOWN ON THE TELECOM DRAWINGS.
8. REFER TO SECURITY DRAWINGS FOR SECURITY DEVICE LOCATIONS
9. COORDINATE ALL WORK AT GARAGE LEVEL WITH FACILITY PERSONNEL FOR INSTALLATION OF FIBER BACKBONE CABLING.

ELECTRICAL CONTRACTOR NOTES:
1. POWER RECEPTACLES, SWITCHES, ETC. SHOWN ON THESE DRAWINGS ARE FOR INFORMATION ONLY. REFER TO ELECTRICAL DRAWINGS FOR ACTUAL QUANTITIES AND LOCATIONS
2. ALL CONDUIT, SLEEVES, FLOOR BOXES, STUB UPS, CABLE TRAY, RACEWAYS, BACK BOXES, AND ACCESS PANELS SHALL BE PROVIDED BY THE ELECTRICAL CONTRACTOR.
3. ELECTRICAL CONTRACTOR SHALL SURVEY THE LOCATION OF MECHANICAL, PLUMBING AND OTHER EQUIPMENT AS REQUIRED PRIOR WORK EXECUTION IN ORDER TO PROPERLY COORDINATE CABLE PATHWAYS.
4. THE EXACT PATH OF THE CONDUITS IS TO BE DETERMINED BY THE ELECTRICAL CONTRACTOR. ALL CONDUITS SHALL BE DEBARRED, CLEANED, CAPPED, TAGGED AND FURNISHED WITH PULL WIRES (BY THE ELECTRICAL CONTRACTOR).
5. ELECTRICAL CONTRACTOR SHALL PROVIDE CONDUITS IN ALL EXPOSED AND INACCESSIBLE WALLS AND CEILINGS FOR THE PURPOSE OF PULLING CABLING TO TELECOMMUNICATIONS OUTLET LOCATIONS.
6. WHEN PENETRATING THE SLAB, SLEEVES SHALL BE CUT A MINIMUM OF 3 INCHES ABOVE THE FINISHED SLAB.
7. PROVIDE PLASTIC BUSHINGS AT ALL SLEEVE AND OPEN CONDUIT ENDS
8. THE CONTRACTOR SHALL RE-ESTABLISH THE FIRE RATING OF ALL PENETRATIONS MADE BY THE CONTRACTOR THROUGH FIRE RATED FLOORS OR WALLS.
9. PROVIDE A PULL BOX IN CONDUIT RUNS SUCH THAT (REFER TO TABLES): - MAXIMUM CONTINUOUS CONDUIT RUN SHALL NOT EXCEED 100FT - NO MORE THAN TWO 90 DEGREE BENDS EXIST IN A CONTINUOUS CONDUIT RUN - AT LEAST ONE PULL BOX PER REVERSE (U-SHAPED) BEND IN CONDUIT RUN - IT IS LOCATED IN THE STRAIGHT SECTION OF A CONDUIT AND NOT IN LIEU OF A BEND - ALL PULL BOXES ARE ACCESSIBLE AND HAVE REMOVABLE COVERS
10. THE MINIMUM BEND RADIUS FOR A CONDUIT THAT IS 2" OR LESS IN DIAMETER SHOULD BE 6 TIMES THE INTERNAL CONDUIT DIAMETER. IF THE CONDUIT IS LARGER THAN 2" THE BEND RADIUS SHOULD BE 10 TIMES THE INTERNAL DIAMETER OF THE CONDUIT
11. ALL HORIZONTAL PATHWAYS SHALL BE ROUTED SUCH THAT THE TOTAL CABLE LENGTH SHALL NOT EXCEED 295FT. IF THIS REQUIREMENT CANNOT BE MET, CONTACT THE ENGINEER PRIOR TO PATHWAY INSTALLATION

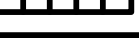DRAWING LIST		
1	T-001	TELECOMMUNICATIONS ABBREVIATIONS, LEGEND AND NOTES
2	T-002	TELECOMMUNICATIONS GENERAL NOTES
3	T-101	TELECOMMUNICATIONS PLAN - 3RD FLOOR WEST WING
4	T-102	TELECOMMUNICATIONS PLAN - 3RD FLOOR CENTRAL WING
5	T-103	TELECOMMUNICATIONS PLAN - 3RD FLOOR NORTH WING
6	T-104	TELECOMMUNICATIONS PART PLANS
7	T-300	TELECOMMUNICATIONS RISER DIAGRAM
8	T-301	TELECOMMUNICATIONS RISER DIAGRAM
9	T-400	TELECOMMUNICATIONS INSTALLATION DETAILS
10	T-401	TELECOMMUNICATIONS INSTALLATION DETAILS


SECURITY LEGEND			
ACCESS CONTROL ALARM MONITORING		CCTV SURVEILLANCE	
SYMBOL	DESCRIPTION	SYMBOL	DESCRIPTION
	CARD READER		FIXED CCTV CAMERA – CEILING MOUNTED
	MAGNETIC CONTACT		
	ELECTRIC LOCKSET WITH INTEGRATED REQUEST TO EXIT		CAMERA POWER SUPPLY
	MOTION DETECTOR REQUEST TO EXIT		DIGITAL VIDEO RECORDER
	MOTION DETECTOR		CCTV MONITOR

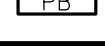OUTLET TYPES AND SYSTEMS			
SYMBOL	OUTLET DESCRIPTION	CABLE DESCRIPTION	REMARK
	2-PORT OUTLET: (1) VOICE (1) DATA	(2) 4-PAIR UTP CATEGORY 6A CABLES	PROVIDE SINGLE GANG BOX WITH (1) 3/4" EMT STUB-UP / CONDUIT AS APPLICABLE
	2-PORT OUTLET: (1) VOICE (1) DATA	(2) 4-PAIR UTP CATEGORY 6A CABLES	
	2-PORT OUTLET: (1) VOICE (1) DATA	(2) 4-PAIR UTP CATEGORY 6A CABLES	
	2-PORT OUTLET: (1) VOICE (1) DATA	(2) 4-PAIR UTP CATEGORY 6A CABLES	
	CCTV OUTLET	(1) 4-PAIR UTP CATEGORY 6A CABLES	PROVIDE 1" EMT EMPTY CONDUIT AND SINGLE GANG BACKBOX WITH PULL STRING TO NEAREST TELECOM ROOM. SEE RISER.
	CCTV OUTLET	(1) 4-PAIR UTP CATEGORY 6A CABLES	PROVIDE 1" EMT EMPTY CONDUIT AND SINGLE GANG BACKBOX WITH PULL STRING TO NEAREST TELECOM ROOM. SEE RISER.
	WIRELESS ACCESS POINT	(1) 4-PAIR UTP CATEGORY 6A CABLES	10 FEET OF CABLE TO BE LEFT COILED IN CEILING/WALL

LEGEND	
SYMBOL	DESCRIPTION
	WALL MOUNTED TELE / DATA OUTLET
	FLOOR MOUNTED TEL / DATA OUTLET
	FURNITURE MOUNTED TELE / DATA OUTLET
	MULLION MOUNTED TELE / DATA OUTLET
	CABLE TRAY OUTSIDE THE TELECOMMUNICATIONS ROOM
	CABLE TRAY IN TELECOMMUNICATIONS ROOM
	CONDUIT GOING UP
	CONDUIT GOING DOWN
	CONDUIT END WITH INSULATED BUSHING
	PULL BOX REFER TO DETAIL #2 OF DWG T08.01 FOR PULL BOX SIZE CONFIGURATION
	MECHANICAL FIRE STOP
	WIRELESS ACCESS POINT

ABBREVIATIONS	
SYMBOL	DESCRIPTION
AFF	ABOVE FINISHED FLOOR
AP	ACCESS POINT
BMS	BUILDING MANAGEMENT SYSTEM
C, COND	CONDUIT
CAB	CABINET
CAT	CATEGORY
CTV	CABLE TELEVISION
CCTV	CLOSED CIRCUIT TELEVISION
CNE	COMMON NETWORK EQUIPMENT
CP	CONSOLIDATION POINT
DWG	DRAWING
EC	ELECTRICAL CONTRACTOR
EF	ENTRANCE FACILITY
ELEC	ELECTRICAL
F, FO	FIBER OPTICS
FM	FURNITURE MOUNTED
G, GRD	GROUND
KVA	KILO VOLT- AMPERE
KW	KILO WATT
LAN	LOCAL AREA NETWORK
LV	LOW VOLTAGE
MCR	MAIN COMMUNICATION ROOM
MIN	MINIMUM
MM	MULTI-MODE FIBER OPTIC CABLES
MTD	MOUNTED
N	NEUTRAL
N/A	NOT APPLICABLE
NIC	NOT IN CONTRACT
NO, #	NUMBER
NTS	NOT TO SCALE
OS	OUTSIDE RATED CABLE
PA	PUBLIC ADDRESS
PB	PULL BOX
PBX	PRIVATE BRANCH EXCHANGE
PVC	POLYVINYL CHLORIDE
PWR	POWER
RM	ROOM
RMU	RACK MOUNT UNIT
SCS	STRUCTURED CABLING SYSTEM
SEC	SECURITY
SM	SINGLE MODE FIBER OPTIC CABLES
SPEC	SPECIFICATIONS
STP	SHIELDED TWISTED PAIR
SW	SWITCH
TAO	TERMINAL AREA OUTLET
TBD	TO BE DETERMINED
TC	TELECOMMUNICATIONS CONTRACTOR
TR	TELECOMMUNICATIONS ROOM
TYP	TYPICAL
UG	UNDERGROUND
UON	UNLESS OTHERWISE NOTED
UNF	UNFUSED
UPS	UNINTERRUPTABLE POWER SUPPLY
UTP	UNSHIELDED TWISTED PAIR
V	VOLT
VA	VOLT-AMPERES
VISPG	VISUAL DISPLAY UNIT
W	WEATHER PROOF
WAN	WIDE AREA NETWORK
WLAN	WIRELESS LOCAL AREA NETWORK

THESE PLANS ARE APPROVED ONLY FOR THE WORK INDICATED ON THE APPLICATION SPECIFICATION SHEET. ALL OTHER MATTERS SHOWN ARE NOT TO BE RELIED UPON OR TO BE CONSIDERED AS EITHER BEING APPROVED OR IN ACCORDANCE WITH APPLICABLE CODES.

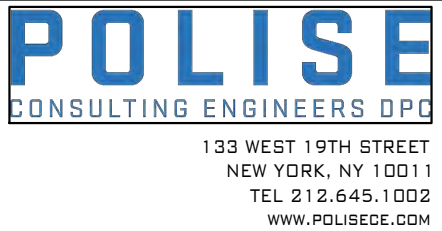

CONSULTANT SEAL		CONSULTANT INFORMATION			
		Graf & Lewent Architects LLP			
		90-30 161st Street, Jamaica, NY 11432 P: 718-651-6200 F: 718-251-6989			
2	06/28/2021				ADDENDUM #2
1	06/21/2021				ADDENDUM #1
REVISION NUMBER	DATE	MADE BY	APP'D BY		REVISION
RECORD DRAWING CERTIFICATION					
<input type="checkbox"/> AS BUILT - CHANGES AS NOTED <input type="checkbox"/> AS BUILT - NO CHANGES					
CONTRACTOR			CONTRACTOR		
NAME: _____			NAME: _____		
SIGNATURE: _____			SIGNATURE: _____		
TITLE: _____			TITLE: _____		
DATE: _____			DATE: _____		
WESTCHESTER COUNTY, NEW YORK DEPARTMENT OF PUBLIC WORKS AND TRANSPORTATION					
DIVISION OF ENGINEERING					
LOW RISE BUILDING RENOVATIONS AND HVAC IMPROVEMENTS 110 DR. MARTIN LUTHER KING, JR. BOULEVARD WHITE PLAINS, NEW YORK 10601					
TELECOMMUNICATIONS ABBREVIATIONS, LEGEND AND NOTES					
CONTRACT NUMBER 19-514		SHEET NUMBER T-001			
SHEET NO. 1		OF 10			
SCALE: AS NOTED					
DATE: MAY 20, 2021					
DPW FILE NO.					
52-01-T-617-0					
REV NO. 0					

GENERAL NOTES

1. THE TELECOMMUNICATIONS CONTRACTOR SHALL BE RESPONSIBLE FOR ALL THE WORK DESCRIBED IN THE BID DOCUMENTS AND SHALL BE REFERRED TO THROUGHOUT THESE DOCUMENTS AS "CONTRACTOR". THE PROJECT DOCUMENTS SHALL INCLUDE THE CONTRACT DRAWINGS, SPECIFICATIONS AND THE PROJECT GENERAL CONDITIONS. IF THE GENERAL CONDITIONS AND THE PROJECT GENERAL CONDITIONS DIFFER ON THE SAME POINT THEN THE MOST STRICT DEFINITION AND/OR INTERPRETATION SHALL BE FOLLOWED.
2. NOTES AND GRAPHIC REPRESENTATIONS ON THE DRAWINGS SHALL NOT LIMIT THE EXTENT OF THE WORK REQUIRED. CONTRACTOR SHALL PROVIDE A COMPLETE TURNKEY FULLY OPERATIONAL SYSTEM BASED UPON THE CONSTRUCTION DOCUMENTS. QUESTIONS REGARDING THE INTENT OF THE DESIGN SHALL BE PROMPTLY BROUGHT TO THE ATTENTION OF THE ENGINEER.
3. THE CONTRACTOR SHALL BE RESPONSIBLE FOR COORDINATING THE FINAL TELECOMMUNICATIONS SYSTEM EQUIPMENT LAYOUT AS SHOWN ON THE DRAWINGS WITH THE SITE CONDITIONS. CONFLICTS, IF ANY, SHALL BE BROUGHT TO THE ATTENTION OF THE ENGINEER, WHO SHALL APPROVE ALL CHANGES PRIOR TO THE INSTALLATION OF THE WORK.
4. ALL CONDUITS, PENETRATIONS, JUNCTION BOXES CABLE LADDERS AND REQUIRED SUPPORTS SHALL BE PROVIDED BY THE ELECTRICAL CONTRACTOR.
5. THE CONTRACTOR SHALL VERIFY THE SIZE OF ALL CONDUCTORS. THE NUMBER OF CONDUCTORS REQUIRED MAY VARY DEPENDENT ON THE MANUFACTURERS OF EQUIPMENT SELECTED BY THE CONTRACTOR. IF THE EQUIPMENT THAT THE CONTRACTOR INTENDS TO FURNISH AND INSTALL HAS ANY SPECIAL REQUIREMENTS, THE CONTRACTOR SHALL PROVIDE FOR THESE REQUIREMENTS IN THE BID AT NO EXTRA COST TO THE OWNER. CONTRACTOR SHALL VERIFY THE SIZE OF ALL CONDUITS AND JUNCTION BOXES (40% MAXIMUM FILL) WITH THE ELECTRICAL CONTRACTOR. THE MINIMUM CONDUIT SIZE SHALL BE ¾".
6. CONTRACTOR SHALL PROMPTLY NOTIFY ENGINEER PRIOR TO INSTALLATION OF WORK IF ANY MOUNTING LOCATIONS NOTED ON THE DRAWINGS ARE OBSTRUCTED AND/OR IF ANY MOUNTING LOCATION CONFLICTS OR PROBLEMS ARE DISCOVERED.
7. WIRING SYSTEMS SHALL BE CONSISTENTLY COLOR CODED AND TAGGED. COORDINATION OF EXACT WIRE CODING AND TAGGING IS MANDATORY AND PART OF THE SUBMITTAL PROCESS. THE CONTRACTOR IS DIRECTLY RESPONSIBLE FOR COORDINATING WIRING FROM EQUIPMENT MANUFACTURERS' TERMINAL STRIPS TO THE FINAL CONNECTION POINTS OF EQUIPMENT WITHIN THE SCOPE OF THE PROJECT.
8. MINIMUM SIZE OF CONDUCTORS SHALL BE 18 AWG, UNLESS OTHERWISE INDICATED. CONTRACTOR SHALL MODIFY STANDARD EQUIPMENT INPUT/OUTPUT WIRING TERMINALS TO ACCEPT 18 AWG. EXCEPTIONS MAY BE ALLOWED FOR MANUFACTURER PROVIDED LEADS AND INTERNAL EQUIPMENT WIRING, IF APPROVED BY THE ENGINEER. THE CONTRACTOR SHALL NOT EXCEED THE MAXIMUM TENSILE FORCE THAT THE MANUFACTURER RECOMMENDS WHEN PULLING CABLE.
9. THE ELECTRICAL CONTRACTOR SHALL PROVIDE 110 VAC INPUT POWER FOR POWER SUPPLIES AND OTHER SYSTEM COMPONENTS. CONTRACTOR SHALL BE RESPONSIBLE FOR ALL LOW VOLTAGE POWER REQUIREMENTS. ALL EQUIPMENT, INCLUDING LOCAL UPS UNITS AND BATTERY BACK-UP POWER SUPPLIES, SHALL BE FROM DEDICATED CIRCUIT BREAKERS CONNECTED TO THE BUILDING'S EMERGENCY POWER DISTRIBUTION SYSTEM.
10. RACEWAYS AND CONDUITS SHALL BE CONCEALED IN WALL AND CEILING. EXPOSED RACEWAYS, WHERE NECESSARY AND APPROVED BY THE ENGINEER, SHALL BE RUN PARALLEL TO OR AT RIGHT ANGLES TO WALLS.
11. WHERE CABLES PASS THROUGH FIRE RATED, FIRE RESISTANT AND/OR FIRE STOPPED FLOORS AND WALLS USE CABLE SLEEVES THAT PREVENT THE SPREAD OF FIRE OR PRODUCTS OF COMBUSTION. SLEEVES SHALL NELSON "FLAME SEAL" OR AS APPROVED BY THE ENGINEER. APPROVED FIRE SEALS SHALL ALSO BE PROVIDED AT ALL CABLE AND CONDUIT PENETRATIONS THROUGH FIRE RATED WALLS AND FLOORS.
12. 110 VAC POWER CONDUCTORS SHALL NOT BE INSTALLED IN THE SAME CONDUIT AS LOW VOLTAGE AUDIO, VIDEO, CONTROL, DC POWER OR ANY OTHER LOW VOLTAGE CABLES.
13. ALL CONDUIT ROUTES SHALL BE GROUNDED AND BONDED.
14. THE ELECTRICAL CONTRACTOR SHALL ENSURE THAT THE BEND RADIUS OF CONDUITS SHALL BE NO LESS THAN SIX TIMES THE OUTSIDE DIAMETER OF THAT CONDUIT. (6X CONDUIT OD). BUSHINGS SHALL BE INSTALLED AT THE END OF ALL CONDUITS TO AVOID CHAFFING OF THE CABLE. IN ADDITION, CONDUIT RUNS CANNOT CONTAIN THE EQUIVALENT OF TWO 90-DEGREE TURNS IN ANY DIMENSIONAL PLANE WITHOUT THE ADDITION OF A PULL BOX.
15. ALL ELECTRICAL, SAFETY AND FIRE CODES SHALL BE FOLLOWED. IF NATIONAL, STATE AND/OR CITY CODES DIFFER ON THE SAME POINT THEN THE MOST STRICT DEFINITION AND/OR INTERPRETATION SHALL BE FOLLOWED.
16. SECURITY CONDUITS INSTALLED TO SUPPORT SECURITY DEVICES SHALL HAVE A 2" GREEN BAND PAINTED ON THE CONDUIT EVERY 20'.
17. EACH INPUT SENSOR SHALL BE CONSIDERED AN INDIVIDUAL ZONE, ELECTRICALLY SUPERVISED AND INSTALLED DIRECTLY (NO SPLICES PERMITTED) TO ITS APPROPRIATE MULTIPLEXER CABINET. END-OF-LINE DEVICES SHALL HAVE A HEAT SHRINK COVERING OVER THE TERMINATION. THE USE OF WIRE-NUTS IS PROHIBITED. TAMPER SWITCH INPUTS SHALL BE CONSIDERED ADDITIONAL ZONES SEPERATE FROM THE ALARM SIGNAL INPUTS.

COMMUNICATIONS DEMOLITION NOTES:

1. REFER TO PHASING PLAN ON ARCHITECTURAL DRAWINGS PRIOR TO DEMOLITION WORK.
2. LOCATE, IDENTIFY, SEPARATE, AND COMPLETELY REMOVE AND DISPOSE OF ALL EXISTING COMMUNICATIONS CABLING WITHIN THE AREAS TO BE RENOVATED AND THE EXISTING TERMINATIONS IN THE COMMUNICATIONS CLOSETS IN ACCORDANCE WITH ELECTRICAL CODE REQUIREMENTS FOR REMOVAL OF ABANDONED CABLING.
3. OTHER ACTIVE LOW VOLTAGE CABLING (INCLUDING COMMUNICATION CABLING) SERVING AREAS NOT TO BE RENOVATED MAY BE BUNDLED AND ROUTED TO MAINTAIN CONNECTIVITY. DO NOT REMOVE OR DAMAGE ANY CABLING SERVING AREAS NOT TO BE RENOVATED.
4. ACTIVE OPTICAL FIBER AND COPPER RISER CABLES, NETWORK SWITCHES, AND OTHER ACTIVE EQUIPMENT IS PRESENT IN THE TELECOM CLOSET. DO NOT DAMAGE OR DISTURB.
5. REMOVE AND SAVE FOR OWNER'S REUSE OWNER'S EXISTING EQUIPMENT RACKS AND PATCH PANELS IN EXISTING COMMUNICATIONS CLOSET. OUTLET & STUB-UP TO BE REMOVED.

GROUNDING AND BONDING NOTES:

1. GROUNDING SYSTEMS SHALL BE INSTALLED IN ACCORDANCE WITH THE REQUIREMENTS OF THE LOCAL AUTHORITIES, AND SUBJECT TO THE APPROVAL OF THE ELECTRICAL ENGINEER.
2. ALL GROUND WIRES AND BONDING JUMPERS SHALL BE GREEN INSULATED, COPPER. ALL GROUND WIRES SHALL BE WITHOUT JOINTS AND SPICES OVER THE ENTIRE LENGTH.
3. WHERE IT IS NECESSARY TO PLACE BONDING CONDUCTORS IN FERROUS METAL CONDUIT THAT EXCEEDS 3' IN LENGTH, THE CONDUCTORS SHALL BE BONDED TO EACH END OF THE CONDUIT. OBTAIN WRITTEN AUTHORIZATION FROM ENGINEER PRIOR TO UTILIZING FERROUS METAL CONDUITS FOR GROUNDING CONDUCTORS.
4. INSTALL BONDING AND GROUNDING CONDUCTORS IN DIRECT, STRAIGHT PATHS WITH NO "SLACK" COPPER LOOPS OR EXTRA LENGTHS. BENDS SHALL BE KEPT TO A MINIMUM, AND SHALL HAVE A RADIUS OF 4", MINIMUM.
5. PROVIDE AN INSULATED, STRANDED UNINTERRUPTED BONDING CONDUCTOR BETWEEN THE TMGB AND THE NEAREST BUILDING STEEL COLUMN, IF APPLICABLE. THE BONDING CONDUCTOR SHALL BE EXOTHERMICALLY WELDED TO THE BUILDING COLUMN AND MECHANICALLY BONDED TO THE TMGB WITH A TWO HOLE LUG THAT IS HYDRAULICALLY CRIMPED ONTO THE CONDUCTOR.
6. PROVIDE AN INSULATED, STRANDED UNINTERRUPTED BONDING CONDUCTOR BETWEEN THE TMGB AND THE MAIN ELECTRICAL PANEL ALTERNATING CURRENT EQUIPMENT GROUND THAT IS SERVING THE BUILDING. THE BONDING CONDUCTOR SHALL BE MECHANICALLY BONDED TO BOTH THE TMGB AND THE GROUND BAR IN THE ELECTRICAL PANEL WITH TWO HOLE LUGS THAT ARE HYDRAULICALLY CRIMPED ONTO EACH END OF THE BONDING CONDUCTOR.
7. PROVIDE AN INSULATED, UNINTERRUPTED TELECOMMUNICATIONS BONDING BACKBONE (TGB) CONDUCTOR BETWEEN THE TMGB AND ALL THE TGBS INDICATED ON THE DRAWINGS. MECHANICALLY BOND THE TGB TO THE TMGB WITH A TWO HOLE LUG THAT IS HYDRAULICALLY CRIMPED ONTO THE END OF THE TGB. BOND EACH TGB TO THE TGB WITH AN INSULATED, STRANDED, UNINTERRUPTED BONDING CONDUCTOR. THE BONDING CONDUCTOR SHALL BE MECHANICALLY BONDED TO BOTH THE TGB AND THE TGB. AT THE TGB, UTILIZE A TWO HOLE LUG THAT IS HYDRAULICALLY CRIMPED ONTO THE END OF THE BONDING CONDUCTOR. AT THE TGB, UTILIZE A HYDRAULICALLY CRIMPED BONDING LUG. REMOVE ONLY AS MUCH INSULATION FROM THE TGB AS IS NECESSARY AND PRACTICAL TO COMPLETE THE BOND.
8. PROVIDE AN INSULATED, UNINTERRUPTED GROUNDING CONDUCTOR FROM EACH TGB TO THE NEAREST ACCESSIBLE STEEL BUILDING COLUMN, IF APPLICABLE. THE BONDING CONDUCTOR SHALL BE EXOTHERMICALLY WELDED TO THE BUILDING COLUMN AND MECHANICALLY BONDED TO THE TGB WITH A TWO HOLE LUG THAT IS HYDRAULICALLY CRIMPED ONTO THE CONDUCTOR.
9. PROVIDE AN INSULATED, UNINTERRUPTED GROUNDING CONDUCTOR FROM EACH TGB TO GROUND BAR IN THE ELECTRICAL DISTRIBUTION PANEL SERVING THE TELECOMMUNICATIONS LOADS IN THAT ROOM. THE BONDING CONDUCTOR SHALL BE MECHANICALLY BONDED TO BOTH THE TGB AND THE GROUND BAR IN THE ELECTRICAL PANEL WITH TWO HOLE LUGS THAT ARE HYDRAULICALLY CRIMPED ONTO EACH END OF THE BONDING CONDUCTOR.

SECURITY INSTALLATION NOTES:

1. ALL WIRING SHALL BE INSTALLED ACCORDING TO THE LATEST REVISION OF THE NATIONAL ELECTRIC CODE, ARTICLE 760.
2. ALL CONDUCTORS MUST TEST FREE OF OPENS, SHORTS AND GROUNDS.
3. WHEN INSTALLING SHIELDED CABLE, THE FOLLOWING MUST BE OBSERVED: A. METALLIC CONTINUITY MUST BE MAINTAINED THROUGHOUT THE ENTIRE LENGTH OF THE CABLE RUN. B. THE CABLE SHIELD MUST BE ISOLATED FROM GROUND.
4. GROUNDING MUST COMPLY WITH ARTICLE 250 OF THE NATIONAL ELECTRICAL CODE. GROUNDING CONDUCTOR MUST BE NO. 10 AWG SINGLE CONDUCTOR UNLESS OTHERWISE NOTED.

ACCESS CONTROL SYSTEM NOTES:

1. DO NOT RUN ANY AC WIRING (120VAC) IN SAME CONDUIT AS ACCESS CONTROL DATA COMMUNICATION, REQUEST TO EXIT OR DOOR CONTACT WIRING.
2. DO NOT RUN ELECTRIFIED LOCK WIRING IN SAME CONDUIT AS ACCESS CONTROL DATA COMMUNICATION WIRING.
3. AUXILIARY DEVICES SUCH AS MOTION DETECTOR REX AND ACCESS CONTROL MODULES WILL BE POWERED WITH NEW POWER SUPPLIES.

CCTV SURVEILLANCE SYSTEM NOTES:

1. MAXIMUM LENGTH FROM MASTER SERVER TO WORKSTATION COMPUTER IS 300 FEET.
2. CCTV CAMERA SHOULD NOT BE POINTED DIRECTLY AT THE SUN AS THE CCD IMAGER MAY BE PERMANENTLY DAMAGED.
3. ALL VIDEO SIGNAL CABLES SHALL BE HOMERUNS WITHOUT ANY SPLICES.
4. THE CCTV CAMERA LOCATIONS ARE SHOWN FOR INTENT. FINAL CAMERA MOUNTING LOCATIONS TO BE APPROVED BY CLIENT.


COMMUNICATIONS PATHWAY NOTES:

1. CONDUITS AND SLEEVES ARE SHOWN DIAGRAMMATICALLY AS COMMUNICATION PATHWAY REQUIREMENTS. EXACT ROUTING, BENDS, PULL-BOX LOCATIONS, ETC. ARE SUBJECT TO FIELD CONDITIONS AND SHALL BE COORDINATED WITH ELECTRICAL ENGINEER. REFER TO ELECTRICAL DRAWINGS FOR DETAILS.
2. COMMUNICATIONS CONDUIT RUNS SHALL BE INSTALLED WITH:
- 2.1. NO BEND IN EXCESS OF 90-DEGREES,
- 2.2. NO AGGREGATE OF BENDS GREATER THAN 180-DEGREES BETWEEN PULL BOXES OR PULL POINTS,
- 2.3. NO CONTINUOUS SECTION IN EXCESS OF 100',
- 2.4. NO BENDS OCCURRING WITHIN PULL BOXES.
3. COMMUNICATIONS CONDUIT BENDS SHALL BE INSTALLED WITH:
- 3.1. A BEND RADIUS OF 6-TIMES THE CONDUIT'S INNER DIAMETER FOR CONDUITS 2 TRADE SIZE OR SMALLER,
- 3.2. A BEND RADIUS OF 10-TIMES THE CONDUIT'S INNER DIAMETER FOR CONDUITS GREATER THAN 2 TRADE SIZE.
4. COMMUNICATIONS CONDUIT SYSTEM SHALL BE PROPERLY BONDED IN ACCORDANCE WITH ALL NATIONAL OR LOCAL REQUIREMENTS.
5. ELECTRICAL CONTRACTOR SHALL SUBMIT SHOP DRAWINGS OF FIELD-COORDINATED TELECOM PATHWAYS TO ELECTRICAL ENGINEER AND TELECOM ENGINEER FOR REVIEW AND APPROVAL.


TELECOMMUNICATIONS AND ELECTRICAL DIVISION OF WORK

EQUIPMENT	SUPPLY	INSTALLATION	REMARKS
FACEPLATES	TC	TC	
HORIZONTAL CABLING AND CONNECTORS	TC	TC	
DEVICE CONDUIT	EC	EC	INCLUDING FLEX CONDUIT BETWEEN BACK BOX AND DEVICES
BACK BOXES, STUB UPS, AND ENCLOSURES	EC	EC	
J-HOOKS	TC	TC	
BACKBONE CABLING AND CONNECTORS	TC	TC	
CONDUIT PATHWAYS AND SLEEVES	EC	EC	INCLUDING GROUNDING AND BONDING
CABLE TRAY	TC	TC	INCLUDING LOCAL GROUNDING AND BONDING
LADDER RACK INSIDE TELECOM SPACES	TC	TC	INCLUDING LOCAL GROUNDING AND BONDING
RACKS AND CABINETS	TC	TC	INCLUDING LOCAL GROUNDING AND BONDING
RACK AND CABINET POWER STRIPS	TC	TC	
PATCH/WORK AREA/CROSSCONNECT CORDS	TC	TC	
PLYWOOD BACKBOARDS	TC	TC	
TERMINATION HARDWARE	TC	TC	
GROUNDING AND BONDING BUSBARS AND BACKBONES	EC	EC	
FIRESTOPPING	TC	TC	INCLUDES CONDUITS, SLEEVES, AND MECHANICAL FIRESTOPS AS SHOWN ON DRAWINGS
J-HOOKS	TC	TC	
LABELING	TC	TC	
TESTING	TC	TC	
TC = TELECOMMUNICATIONS CONTRACTOR			
EC = ELECTRICAL CONTRACTOR			

THESE PLANS ARE APPROVED ONLY FOR THE WORK INDICATED ON THE APPLICATION SPECIFICATION SHEET. ALL OTHER MATTERS SHOWN ARE NOT TO BE RELIED UPON OR TO BE CONSIDERED AS EITHER BENDS APPROVED OR IN ACCORDANCE WITH APPLICABLE CODES.

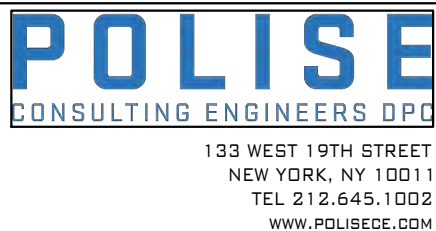

CONSULTANT SEAL		CONSULTANT INFORMATION			
		<div>Graf & Lewent Architects LLP</div> <div>90-30 161st Street, Jamaica, NY 11432</div> <div>P: 718-651-6200 F: 718-251-6989</div>			
2	06/28/2021				ADDENDUM #2
1	06/21/2021				ADDENDUM #1
REVISION NUMBER	DATE	MADE BY	APPD BY	REVISION	
RECORD DRAWING CERTIFICATION					
<input type="checkbox"/> AS BUILT - CHANGES AS NOTED					
<input type="checkbox"/> AS BUILT - NO CHANGES					
CONTRACTOR			CONTRACTOR		
NAME: _____			NAME: _____		
SIGNATURE: _____			SIGNATURE: _____		
TITLE: _____			TITLE: _____		
DATE: _____			DATE: _____		
WESTCHESTER COUNTY, NEW YORK					
DEPARTMENT OF PUBLIC WORKS AND TRANSPORTATION					
DIVISION OF ENGINEERING					
LOW RISE BUILDING RENOVATIONS AND HVAC IMPROVEMENTS					
110 DR. MARTIN LUTHER KING, JR. BOULEVARD					
WHITE PLAINS, NEW YORK 10601					
TELECOMMUNICATIONS GENERAL NOTES					
CONTRACT NUMBER		SHEET NUMBER			
19-514		T-002			
SHEET NO. 2		OF 10			
SCALE: AS NOTED					
DATE: MAY 20, 2021					
DPW FILE NO.					
52-01-T-618-0				REV NO. 0	

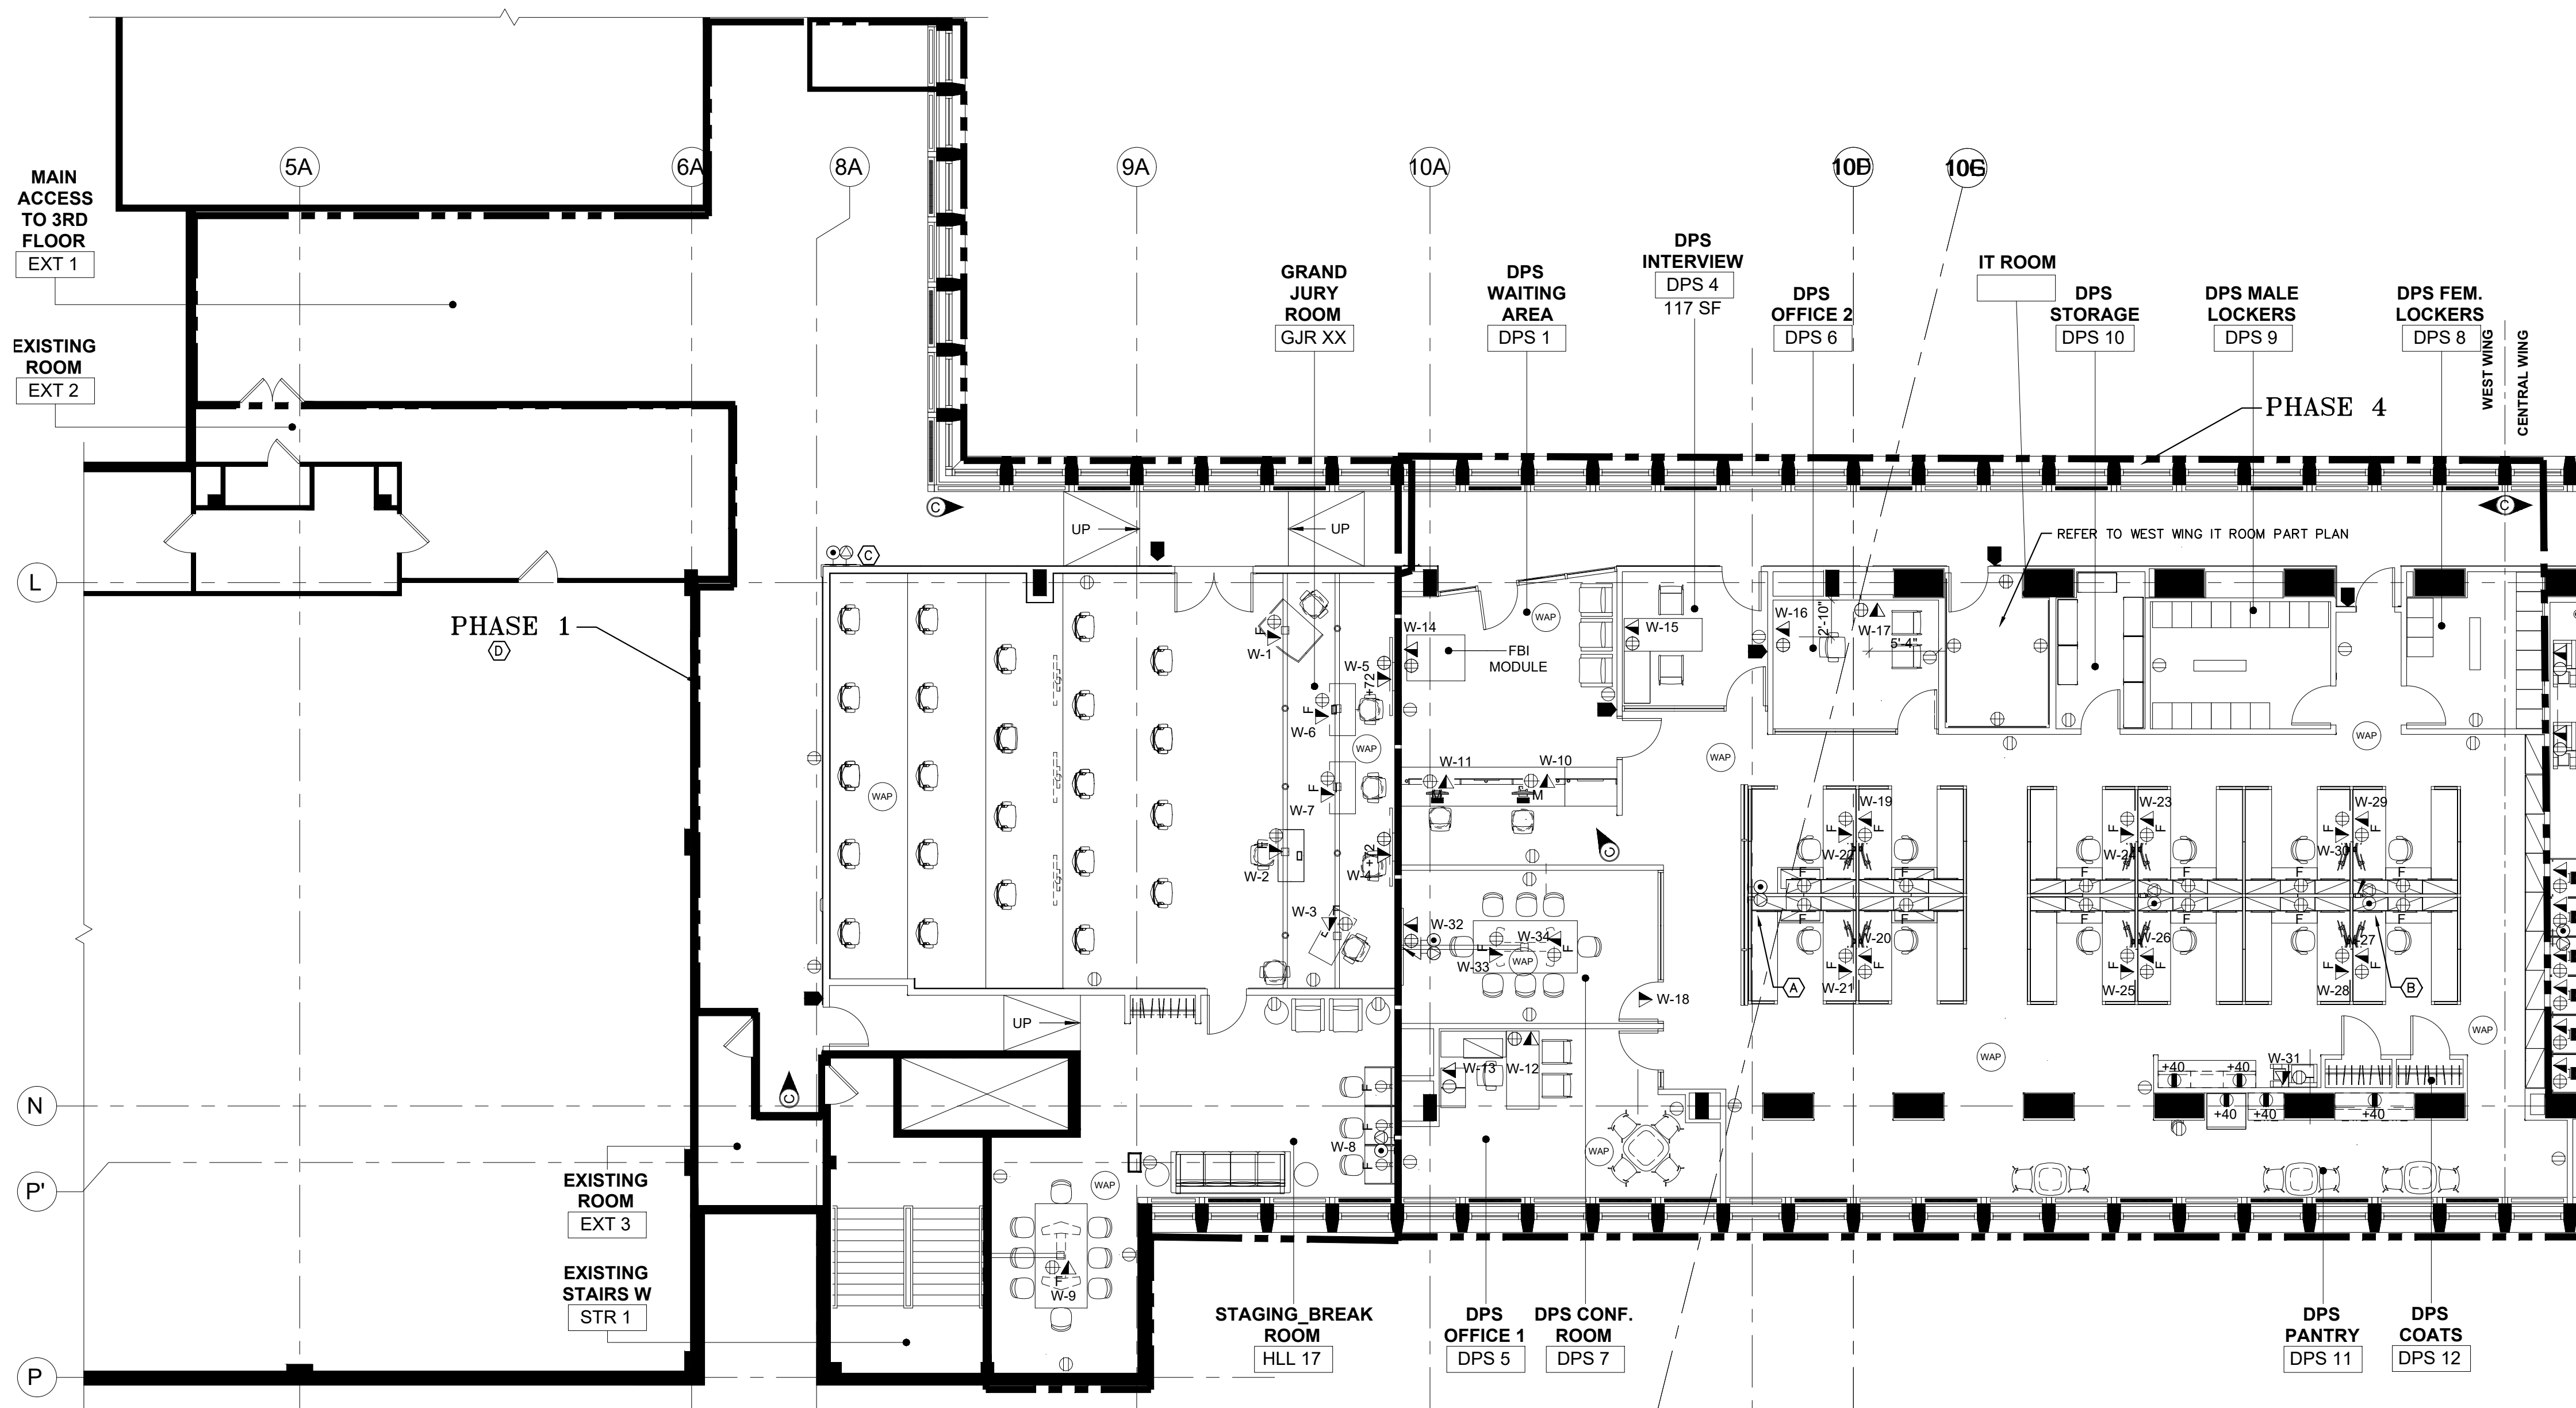

GENERAL NOTES

1. DRAWINGS INDICATE GENERAL ARRANGEMENT OF SYSTEMS AND WORK. FOLLOW DRAWINGS IN LAYING OUT WORK AND CHECK DRAWINGS OF OTHER TRADES TO VERIFY SPACE CONDITIONS, MAINTAIN HEADROOM AND SPACE CONDITIONS.
2. REFER TO PHASING NOTES ON ELECTRICAL AND ARCHITECTURAL DRAWINGS FOR ALL PHASING DETAILS.
3. OUTLET IDENTIFICATION NUMBERING SHALL COMPLY WITH IT DEPARTMENT REQUIREMENTS, EACH CABLEING SHALL BE TAGGED AT ALL TERMINATION POINTS.
4. IDENTIFY ALL INFEE LOCATIONS WITH FURNITURE MANUFACTURER AND ELECTRICAL CONTRACTOR PRIOR TO WORK COMMENCING.
5. PROVIDE ADEQUATE SUPPORT ABOVE CEILING FOR CABLES, PROVIDE CABLE TRAY AS APPLICABLE,

KEY NOTES

- (A) WORKSTATIONS SHALL BE SERVED FROM ABOVE CEILING AND CABLE DROP INSIDE ALUMINUM ENCLOSURES PROVIDED AS PART OF THE GLASS PARTITIONS. ENSURE CABLE IS SUPPORTED JUST ABOVE THE ALUMINUM COLUMN AND AS IT LEAVES THE COLUMN TO ENTER THE WORK STATION, (2) COLUMNS ARE PROVIDED PER GLASS WALL SECTION. COORDINATE WITH ELECTRICIAN ENCLOSURE TO BE USED FOR DATA.
- (B) WORKSTATIONS SHALL BE SERVED FROM ABOVE CEILING AND CABLE DROP INSIDE DATA POLE ENCLOSURES PROVIDED BY OTHERS, DATA POLE INTEGRAL TO FURNITURE SYSTEM AND MAY REQUIRE FIELD MODIFICATION TO SUIT ROOM HEIGHTS.
- (C) COORDINATE CABLE RUN FOR WALL DISPLAY DATA OUTLET.
- (D) PHASE 1 NOTE: ALL CABLEING SERVING DEVICES TO BE INSTALLED AS PART OF PHASE 1 SHALL BE TERMINATED IN CENTRAL IT ROOM, IN A DEDICATED PATCH PANEL. AT COMPLETION OF WEST IT ROOM DURING PHASE 4, THESE CABLES SHALL BE TERMINATED IN WEST WING IT ROOM.

CONSULTANT SEAL

CONSULTANT INFORMATION

Graf & Lewent

Architects LLP

90-30 161st Street, Jamaica, NY 11432

P: 718-651-6200 F: 718-251-6989

2	06/28/2021			ADDENDUM #2	
1	06/21/2021			ADDENDUM #1	
REVISION NUMBER	DATE	MADE BY	APP'D BY	REVISION	

RECORD DRAWING CERTIFICATION


☐ AS BUILT - CHANGES AS NOTED

☐ AS BUILT - NO CHANGES

CONTRACTOR			CONTRACTOR		
NAME: _____			NAME: _____		
SIGNATURE: _____			SIGNATURE: _____		
TITLE: _____ DATE: _____			TITLE: _____ DATE: _____		

WESTCHESTER COUNTY, NEW YORK			<table><tr><td>CONTRACT NUMBER 19-514</td><td rowspan="2">T-101</td></tr><tr><td>SHEET NO. 03 OF 10</td></tr><tr><td colspan="2">SCALE: AS NOTED</td></tr><tr><td colspan="2">DATE: MAY 20, 2021</td></tr><tr><td>DPW FILE NO. 52-01-T-619-0</td><td>(RE) (NO)</td></tr></table>			CONTRACT NUMBER 19-514	T-101	SHEET NO. 03 OF 10	SCALE: AS NOTED		DATE: MAY 20, 2021		DPW FILE NO. 52-01-T-619-0	(RE) (NO)
CONTRACT NUMBER 19-514	T-101													
SHEET NO. 03 OF 10														
SCALE: AS NOTED														
DATE: MAY 20, 2021														
DPW FILE NO. 52-01-T-619-0	(RE) (NO)													
DEPARTMENT OF PUBLIC WORKS AND TRANSPORTATION														
DIVISION OF ENGINEERING														
LOW RISE BUILDING RENOVATIONS AND HVAC IMPROVEMENTS														
110 DR. MARTIN LUTHER KING, JR. BOULEVARD														
WHITE PLAINS, NEW YORK 10601														
TELECOMMUNICATIONS PLAN - 3RD FLOOR WEST WING														

POLISE
CONSULTING ENGINEERS OPC
133 WEST 19TH STREET
NEW YORK, NY 10011
TEL 212.645.1002
WWW.POLISECE.COM

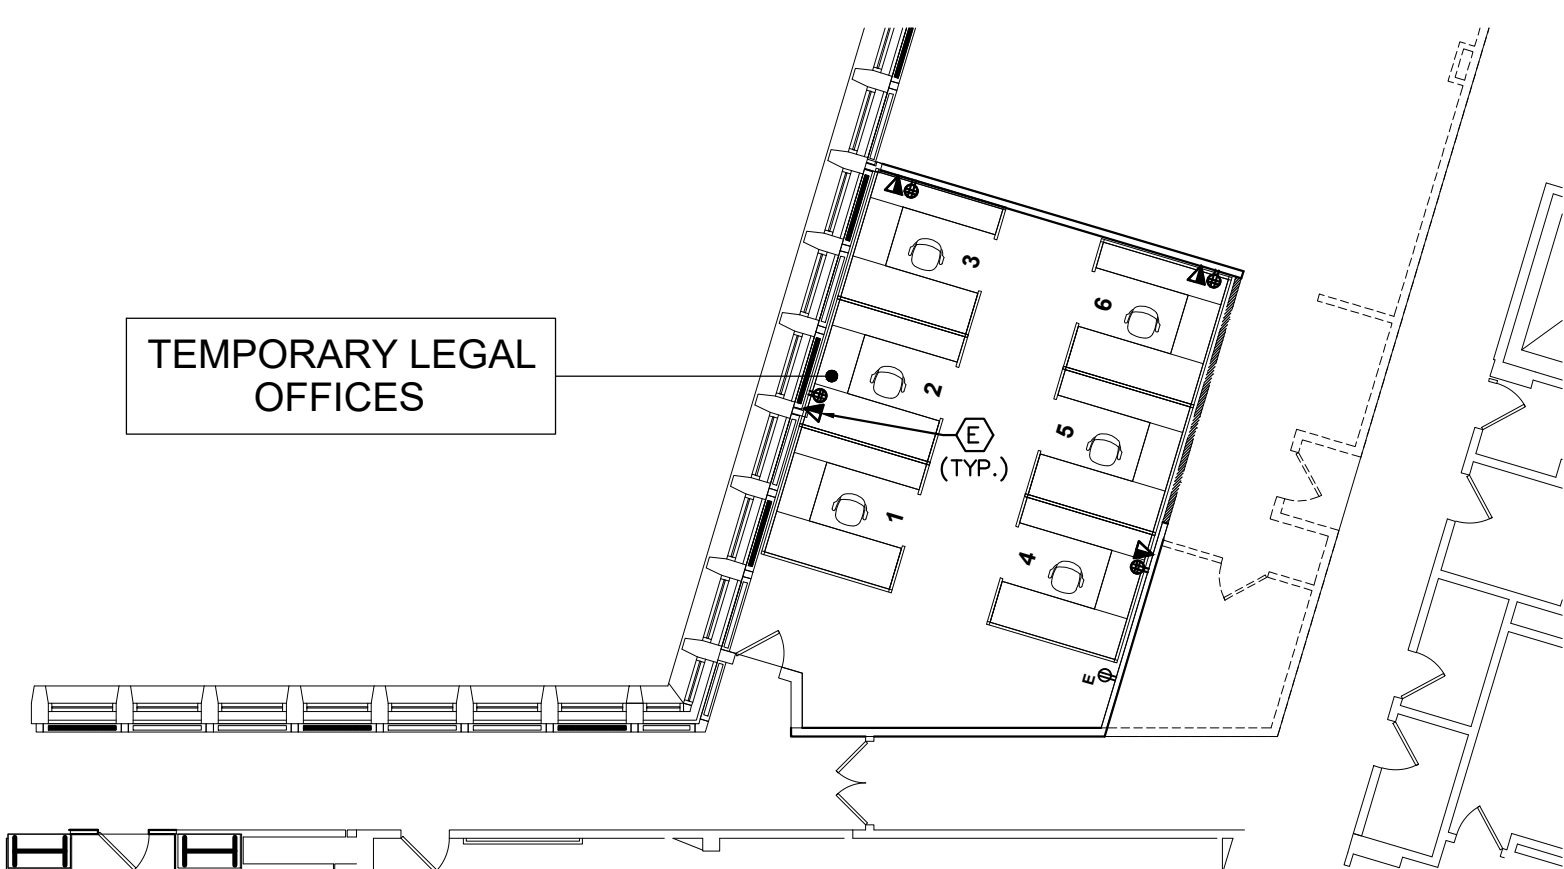

AREA TO BE BUILT IN THIS PHASE

TEMPORARY COUNTY CLERK'S OFFICE


EXISTING DEPARTMENT OF LAND RECORDS







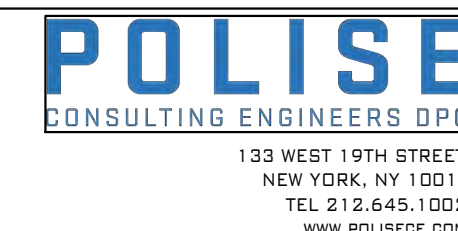


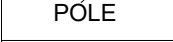



EXISTING NORTH WING CORRIDOR

The site plan shows a rectangular building layout. The top portion is labeled 'AREA TO BE BUILT IN THIS PHASE' and contains several rooms, some with dimensions like '4.0' and '3.0'. The bottom portion is labeled 'EXISTING DEPARTMENT OF LAND RECORDS'. A central area is labeled 'TEMPORARY COUNTY CLERK'S OFFICE'. To the right, an 'EXISTING NORTH WING CORRIDOR' is shown. A specific room is marked with a circled 'E' and '(TYP.)'. The building is situated between a road on the left and a corridor on the right.

[illegible]

THESE PLANS ARE APPROVED ONLY FOR THE WORK INDICATED ON THE APPLICATION SPECIFICATION SHEET. ALL OTHER MATTERS SHOWN ARE NOT TO BE RELIED UPON OR TO BE CONSIDERED AS EITHER BEING APPROVED OR IN ACCORDANCE WITH APPLICABLE CODES.







COMMUNICATIONS PLAN LEGEND	
SYMBOL	DESCRIPTION
	WALL MOUNTED COMMUNICATIONS OUTLET
	FLOOR MOUNTED COMMUNICATIONS OUTLET
	WALL MOUNTED COMMUNICATIONS OUTLET
	FLOOR MOUNTED ELEC AND COMMUNICATIONS OUTLET
	COMMUNICATIONS OUTLET IN FURNITURE PROVIDED BY FURNITURE MANUFACTURER
	QUAD AND DATA OUTLETS SURFACE MOUNTED IN MILLWORK
	FLOOR ELEC/DATA FEED FOR FURNITURE WHIP
	WALL ELEC/DATA FEED FOR FURNITURE WHIP
	POLE ELEC/DATA FEED FOR FURNITURE WHIP
	WALL MOUNTED DISPLAY (AV)
	CARD READER
	CAMERA - CEILING MOUNTED ORIENTATION
	WIRELESS ACCESS POINT

1. DRAWINGS INDICATE GENERAL ARRANGEMENT OF SYSTEMS AND WORK. FOLLOW DRAWINGS IN LAYING OUT WORK AND CHECK DRAWINGS OF OTHER TRADES TO VERIFY SPACE CONDITIONS. MAINTAIN HEADROOM AND SPACE CONDITIONS.
2. REFER TO PHASING NOTES ON ELECTRICAL AND ARCHITECTURAL DRAWINGS FOR ALL PHASING DETAILS.
3. OUTLET IDENTIFICATION NUMBERING SHALL COMPLY WITH IT DEPARTMENT REQUIREMENTS. EACH CABLEING SHALL BE TAPPED AT ALL TERMINATION POINTS.
4. IDENTIFY ALL INFEED LOCATIONS WITH FURNITURE MANUFACTURER AND ELECTRICAL CONTRACTOR PRIOR TO WORK COMMENCING.
5. PROVIDE ADEQUATE SUPPORT ABOVE CEILING FOR CABLES. PROVIDE CABLE TRAY AS APPLICABLE.

- (A) WORKSTATIONS AND FURNITURE ADJACENT TO PERIMETER FAN COILS SHALL BE SERVED FROM ABOVE CEILING, DROPPED DOWN IN FURRED OUT EXTERIOR MULLION, AND RUN PARALLEL TO EXTERIOR WALL FLUSH TO THE FLOOR WITHIN FAN COIL ENCLOSURE UNTIL THE CABLE REACHES THE LOCATION OF THE FURNITURE HARBOUR BOX. COORDINATE CABLE RUN WITH ELECTRICIAN.
- (B) WORKSTATIONS SHALL BE SERVED FROM ABOVE CEILING AND CABLE DROP INSIDE OF GLASS ENCLOSURES PROVIDED BY OTHERS. DATA POLE INTEGRAL TO FURNITURE SYSTEM AND MAY REQUIRE FIELD MODIFICATION TO SUIT ROOM HEIGHTS.
- (C) EXISTING SERVER RACK. COORDINATE ALL DEMOLITION WORK WITH OTHER TRADES AND IT DEPARTMENT.
- (D) EXISTING SECURITY WALL FIELD. COORDINATE ALL DEMOLITION WORK WITH OTHER TRADES AND SECURITY CONTRACTOR.
- (E) COORDINATE TERMINATION OF DATA CABLES WITH IT DEPARTMENT PRIOR TO DEMOLITION WORK COMMENCING.

CONSULTANT SEAL		CONSULTANT INFORMATION	
<h1 style="margin: 0;">Graf & Lewent</h1> <h2 style="margin: 0;">Architects LLP</h2> <p style="margin: 10px 0;">90-30 161st Street, Jamaica, NY 11432 P: 718-651-6200 F: 718-251-6989</p>			
2	06/28/2021		ADDENDUM #2
1	06/21/2021		ADDENDUM #1
REVISION NUMBER	DATE	MADE BY	APP'D BY
REVISION			
RECORD DRAWING CERTIFICATION			
<input type="checkbox"/> AS BUILT - CHANGES AS NOTED <input type="checkbox"/> AS BUILT - NO CHANGES			
CONTRACTOR		CONTRACTOR	
NAME: _____		NAME: _____	
SIGNATURE: _____		SIGNATURE: _____	
TITLE: _____ DATE: _____		TITLE: _____ DATE: _____	
WESTCHESTER COUNTY, NEW YORK DEPARTMENT OF PUBLIC WORKS AND TRANSPORTATION DIVISION OF ENGINEERING LOW RISE BUILDING RENOVATIONS AND HVAC IMPROVEMENTS 110 DR. MARTIN LUTHER KING, JR. BOULEVARD WHITE PLAINS, NEW YORK 10601 TELECOMMUNICATIONS PLAN - 3RD FLOOR NORTH WING			
CONTRACT NUMBER 19-514		SHEET NUMBER T-103	
SHEET NO. 05 OF 10		SCALE: AS NOTED	
DATE: MAY 20, 2021		DWG FILE NO. 52-01-T-621-0	
		(REVISIONS)	

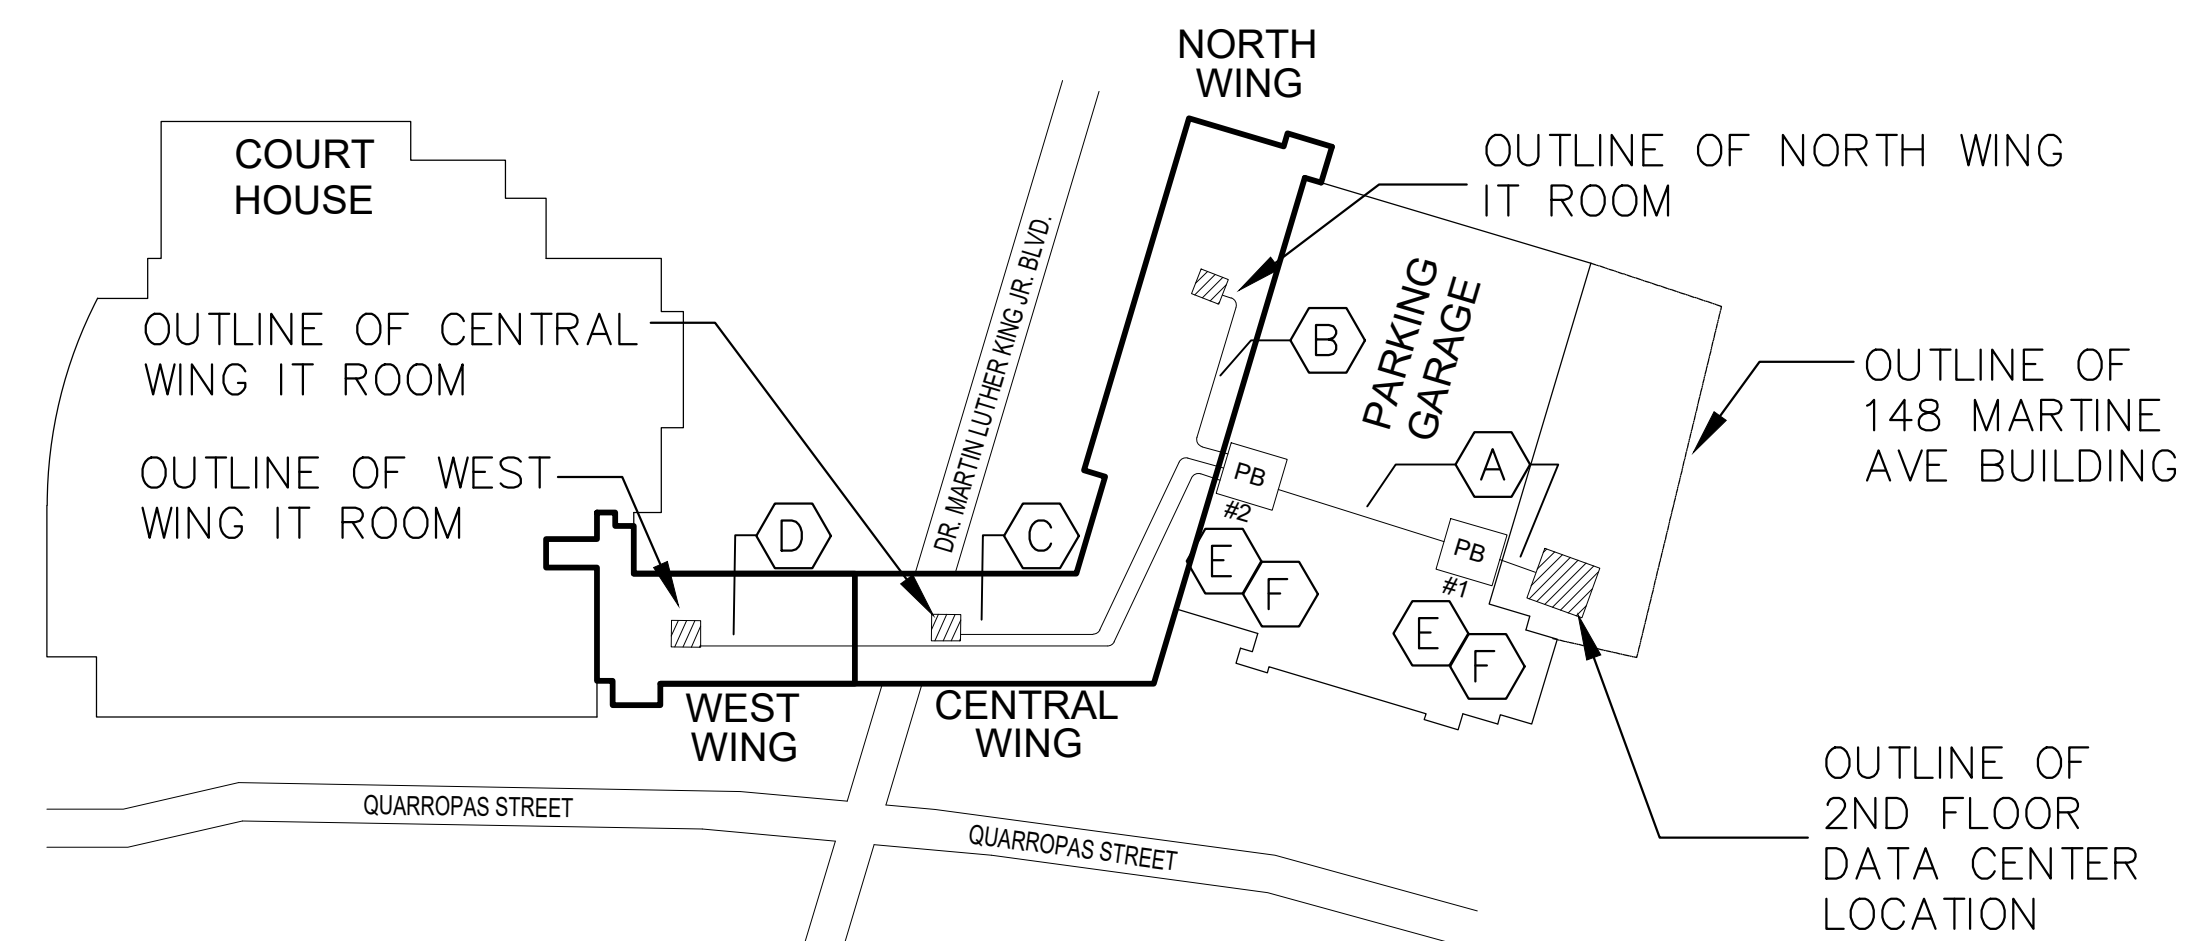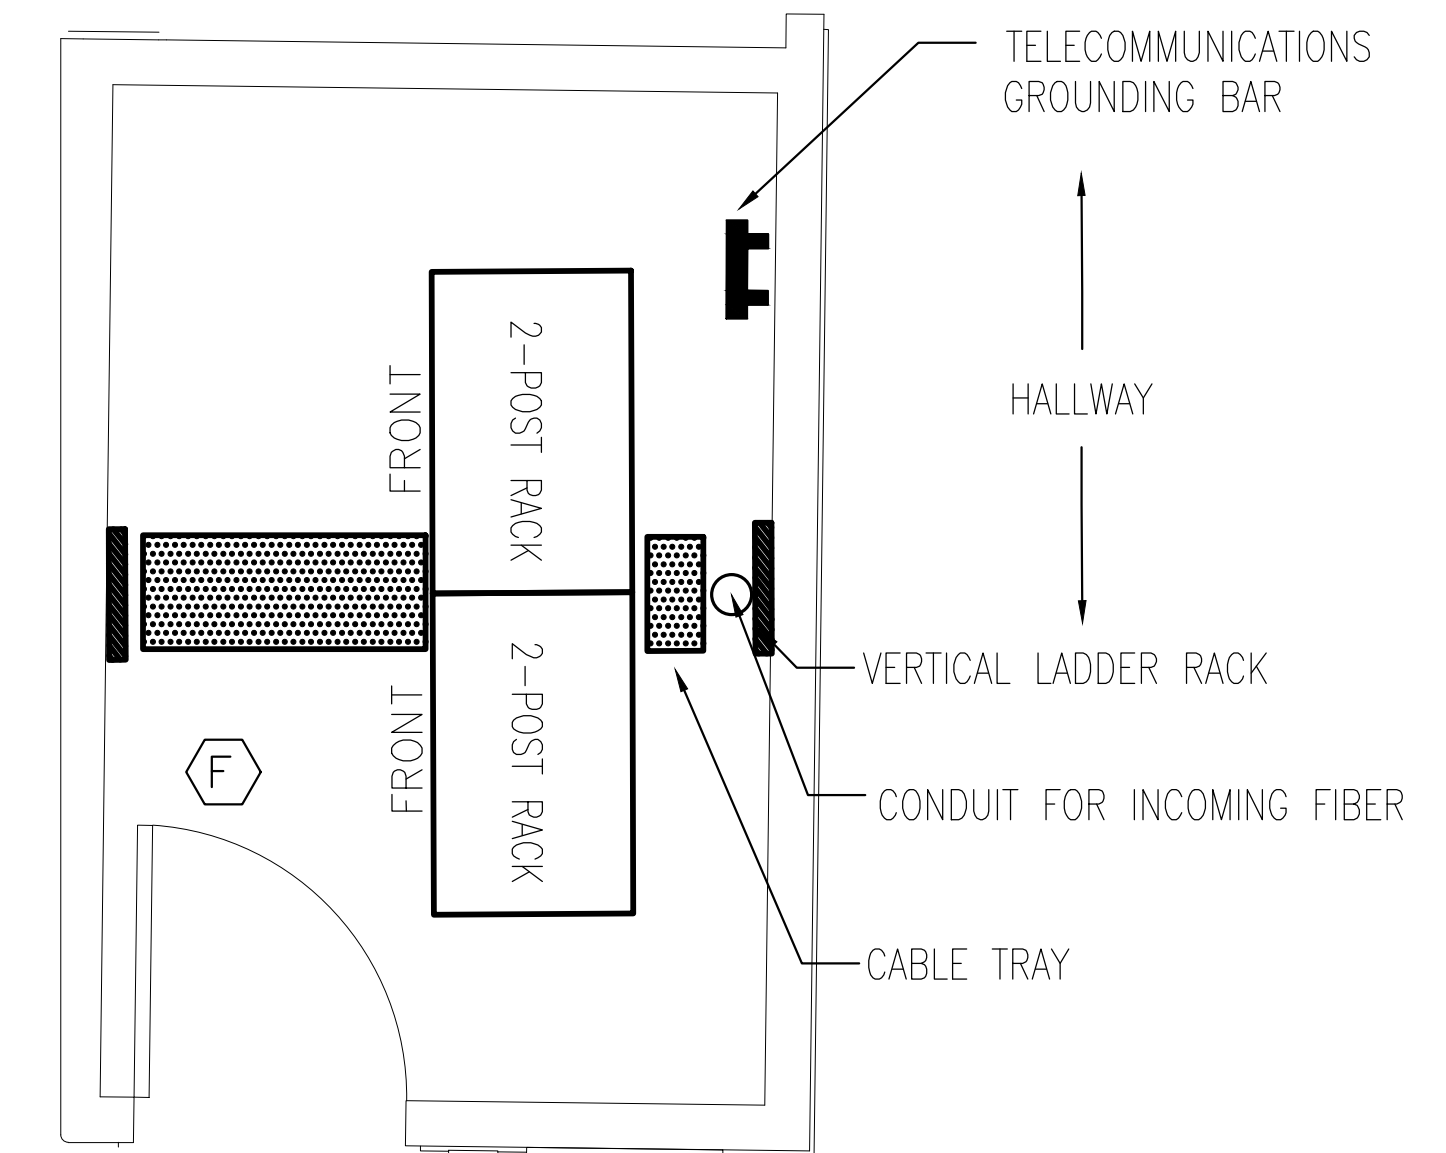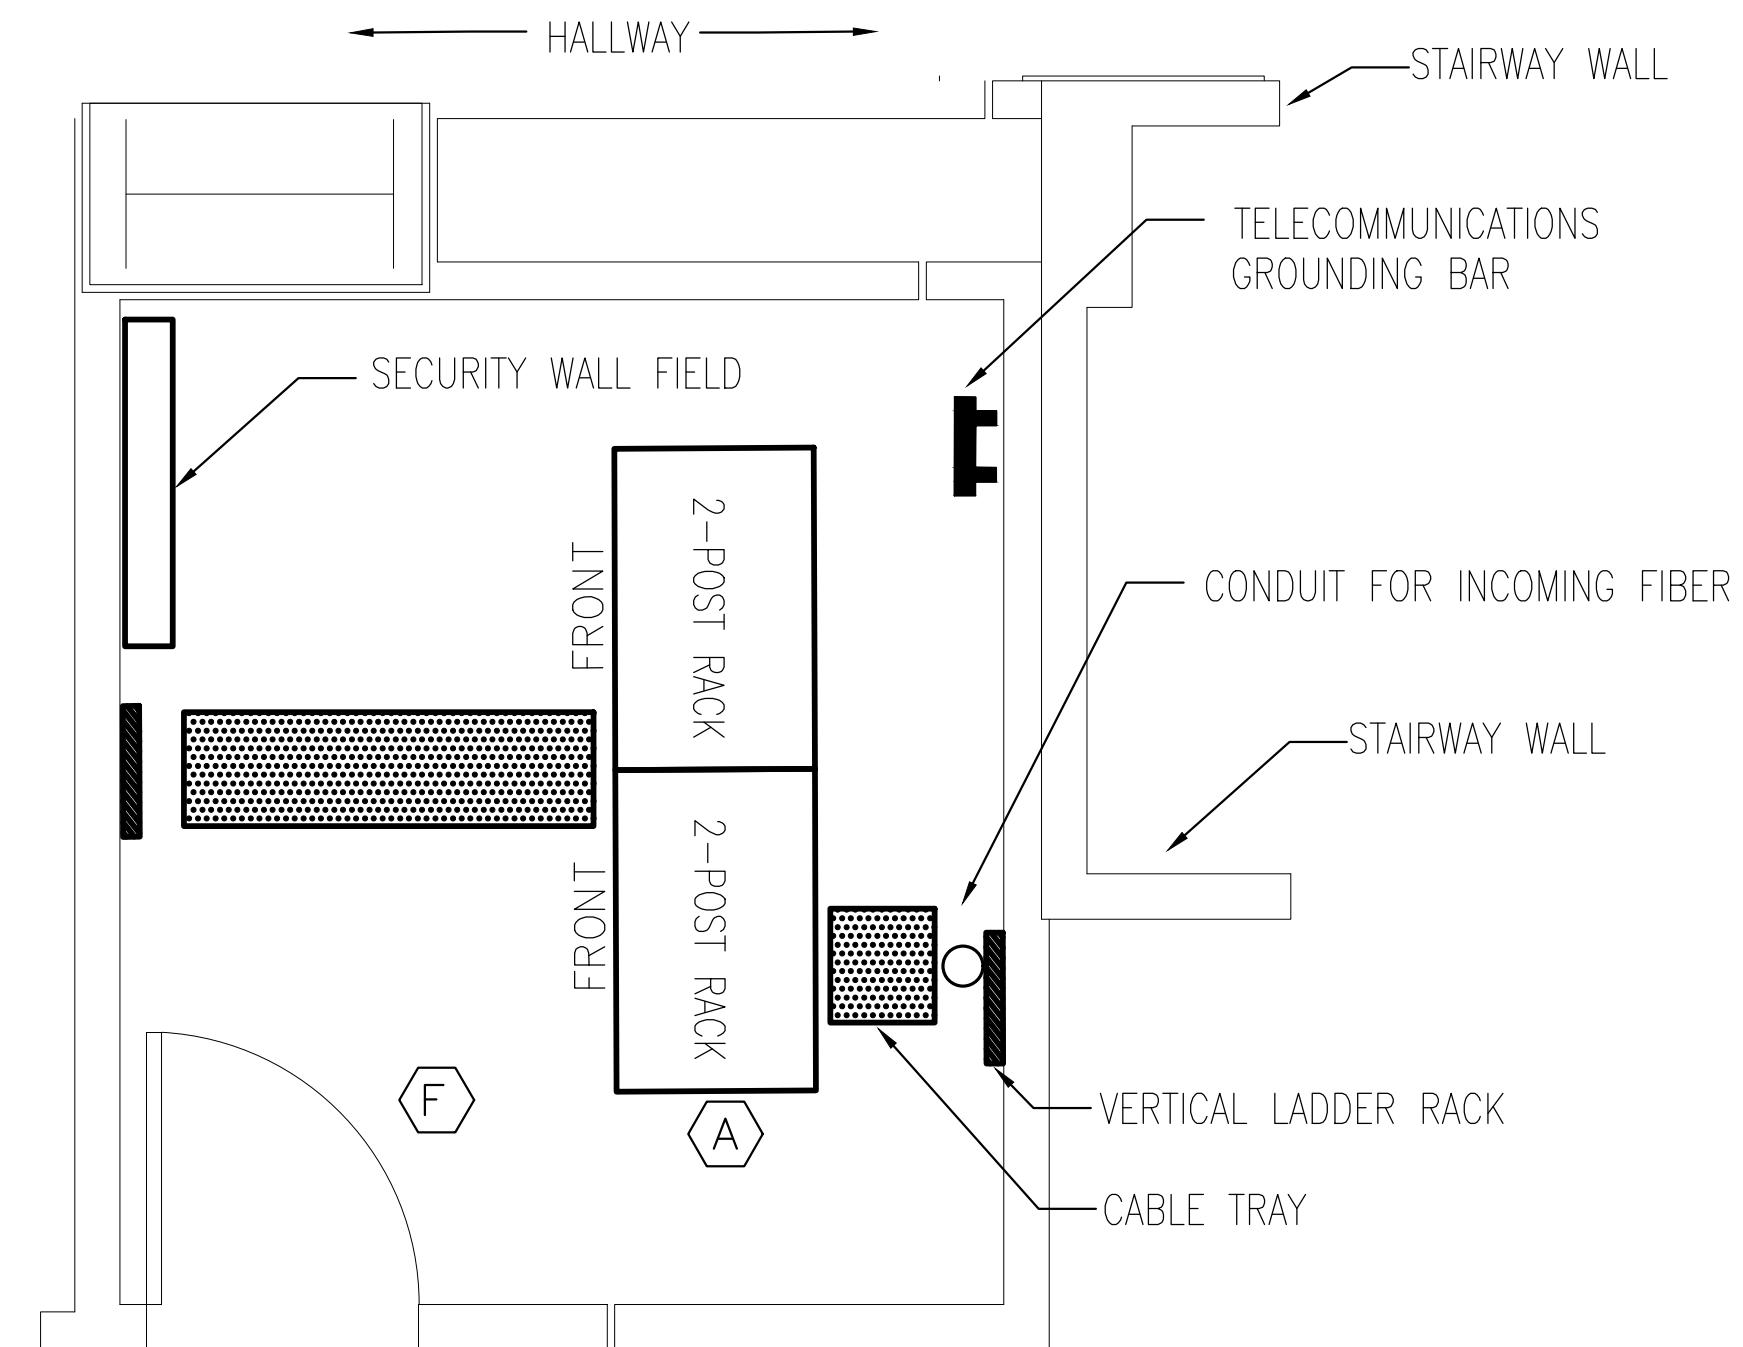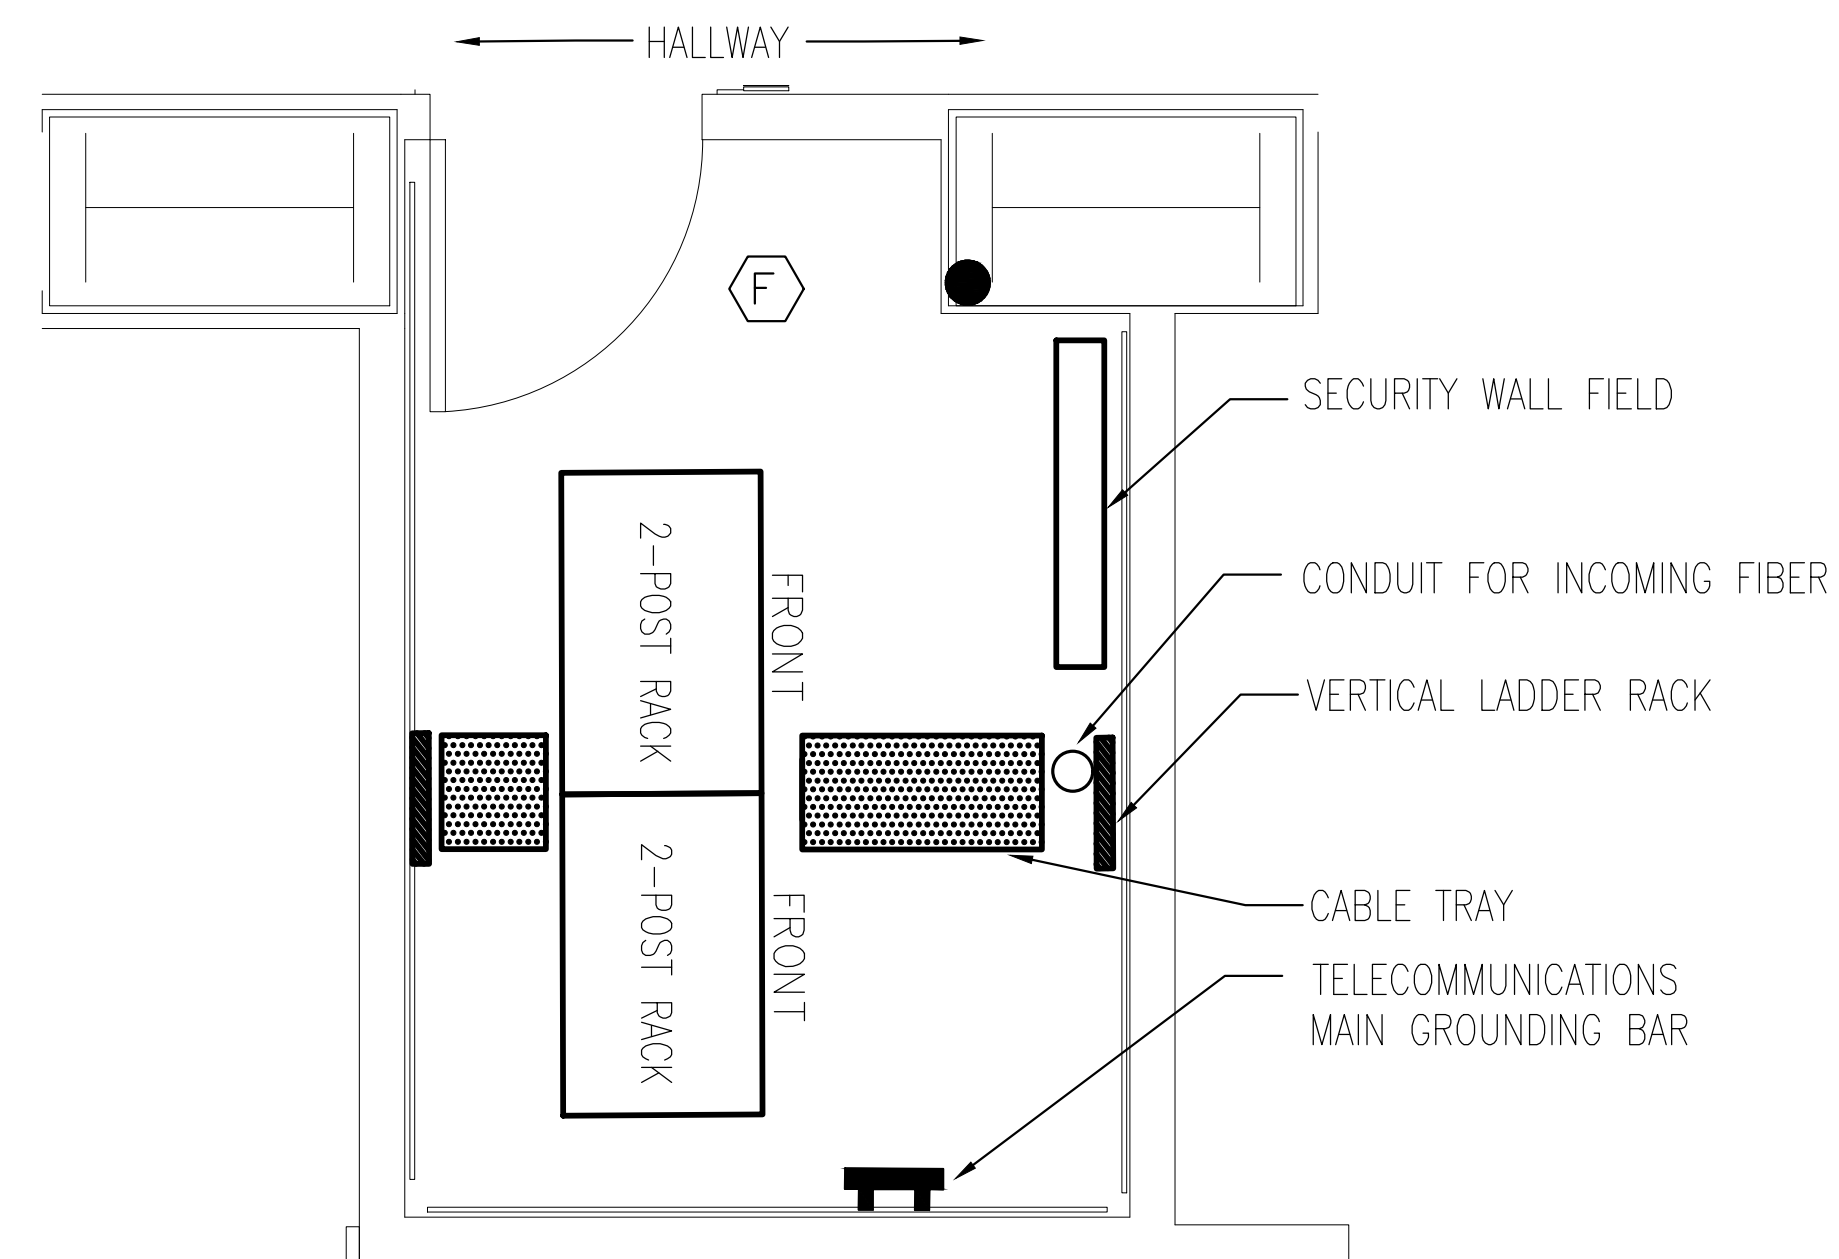

KEY NOTES





- (A) PROVIDE (1) 2" RGS CONDUIT, APPROX. 250 FEET FROM DATA CENTER TO PB #2.
- (B) PROVIDE (1) 1" C TO NORTH WING IT ROOM, APPROX. 100 FEET FROM PB #2.
- (C) PROVIDE (1) 1" C TO CENTRAL WING IT ROOM, APPROX. 150 FEET FROM PB #2.
- (D) PROVIDE (1) 1" C TO WEST WING IT ROOM, APPROX. 200 FEET FROM PB #2.
- (E) PULLBOX INSTALLED AT GARAGE LEVEL CEILING DECK. SIZE AS REQUIRED BY CODE.
- (F) PROVIDE SHOP DRAWING WITH CONDUIT PATH AND IT ROOM LAYOUT FOR ENGINEER APPROVAL PRIOR TO WORK COMMENCING.REFER TO T-400 FOR ELEVATION.

THESE PLANS ARE APPROVED ONLY FOR THE WORK INDICATED ON THE APPLICATION SPECIFICATION SHEET. ALL OTHER MATTERS SHOWN ARE NOT TO BE RELIED UPON OR TO BE CONSIDERED AS EITHER BEING APPROVED OR IN ACCORDANCE WITH APPLICABLE CODES.

POLISE
CONSULTING ENGINEERS DPO


133 WEST 19TH STREET
NEW YORK, NY 10011
TEL 212.645.1002
WWW.POLISECE.COM

CONSULTANT SEAL		CONSULTANT INFORMATION									
<h1 style="margin: 0;">Graf & Lewent</h1> <h2 style="margin: 0;">Architects LLP</h2> <p style="margin: 10px 0 0 0;">90-30 161st Street, Jamaica, NY 11432 P: 718-651-6200 F: 718-251-6989</p>											
2	06/28/2021		ADDENDUM #2								
1	06/21/2021		ADDENDUM #1								
REVISION NUMBER	DATE	MADE BY	REVISION								
RECORD DRAWING CERTIFICATION											
<input type="checkbox"/> AS BUILT - CHANGES AS NOTED <input type="checkbox"/> AS BUILT - NO CHANGES											
CONTRACTOR		CONTRACTOR									
NAME: _____		NAME: _____									
SIGNATURE: _____		SIGNATURE: _____									
TITLE: _____ DATE: _____		TITLE: _____ DATE: _____									
WESTCHESTER COUNTY, NEW YORK DEPARTMENT OF PUBLIC WORKS AND TRANSPORTATION DIVISION OF ENGINEERING		<table border="1" style="width: 100%; border-collapse: collapse;"> <tr> <td style="width: 50%; font-size: x-small;">CONTRACT NUMBER 19-514</td> <td style="width: 50%; font-size: x-small;">SHEET NUMBER T-104</td> </tr> <tr> <td colspan="2" style="font-size: x-small;">SHEET NO. 6 OF 10</td> </tr> <tr> <td colspan="2" style="font-size: x-small;">SCALE: AS NOTED DATE: MAY 20, 2021</td> </tr> <tr> <td style="font-size: x-small;">DPW FILE NO. 52-01-T-622-0</td> <td style="font-size: x-small;">REV NO. 0</td> </tr> </table>		CONTRACT NUMBER 19-514	SHEET NUMBER T-104	SHEET NO. 6 OF 10		SCALE: AS NOTED DATE: MAY 20, 2021		DPW FILE NO. 52-01-T-622-0	REV NO. 0
CONTRACT NUMBER 19-514	SHEET NUMBER T-104										
SHEET NO. 6 OF 10											
SCALE: AS NOTED DATE: MAY 20, 2021											
DPW FILE NO. 52-01-T-622-0	REV NO. 0										
LOW RISE BUILDING RENOVATIONS AND HVAC IMPROVEMENTS 110 DR. MARTIN LUTHER KING, JR. BOULEVARD WHITE PLAINS, NEW YORK 10601											
TELECOMMUNICATIONS PART WORKS											

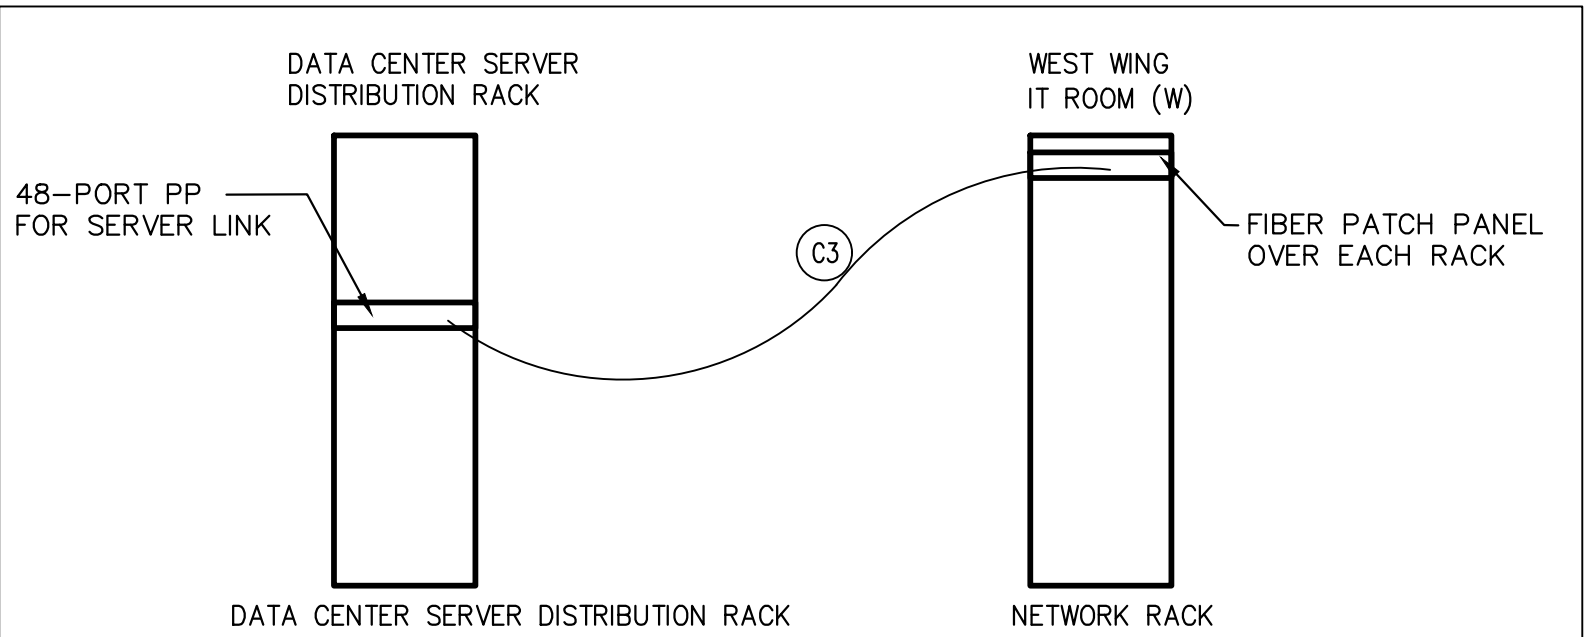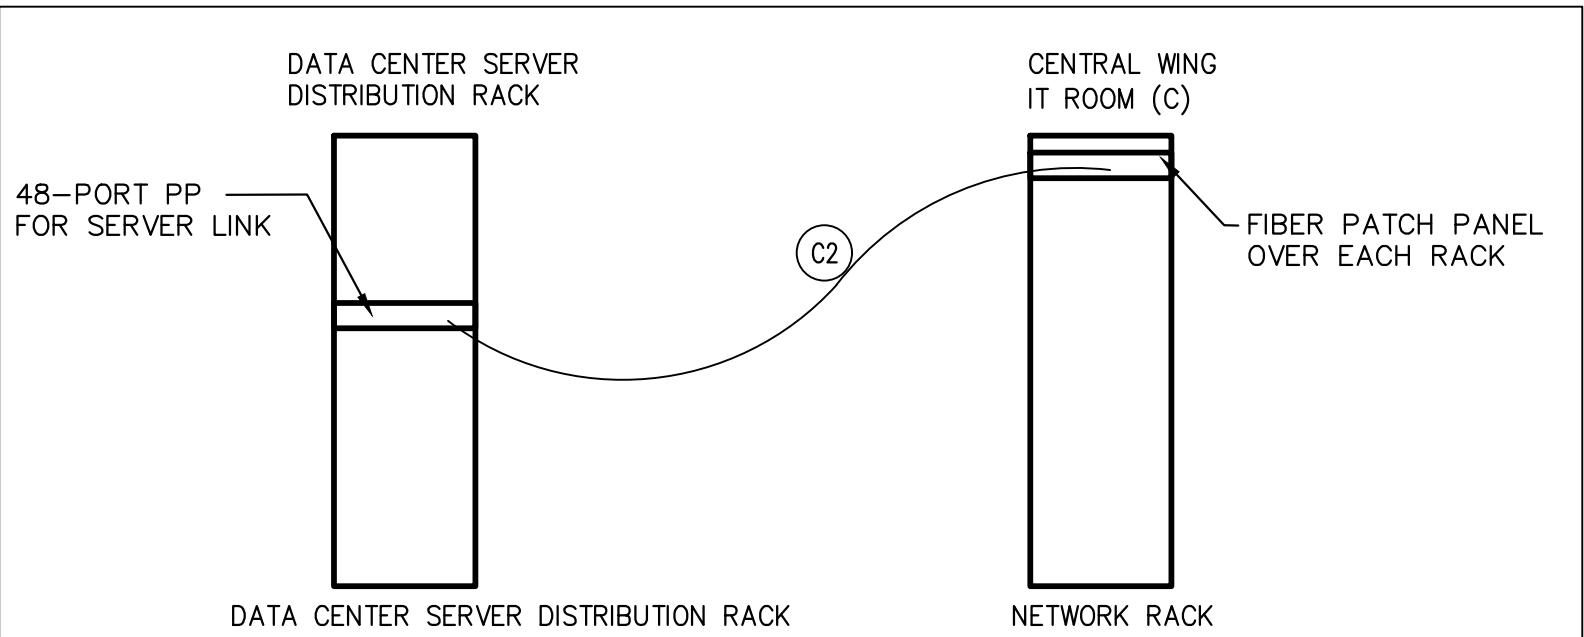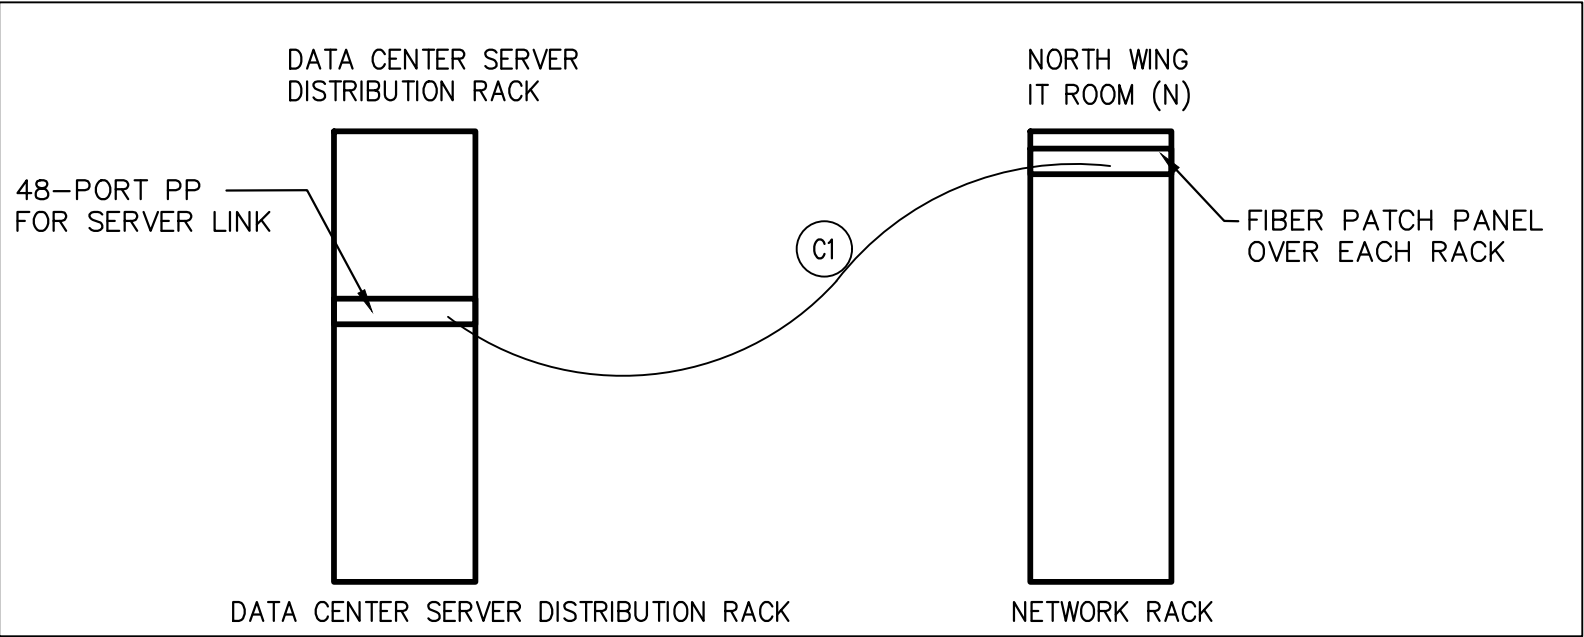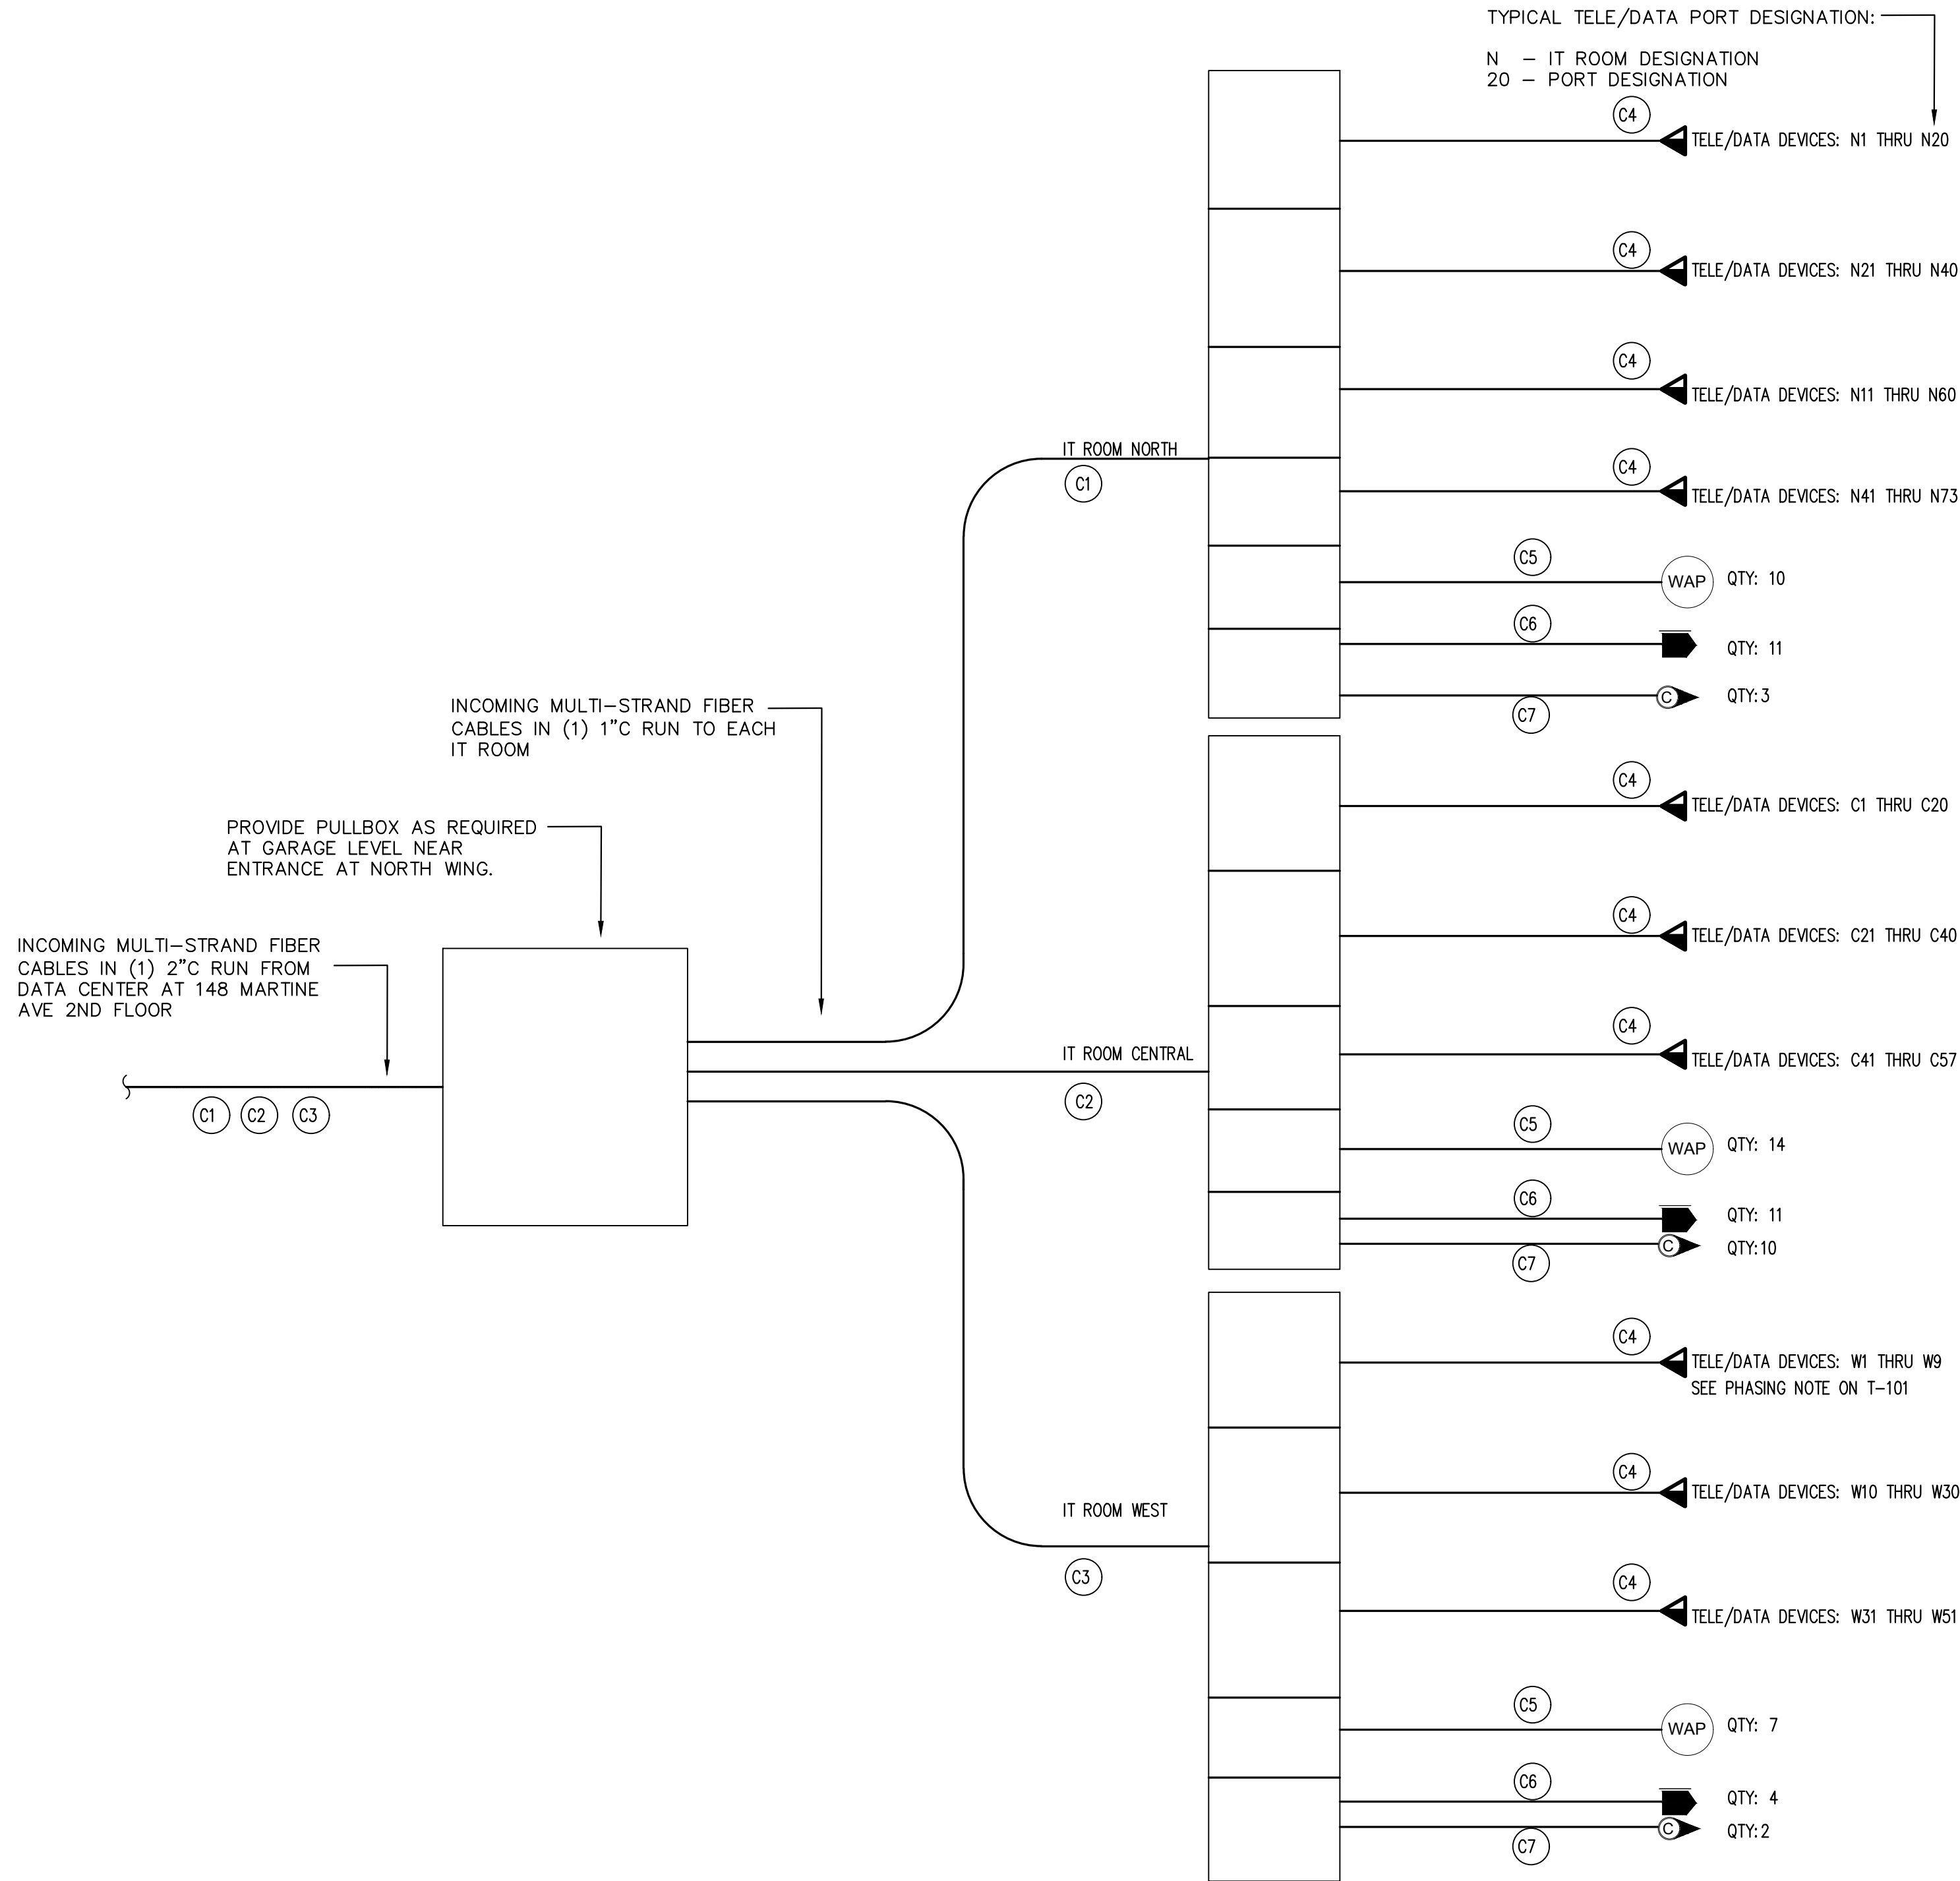


CABLE #	CABLE NAME	CABLE TYPE	TERMINATION
(C1)	PRIMARY BACKBONE	24-STRAND MULTI-MODE 50 MICRON OM4 OR BETTER	FIBER PATCH PANEL
(C2)	PRIMARY BACKBONE	24-STRAND MULTI-MODE 50 MICRON OM4 OR BETTER	FIBER PATCH PANEL
(C3)	PRIMARY BACKBONE	24-STRAND MULTI-MODE 50 MICRON OM4 OR BETTER	FIBER PATCH PANEL
(C4)	HORIZONTAL	TWO (2) 4-PAIR CATEGORY 6A CABLE (TYP)	8-POSITION MODULAR PLUG EACH END
(C5)	HORIZONTAL	4-PAIR CATEGORY 6A CABLE (TYP)	8-POSITION MODULAR PLUG EACH END
(C6)	HORIZONTAL	4-PAIR CATEGORY 6A CABLE (TYP)	8-POSITION MODULAR PLUG EACH END
(C7)	HORIZONTAL	4-PAIR CATEGORY 6A CABLE (TYP)	8-POSITION MODULAR PLUG EACH END

THESE PLANS ARE APPROVED ONLY FOR THE WORK INDICATED ON THE APPLICATION SPECIFICATION SHEET. ALL OTHER MATTERS SHOWN ARE NOT TO BE RELIED UPON OR TO BE CONSIDERED AS EITHER BEING APPROVED OR IN ACCORDANCE WITH APPLICABLE CODES.

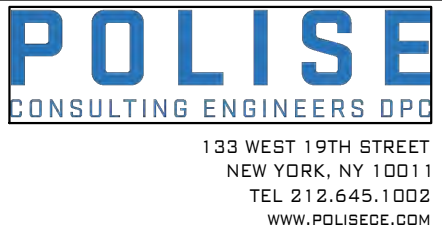

CONSULTANT SEAL		CONSULTANT INFORMATION			
		Graf & Lewent Architects LLP			
		90-30 161st Street, Jamaica, NY 11432 P: 718-651-6200 F: 718-251-6989			
2	06/28/2021				ADDENDUM #2
1	06/21/2021				ADDENDUM #1
REVISION NUMBER	DATE	MADE BY	APP'D BY	REVISION	
RECORD DRAWING CERTIFICATION					
<input type="checkbox"/> AS BUILT - CHANGES AS NOTED <input type="checkbox"/> AS BUILT - NO CHANGES					
CONTRACTOR			CONTRACTOR		
NAME: _____			NAME: _____		
SIGNATURE: _____			SIGNATURE: _____		
TITLE: _____			TITLE: _____		
DATE: _____			DATE: _____		
WESTCHESTER COUNTY, NEW YORK DEPARTMENT OF PUBLIC WORKS AND TRANSPORTATION				CONTRACT NUMBER 19-514	SHEET NUMBER T-300
DIVISION OF ENGINEERING				SHEET NO. 7	OF 10
LOW RISE BUILDING RENOVATIONS AND HVAC IMPROVEMENTS 110 DR. MARTIN LUTHER KING, JR. BOULEVARD WHITE PLAINS, NEW YORK 10601				SCALE: AS NOTED DATE: MAY 20, 2021	
TELECOMMUNICATIONS RISER DIAGRAM				DPW FILE NO. 52-01-T-623-0	REV NO. 0

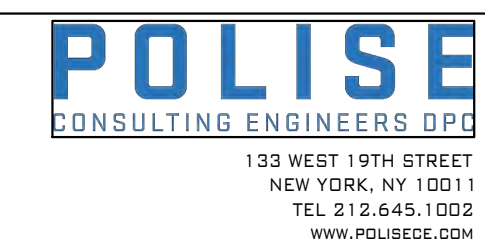

PULL BOX SIZING FOR HORIZONTAL CABLE				
CONDUIT TRADE SIZE	WIDTH (IN)	LENGTH (IN)	DEPTH (IN)	INCREASE FOR ADDITIONAL CONDUIT (IN)
1	3	8	3	2
1 1/4	3	10	3	3
1 1/2	4	12	4	3
2	4	16	4	4
2 1/2	5	20	5	4
3	5	24	5	5
3 1/2	6	28	6	6
4	8	32	6	6



PULL BOX SIZING FOR BACKBONE CABLE				
CONDUIT TRADE SIZE	WIDTH (IN)	LENGTH (IN)	DEPTH (IN)	INCREASE FOR ADDITIONAL CONDUIT (IN)
1	4	16	3	2
1 1/4	6	20	3	3
1 1/2	8	27	4	4
2	8	36	4	5
2 1/2	10	42	5	6
3	12	48	5	6
3 1/2	12	54	6	6
4	15	60	8	8

CONDUIT CAPACITY								
TRADE SIZE (IN)	CABLE OUTSIDE DIAMETER (IN)							
	0.13	0.18	0.22	0.24	0.29	0.31	0.37	0.53
1/2	1	1	0	0	0	0	0	0
3/4	6	5	4	3	2	2	1	0
1	8	8	7	6	3	3	2	1
1 1/4	16	14	12	10	6	4	3	1
1 1/2	20	18	16	15	7	6	4	2
2	30	26	22	20	14	12	7	4
2 1/2	45	40	36	30	17	14	12	6
3	70	60	50	40	20	20	17	7
3 1/2	—	—	—	—	—	—	22	12
4	—	—	—	—	—	—	30	14

NOTE

1. SHALL NOT EXCEED 30% FILL FOR MIXED CABLE DIAMETERS.

PULL BOX CONFIGURATION GUIDELINES

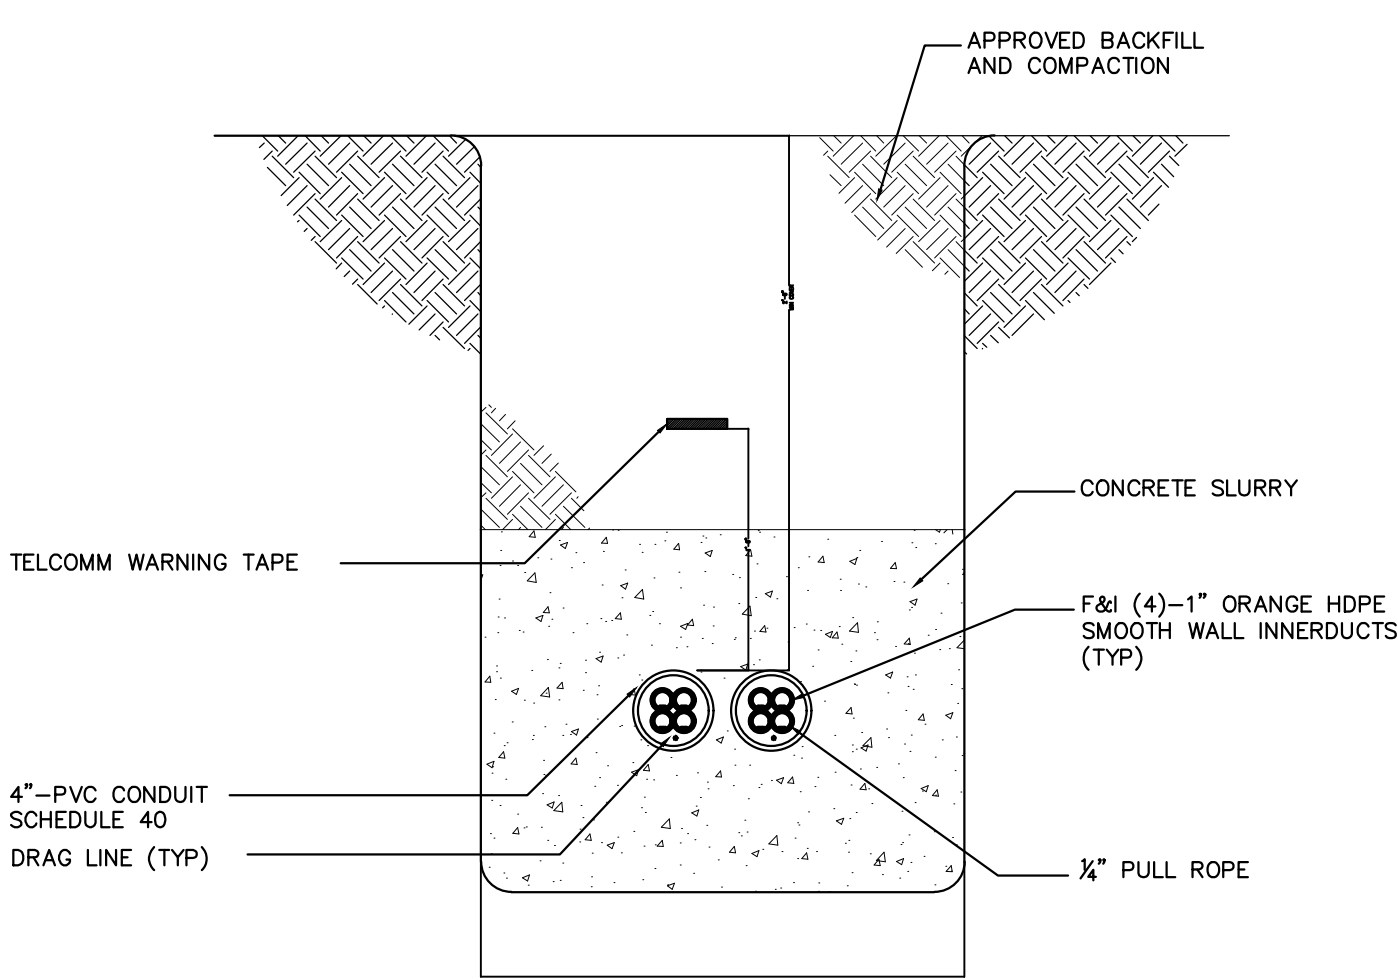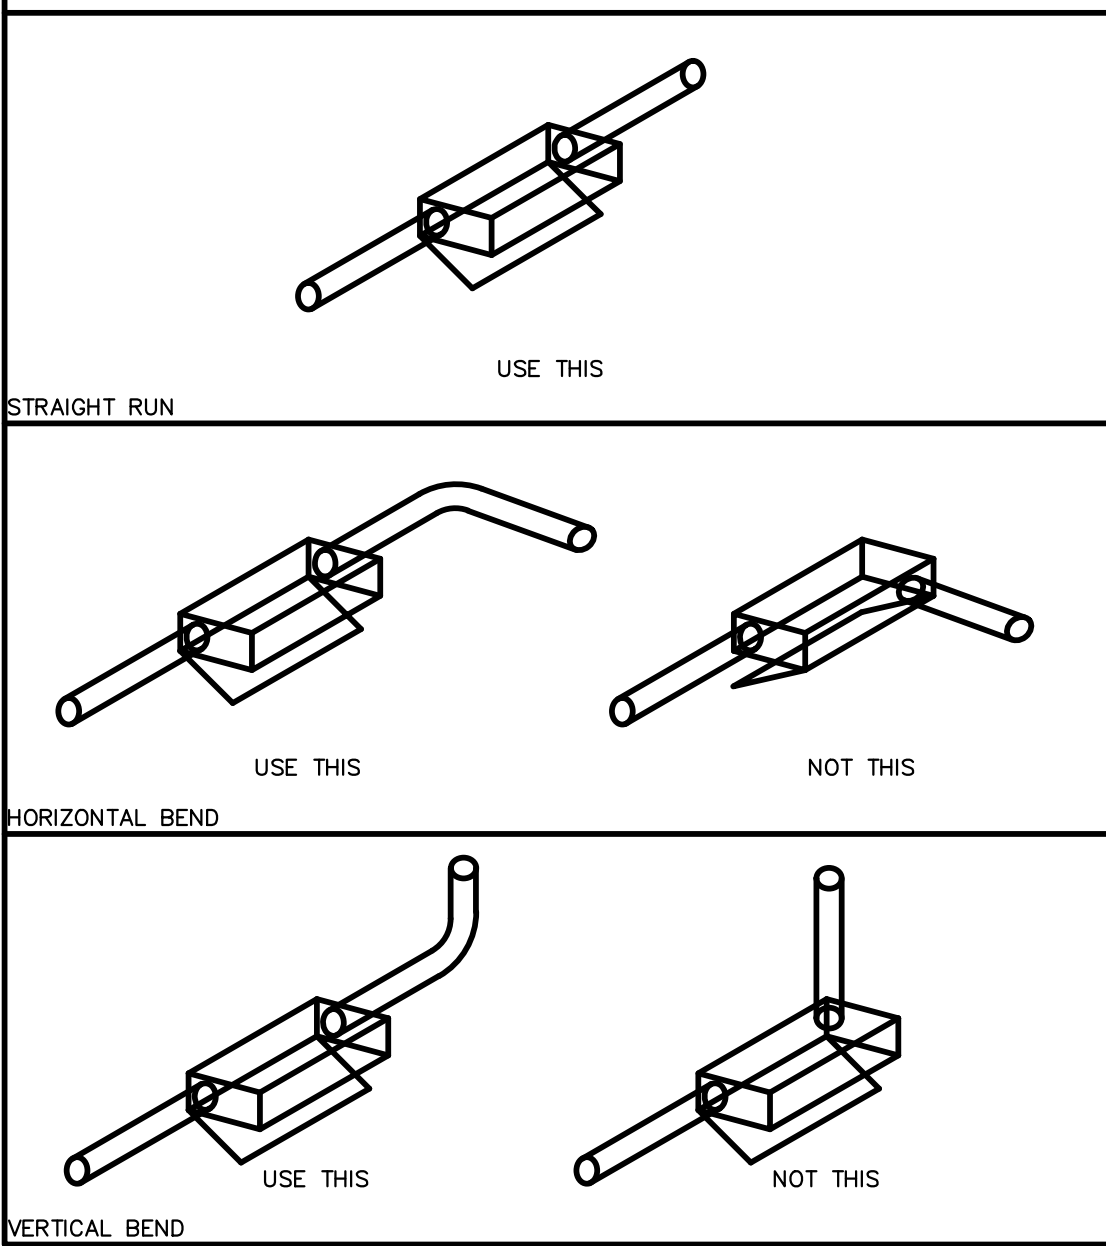

1 TELECOMMUNICATIONS CONDUIT DETAIL

NOTES

- F&I PVC PLASTIC PIPE WITH SCHEDULE 40, TYPE PVC 1120 AND NO PATHWAY SHALL HAVE MORE THAN 180 DEGREES OF BENDS.
- THE ENDS OF CONDUITS SHALL BE PLUGGED WITH DUCT PLUG TO PREVENT WATER WASHING MUD INTO THE CONDUITS DURING AND AFTER CONSTRUCTION.
- BUILDING COREDRILLS MUST BE SEALED AROUND CONDUITS WITH APPROVED WATERPROOF PLUGGING COMPOUND.
- STUB OUT CONDUITS INTO MAIN TELECOM ENTRANCE A MINIMUM OF 6 INCHES ABOVE THE FINISHED FLOOR.
- INSTALL NEW INNERDUCT PULL ROPE IN ALL NEW CONDUITS AS SHOWN AND EXTENDING 3 FEET INTO EACH BUILDING SPACE.
- PLUG ENDS OF THE NEW CONDUITS WITH WATERTIGHT RUBBER CONDUIT PLUGS, CONDUIT CAULKING COMPOUND, OR CONDUIT CAPS TO ENSURE FOREIGN MATTER DOES NOT ENTER THE BUILDINGS.
- NEW CONDUITS SHALL BE BURIED MINIMUM AT 24" BELOW FROST LINE AND SHALL BE ENCASED IN CONCRETE.

THESE PLANS ARE APPROVED ONLY FOR THE WORK INDICATED ON THE APPLICATION SPECIFICATION SHEET. ALL OTHER MATTERS SHOWN ARE NOT TO BE RELIED UPON OR TO BE CONSIDERED AS EITHER BEING APPROVED OR IN ACCORDANCE WITH APPLICABLE CODES.

POLISE
CONSULTING ENGINEERS LLP
133 WEST 19TH STREET
NEW YORK, NY 10011
TEL 212-645-1002
WWW.POLISEENGINEERS.COM

CONSULTANT SEAL		CONSULTANT INFORMATION			
		Graf & Lewent Architects LLP			
		90-30 161st Street, Jamaica, NY 11432 P: 718-651-6200 F: 718-251-6989			
2	06/28/2021				ADDENDUM #2
1	06/21/2021				ADDENDUM #1
REVISION NUMBER	DATE	MADE BY	APP'D BY		REVISION
RECORD DRAWING CERTIFICATION					
<input type="checkbox"/> AS BUILT - CHANGES AS NOTED					
<input type="checkbox"/> AS BUILT - NO CHANGES					
CONTRACTOR			CONTRACTOR		
NAME: _____			NAME: _____		
SIGNATURE: _____			SIGNATURE: _____		
TITLE: _____			TITLE: _____		
DATE: _____			DATE: _____		
WESTCHESTER COUNTY, NEW YORK DEPARTMENT OF PUBLIC WORKS AND TRANSPORTATION					
DIVISION OF ENGINEERING					
LOW RISE BUILDING RENOVATIONS AND HVAC IMPROVEMENTS 110 DR. MARTIN LUTHER KING, JR. BOULEVARD WHITE PLAINS, NEW YORK 10601					
TELECOMMUNICATIONS INSTALLATION DETAILS					
CONTRACT NUMBER 19-514		SHEET NUMBER T-401			
SHEET NO. 10		OF 10			
SCALE: AS NOTED		DATE: MAY 20, 2021			
DPW FILE NO. 52-01-T-626-0		REV NO. 0			