

November 24, 2021

WHITE PLAINS CITY SCHOOL DISTRICT
RENOVATIONS AT ROCHAMBEAU ALTERNATIVE H.S.:
SED Control Number: 66-22-00-01-0-015-019

CONTRACT G – GENERAL CONSTRUCTION ABATEMENT
CONTRACT H- HVAC WORK, CONTRACT P – PLUMBING WORK
CONTRACT E - ELECTRICAL WORK

WESTCHESTER COUNTY, NEW YORK

NOTE: *This clarification forms a part of the contract documents for the above project and must be acknowledged in the plans and specifications. Attach it to the inside front cover of each of the specifications.*

GENERAL CLARIFICATION TO PROJECT:

1. The Alarm Vendor name for Rochambeau Alternative HS is 'Alarm Specialists Inc.' 333 Old Tarrytown Rd., White Plains, NY 10603. Phone (914) 946-1998

CLARIFICATION TO SPECIFICATIONS:

1. Add SPECIFICATION SECTION ROCHAMBEAU – SPECIAL PROVISIONS attached herewith.
2. Add SPECIFICATION SECTION 284600 - FIRE DETECTION AND ALARM attached herewith.
3. Remove SPECIFICATION SECTION 004116.11 – PB – E and add revised SPECIFICATION SECTION 004116.11 – PB – E attached herewith.
4. Remove SPECIFICATION SECTION 004116.11 – PB – G and add revised SPECIFICATION SECTION 004116.11 – PB – G attached herewith.

CLARIFICATION TO DRAWINGS:

1. Remove DRAWING G000.00 GENERAL NOTES, MAPS, DRAWING LIST, STAGING PLAN, LEGENDS and replace with revised DRAWING G000.00 GEN NOTES, MAPS, DRAWING LIST, STAGING PLAN, LEGENDS attached herewith. Please note the drawing has updated the plumbing drawing list.
2. Remove DRAWING AD120.00 PARTIAL GROUND FLOOR DEMOLITION PLAN and replace with revised DRAWING AD120.00 PARTIAL GROUND FLOOR DEMOLITION PLAN attached herewith. Please note this drawing has been revised to show what ceiling areas are included in Add Alt. G1.
3. Remove DRAWING AD121.00 PARTIAL GROUND FLOOR DEMOLITION PLAN and replace with revised DRAWING AD121.00 PARTIAL GROUND FLOOR DEMOLITION PLAN attached herewith. Please note this drawing has been revised to show what ceiling areas are included in Add Alt. G1.
4. Remove DRAWING AD122.00 PARTIAL FIRST FLOOR REFLECTED CEILING PLAN and replace with revised DRAWING AD122.00 PARTIAL FIRST FLOOR REFLECTED CEILING PLAN attached herewith. Please note this drawing has been revised to show what ceiling areas are included in Add Alt. G1.
5. Remove DRAWING AD123.00 PARTIAL FIRST FLOOR REFLECTED CEILING PLAN and replace with revised DRAWING AD123.00 PARTIAL FIRST FLOOR REFLECTED CEILING PLAN attached herewith. Please note

November 24, 2021

revised DRAWING AD124.00 PARTIAL SECOND FLOOR REFLECTED CEILING PLAN attached herewith. Please note this drawing has been revised to show what ceiling areas are included in Add Alt. G1.

7. Remove DRAWING AD125.00 PARTIAL SECOND FLOOR REFLECTED CEILING PLAN and replace with revised DRAWING AD125.00 PARTIAL SECOND FLOOR REFLECTED CEILING PLAN attached herewith. Please note this drawing has been revised to show what ceiling areas are included in Add Alt. G1.
8. Remove DRAWING P200.00 PLUMBING DEMOLITION ENLARGEMENT PLANS FOR ROOMS 110,100A,207,219, AND 308 and replace with revised DRAWING P200.00 PLUMBING DEMOLITION ENLARGEMENT PLANS FOR ROOMS 110,100A,207,219, AND 308 attached herewith. Please note this drawing has been revised to show revised piping scope of work.
9. Remove DRAWING P201.00 PLUMBING DEMOLITION ENLARGEMENT PLANS FOR ROOMS 110,100A,207,219, AND 308 and replace with revised DRAWING P201.00 PLUMBING DEMOLITION ENLARGEMENT PLANS FOR ROOMS 123,124,221,222, AND 318 attached herewith. Please note this drawing has been revised to show revised piping scope of work.
10. Remove DRAWING P202.00 PLUMBING UNDERSLAB, SANITARY AND VENT ENLARGEMENT PLANS FOR ROOMS 110,100A,207,219, AND 308A and replace with revised DRAWING P201.00 PLUMBING DEMOLITION ENLARGEMENT PLANS FOR ROOMS 110,100A,207,219, AND 308A attached herewith. Please note this drawing has been revised to show revised piping scope of work.
11. Remove DRAWING P203.00 PLUMBING UNDERSLAB, SANITARY AND VENT ENLARGEMENT PLANS FOR ROOMS 110,100A,207,219, AND 308 and replace with revised DRAWING P201.00 PLUMBING UNDERSLAB, SANITARY AND VENT ENLARGEMENT PLANS FOR ROOMS 123,124,221,222, AND 318A attached herewith. Please note this drawing has been revised to show revised piping scope of work.
12. Remove DRAWING P204.00 PLUMBING DOMESTIC ENLARGEMENT PLANS FOR ROOMS 110,100A,207,219, AND 308A and replace with revised DRAWING P201.00 PLUMBING DOMESTIC ENLARGEMENT PLANS FOR ROOMS 110,100A,207,219, AND 308A attached herewith. Please note this drawing has been revised to show revised piping scope of work.
13. Remove DRAWING P205.00 PLUMBING DOMESTIC ENLARGEMENT PLANS FOR ROOMS 110,100A,207,219, AND 308 and replace with revised DRAWING P201.00 PLUMBING DOMESTIC ENLARGEMENT PLANS FOR ROOMS 123,124,221,222, AND 318A attached herewith. Please note this drawing has been revised to show revised piping scope of work.

REQUEST FOR INFORMATION FROM ALL CON CONTRACATING:

1. Per demo Key Note 2 on DRAWING AD 100.00 is states that existing wall finishes are to remain and fur out over existing surfaces however, the details don't reflect the new finish referred to on Key Note 4 of DRAWING A 100.00 going over the existing wall tiles. Please clarify if existing wall tile will remain and we are furring over the existing wall/tile or if it needs to be removed.

RFI response: As per Key Note 2 on DRAWING AD 100.00 ENLARGED DEMOLITION BATHROOM PLANS, existing wall finishes to remain including tile shall remain in place U.N.O.. Patch and prepare all existing surfaces for new construction and finishes. Laminate or fur out over existing surface. Key Note 4 on A 100.00 ENLARGED BATHROOM PLANS indicates for new wall tile over new 5/8" cement board on new stud framing, see partition types for additional information. The contractor shall align and prepare new and existing walls to be plumb as required for complete and proper installation of new tile and finishes.

November 24, 2021

2. Are any of the walls being removed per keynote 10 on dwg AD100.00 CMU walls?

RFI response: Yes, the existing walls are of CMU / plaster construction and are to be removed as per Key Note 10.

3. Toilet RCP Key Note 2 call out for new ACT ceiling in the bathrooms, however there is no mention of removing the existing ceilings in the demo drawings. Please clarify if the toilet room ceilings are being removed.

RFI response: The Toilet Room ceilings are not to be demolished as new ceilings are being installed below existing. Prepare existing surface as required for a properly secured & complete installation. Existing ceiling is plaster on concrete deck.

4. The drawings are unclear which ceilings are part of add alt G1. The demo drawings show the removal of the hallway ceilings being part of the base bid, while the RCP has the hallway area outlined as if it is part of the add alt. The RCP does not have the hallway ceilings clearly labeled as an add alt. Please specify the locations of add alt G1 ceilings.

RFI response: See revised Partial Reflected Ceiling Plans attached herewith. Drawings have been revised to indicate what ceiling areas are included in Add Alt. G1.

End of Addendum No. 1

X:\WPSD (WHITE PLAINS CENTRAL SCHOOL DISTRICT) - 10991\WPSD 2009 - (ROCHAMBEAU ALT HS RENOVATIONS)\03-BID\ADDENDA\WPSD 2009 ADDENDUM 1.DOCX

SPECIAL PROVISIONS

These Special Provisions are in addition to the Plans, Specifications and the other Contract Documents and shall be part of this Agreement between the Owner and the Contractor. All references to "This Prime Contractor", "This Contractor" or "Contractor" refer to the **General Contractor, Mechanical Subcontractor and Electrical Contractor**. In cases of contradictions, the most stringent Provision shall govern.

General Requirements for Each Prime Contractor

I. General

1. All dates, durations, etc. defined herein shall be in business days.
2. Except for the basic building permit, each Prime Contractor's price shall include all fees and other costs for securing and maintaining (by the Prime Contractors or their subcontractors) for the life of the job; all permits, PE licenses, connection fees, inspections, etc., applicable to, or customarily secured for the Work. This provision includes any applications and/or permits to be issued by utility companies in the name of the Prime Contractor, or the Owner, as required for the Work. Originals of all permits are to be issued in the name of the Prime Contractor as required for the Work. The Prime Contractor shall furnish the Construction Manager with original copies of all permits prior to the commencement of the Work and shall prominently display a copy of all permits at a location agreed to with the Construction Manager.
3. One week after Notice to Proceed (NTP), each Prime Contractor shall provide two copies of a videotaped recording of all existing conditions to the Construction Manager. This taping shall provide a record of all-existing buildings, grounds, exterior conditions and interior conditions. The Contractor shall schedule a representative of both the Owner and the Construction Manager to be present at this taping. In the absence of this record, the Prime Contractor shall be responsible for paying the costs associated with any and all repairs or replacements of existing materials and/ or conditions that were damaged in an area where the Prime Contractor is working or has worked, as may be deemed necessary by the Owner or the Construction Manager.
4. Each Prime Contractor is responsible for providing the required mock-ups defined by the Contract Documents out of sequence as needed by the Architect.
5. Each Prime Contractor is responsible for providing all required Engineered material calculations as defined by the contract documents.
6. Each Prime Contractor shall provide drinking water for his own employees.
7. On Site Communications. Each Prime Contractor shall provide, or otherwise see that, the project manager, or site managers, and/or responsible workers of each Prime Contractor and major subcontractor are equipped with cellular phones for the purpose of staying in contact with for the Construction Manager.
8. Each Prime Contractor shall include in his base price the cost of all rigging and equipment required for the performance and installation of the Work.

II. Schedule

1. All Contractors are to recognize that the Project Schedule is of critical importance to the Owner. All aspects of construction must reflect a 'time is of the essence' construction strategy. The attached 'Bid Schedules' serves as a guide of critical milestone dates to the Project. Failure to meet intermediate milestone dates will jeopardize the overall Project Schedule. This failure will mandate Contractor(s) to, increase staff, work overtime, or use other means to recover time, at the costs of those Contractor(s) responsible for such delays. In addition, all costs due to delays in completion of the Work, which require additional Custodial Overtime, Construction Management services, Architectural services, and Engineering services beyond the Work duration in the Bid Schedule, shall be borne by Contractor(s) responsible for delays.
2. Each contractor, prior to being awarded the contract shall prepare and submit a Preliminary Master Project Schedule for their Work. **Within (3) weeks of NTP all Prime Contractors will provide a coordinated Draft master schedule.** Each Prime's Project Schedule are to reflect all requirements for submittals, material and equipment procurement, material stockpiling, setting up Contractor's staging area and surveying of existing conditions. These Schedules, reflecting the critical milestone dates established by the attached 'Bid Schedule', are to be coordinated and shall be inclusive of other Prime Contractor's activity. The "Final" agreed upon overall schedule of work shall be developed and maintained by the Prime Contractor for General Construction in conjunction with the Construction Manager utilizing each Prime Contractor's Preliminary and updated Schedule(s). Specific relationships between Contractors, sequencing of activities, phasing, and critical "ties" of coordinated Work must be detailed on the Project Schedule. All Contractors shall utilize "Sure Track Project Manager 3.0-" as produced by Primavera Systems, Inc., -or- equal platform producing Gant Style Scheduling.
3. All Prime Contractors shall review the completed "Final" detailed construction schedule and acknowledge their acceptance of this schedule by signing a copy to be kept on record by the Construction Manager. This agreed upon schedule must incorporate all milestone dates and shall be established within five (5) weeks of Notice to Proceed.
4. The Prime Contractor for General Construction shall update the detailed construction schedule with the Construction Manager and issue copies to the other Prime Contractors, the Owner, Construction Manager, and the Architect monthly. Each Prime Contractor shall provide the Prime Contractor for General Construction with all information necessary to provide these updates.
5. Each Prime Contractor is to submit a schedule of projected fabrication on long lead items (items requiring four weeks and over to fabricate) three weeks after Notice to Proceed. Progress/Status reports on fabrication to be submitted to the Construction Manager every two weeks. 'Rate of Change' chart and marked up shop drawings to be included in these reports.
6. The Prime Contractors shall be responsible for coordinating and expediting their fabrication and delivery schedules and keeping the Construction Manager informed as to their progress and their anticipated ability to stay on schedule. Should it become necessary (in the opinion of the Construction Manager) to supplement the Prime Contractor's expediting efforts in order to maintain job progress, the Construction Manager may elect to charge all costs incurred to said Prime Contractor.

7. In the event that Owner makes special arrangements to open a building at the request of a Contractor and the Contractor does not show, the Prime Contractor shall pay the Owner all costs incurred. All parties agree that any action taken to enforce this requirement shall not be construed by any Prime Contractor or its subcontractors/suppliers, as a reason for a claim (for either time or money) for delay to the Work or to the Prime Contractor, its subcontractors, or suppliers.
8. The Owner shall take partial occupancy of the building additions and renovated spaces in accordance with the dates established by the Bid Schedule and the Special Provisions. The Contractors shall perform all Work necessary to maintain the Owner's move-in and occupancy schedule.
9. The Contractors shall include in their base price, all out of sequence Work and any Work required to be performed during overtime hours or non-working hours necessary to maintain the Master Schedule, the Prime Contractors' project schedule, or, the Owner's move-in schedule.

Milestone Requirements

Submittal Priorities

The following submittal dates (in calendar days) are critical to allow for proper fabrication timeframes to ensure timely completion of the project to meet the attached bid schedule. A complete listing of all submittal requirements is located in "Section 01300 Submissions", which shall be accompanied by each division's specific submittal requirements.

Major General Construction Submittals

Scaffolding and/or Stair tower-(may require PE Stamp)	15 days from Notice to Proceed
Bracing/Shoring-(may require PE Stamp)	15 days from Notice to Proceed
Foundation Shop Drawings	15 days from Notice to Proceed
Rebar/Reinforcing Shop Drawings	15 days from Notice to Proceed
Structural Steel/Decking	15 days from Notice to Proceed
Masonry Submittals/Shop Drawings	15 days from Notice to Proceed
Stormwater/Sanitary	15 days from Notice to Proceed
Doors/Hardware	15 days from Notice to Proceed
Windows/Openings	15 days from Notice to Proceed
Storefront	15 days from Notice to Proceed
Waterproofing	15 days from Notice to Proceed
Louvers	15 days from Notice to Proceed
Interior Finishes	20 days from Notice to Proceed
Display Cases/Cabinets/ Equipment	20 days from Notice to Proceed
Casework	20 days from Notice to Proceed
All remaining Submittals with-in	20 days from Notice to Proceed

Major Electrical Equipment

Service Equipment	15 days from Notice to Proceed
Fire Alarm	15 days from Notice to Proceed
Public Address/Intercom	15 days from Notice to Proceed
Security	15 days from Notice to Proceed
Technology	15 days from Notice to Proceed
Light Fixtures	15 days from Notice to Proceed
All remaining Submittal with-in	20 days from Notice to Proceed

Major HVAC Equipment

Duct Work	15 days from Notice to Proceed
Equipment	20 days from Notice to Proceed
Controls	20 days from Notice to Proceed
Hot/Chilled Piping and Enclosures	20 days from Notice to Proceed
All remaining Submittals with-in	20 days from Notice to Proceed

Construction Milestones

All Prime Contractors

Special consideration should be made to the requirements of the project bid schedule attached in the Specifications. Prime Contractors will be required to man each contract to meet the milestone dates indicated below and/or in the contract bid schedule. All costs should be included in the bid for working multiple shifts, nights, weekends, and holidays to complete each phase of the project.

Time frames indicated, show milestone dates required to be met by all Prime Contractors. These areas, once completed, will be punch-listed and given partial occupancy for the Owner to occupy. Occupying these areas is critical to the Owner. If said dates are not met Liquidated Damages may be assessed and backcharged to the responsible Contractor.

Key Milestone Dates

Rochambeau Alternative High School - Contracts E, G, H & P

- **Construction Start: June 27th, 2022.**
- **Substantial Completion: August 19th, 2022.**
- **Final Completion: September 2, 2022.**

Rochambeau Alternative High School – Contracts E, G, H & P

The bid schedule reflects the phasing and overall construction schedule for the renovations of the existing bathrooms as designated in/on the drawings.

SCHOOL OPERATIONS & CONTRACTOR WORK HOURS

During the school session all contract work not affecting the District's Operation may be performed weekdays during the hours of 7:00 am and 8:00 pm, Monday thru Saturday. All contract work effecting the Operation of the School must be performed on an after-hours schedule, weekends or school holidays.

Each Prime Contractor may work Saturday & Sundays to make up for lost time (Saturday/Sunday work will be required if necessary, to meet deadline) with prior approval from the Owner and after Contractor has verified allowable working hours by town ordinance.

Due to extreme traffic congestion associated with student car and bus transportation, deliveries to any area of the project WILL NOT be allowed during school days from 7:00 a.m. to 8:00 a.m. and 2:00 p.m. to 3:00 p.m.

III. SAFETY / LOGISTICS/STORAGE

1. Two weeks after the receipt of the Notice to Proceed, the Prime Contractor for General Construction shall provide a Site Safety/Logistics Plan to the Construction Manager. The site logistics plan should minimally include locations of the eight-foot high temporary fence, traffic plans for deliveries and removals, refuse container locations, crane locations, pick locations, boom radius, and lift locations. This plan shall also show the location of all staging and storage areas, non-rated and fire-rated partitions used to separate construction and school areas, made with plywood and/or gypsum wallboard, etc. The logistical information represented by the construction documents shall serve as a minimal guide.
2. Each prime contractor is to submit their corporate safety policy (2) weeks after notice to proceed. Plan to minimally meet OSHA standards. Each Prime Contractor shall make the participation of their subcontractors in this program mandatory. These Safety Programs should be a detailed Company Policy defining the specifics as to how a safe work environment shall be maintained
3. Each Prime Contractor is to identify in writing to the Construction Manager their "OSHA Competent Person Regarding Safety" Definition. "Competent person" means one who is capable of identifying existing and predictable hazards in the surroundings or working conditions which are unsanitary, hazardous, or dangerous to employees, and who has authorization to take prompt corrective measures to eliminate them.
4. All flagmen required for deliveries to the site are to be furnished by the Prime Contractor responsible for the delivery. Any and all deliveries crossing the site or student traffic areas shall be escorted by flagmen. All flagmen shall wear orange vests. All deliveries shall be scheduled and coordinated with the Construction Manager and the Owner. Delivery blackout periods for bus traffic interference shall be established with the Construction Manager.

5. Smoking, firearms, alcoholic beverages, and indecent photography are expressly prohibited on all school properties. All persons representing Contractors, subcontractors or suppliers shall wear shirts, long pants and other proper attire while on school property. All persons representing Contractors, subcontractors or suppliers shall conduct themselves in a professional manner consistent with the rules and policies of The School District, and the New York State Education Department while on school property or otherwise representing this project.
6. Each Prime Contractor will ensure that all their employees, while on school property, will wear hard hats, high visibility vests, and ID badges at all times. Anyone on site without this safety gear will be escorted off school property.
7. Each Prime Contractor will ensure that every employee working on this project has completed a 10-hour OSHA training course. Any worker that cannot present a 10-hour OASHA safety-training card will be escorted off the property.
8. Food truck vendors for Construction Workers will only be allowed on school property with prior authorization from the School District. The District may allow or discontinue food vendor truck service at any time for any reason.
9. **Identification Badges.** Each Prime Contractor will provide an ID badge for each of their field personnel prior to coming on school property. All workmen shall display the badge on their person while on site, and at all times. Failure to wear identification badge at all times will result in the immediate removal from the jobsite.
10. Each Prime Contractor is responsible for their own storage and personnel trailers at each site. Each Contractor will be required to supply man trailers and storage box trailers as required. All costs related to its delivery, construction, protection, power, etc. is borne by the individual Contractors utilizing space. The Owner WILL NOT PROVIDE STORAGE SPACE. The placement of these trailers will be strictly limited to predetermined locations. Approval of the placement of any trailer or storage box must be received from the Construction Manager.
11. The parking for construction personnel shall be limited to designated parking areas only. Failure to abide by this rule will result in towing of cars at the expense of the Prime Contractor who employs the individual.
12. All delivery vehicles/trucks/machinery/etc. permitted on site, must be equipped with back-up alarms and enter through the designated access points. Failure to demonstrate this ability will result in cancellation of delivery or stoppage of work. All delays associated with this cancellation will be the responsibility of the Prime Contractor responsible for the delivery involved.
13. All temporary construction site fences installed by any Prime Contractor shall be installed with a tightly woven, blind screen mesh. This mesh is to be installed on the "construction" side of the fence. The General Contractor will maintain all fencing daily and lock gates at the end of the day.
14. All crane picks, material delivery, etc. must be coordinated so as not to lift over any occupied area of the building. If absolutely necessary, this work shall be done on off hours to ensure the safety of the building occupants. Crane location must be carefully chosen to ensure the safety of building occupants. Crane pick must also not be conducted during academic hours within 20' of an occupied building.

15. The Owner or Construction Manager reserves the right to have all hoisting equipment periodically inspected by an independent inspector whose findings will be binding. The Prime Contractor at its own expense must make corrections before continuing work. The Owner or Construction Manager will not assume any responsibility for the safe operation of any hoisting equipment by exercising this right. Each Prime Contractor or Sub Contractor shall cooperate with the inspector by allowing time for the inspection. The Prime Contractor shall be notified 24 hours prior to the time of the inspection. These inspections do not release the Prime Contractor of their responsibility to provide all engineering, permits, and inspections as required by OSHA or the SED prior to use of any hoisting equipment.
16. All vehicular traffic (personal vehicles, trucks, equipment, deliveries, etc.) are to use the designated entrances as outlined on the Logistics Drawings. Access by other routes is to be on exception basis only.

IV. SUBMITTALS

1. Each copy of each submittal shall have attached as the cover page the "Submittal Cover Sheet". All information requested in "Submittal Requirements" shall be provided by the respective Contractor. Submittals will be returned without review if the cover sheet is not accurately completed.
2. Each Prime Contractor shall generate a complete "Submittal Log" within one calendar week of the Notice to Proceed. This log is to list all required submittals specific to your trade as detailed in the Project Manual/Specs. See enclosed form for your use. "ROJ" stands for Required on Job to assist your judgment of the time gap between submission, Architect review, fabrication/procurement and on-site need for putting the work item into place.
3. Each Prime Contractor shall review all submissions for completeness. Each Prime Contractor is responsible to stamp all shop drawings prior to submission to the Architect. The Architect will not review any shop drawings unless first reviewed by said Contractor. Bundle similar material submissions for proper review. Use the Architects Submittal cover sheet located in the Specifications
4. **All submissions shall be sent electronically to the Architect via Newforma. Submittals will be processed and stored electronically, with access available to all Prime Contractors for coordination.**
5. Each Prime Contractor shall provide one transmittal for each submission package identifying each unique submission individually. For each submittal with the submission package, the Prime Contractor shall identify the length of the delivery time and the necessary "last date" an item may be received on site. Each Prime Contractor shall keep a log of all submissions in a manner prescribed by the Construction Manager and the attached form. Minimally, the Contractor shall update this submittal log biweekly and provide a copy to the Construction Manager for review and information.
6. Each Prime Contractor shall copy the Construction Manager's Project Manager on all transmittals, correspondence, RFI's and any other documents sent to the Architect, his consultants or the Owner.
7. At the direction of the Construction Manager, the Prime Contractor shall provide copies of either document and/or data files for any requested document on one of the following programs: Microsoft Word, Microsoft Excel, or Primavera's SureTrack - Project Manager 2.0 scheduling program.

V. MANAGEMENT OF WORK

1. Each Prime Contractor shall employ (from one week after Notice to Proceed until punch-list and closeout are complete) at a minimum a full time Project Manager and/or full time On-Site Super. The Project Manager and/or Site Super shall represent the Prime Contractor. All communications given to the Project Manager or Site Super either verbal or written shall be as binding as if given to the Prime Contractor. Important communications shall be so confirmed in writing.
2. Each Prime Contractor shall have responsible representation at the **MANDATORY** weekly job meetings held at the Construction Manager's job office from notice to proceed thru close out. These meetings will be held to arrange for a satisfactory coordination of all building trades so as not to impede job progress. Prime Contractors or subcontractors who fail to attend the meetings will be backcharged \$500.00 per each occurrence.
3. Each Prime Contractor shall submit two-week look ahead schedules at each Project Meeting thereby identifying the anticipated activity, and material needs for all of the work scheduled to be formed by the Prime Contractor and his subcontractors for the identified time period. The Prime Contractor shall keep this schedule current.
4. The MEP Coordination shall follow the guidelines stated below:
 - a. Each Prime Contractor shall have sufficient responsible representatives at mechanical/electrical/plumbing coordination meetings held at a location to be determined. These meetings shall be held as frequently as required by the Construction Manager or any other Prime Contractor. The General Construction Prime Contractor shall also include a representative at these meetings.
 - b. All Contractors are expected to jointly produce coordination drawings. Prime Contractors are to first submit their respective shop drawings for approval, to the Owner's Architect and Engineers in order to make any necessary changes prior to going through the coordination process. The HVAC Contractor shall provide black line mylars showing all of the approved ductwork. The HVAC Contractor shall locate on these mylars all piping in orange pencil lines. The Plumbing Contractor shall locate the plumbing lines on these mylars in blue pencil lines. The Electrical Contractor shall indicate conduit runs in green pencil lines. The General Contractor will have the last coordination review. As each coordination drawing is completed, Contractors are to meet with the Owner's Representative and the Architect to review and resolve all identified conflicts on the coordination drawings. Note: for areas without HVAC work, the Mechanical Prime shall provide the necessary mylars with black line. All coordination meetings will be held at the Construction Manager's office.
 - c. It is the responsibility of the Prime Contractor for General Construction to coordinate all points of entry through the foundations, slab penetrations, sleeves, roof openings and penetrations, wall openings and penetrations etc. with the work of all other Contractors, including but not limited to M. E. P. Primes, kitchen equipment, casework and casework accessories.

- d. It is the responsibility of each Prime Contractor to coordinate with the architectural details and elements, such as soffits, variations in ceiling height and materials, fire/smoke partitions or barriers, folding partition, doors, lockers, and any other general construction items that impact the space above the ceiling or otherwise requiring light framing and/or miscellaneous support or bracing.
5. If any Prime Contractor fails to keep the site safe and clean within four hours of being notified by the Construction Manager either verbally or in writing, the Construction Manager will have this work performed and back charged to the appropriate Prime Contractor at prevailing overtime rates plus 15%. Notice to field personnel is deemed notice to this Prime Contractor.
6. Dust and fume control is essential to the reduction of health risks to the surrounding personnel. Methods of dust control shall include but not be limited to the following:
 - a. Adequate ventilation.
 - b. Wetting down.
 - c. Keeping bags of insulating materials, cement, etc. closed.
 - d. Controlled mixing of materials under field conditions.
 - e. Special attention should be utilized in sawing of insulation and certain acoustical materials and storage of materials.
 - f. Job housekeeping must be maintained.
 - g. Advising all personnel of hazardous conditions, including supervisors and workmen.
 - h. Each Prime Contractor shall be responsible for instituting the above policies to insure minimal impact to surrounding occupied areas.
7. Each Prime Contractor shall confine operations on the premises to areas designated by the Construction Manager and permitted by law, ordinances, permits and the Contract Documents, and shall not unreasonably encumber the Premises with any materials or equipment. The Prime Contractor shall coordinate all of his operations with, and secure approval from, the Construction Manager, before using any portion of the Premises. Field personnel are to be confined to the work area assigned.
8. Where material is specified to be furnished by others or furnished and delivered only, the Prime Contractor installing the material shall be responsible for scheduling the delivery and receiving, unloading, storing, handling, relocating, hoisting, distribution, laying out and installing this material. Upon receipt by the Prime Contractor installing the material, risk of loss and damage shall be borne by that Contractor.
9. All Prime Contractors and their subcontractors shall allow sufficient time to inspect and accept the work of the previous Contractors. Should any discrepancies be discovered, The Construction Manager shall be notified sufficiently in advance so that corrective action can be agreed to and taken (by all necessary parties) without affecting the progress of any Contractor or the work.
10. All Prime Contractors are advised to exert utmost care and diligence when working in or near any existing buildings or site work which is to remain. The absence of protection around such items shall not excuse the Prime Contractor from his liability to provide protection. Any damages to the existing buildings, sitework or facilities shall be repaired and expensed to the responsible Prime Contractor.

11. Each Prime Contractor shall be solely responsible to remove and replace the existing ceiling tiles and grid in areas of the existing building where their work is required but new ceilings are not scheduled. In the event that the existing ceilings are damaged and cannot be replaced to the satisfaction of the Owner, the responsible Prime Contractor shall be solely responsible for replacing, in kind, the existing ceilings with new tile and grid. A qualified Contractor, acceptable to the Owner, shall perform all ceiling replacements.
12. All disconnect and/or tie-in work involving any utilities that would interfere with the ongoing operations of the Owner shall be completed on an after-hours basis. The performance of this work shall be projected on the required schedules and the Owners Representative is to be notified at least forty-eight hours in advance of commencing with this work. All overtime and standby personnel necessary to complete these tie-ins shall be the responsibility of the Prime Contractor performing the work.
13. At the same time the Prime Contractor submits their Insurance Certificate they shall also submit to the Construction Manager the labor rates of each category of labor for which he or his subcontractors shall employ (either directly or indirectly). This information shall be itemized in the format shown below.

Contractor's Name					
Contractor's Address					
Contractor's Office Phone					
Contractor's Fax Number					
Contractor's Email Address					
Labor Rate Breakdown					
Worker's Title		Journey man	1.5 Rate	Fore man	1.5 Rate
Base Hourly Rate					
Payroll Tax & Insurance:	% Per Hr				
FICA					
Federal Unemployment					
State					
Workers Compensation					
Disability					
Other (Explanation Required)					
Subtotal					
Benefits:	\$ Per Hr.				
Vacation					
Health & Welfare					
Pension					

Annuity					
401K Fund					
Other (Explanation Required)					
Other (Explanation Required)					
Subtotal					
Hourly Labor Rate					

VI. REQUEST FOR INFORMATION (RFIs)

1. Please refer to the specifications for RFI's for a complete explanation of the process and copy of RFI form.

VII. TESTING/INSPECTIONS

1. If the Architect or Owner determines that any work requires special inspection, testing or approval the Owner's Representative will instruct the Prime Contractor of such special inspection, or testing. If such special inspection or testing reveals a failure of the work to comply with the requirements of the Contract Documents, the Prime Contractor shall bear all costs thereof, including compensation for the Architect's and Owner's Representative's. .
2. Contractor shall furnish incidental labor to:
 - a. Provide access to the work to be tested, sampled, and inspected.
 - b. Obtain and handle samples at the project site or at the source of the product to be tested.
 - c. Facilitate inspections, samplings and tests.
 - d. Coordinate with the Owners Rep and testing lab and submit schedule of required tests one week in advance.
 - e. Coordinate inspections
3. As they relate to the timely prosecution of the work, all Prime Contractors shall coordinate independent testing and inspections. If any Prime Contractor fails to coordinate such inspections and additional costs are incurred to the Owner, the Prime Contractor will be responsible for that inspection cost.

4. The following is a list of intended inspections (if applicable):

- a. Soil bearing, sub-grade inspection and/or compaction
- b. Concrete field and plant testing & rebar placement
- c. Masonry or stone field inspection, mortar sampling, reinforcement placement inspection
- d. Structural steel field welding, bolting, connections, and metal deck
- e. Asphalt and sub-base inspection
- f. Soil compaction, density and sieve analysis testing, soil bearing
- g. Water and air infiltration for windows
- h. Roofing, flashing, waterproofing
- i. Under slab plumbing work
- j. Firestopping
- k. Fireproofing
- l. Asbestos air monitoring

5. Architect and Owner's Representative shall be notified forty-eight hours prior to the need of testing, in the event the Contractor does not give proper notification and the work is done with no test, that Contractor will bear all costs for such tests.

VIII. CHANGES TO THE WORK

- 1. Refer to the General Conditions for additional information pertaining to this subject.
- 2. All change proposals for extra work by the Prime Contractors shall be submitted to the Construction Manager, with a complete labor and material breakdown and on the basis of net difference in quantities. The Owner reserves the right to request adequate back up such as invoices, subcontractor quotes, etc., to substantiate the change order cost. Current labor rates for all trades are to be submitted to the Construction Manager by the respective Prime Contractors at the first scheduled job meeting. When both additions and deductions are involved in any one change, the allowance for overhead and profit shall be figured on the basis of net increase or decrease. All change requests shall include the following breakdown:
 - a. Materials (itemized breakdown)
 - b. Rental of equipment (itemized breakdown)
 - c. Labor (itemized breakdown)
 - d. Insurance
 - e. Subtotal
 - f. Overhead 10%
 - g. Subtotal
 - h. Subcontractor work (same as above, subcontractor O & P 10%)
 - i. Subtotal
 - j. Profit 5%
 - k. Subtotal
 - l. Bond charges 2%
 - m. Total change order

IX. SCHEDULE OF VALUES/PAYMENTS

1. Within one week after Notice to Proceed, the Prime Contractor shall submit a detailed billing breakdown on the AIA G702/ G703 form for approval by Construction Manager. No payments will be made until such billing breakdown is approved.
2. The schedule of values will be reviewed and adjusted if necessary. Once approved, the schedule of values is to be used for the AIA pay application. The schedule of value will take into account and include at minimum the following items:
 - a. **Bond/insurance based on actual invoice amount**
 - b. **Labor and material on line items as applicable**
 - c. **Submittals - 1% of contract sum**
 - d. **Punch list - 1% of contract sum**
 - e. **Close-out documents/warranties - 3% of the contract sum**
 - f. **Meeting Attendance & Meeting Documentation - 2% of the contract sum**
 - g. **Allowances**
 - h. **Approved Alternates**
 - i. **Labor and Material breakdown for each line item**

Note: Punch list value will be dispersed only when the work has been confirmed to be completed 100%.

ALL PAYMENT APPLICATIONS SHALL INCLUDE A 5% RETAINAGE FACTOR.

3. The Owner has elected to require the Prime Contractor to submit releases of liens with respect to all Work previously performed and for which payments were made under a preceding application. Beginning with the second payment requisition and with each subsequent payment requisition, each Prime Contractor shall furnish to Owner the following documents:
 1. Labor and/or Materials Affidavit
 2. Daily and Weekly Wage Affidavit
 3. Prime Contractor's-Partial Release and Wavier of Lien
4. Monthly Payment Applications for Payments shall be made as per Article 9 of the General Conditions of the Contract

X. PUNCH LIST:

1. Upon substantial completion of each phase of work, the Prime Contractors are to submit to the Owner/Construction Manager a letter declaring the work is substantial complete. Included with said letter is to be the Contractor's punchlist. Upon the receipt of above, the Construction Manager will schedule with the Owner, Architect, and Contractor a walk through to develop a single final punchlist. This single final punchlist agreed by all parties shall serve as the only punchlist. Upon failure to complete the final punchlist within two weeks from receipt, the Owner reserves the right to complete same and backcharge the costs of material, labor, supervision and other incidental costs.

XI. INSURANCE/INDEMNIFICATION

1. All Prime Contractors must issue a Certificate of Insurance with liability limits as defined in the Construction Documents naming Triton Construction Company, The Architect, and the School District as an 'Additional Insured' in addition to all other parties as stipulated in the General Conditions of the Contract in the project manual.
2. Builder's Risk Insurance: All costs associated with providing and purchasing a Builder's Risk Insurance Policy as described top of page PB-G-1.
3. All Prime Contractors agree to indemnify and hold harmless Triton Construction Company, The Architect, the School District, its agents and employees in addition to all other parties as stipulated in the General Conditions of the Contract in the project manual.
4. All Prime Contractors and Sub-Contractors/sub-subcontractor's/vendors/etc. insurance/indemnification shall comply with Article 10 "Insurance" and Article 12 "Indemnification" as specified in the General Conditions of the Contract in the project manual.

Specific Scope Requirements for Each Prime Contractor

Prime Contractor for General Construction (PCGC)

1. This Prime Contractor shall provide, for all the building construction work, all necessary site refuse containers and disposal services to maintain the site in a clean and safe condition. This Prime Contractor shall be responsible for emptying and/or replacing all containers on a regular basis or when full. All containers and disposal services shall be provided by a single entity. This Prime Contractor shall provide sufficient labor to keep the site clean on a daily basis and shall be responsible for providing the daily broom cleaning as necessary to maintain site safety.
2. This Prime Contractor shall coordinate with the; Electrician, Plumber and Mechanical Contractors to allow all Contractors unabated access to the building and surrounding work areas.
3. This Prime Contractor shall provide and maintain temporary chemical toilets for the duration of the project. The quantity of these toilets should be as required to properly maintain sanitary facilities and easy access for the personnel on the job. This quantity shall be a minimum of two toilets per major work area. This requirement shall include all necessary paper products, supplies and services, as well as the maintenance of these toilets until all work is complete and the Owner assumes partial occupancy of the building additions and renovations. As a minimum, this Contractor shall include the pumping and servicing of these toilets twice per week.
4. All Scaffolding or stair towers shall be designed and stamped by a licensed NYS PE. When designing this scaffolding consideration should be given to the environment, scaffolding system being used, means of access, means of tying the scaffolding to the structure, location, length of time to be erected, climate conditions, wrapping/containment of building, purpose of use, loadings, etc. all scaffolding and/ or stair tower access points must be secured while not in use. If and when needed, the scaffolding may be used for access by other Prime Contractors during construction- this contractor will not restrict access by others using the scaffold.

5. This Prime Contractor shall provide testing and inspection of the scaffolding on a daily basis and per governing regulation (e.g., OSHA). A log of these inspections are to be kept in the PCGC's job trailer, along with inspections tags that identify the status of the scaffolding (inspection dates, okay to use, caution, danger). Report to the Construction Manager all corrective work required through the course of the project.
6. As shown on the logistics plan, this Prime Contractor shall include in his bid price, all costs to provide an 8' ht. rental type chain link construction fencing and gates. All fencing shall have a tightly woven, blind screen mesh installed on the "construction" side of the fence. Mesh to be dark green or black. When directed by the Construction Manager, this Prime Contractor shall remove and dispose of this fencing and all related materials. Gates for man access shall be passive to the exterior of the jobsite during the event of an emergency but remain closed for un-authorized entry during construction. All gates shall be locked when the site is not active, with a double-keyed system, granting the District access to the site after-hours. Included in his bid price, this Prime Contractor shall allow a 1,000 if allowance of orange netting, to be used at the direction of the CM, Architect or Owner.
7. This Prime Contractor shall perform its steel erection according to their Site Logistics/Safety Plan. Booming steel over the Existing Building will not be permitted while occupied. Steel erection within 20 feet of an occupied building/space will require after-hours crane picks.
8. This Prime Contractor will repair, replace, correct, or finish grade, topsoil, and seed all areas with-in the construction site that was disturbed by the work of this project.
9. This Prime Contractor shall provide and maintain all temporary plastic barriers, partition walls, doors, hardware and plywood barriers for the duration of the project to separate work areas from public areas and to maintain security, dust, and noise control. Temporary partitions and doors will be painted with 1x coat of primer and 2x coats of paint for esthetics.
10. Construction Signage. The Prime Contractor shall include in his base price all construction signage required by OSHA. At the site fence, "Construction Area keep out", "Hard Hats Required" and "Authorized personal only" signage shall be posted every 25' on site fencing. This Prime Contractor shall reference the logistics plans for each project to include any other signage designated for entry gates. Signs shall be made of either metal or durable PVC to endure the project duration.
11. Professional Cleaning: The PCGC shall provide a professional commercial cleaning service to prepare all areas of interior construction for use and to provide a final cleaning after substantial completion is achieved and after direction to provide such service is received from the Construction Manager. This work shall be completed in cooperation with the building maintenance staff and their respective procedures. As part of this service, the PCGC shall wax all new or repaired floors, and, wash or clean all walls, doors, windows, frames, casework, blinds, unit ventilators, shelves, counters, toilet fixture, sinks, equipment, etc. All work shall be performed in place or on site and does not include sending items out for service or special cleaning operations. Building Services shall provide this Contractor with the necessary paper products, hand soaps, trash liners and other products to fill (one time) any dispensers or accessories in order for these items to be prepared for use.
12. Unless specifically noted on the contract documents, this Prime Contractor will provide all concrete equipment pads as shown on the contract documents. All other primes will provide pad sizes and locations.

13. This Prime Contractor is responsible for protection of finished work. Including but not limited to; floors, walls, and doors. This General Contractor will provide, maintain, and remove the appropriate protection materials necessary to adequately protect his finished product.
14. This Prime Contractor should note there are numerous areas where the existing ceilings are remaining. This Contractor will be required to remove and reinstall any ceilings displaced by installation of this Contractor's Work. If open ceilings are not replaced within a twenty-four-hour period after a request by the Construction Manager, either verbal or written, the Construction Manager will have said ceilings reinstalled and all related costs will be back charged to said Contractor.
15. Unless otherwise noted in the construction documents, this Prime Contractor will repair and patch all walls, floors, and ceilings to match adjacent finishes after the removal of interior partitions, ceilings, floors, M.E.P. SP. Conduit, piping and ductwork. This includes all walls and ceilings above finished ceilings or spaces. Each Prime Contractor will cut and cap their own work inside finished walls, floors and ceilings.
16. This Prime Contractor shall provide fire extinguishers for the life of the project, the extinguishers are to be hung and identified as per OSHA requirements (1 per 3000 sq ft, or better). These extinguishers are to be re-charged and inspected for the life of the project.
17. If due to location of fabrication plant, a local storage yard is required, all cost associated with this storage yard including receiving, unloading, storing, shake-out, reloading, and delivery to the site shall be this Prime Contractors' cost.
 - a) The Owner may have an Inspector at the plant during the fabrication period. Appropriate access shall be provided at all times for this individual.
18. Abatement Work: This Prime Contractor will be responsible to hire a qualified and DOL licensed Abatement Contractor to perform the Hazardous Material removal at areas involved. This work will only take place during the summer recess. If the work is unable to be completed by the end of the summer, abatement will only take place during prolong holiday weeks after students return.
19. Under slab MEP Trenching at New Slabs: This Prime contractor will be responsible to coordinate with his subcontractors and other Prime Contractors through the Contract Documents and the Coordination Drawings, for any under-slab piping. This Prime Contractor (PCGC) will be responsible to provide the trenching, bedding, backfill and compaction for such MEP under-slab items. As a single Prime Contractor, the PCGC's subcontractors and other Prime Contractors will be responsible to provide a final layout to the PCGC, prior to trenching. Each MEP contractor will be responsible to level the piping with provided bedding from the PCGC, testing the piping prior to back filling.
20. Trenching at existing slabs: This Prime contractor will be responsible to coordinate with his subcontractors and other Prime Contractors to survey, sawcut, trench, lay bedding, backfill trench, dowel existing slab and place new concrete to be level to receive new floor finishes. Where slabs are receiving new floors, This Prime Contractor (PCGC) will provide any corrective patching to the top-of-slab and install the new finish floor. Where existing flooring is to remain and be patched; this Prime Contractor will also be responsible to match the existing finish, prepare and install new material, at approval of the Architect and CM.
21. This Prime Contractor will provide new ductwork penetrations greater than 12"x12" for the HVAC subcontractors in walls, ceilings, or floors, as well as any structural support necessary.

22. This Prime Contractor is required to fire stop and/ or smoke stop all walls, floors and ceilings after completion of all their own work., including their subcontractors.

Prime Contractor for Mechanical (PCM)

1. The PCGC shall provide dumpsters for this contractor to use for day-to-day rubbish. Each Contractor is responsible for collecting, moving, placing, breaking down boxes and pallets, and disposing rubbish, on a daily basis, all debris from their activities into a dumpster supplied by the PCGC. Each Contractor is responsible to broom clean the areas they worked in at the end of each day. This Prime Contractor will include in his bid price the provision to remove large HVAC equipment from the site, at his own costs, including but not limited to RTUs, Chillers, Cooling Towers, Unit Ventilators, and Air Handlers.
2. This Subcontractor for Mechanical should note there are numerous areas where the existing ceilings are remaining. This Contractor will be required to remove and reinstall any ceilings displaced by installation of this Contractor's work. If open ceilings are not replaced within a twenty-four-hour period after a request by the Construction Manager, either verbal or written, the Construction Manager will have said ceilings reinstalled and all related costs will be back charged to said PCGC.
3. Unless otherwise noted in the construction documents, this Subcontractor will cut and cap their own work inside finished walls, floors and ceilings.
4. Each Subcontractor is required to fire stop and/ or smoke stop all walls, floors and ceilings after completion of all their own work.
5. This Subcontractor is responsible for protection of finished work. This Subcontractor will provide, maintain, and remove the appropriate protection materials necessary to adequately protect his finished product.
6. Both louvers openings and duct-work openings in excess 12"x12" in walls, or slabs, will be provided by the PCGC prime contractor at the new additions. This Subcontractor (Mechanical) will be responsible for all other openings, including saw cutting, core-drilling and alike.

Prime Contractor for Electrical (PCE)

1. The Prime Contractor for General Construction (PCGC) shall provide dumpsters. Each Prime Contractor is responsible for collecting, moving, placing, breaking down boxes and pallets, and disposing rubbish, on a daily basis, all debris from their activities into a dumpster supplied by the PCGC. Each Prime Contractor is responsible to broom clean the areas they worked in at the end of each day.
2. The Prime Contractor for Electrical is to temporarily support existing ceiling mounted equipment/devices (i.e., speakers, fire alarm apparatuses, exit signs, wiring, light fixtures, etc.) as required for demolition of existing ceilings until new equipment/devices are installed or existing equipment/device can be permanently remounted in the new ceiling.

3. The Prime Contractor for Electrical shall provide and keep temporary light and power operational for a period of from fifteen minutes before the earliest starting time of the earliest trade, to fifteen minutes after the established quitting time of the trade which stops latest in the evening (fifteen foot candles) throughout the entire building (normal working hours 7:00 am to 4:00 pm). This applies to all scheduled workdays, Monday through Saturday inclusive, which are established as regular workdays for any trade engaged in the work, including such days that are holidays for Electricians but are regular workdays for other trades. These services are to be kept operational until the CM determines that they are no longer required for the execution of the work. Temporary light shall consist of a minimum of (1) bulb and cage per 10 square feet of floor space in all spaces no matter of size throughout the existing building spaces being renovated.
4. The Prime Contractor for Electrical shall include in his base price all costs associated with providing and maintaining adequate temporary light and power to all areas of work required by the construction documents. Each major area of work shall be provided with an adequately sized distribution panel for temporary light and power
5. The Prime Contractor for Electrical shall provide temporary power for masonry work, mixers, steel work, or fire proofing work, compressors etc. that may require 220V temporary power. Power is to be provided at each major area of work if required.
6. The Prime Contractor for Electrical should note there are numerous areas where the existing ceilings are remaining. This Contractor will be required to remove and reinstall any ceilings displaced by installation of this Contractor's work. If open ceilings are not replaced within a twenty-four-hour period after a request by the Construction Manager, either verbal or written, the Construction Manager will have said ceilings reinstalled and all related costs will be back charged to said Contractor.
7. The Prime Contractor for Electrical shall replace all burned out light bulbs when building is turned over to the owner at substantial completion.
8. Unless otherwise noted in the construction documents, this Prime Contractor will cut and cap their own work inside finished walls, floors and ceilings.
9. Each Prime Contractor is required to fire stop and/ or smoke stop all walls, floors and ceilings after completion of all their own work.
10. This Prime Contractor is responsible for protection of finished work. This Prime Contractor will provide, maintain, and remove the appropriate protection materials necessary to adequately protect his finished product.
11. This Prime Contractor will modify all existing Fire Alarm devices that are part of the existing building being renovated, maintain the devices throughout construction, and or disconnect as needed. This Prime Contractor will assure that no troubles exist, by hiring a Fire Alarm vendor who is licensed to modify the existing Fire Alarm system to accept any temporary changes through construction.

12. This Prime Contractor is to develop a separate site-specific electrical service shutdown/upgrade schedule within four weeks after Notice to Proceed. This schedule will be developed in conjunction with the Construction Manager and the Owner. No shutdown/transfer will be permitted at any time without prior written notification. The Prime Contractor for Electrical shall provide temporary power for all 'others' work ongoing at the site during any electrical shutdown or transfer period that would otherwise deny other Contractors power. No shutdown or transfer shall be allowed during active school hours. Any and all shutdowns must be scheduled on the Owners off days (weekends, holidays). Any shutdown longer than three days will require this Prime Contractor to supply temporary power for the Owner (i.e., generators). The Electrical Prime Contractor shall provide a minimum of forty-eight hours' notice to the Owner and the Construction Manager or any necessary power shutdown.
13. Trenching under slab (New/Existing): This Prime contractor will be responsible to layout all locations for any under slab piping. The Prime Contractor for General Construction will be responsible to include trenching provisions for under-slab work where indicated on the plans at new slab locations. This Prime Contractor (PCP) will lay all piping, leveling piping, test and allow the PCGC to backfill in time not to disturb the overall project schedule. This Prime contractor (PCE) will be responsible to sawcut any existing slabs required to install piping, trench, lay bedding and patch the slab to accept new finishes provide by a skilled tradesman hired by this Prime Contractor.

Prime Contractor for Plumbing (PCP)

1. The Prime Contractor for General Construction (PCGC) shall provide dumpsters. Each Prime Contractor is responsible for collecting, moving, placing, breaking down boxes and pallets, and disposing rubbish on a daily basis, all debris from their activities into a dumpster supplied by the PCGC. Each Prime Contractor is responsible to broom clean the areas they worked in at the end of each day.
2. The Prime Contractor for Plumbing is to make sure non affected areas of the building will not have service interrupted whether it be water and/or sewer.
3. The Prime Contractor for Plumbing shall schedule any water shutdown in advance with the CM and Owner. No shutdown/transfer will be permitted at any time without prior written notification.
4. No shutdown or transfer shall be allowed during active school hours. Any and all shutdowns must be scheduled on the Owners off days (weekends, holidays). The Plumbing Prime Contractor shall provide a minimum of forty-eight hours' notice to the Owner and the Construction Manager.
5. Unless otherwise noted in the construction documents this Prime Contractor will cut and cap their own work inside finished walls, floors and ceilings.
6. Each Prime Contractor is required to fire stop and/ or smoke stop all walls, floors and ceilings after completion of all their own work.
7. This Prime Contractor is responsible for protection of finished work. This Prime Contractor will provide, maintain, and remove the appropriate protection materials necessary to adequately protect his finished product.

8. Trenching under slab (New/Existing): This Prime contractor will be responsible to layout all locations for any under slab piping. The Prime Contractor for General Construction will be responsible to include trenching provisions for under-slab work where indicated on the plans at new slab locations. This Prime Contractor (PCP) will lay all piping, leveling piping, test and allow the PCGC to backfill in time not to disturb the overall project schedule. This Prime contractor (PCE) will be responsible to sawcut any existing slabs required to install piping, trench, lay bedding and patch the slab to accept new finishes provide by a skilled tradesman hired by this Prime Contractor.

PART 1 GENERAL

1.01 SECTION INCLUDES

- A. Fire alarm system design and installation, including all components, wiring, and conduit.
- B. Replacement and removal of existing fire alarm system components, wiring, and conduit indicated.

1.02 REFERENCE STANDARDS

- A. 36 CFR 1191 - Americans with Disabilities Act (ADA) Accessibility Guidelines for Buildings and Facilities; Architectural Barriers Act (ABA) Accessibility Guidelines; current edition.
- B. ADA Standards - Americans with Disabilities Act (ADA) Standards for Accessible Design; 2010.
- C. NFPA 70 - National Electrical Code; Most Recent Edition Adopted by Authority Having Jurisdiction, Including All Applicable Amendments and Supplements.
- D. NFPA 72 - National Fire Alarm and Signaling Code; Most Recent Edition Cited by Referring Code or Reference Standard.

1.03 SUBMITTALS

- A. Design Documents: Submit all information required for plan review and permitting by authorities having jurisdiction, including but not limited to floor plans, riser diagrams, and description of operation:
 - 1. Copy (if any) of list of data required by authority having jurisdiction.
 - 2. NFPA 72 "Record of Completion", filled out to the extent known at the time.
 - 3. Manufacturer's detailed data sheet for each component, including wiring diagrams, installation instructions, and circuit length limitations.
 - 4. Certification by either the manufacturer of the control unit or by the manufacturer of each other component that the components are compatible with the control unit.
 - 5. Certification by Contractor that the system design complies with Contract Documents.
 - 6. Do not show existing components to be removed.
- B. Evidence of installer qualifications.
- C. Inspection and Test Reports:
 - 1. Submit inspection and test plan prior to closeout demonstration.
 - 2. Submit documentation of satisfactory inspections and tests.
 - 3. Submit NFPA 72 "Inspection and Test Form," filled out.
- D. Project Record Documents: See Section 017800 for additional requirements; have one set available during closeout demonstration:
 - 1. Complete set of floor plans showing actual installed locations of components, conduit, and zones.
 - 2. "As installed" wiring and schematic diagrams, with final terminal identifications.
 - 3. "As programmed" operating sequences, including control events by device, updated input/output chart, and voice messages by event.

1.04 QUALITY ASSURANCE

- A. Installer Qualifications: Firm with minimum 3 years documented experience installing fire alarm systems of the specified type and providing contract maintenance service as a regular part of their business.

1. Authorized representative of control unit manufacturer; submit manufacturer's certification that installer is authorized; include name and title of manufacturer's representative making certification.
2. Installer Personnel: At least 2 years of experience installing fire alarm systems.
3. Supervisor: NICET level III or IV (3 or 4) certified fire alarm technician; furnish name and address.

PART 2 PRODUCTS

2.01 MANUFACTURERS

- A. Fire Alarm Control Units and Accessories:
- B. Initiating Devices and Notification Appliances:
 1. Same manufacturer as control units.

2.02 FIRE ALARM SYSTEM

- A. Fire Alarm System: Provide modifications and extensions to the existing automatic fire detection and alarm system:
 1. Provide all components necessary, regardless of whether shown in Contract Documents or not.
 2. Existing Fire Alarm Control Unit is an Edwards EST-3.
 3. Comply with the following; where requirements conflict, order of precedence of requirements is as listed:
 - a. ADA Standards.
 - b. The requirements of the local authority having jurisdiction.
 - c. Applicable local codes.
 - d. Contract Documents (drawings and specifications).
 - e. NFPA 72; where the word "should" is used consider that provision mandatory; where conflicts between requirements require deviation from NFPA 72, identify deviations clearly on design documents.
- B. Circuits:
 1. Initiating Device Circuits (IDC): Class B, Style A.
 2. Signaling Line Circuits (SLC) Within Single Building: Class B, Style 0.5.
 3. Notification Appliance Circuits (NAC): Class B, Style W.
- C. Power Sources:
 1. Primary: Dedicated branch circuits of the facility power distribution system.
 2. Secondary: Storage batteries.
 3. Capacity: Sufficient to operate entire system for period specified by NFPA 72.
 4. Each Computer System: Provide uninterruptible power supply (UPS).

2.03 EXISTING COMPONENTS

- A. Existing Fire Alarm System: Remove existing components indicated and incorporate remaining components into new system, under warranty as if they were new; do not take existing portions of system out of service until new portions are fully operational, tested, and connected to existing system.
- B. Clearly label components that are "Not In Service."
- C. Remove unused existing components and materials from site and dispose of properly.

2.04 FIRE SAFETY SYSTEMS INTERFACES

- A. Supervision: Provide supervisory signals in accordance with NFPA 72 for the following:
- B. Alarm: Provide alarm initiation in accordance with NFPA 72 for the following:

2.05 COMPONENTS

- A. General:
 - 1. Provide flush mounted units where installed in finish areas; in unfinished areas, surface mounted unit are acceptable.
 - 2. Provide legible, permanent labels for each control device, using identification used in operation and maintenance data.
- B. Fire Alarm Control Units: Analog, addressable type; listed, classified, and labeled as suitable for the purpose intended.
- C. Addressable Fire Alarm Control Unit - Basis of Design: Edwards.
- D. Initiating Devices:
 - 1. Addressable Systems:
 - a. Addressable Devices: Individually identifiable by addressable fire alarm control unit.
 - b. Provide suitable addressable interface modules as indicated or as required for connection to conventional (non-addressable) devices and other components that provide a dry closure output.
 - 2. Smoke Detectors: Edwards.
 - 3. Heat Detectors: Edwards.
- E. Notification Appliances:
 - 1. Strobes: Edwards Genesis Series.
- F. Circuit Conductors: Copper; provide 200 feet (60 m) extra; color code and label.

PART 3 EXECUTION

3.01 INSTALLATION

- A. Install in accordance with applicable codes, NFPA 72, NFPA 70, and Contract Documents.
- B. Conceal all wiring, conduit, boxes, and supports where installed in finished areas.

3.02 INSPECTION AND TESTING FOR COMPLETION

- A. Notify Owner 7 days prior to beginning completion inspections and tests.
- B. Notify authorities having jurisdiction and comply with their requirements for scheduling inspections and tests and for observation by their personnel.
- C. Provide the services of the installer's supervisor or person with equivalent qualifications to supervise inspection and testing, correction, and adjustments.
- D. Prepare for testing by ensuring that all work is complete and correct; perform preliminary tests as required.
- E. Provide all tools, software, and supplies required to accomplish inspection and testing.

- F. Perform inspection and testing in accordance with NFPA 72 and requirements of local authorities; document each inspection and test.
- G. Correct defective work, adjust for proper operation, and retest until entire system complies with Contract Documents.

3.03 CLOSEOUT

END OF SECTION

Note: The bidder is asked to use either black ink or typewriter (black ribbon) in completing this proposal form. Each line item amount must be completed. Failure to do so will be grounds for disqualification of the bidder.

BASE BID: Contract E – Electrical Construction Work
--

ITEM 1 – BONDS and INSURANCES

(written in words) _____ (\$)

ITEM 2 – DIVISION 1 – GENERAL REQUIREMENTS

(written in words) _____ (\$)

ITEM 3 – DIVISION 1 – PROJECT SUPERVISION

(written in words) _____ (\$)

ITEM 4 – DIVISION 7 – FIRE STOPPING

(written in words) _____ (\$)

ITEM 5 – DIVISION 26 – ELECTRICAL DEMOLITION

(written in words) _____ (\$)

ITEM 6 – DIVISION 26 – CONDUCTORS AND CABLES

(written in words) _____ (\$)

ITEM 7 – DIVISION 26 – GROUNDING AND BONDING

(written in words) _____ (\$)

ITEM 8 – DIVISION 26 – SUPPORT DEVICES and HANGERS

(written in words) _____ (\$)

ITEM 9 – DIVISION 26 – CONDUIT

(written in words) _____ (\$)

ITEM 10 – DIVISION 26 – BOXES and WIREWAYS

(written in words) _____ (\$)

ITEM 11 – DIVISION 26 – ELECTRICAL IDENTIFICATION

(written in words) _____ (\$)

ITEM 12 – DIVISION 26 – LIGHTING CONTROL DEVICES

(written in words) _____ (\$)

PROPOSAL
WHITE PLAINS SCHOOL DISTRICT

ITEM 13 – DIVISION 26 – WIRING DEVICES

(written in words) _____ (\$)

ITEM 14 – DIVISION 26 – LIGHTING

(written in words) _____ (\$)

ITEM 15 – DIVISION 28 – ALARM, SIGNAL & DETECTION

(written in words) _____ (\$)

ITEM 16 – AS-BUILT DRAWINGS

(written in words) _____ (\$)

ITEM 17 – PROJECT CLOSEOUT

(written in words) _____ (\$)

ALLOWANCE E1 – ALLOWANCE FOR GENERAL CONTINGENCY

(written in words) Ten Thousand Dollars and 00 Cents (\$ **10,000.00**)

TOTAL BASE BID (ITEMS 1 – 17 INCLUSIVE, PLUS ALLOWANCE E1)

(written in words) _____ (\$)

ALTERNATES

The contractor shall clearly state whether cost indicated is to be added to or deducted from the base bid cost. Failure to clearly state same will be grounds for disqualification of the bidder.

All work included under this heading shall be subject to the general conditions of the project. All construction, workmanship and finishes required by the alternates shall be as specified in the applicable sections of the specifications manual.

The undersigned proposes and agrees that should the following alternates be accepted and included in the contract, the amount of the TOTAL BASE BID will be revised as follows. The undersigned further agrees that should the following Alternates be accepted at a subsequent date, after the base bid contract is awarded, due to additional funds provided to the school district through a Smart Schools Bond Act, the alternate bid prices indicated shall be held and honored for a period of one year from the date of contract signing.

NUMBER	DESCRIPTION	COST
ALT-E1 (Add)	Provide all electrical and demolition work associated with the removal and disposal of existing lighting and ceiling & wall mounted equipment, and associated items where indicated in drawing. Contractor to provide and install new lighting and ceiling & wall mounted equipment and associated items where indicated in drawings. This alternate shall include all material and labor for this work.	(\$)

PROPOSAL
WHITE PLAINS SCHOOL DISTRICT

ALT-E2 (Add)	Builder's Risk Insurance: All costs associated with providing and purchasing a Builder's Risk Insurance Policy to include interest of the Owner and Contractor jointly in a form satisfactory to the owner. The limit must reflect the total completed value – all material and labor costs and provide coverage for fire, lightning, explosion, extended coverage, vandalism, malicious mischief, windstorm, hail and/or flood.	(\$)
-----------------	---	--------

Note: The WHITE PLAINS CITY SCHOOL DISTRICT is exempt from Federal, New York State and local taxes. TOTAL AMOUNT BID shall be exclusive of all taxes.

EACH BIDDER SHALL SUBMIT WITH IT'S BID A SEPARATE SEALED LIST THAT NAMES THE SUBCONTRACTORS THAT THE BIDDER WILL USE TO PERFORM WORK AND THE AGREED UPON AMOUNT TO BE PAID FOR A.) HEATING, VENTILATION AND AIR-CONDITIONING WORK, B.) PLUMBING WORK AND C.) ELECTRICAL WORK. AFTER THE LOW BID IS ANNOUNCED, THE SEALED LIST OF SUBCONTRACTORS SUBMITTED BY THE APPARENT LOW BIDDER SHALL BE OPENED AND THE NAMES OF THE SUBCONTRACTORS ANNOUNCED. ANY CHANGE OF SUBCONTRACTOR OR AGREED UPON AMOUNT TO BE PAID SHALL REQUIRE THE APPROVAL OF THE PUBLIC OWNER, UPON A SHOWING OF "LEGITIMATE CONSTRUCTION NEED" FOR SUCH CHANGE.

"LEGITIMATE CONSTRUCTION NEED" SHALL INCLUDE, BUT NOT BE LIMITED TO:

A CHANGE IN PROJECT SPECIFICATIONS,
A CHANGE IN CONSTRUCTION MATERIAL COSTS,
A CHANGE IN SUBCONTRACTOR STATUS, OR
THE SUBCONTRACTOR HAS BECOME UNWILLING, UNABLE OR UNAVAILABLE TO PERFORM THE SUBCONTRACT.

THE SEALED LISTS OF SUBCONTRACTORS SUBMITTED BY ALL OTHER BIDDERS SHALL BE RETURNED TO THEM UNOPENED AFTER THE CONTRACT AWARD.

PAYMENTS TO SUBCONTRACTORS AND MATERIAL MEN MUST BE MADE WITHIN 7 CALENDAR DAYS AS OPPOSED TO 15 CALENDAR DAYS OF THE RECEIPT OF PAYMENT FROM THE PUBLIC OWNER. FAILURE TO PAY WITHIN 7 CALENDAR DAYS WILL RESULT IN INTEREST DUE FOR ALL CALENDAR DAYS SUBSEQUENT TO THE SEVENTH DAY THROUGH THE DATE THAT PAYMENT IS MADE.

THE BIDDER UNDERSTANDS THAT THE OWNER RESERVES THE RIGHT TO REJECT ANY OR ALL BIDS AND TO WAIVE ANY INFORMALITIES IN THE BIDDING.

THE BIDDER AGREES THAT THE BID SHALL BE GOOD AND MAY NOT BE WITHDRAWN FOR A PERIOD OF **FORTY-FIVE (45)** CALENDAR DAYS AFTER THE SCHEDULED CLOSING TIME FOR RECEIVING BIDS.

THE BIDDER HAS SUBMITTED ALL REQUESTS FOR OTHER BRAND NAMES OR PRODUCTS NOT LISTED IN THE SPECIFICATIONS IN ACCORDANCE WITH ARTICLE 6(W) OF THE GENERAL CONDITIONS OF THE CONTRACT FOR CONSTRUCTION.

SITE SUPERVISION

THE SUCCESSFUL CONTRACTOR IS TO PROVIDE FULL TIME SITE SUPERVISION FOR HIS OR HER STAFF, SUBCONTRACTORS AND SUPPLIERS FOR THE DURATION OF THIS PROJECT. A COMPETENT SUPERINTENDENT SHALL BE IN ATTENDANCE AT THE JOB SITE AT ALL TIMES WHEN WORK IS BEING PERFORMED UNDER THEIR CONTRACT. THE SUPERINTENDENT IS RESPONSIBLE TO VISIT THE JOB SITE DAILY WHEN WORK IS NOT BEING PERFORMED UNDER THEIR CONTRACT

PROPOSAL
WHITE PLAINS SCHOOL DISTRICT

AND TO MONITOR THE OVERALL CONSTRUCTION PROGRESS. A QUALIFIED SITE SUPERINTENDENT MUST HAVE THE AUTHORITY TO REPRESENT AND MAKE DECISIONS FOR HIS OR HER COMPANY WITH REGARDS TO THE SUBJECT JOB, MUST BE ABLE TO GIVE GUIDANCE AND DIRECTION TO EMPLOYEES, SUBCONTRACTORS AND SUPPLIERS, AND MUST BE KNOWLEDGEABLE ABOUT THE WORK TO BE PROVIDED. **FAILURE TO PROVIDE A QUALIFIED SITE SUPERINTENDENT AT THE JOB SITE SHALL SUBJECT SAID PRIME CONTRACTOR TO A PENALTY OF \$1,000 PER DAY FOR EVERY OCCURRENCE.**

TIME OF COMPLETION

ALL WORK UNDER THIS CONTRACT SHALL BE COMPLETED BETWEEN THE FOLLOWING HOURS, IN ACCORDANCE WITH THE FOLLOWING DATES:

WORK DAYS:	Monday – Saturday
WORK HOURS:	7:00 AM - 8:00 PM
CONSTRUCTION START DATE:	MONDAY, JUNE 27TH, 2022
SUBSTANTIAL COMPLETION:	FRIDAY, AUGUST 19TH, 2022
FINAL COMPLETION:	FRIDAY, SEPTEMBER 2ND, 2022

IF NECESSARY, WEEKEND, HOLIDAY AND EVENING WORK SHALL BE PROVIDED TO ENSURE THE COMPLETION DATES LISTED ABOVE, AT THE SOLE COST AND EXPENSE OF THE BIDDER.

FAILURE OF THE CONTRACTOR TO COMPLETE WORK BY THE SPECIFIED TIME SHALL SUBJECT HIM/HER TO LIQUIDATED DAMAGES AS SET FORTH IN ARTICLE 13 OF THE GENERAL CONDITIONS.

THE CONSTRUCTION MANAGER SHALL ACT AS THE RECORD KEEPER OF CONTRACT DAYS; HE WILL BE THE SOLE JUDGE OF DELAYS CAUSED BY WEATHER. ONLY WEATHER DELAYS, AS ADJUDGED BY THE CONSTRUCTION MANAGER, WILL BE CONSIDERED FOR EXTENSIONS OF THE CONSTRUCTION PERIOD. THE CONTRACTOR SHALL SUBMIT A BI-WEEKLY REQUEST FOR DELAYS DUE TO WEATHER TO THE CONSTRUCTION MANAGER FOR APPROVAL. NO OTHER DELAY CLAIMS WILL BE ACCEPTED, FOR CREDIT TOWARDS THE PROJECT COMPLETION SCHEDULE, REGARDLESS OF THE SOURCE OF THE DELAY.

FAILURE OF THE CONTRACTOR TO COMPLETE ALL WORK SHOWN AND SPECIFIED IN THE CONTRACT DOCUMENTS, BY ALL OF THE SPECIFIED TIME FRAMES, SHALL SUBJECT THE CONTRACTOR TO LIQUIDATED DAMAGES, AS SET FORTH IN ARTICLE 13 OF THE GENERAL CONDITIONS OF THE CONTRACT FOR CONSTRUCTION, IN THE SUM OF ONE THOUSAND DOLLARS (\$1,000.00) PER CALENDAR DAY. SUCH DAMAGES WILL COMMENCE ON THE DAY AFTER THE COMPLETION DATE OR THE DAY AFTER ANY LISTED MILESTONE DATE IN THE NOTICE TO PROCEED.

WITHIN TEN (10) CONSECUTIVE CALENDAR DAYS AFTER THE DATE OF THE NOTICE OF AWARD, THE BIDDER SHALL EXECUTE THE CONTRACT AND FURNISH THE REQUIRED PERFORMANCE BOND, PAYMENT BOND AND INSURANCES.

THE BOARD OF EDUCATION OF THE DISTRICT RESERVES THE RIGHT TO AWARD THIS CONTRACT TO OTHER THAN THE LOW BIDDER IF THE LAW SO PERMITS.

PROPOSAL
WHITE PLAINS SCHOOL DISTRICT

THE UNDERSIGNED HEREBY ACKNOWLEDGES RECEIPT OF THE FOLLOWING ADDENDA (IF ANY):

ADDENDUM NO.

DATED

SPECIFIC DAMAGES WILL BE ASSESSED AND DEDUCTED FROM AMOUNTS OTHERWISE DUE THE CONTRACTOR FOR ADDITIONAL INSPECTION (FIELD) AND CONTRACT ADMINISTRATION (OFFICE) TIME EXPENDED BY THE ARCHITECT/ENGINEER AND/OR OTHER CONSTRUCTION EMPLOYEE(S) HIRED TO ADMINISTER OR OBSERVE THE CONTRACT, SHOULD THE CONTRACTOR COMPLETE THE CONTRACT BEYOND THE CONTRACT COMPLETION PERIOD SPECIFIED ABOVE.

SUCH DEDUCTION SHALL BE IN ACCORDANCE WITH THE ARCHITECT, ENGINEER'S, AND/OR OTHER CONSTRUCTION EMPLOYEE(S) STANDARD HOURLY BILLING RATES IN EFFECT AT THE TIME FOR THE SCHOOL DISTRICT.

THE REQUIREMENTS OF THE PROPOSAL HAVE BEEN COMPLETELY READ, UNDERSTOOD AND ACKNOWLEDGED BY THE BIDDER.

BIDDER: _____

BIDDER'S ADDRESS: _____

SIGNED BY: _____ TITLE: _____

DATE: _____

Telephone number where the contractor or a competent representative can accept a telephone message and provide a reasonable reply as soon as possible, but not later than twenty-four (24) hours:

DAY: () _____ NIGHT: () _____

FAX: () _____

FEDERAL I.D. NO. OR SOCIAL SECURITY NO.: _____

Note: The bidder is asked to use either black ink or typewriter (black ribbon) in completing this proposal form. Each line item amount must be completed. Failure to do so will be grounds for disqualification of the bidder.

BASE BID: Contract G – General Construction and Asbestos Abatement Work

ITEM 1 – BONDS and INSURANCES

(written in words) _____ (\$)

ITEM 2 – DIVISION 1 – GENERAL REQUIREMENTS

(written in words) _____ (\$)

ITEM 3 – DIVISION 1 – PROJECT SUPERVISION

(written in words) _____ (\$)

ITEM 4 – DIVISION 2 – EXISTING CONDITIONS & DEMOLITION WORK

(written in words) _____ (\$)

ITEM 5 – DIVISION 2 – LEAD AND ASBESTOS REMOVAL

(written in words) _____ (\$)

ITEM 6 – DIVISION 3 – CONCRETE

(written in words) _____ (\$)

ITEM 7 – DIVISION 4 – MASONRY

(written in words) _____ (\$)

ITEM 8 – DIVISION 5 – METALS

(written in words) _____ (\$)

ITEM 9 – DIVISION 6 – WOOD, PLASTICS AND COMPOSITES

(written in words) _____ (\$)

ITEM 10 – DIVISION 7 – THERMAL and MOISTURE PROTECTION

(written in words) _____ (\$)

ITEM 11 – DIVISION 8 – OPENINGS

(written in words) _____ (\$)

ITEM 12 – DIVISION 9 - FINISHES

(written in words) _____ (\$)

ITEM 13 – DIVISION 10 - SPECIALTIES

(written in words) _____ (\$ _____)

ITEM 14 – DIVISION 12 - FURNISHINGS

(written in words) _____ (\$ _____)

ITEM 15 – PROJECT CLOSEOUT

(written in words) _____ (\$ _____)

ALLOWANCE G1 – ALLOWANCE FOR GENERAL CONTINGENCY

(written in words) Fourty Thousand Dollars and 00 Cents (\$40,000.00)

ALLOWNACE G2 – ALLOWANCE FOR ASBESTOS ABATEMENT

(written in words) Ten Thousand Dollars and 00 Cents (\$10,000.00)

TOTAL BASE BID (ITEMS 1 – 15 INCLUSIVE, PLUS ALLOWANCE G1 AND G2)

(written in words) _____ (\$ _____)

ALTERNATES

The contractor shall clearly state whether cost indicated is to be added to or deducted from the base bid cost. Failure to clearly state same will be grounds for disqualification of the bidder.

All work included under this heading shall be subject to the general conditions of the project. All construction, workmanship and finishes required by the alternates shall be as specified in the applicable sections of the specifications manual.

The undersigned proposes and agrees that should the following alternates be accepted and included in the contract, the amount of the TOTAL BASE BID will be revised as follows. The undersigned further agrees that should the following Alternates be accepted at a subsequent date, after the base bid contract is awarded, due to additional funds provided to the school district through a Smart Schools Bond Act, the alternate bid prices indicated shall be held and honored for a period of one year from the date of contract signing.

NUMBER	DESCRIPTION	COST
ALT-G1 (Add)	Provide all general construction and demolition work associated with the removal and disposal of existing spline ceiling system, and associated items where indicated in drawings. Contractor to provide and install new acoustical ceiling system and associated items where indicated in drawings. This alternate shall include all material and labor for this work.	(\$ _____)
ALT-G2 (Add)	Builder's Risk Insurance: All costs associated with providing and purchasing a Builder's Risk Insurance Policy to include interest of the Owner and Contractor jointly in a form satisfactory to the owner. The limit must reflect the total completed value – all material and labor costs and provide coverage for fire, lightning, explosion, extended coverage, vandalism, malicious mischief, windstorm, hail and/or flood.	(\$ _____)

Note: The WHITE PLAINS CITY SCHOOL DISTRICT is exempt from Federal, New York State and local taxes. TOTAL AMOUNT BID shall be exclusive of all taxes.

EACH BIDDER SHALL SUBMIT WITH IT'S BID A SEPARATE SEALED LIST THAT NAMES THE SUBCONTRACTORS THAT THE BIDDER WILL USE TO PERFORM WORK AND THE AGREED UPON AMOUNT TO BE PAID FOR A.) HEATING, VENTILATION AND AIR-CONDITIONING WORK, B.) PLUMBING WORK AND C.) ELECTRICAL WORK. AFTER THE LOW BID IS ANNOUNCED, THE SEALED LIST OF SUBCONTRACTORS SUBMITTED BY THE APPARENT LOW BIDDER SHALL BE OPENED AND THE NAMES OF THE SUBCONTRACTORS ANNOUNCED. ANY CHANGE OF SUBCONTRACTOR OR AGREED UPON AMOUNT TO BE PAID SHALL REQUIRE THE APPROVAL OF THE PUBLIC OWNER, UPON A SHOWING OF "LEGITIMATE CONSTRUCTION NEED" FOR SUCH CHANGE.

"LEGITIMATE CONSTRUCTION NEED" SHALL INCLUDE, BUT NOT BE LIMITED TO:

A CHANGE IN PROJECT SPECIFICATIONS,
A CHANGE IN CONSTRUCTION MATERIAL COSTS,
A CHANGE IN SUBCONTRACTOR STATUS, OR
THE SUBCONTRACTOR HAS BECOME UNWILLING, UNABLE OR UNAVAILABLE TO PERFORM THE SUBCONTRACT.

THE SEALED LISTS OF SUBCONTRACTORS SUBMITTED BY ALL OTHER BIDDERS SHALL BE RETURNED TO THEM UNOPENED AFTER THE CONTRACT AWARD.

PAYMENTS TO SUBCONTRACTORS AND MATERIAL MEN MUST BE MADE WITHIN 7 CALENDAR DAYS AS OPPOSED TO 15 CALENDAR DAYS OF THE RECEIPT OF PAYMENT FROM THE PUBLIC OWNER. FAILURE TO PAY WITHIN 7 CALENDAR DAYS WILL RESULT IN INTEREST DUE FOR ALL CALENDAR DAYS SUBSEQUENT TO THE SEVENTH DAY THROUGH THE DATE THAT PAYMENT IS MADE.

THE BIDDER UNDERSTANDS THAT THE OWNER RESERVES THE RIGHT TO REJECT ANY OR ALL BIDS AND TO WAIVE ANY INFORMALITIES IN THE BIDDING.

THE BIDDER AGREES THAT THE BID SHALL BE GOOD AND MAY NOT BE WITHDRAWN FOR A PERIOD OF **FORTY-FIVE (45)** CALENDAR DAYS AFTER THE SCHEDULED CLOSING TIME FOR RECEIVING BIDS.

THE BIDDER HAS SUBMITTED ALL REQUESTS FOR OTHER BRAND NAMES OR PRODUCTS NOT LISTED IN THE SPECIFICATIONS IN ACCORDANCE WITH ARTICLE 6(W) OF THE GENERAL CONDITIONS OF THE CONTRACT FOR CONSTRUCTION.

SITE SUPERVISION

THE SUCCESSFUL CONTRACTOR IS TO PROVIDE FULL TIME SITE SUPERVISION FOR HIS OR HER STAFF, SUBCONTRACTORS AND SUPPLIERS FOR THE DURATION OF THIS PROJECT. A COMPETENT SUPERINTENDENT SHALL BE IN ATTENDANCE AT THE JOB SITE AT ALL TIMES WHEN WORK IS BEING PERFORMED UNDER THEIR CONTRACT. THE SUPERINTENDENT IS RESPONSIBLE TO VISIT THE JOB SITE DAILY WHEN WORK IS NOT BEING PERFORMED UNDER THEIR CONTRACT AND TO MONITOR THE OVERALL CONSTRUCTION PROGRESS. A QUALIFIED SITE SUPERINTENDENT MUST HAVE THE AUTHORITY TO REPRESENT AND MAKE DECISIONS FOR HIS OR HER COMPANY WITH REGARDS TO THE SUBJECT JOB, MUST BE ABLE TO GIVE GUIDANCE AND DIRECTION TO EMPLOYEES, SUBCONTRACTORS AND SUPPLIERS, AND MUST BE KNOWLEDGEABLE ABOUT THE WORK TO BE PROVIDED. FAILURE TO PROVIDE A QUALIFIED

SITE SUPERINTENDENT AT THE JOB SITE SHALL SUBJECT SAID PRIME CONTRACTOR TO A PENALTY OF \$1,000 PER DAY FOR EVERY OCCURRENCE.

TIME OF COMPLETION

ALL WORK UNDER THIS CONTRACT SHALL BE COMPLETED BETWEEN THE FOLLOWING HOURS, IN ACCORDANCE WITH THE FOLLOWING DATES:

WORK DAYS:	Monday – Saturday
WORK HOURS:	7:00 AM - 8:00 PM
CONSTRUCTION START DATE:	MONDAY, JUNE 27TH, 2022
SUBSTANTIAL COMPLETION:	FRIDAY, AUGUST 19TH, 2022
FINAL COMPLETION:	FRIDAY, SEPTEMBER 2ND, 2022

IF NECESSARY, WEEKEND, HOLIDAY AND EVENING WORK SHALL BE PROVIDED TO ENSURE THE COMPLETION DATES LISTED ABOVE, AT THE SOLE COST AND EXPENSE OF THE BIDDER.

FAILURE OF THE CONTRACTOR TO COMPLETE WORK BY THE SPECIFIED TIME SHALL SUBJECT HIM/HER TO LIQUIDATED DAMAGES AS SET FORTH IN ARTICLE 13 OF THE GENERAL CONDITIONS.

THE ARCHITECT/ENGINEER SHALL ACT AS THE RECORD KEEPER OF CONTRACT DAYS; HE WILL BE THE SOLE JUDGE OF DELAYS CAUSED BY WEATHER. ONLY WEATHER DELAYS, AS ADJUDGED BY THE ARCHITECT/ENGINEER, WILL BE CONSIDERED FOR EXTENSIONS OF THE CONSTRUCTION PERIOD. THE CONTRACTOR SHALL SUBMIT A BI-WEEKLY REQUEST FOR DELAYS DUE TO WEATHER TO THE ARCHITECT/ENGINEER FOR APPROVAL. NO OTHER DELAY CLAIMS WILL BE ACCEPTED, FOR CREDIT TOWARDS THE PROJECT COMPLETION SCHEDULE, REGARDLESS OF THE SOURCE OF THE DELAY.

FAILURE OF THE CONTRACTOR TO COMPLETE ALL WORK SHOWN AND SPECIFIED IN THE CONTRACT DOCUMENTS, BY ALL OF THE SPECIFIED TIME FRAMES, SHALL SUBJECT THE CONTRACTOR TO LIQUIDATED DAMAGES, AS SET FORTH IN ARTICLE 13 OF THE GENERAL CONDITIONS OF THE CONTRACT FOR CONSTRUCTION, IN THE SUM OF ONE THOUSAND DOLLARS (\$1,000.00) PER CALENDAR DAY. SUCH DAMAGES WILL COMMENCE ON THE DAY AFTER THE COMPLETION DATE OR THE DAY AFTER ANY LISTED MILESTONE DATE IN THE NOTICE TO PROCEED.

WITHIN TEN (10) CONSECUTIVE CALENDAR DAYS AFTER THE DATE OF THE NOTICE OF AWARD, THE BIDDER SHALL EXECUTE THE CONTRACT AND FURNISH THE REQUIRED PERFORMANCE BOND, PAYMENT BOND AND INSURANCES.

THE BOARD OF EDUCATION OF THE DISTRICT RESERVES THE RIGHT TO AWARD THIS CONTRACT TO OTHER THAN THE LOW BIDDER IF THE LAW SO PERMITS.

THE UNDERSIGNED HEREBY ACKNOWLEDGES RECEIPT OF THE FOLLOWING ADDENDA (IF ANY):

ADDENDUM NO.

DATED

SPECIFIC DAMAGES WILL BE ASSESSED AND DEDUCTED FROM AMOUNTS OTHERWISE DUE THE CONTRACTOR FOR ADDITIONAL INSPECTION (FIELD) AND CONTRACT ADMINISTRATION (OFFICE) TIME EXPENDED BY THE ARCHITECT/ENGINEER AND/OR OTHER CONSTRUCTION EMPLOYEE(S) HIRED TO ADMINISTER OR OBSERVE THE CONTRACT, SHOULD THE CONTRACTOR COMPLETE THE CONTRACT BEYOND THE CONTRACT COMPLETION PERIOD SPECIFIED ABOVE.

SUCH DEDUCTION SHALL BE IN ACCORDANCE WITH THE ARCHITECT, ENGINEER'S, AND/OR OTHER CONSTRUCTION EMPLOYEE(S) STANDARD HOURLY BILLING RATES IN EFFECT AT THE TIME FOR THE SCHOOL DISTRICT.

THE REQUIREMENTS OF THE PROPOSAL HAVE BEEN COMPLETELY READ, UNDERSTOOD AND ACKNOWLEDGED BY THE BIDDER.

BIDDER: _____

BIDDER'S ADDRESS: _____

SIGNED BY: _____ TITLE: _____


DATE: _____

Telephone number where the contractor or a competent representative can accept a telephone message and provide a reasonable reply as soon as possible, but not later than twenty-four (24) hours:

DAY: () _____ NIGHT: () _____

FAX: () _____

FEDERAL I.D. NO. OR SOCIAL SECURITY NO.: _____

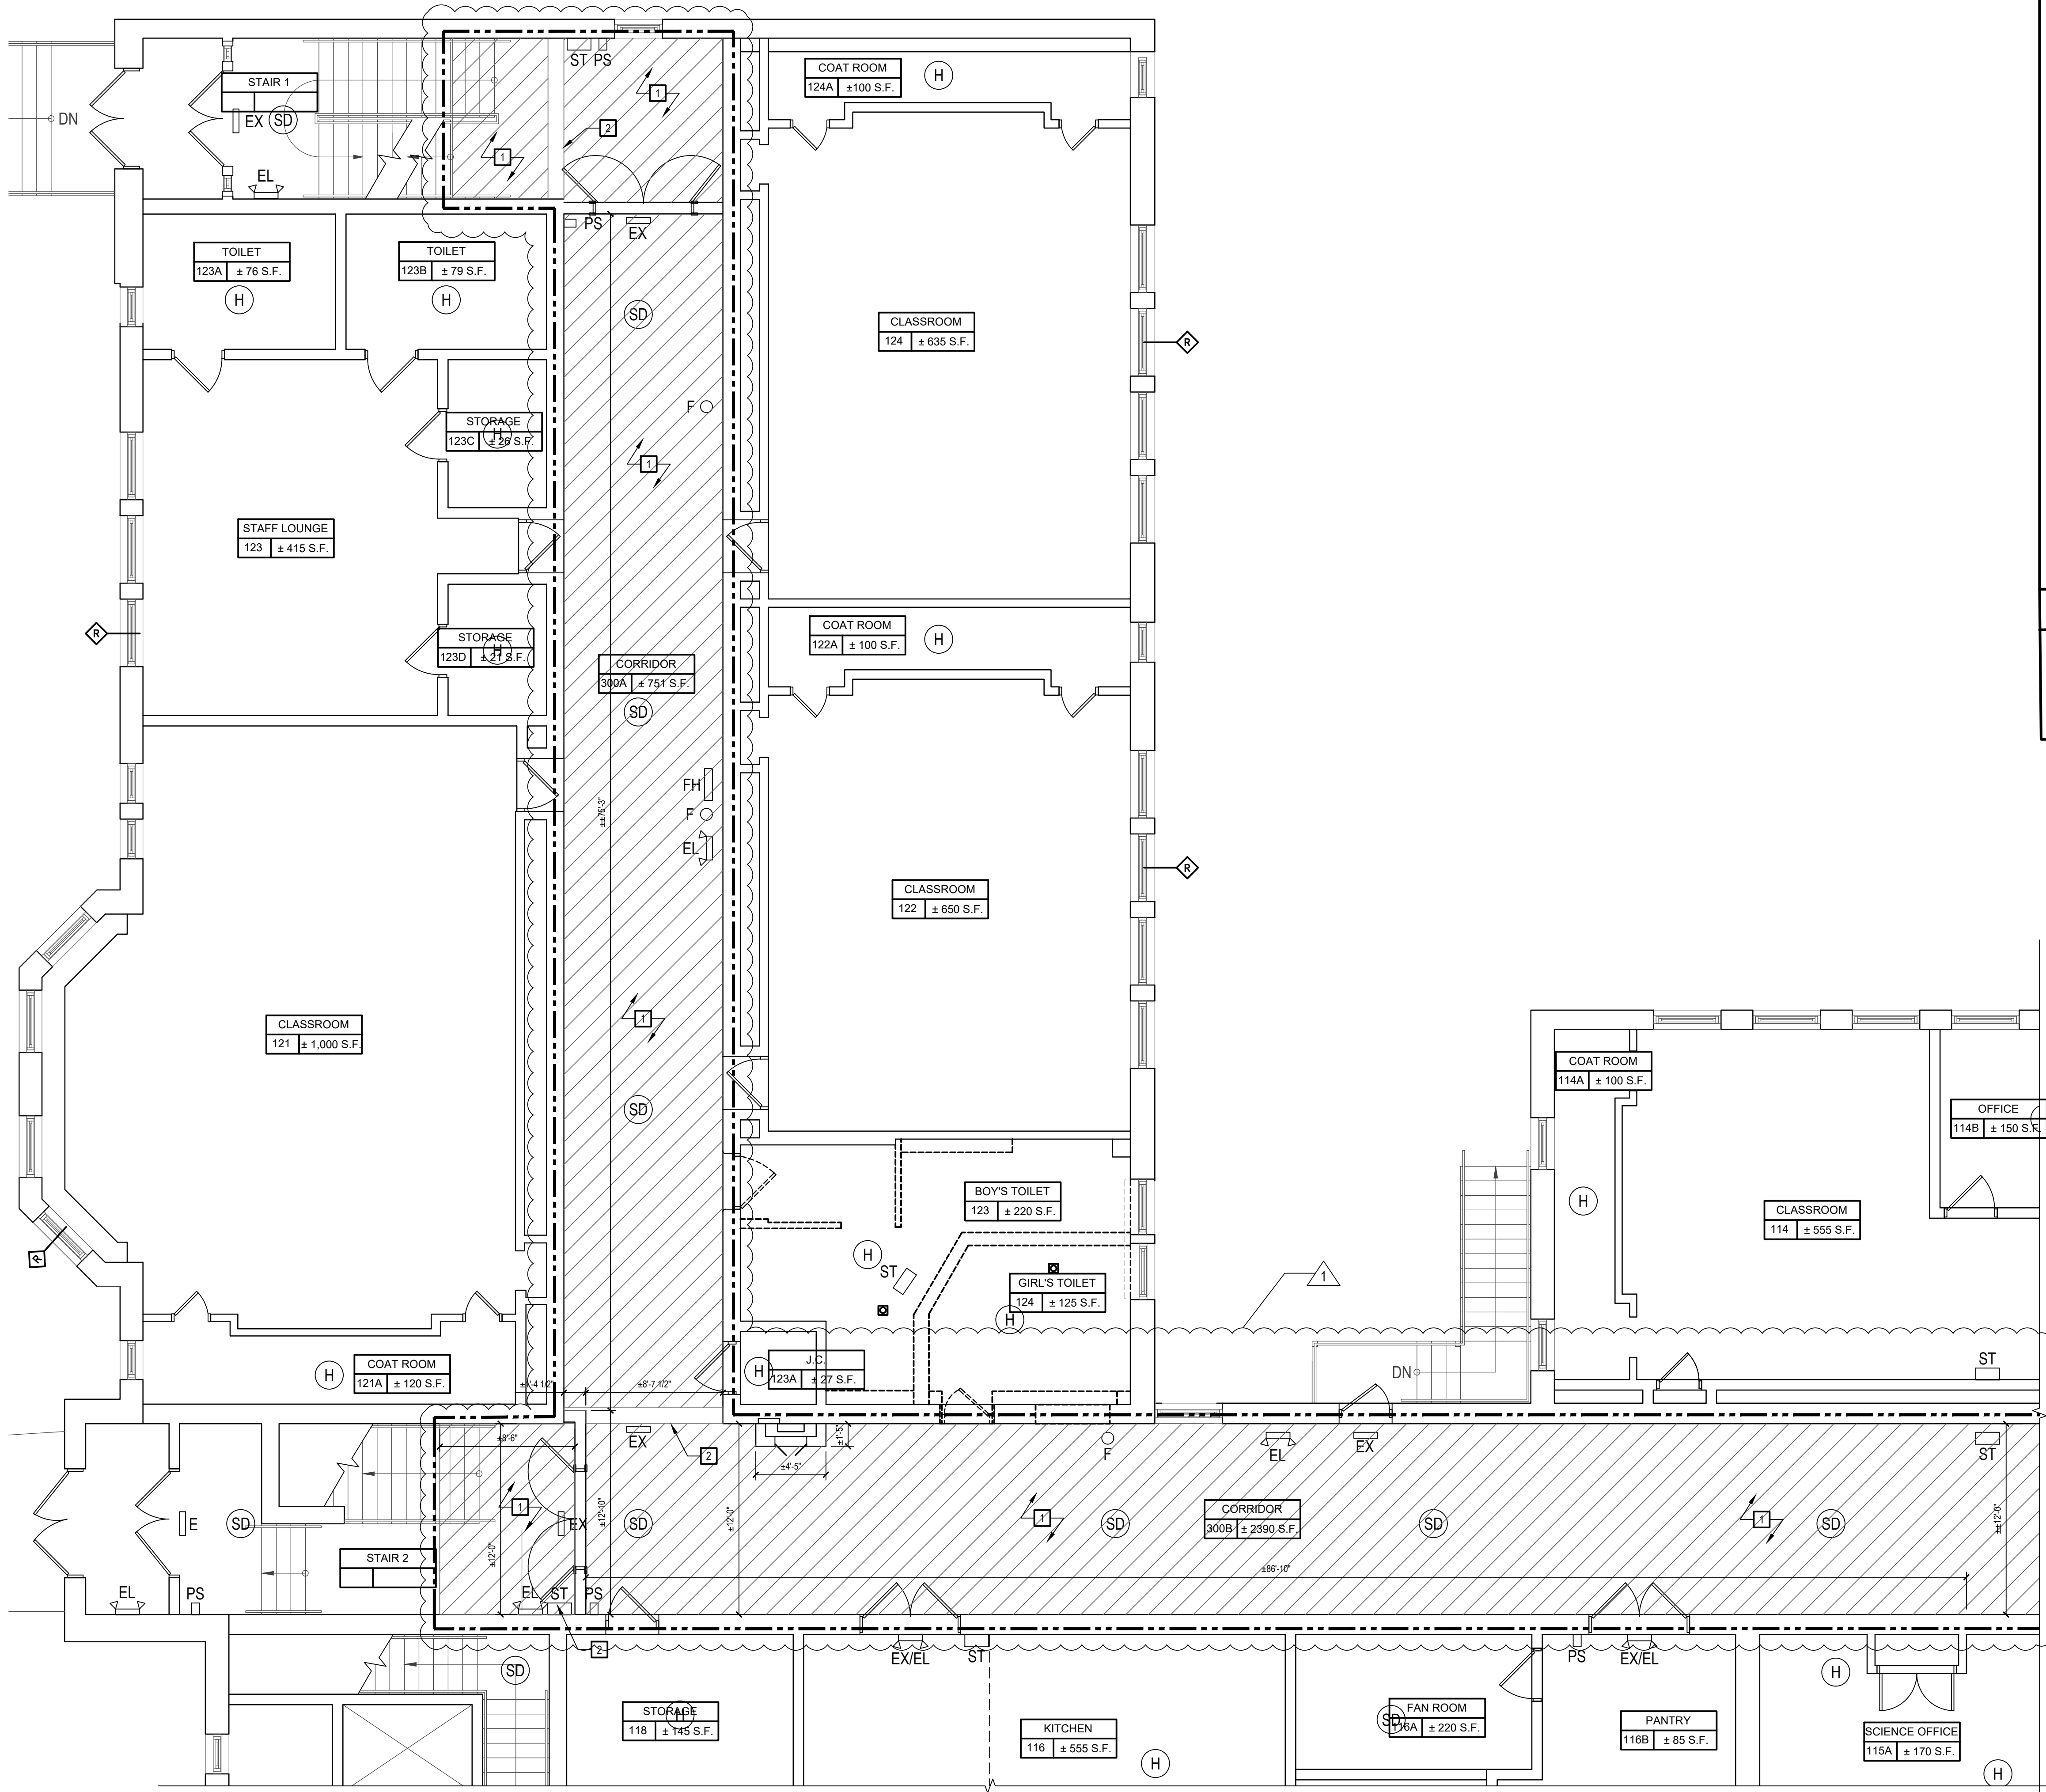

1 Partial Ground Floor Demolition Reflected Ceiling Plan
SCALE: 3/16"=1'-0"

GENERAL DEMOLITION NOTES:

- ALL DEMOLITION WORK SHALL BE IN COMPLIANCE WITH ALL FEDERAL AND NEW YORK STATE APPLICABLE BUILDING AND LIFE AND SAFETY REGULATIONS.
- THE CONTRACTOR SHALL PROTECT ALL PORTIONS OF THE EXISTING BUILDING WHERE NEW WORK IS TO BE COMPLETED FROM DUST, WEATHER INCLEMENCY AND FREEZING. PROVIDE DUST FREE BARRIER PARTITIONS DURING DEMOLITION TO PREVENT DEBRIS FROM ENTERING NON-WORK AREAS. THE CONTRACTOR WILL BE HELD RESPONSIBLE FOR ANY DAMAGE TO THE EXISTING STRUCTURE OR BUILDING CONTENTS.
- THE CONTRACTOR ACCESS SHALL BE AS CALLED OUT ON SHEET G0.0. THE CONTRACTOR SHALL ADEQUATELY PROTECT ALL EXISTING FINISHES SCHEDULED TO REMAIN ALONG THE ACCESS ROUTE AND ADJOINING SURFACES OUTSIDE THE CONTRACT AREA OR SCOPE OF WORK FROM DAMAGE DURING THE PROJECT DURATION. THE CONTRACTOR SHALL BE RESPONSIBLE TO RESTORE EXISTING CONDITIONS AND/OR FINISHES DAMAGED DURING CONSTRUCTION INCLUDING PATCHING AND PAINTING AS REQUIRED AND DEEMED NECESSARY BY THE ARCHITECT AT NO ADDITIONAL COST TO THE OWNER.
- THE CONTRACTOR SHALL REMOVE AND DISPOSE OF ALL CONSTRUCTION DEBRIS AND UNWANTED MATERIAL OFF SITE IN ACCORDANCE WITH ALL FEDERAL AND NEW YORK STATE APPLICABLE BUILDING AND LIFE AND SAFETY REGULATIONS.
- THE CONTRACTOR SHALL TAKE CARE NOT TO DAMAGE ADJOINING SURFACES AND FINISHES DURING DEMOLITION. THE CONTRACTOR SHALL PATCH AND REPAIR ALL ADJACENT SURFACES DAMAGED DURING DEMOLITION. CONTRACTOR SHALL MATCH ALL ADJACENT FINISHES.
- OVER-DEMOLITION SHALL BE ALLOWED PROVIDED THAT ALL SURFACES SHALL BE REBUILT TO MATCH MATERIALS, STRUCTURAL INTEGRITY AND APPEARANCE OF THOSE WHICH WERE REMOVED AND IN CONFORMANCE WITH CONTRACT DOCUMENTS AND AT NO ADDITIONAL COST TO THE OWNER.
- REMOVE ALL ITEMS THAT WILL BE ABANDONED AS A RESULT OF THE WORK BEING PERFORMED.
- THE CONTRACTOR SHALL FIELD VERIFY ALL EXISTING CONDITIONS, DIMENSIONS AND QUANTITIES OF ALL ITEMS PRIOR TO BID.
- THE CONTRACTOR SHALL TAKE CARE NOT TO DAMAGE PARKING LOT PAVING, CONCRETE SIDEWALKS, LANDSCAPING, GRASS AREAS AND EXTERIOR FINISHES. ANY DAMAGED AREAS SHALL BE RESTORED TO EXISTING CONDITION BY THE CONTRACTOR AT NO ADDITIONAL COST TO THE OWNER.
- COORDINATE THE WORK OF THE DEMOLITION DRAWING WITH ALL CONSTRUCTION DRAWINGS AND DOCUMENTS.
- THIS DRAWING IS A GENERAL LIST OF DEMOLITION ITEMS AND IS NOT EVERY ITEM REQUIRED FOR DEMOLITION. CONTRACTOR SHALL PROVIDE ALL DEMOLITION REQUIRED TO PERFORM ALL WORK INDICATED WITHIN THE PROJECT DRAWINGS AND SPECIFICATIONS AND TO PREPARE ALL AREAS FOR THE CONSTRUCTION WORK.
- THE CONTRACTOR SHALL BE RESPONSIBLE TO TEMPORARILY SUPPORT ALL EXISTING DUCTWORK SCHEDULED TO REMAIN WHETHER OR NOT SPECIFICALLY NOTED ON THEIR DOCUMENTS OR NOT.

DEMO KEY NOTES


- REMOVE AND DISPOSE OF EXISTING SPLINE CEILING SYSTEM IN ITS ENTIRETY INCLUDING, BUT NOT LIMITED TO, TILES, GRID, FRAMING, SUPPORTS, TRIM, AND ALL DEVICES USED TO SECURE THE CEILING IN PLACE UP TO STRUCTURAL DECK ABOVE. COORDINATE REMOVAL OF EXISTING LIGHTING REFERENCED ON 'E' DRAWINGS.
- EXISTING SOFFIT TO REMAIN. PRIME & PAINT TO MATCH EXISTING.

DEMOLITION LEGEND:


EXISTING SPLINE CEILING TILE SYSTEM TO BE REMOVED AND LEGALLY DISPOSED OF.

ROOM
000 ± S.F. ROOM NUMBER DESIGNATION TAG

INDICATES AREA OF WORK FOR ALTERNATE 1

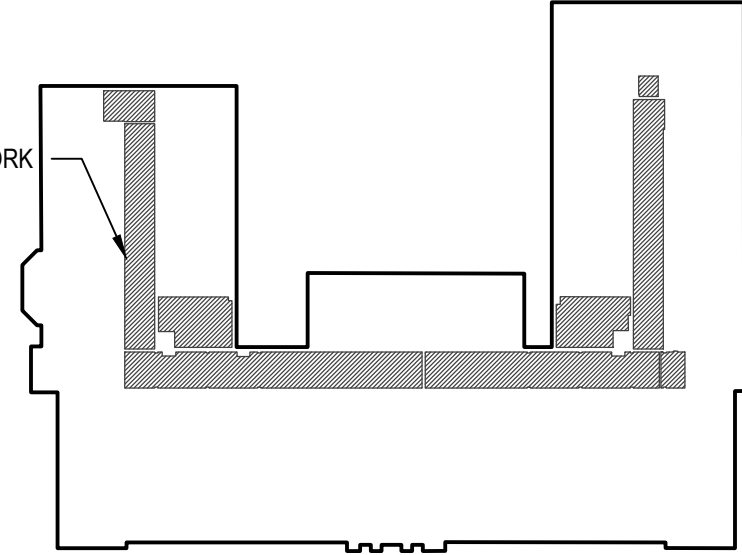

Key Plan
SCALE: N.T.S.

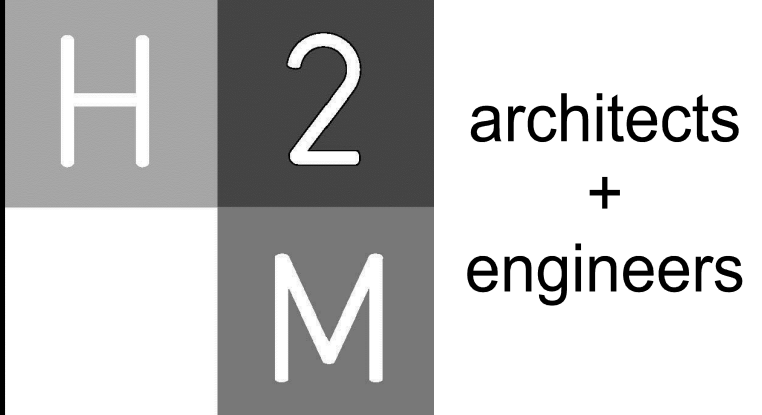

538 Broad Hollow Road, 4th Floor East
Melville, NY 11747
631.756.8000 • www.h2m.com

CONSULTANTS:

MARK	DATE	DESCRIPTION
1	11-22-21	BID ADDENDUM #1
-	11-03-21	FINAL BID SET

STATE OF NEW YORK
JOHN C. MORRIS III
LICENSED PROFESSIONAL ENGINEER
057554-1

"ALTERATION OF THIS DOCUMENT EXCEPT BY A LICENSED PROFESSIONAL IS ILLEGAL."

DESIGNED BY: CWP	DRAWN BY: RLB	CHECKED BY:	REVIEWED BY:
PROJECT NO: WPSD 2009	DATE: NOVEMBER 2021	SCALE:	AS SHOWN

CLIENT
White Plains City School District

**Renovations at
Rochambeau Alternative
High School**



228 Fisher Avenue
White Plains, NY 10606


SED No. 66-22-00-01-0-15-019

CONTRACT
**CONTRACT G
GENERAL CONSTRUCTION**

STATUS
FINAL BID DOCUMENT

SHEET TITLE
**PARTIAL GROUND FLOOR
DEMOLITION REFLECTED
CEILING PLANS**

DRAWING No.
AD 120.00

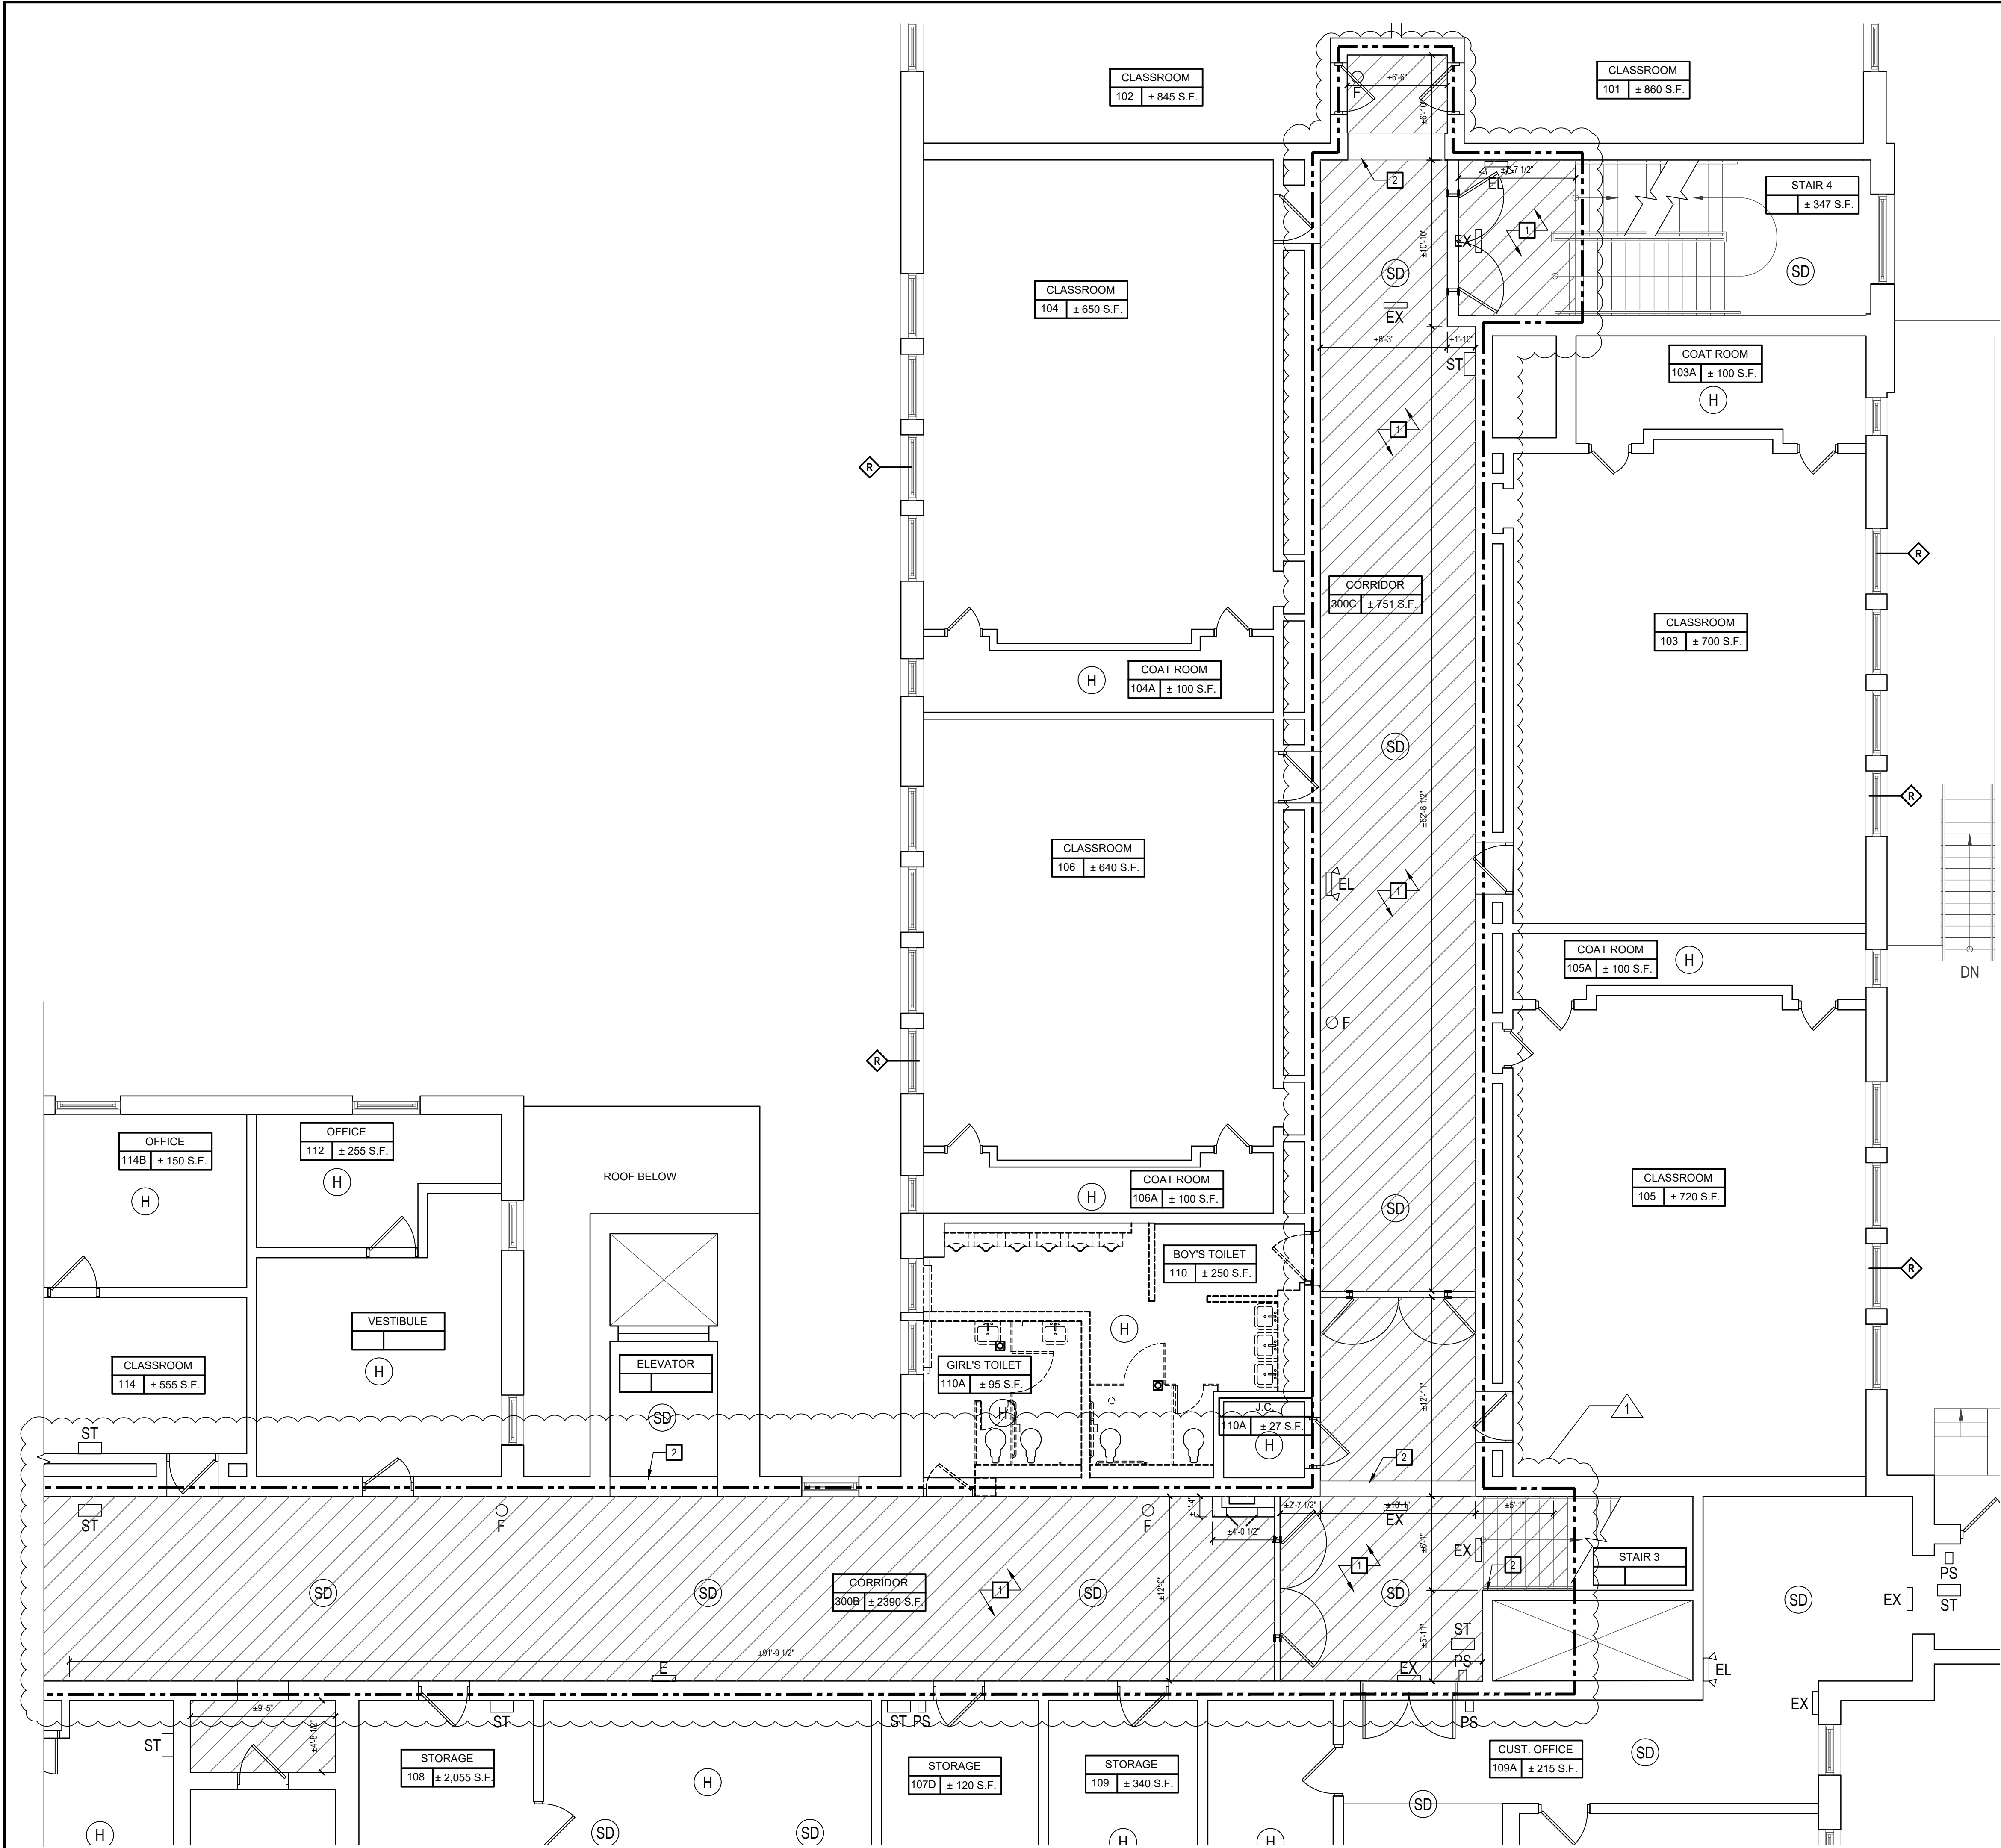

1 Partial Ground Floor Demolition Reflected Ceiling Plan
SCALE: 3/16"=1'-0"

- GENERAL DEMOLITION NOTES:**
- ALL DEMOLITION WORK SHALL BE IN COMPLIANCE WITH ALL FEDERAL AND NEW YORK STATE APPLICABLE BUILDING AND LIFE AND SAFETY REGULATIONS.
 - THE CONTRACTOR SHALL PROTECT ALL PORTIONS OF THE EXISTING BUILDING WHERE NEW WORK IS TO BE COMPLETED FROM DUST, WEATHER INCLEMENCY AND FREEZING. PROVIDE DUST FREE BARRIER PARTITIONS DURING DEMOLITION TO PREVENT DEBRIS FROM ENTERING NON-WORK AREAS. THE CONTRACTOR WILL BE HELD RESPONSIBLE FOR ANY DAMAGE TO THE EXISTING STRUCTURE OR BUILDING CONTENTS.
 - THE CONTRACTOR ACCESS SHALL BE AS CALLED OUT ON SHEET G0.0. THE CONTRACTOR SHALL ADEQUATELY PROTECT ALL EXISTING FINISHES SCHEDULED TO REMAIN ALONG THE ACCESS ROUTE AND ADJOINING SURFACES OUTSIDE THE CONTRACT AREA OR SCOPE OF WORK FROM DAMAGE DURING THE PROJECT DURATION. THE CONTRACTOR SHALL BE RESPONSIBLE TO RESTORE EXISTING CONDITIONS AND/OR FINISHES DAMAGED DURING CONSTRUCTION INCLUDING PATCHING AND PAINTING AS REQUIRED AND DEEMED NECESSARY BY THE ARCHITECT AT NO ADDITIONAL COST TO THE OWNER.
 - THE CONTRACTOR SHALL REMOVE AND DISPOSE OF ALL CONSTRUCTION DEBRIS AND UNWANTED MATERIAL OFF SITE IN ACCORDANCE WITH ALL FEDERAL AND NEW YORK STATE APPLICABLE BUILDING AND LIFE AND SAFETY REGULATIONS.
 - THE CONTRACTOR SHALL TAKE CARE NOT TO DAMAGE ADJOINING SURFACES AND FINISHES DURING DEMOLITION. THE CONTRACTOR SHALL PATCH AND REPAIR ALL ADJACENT SURFACES DAMAGED DURING DEMOLITION. CONTRACTOR SHALL MATCH ALL ADJACENT FINISHES.
 - OVER-DEMOLITION SHALL BE ALLOWED PROVIDED THAT ALL SURFACES SHALL BE REBUILT TO MATCH MATERIALS, STRUCTURAL INTEGRITY AND APPEARANCE OF THOSE WHICH WERE REMOVED AND IN CONFORMANCE WITH CONTRACT DOCUMENTS AND AT NO ADDITIONAL COST TO THE OWNER.
 - REMOVE ALL ITEMS THAT WILL BE ABANDONED AS A RESULT OF THE WORK BEING PERFORMED.
 - THE CONTRACTOR SHALL FIELD VERIFY ALL EXISTING CONDITIONS, DIMENSIONS AND QUANTITIES OF ALL ITEMS PRIOR TO BID.
 - THE CONTRACTOR SHALL TAKE CARE NOT TO DAMAGE PARKING LOT PAVING, CONCRETE SIDEWALKS, LANDSCAPING, GRASS AREAS AND EXTERIOR FINISHES. ANY DAMAGED AREAS SHALL BE RESTORED TO EXISTING CONDITION BY THE CONTRACTOR AT NO ADDITIONAL COST TO THE OWNER.
 - COORDINATE THE WORK OF THE DEMOLITION DRAWING WITH ALL CONSTRUCTION DRAWINGS AND DOCUMENTS.
 - THIS DRAWING IS A GENERAL LIST OF DEMOLITION ITEMS AND IS NOT EVERY ITEM REQUIRED FOR DEMOLITION. CONTRACTOR SHALL PROVIDE ALL DEMOLITION REQUIRED TO PERFORM ALL WORK INDICATED WITHIN THE PROJECT DRAWINGS AND SPECIFICATIONS AND TO PREPARE ALL AREAS FOR THE CONSTRUCTION WORK.
 - THE CONTRACTOR SHALL BE RESPONSIBLE TO TEMPORARILY SUPPORT ALL EXISTING DUCTWORK SCHEDULED TO REMAIN WHETHER OR NOT SPECIFICALLY NOTED ON THEIR DOCUMENTS OR NOT.

- DEMO KEY NOTES**
- REMOVE AND DISPOSE OF EXISTING SPLINE CEILING SYSTEM IN ITS ENTIRETY INCLUDING, BUT NOT LIMITED TO, TILES, GRID, FRAMING, SUPPORTS, TRIM, AND ALL DEVICES USED TO SECURE THE CEILING IN PLACE UP TO STRUCTURAL DECK ABOVE. COORDINATE REMOVAL OF EXISTING LIGHTING REFERENCED ON 'E' DRAWINGS.
 - EXISTING SOFFIT TO REMAIN. PRIME & PAINT TO MATCH EXISTING.


DEMOLITION LEGEND:

EXISTING SPLINE CEILING TILE SYSTEM TO BE REMOVED AND LEGALLY DISPOSED OF.

ROOM NUMBER DESIGNATION TAG

INDICATES AREA OF WORK FOR ALTERNATE 1

1

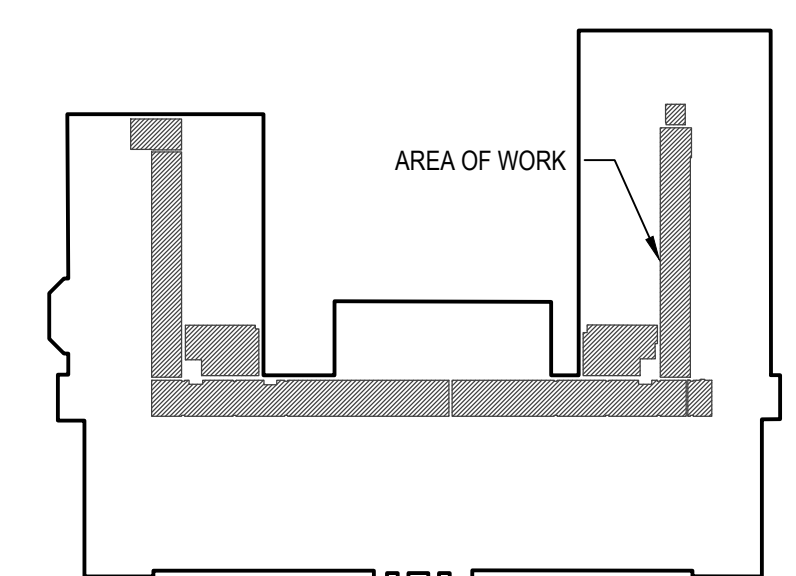

Key Plan
SCALE: N.T.S.

H 2 architects + engineers
M

538 Broad Hollow Road, 4th Floor East
Melville, NY 11747
631.756.8000 • www.h2m.com

CONSULTANTS:

MARK	DATE	DESCRIPTION
1	11-22-21	BID ADDENDUM #1
-	11-03-21	FINAL BID SET

STATE OF NEW YORK
JOHN C. MORRIS II
LICENSED PROFESSIONAL ENGINEER
057554-1

DESIGNED BY: CWP
PROJECT NO: WPSD 2009

DRAWN BY: RLB
DATE: NOVEMBER 2021

CHECKED BY:
SCALE: AS SHOWN

REVIEWED BY:

CLIENT
White Plains City School District

**Renovations at
Rochambeau Alternative
High School**

228 Fisher Avenue
White Plains, NY 10606


SED No. 66-22-00-01-0-15-019

CONTRACT
**CONTRACT G
GENERAL CONSTRUCTION**

STATUS
FINAL BID DOCUMENT

SHEET TITLE
**PARTIAL GROUND FLOOR
DEMOLITION REFLECTED
CEILING PLANS**

DRAWING No.
AD 121.00

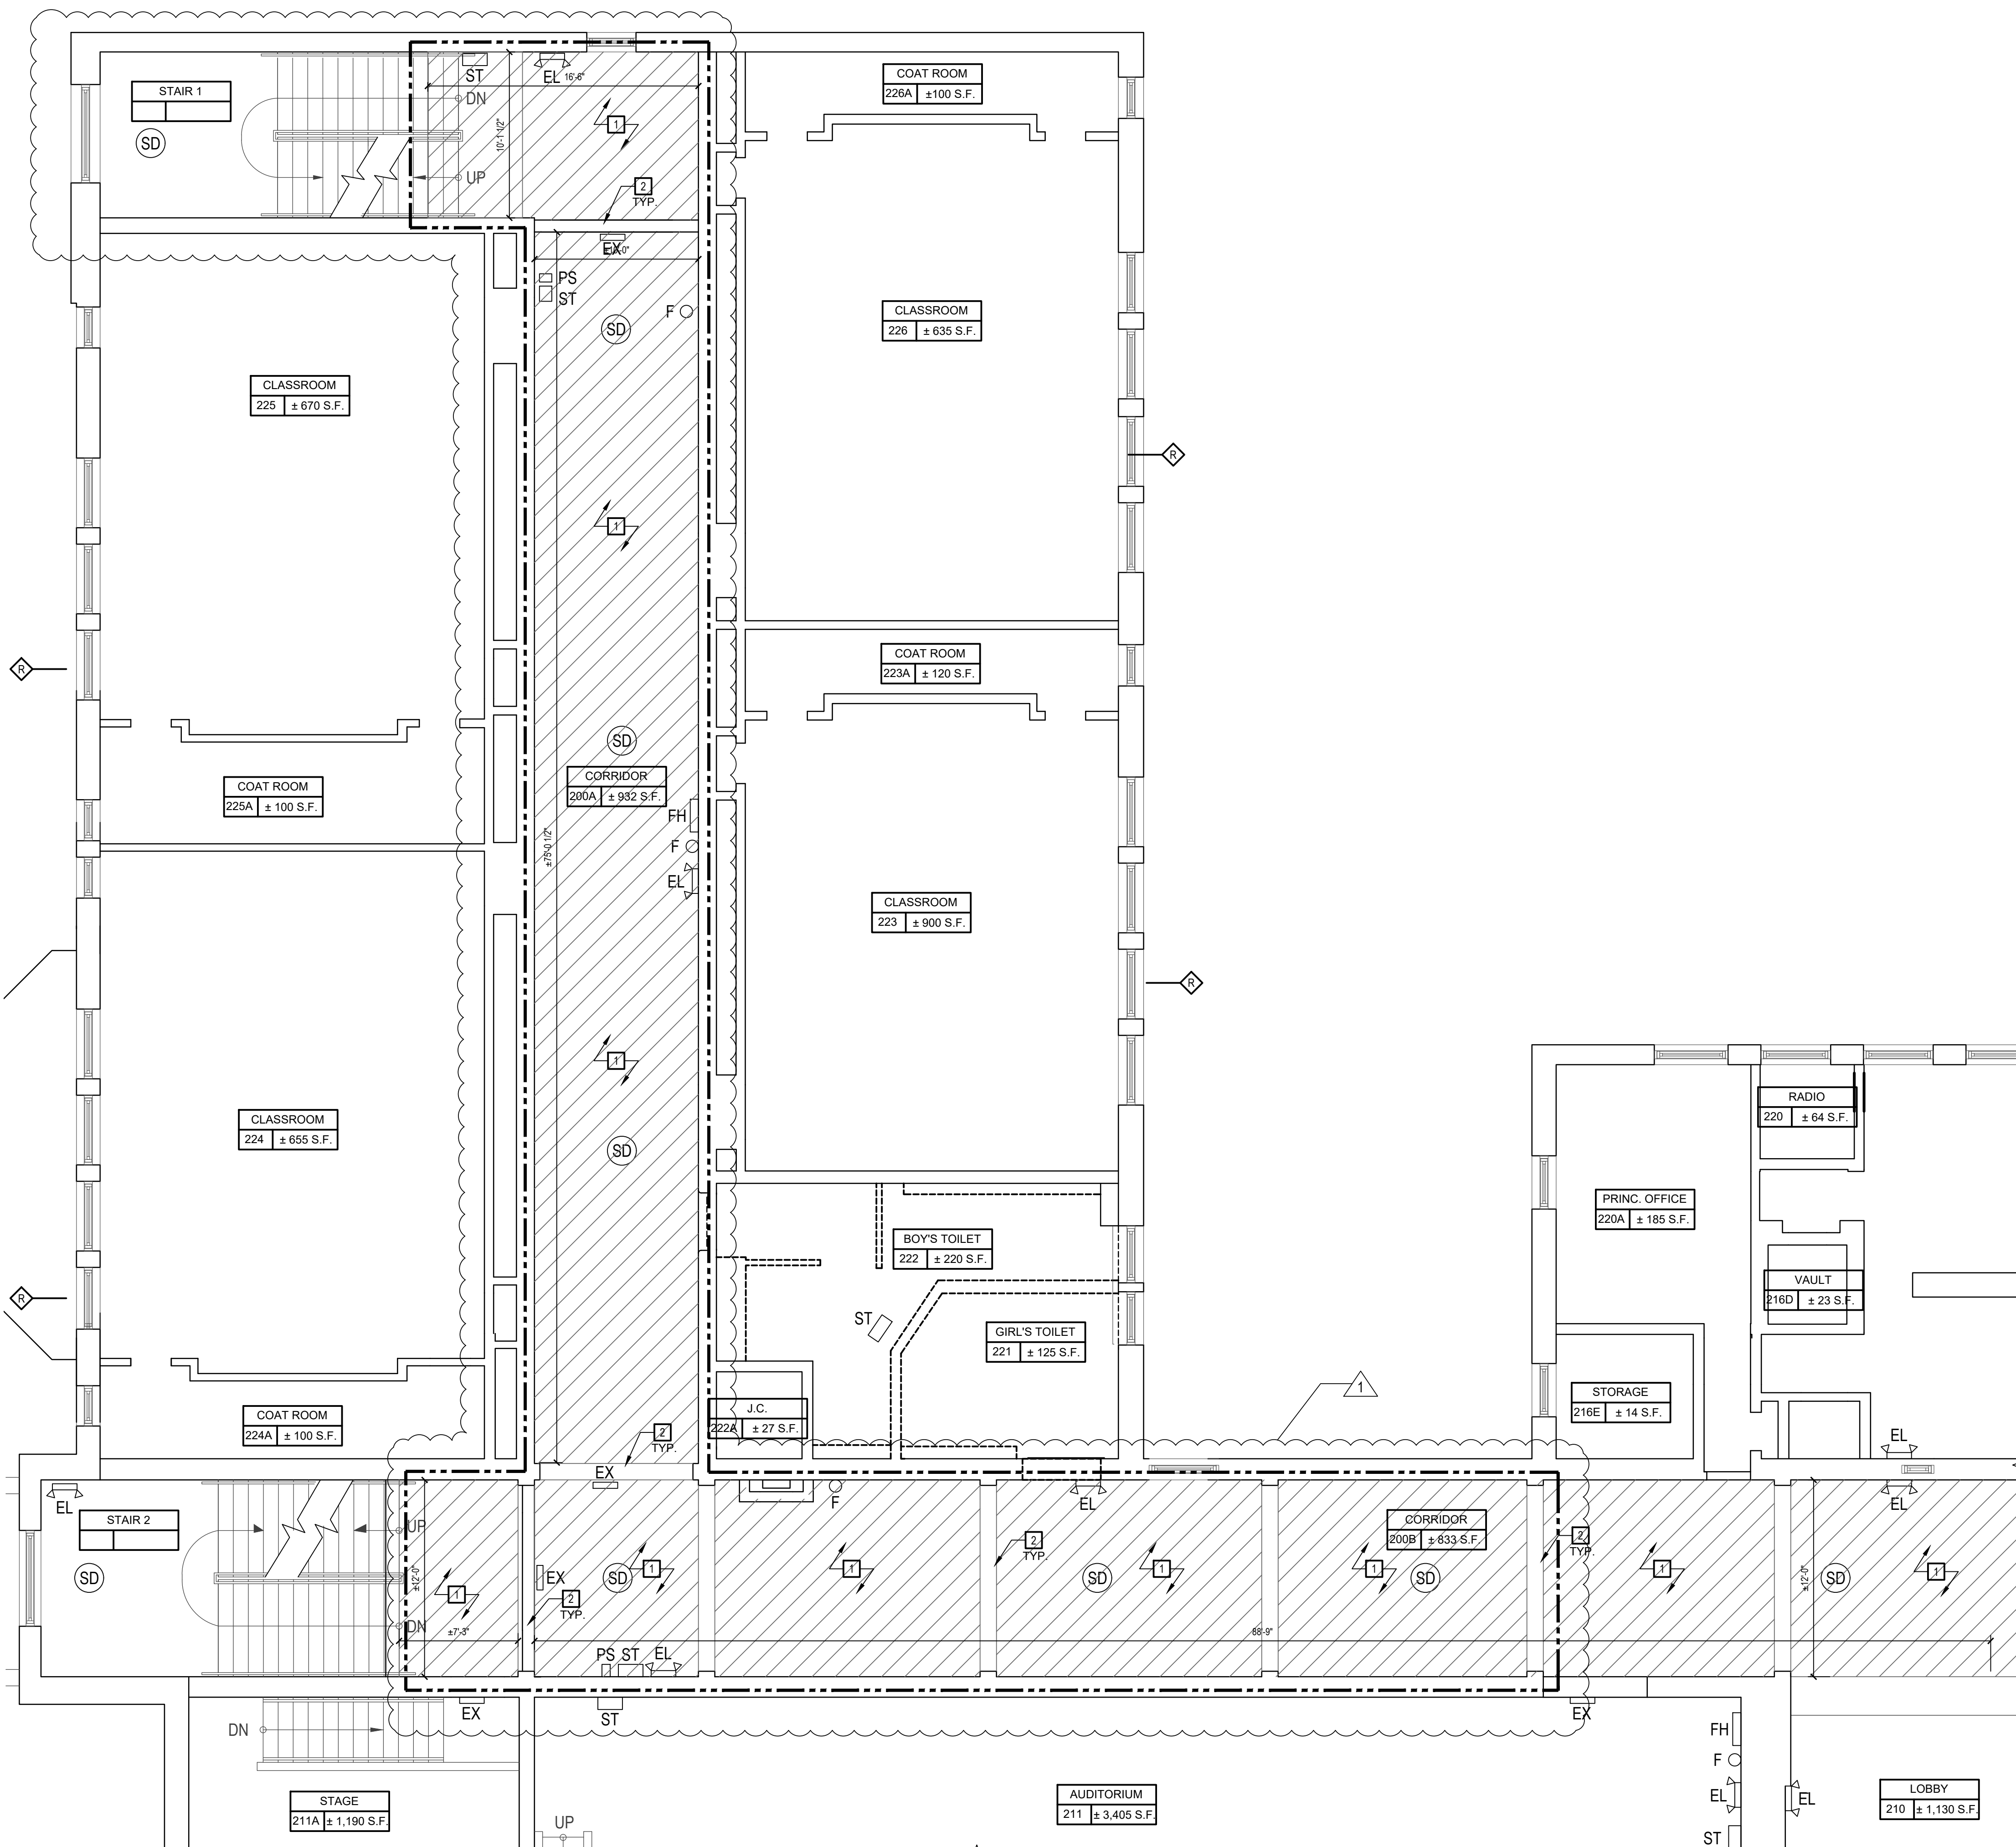

1 Partial First Floor Demolition Reflected Ceiling Plan
SCALE: 3/16"=1'-0"

GENERAL DEMOLITION NOTES:

- ALL DEMOLITION WORK SHALL BE IN COMPLIANCE WITH ALL FEDERAL AND NEW YORK STATE APPLICABLE BUILDING AND LIFE AND SAFETY REGULATIONS.
- THE CONTRACTOR SHALL PROTECT ALL PORTIONS OF THE EXISTING BUILDING WHERE NEW WORK IS TO BE COMPLETED FROM DUST, WEATHER INCLEMENCY AND FREEZING. PROVIDE DUST FREE BARRIER PARTITIONS DURING DEMOLITION TO PREVENT DEBRIS FROM ENTERING NON-WORK AREAS. THE CONTRACTOR WILL BE HELD RESPONSIBLE FOR ANY DAMAGE TO THE EXISTING STRUCTURE OR BUILDING CONTENTS.
- THE CONTRACTOR ACCESS SHALL BE AS CALLED OUT ON SHEET G0.0. THE CONTRACTOR SHALL ADEQUATELY PROTECT ALL EXISTING FINISHES SCHEDULED TO REMAIN ALONG THE ACCESS ROUTE AND ADJOINING SURFACES OUTSIDE THE CONTRACT AREA OR SCOPE OF WORK FROM DAMAGE DURING THE PROJECT DURATION. THE CONTRACTOR SHALL BE RESPONSIBLE TO RESTORE EXISTING CONDITIONS AND/OR FINISHES DAMAGED DURING CONSTRUCTION INCLUDING PATCHING AND PAINTING AS REQUIRED AND DEEMED NECESSARY BY THE ARCHITECT AT NO ADDITIONAL COST TO THE OWNER.
- THE CONTRACTOR SHALL REMOVE AND DISPOSE OF ALL CONSTRUCTION DEBRIS AND UNWANTED MATERIAL OFF SITE IN ACCORDANCE WITH ALL FEDERAL AND NEW YORK STATE APPLICABLE BUILDING AND LIFE AND SAFETY REGULATIONS.
- THE CONTRACTOR SHALL TAKE CARE NOT TO DAMAGE ADJOINING SURFACES AND FINISHES DURING DEMOLITION. THE CONTRACTOR SHALL PATCH AND REPAIR ALL ADJACENT SURFACES DAMAGED DURING DEMOLITION. CONTRACTOR SHALL MATCH ALL ADJACENT FINISHES.
- OVER-DEMOLITION SHALL BE ALLOWED PROVIDED THAT ALL SURFACES SHALL BE REBUILT TO MATCH MATERIALS, STRUCTURAL INTEGRITY AND APPEARANCE OF THOSE WHICH WERE REMOVED AND IN CONFORMANCE WITH CONTRACT DOCUMENTS AND AT NO ADDITIONAL COST TO THE OWNER.
- REMOVE ALL ITEMS THAT WILL BE ABANDONED AS A RESULT OF THE WORK BEING PERFORMED.
- THE CONTRACTOR SHALL FIELD VERIFY ALL EXISTING CONDITIONS, DIMENSIONS AND QUANTITIES OF ALL ITEMS PRIOR TO BID.
- THE CONTRACTOR SHALL TAKE CARE NOT TO DAMAGE PARKING LOT PAVING, CONCRETE SIDEWALKS, LANDSCAPING, GRASS AREAS AND EXTERIOR FINISHES. ANY DAMAGED AREAS SHALL BE RESTORED TO EXISTING CONDITION BY THE CONTRACTOR AT NO ADDITIONAL COST TO THE OWNER.
- COORDINATE THE WORK OF THE DEMOLITION DRAWING WITH ALL CONSTRUCTION DRAWINGS AND DOCUMENTS.
- THIS DRAWING IS A GENERAL LIST OF DEMOLITION ITEMS AND IS NOT EVERY ITEM REQUIRED FOR DEMOLITION. CONTRACTOR SHALL PROVIDE ALL DEMOLITION REQUIRED TO PERFORM ALL WORK INDICATED WITHIN THE PROJECT DRAWINGS AND SPECIFICATIONS AND TO PREPARE ALL AREAS FOR THE CONSTRUCTION WORK.
- THE CONTRACTOR SHALL BE RESPONSIBLE TO TEMPORARILY SUPPORT ALL EXISTING DUCTWORK SCHEDULED TO REMAIN WHETHER OR NOT SPECIFICALLY NOTED ON THEIR DOCUMENTS OR NOT.

DEMO KEY NOTES


- REMOVE AND DISPOSE OF EXISTING SPLINE CEILING SYSTEM IN ITS ENTIRETY INCLUDING, BUT NOT LIMITED TO, TILES, GRID, FRAMING, SUPPORTS, TRIM, AND ALL DEVICES USED TO SECURE THE CEILING IN PLACE UP TO STRUCTURAL DECK ABOVE. COORDINATE REMOVAL OF EXISTING LIGHTING REFERENCED ON 'E' DRAWINGS.
- EXISTING SOFFIT TO REMAIN. PRIME & PAINT TO MATCH EXISTING.

DEMOLITION LEGEND:


EXISTING SPLINE CEILING TILE SYSTEM TO BE REMOVED AND LEGALLY DISPOSED OF.

ROOM
± S.F. ROOM NUMBER DESIGNATION TAG

INDICATES AREA OF WORK FOR ALTERNATE 1

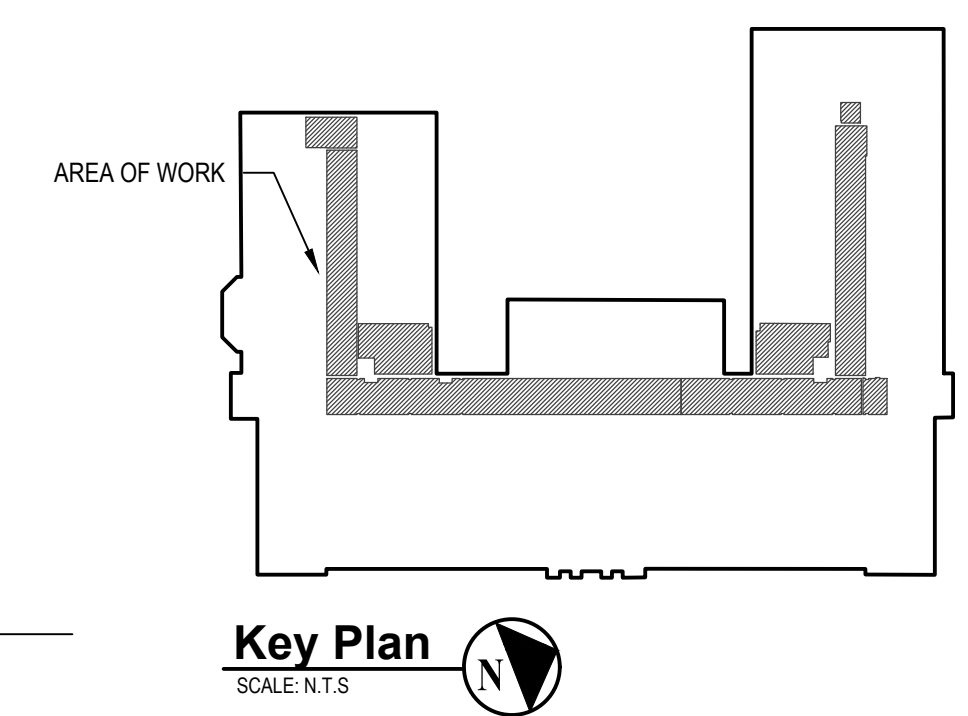

Key Plan
SCALE: N.T.S.

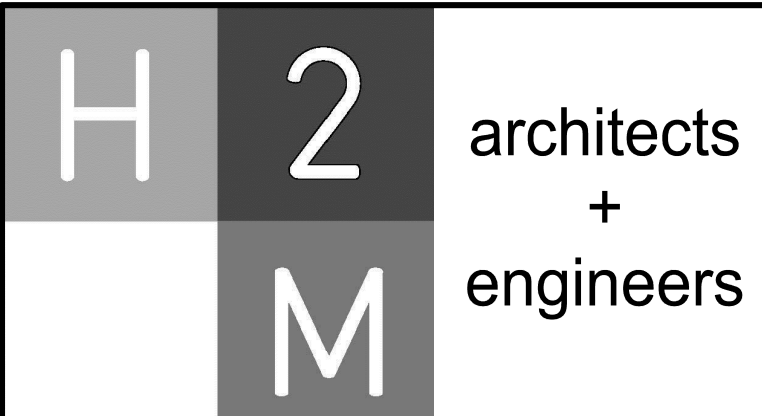

538 Broad Hollow Road, 4th Floor East
Melville, NY 11747
631.756.8000 • www.h2m.com

CONSULTANTS:

MARK	DATE	DESCRIPTION
1	11-22-21	BID ADDENDUM #1
-	11-03-21	FINAL BID SET



DESIGNED BY: CWP	DRAWN BY: RLB	CHECKED BY:	REVIEWED BY:
PROJECT NO: WPSD 2009	DATE: NOVEMBER 2021	SCALE:	AS SHOWN

CLIENT
White Plains City School District

PROJECT
**Renovations at
Rochambeau Alternative
High School**

LOCATION
**228 Fisher Avenue
White Plains, NY 10606**




PROJECT NO.
SED No. 66-22-00-01-0-15-019

CONTRACT
**CONTRACT G
GENERAL CONSTRUCTION**

STATUS
FINAL BID DOCUMENT

SHEET TITLE
**PARTIAL FIRST FLOOR
DEMOLITION REFLECTED
CEILING PLAN**

DRAWING No.
AD 122.00

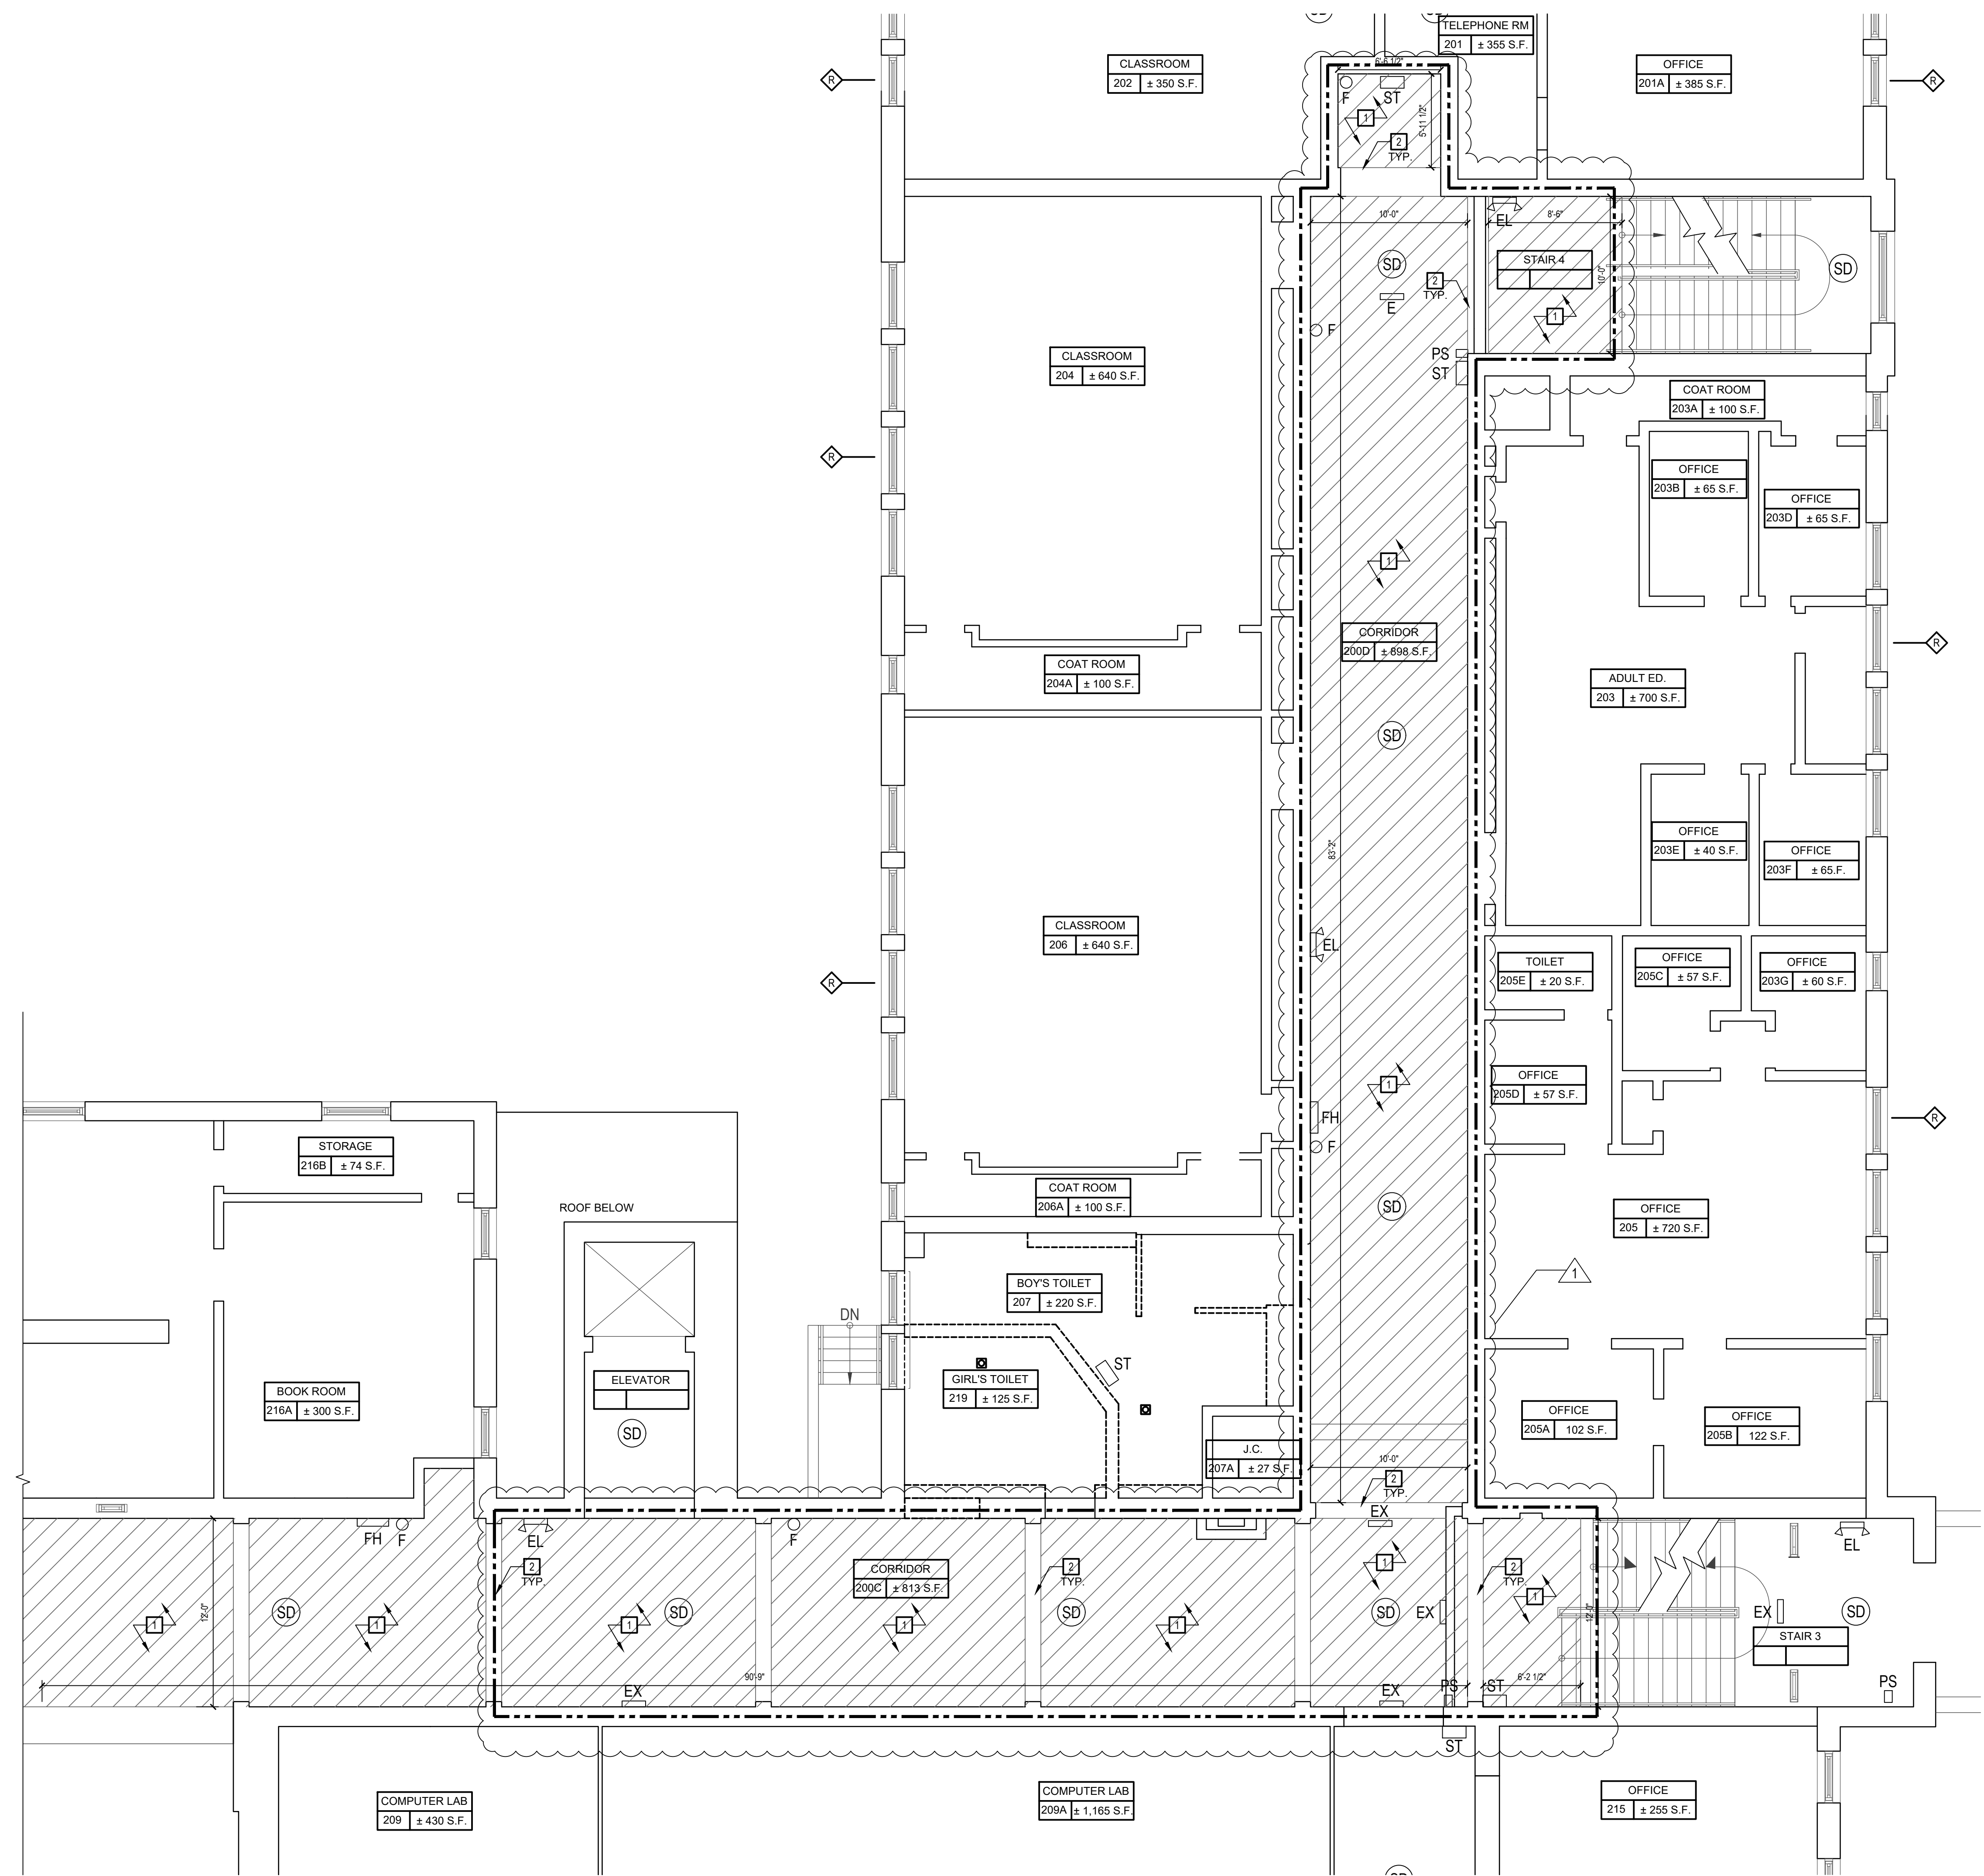

1 Partial First Floor Demolition Reflected Ceiling Plan
SCALE: 3/16"=1'-0"

GENERAL DEMOLITION NOTES:


- ALL DEMOLITION WORK SHALL BE IN COMPLIANCE WITH ALL FEDERAL AND NEW YORK STATE APPLICABLE BUILDING AND LIFE AND SAFETY REGULATIONS.
- THE CONTRACTOR SHALL PROTECT ALL PORTIONS OF THE EXISTING BUILDING WHERE NEW WORK IS TO BE COMPLETED FROM DUST, WEATHER INCLEMENCY AND FREEZING. PROVIDE DUST FREE BARRIER PARTITIONS DURING DEMOLITION TO PREVENT DEBRIS FROM ENTERING NON-WORK AREAS. THE CONTRACTOR WILL BE HELD RESPONSIBLE FOR ANY DAMAGE TO THE EXISTING STRUCTURE OR BUILDING CONTENTS.
- THE CONTRACTOR ACCESS SHALL BE AS CALLED OUT ON SHEET G0.0. THE CONTRACTOR SHALL ADEQUATELY PROTECT ALL EXISTING FINISHES SCHEDULED TO REMAIN ALONG THE ACCESS ROUTE AND ADJOINING SURFACES OUTSIDE THE CONTRACT AREA OR SCOPE OF WORK FROM DAMAGE DURING THE PROJECT DURATION. THE CONTRACTOR SHALL BE RESPONSIBLE TO RESTORE EXISTING CONDITIONS AND/OR FINISHES DAMAGED DURING CONSTRUCTION INCLUDING PATCHING AND PAINTING AS REQUIRED AND DEEMED NECESSARY BY THE ARCHITECT AT NO ADDITIONAL COST TO THE OWNER.
- THE CONTRACTOR SHALL REMOVE AND DISPOSE OF ALL CONSTRUCTION DEBRIS AND UNWANTED MATERIAL OFF SITE IN ACCORDANCE WITH ALL FEDERAL AND NEW YORK STATE APPLICABLE BUILDING AND LIFE AND SAFETY REGULATIONS.
- THE CONTRACTOR SHALL TAKE CARE NOT TO DAMAGE ADJOINING SURFACES AND FINISHES DURING DEMOLITION. THE CONTRACTOR SHALL PATCH AND REPAIR ALL ADJACENT SURFACES DAMAGED DURING DEMOLITION. CONTRACTOR SHALL MATCH ALL ADJACENT FINISHES.
- OVER-DEMOLITION SHALL BE ALLOWED PROVIDED THAT ALL SURFACES SHALL BE REBUILT TO MATCH MATERIALS, STRUCTURAL INTEGRITY AND APPEARANCE OF THOSE WHICH WERE REMOVED AND IN CONFORMANCE WITH CONTRACT DOCUMENTS AND AT NO ADDITIONAL COST TO THE OWNER.
- REMOVE ALL ITEMS THAT WILL BE ABANDONED AS A RESULT OF THE WORK BEING PERFORMED.
- THE CONTRACTOR SHALL FIELD VERIFY ALL EXISTING CONDITIONS, DIMENSIONS AND QUANTITIES OF ALL ITEMS PRIOR TO BID.
- THE CONTRACTOR SHALL TAKE CARE NOT TO DAMAGE PARKING LOT PAVING, CONCRETE SIDEWALKS, LANDSCAPING, GRASS AREAS AND EXTERIOR FINISHES. ANY DAMAGED AREAS SHALL BE RESTORED TO EXISTING CONDITION BY THE CONTRACTOR AT NO ADDITIONAL COST TO THE OWNER.
- COORDINATE THE WORK OF THE DEMOLITION DRAWING WITH ALL CONSTRUCTION DRAWINGS AND DOCUMENTS.
- THIS DRAWING IS A GENERAL LIST OF DEMOLITION ITEMS AND IS NOT EVERY ITEM REQUIRED FOR DEMOLITION. CONTRACTOR SHALL PROVIDE ALL DEMOLITION REQUIRED TO PERFORM ALL WORK INDICATED WITHIN THE PROJECT DRAWINGS AND SPECIFICATIONS AND TO PREPARE ALL AREAS FOR THE CONSTRUCTION WORK.
- THE CONTRACTOR SHALL BE RESPONSIBLE TO TEMPORARILY SUPPORT ALL EXISTING DUCTWORK SCHEDULED TO REMAIN WHETHER OR NOT SPECIFICALLY NOTED ON THEIR DOCUMENTS OR NOT.

DEMO KEY NOTES


- REMOVE AND DISPOSE OF EXISTING SPLINE CEILING SYSTEM IN ITS ENTIRETY INCLUDING, BUT NOT LIMITED TO, TILES, GRID, FRAMING, SUPPORTS, TRIM, AND ALL DEVICES USED TO SECURE THE CEILING IN PLACE UP TO STRUCTURAL DECK ABOVE. COORDINATE REMOVAL OF EXISTING LIGHTING REFERENCED ON 'E' DRAWINGS.
- EXISTING SOFFIT TO REMAIN. PRIME & PAINT TO MATCH EXISTING.

DEMOLITION LEGEND:

- EXISTING SPLINE CEILING TILE SYSTEM TO BE REMOVED AND LEGALLY DISPOSED OF.
- ROOM
± S.F. ROOM NUMBER DESIGNATION TAG
- INDICATES AREA OF WORK FOR ALTERNATE 1

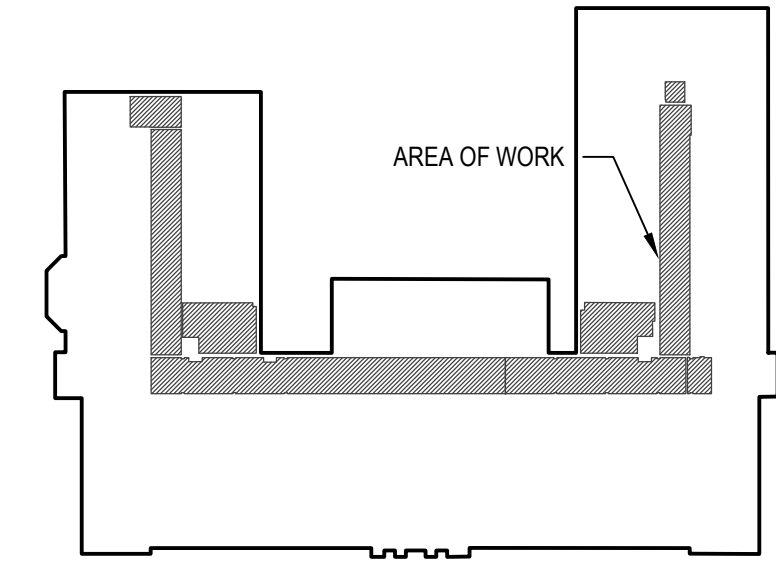

Key Plan
SCALE: N.T.S.

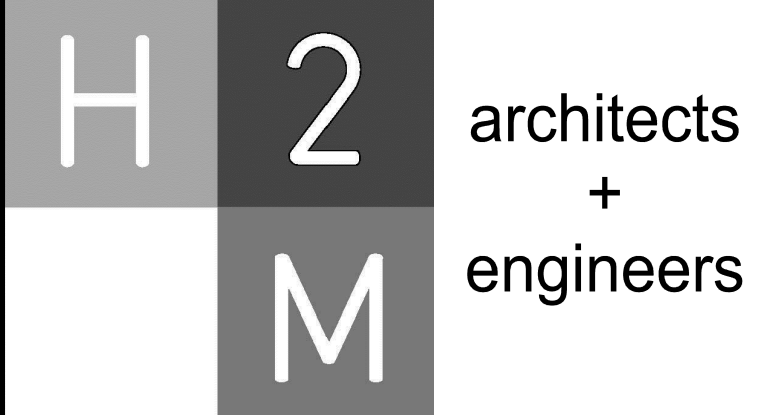

538 Broad Hollow Road, 4th Floor East
Melville, NY 11747
631.756.8000 • www.h2m.com

CONSULTANTS:

MARK	DATE	DESCRIPTION
1	11-22-21	BID ADDENDUM #1
-	11-03-21	FINAL BID SET



DESIGNED BY: CWP	DRAWN BY: RLB	CHECKED BY:	REVIEWED BY:
PROJECT NO: WPSD 2009	DATE: NOVEMBER 2021	SCALE:	AS SHOWN

CLIENT
White Plains City School District

**Renovations at
Rochambeau Alternative
High School**



228 Fisher Avenue
White Plains, NY 10606

SED No. 66-22-00-01-0-15-019


CONTRACT
**CONTRACT G
GENERAL CONSTRUCTION**

STATUS
FINAL BID DOCUMENT

SHEET TITLE
**PARTIAL FIRST FLOOR
DEMOLITION REFLECTED
CEILING PLAN**

DRAWING No.
AD 123.00

DRAWING No. **AD 124.00**

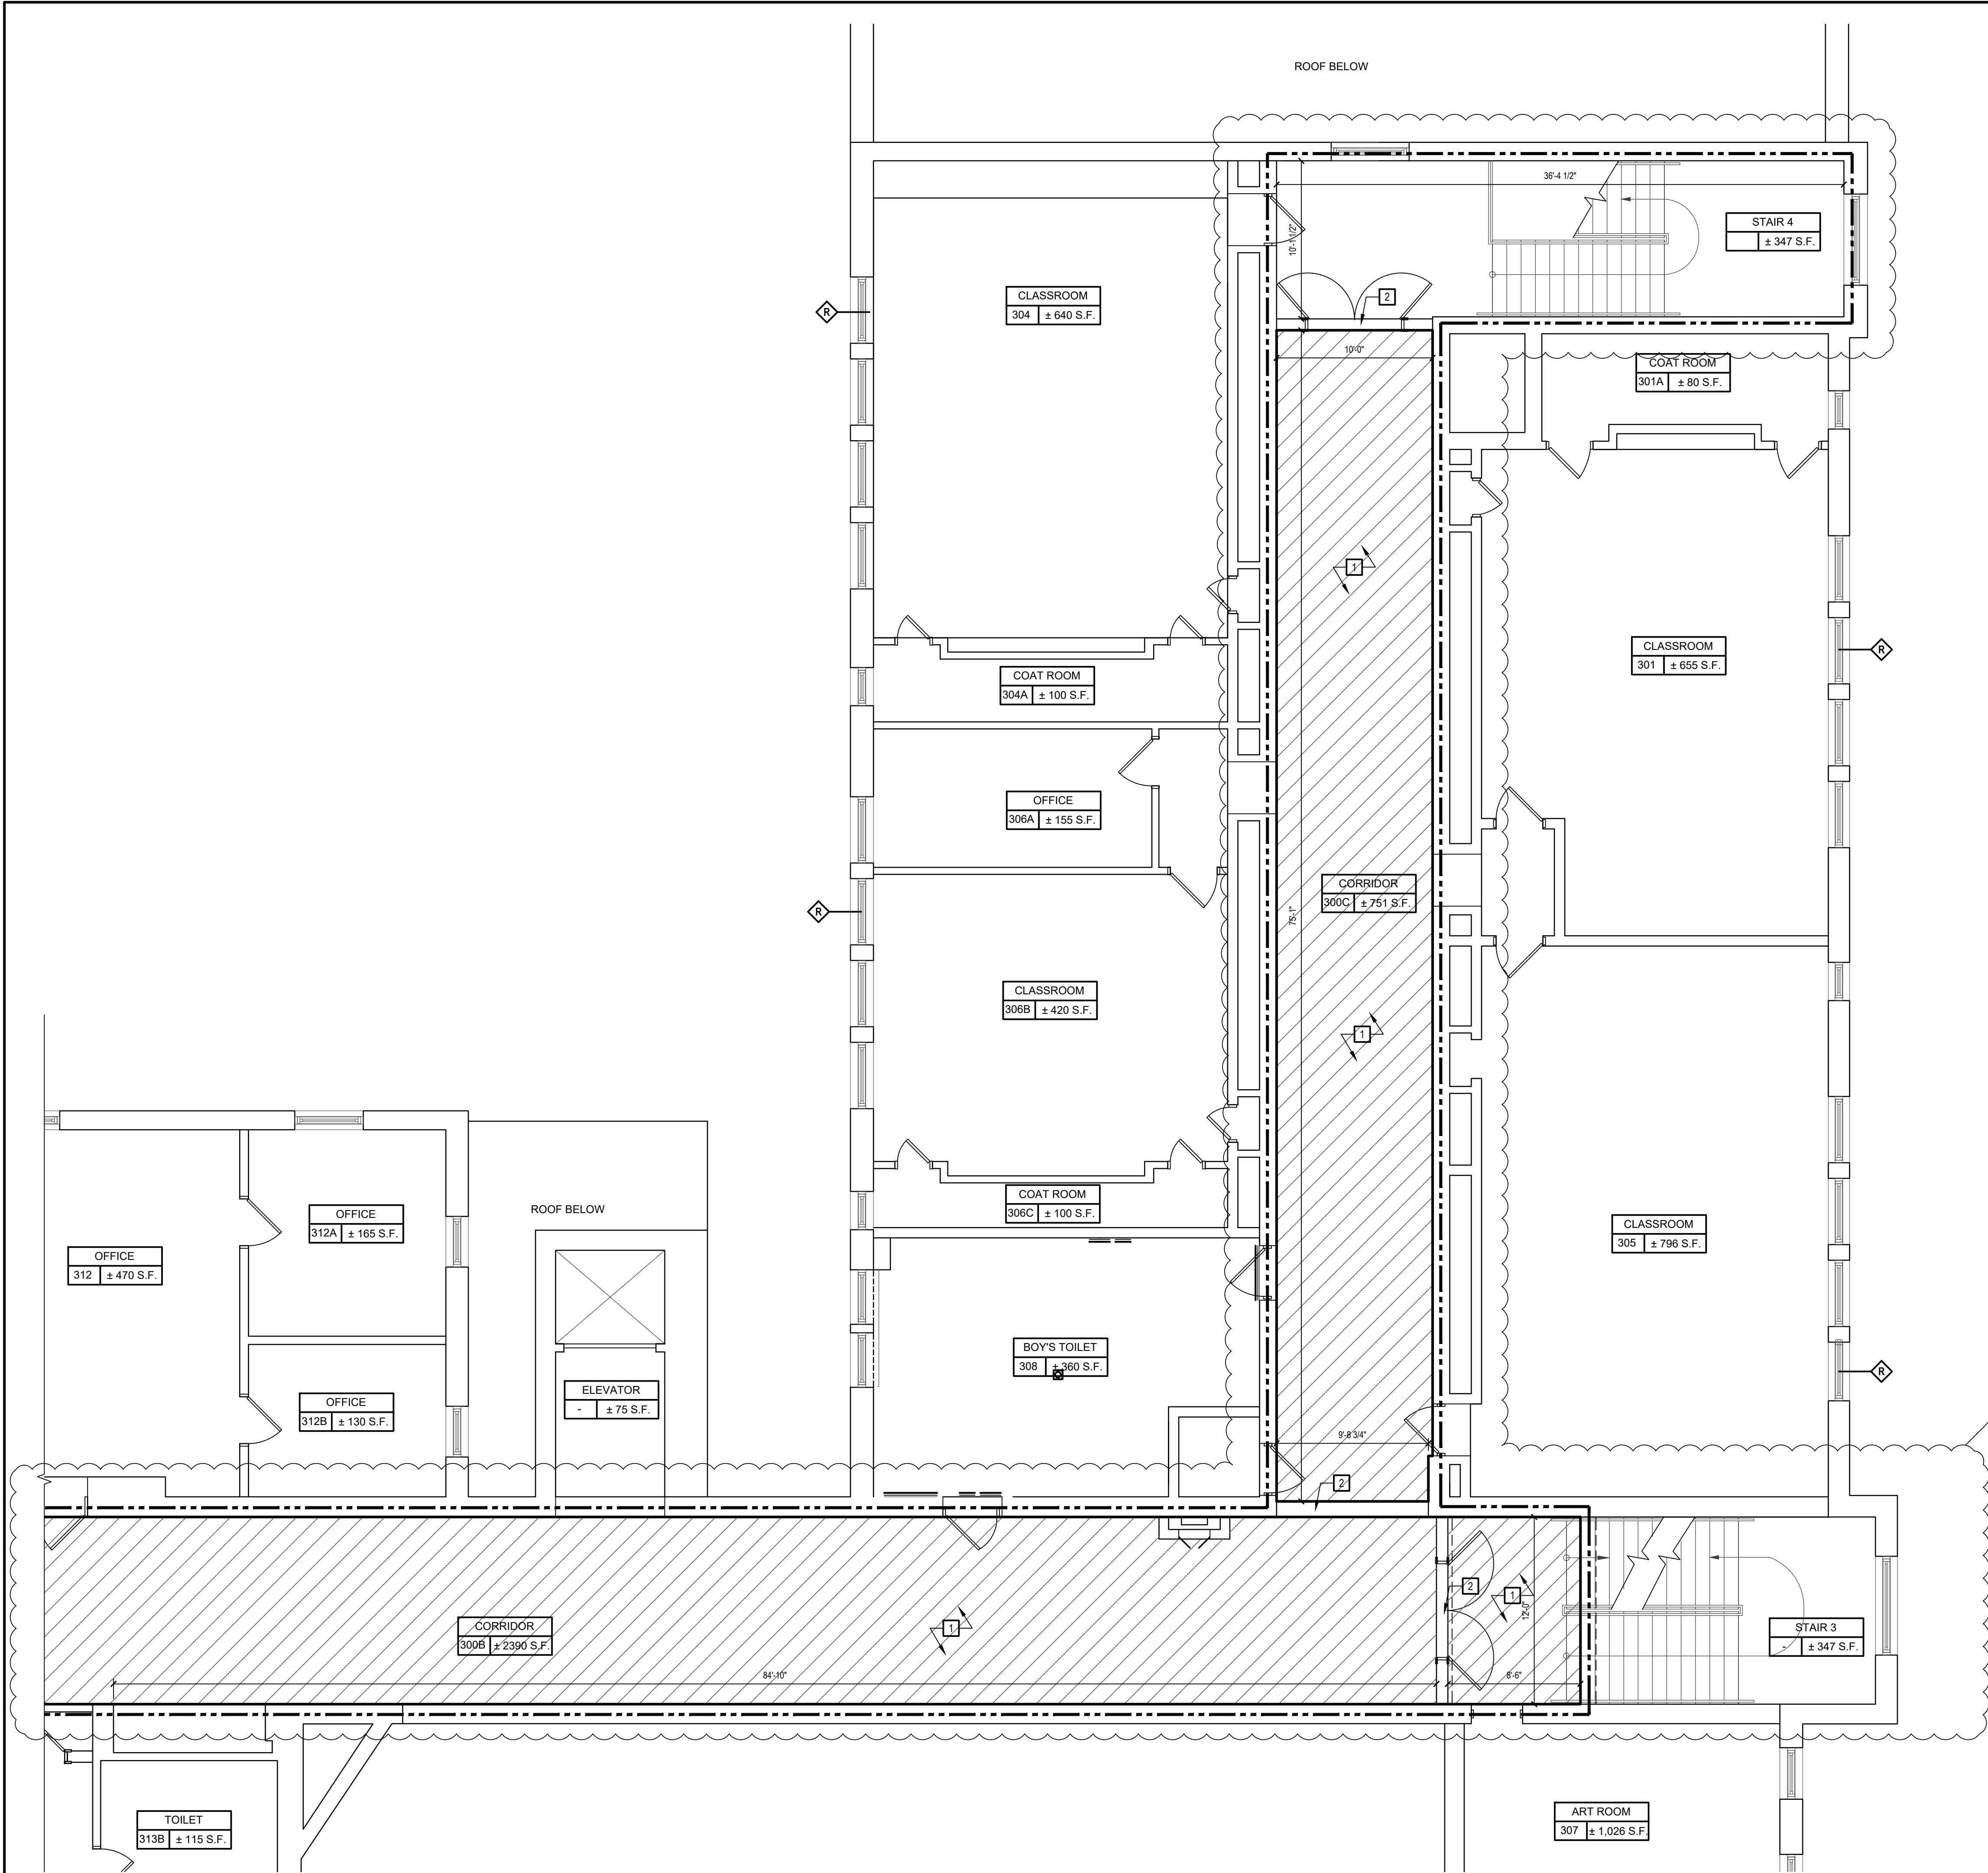

1 Partial Second Floor Demolition Reflected Ceiling Plan
SCALE: 3/16"=1'-0"

GENERAL DEMOLITION NOTES:


1. ALL DEMOLITION WORK SHALL BE IN COMPLIANCE WITH ALL FEDERAL AND NEW YORK STATE APPLICABLE BUILDING AND LIFE AND SAFETY REGULATIONS.
2. THE CONTRACTOR SHALL PROTECT ALL PORTIONS OF THE EXISTING BUILDING WHERE NEW WORK IS TO BE COMPLETED FROM DUST, WEATHER INCLEMENCY AND FREEZING. PROVIDE DUST FREE BARRIER PARTITIONS DURING DEMOLITION TO PREVENT DEBRIS FROM ENTERING NON-WORK AREAS. THE CONTRACTOR WILL BE HELD RESPONSIBLE FOR ANY DAMAGE TO THE EXISTING STRUCTURE OR BUILDING CONTENTS.
3. THE CONTRACTOR ACCESS SHALL BE AS CALLED OUT ON SHEET G0.0. THE CONTRACTOR SHALL ADEQUATELY PROTECT ALL EXISTING FINISHES SCHEDULED TO REMAIN ALONG THE ACCESS ROUTE AND ADJOINING SURFACES OUTSIDE THE CONTRACT AREA OR SCOPE OF WORK FROM DAMAGE DURING THE PROJECT DURATION. THE CONTRACTOR SHALL BE RESPONSIBLE TO RESTORE EXISTING CONDITIONS AND/OR FINISHES DAMAGED DURING CONSTRUCTION INCLUDING PATCHING AND PAINTING AS REQUIRED AND DEEMED NECESSARY BY THE ARCHITECT AT NO ADDITIONAL COST TO THE OWNER.
4. THE CONTRACTOR SHALL REMOVE AND DISPOSE OF ALL CONSTRUCTION DEBRIS AND UNWANTED MATERIAL OFF SITE IN ACCORDANCE WITH ALL FEDERAL AND NEW YORK STATE APPLICABLE BUILDING AND LIFE AND SAFETY REGULATIONS.
5. THE CONTRACTOR SHALL TAKE CARE NOT TO DAMAGE ADJOINING SURFACES AND FINISHES DURING DEMOLITION. THE CONTRACTOR SHALL PATCH AND REPAIR ALL ADJACENT SURFACES DAMAGED DURING DEMOLITION. CONTRACTOR SHALL MATCH ALL ADJACENT FINISHES.
6. OVER-DEMOLITION SHALL BE ALLOWED PROVIDED THAT ALL SURFACES SHALL BE REBUILT TO MATCH MATERIALS, STRUCTURAL INTEGRITY AND APPEARANCE OF THOSE WHICH WERE REMOVED AND IN CONFORMANCE WITH CONTRACT DOCUMENTS AND AT NO ADDITIONAL COST TO THE OWNER.
7. REMOVE ALL ITEMS THAT WILL BE ABANDONED AS A RESULT OF THE WORK BEING PERFORMED.
8. THE CONTRACTOR SHALL FIELD VERIFY ALL EXISTING CONDITIONS, DIMENSIONS AND QUANTITIES OF ALL ITEMS PRIOR TO BID.
9. THE CONTRACTOR SHALL TAKE CARE NOT TO DAMAGE PARKING LOT PAVING, CONCRETE SIDEWALKS, LANDSCAPING, GRASS AREAS AND EXTERIOR FINISHES. ANY DAMAGED AREAS SHALL BE RESTORED TO EXISTING CONDITION BY THE CONTRACTOR AT NO ADDITIONAL COST TO THE OWNER.
10. COORDINATE THE WORK OF THE DEMOLITION DRAWING WITH ALL CONSTRUCTION DRAWINGS AND DOCUMENTS.
11. THIS DRAWING IS A GENERAL LIST OF DEMOLITION ITEMS AND IS NOT EVERY ITEM REQUIRED FOR DEMOLITION. CONTRACTOR SHALL PROVIDE ALL DEMOLITION REQUIRED TO PERFORM ALL WORK INDICATED WITHIN THE PROJECT DRAWINGS AND SPECIFICATIONS AND TO PREPARE ALL AREAS FOR THE CONSTRUCTION WORK.
12. THE CONTRACTOR SHALL BE RESPONSIBLE TO TEMPORARILY SUPPORT ALL EXISTING DUCTWORK SCHEDULED TO REMAIN WHETHER OR NOT SPECIFICALLY NOTED ON THEIR DOCUMENTS OR NOT.

DEMO KEY NOTES


- 1 REMOVE AND DISPOSE OF EXISTING SPLINE CEILING SYSTEM IN ITS ENTIRETY INCLUDING, BUT NOT LIMITED TO, TILES, GRID, FRAMING, SUPPORTS, TRIM, AND ALL DEVICES USED TO SECURE THE CEILING IN PLACE UP TO STRUCTURAL DECK ABOVE. COORDINATE REMOVAL OF EXISTING LIGHTING REFERENCED ON 'E' DRAWINGS.
- 2 EXISTING SOFFIT TO REMAIN. PRIME & PAINT TO MATCH EXISTING.

DEMOLITION LEGEND:

- EXISTING SPLINE CEILING TILE SYSTEM TO BE REMOVED AND LEGALLY DISPOSED OF.
- ROOM ROOM NUMBER DESIGNATION TAG
- INDICATES AREA OF WORK FOR ALTERNATE 1

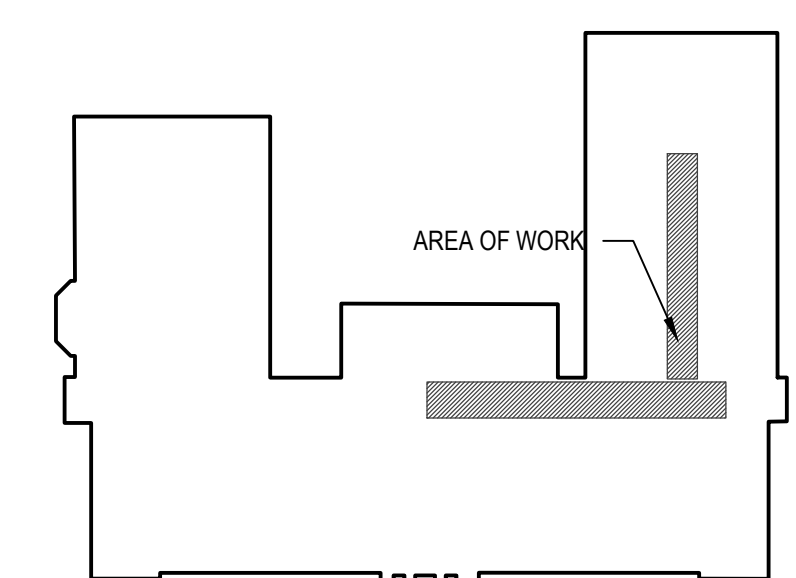

Key Plan
SCALE: N.T.S.

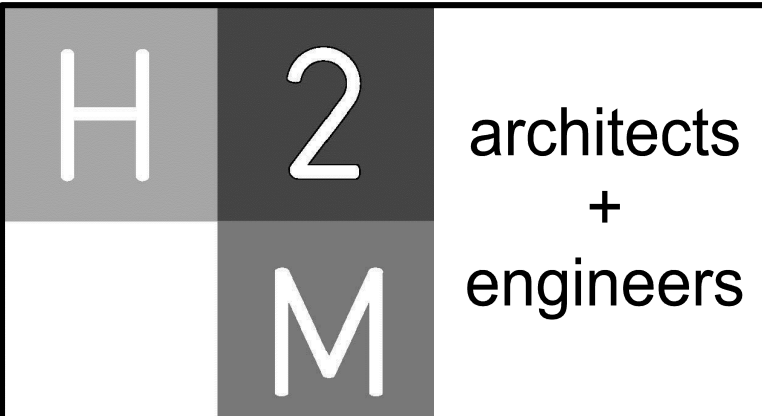

538 Broad Hollow Road, 4th Floor East
Melville, NY 11747
631.756.8000 • www.h2m.com

CONSULTANTS:

MARK	DATE	DESCRIPTION
1	11-22-21	BID ADDENDUM #1
-	11-03-21	FINAL BID SET



DESIGNED BY: CWP	DRAWN BY: RLB	CHECKED BY:	REVIEWED BY:
PROJECT NO: WPSD 2009	DATE: NOVEMBER 2021	SCALE:	AS SHOWN

CLIENT
White Plains City School District

**Renovations at
Rochambeau Alternative
High School**



228 Fisher Avenue
White Plains, NY 10606

SED No. 66-22-00-01-0-15-019

CONTRACT
**CONTRACT G
GENERAL CONSTRUCTION**

STATUS
FINAL BID DOCUMENT

SHEET TITLE
**PARTIAL SECOND FLOOR
DEMOLITION REFLECTED
CEILING PLAN**

DRAWING No.
AD 125.00

CONSULTANTS:

MARK	DATE	DESCRIPTION
1	11-22-21	BID ADDENDUM #1
-	11-03-21	FINAL BID SET



"ALTERATION OF THIS DOCUMENT EXCEPT BY A LICENSED PROFESSIONAL IS ILLEGAL"			
SIGNED BY: JRM	DRAWN BY: CJM	CHECKED BY:	REVIEWED BY: 0
PROJECT No: WPSD 2009	DATE: NOVEMBER 2021	SCALE: AS SHOWN	

White Plains City School District

Renovations at Rochambeau Alternative High School



**228 Fisher Avenue
White Plains, NY 10606**

SED No. 66-22-00-01-0-15-019

CONTRACT

CONTRACT G


GENERAL CONSTRUCTION

STATUS **FINAL BID DOCUMENT**


**PLUMBING DEMOLITION
ENLARGEMENT PLANS
FOR ROOMS 110, 110A,
207, 219 AND 308**

DRAWING No. **P200.00**

1. ALL DEMOLITION WORK SHALL BE IN COMPLIANCE WITH ALL FEDERAL AND NEW YORK STATE APPLICABLE BUILDING AND LIFE AND SAFETY REGULATIONS.
2. THE CONTRACTOR SHALL REMOVE AND DISPOSE OF ALL CONSTRUCTION DEBRIS AND UNWANTED MATERIAL OFF SITE IN ACCORDANCE WITH CONTRACT SPECIFICATIONS.
3. THE CONTRACTOR SHALL TAKE CARE NOT TO DAMAGE ADJOINING SURFACES OUTSIDE THE CONTRACT AREA OR SCOPE OF WORK. THE CONTRACTOR SHALL BE RESPONSIBLE TO RESTORE TO EXISTING CONDITIONS SURFACE DAMAGED DURING CONSTRUCTION INCLUDING PATCHING AND PAINTING AS REQUIRED AND DEEMED NECESSARY BY THE ARCHITECT.
4. CONTRACTOR SITE ACCESS SHALL BE AS CALLED OUT ON SHEET A-0.0. THE CONTRACTOR SHALL ADEQUATELY PROTECT THE WALLS, FLOOR, AND FINISHES WITHIN STAIRWELLS AND SERVICE ELEVATOR FROM DAMAGE DURING THE PROJECT DURATION. THE CONTRACTOR SHALL BE RESPONSIBLE TO PATCH AND RESTORE ALL SURFACES THAT ARE DAMAGED TO THE SATISFACTION OF THE ARCHITECT.
5. THE CONTRACTOR SHALL TAKE CARE AS TO ADEQUATELY PROTECT ALL ADJOINING CLASSROOMS, CLOSETS, CORRIDORS, CRITICAL BARRIERS (DUCTS, VENTS, ETC.), AND OTHER SPACES FROM DUST AND DEBRIS DURING THE DEMOLITION AND INSTALLATION OF THE FLOORING, CEILINGS, LOCKERS, AND PAINTING. THE CONTRACTOR SHALL BE RESPONSIBLE TO WIPE DOWN AND CLEAN ALL AFFECTED ROOMS UPON COMPLETION OF THE PROJECT.
6. ALL EQUIPMENT SHALL BE EXISTING TO REMAIN UNLESS OTHERWISE NOTE AND THUS BE PROTECTED THROUGH THE PROJECT DURATION. THE CONTRACTOR SHALL NOTIFY THE ARCHITECT OF ANY DEFECTIVE OR NON-WORKING EQUIPMENT PRIOR TO WORK STARTING AND FOLLOWING INSTALLATION OF NEW FINISHES, SHALL VERIFY THAT ALL OF THE ITEMS ARE IN PROPER WORKING ORDER UPON COMPLETION.

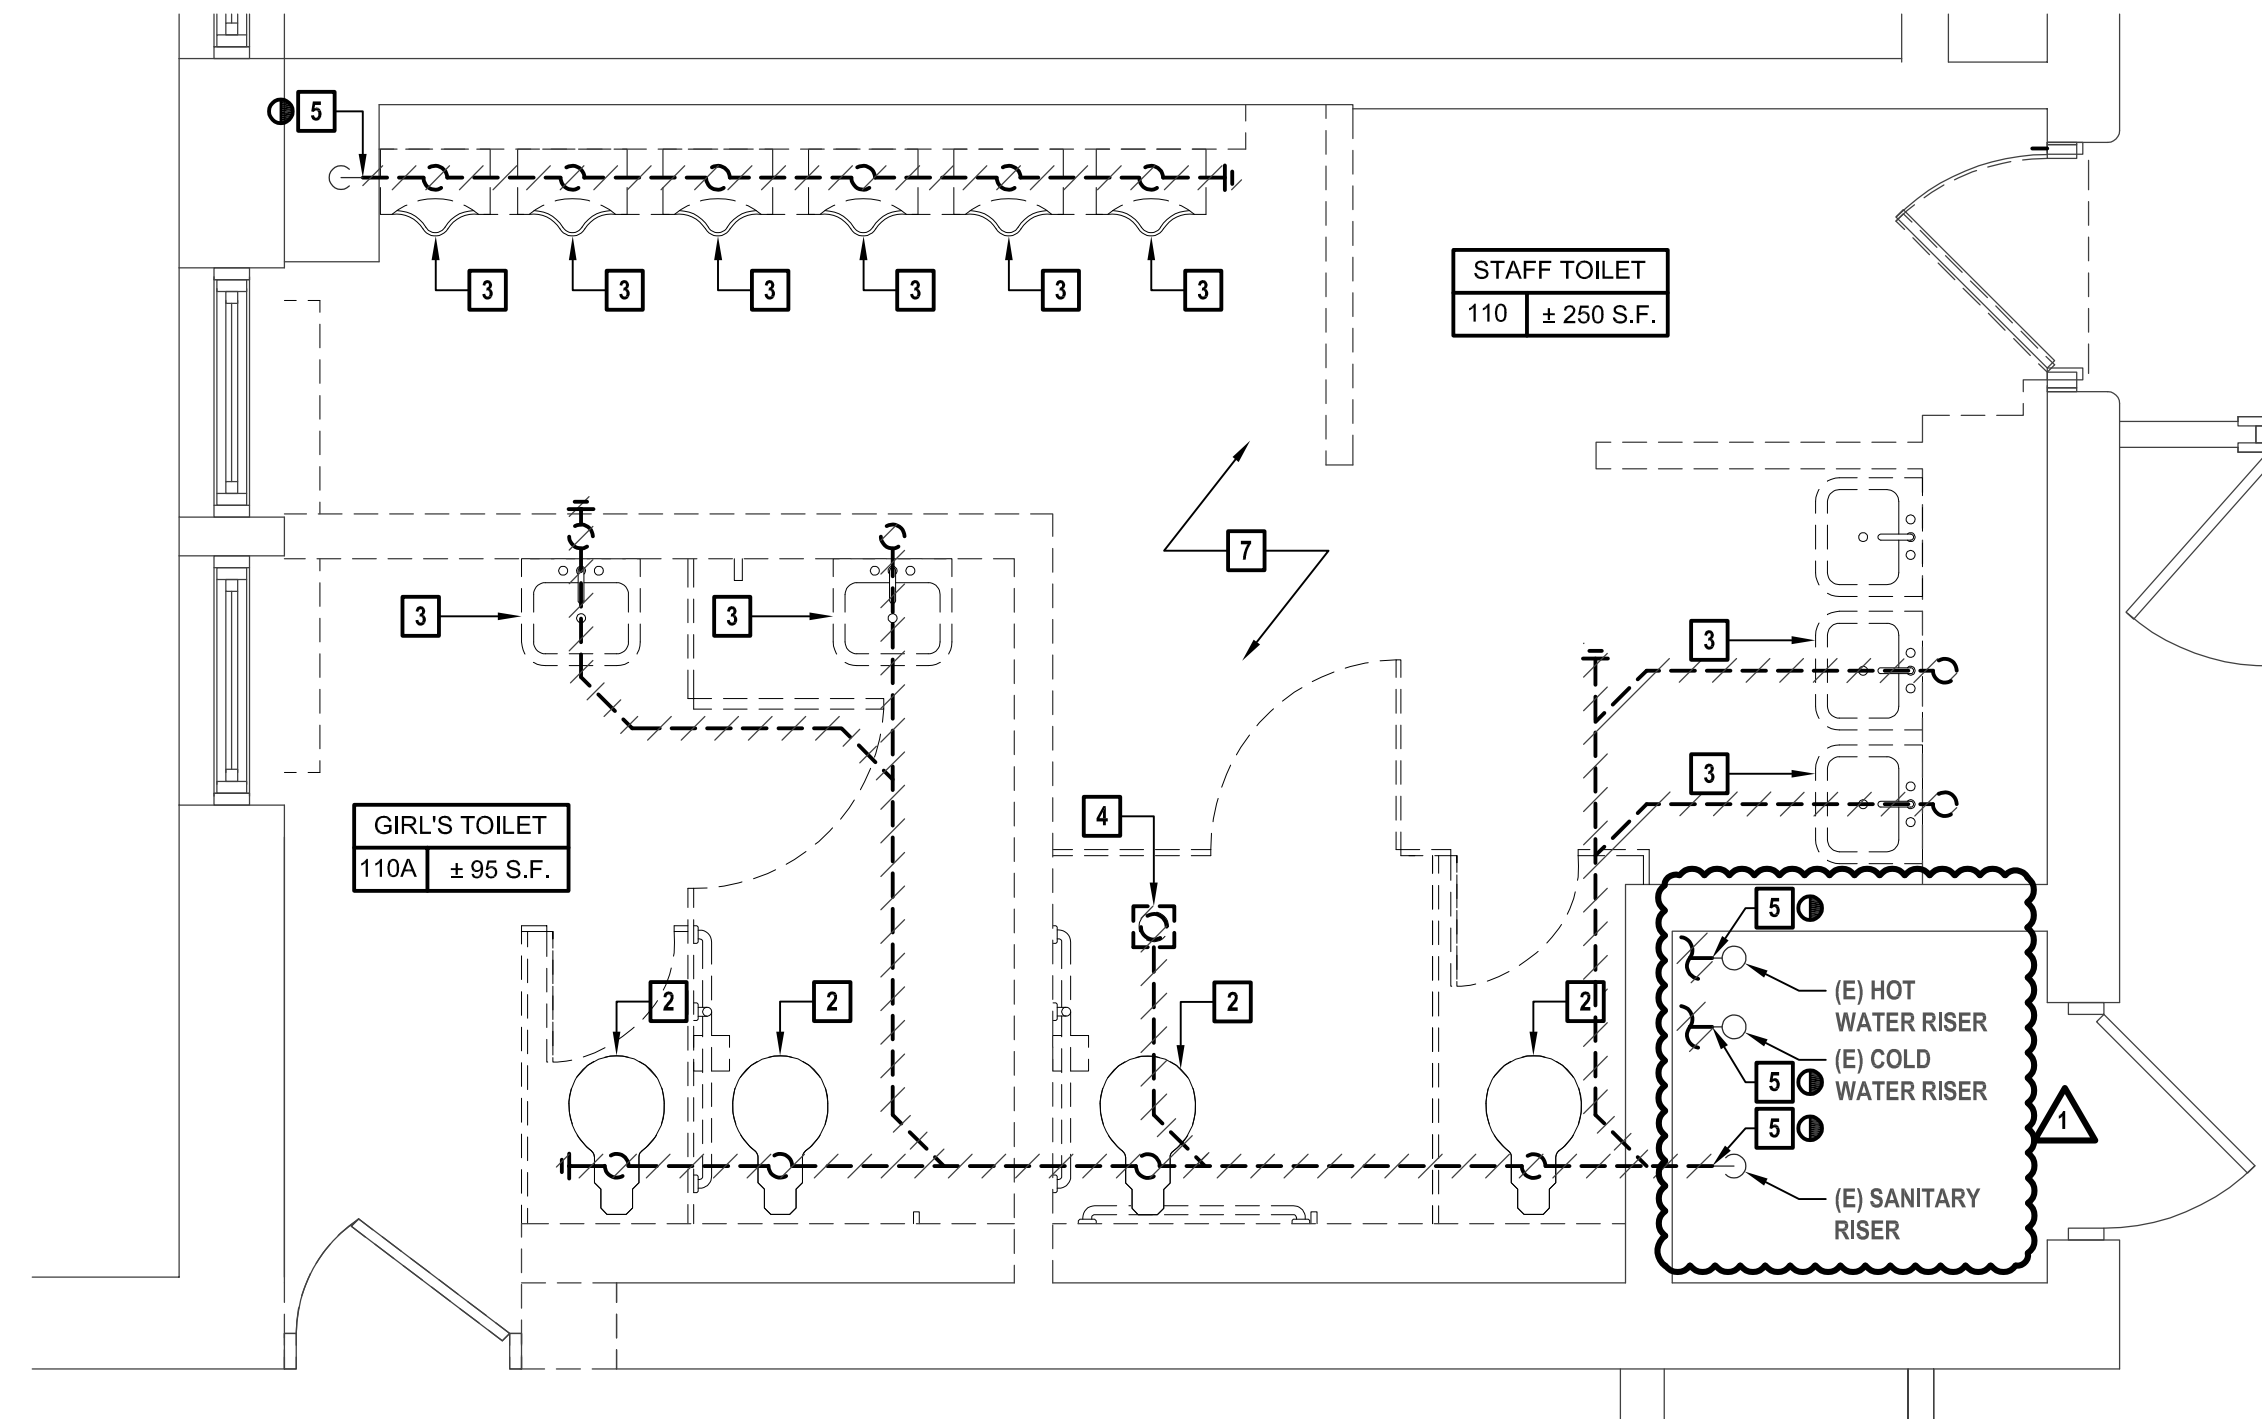


1 Enlarged Demolition 110 Staff Toilet and 110A Girl's Toilet
SCALE: 3/8"=1'-0"

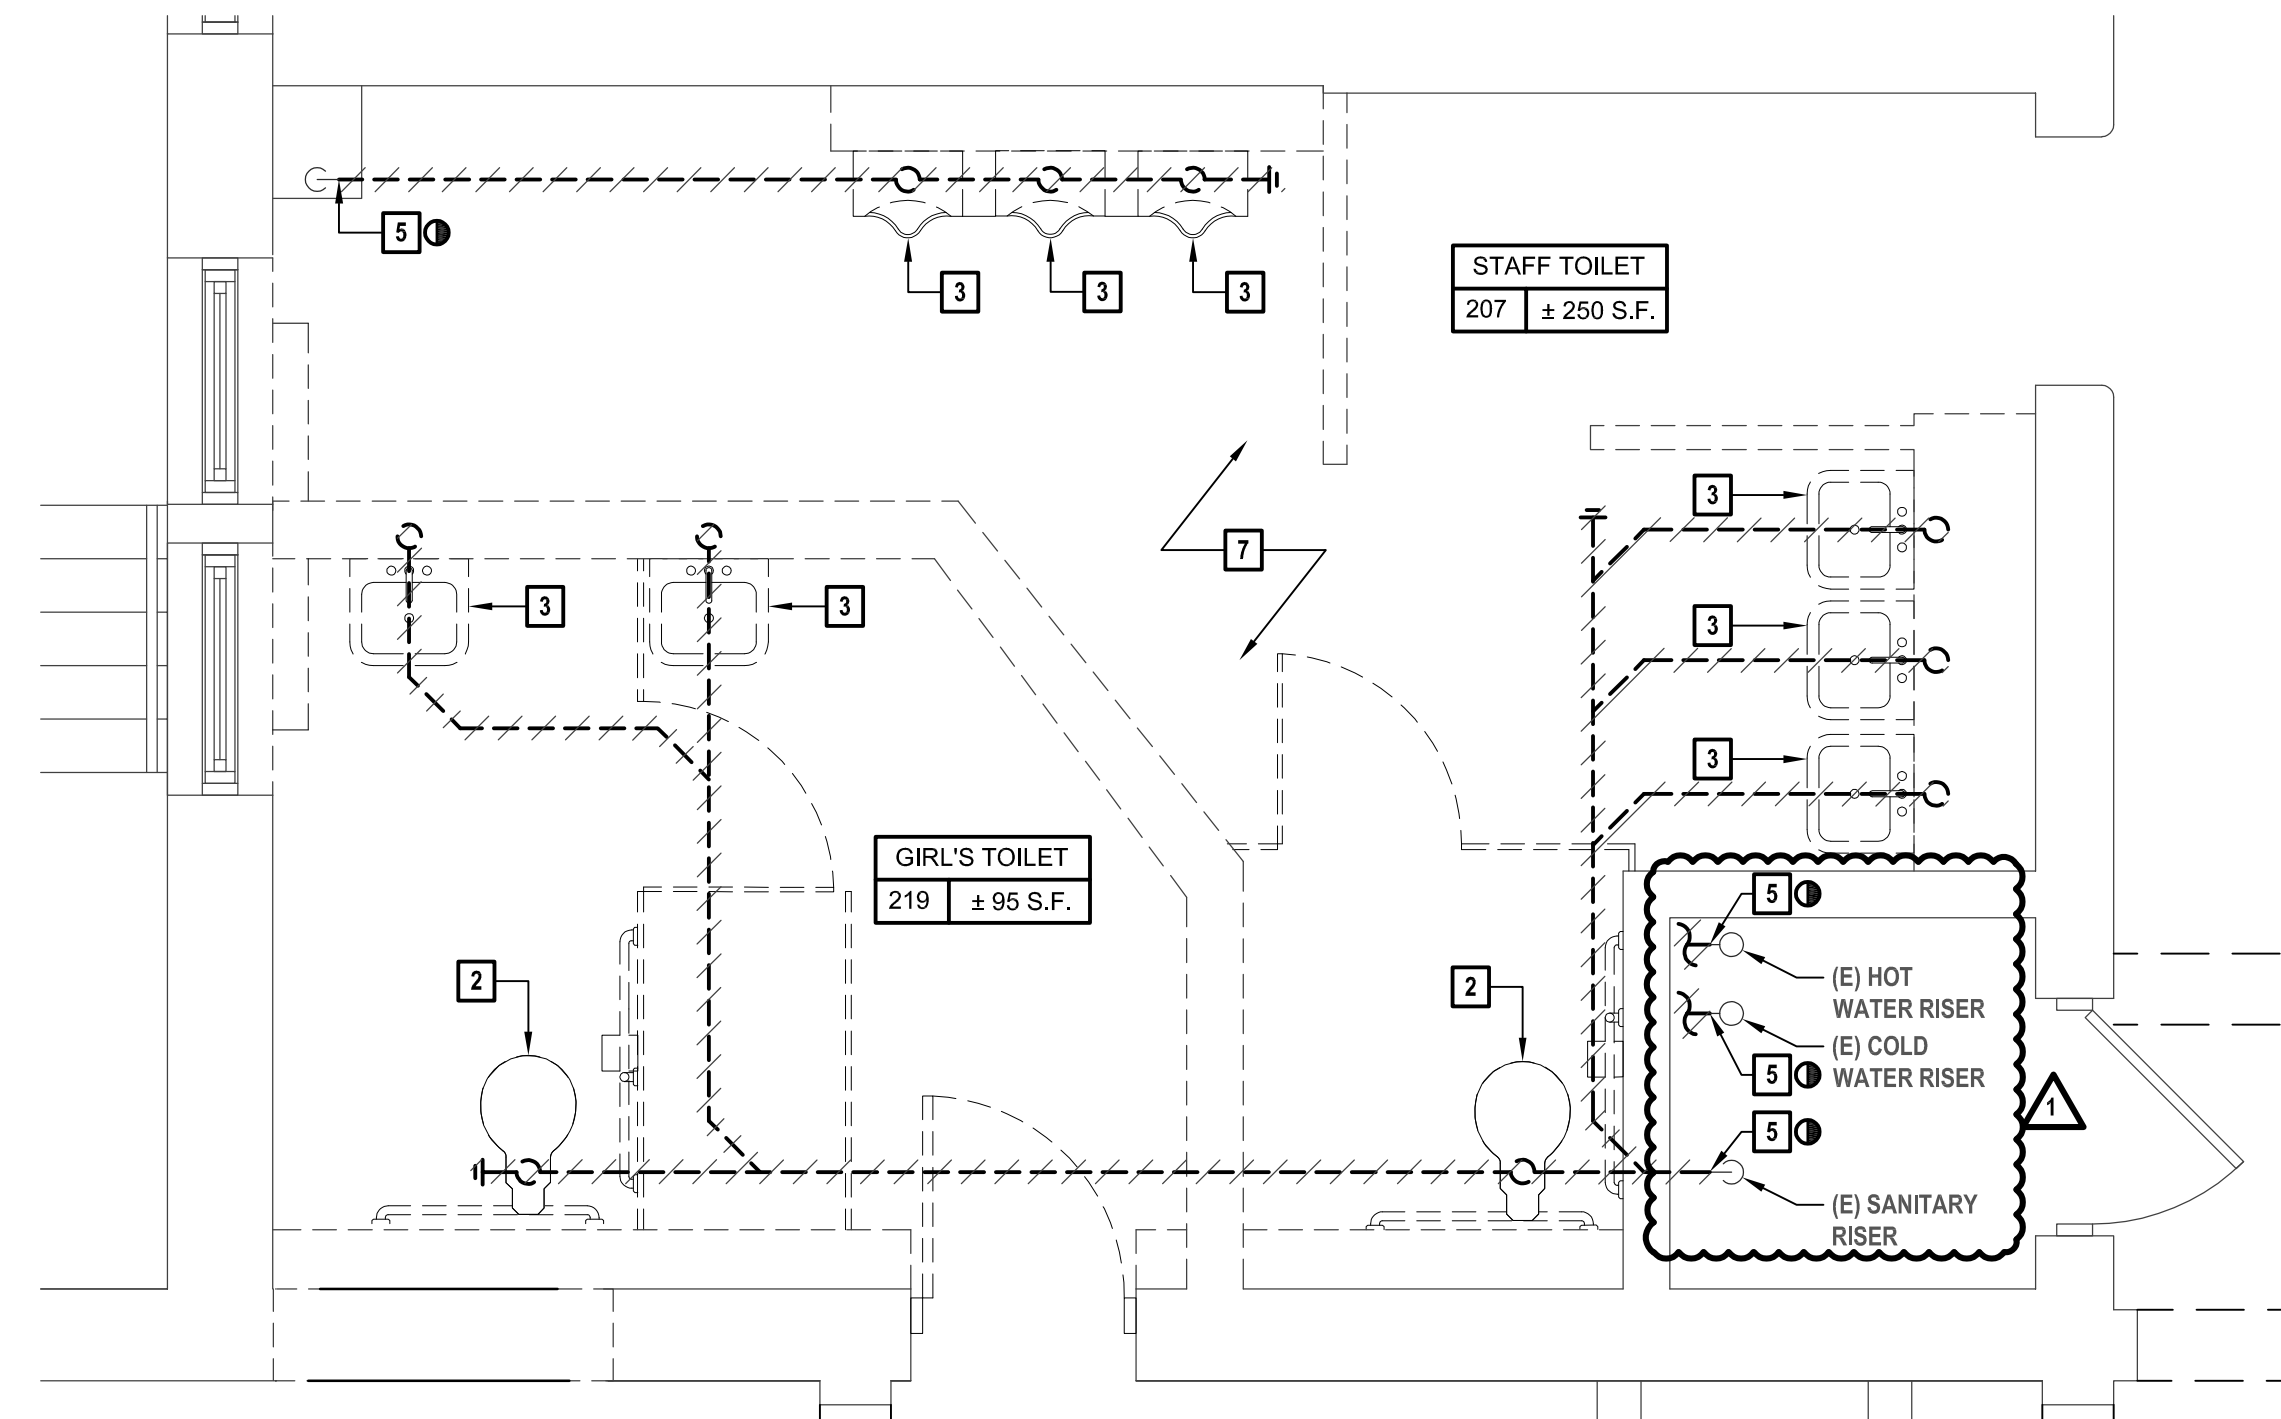


3 Enlarged Demolition 207 Staff Toilet and 219 Girl's Toilet
SCALE: 3/8"=1'-0"

1. PLUMBING FIXTURE TO BE REMOVED AND DISPOSED OF. CUT AND CAP EXISTING SANITARY PIPING AT FLOOR LEVEL TO BE TILED OVER.
2. EXISTING TOILET TO BE REMOVED AND DISPOSED OF. 4" SANITARY AND VENT TO BE REMOVED UNDERSLAB. SEE PLANS FOR EXTENT OF PIPE DEMOLITION.
3. EXISTING LAVATORY AND URINAL TO BE REMOVED AND DISPOSED OF. CUT AND CAP EXISTING SANITARY PIPING AT FLOOR LEVEL AND EXISTING VENT PIPING ABOVE CEILING AND PREPARE FOR RECONNECTION.
4. EXISTING FLOOR DRAIN TO BE REMOVED AND DISPOSED OF. CUT AND CAP PIPING AT FLOOR LEVEL TO BE TILED OVER. SEE PLANS FOR EXTENT OF PIPE DEMOLITION.
5. EXISTING SANITARY SHALL BE CUT AND CAPPED AT EXISTING RISER. EXISTING RISER TO BE ABANDONED IN PLACE.
6. EXISTING SANITARY SHALL BE CUT AND CAPPED AT EXISTING RISER AND PREPARE RISER FOR FUTURE CONNECTION.
7. ALL COLD AND HOT WATER PIPING SHALL BE CUT AND CAPPED AT EXISTING RISERS AND PREPARE RISER FOR FUTURE CONNECTION.

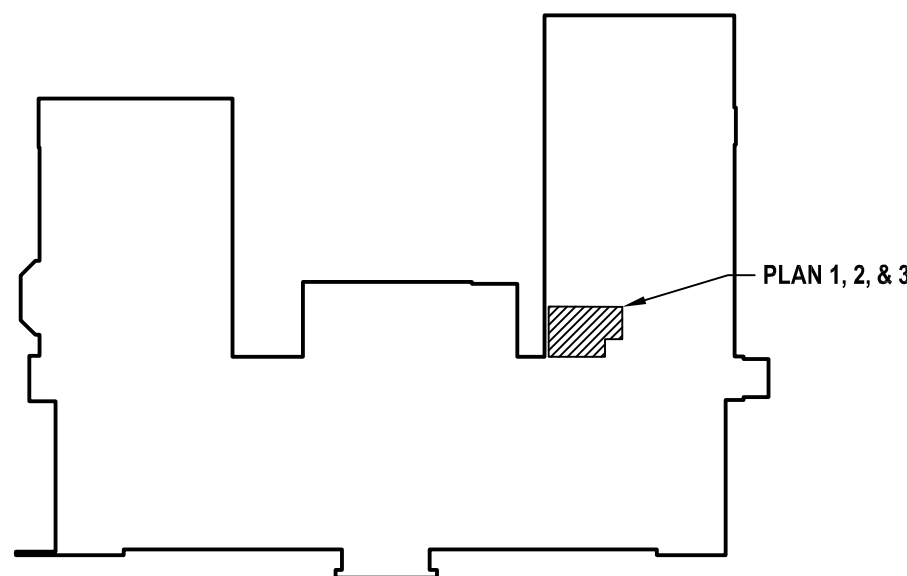


4 Key Plan

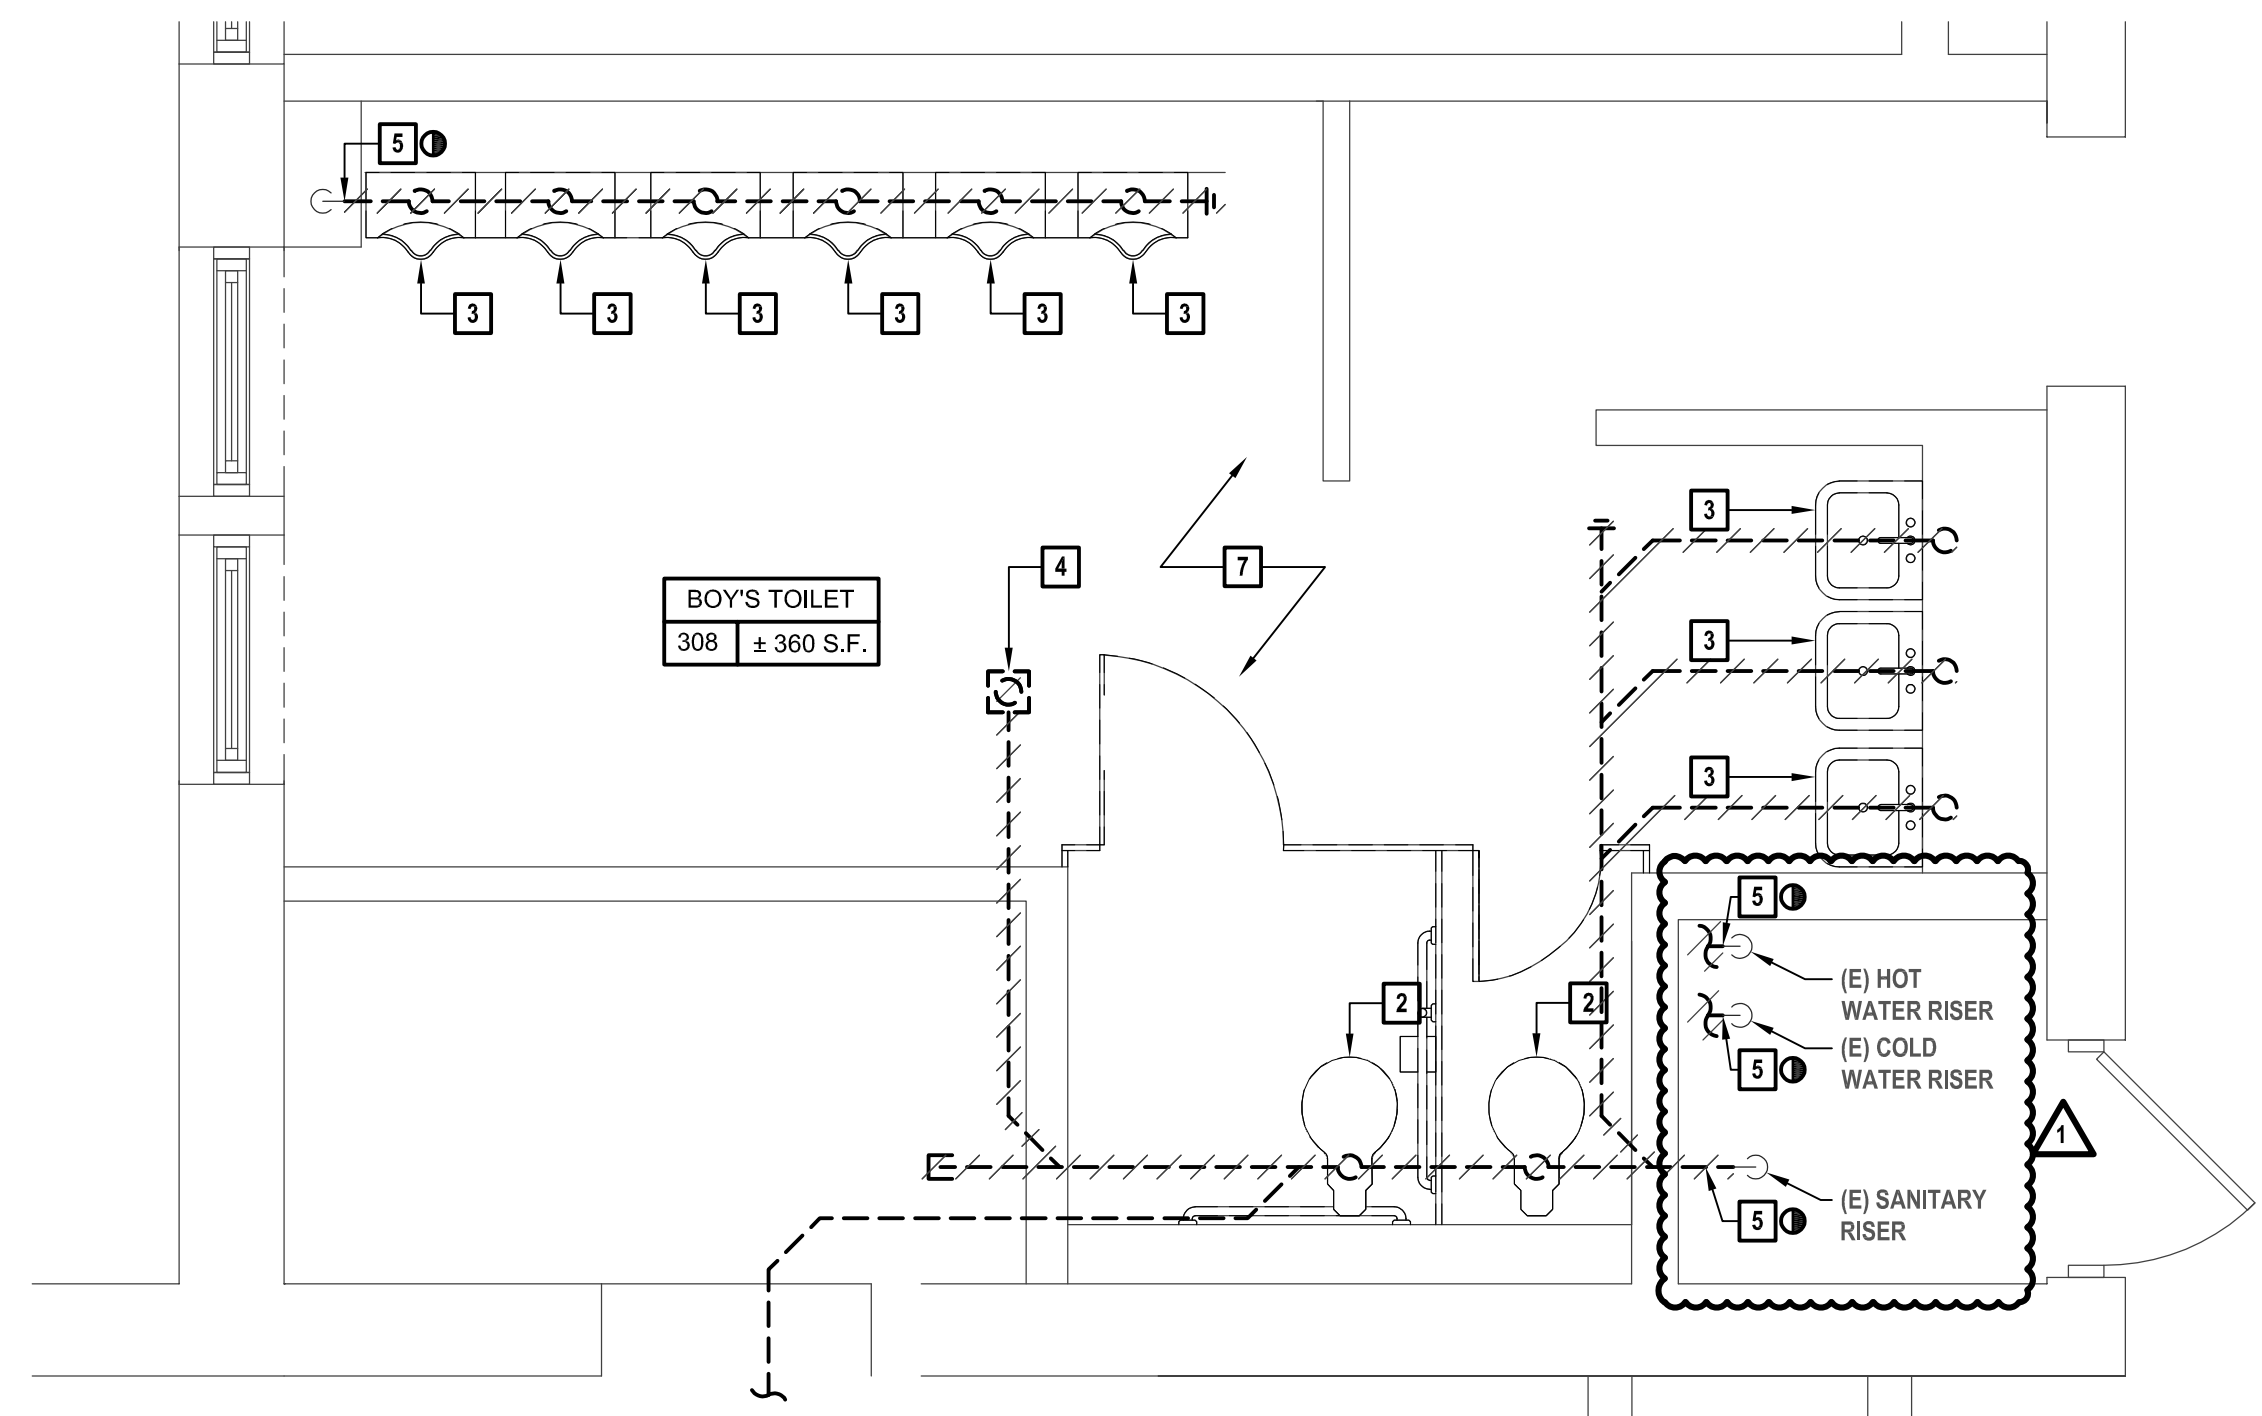

3 Enlarged Demolition 308 Boy's Toilet
SCALE: 3/8"=1'-0"

MARK	DATE	DESCRIPTION
1	11-22-21	BID ADDENDUM #1
-	11-03-21	FINAL BID SET

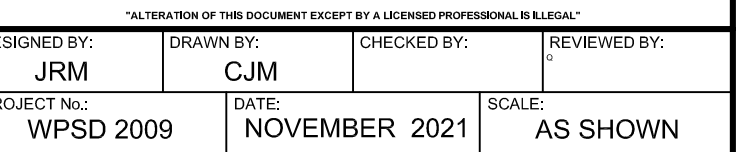

White Plains City School District



SED No. 66-22-00-01-0-15-019

CONTRACT G
GENERAL CONSTRUCTION

FINAL BID DOCUMENT


**PLUMBING DEMOLITION
ENLARGEMENT PLANS
FOR ROOMS 123, 124, 221,
222 AND 318**

P201.00

1. ALL DEMOLITION WORK SHALL BE IN COMPLIANCE WITH ALL FEDERAL AND NEW YORK STATE APPLICABLE BUILDING AND LIFE AND SAFETY REGULATIONS.
2. THE CONTRACTOR SHALL REMOVE AND DISPOSE OF ALL CONSTRUCTION DEBRIS AND UNWANTED MATERIAL OFF SITE IN ACCORDANCE WITH CONTRACT SPECIFICATIONS.
3. THE CONTRACTOR SHALL TAKE CARE NOT TO DAMAGE ADJOINING SURFACES OUTSIDE THE CONTRACT AREA OR SCOPE OF WORK. THE CONTRACTOR SHALL BE RESPONSIBLE TO RESTORE TO EXISTING CONDITIONS SURFACES DAMAGED DURING CONSTRUCTION INCLUDING PATCHING AND PAINTING AS REQUIRED AND DEEMED NECESSARY BY THE ARCHITECT.
4. CONTRACTOR SITE ACCESS SHALL BE AS CALLED OUT ON SHEET A0.0. THE CONTRACTOR SHALL ADEQUATELY PROTECT THE WALLS, FLOOR, AND FINISHES WITHIN STAIRWELLS AND SERVICE ELEVATOR FROM DAMAGE DURING THE PROJECT DURATION. THE CONTRACTOR SHALL BE RESPONSIBLE TO PATCH AND RESTORE ALL SURFACES THAT ARE DAMAGED TO THE SATISFACTION OF THE ARCHITECT.
5. THE CONTRACTOR SHALL TAKE CARE AS TO ADEQUATELY PROTECT ALL ADJOINING CLASSROOMS, CLOSETS, CORRIDORS, CRITICAL BARRIERS (DUCTS, VENTS, ETC.), AND OTHER SPACES FROM DUST AND DEBRIS DURING THE DEMOLITION AND INSTALLATION OF THE FLOORING, CEILINGS, LOCKERS, AND PAINTING. THE CONTRACTOR SHALL BE RESPONSIBLE TO WIPE DOWN AND CLEAN ALL AFFECTED ROOMS UPON COMPLETION OF THE PROJECT.
6. ALL EQUIPMENT SHALL BE EXISTING TO REMAIN UNLESS OTHERWISE NOTE AND THUS BE PROTECTED THROUGH THE PROJECT DURATION. THE CONTRACTOR SHALL NOTIFY THE ARCHITECT OF ANY DEFECTIVE OR NON-WORKING EQUIPMENT PRIOR TO WORK STARTING AND FOLLOWING INSTALLATION OF NEW FINISHES, SHALL VERIFY THAT ALL OF THE ITEMS ARE IN PROPER WORKING ORDER UPON COMPLETION.



1. PLUMBING FIXTURE TO BE REMOVED AND DISPOSED OF. CUT AND CAP EXISTING SANITARY PIPING AT FLOOR LEVEL TO BE TILED OVER.
2. EXISTING TOILET TO BE REMOVED AND DISPOSED OF. 4" SANITARY RISER VENTING TO BE REMOVED UNDERSLAB. SEE PLANS FOR EXTENT OF PIPE DEMOLITION.
3. EXISTING LAVATORY AND URINAL TO BE REMOVED AND DISPOSED OF. CUT AND CAP EXISTING SANITARY PIPING AT FLOOR LEVEL. AND EXISTING VENT PIPING ABOVE CEILING AND PREPARE FOR RECONNECTION.
4. EXISTING FLOOR DRAIN TO BE REMOVED AND DISPOSED OF. CUT AND CAP PIPING AT FLOOR LEVEL TO BE TILED OVER. SEE PLANS FOR EXTENT OF PIPE DEMOLITION.
5. EXISTING SANITARY SHALL BE CUT AND CAPPED AT EXISTING RISER. EXISTING RISER TO BE ABANDONED IN PLACE.
6. EXISTING SANITARY SHALL BE CUT AND CAPPED AT EXISTING RISER AND PREPARE RISER FOR FUTURE CONNECTION.
7. ALL COLD AND HOT WATER PIPING SHALL BE CUT AND CAPPED AT EXISTING RISERS.

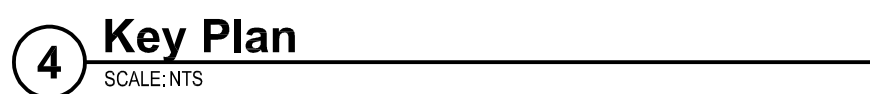

CONSULTANTS:		

MARK	DATE	DESCRIPTION
1	11-22-21	BID ADDENDUM #1
-	11-03-21	FINAL BID SET

STATE OF NEW YORK

JOSEPH RICHARDS, N.Y.S.E.

096440-1

PROFESSIONAL ENGINEER

DESIGNED BY:

JRM

DRAWN BY:

CJM

CHECKED BY:

REVIEWED BY:

PROJECT NO.:

WPSPD 2009

DATE:

NOVEMBER 2021

SCALE:

AS SHOWN

CLIENT
White Plains City School District

Renovations at
Rochambeau Alternative
High School

White Plains Public School

WP

REAL LIFE LEARNING

228 Fisher Avenue
White Plains, NY 10606

SED No. 66-22-00-01-0-15-019

CONTRACT
**CONTRACT G
GENERAL CONSTRUCTION**

STATUS
FINAL BID DOCUMENT

SHEET TITLE
**PLUMBING UNDERSLAB,
SANITARY AND VENT
ENLARGEMENT PLANS
FOR ROOMS 110, 110A,
207, 219, 308 AND 308A**


DRAWING No.
P202.00

PLUMBING NOTES

1. VERIFY IN FIELD EXACT LOCATIONS OF HOT WATER AND COLD WATER SUPPLY LINES, SANITARY, WASTE & VENT LINES. REROUTE AND MODIFY EXISTING PLUMBING LINES AS REQUIRED FOR CONNECTIONS TO NEW PLUMBING FIXTURES.
2. INSULATE ALL NEW WATER PIPING AND RE-INSULATE ALL EXISTING WATER PIPING WHERE INSULATION IS DAMAGED.
3. ALL 3" & 4" SANITARY PIPING TO BE SLOPED A MINIMUM OF 1/8"/FT. ALL 1-1/2" & 2" SANITARY PIPING TO BE SLOPED A MINIMUM OF 1/4"/FT.
4. CHASE WALL WILL NEED TO BE OPENED TO ALLOW ACCESS TO EXISTING PIPING AND THEN REPAIRED. REFER TO ARCHITECTURAL DRAWINGS FOR MORE DETAIL.
5. INSTALL NEW SHUT OFF VALVES OR REPLACE EXISTING VALVES ON ALL COLD WATER AND HOT WATER BRANCH PIPING ENTERING TOILETS.
6. FURNISH AND INSTALL NEW CLEANOUT DECK PLATE, ZURN MODEL Z1400 OR APPROVED EQUAL AS REQUIRED IN EACH BATHROOM.
7. CONTRACTOR IS RESPONSIBLE TO INSTALL ALL NEW DOMESTIC AND SANITARY PIPING IN BATHROOM AND CONNECT TO EXISTING PIPING IN CORRIDORS/CHASE.


KEYED PLUMBING NOTES

1. 4" SAN UP TO WATER CLOSET.
2. 2" SAN UP TO URINAL.
3. 2" SAN UP TO LAVATORY.
4. 2" SAN UP TO FLOOR DRAIN.
5. 2" VENT DROP.
6. 2" VENT UP.
7. 2" VENT DOWN. 4" SAN UP TO WATER CLOSET ON FLOOR ABOVE.
8. 2" VENT DOWN. 2" SAN UP TO URINAL ON FLOOR ABOVE.
9. 1-1/2" VENT DOWN. 2" SAN UP TO LAVATORY ON FLOOR ABOVE.
10. 2 VENT DOWN.
11. 1-1/2" VENT DOWN.

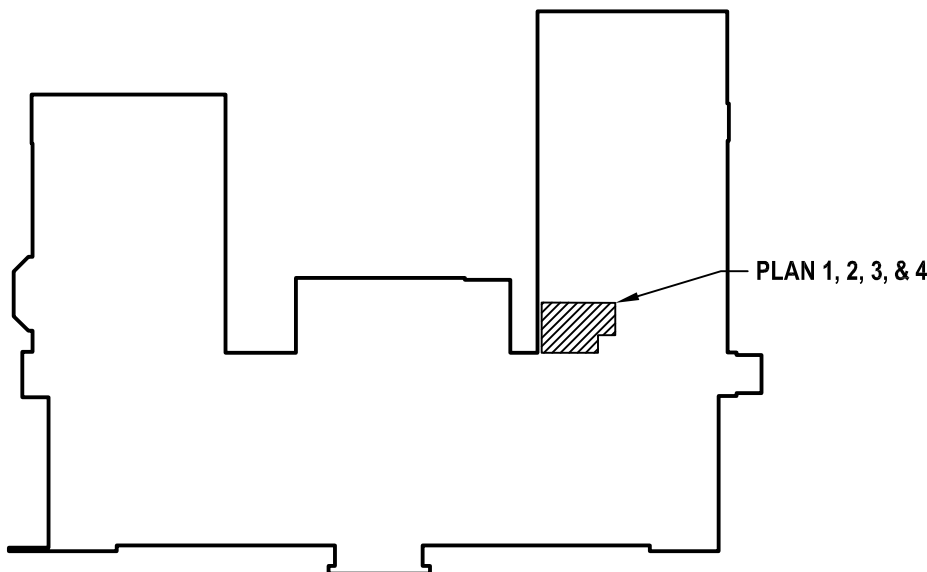


5 Key Plan

SCALE: NTS

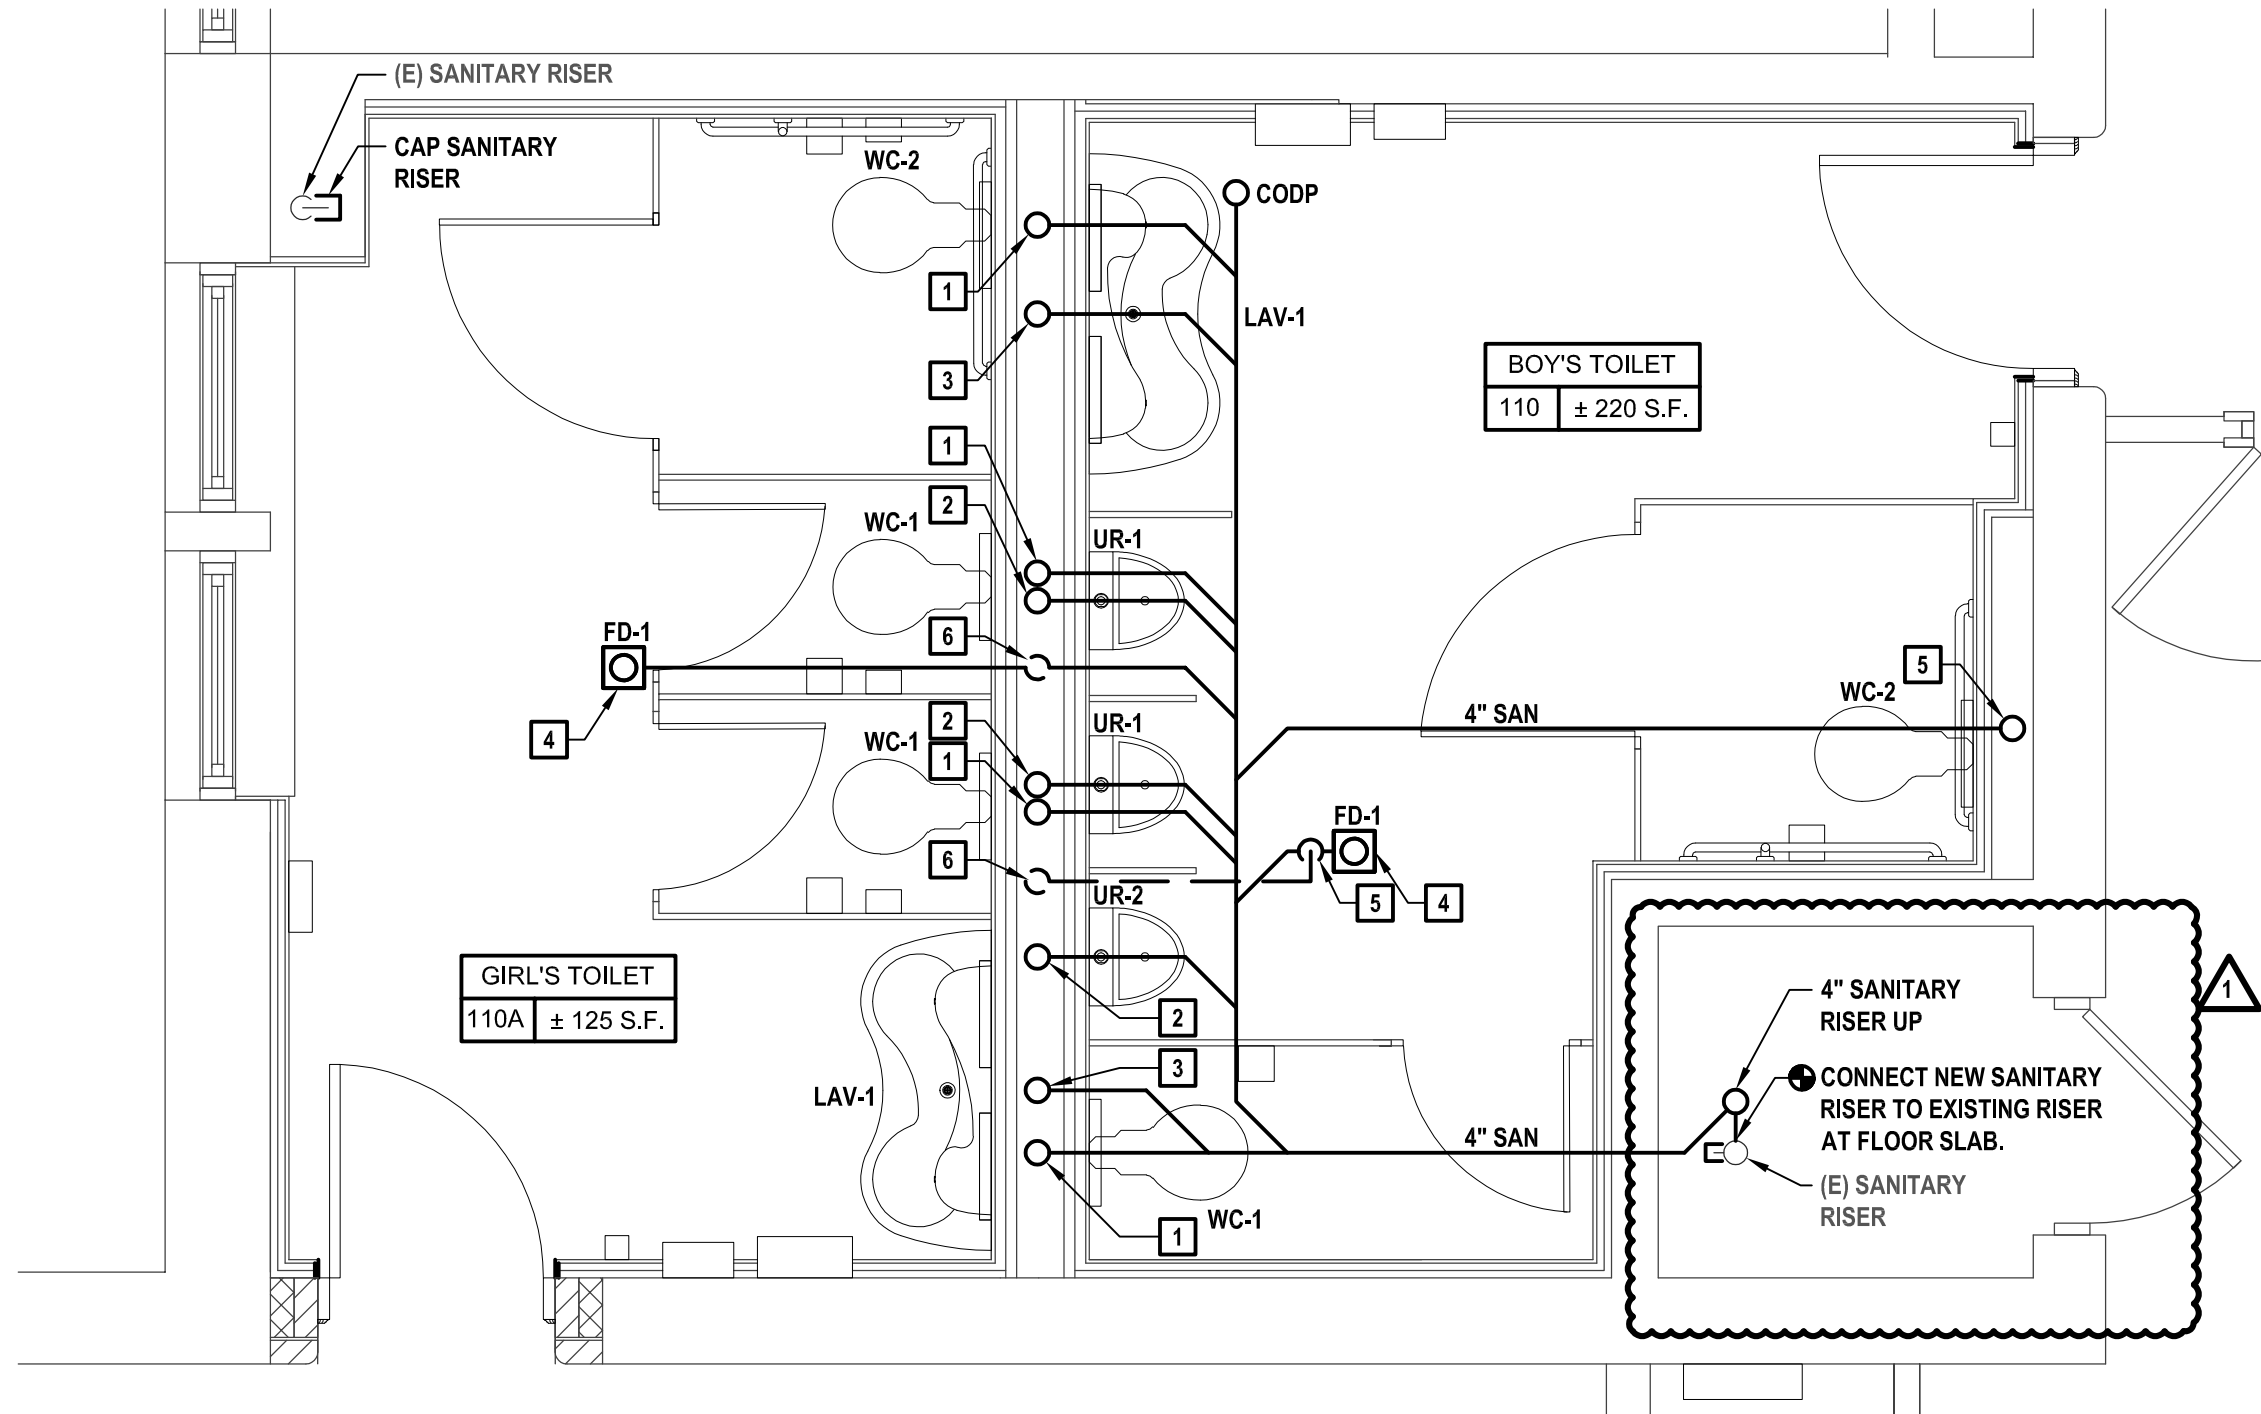

1 Enlarged Sanitary Underslab 110 Boy's Toilet and 110A Girl's Toilet


SCALE: 3/8"=1'-0"

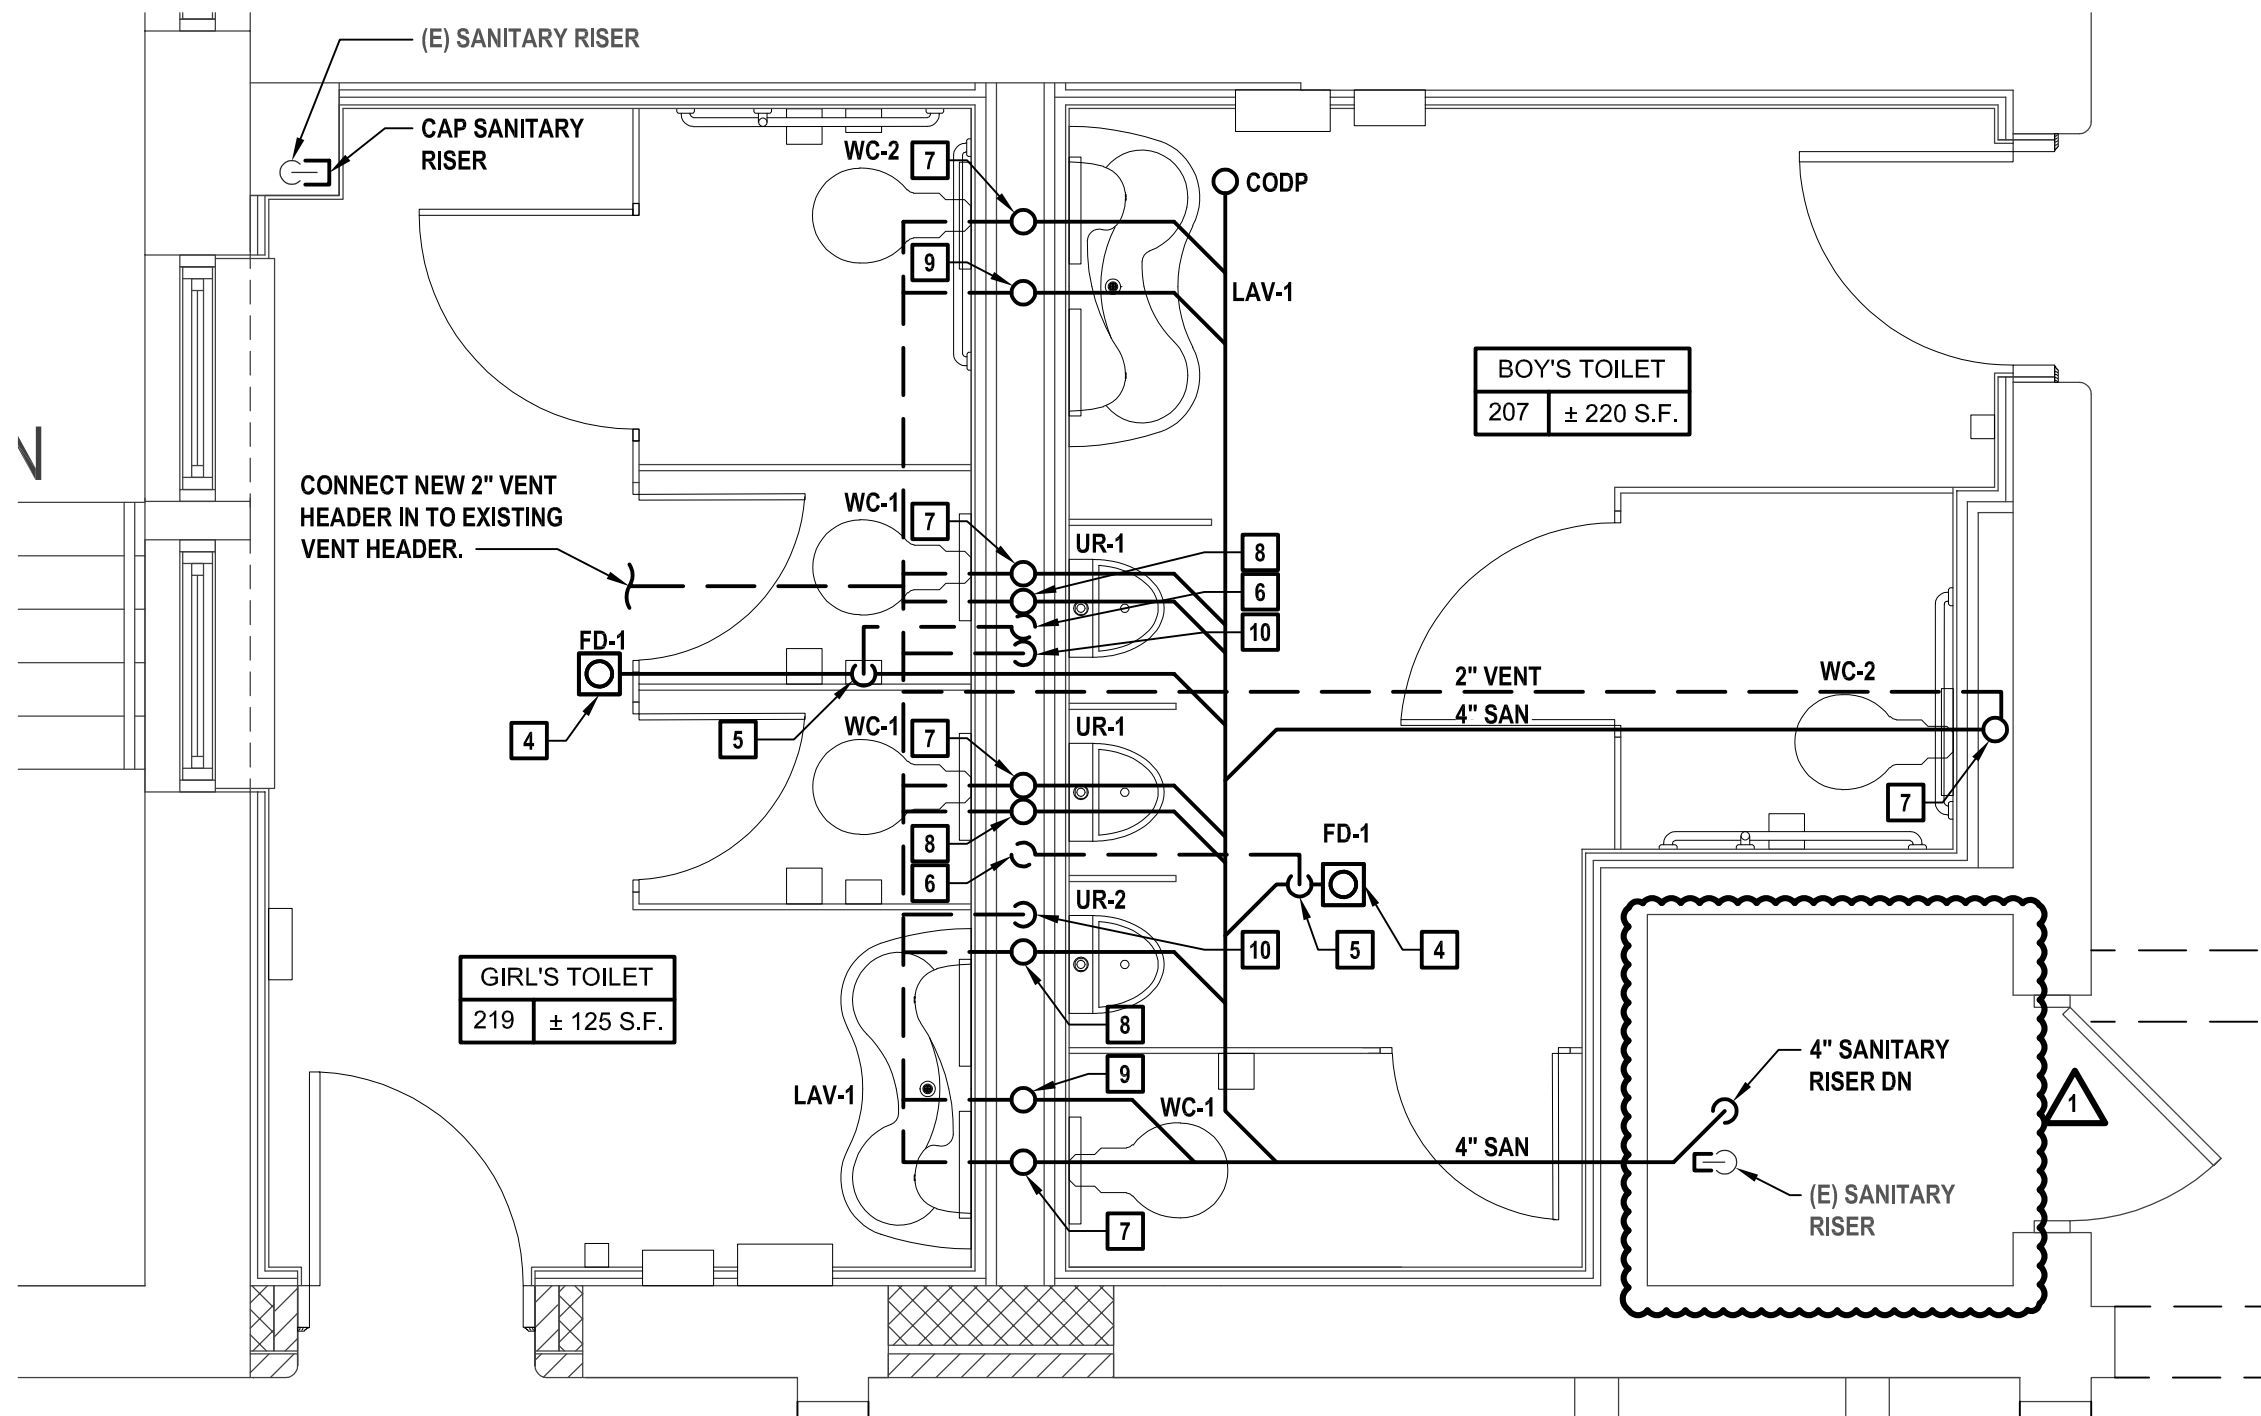

3 Enlarged Sanitary and Vent 207 Boy's Toilet and 219 Girl's Toilet

SCALE: 3/8"=1'-0"


NOTE: SANITARY PIPING ON THIS PLAN IS SERVING FIXTURES ABOVE IN BATHROOMS 308 AND 308A.

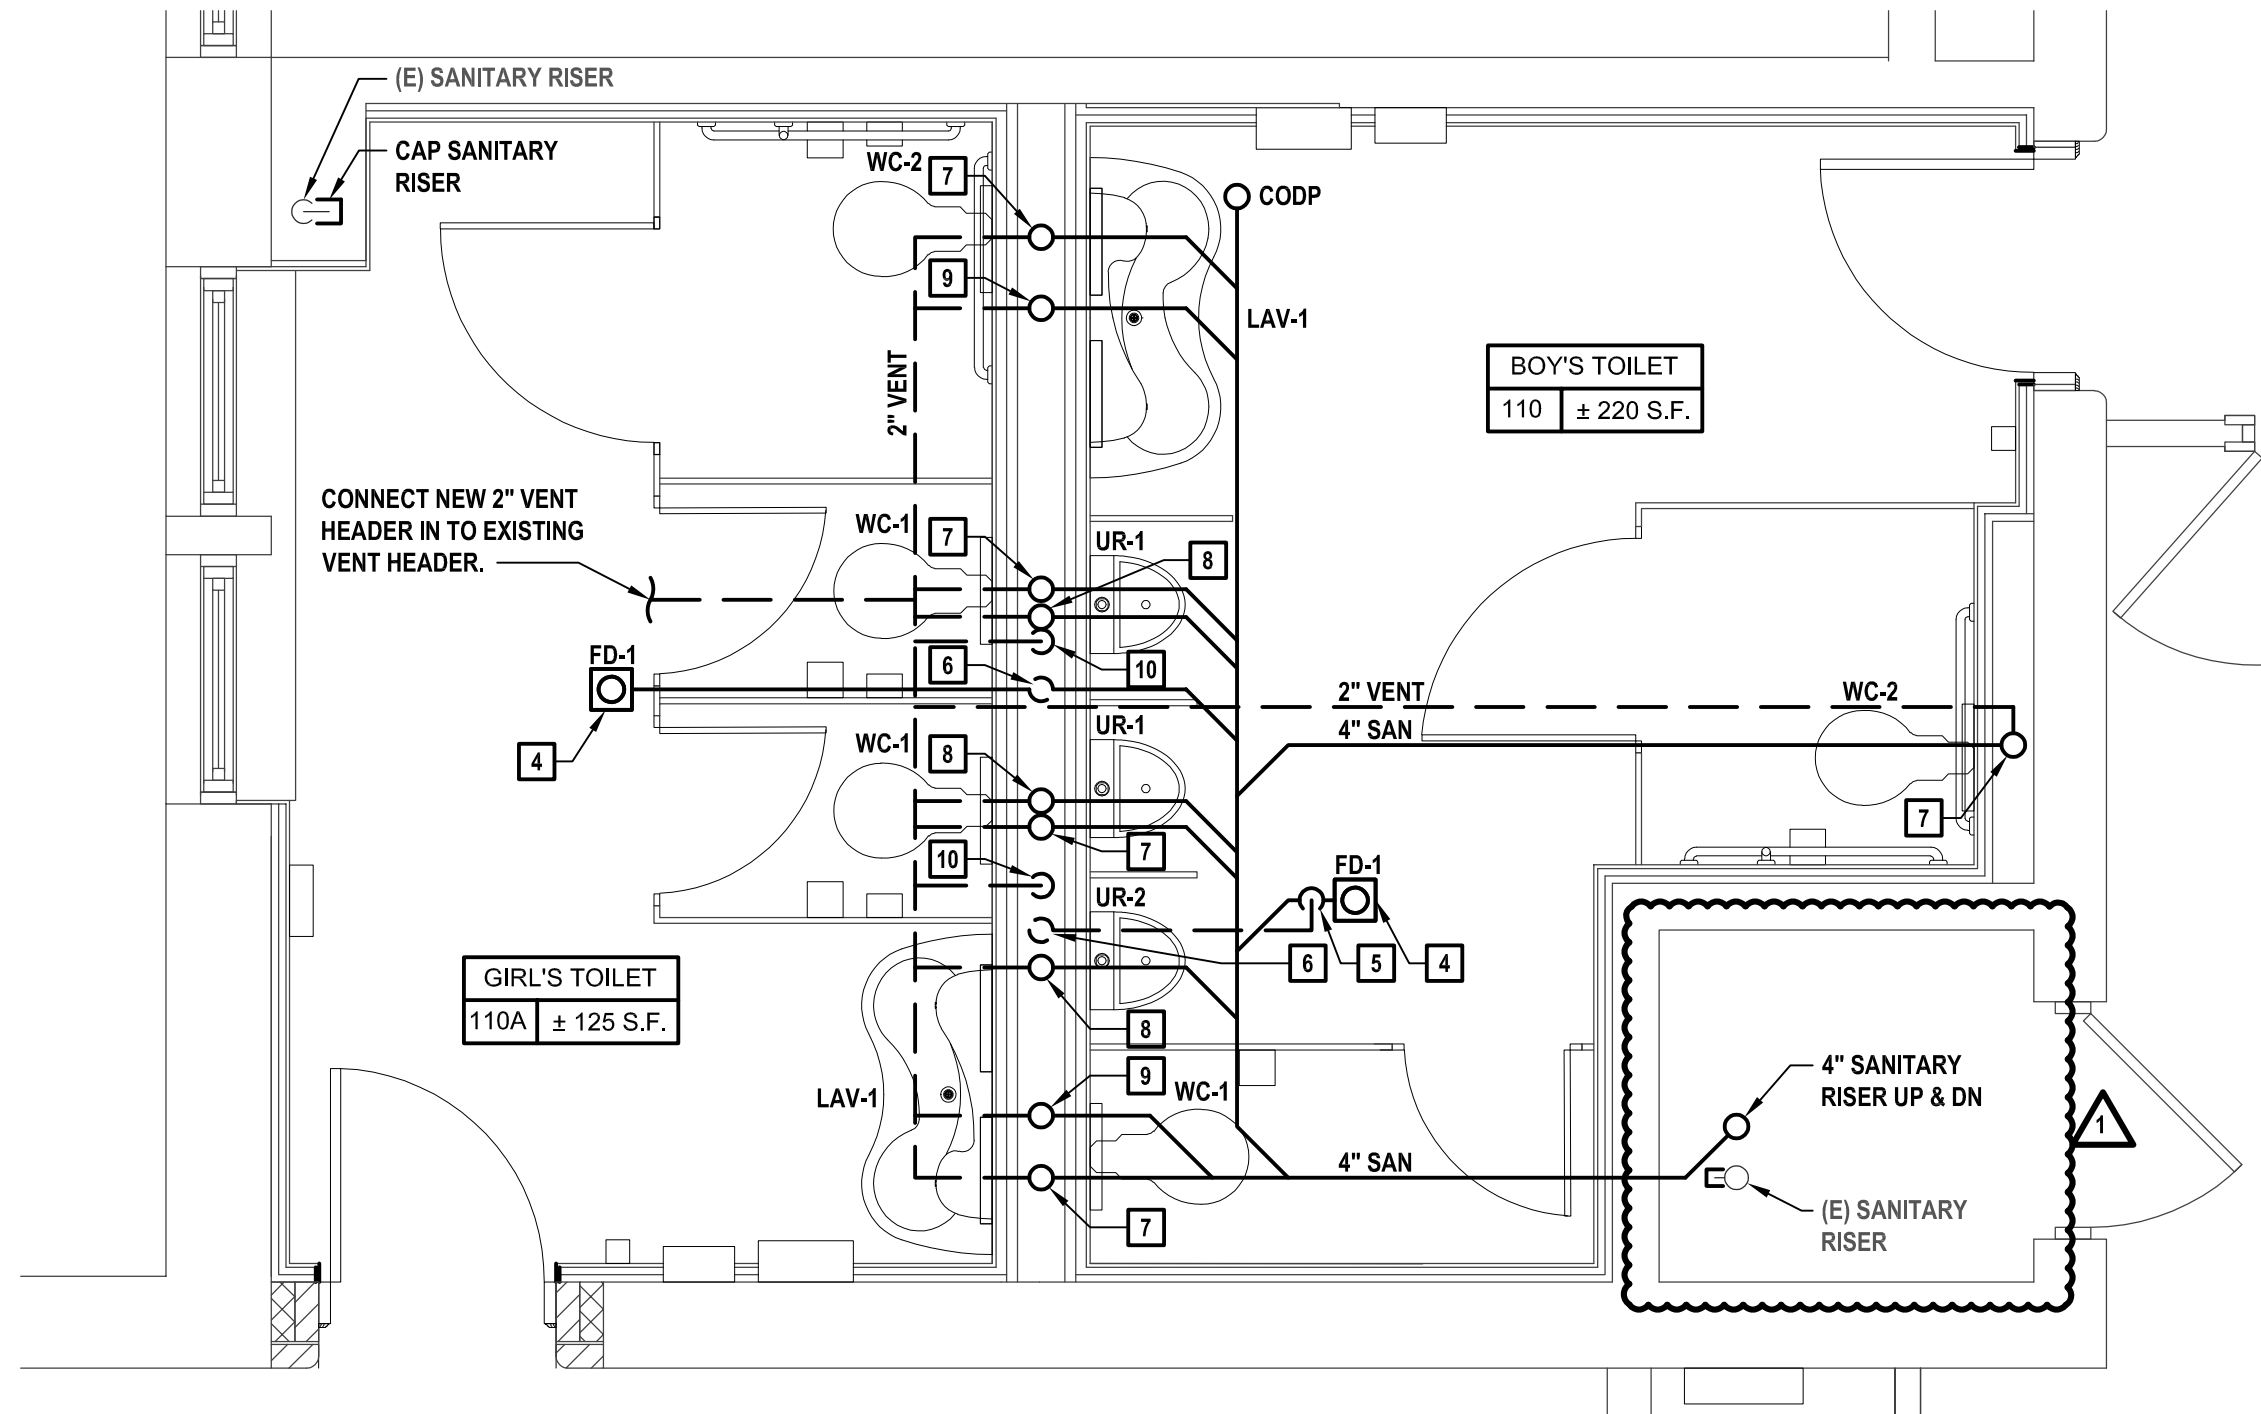

2 Enlarged Sanitary and Vent 110 Boy's Toilet and 110A Girl's Toilet

SCALE: 3/8"=1'-0"

NOTE: SANITARY PIPING ON THIS PLAN IS SERVING FIXTURES ABOVE IN BATHROOMS 207 AND 219.

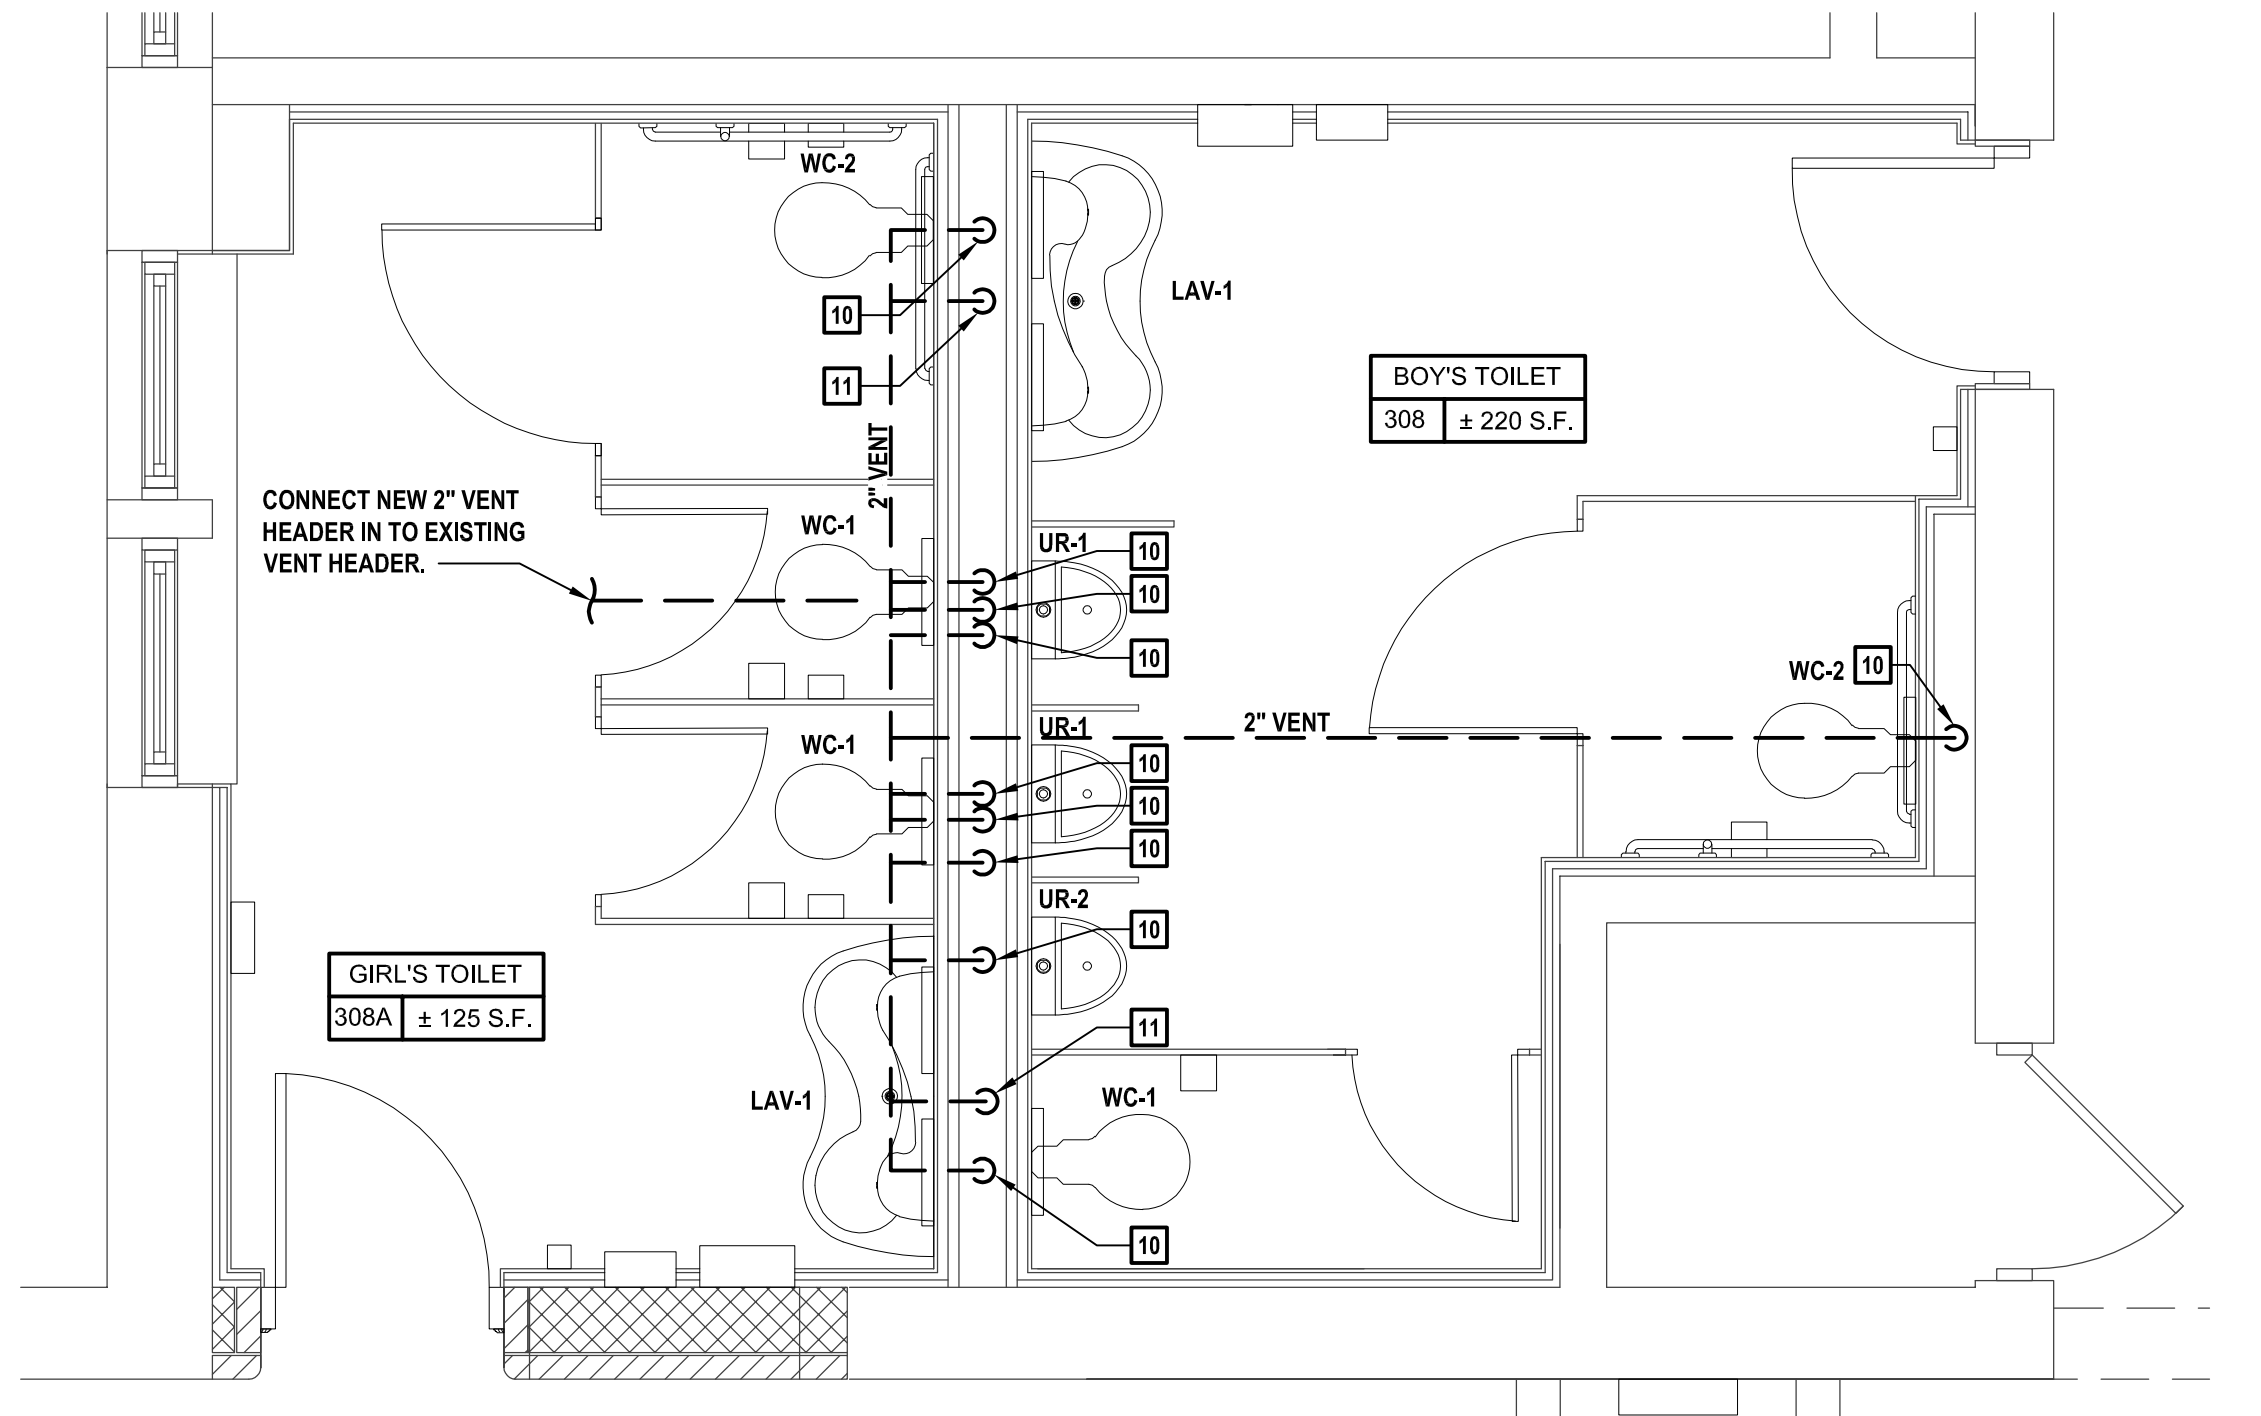


4 Enlarged Sanitary and Vent 308 Boy's Toilet and 308A Girl's Toilet

SCALE: 3/8"=1'-0"

CONSULTANTS:		

MARK	DATE	DESCRIPTION
1	11-22-21	BID ADDENDUM #1
-	11-03-21	FINAL BID SET



ALTERATION OF THIS DOCUMENT EXCEPT BY A LICENSED PROFESSIONAL IS ILLEGAL.

DESIGNED BY: JRM	DRAWN BY: CJM	CHECKED BY:	REVIEWED BY:
PROJECT NO.: WPSPD 2009	DATE: NOVEMBER 2021	SCALE: AS SHOWN	

CLIENT
White Plains City School District

**Renovations at
Rochambeau Alternative
High School**



**228 Fisher Avenue
White Plains, NY 10606**

SED No. 66-22-00-01-0-15-019

CONTRACT
**CONTRACT G
GENERAL CONSTRUCTION**

STATUS
FINAL BID DOCUMENT

SHEET TITLE
**PLUMBING UNDERSLAB,
SANITARY AND VENT
ENLARGEMENT PLANS
FOR ROOMS 123, 124, 222,
221, 318 AND 318A**


DRAWING No.
P203.00

PLUMBING NOTES

1. VERIFY IN FIELD EXACT LOCATIONS OF HOT WATER AND COLD WATER SUPPLY LINES, SANITARY, WASTE & VENT LINES. REROUTE AND MODIFY EXISTING PLUMBING LINES AS REQUIRED FOR CONNECTIONS TO NEW PLUMBING FIXTURES.
2. INSULATE ALL NEW WATER PIPING AND RE-INSULATE ALL EXISTING WATER PIPING WHERE INSULATION IS DAMAGED.
3. ALL 3" & 4" SANITARY PIPING TO BE SLOPED A MINIMUM OF 1/8"/FT. ALL 1-1/2" & 2" SANITARY PIPING TO BE SLOPED A MINIMUM OF 1/4"/FT.
4. CHASE WALL WILL NEED TO BE OPENED TO ALLOW ACCESS TO EXISTING PIPING AND THEN REPAIRED. REFER TO ARCHITECTURAL DRAWINGS FOR MORE DETAIL.
5. INSTALL NEW SHUT OFF VALVES OR REPLACE EXISTING VALVES ON ALL COLD WATER AND HOT WATER BRANCH PIPING ENTERING TOILETS.
6. FURNISH AND INSTALL NEW CLEANOUT DECK PLATE, ZURN MODEL Z1400 OR APPROVED EQUAL AS REQUIRED IN EACH BATHROOM.
7. CONTRACTOR IS RESPONSIBLE TO INSTALL ALL NEW DOMESTIC AND SANITARY PIPING IN BATHROOM AND CONNECT TO EXISTING PIPING IN CORRIDORS/CHASE.


KEYED PLUMBING NOTES

1. 4" SAN UP TO WATER CLOSET.
2. 2" SAN UP TO URINAL.
3. 2" SAN UP TO LAVATORY.
4. 2" SAN UP TO FLOOR DRAIN.
5. 2" VENT DROP.
6. 2" VENT UP.
7. 2" VENT DOWN. 4" SAN UP TO WATER CLOSET ON FLOOR ABOVE.
8. 2" VENT DOWN. 2" SAN UP TO URINAL ON FLOOR ABOVE.
9. 1-1/2" VENT DOWN. 2" SAN UP TO LAVATORY ON FLOOR ABOVE.
10. 2 VENT DOWN.
11. 1-1/2" VENT DOWN.

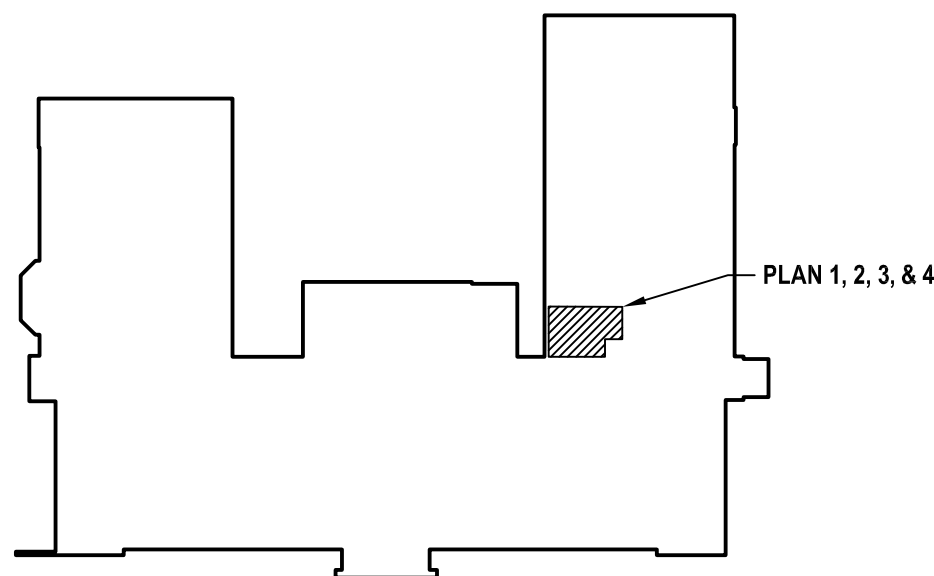


5 Key Plan

SCALE: NTS

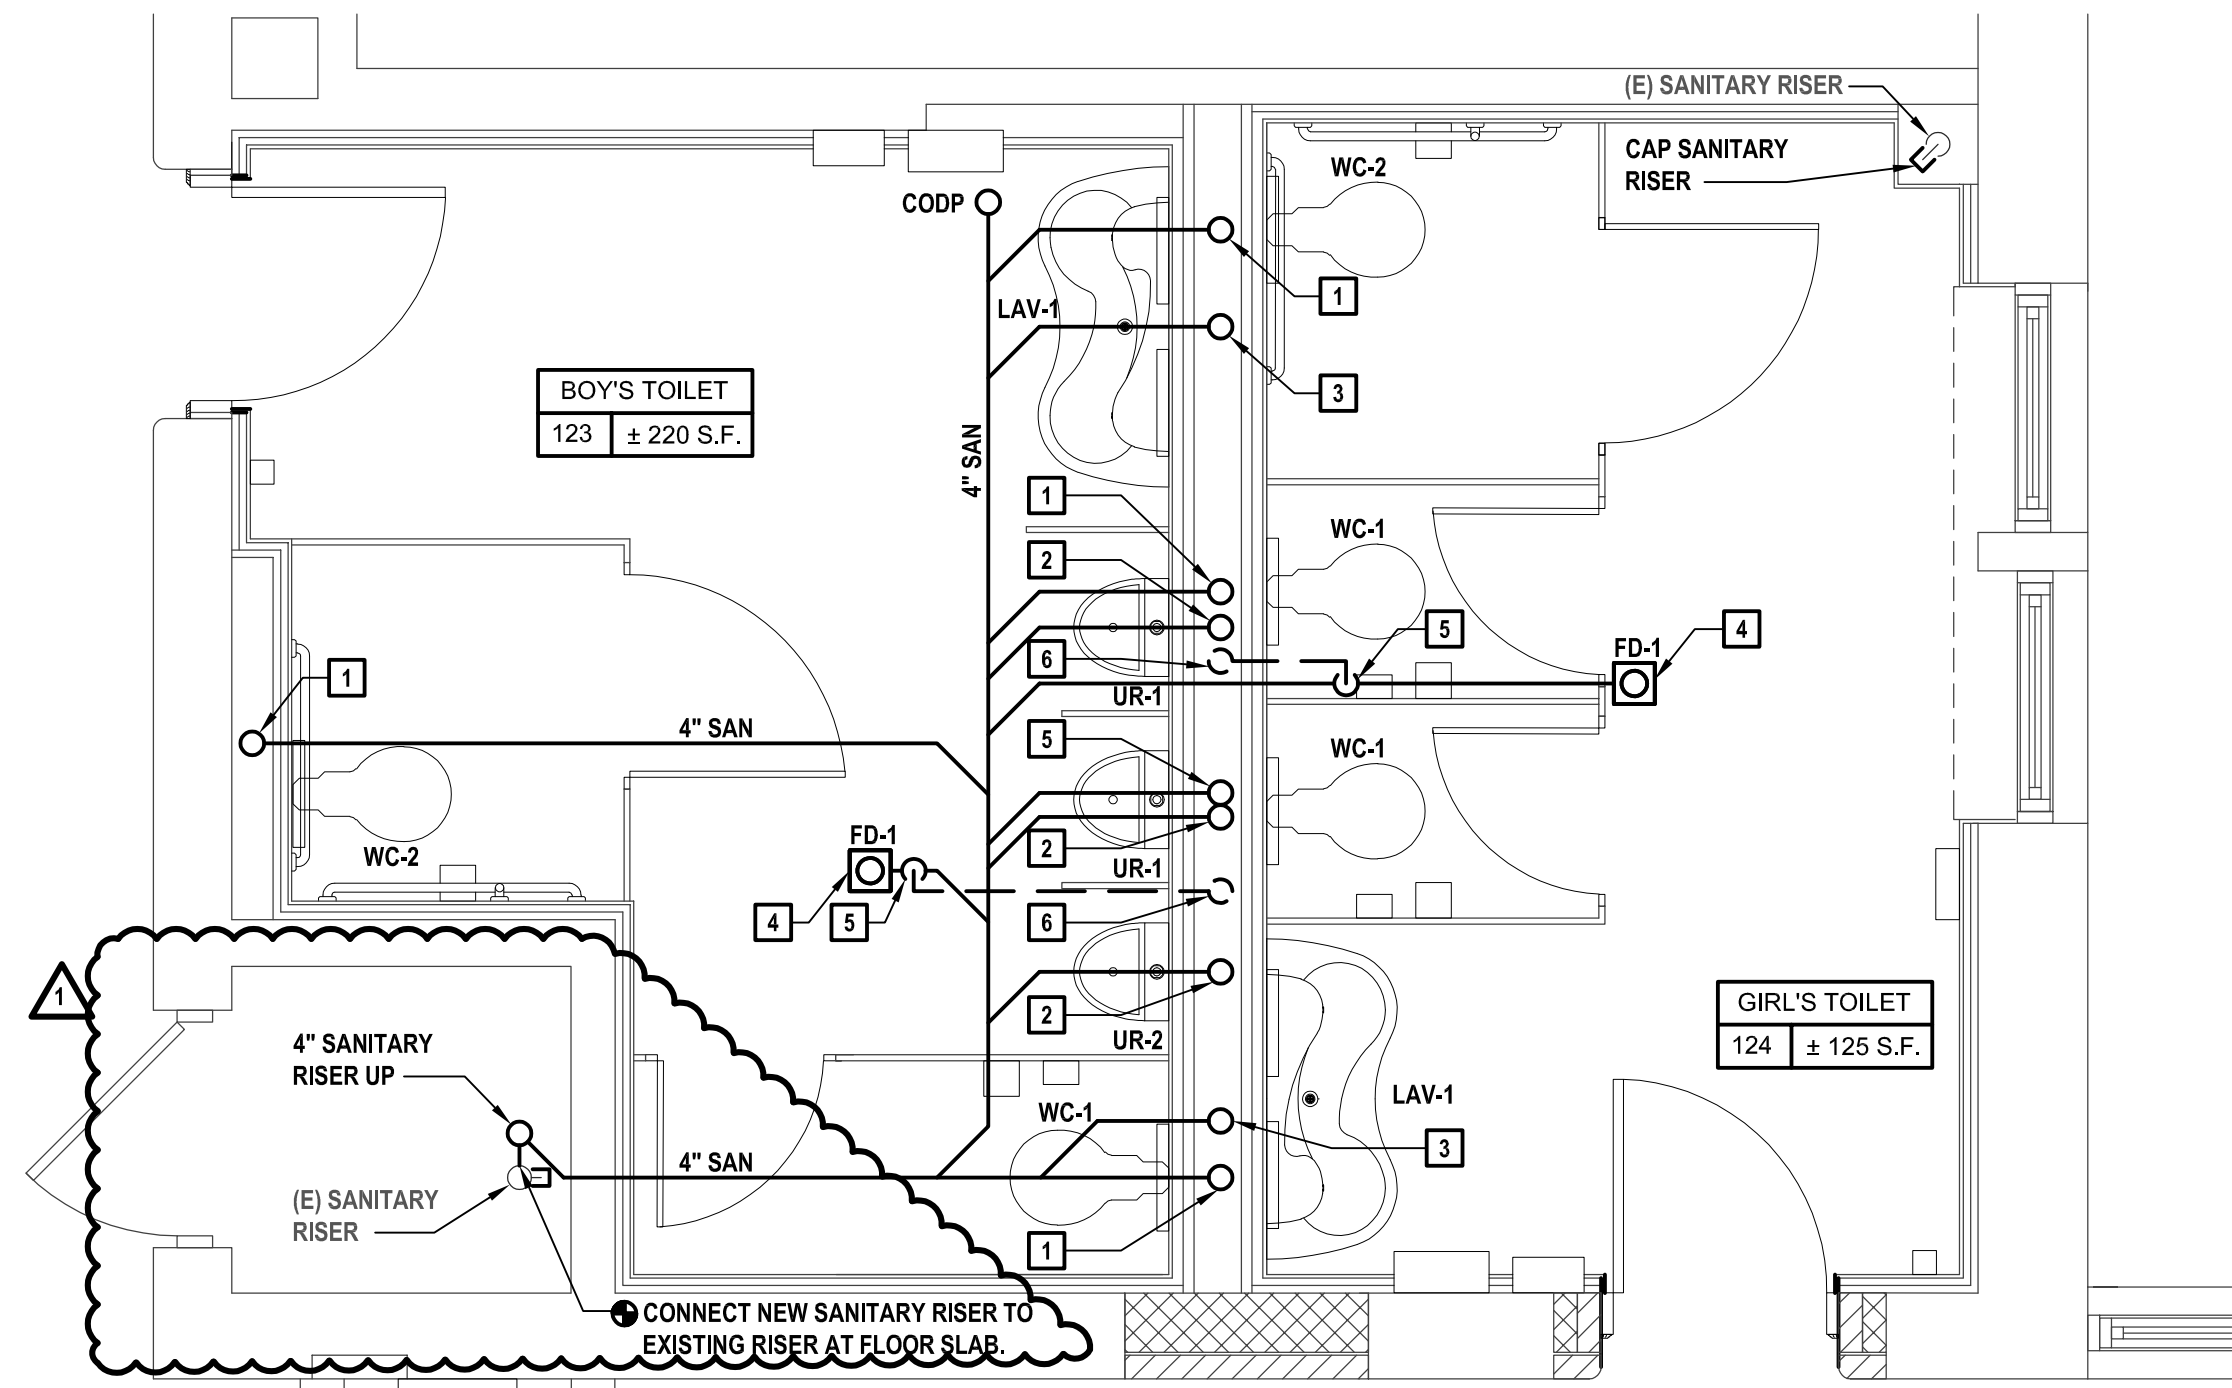

1 Enlarged Sanitary Underslab 123 Boy's Toilet and 124 Girl's Toilet


SCALE: 3/8"=1'-0"

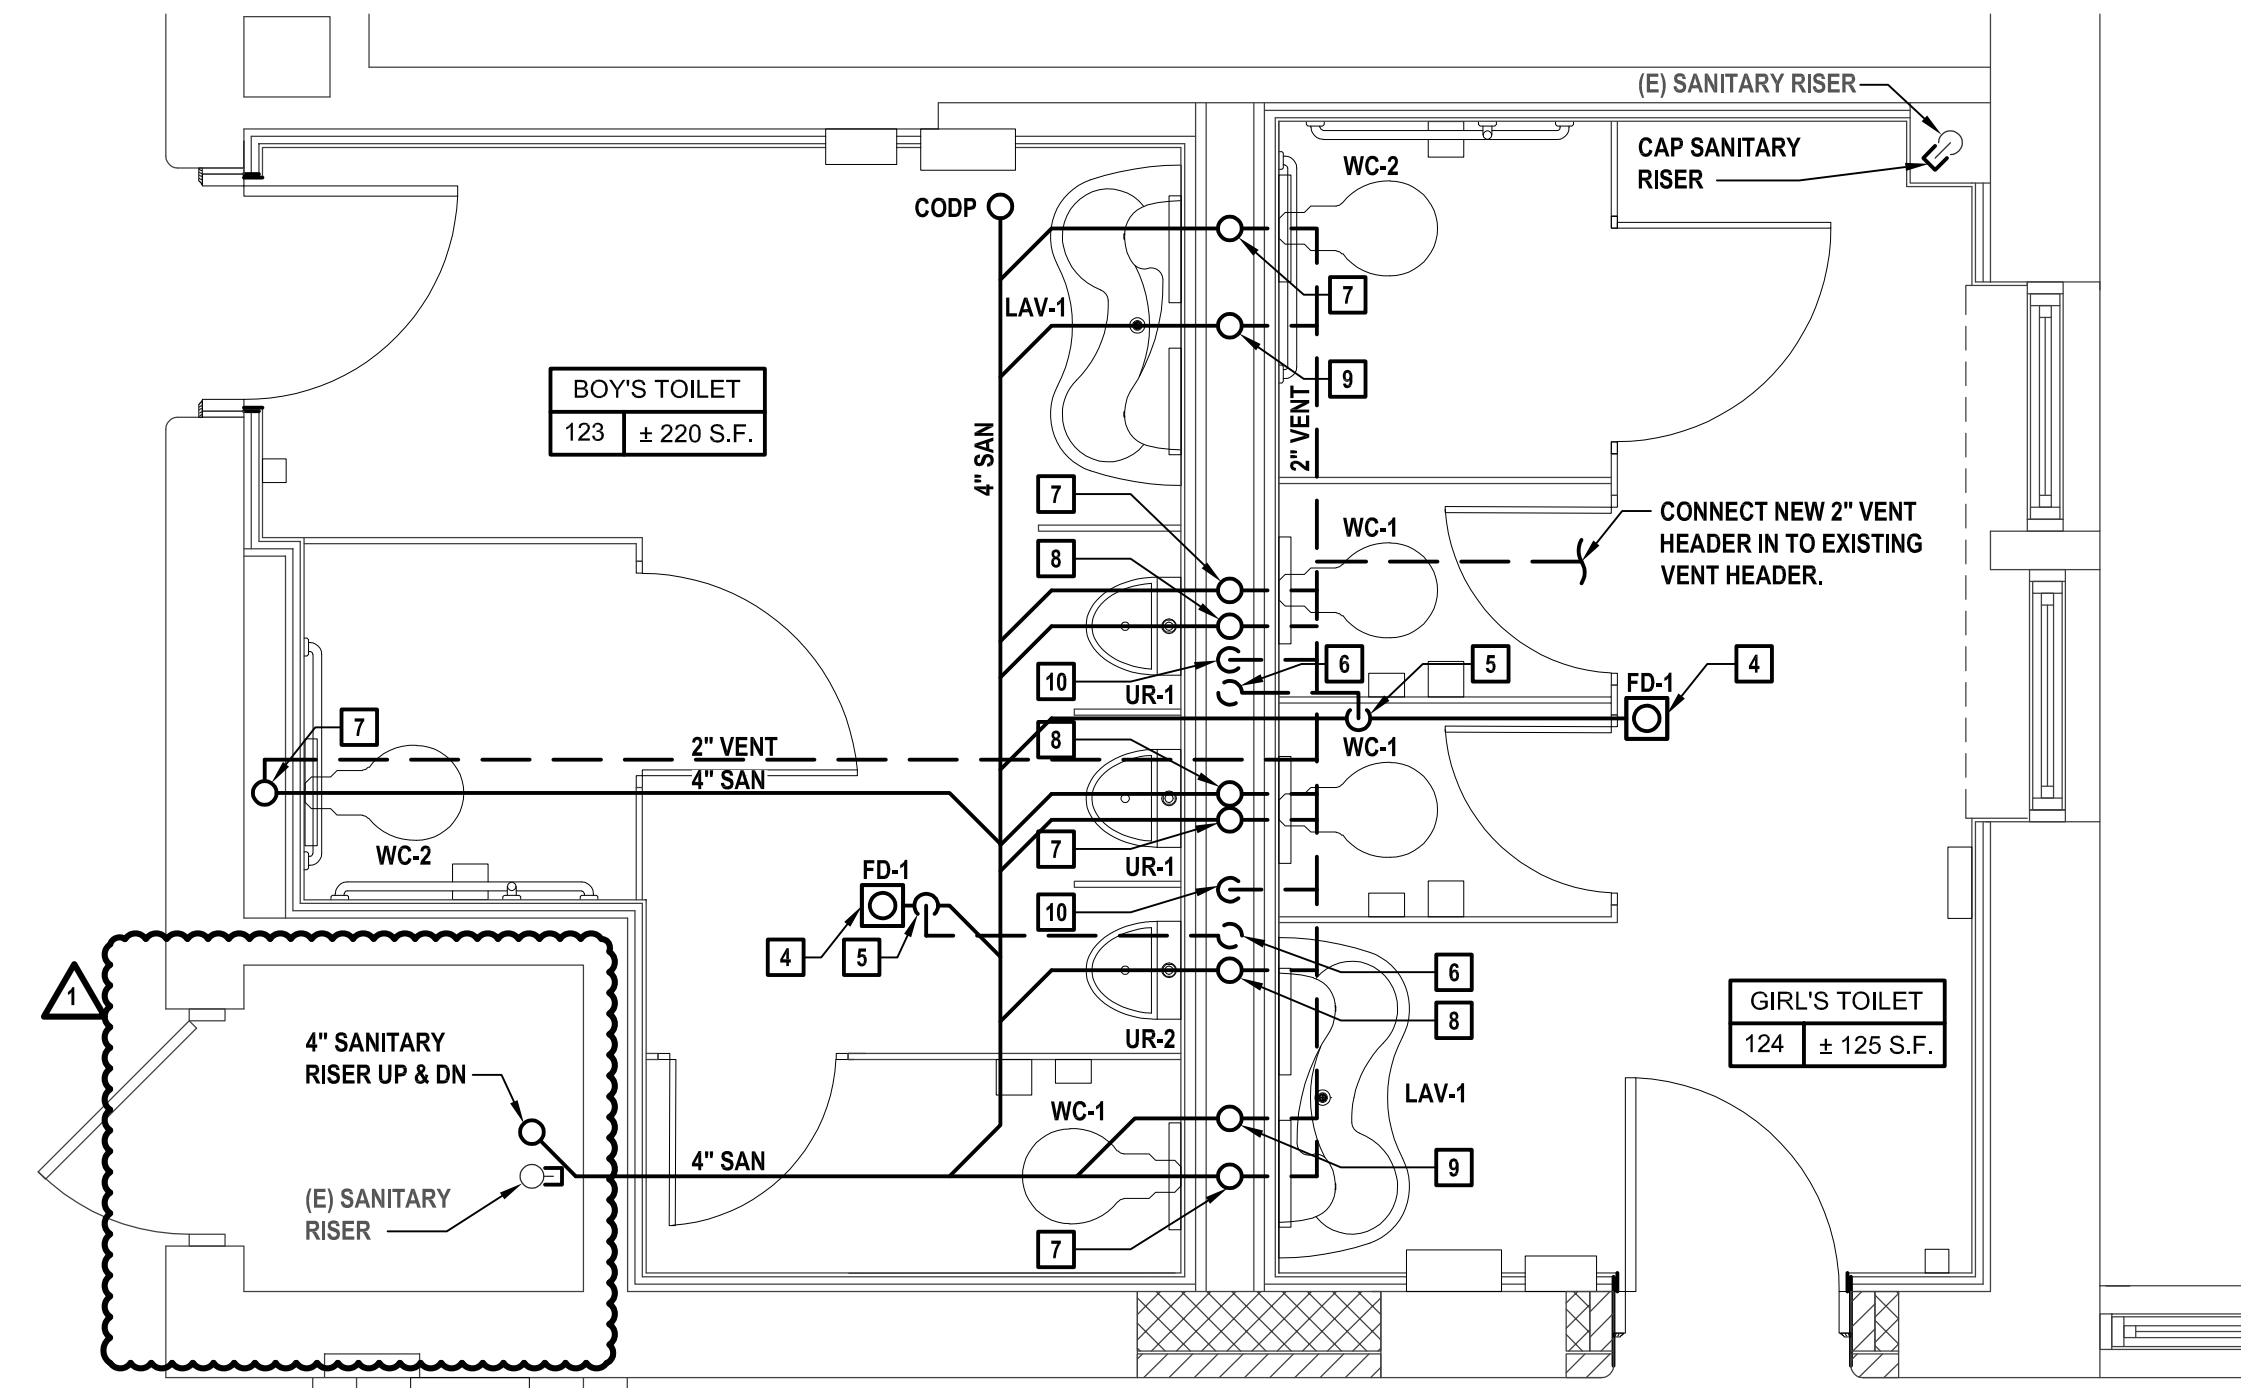

2 Enlarged Sanitary and Vent 123 Boy's Toilet and 124 Girl's Toilet

SCALE: 3/8"=1'-0"


NOTE: SANITARY PIPING ON THIS PLAN IS SERVING FIXTURES ABOVE IN BATHROOMS 222 AND 221.

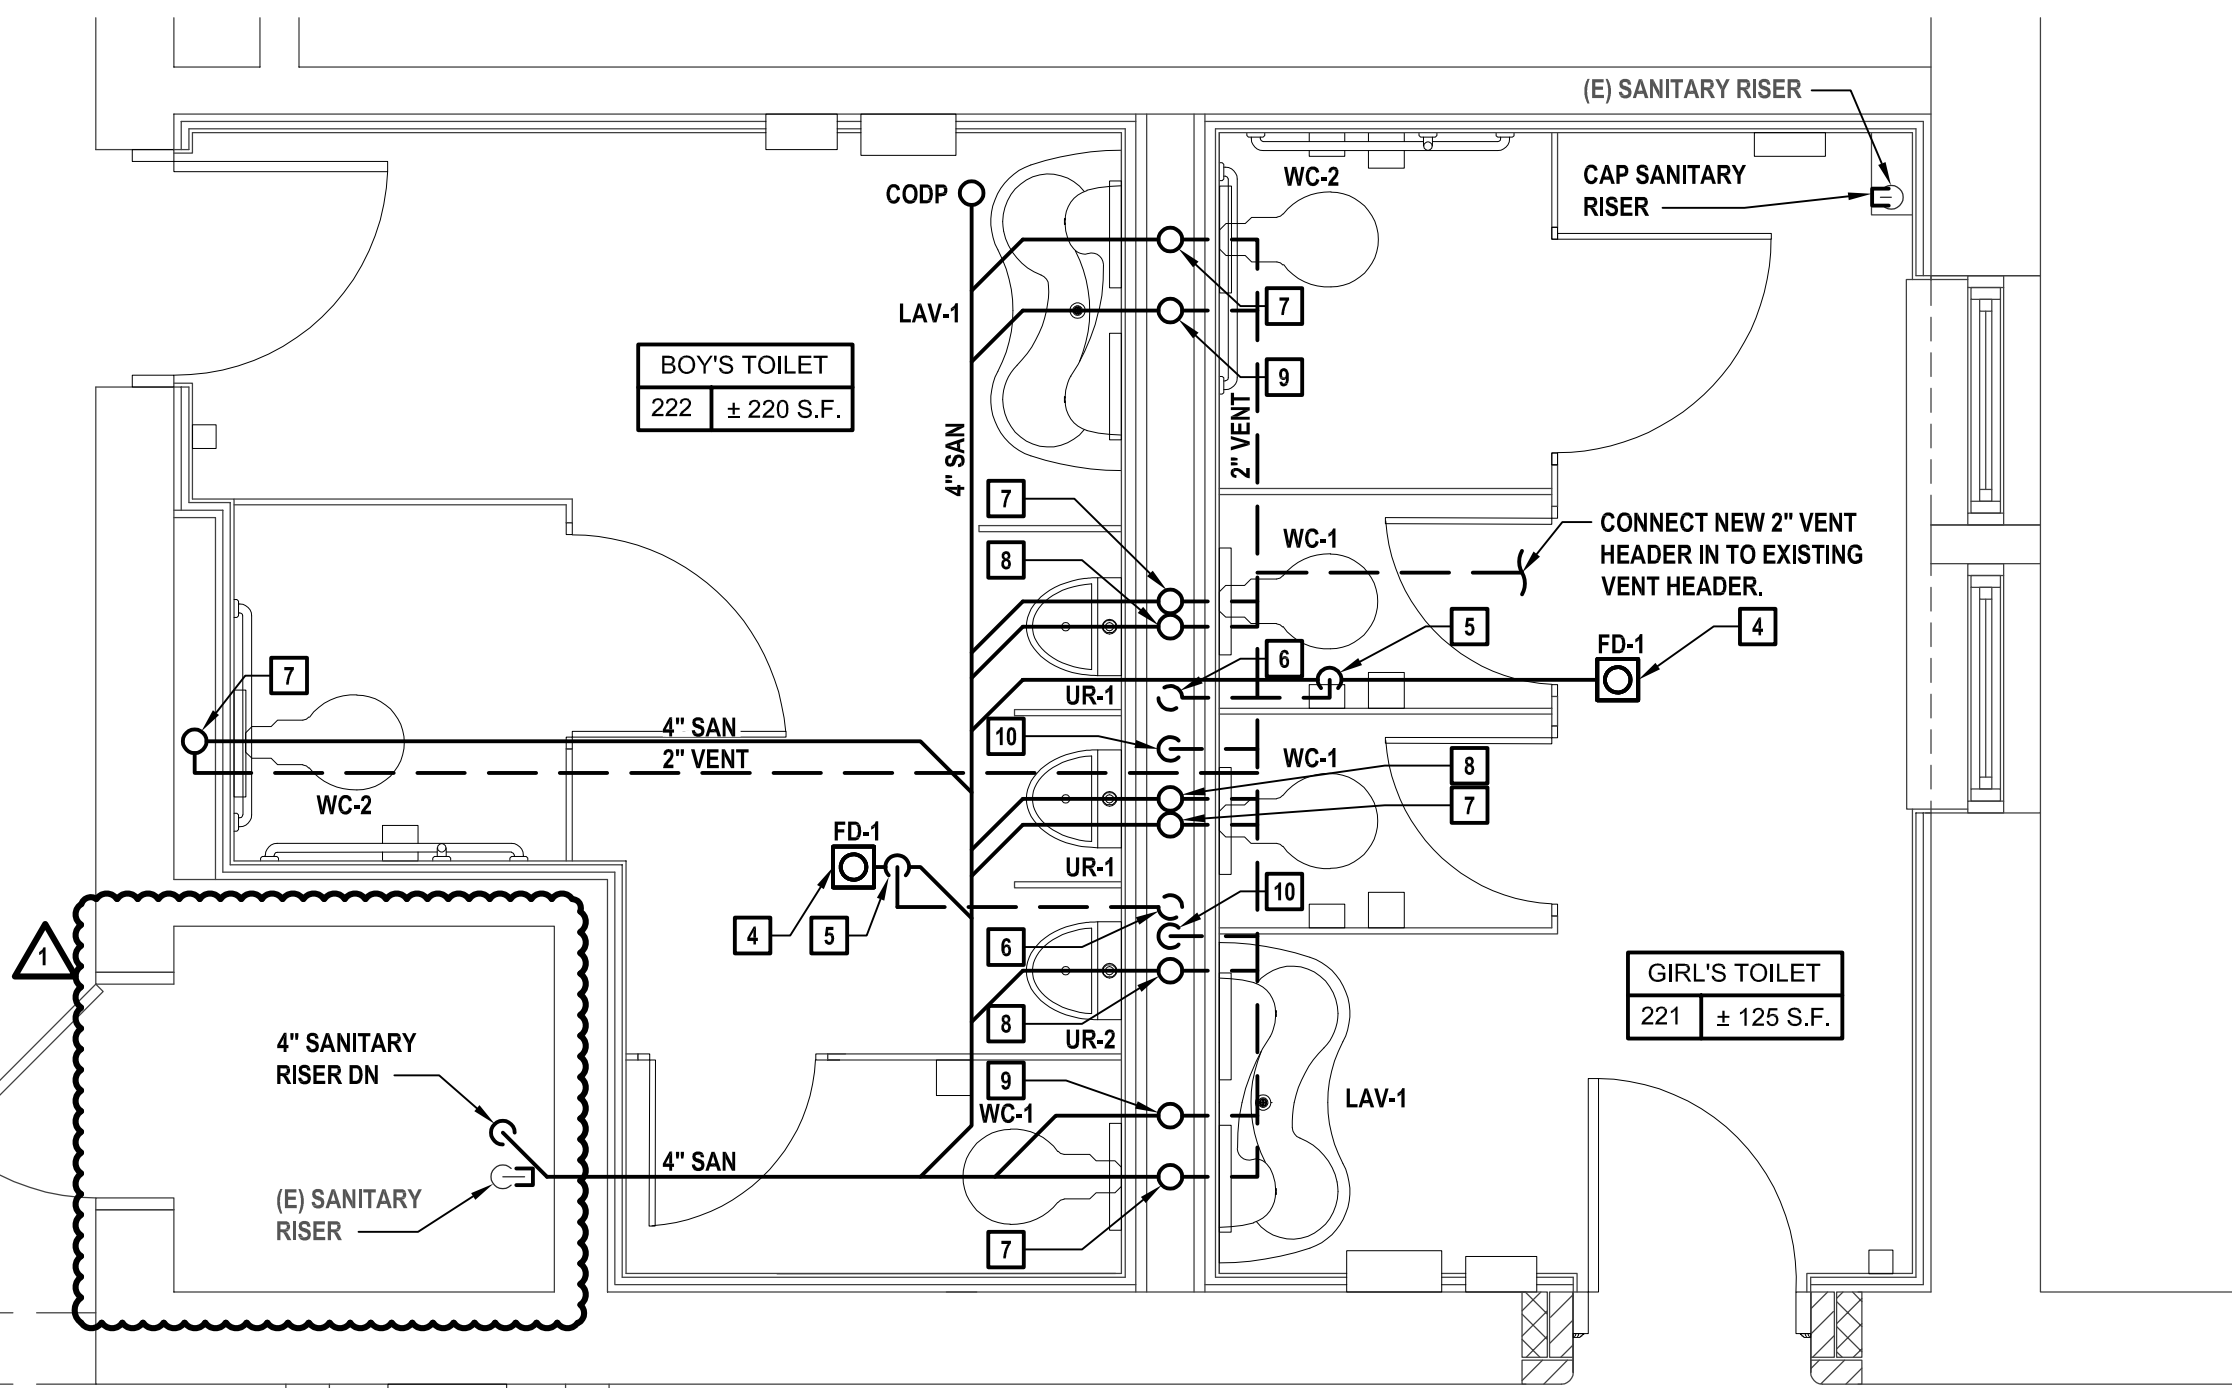

3 Enlarged Proposed 222 Boy's Toilet and 221 Girl's Toilet Sanitary and Vent Plan

SCALE: 3/8"=1'-0"


NOTE: SANITARY PIPING ON THIS PLAN IS SERVING FIXTURES ABOVE IN BATHROOMS 318 AND 318A.

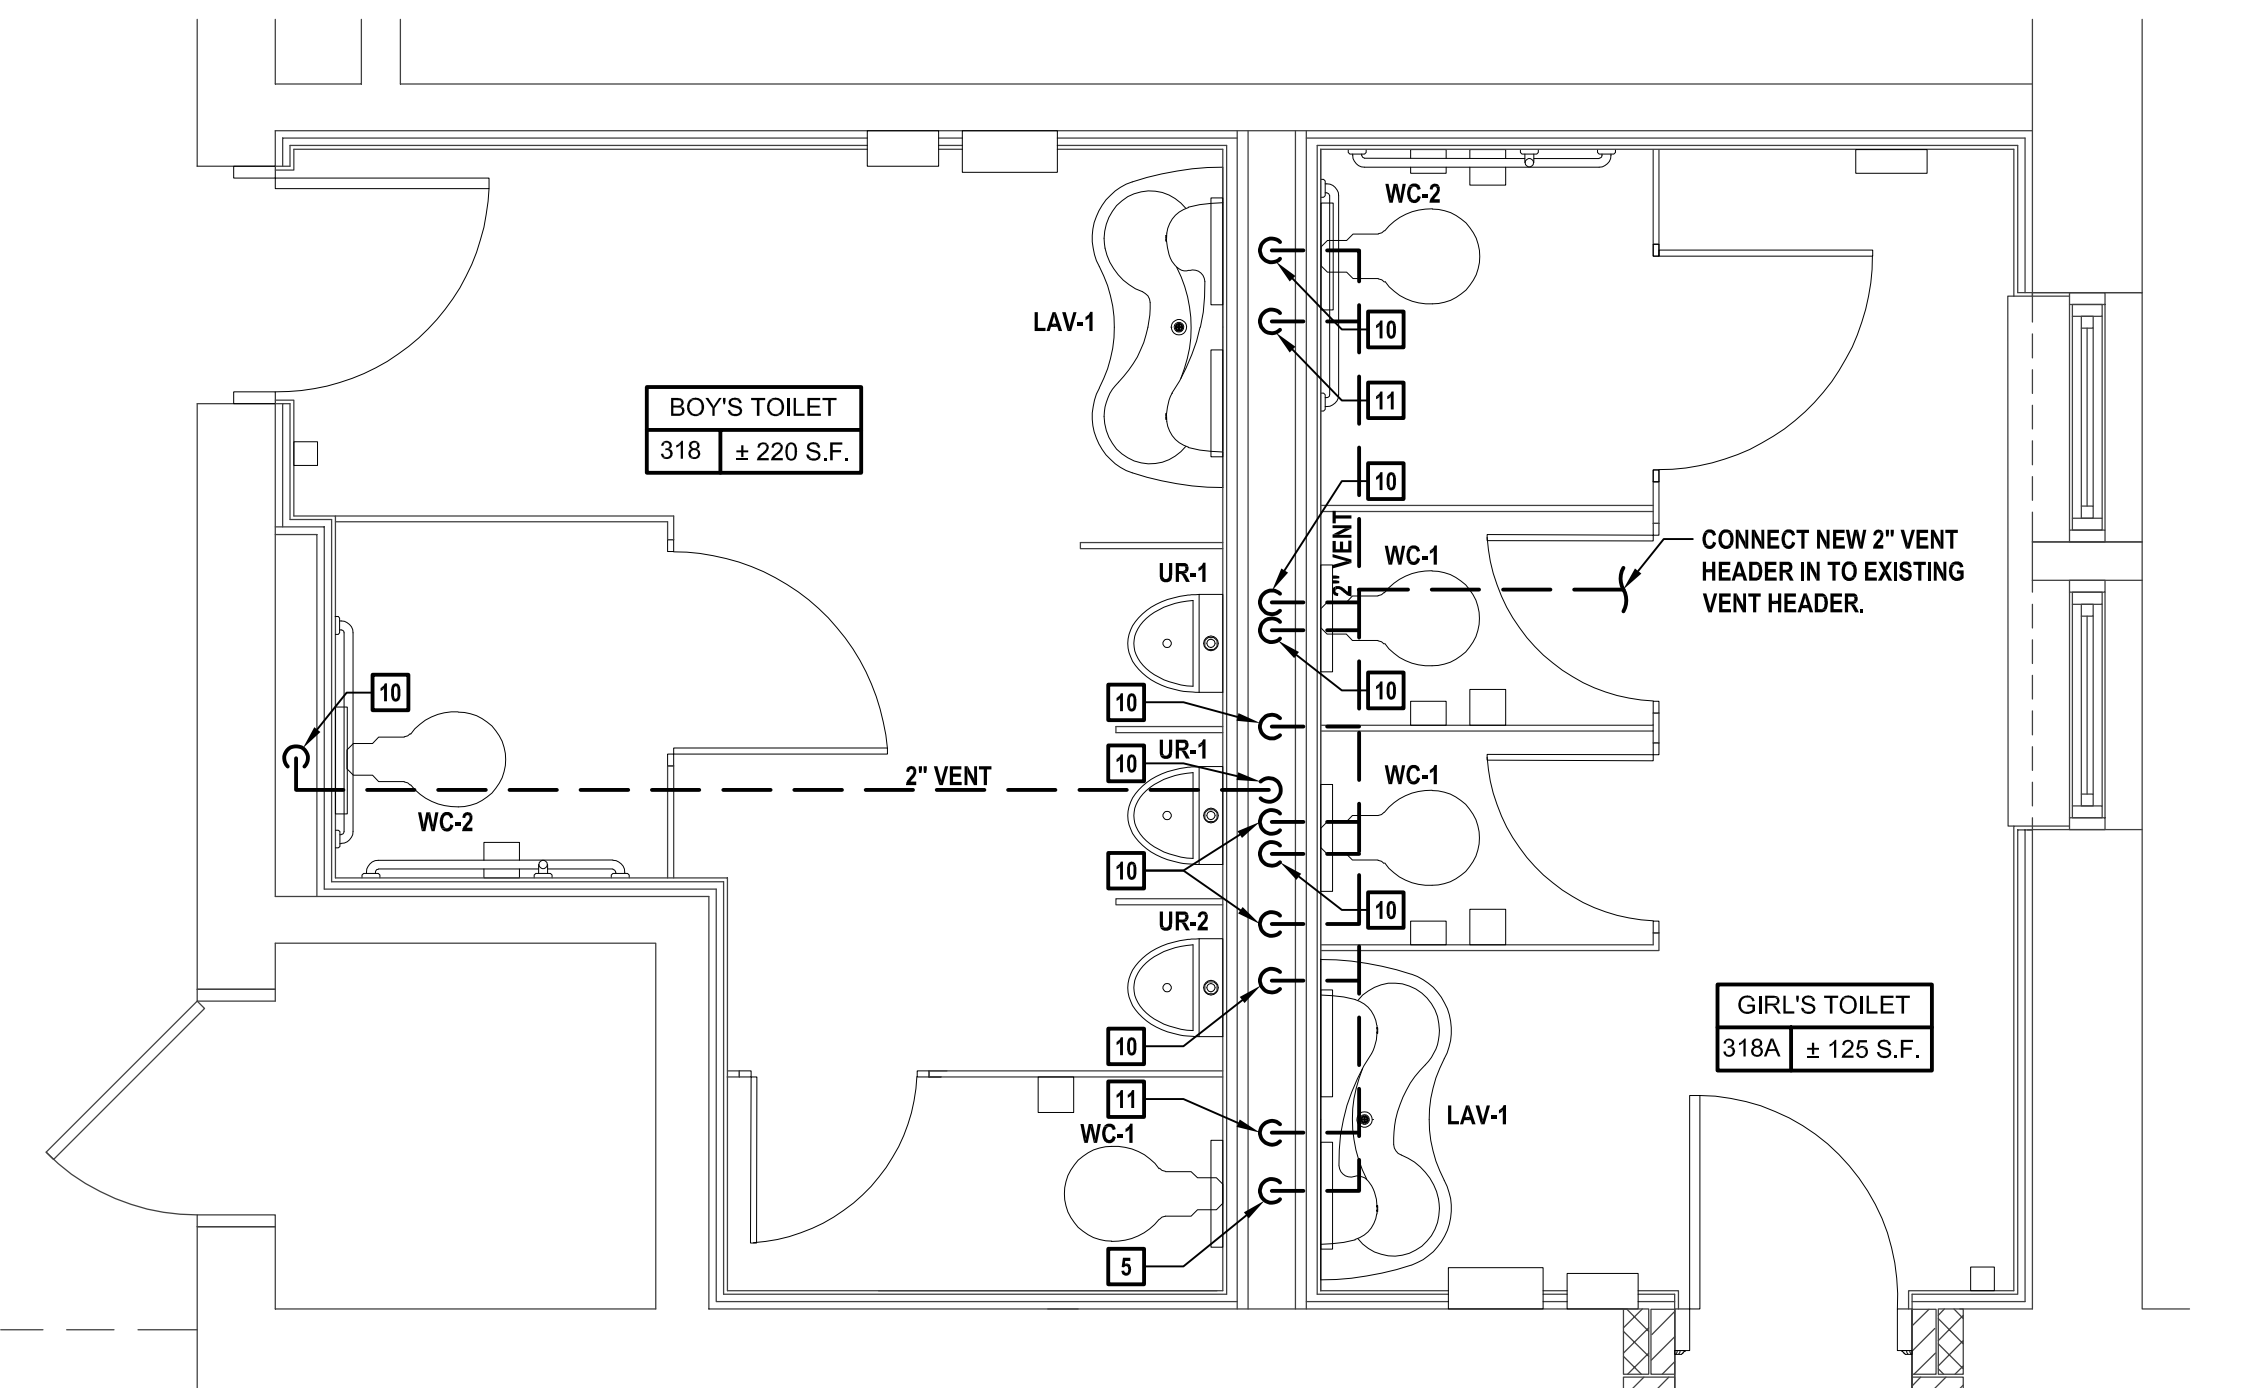

4 Enlarged Proposed 318 Boy's Toilet and 318A Girl's Toilet Sanitary and Vent Plan

SCALE: 3/8"=1'-0"

MARK	DATE	DESCRIPTION
1	11-22-21	BID ADDENDUM #1
-	11-03-21	FINAL BID SET

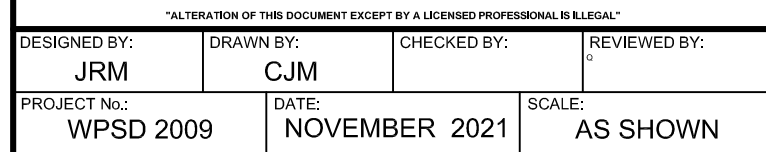

DRAWING No. **P204.00**

4 Key Plan

CONSULTANTS:

MARK	DATE	DESCRIPTION
1	11-22-21	BID ADDENDUM #1
-	11-03-21	FINAL BID SET



DESIGNED BY: JRM	DRAWN BY: CJM	CHECKED BY:	REVIEWED BY:
PROJECT NO.: WPSP 2009	DATE: NOVEMBER 2021	SCALE: AS SHOWN	

CLIENT
White Plains City School District

Renovations at
Rochambeau Alternative
High School



228 Fisher Avenue
White Plains, NY 10606

SED No. 66-22-00-01-0-15-019

CONTRACT
**CONTRACT G
GENERAL CONSTRUCTION**

STATUS
FINAL BID DOCUMENT

SHEET TITLE
**PLUMBING DOMESTIC
ENLARGEMENT PLANS
FOR ROOMS 123, 124, 222,
221, 318 AND 318A**


DRAWING No.
P205.00

PLUMBING NOTES


1. VERIFY IN FIELD EXACT LOCATIONS OF HOT WATER AND COLD WATER SUPPLY LINES, SANITARY, WASTE & VENT LINES. REROUTE AND MODIFY EXISTING PLUMBING LINES AS REQUIRED FOR CONNECTIONS TO NEW PLUMBING FIXTURES.
2. INSULATE ALL NEW WATER PIPING AND RE-INSULATE ALL EXISTING WATER PIPING WHERE INSULATION IS DAMAGED.
3. ALL 3" & 4" SANITARY PIPING TO BE SLOPED A MINIMUM OF 1/8"/FT. ALL 1-1/2" & 2" SANITARY PIPING TO BE SLOPED A MINIMUM OF 1/4"/FT.
4. CHASE WALL WILL NEED TO BE OPENED TO ALLOW ACCESS TO EXISTING PIPING AND THEN REPAIRED. REFER TO ARCHITECTURAL DRAWINGS FOR MORE DETAIL.
5. INSTALL NEW SHUT OFF VALVES OR REPLACE EXISTING VALVES ON ALL COLD WATER AND HOT WATER BRANCH PIPING ENTERING TOILETS.
6. FURNISH AND INSTALL NEW CLEANOUT DECK PLATE, ZURN MODEL Z1400 OR APPROVED EQUAL AS REQUIRED IN EACH BATHROOM.
7. CONTRACTOR IS RESPONSIBLE TO INSTALL ALL NEW DOMESTIC AND SANITARY PIPING IN BATHROOM AND CONNECT TO EXISTING PIPING IN CORRIDORS/CHASE.

KEYED PLUMBING NOTES


1. 1" CW DN TO WATER CLOSET.
2. 3/4" CW DN TO URINAL.
3. 1/2" CW AND HW DN TO LAV-1.
4. 3/4" CW DN TO HOSE BIBB.
5. CONNECT NEW CW AND HW TO CLOSEST EXISTING CW AND HW MAIN IN CLOSET.

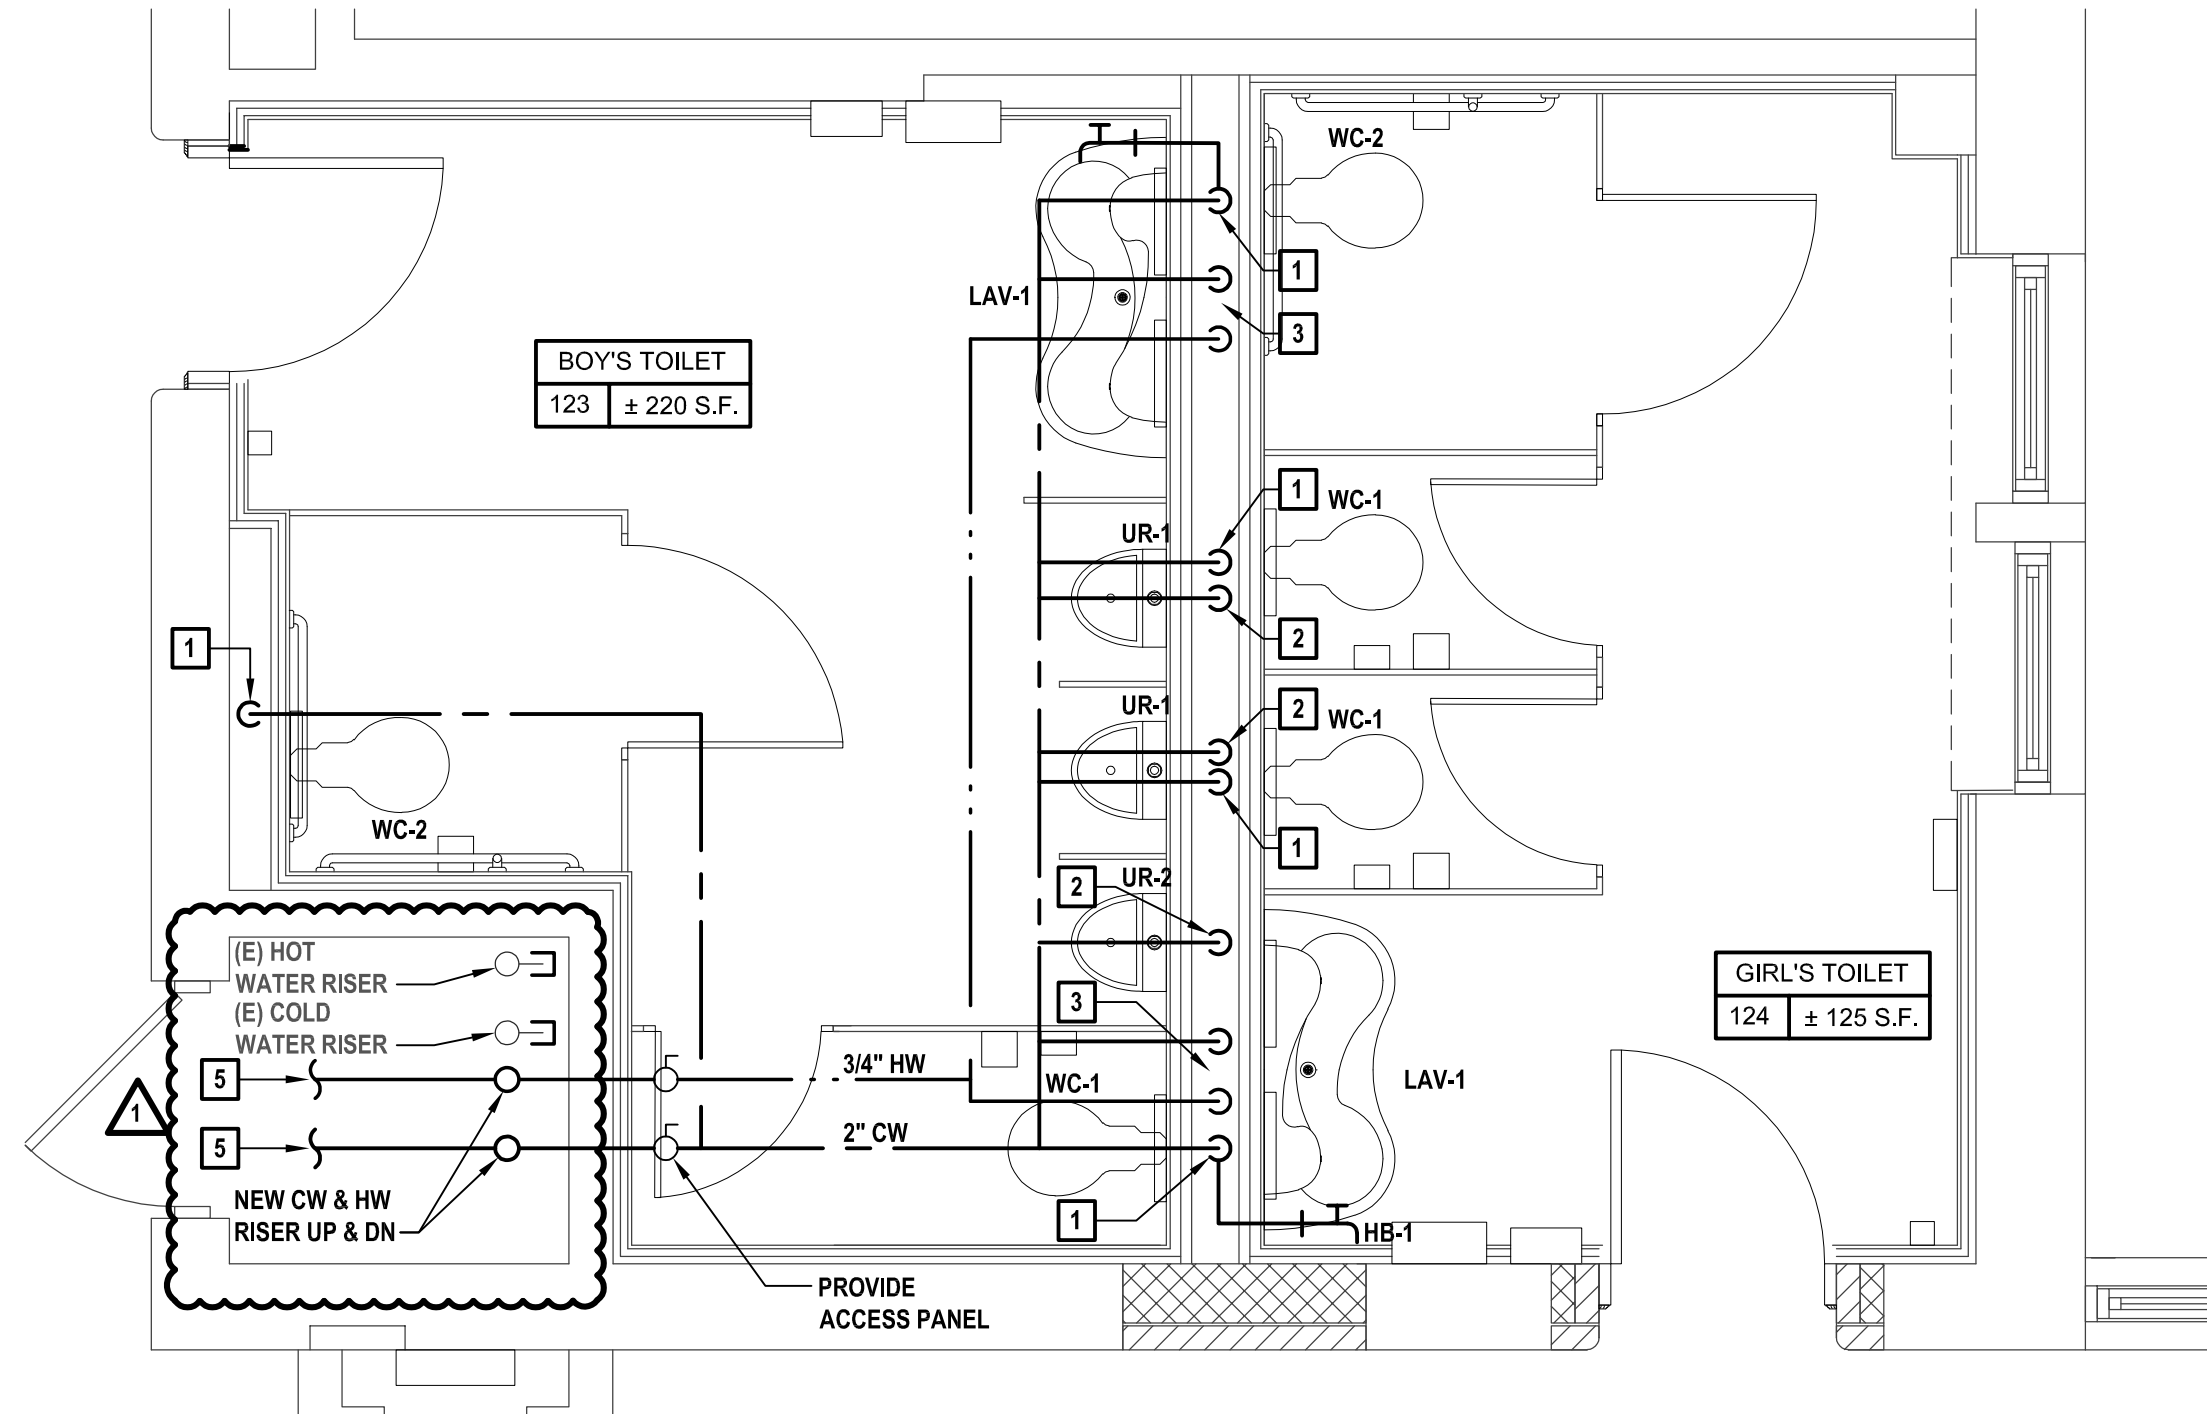


1 Enlarged Domestic 123 Boy's Toilet and 124 Girl's Toilet
SCALE: 3/8"=1'-0"

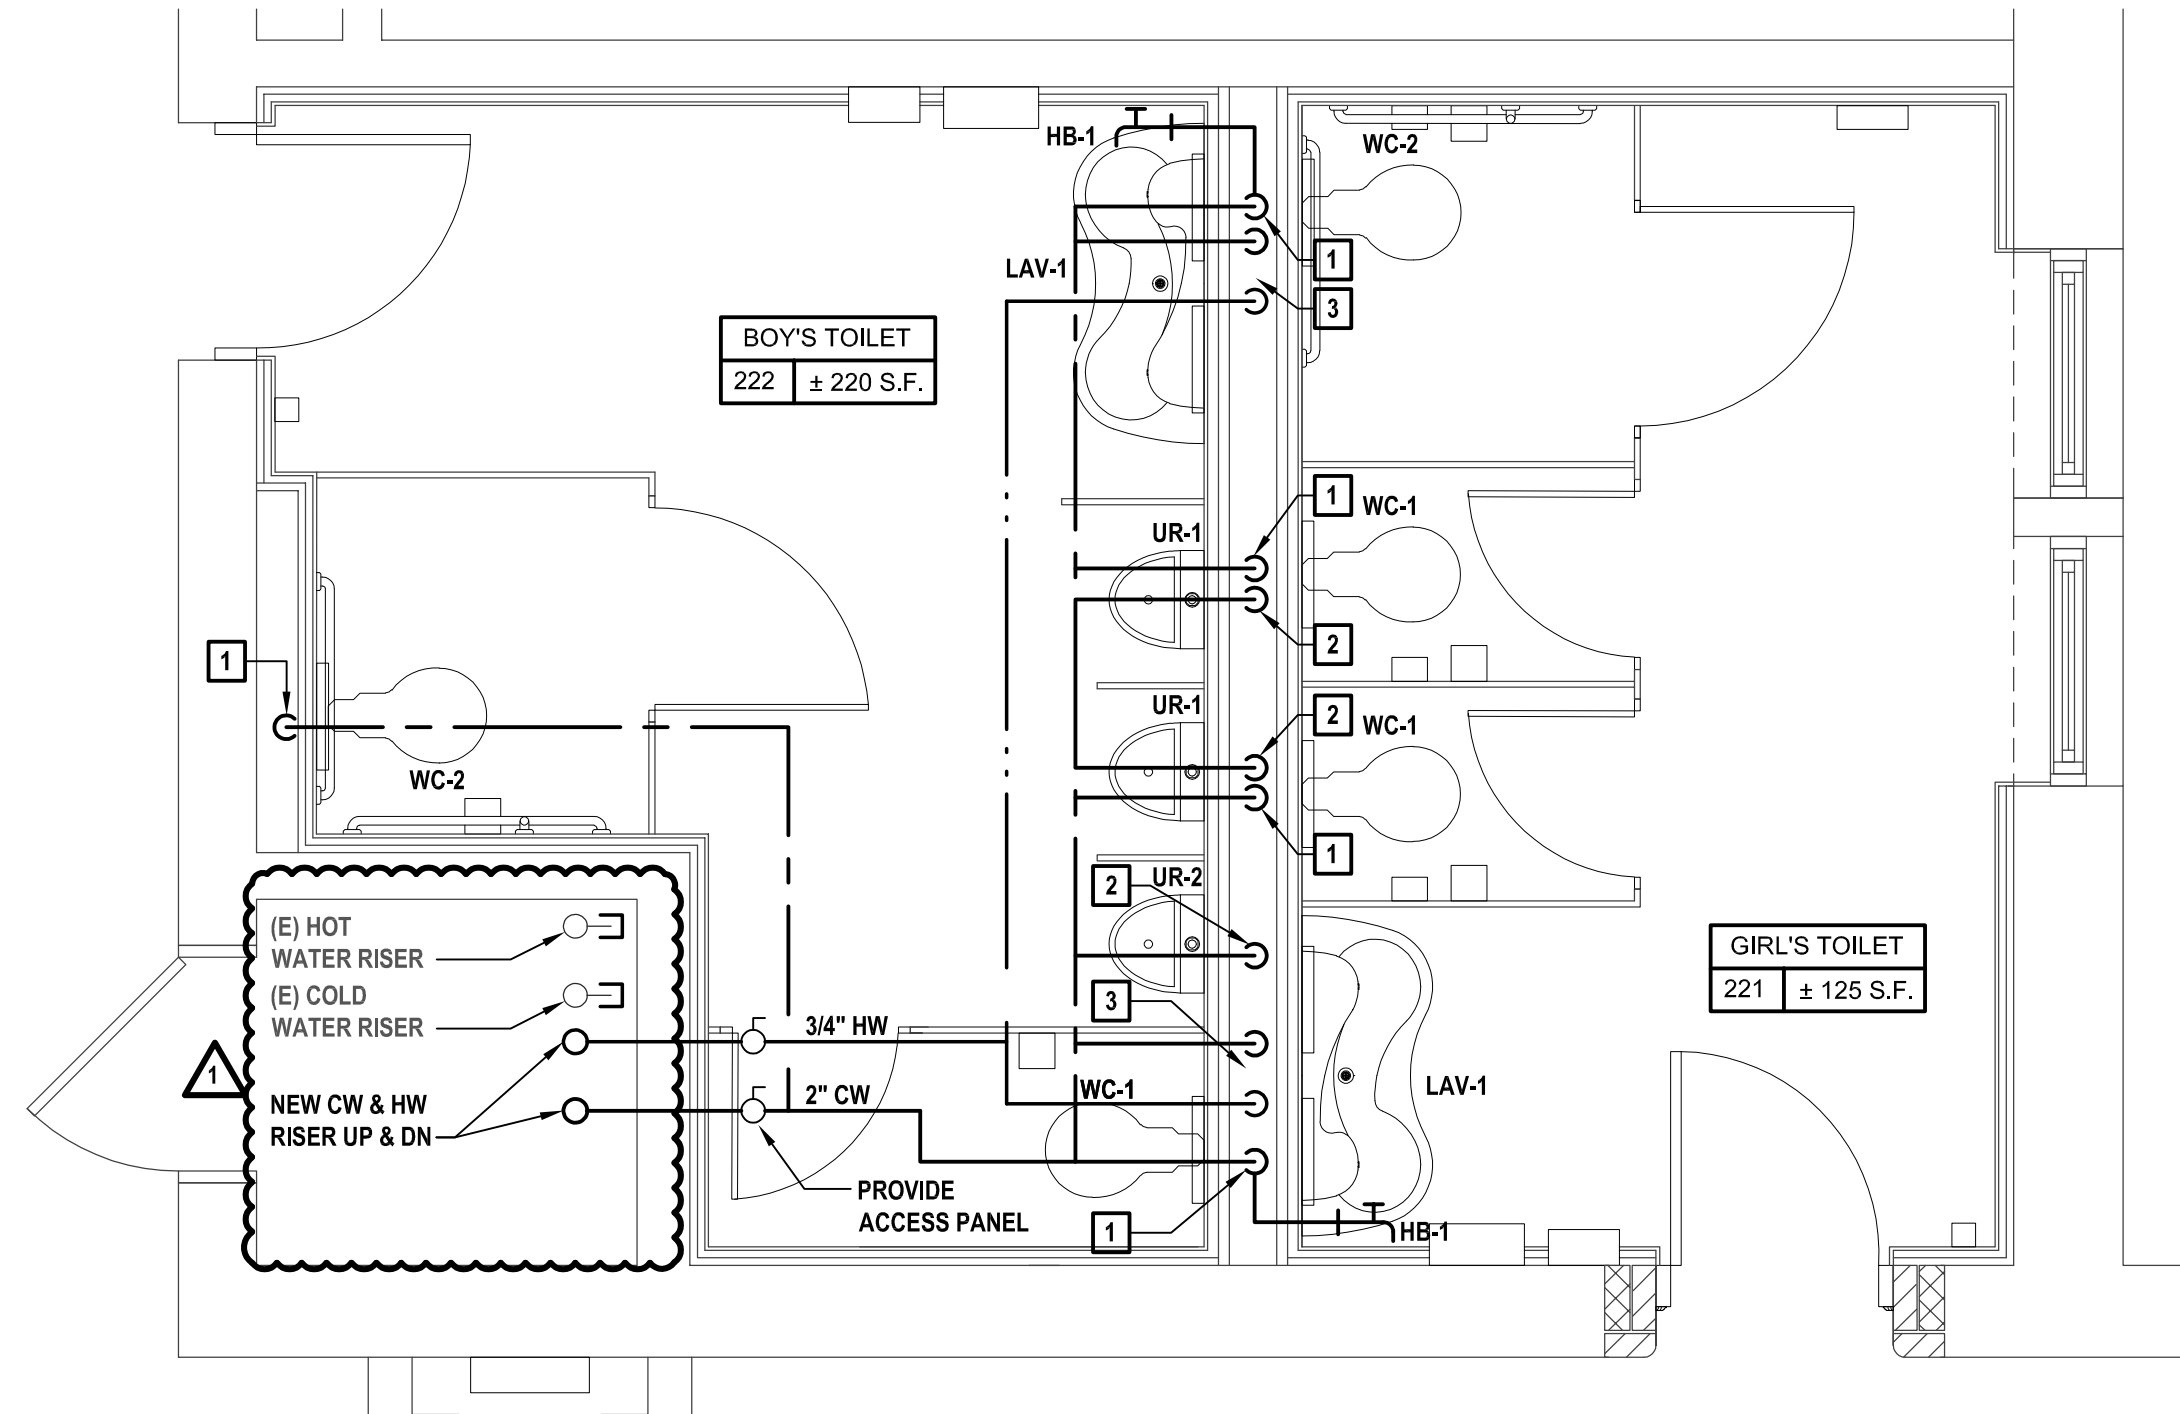

2 Enlarged Domestic 222 Boy's Toilet and 221 Girl's Toilet
SCALE: 3/8"=1'-0"

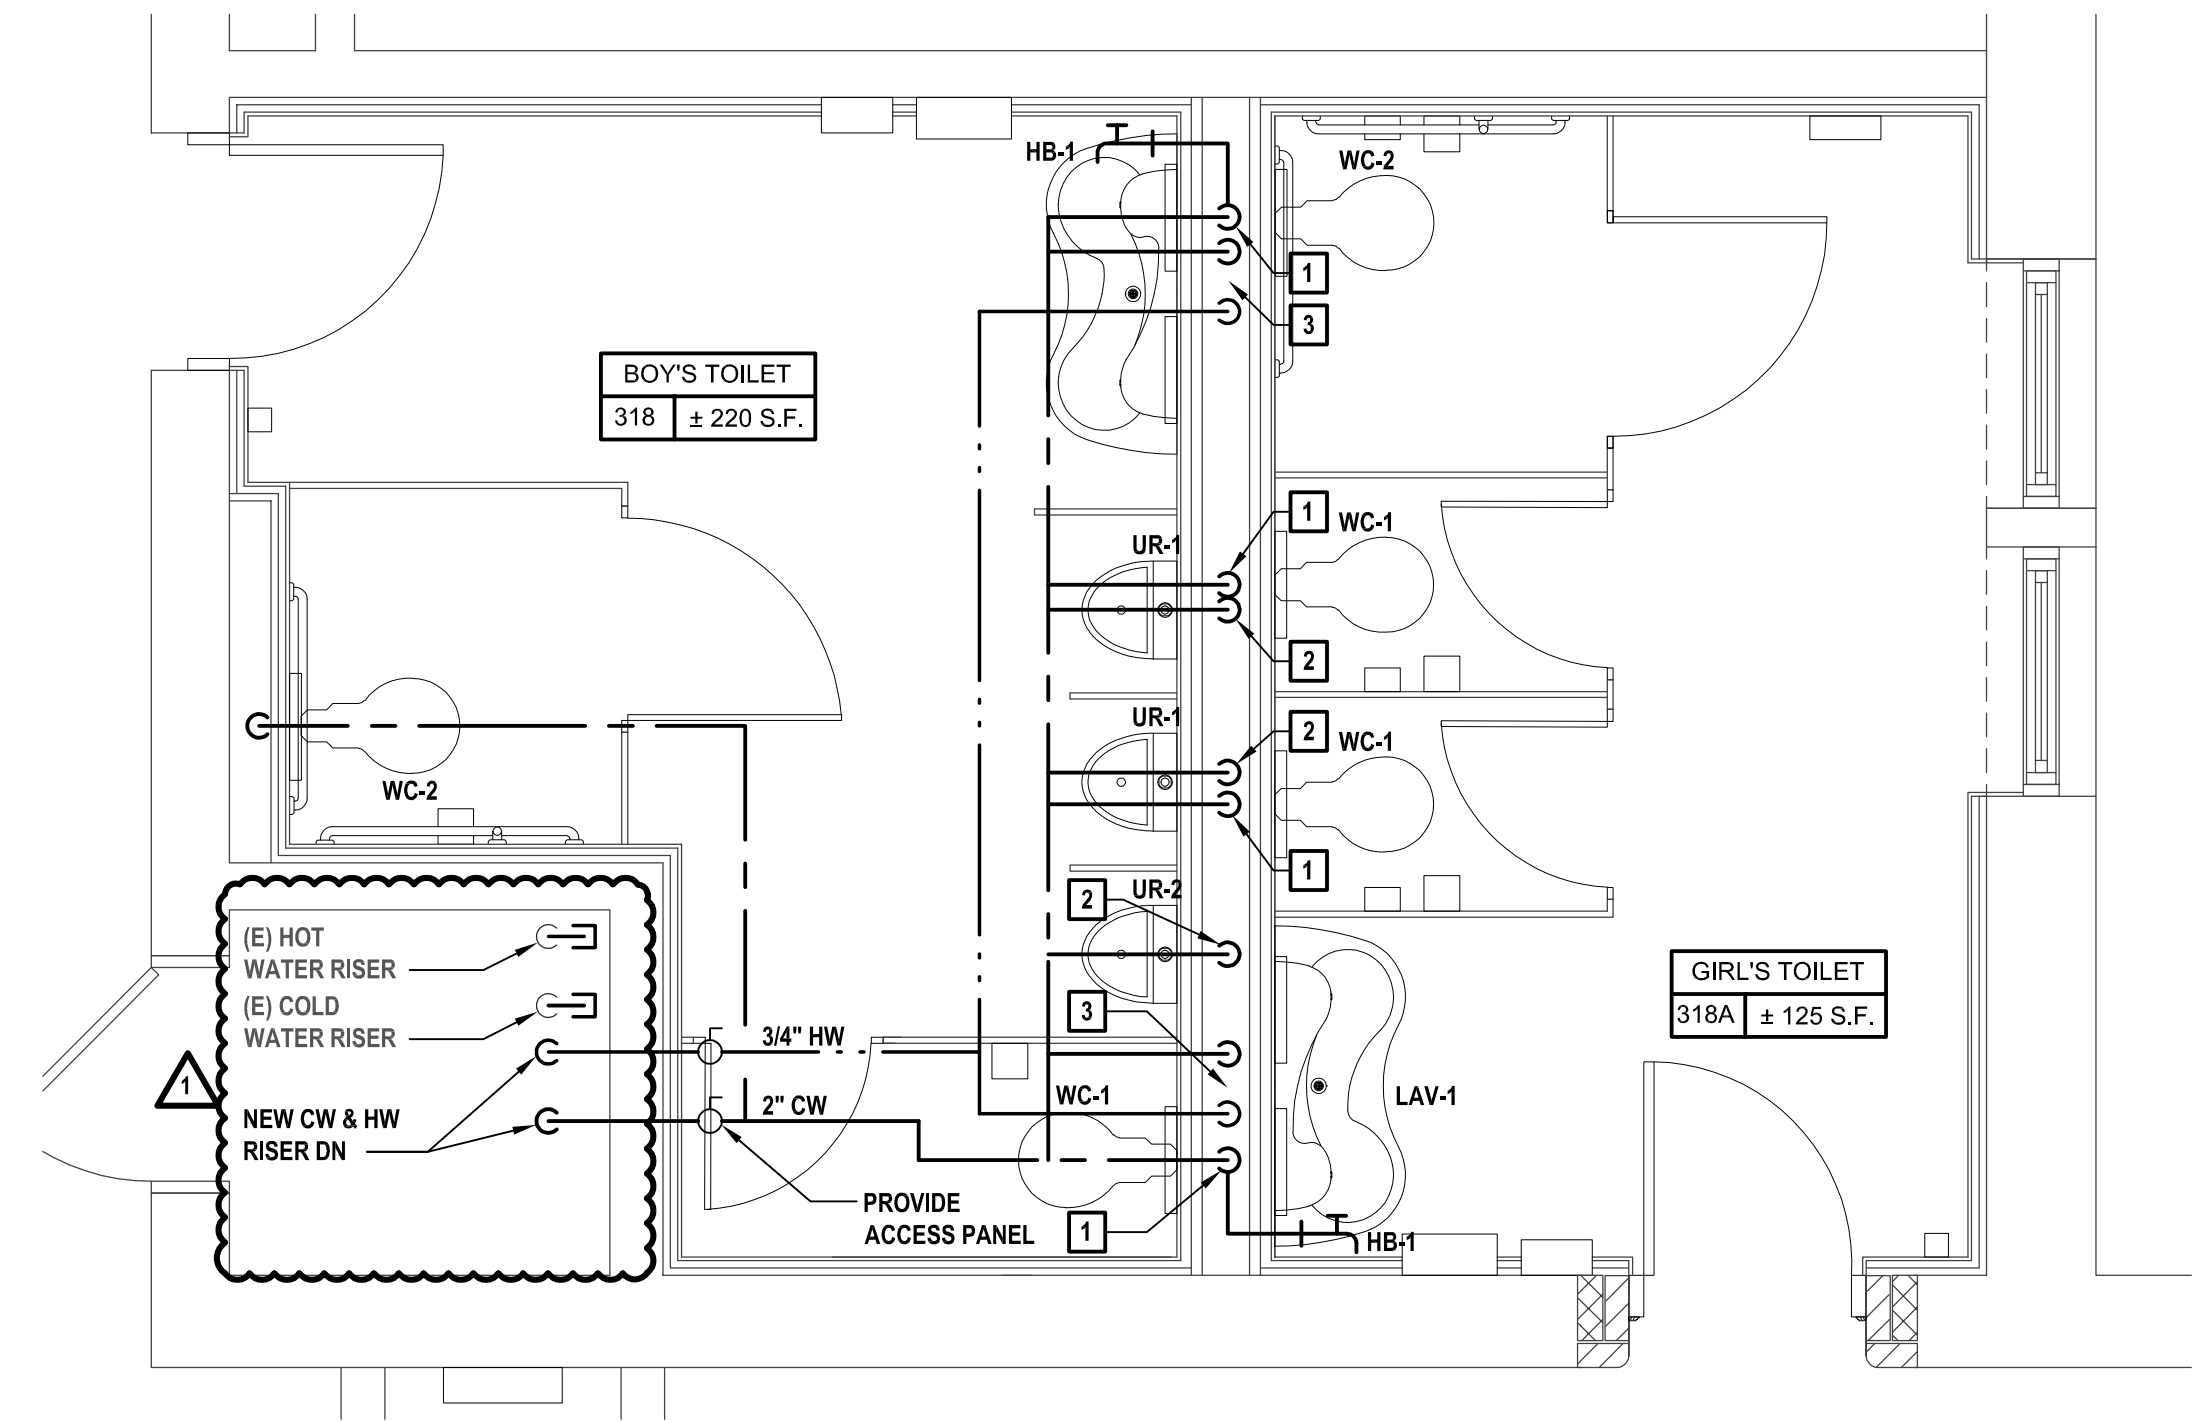

3 Enlarged Domestic 318 Boy's Toilet and 318A Girl's Toilet
SCALE: 3/8"=1'-0"

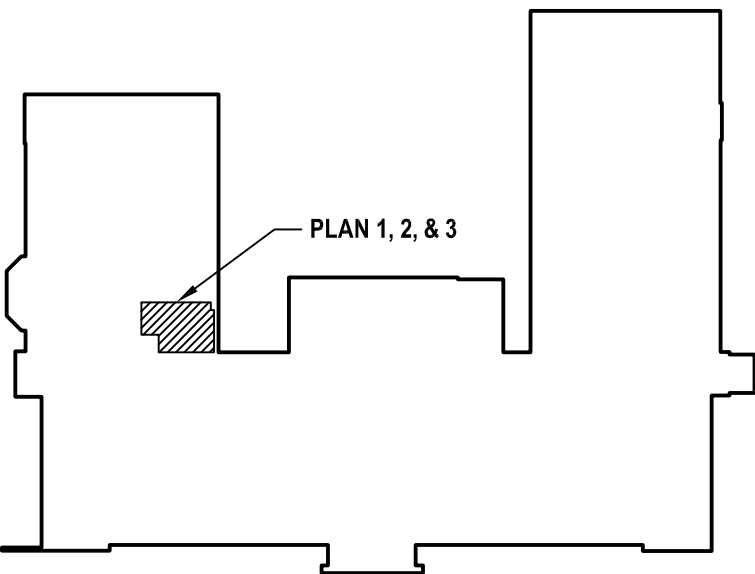

4 Key Plan
SCALE: NTS