


GENERAL NOTES:

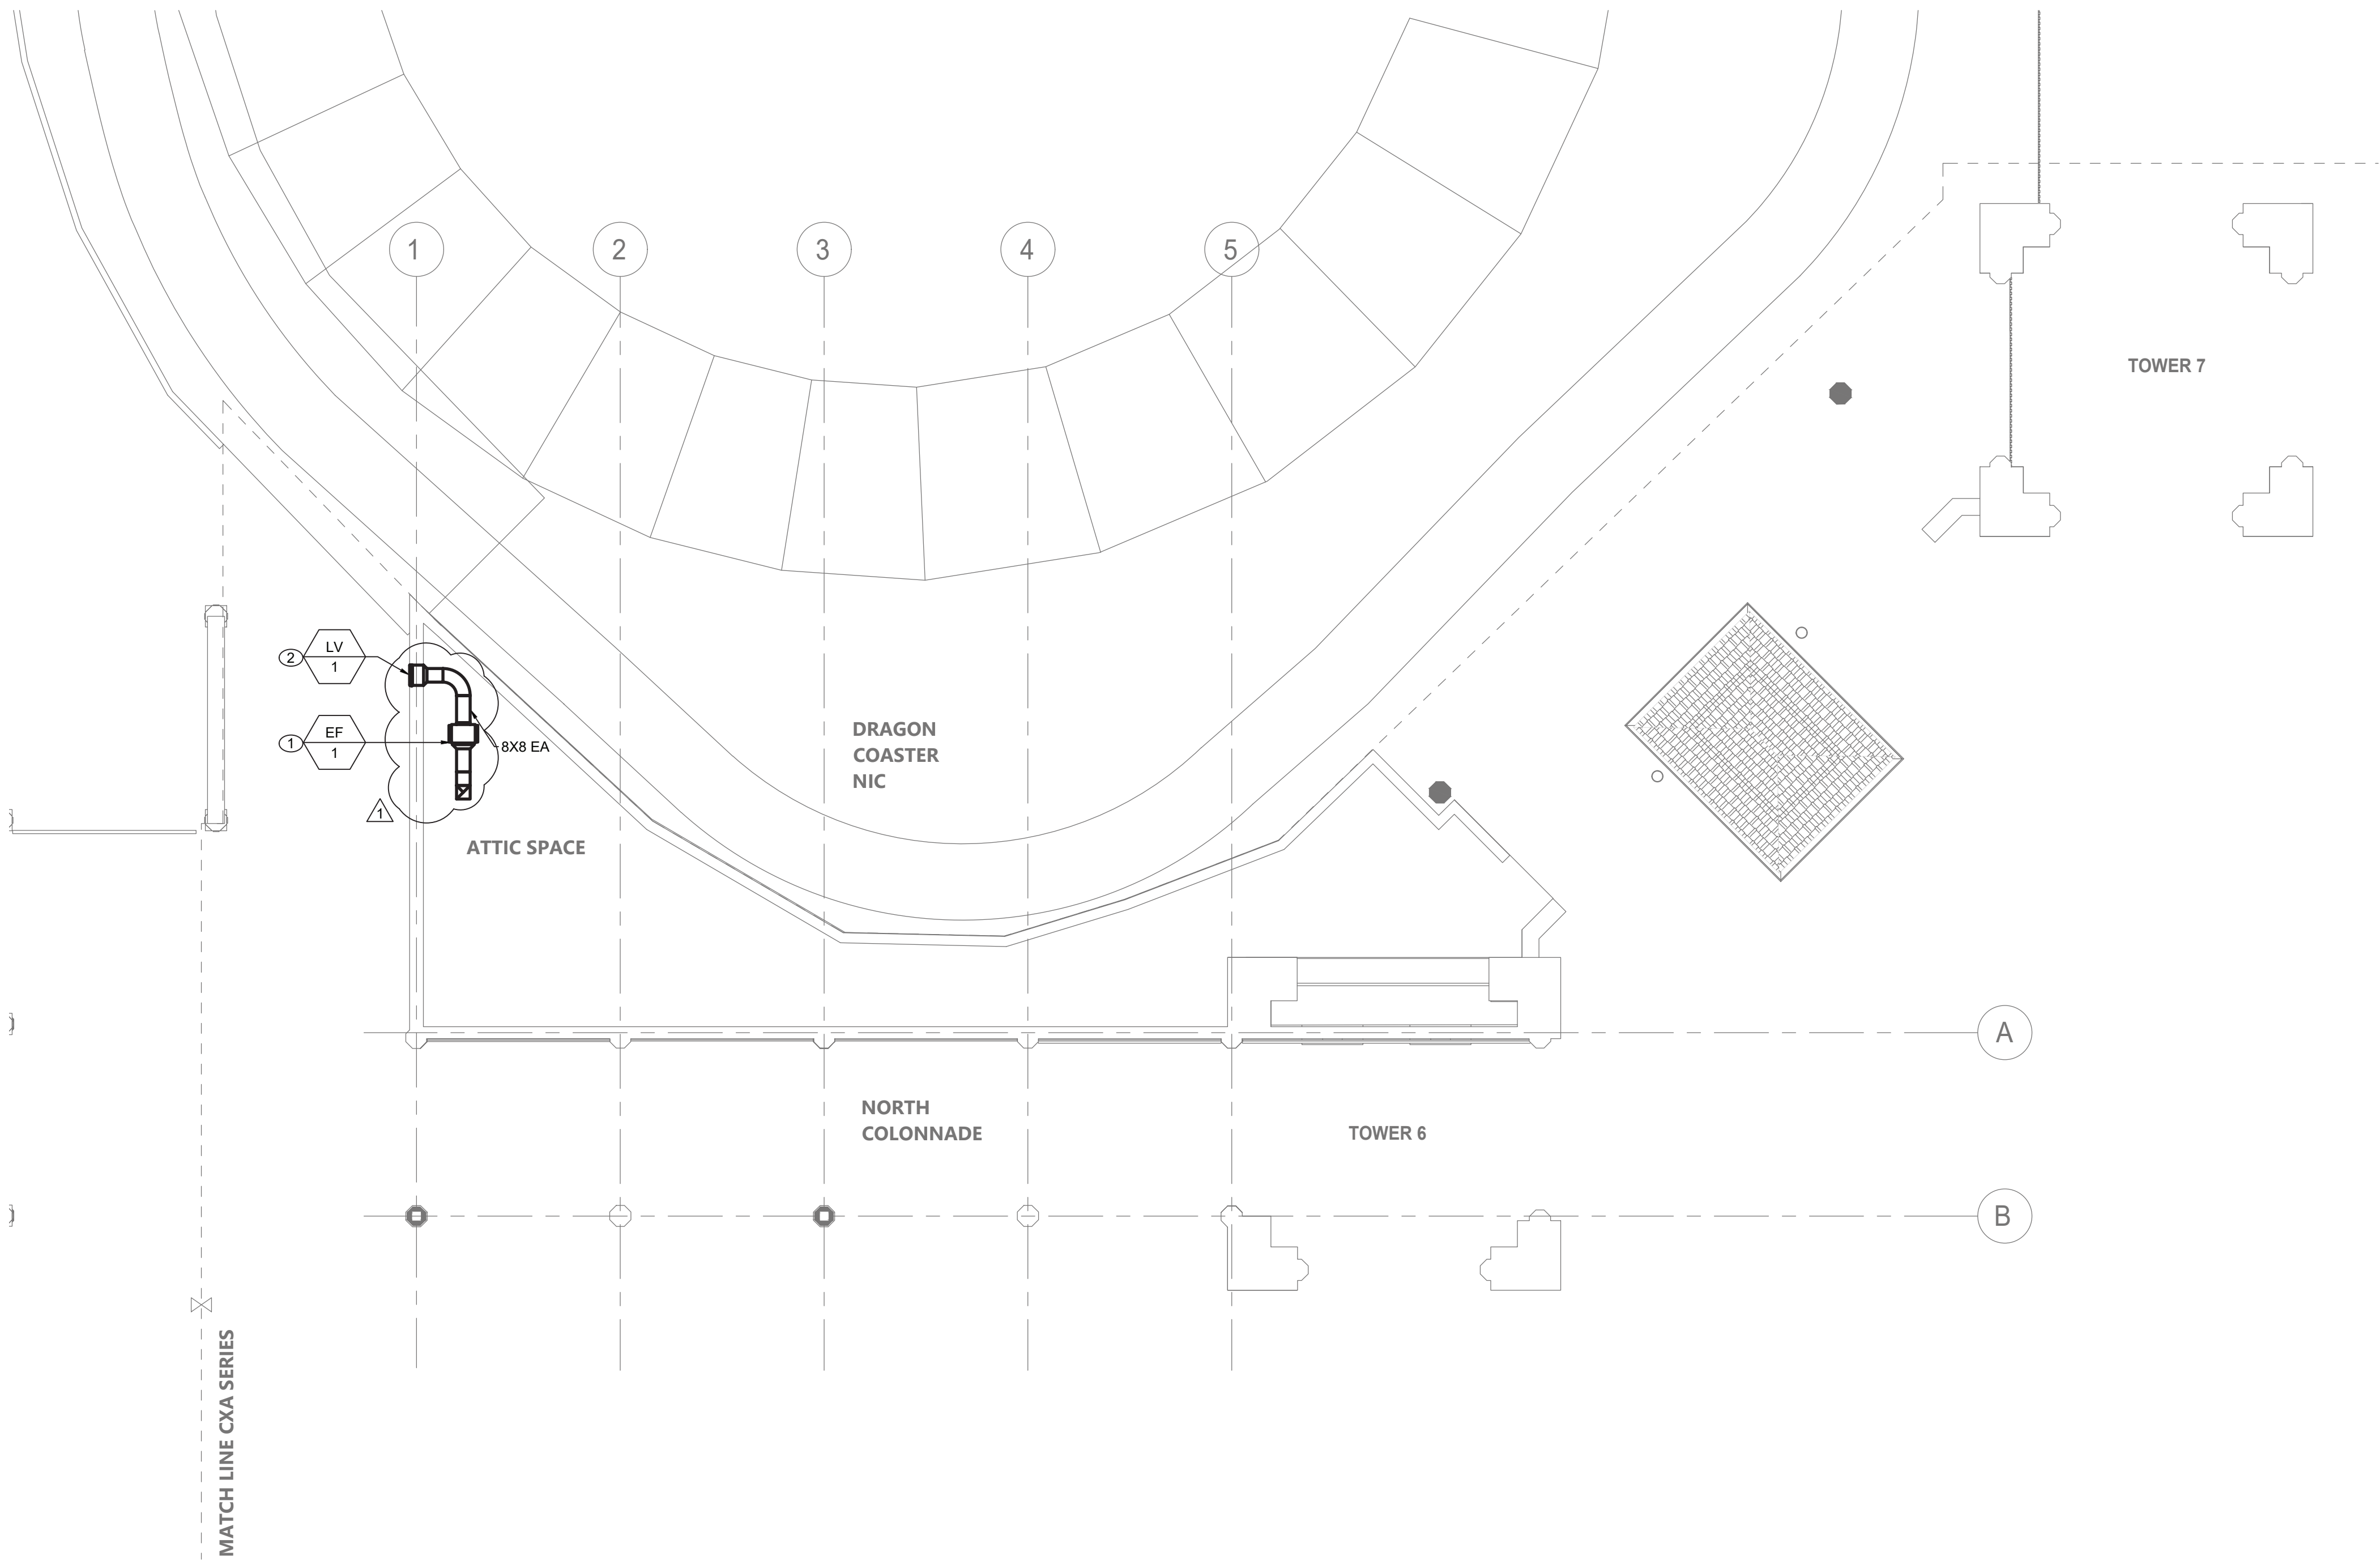

1. CONTRACTOR TO COORDINATE WITH FACILITY WHEN WORKING AROUND OR ABOVE THE RIDE COMPONENTS, AND PROVIDE ALL NECESSARY MEASURES TO PROTECT THESE COMPONENTS PER THE REQUIREMENTS OF THE FACILITY.
2. UPON COMPLETION, SYSTEM SHALL BE TESTED FOR PROPER OPERATION.

MECHANICAL CONSTRUCTION NOTES:

- ① PROVIDE NEW EXHAUST FAN AND ASSOCIATED DUCTWORK AS SCHEDULED. (INSTALL EF-1 ABOVE CEILING AT 11' 9-1/2" AFF.) COORDINATE ELECTRICAL POWER AND WIRING WITH ELECTRICAL DRAWINGS.
- ② PROVIDE NEW RAIN RESISTANT LOUVER AS SCHEDULED. (INSTALL LV-1 AT 11' 9-1/2" AFF.) REFER TO INSTALLATION DETAIL ON DVC-M-61.



**MECHANICAL ATTIC CONSTRUCTION PLAN**  
SCALE: 3/16" = 1'-0"

<div>CONSULTANT INFORMATION</div> <div><b>LiRo Engineers, Inc.</b> <i>A LiRo Group Company</i> Syosset, N.Y. 516-214-8157[T]</div>	<div>CONSULTANT SEAL</div> <div></div>						<div>RECORD DRAWING CERTIFICATION</div> <div><input type="checkbox"/> AS BUILT – CHANGES AS NOTED      <input type="checkbox"/> AS BUILT – NO CHANGES</div>		<div>WESTCHESTER COUNTY, NEW YORK</div> <div>DEPARTMENT OF PUBLIC WORKS AND TRANSPORTATION</div> <div>DIVISION OF ENGINEERING</div>		<div>CONTRACT NUMBER</div> <div>22-523</div>	<div>SHEET NUMBER</div> <div>DCV-M-22</div>
											<div>DWG NO.: 472 of 664</div>	
											<div>SCALE: AS INDICATED</div>	
		<div>1</div>	<div>09/21/22</div>	<div>MADE BY</div>	<div>APP'D BY</div>	<div>BID ADDENDUM #3</div>	<div>NAME</div> <div>SIGNATURE</div> <div>TITLE</div>	<div>PROJECT COORDINATOR</div> <div>NAME</div> <div>SIGNATURE</div> <div>TITLE</div>	<div>INFRASTRUCTURE REHABILITATION - PHASE 3</div> <div>PLAYLAND PARK, RYE, NEW YORK</div> <div>DRAGON COASTER VENDORS</div> <div>MECHANICAL ATTIC CONSTRUCTION PLAN</div>		<div>DPW FILE NUMBER</div> <div>1-118-M-1221-1</div>	<div>REV. NO.</div> <div>1</div>