

BID
ADDENDUM NO. 2
TO
CONTRACT DOCUMENTS
AND
TECHNICAL SPECIFICATIONS
FOR
2019 BOND REFERENDUM
CAPITAL IMPROVEMENTS
AT
MAMARONECK HIGH SCHOOL
PHASE 2
NYSED #66-07-01-03-0-001-039
BID # 20/21 – MUFSD-00

Mamaroneck Union Free School District
1000 West Boston Post Road
Mamaroneck, NY 10543

Telephone No. 914-220-3040

Contact: Ms. Sylvia Wallach
Assistant Superintendent for Business

LAN Job #4.1092.72.06
December 23, 2021

Michael J. McGovern, RA
NYS #022257

1.0 General: The original contract documents dated **November 22, 2021**, issued to the New York State Education Department (NYSED) for this project, are hereby amended as noted in this NYSED addendum which shall become part of said contract documents, as if originally included therein. Bidders must acknowledge receipt of this NYSED addendum and all other addenda on the proposal form when submitting proposals. In case any bidder fails to acknowledge receipt of addenda, his proposal will nevertheless be construed as though it has been received, acknowledged, and the submission of his proposal shall constitute acknowledgment by the bidder of the receipt of same.

This is to advise all prospective bidders that this addendum has been issued to all bidders and that it contains a change in the contract documents.

Sealed bid proposals shall be received by **2:00 p.m. prevailing time on Wednesday, January 12, 2022**, by mail or in person at the Boston Post Road main entrance, at the Mamaroneck Union Free School District Office, 1000 West Boston Post Road, NY 10543. All bids must be received by 2:00 p.m. prevailing time at which time they shall be publicly opened and read aloud at 3:00 p.m. prevailing time. **Staff will be available to accept hand delivered bids between the hours of 8:00 a.m. and 2:00 p.m. on January 12, 2022. Please be advised that masks are mandatory, and all attendees will be required to socially distance during the bid opening.**

2.0 Amendments to Specifications:

Section No.	Page No.	Addendum Requirements
01 12 00		The following section was revised as follows: [01 12 00 Pg. 5 of 28 – IV. Construction Milestones “Mamaroneck High School”] <u>PH-2 MHS Capital Improvement Bond Project Bid Schedule</u> . Activity ID 0180 – Notice to Proceed to Contractor shall be changed from <u>February 2, 2022</u> to <u>February 16, 2022</u> .
TOC	5	Revised Table of Contents to include Specification Section 233113 Metal Ducts
233113	All	Added Specification Section 233113 Metal Ducts

3.0 Amendments to Drawings:

Drawing No.	Addendum Requirements
A 2.10 and A2.11	Floor Plans updated to reflect a new sink added in Prototyping Studio 341.
P1.12	Plumbing Floor Plan updated to reflect a new sink added to Prototyping Studio 341.
P1.13	Plumbing Fixture Schedule – STEAM Lab updated to reflect a new sink added to Prototyping Studio 341.
M1.81	Drawing revised to show existing gas piping to be removed by the Plumbing Contractor. Additional notes referencing the separation of work between Prime Contracts were added to the drawings.

3.0 Amendments to Drawings: (continued)

Drawing No.	Addendum Requirements
M2.81	Drawing revised to show new gas piping by the Plumbing Contractor. Drawing revised to show new floor drains by Plumbing Contractor. Additional notes referencing the separation of work between Prime Contracts were added to the drawings.
P2.81	New Drawing added to the set showing Plumbing scope of work associated with the Palmer Boilers (Work Area H).

4.0 Requests for Information (RFIs):

No.	Question / Response
1	<p>Question: Ceiling Hung Assembly: Upon review of spec section 010101-1.08, Note 12 states, "Temporarily remove, carefully store and reinstall existing hung ceiling panel assembly as required to access areas of work within plenum." After review it is unclear what area(s) this is in reference to, please advise</p> <p>Response: This note refers to each prime contractor being responsible to carefully remove, store and reinstall existing ceilings when their work requires them to be removed to gain access above.</p> <p>This requirement is also stated in 011200 - Special Provisions, Section IX. MANAGEMENT OF WORK, Note #12</p> <p>Each Prime Contractor shall be solely responsible to remove and replace the existing ceiling tiles and grid in areas of the existing building where their work is required but new ceilings are not scheduled. In the event that the existing ceilings are damaged and cannot be replaced to the satisfaction of the Owner, the responsible Prime Contractor shall be solely responsible for replacing, in kind, the existing ceilings with new tile and grid. A qualified Contractor, acceptable to the Owner, shall perform all ceiling replacements.</p>
2	<p>Question: BMS Power Wiring: Please refer to Spec Section 010000-1.32, "Control wiring must connect to a point of electrical power supply as shown in the contract documents. (Power wiring and supply shall be provided by the Electrical Contractor)". Please confirm the power wiring required from BMS devices to a point of electrical power supply is to be provided by the Electrical Contractor.</p> <p>Response: Power (120VAC) wiring from a BMS device to a point of electrical power supply is to be provided by the Electrical Contractor.</p>

4.0 Requests for Information (RFIs): (continued)

No. Question / Response

- 3 Question: STEAM Lab Existing Ceilings to Remain: Please refer to contract Drawing A2.01, Construction Key Notes A23 & A25, (2) existing suspended ceiling systems are to remain in place. As indicated on A4.10, penetration of existing plaster barrel vault and existing gypsum wallboard ceiling for hangers & supports and misc. mechanical devices, will be required. Access to these areas will require openings larger than 12"x12". Per spec 011010 (PCGC) #23 it appears that this is the responsibility of the Prime GC, please confirm.
- Response: GC is to coordinate with the other trades to provide openings larger than 12" x 12" for equipment AND access to the space above the STEAM lab.
- 4 Question: STEAM Lab Convactor Cover Painting: Please refer to contract Drawing M2.11, note 1 regarding FTR-1. Existing cover is to be reinstalled and painted. Please advise if GC is to perform the painting of the cover as part of the surrounding areas that are scheduled to be painted.
- Response: Convactor covers to be painted by the GC.
- 5 Question: Project Schedule: Please confirm the Steam Lab and Culinary Arts scheduled for a Construction Start of March 2022 are to be performed on 2nd shift (3:30pm start). In addition, please advise if the schedule can be advanced for the Palmer Boiler Room to start on 2nd shift (3:30pm start)
- Response: Second Shift is confirmed prior to 6/27. An early start will be discussed with the Owner, once the project is awarded.
- 6 Question: Palmer Boiler Room Trench Drain: Please refer to Contract Drawing M2.81 Key Note 2, please confirm installation of new floor drains including "televise existing drain pipe and snake line, patch floor to match existing", is by PC. Please refer to A1.80 which indicates this work is within the PC's scope. In addition, please confirm New Floor Drain indicated to be replaced on M2.81 near P-1 thru 3 is to be performed by others.
- Response: Scope of work for floor drawings is the responsibility of the Plumbing Contractor. A new plumbing drawing reflecting this work (P2.81) has been added to the drawing set.
- 7 Question: STEAM Lab Existing Space Above Ceiling: During walkthrough access to existing Attic Mechanical Space above future Steam Lab, was not available. Please refer to Contract Drawing M1.11 Key Plan 3 & M2.11 Key Plan 3. If possible, please provide additional information or pictures of this space. Does the entire space have an existing continuous floor surface or is a temporary surface required to perform scope of work?
- Response: Any additional site visit can be requested through Mr. Stephen Brugge, Director of Facilities, at 914-220-3081.

4.0 Requests for Information (RFIs): (continued)

No.	Question / Response	
8	Question:	STEAM Lab Metal Wood Shop Ductwork: Please refer to Contract Drawing M2.13, Steam Equipment Schedule indicates required ductwork connection requirements for associated equipment furnished and installed by others (A2.10). Upon review of M2.11, no ductwork system is shown to support these individual pieces of equipment. Please advise
	Response:	The portable dust collectors shall be utilized to remove dust contaminated air. No ductwork network is required, however proper flex ductwork accessory shall be selected to each piece of equipment based on each MFR requirements.
9	Question:	STEAM Lab Access Window Opening Size: Can you please confirm center mullion will be removed in Classroom 306 for Steam Lab delivery access? Can you please provide expected opening width and height?
	Response:	Window units will be removed including center window mullion. No brick or wall area will be removed. Windows can be measured onsite.
10	Question:	DCH – Portable Dust Collector: Please confirm PCM is to furnish and install Portable Dust Collectors tagged "DCH" as shown on Contract Drawing M2.13 in room 345A and in room 346A. In room 346A please clarify if Airflow Systems DCH-1 or DCH-2 is desired? Please clarify if any additional accessories are required.
	Response:	Basis of design is Airflow systems and if contractor want to substitute. they need to provide a substitution request per the contract documents with the substituted units meeting the basis of design including meeting all the required all applicable codes.
11	Question:	STEAM Lab Louvers: Please refer to Contract Drawing M2.11 Part Plan 2 & 3, (5) Greenheck 24"x14" louvers are scheduled to be installed in the Steam Lab serving ERV-1, ERV-2 & MAU-1. These openings will be larger than 12"x12". Per Spec Section, 01-10-10 PCGC Item# 23 these openings shall be performed by PCGC. Upon review of site conditions scaffolding will be required to perform this work. Please confirm scaffolding and openings are to be provided by PCGC. Please confirm Louvers are to be provided by the PCM.
	Response:	The GC is to provide unabated access to areas of work where other Prime contractors are performing installation or demolition, where BOTH Prime contractors require access. This includes access via scaffold for new exterior louvers where the PCGC and PCM will work and coordinate on louver openings. This general note should extend for any work that includes both the PCGC and PCM, PCP and PCE's contract work. Anywhere the PCGC is not providing cutting, patching or modification of existing walls/floors/roofs/etc.,, access will be by the specific trade performing the work.
12	Question:	Boiler Room Emergency Shut-Off Switch: Please refer to Contract Drawing M2.81, a switch symbol with the note "Provide new emergency shut-off switch" is indicated. This system is detailed on Electrical Contract Drawings E0.02 Detail 3 and E2.80 Note 7. Please confirm no scope of work is required by Mechanical Contractor for this system.
	Response:	Emergency shut off switch to be provided, wired and installed by the Electrical Contractor.

4.0 Requests for Information (RFIs): (continued)

No.	Question / Response	
13	Question:	STEAM Lab Culinary Arts Exposed Double Wall Ductwork: Please refer to Contract Drawing M2.13, in Metal Shop Room 346 "Double Wall Spiral Ductwork" is indicated. In addition, please refer to Contract Drawing M2.2 1, in Culinary Arts Room C100 "Exposed Double Wall Flat Oval Ductwork" is indicated. Please provide a desired product specification.
	Response:	Use double wall spiral ductwork in Metal Shop Room 346 & use exposed double wall flat oval ductwork in Culinary Arts Room C100.
14	Question:	Boiler Room Equipment Rigging: During a recent site visit and in review of rigging needed for the boiler room equipment we noticed that the area between the stairs and the chimney has a permanent barrier installed. Upon review, the area shown clouded in the attached pictures appears to be slab on deck with blacktop covering. Please advise on the weight capacity of this area; we are assuming a crane is needed to rig the new equipment into the boiler room due to existing constraints.
	Response:	This area adjacent to the building is the electrical Transformer vault. The weight capacity is 0 lbs. and this area should be avoided.
15	Question:	Condensate Piping: Upon review of Contract drawings, the condensate piping for the A/C Units in the STEAM area and the Culinary Arts area is not shown. Please provide a drawing showing desired routing and termination location.
	Response:	Refer to Plumbing contract drawings P2.06 & P1.12 for Condensate piping plan in the areas listed.
16	Question:	Sheetmetal Specifications: Upon review of specifications, a general ductwork specification (typically 233113) does not appear to be included. Please confirm Contract Drawing M0.01 - H.V.A.C. Materials - Ductwork & Spec Section 233522 - Kitchen Ventilation System is to be utilized for project duct construction standards (less lined ductwork).
	Response:	1. duct spec section 233113 added to Addendum 2. 2. All Acoustic duct insulation shall follow 230714 regardless. All other ductwork insulation shall follow what's listed on the material schedule on M0.01.
17	Question:	Maintenance bond/warranty/guarantee. Can you please advise on what the maintenance bond/warranty/guarantee period is?
	Response:	3 years from date of Substantial Completion.
18	Question:	M-001 under "Controls Note" states that the district has a standardization of Schneider Electric/Continuum. Is there a specific controls vendor who is currently serving the school in which we need to utilize?
	Response:	EMF Building Automation Systems Walter E. Greenwood "Chip" Phone: 914-747-1007 Mobile: 914-403-4702

4.0 Requests for Information (RFIs): (continued)

No.	Question / Response
-----	---------------------

- | | |
|----|--|
| 19 | Question: What is the dimension of the donor plaque?
Response: See drawing A7.11 and note A55 on A2.01. |
| 20 | Question: The specs calls for bulletin boards and directories. I don't see any specs for those. Please provide.
Response: There are no bulletin boards or directories on the project. |
| 21 | Question: On A7.10, there is graphics. Can you please clarify what I am bidding? "THINK TANK" (Interior elevation design studio #3) What substrate is the letters going on (Glass etc.) and the height of the letters. Please confirm this is vinyl.
Response: The material is answered in A49 on A2.01. The substrate is glass. The lettering is 12" high; final graphics to be provided by owner. |
| 22 | Question: A7.10 "PROTOTYPING STUDIO" What is substrate to be applied?
Response: All graphics indicated by note A35 shall be installed over gypsum wall board. Final graphics are to be provided by the owner. |
| 23 | Question: A7.11 graphic letters. "MHS CO LAB" Same question as #3.
Response: Material is indicated in note A56 on drawing A2.01. The substrate is gypsum wall board. The lettering is 12" high; final graphics to be provided by owner. |
| 24 | Question: Room signs have no sizes or schedule. Please provide.
Response: Room signage details can be found on Drawing A6.20. |

5.0 Clarifications:

No.
N/A

6.0 Substitution Requests:

Specification Section No.
N/A

END OF ADDENDUM NO. 2

Attachment: #1 – Revised Table of Contents
#2 – Added Specification Section 233113
#3 – Revised Drawings A 2.10, A2.11, P1.12, P1.13, M1.81, M2.81
#4 – Added Drawing P2.81

TABLE OF CONTENTS

<u>DIVISION NO.</u>	<u>TITLE</u>	<u>PAGE NO.</u>
0	GENERAL DOCUMENTS	
	Cover	
	Soft Cover (Seal & Signature of A/E).....	A/E-1
	Table of Contents.....	TOC-1

DIVISION 00 – PROCUREMENT AND CONTRACTING REQUIREMENTS

00 01 15	List of Drawings.....	000115-1
00 11 13	Notice to Bidders.....	001113-1
00 21 13	Instructions to Bidders	002113-1
00 31 26	Existing Hazardous Material Information	003126-1
00 41 00	Forms to Be Submitted with Bid.....	004100-1
00 41 01	Bid Proposal Form	004101-1
00 41 02	Bid Forms.....	004102-1
00 43 90	Surety's Consent.....	004390-1
00 43 91	Certificate of Bidder.....	004391-1
00 43 92	Qualifications of Bidders	004392-1
00 43 93	Statement of Bidders Qualifications	004393-1
00 43 94	Bidder's Personnel	004394-1
00 43 95	Conflict of Interest Certificate	004395-1
00 43 96	Form of Disclosure Certificate.....	004396-1
00 43 97	Non-Collusion Affidavit.....	004397-1
00 43 98	Certification of Compliance with the Iran Divestment Act	004398-1
00 43 99	Declaration of Bidder's Inability to Provide Certification of Compliance with the Iran Divestment Act.....	004399-1
00 44 00	Sexual Harassment Prevention Certification Form	004400-1
00 45 21	Hold Harmless Agreement.....	004521-1
00 46 43	Wage Rates	004643-1
00 50 00	Owner Contractor Agreement	005000-1
00 61 00	Bond Requirements	006100-1
00 61 01	Bid Bond Form AIA 310-2010	006101-1
00 61 02	Performance Bond Form AIA 312-2010.....	006102-1
00 61 03	Payment Bond Form AIA 312-2010	006103-1
00 63 00	Request for Information	006300-1
00 63 01	RFI Form AIA G716-2004	006301-1
00 70 00	General Conditions of the Contract for Construction	007000-1
00 70 01	Requisition for Partial Waiver of Liens	007001-1
00 70 02	Certified Payroll.....	007002-1
00 73 16	Insurance Requirements	007316-1

DIVISION 1 - GENERAL REQUIREMENTS

01 00 00	General Requirements	010000-1
	Liquidated Damages Table 1-1	010000-24
01 01 01	Multiple Contract Summary of Work	010101-1
01 11 00	Milestone Schedule.....	011100-1

<u>DIVISION NO.</u>	<u>TITLE</u>	<u>PAGE NO.</u>
DIVISION 1 - GENERAL REQUIREMENTS (continued)		
01 12 00	Special Provisions.....	011200-1
01 21 00	Allowances	012100-1
01 22 00	Unit Prices	012200-1
01 23 00	Alternates	012300-1
01 25 00	Substitution Procedures	012500-1
01 26 00	Contract Modification Procedures	012600-1
01 31 00	Project Management and Coordination	013100-1
01 32 00	Construction Progress Documentation	013200-1
01 32 33	Photographic Documentation.....	013233-1
01 33 00	Submittal Procedures.....	013300-1
01 40 00	Quality Requirements.....	014000-1
01 43 39	Mockup Requirements	014339-1
01 45 33	Code-Required Special Inspections.....	014533-1
01 50 00	Temporary Facilities and Controls	015000-1
01 51 10	SED Commissioners Regulations.....	015110-1
01 73 00	Execution Requirements	017300-1
01 73 10	Cutting and Patching.....	017310-1
01 74 19	Construction Waste Management and Disposal.....	017419-1
01 77 00	Close-Out Procedures.....	017700-1
01 78 23	Operation and Maintenance Data	017823-1
01 78 39	Project Record Documents	017839-1
01 91 13	General Commissioning Requirements	019113-1
DIVISION 2 – EXISTING CONDITIONS		
02 08 00	Asbestos Abatement Procedures	020800-1
02 41 19	Selective Demolition.....	024119-1
02 41 20	Site Demolition	024120-1
DIVISION 3 – CONCRETE		
03 01 30	Maintenance of Cast-in-Place Concrete	030130-1
03 30 00	Cast-in-Place Concrete	033000-1
03 54 00	Concrete Underlayment Patch	035400-1
03 54 16	Cement-Based, Interior, Self-Leveling Underlayment	035416-1
DIVISION 4 – MASONRY		
04 01 10	Masonry Cleaning	040110-1
04 01 20	Unit Masonry Restoration	040420-1
04 01 22	Stone Restoration	040422-1
04 21 13	Brick Masonry	042113-1
04 22 00	Concrete Unit Masonry	042200-1
04 72 00	Cast Stone Masonry.....	047200-1

<u>DIVISION NO.</u>	<u>TITLE</u>	<u>PAGE NO.</u>
DIVISION 5 – METALS		
05 12 00	Structural Steel Framing	051200-1
05 31 00	Steel Decking	053100-1
05 40 00	Cold Formed Framing	054000-1
05 50 13	Miscellaneous Structural Fabrications	055013-1
05 51 00	Metal Stairs and Railings	055100-1
05 51 33	Metal Ladders	055133-1
05 73 00	Decorative Metal Railings	057300-1
DIVISION 6 – WOOD AND PLASTICS		
06 10 00	Rough Carpentry	061000-1
06 10 53	Miscellaneous Rough Carpentry	061053-1
06 20 00	Finish Carpentry	062000-1
06 61 16	Solid Surfacing Fabrications	066116-1
DIVISION 7 – THERMAL AND MOISTURE PROTECTION		
07 01 50	Preparation for Re-Roofing	070150-1
07 01 51	Rehabilitation of Built-Up Roofing	070151-1
07 21 00	Building Insulation	072100-1
07 21 13	Continuous Insulation	072113-1
07 27 26	Air Barriers	072726-1
07 56 00	Fluid Applied Roofing	075600-1
07 57 13	Spray Polyurethane Foam Roofing	075713-1
07 62 00	Sheet Metal Flashing and Trim	076200-1
07 71 00	Manufactured Roof Specialties	077100-1
07 72 33	Roof Hatches	077233-1
07 81 00	Applied Firestopping	078100-1
07 81 23	Intumescent Firestopping	078123-1
07 84 43	Firestopping	078443-1
07 90 00	Pre-Compressed Expansion Joints.....	079000-1
07 92 00	Joint Sealants.....	079200-1
07 95 13	Interior Expansion Cover Assemblies	079513-1
DIVISION 8 – OPENINGS		
08 11 13	Hollow Metal Doors and Frames.....	081113-1
08 11 16	Medium Stile Monumental Door	081116-1
08 11 18	Wide Stile Monumental Door	081118-1
08 14 16	Flush Wood Doors	081416-1
08 31 13	Access Doors and Frames.....	083113-1
08 32 26	All Glass Folding System	083226-1
08 41 23	Fire Rated Steel Framed Entrances and Storefronts.....	084123-1
08 41 24	Fire Rated Aluminum Framed Entrances and Storefronts	084124-1
08 41 25	Fire Rated Glass and Framing Systems	084125-1
08 43 33	Folding Glass Doors.....	084333-1
08 51 13	Aluminum Windows.....	085113-1

<u>DIVISION NO.</u>	<u>TITLE</u>	<u>PAGE NO.</u>
DIVISION 8 – OPENINGS (continued)		
08 71 00	Door Hardware	087100-1
08 81 00	Glass and Glazing.....	088100-1
08 81 17	Fire-Rated Glass	088117-1
08 90 00	Louvers and Vents	089000-1

DIVISION 9 – FINISHES

09 05 61	Water Vapor Emission Control System for Concrete Slabs.....	090561-1
09 29 00	Gypsum Board	092900-1
09 30 13	Ceramic Tile	093013-1
09 50 00	Direct Apply Acoustical Ceilings	095000-1
09 50 10	Acoustical Ceilings Blades.....	095010-1
09 51 13	Acoustical Tile Ceilings	095113-1
09 54 20	Acoustical Metal Ceilings	095420-1
09 54 46	Feltworks Open Cell.....	095446-1
09 64 20	Wood Gymnasium Flooring	096420-1
09 65 13	Resilient Base and Accessories.....	096513-1
09 65 14	Stair Landings, Risers, Treads and Ramps	096514-1
09 65 20	Resilient Solid Vinyl Tile.....	096520-1
09 67 13	Elastomeric Liquid Flooring.....	096713-1
09 67 23	Resinous Flooring	096723-1
09 68 13	Carpet Tile.....	096813-1
09 80 00	Custom Aluminum Metal Wall System.....	098000-1
09 91 13	Exterior Painting.....	099113-1
09 91 23	Interior Painting	099123-1
09 93 00	Staining and Transparent Finishing	099300-1
09 96 46	Intumescent Painting.....	099646-1

DIVISION 10 – SPECIALTIES

10 11 00	Visual Display Boards	101100-1
10 12 00	Display Cases	101200-1
10 14 19	Interior Signs	101419-1
10 22 19	Demountable Partitions.....	102219-1
10 26 00	Wallcovering.....	102600-1
10 44 00	Fire Protection Specialties	104400-1

DIVISION 11 – EQUIPMENT

11 40 00	Food Service Equipment.....	114000-1
----------	-----------------------------	----------

DIVISION 12 – FURNISHINGS

12 21 24	Manual Roller Shade System	122124-1
12 35 54	Manufactured Casework	123554-1

<u>DIVISION NO.</u>	<u>TITLE</u>	<u>PAGE NO.</u>
DIVISION 14 – CONVEYING EQUIPMENT		
14 24 23	Hydraulic Elevator Modernization	142423-1
DIVISION 22 – PLUMBING		
22 00 00	Plumbing Summary of Work	220000-1
22 05 01	Basic Plumbing Materials and Methods	220501-1
22 05 17	Sleeves and Sleeve Seals for Plumbing Piping	220517-1
22 05 19	Meters and Gages for Plumbing Piping	220519-1
22 05 23	Plumbing Valves	220523-1
22 05 29	Hangers and Supports for Plumbing and Piping Equipment	220529-1
22 05 48	Vibration and Seismic Controls	220548-1
22 05 53	Identification for Plumbing Piping and Equipment	220553-1
22 07 19	Plumbing Piping Insulation.....	220719-1
22 11 16	Domestic Water Piping	221116-1
22 11 19	Domestic Water Piping Specialties	221119-1
22 11 23	Facility Natural-Gas Piping	221123-1
22 13 16	Sanitary Waste and Vent Piping	221316-1
22 13 19	Sanitary Waste Piping Specialties	221319-1
22 13 23	Sanitary Waste Interceptors.....	221323-1
22 14 13	Facility Storm Drainage Piping.....	221413-1
22 14 23	Storm Drainage Piping Specialties	221423-1
22 34 00	Fuel-Fired Domestic Water Heater	223400-1
22 42 13	Plumbing Fixtures	224213-1
DIVISION 23 – HEATING, VENTILATING AND AIR CONDITIONING		
23 00 00	Mechanical Summary of Work	230000-1
23 05 00	Common Work Results for HVAC	230500-1
23 05 13	Common Motor Requirements for HVAC Equipment	230513-1
23 05 16	Expansion Fittings and Loops for HVAC Piping	230516-1
23 05 19	Meters and Gages for HVAC Piping	230519-1
23 05 23	General-Duty Valves for HVAC Piping.....	230523-1
23 05 29	Hangers and Supports for HVAC Piping and Equipment	230529-1
23 05 48	Mechanical Vibration and Seismic Controls	230548-1
23 05 53	Mechanical Identification.....	230553-1
23 05 93	Testing, Adjusting and Balancing for HVAC	230593-1
23 07 13	Duct Insulation	230713-1
23 07 14	Acoustic Duct Insulation.....	230714-1
23 07 19	Piping Insulation.....	230719-1
23 09 93	Sequence of Operations for HVAC Controls	230993-1
23 21 13	Hydronic Piping	232113-1
23 21 16	Hydronic Piping Specialties	232116-1
23 21 20	Hydronic Specialties.....	232120-1
23 21 23	Hydronic Pumps.....	232123-1
23 23 00	Refrigerant Piping	232300-1
23 31 13	Metal Ducts	233113-1
23 33 00	Air Duct Accessories	233300-1

<u>DIVISION</u> <u>NO.</u>	<u>TITLE</u>	<u>PAGE</u> <u>NO.</u>
-------------------------------	--------------	---------------------------

DIVISION 23 – HEATING, VENTILATING AND AIR CONDITIONING (continued)

23 34 16	Centrifugal HVAC Fans	233416-1
23 35 33	Listed Kitchen Ventilation System Exhaust Ducts	233533-1
23 37 13	Diffusers, Registers and Grilles	233713-1
23 38 13	Commercial-Kitchen Hoods	233813-1
23 51 00	Breechings, Chimneys and Stacks	235100-1
23 51 13.11	Draft Control Fans.....	235113.11-1
23 52 16	Condensing Boiler.....	235216-1
23 64 26	Rotary-Screw Water Chillers.....	236426-1
23 72 00	Energy Recovery Ventilators	237200-1
23 74 13	Packaged Rooftop HVAC Units	237413-1
23 81 26	Split-Systems Air-Conditioners	238126-1
23 82 36	Finned-Tube Radiation Heaters	238236-1

DIVISION 26 – ELECTRICAL

26 05 00	Common Work Results for Electrical	260500-1
26 05 19	Low-Voltage Electrical Power Conductors and Cables	260519-1
26 05 23	Control-Voltage Electrical Power Cables	260523-1
26 05 26	Grounding and Bonding for Electrical Systems	260526-1
26 05 29	Hangers and Supports for Electrical Systems	260529-1
26 05 33	Raceway and Boxes for Electrical Systems	260533-1
26 05 44	Sleeves and Sleeve Seals for Electrical Raceways and Cabling	260544-1
26 05 48	Seismic Controls for Electrical Systems	260548-1
26 05 53	Electrical Identification	260553-1
26 09 43	Network Lighting Controls.....	260943-1
26 24 16	Panelboards	262416-1
26 27 26	Wiring Devices	262726-1
26 28 12	Safety Switches.....	262812-1
26 28 13	Fuses	262813-1
26 28 16	Enclosed Switches and Circuit Breakers	262816-1
26 51 00	Lighting.....	265100-1
26 51 19	LED Interior Lighting	265119-1

DIVISION 27 – COMMUNICATIONS

27 00 00	Communication	270000-1
27 05 00	Common Work Results for Communications	270500-1
27 05 26	Grounding and Bonding for Communications	270526-1
27 05 28	Pathways for Communications Systems.....	270528-1
27 05 36	Cable Tray for Communications	270536-1
27 10 00	Structured Cabling	271000-1
27 11 00	Communications Equipment Room Fittings.....	271100-1
27 13 00	Communications Backbone Cabling.....	271300-1
27 15 00	Communications Horizontal Cabling.....	271500-1
27 20 00	Data Communications.....	272000-1
27 21 00	Data Communications Network Equipment.....	272100-1
27 21 02	Data Systems.....	272102-1
27 66 00	Communications Equipment Rooms and Fittings.....	276600-1

<u>DIVISION NO.</u>	<u>TITLE</u>	<u>PAGE NO.</u>
DIVISION 28 – ELECTRONIC SAFETY AND SECURITY		
28 00 00	Electronic Safety and Security	280000-1
28 05 00	Common Work Results for Electronic Safety and Security.....	280500-1
28 05 13	Conductors and Cables for Electronic Safety and Security	280513-1
28 05 28	Pathways for Electronic Safety and Security	280528-1
28 31 01	Fire Alarm System.....	283101-1
DIVISION 31 – EARTHWORK		
31 10 00	Site Clearing.....	311000-1
31 20 01	Earthwork	312001-1
31 23 19	Dewatering	312319-1
31 31 17	Soil Conservation	313117-1
DIVISION 32 – EXTERIOR IMPROVEMENTS		
32 13 13	Bituminous Concrete Paving.....	321313-1
32 16 14	Concrete Site Work	321614-1
32 17 23	Pavement Markings	321723-1
32 31 13	Chain-link Fences	323113-1
32 92 00	Lawns and Grasses	329200-1
DIVISION 33 – UTILITIES		
33 05 00	Common Work for Utilities	330500-1
33 41 00	Storm Drainage	334100-1

SECTION 23 31 13 - METAL DUCTS

PART 1 - GENERAL

1.1 RELATED DOCUMENTS

- A. Drawings and general provisions of the Contract, including General and Supplementary Conditions and Division 1 Specification Sections, apply to this Section.

1.2 SUMMARY

- A. This Section includes metal ducts for supply, return, outside, and exhaust air-distribution systems in pressure classes from minus 2- to plus 10-inch wg (minus 500 to plus 2500 Pa). Metal ducts include the following:
 - 1. Rectangular ducts and fittings.
 - 2. Single-wall round spiral-seam ducts and formed fittings.
 - 3. Double-wall, round spiral-seam ducts and formed fittings.
- B. Related Sections include the following:
 - 1. Division 23 Section "Duct Accessories" for dampers, sound-control devices, duct-mounting access doors and panels, turning vanes, and flexible ducts.

1.3 DEFINITIONS

- A. NUSIG: National Uniform Seismic Installation Guidelines.

1.4 SYSTEM DESCRIPTION

- A. Duct system design, as indicated, has been used to select size and type of air-moving and -distribution equipment and other air system components.
- B. Changes to layout or configuration of duct system must be specifically approved in writing by Architect.
- C. Accompany requests for layout modifications with calculations showing that proposed layout will provide original design results without increasing system total pressure.

1.5 SUBMITTALS

- A. Shop Drawings: CAD-generated and drawn to 1/4 inch equals 1 foot. Show fabrication and installation details for metal ducts.
 - 1. Fabrication, assembly, and installation, including plans, elevations, sections, components, and attachments to other work.
 - 2. Duct layout indicating sizes and pressure classes.

3. Elevations of top and bottom of ducts.
 4. Dimensions of main duct runs from building grid lines.
 5. Fittings.
 6. Reinforcement and spacing.
 7. Seam and joint construction.
 8. Penetrations through fire-rated and other partitions.
 9. Equipment installation based on equipment being used on Project.
 10. Duct accessories, including access doors and panels.
 11. Hangers and supports, including methods for duct and building attachment, vibration isolation, and seismic restraints.
- B. Coordination Drawings: Reflected ceiling plans, drawn to scale, on which the following items are shown and coordinated with each other, based on input from installers of the items involved:
1. Ceiling suspension assembly members.
 2. Other systems installed in same space as ducts.
 3. Ceiling- and wall-mounting access doors and panels required to provide access to dampers and other operating devices.
 4. Ceiling-mounting items, including lighting fixtures, diffusers, grilles, speakers, sprinklers, access panels, and special moldings.
- C. Welding certificates.
- D. Field quality-control test reports.

1.6 QUALITY ASSURANCE

- A. Welding: Qualify procedures and personnel according to AWS D1.1, "Structural Welding Code-Steel," for hangers and supports and AWS D9.1, "Sheet Metal Welding Code," for duct joint and seam welding.
- B. NFPA Compliance:
1. NFPA 90A, "Installation of Air Conditioning and Ventilating Systems."
 2. NFPA 90B, "Installation of Warm Air Heating and Air Conditioning Systems."
- C. Comply with NFPA 96, "Ventilation Control and Fire Protection of Commercial Cooking Operations," Ch. 3, "Duct System," for range hood ducts, unless otherwise indicated.

PART 2 - PRODUCTS

2.1 MANUFACTURERS

- A. In other Part 2 articles where titles below introduce lists, the following requirements apply to product selection:
1. Available Manufacturers: Subject to compliance with requirements, manufacturers offering products that may be incorporated into the Work include, but are not limited to, manufacturers specified.

2. Manufacturers: Subject to compliance with requirements, provide products by one of the manufacturers specified.

2.2 SHEET METAL MATERIALS

- A. Comply with SMACNA's "HVAC Duct Construction Standards--Metal and Flexible" for acceptable materials, material thicknesses, and duct construction methods, unless otherwise indicated. Sheet metal materials shall be free of pitting, seam marks, roller marks, stains, discolorations, and other imperfections.
- B. Galvanized Sheet Steel: Lock-forming quality; complying with ASTM A 653/A 653M and having G90 (Z275) coating designation; ducts shall have mill-phosphatized finish for surfaces exposed to view.
- C. Carbon-Steel Sheets: ASTM A 366/A 366M, cold-rolled sheets; commercial quality; with oiled, matte finish for exposed ducts.
- D. Aluminum Sheets: ASTM B 209 (ASTM B 209M), alloy 3003, temper H14; with mill finish for concealed ducts and standard, 1-side bright finish for exposed ducts.
- E. Reinforcement Shapes and Plates: Galvanized-steel reinforcement where installed on galvanized sheet metal ducts.
- F. Tie Rods: Galvanized steel, 1/4-inch (6-mm) minimum diameter for lengths 36 inches (900 mm) or less; 3/8-inch (10-mm) minimum diameter for lengths longer than 36 inches (900 mm).

2.3 DUCT LINER

- A. Fibrous-Glass Liner: Comply with NFPA 90A or NFPA 90B and with NAIMA AH124.
 1. Manufacturers:
 - a. CertainTeed Corp.; Insulation Group.
 - b. Johns Manville International, Inc.
 - c. Knauf Fiber Glass GmbH.
 - d. Owens Corning.
 - e. Or approved equal.
 2. Materials: ASTM C 1071; surfaces exposed to air stream shall be coated to prevent erosion of glass fibers.
 - a. Thickness: 1 inch.
 - b. Thermal Conductivity (k-Value): 0.26 at 75 deg F (0.037 at 24 deg C) mean temperature.
 - c. Fire-Hazard Classification: Maximum flame-spread index of 25 and smoke-developed index of 50 when tested according to ASTM E 84.
 - d. Liner Adhesive: Comply with NFPA 90A or NFPA 90B and with ASTM C 916.
 - e. Mechanical Fasteners: Galvanized steel suitable for adhesive attachment, mechanical attachment, or welding attachment to duct without damaging liner when applied as recommended by manufacturer and without causing leakage in duct.
 - 1) Tensile Strength: Indefinitely sustain a 50-lb- (23-kg-) tensile, dead-load test perpendicular to duct wall.

- 2) Fastener Pin Length: As required for thickness of insulation and without projecting more than 1/8 inch (3 mm) into air stream.
- 3) Adhesive for Attaching Mechanical Fasteners: Comply with fire-hazard classification of duct liner system.

2.4 SEALANT MATERIALS

- A. Joint and Seam Sealants, General: The term "sealant" is not limited to materials of adhesive or mastic nature but includes tapes and combinations of open-weave fabric strips and mastics.
- B. Joint and Seam Tape: 2 inches (50 mm) wide; glass-fiber-reinforced fabric.
- C. Tape Sealing System: Woven-fiber tape impregnated with gypsum mineral compound and modified acrylic/silicone activator to react exothermically with tape to form hard, durable, airtight seal.
- D. Water-Based Joint and Seam Sealant: Flexible, adhesive sealant, resistant to UV light when cured, UL 723 listed, and complying with NFPA requirements for Class 1 ducts.
- E. Solvent-Based Joint and Seam Sealant: One-part, nonsag, solvent-release-curing, polymerized butyl sealant formulated with a minimum of 75 percent solids.
- F. Flanged Joint Mastic: One-part, acid-curing, silicone, elastomeric joint sealant complying with ASTM C 920, Type S, Grade NS, Class 25, Use O.
- G. Flange Gaskets: Butyl rubber or EPDM polymer with polyisobutylene plasticizer.

2.5 HANGERS AND SUPPORTS

- A. Building Attachments: Concrete inserts, powder-actuated fasteners, or structural-steel fasteners appropriate for construction materials to which hangers are being attached.
 1. Use powder-actuated concrete fasteners for standard-weight aggregate concretes or for slabs more than 4 inches (100 mm) thick.
 2. Exception: Do not use powder-actuated concrete fasteners for lightweight-aggregate concretes or for slabs less than 4 inches (100 mm) thick.
- B. Hanger Materials: Galvanized sheet steel or threaded steel rod.
 1. Hangers Installed in Corrosive Atmospheres: Electro-galvanized, all-thread rods or galvanized rods with threads painted with zinc-chromate primer after installation.
 2. Strap and Rod Sizes: Comply with SMACNA's "HVAC Duct Construction Standards--Metal and Flexible" for steel sheet width and thickness and for steel rod diameters.
 3. Galvanized-steel straps attached to aluminum ducts shall have contact surfaces painted with zinc-chromate primer.
- C. Duct Attachments: Sheet metal screws, blind rivets, or self-tapping metal screws; compatible with duct materials.
- D. Trapeze and Riser Supports: Steel shapes complying with ASTM A 36/A 36M.

1. Supports for Galvanized-Steel Ducts: Galvanized-steel shapes and plates.
2. Supports for Stainless-Steel Ducts: Stainless-steel support materials.
3. Supports for Aluminum Ducts: Aluminum support materials unless materials are electrolytically separated from ducts.

2.6 RECTANGULAR DUCT FABRICATION

- A. Fabricate ducts, elbows, transitions, offsets, branch connections, and other construction according to SMACNA's "HVAC Duct Construction Standards--Metal and Flexible" and complying with requirements for metal thickness, reinforcing types and intervals, tie-rod applications, and joint types and intervals.
 1. Lengths: Fabricate rectangular ducts in lengths appropriate to reinforcement and rigidity class required for pressure class.
 2. Deflection: Duct systems shall not exceed deflection limits according to SMACNA's "HVAC Duct Construction Standards--Metal and Flexible."
- B. Transverse Joints: Prefabricated slide-on joints and components constructed using manufacturer's guidelines for material thickness, reinforcement size and spacing, and joint reinforcement.
 1. Manufacturers:
 - a. Ductmate Industries, Inc.
 - b. Nexus Inc.
 - c. Ward Industries, Inc.
- C. Formed-On Flanges: Construct according to SMACNA's "HVAC Duct Construction Standards--Metal and Flexible," Figure 1-4, using corner, bolt, cleat, and gasket details.
 1. Manufacturers:
 - a. Ductmate Industries, Inc.
 - b. Lockformer.
 2. Duct Size: Maximum 30 inches (750 mm) wide and up to 2-inch wg (500-Pa) pressure class.
 3. Longitudinal Seams: Pittsburgh lock sealed with noncuring polymer sealant.
- D. Cross Breaking or Cross Beading: Cross break or cross bead duct sides 19 inches (480 mm) and larger and 0.0359 inch (0.9 mm) thick or less, with more than 10 sq. ft. (0.93 sq. m) of non-braced panel area unless ducts are lined.

2.7 APPLICATION OF LINER IN RECTANGULAR DUCTS

- A. Adhere a single layer of indicated thickness of duct liner with at least 90 percent adhesive coverage at liner contact surface area. Attaining indicated thickness with multiple layers of duct liner is prohibited.
- B. Apply adhesive to transverse edges of liner facing upstream that do not receive metal nosing.
- C. Butt transverse joints without gaps and coat joint with adhesive.

- D. Fold and compress liner in corners of rectangular ducts or cut and fit to ensure butted-edge overlapping.
- E. Do not apply liner in rectangular ducts with longitudinal joints, except at corners of ducts, unless duct size and standard liner product dimensions make longitudinal joints necessary.
- F. Apply adhesive coating on longitudinal seams in ducts with air velocity of 2500 fpm (12.7 m/s).
- G. Secure liner with mechanical fasteners 4 inches (100 mm) from corners and at intervals not exceeding 12 inches (300 mm) transversely; at 3 inches (75 mm) from transverse joints and at intervals not exceeding 18 inches (450 mm) longitudinally.
- H. Secure transversely oriented liner edges facing the airstream with metal nosings that have either channel or "Z" profiles or are integrally formed from duct wall. Fabricate edge facings at the following locations:
 - 1. Fan discharges.
 - 2. Intervals of lined duct preceding unlined duct.
 - 3. Upstream edges of transverse joints in ducts where air velocities are greater than 2500 fpm (12.7 m/s) or where indicated.
- I. Terminate inner ducts with build outs attached to fire-damper sleeves, dampers, turning vane assemblies, or other devices. Fabricated build outs (metal hat sections) or other build out means are optional; when used, secure build outs to duct walls with bolts, screws, rivets, or welds.

2.8 ROUND DUCT AND FITTING FABRICATION (WHERE INDICATED ON DRAWINGS)

- A. Round, Longitudinal- and Spiral Lock-Seam Ducts: Fabricate exhaust air ducts of aluminum according to SMACNA's "HVAC Duct Construction Standards--Metal and Flexible."
 - 1. Manufacturers:
 - a. McGill AirFlow Corporation.
 - b. SEMCO Incorporated.
- B. Duct Joints:
 - 1. Ducts up to 20 Inches (500 mm) in Diameter: Interior, center-beaded slip coupling, sealed before and after fastening, attached with sheet metal screws.
 - 2. Ducts 21 to 72 Inches (535 to 1830 mm) in Diameter: Three-piece, gasketed, flanged joint consisting of two internal flanges with sealant and one external closure band with gasket.
 - 3. Round Ducts: Prefabricated connection system consisting of double-lipped, EPDM rubber gasket. Manufacture ducts according to connection system manufacturer's tolerances.
 - a. Manufacturers:
 - 1) Ductmate Industries, Inc.
 - 2) Lindab Inc.
- C. 90-Degree Tees and Laterals and Conical Tees: Fabricate to comply with SMACNA's "HVAC Duct Construction Standards--Metal and Flexible," with metal thicknesses specified for longitudinal-seam straight ducts.

- D. Diverging-Flow Fittings: Fabricate with reduced entrance to branch taps and with no excess material projecting from fitting onto branch tap entrance.
- E. Fabricate elbows using die-formed, gored, pleated, or mitered construction. Bend radius of die-formed, gored, and pleated elbows shall be 1-1/2 times duct diameter. Unless elbow construction type is indicated, fabricate elbows as follows:
1. Mitered-Elbow Radius and Number of Pieces: Welded construction complying with SMACNA's "HVAC Duct Construction Standards--Metal and Flexible," unless otherwise indicated.
 2. Round Mitered Elbows: Welded construction with the following metal thickness for pressure classes from minus 2- to plus 2-inch wg (minus 500 to plus 500 Pa):
 - a. Ducts 3 to 36 Inches (75 to 915 mm) in Diameter: 0.034 inch (0.85 mm).
 - b. Ducts 37 to 50 Inches (940 to 1270 mm) in Diameter: 0.040 inch (1.0 mm).
 3. Round Mitered Elbows: Welded construction with the following metal thickness for pressure classes from 2- to 10-inch wg (500 to 2500 Pa):
 - a. Ducts 3 to 26 Inches (75 to 660 mm) in Diameter: 0.034 inch (0.85 mm).
 - b. Ducts 27 to 50 Inches (685 to 1270 mm) in Diameter: 0.040 inch (1.0 mm).
 4. Round Elbows 8 Inches (200 mm) and Less in Diameter: Fabricate die-formed elbows for 45- and 90-degree elbows and pleated elbows for 30, 45, 60, and 90 degrees only. Fabricate nonstandard bend-angle configurations or nonstandard diameter elbows with gored construction.
 5. Round Elbows 9 through 14 Inches (225 through 355 mm) in Diameter: Fabricate gored or pleated elbows for 30, 45, 60, and 90 degrees unless space restrictions require mitered elbows. Fabricate nonstandard bend-angle configurations or nonstandard diameter elbows with gored construction.
 6. Die-Formed Elbows for Sizes through 8 Inches (200 mm) in Diameter and All Pressures 0.040 inch (1.0 mm) thick with 2-piece welded construction.
 7. Round Gored-Elbow Metal Thickness: Same as non-elbow fittings specified above.
 8. Pleated Elbows for Sizes through 14 Inches (355 mm) in Diameter and Pressures through 10-Inch wg (2500 Pa): 0.022 inch (0.55 mm).

2.9 DOUBLE-WALL DUCT AND FITTING FABRICATION (WHERE INDICATED ON DRAWINGS)

- A. Manufacturers:
1. Lindab Inc.
 2. McGill AirFlow Corporation.
 3. SEMCO Incorporated.
 4. Or approved equal.
- B. Ducts: Fabricate double-wall (insulated) ducts with an outer shell and an inner duct. Dimensions indicated are for inner ducts.
1. Outer Shell: Base metal thickness on outer-shell dimensions. Fabricate outer-shell lengths 2 inches (50 mm) longer than inner duct and insulation and in metal thickness specified for single-wall duct.
 2. Insulation: 1-inch- (25-mm-) thick fibrous glass, unless otherwise indicated. Terminate insulation where double-wall duct connects to single-wall duct or uninsulated components and reduce outer shell diameter to inner duct diameter.
 - a. Thermal Conductivity (k-Value): 0.26 at 75 deg F (0.037 at 24 deg C) mean temperature.

3. Solid Inner Ducts: Refer to drawings for areas with solid inner walls. Use the following sheet metal thicknesses and seam construction:
 - a. Ducts 3 to 8 Inches (75 to 200 mm) in Diameter: 0.019 inch (0.5 mm) with standard spiral-seam construction.
 - b. Ducts 9 to 42 Inches (225 to 1070 mm) in Diameter: 0.019 inch (0.5 mm) with single-rib spiral-seam construction.
 4. Perforated Inner Ducts: Refer to drawings for areas with perforated inner walls. Fabricate with 0.028-inch-0.7-mm- thick sheet metal having 3/32-inch- (2.4-mm-) diameter perforations, with overall open area of 23 percent.
 5. Maintain concentricity of inner duct to outer shell by mechanical means. Prevent dislocation of insulation by mechanical means.
- C. Fittings: Fabricate double-wall (insulated) fittings with an outer shell and an inner duct.
1. Solid Inner Ducts: Use the following sheet metal thicknesses:
 - a. Ducts 3 to 34 Inches (75 to 865 mm) in Diameter: 0.028 inch (0.7 mm).
 - b. Ducts 35 to 58 Inches (890 to 1475 mm) in Diameter: 0.034 inch (0.85 mm).
 2. Perforated Inner Ducts: Fabricate with 0.028-inch- (0.7-mm-) thick sheet metal having 3/32-inch- (2.4-mm-) diameter perforations, with overall open area of 23 percent.

PART 3 - EXECUTION

3.1 DUCT APPLICATIONS

- A. Static-Pressure Classes: Unless otherwise indicated, construct ducts according to the following:
 1. Return Ducts (Negative Pressure): 2-inch wg.
 2. Exhaust Ducts (Negative Pressure): 2-inch wg.
- B. All ducts shall be galvanized steel except exhaust air duct for chemical fume hood shall be aluminum construction.

3.2 DUCT INSTALLATION

- A. Construct and install ducts according to SMACNA's "HVAC Duct Construction Standards--Metal and Flexible," unless otherwise indicated.
- B. Install round ducts in lengths not less than 12 feet (3.7 m) unless interrupted by fittings.
- C. Install ducts with fewest possible joints.
- D. Install fabricated fittings for changes in directions, size, and shape and for connections.
- E. Install couplings tight to duct wall surface with a minimum of projections into duct. Secure couplings with sheet metal screws. Install screws at intervals of 12 inches (300 mm), with a minimum of 3 screws in each coupling.

- F. Install ducts, unless otherwise indicated, vertically and horizontally and parallel and perpendicular to building lines; avoid diagonal runs.
- G. Install ducts close to walls, overhead construction, columns, and other structural and permanent enclosure elements of building.
- H. Install ducts with a clearance of 1 inch (25 mm), plus allowance for insulation thickness.
- I. Conceal ducts from view in finished spaces. Do not encase horizontal runs in solid partitions unless specifically indicated.
- J. Coordinate layout with suspended ceiling, fire- and smoke-control dampers, lighting layouts, and similar finished work.
- K. Seal all joints and seams. Apply sealant to male end connectors before insertion, and afterward to cover entire joint and sheet metal screws.
- L. Electrical Equipment Spaces: Route ducts to avoid passing through transformer vaults and electrical equipment spaces and enclosures.
- M. Non-Fire-Rated Partition Penetrations: Where ducts pass through interior partitions and exterior walls and are exposed to view, conceal spaces between construction openings and ducts or duct insulation with sheet metal flanges of same metal thickness as ducts. Overlap openings on 4 sides by at least 1-1/2 inches (38 mm).
- N. Fire-Rated Partition Penetrations: Where ducts pass through interior partitions and exterior walls, install appropriately rated fire dampers, sleeves, and firestopping sealant. Fire and smoke dampers are specified in Division 23 Section "Duct Accessories." Firestopping materials and installation methods are specified in Division 7 Section "Through-Penetration Firestop Systems."
- O. Install ducts with hangers and braces designed to withstand, without damage to equipment, seismic force required by applicable building codes. Refer to SMACNA's "Seismic Restraint Manual: Guidelines for Mechanical Systems."
- P. Protect duct interiors from the elements and foreign materials until building is enclosed. Follow SMACNA's "Duct Cleanliness for New Construction."
- Q. Paint interiors of metal ducts, that do not have duct liner, for 24 inches (600 mm) upstream of registers and grilles. Apply one coat of flat, black, latex finish coat over a compatible galvanized-steel primer. Paint materials and application requirements are specified in Division 9 painting Sections.

3.3 SEAM AND JOINT SEALING

- A. Seal duct seams and joints according to SMACNA's "HVAC Duct Construction Standards--Metal and Flexible" for duct pressure class indicated.
 - 1. For pressure classes lower than 2-inch wg (500 Pa), seal transverse joints.
- B. Seal ducts before external insulation is applied.

3.4 HANGING AND SUPPORTING

- A. Support horizontal ducts within 24 inches (600 mm) of each elbow and within 48 inches (1200 mm) of each branch intersection.
- B. Support vertical ducts at maximum intervals of 16 feet (5 m) and at each floor.
- C. Install upper attachments to structures with an allowable load not exceeding one-fourth of failure (proof-test) load.
- D. Install concrete inserts before placing concrete.
- E. Install powder-actuated concrete fasteners after concrete is placed and completely cured.
 - 1. Do not use powder-actuated concrete fasteners for lightweight-aggregate concretes or for slabs less than 4 inches (100 mm) thick.

3.5 CONNECTIONS

- A. Make connections to equipment with flexible connectors according to Division 23 Section "Duct Accessories."
- B. Comply with SMACNA's "HVAC Duct Construction Standards--Metal and Flexible" for branch, outlet and inlet, and terminal unit connections.

3.6 FIELD QUALITY CONTROL

- A. Perform the following field tests and inspections according to SMACNA's "HVAC Air Duct Leakage Test Manual" and prepare test reports:
 - 1. Disassemble, reassemble, and seal segments of systems to accommodate leakage testing and for compliance with test requirements.
 - 2. Conduct tests at static pressures equal to maximum design pressure of system or section being tested. If pressure classes are not indicated, test entire system at maximum system design pressure. Do not pressurize systems above maximum design operating pressure. Give seven days' advance notice for testing.
 - 3. Maximum Allowable Leakage: Comply with requirements for Leakage Class 3 for round ducts, Leakage Class 12 for rectangular ducts in pressure classes lower than and equal to 2-inch wg (500 Pa) (both positive and negative pressures), and Leakage Class 6 for pressure classes from 2- to 10-inch wg (500 to 2500 Pa).
 - 4. Remake leaking joints and retest until leakage is equal to or less than maximum allowable.

3.7 CLEANING NEW SYSTEMS

- A. Mark position of dampers and air-directional mechanical devices before cleaning and perform cleaning before air balancing.
- B. Use service openings, as required, for physical and mechanical entry and for inspection.


1. Create other openings to comply with duct standards.
 2. Disconnect flexible ducts as needed for cleaning and inspection.
 3. Remove and reinstall ceiling sections to gain access during the cleaning process.
- C. Vent vacuuming system to the outside. Include filtration to contain debris removed from HVAC systems and locate exhaust down wind and away from air intakes and other points of entry into building.
- D. Clean the following metal duct systems by removing surface contaminants and deposits:
1. Air outlets and inlets (registers, grilles, and diffusers).
 2. Supply, return, and exhaust fans including fan housings, plenums (except ceiling supply and return plenums), scrolls, blades or vanes, shafts, baffles, dampers, and drive assemblies.
 3. Air-handling unit internal surfaces and components including mixing box, coil section, air wash systems, spray eliminators, condensate drain pans, humidifiers and dehumidifiers, filters and filter sections, and condensate collectors and drains.
 4. Coils and related components.
 5. Return-air ducts, dampers, and actuators except in ceiling plenums and mechanical equipment rooms.
 6. Supply-air ducts, dampers, actuators, and turning vanes.
- E. Mechanical Cleaning Methodology:
1. Clean metal duct systems using mechanical cleaning methods that extract contaminants from within duct systems and remove contaminants from building.
 2. Use vacuum-collection devices that are operated continuously during cleaning. Connect vacuum device to downstream end of duct sections so areas being cleaned are under negative pressure.
 3. Use mechanical agitation to dislodge debris adhered to interior duct surfaces without damaging integrity of metal ducts or duct accessories.
- F. Cleanliness Verification:
1. Visually inspect metal ducts for contaminants.
 2. Where contaminants are discovered, re-clean and reinspect ducts.

3.8 CLEANING EXISTING SYSTEMS


- A. Use service openings, as required, for physical and mechanical entry and for inspection.
1. Use existing service openings where possible.
 2. Create other openings to comply with duct standards.
 3. Disconnect flexible ducts as needed for cleaning and inspection.
 4. Remove and reinstall ceiling sections to gain access during the cleaning process.
- B. Mark position of dampers and air-directional mechanical devices before cleaning and restore to their marked position on completion.
- C. Particulate Collection and Odor Control:

1. When venting vacuuming system inside the building, use HEPA filtration with 99.97 percent collection efficiency for 0.3-micron size (or larger) particles.
 2. When venting vacuuming system to the outside, use filtration to contain debris removed from HVAC system, and locate exhaust down wind and away from air intakes and other points of entry into building.
- D. Clean the following metal duct systems by removing surface contaminants and deposits:
1. Air outlets and inlets (registers, grilles, and diffusers).
 2. Supply, return, and exhaust fans including fan housings, plenums (except ceiling supply and return plenums), scrolls, blades or vanes, shafts, baffles, dampers, and drive assemblies.
 3. Air-handling unit internal surfaces and components including mixing box, coil section, air wash systems, spray eliminators, condensate drain pans, humidifiers and dehumidifiers, filters and filter sections, and condensate collectors and drains.
 4. Coils and related components.
 5. Return-air ducts, dampers, and actuators except in ceiling plenums and mechanical equipment rooms.
 6. Supply-air ducts, dampers, actuators, and turning vanes.
 7. Dedicated exhaust and ventilation components and makeup air systems.
 8. Submit photo documentation indicating effectiveness of duct cleaning, before and after cleaning.
- E. Mechanical Cleaning Methodology:
1. Clean metal duct systems using mechanical cleaning methods that extract contaminants from within duct systems and remove contaminants from building.
 2. Use vacuum-collection devices that are operated continuously during cleaning. Connect vacuum device to downstream end of duct sections so areas being cleaned are under negative pressure.
 3. Use mechanical agitation to dislodge debris adhered to interior duct surfaces without damaging integrity of metal ducts or duct accessories.
 4. Clean coils and coil drain pans according to NADCA 1992. Keep drain pan operational. Rinse coils with clean water to remove latent residues and cleaning materials; comb and straighten fins.
 5. Provide operative drainage system for wash down procedures.
 6. Biocidal Agents and Coatings: Apply biocidal agents if fungus is present. Apply biocidal agents according to manufacturer's written instructions after removal of surface deposits and debris.
- F. Cleanliness Verification:
1. Verify cleanliness after mechanical cleaning and before application of treatment, including biocidal agents and protective coatings.
 2. Visually inspect metal ducts for contaminants.
 3. Where contaminants are discovered, re-clean and re-inspect ducts.
- G. Verification of Coil Cleaning: Cleaning must restore coil pressure drop to within 10 percent of pressure drop measured when coil was first installed. If original pressure drop is not known, coil will be considered clean only if it is free of foreign matter and chemical residue, based on thorough visual inspection.

END OF SECTION 233113

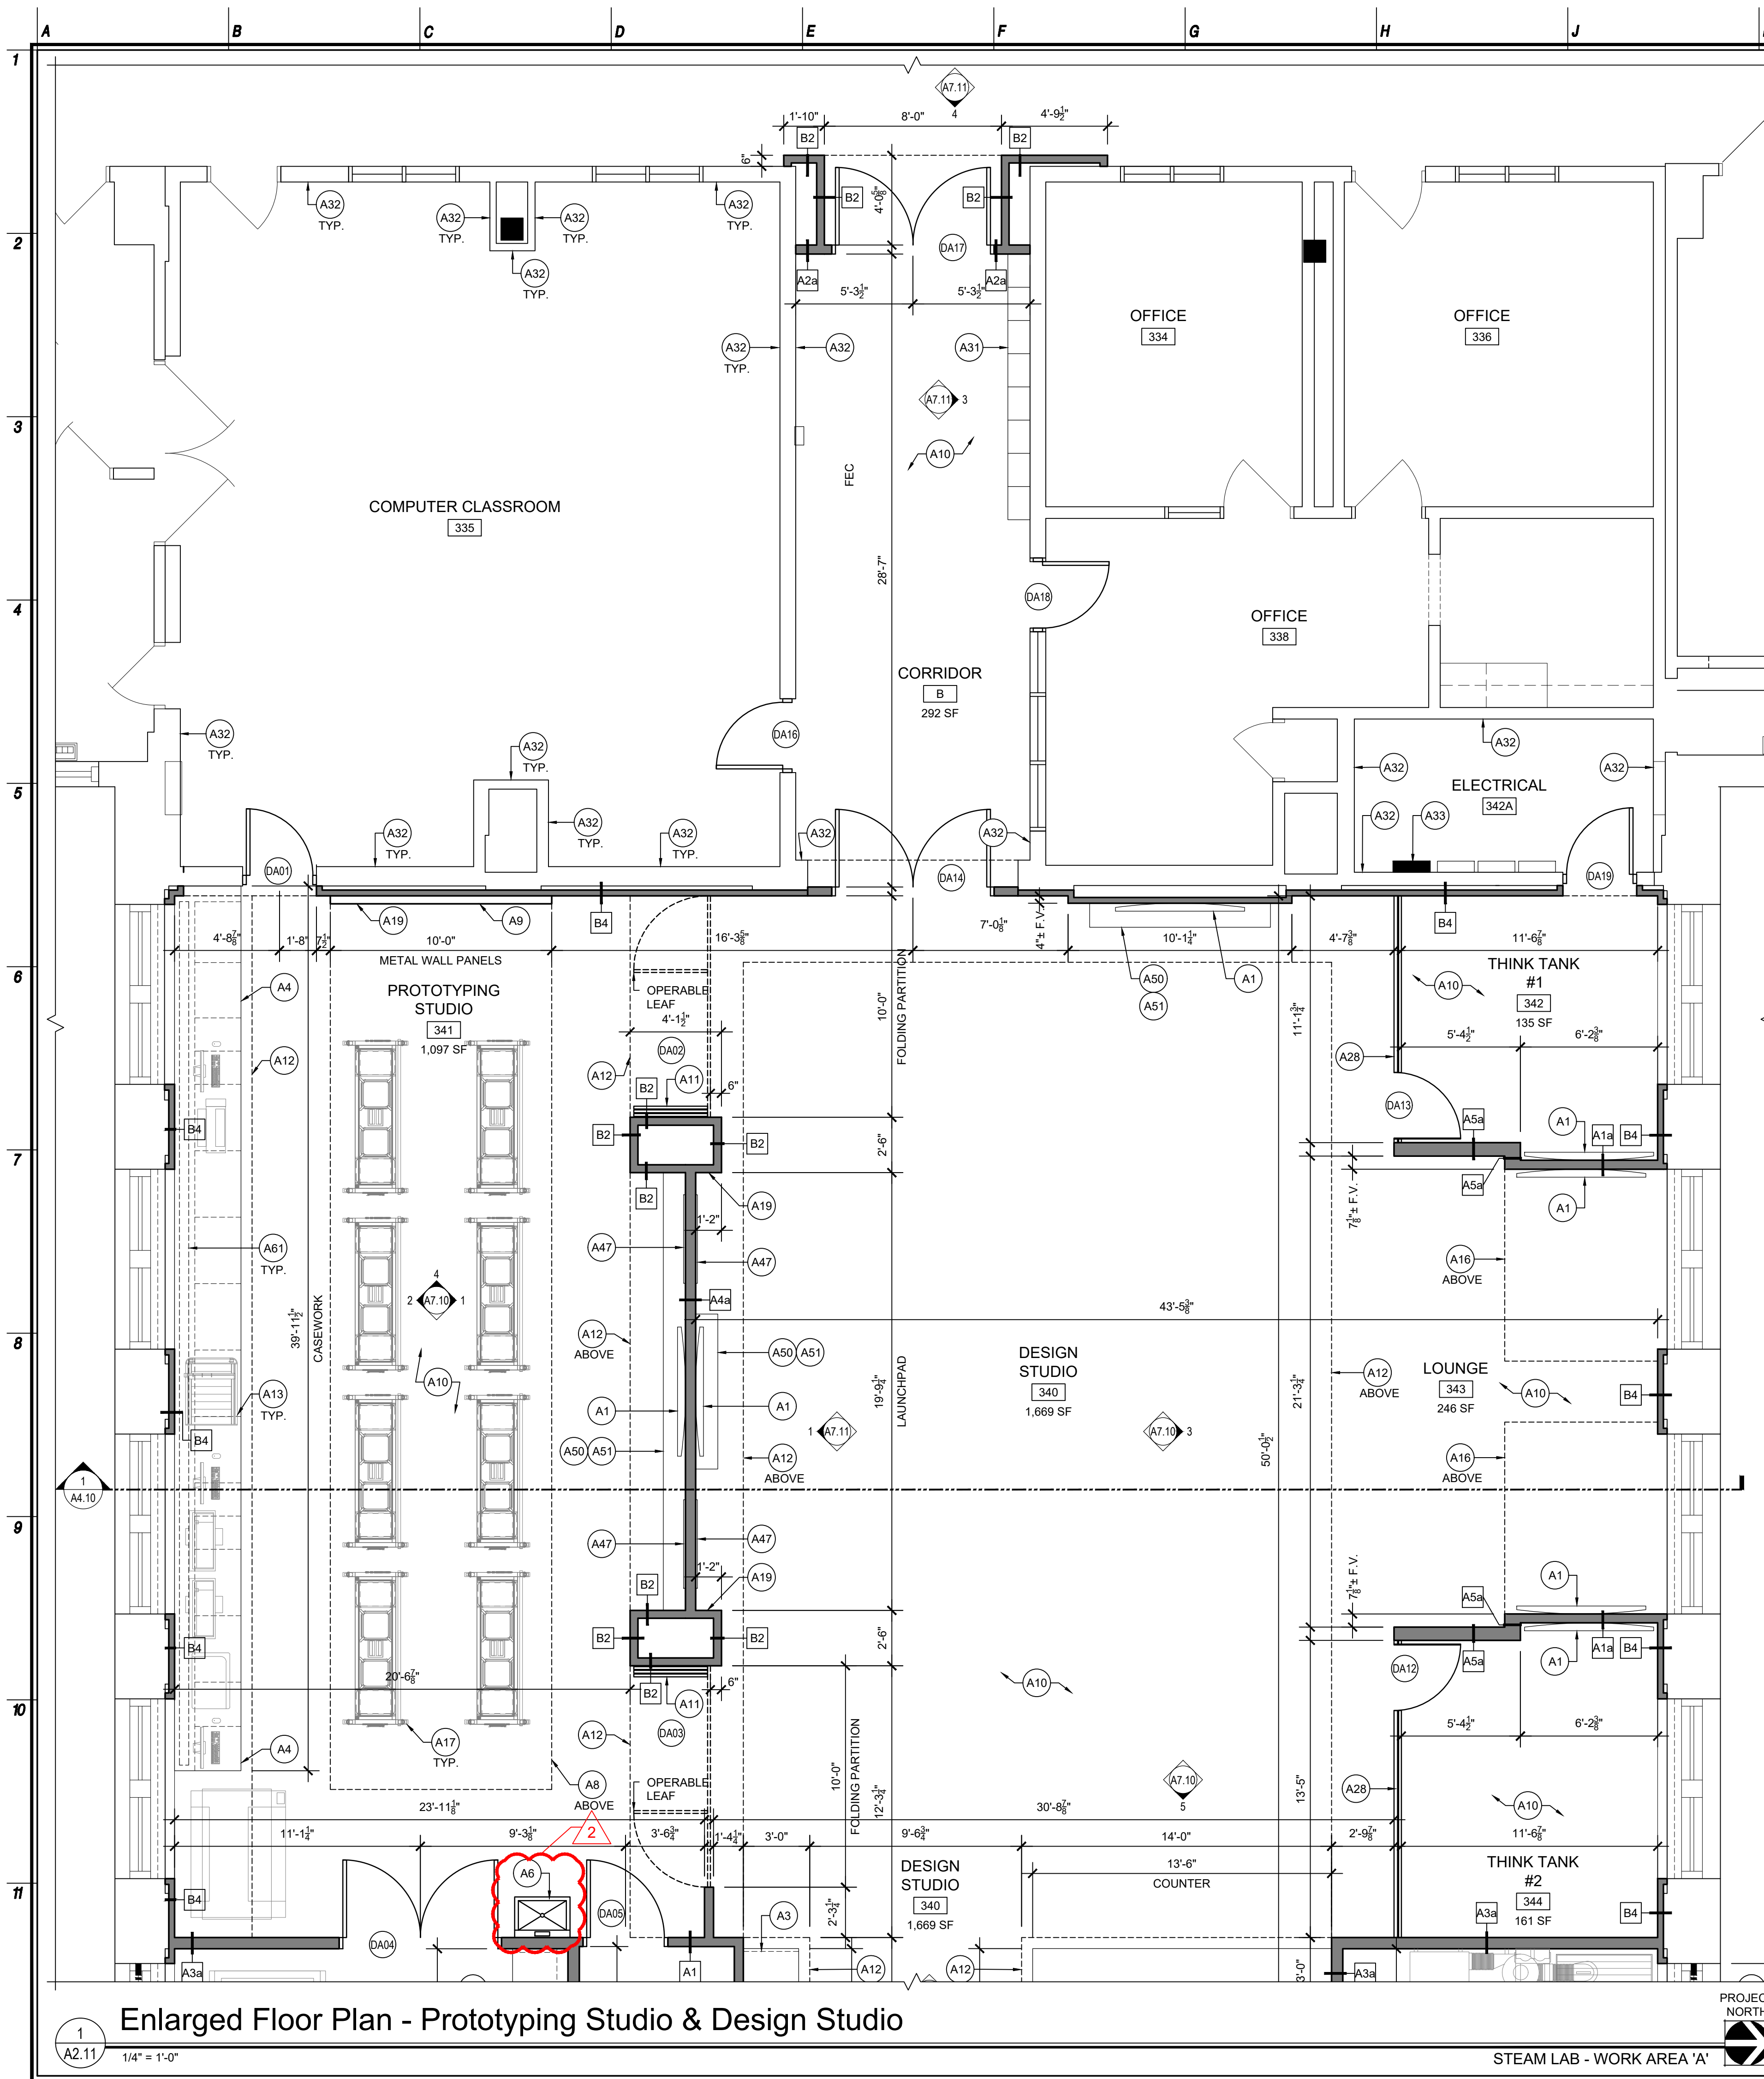


Enlarged Floor Plan - Prototyping Studio & Design Studio

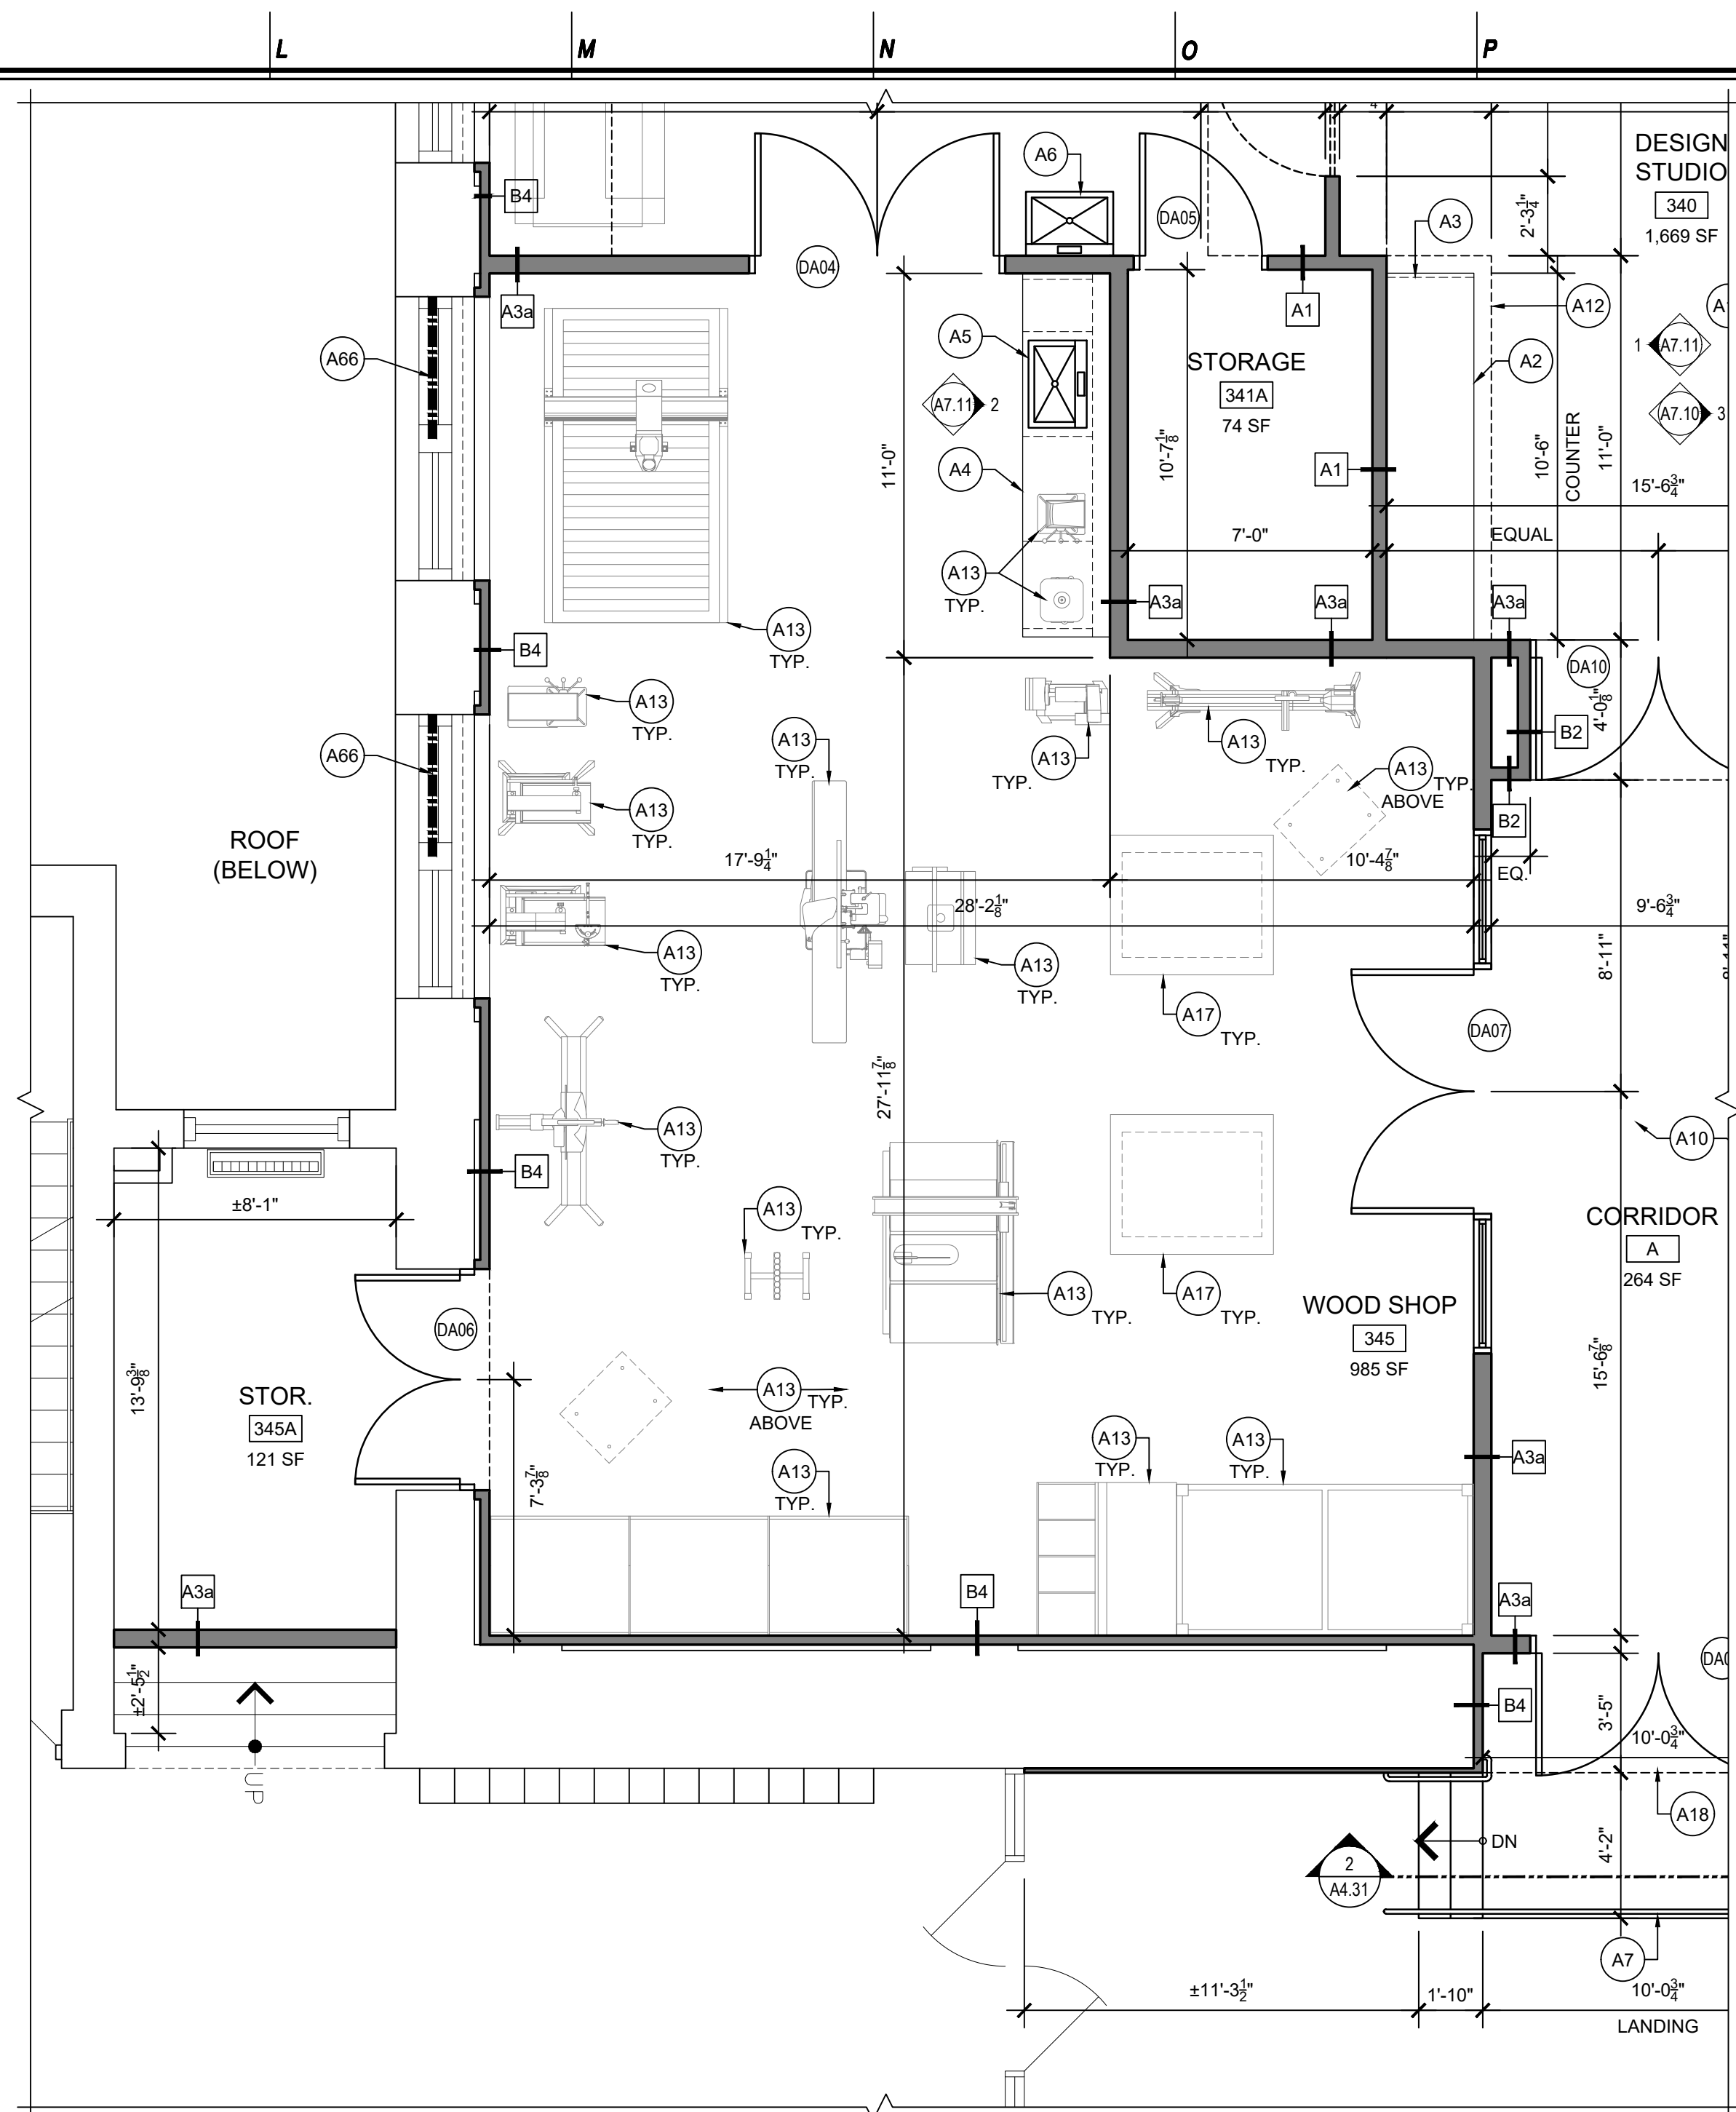

Enlarged Floor Plan - Wood Shop

REFER TO GENERAL NOTES ON SHEET A2.01
SYMBOL DENOTES WALL TYPES, REFER TO PARTITION TYPE SHEET A8.01
X# SYMBOL INDICATES CONSTRUCTION KEY NOTE REFER TO CONSTRUCTION KEY NOTES ON SHEET A2.01

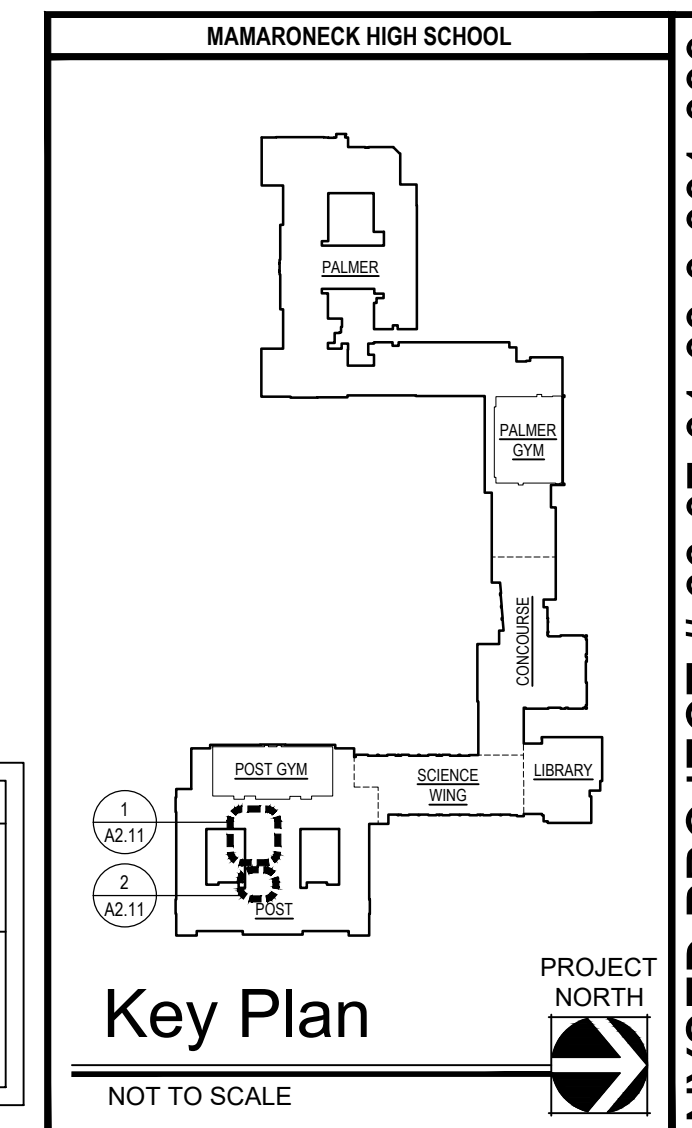

KEY PLAN
NOT TO SCALE

MICHAEL J. MCGOVERN, R.A.
REGISTERED ARCHITECT
License No. 022257-1

Revisions:	
#	ISSUE FOR BID
1	BID ADDENDUM NO. 1 12/10/21
2	BID ADDENDUM NO. 2 12/23/21


UNAUTHORIZED ALTERATIONS OR ADDITIONS TO THIS DOCUMENT IS A VIOLATION OF SECTION 2209 OF THE NEW YORK STATE EDUCATION LAW. THESE DOCUMENTS REMAIN THE EXCLUSIVE PROPERTY OF THE ENGINEER, AND MAY NOT BE USED FOR ANY PURPOSE WHATSOEVER WITHOUT THE WRITTEN CONSENT OF THE ENGINEER.

LAN ASSOCIATES
engineering • planning • architecture • surveying
252 MAIN STREET, GOSHEN, NEW YORK 10924 (845)818-0350


NYSED PROJECT # 66-07-01-03-0-001-039

ENLARGED FLOOR PLANS - WORK AREA 'A'
CAPITAL IMPROVEMENTS AT
MAMARONECK HIGH SCHOOL
MAMARONECK UNION FREE SCHOOL DISTRICT
1000 BOSTON POST ROAD, MAMARONECK, NY 10543
Job No. 4.1092.72.6
File No. 10927206A210


A2.11

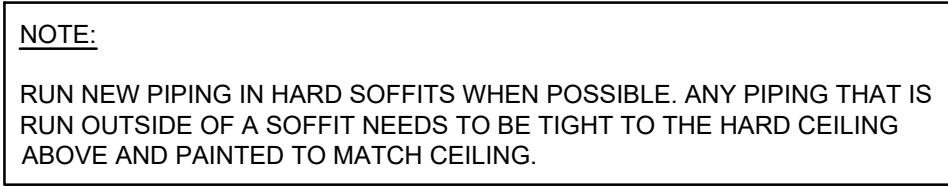

NORTH

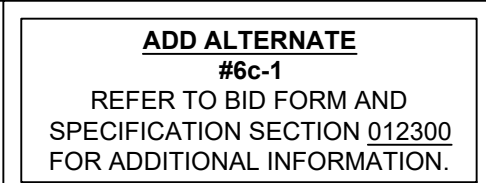

WASTE/VENTING

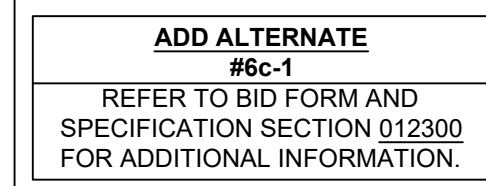

DOMESTIC WATER



Revisions:

	ISSUE FOR BID 11/23/2021
	BID ADDENDUM NO. 12/10/21
	BID ADDENDUM NO. 12/23/21

UNAUTHORIZED ALTERATIONS OR ADDITIONS TO THIS DOCUMENT IS A VIOLATION OF SECTION 7028 OF THE NEW YORK STATE EDUCATION LAW. THESE DOCUMENTS REMAIN THE EXCLUSIVE PROPERTY OF THE ENGINEER, AND MAY NOT BE USED FOR ANY PURPOSE WHATSOEVER WITHOUT THE WRITTEN CONSENT OF THE ENGINEER.


252 MAIN STREET, GOSHEN, NEW YORK 10924 (845)615-0350

<p>WORK AREA A: STEAM LAB PROPOSED PLUMBING PLANS</p>	<p>CAPITAL IMPROVEMENTS AT MAMARONECK HIGH SCHOOL MAMARONECK UNION FREE SCHOOL DISTRICT 1000 BOSTON POST ROAD, MAMARONECK, NY 10543</p>
<p>Job No. 4,1092.72.6</p>	
<p>File No. 10927206P211-114</p>	
<p>P1.12</p>	

P1.12


2

PLUMBING FIXTURE SCHEDULE - STEAM LAB													
NUMBER	FIXTURE	MANUFACTURER	TYPE & MODEL No.	TRIM No.	SUPPLY PIPE No.	TRAP No.	SUPPORT No.	PIPE SIZES					DESCRIPTION
								TRAP	WASTE	VENT	DCW	DHW	
P-1	SINK (WOOD SHOP)	KOHLER	K-31466-1	KOHLER K-24982	McGUIRE LF158	McGUIRE 8902C	J.R. SMITH 0700-17M	1-1/4" x 1-1/2"	1-1/2"	1-1/2"	1/2"	1/2"	TOP MOUNT PROLOGUE K-31466-1, 33x16x9 STAINLESS STEEL. PROVIDE SINGLE HANDLE KOHLER PURIST K-24982-VS SINGLE HOLE STAINLESS. PROVIDE GRID STRAINER, TRAP ETC. PROVIDE WATTS TMV MODEL #LFMMV-US-M1.
P-2	SINK (METAL SHOP) (PROTO TYPING)	ADVANCED TABCO	4-41-24	AM STANDARD 7293-172H	McGUIRE LF158	McGUIRE 8902C	J.R. SMITH 0700-17M	1-1/4" x 1-1/2"	1-1/2"	1-1/2"	1/2"	1/2"	FLOOR MOUNT SINK ADVANCE TABCO SINGLE BOWL 4-41-24 STAINLESS STEEL. PROVIDE AMERICAN STANDARD WALL MOUNT TWO HANDLE FAUCET 7293.172H. PROVIDE WATTS TMV MODEL #LFMMV-US-M1.
P-3	SAFETY EYE WASH (METAL SHOP)	GUARDIAN	G1848LH-L								1/2"	1/2"	EYEWASH, WALL MOUNTED, AUTOFLOW 90° SWING-DOWN. PROVIDE G3600LF THERMOSTATIC MIXING VALVE, TWO GS-PLUS SPRAY HEADS w/ FLIP TOP DUST COVER AND FILTER.

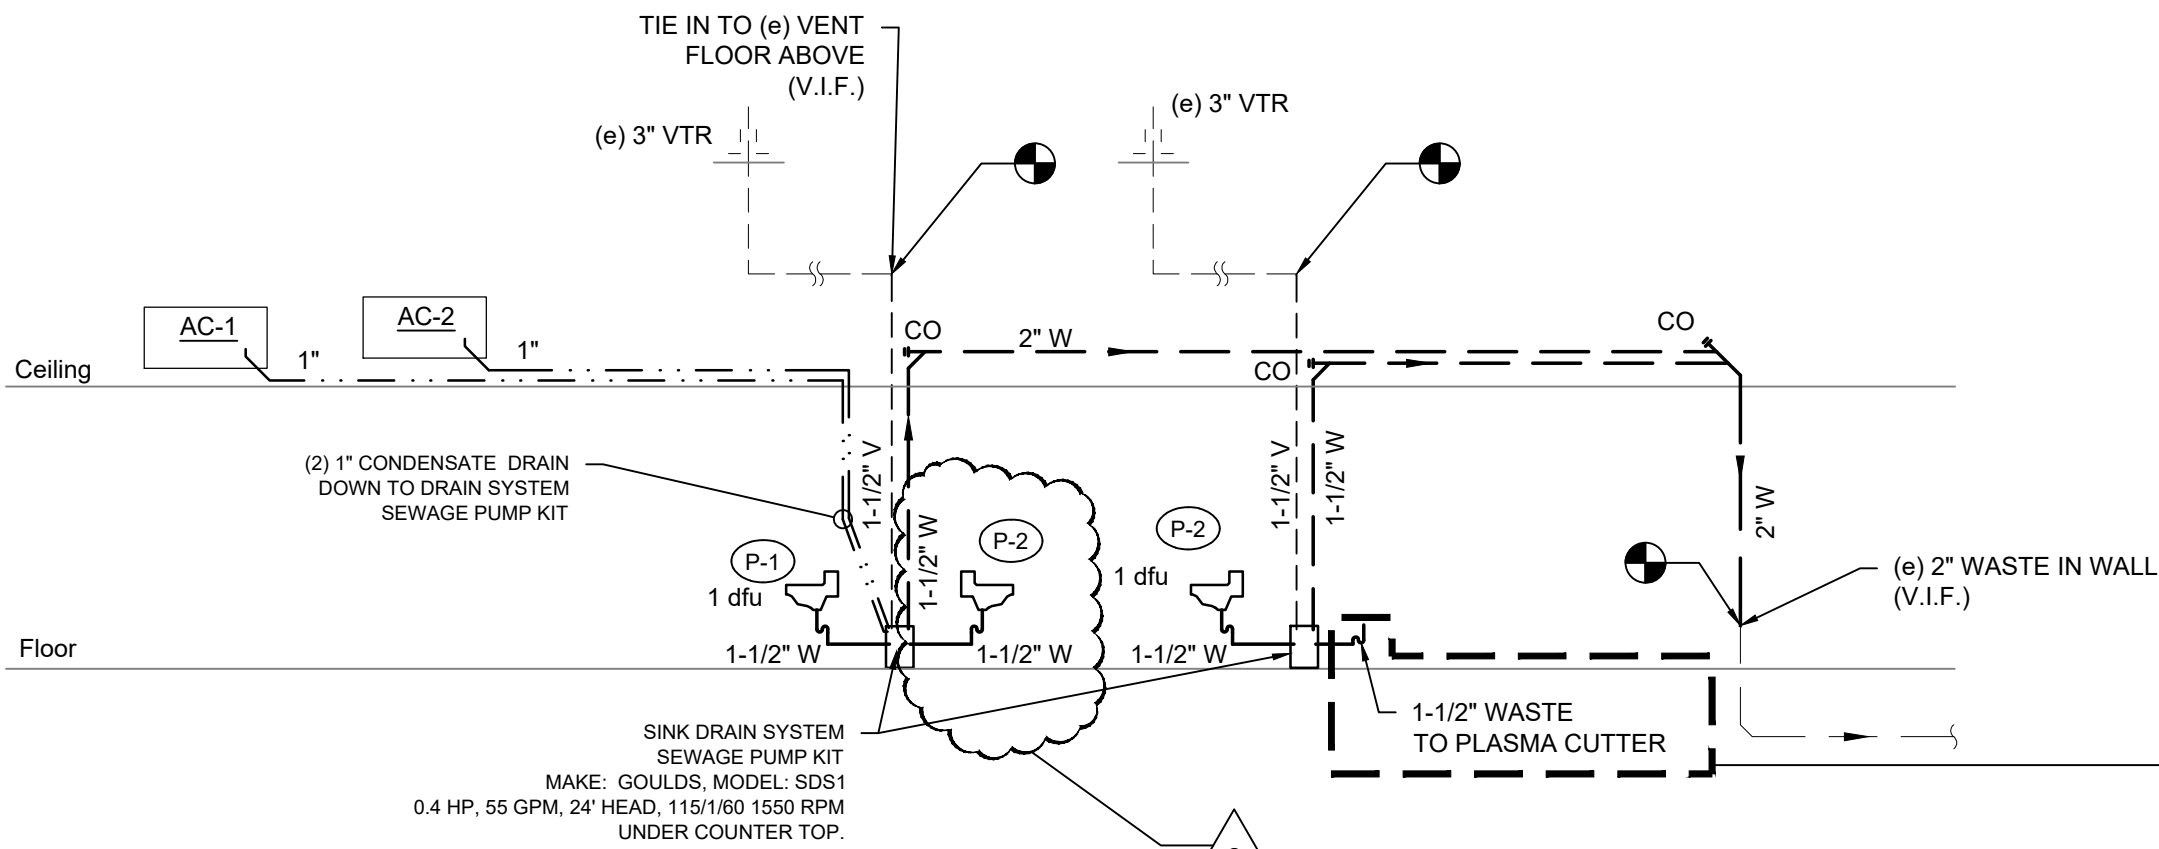

1
P1.13
N.T.S.
WASTE/VENT PIPING RISER DIAGRAM

ADD ALTERNATE #6c-1
REFER TO BID FORM AND SPECIFICATION SECTION 012300 FOR ADDITIONAL INFORMATION.

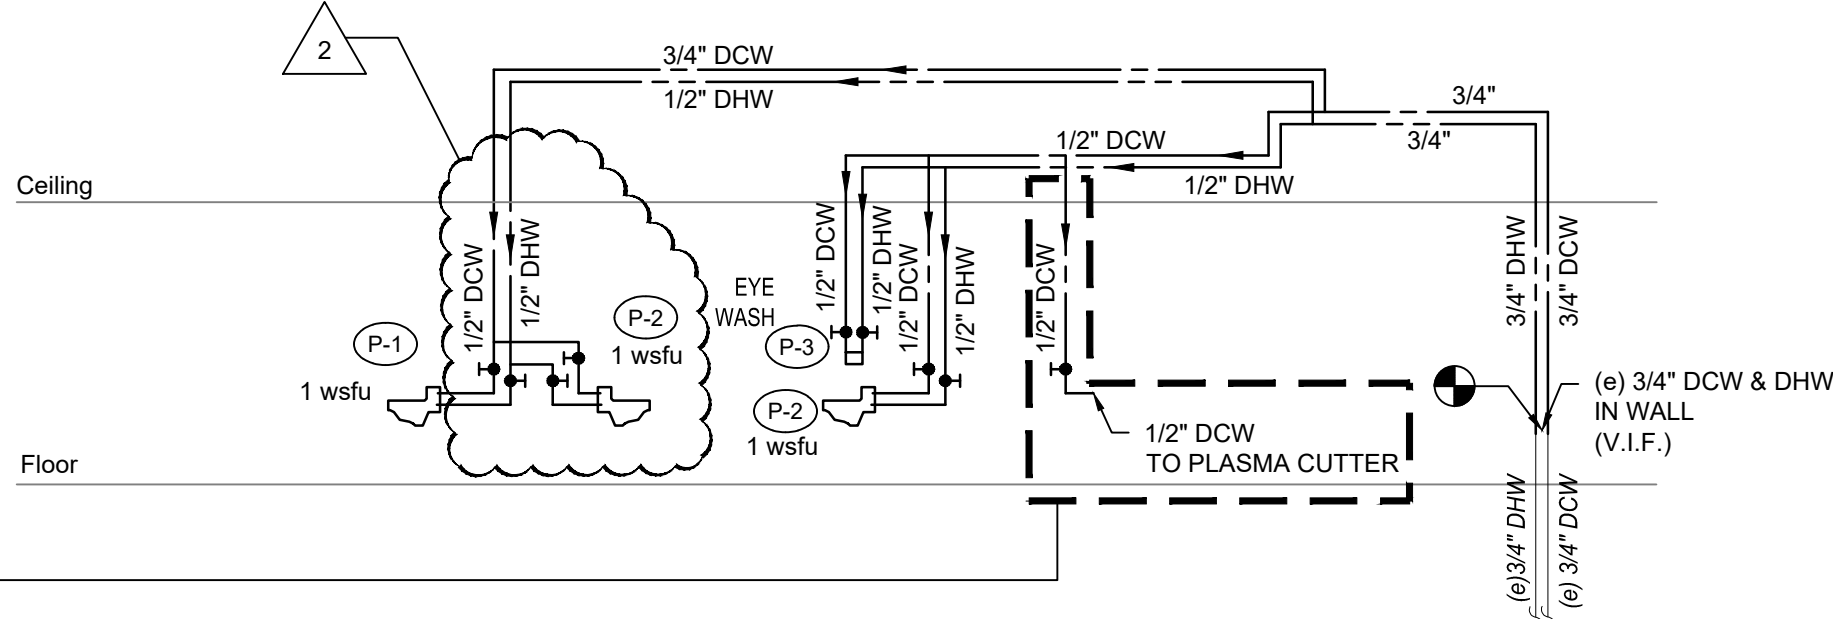


2
P1.13
N.T.S.
DOMESTIC WATER PIPING RISER DIAGRAM

Plumbing Legend	
Domestic Cold Water	_____
Domestic Hot Water 110°F	_____
Domestic Hot Water Return	_____
Domestic Hot Water 140°F	_____
Sanitary Waste	_____
Sanitary Vent	_____
Condensate Drain	_____
Compressed Air from Shop Compressor	AIR _____
Compressed Air Wall Mounted Quick Coupling	
Compressed Air Ceiling Mounted Cord Reel	
Natural Gas (GAS)	_____
Point of Connection	


AIR COMPRESSOR SCHEDULE											(GARDNER DENVER AS STANDARD)
MARK	DESCRIPTION	MANUFACTURER	MODEL NUMBER	175 PSI RATING		ELECTRICAL REQUIREMENTS	HP	GAL. CAPACITY	DIM LxWxH (INCHES)	NOTES	
				RPM	CFM DEL'Y						
RAC-1	RECIPROCATING AIR COMPRESSOR	GARDNER DENVER	HR15-12	776	54.1		208V 3PH	15	120	73 x 36 x 62	SEE BELOW
NOTES: 1. HEAVY DUTY TWO-STAGE, SPLASH-LUBRICATED AIR COMPRESSOR PUMP 2. RANGE 54.1 CFM @ 175 psi / 776 RPM 3. VIBRATION ISOLATORS 4. 0-300 PSIG AIR PRESSURE GAUGE 5. CENTRIFUGAL UNLOADER FOR LOADLESS STARTING 6. MOUNTED FULL VOLTAGE MOTOR STARTER 7. SLOW SPEED COMPRESSOR 8. CAST IRON PUMP WITH SINGLE PIECE CYLINDER/HEAD 9. BELT GUARD 10. AUTOMATIC TANK DRAIN 11. TANK FEET VIBRATION ISOLATORS 12. LOW OIL LEVEL SWITCH 13. ON-OFF-AUTO SELECTOR SWITCH 14. HOUR METER											

NOTE:
RUN COMPRESSED AIR (AIR) PIPING ABOVE CEILING TYPE CT-6 IN PROTOTYPING STUDIO. SEE ARCHITECTURAL RCP ON SHEET A5.10 AND CEILING TYPES ON A5.00 FOR ADDITIONAL INFORMATION

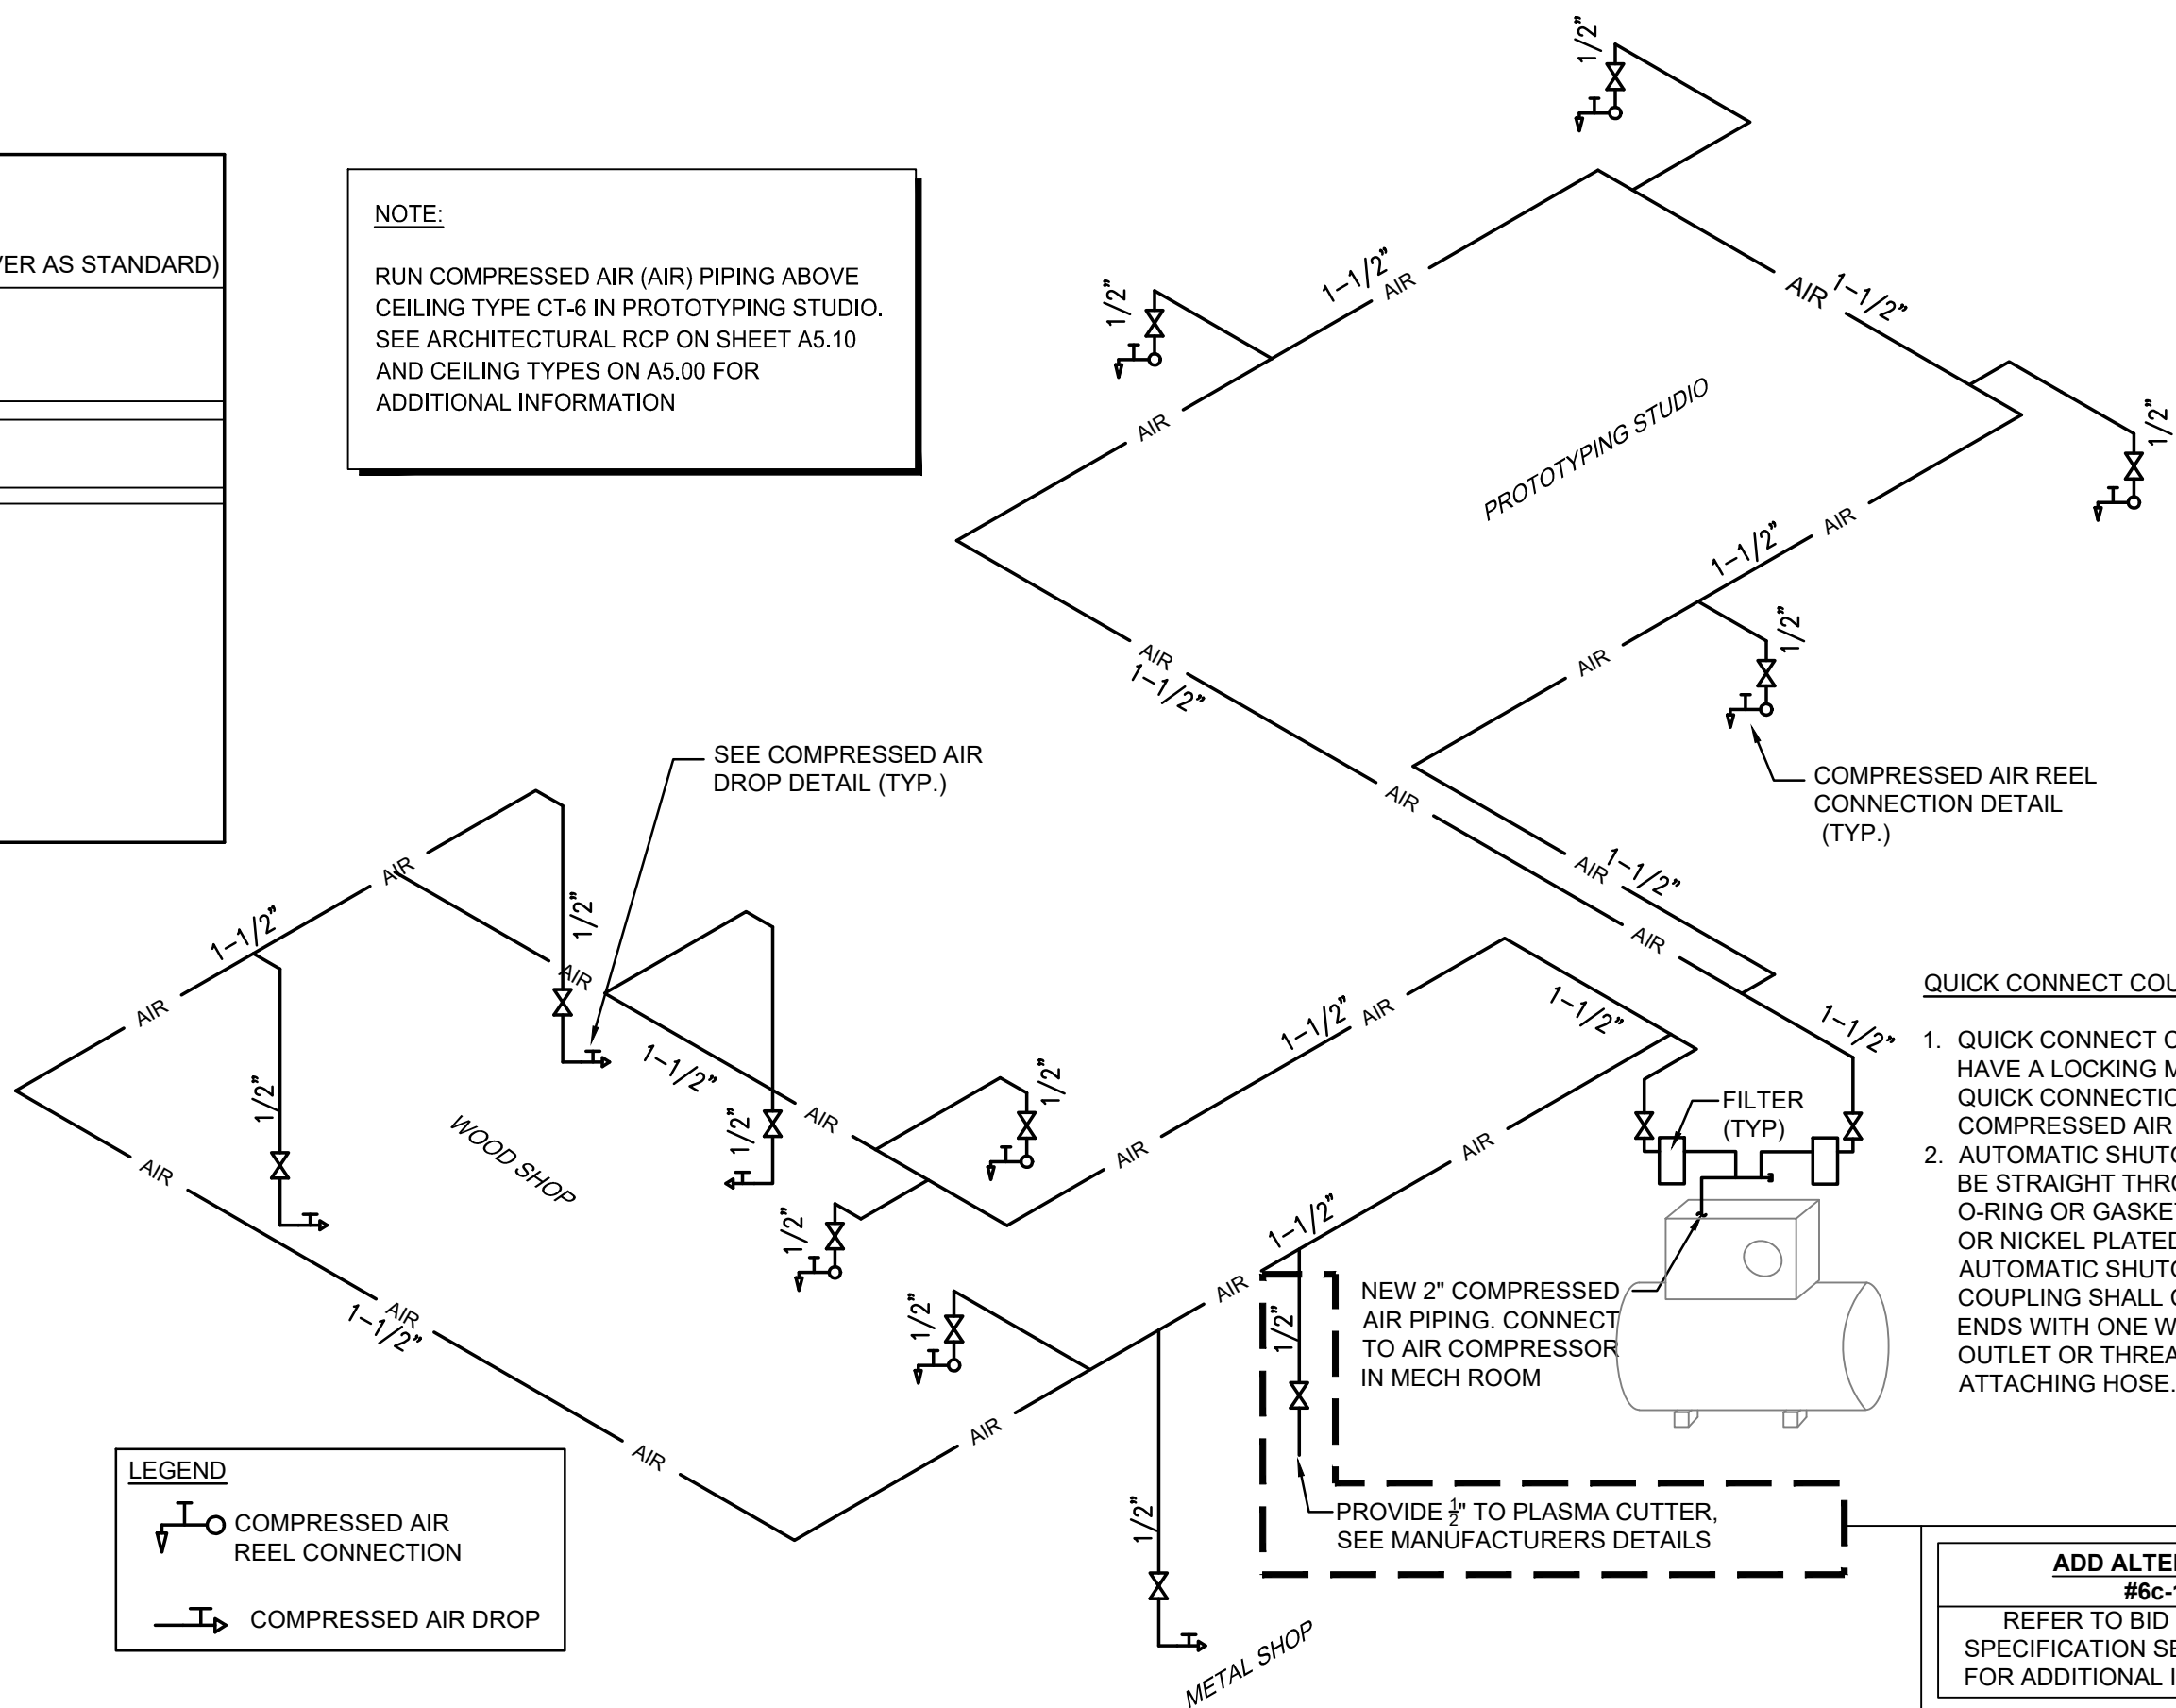

LEGEND
 COMPRESSED AIR REEL CONNECTION
 COMPRESSED AIR DROP


3
P1.13
N.T.S.
COMPRESSED AIR PIPING RISER DIAGRAM

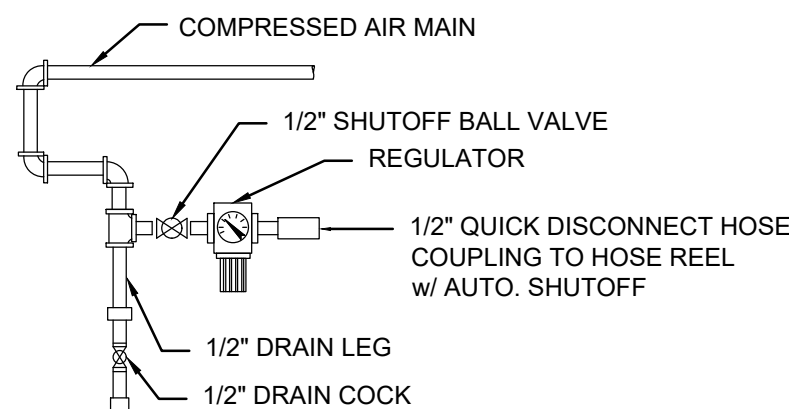

COORDINATE HEIGHT IN FIELD & w/ OWNER
COMPRESSED AIR REEL CONNECTION DETAIL

QUICK CONNECT COUPLING NOTE:

1. QUICK CONNECT COUPLING ASSEMBLIES SHALL HAVE A LOCKING MECHANISM FEATURE FOR QUICK CONNECTION & DISCONNECTION OF COMPRESSED AIR HOSE.
2. AUTOMATIC SHUTOFF QUICK COUPLINGS SHALL BE STRAIGHT THROUGH BRASS BODY WITH O-RING OR GASKET SEAL AND STAINLESS STEEL OR NICKEL PLATED STEEL OPERATING PARTS. AUTOMATIC SHUTOFF QUICK CONNECT COUPLING SHALL CONSIST OF SOCKET OR PLUG ENDS WITH ONE WAY VALVE AND WITH BARBED OUTLET OR THREADED HOSE FITTINGS FOR ATTACHING HOSE.

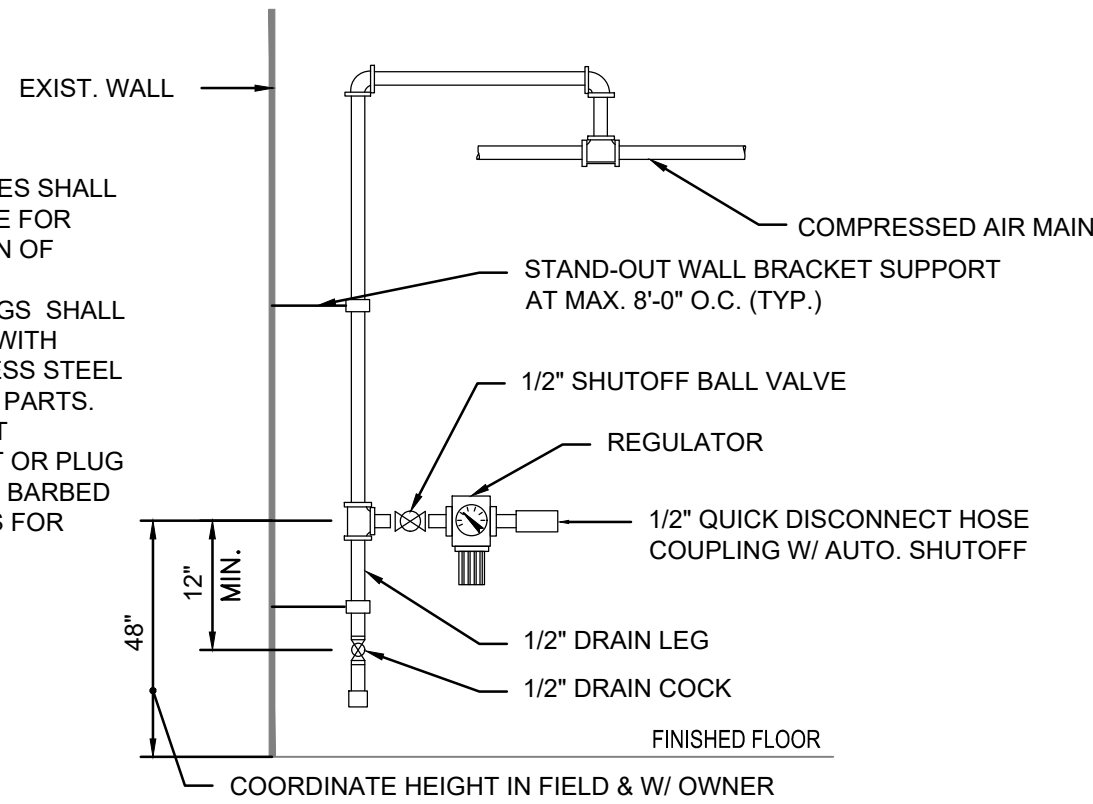

COORDINATE HEIGHT IN FIELD & w/ OWNER
COMPRESSED AIR DROP DETAIL

Date02/05/21

CheckedMAM

DrawnRJS

MICHAEL J. MCGOVERN, R.A.

REGISTERED ARCHITECT

License No. 022257-1

Revisions:

#

ISSUE FOR BID

11/22/2021

1

BID ADDENDUM NO. 1

12/10/21

2

BID ADDENDUM NO. 2

12/23/21

UNAUTHORIZED ALTERATIONS OR ADDITIONS TO THIS DOCUMENT IS A VIOLATION OF SECTION 2209 OF THE NEW YORK STATE EDUCATION LAW. THESE DOCUMENTS REMAIN THE EXCLUSIVE PROPERTY OF THE ENGINEER, AND MAY NOT BE USED FOR ANY PURPOSE WHATSOEVER WITHOUT THE WRITTEN CONSENT OF THE ENGINEER.

LAN ASSOCIATES

engineering • planning • architecture • surveying

252 MAIN STREET, GOSHEN, NEW YORK 10924 (845)815-0350

NYSed PROJECT # 66-07-01-03-0-001-039

WORK AREA A: STEAM LAB

PLUMBING RISERS AND DETAILS

CAPITAL IMPROVEMENTS AT

MAMARONECK HIGH SCHOOL

MAMARONECK UNION FREE SCHOOL DISTRICT

1000 BOSTON POST ROAD, MAMARONECK, NY 10543

Job No. 4,1092.72.6

File No. 10927206P111_114

P1.13



PIPE LEGEND (DEMOLITION)

- HWS
- HWR
- HWS
- HWR

EXIST. DOMESTIC/MAKEUP COLD WATER (DCW) PIPING TO BE REMOVED


- GAS
- GAS
- GAS

POINT OF DISCONNECTION OF OLD PIPING FROM EXISTING

- REFER TO ARCHITECTURAL, MECHANICAL & PLUMBING
DRAWINGS FOR ADDITIONAL WORK REQUIREMENTS.
MECHANICAL CONTRACTOR RESPONSIBLE FOR ALL WORK
CALLED OUT TO BE PERFORMED BY "MC" OR "MECHANICAL
CONTRACTOR", REGARDLESS OF THE DRAWING.

- GENERAL CONSTRUCTION NOTES:
1. REFER TO "MULTIPLE PRIME CONTRACT NOTE" ON DWG. A1.00 & SPECIFICATION SECTION 011200 - SPECIAL PROVISIONS FOR CONTRACTOR'S RESPONSIBILITIES.
 2. CORE DRILLING SHALL BE PERFORMED BY EACH INDIVIDUAL PRIME CONTRACT. REFER TO SPECIFICATION SECTION 011200 - SPECIAL PROVISIONS FOR ADDITIONAL INFORMATION. SEE DRAWINGS FOR APPROXIMATE LOCATIONS OF PIPES, DUCT, ETC.



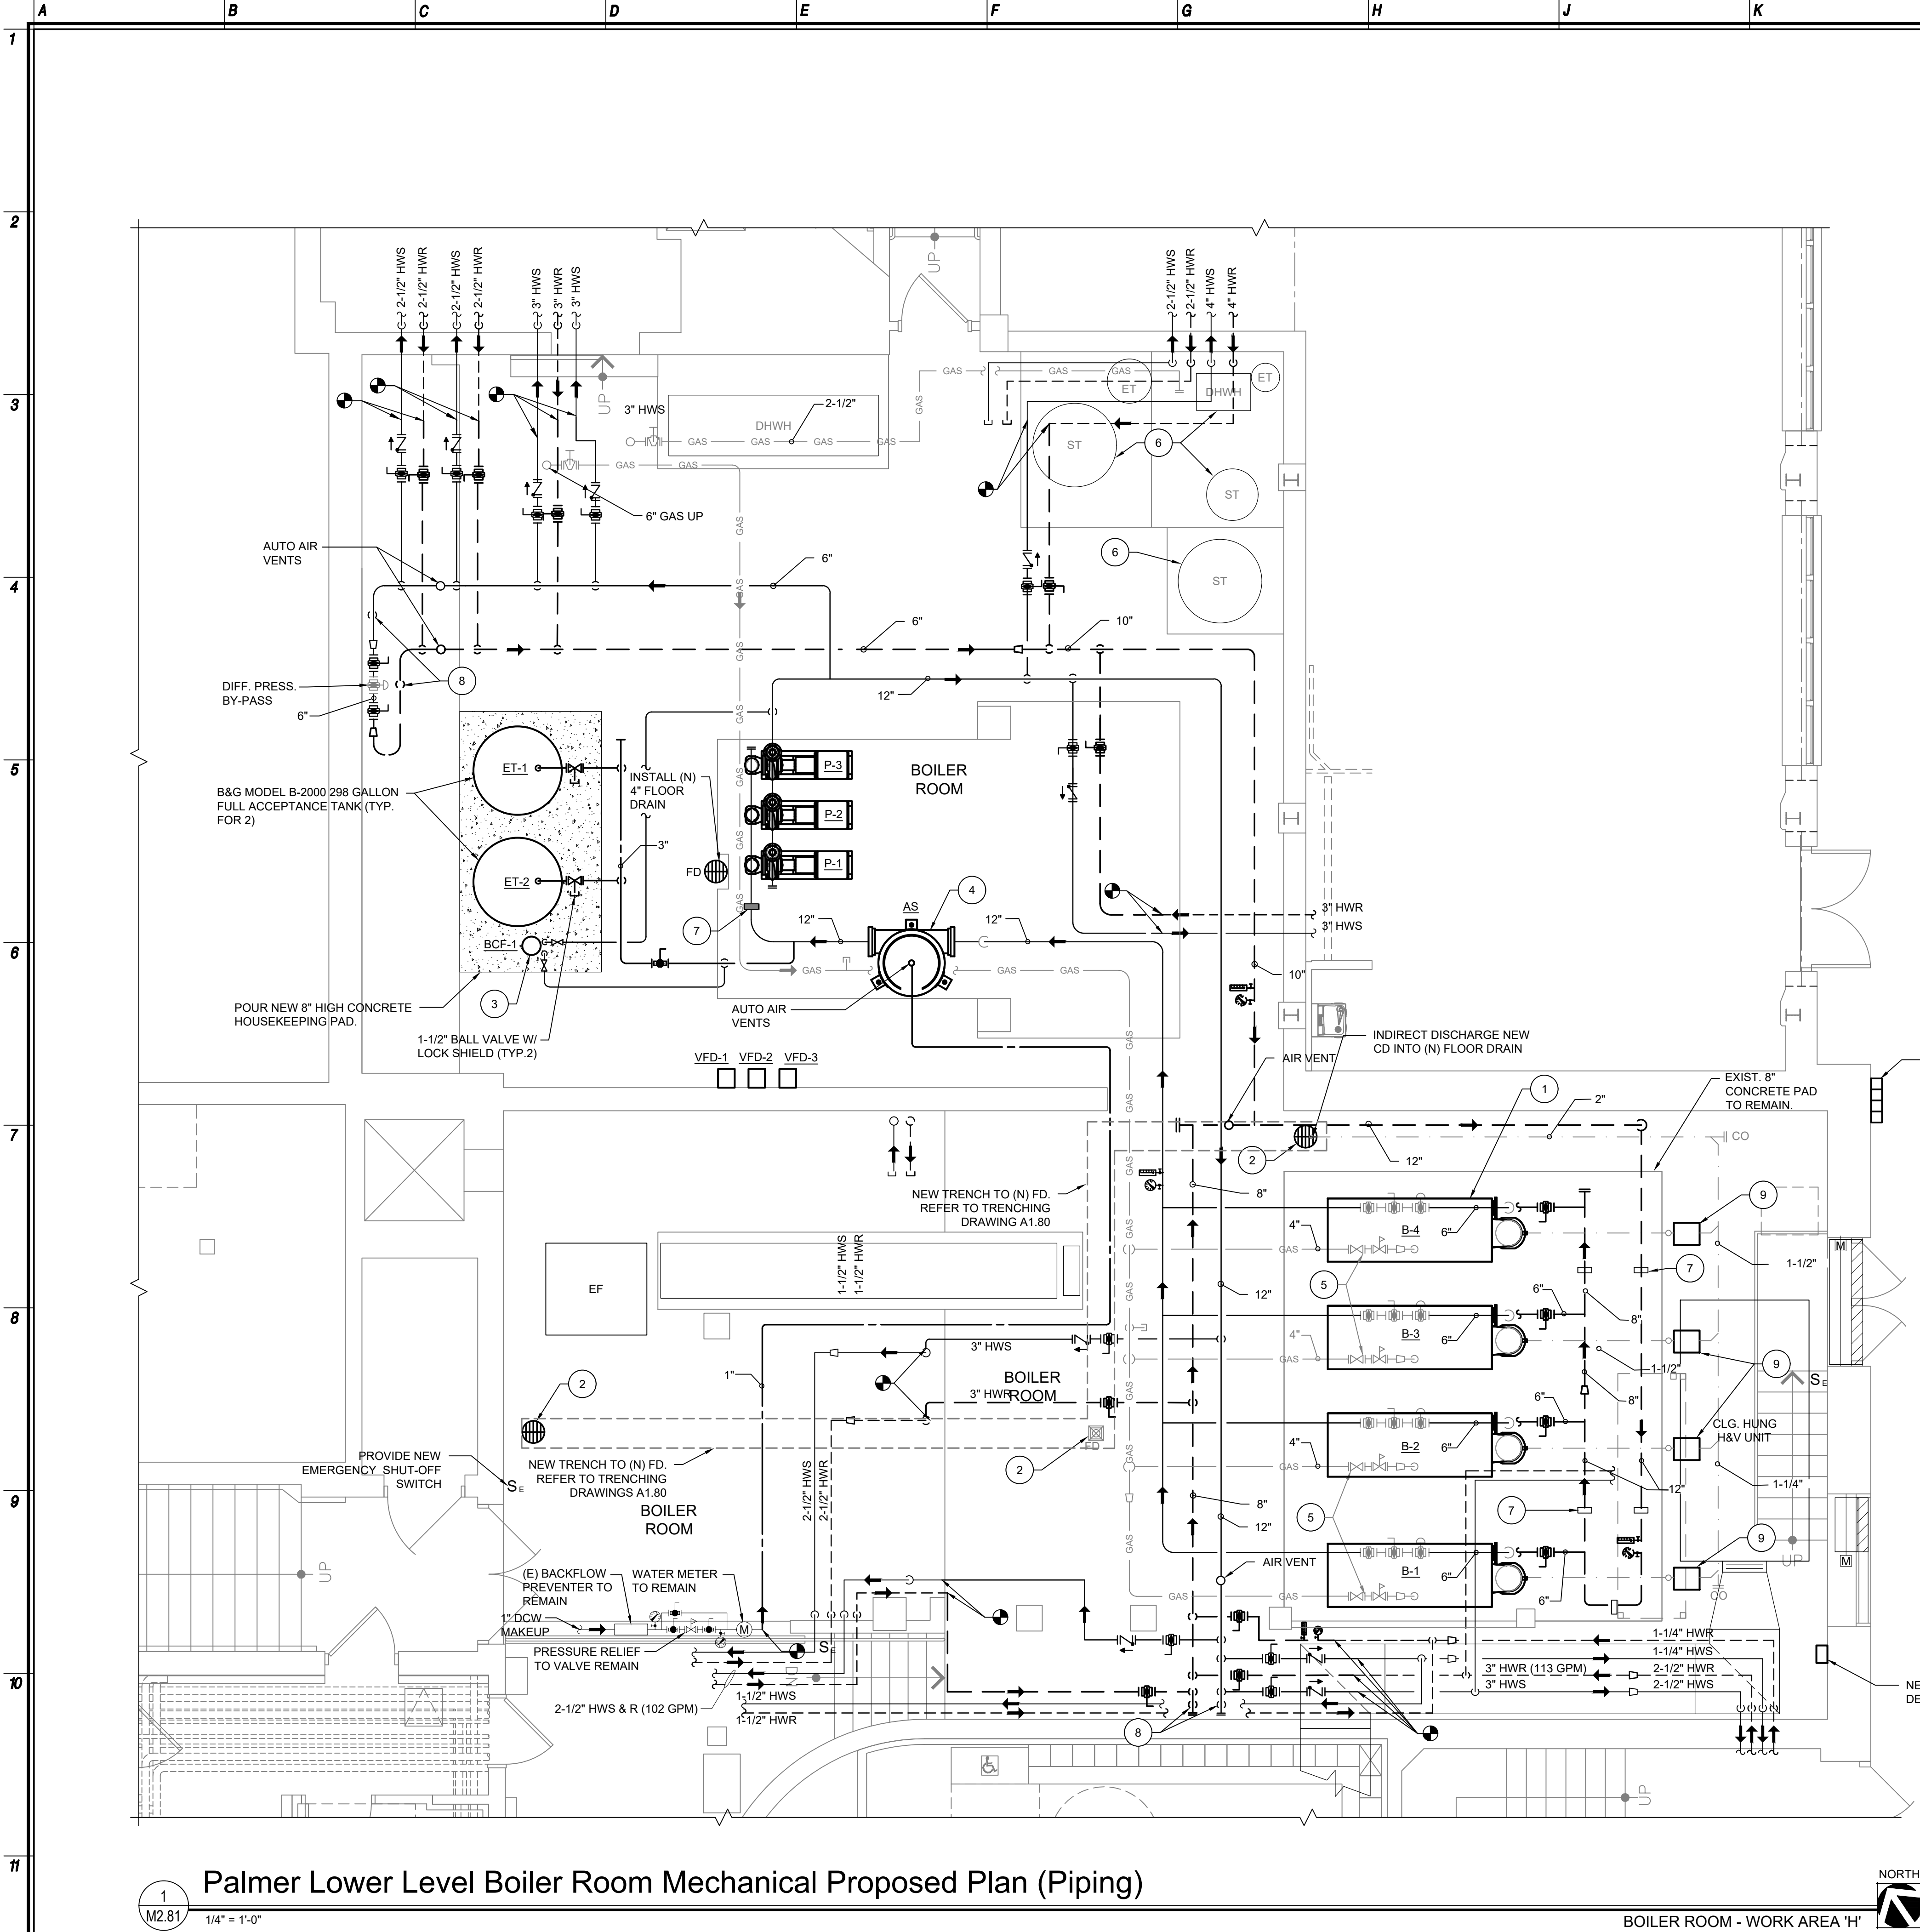

- CONSTRUCTION NOTES**
1. ALL NEW GAS LINES IN BOILER ROOM SHALL BE PAINTED YELLOW. ALL GAS VENT LINES AND BOILER DRAIN LINES SHALL BE PAINTED BLACK W/ HIGH TEMPERATURE PAINT. ALL EXTERIOR GAS VENT LINES SHALL BE PAINTED TO MATCH EXIST. MASONRY FINISH. ALL PAINTING SHALL BE 1 PRIMER & 2 FINISH COATS.
 2. CONTRACTOR TO NOTE THAT NOT ALL EXIST. PIPING IN BOILER ROOM HAS BEEN SHOWN ON DRAWINGS. CONTRACTOR SHALL CHECK IN FIELD TO AVOID CONFLICTS W/ INSTALLATION OF NEW EQUIPMENT & PIPING, ETC.
 3. SIZES OF HOT WATER PIPING (HWS & HWR) SHOWN ARE APPROXIMATE. CONTRACTOR SHALL BE RESPONSIBLE TO VERIFY IN FIELD & PROVIDE. ALL NEW VALVES SHALL BE LINE-SIZE. CHECK IN FIELD.
 4. NEW EQUIPMENT, PIPING, VALVES AND BREECHING INSTALLED ABOVE FINISHED FLOOR SHALL BE SUPPORTED OFF CEILING STRUCTURE WITH SUPPORT RODS AND HANGERS.
 5. CONTRACTOR IS RESPONSIBLE FOR REMOVAL, RELOCATION, AND REINSTALLATION OF ALL EXIST. PIPING, WIRING & CONDUITS, ELECTRICAL, ETC. IN ORDER TO ACCOMMODATE INSTALLATION OF ALL NEW WORK, WHETHER OR NOT SHOWN/CALLED OUT ON DWGS. PROVIDE REQUIRED PIPE ELBOWS & FITTINGS, ETC.
 6. CONTRACTOR IS REQUIRED TO DRAIN-DOWN THE ENTIRE HOT WATER HEATING SYSTEM CONTINUOUSLY UNTIL ALL SCALE & SLUDGE ARE REMOVED FROM THE PIPING SYSTEM. PROVIDE NEW BLEEDER VALVES (AIR VENTS) ON HEATING PIPING IN BOILER ROOM & ALSO USE EXIST. BLEEDER VALVES THROUGHOUT THE BUILDING TO BLEED OUT ALL AIR FROM THE PIPING SYSTEM. CLEAN ALL STRAINERS. PROVIDE ONE (1) TIME CHEMICAL WATER TREATMENT FOR NEW BOILER HEATING SYSTEM.
 7. ALL NEW & EXIST. WALL/FLOOR OPENINGS SHALL BE PATCHED. USE UL FIRE STOPPING SYSTEM #C-BJ-5001 (2HR RATING) FOR ALL PIPE/CONDUIT WALL PENETRATIONS.
 8. PERFORM HYDROSTATIC TEST ON ALL NEW INSTALLED PIPING AT NOT LESS THAN 1.5 TIMES THE WORKING PRESSURE FOR A MINIMUM OF TWO (2) HOURS. EXAMINE ALL PIPING JOINTS & CONNECTIONS FOR LEAKAGE. ELIMINATE LEAKAGE.

- SCOPE OF WORK:**
1. REMOVE THREE (3) EXISTING 8,000 MBH HOT WATER BOILERS ALONG WITH ASSOCIATED PIPING, VALVES, FITTINGS, ZONE CIRCULATING PUMPS, BREECHING, DAMPERS, CONTROLS, ETC.
 2. FURNISH AND INSTALL FOUR (4) NEW 5,000 MBH AERCO BMK PLATINUM 5000-N MODULAR BOILERS.
 3. PROVIDE THREE (3) NEW IN-BASE MOUNTED PRIMARY PUMPS.
 4. PROVIDE NEW COMBUSTION AIR INTAKE, BREECHING, CONTROLS, ETC.


PIPE LEGEND (PROPOSED)	
	NEW HOT WATER SUPPLY (HWS) PIPING
	NEW HOT WATER RETURN (HWR) PIPING
	EXIST. HOT WATER SUPPLY (HWS) PIPING TO REMAIN
	EXIST. HOT WATER RETURN (HWR) PIPING TO REMAIN
	NEW DOMESTIC/MAKEUP COLD WATER (DCW) PIPING
	EXIST. DOMESTIC COLD WATER (DCW) PIPING TO REMAIN
	EXIST. DOMESTIC HOT WATER (DHW) PIPING TO REMAIN
	NEW GAS PIPING (SEE P2.81 FOR PLUMBING PLAN)
	EXIST. GAS PIPING (GAS) TO REMAIN (SEE P2.81 PLUMBING PLAN)
	POINT OF CONNECTION OF NEW PIPING TO EXISTING

MECHANICAL KEY NOTES (PROPOSED)	
1	INSTALL ALL 4 BOILERS ON EXIST. CONCRETE HOUSEKEEPING PAD. ANCHOR BOILER TO SLAB AT ALL ANCHORING POINTS INDICATED ON THE MFR. INSTRUCTIONS.
2	INSTALL NEW FLOOR DRAIN IN THE LOCATION SHOWN. GC TO SAWCUT AND TRENCH TO EXISTING DRAIN TO BE REMOVED AND ROUTE TO NEW PER TRENCHING DRAWING A1.80. TELEWISE EXISTING DRAIN PIPE AND SNAKE LINE. PATCH FLOOR TO MATCH EXISTING. (SEE P2.81 FOR PLUMBING PLAN)
3	INSTALL BY-PASS FEEDER "NEPTUNE DBF-2HP" IN THE LOCATION SHOWN.
4	PROVIDE NEW "B&G ROLAIRTROL RL-12F" AIR SEPARATOR.
5	NEW 4" GAS DN TO NEW BOILER. INSTALL NEW GAS PRESSURE REGULATOR, SHUTOFF BALL VALVE AT MIN. 24" ABOVE BOILER. (TYP. 4) (SEE P2.81 FOR PLUMBING PLAN)
6	EXIST. DHW SYSTEM (DHW HEATER HWH-1, STORAGE TANKS ST-1 & 2) & RELATED PIPING, VALVES, ETC. TO REMAIN.
7	PROVIDE PIPE SUPPORT W/ FIXED SADDLE (TYP. TO PIPING CLOSE TO GROUND). REFER TO DETAIL 5/M2.83
8	1" DRAIN VALVE & DIRT POCKET AT THE END POINT OF 6" HWS & R PIPES
9	INSTALL (N) CONDENSATE NEUTRALIZATION TANK BELOW EXISTING HOUSEKEEPING PAD. (TYP. 4)

REFER TO ARCHITECTURAL, MECHANICAL & PLUMBING DRAWINGS FOR ADDITIONAL WORK REQUIREMENTS. MECHANICAL CONTRACTOR RESPONSIBLE FOR ALL WORK CALLED OUT TO BE PERFORMED BY "MC" OR "MECHANICAL CONTRACTOR", REGARDLESS OF THE DRAWING.



GENERAL CONSTRUCTION NOTES:

1. REFER TO "MULTIPLE PRIME CONTRACT NOTE" ON DWG A1.00 & SPECIFICATION SECTION 011200 - SPECIAL PROVISIONS FOR CONTRACTOR'S RESPONSIBILITIES.
2. CORE DRILLING SHALL BE PERFORMED BY EACH INDIVIDUAL PRIME CONTRACT. REFER TO SPECIFICATION SECTION 011200 - SPECIAL PROVISIONS FOR ADDITIONAL INFORMATION. SEE DRAWINGS FOR APPROXIMATE LOCATIONS OF PIPES, DUCT, ETC.

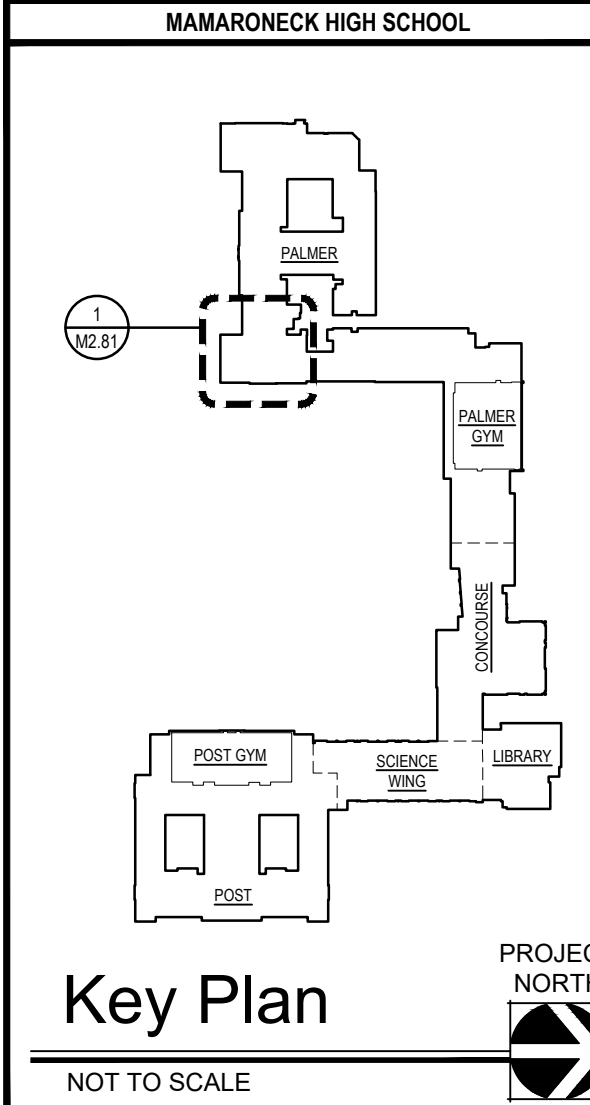


Date	02/05/21
Checked	AL
Drawn	IM
MICHAEL J. MCGOVERN, R.A. REGISTERED ARCHITECT License No. 022257-1	
Revisions:	
#	ISSUE FOR BD
1	11/22/2021
2	BD ADDENDUM NO. 1
3	12/10/21
4	BD ADDENDUM NO. 2
5	12/23/21
UNAUTHORIZED ALTERATIONS OR ADDITIONS TO THIS DOCUMENT IS A VIOLATION OF SECTION 2209 OF THE NEW YORK STATE EDUCATION LAW. THESE DOCUMENTS REMAIN THE EXCLUSIVE PROPERTY OF THE ENGINEER, AND MAY NOT BE USED FOR ANY PURPOSE WHATSOEVER WITHOUT THE WRITTEN CONSENT OF THE ENGINEER.	
LAN ASSOCIATES engineering • planning • architecture • surveying 252 MAIN STREET, GOSHEN, NEW YORK 10924 (845) 815-0350	
BOILER ROOM PROPOSED PLAN CAPITAL IMPROVEMENTS AT MAMARONECK HIGH SCHOOL MAMARONECK UNION FREE SCHOOL DISTRICT 1000 BOSTON POST ROAD, MAMARONECK, NY 10543	
Job No. 4,1092.72.6	
File No. 10927206M280	
M2.81	

NYSED PROJECT # 66-07-01-03-0-001-039

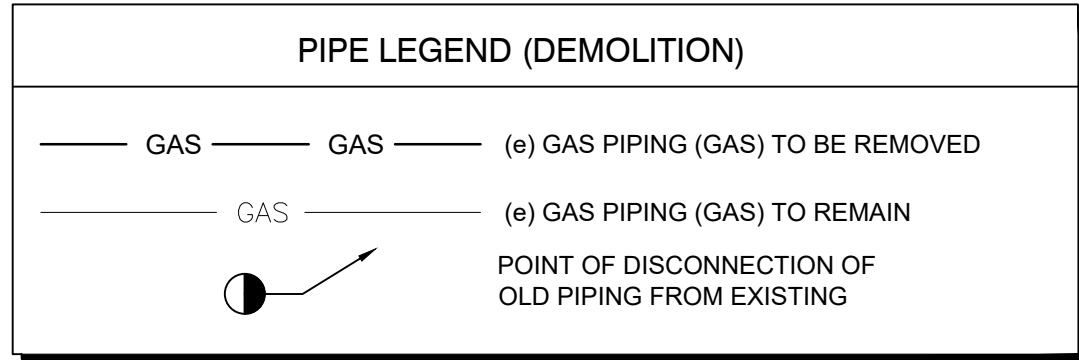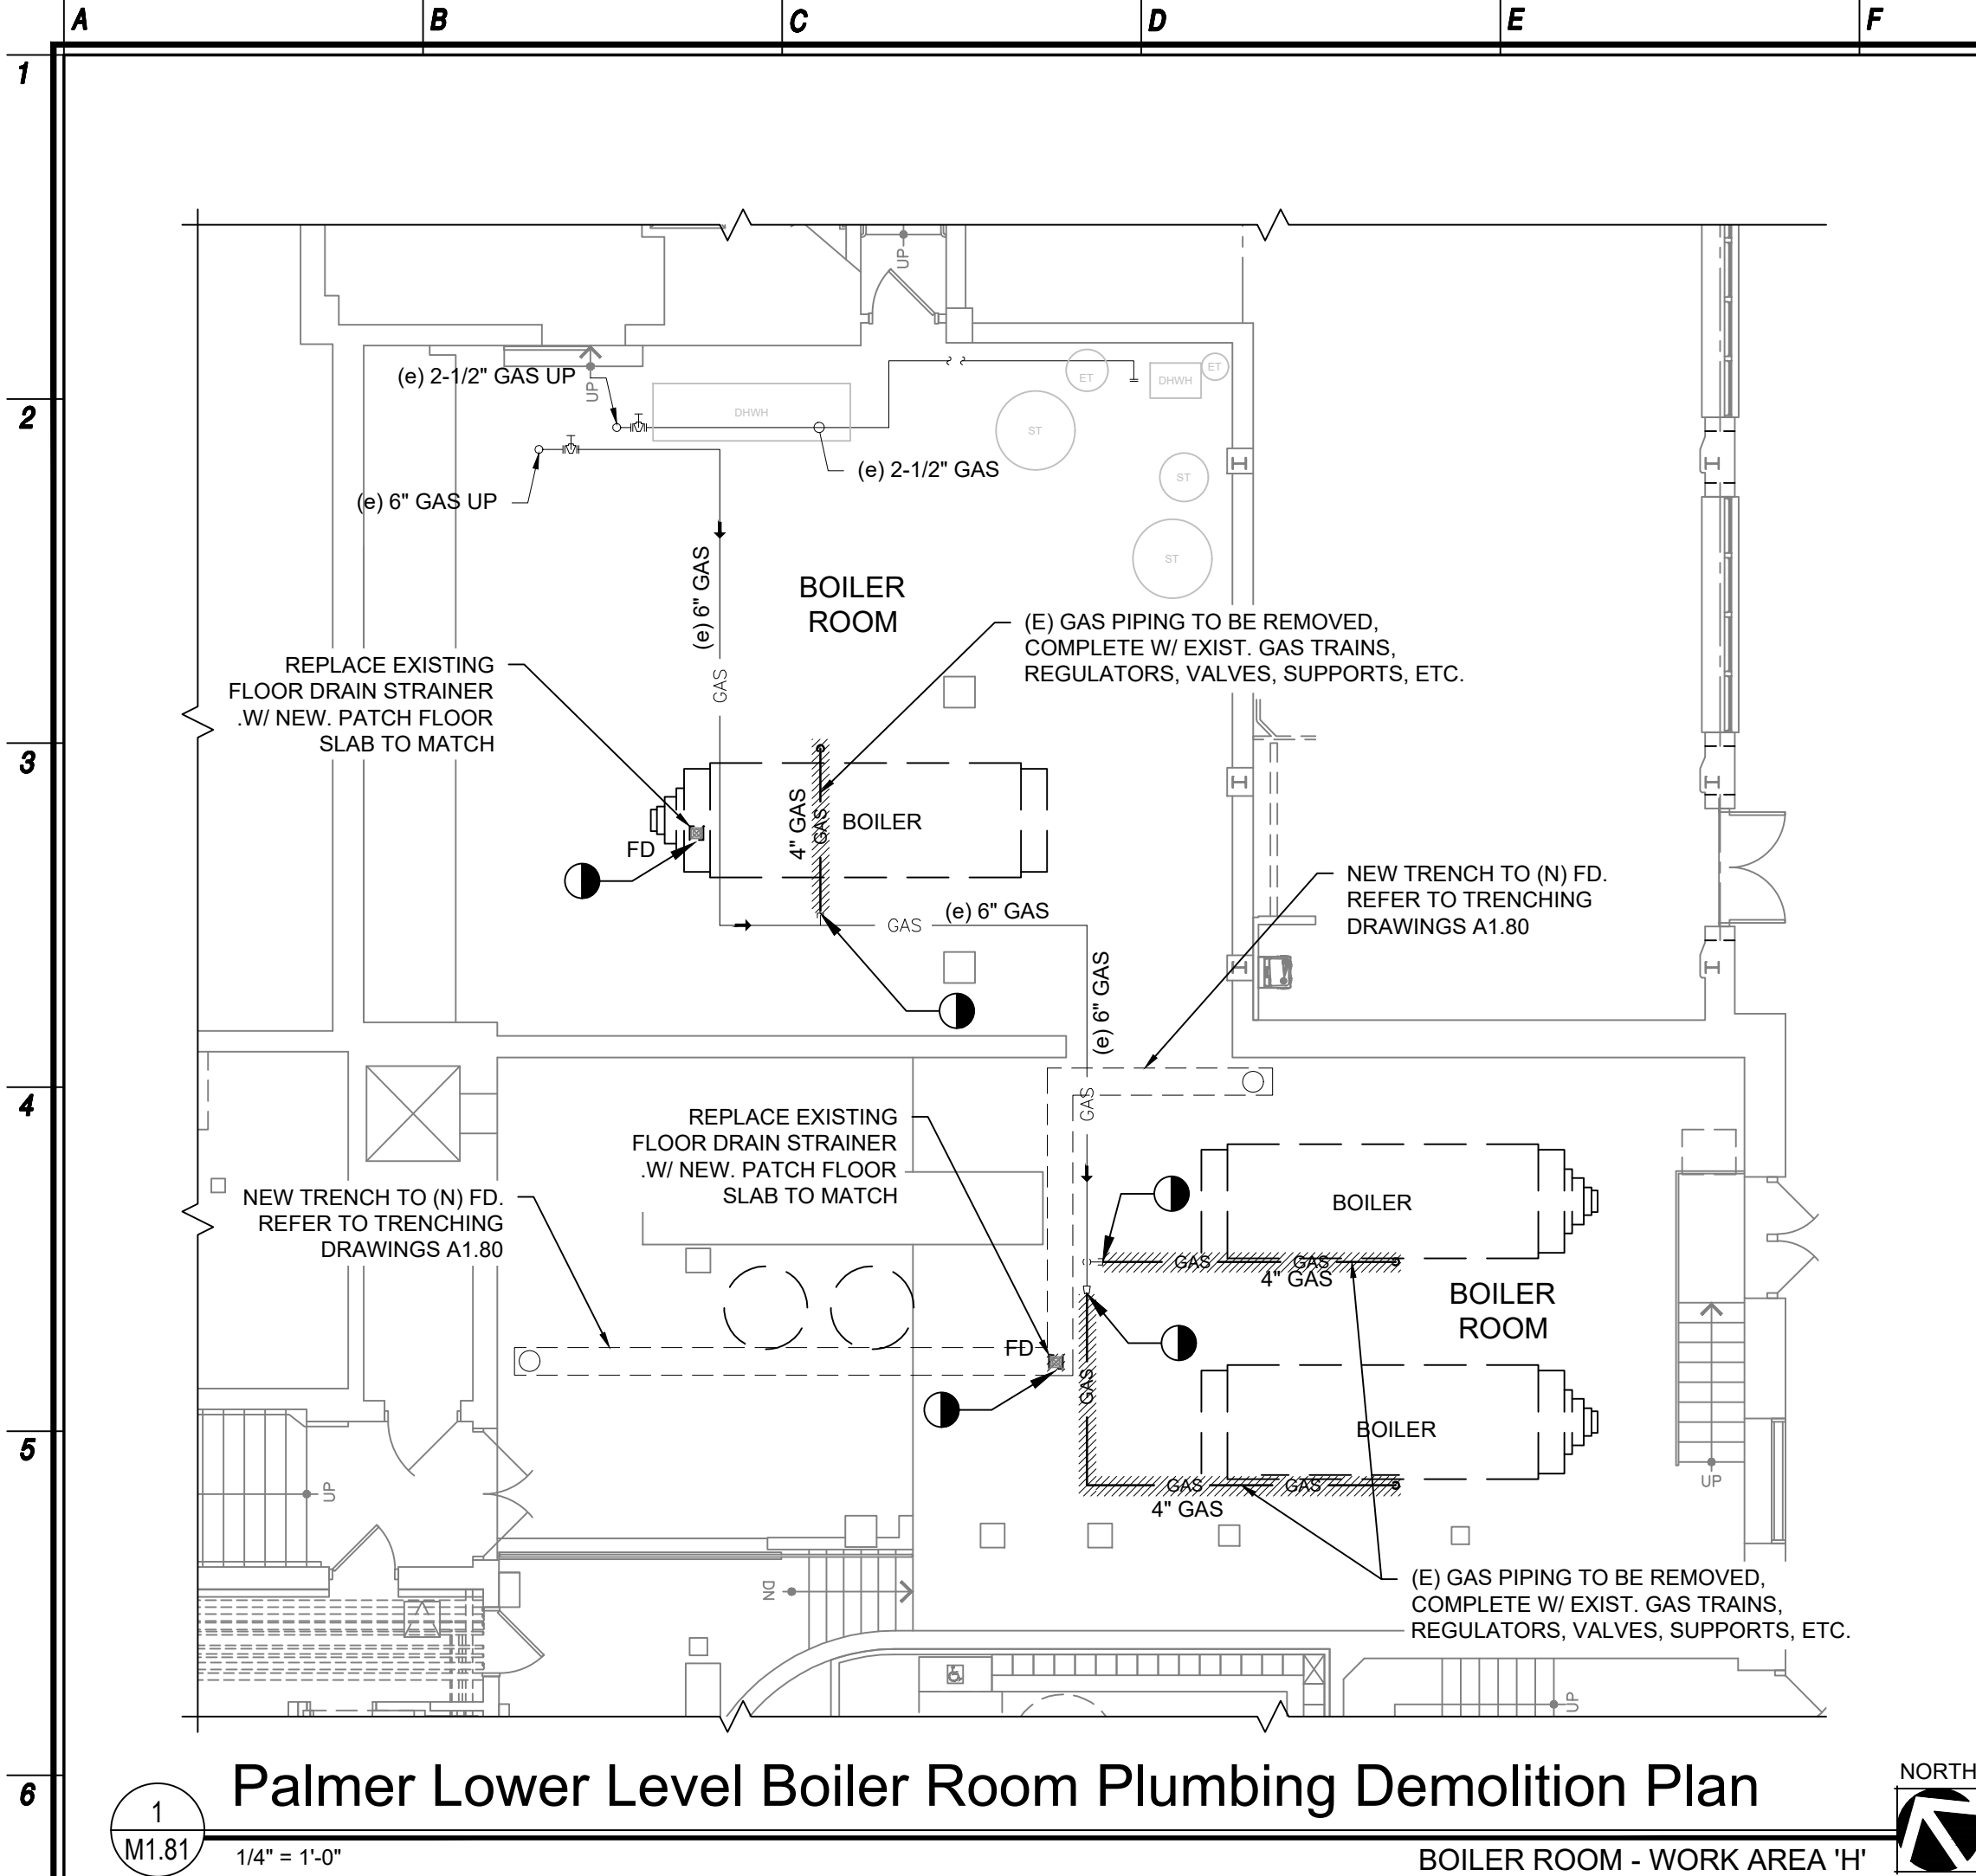

- DEMOLITION NOTES**
- HATCHED LINES INDICATE ITEMS TO BE REMOVED, UNLESS OTHERWISE NOTED.
 - ALL BURNER GAS VENT PIPING TO BE REMOVED IN ENTIRETY FROM BOILER ROOM TO TERMINATION. SEAL ALL WALL PENETRATIONS (IF NOT BEING REUSED) & CAULK WITH 2HR FIRE-STOPPING MATERIALS. PAINT TO MATCH EXISTING.
 - ALL EXIST. PILOT GAS LINES, REGULATORS, VALVES, ETC. (NOT SHOWN) ASSOCIATED WITH EXIST. BOILERS SHALL BE REMOVED IN BOILER ROOM. CHECK IN FIELD.
 - DURING DEMOLITION AND CONSTRUCTION, CONTRACTOR SHALL PROVIDE EXHAUST FANS AT STRATEGIC LOCATIONS IN BOILER ROOM TO DISCHARGE AIR OUTSIDE OF THE BUILDING & PREVENT ODORS OR FUME FROM MIGRATING INTO THE BUILDING.
 - CONTRACTOR TO NOTE THAT LOCATIONS & SIZES OF EXIST. PLUMBING PIPING SHOWN (GAS, WASTE, VENT, DCW, DHW, DHWR, ETC) ARE BASED ON FIELD OBSERVATIONS AND AVAILABLE BLUEPRINTS AND ARE APPROXIMATE. CONTRACTOR SHALL INVESTIGATE/TRACE (WITH CAMERA OR ELECTRONIC DEVICES) THE EXISTING SANITARY WASTE LINES TO BE REMOVED/REPLACED OR RESCHEDULED TO BE REUSED. THE CONTRACTOR SHALL NOTIFY THE ARCHITECT/ENGINEER OF ANY DISCREPANCIES. EXISTING VENTING AND WATER LINES ARE SHOWN GRAPHICALLY TO GIVE AN HONEST REPRESENTATION OF THE EXISTING CONDITIONS. THE CONTRACTOR SHALL BE RESPONSIBLE TO VERIFY ALL SIZES & LOCATIONS IN FIELD.
 - ALL SANITARY LINES BEING DEMOLISHED SHALL BE REMOVED BACK TO THE MAINS. DEAD END SHALL NOT EXCEED THE MAXIMUM LENGTH PER LATEST PLUMBING

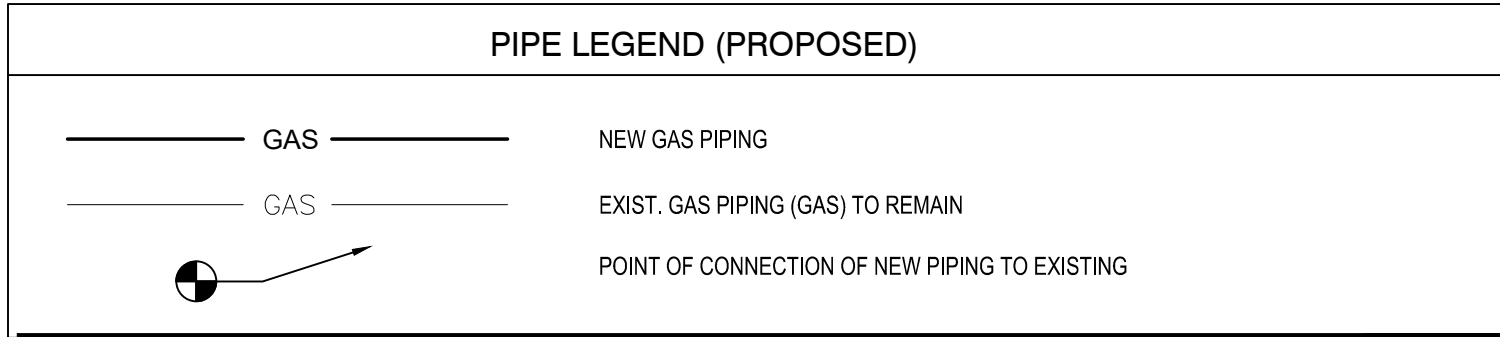


- CONSTRUCTION NOTES**
- ALL NEW GAS LINES IN BOILER ROOM SHALL BE PAINTED YELLOW. ALL GAS VENT LINES AND BOILER DRAIN LINES SHALL BE PAINTED BLACK W/ HIGH TEMPERATURE PAINT. ALL EXTERIOR GAS VENT LINES SHALL BE PAINTED TO MATCH EXIST. MASONRY FINISH. ALL PAINTING SHALL BE 1 PRIMER & 2 FINISH COATS.
 - CONTRACTOR TO NOTE THAT NOT ALL EXIST. PIPING IN BOILER ROOM HAS BEEN SHOWN ON DRAWINGS. CONTRACTOR SHALL CHECK IN FIELD TO AVOID CONFLICTS W/ INSTALLATION OF NEW EQUIPMENT & PIPING, ETC.
 - SIZES OF HOT WATER PIPING (HWS & HWR) SHOWN ARE APPROXIMATE. CONTRACTOR SHALL BE RESPONSIBLE TO VERIFY IN FIELD & PROVIDE. ALL NEW VALVES SHALL BE LINE-SIZE. CHECK IN FIELD.
 - NEW EQUIPMENT, PIPING, VALVES AND BREECHING INSTALLED ABOVE FINISHED FLOOR SHALL BE SUPPORTED OFF CEILING STRUCTURE WITH SUPPORT RODS AND HANGERS.
 - CONTRACTOR IS RESPONSIBLE FOR REMOVAL, RELOCATION, AND REINSTALLATION OF ALL EXIST. PIPING, WIRING & CONDUITS, ELECTRICAL, ETC. IN ORDER TO ACCOMMODATE INSTALLATION OF ALL NEW WORK, WHETHER OR NOT SHOWN/CALLED OUT ON DWGS. PROVIDE REQUIRED PIPE ELBOWS & FITTINGS, ETC.
 - CONTRACTOR IS REQUIRED TO DRAIN-DOWN THE ENTIRE HOT WATER HEATING SYSTEM CONTINUOUSLY UNTIL ALL SCALE & SLUDGE ARE REMOVED FROM THE PIPING SYSTEM. PROVIDE NEW BLEEDER VALVES (AIR VENTS) ON HEATING PIPING IN BOILER ROOM & ALSO USE EXIST. BLEEDER VALVES THROUGHOUT THE BUILDING TO BLEED OUT ALL AIR FROM THE PIPING SYSTEM. CLEAN ALL STRAINERS. PROVIDE ONE (1) TIME CHEMICAL WATER TREATMENT FOR NEW BOILER HEATING SYSTEM.
 - ALL NEW & EXIST. WALL/FLOOR OPENINGS SHALL BE PATCHED. USE UL FIRE STOPPING SYSTEM #C-BJ-5001 (2HR RATING) FOR ALL PIPE/CONDUIT WALL PENETRATIONS.
 - PERFORM HYDROSTATIC TEST ON ALL NEW INSTALLED PIPING AT NOT LESS THAN 1.5 TIMES THE WORKING PRESSURE FOR A MINIMUM OF TWO (2) HOURS. EXAMINE ALL PIPING JOINTS & CONNECTIONS FOR LEAKAGE. ELIMINATE LEAKAGE.

ITEM #	GAS KEY NOTES (PROPOSED)
A	NEW 4" GAS DN TO NEW BOILER. INSTALL NEW GAS PRESSURE REGULATOR, SHUTOFF BALL VALVE AT MIN. 24" ABOVE BOILER. (TYP. 4)

Palmer Lower Level Boiler Room Plumbing Demolition Plan

1 M1.81 1/4" = 1'-0"

BOILER ROOM - WORK AREA 'H'

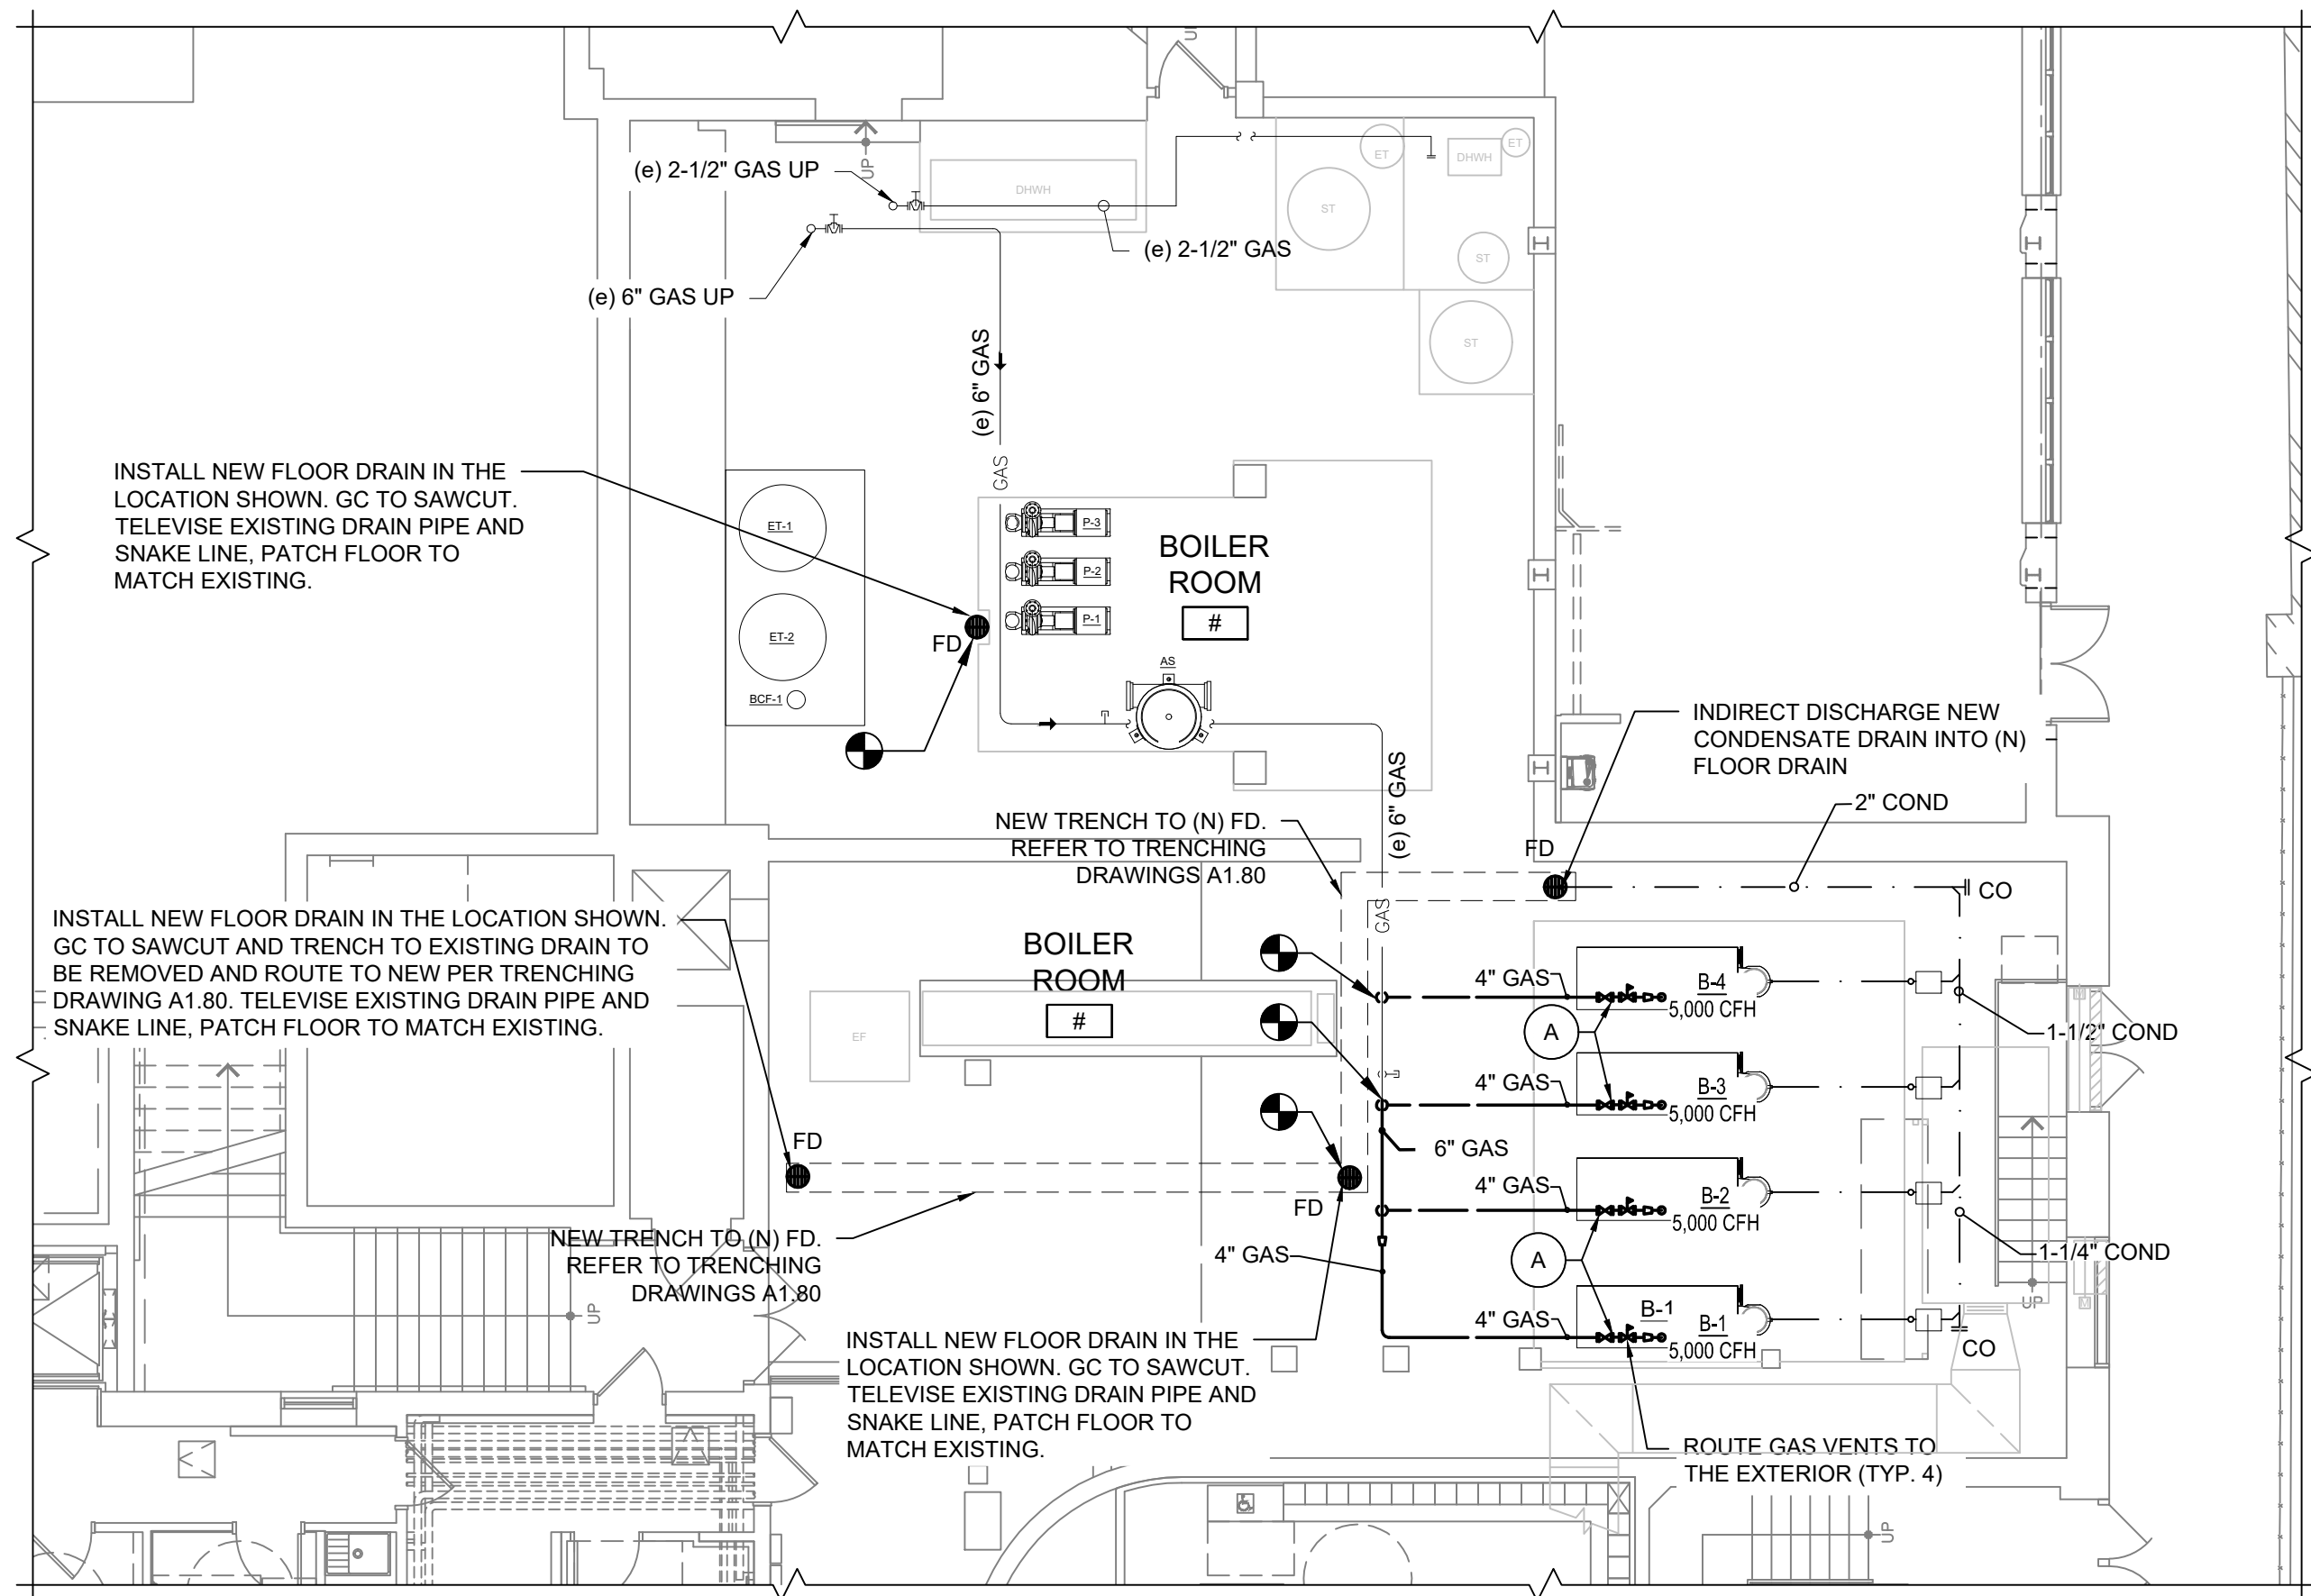


Palmer Lower Level Boiler Room Plumbing Proposed Plan (Piping)

1 M2.81 1/4" = 1'-0"

BOILER ROOM - WORK AREA 'H'

REFER TO ARCHITECTURAL, MECHANICAL & PLUMBING DRAWINGS FOR ADDITIONAL WORK REQUIREMENTS. PLUMBING CONTRACTOR RESPONSIBLE FOR ALL WORK CALLED OUT TO BE PERFORMED BY "PC" OR "PLUMBING CONTRACTOR", REGARDLESS OF THE DRAWING.

- GENERAL CONSTRUCTION NOTES:**
- REFER TO "MULTIPLE PRIME CONTRACT NOTE" ON DWG A1.00 & SPECIFICATION SECTION 011200 - SPECIAL PROVISIONS FOR CONTRACTOR'S RESPONSIBILITIES.
 - CORE DRILLING SHALL BE PERFORMED BY EACH INDIVIDUAL PRIME CONTRACT. REFER TO SPECIFICATION SECTION 011200 - SPECIAL PROVISIONS FOR ADDITIONAL INFORMATION. SEE DRAWINGS FOR APPROXIMATE LOCATIONS OF PIPES, DUCT, ETC.

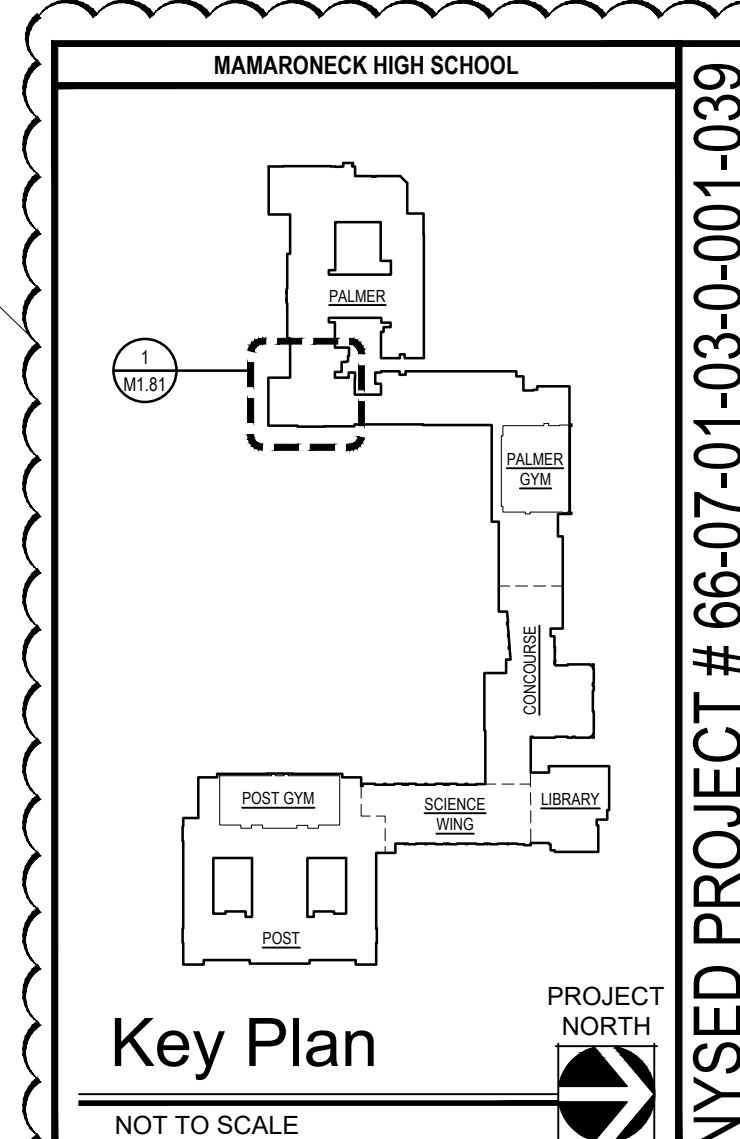

Date	02/05/21
Checked	MB
Drawn	RJS

MICHAEL J. MCGOVERN, R.A.

License No. 022257-1

REGISTERED ARCHITECT

Revisions:

#	ISSUE FOR BD	DATE
1	BD ADDENDUM NO. 1	12/10/21
2	BD ADDENDUM NO. 2	12/23/21

UNAUTHORIZED ALTERATIONS OR ADDITIONS TO THIS DOCUMENT IS A VIOLATION OF SECTION 2209 OF THE NEW YORK STATE EDUCATION LAW. THESE DOCUMENTS REMAIN THE EXCLUSIVE PROPERTY OF THE ENGINEER, AND MAY NOT BE USED FOR ANY PURPOSE WHATSOEVER WITHOUT THE WRITTEN CONSENT OF THE ENGINEER.

LAN ASSOCIATES

engineering • planning • architecture • surveying

252 MAIN STREET, GOSHEN, NEW YORK 10924 (845)818-0350

BOILER ROOM PUMPING PLANS

CAPITAL IMPROVEMENTS AT MAMARONECK HIGH SCHOOL

MAMARONECK UNION FREE SCHOOL DISTRICT

1000 BOSTON POST ROAD, MAMARONECK, NY 10543

Job No. 4.1092.72.6

File No. 10927206P215

P2.81

NYSED PROJECT # 66-07-01-03-0-001-039