

January 24, 2022

UV REPLACEMENT AT HAVERSTRAW ELEMENTARY SCHOOL

MSA File No. 41048

North Rockland High School

SED No. 50-02-01-06-0-009-018

NOTICE TO BIDDERS

Re: ADDENDUM NO. 3

THE FOLLOWING REVISIONS TO THE PROJECT MANUAL AND OR THE DRAWINGS REFERENCED HEREIN SHALL BECOME A PART OF THE CONTRACT DOCUMENTS AND SHALL SUPERSEDE ANY PRIOR OR CONFLICTING INFORMATION.

- 1) SEALED BIDS will be received until 2:00 P.M. in the office of facilities, on the 27th of January 2022, at the North Rockland Central School District, 65 Chapel Street, Garnerville, NY 10923, at which time and place they will be publicly opened and read. Faxed bids will NOT be accepted. Bids must be in sealed envelope(s) approximately labeled with the following label:
“UV Replacement at Haverstraw Elementary School – General Construction”
“UV Replacement at Haverstraw Elementary School – Mechanical Construction”
“UV Replacement at Haverstraw Elementary School – Electrical Construction”
- 2) Clarification for location of unit CU-5. Refer to note 13 on M-101. The unit is to be wall mounted outside on the first floor level but 3’-0” above grade.
- 3) See attached revised specification section 011200 Multiple Contract Summary dated 01-24-22. Section 1.8 Plumbing Contract has been voided as there is no separate Plumbing Contract for bid in this project. Remove original and replace with attached.
- 4) Alternates 1 and 2 have been added for work phasing (Phase A and Phase B). Alternate 1 is to have Phase A begin on site on June 27th 2022, and complete by August 19th 2022, and Phase B begin on site on June 2023 and complete by August 2023. Alternate 2 is to have Phase A begin on site on June 2022 and complete by August 2022, and Phase B as second shift work starting in September 2022. Phase A will include the work related to the mechanical installation in the Western portion of the building (containing the three floors of classrooms), and any additional GC work not related to installation of mechanical equipment. Phase B will include the work related to the mechanical installation in the Eastern portion of the building (containing the gymnasium, auditorium, and locker rooms). Refer to the architectural and mechanical floor plans as part of this addendum for additional location information. See attached revised drawings A-000, A-101, A-102, A-103, A-104, M-101, M-102, M-103 and M-104 dated 01-24-22. See attached revised specification section 012300 Alternates and Bid Forms 003000G, 003000M and 003000E dated 01-24-22. Remove originals and replace with attached. The base bid work will remain unchanged as all work to be performed and completed in the summer of 2022.
- 5) Please provide fire alarm contractor name & phone number for this location.
Answer: The district uses SafeNET Security for fire alarm services in their buildings. SafeNET Security telephone number is 845-501-2323.
- 6) Mechanical contractor to coordinate with SIEMENS for controls of new mechanical equipment.

- 7) Electrical Contractor will supply, install, and coordinate all fire alarm wiring and devices. Electrical Contractor will provide to HVAC duct detector for installation. See attached revised specification section 011200 Multiple Contract Summary dated 01-21-22. Remove original and replace with attached.
- 8) Due to lead time, Controllers are to be shipped separately for field installation, TYP. all new units. Mechanical drawings are reissued with revisions.

List of Drawings:

1. M-001- Revised Sequence to reference Steam Valves, added notes regarding BMS integration for all Unit Ventilators. Added note regarding to shop controller separate for field installation due to global chip shortage crisis and long lead time.
2. M-002- Added requirements for new energy recovery ventilator for RTU-2, Auditorium.
3. M-003- Added MERV 13 kit to (2) indoor units AC-9B, AC-9E. Added note regarding to shop controller separate for field installation due to global chip shortage crisis and long lead time.
4. M-004- Clarified valve indication on detail 2, to indicate STM(Steam) valve.
5. M-006- Added notes regarding controls for Unit Ventilators. Added note regarding to shop controller separate for field installation due to global chip shortage crisis and long lead time
6. M-061- Added “-Demo” to title of part plan. Added room names throughout for clarity purposes.
7. M-062- Added “-Demo” to title of part plan, added keynote #9 throughout part plan to indicate areas where radiators are to remain.
8. M-063- Added “-Demo” to title of part plan, added keynote #9 throughout part plan to indicate areas where radiators are to remain.
9. M-101- Added phasing and phasing notes, revised keynote #9 to indicate side grille type product, approved equal Titus 300/350 added.
10. M-102- Added phasing and phasing notes, revised keynote #9 to indicate side grille type product, approved equal Titus 300/350 added.
11. M-103- Added phasing and phasing notes, revised keynote #9 to indicate side grille type product, approved equal Titus 300/350 added.
12. M-104- Added phasing and phasing notes.
13. M-501- Added note to detail 9 regarding relief air for Unit Ventilator. Additional motorpack/end switch required for proper backdraft capabilities, approved equal product Greenheck WD-300 added.

END OF ADDENDUM NO. 3

PART 1 - GENERAL

1.01 GENERAL

- A. Pursuant to, and in compliance with, your Advertisement for Bids and the Information to Bidders relative thereto and all of the Contract Documents, including any Addenda issued by the Architect and mailed to the undersigned prior to the opening Bids, whether received by the undersigned or not, we

(CONTRACTOR NAME)

hereby proposes to furnish all plant, labor, supplies, materials, and equipment for UV Replacement at Haverstraw Elementary School – General Construction, as required by and in strict accord with the applicable provisions of the Drawings and Specifications entitled “UV Replacement at Haverstraw Elementary School – General Construction at Haverstraw Elementary School, 16 Grant Street, Haverstraw, NY 10927 for the North Rockland Central School District, 65 Chapel Street, Garnerville, NY 10923 ", all to the satisfaction and approval of the Architect and the Owner in accordance with the terms and conditions of the Contract Documents for the following prices:

1. _____ Dollars

(Write out in words)

(_____) Base Bid for all work.

_____ Consecutive Calendar Days for substantial completion _____ with base bid.

The undersigned further proposes and agrees hereby to commence work with an adequate force and equipment immediately after being notified in writing to do so, and to achieve substantial completion for all work as required by the plans and specifications within the number of consecutive calendar days as itemized above.

- A. UV Replacement at Haverstraw Elementary School

Total Project General Construction (\$ _____)

B. ALTERNATES

The undersigned further proposes and agrees that, should any of the following alternates be accepted and included in the Contract, the amount of the Base Bid, is hereto stated, shall be increased or decreased by the amounts indicated below.

Alternate No. 1

Work phasing. Phase A to be in summer of 2022 and phase B to be in summer of 2023. See architectural and mechanical floor plans for phase A and phase B locations.
(Indicate add or deduct amount to Base Bid.)

(\$ _____)

Alternate No. 2

Work phasing. Phase A to be in summer of 2022 and phase B to be during fall of 2022 2nd shift. See architectural and mechanical floor plans for phase A and phase B locations.
(Indicate add or deduct amount to Base Bid.)

(\$ _____)

C. ALLOWANCES

The undersigned further proposes and agrees that, should any of the following alternates be accepted and included in the Contract, the amount of the Base Bid, is hereto stated, shall be increased or decreased by the amounts indicated below.

Allowance No. 1
Not used. (\$ _____)

Allowance No. 2
Not used. (\$ _____)

Allowance No. 3
Not used. (\$ _____)

Allowance No. 4
Not used. (\$ _____)

Allowance No. 5:
Contractors to include allowance for LF of line set enclosure noted on drawings.
Adjustment to increase/decrease the LF will be in Unit Price No. 1. (\$ _____)

Allowance No. 6:
Not used. (\$ _____)

Allowance No. 7:
Not used. (\$ _____)

1.02 TIME OF COMPLETION

- A. It is agreed by the undersigned that after receipt of Notice of Award and a consummation of a Contract Agreement in accord with the terms of the Contract Documents, he will start work on June 27, 2022. Substantial completion will be August 19, 2022. The punch list work will be completed by September 16, 2022 and performed after school hours.

1.03 BID SECURITY

- A. Attached hereto is Bid Security in the amount of five percent (5%) of the Base Bid.

1.04 UNIT PRICES

- A. Unit Price No. 1: Provide unit price to increase or reduce by 10' - 0" the line set enclosure. (\$ _____)
- B. Unit Price No. 2: Provide unit price per square foot of VCT replacement. (\$ _____)
- C. Unit Price No. 3: Provide a unit price for linear feet of wood base replacement. (\$ _____)
- D. Unit Price No. 4: Not used (\$ _____)
- E. Unit Price No. 5: Not used (\$ _____)

1.06 NON-COLLUSIVE BIDDING CERTIFICATION

A. By submission of this bid, each bidder and each person signing on behalf of any bidder certifies, and in the case of a joint bid each party thereto certifies as to its own organization, under penalty of perjury, that to the best of knowledge and belief:

1. The prices in this bid have been arrived at independently without collusion, consultation, communication, or agreement, for the purpose of restricting competition, as to any matter relating to such prices with any other bidder or with any competitor.
2. Unless otherwise required by law, the prices which have been quoted in this bid have not been knowingly disclosed by the bidder and will not knowingly be disclosed by the bidder prior to opening, directly or indirectly, to any other bidder or to any competitor; and
3. No attempt has been made or will be made by the bidder to induce any other person, partnership or corporation to submit or not submit a bid for the purpose of restricting competition.

Resolved that _____
(Name of Individual)

be authorized to sign and submit the bid or proposal of this corporation for the following project

_____ and to include in such bid or proposal the certificate as to non-collusion required by Section One Hundred Three (d) (103d) of the General Municipal Law as the act and deed of such corporation, and for any inaccuracies or misstatements in such certificate this corporate bidder shall be liable under the penalty of perjury.

The foregoing is a true and correct copy of the resolution by

Corporation at a meeting of its Board of Directors held on the
_____ day of _____, 20____.

(SEAL OF THE CORPORATION)

Secretary

1.07 ACCEPTANCE

A. When this Proposal is accepted, the undersigned agrees to enter into Contract with the Owner as provided in the Form of Agreement.

1.08 AFFIRMS

A. The undersigned affirms and agrees that this Proposal is a firm one which remains in effect and will be irrevocable for a period of forty-five (45) days after opening of Bids.

1.09 TYPE OF BUSINESS

A. The undersigned hereby represents that it is a _____
(Corporation, Partnership, or an Individual). If a Corporation, then the undersigned further represents that it is duly qualified as a Corporation under laws of New York State and it is authorized to do business in this State.

1.10 PLACE OF BUSINESS

A. The following is the name and address of the person to whom all notices required in the connection with this Proposal may be telephoned, mailed or delivered.

(Name)

(Address)

(Telephone)

1.11 EXECUTION OF CONTRACT

- A. When written Notice of Acceptance of the Proposal is mailed or delivered to the undersigned within forty-five (45) days after the opening of Bids, or anytime thereafter should the Proposal not be withdrawn, the undersigned, within ten (10) days, will execute the Form of Agreement with the Owner.

1.12 ADDENDA

- A. Any Addenda issued by the Architect and mailed or delivered to the undersigned prior to the Bid opening date shall become part of the Contract Documents. The Bidder shall enter on this list any addenda issued after this Form of Proposal has been received and shall fill in the addenda number and date.

Addendum # _____	Dated _____
Addendum # _____	Dated _____
1.13 ASBESTOS

- A. The Contractor certifies that no asbestos or asbestos-containing material will be incorporated into the Work of this Contract.

(Sign Bid Here)

Dated _____, 20____ Legal Name of Person, Partnership
or Corporation

By _____

Title _____

Address _____

PART 1 - GENERAL

1.01 GENERAL

- A. Pursuant to, and in compliance with, your Advertisement for Bids and the Information to Bidders relative thereto and all of the Contract Documents, including any Addenda issued by the Architect and mailed to the undersigned prior to the opening Bids, whether received by the undersigned or not, we

(CONTRACTOR NAME)

hereby proposes to furnish all plant, labor, supplies, materials and equipment for UV Replacement at Haverstraw Elementary School – Electrical, as required by and in strict accord with the applicable provisions of the Drawings and Specifications entitled “UV Replacement at Haverstraw Elementary School – Electrical at Haverstraw Elementary School, 16 Grant Street, Haverstraw, NY 10927 for the North Rockland Central School District, 65 Chapel Street, Garnerville, NY 10923 ", all to the satisfaction and approval of the Architect and the Owner in accordance with the terms and conditions of the Contract Documents for the following prices:

1. _____ Dollars

(Write out in words)

(_____) Base Bid for all work.

_____ Consecutive Calendar Days for substantial completion _____ with base bid.

The undersigned further proposes and agrees hereby to commence work with an adequate force and equipment immediately after being notified in writing to do so, and to achieve substantial completion for all work as required by the plans and specifications within the number of consecutive calendar days as itemized above.

- A. UV Replacement at Haverstraw Elementary School

Total Project Electrical (\$ _____)

B. ALTERNATES

The undersigned further proposes and agrees that, should any of the following alternates be accepted and included in the Contract, the amount of the Base Bid, is hereto stated, shall be increased or decreased by the amounts indicated below.

Alternate No. 1

Work phasing. Phase A to be in summer of 2022 and phase B to be in summer of 2023. See architectural and mechanical floor plans for phase A and phase B locations.
(Indicate add or deduct amount to Base Bid.)

(\$ _____)

Alternate No. 2

Work phasing. Phase A to be in summer of 2022 and phase B to be during fall of 2022 2nd shift. See architectural and mechanical floor plans for phase A and phase B locations.

(Indicate add or deduct amount to Base Bid.)

(\$ _____)

C. ALLOWANCES

The undersigned further proposes and agrees that, should any of the following alternates be accepted and included in the Contract, the amount of the Base Bid, is hereto stated, shall be increased or decreased by the amounts indicated below.

Allowance No. 1
Not used. (\$ _____)

Allowance No. 2
Not used. (\$ _____)

Allowance No. 3
Not used. (\$ _____)

Allowance No. 4: Quantity Allowance: Provide for the relocation of
40 electrical devices that require relocation due to the increased size of
the new unit ventilators. (\$ _____)

Allowance No. 5:
Not used (\$ _____)

Allowance No. 6:
Not used. (\$ _____)

Allowance No. 7:
Contractor to include allowance for LF of wire mold noted on drawings.
Adjustment to increase/decrease the LF will be in Unit Price No. 4. (\$ _____)

1.02 TIME OF COMPLETION

A. It is agreed by the undersigned that after receipt of Notice of Award and a consummation of a Contract Agreement in accord with the terms of the Contract Documents, he will start work on June 27, 2022. Substantial completion will be August 19, 2022. The punch list work will be completed by September 16, 2022 and performed after school hours.

1.03 BID SECURITY

A. Attached hereto is Bid Security in the amount of five percent (5%) of the Base Bid.

1.04 UNIT PRICES

A. Unit Price No. 1: Not used (\$ _____)

B. Unit Price No. 2: Not used (\$ _____)

C. Unit Price No. 3: Not used (\$ _____)

- D. Unit Price No. 4: Provide into price to increase or reduce by 10'-0" the wire mold. (\$ _____)
- E. Unit Price No. 5: Not used (\$ _____)

1.06 NON-COLLUSIVE BIDDING CERTIFICATION

- A. By submission of this bid, each bidder and each person signing on behalf of any bidder certifies, and in the case of a joint bid each party thereto certifies as to its own organization, under penalty of perjury, that to the best of knowledge and belief:
1. The prices in this bid have been arrived at independently without collusion, consultation, communication, or agreement, for the purpose of restricting competition, as to any matter relating to such prices with any other bidder or with any competitor.
 2. Unless otherwise required by law, the prices which have been quoted in this bid have not been knowingly disclosed by the bidder and will not knowingly be disclosed by the bidder prior to opening, directly or indirectly, to any other bidder or to any competitor; and
 3. No attempt has been made or will be made by the bidder to induce any other person, partnership or corporation to submit or not submit a bid for the purpose of restricting competition.

Resolved that _____
(Name of Individual)

be authorized to sign and submit the bid or proposal of this corporation for the following project

_____ and to include in such bid or proposal
the certificate as to non-collusion required by Section One Hundred Three (d) (103d) of the General Municipal Law as the
act and deed of such corporation, and for any inaccuracies or misstatements in such certificate this corporate bidder shall
be liable under the penalty of perjury.

The foregoing is a true and correct cop of the resolution by

Corporation at a meeting of its Board of Directors held on the
_____ day of _____, 20____.

(SEAL OF THE CORPORATION)

Secretary

1.07 ACCEPTANCE

- A. When this Proposal is accepted, the undersigned agrees to enter into Contract with the Owner as provided in the Form of Agreement.

1.08 AFFIRMS

- A. The undersigned affirms and agrees that this Proposal is a firm one which remains in effect and will be irrevocable for a period of forty-five (45) days after opening of Bids.

1.09 TYPE OF BUSINESS

- A. The undersigned hereby represents that it is a _____
(Corporation, Partnership, or an Individual). If a Corporation, then the undersigned further represents that it is duly qualified as a Corporation under laws of New York State and it is authorized to do business in this State.

1.10 PLACE OF BUSINESS

- A. The following is the name and address of the person to whom all notices required in the connection with this Proposal may

be telephoned, mailed or delivered.

(Name)

(Address)

(Telephone)

1.11 EXECUTION OF CONTRACT

- A. When written Notice of Acceptance of the Proposal is mailed or delivered to the undersigned within forty-five (45) days after the opening of Bids, or anytime thereafter should the Proposal not be withdrawn, the undersigned, within ten (10) days, will execute the Form of Agreement with the Owner.

1.12 ADDENDA

- A. Any Addenda issued by the Architect and mailed or delivered to the undersigned prior to the Bid opening date shall become part of the Contract Documents. The Bidder shall enter on this list any addenda issued after this Form of Proposal has been received and shall fill in the addenda number and date.

Addendum # _____	Dated _____
Addendum # _____	Dated _____
1.13 ASBESTOS

- A. The Contractor certifies that no asbestos or asbestos-containing material will be incorporated into the Work of this Contract.

(Sign Bid Here)

Dated _____, 20____

Legal Name of Person, Partnership
or Corporation

By _____

Title _____

Address _____

PART 1 - GENERAL

1.01 GENERAL

- A. Pursuant to, and in compliance with, your Advertisement for Bids and the Information to Bidders relative thereto and all of the Contract Documents, including any Addenda issued by the Architect and mailed to the undersigned prior to the opening Bids, whether received by the undersigned or not, we

(CONTRACTOR NAME)

hereby proposes to furnish all plant, labor, supplies, materials, and equipment for UV Replacement at Haverstraw Elementary School – Mechanical, as required by and in strict accord with the applicable provisions of the Drawings and Specifications entitled “UV Replacement at Haverstraw Elementary School – Mechanical at Haverstraw Elementary School, 16 Grant Street, Haverstraw, NY 10927 for the North Rockland Central School District, 65 Chapel Street, Garnerville, NY 10923”, all to the satisfaction and approval of the Architect and the Owner in accordance with the terms and conditions of the Contract Documents for the following prices:

1. _____ Dollars
(Write out in words)

(_____) Base Bid for all work.

_____ Consecutive Calendar Days for substantial completion _____ with base bid.

The undersigned further proposes and agrees hereby to commence work with an adequate force and equipment immediately after being notified in writing to do so, and to achieve substantial completion for all work as required by the plans and specifications within the number of consecutive calendar days as itemized above.

- A. UV Replacement at Haverstraw Elementary School

Total Project Mechanical Construction (\$ _____)

B. ALTERNATES

The undersigned further proposes and agrees that, should any of the following alternates be accepted and included in the Contract, the amount of the Base Bid, is hereto stated, shall be increased, or decreased by the amounts indicated below.

Alternate No. 1

Work phasing. Phase A to be in summer of 2022 and phase B to be in summer of 2023. See architectural and mechanical floor plans for phase A and phase B locations.
(Indicate add or deduct amount to Base Bid.)

(\$ _____)

Alternate No. 2

Work phasing. Phase A to be in summer of 2022 and phase B to be during fall of 2022 2nd shift. See architectural and mechanical floor plans for phase A and phase B locations.
(Indicate add or deduct amount to Base Bid.)

(\$ _____)

C. ALLOWANCES

The undersigned further proposes and agrees that, should any of the following alternates be accepted and included in the Contract, the amount of the Base Bid, is hereto stated, shall be increased, or decreased by the amounts indicated below.

Allowance No. 1: Unit-Cost, Clean Existing Main Ductwork. Provide allowance to clean existing main ductwork for 20 linear feet per unit. (\$_____)

Allowance No. 2: Unit Cost Allowance: Replace Existing Supply and Return Steam Piping and Insulation. Provide Allowance to replace existing supply and return steam piping and insulation for 20 linear feet per unit. (\$_____)

Allowance No. 3: Commissioning Allowance: Provide a proposal from a third-party HVAC Commissioning Agent Contractor is to include this amount in their base bid. Contractor will issue a credit change order to the Owner for the commissioning proposal amount. Owner will contract directly with the commissioning agent. (\$_____)

Allowance No. 4: Not used (\$_____)

Allowance No. 5: Not used (\$_____)

Allowance No. 6: Contractor shall include in their bid an allowance 10' of piping/insulation for each UV and 20' at each RTU. See drawings 3/M-501 and 4/M-501. Adjustment to increase/decrease the LF will be in Unit Price No. 5. (\$_____)

Allowance No. 7: Not used (\$_____)

1.02 TIME OF COMPLETION

A. It is agreed by the undersigned that after receipt of Notice of Award and a consummation of a Contract Agreement in accord with the terms of the Contract Documents, he will start work on June 27, 2022. Substantial completion will be August 19, 2022. The punch list work will be completed by September 16, 2022 and performed after school hours.

1.03 BID SECURITY

A. Attached hereto is Bid Security in the amount of five percent (5%) of the Base Bid.

1.04 UNIT PRICES

A. Unit Price No. 1: Not used (\$_____)

B. Unit Price No. 2: Not used (\$_____)

C. Unit Price No. 3: Not used (\$_____)

D. Unit Price No. 4: Not used (\$_____)

E. Unit Price No. 5: Provide unit price to increase or reduce by 10'- 0" of piping/insulation. (\$_____)

1.06 NON-COLLUSIVE BIDDING CERTIFICATION

A. By submission of this bid, each bidder and each person signing on behalf of any bidder certifies, and in the case of a joint

bid each party thereto certifies as to its own organization, under penalty of perjury, that to the best of knowledge and belief:

1. The prices in this bid have been arrived at independently without collusion, consultation, communication, or agreement, for the purpose of restricting competition, as to any matter relating to such prices with any other bidder or with any competitor.
2. Unless otherwise required by law, the prices which have been quoted in this bid have not been knowingly disclosed by the bidder and will not knowingly be disclosed by the bidder prior to opening, directly or indirectly, to any other bidder or to any competitor; and
3. No attempt has been made or will be made by the bidder to induce any other person, partnership or corporation to submit or not submit a bid for the purpose of restricting competition.

Resolved that _____
(Name of Individual)

be authorized to sign and submit the bid or proposal of this corporation for the following project

_____ and to include in such bid or proposal the certificate as to non-collusion required by Section One Hundred Three (d) (103d) of the General Municipal Law as the act and deed of such corporation, and for any inaccuracies or misstatements in such certificate this corporate bidder shall be liable under the penalty of perjury.

The foregoing is a true and correct copy of the resolution by

Corporation at a meeting of its Board of Directors held on the
_____ day of _____, 20____.

(SEAL OF THE CORPORATION)

Secretary

1.07 ACCEPTANCE

- A. When this Proposal is accepted, the undersigned agrees to enter into Contract with the Owner as provided in the Form of Agreement.

1.08 AFFIRMS

- A. The undersigned affirms and agrees that this Proposal is a firm one which remains in effect and will be irrevocable for a period of forty-five (45) days after opening of Bids.

1.09 TYPE OF BUSINESS

- A. The undersigned hereby represents that it is a _____
(Corporation, Partnership, or an Individual). If a Corporation, then the undersigned further represents that it is duly qualified as a Corporation under laws of New York State and it is authorized to do business in this State.

1.10 PLACE OF BUSINESS

- A. The following is the name and address of the person to whom all notices required in the connection with this Proposal may be telephoned, mailed or delivered.

(Name)

(Address) _____

(Telephone) _____

1.11 EXECUTION OF CONTRACT

- A. When written Notice of Acceptance of the Proposal is mailed or delivered to the undersigned within forty-five (45) days after the opening of Bids, or anytime thereafter should the Proposal not be withdrawn, the undersigned, within ten (10) days, will execute the Form of Agreement with the Owner.

1.12 ADDENDA

- A. Any Addenda issued by the Architect and mailed or delivered to the undersigned prior to the Bid opening date shall become part of the Contract Documents. The Bidder shall enter on this list any addenda issued after this Form of Proposal has been received and shall fill in the addenda number and date.

Addendum # _____	Dated _____
Addendum # _____	Dated _____
1.13 ASBESTOS

- A. The Contractor certifies that no asbestos or asbestos-containing material will be incorporated into the Work of this Contract.

(Sign Bid Here)

Dated _____, 20____

Legal Name of Person, Partnership
or Corporation

By _____

Title _____

Address _____

SECTION 011200 - MULTIPLE CONTRACT SUMMARY

PART 1 - GENERAL

1.1 RELATED DOCUMENTS

- A. Drawings and general provisions of the Contract, including General and Supplementary Conditions and other Division 01 Specification Sections, apply to this Section.

1.2 SUMMARY

- A. Section includes a summary of each contract, including responsibilities for coordination and temporary facilities and controls.
- B. Specific requirements for Work of each contract are also indicated in individual Specification Sections and on Drawings.
- C. Related Requirements:
 - 1. Section 011000 "Summary" for the Work covered by the Contract Documents, restrictions on use of Project site, phased construction, coordination with occupants, and work restrictions.
 - 2. Section 013100 "Project Management and Coordination" for general coordination requirements.

1.3 DEFINITIONS

- A. Permanent Enclosure: As determined by Architect, the condition at which roofing is insulated and weathertight; exterior walls are insulated and weathertight; and all openings are closed with permanent construction or substantial temporary closures equivalent in weather protection to permanent construction.

1.4 PROJECT COORDINATOR

- A. Project coordinator shall be responsible for coordination between the General Construction Contract, Plumbing Contract, HVAC Contract, Electrical Contract,.
 - 1. HVAC Contractor will act as Project Coordinator.

1.5 COORDINATION ACTIVITIES

- A. Coordination activities of Project coordinator include, but are not limited to, the following:
 - 1. Provide overall coordination of the Work.
 - 2. Coordinate shared access to workspaces.
 - 3. Coordinate product selections for compatibility.
 - 4. Provide overall coordination of temporary facilities and controls.
 - 5. Coordinate, schedule, and approve interruptions of permanent and temporary utilities, including those necessary to make connections for temporary services.
 - 6. Coordinate construction and operations of the Work with work performed by each Contract and Owner's construction forces and separate contracts.
 - 7. Prepare coordination drawings in collaboration with each contractor to coordinate work by more than one contract.
 - 8. Coordinate sequencing and scheduling of the Work. Include the following:

- a. Initial Coordination Meeting: At earliest possible date, arrange and conduct a meeting with contractors for sequencing and coordinating the Work; negotiate reasonable adjustments to schedules.
 - b. Prepare a combined contractors' construction schedule for entire Project. Base schedule on preliminary construction schedule. Secure time commitments for performing critical construction activities from contractors. Show activities of each contract on a separate sheet. Prepare a simplified summary sheet indicating combined construction activities of contracts.
 - 1) Submit schedules for approval.
 - 2) Distribute copies of approved schedules to contractors.
9. Provide photographic documentation.
 10. Provide quality-assurance and quality-control services specified in Section 014000 "Quality Requirements."
 11. Coordinate sequence of activities to accommodate tests and inspections, and coordinate schedule of tests and inspections.
 12. Provide information necessary to adjust, move, or relocate existing utility structures affected by construction.
 13. Locate existing permanent benchmarks, control points, and similar reference points, and establish permanent benchmarks on Project site.
 14. Provide field surveys of in-progress construction and site work and final property survey.
 15. Provide progress cleaning of common areas and coordinate progress cleaning of areas or pieces of equipment where more than one contractor has worked.
 16. Coordinate cutting and patching.
 17. Coordinate protection of the Work.
 18. Coordinate firestopping.
 19. Coordinate completion of interrelated punch list items.
 20. Coordinate preparation of Project record documents if information from more than one contractor is to be integrated with information from other contractors to form one combined record.
 21. Print and submit record documents if installations by more than one contractor are indicated on the same contract drawing or shop drawing.
 22. Collect record Specification Sections from contractors, collate Sections into numeric order, and submit complete set.
 23. Coordinate preparation of operation and maintenance manuals if information from more than one contractor is to be integrated with information from other contractors to form one combined record.
- B. Responsibilities of Project coordinator for temporary facilities and controls include, but are not limited to, the following:
1. Provide common-use field office for use by all personnel engaged in construction activities.

1.6 GENERAL REQUIREMENTS OF CONTRACTS

- A. Extent of Contract: Unless the Agreement contains a more specific description of the Work of each Contract, requirements indicated on Drawings and in Specification Sections determine which contract includes a specific element of Project.
1. Unless otherwise indicated, the work described in this Section for each contract shall be complete systems and assemblies, including products, components, accessories, and installation required by the Contract Documents.
 2. Trenches and other excavation for the work of each contract shall be the work of each contract for its own work.
 3. Blocking, backing panels, sleeves, and metal fabrication supports for the work of each contract shall be the work of each contract for its own work.
 4. Furnishing of access panels for the work of each contract shall be the work of each contract for its own work. Installation of access panels shall be the work of the General Construction Contract.
 5. Equipment pads for the work of each contract shall be the work of each contract for its own work.
 6. Roof-mounted equipment curbs for the work of each contract shall be the work of each contract for its own work.
 7. Painting for the work of each contract shall be the work of each contract for its own work.
 8. Cutting and Patching: Each contract shall perform its own cutting; patching shall be under the General Construction Contract.

9. Through-penetration firestopping for the work of each contract shall be provided by each contract for its own work.
 10. Contractors' Startup Construction Schedule: Within five working days after startup horizontal bar-chart-type construction schedule submittal has been received from Project coordinator, submit a matching startup horizontal bar-chart schedule showing construction operations sequenced and coordinated with overall construction.
- B. Substitutions: Each contractor shall cooperate with other contractors involved to coordinate approved substitutions with remainder of the work.
1. Project coordinator shall coordinate substitutions.
- C. Temporary Facilities and Controls: In addition to specific responsibilities for temporary facilities and controls indicated in this Section and in Section 015000 "Temporary Facilities and Controls," each contractor is responsible for the following:
1. Installation, operation, maintenance, and removal of each temporary facility necessary for its own normal construction activity, and costs and use charges associated with each facility, except as otherwise provided for in this Section.
 2. Plug-in electric power cords and extension cords, supplementary plug-in task lighting, and special lighting necessary exclusively for its own activities.
 3. Its own field office, complete with necessary furniture, utilities, and telephone service.
 4. Its own storage and fabrication sheds.
 5. Temporary enclosures for its own construction activities.
 6. Staging and scaffolding for its own construction activities.
 7. General hoisting facilities for its own construction activities, up to 2 tons (2000 kg).
 8. Waste disposal facilities, including collection and legal disposal of its own hazardous, dangerous, unsanitary, or other harmful waste materials.
 9. Progress cleaning of work areas affected by its operations on a daily basis.
 10. Secure lockup of its own tools, materials, and equipment.
 11. Construction aids and miscellaneous services and facilities necessary exclusively for its own construction activities.
- D. Temporary Heating, Cooling, and Ventilation: Project coordinator] is responsible for temporary heating, cooling, and ventilation, including utility-use charges, temporary meters, and temporary connections.
- E. Use Charges: Comply with the following:
1. Water Service: Include the cost for water service, whether metered or otherwise, for water used by all entities engaged in construction activities at Project site in the General Construction Contract.
 2. Electric Power Service: Include the cost for electric power service, whether metered or otherwise, for electricity used by all entities engaged in construction activities at Project site in the General Construction Contract.
- 1.7 GENERAL CONSTRUCTION CONTRACT
- A. Supply all necessary materials, labor, services, equipment, and tools required to perform the following site General Construction, work for the UV Replacement and Rooftop HVAC Units. All work to be installed in strict accordance with Specifications and Drawings.
- B. Supply all necessary materials, equipment, devices and labor for implementation and up-keep of site safety as it relates to this scope of work, to meet or exceed OSHA and / or safety agencies having jurisdiction on this project. Any and all costs resulting from OSHA sited violations will be the complete responsibility of this subcontractor.
- C. This project is a prevailing wage project, and it is the responsibility of this sub-contractor to ensure that all of the latest rules and regulations published by the NYS Department of Labor, Wage and Workplace Standards Division, Public Contract Compliance Unit are strictly followed and adhered to. In the events of an audit conduct by the NYS Department of Labor, this sub-contractor will be responsible for any and all costs associated with the audit and the Departments' final decision.

- D. Work in the General Construction Contract includes, but is not limited to, the following:
1. Ceiling tile removal and installation. Provide replacement tiles and grid if damaged during removal.
 2. Supply all materials, labor, equipment, and tools for installation of metal stud partition to encase new ductwork, relief air gypsum enclosures, and HVAC lines.
 3. Supply all materials, labor, equipment, and tools to install and finish gypsum at newly constructed metal stud chases, wall area, and masonry walls. Finish and paint all new surfaces, and any damaged existing surfaces.
 4. Supply all materials, labor, equipment, and tools to install all access panels, patch and paint all disturbed areas.
 5. Supply and install all necessary blocking, anchors, and hangers to support and secure ductwork, and roof curbs.
 6. Supply all materials, labor, equipment, and tools to modify/construct all interior walls, gypsum and masonry patching and paint as required.
 7. File, pay for, and obtain all required permit, inspections and approvals.
 8. Schedule and perform all inspections required by this scope of work.
 9. Removal and disposal of daily generated debris. Upon completion of this contractor's work, all excess materials and debris in the building and site are to be removed and disposed of promptly.
 10. Cut and patch roofing. The roof has a 5-year-old Tremco built-up roof. Contractor shall comply with Tremco standards to extend warranty to new areas.
 11. Fabricate, install, and paint all line set enclosures.
 12. This is a prevailing wage project.
 13. Structural work for installation of roof top units.
 14. Cut and install FAI in existing insulating panel, louver to be provided by HVAC contractor.

1.8 PLUMBING CONTRACT – VOID, NOT IN CONTRACT

1.9 HVAC CONTRACT

- A. Supply all necessary materials, labor, services, equipment and tools required to perform the following site electrical work for the UV Replacement and Rooftop HVAC Units. All work to be installed in strict accordance with Specifications and Drawings.
- B. Supply all necessary materials, equipment, devices and labor for implementation and up-keep of site safety as it relates to this scope of work, to meet or exceed OSHA and / or safety agencies having jurisdiction on this project. Any and all costs resulting from OSHA sited violations will be the complete responsibility of this subcontractor
- C. This project is a prevailing wage project and it is the responsibility of this sub-contractor to ensure that all of the latest rules and regulations published by the NYS Department of Labor, Wage and Workplace Standards Division, Public Contract Compliance Unit are strictly followed and adhered to. In the events of an audit conduct by the NYS Department of Labor, this sub-contractor will be responsible for any and all costs associated with the audit and the Departments' final decision.
- D. Work in the HVAC Contract includes, but is not limited to, the following:
1. Remaining work not identified as work under other contracts.
 2. Curbs, RTUs/UV's, and accessories to be hoisted onto the roof or required floor level.
 3. Assemble roof curbs and dunnage, set in place, anchor, and flash to roof structure.
 4. Supply and install galvanized supply and return curb transitions.
 5. Install RTUs onto curbs and weather-tight.
 6. Install all RTU accessories, including filters.
 7. Install UV's and new cabinets, associated ductwork work and duct/pipe insulation.
 8. Install thermostats connect to BMS and make connections at RTUs and UV's.
 9. Program thermostats for heat, cooling, and occupied & unoccupied times.
 10. Make all supply and return ductwork connections.

11. Start up and test RTUs/UV's for heat. Cooling and fresh air where applicable.
12. Adjust all volume dampers and diffusers to provide proper air flow.
13. Make all ductwork connections for fans.
14. Test all fans.
15. Balance system as per specifications.
16. File, pay for, and obtain all required permit, inspections, and approvals.
17. Schedule and perform all inspections required by this scope of work.
18. Removal and disposal of daily generated debris.
19. Demolition of existing system that are being replaced.
20. Upon completion of this contractor's work, all excess materials and debris in the building and site are to be removed and disposed of promptly.
21. Integrate with current BMS system.
22. This is a prevailing wage project.
23. Installation of duct smoke detectors, provided by the Electrical Engineer.
24. Provide general contractor FAI louver for insulated panel.

E. Temporary facilities and controls in the HVAC Contract include, but are not limited to, the following:

1. Temporary facilities and controls that are not otherwise specifically assigned to the Plumbing Contract.
2. Temporary enclosure for building exterior.
3. Temporary roads and paved areas.
4. Project identification and temporary signs.
5. General waste disposal facilities.
6. Temporary fire-protection facilities.
7. Barricades, warning signs, and lights.
8. Site enclosure fence.
9. Security enclosure and lockup.
10. Environmental protection.
11. Restoration of Owner's existing facilities used as temporary facilities.

1.10 ELECTRICAL CONTRACT

- A. Supply all necessary materials, labor, services, equipment and tools required to perform the following site electrical work for the UV Replacement and Rooftop HVAC Units. All work to be installed in strict accordance with Specifications and Drawings.
- B. Supply all necessary materials, equipment, devices and labor for implementation and up-keep of site safety as it relates to this scope of work, to meet or exceed OSHA and / or safety agencies having jurisdiction on this project. Any and all costs resulting from OSHA cited violations will be the complete responsibility of this subcontractor
- C. This project is a prevailing wage project and it is the responsibility of this sub-contractor to ensure that all of the latest rules and regulations published by the NYS Department of Labor, Wage and Workplace Standards Division, Public Contract Compliance Unit are strictly followed and adhered to. In the events of an audit conduct by the NYS Department of Labor, this sub-contractor will be responsible for any and all costs associated with the audit and the Departments' final decision.
- D. Work in the Electrical Contract includes, but is not limited to, the following:
 1. Supply and install all electrical materials, devices, and equipment for the RTU, UV, heat pumps .
 2. Supply and install complete electrical service from source to new RTU's, heat pumps.
 3. Supply and install complete electrical service from source to new RTU Condenser units.
 4. Supply and install RTU disconnects and make electrical connections.
 5. Supply and install RTU maintenance receptacles and make electrical connections.
 6. Disconnect and reconnect electrical connection to UV's .
 7. Test all site installed systems.
 8. Test all factory installed systems.
 9. File and obtain and pay for all required permits, inspections, and approval.

10. Schedule and perform all inspections required by this scope of work.
11. Start up RTUs
12. Supply, install and coordinate fire alarm wiring and devices. Provide duct detectors to HVAC Contractor for installation.
13. Removal and disposal of daily generated debris.
14. Upon completion of this contractor's work, all excess materials and debris in the building, connecting link and site are to be removed and disposed of promptly, and site restored to original condition.
15. This is a prevailing wage project.

E. Temporary facilities and controls in the Electrical Contract include, but are not limited to, the following:

1. Electric power service and distribution.
2. Electrical connections to existing systems and temporary facilities and controls furnished by the General Construction Contract, Plumbing Contract, HVAC Contract, Electrical Contract,.

PART 2 - PRODUCTS (Not Used)

PART 3 - EXECUTION (Not Used)

END OF SECTION 011200



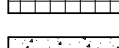
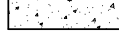









UNIVENT REPLACEMENT AT HAVERSTRAW ELEMENTARY

HAVERSTRAW ELEMENTARY SCHOOL
16 Grant Street
Haverstraw, NY 10927
SED# 50-02-01-06-0-009-018


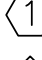

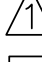
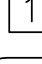
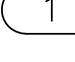
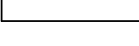
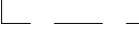


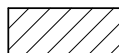
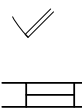
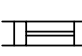
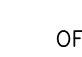
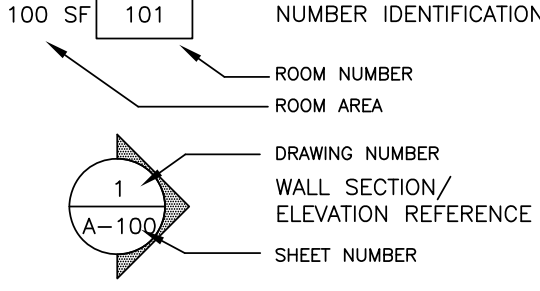
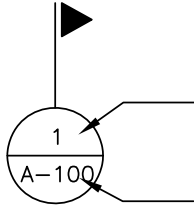

OWNER:
NORTH ROCKLAND
CENTRAL SCHOOL DISTRICT
65 Chapel Street
Garnerville, NY 10923

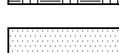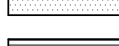ARCHITECT:
MICHAEL SHILALE ARCHITECTS, LLP
140 Park Avenue
New City, NY 10956

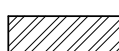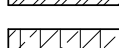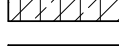**PME ENGINEER:
GREENMAN-PEDERSON, INC.
400 Rella Boulevard, Suite 207
Montabello, NY 10901**

	CONCRETE MASONRY UNIT
	BRICK
	RIGID INSULATION
	CONCRETE
	GRAVEL OR STONE
	EARTH
	EIFS
	ASPHALT PAVING
	SAND/MORTAR/GYPSUM BOARD
	STEEL
	ACT
	ROUGH WOOD
	BRONZE

MATERIALS LEGEND

	DOOR NUMBER
	KEY NOTE
	PARTITION TYPE
	REVISION NUMBER
	WINDOW TYPE
	MECHANICAL EQUIPMENT
	EXISTING PARTITION
	EXISTING PARTITION TO BE REMOVED
	NEW PARTITION (SEE PARTITION LEGEND A-101)
	NEW DOOR
	EXISTING DOOR
	EXISTING DOOR TO BE REMOVED
	EXISTING WINDOW
	NEW WINDOW
	
	
	

SYMBOLS LEGEND

1. ALL PLAN DIMENSIONS ARE NOMINAL U.O.N. DIMENSIONS TO THE FINISHED FACE OF AN ELEMENT OR WALL WILL BE DESIGNATED WITH AN "F" AS SHOWN.
2. G.C. TO VERIFY ALL DIMENSIONS IN THE FIELD AND IS TO NOTIFY ARCHITECT IF THERE ARE ANY DISCREPANCIES.

GENERAL NOTES

ALTERNATE NO. 1: WORK PHASING. PHASE A TO BE IN SUMMER OF 2022 AND PHASE B TO BE IN SUMMER OF 2023. SEE ARCHITECTURAL AND MECHANICAL FLOOR PLANS FOR PHASE A AND PHASE B LOCATIONS.

ALTERNATE NO. 2: WORK PHASING, PHASE A TO BE IN SUMMER OF 2022 AND PHASE B TO BE DURING FALL OF 2022 2ND SHIFT. SEE ARCHITECTURAL AND MECHANICAL FLOOR PLANS FOR PHASE A AND PHASE B LOCATIONS.

ALTERNATES

DRAWING No.	DRAWING TITLE	DATE
A-000	COVER SHEET	01-24-22
B-100	CODE ANALYSIS	12-17-21
S-101	ROOF PLAN & GENERAL NOTES	12-17-21
S-102	ROOF PARTIAL PLANS	12-17-21
S-103	SECTIONS & TYPICAL DETAILS	12-17-21
S-104	SECTIONS & TYPICAL DETAILS S-2	12-17-21
D-101	FIRST FLOOR DEMO PLAN	12-17-21
D-102	SECOND FLOOR DEMO PLAN	12-17-21
D-103	THIRD FLOOR DEMO PLAN	12-17-21
D-104	ROOF DEMO PLAN	12-17-21
A-101	PROPOSED FIRST FLOOR PLAN	01-24-22
A-102	PROPOSED SECOND FLOOR PLAN	01-24-22
A-103	PROPOSED THIRD FLOOR PLAN	01-24-22
A-104	PROPOSED ROOF PLAN	12-17-21
A-400	REFLECTED CEILING PLAN	12-17-21
A-500	DETAILS	12-17-21
A-501	UNIT ELEVATIONS	12-17-21
A-501.1	UNIT ELEVATIONS	12-17-21
A-502	DETAILS	12-17-21
A-503	DETAILS	12-17-21
M-001	MECHANICAL NOTES	01-24-22
M-002	MECHANICAL SCHEDULES	01-24-22
M-003	MECHANICAL SCHEDULES 2	01-24-22
M-004	CONTROLS	01-24-22
M-005	VENTILATION SCHEDULE	12-17-21
M-006	UV SCHEDULE	01-24-22
M-061	HVAC DEMO FIRST FLOOR PLAN	01-24-22
M-062	HVAC DEMO SECOND FLOOR PLAN	01-24-22
M-063	HVAC DEMO THIRD FLOOR PLAN	01-24-22
M-101	FIRST FLOOR PLAN MECHANICAL	01-24-22
M-102	SECOND FLOOR PLAN MECHANICAL	01-24-22
M-103	THIRD FLOOR PLAN MECHANICAL	01-24-22
M-104	ROOF PLAN MECHANICAL	01-24-22
M-301	HVAC PIPING - 1ST FLOOR PLAN	12-17-21
M-302	HVAC PIPING - 2ND FLOOR PLAN	12-17-21
M-303	HVAC PIPING - 3RD FLOOR PLAN	12-17-21
M-401	VRF PIPING RISERS	12-17-21
M-501	MECHANICAL DETAILS	01-24-22
M-502	MECHANICAL DETAILS 2	12-17-21
FA-001	FIRE ALARM SYSTEM COVER SHEET	12-17-21
FA-101	THIRD FLOOR PLAN FIRE ALARM	12-17-21
FA-102	ROOF PLAN FIRE ALARM	12-17-21
E-001	ELECTRICAL COVER SHEET	12-17-21
E-060	BASEMENT DEMO PLAN ELECTRICAL	12-17-21
E-061	FIRST FLOOR ELECTRICAL DEMO PLAN	12-17-21
E-062	SECOND FLOOR ELECTRICAL DEMO PLAN	12-17-21
E-063	THIRD FLOOR ELECTRICAL DEMO PLAN	12-17-21
E-100	BASEMENT PLAN ELECTRICAL	12-17-21
E-101	FIRST FLOOR PLAN ELECTRICAL	12-17-21
E-102	SECOND FLOOR PLAN ELECTRICAL	12-17-21
E-103	THIRD FLOOR PLAN ELECTRICAL	12-17-21
E-104	ROOF PLAN ELECTRICAL	12-17-21
E-201	ELECTRICAL SCHEDULES & RISER	12-17-21
E-301	ELECTRICAL DETAILS	12-17-21

LIST OF DRAWINGS

ACT ACoustical CEILING TILE
A.F.F. ABOVE FINISH FLOOR
ASPH ASPHALT
BLK BLOCK
BLK'G BLOCKING
BUR BUILT UP ROOFING
GLG CEILING
CONC CONCRETE
CONT CONTINUOUS
CONTR CONTRACT JOINT
C.J. DOWN
DN DOWN
DIA DIAMETER
DRAW DRAWING
E.F. EACH FACE
EIFS EXTERIOR INSULATION
S.F. SQUARE FEET
E.W. EACH WAY
E.W.C. ELECTRICAL WATER COOLER
E.C. ELECTRICAL CABLE
ELC ELECTRICAL CONTRACTOR
EXIST EXISTING
EXPAN EXPANSION
EXT'G EXISTING
EXTR EXTERIOR
FP FIREPROOF
FN FINISHED
G GAUGE
GC GENERAL CONTRACTOR
GALV GALVANIZED
GL GLASS
GWB GYPSUM WALL BOARD
HLM HALF METAL
H.P. HIGH POINT
HAC HEATING & A/C CONTRACTOR
H.W.L. HYDRAULIC TREATMENT ROOM
JT JOINT
LAM LAMINATE
LAVTORY LAUNDRY
LP LOW POINT
MAX MAXIMUM
MFR MANUFACTURER
MTL METAL
MIN MINIMUM
MO MASONRY OPENING
NO NOT IN CONTRACT
NO. NUMBER
ON ON CENTER
OP'NG OPENING
PBC PLUMBING CONTRACTOR
PLAS.LAM. PLASTIC LAMINATE
PL PLATE
PLY'D PLWOOD
RAD RADIUS
REF.CLG. REFLECTED CEILING
REQ. REQUIRED
RO ROUGH OPENING
SIM SIMILAR
STL STEEL
SUSP.CLG. SUSPENDED CEILING
TOP. TOP OF MASONRY
T.O.S. TOP OF STEEL
TYP. TYPICAL
U.O.N. UNLESS OTHERWISE NOTED
V.I.F. VERTICAL FIELD
VCT VINYL COMPOSITE TILE
W/ WITH
W/ WOOD

ALLOWANCE NO. 1: PROVIDE ALLOWANCE TO CLEAN EXISTING MAIN DUCTWORK FOR 20 LINEAR FEET PER UNIT.

ALLOWANCE NO. 2: PROVIDE ALLOWANCE TO REPLACE EXISTING SUPPLY AND RETURN PIPING AND INSULATION FOR 20 LINEAR FEET PER UNIT.

ALLOWANCE NO. 3: PROVIDE A PROPOSAL FROM A THIRD PARTY HVAC COMMISSIONING AGENT CONTRACTOR IS TO INCLUDE THIS AMOUNT IN THEIR BASE BID. THE CONTRACTOR WILL ISSUE A CREDIT CHANGE ORDER TO THE OWNER FOR THE COMMISSIONING PROPOSAL AMOUNT, OWNER WILL CONTRACT DIRECTLY WITH THE COMMISSIONING AGENT.

ALLOWANCE NO. 4: PROVIDE ALLOWANCE FOR THE RELOCATION OF 10 TO ELECTRICAL DEVICES THAT REQUIRE RELOCATION DUE TO THE INCREASED SIZE OF THE NEW UNIT VENTILATORS.

ALLOWANCE NO. 5: CONTRACTOR TO INCLUDE ALLOWANCE FOR LF OF LINE SET ENCLOSURE NOTED ON DRAWINGS.

ALLOWANCE NO. 6: CONTRACTOR SHALL INCLUDE IN THEIR BID AN ALLOWANCE FOR 10' OF PIPING/ INSULATION FOR EACH UV AND 20' AT EACH RTU. SEE DRAWINGS 3/M-501 AND 4/M-501.

ALLOWANCE NO. 7: CONTRACTOR TO INCLUDE ALLOWANCE FOR LF OF WIRE MOLD, NOTED ON DRAWINGS.

ALLOWANCES

UNIT PRICE NO. 1:
PROVIDE UNIT PRICE TO INCREASE OR
REDUCE BY 10'-0" THE LINE SET COVER.
SEE DETAIL 5/A-500.

UNIT PRICE NO. 2:
PROVIDE UNIT PRICE PER SQUARE FOOT OF
VCT REPLACEMENT.

UNIT PRICE NO. 3:
PROVIDE A UNIT PRICE FOR LF OF WOOD
BASE REPLACEMENT.

UNIT PRICE NO. 4:
PROVIDE A UNIT PRICE TO INCREASE OR
REDUCE BY 10'-0" OF WIRE MOLD.

UNIT PRICE NO. 5:
PROVIDE A UNIT PRICE TO INCREASE OR
REDUCE BY 10'-0" OF PIPING/INSULATION.

UNIT PRICES

IF THIS BAR DOES NOT MEASURE 1" THEN DRAWING IS NOT TO FULL SCALE

IT IS A VIOLATION OF THE LAW FOR ANY PERSON, UNLESS ACTING UNDER THE DIRECTION OF A LICENSED ARCHITECT, TO ALTER AN ITEM IN ANY WAY.

No.	Date	Revisions
1	08-30-21	BIDDING DOCUMENTS
2	11-19-21	SED ADDENDUM 1
3	12-17-21	ISSUED FOR BID
4	01-14-21	ADDENDUM 1
5	01-24-21	ADDENDUM 3

Drawn by	MAL
Checked by	MS/JC
Project No.	41048
Scale	AS NOTED
Date	08-30-21

Mechanical & Electrical Engineer:	GREENMAN PEDERSEN, INC 400 RELLA BOULEVARD MONTEBELLO, NY 10901
Structural Engineer:	— — — —

UNIVENT REPLACEMENT
AT
HAVERSTRAW
ELEMENTARY
SED# 50-02-01-06-0-009-018
16 Court Street
Haverstraw, NY 10827
COUNTY OF ROCKLAND



MICHAEL SHILALE ARCHITECTS, L.L.P.
140 Park Avenue New City, NY 10956 Tel 845-708-0200
www.shilale.com

Drawing Title	COVER SHEET
Drawing No.	A-000

© COPYRIGHT, MICHAEL SHILALE ARCHITECTS LLP, ALL RIGHTS RESERVED.

EXISTING THROUGH WALL LOUVER

SUPPLY REGISTER

NEW UNIT VENT

UV-00

NEW FAN COIL UNIT

FC-00

NEW CASSETTE

CS-00

EXISTING UNIT VENT (TO REMAIN)

EXISTING UNIT VENT (TO BE REMOVED)

NEW RELIEF VENT ENCLOSURE

RA

AREA OF NEW ROOF

*LF

WM

WIRE MOLD NUMBER INDICATES AMOUNT OF LINEAR FEET FOR EACH ROOM. SEE DETAIL 7/A-500

*LF

LE

LINE SET ENCLOSURE NUMBER INDICATES AMOUNT OF LINEAR FEET FOR EACH ROOM. SEE DETAIL 6/A-500

LEGEND

A1

INSTALL NEW UNIT VENTILATORS.

A2

INSTALL NEW CEILING AS REQUIRED: 095113. INSTALL DUCTS AND REGISTERS AS REQUIRED.

A3

REMOVE EXISTING CEILING TO ACCESS DUCT WORK. REPLACE WITH NEW CLG TILE: 095113

A4

PROVIDE NEW FIN TUBE ENCLOSURES IN ENTIRE ROOM.

A5

VOID

A6

REROUTE EXISTING ELECTRICAL SUPPLY TO NEW CEILING MOUNTED UNIT.

A7

PROVIDE METAL STUD AND GYPSUM ENCLOSURE AROUND NEW INTAKE AIR DUCT AT FLOOR LEVEL AND DUCT TO CEILING. MODIFY GYPSUM CEILING FOR NEW DUCT.

A8

CONSTRUCT GYPSUM ENCLOSURE TO COVER RELIEF AIR DUCT. COORDINATE WITH MECHANICAL DRAWINGS AND DRAWING 5/A-500.

A9

INSTALL NEW GYPSUM SOFFIT FOR NEW CEILING MOUNTED UNIT VENTILATORS. SEE: DRAWINGS 1/A-502 AND 2/A-502.

A10

INSTALL NEW ACCESS PANEL IN PLASTER CEILING.

A11

PATCH EXISTING MASONRY AT DUCTWORK PENETRATIONS IN FAN ROOM.

A12

PATCH AND PAINT EXISTING PLASTER CEILING WHERE NEW UNIT IS MOUNTED IN CEILING.

A13

INSTALL LINESET AND POWER ABOVE CEILING AND IN TO CHASE FOR HVAC UNITS. ALL WIRE AND MECHANICAL EQUIPMENT SHALL BE CONCEALED.

A14

REINSTALL EXISTING DOORS TO SWING IN DIRECTION OF EGRESS.

A15

INSTALL NEW HOLLOW METAL DOOR AT BOILER ROOM. PROVIDE 1 1/2" HR LABEL DOOR WITH CLOSER. REUSE EXISTING LOCKSET. PAINT DOOR AND FRAME (COLOR BY ARCHITECT)(BOILER ROOM DOOR IN BASEMENT)

A16

PROVIDE AND INSTALL (1) 10 LB FIRE EXTINGUISHER AT SELECTED LOCATION.

A17

SAW CUT PLASTER CEILING FOR INSTALLATION OF HVAC COMBINER BOX. REINSTALL EXISTING CEILING TILE.

A18

PATCH WALL WHERE EXISTING UNIVENT IS REMOVED. PAINT TO MATCH EXISTING.

A19

REMOVE EXISTING DOOR TO UNDERCUT EXISTING DOOR TO ALLOW FOR 2" AIR SPACE. REINSTALL DOOR.

A20

GLAZING PANEL IN AREA TO BE REMOVED AND TESTED TO DETERMINE THAT IT IS SAFETY GLAZING. GLAZING TO BE REPLACED WITH LAMINATED GLAZING. OWNER AND ARCHITECT TO DETERMINE WHICH PANELS TO BE REMOVED.

A21

CONSTRUCT NEW CLOSET TO HOUSE NEW AC UNIT. COORDINATE CLOSET SIZING WITH UNIT. PROVIDE NEW DOOR AND FINISHES. CONFIRM SIZE AND COLOR WITH OWNER AND ARCHITECT.

KEY NOTES

1.

CONTRACTOR SHALL BE REQUIRED TO CORE DRILL ALL HOLES IN WALLS, FLOORS AND CEILINGS TO FACILITATE NEW LINESETS, ELECTRICAL CONDUITS AND CONDENSATE LINES.

2.

PATCH EXISTING VCT FLOORING AT BASE UNDER UNI-VENT.

3.

WIRE MOLD RUNS ALONG THE EXISTING TRIM UNDER WINDOW SILL INTO RELIEF VENT FOR FIRST AND SECOND FLOORS UNLESS OTHERWISE NOTED. CONTRACTOR WILL REVIEW LAYOUT WITH ARCHITECT/OWNER PRIOR TO INSTALLATION.

4.

WIRE MOLD RUNS UP WALL 9FT ABOVE DROPPED CEILING, THEN DOWN 5FT INTO RELIEF VENT FOR 3RD FLOOR ONLY. CONTRACTOR WILL REVIEW LAYOUT WITH ARCHITECT/OWNER PRIOR TO INSTALLATION.

GENERAL NOTES

NOTE: ALL LINE SETS AND ELECTRICAL CONDUIT IN CORRIDOR SHALL BE ABOVE THE EXISTING ACT CEILING.

5

NOTE: FLASH PATCH EXISTING CONCRETE AT NEW UV LOCATIONS AND INSTALL NEW VCT/WOOD TO MATCH EXISTING MATERIAL. COLOR TO BE SELECTED BY OWNER.

5

NOTE: ANY GC WORK NOT RELATED TO INSTALLATION OF MECHANICAL EQUIPMENT TO BE PART OF PHASE A.

5

PHASE B WORK. ALL WORK REGARDING UV AND CU INSTALLATION WITHIN THIS AREA TO BE PERFORMED IN PHASE B.

PHASE A WORK. ALL WORK REGARDING UV AND CU INSTALLATION WITHIN THIS AREA TO BE PERFORMED IN PHASE A.

1

A-400

2

A-400

3

A-400

4

A-400

STAIRWAY 100A

STAIRWAY 100B

STAIRWAY 100C

STAIRWAY 100D

STAIRWAY 100E

STAIRWAY 100F

STAIRWAY 100G

STAIRWAY 100H

STAIRWAY 100I

STAIRWAY 100J

STAIRWAY 100K

STAIRWAY 100L

STAIRWAY 100M

STAIRWAY 100N

STAIRWAY 100O

STAIRWAY 100P

STAIRWAY 100Q

STAIRWAY 100R

STAIRWAY 100S

STAIRWAY 100T

STAIRWAY 100U

STAIRWAY 100V

STAIRWAY 100W

STAIRWAY 100X

STAIRWAY 100Y

STAIRWAY 100Z

STAIRWAY 100AA

STAIRWAY 100AB

STAIRWAY 100AC

STAIRWAY 100AD

STAIRWAY 100AE

STAIRWAY 100AF

STAIRWAY 100AG

STAIRWAY 100AH

STAIRWAY 100AI

STAIRWAY 100AJ

STAIRWAY 100AK

STAIRWAY 100AL

STAIRWAY 100AM

STAIRWAY 100AN

STAIRWAY 100AO

STAIRWAY 100AP

STAIRWAY 100AQ

STAIRWAY 100AR

STAIRWAY 100AS

STAIRWAY 100AT

STAIRWAY 100AU

STAIRWAY 100AV

STAIRWAY 100AW

STAIRWAY 100AX

STAIRWAY 100AY

STAIRWAY 100AZ

STAIRWAY 100BA

STAIRWAY 100BB

STAIRWAY 100BC

STAIRWAY 100BD

STAIRWAY 100BE

STAIRWAY 100BF

STAIRWAY 100BG

STAIRWAY 100BH

STAIRWAY 100BI

STAIRWAY 100BJ

STAIRWAY 100BK

STAIRWAY 100BL

STAIRWAY 100BM

STAIRWAY 100BN

STAIRWAY 100BO

STAIRWAY 100BP

STAIRWAY 100BQ

STAIRWAY 100BR

STAIRWAY 100BS

STAIRWAY 100BT

STAIRWAY 100ZI

STAIRWAY 100ZJ

STAIRWAY 100ZK

STAIRWAY 100ZL

STAIRWAY 100ZM

STAIRWAY 100ZN

STAIRWAY 100ZO

STAIRWAY 100ZP

STAIRWAY 100ZQ

STAIRWAY 100ZR

STAIRWAY 100ZS

STAIRWAY 100ZT

STAIRWAY 100ZU

STAIRWAY 100ZV

STAIRWAY 100ZW

STAIRWAY 100ZX

STAIRWAY 100ZY

STAIRWAY 100ZZ

PLAN NORTH

0

1/2

1

IF THIS BAR DOES NOT MEASURE 1" THEN DRAWING IS NOT TO FULL SCALE

IT IS A VIOLATION OF THE LAW FOR ANY PERSON, UNLESS ACTING UNDER THE DIRECTION OF A LICENSED ARCHITECT, TO ALTER AN ITEM IN ANY WAY.

Drawn by

Checked by

Project No.

Scale

Date

GREENMAN PEDERSEN, INC

400 BELLA BOULEVARD

MONTEBELLO, NY 10001

Mechanical & Electrical Engineer.

Structural Engineer.

UNIVENT REPLACEMENT AT HAVERSTRAW ELEMENTARY

SED# 50-02-01-06-0-009-018

18 Grant Street

Haverstraw, NY 10627

COUNTY OF ROCKLAND

PROPOSED FIRST FLOOR PLAN

Drawing No.

A-101

© COPYRIGHT, MICHAEL SHILALE ARCHITECTS, ALL RIGHTS RESERVED.

Drawing Title

Proposed First Floor Plan

Michael Shilale Architects, L.L.P.

140 Park Avenue New York, NY 10022 Tel 945-064900

www.mshilale.com

EXISTING THROUGH WALL LOUVER

SUPPLY REGISTER

NEW UNIT VENT

UV-00

NEW FAN COIL UNIT

FC-00

NEW CASSETTE

CS-00

EXISTING UNIT VENT (TO REMAIN)

EXISTING UNIT VENT (TO BE REMOVED)

NEW RELIEF VENT ENCLOSURE

AREA OF NEW ROOF

*LF

WM

WIRE MOLD NUMBER INDICATES AMOUNT OF LINEAR FEET FOR EACH ROOM. SEE DETAIL 7/A-500

*LF

LE

LINE SET ENCLOSURE NUMBER INDICATES AMOUNT OF LINEAR FEET FOR EACH ROOM. SEE DETAIL 6/A-500

LEGEND

A1

INSTALL NEW UNIT VENTILATORS.

A2

INSTALL NEW CEILING AS REQUIRED: 095113. INSTALL DUCTS AND REGISTERS AS REQUIRED.

A3

REMOVE EXISTING CEILING TO ACCESS DUCT WORK. REPLACE WITH NEW CLG TILE: 095113

A4

PROVIDE NEW FIN TUBE ENCLOSURES IN ENTIRE ROOM.

A5

VOID

A6

REROUTE EXISTING ELECTRICAL SUPPLY TO NEW CEILING MOUNTED UNIT.

A7

PROVIDE METAL STUD AND GYPSUM ENCLOSURE AROUND NEW INTAKE AIR DUCT AT FLOOR LEVEL AND DUCT TO CEILING. MODIFY GYPSUM CEILING FOR NEW DUCT.

A8

CONSTRUCT GYPSUM ENCLOSURE TO COVER RELIEF AIR DUCT. COORDINATE WITH MECHANICAL DRAWINGS AND DRAWING 5/A-500.

A9

INSTALL NEW GYPSUM SOFFIT FOR NEW CEILING MOUNTED UNIT VENTILATORS. SEE DRAWINGS 1/A-502 AND 2/A-502.

A10

INSTALL NEW ACCESS PANEL IN PLASTER CEILING.

A11

PATCH EXISTING MASONRY AT DUCTWORK PENETRATIONS IN FAN ROOM.

A12

PATCH AND PAINT EXISTING PLASTER CEILING WHERE NEW UNIT IS MOUNTED IN CEILING.

A13

INSTALL LINESET AND POWER ABOVE CEILING AND IN TO CHASE FOR HVAC UNITS. ALL WIRE AND MECHANICAL EQUIPMENT SHALL BE CONCEALED.

A14

REINSTALL EXISTING DOORS TO SWING IN DIRECTION OF EGRESS.

A15

INSTALL NEW HOLLOW METAL DOOR AT BOILER ROOM. PROVIDE 1 1/2" HR LABEL DOOR WITH CLOSER. REUSE EXISTING LOCKSET. PAINT DOOR AND FRAME (COLOR BY ARCHITECT)(BOILER ROOM DOOR IN BASEMENT)

A16

PROVIDE AND INSTALL (1) 10 LB FIRE EXTINGUISHER AT SELECTED LOCATION.

A17

SAW CUT PLASTER CEILING FOR INSTALLATION OF HVAC COMBINER BOX. REINSTALL EXISTING CEILING TILE.

A18

PATCH WALL WHERE EXISTING UNIVENT IS REMOVED. PAINT TO MATCH EXISTING.

A19

REMOVE EXISTING DOOR TO UNDERCUT EXISTING DOOR TO ALLOW FOR 2" AIR SPACE. REINSTALL DOOR.

A20

GLAZING PANEL IN AREA TO BE REMOVED AND TESTED TO DETERMINE THAT IT IS SAFETY GLAZING. GLAZING TO BE REPLACED WITH LAMINATED GLAZING. OWNER AND ARCHITECT TO DETERMINE WHICH PANELS TO BE REMOVED.

A21

CONSTRUCT NEW CLOSET TO HOUSE NEW AC UNIT. COORDINATE CLOSET SIZING WITH UNIT. PROVIDE NEW DOOR AND FINISHES. CONFIRM SIZE AND COLOR WITH OWNER AND ARCHITECT.

KEY NOTES

1.

CONTRACTOR SHALL BE REQUIRED TO CORE DRILL ALL HOLES IN WALLS, FLOORS AND CEILINGS TO FACILITATE NEW LINESETS, ELECTRICAL CONDUITS AND CONDENSATE LINES.

2.

PATCH EXISTING VCT FLOORING AT BASE UNDER UNI-VENT.

3.

WIRE MOLD RUNS ALONG THE EXISTING TRIM UNDER WINDOW SILL INTO RELIEF VENT FOR FIRST AND SECOND FLOORS UNLESS OTHERWISE NOTED. CONTRACTOR WILL REVIEW LAYOUT WITH ARCHITECT/OWNER PRIOR TO INSTALLATION.

4.

WIRE MOLD RUNS UP WALL 9FT ABOVE DROPPED CEILING, THEN DOWN 5FT INTO RELIEF VENT FOR 3RD FLOOR ONLY. CONTRACTOR WILL REVIEW LAYOUT WITH ARCHITECT/OWNER PRIOR TO INSTALLATION.

GENERAL NOTES

NOTE: ALL LINE SETS AND ELECTRICAL CONDUIT IN CORRIDOR SHALL BE ABOVE THE EXISTING ACT CEILING.

NOTE: FLASH PATCH EXISTING CONCRETE AT NEW UV LOCATIONS AND INSTALL NEW VCT/WOOD TO MATCH EXISTING MATERIAL. COLOR TO BE SELECTED BY OWNER.

NOTE: ANY GC WORK NOT RELATED TO INSTALLATION OF MECHANICAL EQUIPMENT TO BE PART OF PHASE A.

PHASE B WORK. ALL WORK REGARDING UV, CU AND RTU INSTALLATION WITHIN THIS AREA TO BE PERFORMED IN PHASE B.

PHASE A WORK. ALL WORK REGARDING UV AND CU INSTALLATION WITHIN THIS AREA TO BE PERFORMED IN PHASE A.

0 1/2 1

IF THIS BAR DOES NOT MEASURE 1" THEN DRAWING IS NOT TO FULL SCALE

1

PROPOSED SECOND FLOOR PLAN

SCALE: 1/16"=1'-0"

Drawn by

Checked by

Project No.

Scale

Date

MAL

MS/JC

41048

AS NOTED

05-14-21

GREENMAN PEDERSEN, INC

400 BELLA BOULEVARD

MONTEBELLO, NY 10901

Mechanical & Electrical Engineer.

Structural Engineer.

UNIVENT REPLACEMENT AT HAVERSTRAW ELEMENTARY

SED # 50-02-01-06-0-009-018

18 Grant Street Haverstraw, NY 10927

COUNTY OF ROCKLAND

MSA

MICHAEL SHILALE ARCHITECTS, L.L.P.

140 Park Avenue New York, NY 10022 Tel 945-064900

www.mshale.com

Proposed SECOND FLOOR PLAN

Drawing No.

A-102


© COPYRIGHT, MICHAEL SHILALE ARCHITECTS, ALL RIGHTS RESERVED.

Drawing Title

IF THIS BAR DOES NOT MEASURE 1" THEN DRAWING IS NOT TO FULL SCALE

Revisions

No.	Date	Revisions
1	05-14-21	ISSUED FOR BID
2	11-19-21	ADDENDUM 1
3	12-17-21	ADDENDUM 2
4	01-14-22	ADDENDUM 3
5	01-24-22	ADDENDUM 4

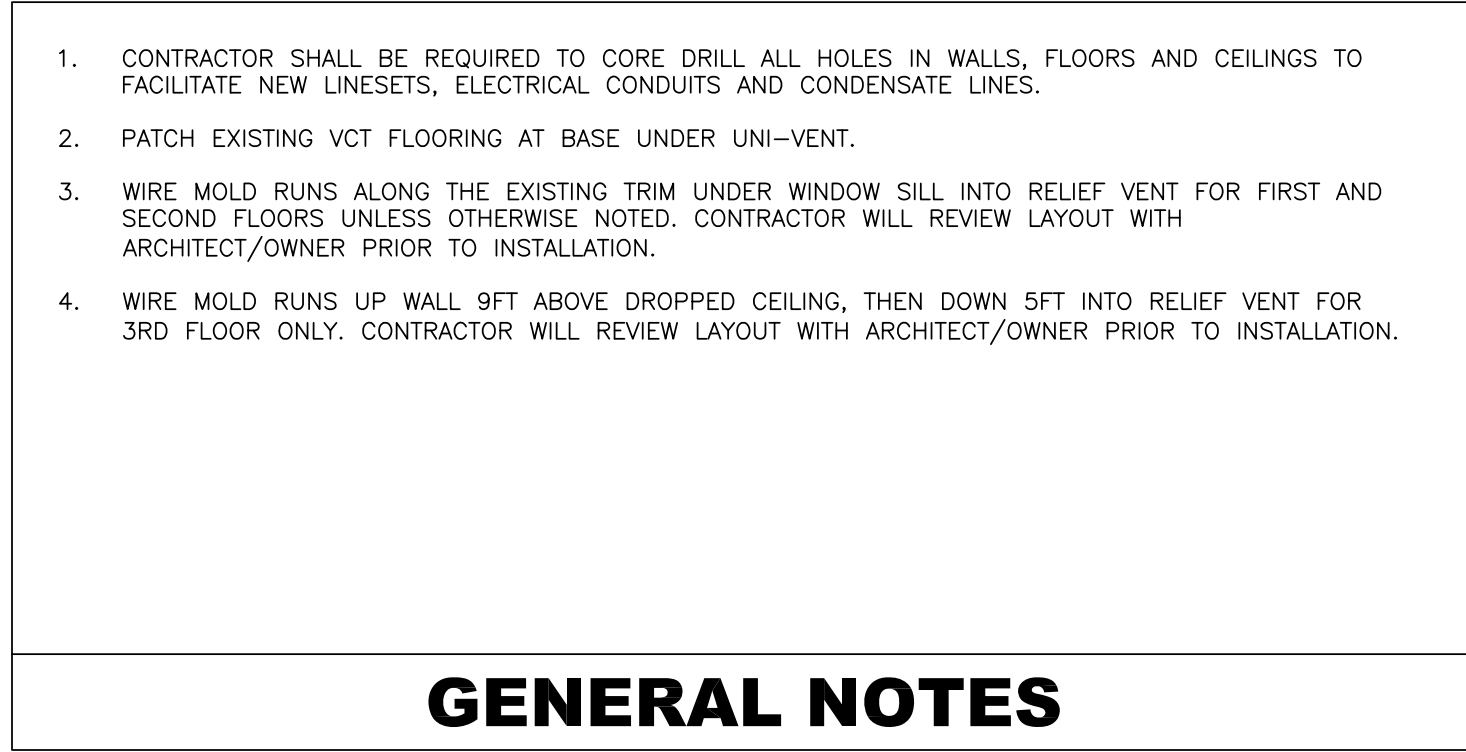

Drawing Title

**PROPOSED
THIRD FLOOR
PLAN**

Drawing No.

A-103

VRF HEAT RECOVERY OUTDOOR CONDENSING UNIT SCHEDULE																		
Tag Reference	Model Number	Modules	Nominal Cooling Capacity (BTU/h)	Nominal Heating Capacity (BTU/h)	Cooling Efficiency IEE/IEER [SEER]	Heating COP @ 47°F [HSPF]	Nom System Connected Capacity (% of NOM)	Design Cooling Outdoor Temp DB (°F)	Design Heating Outdoor Temp WB (°F)	Refrigerant Pipe Dim. (See Note 4)	Corrected Cooling Total Capacity (BTU/h)	Corrected Heating Capacity (BTU/h)	Preliminary Added Field Charge (lbs) (See Note 5)	Electrical 208/230				Notes / Options
														Voltage / Phase	MCA	RFS	MOC	
CU-1	TURYE1683AN40AN	P168	168,000.0	188,000.0	25.7 / 11.55	3.55	95.2%	87.0	10.8	7/8 / 1 1/8	161,812.2	116,233.7	41.4	208/230V / 3-phase 3-wire	57/53	70/70	90/80	SEE NOTES
CU-2	TURYE1683AN40AN	P168	168,000.0	188,000.0	25.7 / 11.55	3.55	89.3%	87.0	10.8	7/8 / 1 1/8	168,904.3	117,081.5	37.2	208/230V / 3-phase 3-wire	57/53	70/70	90/80	SEE NOTES
CU-3	TURYE1683AN40AN	P168	168,000.0	188,000.0	25.7 / 11.55	3.55	97.6%	87.0	10.8	7/8 / 1 1/8	165,288.8	117,637.5	32.5	208/230V / 3-phase 3-wire	57/53	70/70	90/80	SEE NOTES
CU-4	TURYE1683AN40AN	P168	168,000.0	188,000.0	25.7 / 11.55	3.55	92.9%	87.0	10.8	7/8 / 1 1/8	162,384.3	115,947.9	46.6	208/230V / 3-phase 3-wire	57/53	70/70	90/80	SEE NOTES
CU-5	TURYE1683AN40AN	P168	168,000.0	188,000.0	25.7 / 11.55	3.55	88.1%	87.0	10.8	7/8 / 1 1/8	157,289.8	113,679.3	54.5	208/230V / 3-phase 3-wire	57/53	70/70	90/80	SEE NOTES
CU-6	TURYE1443AN40AN	P144	144,000.0	160,000.0	26.9 / 12.3	3.67	91.7%	87.0	10.8	7/8 / 1 1/8	141,585.8	98,636.2	33.5	208/230V / 3-phase 3-wire	49/45	60/60	80/70	SEE NOTES
CU-7	TURYE1203AN40AN	P120	120,000.0	135,000.0	27.55 / 13.2	3.87	76.7%	87.0	10.8	3/4 / 1 1/8	123,425.0	83,382.0	26.0	208/230V / 3-phase 3-wire	41/38	60/60	60/60	SEE NOTES
CU-8	TURYE1443AN40AN	P144	144,000.0	160,000.0	26.9 / 12.3	3.67	97.2%	87.0	10.8	7/8 / 1 1/8	142,210.2	99,763.9	26.8	208/230V / 3-phase 3-wire	49/45	60/60	80/70	SEE NOTES
CU-9	TURYE1683AN40AN	P168	168,000.0	188,000.0	25.7 / 11.55	3.55	100.6%	87.0	10.8	7/8 / 1 1/8	157,679.7	115,937.2	52.3	208/230V / 3-phase 3-wire	57/53	70/70	90/80	SEE NOTES
CU-10	TURYE1683AN40AN	P168	168,000.0	188,000.0	25.7 / 11.55	3.55	94.0%	87.0	10.8	7/8 / 1 1/8	163,431.9	116,457.7	38.9	208/230V / 3-phase 3-wire	57/53	70/70	90/80	SEE NOTES
CU-11	TURYE1443AN40AN	P144	144,000.0	160,000.0	26.9 / 12.3	3.67	70.8%	87.0	10.8	7/8 / 1 1/8	148,717.8	100,475.3	24.9	208/230V / 3-phase 3-wire	49/45	60/60	80/70	SEE NOTES
CU-12	TURYE1683AN40AN	P168	168,000.0	188,000.0	25.7 / 11.55	3.55	89.3%	87.0	10.8	7/8 / 1 1/8	170,280.6	117,464.2	33.9	208/230V / 3-phase 3-wire	57/53	70/70	90/80	SEE NOTES

OUTDOOR CONDENSING UNIT SCHEDULE NOTES:

- NOMINAL COOLING CAPACITIES ARE BASED ON INDOOR COIL EAT OF 80/67°F (DB/WB), OUTDOOR OF 95°F (DB)
- NOMINAL HEATING CAPACITIES ARE BASED ON INDOOR COIL EAT OF 70°F (DB), OUTDOOR OF 43°F (WB)
- EFFICIENCY VALUES FOR EER, IEER, COP ARE BASED ON AHRI 1230 TEST METHOD FOR MIXTURE OF DUCTED & NON-DUCTED INDOOR UNITS.
- FOR SYSTEMS WITH MULTIPLE MODULES, REFRIGERANT PIPE DIMENSIONS INDICATE TOTAL SYSTEM COMBINED PIPING DOWNSTREAM OF MODULE TWINNING.
- ADDED FIELD CHARGE LISTED IS IN ADDITION TO FACTORY CHARGE; THIS MUST BE UPDATED BASED UPON FINAL AS-BUILT PIPING LAYOUT.
- COOLING EFFICIENCY FOR CONDENSING UNITS MUST BE 10% GREATER THAN LIMITS SET IN 2020 ECC NYS C406.2-10.5 EER, 11.8 IEER
- FACTORY REPRESENTATIVES SHALL STARTUP AND COMMISSION CITY MULTI EQUIPMENT UPON COMPLETION OF EQUIPMENT INSTALLATION.
- FACTORY REPRESENTATIVES SHALL PROVIDE ON-SITE ASSISTANCE FOR THE BMS INTEGRATION OF THE CITY MULTI EQUIPMENT.

VRF HEAT RECOVERY BRANCH CIRCUIT CONTROLLER SCHEDULE										
Tag Reference	System Tag	Model Number	Type (double / Main / Sub)	Number of Ports	Connected Capacity to BC	Voltage / Phase	Power Cooling 208V/230V (kW)	Power Heating 208V/230V (kW)	MCA 208/230	Notes / Options
BC-1	CU-1	TCMBM0108JA11N4	Main	8	160,000.0	208/230V/1-phase	0.137/0.176	0.076/0.098	0.83/0.97	1, 2, 3, 4
BC-2	CU-2	TCMBM0108JA11N4	Main	8	150,000.0	208/230V/1-phase	0.137/0.176	0.076/0.098	0.83/0.97	1, 2, 3, 4
BC-3	CU-3	TCMBM0108JA11N4	Main	8	164,000.0	208/230V/1-phase	0.137/0.176	0.076/0.098	0.83/0.97	1, 2, 3, 4
BC-4	CU-4	TCMBM0108JA11N4	Main	8	156,000.0	208/230V/1-phase	0.137/0.176	0.076/0.098	0.83/0.97	1, 2, 3, 4
BC-5	CU-5	TCMBM0108JA11N4	Main	8	148,000.0	208/230V/1-phase	0.137/0.176	0.076/0.098	0.83/0.97	1, 2, 3, 4
BC-6	CU-6	TCMBM0108JA11N4	Main	8	132,000.0	208/230V/1-phase	0.137/0.176	0.076/0.098	0.83/0.97	1, 2, 3, 4
BC-7	CU-7	TCMBM0108JA11N4	Main	8	92,000.0	208/230V/1-phase	0.137/0.176	0.076/0.098	0.83/0.97	1, 2, 3, 4
BC-8	CU-8	TCMBM0108JA11N4	Main	8	140,000.0	208/230V/1-phase	0.137/0.176	0.076/0.098	0.83/0.97	1, 2, 3, 4
BC-9	CU-9	TCMBM1016JA11N4	Main	16	169,000.0	208/230V/1-phase	0.258/0.333	0.137/0.176	1.57/1.82	1, 2, 3, 4
BC-10	CU-10	TCMBM0108JA11N4	Main	8	158,000.0	208/230V/1-phase	0.137/0.176	0.076/0.098	0.83/0.97	1, 2, 3, 4
BC-11	CU-11	TCMBM0108JA11N4	Main	8	102,000.0	208/230V/1-phase	0.137/0.176	0.076/0.098	0.83/0.97	1, 2, 3, 4
BC-12	CU-12	TCMBM0108JA11N4	Main	8	150,000.0	208/230V/1-phase	0.137/0.176	0.076/0.098	0.83/0.97	1, 2, 3, 4

BC CONTROLLER SCHEDULE NOTES:

- INCLUDE DIAMONDBACK BALL VALVES BV-SERIES, 700PSIG WORKING PRESSURE, FULL PORT, 410A RATED.
- A SUB BC CONTROLLER IS NOT REQUIRED FOR THIS PROJECT. FOR SUB BC CONTROLLER INFO, SEE MANUFACTURER'S INSTALLATION INSTRUCTIONS.
- PROVIDE REFRIGERATION BALL VALVE-BRAZE/SCHRADER/INSULATED - 3/8" SIZE
- PROVIDE REFRIGERATION BALL VALVE-BRAZE/SCHRADER/INSULATED - 5/8" SIZE

STEAM HEATING COIL

UNIT SERVED	RTU-2	RTU-3
LOCATION	RTU-2	RTU-3
BTU/HR	125,000	137,500
STEAM FLOW RATE (LB/H)	318	318
AIRFLOW (CFM)	8,085	8,328
ENTERING AIR TEMP (°F)	45.4	45.4
LEAVING AIR TEMP (°F)	80.5	80.5
ENTERING STEAM PRESSURE (PSIG)	2	2
STEAM PRESSURE DROP (PSIG)	1	1
AIRSIDE PRESSURE DROP (IN WC)	0.25	0.25
NOMINAL TUBE DIAMETER (IN)	1	1
TUBE THICKNESS (IN)	0.035	0.035

REMARKS:

- PROVIDE STEAM DISTRIBUTING TYPE COIL.
- THIS COIL SHALL BE A STANDARD PRODUCT OF THE RTU MANUFACTURER AND SHALL BE INTEGRAL TO THE RTU HEATING SECTION. REFER TO THE ROOFTOP UNIT SCHEDULE FOR RTU DETAILS.

ROOFTOP AIR HANDLING UNITS

UNIT TAG	AREA SERVED	REFRIGERANT	TOTAL SUPPLY AIRFLOW (CFM)	MINIMUM OUTSIDE AIRFLOW (CFM)		MAXIMUM OUTSIDE AIRFLOW (CFM)	EXTERNAL STATIC PRESSURE (IN W.C.)	COOLING						HEATING (SEE STEAM HEATING COIL SCHEDULE)		FILTER	ELECTRICAL				SUPPLY FAN MOTOR INFO		UNIT WEIGHT (LBS)	UNIT DIMENSIONS (LxWxH, IN)	BASIS OF DESIGN	REMARKS
				COOLING	HEATING			NOMINAL CAPACITY (TONS)	MIN. TOTAL CAPACITY (MBH)	MIN. SENSIBLE CAPACITY (MBH)	MINIMUM EER	MINIMUM IEER	CONDENSER	MCA	MOP		VOLT/PH/HZ	HP	BHP							
													EAT (°F DB)													
RTU-2	AUDITORIUM (218)	R410A	12000	6200	6200	12000	1.0	27.50	364.82	261.04	11.0	13.6	95	-	-	14	161.97	175	208/3/60	10	8.30	5000	180x90x72	TRANE TCD330BE	SEE NOTES	
RTU-3	GYMNASIUM (220)	R410A	11500	2500	2500	11500	1.0	30.00	350.91	247.60	10.6	13.3	95	-	-	14	170.53	200	208/3/60	10	7.67	5000	180x90x72	TRANE TCD360BE	SEE NOTES	

PACKAGED ROOFTOP UNIT SCHEDULE NOTES:

- PROVIDE SINGLE ZONE VARIABLE AIR VOLUME (SZVAV) CONTROL AND VARIABLE SPEED COMPRESSORS (TRANE eFLEX OR EQUAL).
- PROVIDE LOW LEAKAGE REFERENCE OR COMPARATIVE ENTHALPY ECONOMIZER WITH FAULT DETECTION DIAGNOSIS AND BAROMETRIC RELIEF DAMPER.
- PROVIDE CO2 BASED DEMAND CONTROLLED VENTILATION WITH FIELD INSTALLED, WALL MOUNTED CO2 SENSORS. SEE SPEC 237313, 2.20 FOR MORE INFO.
- PROVIDE ROOF CURB, 24" HIGH U.O.N. REFER TO DETAIL 6/M502.
- PROVIDE DISCONNECT SWITCH AND POWERED CONVENIENCE OUTLET.
- PROVIDE WITH MANUFACTURER'S STANDARD STEAM HEATING COIL SECTION. REFER TO THE STEAM COIL SCHEDULE ON THIS DRAWING.
- PROVIDE DUCT SMOKE DETECTORS FOR BOTH THE SUPPLY AND RETURN AIR, SEE GENERAL NOTE #5 ON M-004.
- PROVIDE MOTORIZED DAMPERS AT OUTSIDE AND EXHAUST AIR OPENINGS. SEE HVAC NOTE #16 ON M-001.
- PROVIDE FREEZE/STAT FOR FROST PROTECTION. FOR OTHER REQUIRED SENSORS AND CONTROLS, SEE DRAWING M-004, SPEC 230993 AND 237313.
- PROVIDE ENERGY RECOVERY VENTILATOR(ENERGY WHEEL) FOR RTU-2, AUDITORIUM

0 1/2 1
IF THIS BAR DOES NOT MEASURE 1" THEN DRAWING IS NOT TO FULL SCALE

5 01-24-22 ADDENDUM 3
3 12-17-21 ISSUED FOR BID
2 11-19-21 SED ADDENDUM 1
1 08-30-21 BIDDING DOCUMENTS

No. Date Revisions

Drawn by WM
Checked by ERF
Project No. 41048
Scale AS NOTED
Date 08-30-21

GREENMAN PEDERSEN, INC
400 BELLA BOULEVARD
MONTICELLO, NY 10801
Mechanical & Electrical Engineer:
Structural Engineer:

UNIVENT REPLACEMENT AT HAVERSTRAW ELEMENTARY
SED# 50-02-01-06-0-009-018
18 Grant Street
Haverstraw, NY 10627
COUNTY OF ROCKLAND

MSA
MICHAEL SHILALE ARCHITECTS, L.L.P.
New City, NY 10958 Tel 845-708-9200
140 Park Avenue
www.shilale.com

Drawing Title
MECHANICAL SCHEDULES

Drawing No.

M-002

VRF HEAT RECOVERY INDOOR UNIT SCHEDULE																		
Tag Reference	Related System	Room Name	Model	Type	Nominal Cooling Capacity (BTU/h)	Nominal Heating Capacity (BTU/h)	Cooling Design Entering Temp DB/WB (°F)	Heating Design Entering Temp DB/WB (°F)	Cooling Total Capacity (BTU/h)	Cooling Sensible Capacity (BTU/h)	Heating Capacity (BTU/h)	Estimated Cooling Coil LAT (°F)	Estimated Heating Coil LAT (°F)	Refrig Pipe Dim Liquid/Suction (inch)	Voltage / Phase	Power 208V Cooling/Heating (kW)	Electrical MCA/MFS	Notes / Options
UV-101	CU-1	CR 101	30000 Btu/h LEV Kit	LEV KIT	30,000.0	34,000.0	78.0/67.9	72.0	30,157.2	Dependent on 3rd Party Coil	21,809.8	78.0	72.0	3/8 / 5/8	208/230V/1-phase	0.012 / 0.012	/16	1, 2, 3, 4, 5, 6
UV-102	CU-1	CR 102	30000 Btu/h LEV Kit	LEV KIT	30,000.0	34,000.0	78.0/67.9	72.0	30,157.2	Dependent on 3rd Party Coil	21,809.8	78.0	72.0	3/8 / 5/8	208/230V/1-phase	0.012 / 0.012	/16	1, 2, 3, 4, 5, 6
UV-103	CU-1	CR 103	30000 Btu/h LEV Kit	LEV KIT	30,000.0	34,000.0	78.0/67.9	72.0	30,157.2	Dependent on 3rd Party Coil	21,809.8	78.0	72.0	3/8 / 5/8	208/230V/1-phase	0.012 / 0.012	/16	1, 2, 3, 4, 5, 6
UV-104	CU-1	CR 104	30000 Btu/h LEV Kit	LEV KIT	30,000.0	34,000.0	78.0/67.9	72.0	30,157.2	Dependent on 3rd Party Coil	21,809.8	78.0	72.0	3/8 / 5/8	208/230V/1-phase	0.012 / 0.012	/16	1, 2, 3, 4, 5, 6
AC-1A	CU-1	AP 105D	TPLFY005FM140A	Ceiling-Cassette (Four-Way)	5,000.0	5,600.0	78.0/67.9	72.0	5,026.2	3,757.3	3,592.2	65.4	83.9	1/4 / 1/2	208/230V/1-phase	0.02 / 0.02	0.24/15	1, 2, 3, 4, 5, 6
AC-1B	CU-1	Kitchenette 105	TPLFY005FM140A	Ceiling-Cassette (Four-Way)	5,000.0	5,600.0	78.0/67.9	72.0	5,026.2	3,757.3	3,592.2	65.4	83.9	1/4 / 1/2	208/230V/1-phase	0.02 / 0.02	0.24/15	1, 2, 3, 4, 5, 6
UV-106	CU-1	CR 106	30000 Btu/h LEV Kit	LEV KIT	30,000.0	34,000.0	78.0/67.9	72.0	30,157.2	Dependent on 3rd Party Coil	21,809.8	78.0	72.0	3/8 / 5/8	208/230V/1-phase	0.012 / 0.012	/16	1, 2, 3, 4, 5, 6
UV-201	CU-2	CR 201	30000 Btu/h LEV Kit	LEV KIT	30,000.0	34,000.0	78.0/67.9	72.0	30,157.2	Dependent on 3rd Party Coil	23,416.3	78.0	72.0	3/8 / 5/8	208/230V/1-phase	0.012 / 0.012	/16	1, 2, 3, 4, 5, 6
UV-202	CU-2	CR 202	30000 Btu/h LEV Kit	LEV KIT	30,000.0	34,000.0	78.0/67.9	72.0	30,157.2	Dependent on 3rd Party Coil	23,416.3	78.0	72.0	3/8 / 5/8	208/230V/1-phase	0.012 / 0.012	/16	1, 2, 3, 4, 5, 6
UV-203	CU-2	CR 203	30000 Btu/h LEV Kit	LEV KIT	30,000.0	34,000.0	78.0/67.9	72.0	30,157.2	Dependent on 3rd Party Coil	23,416.3	78.0	72.0	3/8 / 5/8	208/230V/1-phase	0.012 / 0.012	/16	1, 2, 3, 4, 5, 6
UV-204	CU-2	CR 204	30000 Btu/h LEV Kit	LEV KIT	30,000.0	34,000.0	78.0/67.9	72.0	30,157.2	Dependent on 3rd Party Coil	23,416.3	78.0	72.0	3/8 / 5/8	208/230V/1-phase	0.012 / 0.012	/16	1, 2, 3, 4, 5, 6
UV-205	CU-2	CR 205	30000 Btu/h LEV Kit	LEV KIT	30,000.0	34,000.0	78.0/67.9	72.0	30,157.2	Dependent on 3rd Party Coil	23,416.3	78.0	72.0	3/8 / 5/8	208/230V/1-phase	0.012 / 0.012	/16	1, 2, 3, 4, 5, 6
UV-301	CU-3	CR 301	30000 Btu/h LEV Kit	LEV KIT	30,000.0	34,000.0	78.0/67.9	72.0	30,157.2	Dependent on 3rd Party Coil	21,619.9	78.0	72.0	3/8 / 5/8	208/230V/1-phase	0.012 / 0.012	/16	1, 2, 3, 4, 5, 6
UV-302	CU-3	CR 302	30000 Btu/h LEV Kit	LEV KIT	30,000.0	34,000.0	78.0/67.9	72.0	30,157.2	Dependent on 3rd Party Coil	21,619.9	78.0	72.0	3/8 / 5/8	208/230V/1-phase	0.012 / 0.012	/16	1, 2, 3, 4, 5, 6
UV-303	CU-3	CR 303	36000 Btu/h LEV Kit	LEV KIT	36,000.0	40,000.0	78.0/67.9	72.0	36,188.6	Dependent on 3rd Party Coil	25,435.1	78.0	72.0	3/8 / 5/8	208/230V/1-phase	0.012 / 0.012	/16	1, 2, 3, 4, 5, 6
UV-304	CU-3	CR 304	30000 Btu/h LEV Kit	LEV KIT	30,000.0	34,000.0	78.0/67.9	72.0	30,157.2	Dependent on 3rd Party Coil	21,619.9	78.0	72.0	3/8 / 5/8	208/230V/1-phase	0.012 / 0.012	/16	1, 2, 3, 4, 5, 6
AC-3A	CU-3	CR 305	TPEFYP008MA143A	Ceiling-Concealed (Ducted)	8,000.0	9,000.0	78.0/67.9	72.0	8,041.9	5,558.7	5,722.9	60.6	89.8	1/4 / 1/2	208/230V/1-phase	0.06 / 0.04	1.05/15	1, 2, 3, 4, 5, 6, 8
UV-306	CU-3	CR 306	30000 Btu/h LEV Kit	LEV KIT	30,000.0	34,000.0	78.0/67.9	72.0	30,157.2	Dependent on 3rd Party Coil	21,619.9	78.0	72.0	3/8 / 5/8	208/230V/1-phase	0.012 / 0.012	/16	1, 2, 3, 4, 5, 6
AC-4A	CU-4	Main Office 105A	TPEFYP008MA143A	Ceiling-Concealed (Ducted)	8,000.0	9,000.0	78.0/67.9	72.0	8,041.9	5,558.7	5,939.3	60.6	90.4	1/4 / 1/2	208/230V/1-phase	0.06 / 0.04	1.05/15	1, 2, 3, 4, 5, 6, 8
AC-4B	CU-4	Principal 105C	TPEFYP008MA143A	Ceiling-Concealed (Ducted)	6,000.0	6,700.0	78.0/67.9	72.0	6,031.4	4,892.2	4,421.5	78.0	85.7	1/4 / 1/2	208/230V/1-phase	0.06 / 0.04	1.05/15	1, 2, 3, 4, 5, 6, 8
AC-4C	CU-4	Conference 105B	TPEFYP008MA143A	Ceiling-Concealed (Ducted)	8,000.0	9,000.0	78.0/67.9	72.0	8,041.9	5,558.7	5,939.3	60.6	90.4	1/4 / 1/2	208/230V/1-phase	0.06 / 0.04	1.05/15	1, 2, 3, 4, 5, 6, 8
UV-206	CU-4	CR 206	30000 Btu/h LEV Kit	LEV KIT	30,000.0	34,000.0	78.0/67.9	72.0	30,157.2	Dependent on 3rd Party Coil	21,619.9	78.0	72.0	3/8 / 5/8	208/230V/1-phase	0.012 / 0.012	/16	1, 2, 3, 4, 5, 6
UV-207	CU-4	CR 207	30000 Btu/h LEV Kit	LEV KIT	30,000.0	34,000.0	78.0/67.9	72.0	30,157.2	Dependent on 3rd Party Coil	22,437.3	78.0	72.0	3/8 / 5/8	208/230V/1-phase	0.012 / 0.012	/16	1, 2, 3, 4, 5, 6
UV-208	CU-4	CR 208	30000 Btu/h LEV Kit	LEV KIT	30,000.0	34,000.0	78.0/67.9	72.0	30,157.2	Dependent on 3rd Party Coil	22,437.3	78.0	72.0	3/8 / 5/8	208/230V/1-phase	0.012 / 0.012	/16	1, 2, 3, 4, 5, 6
UV-307	CU-4	CR 307	36000 Btu/h LEV Kit	LEV KIT	36,000.0	40,000.0	78.0/67.9	72.0	36,188.6	Dependent on 3rd Party Coil	26,396.8	78.0	72.0	3/8 / 5/8	208/230V/1-phase	0.012 / 0.012	/16	1, 2, 3, 4, 5, 6
AC-4D	CU-4	CR 309	TPEFYP008MA143A	Ceiling-Concealed (Ducted)	8,000.0	9,000.0	78.0/67.9	72.0	8,041.9	5,558.7	5,939.3	60.6	90.4	1/4 / 1/2	208/230V/1-phase	0.06 / 0.04	1.05/15	1, 2, 3, 4, 5, 6, 8
UV-186	CU-5	Music 186	30000 Btu/h LEV Kit	LEV KIT	30,000.0	34,000.0	78.0/67.9	72.0	30,157.2	Dependent on 3rd Party Coil	23,116.6	78.0	72.0	3/8 / 5/8	208/230V/1-phase	0.012 / 0.012	/16	1, 2, 3, 4, 5, 6
AC-5C	CU-5	Music 185	TPVFYP018AM141A	Multi-Position Air Handler	18,000.0	40,000.0	78.0/67.9	72.0	18,094.3	11,937.6	13,598.0	58.8	93.6	1/4 / 1/2	208/230V/1-phase	0.13 / 0.13	3.0/15	1, 2, 3, 4, 5, 6
UV-190	CU-5	Home Ec 190	30000 Btu/h LEV Kit	LEV KIT	30,000.0	34,000.0	78.0/67.9	72.0	30,157.2	Dependent on 3rd Party Coil	23,116.6	78.0	72.0	3/8 / 5/8	208/230V/1-phase	0.012 / 0.012	/16	1, 2, 3, 4, 5, 6
UV-195A	CU-5	Home Ec 195A	30000 Btu/h LEV Kit	LEV KIT	30,000.0	34,000.0	78.0/67.9	72.0	30,157.2	Dependent on 3rd Party Coil	23,116.6	78.0	72.0	3/8 / 5/8	208/230V/1-phase	0.012 / 0.012	/16	1, 2, 3, 4, 5, 6
AC-5A	CU-5	Office 220A	TPLFY005FM140A	Ceiling-Cassette (Four-Way)	5,000.0	5,600.0	78.0/67.9	72.0	5,026.2	3,757.3	3,807.4	65.4	84.7	1/4 / 1/2	208/230V/1-phase	0.02 / 0.02	0.24/15	1, 2, 3, 4, 5, 6
AC-5B	CU-5	Office 220B	TPLFY005FM140A	Ceiling-Cassette (Four-Way)	5,000.0	5,600.0	78.0/67.9	72.0	5,026.2	3,757.3	3,807.4	65.4	84.7	1/4 / 1/2	208/230V/1-phase	0.02 / 0.02	0.24/15	1, 2, 3, 4, 5, 6
UV-105B	CU-5	Conference 105B	30000 Btu/h LEV Kit	LEV KIT	30,000.0	34,000.0	78.0/67.9	72.0	30,157.2	Dependent on 3rd Party Coil	23,116.6	78.0	72.0	3/8 / 5/8	208/230V/1-phase	0.012 / 0.012	/16	1, 2, 3, 4, 5, 6
UV-180A-1	CU-6	Room 180A	36000 Btu/h LEV Kit	LEV KIT	36,000.0	40,000.0	78.0/67.9	72.0	36,188.6	Dependent on 3rd Party Coil	27,023.6	78.0	72.0	3/8 / 5/8	208/230V/1-phase	0.012 / 0.012	/16	1, 2, 3, 4, 5, 6
UV-180A-2	CU-6	Room 180A	36000 Btu/h LEV Kit	LEV KIT	36,000.0	40,000.0	78.0/67.9	72.0	36,188.6	Dependent on 3rd Party Coil	27,023.6	78.0	72.0	3/8 / 5/8	208/230V/1-phase	0.012 / 0.012	/16	1, 2, 3, 4, 5, 6
UV-175	CU-6	Room 175	60000 Btu/h LEV Kit	LEV KIT	60,000.0	66,000.0	78.0/67.9	72.0	60,314.4	Dependent on 3rd Party Coil	44,589.0	78.0	72.0	3/8 / 3/4	208/230V/1-phase	0.012 / 0.012	/16	1, 2, 3, 4, 5, 6
UV-221	CU-7	Locker Rm 221	36000 Btu/h LEV Kit	LEV KIT	36,000.0	40,000.0	78.0/67.9	72.0	36,188.6	Dependent on 3rd Party Coil	32,571.1	78.0	72.0	3/8 / 5/8	208/230V/1-phase	0.012 / 0.012	/16	1, 2, 3, 4, 5, 6
UV-222	CU-7	Locker Rm 222	36000 Btu/h LEV Kit	LEV KIT	36,000.0	40,000.0	78.0/67.9	72.0	36,188.6	Dependent on 3rd Party Coil	32,571.1	78.0	72.0	3/8 / 5/8	208/230V/1-phase	0.012 / 0.012	/16	1, 2, 3, 4, 5, 6
AC-7A	CU-7	Office 222C	TPLFY005FM140A	Ceiling-Cassette (Four-Way)	5,000.0	5,600.0	78.0/67.9	72.0	5,026.2	3,757.3	4,560.0	65.4	87.2	1/4 / 1/2	208/230V/1-phase	0.02 / 0.02	0.24/15	1, 2, 3, 4, 5, 6, 7
AC-7B	CU-7	Office 222B	TPLFY005FM140A	Ceiling-Cassette (Four-Way)	5,000.0	5,600.0	78.0/67.9	72.0	5,026.2	3,757.3	4,560.0	65.4	87.2	1/4 / 1/2	208/230V/1-phase	0.02 / 0.02	0.24/15	1, 2, 3, 4, 5, 6, 7
AC-7C	CU-7	Office 221B	TPLFY005FM140A	Ceiling-Cassette (Four-Way)	5,000.0	5,600.0	78.0/67.9	72.0	5,026.2	3,757.3	4,560.0	65.4	87.2	1/4 / 1/2	208/230V/1-phase	0.02 / 0.02	0.24/15	1, 2, 3, 4, 5, 6, 7
AC-7D	CU-7	Office 221C	TPLFY005FM140A	Ceiling-Cassette (Four-Way)	5,000.0	5,600.0	78.0/67.9	72.0	5,026.2	3,757.3	4,560.0	65.4	87.2	1/4 / 1/2	208/230V/1-phase	0.02 / 0.02	0.24/15	1, 2, 3, 4, 5, 6, 7
UV-207-1	CU-8	Library 207	36000 Btu/h LEV Kit	LEV KIT	36,000.0	40,000.0	78.0/67.9	72.0	36,188.6	Dependent on 3rd Party Coil	25,745.5	78.0	72.0	3/8 / 5/8	208/230V/1-phase	0.012 / 0.012	/16	1, 2, 3, 4, 5, 6
UV-207-2	CU-8	Library 207	36000 Btu/h LEV Kit	LEV KIT	36,000.0	40,000.0	78.0/67.9	72.0	36,188.6	Dependent on 3rd Party Coil	25,745.5	78.0	72.0	3/8 / 5/8	208/230V/1-phase	0.012 / 0.012	/16	1, 2, 3, 4, 5, 6
UV-311	CU-8	Science 311	60000 Btu/h LEV Kit	LEV KIT	60,000.0	66,000.0	78.0/67.9	72.0	60,314.4	Dependent on 3rd Party Coil	42,480.1	78.0	72.0	3/8 / 3/4	208/230V/1-phase	0.012 / 0.012	/16	1, 2, 3, 4, 5, 6
AC-8A	CU-8	Office 209A	TPEFYP008MA143A	Ceiling-Concealed (Ducted)	8,000.0	9,000.0	78.0/67.9	72.0	8,041.9	5,558.7	5,792.7	60.6	90.0	1/4 / 1/2	208/230V/1-phase	0.06 / 0.04	1.05/15	1, 2, 3, 4, 5, 6, 8
AC-9A	CU-9	Office 107B	TPEFYP006MA143A	Ceiling-Concealed (Ducted)	6,000.0	6,700.0	78.0/67.9	72.0	5,598.1	4,738.6	4,071.2	63.1	84.6	1/4 / 1/2	208/230V/1-phase	0.06 / 0.04	1.05/15	1, 2, 3, 4, 5, 6, 8
AC-9B	CU-9	Office 107F	TPEFYP006MA143A	Ceiling-Concealed (Ducted)	6,000.0	6,700.0	78.0/67.9	72.0	5,598.1	4,738.6	4,071.2	63.1	84.6	1/4 / 1/2	208/230V/1-phase	0.06 / 0.04	1.05/15	1, 2, 3, 4, 5, 6, 8
AC-9C	CU-9	Office 107D	TPEFYP006MA143A	Ceiling-Concealed (Ducted)	6,000.0	6,700.0	78.0/67.9	72.0	5,598.1	4,738.6	4,071.2	63.1	84.6	1/4 / 1/2	208/230V/1-phase	0.06 / 0.04	1.05/15	1, 2, 3, 4, 5, 6, 8
AC-9E	CU-9	Office 107E	TPEFYP006MA143A	Ceiling-Concealed (Ducted)	6,000.0	6,700.0	78.0/67.9	72.0	5,598.1	4,738.6	4,071.2	63.1	84.6	1/4 / 1/2	208/230V/1-phase	0.06 / 0.04	1.05/15	1, 2, 3, 4, 5, 6, 8
AC-9I	CU-9	Office 108E	TPLFY005FM140A	Ceiling-Cassette (Four-Way)	5,000.0	5,												


1. DUCT SMOKE DETECTORS SHALL BE PROVIDED IN MAIN SUPPLY AND RETURN DUCT FOR SYSTEMS OVER 1,000 CFM AND ALSO UPSTREAM OF EACH STORY RETURN DUCT/ RISER CONNECTION WHERE RETURN AIR RISERS SERVE TWO OR MORE STORIES FOR SYSTEMS OVER 15,000 CFM.
2. INTEGRATE AIR FLOW MEASURING APPARATUS INTO THE BMS/DDC NETWORK. PROVIDE ONE OUTSIDE AIR FLOW MEASURING STATION FOR EACH OUTSIDE AIR INTAKE PORT. PROVIDE FACTORY INSTALLED AIRFLOW STATION.
3. PROVIDE NEW THERMOSTATS WITH LOCK BOXES IN ROOMS BEING SERVED BY AHU. CONTRACTOR SHALL PROVIDE ALL ASSOCIATED CONTROL WIRING.
4. SAFETY SHUTDOWN DEVICES SHALL BE HARDWIRED TO THE FAN STARTER CIRCUIT IN ADDITION TO THE DDC SYSTEM. COORDINATE WITH MANUFACTURER FOR SHUTDOWN UNDER ALL MODES OF OPERATION.
5. MECHANICAL CONTRACTOR SHALL HIRE A FIRE ALARM SUBCONTRACTOR. FIRE ALARM CONTRACTOR TO FURNISH FIRE ALARM SYSTEM COMPLIANT SMOKE DETECTORS TO THE MECHANICAL CONTRACTOR WHO SHALL IN TURN FURNISH THEM TO THE CENTRAL AIR HANDLING UNIT MANUFACTURER FOR FACTORY INSTALLATION OR TO THE SHEET METAL CONTRACTOR FOR FIELD DUCTWORK INSTALLATION FOR THE FLOOR RETURN/RISER RETURN CONNECTIONS AS APPLICABLE. CONTRACTOR SHALL PROVIDE ALL SIGNAL AND CONTROL POWER WIRING TO UNIT.

GENERAL NOTES


VFD TLL-1 TCC TS-1 TS-2 TS-3 TS-4 TS-5 FE FM BI BO DA OA SA RA IDU ODU FLTG TEMP STPT VAL EC	VARIABLE FREQUENCY DRIVE TEMPERATURE LOW LIMIT TEMPERATURE CONTROLS CONTRACTOR OUTSIDE AIR TEMP MIXED AIR TEMP HEATING COIL DISCHARGE DISCHARGE AIR TEMP RETURN AIR TEMP FLOW ELEMENT FLOW METER BINARY INPUT BINARY OUTPUT DISCHARGE AIR OUTSIDE AIR SUPPLY AIR RETURN AIR INDOOR UNIT OUTDOOR UNIT FLOATING TEMPERATURE SETPOINT VALVE ELECTRICAL CONTRACTOR	DCV CO2 DI DO AI AO LON PSL PSH DPS/I AD BMS RTU VRF STM SUP COND WCI MA ACT SF STS SPD CMD ---	DEMAND CONTROL VENTILATION CARBON DIOXIDE DIGITAL INPUT DIGITAL OUTPUT ANALOG INPUT ANALOG OUTPUT LONWORKS NETWORK CONNECTION PRESSURE SWITCH LOW PRESSURE SWITCH HIGH DIFF. PRESSURE SWITCH/INDICATOR DPR ACTUATORS BUILDING MANAGEMENT SYSTEM ROOFTOP UNIT VARIABLE REFRIGERANT FLOW STEAM SUPPLY CONDENSATE RETURN WIRELESS COMMUNICATION INTERFACE MIXED AIR ACTIVE SUPPLY FAN STATUS SPEED COMMAND FIELD INSTALLED WIRING
--	--	--	---

LEGEND

- POINTS LIST NOTES:**
LEGEND:
X = PROVIDE QUANTITY AS REQUIRED TO INCLUDE ALL INSTANCES OF THE INDICATED FEATURE. INCLUDE MULTIPLE POINTS WITHIN EACH MECHANICAL SYSTEM AS NECESSARY. COORDINATE WITH EQUIPMENT VENDOR.
B = INFORMATION PROVIDED TO EACH SYSTEM VIA NETWORK BROADCAST.
NVO = NETWORK VARIABLE OUTPUT, NVI = NETWORK VARIABLE INPUT
- KEY NOTES:**
- THE POINT LISTED HEREIN ARE THE MINIMUM POINTS REQUIRED FOR THE CONTROL AND MONITORING OF THIS EQUIPMENT. THIS POINT LIST IS TYPICAL FOR EACH MECHANICAL/ELECTRICAL SYSTEM OF THIS TYPE. IF THE SEQUENCE OF OPERATION REQUIRES ADDITIONAL OR DIFFERING INFORMATION, IT MUST BE PROVIDED BY THE RESPECTIVE PROVIDER OF THE CONTROLS FOR THIS TYPE OF EQUIPMENT AS COORDINATED BY THE GENERAL AND MECHANICAL CONTRACTORS.
 - THE TCC SHALL PROVIDE ALL DIGITAL ALARM LOGIC. ALL DIGITAL ALARMS SHALL BE COMPATIBLE WITH THE EXISTING SIEMENS BMS SYSTEM.
 - THE TCC SHALL PROVIDE ALL TRENDING AND ANALOG ALARMING VIA THE SOFTWARE USED AT THE EXISTING SIEMENS BMS SYSTEM.
 - PROVIDE ACCUMULATED AIR FLOW FOR VALIDATION OF PURGE-MODE AND FOR PERMANENT VALIDATION OF OCCUPANT VENTILATION.
 - PROVIDE MANUAL RESET DEVICE. NOTE THAT THIS DEVICE BOTH ALARMS IN THE BMS AND IS HARDWIRED TO THE VFDs FOR SHUTDOWN OF THE FANS IN ALL OPERATING CONDITIONS OF THE VFD.
 - PROVIDE THE ALARM WHEN AT THE CALCULATED DIFFERENTIAL BETWEEN OUTSIDE AIR AND SPACE AIR CO2 VALUE IS 1000 ppm.
 - PROVIDE LON COMMUNICATION CONNECTION TO THIS DEVICE MAPPING ALL REQUIRED POINTS INTO THE LNS DATABASE.

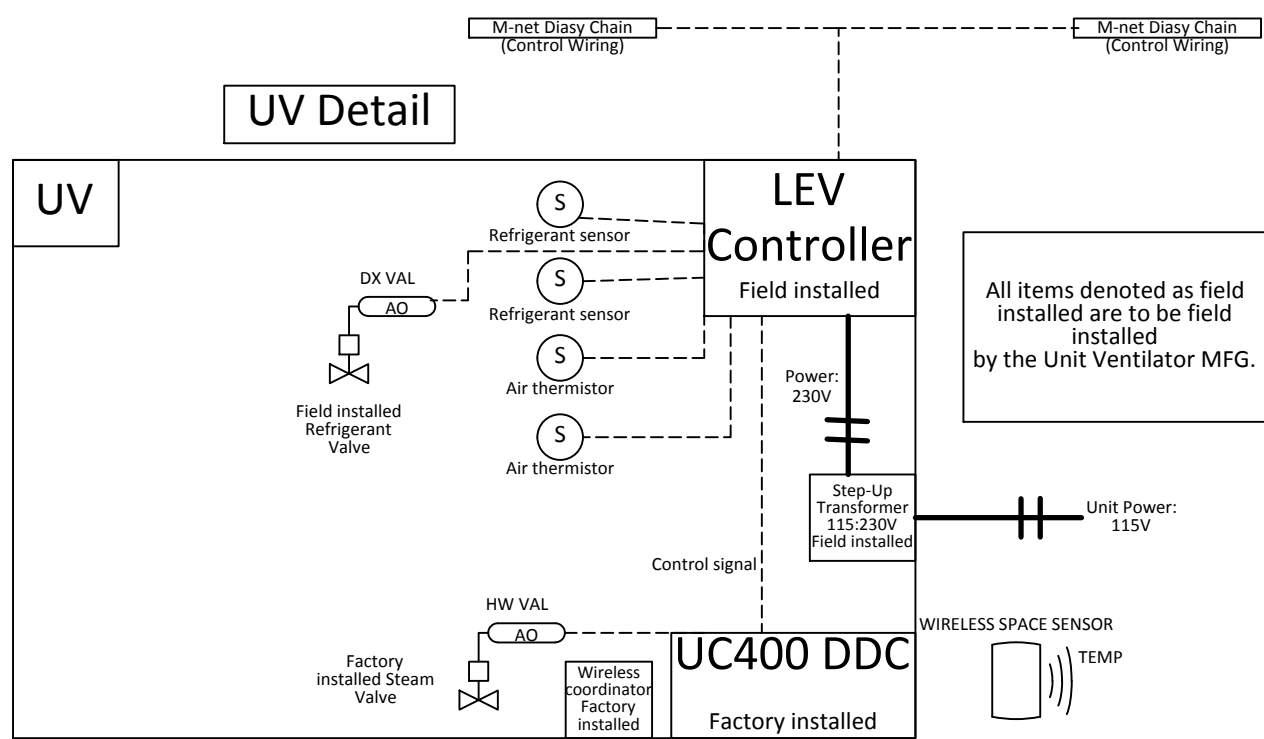

4 LEV KIT WIRING DIAGRAM SCALE: N.T.S.

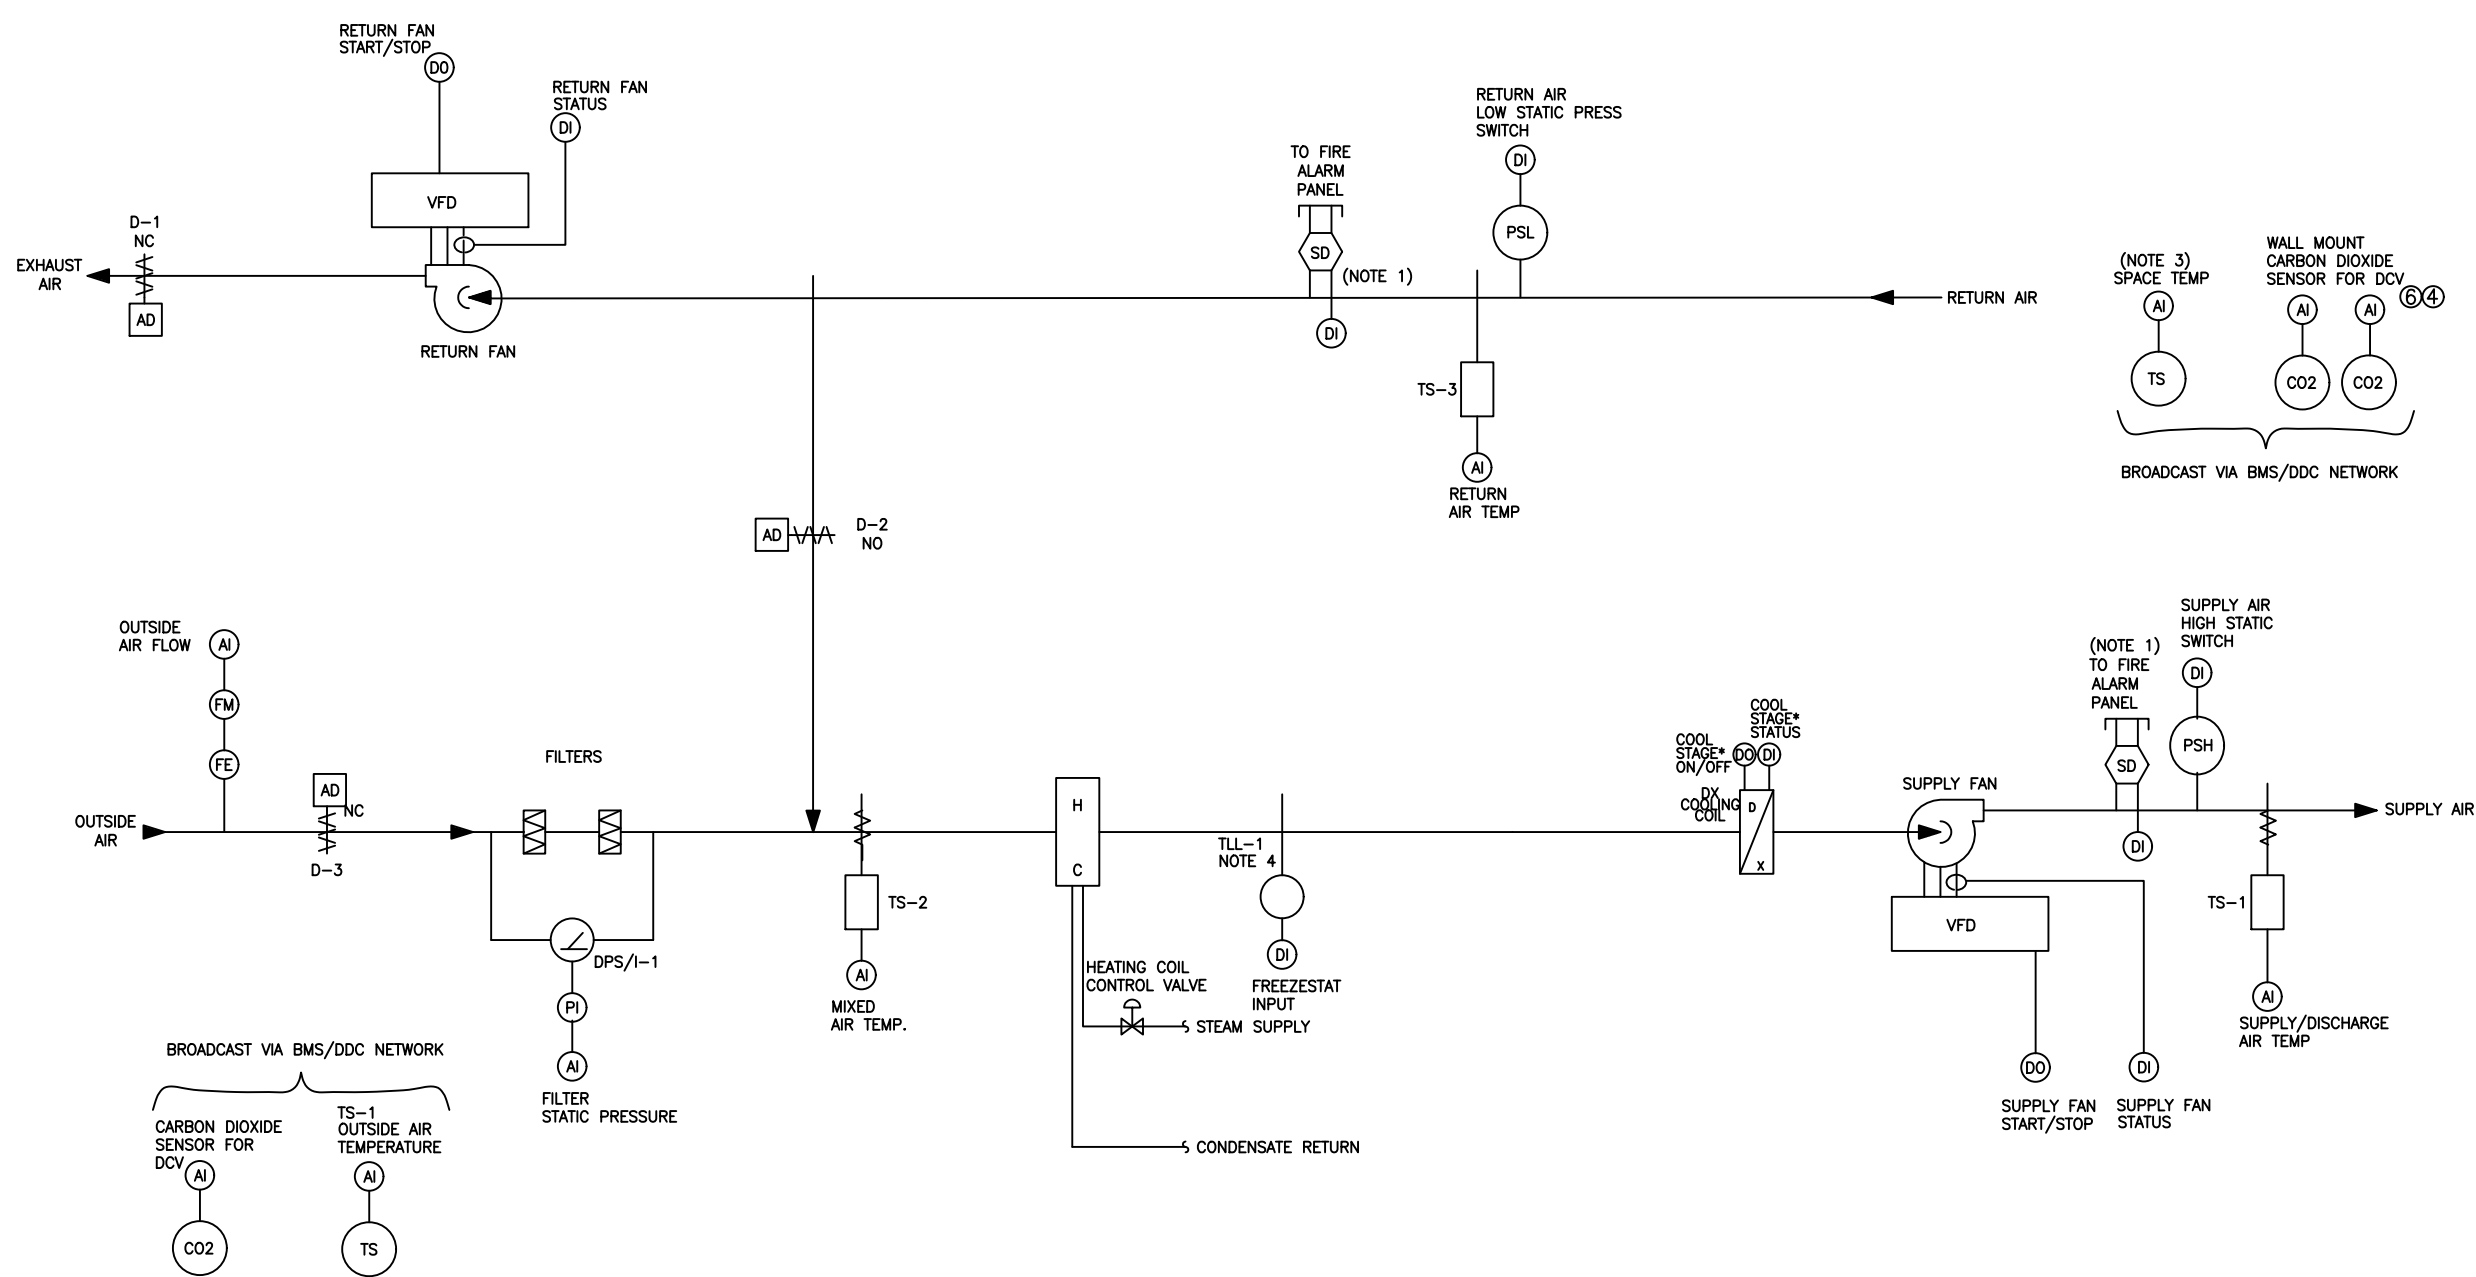

UNIT VENTILATOR SCHEDULE

UNIT TAG	LOCATION	TOTAL SUPPLY AIRFLOW (CFM)	MINIMUM OUTSIDE AIRFLOW (CFM)		MAXIMUM OUTSIDE AIRFLOW (CFM)	COOLING						HEATING				FILTER	ELECTRICAL				UNIT WEIGHT (LBS)	UNIT DIMENSIONS (LxDxH, IN) (V.I.F.)	BASIS OF DESIGN	REMARKS
			COOLING	HEATING		EADB (°F)	EAWB (°F)	LADB (°F)	LADB (°F)	MIN. SENSIBLE CAPACITY (BTU/H)	MIN. TOTAL CAPACITY (BTU/H)	EADB (°F)	LADB (°F)	STEAM PRESSURE (PSIG)	REQUIRED TOTAL CAPACITY (BTU/H)	MERV	MCA	MAX FUSE SIZE	VOLT/PH/HZ					
UV-101	101	750	400	400	750	80.0	67.0	54.7	52.4	17,810	28,250	12.0	102.6	2.0	63,200	13	4.5	15	115/1/60	320	69x21.25x30	TRANE VUVE0750	SEE NOTES 1-10	
UV-102	102	750	400	400	750	80.0	67.0	54.7	52.4	17,810	28,250	12.0	102.6	2.0	63,200	13	4.5	15	115/1/60	320	69x21.25x30	TRANE VUVE0750	SEE NOTES 1-10	
UV-103	103	750	400	400	750	80.0	67.0	54.7	52.4	17,810	28,250	12.0	102.6	2.0	63,200	13	4.5	15	115/1/60	320	69x21.25x30	TRANE VUVE0750	SEE NOTES 1-10	
UV-104	104	750	375	375	750	80.0	67.0	54.7	52.4	17,810	28,250	12.0	102.6	2.0	63,200	13	4.5	15	115/1/60	320	69x21.25x30	TRANE VUVE0750	SEE NOTES 1-10	
UV-105B	105	750	375	375	750	80.0	67.0	54.7	52.4	17,810	28,250	12.0	102.6	2.0	63,200	13	4.5	15	115/1/60	320	69x21.25x30	TRANE VUVE0750	SEE NOTES 1-10,11	
UV-106	106	750	375	375	750	80.0	67.0	54.7	52.4	17,810	28,250	12.0	102.6	2.0	63,200	13	4.5	15	115/1/60	320	69x21.25x30	TRANE VUVE0750	SEE NOTES 1-10	
UV-107	107	750	400	400	750	80.0	67.0	54.7	52.4	17,810	28,250	12.0	102.6	2.0	63,200	13	4.5	15	115/1/60	320	69x21.25x30	TRANE VUVE0750	SEE NOTES 1-10	
UV-109	109	750	400	400	750	80.0	67.0	54.7	52.4	17,810	28,250	12.0	102.6	2.0	63,200	13	4.5	15	115/1/60	320	69x21.25x30	TRANE VUVE0750	SEE NOTES 1-10	
UV-110	110	750	475	475	750	80.0	67.0	54.7	52.4	17,810	28,250	12.0	102.6	2.0	63,200	13	4.5	15	115/1/60	320	69x21.25x30	TRANE VUVE0750	SEE NOTES 1-10	
UV-111	111	750	400	400	750	80.0	67.0	54.7	52.4	17,810	28,250	12.0	102.6	2.0	63,200	13	4.5	15	115/1/60	320	69x21.25x30	TRANE VUVE0750	SEE NOTES 1-10	
UV-175	175	1500	850	850	1500	80.0	67.0	55.4	52.2	30,890	51,010	12.0	116.3	2.0	129,700	13	9.0	15	115/1/60	470	105x21.25x30	TRANE VUVE1500	SEE NOTES 1-10	
UV-180A-1	180A	1000	525	525	1000	80.0	67.0	54.7	51.8	21,720	35,670	12.0	124.2	2.0	106,950	13	4.5	15	120/1/60	375	82.25x35.6x16.6	TRANE HUV1001	SEE NOTES 1-10,12	
UV-180A-2	180A	1000	525	525	1000	80.0	67.0	54.7	51.8	21,720	35,670	12.0	124.2	2.0	106,950	13	4.5	15	120/1/60	375	82.25x35.6x16.6	TRANE HUV1001	SEE NOTES 1-10,12	
UV-186	186	1000	500	500	1000	80.0	67.0	54.7	51.8	21,720	35,670	12.0	112.5	2.0	85,380	13	4.5	15	115/1/60	405	81x21.25x30	TRANE VUVE1000	SEE NOTES 1-10,11	
UV-190	190	750	365	365	750	80.0	67.0	54.7	52.4	17,810	28,250	12.0	102.6	2.0	63,200	13	4.5	15	115/1/60	320	69x21.25x30	TRANE VUVE0750	SEE NOTES 1-10	
UV-195A	195A	750	435	435	750	80.0	67.0	54.7	52.4	17,810	28,250	12.0	102.6	2.0	63,200	13	4.5	15	115/1/60	320	69x21.25x30	TRANE VUVE0750	SEE NOTES 1-10	
UV-201	201	750	400	400	750	80.0	67.0	54.7	52.4	17,810	28,250	12.0	102.6	2.0	63,200	13	4.5	15	115/1/60	320	69x21.25x30	TRANE VUVE0750	SEE NOTES 1-10	
UV-202	202	750	400	400	750	80.0	67.0	54.7	52.4	17,810	28,250	12.0	102.6	2.0	63,200	13	4.5	15	115/1/60	320	69x21.25x30	TRANE VUVE0750	SEE NOTES 1-10	
UV-203	203	750	400	400	750	80.0	67.0	54.7	52.4	17,810	28,250	12.0	102.6	2.0	63,200	13	4.5	15	115/1/60	320	69x21.25x30	TRANE VUVE0750	SEE NOTES 1-10	
UV-204	204	750	300	300	750	80.0	67.0	54.7	52.4	17,810	28,250	12.0	102.6	2.0	63,200	13	4.5	15	115/1/60	320	69x21.25x30	TRANE VUVE0750	SEE NOTES 1-10	
UV-205	205	750	375	375	750	80.0	67.0	54.7	52.4	17,810	28,250	12.0	102.6	2.0	63,200	13	4.5	15	115/1/60	320	69x21.25x30	TRANE VUVE0750	SEE NOTES 1-10	
UV-222	222	1000	100	100	1000	80.0	67.0	54.7	51.8	21,720	35,670	12.0	112.5	2.0	85,380	13	4.5	15	115/1/60	405	81x21.25x30	TRANE VUVE1000	SEE NOTES 1-10	
UV-301	301	750	400	400	750	80.0	67.0	54.7	52.4	17,810	28,250	12.0	102.6	2.0	63,200	13	4.5	15	115/1/60	320	69x21.25x30	TRANE VUVE0750	SEE NOTES 1-10	
UV-302	302	750	375	375	750	80.0	67.0	54.7	52.4	17,810	28,250	12.0	102.6	2.0	63,200	13	4.5	15	115/1/60	320	69x21.25x30	TRANE VUVE0750	SEE NOTES 1-10	
UV-303	303	1000	475	475	1000	80.0	67.0	54.7	51.8	21,720	35,670	12.0	112.5	2.0	85,380	13	4.5	15	115/1/60	405	81x21.25x30	TRANE VUVE1000	SEE NOTES 1-10	
UV-304	304	750	350	350	750	80.0	67.0	54.7	52.4	17,810	28,250	12.0	102.6	2.0	63,200	13	4.5	15	115/1/60	320	69x21.25x30	TRANE VUVE0750	SEE NOTES 1-10	
UV-306	306	1000	500	500	1000	80.0	67.0	54.7	51.8	21,720	35,670	12.0	112.5	2.0	85,380	13	4.5	15	115/1/60	405	81x21.25x30	TRANE VUVE1000	SEE NOTES 1-10	
UV-307	307	1000	400	400	1000	80.0	67.0	54.7	51.8	21,720	35,670	12.0	112.5	2.0	85,380	13	4.5	15	115/1/60	405	81x21.25x30	TRANE VUVE1000	SEE NOTES 1-10	
UV-310	310	750	400	400	750	80.0	67.0	54.7	52.4	17,810	28,250	12.0	102.6	2.0	63,200	13	4.5	15	115/1/60	320	105x21.25x30	TRANE VUVE1500	SEE NOTES 1-10	
UV-311	311	1500	625	625	1500	80.0	67.0	55.4	52.2	30,890	51,010	12.0	116.3	2.0	129,700	13	9.0	15	115/1/60	470	105x21.25x30	TRANE VUVE1500	SEE NOTES 1-10	
UV-312	312	750	400	400	750	80.0	67.0	54.7	52.4	17,810	28,250	12.0	102.6	2.0	63,200	13	4.5	15	115/1/60	320	69x21.25x30	TRANE VUVE0750	SEE NOTES 1-10	
UV-313	313	1500	575	575	1500	80.0	67.0	55.4	52.2	30,890	51,010	12.												

UNIT VENTILATOR SCHEDULE NOTES:


1. PROVIDE VARIABLE VOLUME SPEED CONTROL ECM MOTORS. MOTOR CONTROL TO BE FIELD INSTALLED.
2. PROVIDE LOW LEAKAGE OUTSIDE AIR DAMPER, CLASS 1 MOTORIZED DAMPERS, LOW LEAKAGE TYPE FOR OUTSIDE AIR AND EXHAUST OPENINGS. AIR LEAKAGE SHALL NOT BE GREATER THAN 4CFM/FT² AND BE IN ACCORDANCE WITH AMCA 5000.
3. PROVIDE FIXED DRY-BULB ECONOMIZER WITH FAULT DETECTION DIAGNOSIS.
4. PROVIDE DISCONNECT SWITCH.
5. CONTRACTOR TO VERIFY STEAM HEAT COIL PIPING CONNECTIONS AND NEW DX COIL PIPING CONNECTIONS PRIOR TO ORDERING. STEAM HEAT COILS SHALL MATCH EXISTING LOCATIONS. TYPICAL LOCATIONS ARE AS FOLLOWS: ELECTRICAL - LH SIDE, STEAM - RH SIDE, DX - RH SIDE.
6. AT COMPLETION OF UV INSTALLATION, CONTRACTOR SHALL INSTALL MERV-13 FILTERS FURNISHED BY THE UNIT MANUFACTURER.
7. PROVIDE MODULATING TWO-WAY STEAM CONTROL VALVE.
8. CABINET COLOR TO BE OF DELUXE BEIGE FINISH U.O.N. BY ARCHITECT AND/OR FACILITIES.
9. PROVIDE HEAVY GAUGE FRONT PANEL AND CUT-TO-FIT FILLER PANELS ON BOTH SIDES OF THE UNIT VENTILATOR TO MATCH THE INSTALLED WIDTH OF THE EXISTING UNITS AND ENCLOSE EXISTING PIPING.
10. PROVIDE FIELD INSTALLED DDC CONTROLS TO SATISFY SEQUENCE OF OPERATIONS, COORDINATE/INTEGRATE WITH EXISTING SIEMENS BMS. SEE DRAWING M004 FOR MORE INFO. PROVIDE LEV KIT AS PER INDOOR UNIT SCHEDULE, SEE DRAWING M003.
11. PROVIDE WITH NO ENCLOSURE/END COVERS FOR INSTALLATION BEHIND EXISTING CABINTRY ENCLOSURE.
12. PROVIDE ALL REQUIRED SUPPORTS FOR CEILING MOUNT HORIZONTAL UNIT.
13. AT ALL UNIT VENTILATORS, CONTRACTOR IS RESPONSIBLE TO REMOVE FACTORY INSTALLED STANDARD DX CONTROL VALVE FOR

- (1) DEMOLISH EXISTING UNIT VENTILATOR OR FCU.
- (2) REMOVE STEAM CONTROL VALVE, TRAPS, AND ASSOCIATED APPURTENANCES. CAP AND REMOVE STEAM PIPING BACK TO NEAREST RISER, APPROX. 5 LF OF PIPING.
- (3) REMOVE AND DISCONNECT FRESH AIR CONNECTION. EXISTING LOUVER TO REMAIN. PROVIDE TEMPORARY CLOSURE FOR OA LOUVER TO PREVENT INFILTRATION FROM OUTDOORS.
- (4) REMOVE AND DISCONNECT FRESH AIR CONNECTION. PERMANENTLY CAP EXISTING 36"x12" (V.I.F.) LOUVER OPENING FROM THE INSIDE WITH 22 GA MIN GALVANIZED PANEL. FILL VOID WITH INSULATION, R-12 MIN. RESTORE INTERIOR FINISHES, COORDINATE WITH GC AND ARCHITECT.
- (5) DEMO EXISTING A/C UNIT IN SPACE AND ASSOCIATED CONDENSING UNIT AND RETURN EQUIPMENT TO FACILITIES.
- (6) DEMO EXISTING WINDOW A/C UNIT. RETURN WINDOW A/C UNIT TO THE SCHOOL. CAP INSULATED WINDOW PANEL AT LOCATION OF EXISTING WINDOW AC UNIT, REFER TO ARCHITECTURAL PLANS.
- (7) DEMO EXISTING VACUUM EXHAUST DUCT, FITTINGS AND SUPPORTS IN CEILING. TEMPORARILY CAP AND SEAL ANY PENETRATIONS TO THE OUTSIDE. ALL DUCT DIMENSIONS AND ROUTING AS SHOWN ARE APPROXIMATE. CONTRACTOR TO VERIFY IN THE FIELD.
- (8) PERMANENTLY CAP EXISTING DUCT AT BUILDING WALL.
- (9) EXISTING RADIATOR TO REMAIN.
- (10) EXISTING CABINETY ENCLOSURE TO REMAIN.
- (11) EXISTING ENERGY RECOVERY VENTILATOR IN SPACE TO REMAIN.

The floor plan shows the second floor of a school building. Key areas include:

- Classrooms:** SP ED 666 S.F. 102, SP ED 666 S.F. 104, SP ED 106, SP ED 760 S.F. 101, CLASSROOM 762 S.F. 103, MAIN OFFICE 635 S.F. 105A, CLASSROOM 755 S.F. 107, CLASSROOM 765 S.F. 109, CLASSROOM 740 S.F. 111.
- Offices:** MUSIC 1070 S.F. 186, HOME EC 690 S.F. 190, OFFICE 170 S.F. 110A, OFFICE 155 S.F. 107B, EXAM ROOM 73 S.F. 107F, OFFICE 75 S.F. 107D, OFFICE 135 S.F. 107C.
- Other Rooms:** RESTROOM 191A, RESTROOM 191B, GUIDANCE 108, ART 896 S.F. 110, NURSE 70 S.F. 107A, WORK ROOM 355 S.F. 107E, CONF. 420 S.F. 105B, PRINCIPAL 460 S.F. 105C, ASST. PRINC. 150 S.F. 105D, KITCHENETTE 85 S.F. 105E.
- Stairways and Corridors:** STAIRWAY 100A, STAIRWAY 192, STAIR LOBBY 191, STAIRWAY 100B, CORRIDOR 100.
- UV Units:** UV-102, UV-104, UV-106, UV-101, UV-103, UV-105B, UV-107, UV-109, UV-110, UV-111.
- Other Features:** ELECTRIC/IT ROOM 100 S.F. 108A, STAIRWAY 193, STAIRWAY 100A, STAIRWAY 100B.

5

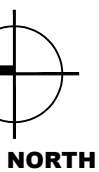


© COPYRIGHT, MICHAEL SHILALE ARCHITECTS, ALL RIGHTS RESERVED.

Drawing	Title
1	...
2	...
3	...
HVAC DEMO - 1ST FLOOR PLAN

Drawing No.

M-061

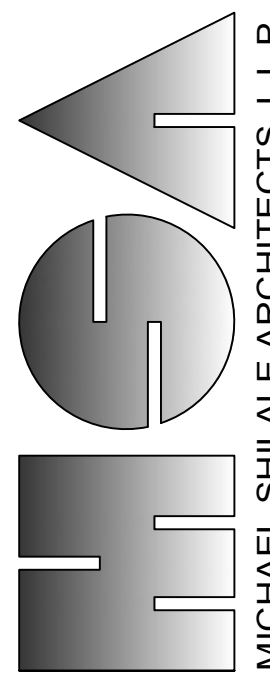

MICHAEL SHILALE ARCHITECTS, L.L.P.

140 Park Avenue New City, NY 109
www.shilale.com

UNIVENT REPLACEMENT AT HAVERSTRAW ELEMENTARY

SED# 50-02-01-06-0-009-018

16 Grant Street
Haverstraw, NY 10927

COUNTY OF ROCKLAND

**GREENMAN
PEDERSEN, INC**
400 RELLIS BOULEVARD
MONTEBELLO, NY 10901

Mechanical
& Electrical
Engineer:

Structural Engineer:

Drawn by

Checked by

Project No.

Scale AS NOTED

Date 09 30 21

No.	Date	Revisions
5	01-24-22	ADDENDUM 3
3	12-17-21	ISSUED FOR BID
2	11-19-21	SED ADDENDUM 1
1	08-30-21	BIDDING DOCUMENTS


0 1/2 1

IF THIS BAR DOES NOT MEASURE 1" THEN DRAWING IS NOT TO FULL SCALE

NOTES:

- ① DEMOLISH EXISTING UNIT VENTILATOR OR FCU.
- ② REMOVE STEAM CONTROL VALVE, TRAPS, AND ASSOCIATED APPURTENANCES. CAP AND REMOVE STEAM PIPING BACK TO NEAREST RISER, APPROX. 5 LF OF PIPING.
- ③ REMOVE AND DISCONNECT FRESH AIR CONNECTION. EXISTING LOUVER TO REMAIN. PROVIDE TEMPORARY CLOSURE FOR OA LOUVER TO PREVENT INFILTRATION FROM OUTDOORS.
- ④ REMOVE AND DISCONNECT FRESH AIR CONNECTION. PERMANENTLY CAP EXISTING 36"x12" (V.I.F.) LOUVER OPENING FROM THE INSIDE WITH 22 GA MIN GALVANIZED PANEL. FILL VOID WITH INSULATION, R-12 MIN. RESTORE INTERIOR FINISHES, COORDINATE WITH GC AND ARCHITECT.
- ⑤ DEMO EXISTING A/C UNIT IN SPACE AND ASSOCIATED CONDENSING UNIT AND RETURN EQUIPMENT TO FACILITIES.
- ⑥ DEMO EXISTING WINDOW A/C UNIT. RETURN WINDOW A/C UNIT TO THE SCHOOL. CAP INSULATED WINDOW PANEL AT LOCATION OF EXISTING WINDOW AC UNIT, REFER TO ARCHITECTURAL PLANS.
- ⑦ DEMO EXISTING VACUUM EXHAUST DUCT, FITTINGS AND SUPPORTS IN CEILING. TEMPORARILY CAP AND SEAL ANY PENETRATIONS TO THE OUTSIDE. ALL DUCT DIMENSIONS AND ROUTING AS SHOWN ARE APPROXIMATE. CONTRACTOR TO VERIFY IN THE FIELD.
- ⑧ PERMANENTLY CAP EXISTING DUCT AT BUILDING WALL.
- ⑨ EXISTING RADIATOR TO REMAIN.
- ⑩ EXISTING CABINETRY ENCLOSURE TO REMAIN.

NOTES

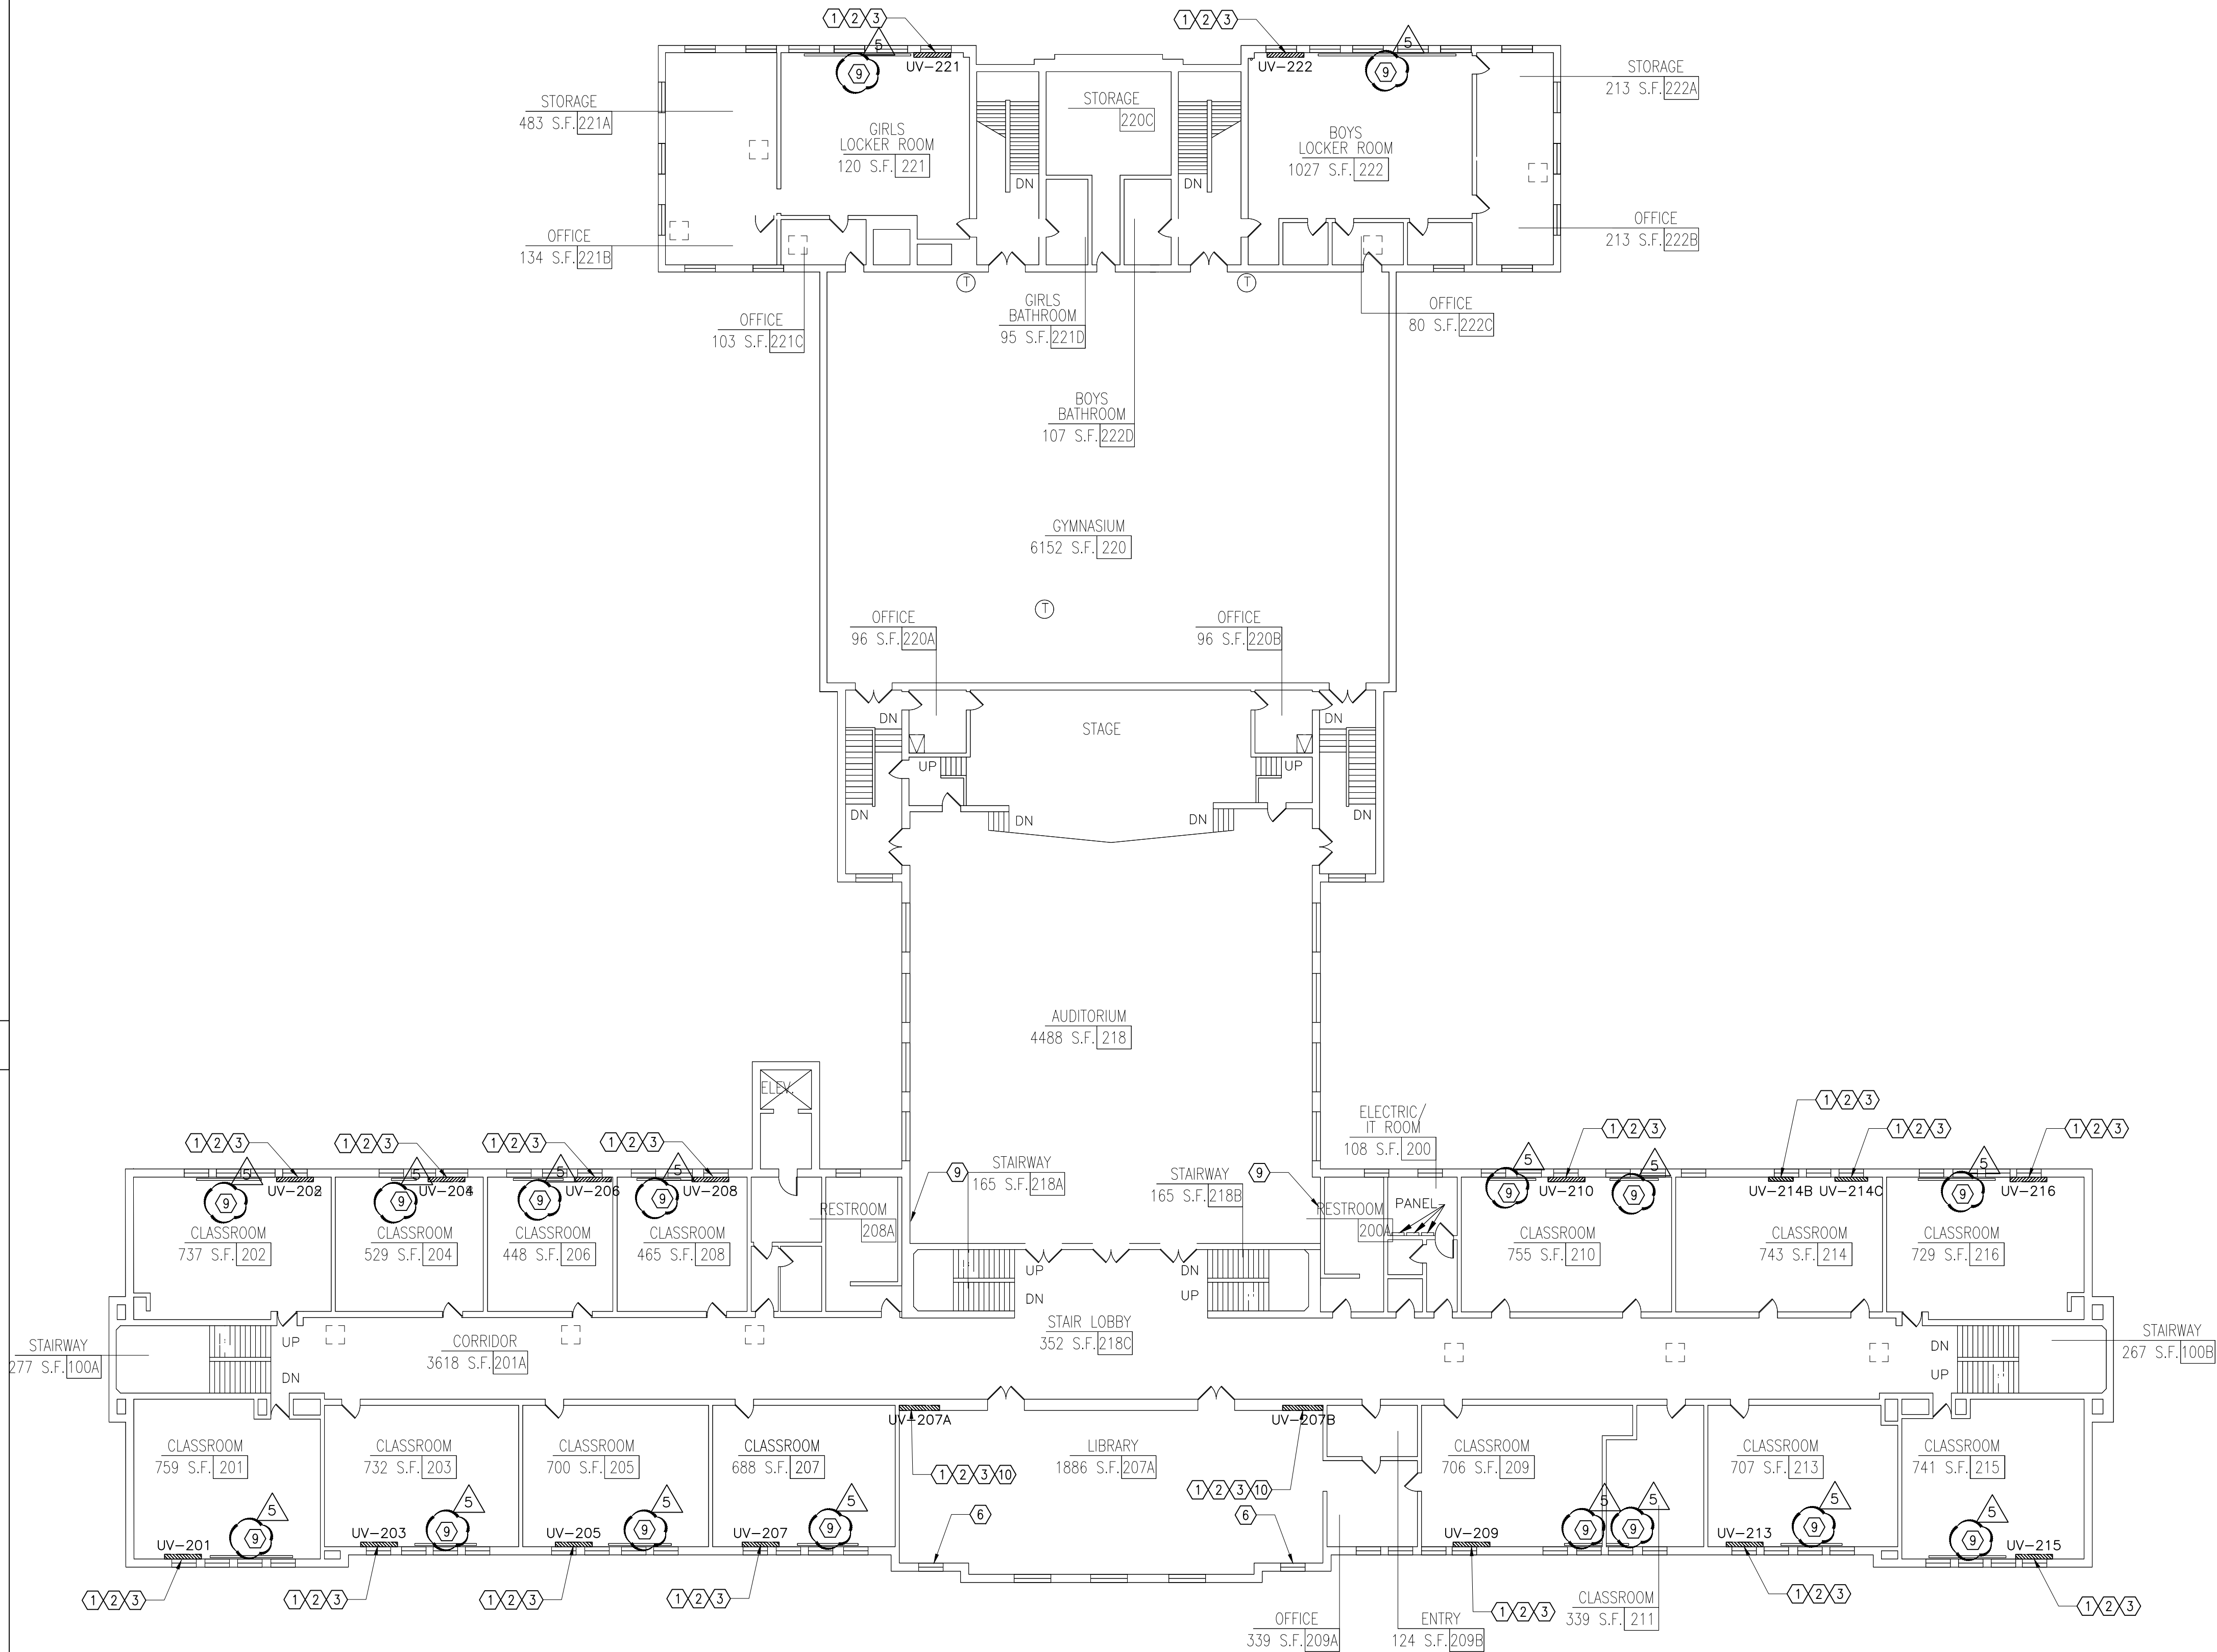

1 SECOND FLOOR PLAN - DEMO
SCALE: 1/16" = 1'-0"



© COPYRIGHT, MICHAEL SHILALE ARCHITECTS, ALL RIGHTS RESERVED.

MSA
MICHAEL SHILALE ARCHITECTS, L.L.P.
140 Park Avenue
New City, NY 10956
Tel: 845-708-9200
www.shilale.com

**UNIVENT REPLACEMENT
AT
HAVERSTRAW
ELEMENTARY**
SED# 50-02-01-06-0-009-018
18 Grant Street
Haverstraw, NY 10627
COUNTY OF ROCKLAND

**GREENMAN
PEDERSEN, INC**
400 BELLA BOULEVARD
MONTICELLO, NY 10801

Mechanical
Electrical
Engineer:

Structural
Engineer:

Drawn by WM
Checked by ERF
Project No. 41048
Scale AS NOTED
Date 08-30-21

No.	Date	Revisions
1	08-30-21	BIDDING DOCUMENTS
2	11-19-21	ISSUED ADDENDUM 1
3	12-17-21	ISSUED FOR BID
5	01-24-22	ADDENDUM 3

- ① DEMOLISH EXISTING UNIT VENTILATOR OR FCU.
- ② REMOVE STEAM CONTROL VALVE, TRAPS, AND ASSOCIATED APPURTENANCES. CAP AND REMOVE STEAM PIPING BACK TO NEAREST RISER, APPROX. 5 LF OF PIPING.
- ③ REMOVE AND DISCONNECT FRESH AIR CONNECTION. EXISTING LOUVER TO REMAIN. PROVIDE TEMPORARY CLOSURE FOR OA LOUVER TO PREVENT INFILTRATION FROM OUTDOORS.
- ④ REMOVE AND DISCONNECT FRESH AIR CONNECTION. PERMANENTLY CAP EXISTING 36"x12" (V.I.F.) LOUVER OPENING FROM THE INSIDE WITH 22 GA MIN GALVANIZED PANEL. FILL VOID WITH INSULATION, R-12 MIN. RESTORE INTERIOR FINISHES, COORDINATE WITH GC AND ARCHITECT.
- ⑤ DEMO EXISTING A/C UNIT IN SPACE AND ASSOCIATED CONDENSING UNIT AND RETURN EQUIPMENT TO FACILITIES.
- ⑥ DEMO EXISTING WINDOW A/C UNIT. RETURN WINDOW A/C UNIT TO THE SCHOOL. CAP INSULATED WINDOW PANEL AT LOCATION OF EXISTING WINDOW AC UNIT, REFER TO ARCHITECTURAL PLANS.
- ⑦ DEMO EXISTING VACUUM EXHAUST DUCT, FITTINGS AND SUPPORTS IN CEILING. TEMPORARILY CAP AND SEAL ANY PENETRATIONS TO THE OUTSIDE. ALL DUCT DIMENSIONS AND ROUTING AS SHOWN ARE APPROXIMATE. CONTRACTOR TO VERIFY IN THE FIELD.
- ⑧ PERMANENTLY CAP EXISTING DUCT AT BUILDING WALL.
- ⑨ EXISTING RADIATOR TO REMAIN.
- ⑩ EXISTING CABINETRY ENCLOSURE TO REMAIN.
- ⑪ DEMOLISH EXISTING AIR HANDLING UNIT, SUPPORTS AND ASSOCIATED DISCONNECT SWITCH/CONTROLS.
- ⑫ DEMOLISH EXISTING DUCTWORK AND SUPPORTS.
- ⑬ EXISTING GRILLE/REGISTER TO REMAIN.
- ⑭ DEMOLISH EXISTING STEAM AND CONDENSATE RETURNS AND F&T TRAPS. CAP PIPING BACK AT MAIN IN EACH SPACE.

© COPYRIGHT, MICHAEL SHILALE ARCHITECTS, ALL RIGHTS RESERVED.

Drawing Title
**HVAC DEMO -
3RD FLOOR
PLAN**

Drawing No.

M-063

MICHAEL SHILALE ARCHITECTS, L.L.P.
 140 Park Avenue New City, NY 10956 Tel 845-708-9200
www.shilale.com

UNIVENT REPLACEMENT AT HAVERSTRAW ELEMENTARY

SED# 50-02-01-06-0-009-018

16 Grant Street
Haverstraw, NY 10927

**GREENMAN
PEDERSEN, INC**
400 RELLIS BOULEVARD
MONTEBELLO, NY 10901

Drawn by	WM
Checked by	ERF
Project No.	41048
Scale	AS NOTED
Date	08-30-21

[illegible]

- (1) FURNISH AND INSTALL NEW VERTICAL UNIT VENTILATOR. REFER TO THE UNIT VENTILATOR SCHEDULE ON DRAWING M-006 AND DETAILS ON DRAWING M-501. CONNECT OUTSIDE AIR DUCT TO EXISTING OUTSIDE AIR OPENING/LOUVER.
- (2) FURNISH AND INSTALL NEW VERTICAL UNIT VENTILATOR. UTILIZE EXISTING ORIGINAL BUILT-IN CABINETY ENCLOSURE. REFER TO THE UNIT VENTILATOR SCHEDULE ON DRAWING M-006 AND DETAILS ON DRAWING M-501. CONNECT OUTSIDE AIR DUCT TO EXISTING OUTSIDE AIR OPENING/LOUVER.
- (3) FURNISH AND INSTALL NEW HORIZONTAL UNIT VENTILATOR WITH NEW CEILING SUPPORTS. REFER TO THE UNIT VENTILATOR SCHEDULE ON DRAWING M-006 AND DETAILS ON DRAWING M-501.
- (4) FURNISH AND INSTALL NEW EVAPORATOR/AC INDOOR UNIT. REFER TO VRF HEAT RECOVERY INDOOR UNIT SCHEDULE ON DRAWING M-003 AND DETAILS ON DRAWING M-501.
- (5) FURNISH AND INSTALL NEW OUTSIDE AIR INTAKE LOUVER AT WINDOW INSULATED PANEL. GC TO PROVIDE OPENING TO ACCOMMODATE NEW LOUVER. COORDINATE OPENINGS WITH THE ARCHITECT AND GC. FURNISH AND INSTALL OUTSIDE AIR DUCT CONNECTION TO LOUVER WITH VOLUME DAMPER, SEE PLANS FOR DUCT SIZE.
- (6) EXISTING OUTSIDE AIR WALL LOUVER TO REMAIN. SIZE VARIES PER EACH ROOM. CONNECT OA INTAKE DUCT TO EXISTING LOUVER. SEE DETAILS ON DRAWING M-501.
- (7) FURNISH AND INSTALL NEW PROGRAMMABLE ELECTRONIC THERMOSTAT WITH LOCKING GUARD. INTEGRATE WITH THE SIEMENS BMS.
- (8) FURNISH AND INSTALL NEW RELIEF AIR LOUVER WITH MOTORIZED DAMPER, PROVIDE NEW OPENING AT INSULATED PANEL. COORDINATE OPENINGS WITH GC, SEE ARCHITECTURAL DETAILS. SEE DETAIL 9/M-501.
- (9) PROVIDE SUPPLY DIFFUSER WITH VOLUME DAMPER AND ASSOCIATED INSULATED DUCTWORK AS INDICATED. DUCT SHALL BE LIMITED TO 3'-0" MAX. BASIS OF DESIGN: FOR CEILING: TITUS TMS OR EQUAL, FOR SIDE: TITUS 300/350 OR EQUAL.
- (10) PROVIDE 24x24 RETURN GRILLE IN EXISTING LAY-IN ACOUSTIC CEILING OR NEW SOFFIT. BASIS OF DESIGN: TITUS 45F OR EQUAL. EXTEND DUCTWORK AS INDICATED.
- (11) THE EXISTING DOOR UNDERCUT IS SUFFICIENT FOR AIR TRANSFER TO THE ADJACENT SPACE.
- (12) PROVIDE NEW DOOR UNDERCUT IN SPACE FOR SUFFICIENT AIR TRANSFER OF RELIEF AIR, SEE ARCHITECT DRAWINGS.
- (13) FURNISH AND INSTALL NEW OUTDOOR CONDENSING UNIT, SEE SCHEDULE ON DRAWING M-002. MOUNT AND SECURE UNIT TO WALL. UNIT SHALL BE MOUNTED MIN. 3'-0" ABOVE GRADE.

FOR PIPING LAYOUT FOR EACH NEW EQUIPMENT, REFER TO DRAWINGS M-301, M-302 AND M-303.

NOTE: ALL LINE SETS AND ELECTRICAL CONDUIT IN CORRIDOR SHALL BE ABOVE THE EXISTING ACT CEILING.

5

NOTE: ANY GC WORK NOT RELATED TO INSTALLATION OF MECHANICAL EQUIPMENT TO BE PART OF PHASE A.


5

[illegible]

Drawn by	WM
Checked by	ERF
Project No.	41048
Scale	AS NOTED
Date	08-30-21

Mechanical & Electrical Engineer:	GREENMAN PEDERSEN, INC 400 BELLA BOULEVARD MONTEBELLO, NY 10901
Structural Engineer:	— — —

UNIVERSITY REPLACEMENT
AT
HAVERSTRAW
ELEMENTARY
SED# 50-02-01-06-0-009-018
16 Grant Street
Haverstraw, NY 10927
COUNTY OF ROCKLAND

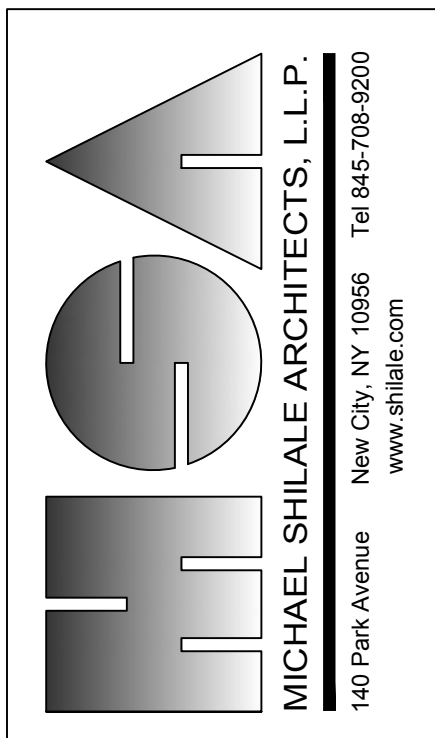

Drawing Title
**1ST FLOOR
 PLAN -
 MECHANICAL**

- NOTES:
- FURNISH AND INSTALL NEW VERTICAL UNIT VENTILATOR. REFER TO THE UNIT VENTILATOR SCHEDULE ON DRAWING M-006 AND DETAILS ON DRAWING M-501. CONNECT OUTSIDE AIR DUCT TO EXISTING OUTSIDE AIR OPENING/LOUVER.
 - FURNISH AND INSTALL NEW VERTICAL UNIT VENTILATOR. UTILIZE EXISTING ORIGINAL BUILT-IN CABINETY ENCLOSURE. REFER TO THE UNIT VENTILATOR SCHEDULE ON DRAWING M-006 AND DETAILS ON DRAWING M-501. CONNECT OUTSIDE AIR DUCT TO EXISTING OUTSIDE AIR OPENING/LOUVER.
 - FURNISH AND INSTALL NEW HORIZONTAL UNIT VENTILATOR WITH NEW CEILING SUPPORTS. REFER TO THE UNIT VENTILATOR SCHEDULE ON DRAWING M-006 AND DETAILS ON DRAWING M-501.
 - FURNISH AND INSTALL NEW EVAPORATOR/AC INDOOR UNIT. REFER TO VRF HEAT RECOVERY INDOOR UNIT SCHEDULE ON DRAWING M-003 AND DETAILS ON DRAWING M-501.
 - FURNISH AND INSTALL NEW OUTSIDE AIR INTAKE LOUVER AT WINDOW INSULATED PANEL. GC TO PROVIDE OPENING TO ACCOMMODATE NEW LOUVER. COORDINATE OPENINGS WITH THE ARCHITECT AND GC. FURNISH AND INSTALL OUTSIDE AIR DUCT CONNECTION TO LOUVER WITH VOLUME DAMPER, SEE PLANS FOR DUCT SIZE.
 - EXISTING OUTSIDE AIR WALL LOUVER TO REMAIN. SIZE VARIES PER EACH ROOM. CONNECT OA INTAKE DUCT TO EXISTING LOUVER. SEE DETAILS ON DRAWING M-501.
 - FURNISH AND INSTALL NEW PROGRAMMABLE ELECTRONIC THERMOSTAT WITH LOCKING GUARD. INTEGRATE WITH THE SIEMENS BMS.
 - FURNISH AND INSTALL NEW RELIEF AIR LOUVER WITH MOTORIZED DAMPER, PROVIDE NEW OPENING AT INSULATED PANEL. COORDINATE OPENINGS WITH GC, SEE ARCHITECTURAL DETAILS. SEE DETAIL 9/M-501.
 - PROVIDE SUPPLY DIFFUSER WITH VOLUME DAMPER AND ASSOCIATED INSULATED DUCTWORK AS INDICATED. FLEX DUCT SHALL BE LIMITED TO 3'-6" MAX. BASIS OF DESIGN: FOR CEILING: TITUS TMS OR EQUAL, FOR SIDE: TITUS 300/350 OR EQUAL.
 - PROVIDE 24x24 RETURN GRILLE IN EXISTING LAY-IN ACOUSTIC CEILING OR NEW SOFFIT. BASIS OF DESIGN: TITUS 45F OR EQUAL.
 - THE EXISTING DOOR UNDERCUT IS SUFFICIENT FOR AIR TRANSFER TO THE ADJACENT SPACE.
 - PROVIDE NEW DOOR UNDERCUT IN SPACE FOR SUFFICIENT AIR TRANSFER OF RELIEF AIR, SEE ARCHITECT DRAWINGS.
 - FURNISH AND INSTALL NEW WALL MOUNT CARBON DIOXIDE SENSOR FOR NEW RTU. REFER TO DRAWING M-004 FOR CONTROL DIAGRAM. MOUNT THE SENSOR ON INSIDE WALL OR PANEL APPROXIMATELY 54" ABOVE THE FLOOR (OR OTHERWISE DIRECTED) TO ALLOW EXPOSURE TO THE AVERAGE ZONE TEMPERATURE. FOR ACCURATE TEMPERATURE SENSING DO NOT MOUNT DEVICE ON OUTSIDE WALL, ADJACENT TO PIPES, IN DIRECT SUNLIGHT, NEAR RADIANT HEAT SOURCES, AIR DUCTS, ETC. THAT COULD IMPACT SENSING ACCURACY. REFER TO MANUFACTURER'S IOM INSTRUCTIONS FOR MORE INFO.

GENERAL NOTE:
FOR PIPING LAYOUT FOR EACH NEW EQUIPMENT, REFER TO DRAWINGS M-301, M-302 AND M-303.


NOTES

NOTE: ALL LINE SETS AND ELECTRICAL CONDUIT IN CORRIDOR SHALL BE ABOVE THE EXISTING ACT CEILING.

NOTE: ANY GC WORK NOT RELATED TO INSTALLATION OF MECHANICAL EQUIPMENT TO BE PART OF PHASE A.

PHASE B WORK. ALL WORK REGARDING UV, CU AND RTU INSTALLATION WITHIN THIS AREA TO BE PERFORMED IN PHASE B.

PHASE A WORK. ALL WORK REGARDING UV AND CU INSTALLATION WITHIN THIS AREA TO BE PERFORMED IN PHASE A.

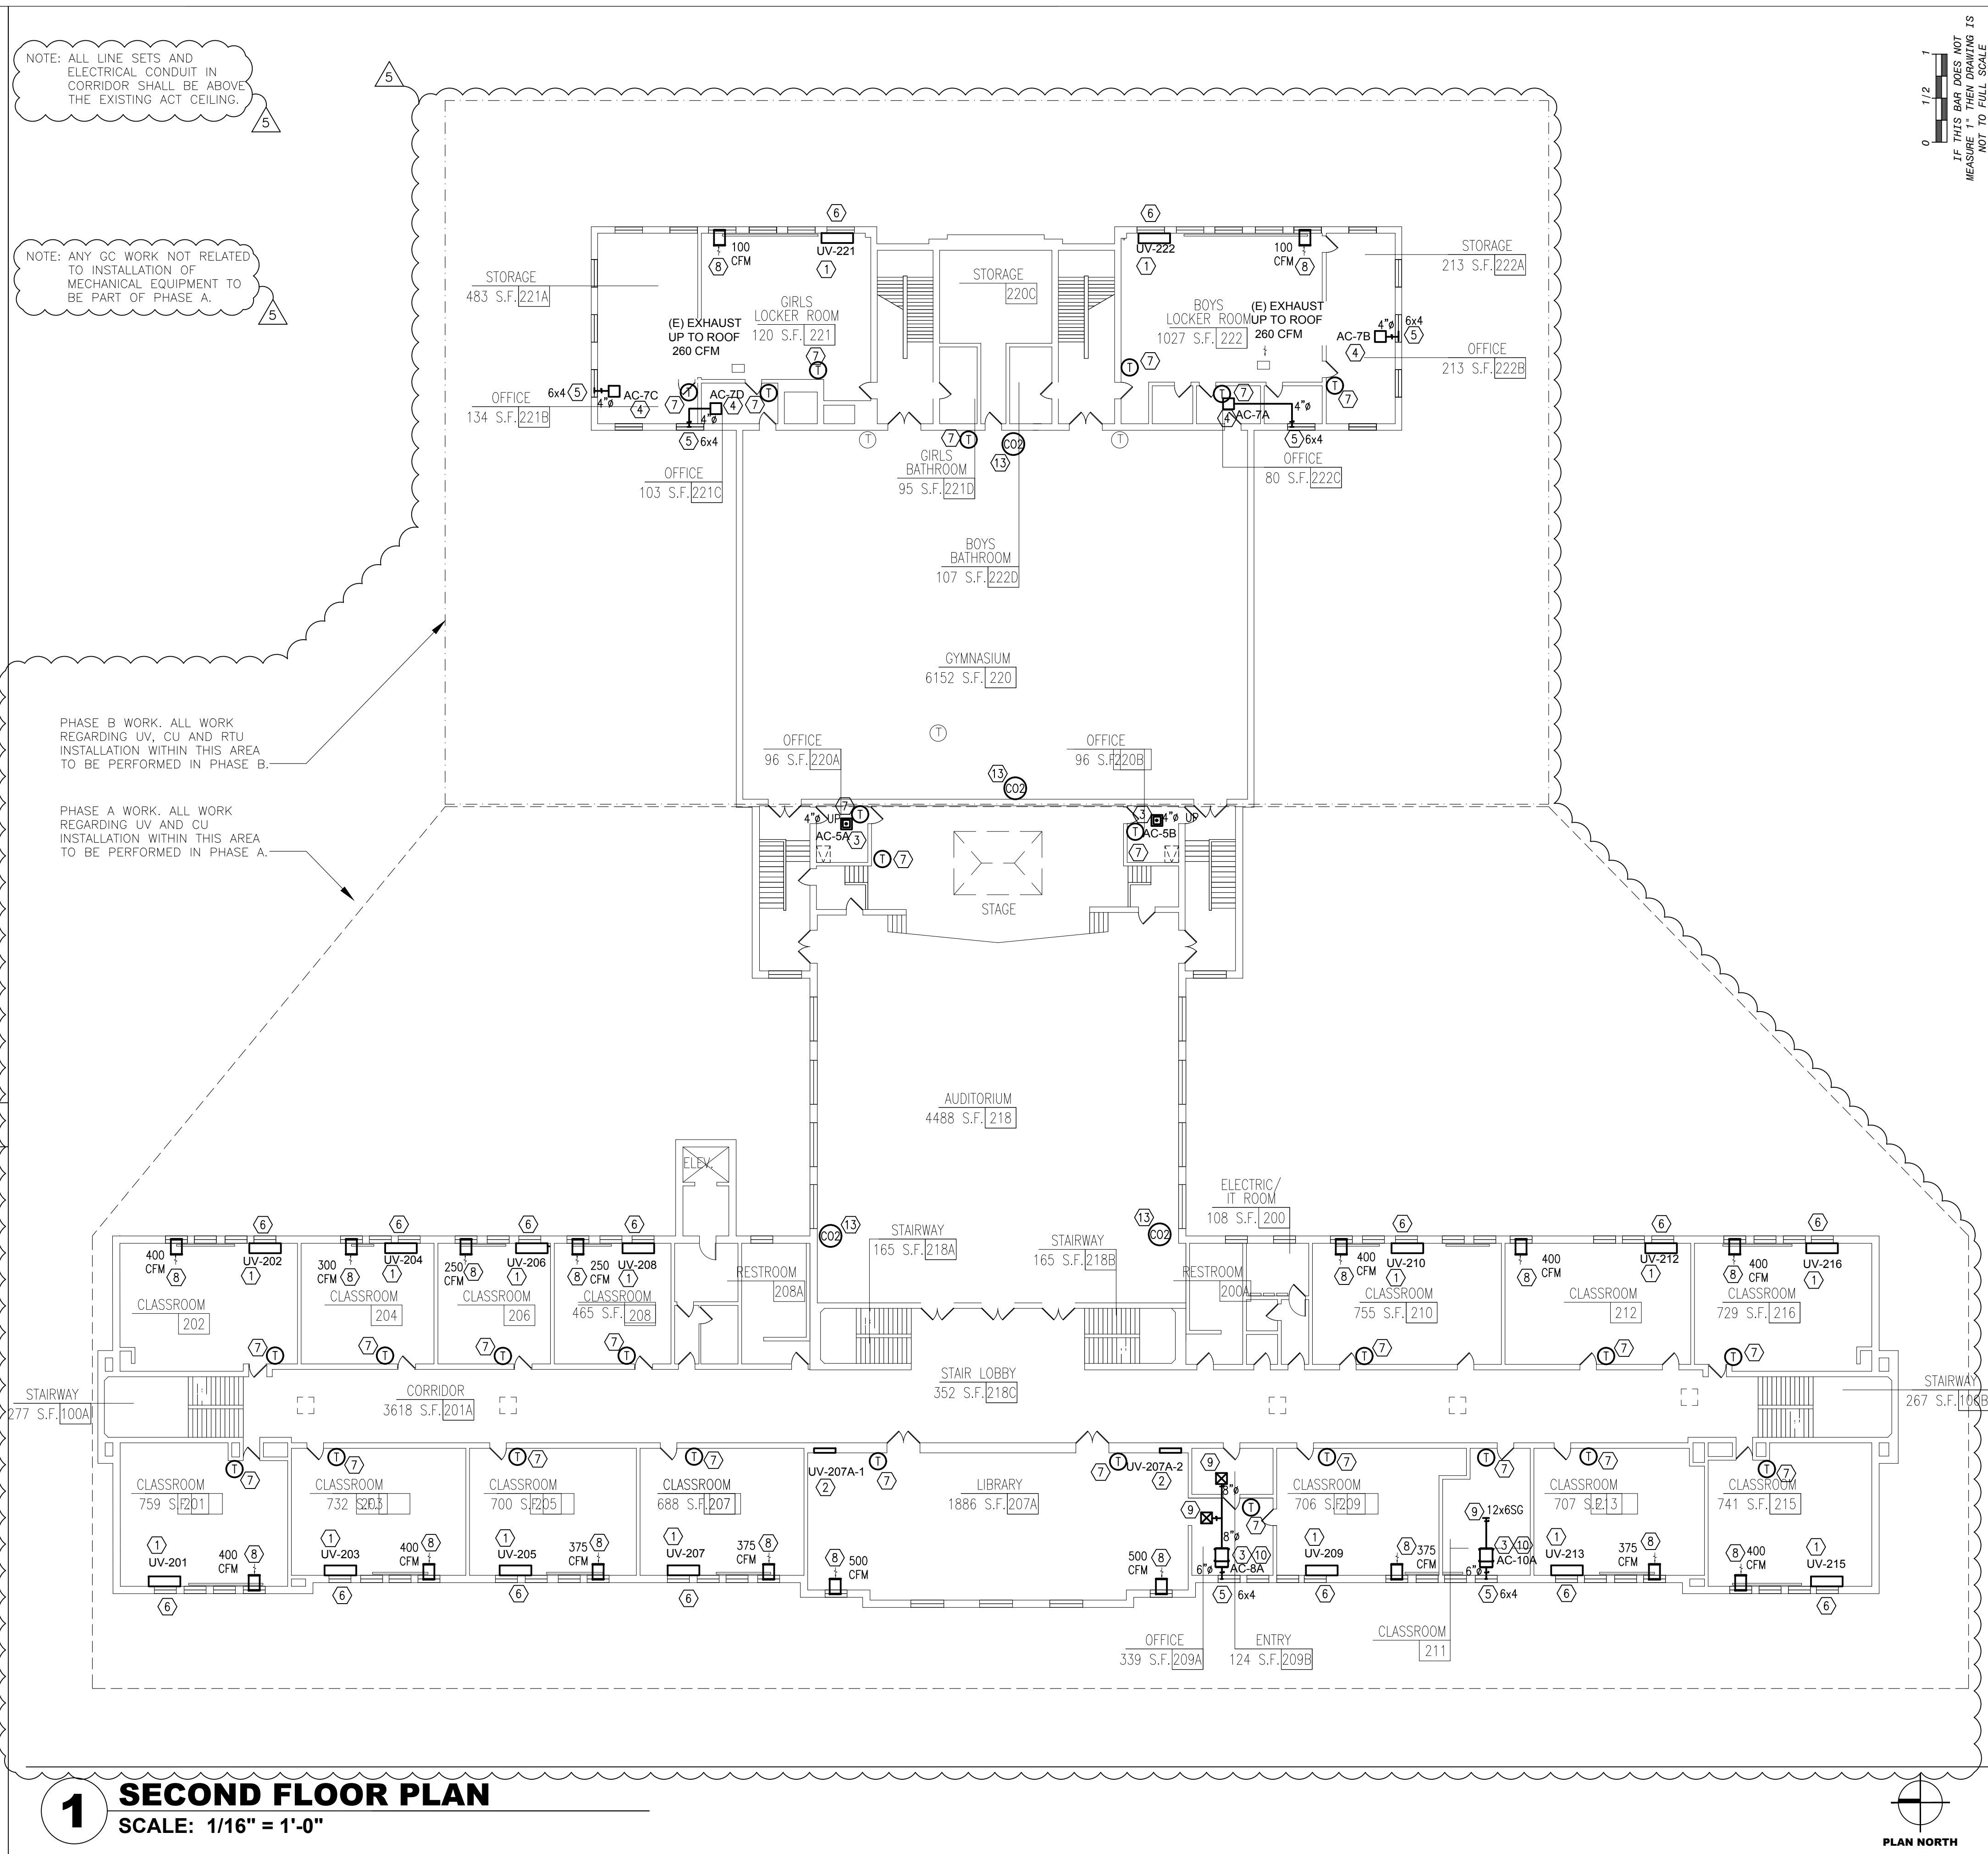

NOTES:

- FURNISH AND INSTALL NEW VERTICAL UNIT VENTILATOR. REFER TO THE UNIT VENTILATOR SCHEDULE ON DRAWING M-006 AND DETAILS ON DRAWING M-501. CONNECT OUTSIDE AIR DUCT TO EXISTING OUTSIDE AIR OPENING/LOUVER.
- FURNISH AND INSTALL NEW VERTICAL UNIT VENTILATOR. UTILIZE EXISTING ORIGINAL BUILT-IN CABINETY ENCLASURE. REFER TO THE UNIT VENTILATOR SCHEDULE ON DRAWING M-006 AND DETAILS ON DRAWING M-501. CONNECT OUTSIDE AIR DUCT TO EXISTING OUTSIDE AIR OPENING/LOUVER.
- FURNISH AND INSTALL NEW HORIZONTAL UNIT VENTILATOR WITH NEW CEILING SUPPORTS. REFER TO THE UNIT VENTILATOR SCHEDULE ON DRAWING M-006 AND DETAILS ON DRAWING M-501.
- FURNISH AND INSTALL NEW EVAPORATOR/AC INDOOR UNIT. REFER TO VRF HEAT RECOVERY INDOOR UNIT SCHEDULE ON DRAWING M-003 AND DETAILS ON DRAWING M-501.
- FURNISH AND INSTALL NEW OUTSIDE AIR INTAKE LOUVER AT WINDOW INSULATED PANEL. GC TO PROVIDE OPENING TO ACCOMMODATE NEW LOUVER. COORDINATE OPENINGS WITH THE ARCHITECT AND GC. FURNISH AND INSTALL OUTSIDE AIR DUCT CONNECTION TO LOUVER WITH VOLUME DAMPER, SEE PLANS FOR DUCT SIZE.
- EXISTING OUTSIDE AIR WALL LOUVER TO REMAIN. SIZE VARIES PER EACH ROOM. CONNECT OA INTAKE DUCT TO EXISTING LOUVER. SEE DETAILS ON DRAWING M-501.
- FURNISH AND INSTALL NEW PROGRAMMABLE ELECTRONIC THERMOSTAT WITH LOCKING GUARD. INTEGRATE WITH THE SIEMENS BMS.
- FURNISH AND INSTALL NEW RELIEF AIR LOUVER 24X12 WITH MOTORIZED DAMPER(24x12), PROVIDE NEW OPENING AT INSULATED PANEL. COORDINATE OPENINGS WITH GC, SEE ARCHITECTURAL DETAILS. SEE DETAIL 9/M-501.
- PROVIDE SUPPLY DIFFUSER WITH VOLUME DAMPER AND ASSOCIATED INSULATED DUCTWORK AS INDICATED. FLEX DUCT SHALL BE LIMITED TO 3'-0" MAX. BASIS OF DESIGN: FOR CEILING: TITUS TMS OR EQUAL, FOR SIDE: TITUS 300/350 OR EQUAL.
- PROVIDE 24x24 RETURN GRILLE IN EXISTING LAY-IN ACOUSTIC CEILING OR NEW SOFFIT. BASIS OF DESIGN: TITUS 45F OR EQUAL.
- THE EXISTING DOOR UNDERCUT IS SUFFICIENT FOR AIR TRANSFER TO THE ADJACENT SPACE.
- PROVIDE NEW DOOR UNDERCUT IN SPACE FOR SUFFICIENT AIR TRANSFER OF RELIEF AIR, SEE ARCHITECT DRAWINGS.
- FURNISH AND INSTALL NEW WALL MOUNT CARBON DIOXIDE SENSOR FOR NEW RTU. REFER TO DRAWING M-004 FOR CONTROL DIAGRAM. MOUNT THE SENSOR ON INSIDE WALL OR PANEL APPROXIMATELY 54" ABOVE THE FLOOR (OR OTHERWISE DIRECTED) TO ALLOW EXPOSURE TO THE AVERAGE ZONE TEMPERATURE. FOR ACCURATE TEMPERATURE SENSING DO NOT MOUNT DEVICE ON OUTSIDE WALL, ADJACENT TO PIPES, IN DIRECT SUNLIGHT, NEAR RADIANT HEAT SOURCES, AIR DUCTS, ETC. THAT COULD IMPACT SENSING ACCURACY. REFER TO MANUFACTURER'S IOM INSTRUCTIONS FOR MORE INFO.
- PROVIDE NEW NON-FLANGED LOUVER AT EXISTING OPENING. INFILL EXISTING OPENING TO ACCOMMODATE NEW LOUVER. SEE ARCHITECT'S PLANS FOR PATCHING AND REPAIR DETAILS AT BUILDING FACADE.
- FURNISH AND INSTALL DUCT SMOKE DETECTOR ON STRAIGHT DUCT, COORDINATE INSTALLATION WITH ELECTRICAL. FURNISH AND INSTALL FIRE SMOKE DAMPER AT ROOF PENETRATION. (TYP. 4).
- CONTRACTOR RESPONSIBLE TO FIELD VERIFY AND MEASURE ROUTING OF NEW DUCTWORK AT STAGE AREA FOR THE NEW RTUs. AVOID ANY CONFLICTS/INTERFERENCE WITH EXISTING CONDITIONS, SUCH AS THE CABLES AND PULLEYS FOR THE STAGE CURTAINS. DUCTWORK SHALL BE ROUTED HIGH AT WALL. SUPPLY DUCTWORK IS TO BE INSULATED. RETURN DUCTWORK TO BE PAINTED BLACK, VERIFY FINISH REQUIREMENTS WITH ARCHITECT.

GENERAL NOTE:

FOR PIPING LAYOUT FOR EACH NEW EQUIPMENT, REFER TO DRAWINGS M-301, M-302 AND M-303.


NOTES

NOTE: ANY GC WORK NOT RELATED TO INSTALLATION OF MECHANICAL EQUIPMENT TO BE PART OF PHASE A.

PHASE B WORK. ALL WORK REGARDING UV AND CU INSTALLATION WITHIN THIS AREA TO BE PERFORMED IN PHASE B.

PHASE A WORK. ALL WORK REGARDING UV AND CU INSTALLATION WITHIN THIS AREA TO BE PERFORMED IN PHASE A.

NOTE: ALL LINE SETS, COMBINER BOXES AND ELECTRICAL CONDUIT ON THIS FLOOR ARE RUN IN THE ATTIC AND DROP VERTICAL TO THE UV UNITS.

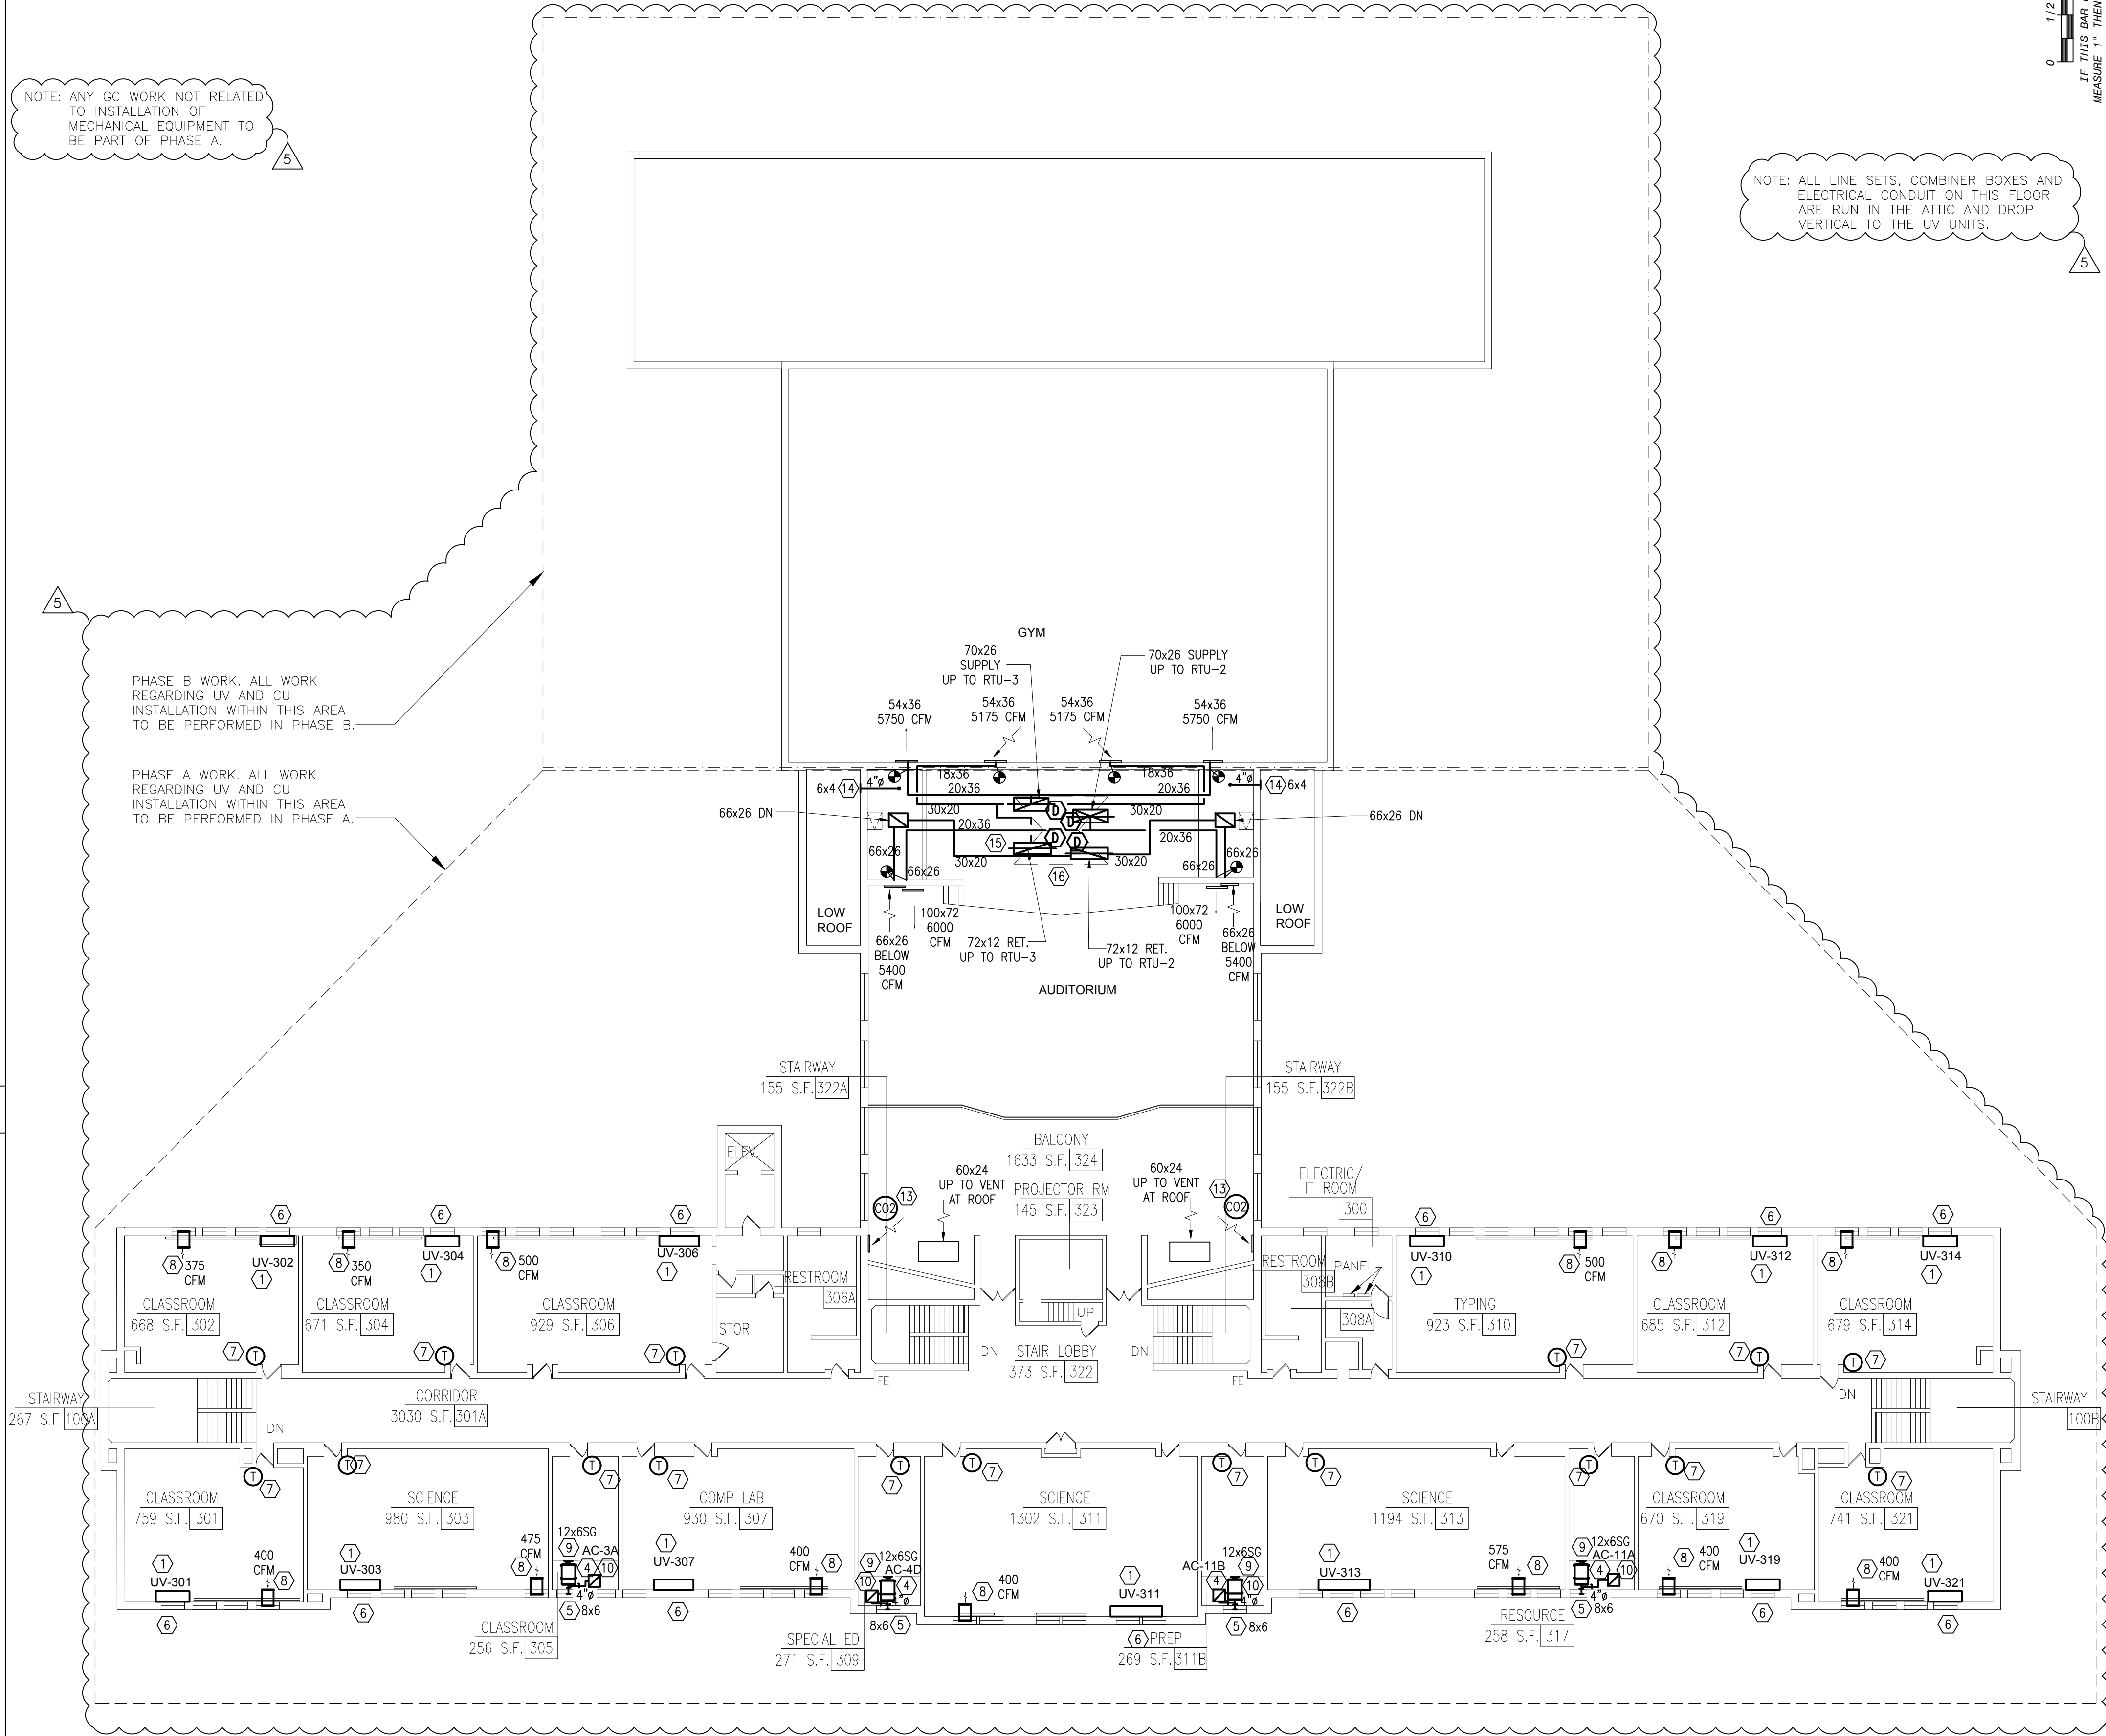

1

THIRD FLOOR PLAN

SCALE: 1/16" = 1'-0"



© COPYRIGHT, MICHAEL SHILALE ARCHITECTS, ALL RIGHTS RESERVED.

MSA
MICHAEL SHILALE ARCHITECTS, L.L.P.
140 Park Avenue
New City, NY 10956
Tel 845-708-9200
www.shilale.com

Drawing Title
**3RD FLOOR
PLAN -
MECHANICAL**

Drawing No.

M-103

**GREENMAN
PEDERSEN, INC**
400 BELLA BOULEVARD
MONTICELLO, NY 10801

Mechanical
Structural
Engineer:

Drawn by WM
Checked by ERF
Project No. 41048
Scale AS NOTED
Date 08-30-21

No.	Date	Revisions
1	08-30-21	BIDDING DOCUMENTS
2	11-19-21	ISSUED ADDENDUM 1
3	12-17-21	ISSUED ADDENDUM 1
5	01-24-22	ADDENDUM 3

NOTES:

- 1 DEMOLISH EXISTING GRAVITY VENTILATOR AND DAMPER AT ROOF. DEMOLISH ASSOCIATED DUCTWORK DIRECTLY BELOW ROOF. DISCONNECT DAMPER FROM SIEMENS BMS CONTROL.
- 2 PROVIDE NEW OUTDOOR CONDENSING UNIT, SEE SCHEDULE ON DRAWING M-002. MOUNT UNIT ON MODIFIED ROOF CURB/DUNNAGE, SEE STRUCTURAL DRAWINGS.
- 3 PROVIDE NEW DX PIPING FROM BRANCH CONTROLLER, SEE FLOOR BELOW. FOR ROOF CURB AND ROOF SUPPORT DETAIL, SEE DRAWING M-502 AND ARCHITECTURAL DRAWINGS FOR PROPER SEALING FOR PIPE SIZES, SEE DRAWING M-401.
- 4 PROVIDE NEW ROOFTOP AIR HANDLING UNIT AT LOCATION OF EXISTING SKYLIGHT, SEE SCHEDULE ON DRAWING M-002. GC TO DEMO EXISTING SKYLIGHT. MOUNT AHUS ON NEW ROOF CURB. PROVIDE ADEQUATE CLEARANCE AS PER MANUFACTURER'S IOM. SEE DETAILS FOR MORE INFO.
- 5 EXISTING GRAVITY VENTILATOR TO REMAIN.
- 6 PROVIDE NEW CONDENSATE DRAINAGE, TERMINATE ON ROOF TO NEAREST DRAIN. PROVIDE SPLASH BLOCK. SEE DETAIL 5/M501 FOR SUPPORT OF PIPING ON ROOF.
- 7 PROVIDE NEW STEAM AND CONDENSATE PIPING, CONNECT TO EXISTING MAIN. SEE DETAIL 3/M501. PROVIDE FACTORY ASSEMBLED PIPE CABINET WITH ROOFTOP AIR HANDLING UNIT. EXTEND BASE FLASHING TO CURB.

NOTES

NOTE: ANY GC WORK NOT RELATED TO INSTALLATION OF MECHANICAL EQUIPMENT TO BE PART OF PHASE A.

PHASE B WORK. ALL WORK REGARDING UV AND CU INSTALLATION WITHIN THIS AREA TO BE PERFORMED IN PHASE B.

PHASE A WORK. ALL WORK REGARDING UV AND CU INSTALLATION WITHIN THIS AREA TO BE PERFORMED IN PHASE A.

1 ROOF PLAN
SCALE: 1/16" = 1'-0"




0 1/2 1
IF THIS BAR DOES NOT MEASURE 1" THEN DRAWING IS NOT TO FULL SCALE

ROOF PLAN -
MECHANICAL

Drawing No.

M-104

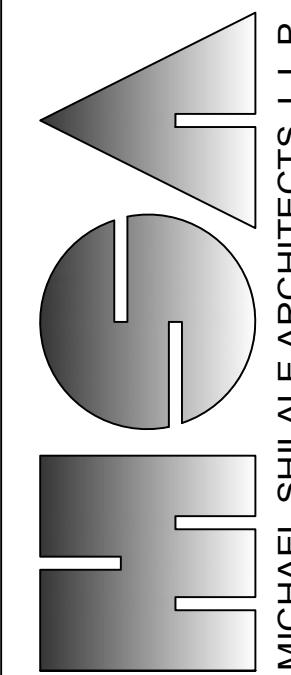

MICHAEL SHILALE ARCHITECTS, L.L.P.
140 Park Avenue
New City, NY 10956
Tel 845-708-9200
www.shilale.com

UNIVENT REPLACEMENT
AT
HAVERSTRAW
ELEMENTARY

SED# 50-02-01-06-0-009-018

18 Grant Street
Haverstraw, NY 10627

COUNTY OF ROCKLAND

GREENMAN
PEDERSEN, INC
400 BELLA BOULEVARD
MONTICELLO, NY 10801

Mechanical
Electrical
Engineer:

Structural
Engineer:

Drawn by WM

Checked by ERF

Project No. 41048

Scale AS NOTED

Date 08-30-21

5 01-24-22 ADDENDUM 3

3 12-17-21 ISSUED FOR BID

2 11-19-21 SED ADDENDUM 1

1 08-30-21 BIDDING DOCUMENTS

No. Date Revisions



5




- ## 6 REFRIGERANT PIPE SUPPORT DETAIL
- SCALE: N.T.S.




2 HORIZONTAL UNIT VENTILATOR

SCALE: N.T.S.

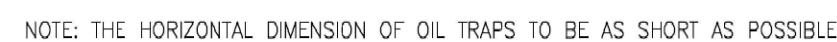

5 DX COIL PIPING DIAGRAM

NOTES:
1. REFER TO THE UNIT VENTILATOR SCHEDULE ON DRAWING M-006 FOR FURTHER INFORMATION.

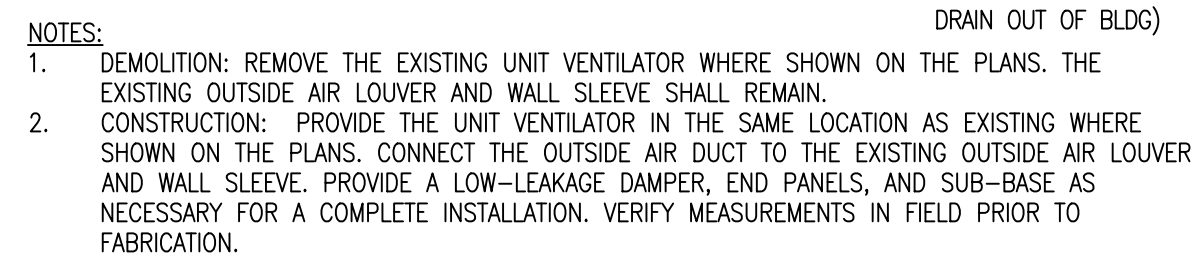

1 UNIT VENTILATOR DETAILS



Diagram illustrating the components and airflow of a mechanical room enclosure:

- (E) WINDOW
- FALSE BACK
- (E) MASONRY WALL
- INSULATED SUPPLY DUCT (72x12 V.I.F.)
- OA LOUVER TO REMAIN
- OA (Outdoor Air) arrow pointing right
- GRADE
- SA (Supply Air) arrow pointing up
- ENCLOSURE
- COILS
- DRAIN PAN
- FILTER
- OA DAMPER
- RA DAMPER
- RA (Return Air) arrow pointing left
- FLOOR
- CONDENSATE DRAIN (PROVIDE FLEX TUB THRU EXISTING GRID DRAIN OUT OF BLDG)

© COPYRIGHT, MICHAEL SHILALE ARCHITECTS, ALL RIGHTS RESERVED.

Drawing	Title
---------	-------

MECHANICAL DETAILS

Drawing No.

M-501

UNIVENT REPLACEMENT

AI HAVERSTRAW ELEMENTARY

SED# 50-02-01-06-0-009-018

8 Grant Street
Taverstraw, NY 10827

**GREENMAN
PEDERSEN, INC.**
400 REILA BOULEVARD
MONTEBELLO, NY 10901

Mechanical
& Electrical
Engineer:

Structural Engineer:

Drawn by	WM
Checked by	ERF
Project No.	41048
Scale	AS NOTED
Date	08-30-21

Date 08-30-21

Revisions