

BUREAU OF CAPITAL PRC



LOCATION PLAN

Purning Dharia.

PURNIMA DHARIA, P.E. EXECUTIVE DIRECTOR, IN-HOUSE DESIGN BUREAU OF ENGINEERING DESIGN AND CONSTRUCTION

NEW YORK CITY ENVIRONMENTAL PROTECTION BUREAU OF ENGINEERING DESIGN AND CONSTRUCTION

CAPITAL PROGRAM KENSICO-EASTVIEW CONNECTION CONTRACT KENS-EAST-2 KENSICO SITE PREPARATION

TOWN OF MOUNT PLEASANT, NY

04/2023

BID SET

APRIL, 2023

Environmental Protection BEDC/IHD



Ana Barrio

ANA BARRIO DEPUTY COMMISSIONER BUREAU OF ENGINEERING DESIGN AND CONSTRUCTION

CTION NECTION

AREA PLAN

'iniano

KIMBERLY CIPRIANO DEPUTY CHIEF OPERATING OFFICER DEPARTMENT OF ENVIRONMENTAL PROTECTION

	DRAWING No.	SHEET TITLE		DRAWING No,	SHEET TITLE		DRAWING No.	SHEET TITLE
		GENERAL	1/2	KSPP-C-155.02	SOIL EROSION & SEDIMENT CONTROL PLAN PHASE 4	$\neg \land$	KSPP-C-320.01	UTH, ITY TRENCH PLAN AND PROFILE 1
$\wedge \mid$	KEC2-G-001.00	COVER SHEET	1 \	KSPP-C-156.00	SOIL EROSION & SEDIMENT CONTROL PLAN PHASE 5		KSPP-C-321.01	UTILITY TRENCH PLAN AND PROFILE 2
2\	KEC2-G-002.02	DRAWING INDEX	1	KSPP-C-157.00	SOIL EROSION & SEDIMENT CONTROL PLAN PHASE 6		KSPP-C-322.00	UTHITY TRENCH PLAN AND PROFILE 3
	KEC2-G-003.01	DRAWING INDEX	1	KSPP-C-158.00	SOIL EROSION & SEDIMENT CONTROL PLAN PHASE 7			CATSKILL SANITARY LINE - PLAN AND PROFILE
	KEC2-G-004.02				SØIL EROSION & SEDIMENT CONTROL PLAN PHASE 8	-		NEW CATSKILL WATER - PLAN AND PROFILE
∇	\checkmark	GENERAL STRUCTURAL			NEW SITE OVERALL PLAN	-		EXISTING COLUMBUS AVE CULVERT - PLAN AND PROFILE
2	KEC2-GS-001 01	STRUCTURAL GENERAL STRUCTURAL NOTES, CODES, AND STANDARDS			NEW SITE PLAN 1	-		CHLORINE MANHOLE RELOCATION
		SIRUCTURAL GENERAL CONCRETE, GROUT, AND ANCHORING NOTES			NEW SITE PLAN 2	-1		
			┫ (/	\neg		RELOCATED WESTLAKE DRIVE ROADWAY PLAN SHEET 1
		STRUCTURAL GENERAL ABBREVIATIONS AND SYMBOLS	$ \land$		NEW SITE PLAN 3	-1	7	RELOCATED WESTLAKE DRIVE ROADWAY PLAN SHEET 2
		STRUCTURAL GENERAL CONCRETE NOTES, TABLES, AND DETAILS	4		NEW SHE PLAN 4	_ (ROADWAY BASELINE DATA TABLES
$^{\land}$	KEC2-GS-005.00	STRUCTURAL GENERAL TYPICAL GENERAL CONCRETE DETAILS	4		NEW SITE PLAN 5			RELOCATED WESTLAKE DRIVE PROFILE SHEET 1
2	\sim			KSPP-C-186.01	NEW SITE PLAN 6		KSPP-C-404.00	RELOCATED WESTLAKE DRIVE PROPILE SHEET 2
$\overline{\langle}$	KSPP-C-001.01	GENERAL NOTES		KSPP-C-187.00	NEW SITE PARTIAL PLAN 7		KSPP-C-405.00	PROFILES OF AERATOR ROAD AND ACCESS RAMPS
	KSPP-C-002.01	LEGEND AND ABBREVIATIONS		KSPP-C-188.00	NEW SITE OPERATIONS ENTRANCE PLAN		KSPP-C-430.00	OPERATIONS ENTRANCE PLAN AND PROFILE
	KSPP-C-003.00	UTILITY NOTES		KSPP-C-189.00	NEW SITE ELECTRICAL BUILDING PLAN		KSPP-C-431.00	SOUTH SCREEN CHAMBER ROAD PLAN AND PROFILE
	KSPP-C-100.00	EXISTING SITE OVERALL PLAN	1	KSPP-C-200.02	GRADING OVERALL PLAN		KSPP-C-432.00	SCREEN CHAMBER ACCESS ROAD PLAN AND PROFILE
	KSPP-C-101.00	EXISTING SITE & BORING LOCATION PLAN 1	1 🔨	KSPP-C-201.01	GRADING PLAN SHEET 1	1	KSPP-C-433.00	NORTH SCREEN CHAMBER ROAD PLAN AND PROFILE
		EXISTING SITE & BORING LOCATION PLAN 2	1 /2 \	/	GRADING SHEET 2			CURB, SIDEWALK, AND RAMP DETAILS
		EXISTING SITE & BORING LOCATION PLAN 3	1		GRADING PARTIAL PLAN 3	$-\chi^2 \chi$		INTERSECTION PLANS, CURB TIES SHEET 1
			4			-		INTERSECTION PLANS, CURB TIES SHEET 2
		EXISTING SITE & BORING LOCATION PLAN 4	-		GRADING PARTIAL PLAN 4	-		
		EXISTING SITE & BORING LOCATION PLAN 5	4		GRADING PARTIAL PLAN 5			MAINTENANCE & PROTECTION OF TRAFFIC NOTES
		EXISTING SITE & BORING LOCATION PLAN 6	4		GRADING PARTIAL PLAN 6	┥.		PHASE 1 - MAINTENANCE & PROTECTION OF TRAFFIC PLAN - SHEET 1
		EXISTING SITE & BORING LOCATION PLAN 7	4		GRADING PARTIAL PLAN 7	\neg		PHASE 1 - MAINTENANCE & PROTECTION OF TRAFFIC PLAN - SHEET 2
	KSPP-C-108.00	EXISTING SITE & BORING LOCATION AERATOR ROAD PLAN 1	1	KSPP-C-208.00	GRADING OPERATIONS ENTRANCE PLAN		KSPP-C-473.01	PHASE 1 - MAINTENANCE & PROTECTION OF TRAFFIC PLAN - SHEET 3
	KSPP-C-109.00	EXISTING SITE & BORING LOCATION AERATOR ROAD PLAN 2		KSPP-C-209.00	GRADING ELECTRICAL BUILDING PLAN		(KSPP-C-474.01	PHASE 1 - MAINTENANCE & PROTECTION OF TRAFFIC PLAN - SHEET 4
	KSPP-C-110.00	SITE DEMOLITION OVERALL PLAN		KSPP-C-210.01	DRAINAGE OVERALL PLAN		KSPP-C-475.01	PHASE 2 - MAINTENANCE & PROTECTION OF TRAFFIC PLAN - SHEET 1
	KSPP-C-111.00	SITE DEMOLITION PLAN 1	144	KSPP-C-211.02	DRAINAGE PLAN 1		KSPP-C-476.01	PHASE 2 - MAINTENANCE & PROTECTION OF TRAFFIC PLAN - SHEET 2
		SITE DEMOLITION PLAN 2	1 /\`		DRAUMAGEPHANZ			TARTS PLAN FOR RIPE-REPLACENENT
		SITE DEMOLITION PLAN 3	┫╱╧╱╱	· · · ·	DRAINAGE PLAN 3	\neg	X	SIGNING AND STRIPING PLAN SHEET 1
		SITE DEMOLITION PLAN 4	1 \		DRAINAGE PLAN 4 / / /			SIGNING AND STRIPING REAM SHEET 2
2								
- \		SITE DEMOLITION PLAN 5	2	· · · · · · · · · · · · · · · · · · ·	DRAIMAGE PLAN 5	-1/2		SIGNING AND STRIPING PLAN SHEET 3
		SITE DEMOLITION PLAN 6	\downarrow		DRAINAGE PLAN 6			SIGNING AND STRIPING PLAN SHEET 4
		SITE DEMOLITION PLAN 7			DRAINAGE PLAN 7	-		SIGNING AND STRIPING PLAN SHEET 5
\sim		SITE DEMOLITION - VAD REMOVAL PLAN 1			DRAINAGE ELECTRICAL BUILDING PLAN	4	KSPP-C-531.00	HORIZONTAL CONTROLS PLAN 1
2λ	KSPP-C-119,01	SHE DEMOLITION - VAD REMOVAL PLAN 2	$\underline{\checkmark}$	KSPP-C-219.01	DRAINAGE - MANHOLE CONNECTION DETAIL		KSPP-C-532.00	HORIZONTAL CONTROLS PLAN 2
$\langle $	KSPP-Ç-120.01	TREE CLEARING SCHEDULE PARTIAL PLAN 1		KSPP-C-220.01	DRAINAGE PROFILE SHEET 1		KSPP-C-533.01	HORIZONTAL CONTROLS PLAN 3
	KSPP-C-121.00	TREE CLEARING SCHEDULE SHEET'S		KSPP-C-221.01	DBAINAGE PROFILE SHEET 2		KSPP-C-534.01	HORIZONTAL CONTROLS PLAN 4
	KSPP-C-122.00	TREE CLEARING SCHEDULE SHEET 3	1	KSPP-C-222.00	DRAINAGE PLAN AND PROFILE 4		KSPP-C-535.00	HORIZONTAL CONTROLS PLAN 5
	KSPP-C-123.00	TREE CLEARING SCHEDULE SHEET 4		KSPP-C-223.00	DRAINAGE PLAN AND PROFILE 5	1	KSPP-C-538.00	HORIZONTAL CONTROLS - OPERATION'S ENTRANCE PLAN
		TREE CLEARING SCHEDULE PARTIAL PLAN 5	1/2		DRAINAGE PLAN AND PROFILE 6	-		HORIZONTAL CONTROLS - ELECTRICAL BUILDING PLAN
		TREE CLEARING TABLE SHEET 1			PARKING LOT GRADING AND DRAINAGE	-		HORIZONTAL CONTROLS - RWLD POND PLAN
		TREE CLEARING TABLE SHEET 2	4 \		DBAINAGE SWALE PROFILES SHEET 1	-		HORIZONTAL CONTROLS - CATSKILL POND PLAN
						-		
		TREE CLEARING TABLE SHEET 3	/2	~	DRAINAGE SWALE PROFILES SHEET 2			HORIZONTAL CONTROLS - DELAWARE POND PLAN
		TREE CLEARING TABLE SHEET 4			DRAÎNAGE SWALE PROFILES SHEET 3	-		HORIZONTAL CONTROLS - TABLE
		TREE CLEARING TABLE SHEET 5	\downarrow \checkmark		DRAINAGE SWALE PROFILES SHEET 4	_		CROSS SECTIONS SHEET 1
	KSPP-C-130.00	TREE CLEARING TABLE SHEET 6		KSPP-C-234.00	DRAINAGE SWALE PROFILES SHEET 5		KSPP-C-601.00	EARTHWORK CROSS SECTION 1
	KSPP-C-131.00	TREE CLEARING TABLE SHEET 7		KSPP-C-235.01	DRAIŇAGE SWALE PROFILES SHEET 6		KSPP-C-602.00	EARTHWORK CROSS SECTION 2
	KSPP-C-132.00	TREE CLEARING TABLE SHEET 8		KSPP-C-236.01	DRAINAGE SWALE PROFILES SHEET,7		KSPP-C-603.00	EARTHWORK CROSS SECTION 3
	KSPP-C-133.00	TREE CLEARING TABLE SHEET 9		KSPP-C-240.00	D109 TOWER RETAINING WALL PLAN		KSPP-C-604.00	EARTHWORK CROSS SECTION 4
		TREE CLEARING TABLE SHEET 10	1		D109 TOWER RETAINING WALL ELEVATION	7		EARTHWORK CROSS SECTION 5
		TREE CLEARING TABLE SHEET 11	1		D109 TOWER RETAINING WALL SECTION	1		EARTHWORK CROSS SECTION 4
		TREE CLEARING TABLE SHEET 12	1		D110 TOWER RETAINING WALL PLAN	1		ROADWAY CROSS SECTIONS SHEET 1
		TREE CLEARING TABLE SHEET 12	1		D110 TOWER RETAINING WALL ELEVATION	-		ROADWAY CROSS SECTIONS SHEET 2
						-		
		TREE CLEARING TABLE SHEET 14	$\sqrt{2}$		BILLOFOWER REFAINING WALL SECTION			SITE CROSS-SECTIONS
$\langle \rangle$		TREE CLEARING TABLE SHEET 15	$+$ $\overline{\langle}$		SITE UTILITY OVERALL PLAN	- / 2	V	SITE DETAILS 1
<u> </u>		CONSTRUCTION STAGING PLAN 1	┥ `		SUTE UTIL/TX PLAN 1	\dashv		SITE DETAILS 2
(CONSTRUCTION STAGING PLAN 2	4		SITE UTILITY PLAN 2			SITE DETAILS 3
\setminus		CONSTRUCTION STAGING PLAN - SHAFT 1C STAGING AREA	4	KSPP-C-303.01	SITE UTILITY PLAN 3		KSPP-C-705.00	SITE DETAILS 4
	KSPP-C-150.00	SOLL EROSION & SEDIMENT CONTROL PLAN	J	KSPP-C-304.01	SITE UTILITY PLAN 4		KSPP-C-706.00	SITE DETAILS 5
Ϋ́Ι	Курр-С-151.02	SOIL EROSION & SEDIMENT CONTROL PLAN PHASE	J	KSPP-C-305.00	SITE UTILITY PLAN 5		KSPP-C-707.00	SITE DETAILS 6
	KSPP-C-152.02	SOIL EROSION & SEDIMENT CONTROL PLAN PHASE 2	1	KSPP-C-308.00	OPERATIONS ENTRANCE PLAN	7	KSPP-C-708.00	SITE DETAILS 7
		SOIL EROSION & SEDIMENT CONTROL PLAN PHASE 3 SHEET 1	1		ELECTRICAL BUILDING UTILITY PLAN	7		SITE DETAILS 8
\setminus	KSPP-C-154.01	SOIL EROSION & SEDIMENT CONTROL PLAN PHASE 3 SHEET 2	1	KSPP-C-311.00	LAKEVIEW AVENUE ENTRANCE UTILITY RELOCATION PLAN			EROSION & SEDIMENT CONTROL DETAILS 1
			-					
		DESIGNED BY: DRA	WN BY:		OF NEW ACCOUNTABLE MANAG	GER		
		ABA EF		/	KRENT LOSS IN RIVELLINO		NEW YOR	K STATE EDUCATION LAW, 7209.2, FOR ANY PERSON,
		CHECKED BY:			PORTFOLIO MANAGER		UNLESS (S)HE IS ACTING UNDER THE FNVIRONMENTAL, PRC
+		AD		TTM			PROFESS	IN OF A LICENSED IONAL ENGINEER, TO ALTER BUREAU OF ENGINEERING DESIGN &
07/2	2023 ADDENDUM 2	UESIGN LEAD:	イス				THIS DOC	UMENT IN ANY WAY. IF , THE ALTERING PERSON SHALL 96-05 HORACE HARDING EXPRESSW
								, THE ALTERING PERSON SHALL WITH THE REQUIREMENTS OF CORONA, NEW YORK 113

4

2



8

10

В

С

D

Е

F

DRAWING No.	SHEET TITLE
KSPP-C-711.01	EROSION & SEDIMENT CONTROL DETAILS 2
KSPP-C-712.00	EROSION & SEDIMENT CONTROL DETAILS 3
KSPP-C-715.00	EROSION & SEDIMENT CONTROL DETAILS 4
KSPP-C-716.00	EROSION & SEDIMENT CONTROL DETAILS 5
KSPP-C-717.00	EROSION & SEDIMENT CONTROL DETAILS 6
KSPP-C-718.01	EROSION & SEDIMENT CONTROL DETAILS 7
KSPP-C-720.00	DRAINAGE DETAILS 1
KSPP-C-721.00	DRAINAGE DETAILS 2
KSPP-C-725.01	DRAINAGE DETAILS 3
KSPP-C-726.00	DRAINAGE DETAILS 4
KSPP-C-727.00	DRAINAGE DETAILS 5
KSPP-C-728.01	DRAINAGE-DETAILS 6
KSPP-C-730.01	DRAINAGE RWLD POND - ENLARGED PLAN
KSPP-C-731.01	DRAINAGE RWLD POND - PROFILE AND DETAILS
KSPP-C-732.01	DRAINAGE CATSKILL POND - ENLARGED PLAN
KSPP-6-733.00	BRAINAGE CATSKILL POND PROFILE AND DELAILS
KSPP-C-734.01	DRAINAGE DELAWARE POND - ENLARGED PLAN
KSPP-C-735.00	DRAINAGE DELAWARE POND - PROFILE AND DETAILS
KSP P=6- 73 6.00	DRAINAGE POND DETAILS
KSPP-C-740.01	ROADWAY DETAILS SHEET 1
KSPP-C-741.00	ROADWAY DETAILS SHEET 2
KSPP-C-745.00	SIDEWALK PAVEMENT SHEET 1
KSPP-C-748.00	SIGN TEXT DATA DETAILS SHEET 1
KSPP-C-749.00	TEMPORARY TRAFFIC CONTROL SIGNS AND DETAILS
KSPP-C-750.00	TEMPORARY TRAFFIC CONTROL DETAILS
KSPP-C-760.00	UTILITY DETAILS SHEET 1
KSPP-C-762.00	UTILITY DETAILS SHEET 2
KSPP-C-763.00	UTILITY DETAILS SHEET 3
KSPP-C-764.00	DRAINAGE CULVERT - PLAN AND PROFILE 1
KSPP-C-765.00	DRAINAGE CULVERT - PLAN AND PROFILE 2
KSPP-C-766.00	DRAINAGE CULVERT - PLAN AND PROFILE 3
KSPP-C-770.00	CON ED TOWER RETAINING WALL REINFORCEMENT DETAIL
KSPP-C-780.00	DRAINAGE OUTLET STRUCTURAL NOTES 1
KSPP-C-781.00	DRAINAGE OUTLET STRUCTURAL NOTES 2
KSPP-C-782.00	DRAINAGE OUTLET TYPICAL CONCRETE REINFORCING NOTES
KSPP-C-783.00	DRAINAGE OUTLET TYPICAL DETAILS
KSPP-C-784.00	DRAINAGE OUTLET TYPICAL PLANS
KSPP-C-785.00	DRAINAGE OUTLET TYPICAL SECTIONS 1
KSPP-C-786.00	DRAINAGE OUTLET TYPICAL SECTIONS 2
KSPP-C-787.00	DRAINAGE OUTLET RWLD POND SECTIONS 1
KSPP-C-788.00	DRAINAGE OUTLET RWLD POND SECTIONS 2
KSPP-C-789.00	DRAINAGE OUTLET TYPICAL 3D VIEWS

	ADDENDUM NO. 2 DATE ISSUED: 07/2023	GRAPHIC SCALES CHECK BEFORE USE IF SHEET IS LESS THAN 22" IT IS A REDUCED PRINT SCALE ACCORDINGLY		VERTICAL DATUM CONVERSION (ft) +1.28 BWS 0 - NAVD88
ECTION	CONTRACT KENS-E KENSICO SITE PREPA		DATE: SCALE SHEET	JULY 2023 : AS NOTED NO:
STRUCTION 5th FLOOR	DRAWING IND	EX		WING NO. 2-G-002.02

7/28/2023 4:01 Plot Style To ÷ Date & Time Plott Plot Scale:1:1 0 4 Last Saved By: Julian.safar Last Date Saved: 7/28/2023 Paper Size Printed/Plotted: (34.00 x 22.00 Inches) "

DR	AWING No.	I	IEET TITI	.E		DRAWING No.	
11075			RAL			KSEB-S-104.00	ENLARGED GENERA
	3-A-001.00 3-A-002.00	ABBREVIATIONS & SYMBOLS ZONING ANALYSIS			—	KSEB-S-105.00 KSEB-S-110.00	EQUIPMENT PAD LA
	3-A-002.00	NEW YORK STATE BUILDING CODE				KSEB-S-110.00 KSEB-S-111.00	ENLARGED ROOF PLA
	3-A-004.00	NEW YOR STATE ENERGY CODE				KSEB-S-112.00	ROOF TOPPING SLA
KSEE	3-A-005.00	GENERAL NOTES				KSEB-S-113.00	ENLARGED ROOFIN
KSEE	3-A-100.00	SITE PLAN				KSEB-S-114.00	ENLARGED ROOF U
	3-A-101.00	FLOOR PLAN				KSEB-S-115.00	ROOF TOP STEEL D
	3-A-102.00				_	KSEB-S-116.00	ROOF TOP STEEL D
	3-A-103.00				_	KSEB-S-120.00	SPIRAL STAIR TOWI
	3-A-104.00 3-A-200.00	ENLARGED PLANS ELEVATIONS 1			_	KSEB-S-121.00 KSEB-S-201.00	NORTH AND SOUTH
	3-A-201.00	ELEVATIONS 2				KSEB-S-202.00	NORTH WALL FACA
	3-A-202.00	EYEWASH ENCLOSURE ELEVATIONS	5			KSEB-S-203.00	NORTH WALL CON
KSEE	3-A-300.00	SECTION 1				KSEB-S-204.00	NORTH PARAPET -I
KSEE	3-A-301.00	SECTION 2				KSEB-S-205.00	SOUTH WALL FACA
	3-A-400.00	WALL SECTIONS 1				KSEB-S-206.00	SOUTH WALL CON
	3-A-401.00	WALL SECTIONS 2			_	KSEB-S-207.00	SOUTH PARAPET -II
	3-A-402.00	WALL SECTIONS 3				KSEB-S-208.00	
	3-A-403.00					KSEB-S-209.00 KSEB-S-210.00	WEST WALL ELEVA
	3-A-404.00 3-A-500.01	WALL SECTIONS 5 TYP. WALL (PLAN) DETAILS			$\rightarrow $	KSEB-S-210.00 KSEB-S-211.00	WEST WALL CONN
	3-A-501.00	TYP. WALL (SECTION) DETAILS	\sim			KSEB-S-212.00	WEST WALL FACAD
	3-A-502.00	SLIDING DOOR DETAILS 1				KSEB-S-213.00	WEST WALL CONN
KSEE	3-A-503.00	SLIDING DOOR DETAILS 2				KSEB-S-214.00	WEST PARAPET INN
KSEE	3-A-504.00	SLIDING DOOR MOTOR DETAILS				KSEB-S-215.00	EAST WALL ELEVAT
	3-A-505.00	WINDOW DETAILS				KSEB-S-216.00	EAST WALL FACADE
	3-A-506.00					KSEB-S-217.00	EAST WALL EAST W
	3-A-507.00	WINDOW/DOOR/LOUVER DETAILS			—	KSEB-S-218.00	EAST WALL FACADE
	3-A-508.00 3-A-509.00	ROOF DRAINAGE DETAILS 1 ROOF DRAINAGE DETAILS 2			—	KSEB-S-219.00	EAST WALL CONNE
	3-A-509.00 3-A-510.00	PARAPET DETAILS 1				KSEB-S-220.00 KSEB-S-221.00	TYPICAL BUILDING
	3-A-510.00	PARAPET DETAILS 2				KSEB-S-222.00	THROUGH BUILDIN
	3-A-512.00	BUILDING CORNER/CORNICE/COPI	NG DETA	LS		KSEB-S-223.00	THROUGH BUILDIN
KSEE	KSEB-A-513.00 ROOF & ROOF MOUNTING DETAILS					KSEB-S-224.00	GENERATOR PAD S
	3-A-514.00	ROOF PENETRATION AND MOUNTI	ILS 1		KSEB-S-225.00	SLIDING DOOR FRA	
	3-A-515.00	ROOF PENETRATION AND MOUNTI				KSEB-S-230.00	SPIRAL STAIR TOW
	3-A-516.00	ROOF PENETRATION AND MOUNTI	NG DETA	ILS 3	—	KSEB-S-231.00	SPIRAL STAIR TOW
	3-A-517.00 3-A-518.00	ROOF ACCESS DETAILS			—	KSEB-S-232.00	SPIRAL STAIR ELEVA
	3-A-518.00 3-A-519.00	SPIRAL STAIR ENCLOSURE DETAILS				KSEB-S-301.00 KSEB-S-302.00	CONCRETE NOTES,
	3-A-519.00	GFRC MOUNTING DETAILS				KSEB-S-302.00 KSEB-S-303.00	TYPICAL GENERAL O
	3-A-521.00	EYEWASH ENCLOSURE DETAILS 1				KSEB-S-304.00	TYPICAL CONCRETE
KSEE	3-A-522.00	EYEWASH ENCLOSURE DETAILS 2				KSEB-S-305.00	TYPICAL CONCRETE
KSEE	3-A-523.00	EXEWASH ENCLOSURE DEFAILS 3	\checkmark			KSEB-S-306.00	TYPICAL CONCRETE
	3-A-600.01	DOOR SCHEDULE & DETAILS	_			KSEB-S-307.00	TYPICAL CONCRETE
	3-A-601.01	WINDOW, LOUVER, & FINSIH SCHE	DULES			KSEB-S-308.00	TYPICAL CONCRETE
KSEE	3-A-602.00	SIGN SCHEDULE			_	KSEB-S-309.00	TYPICAL CONCRETE
KCER	3-S-001.01	CODES, STANDARDS, AND GENERA			~	KSEB-S-310.00	TYPICAL CONCRETE
	3-S-001.01 3-S-002.00	CONCRETE AND PRECAST GENERAL			\rightarrow	KSEB-S-311.00 KSEB-S-312.00	TYPICAL CONCRETE
	3-S-002.00 — 3-S-003.00	STEEL, ANCHORAGE, AND MASONF				KSEB-S-312.00 KSEB-S-313.00	TYPICAL CONCRETE
	3-S-004.00	ELEMENTS DESIGNED BY CONTRAC				KSEB-S-314.00	TYPICAL SLIDING D
KSEE	3-S-005.00	SPECIAL INSPECTION AND TEST REC	QUIREME	NTS		KSEB-S-315.00	PRECAST STRUCTU
KSEE	3-S-006.00	ABBREVIATIONS AND SYMBOLS				KSEB-S-316.00	PRECAST PRESTRES
	3-S-010.00	LOADING CRITERIA				KSEB-S-317.00	CONCRETE WALL W
	3-S-011.00	SNOW AND WIND LOADING CRITER				KSEB-S-318.00	PRESTRESSED SLAB
	3-S-012.00	WIND COMPONENTS & CLADDING	loads		—	KSEB-S-319.00	PRESTRESSED SLAB
	3-S-013.00 3-S-014.00	SPIRAL STAIR LOADING CRITERIA PRECAST PRESTRESSED BEAM LOAI)F 3	—	KSEB-S-320.00	PRECAST CONCRET
	3-S-014.00 3-S-015.00	PRECAST PRESTRESSED BEAM LOAL				KSEB-S-321.00 KSEB-S-322.00	CONCRETE STRUCT
	3-S-015.00 3-S-016.00	PRECAST PRESTRESSED BEAM LOAD				KSEB-S-322.00 KSEB-S-323.00	WALL & HEADER R
	3-S-100.00	OVERALL FLOOR PLAN OF ELECTRIC				KSEB-S-324.00	WALL & HEADER C
KSEE	3-S-101.00	OVERALL FLOOR PLAN OF ELECTRIC	AL PADS			KSEB-S-325.00	WALL REINFORCEM
KSEE	3-S-102.00	ENLARGED FOUNDATION PLAN				KSEB-S-326.00	CMU WALL WITH P
KSEE	3-S-103.00	ENLARGED ELECTRICAL BUILDING F	LOOR			KSEB-S-327.00	CMU WALL WITH P
				DESIGNED BY:	DRAWN BY:		E OF NEW LO
				ABA	EF	/	AP INCENT LE PA
				CHECKED BY: AD	·		
				DESIGN LEAD:	ΙΔΓ	UP	
			VL	VINCENT LEE, PE			U. LICEISON
07/2023	ADDENDUM 2		۷L	SECTION MANAGER:			POFESSIONAL EN

All inquiries regarding this drawing(s) or project should be made to NYC Environmental Protection, Bureau of Engineering Design and Construction.

4

6

SHEET TITLE
ERATOR PAD STAIR PLAN
D LAYOUT PLAN
PLAN OF ELECTRICAL BUILDING
F PLAN OF ELECTRICAL BUILDING
SLAB REINFORCEMENT LAYOUT
FING PENETRATION PLAN
F UNDERSLAB EMBEDMENT PLAN
DUNNAGE FRAMING PLAN
DUNNAGE ACCESS PLAN
WER PLANS
WER PLAN (CONTINUED)
JTH WALL ELEVATION
DNNECTION ELEVATION
Γ-INNER FACE ELEVATION
CADE ELEVATION
ONNECTION ELEVATION
Γ-INNER FACE ELEVATION
ELEVATION
VATION
CADE PARTIAL ELEVATION (NORTH)
CADE PARTIAL ELEVATION (SOUTH)
NNECTION PARTIAL ELEVATION (SOUTH)
INNER FACE (LOOKING WEST)
/ATION
ADE PARTIAL ELEVATION (SOUTH)
WALL CONNECTION PARTIAL ELEVATION
ADE PARTIAL ELEVATION (NORTH)
NECTION PARTIAL ELEVATION (NORTH)
NNER FACE (LOOKING EAST)
NG SECTION (LOOKING NORTH)
DING (LOOKING EAST) (NORTH)
DING (LOOKING EAST) (SOUTH)
D STAIR ELEVATION
RAMING ELEVATION
OWER FRAMING ELEVATION
WER FRAMING ELEVATION (CONTINUED)
EVATION
ES, TABLES, AND DETAILS
AL CONCRETE DETAILS
OR S.O.G. CONCRETE DETAILS
ETE DETAILS 1
ETE DETAILS 2
ETE DETAILS 3
ETE DETAILS 4
ETE DETAILS 5
ETE DETAILS 6
ETE DETAILS 7
ETE DETAILS 8
ETE DETAILS 9
G DOOR SUPPORT DETAILS 1
G DOOR SUPPORT DETAILS 2
TURAL WALL BRACING DETAILS
RESSED SLAB CONN. DETAILS
L WITH CORBEL DETAILS
AB AND BEAM DETAILS
AB CONN. DETAILS
RETE WALL OPENING DETAILS
ICTURAL WALL DETAILS 1
ICTURAL WALL DETAILS 1
R REINFORCEMENT DETAILS
R CONNECTION SYMBOL LEGEND
CEMENT SCHEDULE
H PRECAST DETAILS 1
H PRECAST DETAILS 2

DRAWING No.	SHEET TITLE
KSEB-S-328.00	TYPICAL DUNNAGE RAILING DETAILS 1
KSEB-S-329.00	DUNNAGE SWING GATE DETAILS
KSEB-S-330.00	TYPICAL DUNNAGE LADDER DETAILS
KSEB-S-331.00	TYPICAL ROOF DUNNAGE DETAILS 1
KSEB-S-332.00	TYPICAL ROOF DUNNAGE DETAILS 2
KSEB-S-333.00	TYPICAL ROOF DUNNAGE DETAILS 3
KSEB-S-334.00	TYPICAL ROOF DUNNAGE DETAILS 4
KSEB-S-335.00	TYPICAL ROOF DUNNAGE DETAILS 5
KSEB-S-336.00	TYPICAL ROOF DUNNAGE DETAILS 6
KSEB-S-337.00	TYPICAL ROOF DUNNAGE DETAILS 7
KSEB-S-338.00	STEEL DUNNAGE CONNECTION DETAILS
KSEB-S-339.00	ROOF SLAB DETAILS AT COLLECTION DRAIN
KSEB-S-340.00	ROOF BEAM & PILASTER DETAILS
KSEB-S-341.00	HUNG MEP SUPPORT DETAILS 1
KSEB-S-342.00	HUNG MEP SUPPORT DETAILS 2
KSEB-S-343.00	HUNG MEP SUPPORT DETAILS 3
KSEB-S-344.00	REMOVABLE GRATING WALKWAY DETAILS
KSEB-S-345.00	ROOFTOP DAVIT DETAILS 1
KSEB-S-346.00	ROOFTOP DAVIT DETAILS 2
KSEB-S-347.00	ROOFTOP DAVIT DETAILS 3
KSEB-S-348.00	DUNNAGE 2 RAILING DETAIL AT CORNICE
KSEB-S-349.00	GRATING WALKWAY DETAIL AT SPIRAL STAIR
KSEB-S-350.00	TYPICAL ROOF STUB DETAILS
KSEB-S-351.00	TYPICAL ROOFTOP MEP SUPPORT DETAILS 1
KSEB-S-352.00	TYPICAL ROOFTOP MEP SUPPORT DETAILS 2
KSEB-S-360.00	KENSICO SITE ELECTRICAL HOUSE PAD
KSEB-S-361.00	ENLARGED EYE WASH ENCLOSURE PLANS
KSEB-S-362.00	EYE WASH ENCLOSURE ELEVATIONS
KSEB-S-401.00	TYPICAL STAIR DETAILS 1
KSEB-S-402.00	TYPICAL STAIR DETAILS 2
KSEB-S-403.00	TYPICAL STAIR DETAILS 3
KSEB-S-405.00 KSEB-S-410.00	TYPICAL GRATING AND MISCELLANEOUS DETAILS SPIRAL STAIR DETAILS 1
KSEB-S-410.00	SPIRAL STAIR DETAILS 1
KSEB-S-411.00	SPIRAL STAIR DETAILS 2
KSEB-S-412.00	SPIRAL STAIR DETAILS S
KSEB-S-413.00	SPIRAL STAIR DETAILS 4
KSEB-S-414.00	SPIRAL STAIR DETAILS 5
KSEB-S-415.00	SPIRAL STAIR DETAILS 0
KSEB-S-417.00	SPIRAL STAIR DETAILS 8
KSEB-S-417.00	SPIRAL STAIR DETAILS 9
KSEB-S-419.00	SPIRAL STAIR DETAILS 10
KSEB-S-450.00	STEEL BEAM SHEAR CONNECTION TABLE NOTES
KSEB-S-450.00	STEEL BEAM SHEAR CONNECTION TABLE NOTES
KSEB-S-452.00	STEEL BEAM SHEAR CONNECTION DETAILS 1
KSEB-S-453.00	STEEL BEAM SHEAR CONNECTION DETAILS 2
KSEB-S-454.00	STEEL BEAM SHEAR CONNECTION DETAILS 5
KSEB-S-455.00	STEEL BEAM SHEAR CONNECTION DETAILS 5 OF 5
KSEB-S-501.00	TYP. NON-LOAD BEARING MASONRY DETAILS 1
KSEB-S-502.00	TYP. NON-LOAD BEARING MASONRY DETAILS 2
KSEB-S-503.00	TYP. NON-LOAD BEARING MASONRY DETAILS 3
KSEB-S-504.00	TYP. NON-LOAD BEARING MASONRY DETAILS 4
KSEB-S-505.00	TYP. NON-LOAD BEARING MASONRY DETAILS 5
KSEB-S-510.00	TYPICAL FACADE SUPPORT DETAILS 1
KSEB-S-511.00	TYPICAL FACADE SUPPORT DETAILS 2
KSEB-S-512.00	TYPICAL FACADE SUPPORT DETAILS 3
KSEB-S-513.00	TYPICAL FACADE SUPPORT DETAILS 4
KSEB-S-514.00	TYPICAL FACADE SUPPORT DETAILS 5
KSEB-S-515.00	TYPICAL FACADE SUPPORT DETAILS 6
	EYE WASH ENCLOSURE DETAILS 1 OF 5
KSEB-S-516.00	
KSEB-S-516.00 KSEB-S-517.00	EYE WASH ENCLOSURE DETAILS 2 OF 5
	EYE WASH ENCLOSURE DETAILS 2 OF 5 EYE WASH ENCLOSURE DETAILS 3 OF 5
KSEB-S-517.00	
KSEB-S-517.00 KSEB-S-518.00	EYE WASH ENCLOSURE DETAILS 3 OF 5
KSEB-S-517.00 KSEB-S-518.00 KSEB-S-519.00	EYE WASH ENCLOSURE DETAILS 3 OF 5 EYE WASH ENCLOSURE DETAILS 4 OF 5
KSEB-S-517.00 KSEB-S-518.00 KSEB-S-519.00 KSEB-S-520.00	EYE WASH ENCLOSURE DETAILS 3 OF 5 EYE WASH ENCLOSURE DETAILS 4 OF 5 EYE WASH ENCLOSURE DETAILS 5 OF 5



ACCOUNTABLE MANAGER"WARN
NEW Y
SECTIOJUSTIN RIVELLINOSECTIO
UNLESPORTFOLIO MANAGERUNLES
DIRECLAUREN D'ATTILE, PEPROFE
THIS D
ALTERDEPUTY DIRECTOR, IN HOUSE DESIGNCOMPL
NEW Y
NEW YMICHAEL LOEHR, PE7209 2

"WARNING-IT IS A VIOLATION, OF THE NEW YORK STATE EDUCATION LAW, SECTION, 7209.2, FOR ANY PERSON, UNLESS (S)HE IS ACTING UNDER THE DIRECTION OF A LICENSED PROFESSIONAL ENGINEER, TO ALTER THIS DOCUMENT IN ANY WAY. IF ALTERED, THE ALTERING PERSON SHALL COMPLY WITH THE REQUIREMENTS OF NEW YORK EDUCATION, LAW, SECTION, 7209.2."

NEW YORK CITY ENVIRONMENTAL PROTECTION BUREAU OF ENGINEERING DESIGN & CONSTRUCTION 96-05 HORACE HARDING EXPRESSWAY 5th FLOOR CORONA, NEW YORK 11368 www.nyc.gov/dep

8

DRAWING No.	SHEET TITLE				
KSEB-S-902.00	NORTH WALL 3D VIEW				
KSEB-S-903.00	S-903.00 SLAB 3D VIEW				
KSEB-S-904.00	NON-LOAD BEARING CMU WALL CONNECTION				
KSEB-S-905.00	ROOF STEEL DUNNAGE 3D VIEW				
KSEB-S-906.00	SPIRAL STAIR 3D VIEW				
KSEB-S-907.00	SPIRAL STAIR PLATFORM 3D VIEW (WEST SIDE)				
KSEB-S-908.00	SPIRAL STAIR PLATFORM 3D VIEW (EAST SIDE)				
KSEB-S-909.00	STAIR INNER PLATFORM SUPPORT 3D VIEW				
	HVAC				
KSEB-H-001.00	SYMBOLS AND ABBREVIATIONS				
KSEB-H-002.00	GENERAL NOTES				
KSEB-H-003.00	EQUIPMENT SCHEDULES 1				
KSEB-H-004.00	EQUIPMENT SCHEDULES 2				
KSEB-H-301.00	SINGLE LINE DIAGRAMS				
KSEB-H-401.00	FLOOR PLAN				
KSEB-H-402.00	ROOF PLAN				
KSEB-H-701.00	SECTIONS 1				
KSEB-H-702.00	SECTIONS 2				
KSEB-H-703.00	SECTIONS 3				
KSEB-H-801.00	HVAC DETAILS 1				
KSEB-H-802.00	HVAC DETAILS 2				
KSEB-H-901.00	CONTROLS SYMBOLS AND ABBREVIATIONS				
KSEB-H-902.00	CONTROLS DIAGRAMS 1				
KSEB-H-903.00	CONTROLS DIAGRAMS 2				
KSEB-H-904.00	CONTROLS DIAGRAMS 3				
KSEB-H-905.00	CONTROLS DETAILS 1				
KSEB-H-906.00	CONTROLS DETAILS 2				
KSEB-H-907.00	CONTROLS DETAILS 3				

KSEB-H-908.00 CONTROLS DETAILS 4

GRAPHIC SCALES CHECK BEFORE USE VERTICAL DATUM CONVERSION (ft) Environmental Protection BEDC/IHD +1.28 _CBWS ADDENDUM NO. 2 IF SHEET IS LESS THAN 22" X 34" IT IS A REDUCED PRINT. SCALE ACCORDINGLY DATE ISSUED: 07/2023 0 ^L NAVD88 DATE: JULY 2023 **CONTRACT KENS-EAST-2** SCALE: AS NOTED **KENSICO SITE PREPARATION** SHEET NO: DRAWING NO. DRAWING INDEX KEC2-G-003.01

D

F

	SHEET TITLE
_	PLUMBING
	SYMBOL LIST, NOTES, LEGENDS & SCHEDULES
	FLOOR PLAN
	ENLARGED PLANS & RISERS
_	DETAILS
	FIRE PROTECTION
	SYMBOL LIST, NOTES, LEGENDS & SCHEDULES
	FLOOR PLAN OPERATING FLOOR
	TYPICAL DETAILS 1
	TYPICAL DETAILS 2
	ELECTRICAL
	GENERAL NOTES, LEGENDS & ABBREVIATIONS 1
	GENERAL NOTES, LEGENDS & ABBREVIATIONS 2
	OVERALL SITE PLAN
	SITE PLAN 1
	SITE PLAN 2
	SITE PLAN 3
	SITE PLAN 4
	SITE PLAN 5
	SITE PLAN 6

DRAWING No.

KSEB-P-001.01 KSEB-P-401.01

KSEB-P-501.01

KSEB-P-801.01 \sim

KSEB-FP-001.00

KSEB-FP-401.00

KSEB-FP-801.00

KSEB-FP-802.00

KSEB-E-001.00

KSEB-E-002.00 KSEB-E-100.00

KSEB-E-101.01

KSEB-E-102.00 KSEB-E-103.01

KSEB-E-104.00

KSEB-E-105.00 KSEB-E-106.00

KSEB-E-107.00

KSEB-E-120.00

KSEB-E-300.00

KSEB-E-301.00

KSEB-E-302.00

KSEB-E-303.00

KSEB-E-304.00 KSEB-E-305.00

KSEB-E-306.00

KSEB-E-310.00

KSEB-E-311.00

KSEB-E-320.00 KSEB-E-321.00

KSEB-E-322.00

KSEB-E-323.00 KSEB-E-324.00

KSEB-E-325.00

KSEB-E-326.00

KSEB-E-327.00

KSEB-E-328.00

SITE PLAN 7

GROUNDING SITE PLAN

ONE LINE DIAGRAM 2

ONE LINE DIAGRAM 3 ONE LINE DIAGRAM 4

ONE LINE DIAGRAM 5

ONE LINE DIAGRAM 6

EQUIPMENT ELEVATION 1

EQUIPMENT ELEVATION 2

BREAKER CONTROL SCHEMATIC 1

BREAKER CONTROL SCHEMATIC 2

BREAKER CONTROL SCHEMATIC 3

BREAKER CONTROL SCHEMATIC 4

BREAKER CONTROL SCHEMATIC 5

BREAKER CONTROL SCHEMATIC 6

BREAKER CONTROL SCHEMATIC 7

BREAKER CONTROL SCHEMATIC 8

BREAKER CONTROL SCHEMATIC 9

OVERALL ONE LINE DIAGRAM

ONE LINE DIAGRAM 1 ONE LINE DIAGRAM 1

2

DRAWING No.	SHEET TITLE
KSEB-E-910.00	CABLE AND CONDUIT SCHEDULE 1
KSEB-E-911.00	CABLE AND CONDUIT SCHEDULE 2
KSEB-E-912.00	CABLE AND CONDUIT SCHEDULE 3
KSEB-E-913.00	CABLE AND CONDUIT SCHEDULE 3
	FIRE ALARM
KSEB-FA-001.00	SYMBOLS, ABBREVIATIONS & GENERAL NOTES
KSEB-FA-002.00	GENERAL NOTES
KSEB-FA-301.00	RISER DIAGRAM & MATRIX
KSEB-FA-601.00	GROUND FLOOR PLAN
	SECURITY
KSPP-SE-001.00	GENERAL NOTES, SYMBOLS AND ABBREVIATIONS
KSPP-SE-138.00	TEMP SHAFT 18 ENTRANCE SITE PLAN
KSPP-SE-300.00	SYSTEM ARCHITECTURE DIAGRAM
KSPP-SE-700.00	SCHEDULES SHEET 1
KSPP-SE-801.00	DETAILS SHEET 1
KSPP-SE-802.00	DETAILS SHEET 2
KSPP-SE-803.00	DETAILS SHEET 3
KSEB-SE-401.00	GROUND FLOOR PLAN
KSEB-SE-402.00	RACK ELEVATIONS
	LANDSCAPING
KSEB-L-001.00	LANDSCAPE NOTES
KSEB-L-002.00	LANDSCAPE ABBREVIATIONS
KSEB-L-100.00	LANDSCARE OVERALL SITE PLAN
KSEB-L-101.01	LANDSCAPE PLAN - SHEET 1
KSEB-L-102.00	LANDSCAPE PLAN - SHEET 2
KSEB-L-103.00	LANDSCAPE PLAN - SHEET 3
KSEB-1-104.00	TANDSCAPE PLAN-SHEET 4
KSEB-L-105.01	LANDSCAPE PLAN - SHEET 5
KSEB-L-500.00	LANDSCAPE PLANTING DETAILS

	KSEE	B-E-507.00	PV PANEL LAYOUT & BLOCK						
	KSEE	B-E-510.00	POWER PLAN - EOH HEADQ	UARTERS					
	KSEE	B-E-520.00	POWER PLAN - LEC	EC					
		B-E-530.00	POWER PLAN - WATERFOW						
		B-E-600.00	NETWORK BLOCK DIAGRAM	1		———————————————————————————————————————			
		KSEB-E-615.00 BLOCK DIAGRAM KSEB-E-700.00 ELECTRICAL DUCTBANK DETAILS 1				———————————————————————————————————————			
		B-E-700.00 B-E-701.00	ELECTRICAL DUCTBANK DET			———————————————————————————————————————			
		B-E-800.00	ELECTRICAL DOCTBANK DET						
	KSEB-E-801.00		ELECTRICAL DETAILS 2						
		B-E-802.00	ELECTRICAL DETAILS 3						
	KSEE	B-E-810.00	ELECTRICAL DETAILS						
	KSEE	B-E-900.00	LIGHT FIXTURE SCHEDULE						
	KSEE	B-E-901.00	PANEL SCHEDULE -1						
		B-E-902.00	PANEL SCHEDULE -2						
	KSEE	B-E-902.00	PANEL SCHEDULE -3						
					DESIGNED BY: ABA	DRAWN BY: EF	TE OF NEW LOA		
					CHECKED BY:		ST JUNCENT (FR)		
					AD				
1	07/2023	ADDENDUM 2		VL	DESIGN LEAD: VINCENT LEE, PE				
1	05/2023	ADDENDUM 1		VL	SECTION MANAGER:		0 087876-1 L		
NO.	DATE		REVISIONS/DESCRIPTION	APPR'D.			POFESSIONALE		

4	I	5



ACCOUNTABLE MANAGER JUSTIN RIVELLINO PORTFOLIO MANAGER LAUREN D'ATTILE, PE DEPUTY DIRECTOR, IN HOUSE DESIGN MICHAEL LOEHR, PE

"WARNING-IT IS A VIOLATION, OF THE NEW YORK STATE EDUCATION LAW, SECTION, 7209.2, FOR ANY PERSON, UNLESS (S)HE IS ACTING UNDER THE DIRECTION OF A LICENSED PROFESSIONAL ENGINEER, TO ALTER THIS DOCUMENT IN ANY WAY. IF ALTERED, THE ALTERING PERSON SHALL COMPLY WITH THE REQUIREMENTS OF NEW YORK EDUCATION, LAW, SECTION, 7209.2."

NEW YORK CITY ENVIRONMENTAL PROTEC BUREAU OF ENGINEERING DESIGN & CONSTR 96-05 HORACE HARDING EXPRESSWAY 5th FI CORONA, NEW YORK 11368 www.nyc.gov/dep

on.

	Environmental Protection BEDC/IHD	GRAPHIC SCALES CHECK BEFORE USE		VERTICAL DATUM CONVERSION (ft)
	ADDENDUM NO. 2 DATE ISSUED: 07/2023		USE CONVERSION (f +1.28 BWS PRINT. BWS	
	CONTRACT KENS-EAST-2 KENSICO SITE PREPARATION			CALE: AS NOTED
TION				
RUCTION LOOR	DRAWING IND	CHECK BEFORE USECON2 23IF SHEET IS LESS THAN 22" X 34" IT IS A REDUCED PRINT. SCALE ACCORDINGLY+1.28KENS-EAST-2 PREPARATIONDATE: SCALE:JULY SCALE:AG INDEXDRAWING		

10

А

С

D

Е

F

	1		2		3
CC	DES AND STA	NDARDS SUM	MARY.		
<u>00</u> 1.	2020 BUILDING CODE EDITION OF THE INT CONTRACT DOCUME	OF NEW YORK STA	ATE (NYSBC), WHIC NG CODE (IBC), EX		
2.	MINIMUM DESIGN LC MODIFIED BY THE 20				-16, AS
3.	BUILDING CODE REC AMERICAN CONCRE			RETE AND COMME	NTARY,
4.	SPECIFICATIONS FO ACI SPEC-301-16.	R STRUCTURAL CON	NCRETE, AMERICAN	N CONCRETE INST	ITUTE,
5.	GUIDE TO PRESENT		TEEL DESIGN DETA	AILS, AMERICAN	
6.	ACI DETAILING MANU	JAL, AMERICAN CON	ICRETE INSTITUTE,	, ACI, MNL-66, 2020).
7.	SPECIFICATION FOR STEEL CONSTRUCTI METHOD, U.O.N.				
8.	MANUAL OF STEEL C CONSTRUCTION, AIS U.O.N.				
9.	SPECIFICATION FOR			DINGS, AMERICAN	2
10.	SPECIFICATION FOR RESEARCH COUNCIL				4
11.	AMERICAN WELDING A. D1.1 STEEL (201 B. D1.3 SHEET STE C. D1.4 REINFORCI D. D1.6 STAINLESS	5) EL (2018) NG STEEL (2018)	JRAL WELDING CO	DE (AWS):	
12.	AMERICAN INSTITUT STRUCTURAL STAIN			SIGN GUIDE SERIE	S NO. 27:
13.	OCCUPATIONAL SAF	ETY AND HEALTH A	CT, OSHA (STANDA	RDS-29CFR).	,
14.	DEP, BUREAU OF EN HEALTH AND SAFET				ITAL
_					
					ł

- ENGINEER.
- CITY.
- DOCUMENTS.

- STRUCTURAL DRAWINGS SHALL BE USED IN COORDINATION WITH DRAWINGS OF ALL OTHER DISCIPLINES AND SHOP DRAWINGS. PRIOR TO CONSTRUCTION, THE CONTRACTOR SHALL EXAMINE SAID DRAWINGS FOR VERIFICATION OF LOCATIONS AND DIMENSIONS OF ANY WORK REQUIREMENTS NOT SHOWN ON THE STRUCTURAL DRAWINGS. ANY CONFLICTS BETWEEN THESE WORK REQUIREMENTS AND THE STRUCTURAL WORK SHALL BE BROUGHT TO THE ATTENTION OF THE ENGINEER FOR RESOLUTION. SAID WORK REQUIREMENTS SHALL THEN BE INCORPORATED INTO THE STRUCTURAL WORK. WORK REQUIREMENTS MAY INCLUDE BUT ARE NOT LIMITED TO EQUIPMENT, OPENINGS, SLEEVES, ANCHOR RODS, INSERTS, AND OTHER EMBEDDED ITEMS AND UNDERGROUND INSTALLATIONS. ALL ANCHOR PATTERNS SHALL BE TEMPLATED TO ENSURE ACCURACY OF PLACEMENT.
- CONTRACTOR SHALL
- a. PROVIDE A MINIMUM OF 2" CLEAR BETWEEN CONDUITS PROVIDE A MINIMUM OF 1" CLEAR BETWEEN CONDUITS AND REINFORCEMENT BARS
- c. LOCATE ALL EXISTING REINFORCEMENT BARS BY USE OF GROUND PENETRATING RADAR (GPR) OR OTHER SUITABLE MEANS PRIOR TO CORE DRILLING ANY EXISTING STRUCTURAL WORKS FOR INSTALLATION OF CONDUITS, SLEEVES, AND ETC
- THE CONTRACTOR SHALL DESIGN, AND SUBMIT TO THE ENGINEER FOR REVIEW I INFORMATION ONLY, A METHOD FOR SUPPORTING THE EXCAVATION. THE DESIG PROVIDE WATERTIGHT AND FIRE RATED SEALS AS REQUIRED AT ALL CONDUIT OF THE EXCAVATION SUPPORT SHALL ACCOMMODATE UNDERGROUND UTILITY PENETRATIONS AS SHOWN ON THE ELECTRICAL DRAWINGS. SERVICES, BOTH CITY AND PRIVATELY OWNED, MANAGEMENT OF GROUNDWATE ALUMINUM CONDUITS ARE NOT ALLOWED TO BE EMBEDDED IN CONCRETE AS AND PROTECTION OF EXISTING STRUCTURES. THE DESIGN OF THE EXCAVATION PER PROVISIONS IN ACI 318 CODE. SUPPORT SYSTEM SHALL BE SIGNED AND SEALED BY A PROFESSIONAL ENGINEE PROVIDE EMBEDMENTS THAT FOLLOW ALL APPLICABLE PROVISIONS AS REGISTERED IN THE STATE OF NEW YORK. WORK SHALL NOT COMMENCE WITHO DETAILED IN CHAPTER 20 AND CHAPTER 26 OF STATED ACI 318 CODE. APPROVAL OF THE EXCAVATION SUPPORT SYSTEM.
- d
- ELEMENT IS STRICTLY PROHIBITED.
- BY THE CONTRACTOR AND APPROVED BY THE ENGINEER.
- AGENCIES SHALL GOVERN.
- DEMOLITION.

				DESIGNED BY: CC, AM	DRAWN BY: CC, AM, XX	OF NEW YORK
				CHECKED BY: CC, PMB		15 3 - 07 20
				DESIGN LEAD: CLEMENT CHAN, PE		*
1	07/2023	ADDENDUM NO. 2	CC		-	a lentos
NO.	DATE	REVISIONS/DESCRIPTION	APPR'D.	SECTION MANAGER: ALEXANDER LOPEZ, PE		OFO PROFESSION

4	5	5

THESE NOTES ARE GENERAL AND SUPPLEMENTAL TO THE SPECIFICATIONS. IN CASE OF CONFLICT BETWEEN THESE NOTES, DRAWINGS, OR SPECIFICATIONS, THE CONTRACTOR SHALL IMMEDIATELY NOTIFY THE ENGINEER OF THIS CONFLICT AND CONTINUE WITH THE WORK AFTER THE CONFLICT IS RESOLVED BY THE

2. ALL EXISTING CONDITIONS (I.E. UNDERGROUND UTILITY PIPES, EXISTING STRUCTURES, CONDUITS, ETC.) SHOWN ON THE DRAWINGS ARE FROM KNOWN AVAILABLE RECORDS AND THEIR ACCURACY IS NOT GUARANTEED. THE CONTRACTOR IS RESPONSIBLE FOR VERIFYING ALL EXISTING CONDITIONS IN THE FIELD BEFORE PROCEEDING WITH THE WORK. IT SHALL BE THE CONTRACTOR'S **RESPONSIBILITY TO NOTIFY THE OWNERS OF UTILITIES OR EXISTING STRUCTURES** CONCERNED BEFORE STARTING WORK. THE CONTRACTOR FURTHER ASSUMES ALL LIABILITY AND RESPONSIBILITY FOR THE UNDERGROUND UTILITY PIPES. CONDUITS, OR STRUCTURES SHOWN OR NOT SHOWN ON THESE DRAWINGS. THE ENGINEER SHALL BE ALERTED IF ANY KNOWN OR UNKNOWN UTILITY IS EXPOSED AND REQUIRES SUPPORT BEFORE PROCEEDING WITH THE WORK. ANY AND ALL RE-ROUTING OF ANY EXISTING UTILITY PIPING, CONDUITS, ETC. KNOWN OR UNKNOWN THAT NEED TO OCCUR SHALL BE COORDINATED AT NO COST TO THE

THE CONTRACTOR SHALL IMMEDIATELY NOTIFY THE ENGINEER IF EXISTING CONDITIONS VARY SIGNIFICANTLY FROM THAT SHOWN ON THE CONTRACT

FOR DETAILED SCOPE OF WORK AND GENERAL CONDITIONS, REFER TO THE CONTRACT SPECIFICATIONS. THE CONTRACTOR SHALL PERFORM ALL INCIDENTAL WORK REQUIRED, AS INTENDED AND DIRECTED BY THE ENGINEER FOR THE COMPLETION OF THE CONTRACT WITHOUT ADDITIONAL COST TO THE CITY.

THE CONTRACTOR IS ALERTED TO THE POSSIBLE PRESENCE OF EXISTING UNDERGROUND STRUCTURES, UTILITIES, AND/OR EARTH RETAINING SYSTEMS THAT HAVE BEEN ABANDONED IN THE VICINITY OF THE WORK AREA. ANY ADDITIONAL WORK THAT MAY BE REQUIRED BY THE CONTRACTOR TO PERFORM CONTRACT WORK DUE TO THE PRESENCE OF SAID STRUCTURES SHALL BE AT THE CONTRACTOR'S EXPENSE WITH NO ADDITIONAL COST TO THE CITY.

THE CONTRACTOR IS RESPONSIBLE FOR VERIFYING ALL EXISTING STRUCTURE DIMENSIONS AND INFORMATION AS REQUIRED FOR NEW WORK.

8. FOR ELECTRICAL CONDUIT PENETRATIONS, EMBEDMENT, AND CLEARANCES THE

9. STRUCTURES HAVE BEEN DESIGNED FOR OPERATIONAL LOADS OF THE COMPLETED STRUCTURE. DURING CONSTRUCTION, THE STRUCTURES SHALL BE PROTECTED BY BRACING, SHORING AND TEMPORARY SUPPORTS TO RESIST ANY APPLIED LOADING THAT MAY OCCUR. OVERSTRESSING OF ANY STRUCTURAL

10. TEMPORARY BRACING, SHEETING AND SHORING REQUIRED TO ENSURE THE STRUCTURAL INTEGRITY AND STABILITY OF NEARBY EXISTING STRUCTURES SIDEWALKS, UTILITIES, AND ETC. DURING CONSTRUCTION SHALL BE PROVIDED BY THE CONTRACTOR. UNLESS DETAILED ON THE CONTRACT DOCUMENTS, IT IS THE RESPONSIBILITY OF THE CONTRACTOR TO PROVIDE DETAILS OF SUCH TEMPORARY WORK WHICH SHALL BE DESIGNED BY A LICENSED PROFESSIONAL ENGINEER REGISTERED IN THE STATE OF NEW YORK, EMPLOYED AND PAID FOR

11. THE CONTRACTOR SHALL FULLY ADHERE TO THE REQUIREMENTS OF THE DEP ENVIRONMENTAL HEALTH AND SAFETY POLICIES AND PROCEDURES. IN INSTANCES WHERE RELATED GOVERNING REGULATORY AGENCIES SUCH AS OSHA, EPA, AND NYSDEC ARE MORE STRINGENT, THE REGULATIONS OF SAID

12. THE CONTRACTOR SHALL COMPLY WITH THE PROVISIONS OF THE NEW YORK STATE BUILDING CODE REGARDING SAFEGUARDS DURING CONSTRUCTION OR

GENERAL NOTES (CONTINUED)

- 13. IF A CONFLICT IS FOUND BETWEEN DIFFERENT PORTIONS OF THE CONTRACT DOCUMENTS, THE CONTRACTOR SHALL NOTIFY THE ENGINEER IMMEDIATELY. CONTINUED CONSTRUCTION OF THE AREA IN CONFLICT SHALL BE AT THE CONTRACTOR'S OWN RISK UNTIL THE CONFLICT IS RESOLVED BY THE ENGINEER
- 14. ALL AREAS, STRUCTURES AND EQUIPMENT DISTURBED AND/OR DAMAGED BY TH CONTRACTOR WITHOUT THE AUTHORIZATION OF THE ENGINEER SHALL BE RESTORED BY THE CONTRACTOR TO ORIGINAL CONDITION AT NO EXPENSE TO T CITY.
- 15. THE CONTRACTOR SHALL PROVIDE FOR THE MAINTENANCE AND PROTECTION OF TRAFFIC DURING THE PERFORMANCE OF THE CONTRACT WORK. ALL SUCH WOR SHALL CONFORM TO THE MOST CURRENT NEW YORK STATE MANUAL OF UNIFOR TRAFFIC CONTROL DEVICES (MUTCD) UNLESS OTHERWISE MODIFIED BY THE CONTRACT DOCUMENTS OR, IN THE COURSE OF THE WORK, MODIFIED PER ENGINEER'S DIRECTION.
- 16. THE CONTRACTOR SHALL EMPLOY THE SERVICES OF A NEW YORK STATE LICENS LAND SURVEYOR FO, PERFORM A TOPOGRAPHIC SURVEY AT THE WORK AREA. IN ADDITION, SURVEYS SHOWING THE LOCATION OF ALL NEW STRUCTURES PRIOR BACKFILL, AND COMPLETION OF SAID STRUCTURES SHALL BE INCLUDED IN THE CONTRACT. ALL SURVEY GRADES AND ELEVATIONS SHALL BE REFERRED TO TH SEPTY DATUM AS SHOWN IN THE CIVIL DRAWINGS. IN SUMMARY, SURVEYOR WOR SHALL INCLUDE:
 - a. ELEVATION PROGRESS INSPECTION SURVEY
 - b. FINAL SURVEY c. AN ELEVATION CERTIFICATE
- 17. ALL ELEVATIONS REFER TO THE NORTH AMERICAN VERTICAL DATUM 1988 (NAVD U.O.N.
- 18. DO NOT SCALE DRAWINGS TO OBTAIN DIMENSIONAL INFORMATION. LOCATIONS. SIZES OF ANY ELEMENT
- 19. AT ALL TIMES DURING CONSTRUCTION, THE CONTRACTOR SHALL BE SOLELY RESPONSIBLE FOR THE CONDITIONS OF THE JOBSITE, SEE SPECIFICATIONS FOR ADDITIONAL INFORMATION.
- 20. DETAILS AND SECTIONS LABELED WITH "TYPICAL" IN THEIR TITLES SHALL APPLY ALL SITUATIONS OCCURRING ON THE PROJECT THAT ARE THE SAME OR SIMILAR THOSE SPECIFICALLY SHOWN. THE APPLICABILITY OF THE CONTENT OF THESE VIEWS TO LOCATIONS ON THE PLAN CAN BE DETERMINED FROM THE TITLE OF TH VIEWS. SUCH VIEWS SHALL APPLY WHETHER OR NOT THEY ARE CALLED OUT AT EACH LOCATION.
- 21. TYPICAL DETAILS ARE GENERALLY NOT INDICATED ON THE PLANS. THE CONTRACTOR IS RESPONSIBLE FOR COORDINATING ALL TYPICAL DETAIL APPLICATIONS.

STRUCTURAL NOTES

IN ADDITION TO GENERAL NOTES, THE FOLLOWING NOTES SHALL APPLY TO ALL STRUCTURAL WORKS:

- THE CONTRACTOR SHALL PROTECT EXCAVATION FROM FLOODING UNTIL ALL WA AND ROOF FRAMING ARE IN PLACE AND BACKFILLING HAS BEGUN. THE GROUNDWATER LEVEL SHALL BE MAINTAINED BELOW EXCAVATION AT ALL TIMES UNTIL STRUCTURE IS IN PLACE
- NON-STRUCTURAL ITEMS MAY BE SHOWN ON THE STRUCTURAL DRAWINGS FOR PURPOSE OF CLARITY IN THE INTERFACE WITH STRUCTURAL WORK. NON-STRUCTURAL ITEMS MAY NOT BE FULLY DEFINED ON THE STRUCTURAL DRAWING REFER TO ARCHITECTURAL, MEP. CIVIL DRAWINGS & SPECIFICATIONS FOR NON-STRUCTURAL WORK.



ACCOUNTABLE MANAGER JUSTIN RIVELLINO ORTFOLIO MANAGER LAUREN D'ATTILE, PE DEPUTY DIRECTOR, IN HOUSE DESIGN MICHAEL LOEHR, PE

"WARNING-IT IS A VIOLATION. OF THE NEW YORK STATE EDUCATION LAW, SECTION, 7209.2, FOR ANY PERSON, UNLESS (S)HE IS ACTING UNDER THE DIRECTION OF A LICENSED PROFESSIONAL ENGINEER, TO ALTER THIS DOCUMENT IN ANY WAY. IF ALTERED, THE ALTERING PERSON SHALI COMPLY WITH THE REQUIREMENTS OF NEW YORK EDUCATION, LAW, SECTION, 7209.2."

NEW YORK CITY ENVIRONMENTAL PROTEC BUREAU OF ENGINEERING DESIGN & CONST 96-05 HORACE HARDING EXPRESSWAY 5th CORONA, NEW YORK 11368 www.nyc.gov/dep


8		9		10	
	CC	NTRACTOR'S SHOP DRAWI	NGS		
ج.		SHOP DRAWINGS SHALL BE SUBMITTED THE START OF FABRICATION OR COMME REGARDING SHOP DRAWING FORMAT, A AND ETC.	NCEMENT OF WORK. SE	E SPECIFICATIONS	
HE ź		REPRODUCTION OF ANY PORTION OF CO SHOP DRAWINGS IS PROHIBITED.	ONTRACT DRAWINGS FOR	R SUBMITTAL AS	A
		CHANGES TO SHOP DRAWINGS THAT AR SOMEHOW INDICATED THAT A CHANGE I REVIEWED DRAWINGS.			
ISED N TO IE RK					В
D 88),					
, OR R					
Ύ ΤΟ R TO ΉΕ T					С
ALLS S,					D
FOR GN ER, N ER OUT					
R THE IGS, -					E
					F
		ADDENDUM NO. 2 DATE ISSUED: 07/2023	GRAPHIC SCALES CHECK BEFORE USE IF SHEET IS LESS THAN 22" 2 IT IS A REDUCED PRINT SCALE ACCORDINGLY		
C TIO f ructi (1 FLOOR	ON	CONTRACT KENS-H KENSICO SITE PREPA STRUCTURAL	RATION	DATE: JULY 2023 SCALE: AS NOTED SHEET NO: DRAWING NO.	
		GENERAL STRUCTURAL NOTES, CODES,	AND STANDARDS	KEC2-GS-001.01	

AM able:


All inquiries regarding this drawing(s) or project should be made to NYC Environmental Protection, Bureau of Engineering Design and Construction.


4	5 6	7
UED	CIVIL GENERAL NOTES - CONTINUED	CIVIL GENERAL NOTES - CONTIN
	EROSION CONTROL:	DEMOLITION NOTES:
E STATE RIA FOR THE RY SEWERS.	 CHECK DAMS, CONSTRUCTION DITCHES, GRASSED WATERWAYS AND OTHER RUNOFF CONTROL PRACTICES SHALL BE IN PLACE PRIOR TO ROUGH GRADING. 	 ALL DEMOLITION WORK SHALL BE PERFOR ACCORDANCE WITH THE CONTRACT DRAV SPECIFICATIONS.
ES OF MINIMUM SHOWN OR ER MAINS SHALL	2. FIBER ROLLS AND OR HAY BALES SHALL BE PLACED ACROSS ALL DRAINAGE AREAS CREATED DURING GRADING TO SLOW RUN-OFF WATER AND MINIMIZE EROSION.	2. ITEMS IDENTIFIED "TO BE REMOVED" SHAL EXPENSE OF CONTRACTOR, AND SHALL BI
ETWEEN INVERT	3. ALL SLOPE PROTECTION SWALES TO BE CONSTRUCTED AT THE SAME TIME AS THE BANKS ARE GRADED.	ACCORDANCE WITH ALL FEDERAL, STATE REQUIREMENTS.
E BOXES, PULL UNLESS LES IN OPEN FIELDS PROXIMATE RIM	4. THE CONTRACTOR IS RESPONSIBLE FOR IMPLEMENTATION OF THE EROSION CONTROL MEASURES AS REQUIRED AND ALSO TO PROVIDE ANY ADDITIONAL CONTROL MEASURES (I.E. SANDBAGGING, DIVERSION DITCHES, RETENTION BASINS, ETC.) DICTATED BY FIELD CONDITIONS TO PREVENT EROSION AND/OR THE INTRODUCTION OF DIRT, MUD OR DEBRIS ONTO EXISTING PUBLIC STREETS, RECEIVING WATER BODIES, AND/OR ONTO ADJACENT PROPERTIES DURING ANY PHASE OF CONSTRUCTION	3. UNLESS OTHERWISE INDICATED SPECIFIC FACILITIES ARE TO BE PROTECTED IN PLA FEATURES THAT ARE DAMAGED DURING C BE REPAIRED OR REPLACED IN-KIND AT TH EXPENSE.
POINTS AND VERIFY D ACTUAL	 OPERATIONS. 5. CONTRACTOR IS RESPONSIBLE FOR EROSION, DUST AND TEMPORARY DRAINAGE CONTROL DURING GRADING AND CONSTRUCTION OPERATIONS. 	4. CONTRACTOR SHALL COORDINATE AND SE ENGINEER ALL DEMOLITION WORK TO BE I WORK SHALL BE PERFORMED WITHOUT PI ENGINEER. WORK SHALL BE DONE IN THE
CT SPECIFICATIONS, SDEC STANDARDS DIMENT CONTROL,	 CONTRACTOR SHALL PROVIDE SLOPE STABILIZATION IN ACCORDANCE WITH THE NYSDEC BLUE BOOK. CONTRACTOR SHALL PROVIDE LANDSCAPING IN ACCORDANCE WITH THE LANDSCAPING CONTRACT DRAWINGS. 	 ENGINEER. 5. THE CONTRACTOR SHALL COORDINATE W ON ALL UNIDENTIFIED UTILITIES NOT SHOW
EASANT. DUND UNTIL THE EBRIS AND OTHER A DEPTH OF	7. TEMPORARY ROADS AND STAGING AREAS SHALL BE STABILIZED IN ACCORDANCE WITH THE NYS BLUE BOOK STANDARD AND SPECIFICATIONS FOR CONSTRUCTION ROAD STABILIZATION.	THAT ARE IN CONFLICT WITH THE PROPOS IF RELOCATION OR REMOVAL OF THE UTIL THE CONTRACTOR SHALL CONTACT THE L BEFORE STARTING ANY WORK AND COOR
ED IN SECTION 31 23 XIMUM FILL SLOPES N THE DRAWINGS	 ALL WATERCOURSES SHALL BE PROTECTED FROM SITE SURFACE RUNOFF IN ACCORDANCE WITH CONTRACT SECTION 31 25 10 - DUST, SOIL, EROSION AND SEDIMENT CONTROL. EACH SITE HAS A STORMWATER POLLUTION PREVENTION PLAN (SWPPP) THAT THE CONTRACTOR MUST SIGN ON TO, FOLLOW, AND UPDATE AS REQUIRED BY SITE CONDITIONS. MORE INFORMATION ABOUT RECEIVING SURFACE WATERS AT THE 	RELOCATION OR REMOVAL OF THE EXISTI
Y DRAINAGE	EASTVIEW SITE CAN BE FOUND IN THE EASTVIEW SWPPP SECTION 3.1.5.	
TOR TO PREVENT	9. DUST SHALL BE CONTROLLED IN ACCORDANCE WITH CONTRACT SECTION 31 25 10 - DUST, SOIL EROSION AND SEDIMENT CONTROL. EACH SITE HAS A STORMWATER POLLUTION PREVENTION PLAN (SWPPP) THAT THE CONTRACTOR MUST SIGN	
INTAINING A G CONSTRUCTION. SSARY PERMIT(S)	ON TO, FOLLOW, AND UPDATE AS REQUIRED BY SITE CONDITIONS. MORE INFORMATION ABOUT DUST CONTROL AT THE EASTVIEW SITE CAN BE FOUND IN THE EASTVIEW SWPPP SECTION 3.4.2.	
PONSIBILITY TO STRUCTION OF THE AL DISPOSAL OF SECTION 31 23 19 -	10. THE LAYOUT OF CONTRACTOR FACILITIES AND WORK AREAS AT THE SITE ARE GENERAL SUGGESTIONS. ACTUAL LAYOUT SHALL BE DETERMINED BY THE CONTRACTOR, AND APPROVED BY THE ENGINEER.	
L BE STABILIZED E WITH THE NYSDEC	FENCING:	
VICES OF A NEW PERFORM A EA. A SURVEY CTURES, PIPES AND O BACKFILLING AND	 PERIMETER CONCRETE-MOUNTED CHAIN-LINK FENCE SHALL BE TEMPORARILY RELOCATED AS REQUIRED FOR FINAL SECURITY FENCE INSTALLATION. SECURE PERIMETER SHALL BE MAINTAINED AT ALL TIMES. CHAIN-LINK FENCE SHALL BE REMOVED AFTER FINAL SECURITY FENCE INSTALLATION. SEE SECTION 01 14 00 - WORK RESTRICTIONS. 	
\sum_{1}	2. CATSKILL AERATOR CONCRETE BARRIER AND LEC FENCE SHALL ONLY BE REMOVED AFTER SUBSTANTIAL COMPLETION OF POLICE BOOTH, DELAWARE AERATOR AND SCREEN CHAMBER AREA SITE WORK, AND FINAL PERIMETER FENCE INSTALLATION. REMOVAL SHALL BE COORDINATED WITH BWS OPERATIONS, BPS, OTHER KENS-EAST CONTRACTORS AND SHALL REQUIRE ENGINEER'S APPROVAL.	
Environment Protection	ACCOUNTABLE MANAGER JUSTIN RIVELLINO PORTFOLIO MANAGER LAUREN D'ATTILE, PE DEPUTY DIRECTOR, IN HOUSE DESIGN MICHAEL LOEHR, PE MARNING-IT IS A VIOLATION, OF THE NEW YORK STATE EDUCATION LAW, SECTION, 7209.2, FOR ANY PERSON, UNLESS (S)HE IS ACTING UNDER THE DIRECTION OF A LICENSED PROFESSIONAL ENGINEER, TO ALTER THIS DOCUMENT IN ANY WAY. IF ALTERED, THE ALTERING PERSON SHALL COMPLY WITH THE REQUIREMENTS OF NEW YORK EDUCATION, LAW, SECTION, 7209.2."	NEW YORK CITY ENVIRONMENTAL PROTECT BUREAU OF ENGINEERING DESIGN & CONSTRU 96-05 HORACE HARDING EXPRESSWAY 5th FLO CORONA, NEW YORK 11368 www.nyc.gov/dep
uction.		

8		9		10		
INUED						
ORMED IN AWINGS AN	1D					А
IALL BE DISF . BE DONE S FE AND LOC						
FICALLY, ALL LACE. ANY E CONSTRUE THE CONTE	EXISTING CTION SHALL					
SCHEDULE E PERFORM PRIOR NOT IE PRESENC	NED. NO TICE TO THE					В
	HE PLANS OVEMENTS. TERMINED, WNER					
STING UTILIT	ΓΥ.					С
						D
						E
						 F
	ADDEN DATE ISSUE	NDUM NO. 2	GRAPHIC SCAL CHECK BEFORE IF SHEET IS LESS THA IT IS A REDUCED SCALE ACCORDI	USE N 22" X 34" PRINT.	VERTICAL DATUM CONVERSION (ft) +1.28 BWS 0 NAVD88	
		CONTRACT KENS-E KENSICO SITE PREPA			APRIL 2023 AS NOTED	
TION RUCTION		CIVIL		SHEET N		
LOOR		GENERAL NOT	ES		ING NO. P-C-001.01	
						•

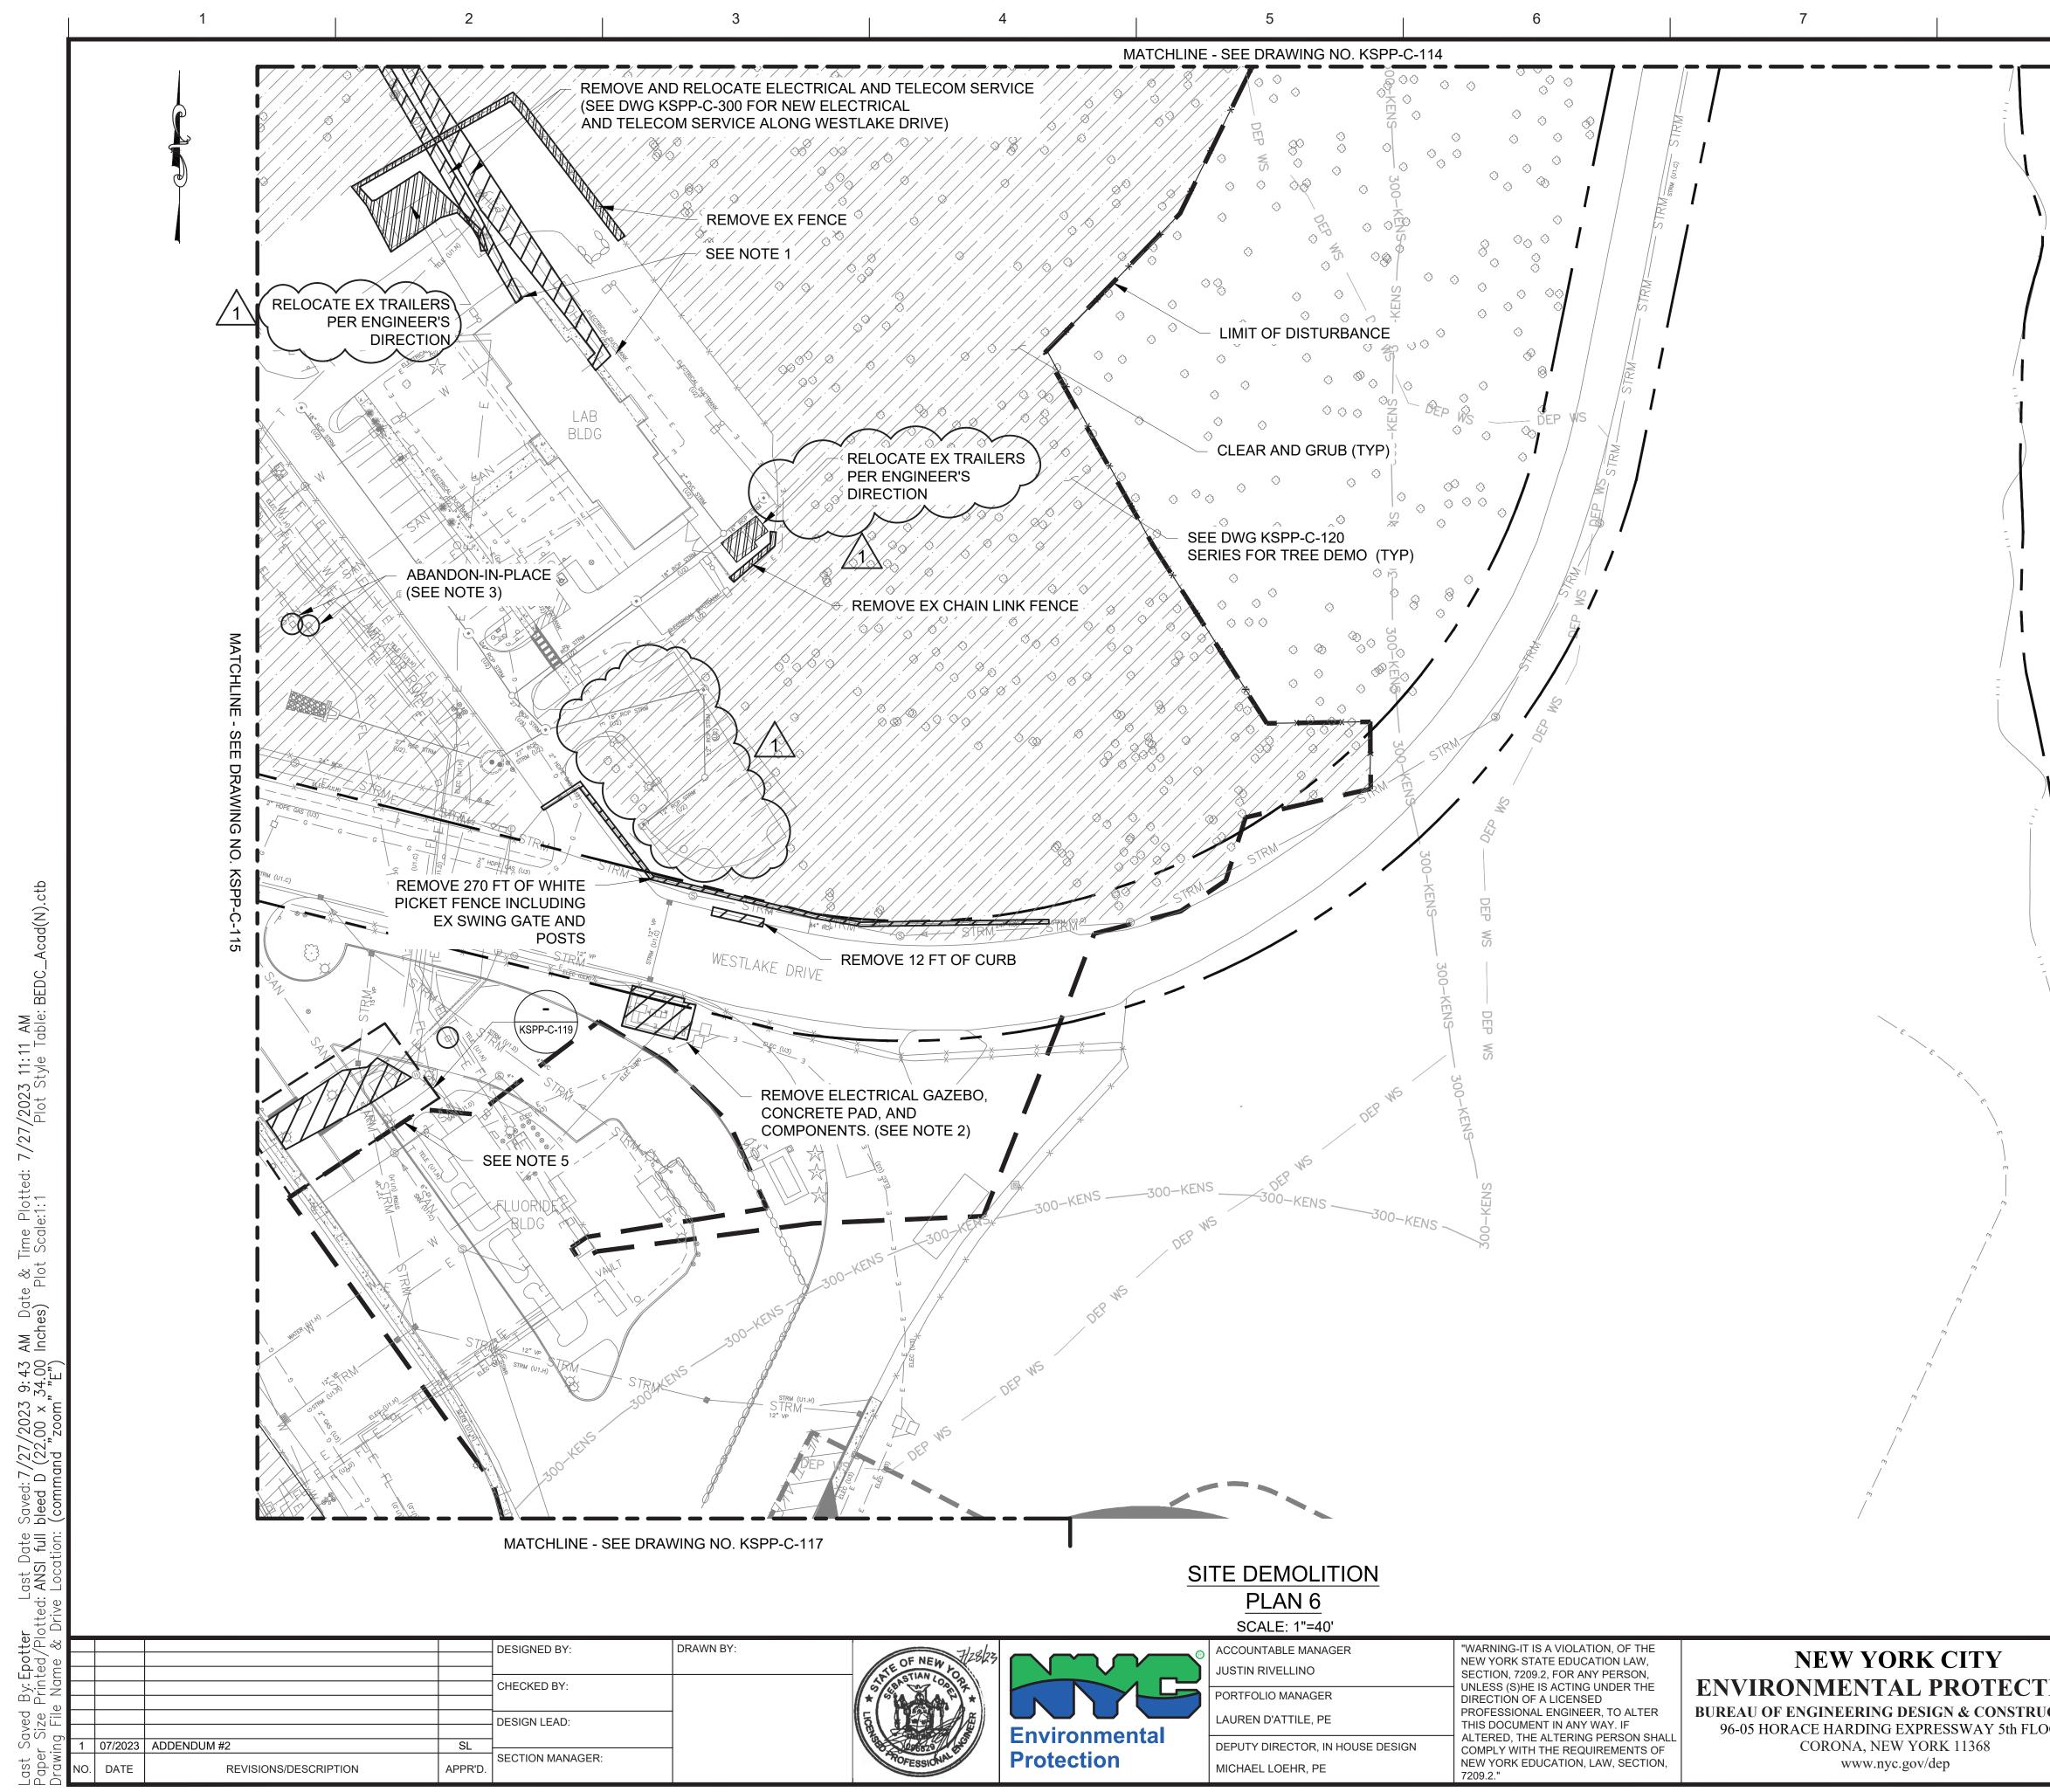

8			9			10	
		NOT	ES:				
		1. 2.	THE CONTRACTOR S POWER AND TELECO INSTALLATION OF N TELECOMMUNICATION BUILDING AS SHOW REMOVE EXISTING F A. THE EXISTING SHALL ONLY BE BUILDING ELECT INSTALLED, TES FLUORIDE BUILD INTERRUPTED.	OM DEMO EW ELECT ON SERVI N IN KSPP FLUORIDE FLUORIDE REMOVEI FRICAL SE TED, AND	LITION REQUIRE FRICAL POWER CE TO THE EOH P-C-300. BUILDING ELEC DE BUILDING ELEC DAFTER THE NE RVICE, AS PER BROUGHT INTC	ED FOR AND I-HEADQUARTERS CTRICAL SERVICE. ECTRICAL SERVIC EW FLUORIDE SEB-E-107, IS D SERVICE.	А
		3.	B. FLUORIDE BU BE COORDINATE C. CONTRACTOF APPURTENANCE ELECTRICAL EQ STRUCTURE. D. CONTRACTOF COVER IN AREA	ED WITH B R SHALL R ES INCLUE UIPMENT, R SHALL P OF REMO VITH SECT	WS. EMOVE AND DIS DING, BUT NOT E CONCRETE PAI ROVIDE TOPSO VED CONCRETE FION 32 90 00 - F	EXCLUSIVE, TO D. SHADE OIL AND GRASS E PAD IN PLANTING AND 32 S BE ABANDONED IN	в
		4. 5.	AND REMOVALS ALL EXISTING UTILIT CATCH BASINS NOT SHALL BE PROTECT ADJUSTED TO NEW EXISTING POLICE BO ONLY AFTER THE TE	SPECIFIC ED IN PLA GRADES OOTH ANE EMPORAR	CALLY NOTED FO CE. IF REQUIRE AS PER KSPP-C DBARRIERS WIL Y ENTRANCE IS	OR ABANDONMEN ED, RIMS SHALL BE -200 SERIES. L BE DEMOLISHEE PUT INTO SERVIC	E D
	KENSICO RESERVOIR		AND A NEW TT218 G			T OF THE EXISTING	с С
							D
							E
	\ 			1"=-	0 40	PLAN 0 80 FT.	F
	ADDE DATE ISSU	NDL	JM NO. 2 07/2023	CH IF SHEET IT IS	GRAPHIC SCALES IECK BEFORE USE IS LESS THAN 22" 2 A REDUCED PRINT ALE ACCORDINGLY	0 – NAVD8	(ft)
FION UCTION OOR			ONTRACT KENS-E SICO SITE PREPA		Ţ	DATE: SCALE: AS NOTED SHEET NO: DRAWING NO.	
						KSPP-C-116.0	<u>'</u>

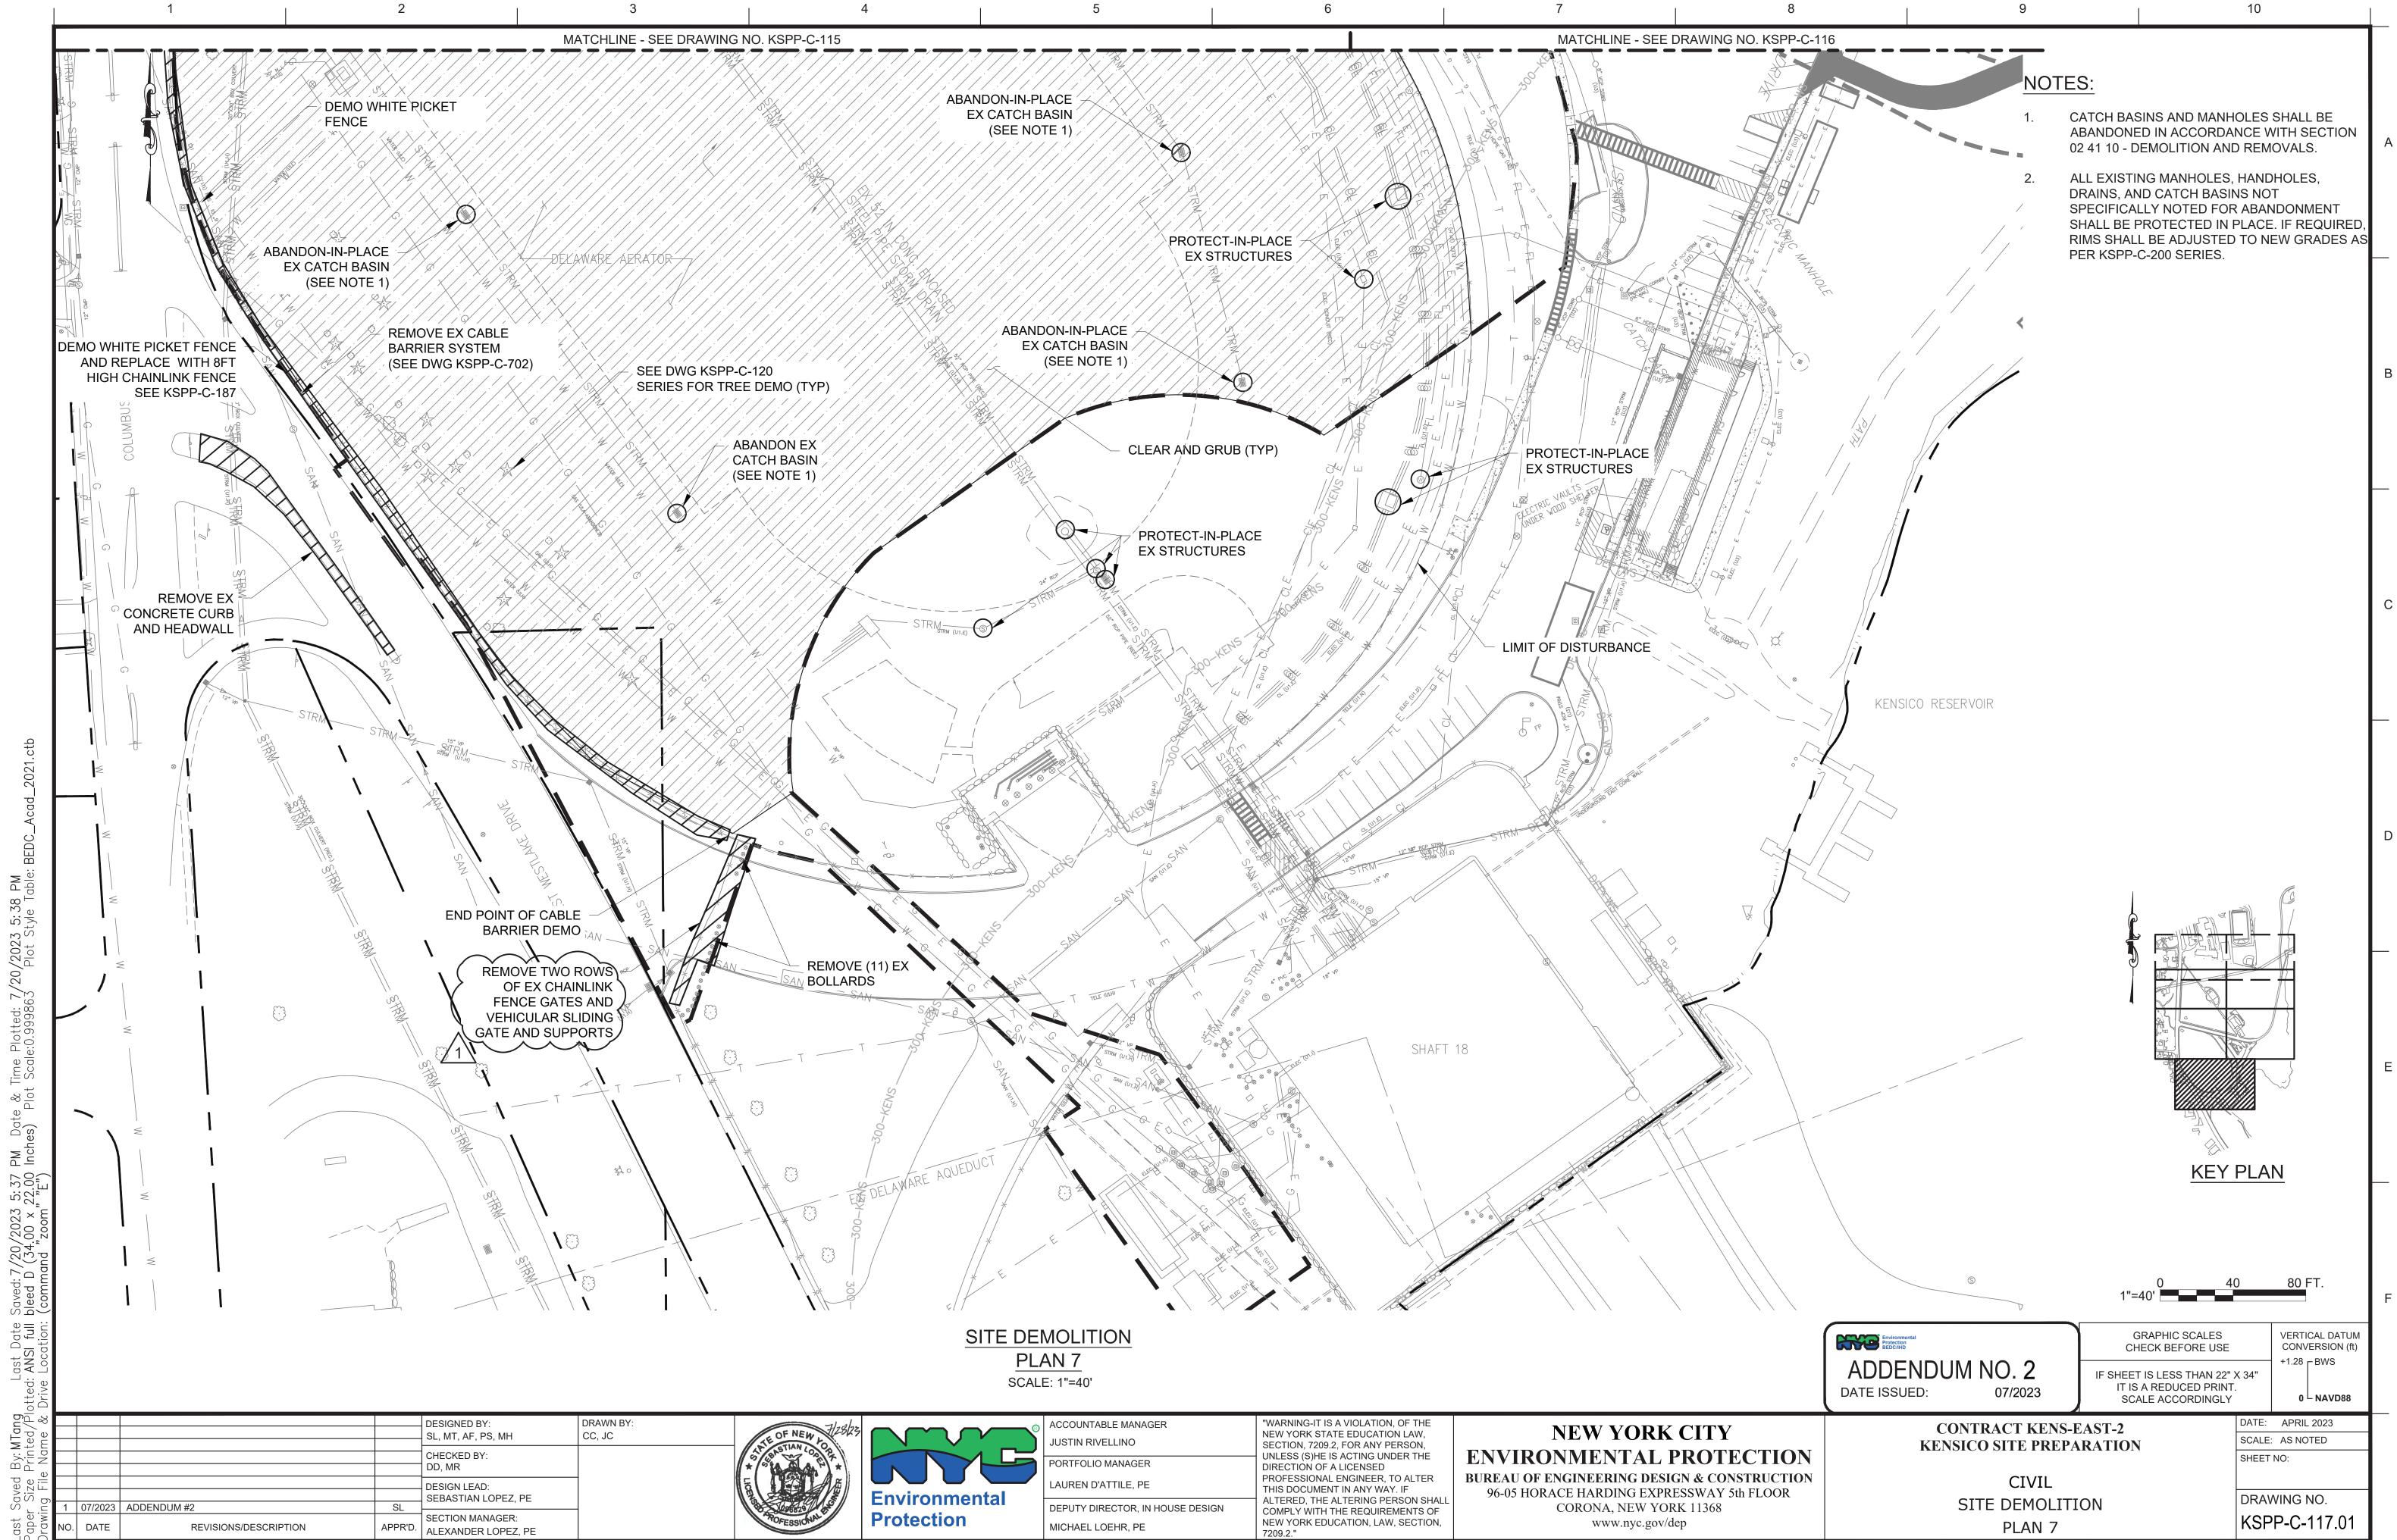

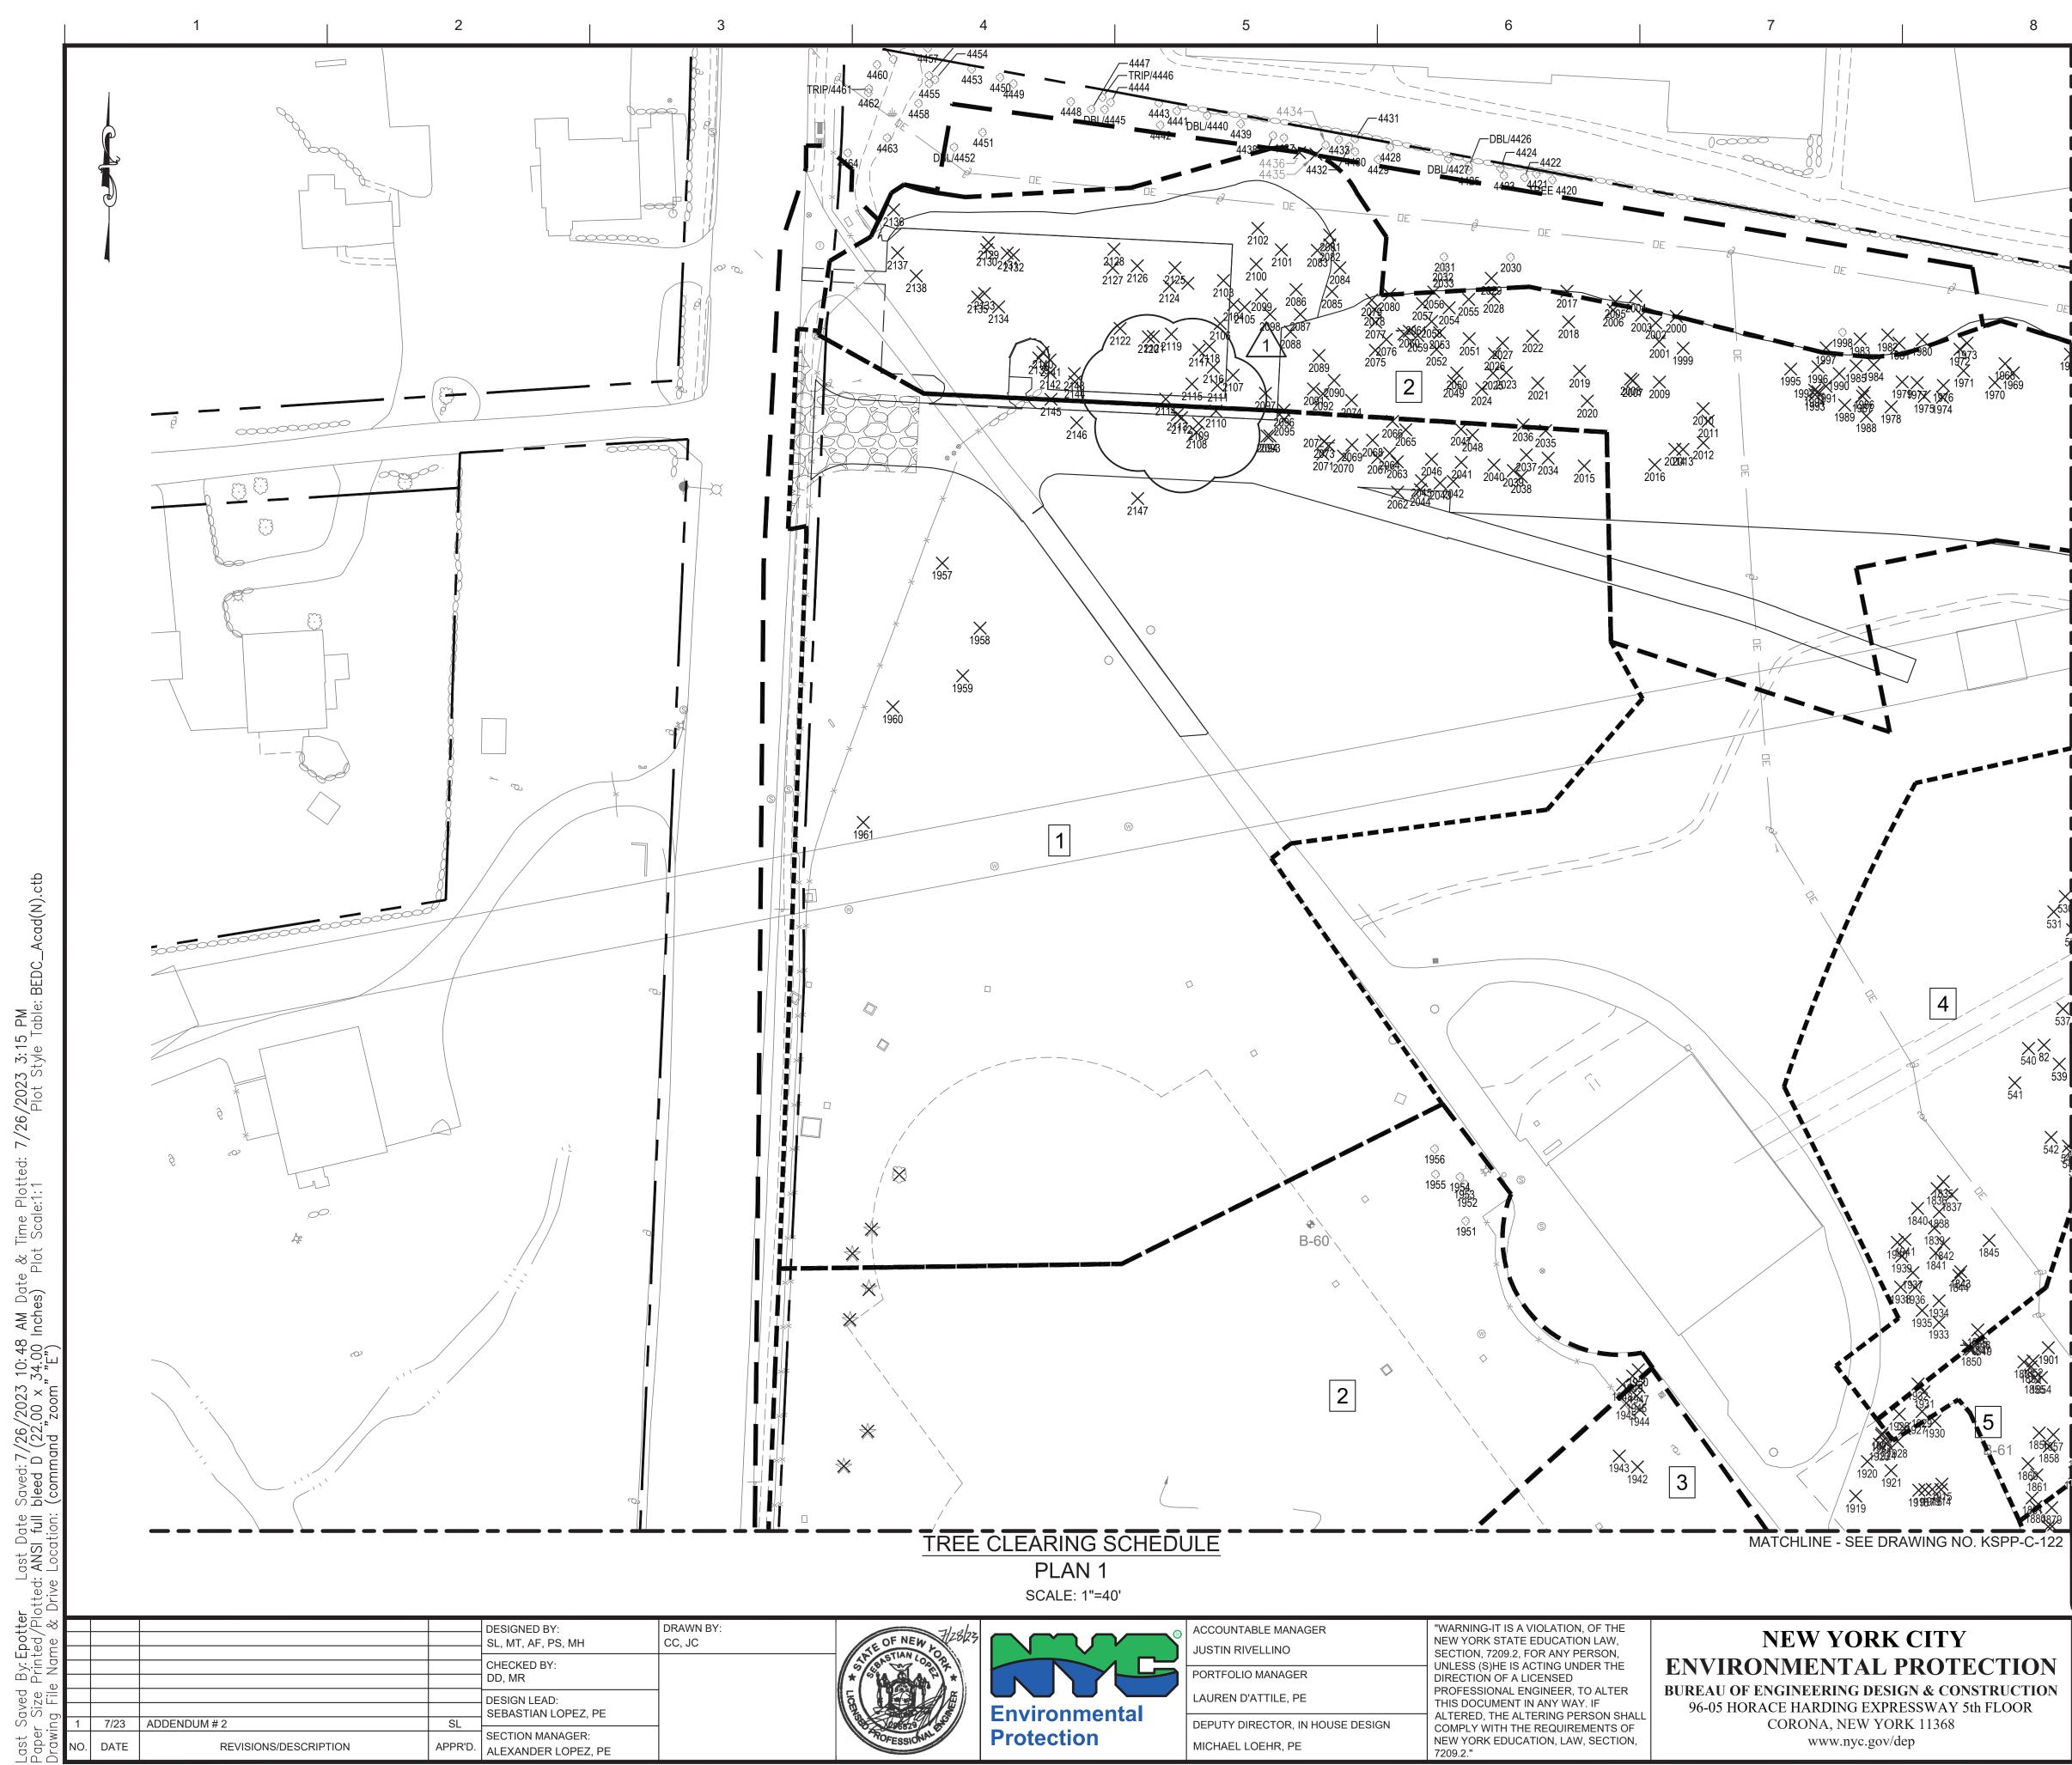




 $\underset{540}{\times}$

X 541

3.




- THE TREE INVENTORY WAS PERFORMED BY 1. SARATOGA ASSOCIATES IN 2018. TREES SMALLER THAN 4IN DIAMETER AT BREAST HEIGHT AT THE TIME OF SURVEY WERE NOT INCLUDED IN THE TREE CLEARING SCHEDULE. 2.
 - TREE LOCATIONS ARE BASED ON FIELD SURVEY PERFORMED BY NAIK ON 08/2018 AND BY MATRIX NEW WORLD ON 09/2020. TREE CLEARING SHALL BE PERFORMED IN ACCORDANCE WITH SECTION 01 14 00 -WORK RESTRICTIONS, 02 41 10 - DEMOLITION AND REMOVALS, SECTION 31 10 10 - SITE CLEARING, SECTION 31 25 10 - DUST EROSION AND SEDIMENT CONTROL, AND THE KENSICO SITE STORMWATER POLLUTION PREVENTION PLAN.

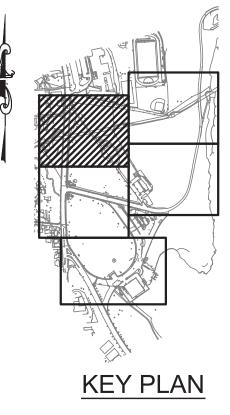


D

1 1859457 1859457 1869× 1861		0 40 1"=40'	0	80 FT.	F
P-C-122	Environmental Protection BEDC/IHD	GRAPHIC SCALES CHECK BEFORE USE		VERTICAL DATUM CONVERSION (ft)	
	ADDENDUM NO. 2 DATE ISSUED: 07/2023	IF SHEET IS LESS THAN 22" 2 IT IS A REDUCED PRINT SCALE ACCORDINGLY		+1.28 BWS 0 NAVD88	
	CONTRACT KENS-F	CAST-2	DATE:	APRIL 2023	
	KENSICO SITE PREPA		SCALE: AS NOTED		
TION			SHEET	NO:	
JCTION	CIVIL				
OOR	TREE CLEARING SC	HEDULE	DRAV	VING NO.	
				KSPP-C-120.01	

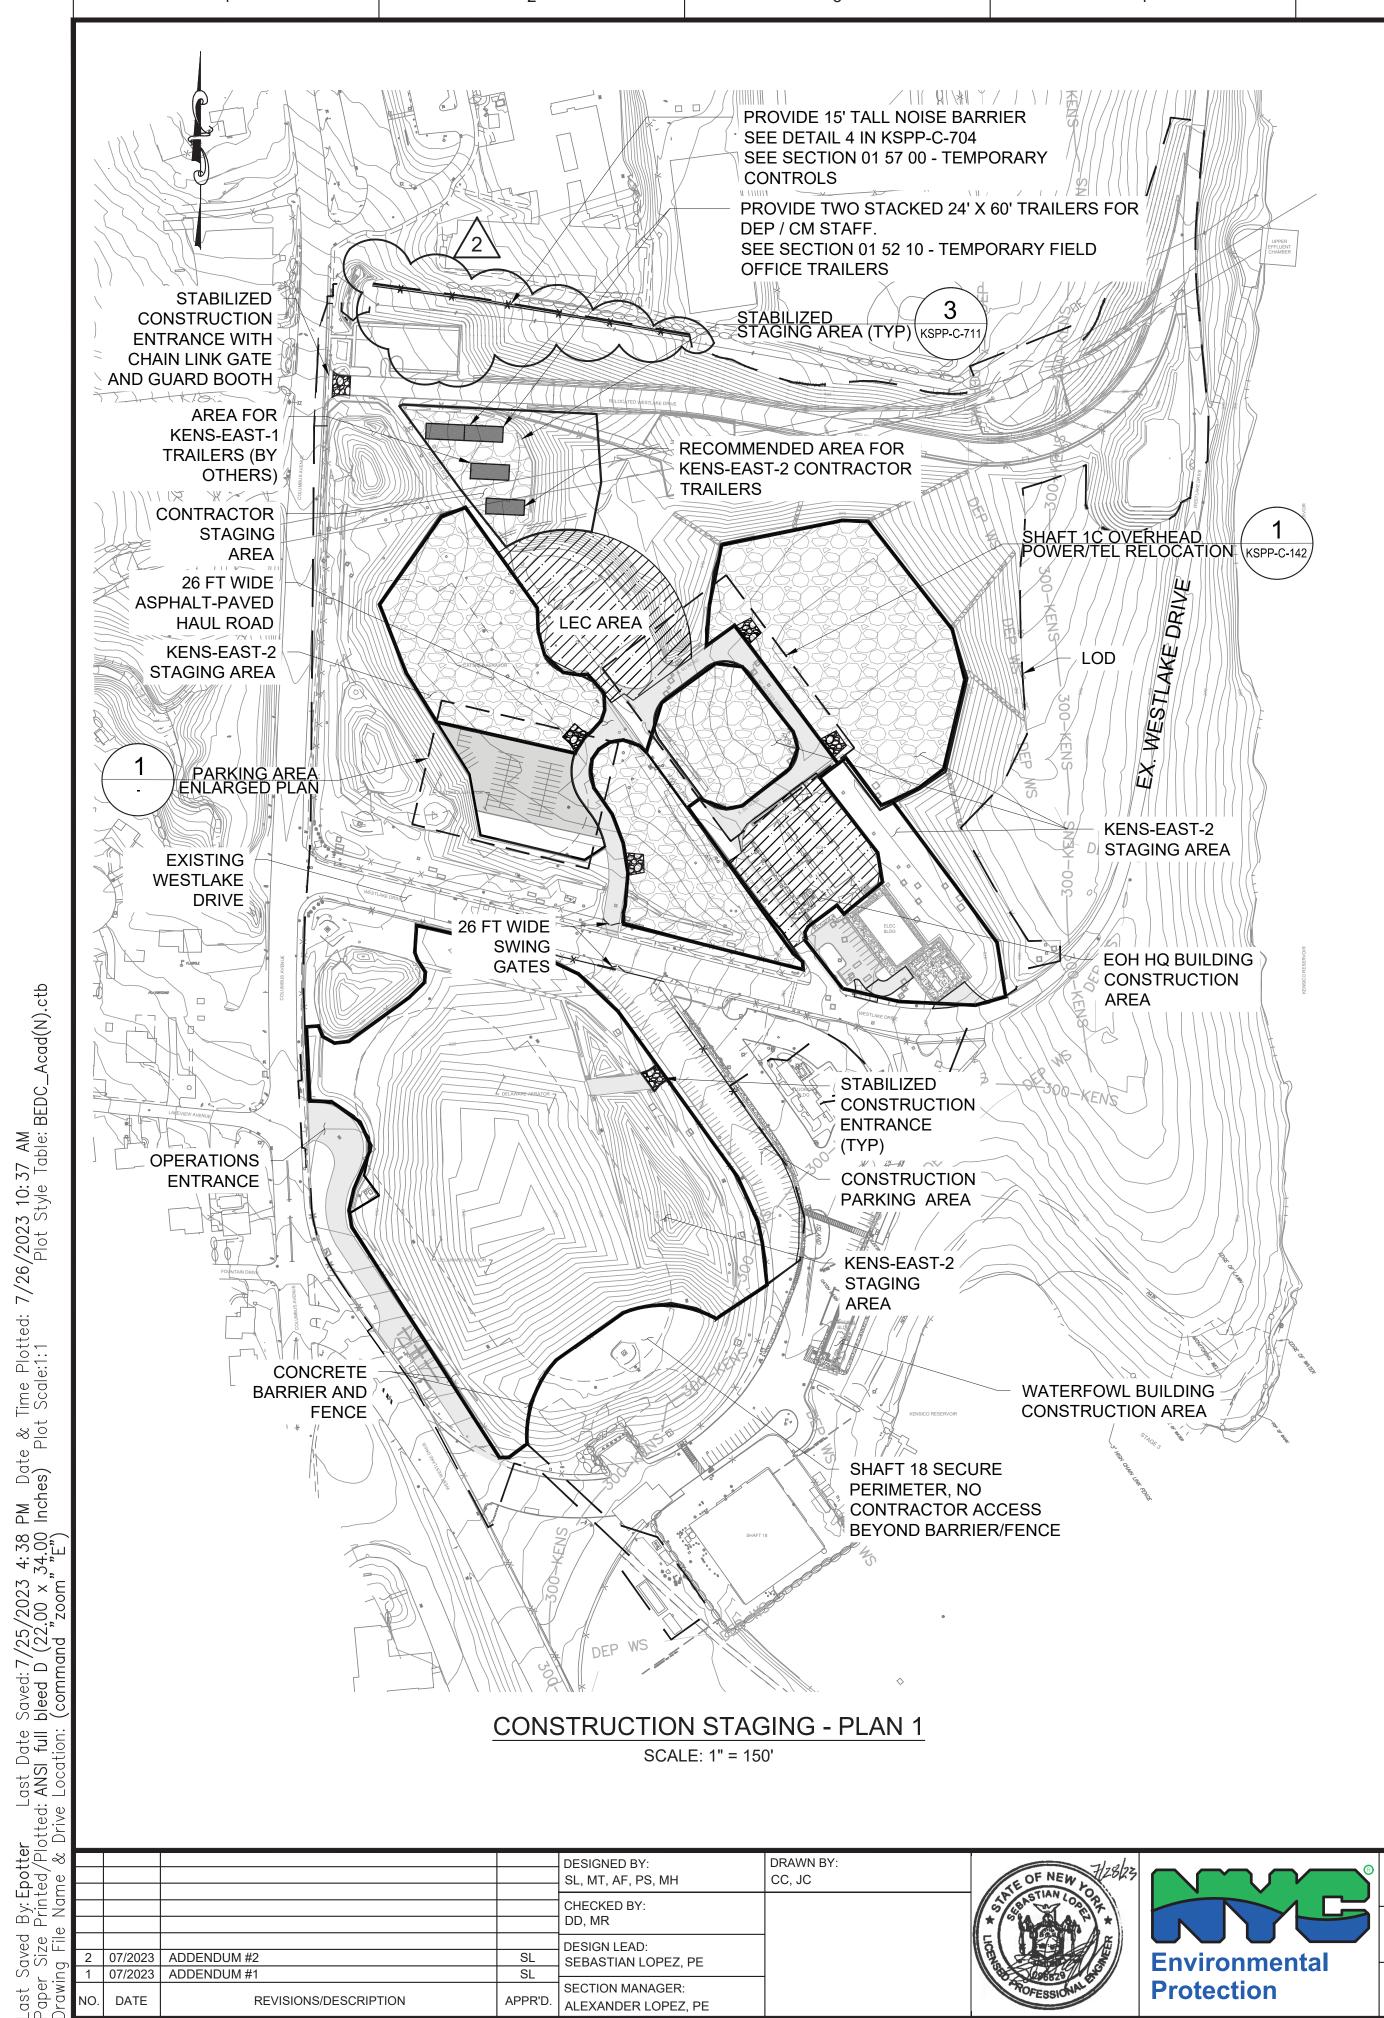





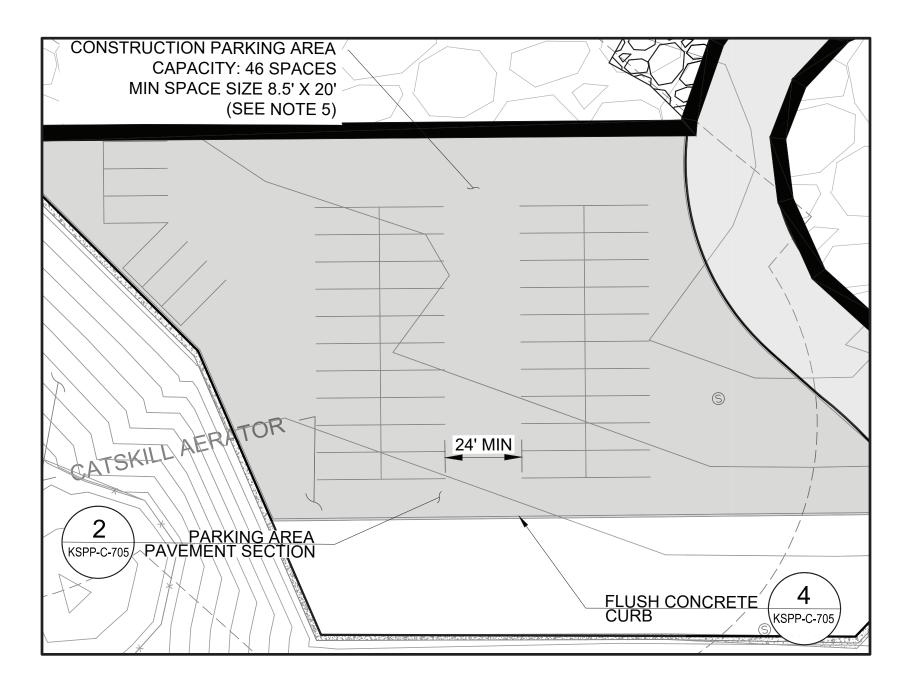

> PARKING AREA ENLARGED PLAN SCALE: 1' = 30' -

ACCOUNTABLE MANAGER JUSTIN RIVELLINO PORTFOLIO MANAGER LAUREN D'ATTILE, PE DEPUTY DIRECTOR, IN HOUSE DESIGN MICHAEL LOEHR, PE

"WARNING-IT IS A VIOLATION, OF THE NEW YORK STATE EDUCATION LAW, SECTION, 7209.2, FOR ANY PERSON, UNLESS (S)HE IS ACTING UNDER THE DIRECTION OF A LICENSED PROFESSIONAL ENGINEER, TO ALTER THIS DOCUMENT IN ANY WAY. IF ALTERED, THE ALTERING PERSON SHALL COMPLY WITH THE REQUIREMENTS OF NEW YORK EDUCATION, LAW, SECTION, 7209.2."


NEW YORK CITY ENVIRONMENTAL PROTECT BUREAU OF ENGINEERING DESIGN & CONSTRU 96-05 HORACE HARDING EXPRESSWAY 5th FLO CORONA, NEW YORK 11368 www.nyc.gov/dep

8		9	10	
	NOT	ES:		
	1.	DISTURBANCE AREA: 38.1ACF	RES	
	2.	SEE KSPP-C-150 FOR CONSTR	RUCTION PHASING	
	3.	FOR AERATOR ROAD CIRCULA BE USED BY THE CONTRACTO MATERIAL STORAGE. THE CO	SE USED BY THE CONTRACTOR ATION. THE LEC AREA SHALL NOT OR FOR EQUIPMENT AND/OR NTRACTOR SHALL MAINTAIN DEP TALL TIMES. SEE SECTION 01 14	A
	4.		L RELOCATED WESTLAKE DRIVE ONED AND OPEN TO THE PUBLIC.	
	5.	EXISTING WESTLAKE DRIVE S OR EQUIPMENT STORAGE.	HALL NOT BE USED FOR STAGING	
	6.	AS SUITED FOR THEIR NEEDS THE CM AND THE KENS-EAST	CTOR SHALL ARRANGE PARKING S AND IN COORDINATION WITH	В

С

D

		0 30 1"=30' 0 15 1"=150' 0 15		60 FT. 300 FT.	F
	Environmental Protection BEDC/IHD	GRAPHIC SCALES CHECK BEFORE USE		VERTICAL DATUM CONVERSION (ft)	
	ADDENDUM NO. 2 DATE ISSUED: 07/2023	IF SHEET IS LESS THAN 22" 2 IT IS A REDUCED PRINT SCALE ACCORDINGLY		+1.28 BWS 0 NAVD88	
	CONTRACT KENS-EAST-2 KENSICO SITE PREPARATION CIVIL CONSTRUCTION STAGING		DATE: APRIL 2023		
TION CTION OOR			SCALE: AS NOTED SHEET NO:		
			DRAWING NO.		
			KSPP-C-140.02		

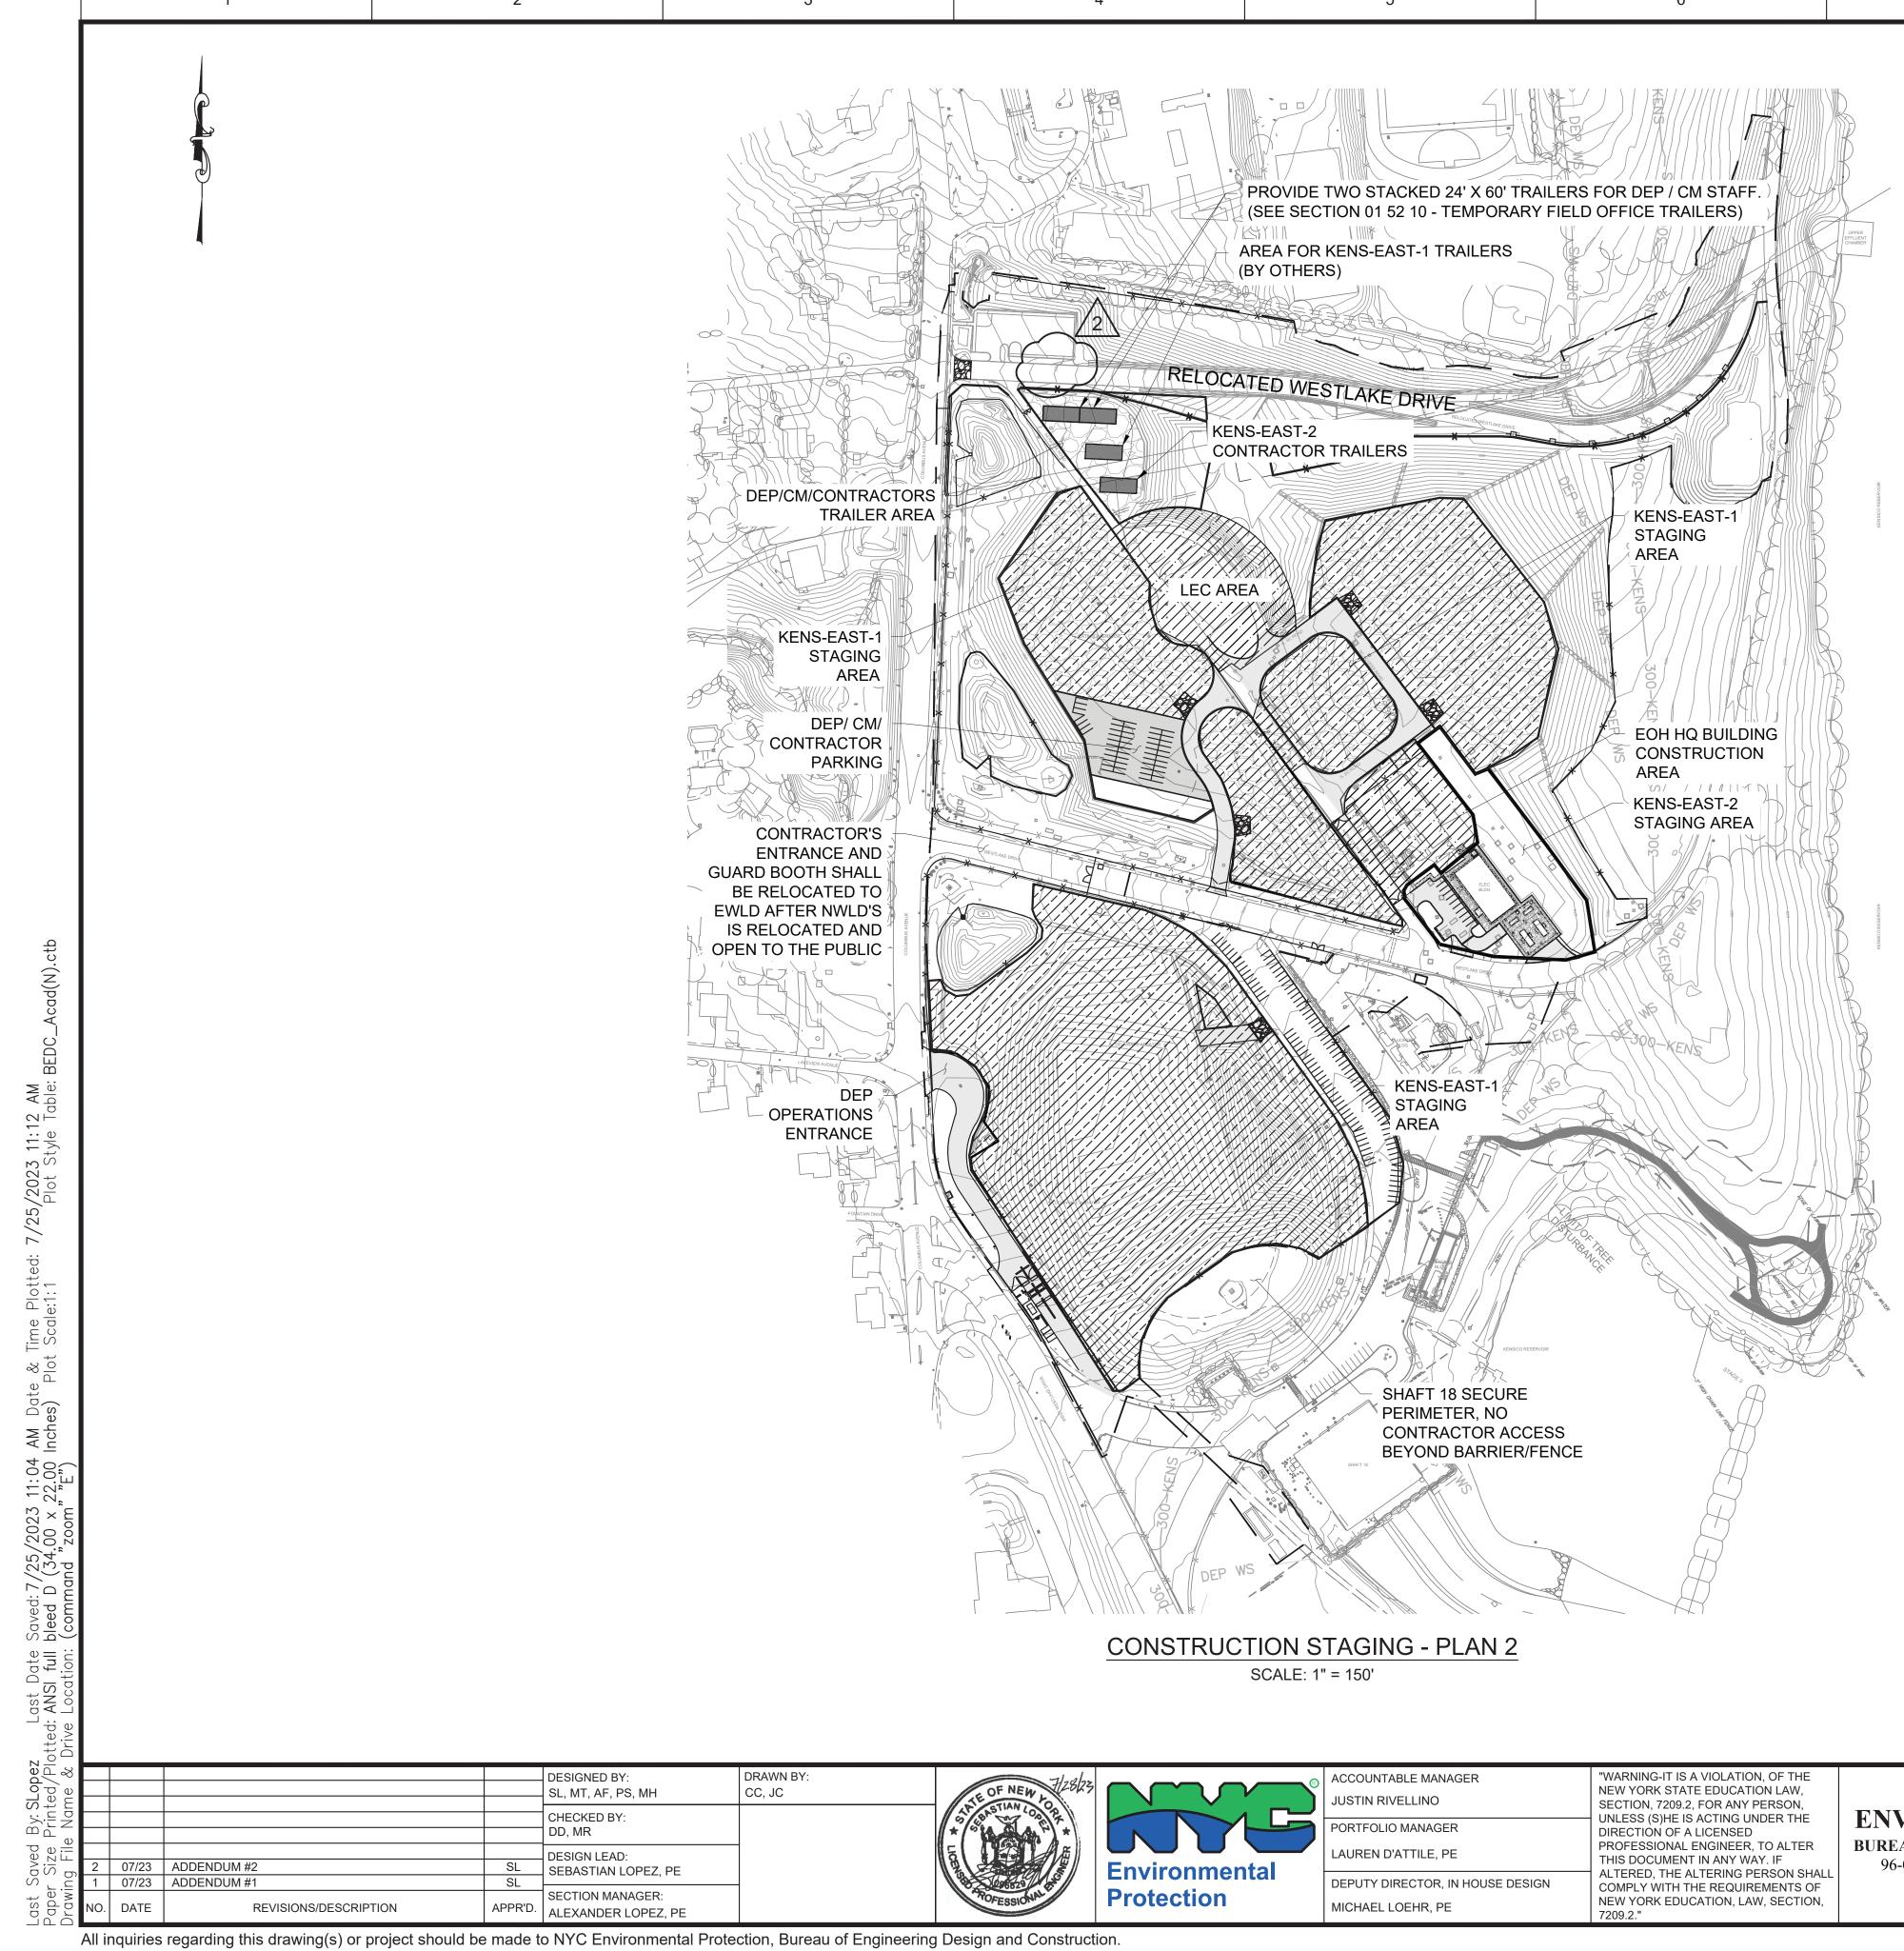



NEW YORK CITY ENVIRONMENTAL PROTECT BUREAU OF ENGINEERING DESIGN & CONSTRU 96-05 HORACE HARDING EXPRESSWAY 5th FLO CORONA, NEW YORK 11368 www.nyc.gov/dep

	9 10	
N	DTES:	
1.	DISTURBANCE AREA: 38.1ACRES	
2.	SEE KSPP-C-150 FOR CONSTRUCTION PHASING	
3.	THE LEC AREA SHALL ONLY BE USED BY THE CONTRACTOR FOR AERATOR ROAD CIRCULATION. THE LEC AREA SHALL NOT BE USED BY THE CONTRACTOR FOR EQUIPMENT AND/OR MATERIAL STORAGE. THE CONTRACTOR SHALL MAINTAIN DEP ACCESS TO THE LEC AREA AT ALL TIMES. SEE SECTION 01 14 00 - WORK RESTRICTIONS.	A
		В
		С

D

		0 15 1"=150'	50	300 FT.	F
1	Environmental Protection BEDC/IHD	GRAPHIC SCALES CHECK BEFORE USE		VERTICAL DATUM CONVERSION (ft)	
	ADDENDUM NO. 2 DATE ISSUED: 07/2023	IF SHEET IS LESS THAN 22") IT IS A REDUCED PRINT. SCALE ACCORDINGLY		+1.28 BWS 0 NAVD88	
TION JCTION DOR	CONTRACT KENS-EAST-2		DATE: APRIL 2023 SCALE: AS NOTED		
	KENSICO SITE PREPA	RATION	SHEET		
	CONSTRUCTION STAGING				
				RAWING NO.	
	PLAN 2		KSPP-C-141.02		

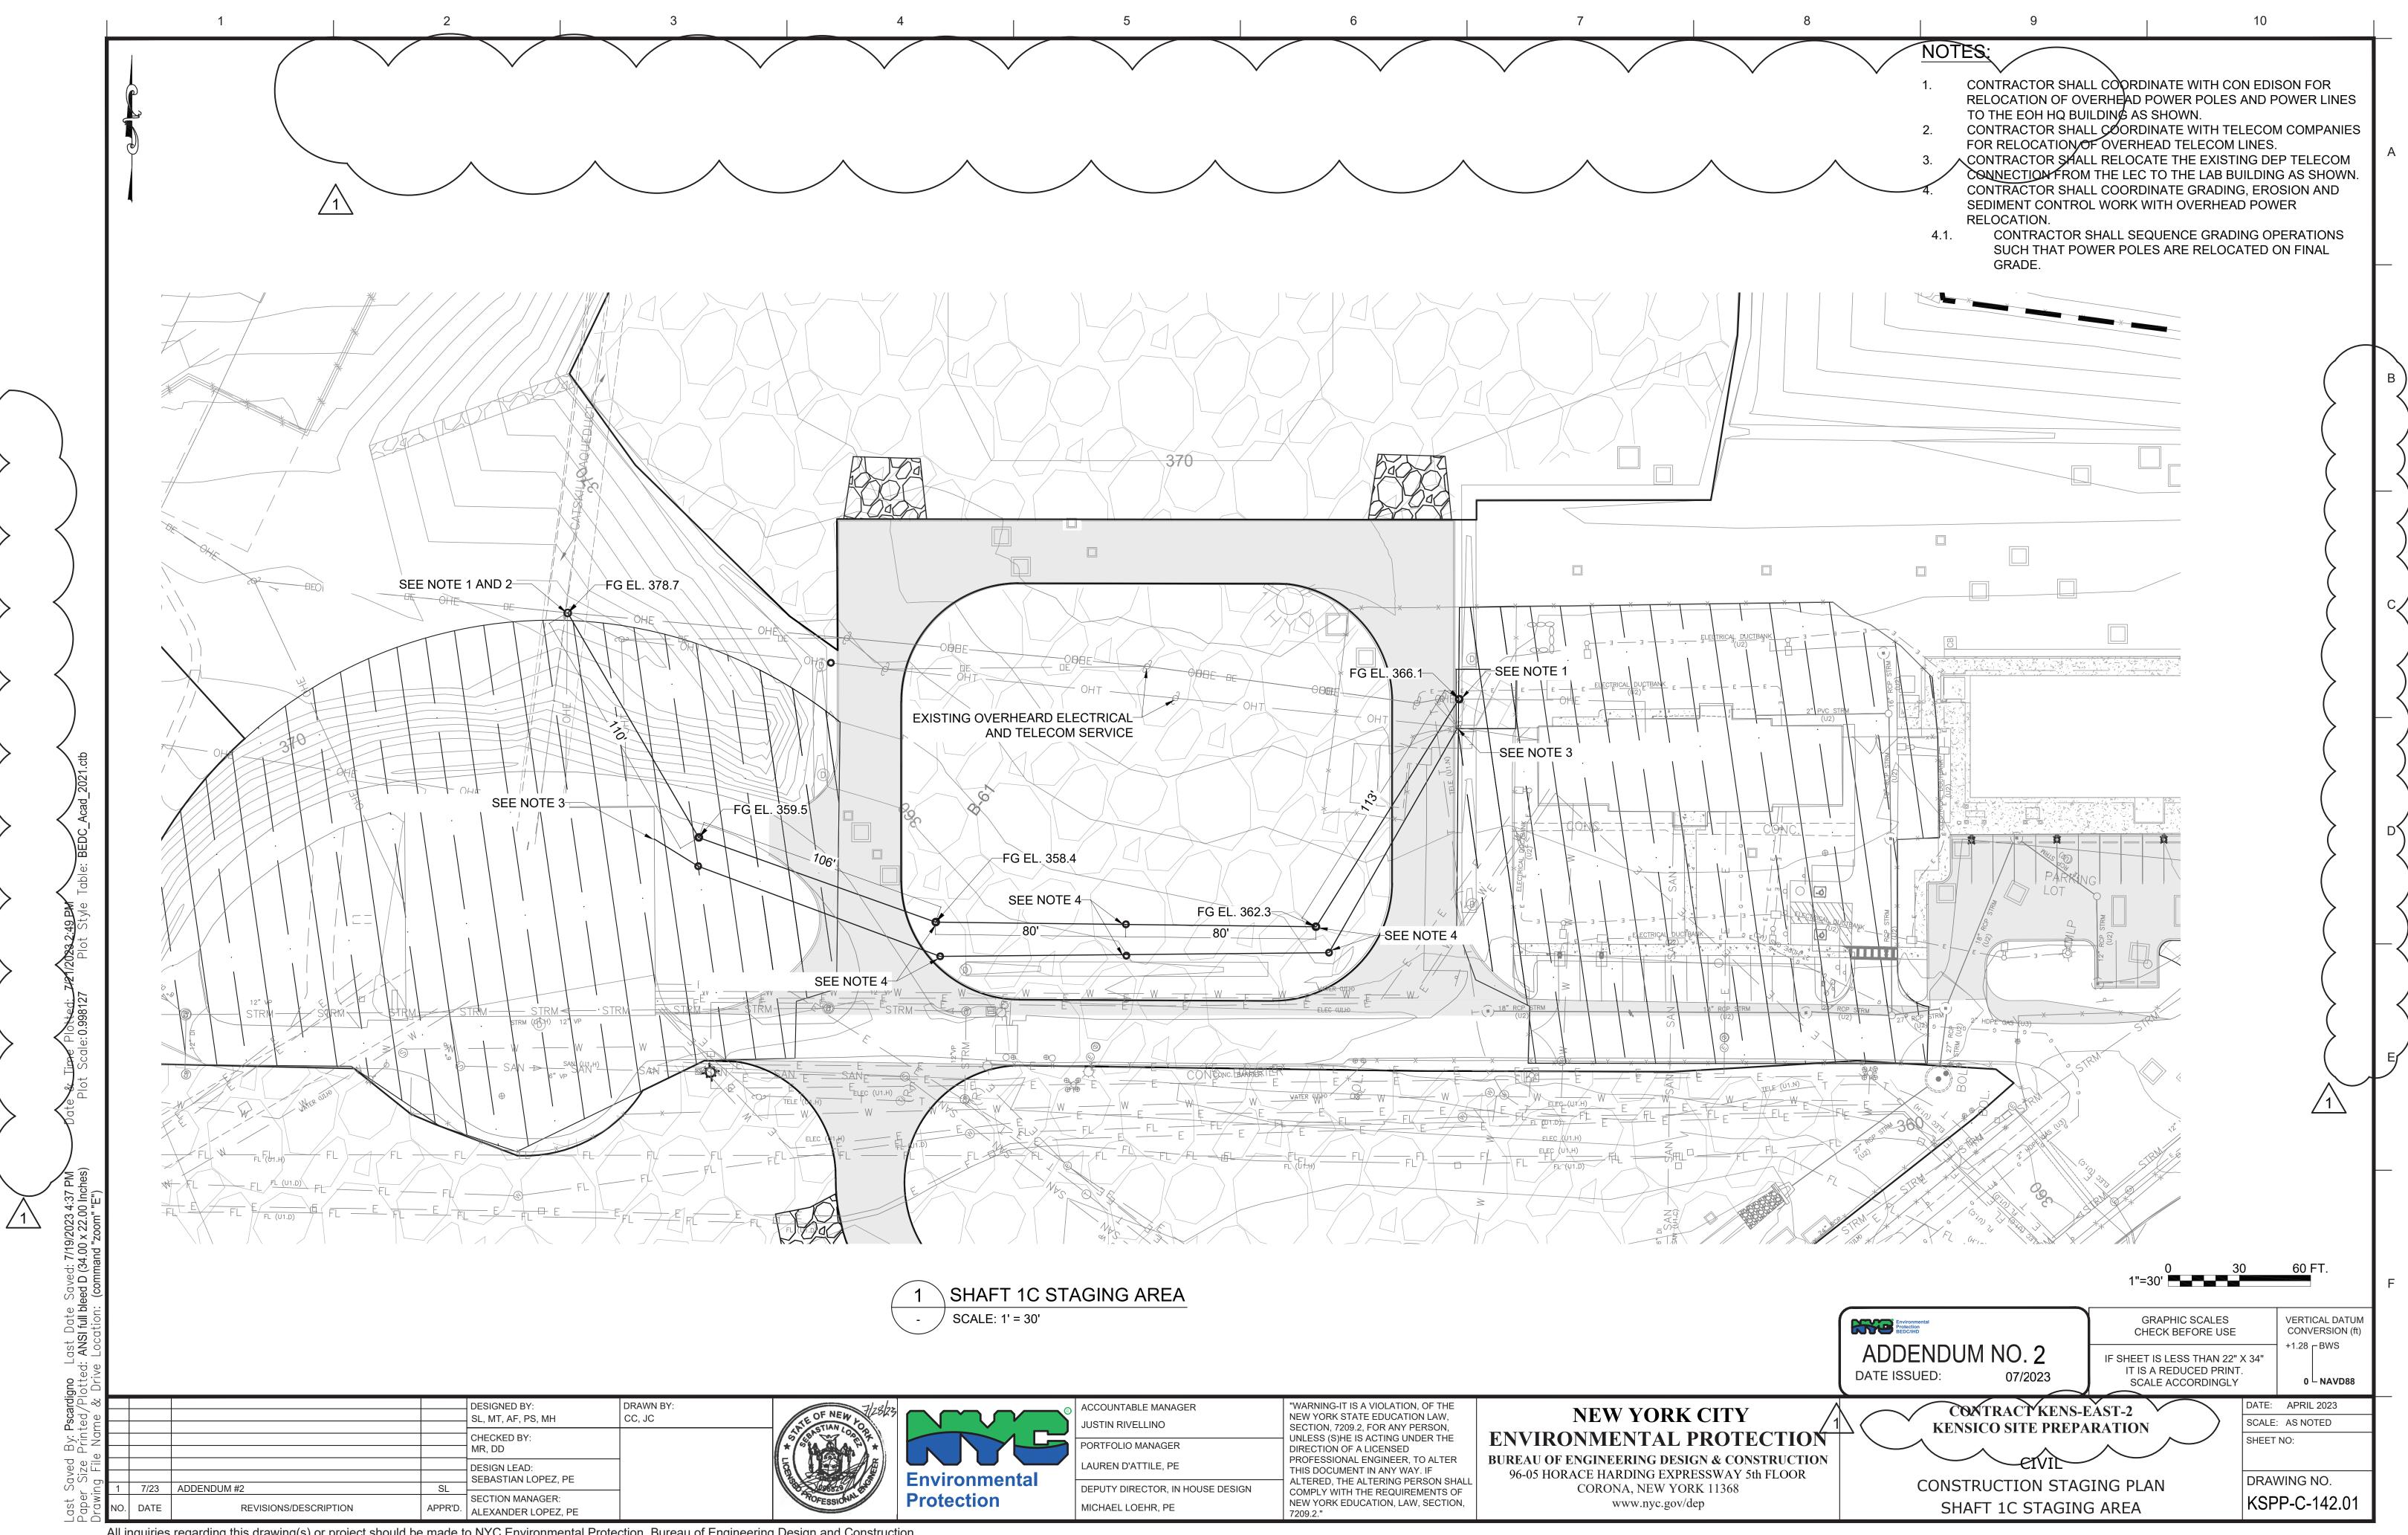


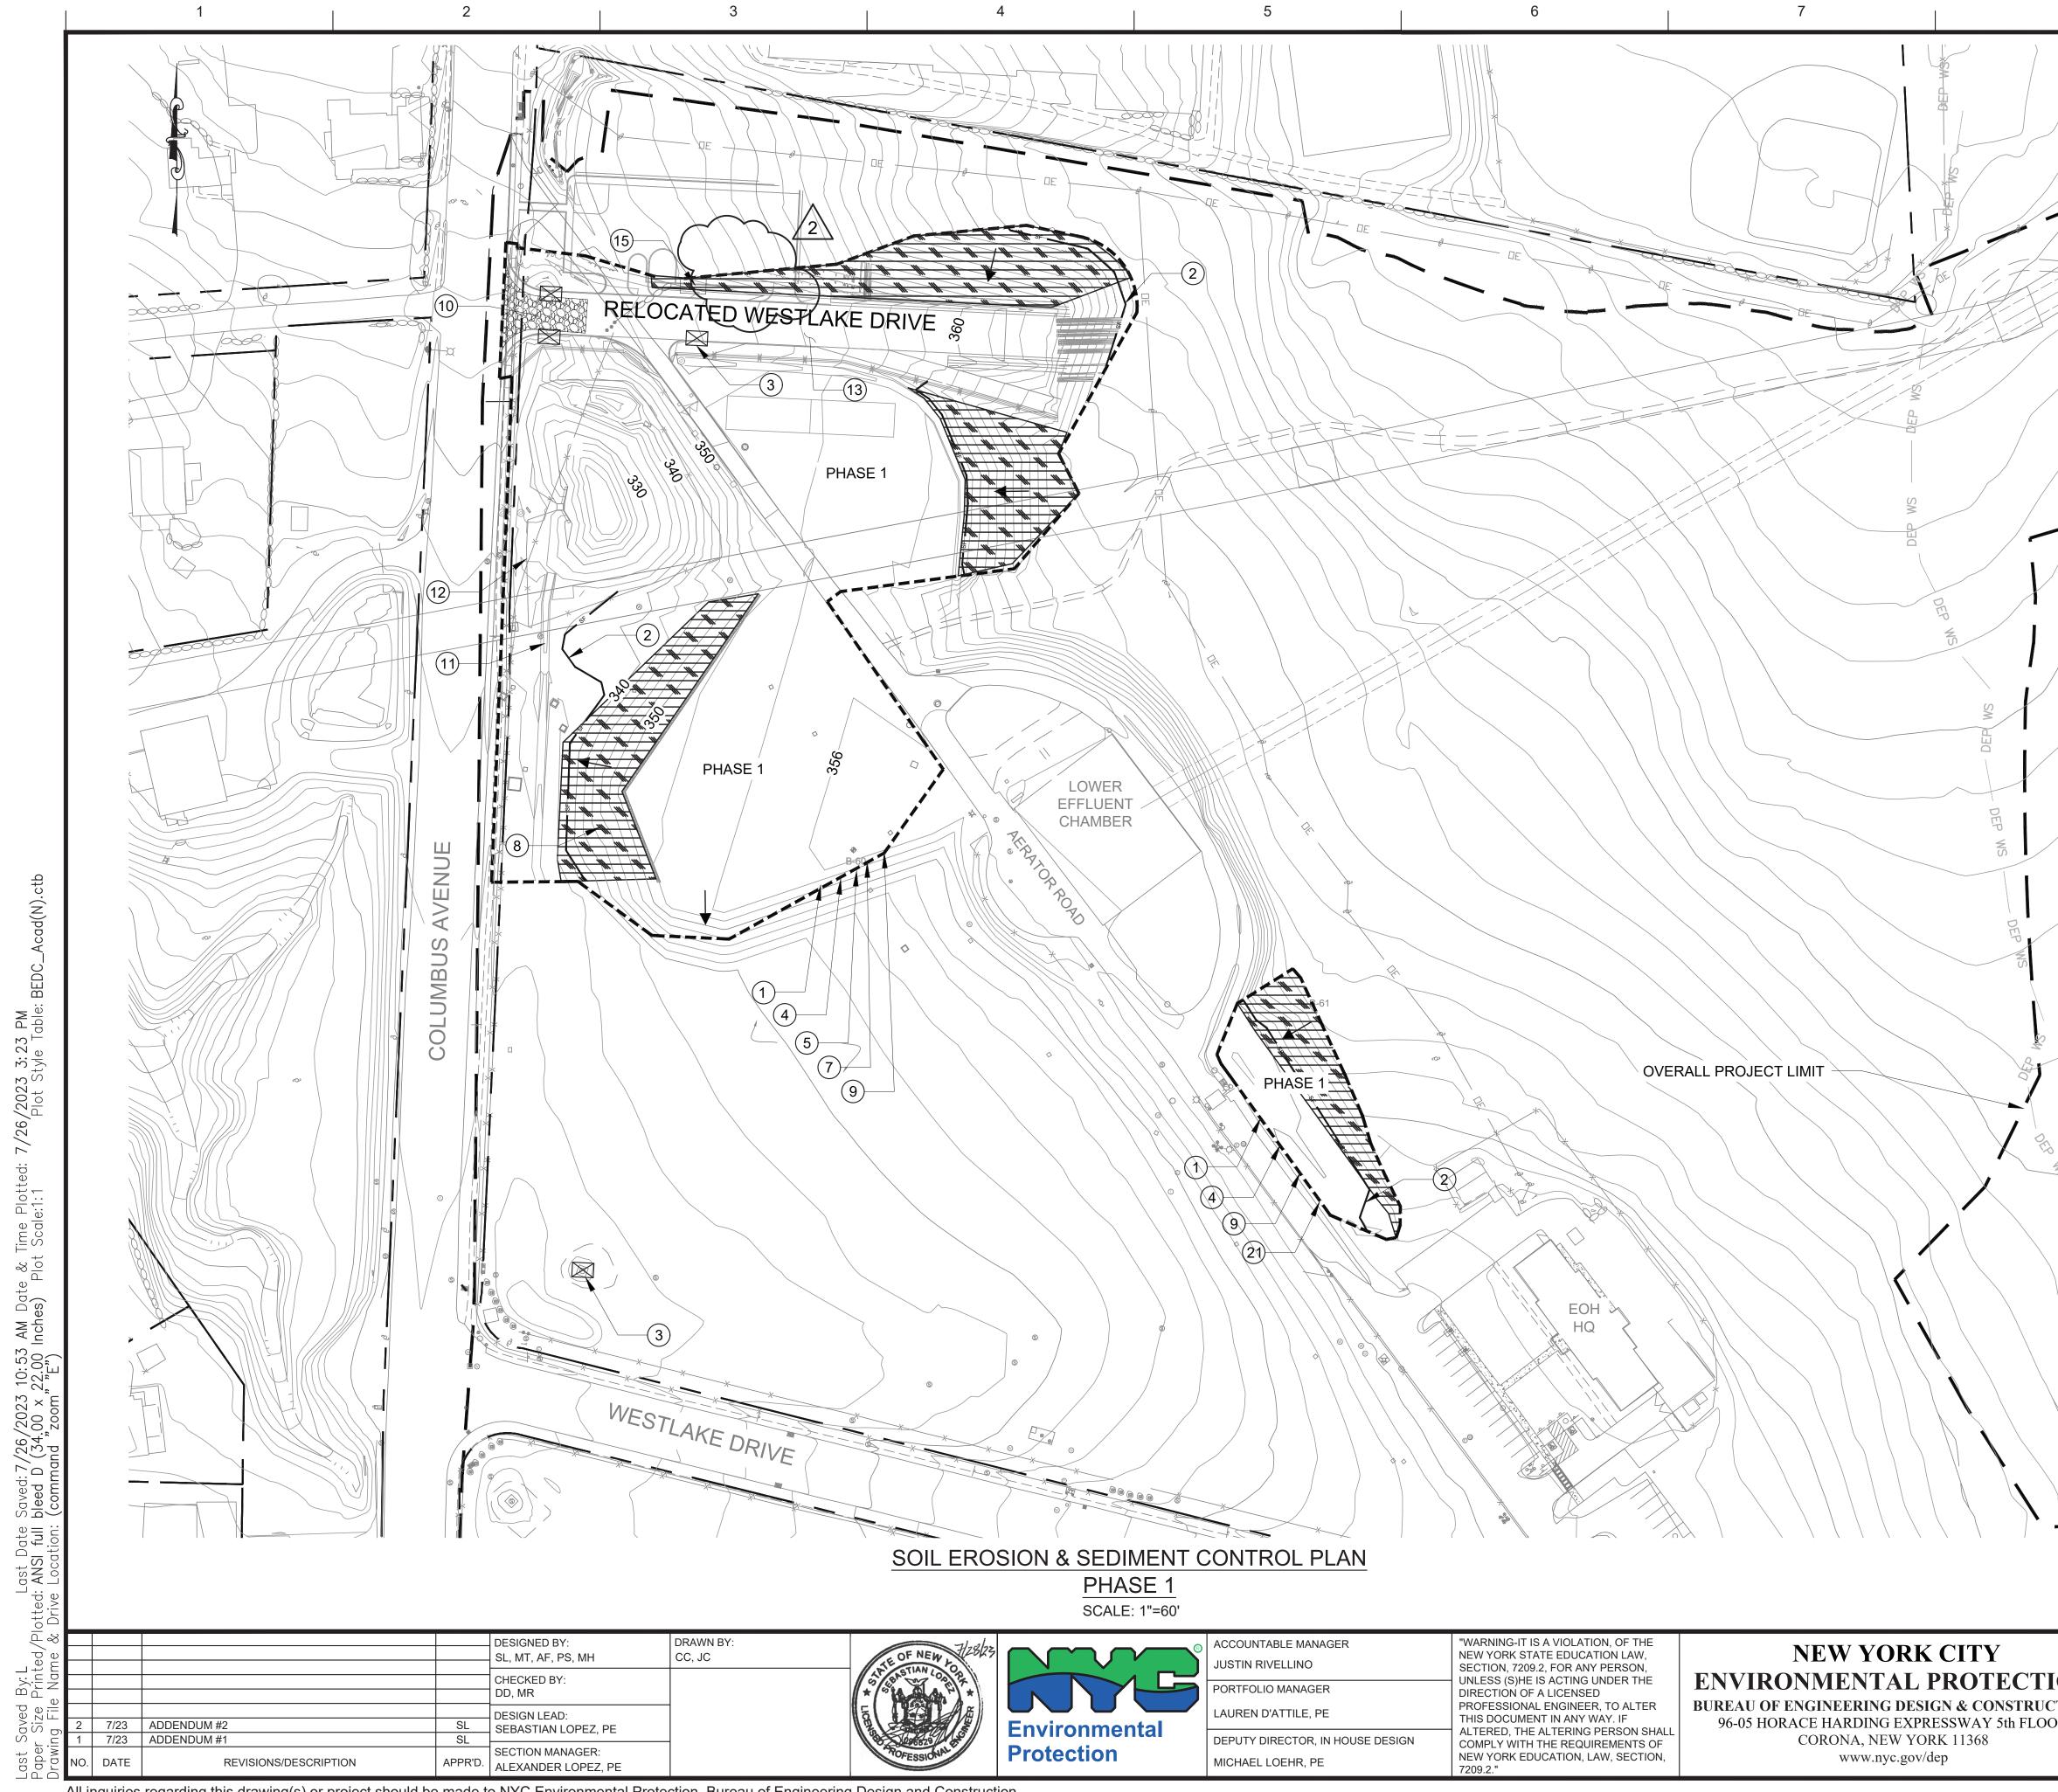


3/23		ACCOUNTABLE MA JUSTIN RIVELLINO PORTFOLIO MANAG LAUREN D'ATTILE,
/	Environmental Protection	DEPUTY DIRECTOR MICHAEL LOEHR, F

96-05 HORACE HARDING EXPRESSWAY 5th FLOO

8	9			10		
	EROSION AND SEDIME		TROL PR	ACTICE	ELEGEND	
	1 ESTABLISH LIMIT OF DISTURB DISTURBANCE TO NO MORE T LOCATION.	ANCE. CONT HAN 3 ACRE	RACTOR TO S AT A TIME	limit Regardle	ESS OF	
/ ht	2 INSTALL SILT FENCE PER DET					A
	(3) INSTALL INLET PROTECTION F (4) INSTALL DRAINAGE PIPES AN DRAINAGE PLANS WITH INLET	D CATCH BAS	SINS AS SHO	WN ON TH	E 'G	
	KSPP-C-710. 5 PROVIDE TREE REMOVAL, CL				-	
	6 MASS EXCAVATION OF SCREE 7 GRADE CATSKILL STAGING A		RAREA.			┢
300-KENS	8 INSTALL EROSION CONTROL I DETAIL 2 ON DWG KSPP-C-712	MATTING FO	R DISTURBEI	D AREAS P	ER	
3((9) INSTALL UTILITIES (PARTIALL) (10) INSTALL CONSTRUCTION ENT 	,		DWG KSPI	P-C-711	
	CONSTRUCT VEGETATED SW	ALE PER DE	AIL 1 ON DW	/G KSPP-C-	721.	B
300-	 (12) CONSTRUCT RELOCATED WE DWG KSPP-C-730. (13) MASS EXCAVATION OF RELOC 				ON	
KENS	(13) MASS EXCAVATION OF RELOC					L
300-KE	(15) PROVIDE TRUCK WASH AND C WITH THE NYSDEC BLUE BOC	NK.				
	(16) GRADE DELAWARE AREA AND ROAD. CONTRACTOR TO TUR COMPLETION AND INSTALLAT	N OVER CON	TROL TO OP	PERATIONS	NCE AFTER	
0-KENS	(17) CONSTRUCT DELAWARE PON (18) CONSTRUCT BIORETENTION I					С
30	(19) MASS EXCAVATION OF ELECT	RICAL BUILD	ING.			
300-	 (20) CONSTRUCT GRAVEL SWALE (21) RELOCATE OVERHEAD POWE SEE KSPP-C-142. 					
KENS	SEE NSFF-0-142.					┝
3	LEGEND PHASE LIMITS					
00-KEN	OVERALL PROJECT LIMIT SILT FENCE (760-FT)	SF	SF			
(/	INLET PROTECTION	\ge				D
	FLOW LINE EROSION CONTROL MATTING	<i>"\\ \\</i>	₩ ₩			
	ERUSION CONTROL MATTING		<i>W W</i>			
	CONTRACTOR SHALL CONDUC		ORK CONSTR	RUCTION		F
40	 CLEAN AND GRUB THE REMOVE AND STOCKP 	_	-	JSE.		
	3. PERFORM EARTHWOR THE GRADING SHOWN	K AND GRAD	ING OPERAT			
EF	4. INSTALL PLANTINGS A	S SHOWN IN	KSPP-L DRA	WINGS.		ו
	_					
						L
		1"	0 =60' 	60	120 FT.	F
	Environmental Protection BEDC/IHD		GRAPHIC SCAL		VERTICAL DATUM CONVERSION (ft)	
	ADDENDUM NO. 2 DATE ISSUED: 07/2023	IF SHE	ET IS LESS THAI S A REDUCED F CALE ACCORDI	N 22" X 34" PRINT.	+1.28 BWS	
ON	CONTRACT KEI KENSICO SITE PR		N	DATE: SCALE: SHEET	APRIL 2023 AS NOTED NO:	
CTION DR	CIVIL SOIL EROSION & SEDIME PHASE	ENT CONT	ROL PLAN		ving no. P-C-151.02	
				1		4

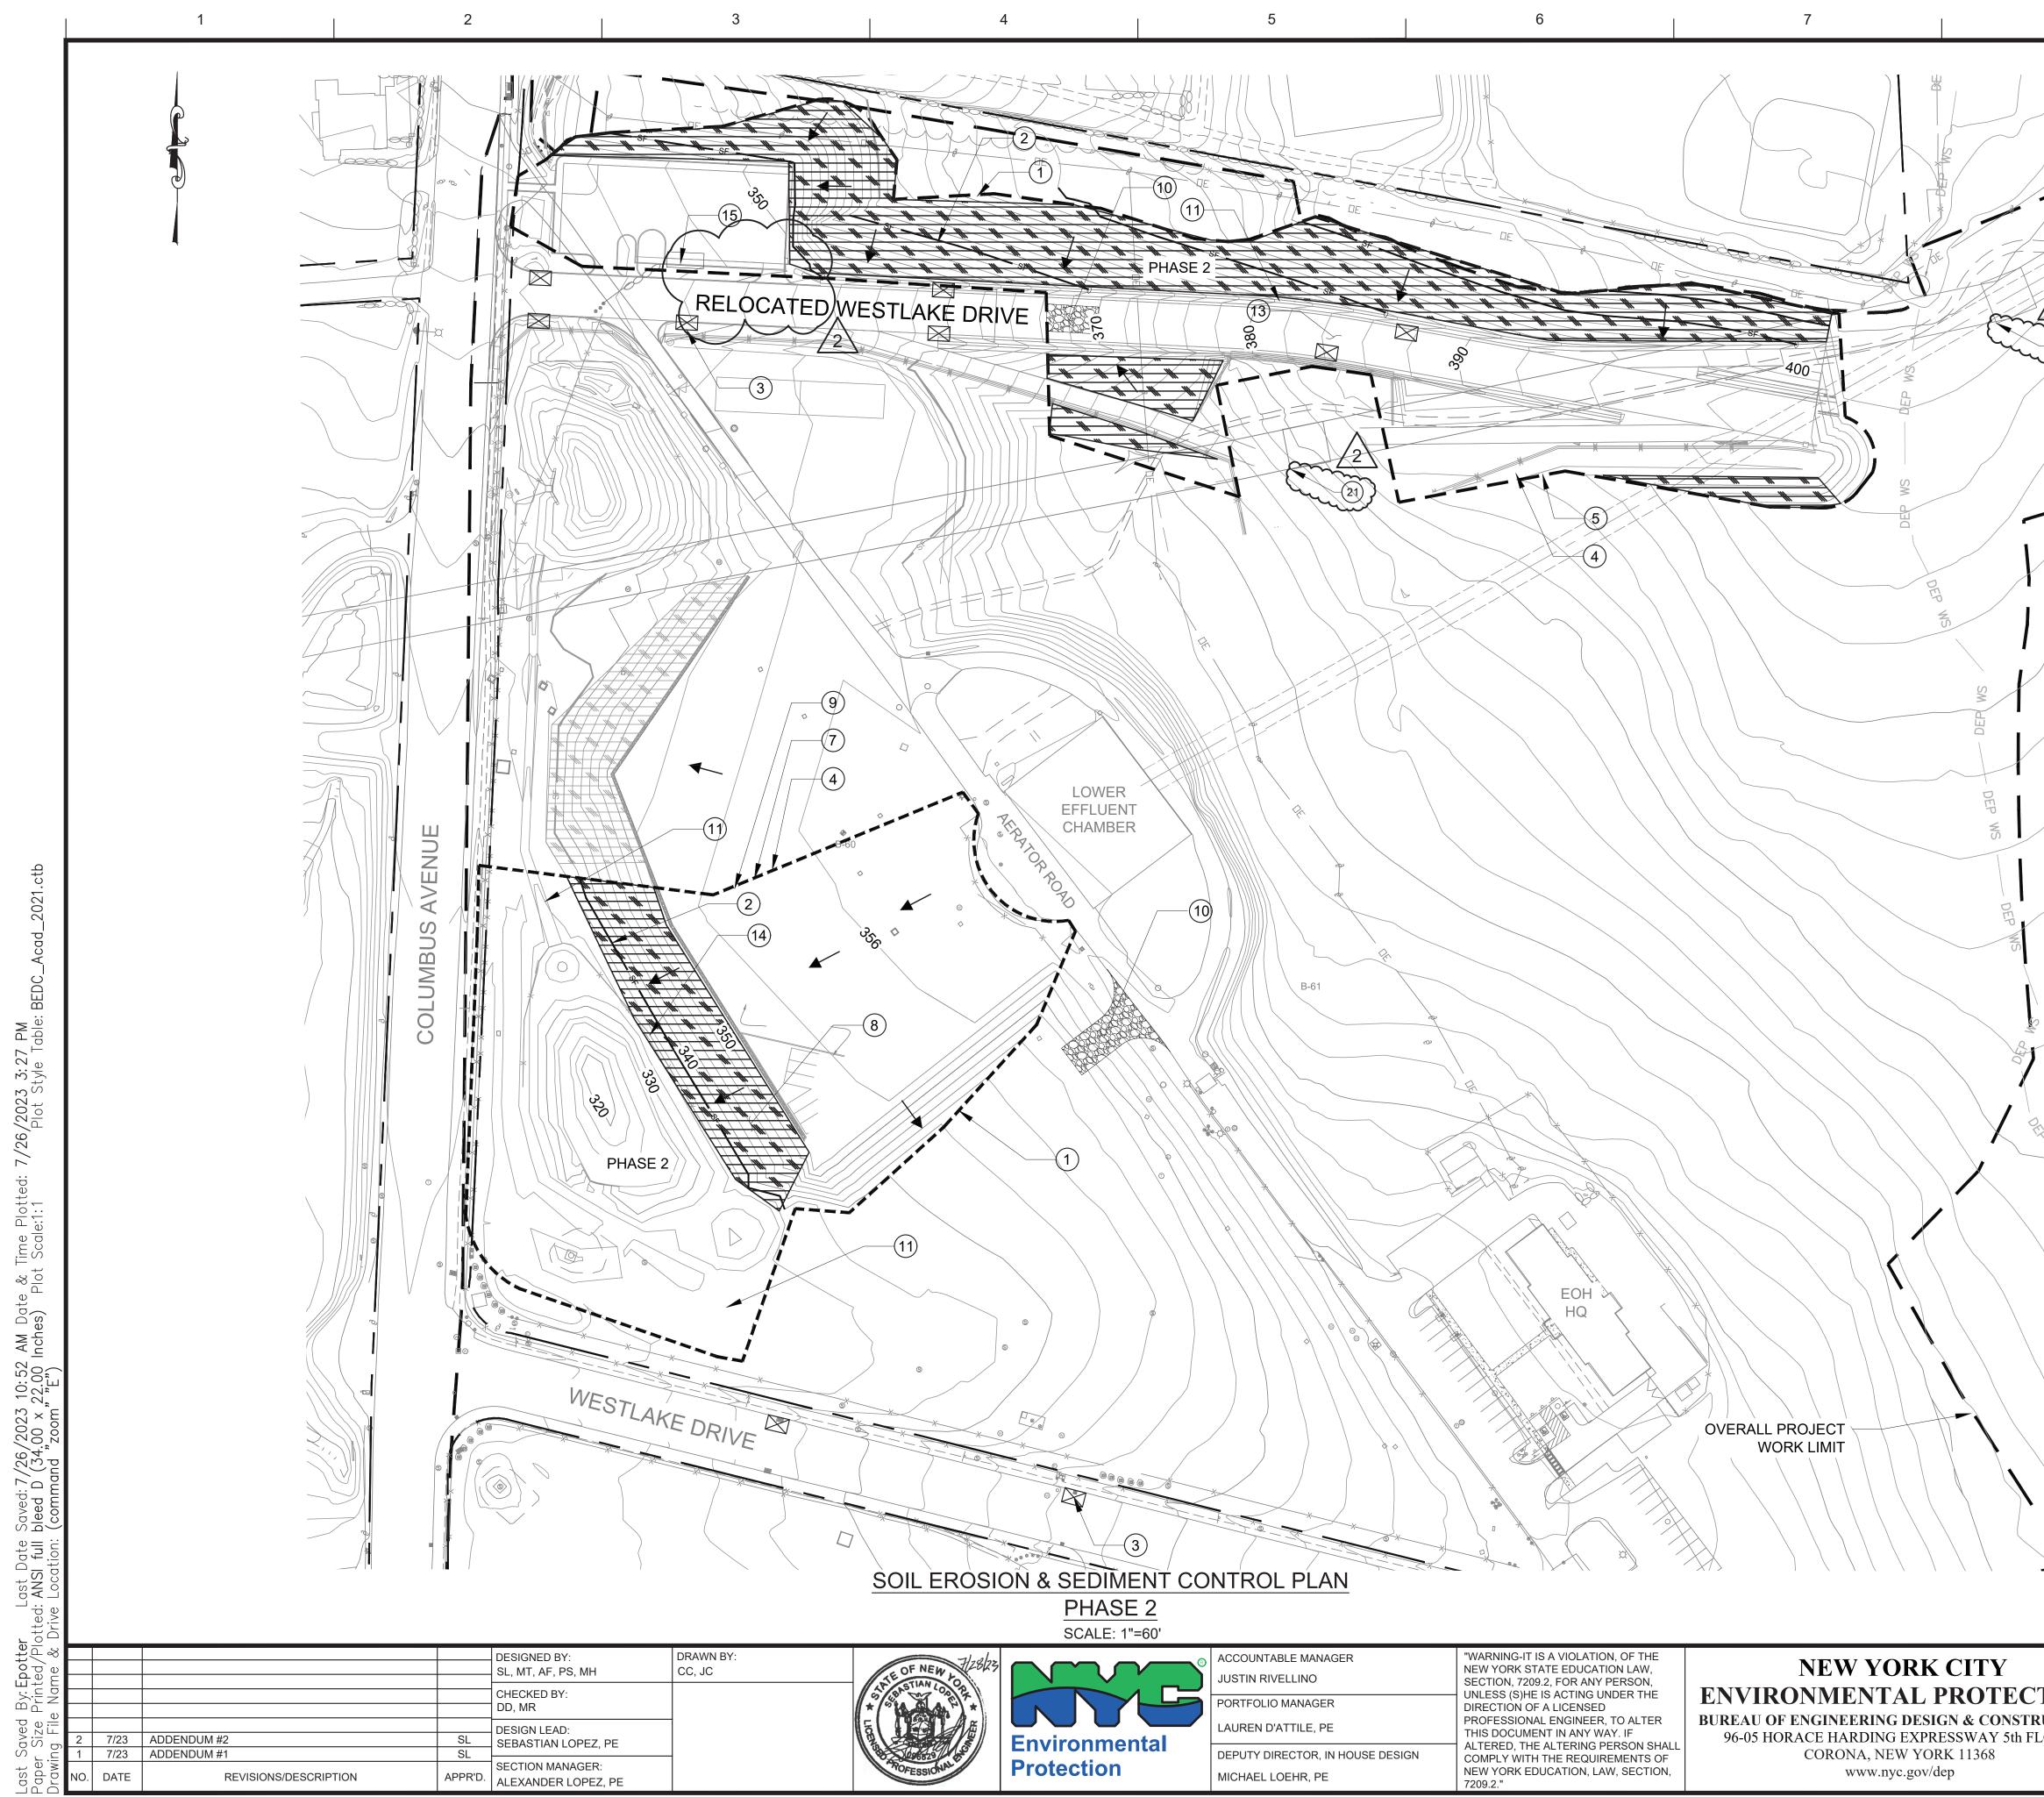


8	9		10	
/	<pre> <u> </u></pre>	CONTROL PRAC	TICE LEGEND	
	ESTABLISH LIMIT OF DISTURBANC DISTURBANCE TO NO MORE THAN LOCATION.	E. CONTRACTOR TO LIMI 3 ACRES AT A TIME REG	T ARDLESS OF	
	2 INSTALL SILT FENCE PER DETAIL	I ON DWG KSPP-C-710.		A
KENS	3 INSTALL INLET PROTECTION PER			
	(4) INSTALL DRAINAGE PIPES AND CA DRAINAGE PLANS WITH INLET PRO KSPP-C-710.	TCH BASINS AS SHOWN (DTECTION PER DETAIL 4 (ON THE ON DWG	
	 (6) MASS EXCAVATION OF SCREEN C (7) GRADE CATSKILL STAGING AREA. 			
On On	 8 INSTALL EROSION CONTROL MAT DETAIL 2 ON DWG KSPP-C-712. 		EAS PER	
X	(9) INSTALL UTILITIES (PARTIALLY) PE	R UTILITY PLAN.		
-KENS	10 INSTALL CONSTRUCTION ENTRAN		G KSPP-C-711.	В
-300-	(1) CONSTRUCT VEGETATED SWALE			
	(12) CONSTRUCT RELOCATED WESTLA KSPP-C-730.	AKE DRIVE POND PER DE	TAILS ON DWG	
KENS	(13) MASS EXCAVATION OF RELOCATE		0.700	
-000	 (14) CONSTRUCT CATSKILL POND PER (15) PROVIDE TRUCK WASH AND CONC 			
	WITH THE NYSDEC BLUE BOOK.			
KENS	(16) GRADE DELAWARE AREA AND CC ROAD. CONTRACTOR TO TURN OV COMPLETION AND INSTALLATION	'ER CONTROL TO OPERA	TIONS AFTER	
-300	CONSTRUCT DELAWARE POND PE	R DETAILS ON DWG KSPI	P-C-734.	С
	18 CONSTRUCT BIORETENTION FACI		G KSPP-C-725.	
- 300-	(19) MASS EXCAVATION OF ELECTRICA (20) CONSTRUCT GRAVEL SWALE PER		C-721.	
-KENS	21 CONTRACTOR SHALL VERIFY-IN-F EDISON TOWER GROUNDING SYS	IELD LOCATION OF EXIST	ING CON	
	CABLES CONFLICT WITH GRADING	G, THE CONTRACTOR SHA	LL 🖌 丨	
-300-	TO THE REQUIRED DEPTH BELOW			
-KENS	LEGEND			
	PHASE LIMITS OVERALL PROJECT LIMIT			
	SILT FENCE (1470-FT)	SF		D
	FLOW LINE			
/		# # #		
	NOTES:			
KP WO	1. CONTRACTOR SHALL CONDU CONSTRUCTION FOR EACH P 1.1. CLEAN AND GRUB THE AF	HASE AS FOLLOWS:		
	1.2. ŘEMOVE ANĎ STOCKPILE 1.3. PERFORM EARTHWORK A	E 12" TOPSOIL FOR REUSE AND GRADING OPERATION		
DEP	PER THE GRADING SHOW 1.4. INSTALL PLANTINGS AS S 2. ALL EMBANKMENT SLOPES A	HOWN IN KSPP-L DRAWIN	IGS.	
×.	3. CONTRACTOR SHALL PERIOD DRAINAGE STRUCTURES AND	ICALLY INSPECT ALL	-	E
	4. CONTRACTOR SHALL EMPLO WESTLAKE DRIVE DURING CO			
		0 6	0 120 FT.	
		1"=60'		F
	Environmental Protection BEOCIMD	GRAPHIC SCALES CHECK BEFORE USE	VERTICAL DATUM CONVERSION (ft)	
	ADDENDUM NO. 2	IF SHEET IS LESS THAN 22"	+1.28 BWS	
	DATE ISSUED: 07/2023	IT IS A REDUCED PRINT SCALE ACCORDINGLY		
	CONTRACT KENS- KENSICO SITE PREPA		DATE: APRIL 2023 SCALE: AS NOTED	_
TION RUCTION			SHEET NO:	
LOOR	CIVIL SOIL EROSION & SEDIMENT	CONTROL PLAN	DRAWING NO.	
	PHASE 2		KSPP-C-152.02	

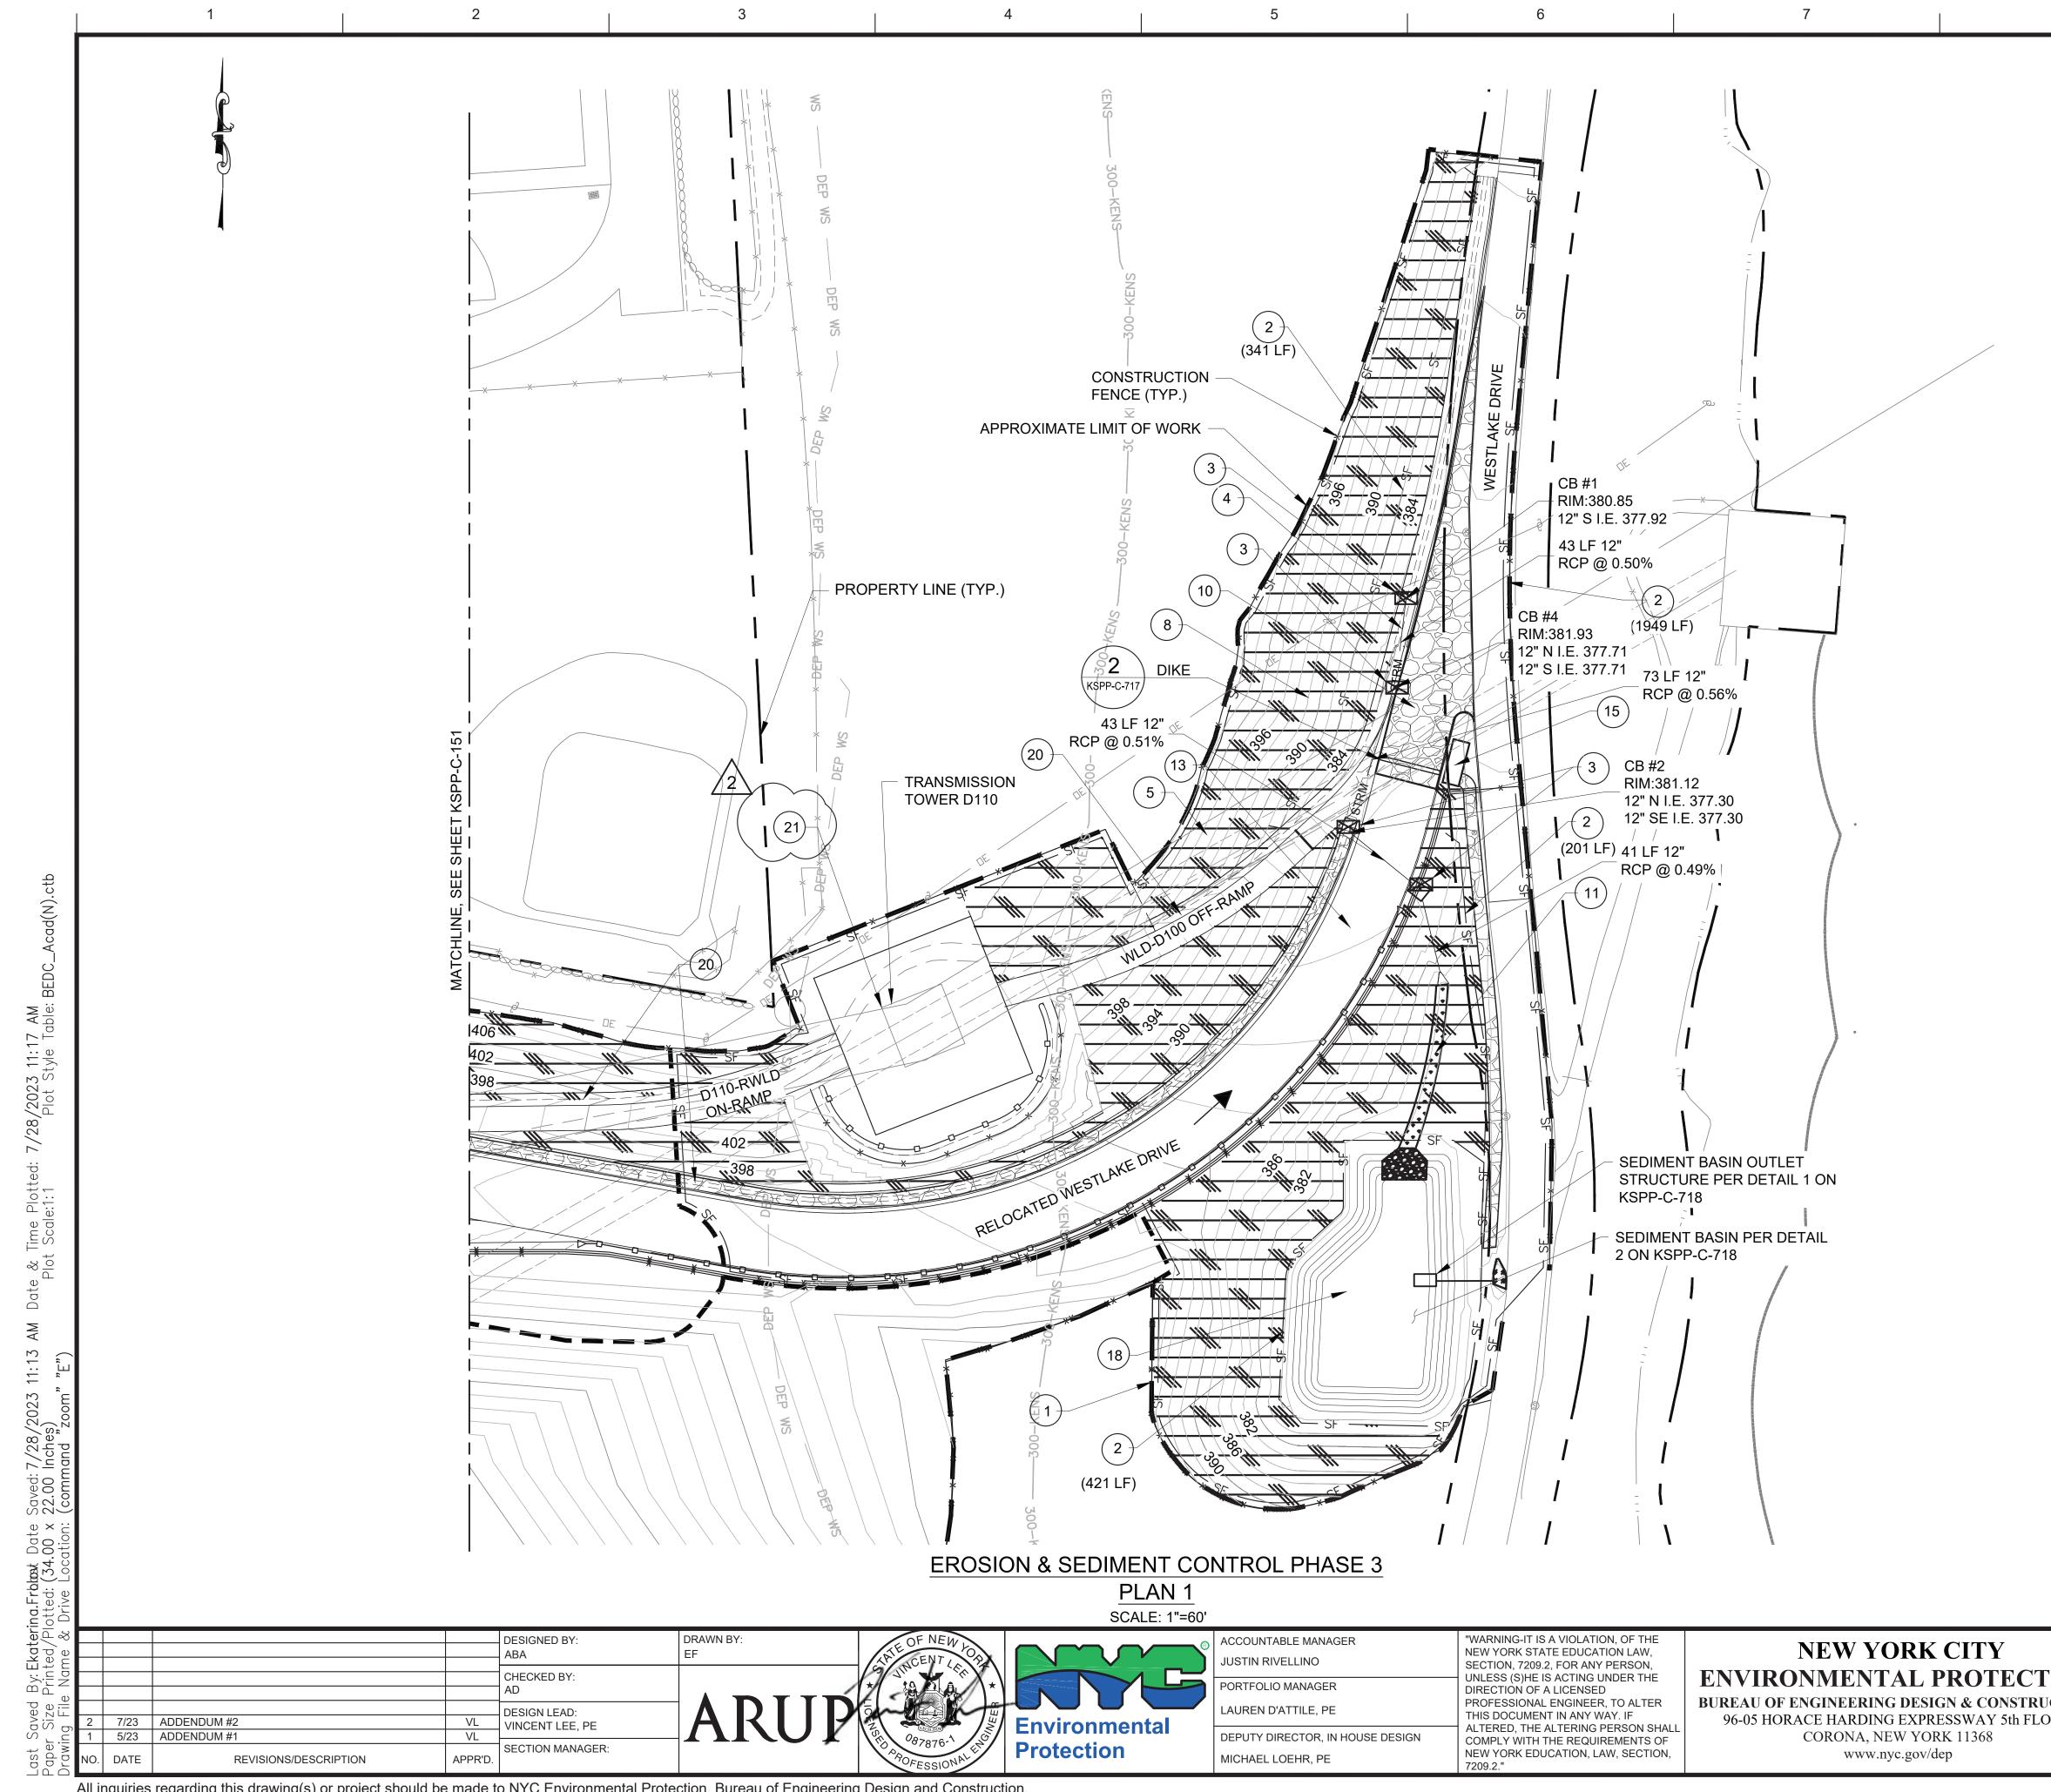

96-05 HORACE HARDING EXPRESSWAY 5th FLO

8	9 10	_
	EROSION AND SEDIMENT CONTROL PRACTICE LEGEND ESTABLISH LIMIT OF DISTURBANCE AND TREE PROTECTION. CONTRACTOR TO LIMIT DISTURBANCE TO NO MORE THAN 5 ACRES AT A	
	TIME REGARDLESS OF LOCATION. 2 INSTALL SILT FENCE PER DETAIL 1 ON DWG KSPP-C-710.	
	(4) INSTALL DRAINAGE PIPES AND CATCH BASINS AS SHOWN ON THE DRAINAGE PLANS WITH INLET PROTECTION PER DETAIL 4 ON DWG	4
	KSPP-C-710. 5 PROVIDE TREE REMOVAL, CLEARING AND GRUBBING.	
	 (6) MASS EXCAVATION OF SCREEN CHAMBER AREA. (7) GRADE CATSKILL STAGING AREA. 	_
	 8 INSTALL EROSION CONTROL MATTING FOR DISTURBED AREAS PER DETAIL 2 ON DWG KSPP-C-712. 	
	9 INSTALL UTILITIES (PARTIALLY) PER UTILITY PLANS.	
	 (10) INSTALL CONSTRUCTION ENTRANCE PER DETAIL 2 ON DWG KSPP-C-711. (11) CONSTRUCT VEGETATED SWALE PER DETAIL 1 ON DWG C-721. 	
	 CONSTRUCT RELOCATED WESTLAKE DR/CATSKILL SEDIMENTATION BASIN PER DETAILS ON DWG C-730. 	3
	(13) MASS EXCAVATION OF RELOCATED WESTLAKE DRIVE.	
	(14) CONSTRUCT CATSKILL POND PER DETAILS ON DWG C-732.	
	(15) PROVIDE TRUCK WASH AND CONCRETE TRUCK WASH IN ACCORDANCE WITH THE NYSDEC BLUE BOOK.	-
	(16) GRADE DELAWARE AREA AND CONSTRUCT OPERATIONS ENTRANCE ROAD. CONTRACTOR TO TURN OVER CONTROL TO OPERATIONS AFTER COMPLETION AND INSTALLATION OF JERSEY BARRIERS.	
	(17) CONSTRUCT DELAWARE POND PER DETAILS ON DWG C-734.	
	(18) CONSTRUCT SEDIMENT BASIN AND CONVERT IT TO BIORETENTION FACILITY PER DETAILS ON DWG C-725 AFTER COMPLETION OF RELOCATED WESTLAKE DRIVE.	С
^	(19) MASS EXCAVATION OF ELECTRICAL BUILDING.	
/2	(20) CONSTRUCT GRAVEL SWALE PER DETAIL 1 ON DWG KSPP-C-727 (21) CONTRACTOR SHALL VERIFY-IN-FIELD LOCATION OF EXISTING CON	
	EDISON TOWER GROUNDING SYSTEM. IN THE EVENT GROUNDING CABLES CONFLICT WITH FINAL GRADE, THE CONTRACTOR SHALL COORDINATE WITH CON EDISON AND RELOCATE GROUNDING CABLES TO THE REQUIRED DEPTH BELOW FINAL GRADE.	-
	22) RELOCATE OVERHEAD POWER AND TELECOM TO EOH/LAB BUILDING. SEE KSPP-C-142.	
	PHASE LIMIT — — — — — —	
	OVERALL PROJECT LIMIT	C
	SILT FENCE (2605-FT) SF	
	FLOW LINE EROSION CONTROL MATTING	
	RIP-RAP	-
	NOTES: 1. CONTRACTOR SHALL CONDUCT EARTHWORK CONSTRUCTION FOR EACH PHASE AS FOLLOWS:	
	 CLEAN AND GRUB THE AREA OF EACH PHASE REMOVE AND STOCKPILE 12" TOPSOIL PERFORM EARTHWORK AND GRADING OPERATIONS PER THE GRADING SHOWN FOR EACH PHASE 	
	1.4 INSTALL PLANTINGS AS SHOWN IN KSPP-L DRAWINGS.	Ξ
	TO BE SEEDED. 3. CONTRACTOR SHALL	
	PERIODICALLY INSPECT ALL DRAINAGE STRUCTURES AND FEATURES AND	
	REMOVE SEDIMENT AND SILT. 4. CONTRACTOR TO EMPLOY	_
	4. CONTRACTOR TO EMPLOY WATER BARS ALONG RELOCATED WESTLAKE DRIVE DURING	
	CONSTRUCTION KEY PLAN	
	 0 40 80 FT. F	_
í	1"=40' GRAPHIC SCALES VERTICAL DATUM CHECK BEFORE USE VERTICAL DATUM	
	ADDENDUM NO. 2 IF SHEET IS LESS THAN 22" X 34"	
	DATE ISSUED: 07/2023 IT IS A REDUCED PRINT. SCALE ACCORDINGLY 0 NAVD88	_
ION	CONTRACT KENS-EAST-2 KENSICO SITE PREPARATIONDATE: JULY 2023SCALE: AS NOTEDSHEET NO:	
CTION OOR	CIVIL	
	SOIL EROSION & SEDIMENT CONTROL PLAN PHASE 3 PLAN 1 DRAWING NO. KSPP-C-153.02	
	PHASE 3 PLAN 1 KSPP-C-153.02	

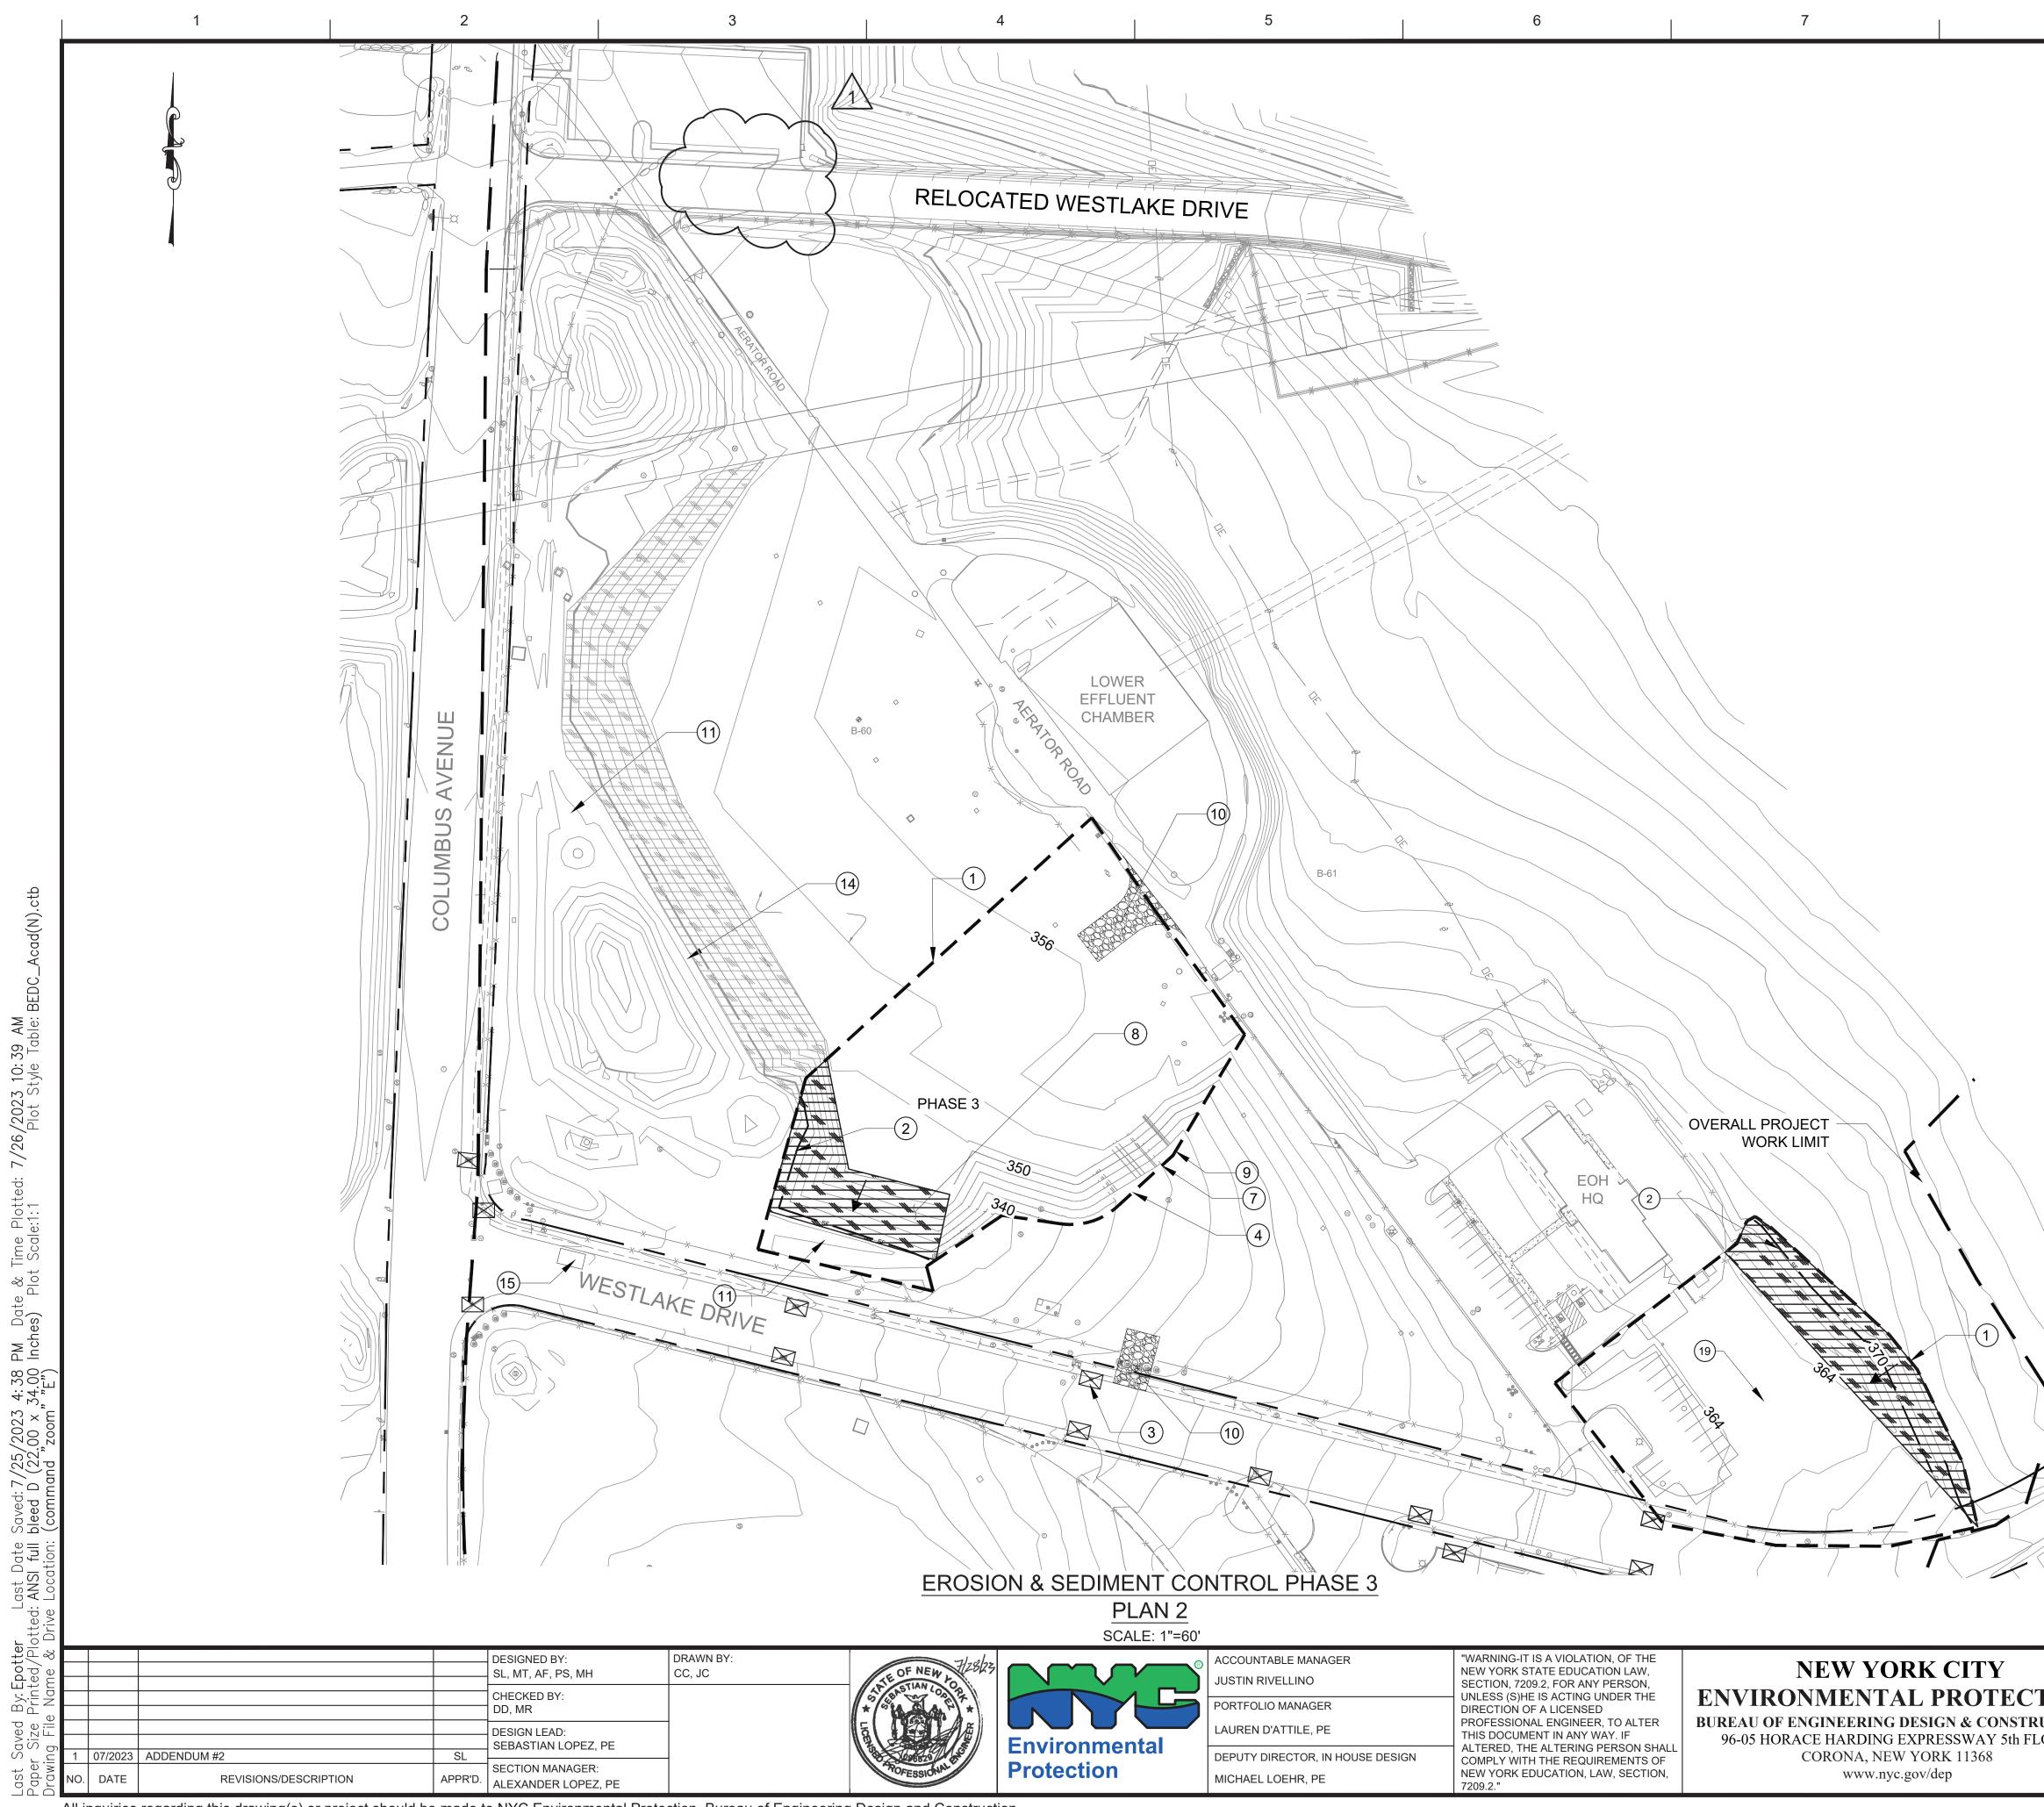

10


EROSION AND SEDIMENT CONTROL PRACTICE LEGEND

- 1 ESTABLISH LIMIT OF DISTURBANCE. CONTRACTOR TO LIMIT DISTURBANCE TO NO MORE THAN 3 ACRES AT A TIME REGARDLESS OF LOCATION.
- (2) INSTALL SILT FENCE PER DETAIL 1 ON DWG KSPP-C-710.
- (3) INSTALL INLET PROTECTION PER DETAIL 4 ON DWG KSPP-C-710.
- (4) INSTALL DRAINAGE PIPES AND CATCH BASINS AS SHOWN ON THE DRAINAGE PLANS WITH INLET PROTECTION PER DETAIL 4 ON DWG KSPP-C-710.
- (5) PROVIDE TREE REMOVAL, CLEARING AND GRUBBING.
- (6) MASS EXCAVATION OF SCREEN CHAMBER AREA
- (7) GRADE CATSKILL STAGING AREA.
- 8 INSTALL EROSION CONTROL MATTING FOR DISTURBED AREAS PER DETAIL 2 ON DWG KSPP-C-712.
- (9) INSTALL UTILITIES (PARTIALLY) PER UTILITY PLAN.
- (10) INSTALL CONSTRUCTION ENTRANCE PER DETAIL 2 ON DWG KSPP-C-711.
- (11) CONSTRUCT VEGETATED SWALE PER DETAIL 1 ON DWG KSPP-C-721.
- (12) CONSTRUCT RELOCATED WESTLAKE DRIVE POND PER DETAILS ON DWG KSPP-C-730.
- (13) MASS EXCAVATION OF RELOCATED WESTLAKE DRIVE.
- (14) CONSTRUCT CATSKILL POND PER DETAILS ON DWG KSPP-C-732.
- 15 PROVIDE TRUCK WASH AND CONCRETE TRUCK WASH IN ACCORDANCE WITH THE NYSDEC BLUE BOOK.
- (16) GRADE DELAWARE AREA AND CONSTRUCT OPERATIONS ENTRANCE ROAD. CONTRACTOR TO TURN OVER CONTROL TO OPERATIONS AFTER COMPLETION AND INSTALLATION OF JERSEY BARRIERS.
- (17) CONSTRUCT DELAWARE POND PER DETAILS ON DWG KSPP-C-734.
- (18) CONSTRUCT BIORETENTION FACILITY PER DETAILS ON DWG KSPP-C-725.
- (19) MASS EXCAVATION OF ELECTRICAL BUILDING.
- (20) CONSTRUCT GRAVEL SWALE PER DETAIL 2 ON DWG KSPP-C-721.

LEGEND

PHASE LIMITS **OVERALL PROJECT LIMI** SILT FENCE (410-FT) INLET PROTECTION FLOW LINE


EROSION CONTROL MATTING

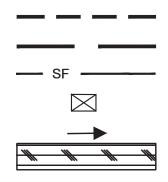

CONTRACTOR SHALL CONDUCT EARTHWORK CONSTRUCTION FOR EACH PHASE AS FOLLOWS:

- CLEAN AND GRUB THE AREA OF EACH PHASE.
- REMOVE AND STOCKPILE 12" TOPSOIL FOR REUSE.
- PERFORM EARTHWORK AND GRADING OPERATIONS PER THE GRADING SHOWN FOR EACH PHASE. 3.
- INSTALL PLANTINGS AS SHOWN IN KSPP-L DRAWINGS.

		0 60 1"=60'	0	120 FT.	F
	ADDENDUM NO. 2 DATE ISSUED: 07/2023	GRAPHIC SCALES CHECK BEFORE USE		VERTICAL DATUM CONVERSION (ft)	
		IF SHEET IS LESS THAN 22" X 34" IT IS A REDUCED PRINT. SCALE ACCORDINGLY		+1.28 BWS 0 NAVD88	
	CONTRACT KENS-EAST-2			DATE: APRIL 2023	
	KENSICO SITE PREPARATION CIVIL SOIL EROSION & SEDIMENT CONTROL PHASE 3		SCALE: AS NOTED		
ΓΙΟΝ			SHEET NO:		
UCTION					
OOR			DRAWING NO.		
			KSPP-C-154.01		

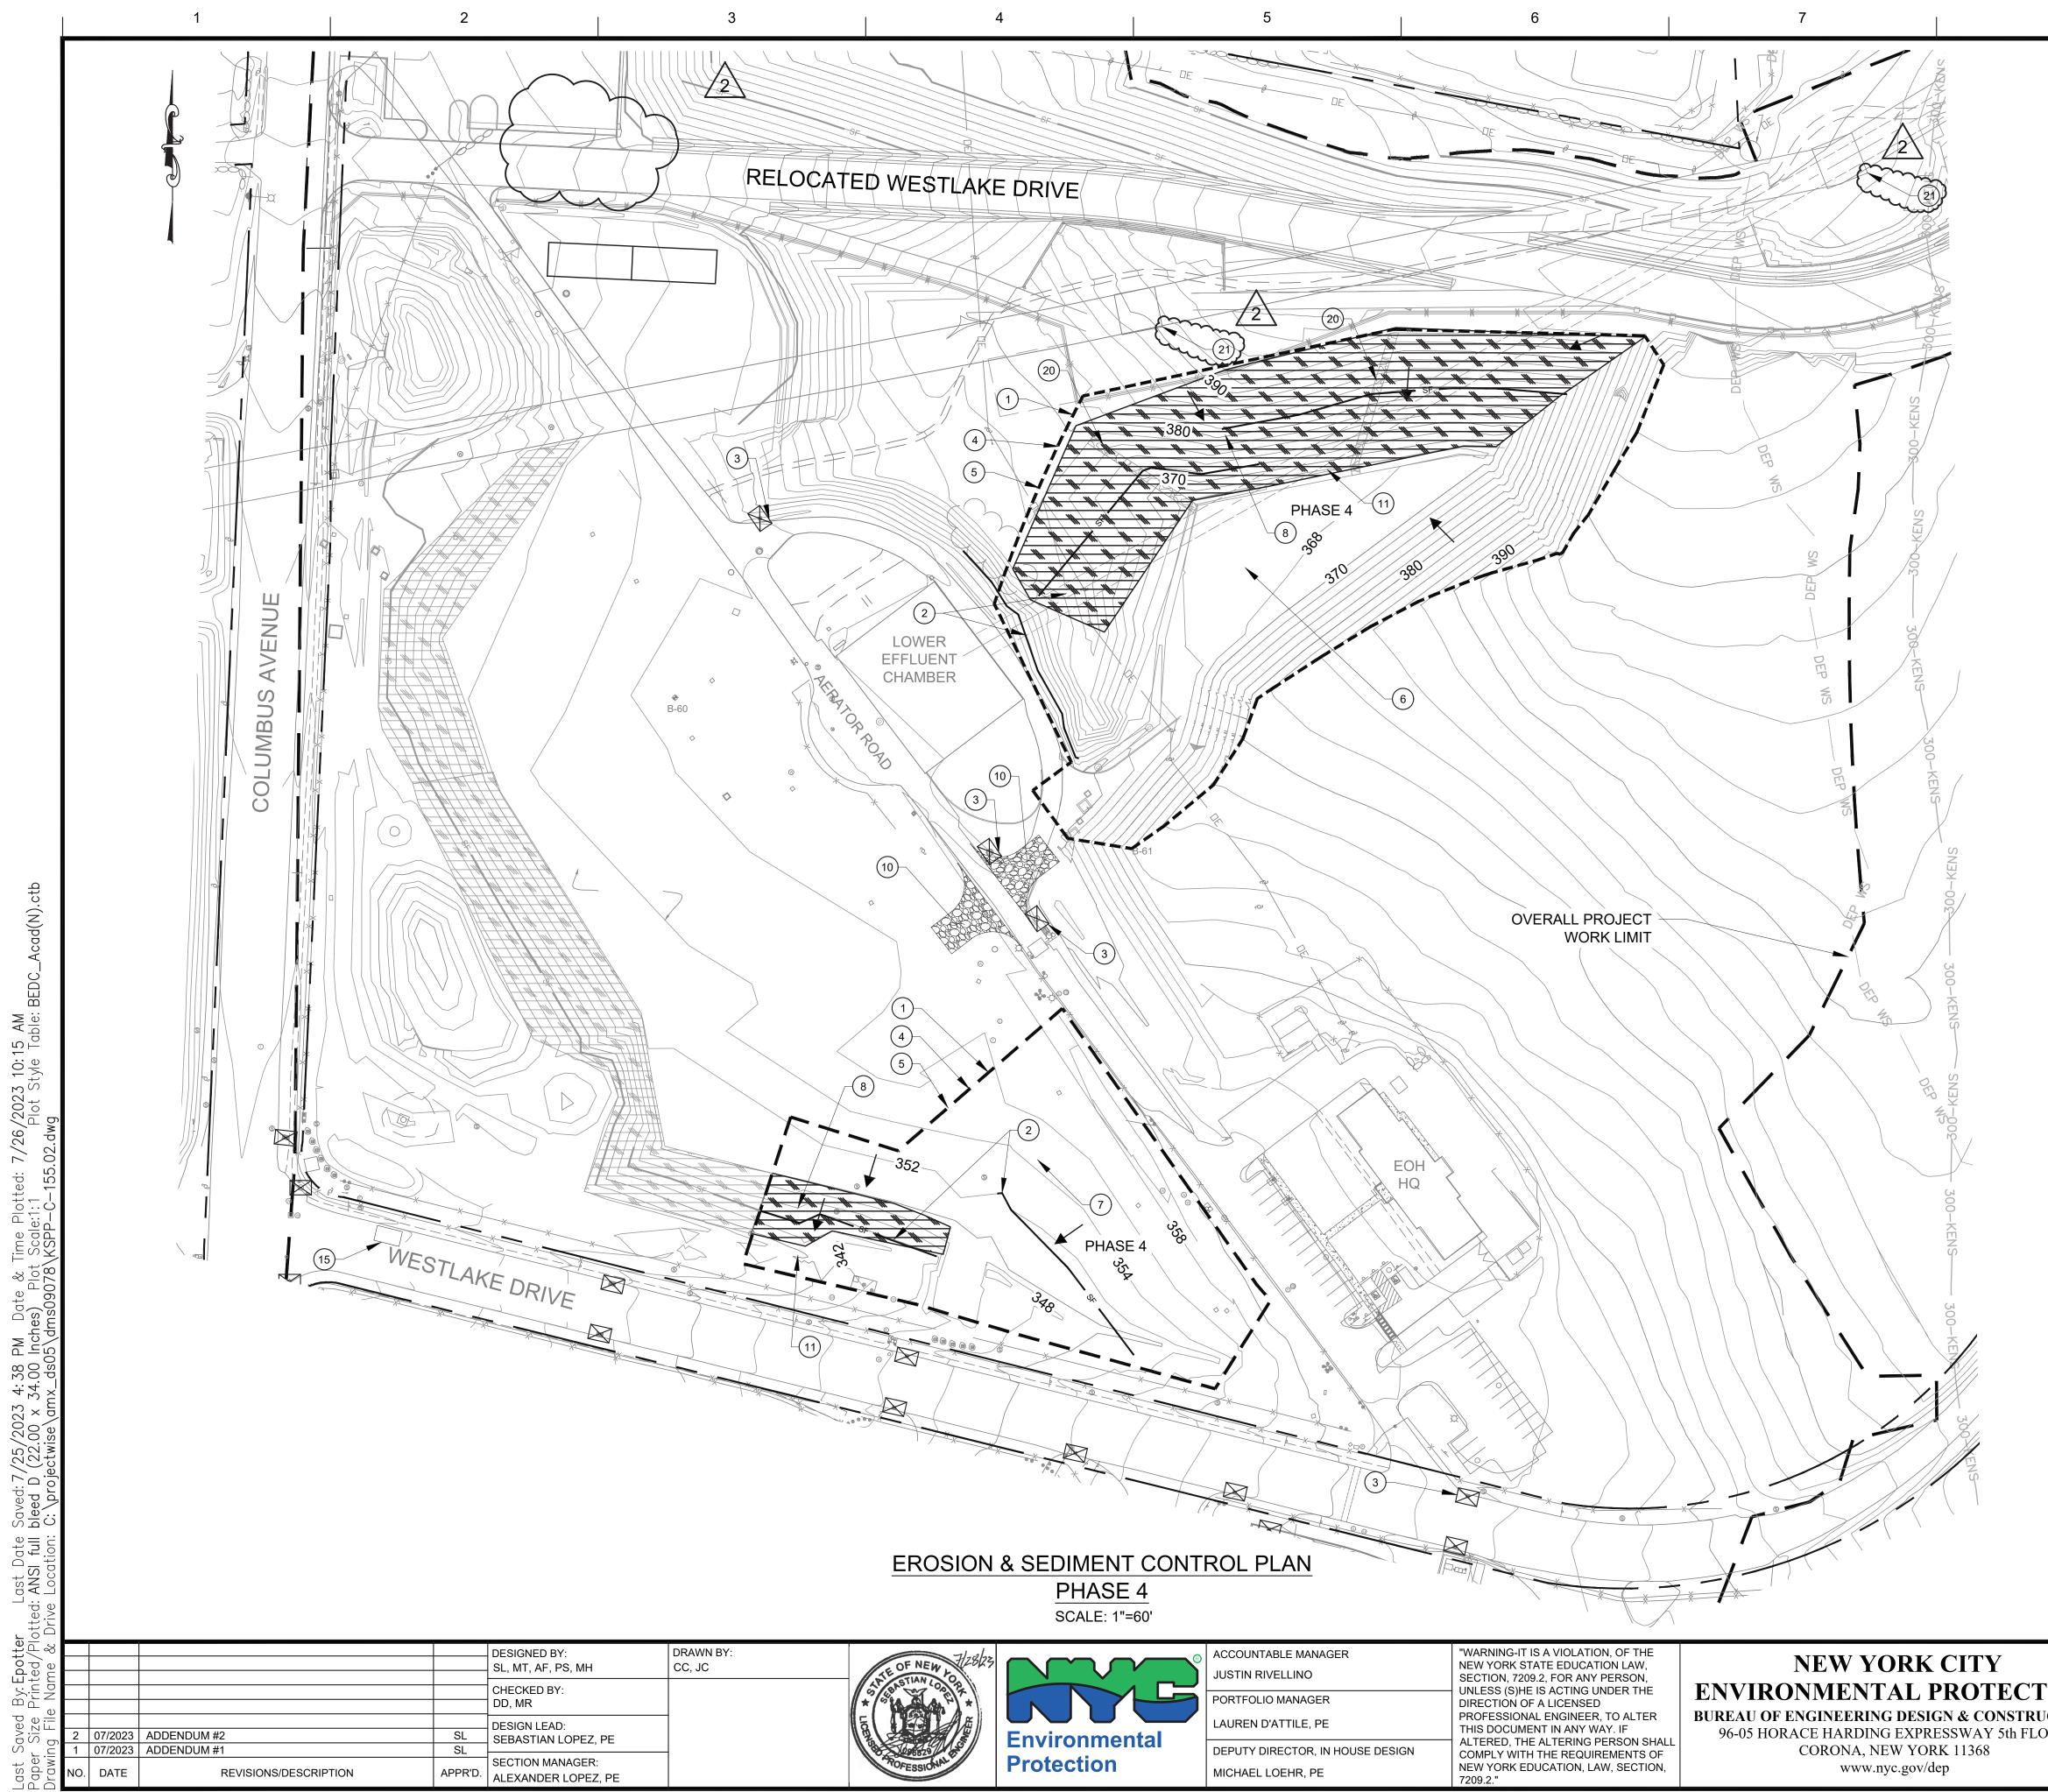

10

|--|

1	ESTABLISH LIMIT OF DISTURBANCE. CONTRACTOR TO LIMIT DISTURBANCE TO NO MORE THAN 3 ACRES AT A TIME REGARDLESS OF LOCATION.
2	INSTALL SILT FENCE PER DETAIL 1 ON DWG KSPP-C-710.
3	INSTALL INLET PROTECTION PER DETAIL 4 ON DWG KSPP-C-710.
4	INSTALL DRAINAGE PIPES AND CATCH BASINS AS SHOWN ON THE DRAINAGE PLANS WITH INLET PROTECTION PER DETAIL 4 ON DWG KSPP-C-710.

- (5) PROVIDE TREE REMOVAL, CLEARING AND GRUBBING.
- (6) MASS EXCAVATION OF SCREEN CHAMBER AREA.
- (7) GRADE CATSKILL STAGING AREA.
- (8) INSTALL EROSION CONTROL MATTING FOR DISTURBED AREAS PER DETAIL 2 ON DWG KSPP-C-712.
- (9) INSTALL UTILITIES (PARTIALLY) PER UTILITY PLAN.
- (10) INSTALL CONSTRUCTION ENTRANCE PER DETAIL 2 ON DWG KSPP-C-711.
- (11) CONSTRUCT VEGETATED SWALE PER DETAIL 1 ON DWG KSPP-C-721.
- (12) CONSTRUCT RELOCATED WESTLAKE DRIVE POND PER DETAILS ON DWG KSPP-C-730.
- $(\widehat{13})$ MASS EXCAVATION OF RELOCATED WESTLAKE DRIVE.
- (14) CONSTRUCT CATSKILL POND PER DETAILS ON DWG KSPP-C-732.
- (15) PROVIDE TRUCK WASH AND CONCRETE TRUCK WASH IN ACCORDANCE WITH THE NYSDEC BLUE BOOK.
- (16) GRADE DELAWARE AREA AND CONSTRUCT OPERATIONS ENTRANCE ROAD. CONTRACTOR TO TURN OVER CONTROL TO OPERATIONS AFTER COMPLETION AND INSTALLATION OF JERSEY BARRIERS.
- (17) CONSTRUCT DELAWARE POND PER DETAILS ON DWG KSPP-C-734.
- (18) CONSTRUCT BIORETENTION FACILITY PER DETAILS ON DWG KSPP-C-725.
- (19) MASS EXCAVATION OF ELECTRICAL BUILDING.
- (20) CONSTRUCT GRAVEL SWALE PER DETAIL 2 ON DWG KSPP-C-721 ă mana a man

21) CONTRACTOR SHALL VERIFY-IN-FIELD LOCATION OF EXISTING CON EDISON TOWER GROUNDING SYSTEM. IN THE EVENT GROUNDING CABLES CONFLICT WITH GRADING, THE CONTRACTOR SHALL COORDINATE WITH CON EDISON AND RELOCATE GROUNDING CABLES TO THE REQUIRED DEPTH BELOW FINAL GRADE.

LEGEND

PHASE LIMITS **OVERALL PROJECT LIMIT** SILT FENCE (740-FT) INLET PROTECTION FLOW LINE **EROSION CONTROL MATTING**


SF

Е

CONTRACTOR SHALL CONDUCT EARTHWORK CONSTRUCTION FOR EACH PHASE AS FOLLOWS:

- CLEAN AND GRUB THE AREA OF EACH PHASE.
- REMOVE AND STOCKPILE 12" TOPSOIL FOR REUSE.
- PERFORM EARTHWORK AND GRADING OPERATIONS PER THE GRADING SHOWN FOR EACH PHASE.
- INSTALL PLANTINGS AS SHOWN IN KSPP-L DRAWINGS. 4

		0 60 1"=60' 1 - 1)	120 FT.	F
	Environmental Protection BEDC/IHD	GRAPHIC SCALES CHECK BEFORE USE		VERTICAL DATUM CONVERSION (ft) +1.28 ⊢ BWS	
	ADDENDUM NO. 2 DATE ISSUED: 07/2023	IF SHEET IS LESS THAN 22" 2 IT IS A REDUCED PRINT SCALE ACCORDINGLY		0 - NAVD88	
	CONTRACT KENS-F	EAST-2	DATE:	APRIL 2023	
	KENSICO SITE PREPARATION		SCALE: AS NOTED		
ION			SHEET	NO:	
CTION DOR	SOIL EROSION & SEDIMENT CONTROL PLAN				
			DRAWING NO.		
			KSPP-C-155.02		

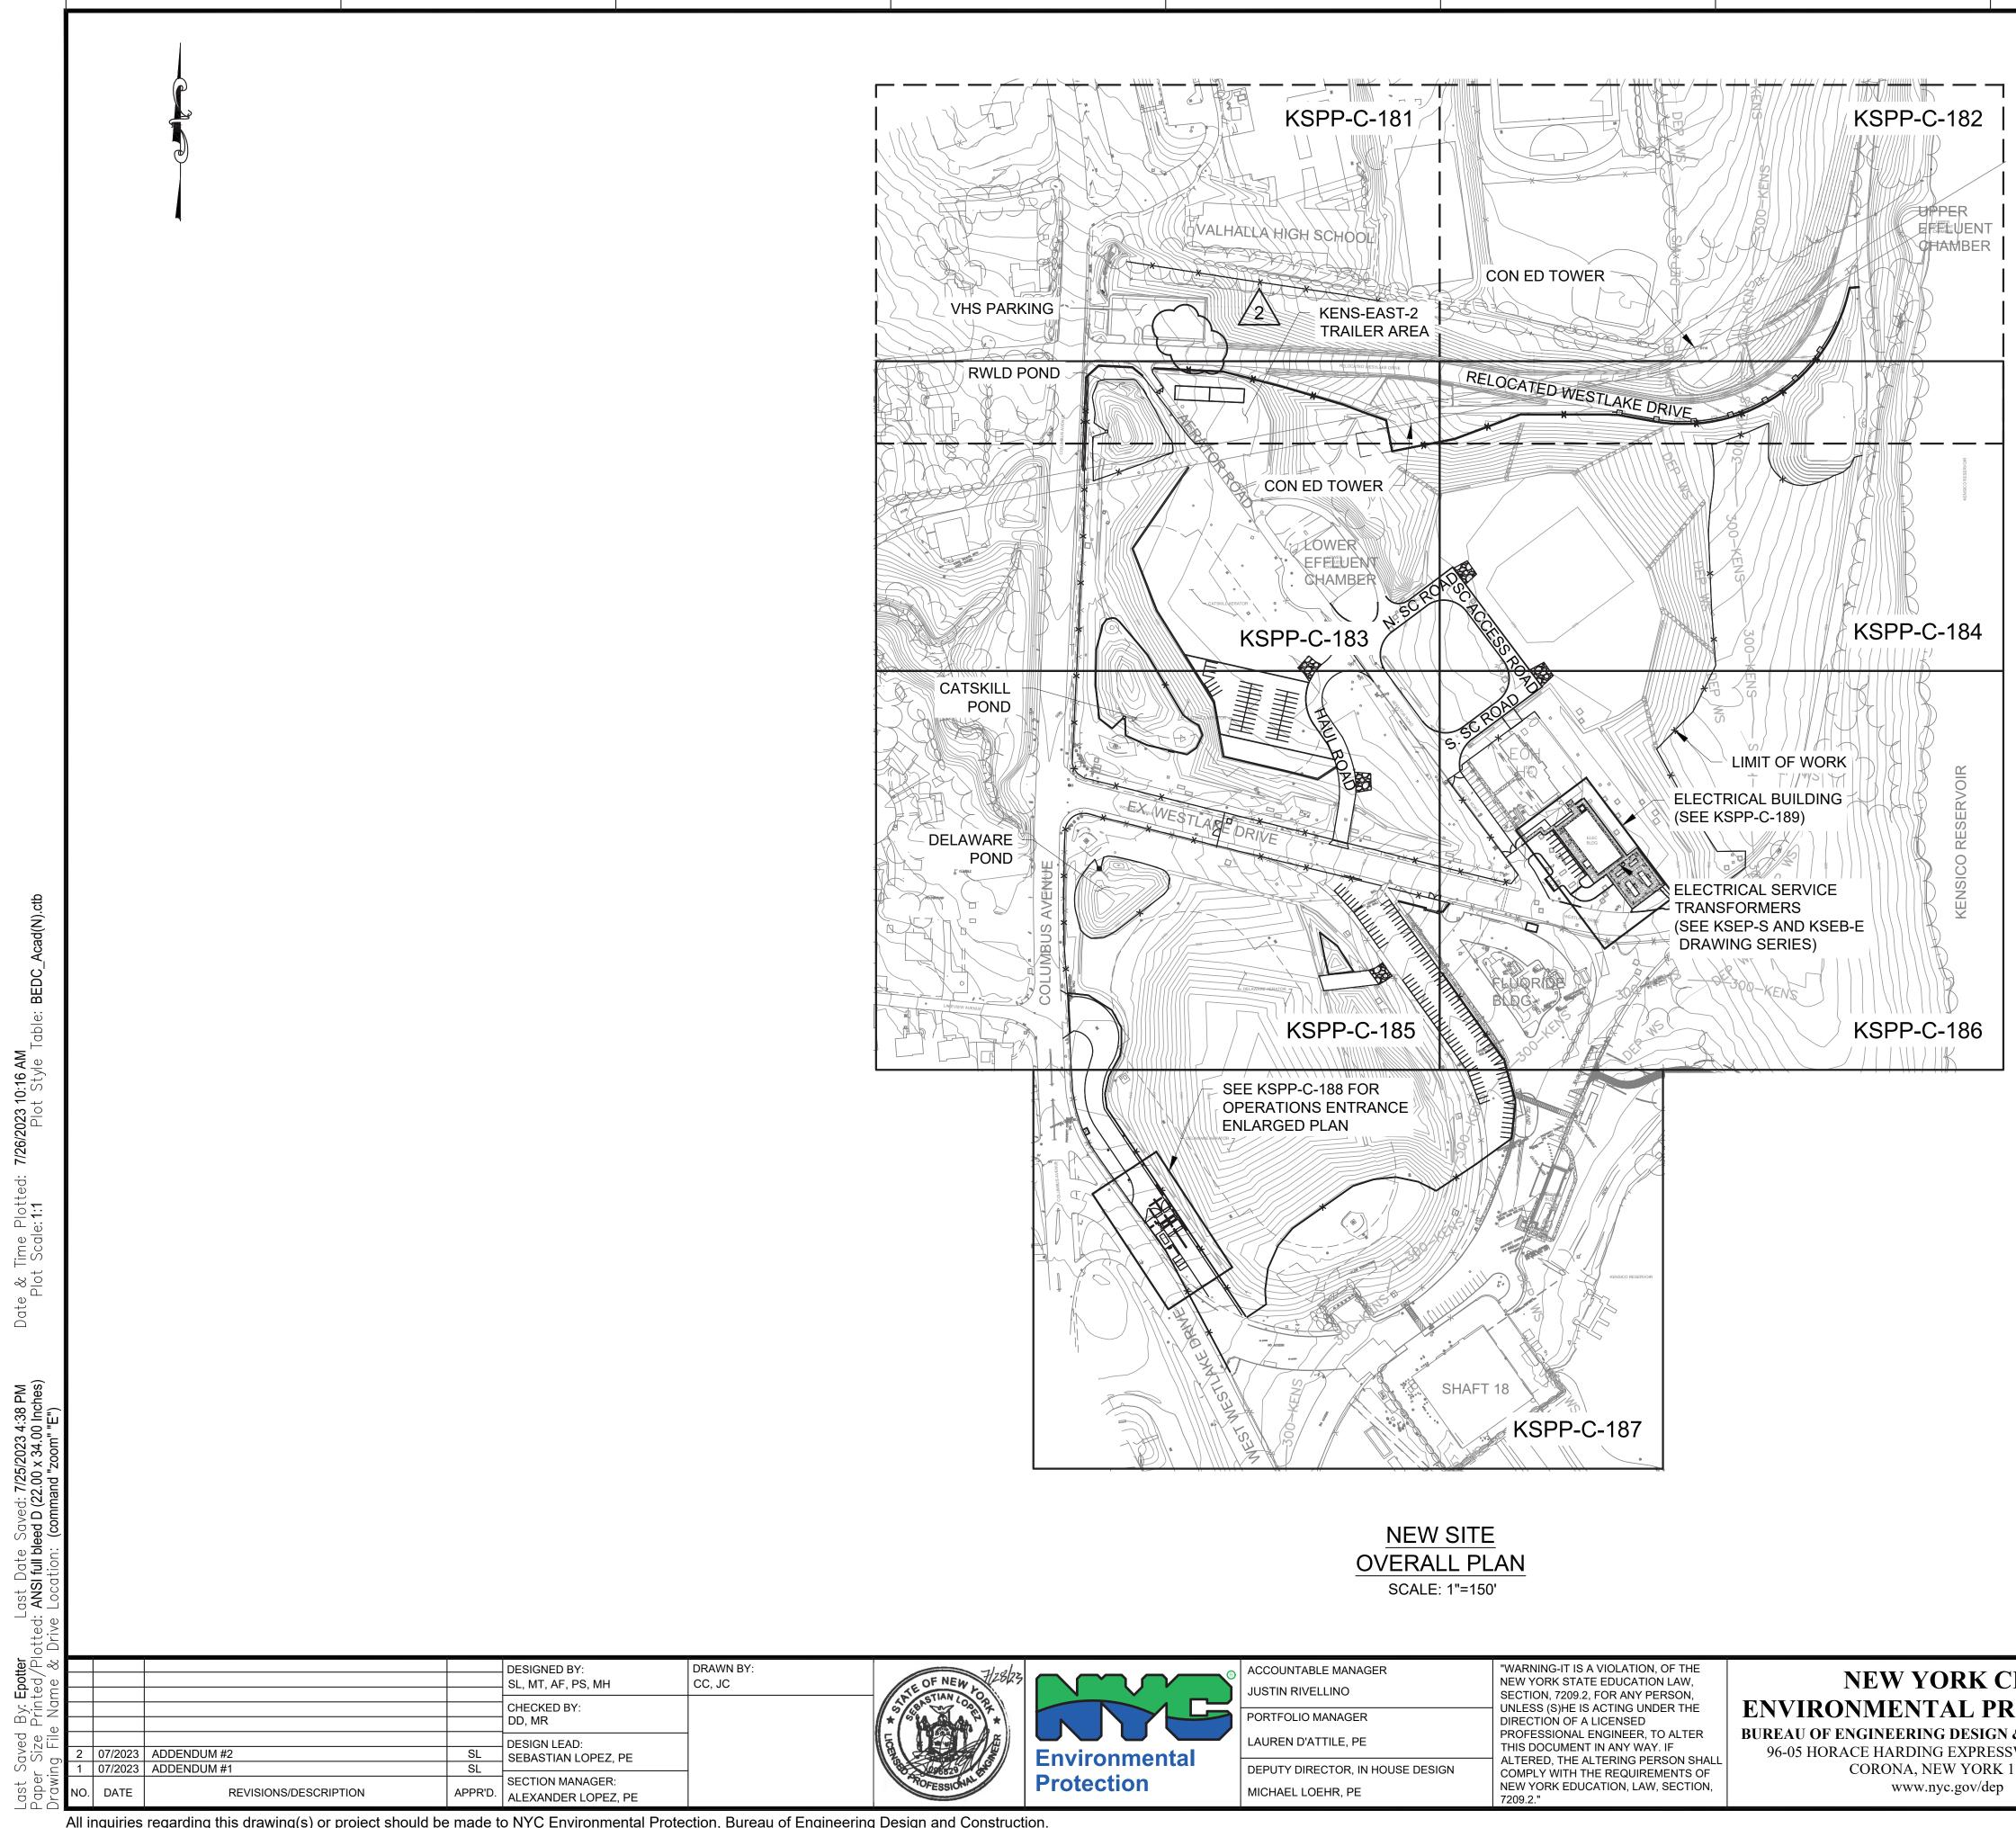

2


R	ACCOUNTABLE MANAGER
	JUSTIN RIVELLINO
	PORTFOLIO MANAGER
	LAUREN D'ATTILE, PE
	DEPUTY DIRECTOR, IN HOUSE DESIG


NEW YORK CITY ENVIRONMENTAL PROTEC BUREAU OF ENGINEERING DESIGN & CONST 96-05 HORACE HARDING EXPRESSWAY 5th Fl CORONA, NEW YORK 11368

					E
		0 15 1"=150'	50	300 FT.	F
	ADDENDUM NO. 2 DATE ISSUED: 07/2023	GRAPHIC SCALES CHECK BEFORE USE IF SHEET IS LESS THAN 22" 2 IT IS A REDUCED PRINT SCALE ACCORDINGLY		VERTICAL DATUM CONVERSION (ft) +1.28 BWS 0 NAVD88	
CTION RUCTION	CONTRACT KENS-F KENSICO SITE PREPA CIVIL		DATE: SCALE: SHEET	APRIL 2023 AS NOTED NO:	
LOOR				ving no. P-C-180.02	


10

D

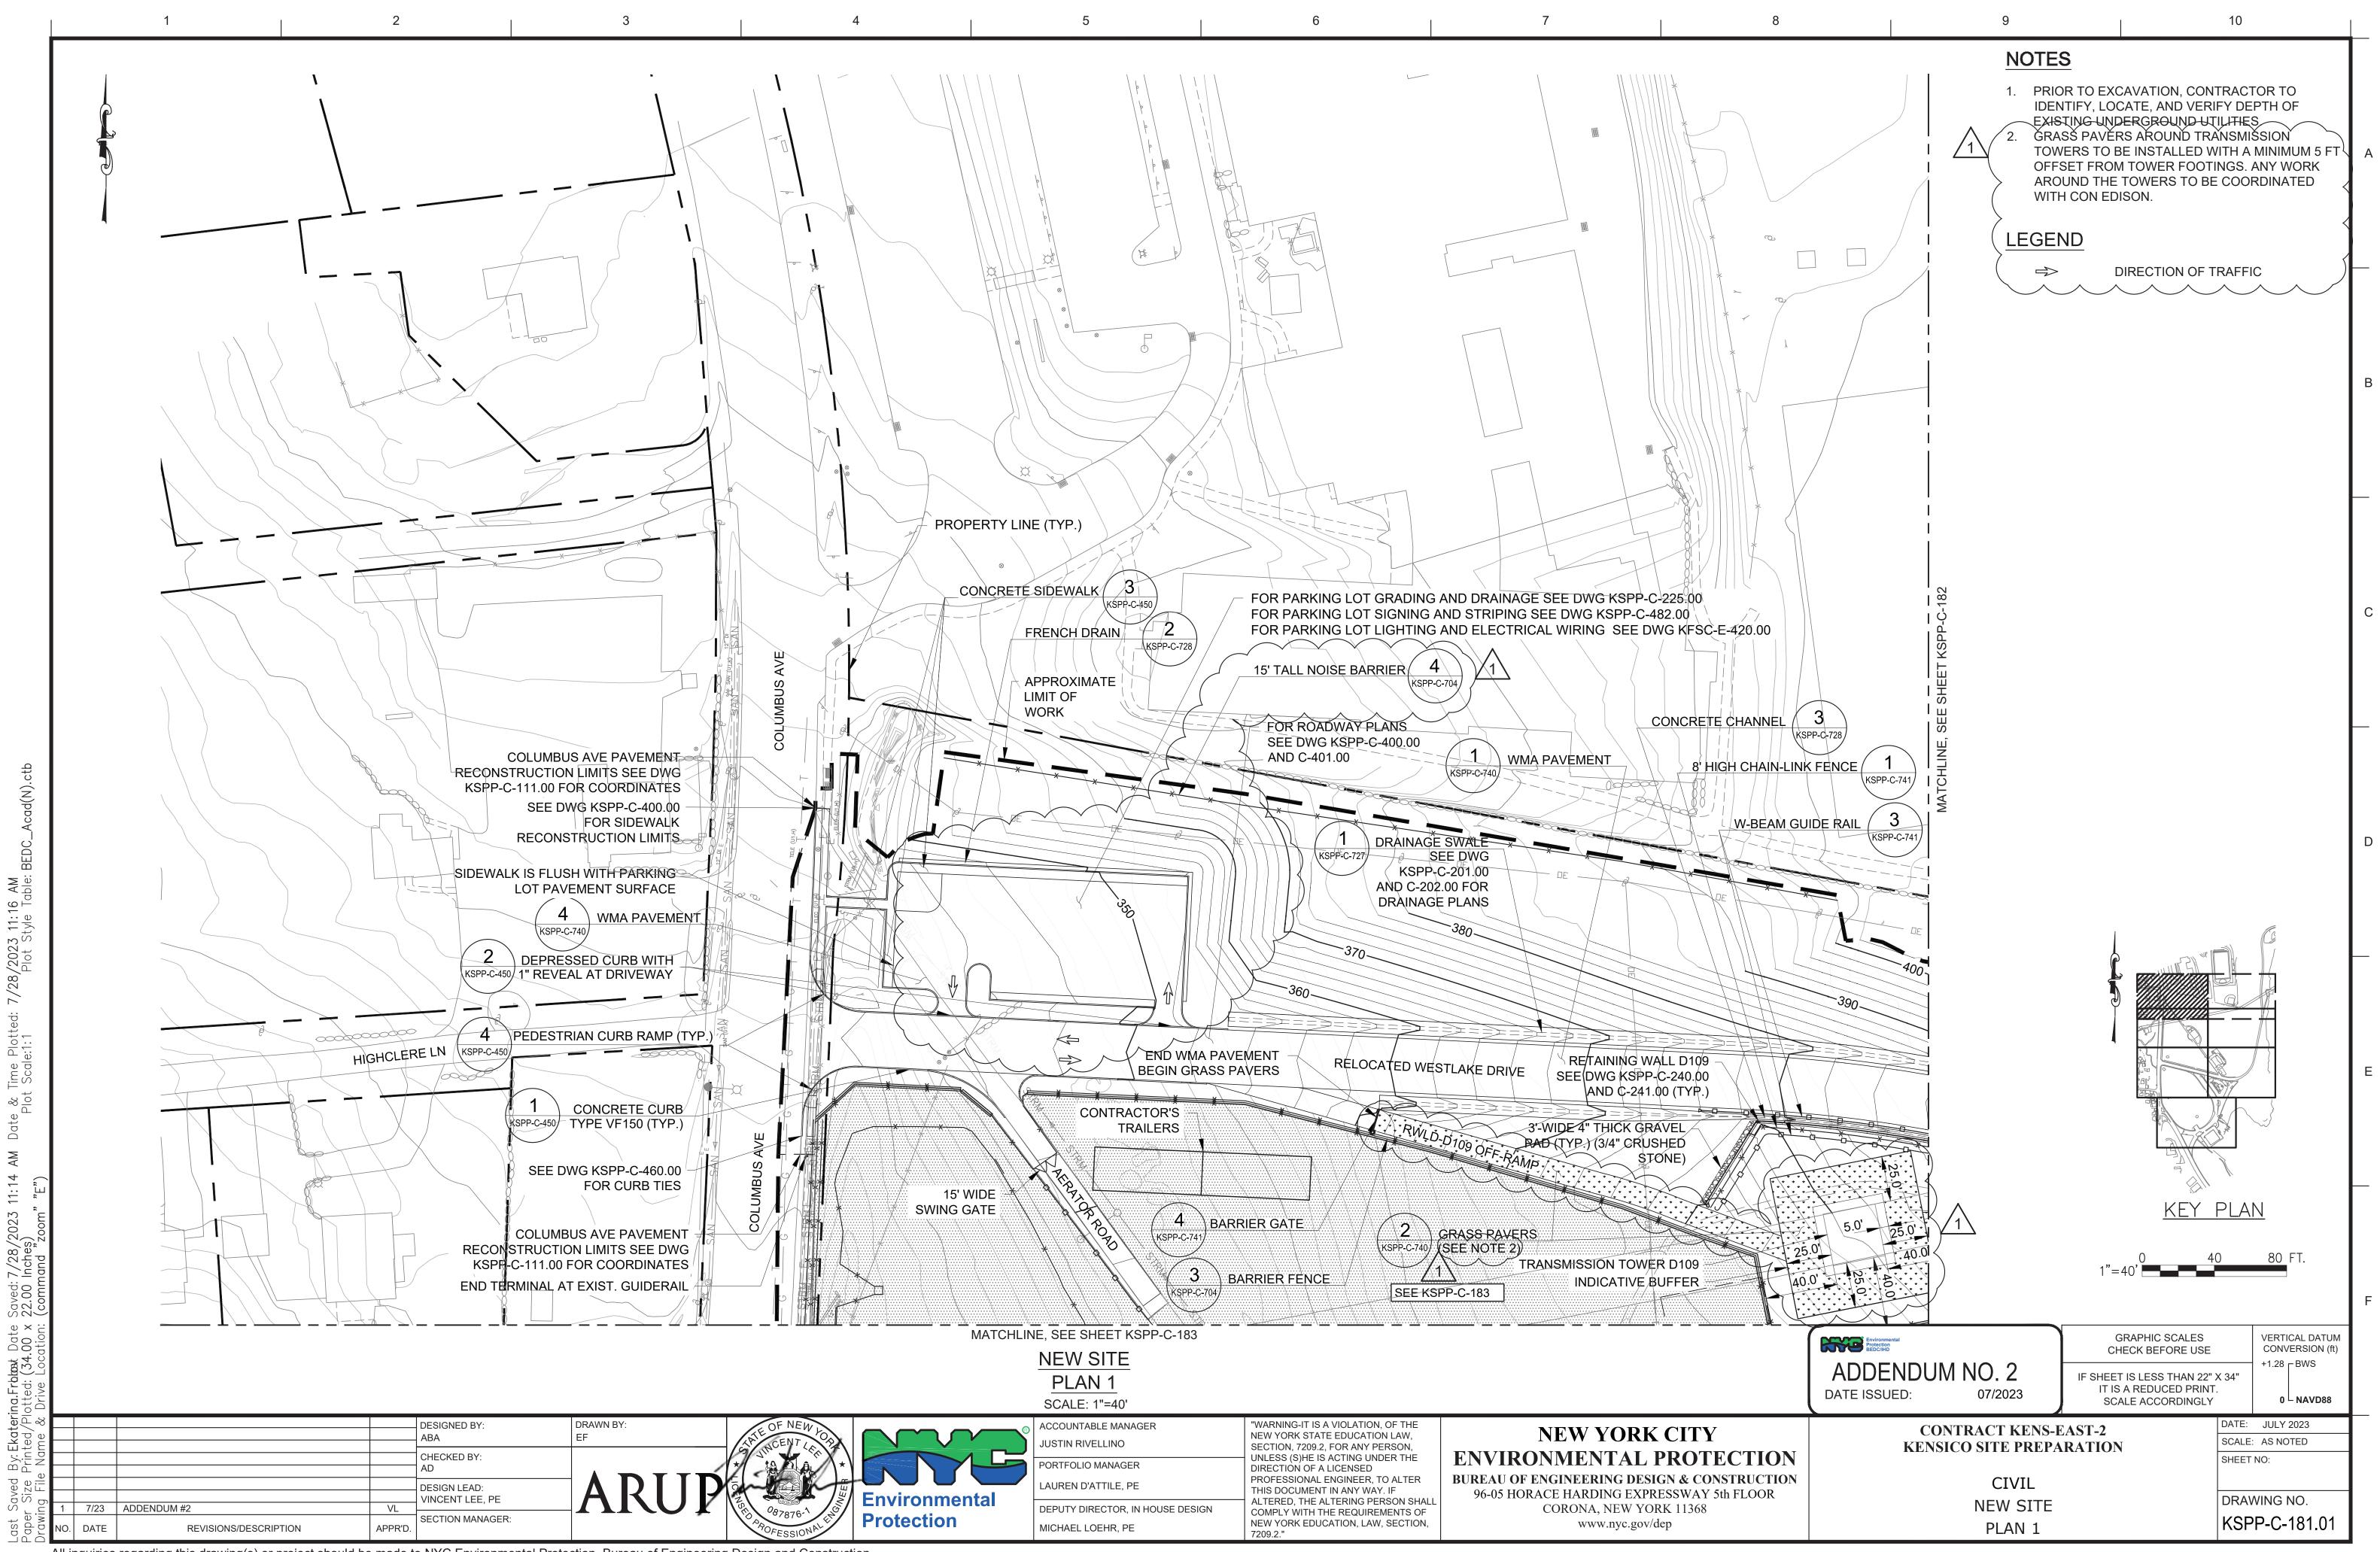


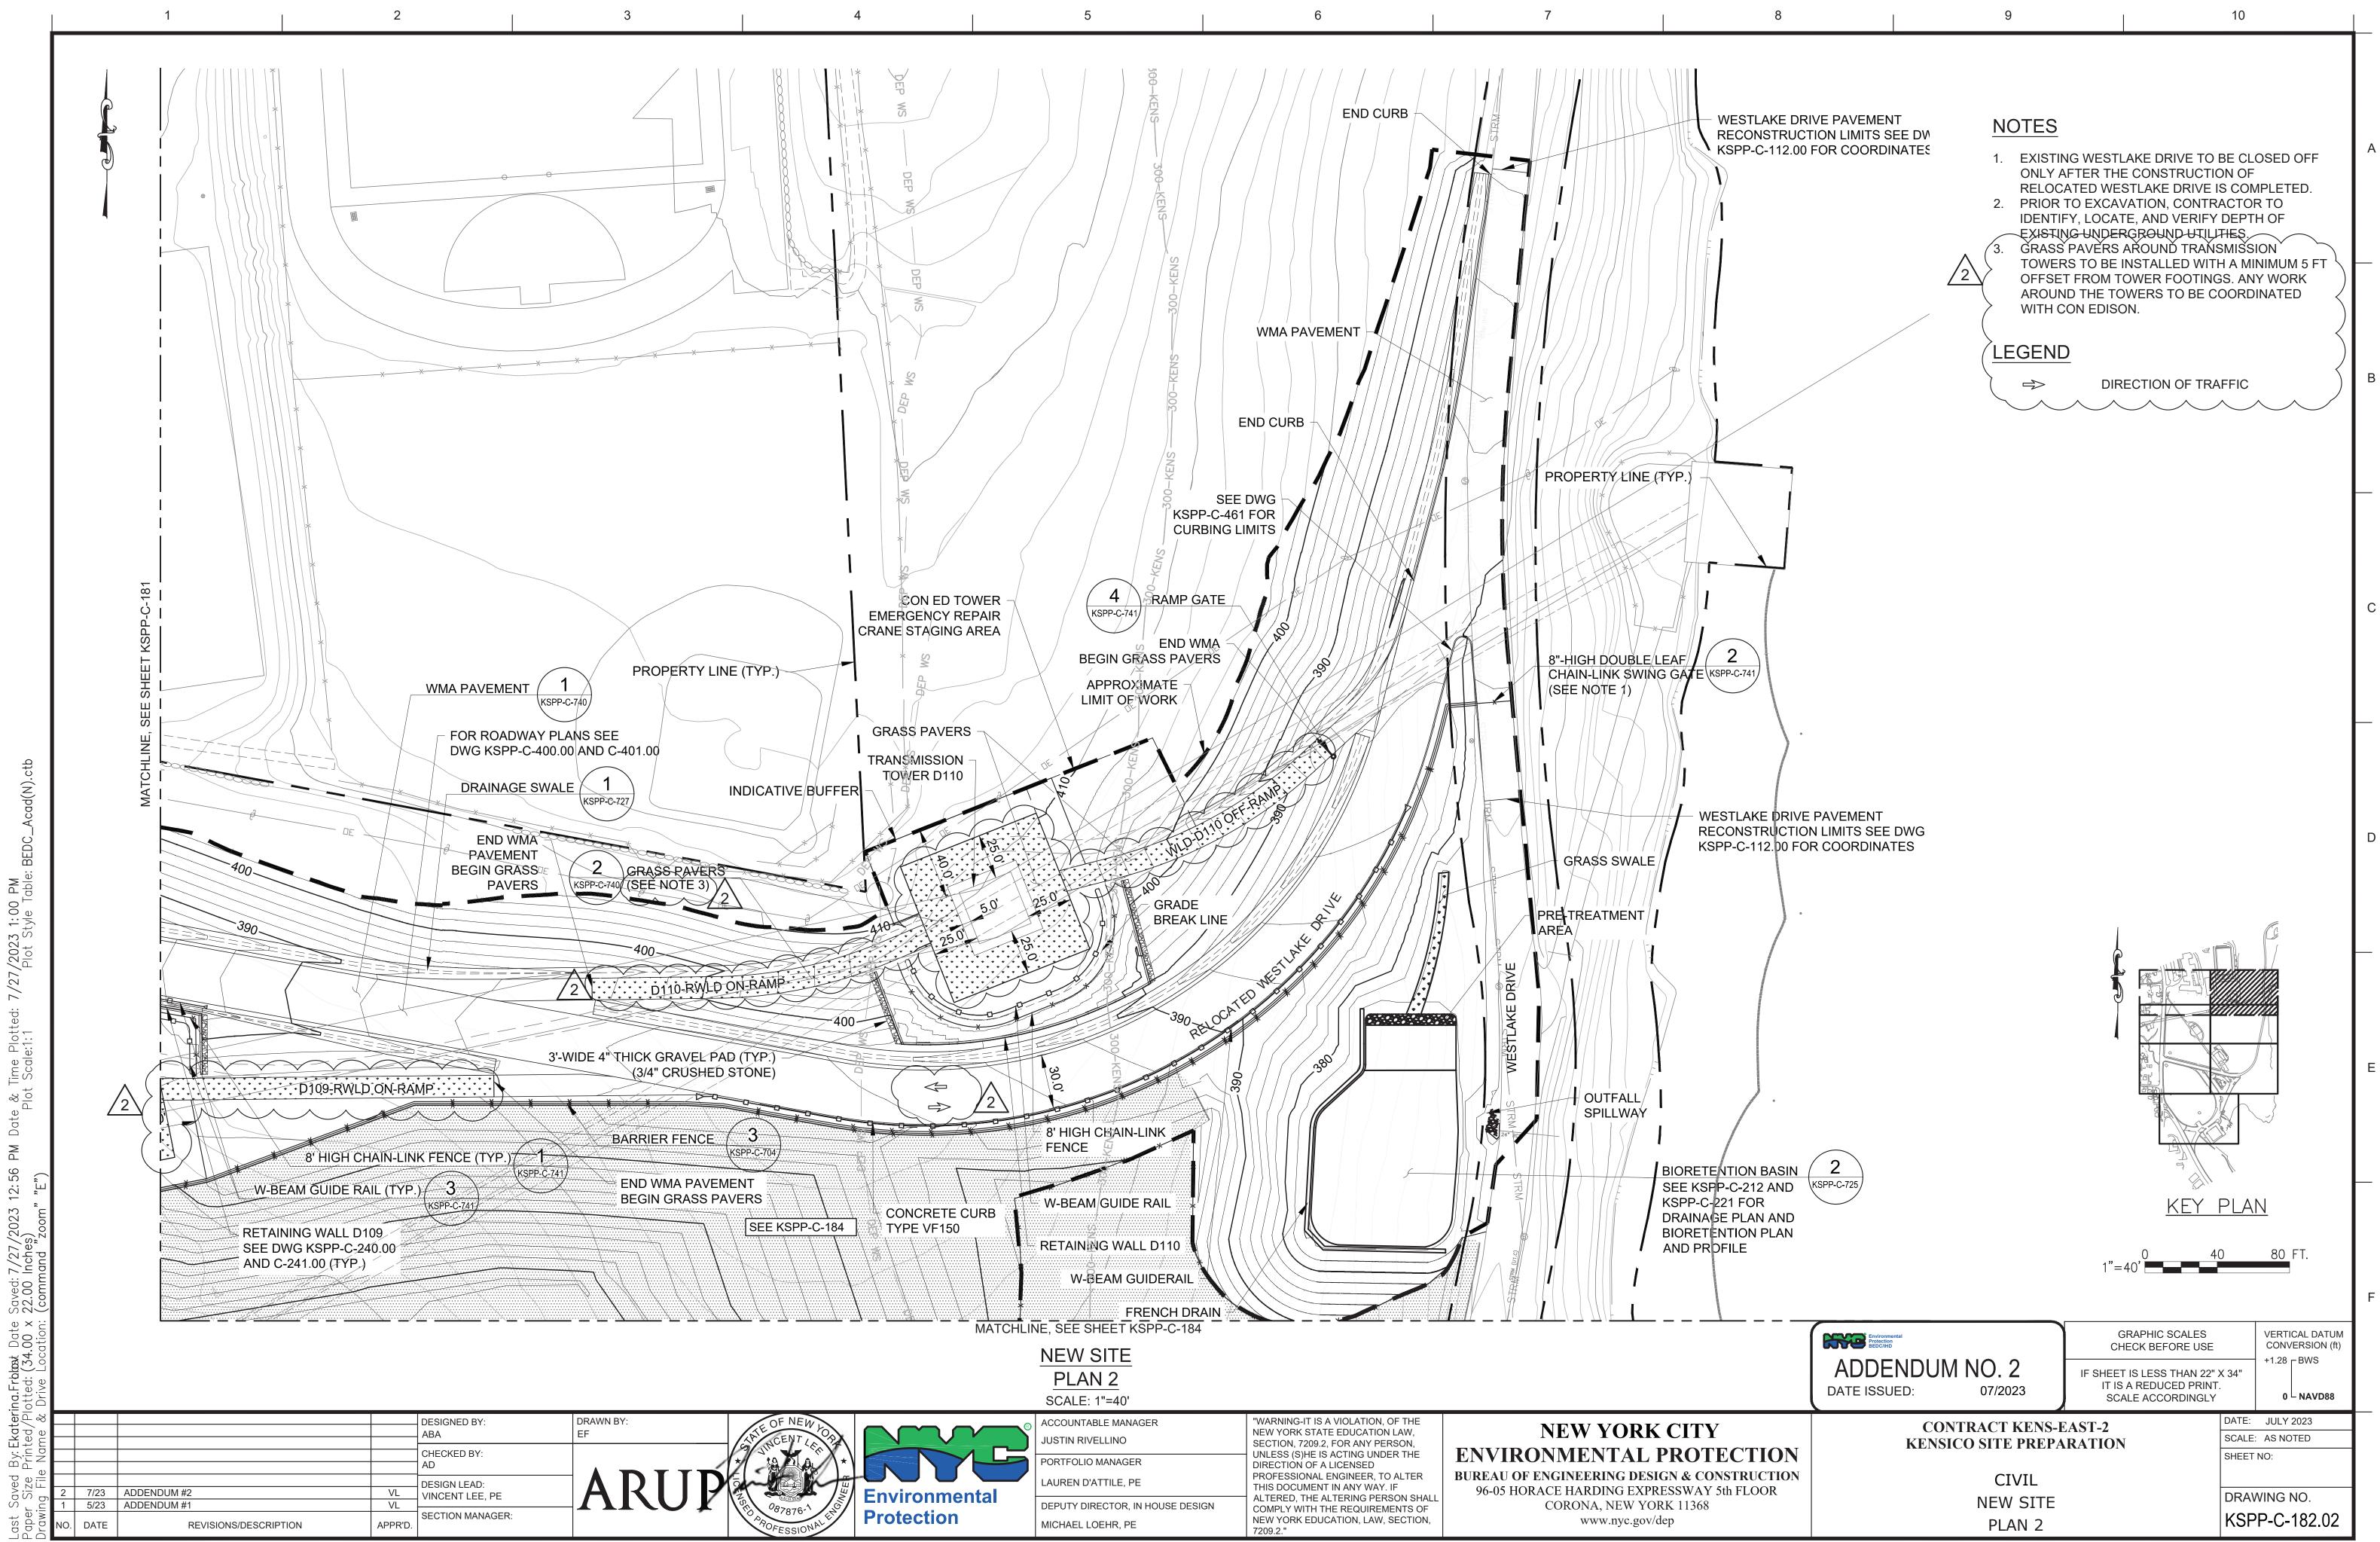

All inquiries regarding this drawing(s) or project should be made to NYC Environmental Protection, Bureau of Engineering Design and Construction.

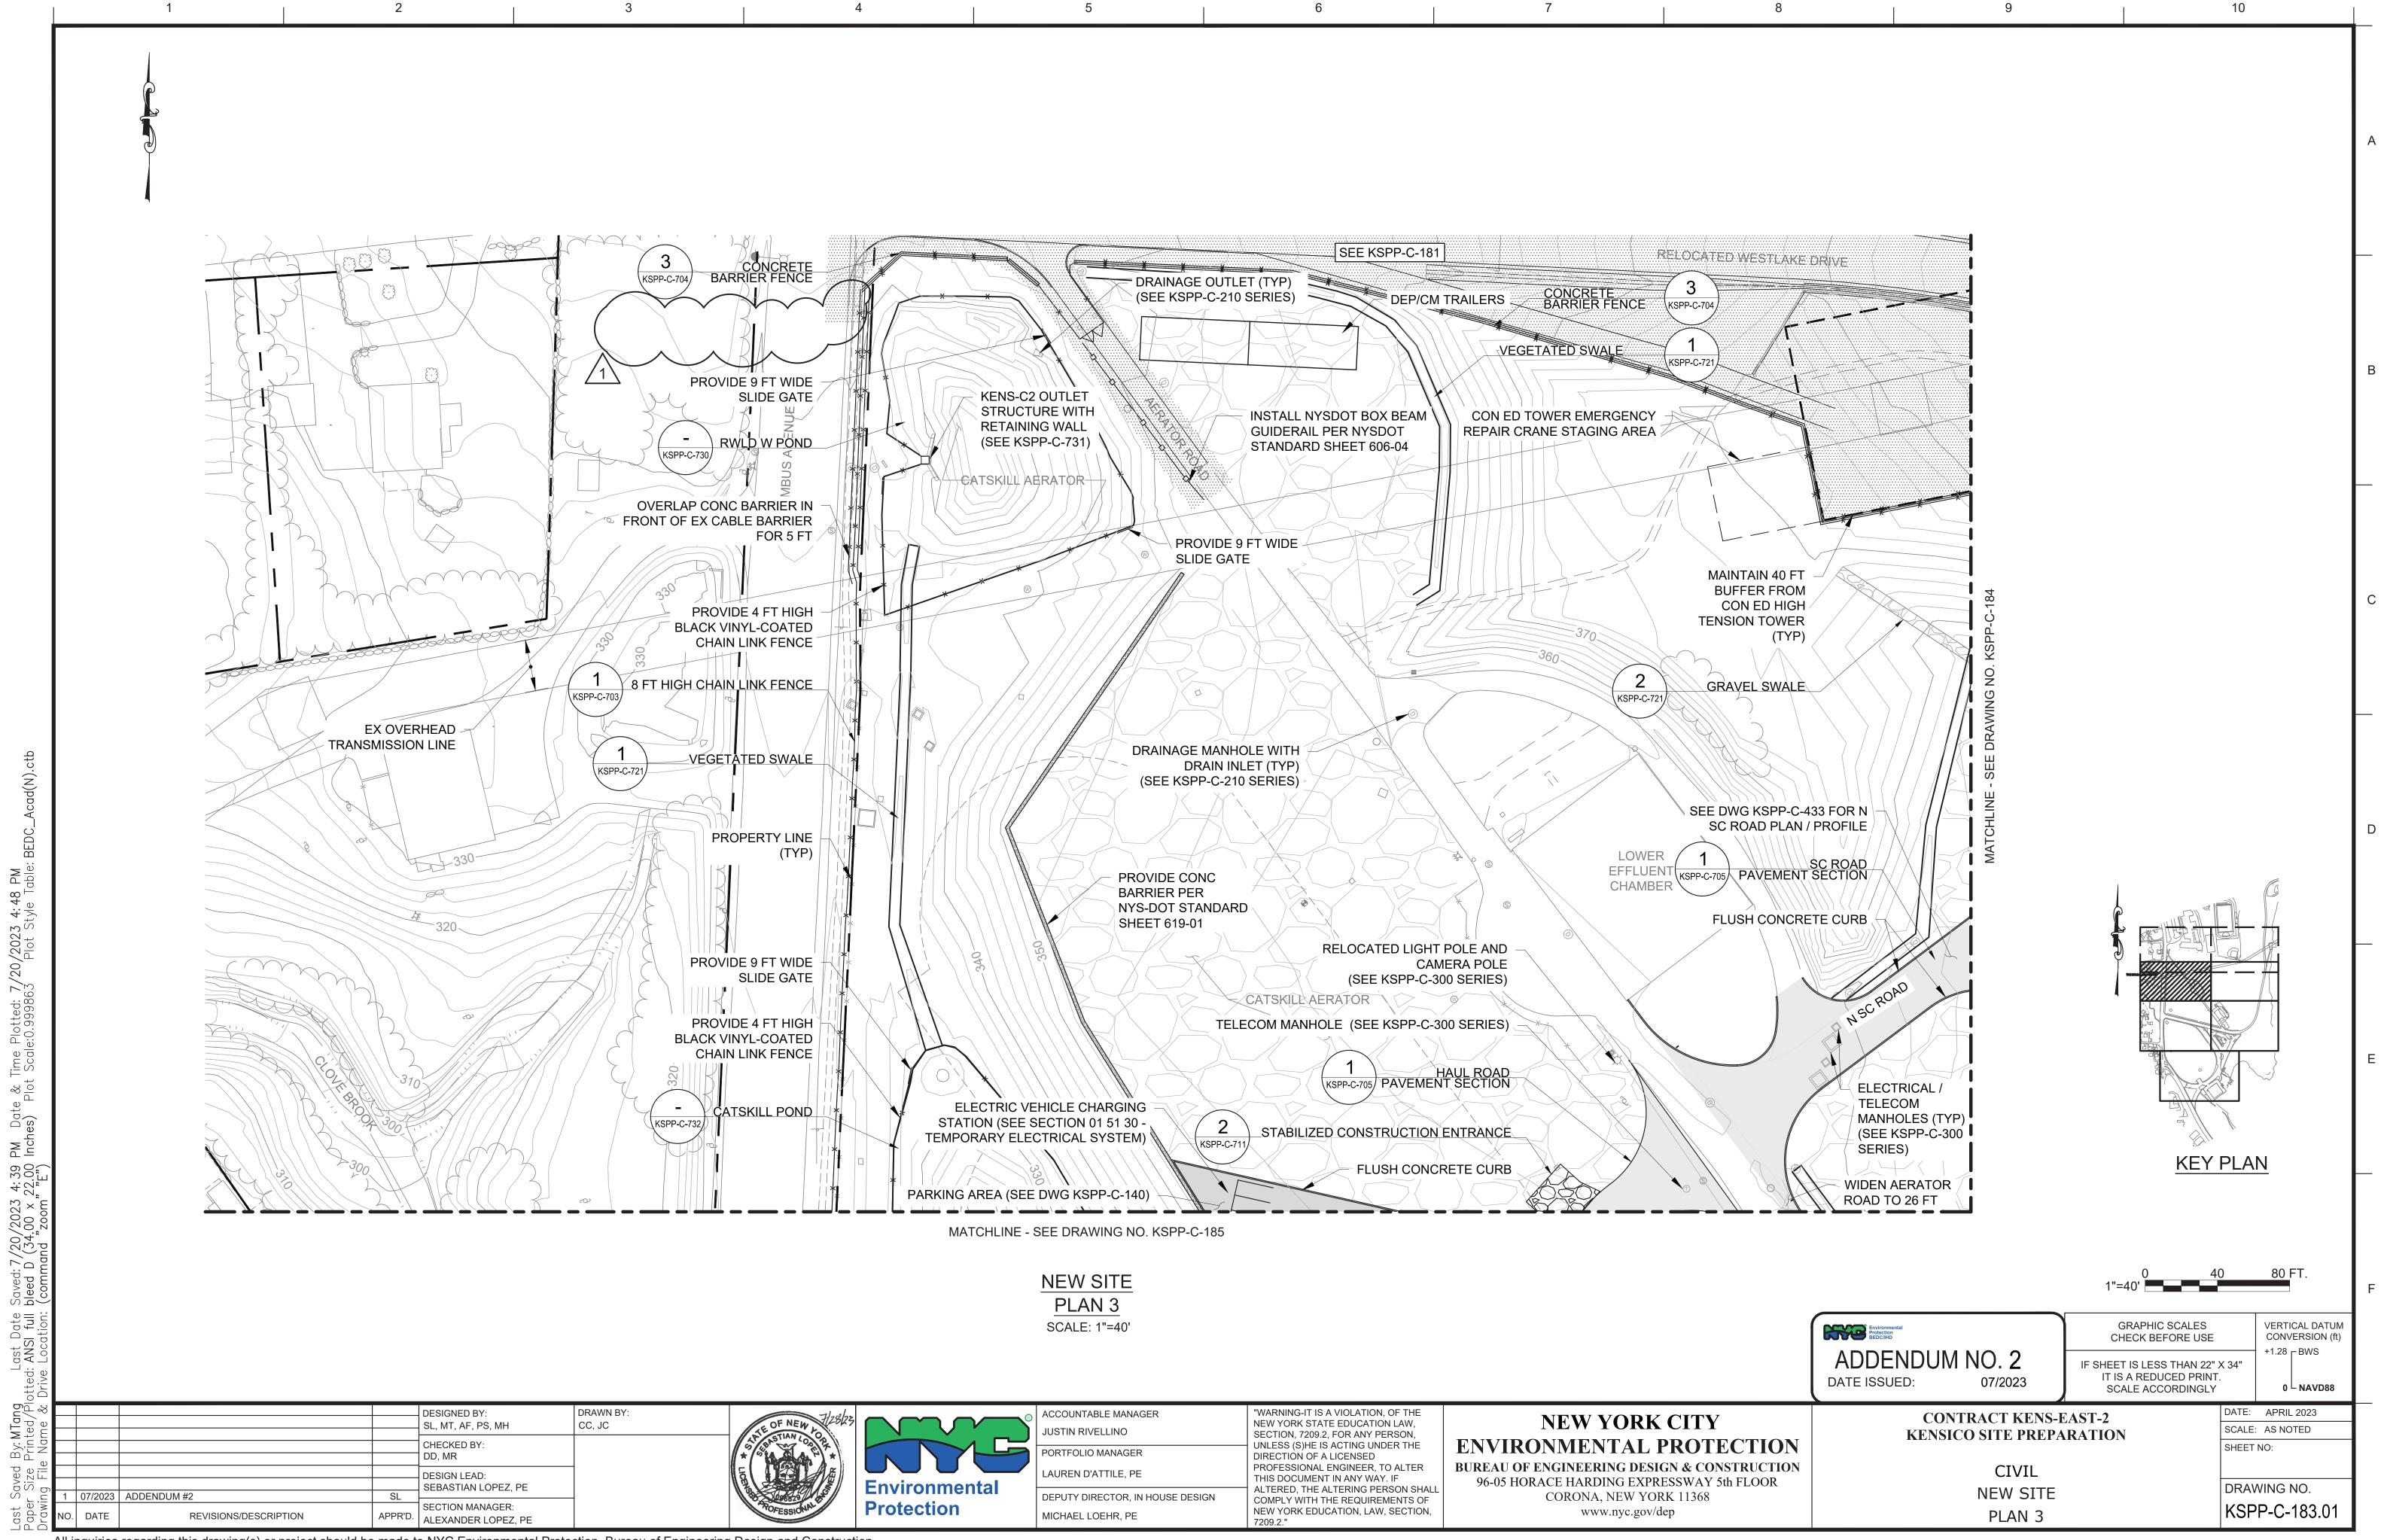

MANAGER	"WARNING-IT IS A VIC
INO	NEW YORK STATE ED SECTION, 7209.2, FOR
NAGER	UNLESS (S)HE IS ACT DIRECTION OF A LICE
ILE, PE	PROFESSIONAL ENG THIS DOCUMENT IN A
TOR, IN HOUSE DESIGN	ALTERED, THE ALTER COMPLY WITH THE R
IR, PE	NEW YORK EDUCATIO

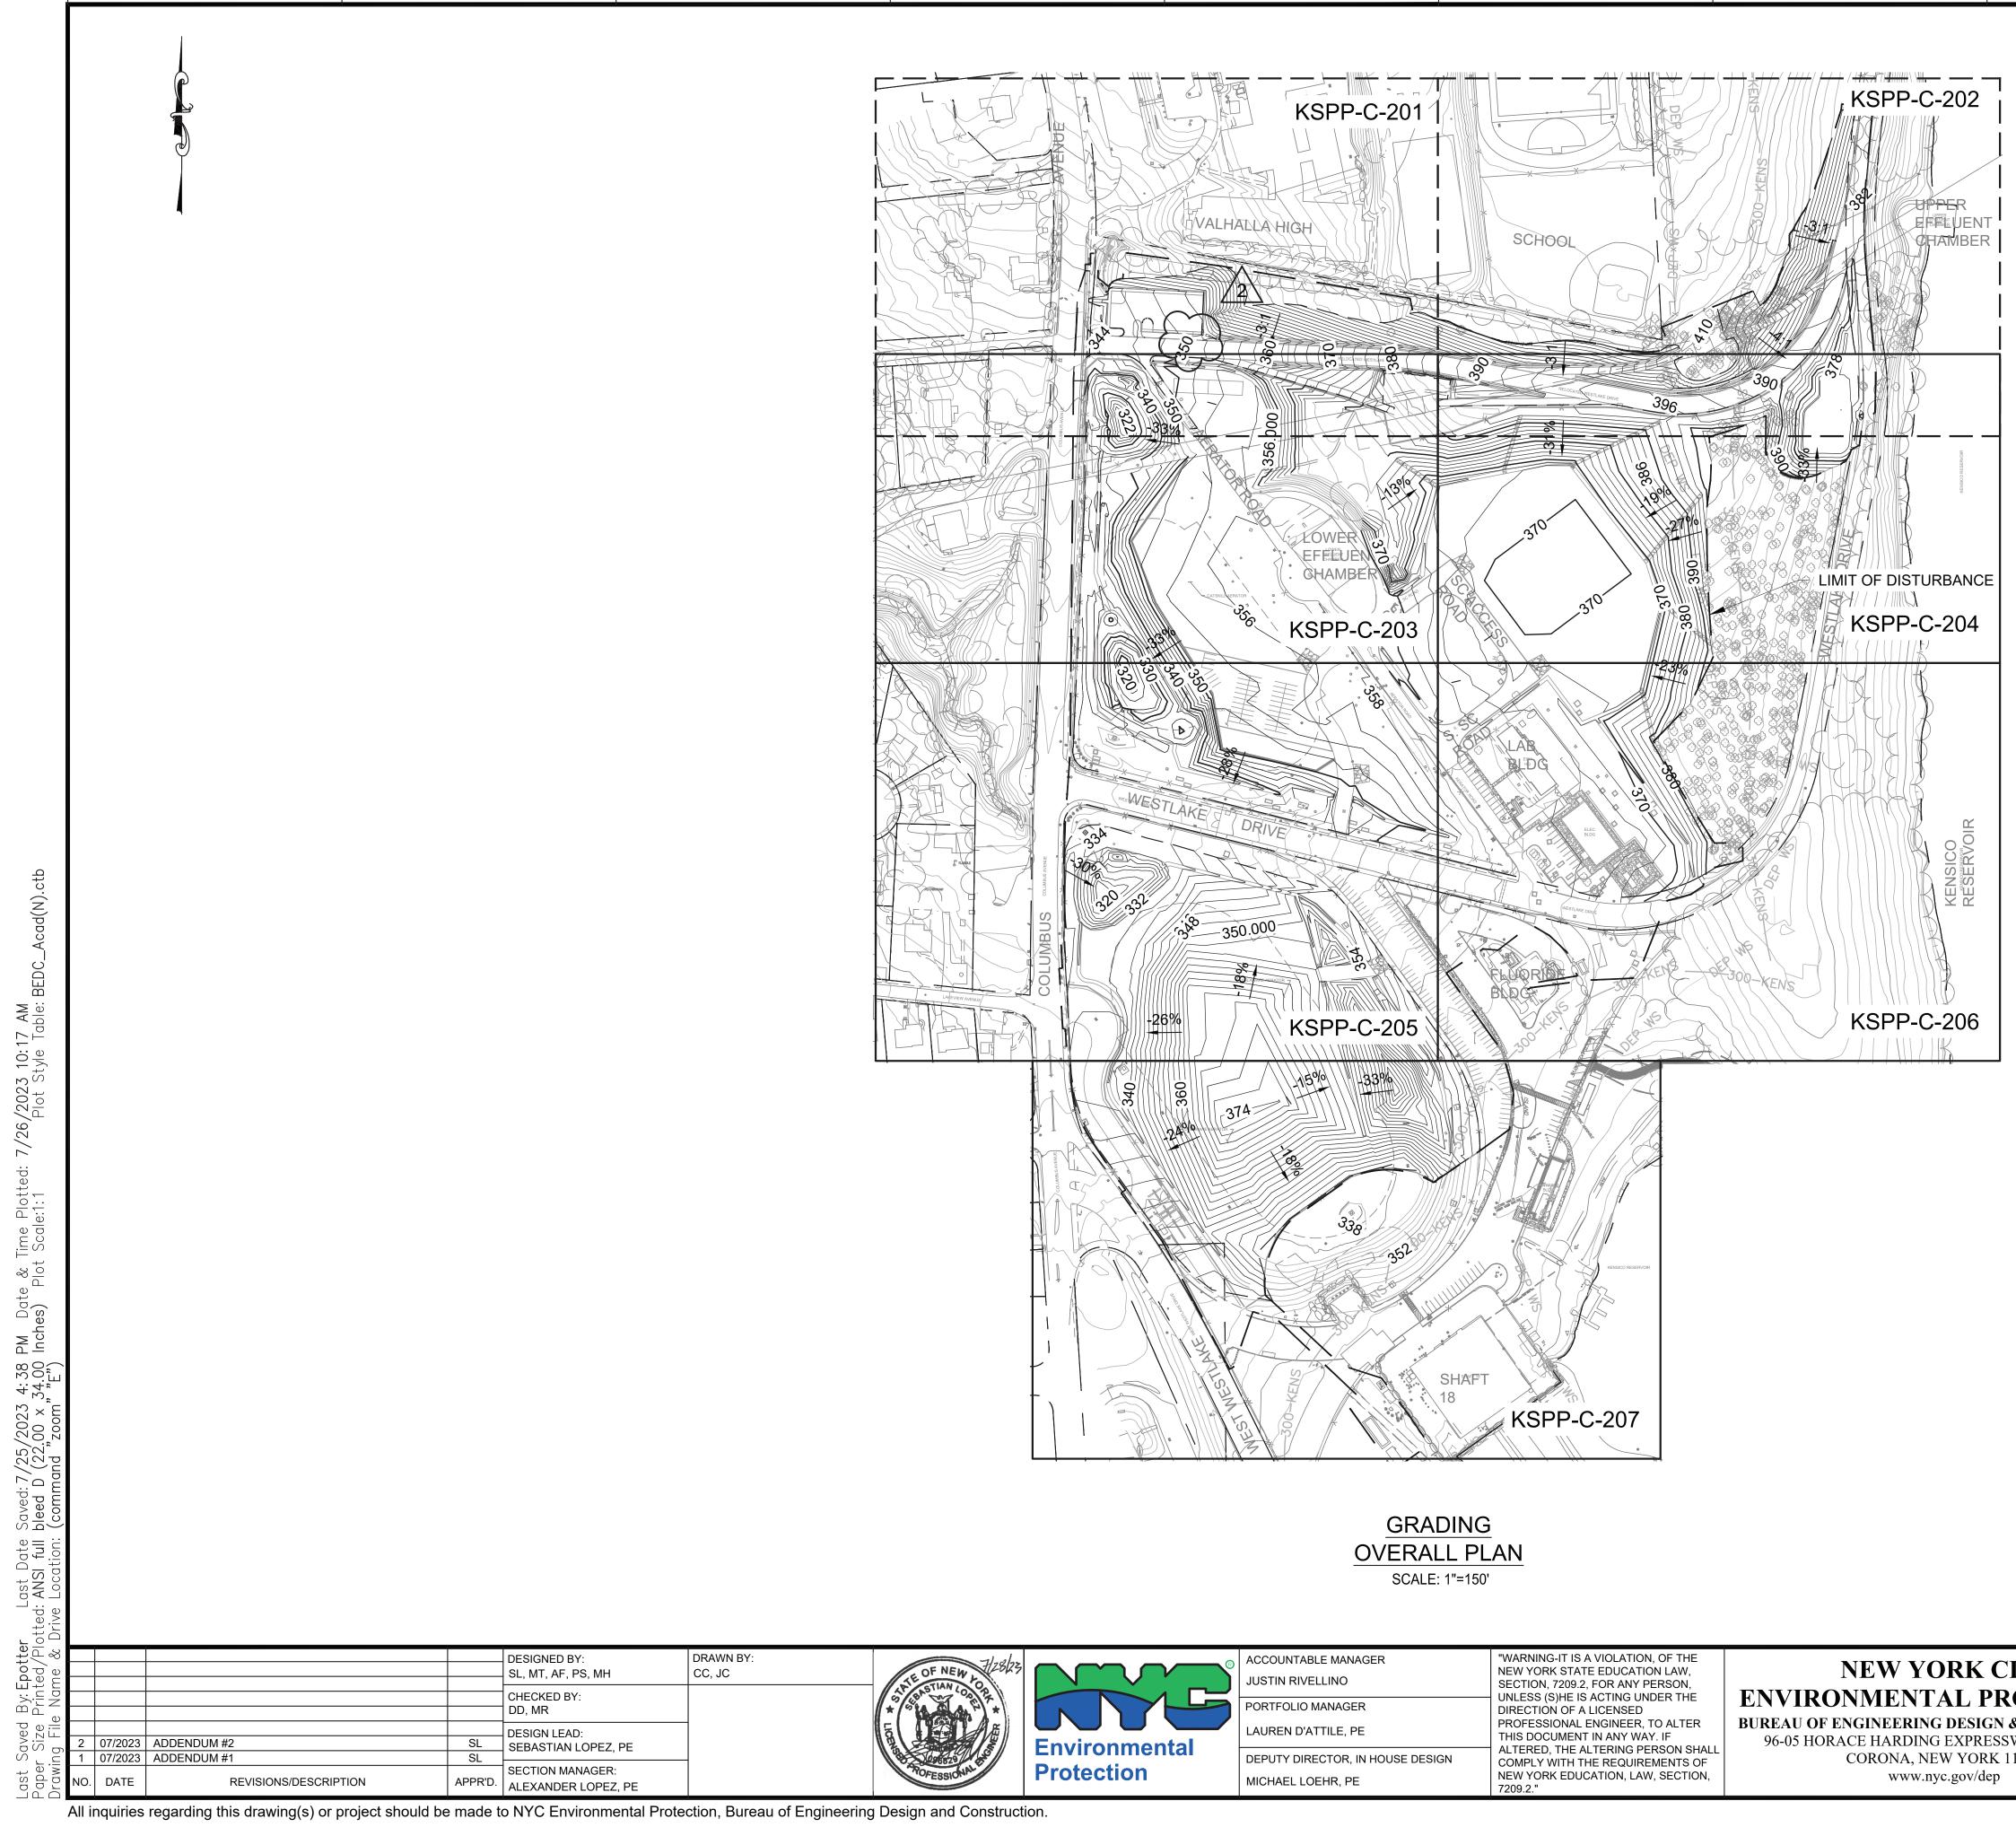

2

R	ACCOUNTABLE MANAGER
	JUSTIN RIVELLINO
)	PORTFOLIO MANAGER
	LAUREN D'ATTILE, PE
	DEPUTY DIRECTOR, IN HOUSE DESIG

NEW YORK CITY ENVIRONMENTAL PROTECT BUREAU OF ENGINEERING DESIGN & CONSTRU 96-05 HORACE HARDING EXPRESSWAY 5th FLO CORONA, NEW YORK 11368

7

8	9	10
	NOTES:	
		OWER MANHOLE AND HANDHOLE CESS/OPERABILITY OF EXISTING


Α


D

Е

KENSICO SITE UTILITIES


		0 15 1"=150' 	50	300 FT.	F
Í	Environmental Protection BEDC/IHD	GRAPHIC SCALES CHECK BEFORE USE		VERTICAL DATUM CONVERSION (ft)	
	ADDENDUM NO. 2 DATE ISSUED: 07/2023	IF SHEET IS LESS THAN 22") IT IS A REDUCED PRINT. SCALE ACCORDINGLY		+1.28 BWS 0 NAVD88	
	CONTRACT KENS-F	CAST-2	DATE:	APRIL 2023	
	KENSICO SITE PREPARATION		SCALE: AS NOTED		
'ION			SHEET	NO:	
CTION	CIVIL				
OOR	GRADING		DRAV	VING NO.	
	OVERALL PLA	Ν	KSP	P-C-200.02	

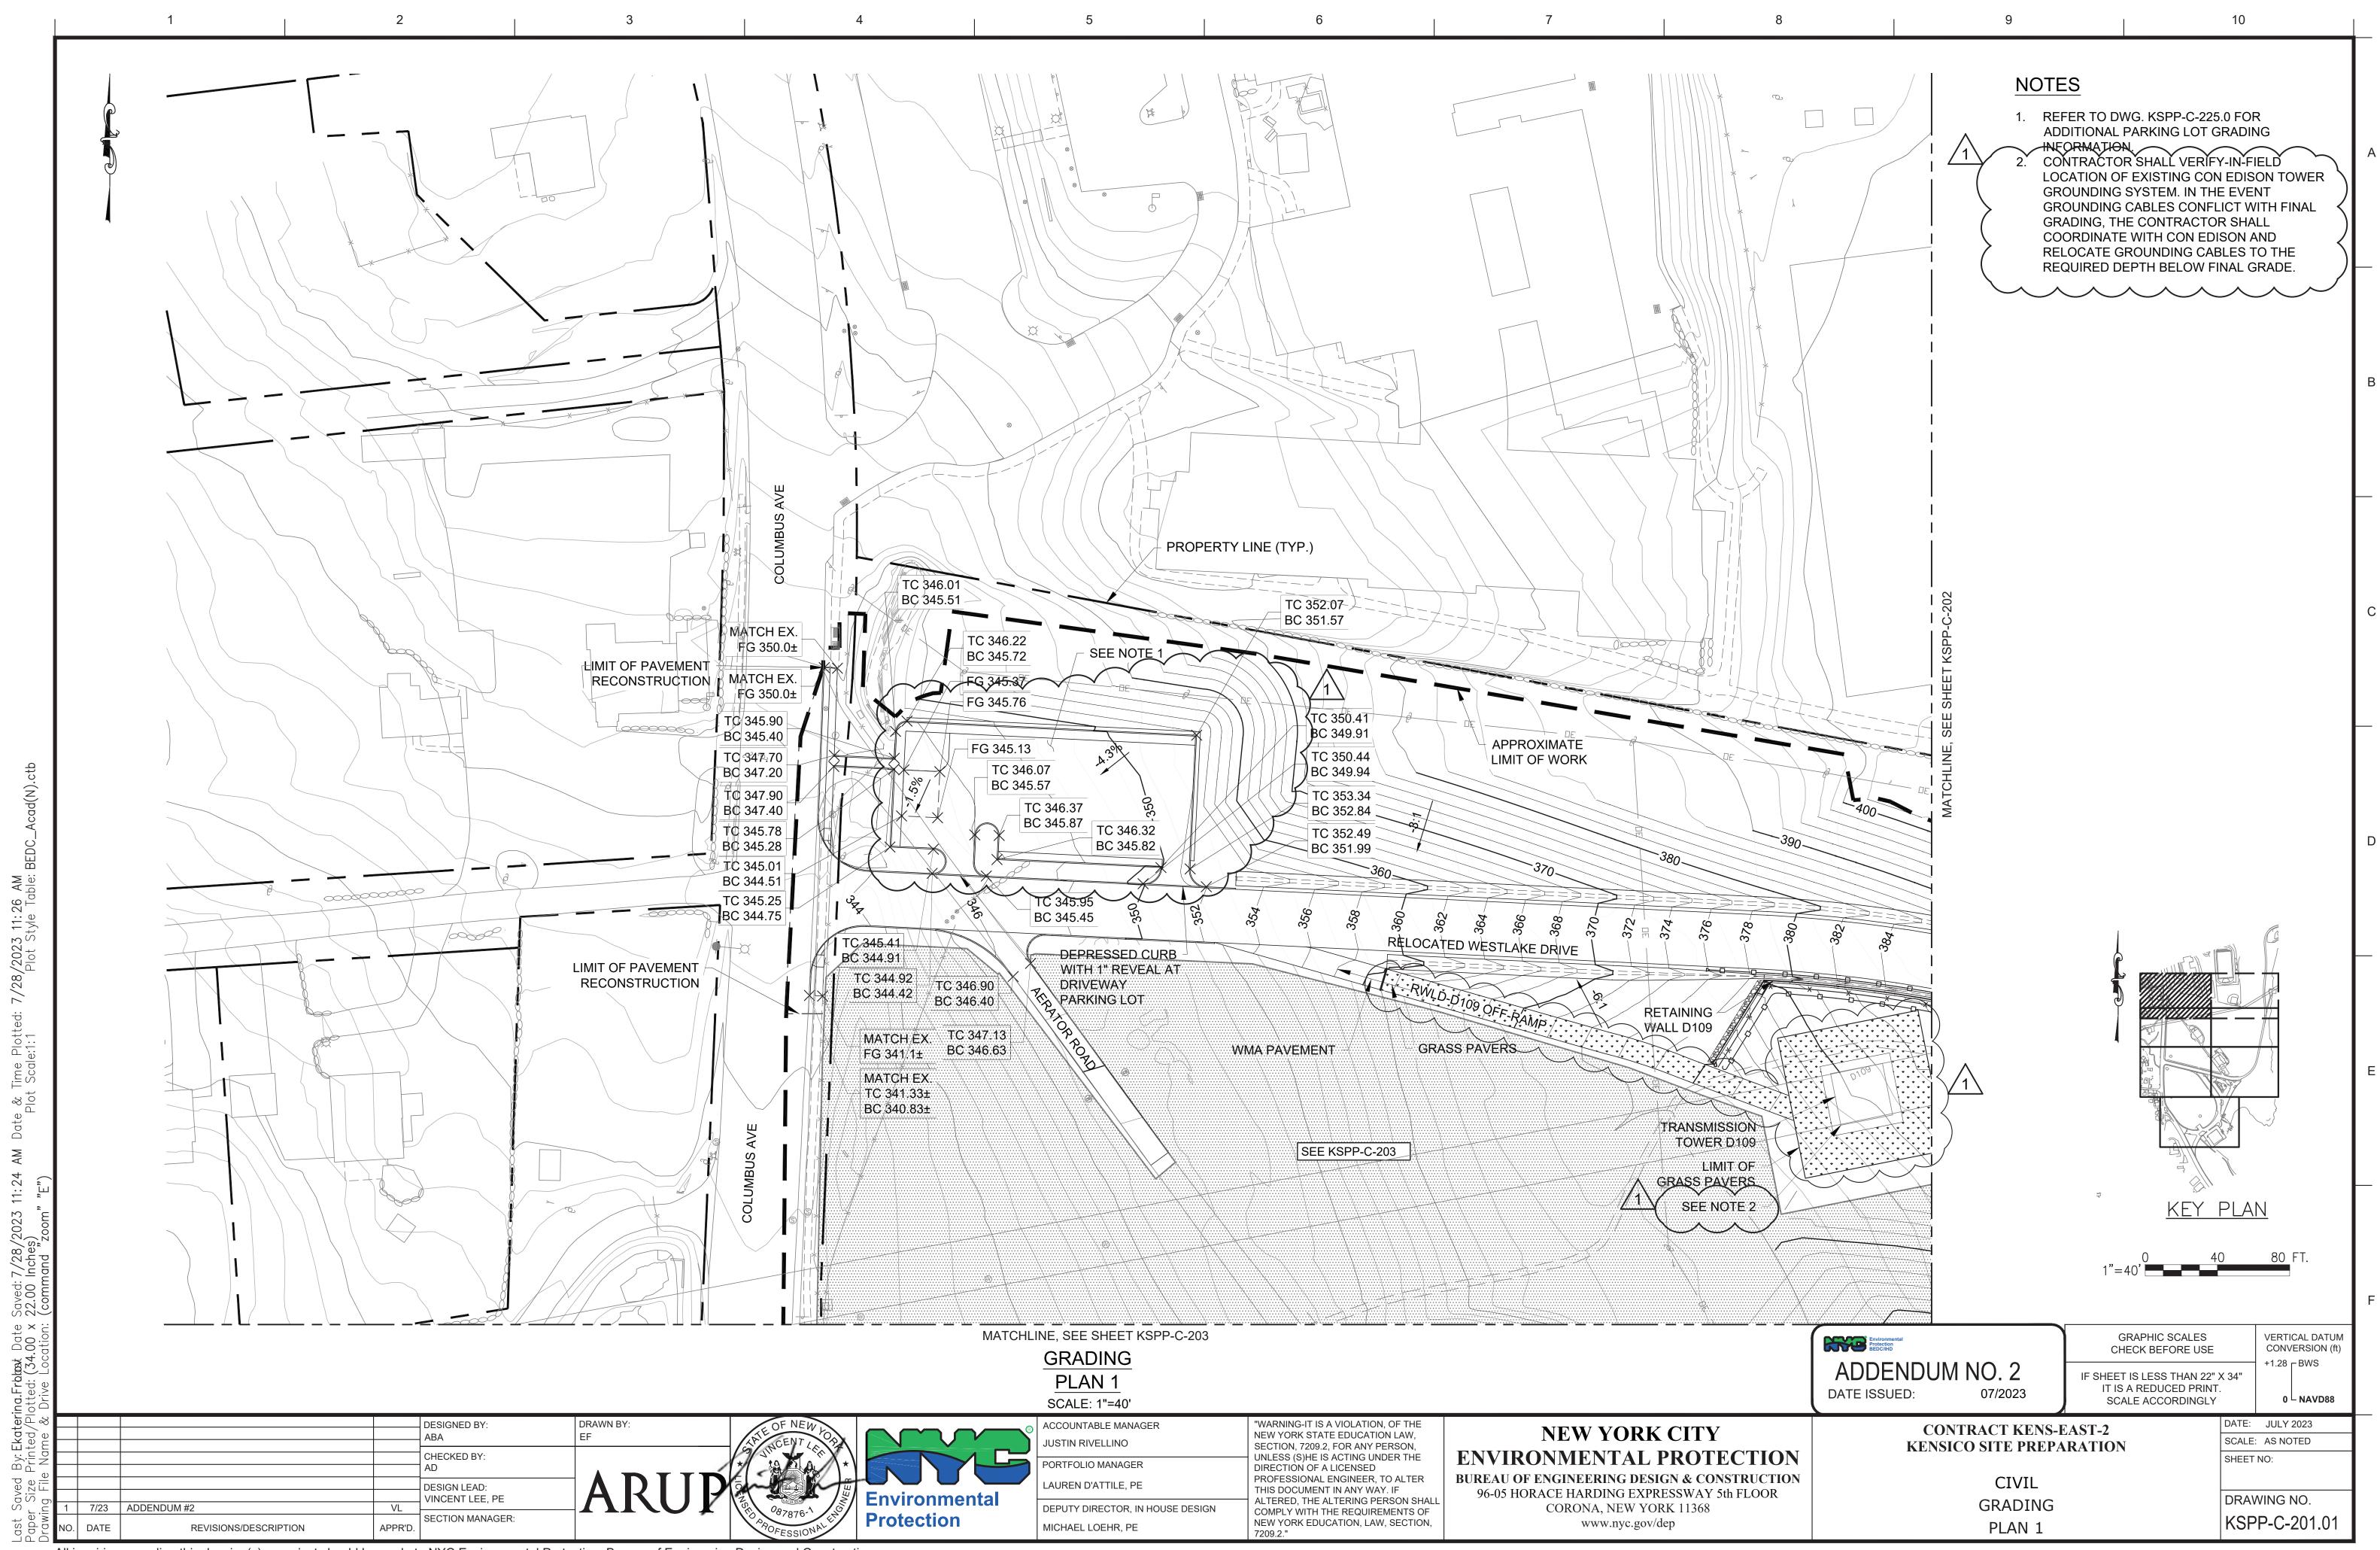

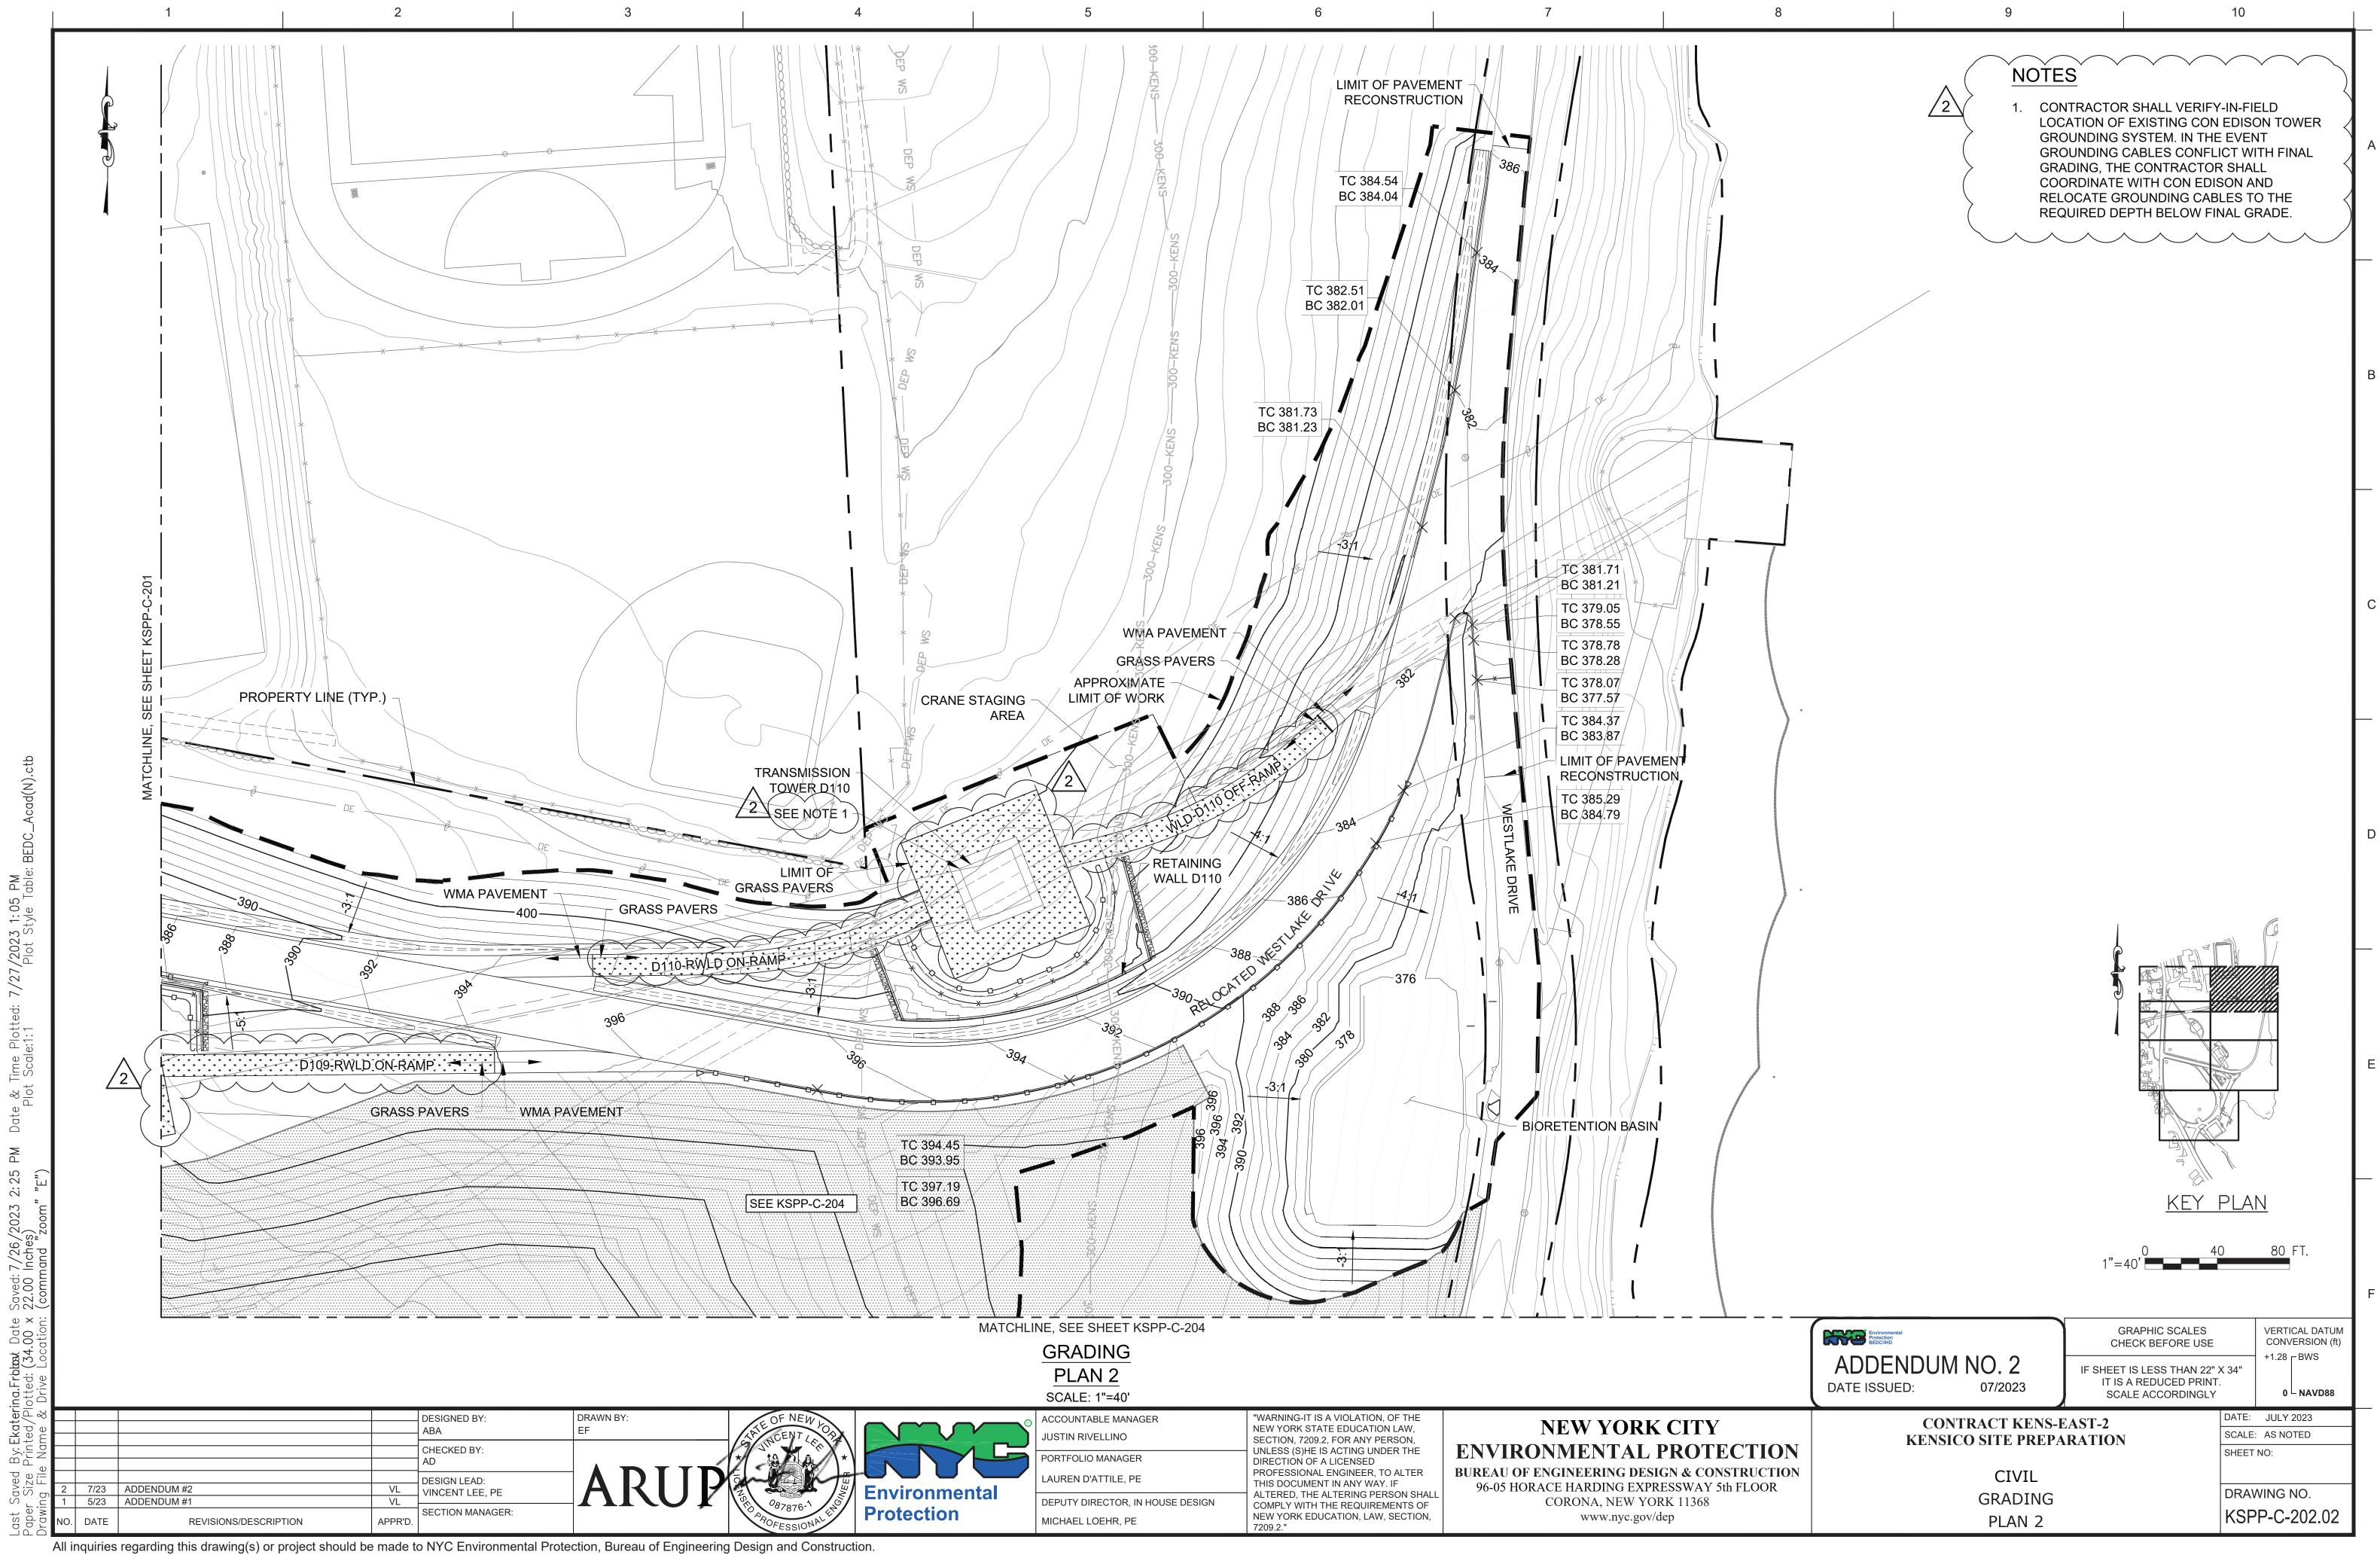





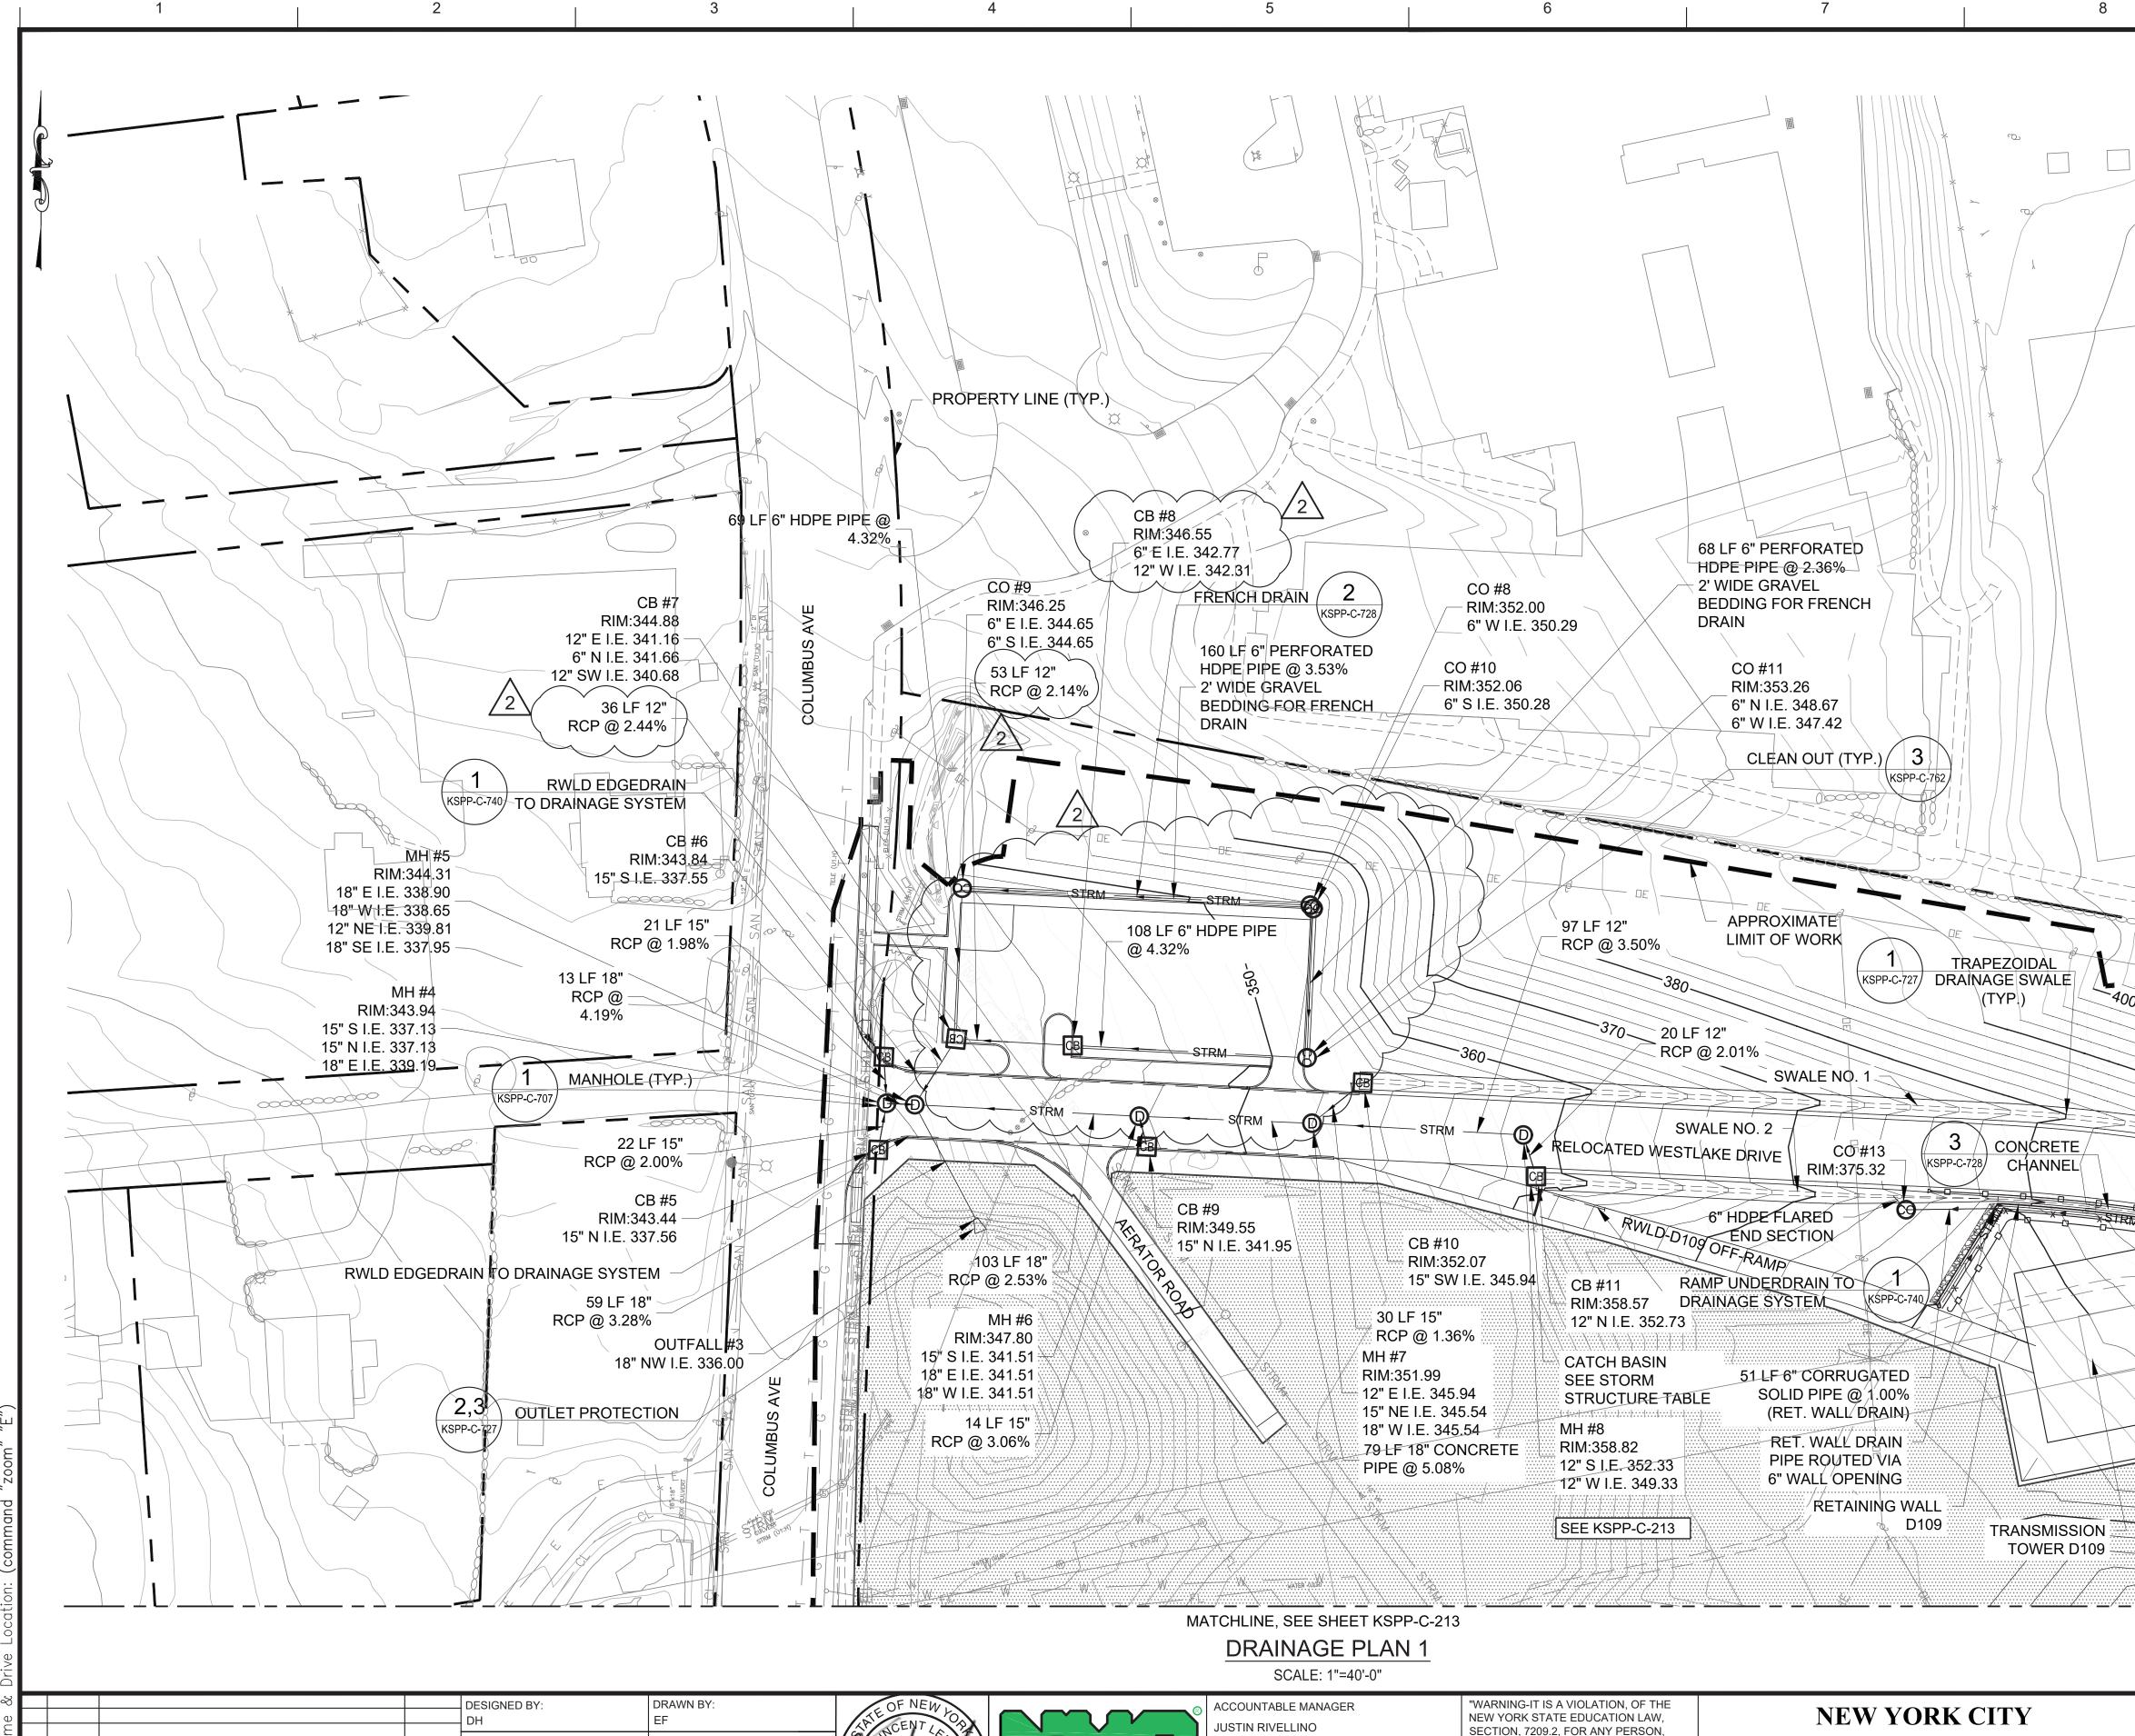

				CHECKED BY: VL		
-				DESIGN LEAD:		
2	7/23	ADDENDUM #2	VL	VINCENT LEE, PE		Env
1	5/23	ADDENDUM #1	VL	,,		
NO.	DATE	REVISIONS/DESCRIPTION	APPR'D.	SECTION MANAGER:	AROFESSIONAL	Pro




USTIN RIVELLINO PORTFOLIO MANAGER LAUREN D'ATTILE, PE DEPUTY DIRECTOR, IN HOUSE DESIGN MICHAEL LOEHR, PE

SECTION, 7209.2, FOR ANY PERSON, UNLESS (S)HE IS ACTING UNDER THE DIRECTION OF A LICENSED PROFESSIONAL ENGINEER, TO ALTER THIS DOCUMENT IN ANY WAY. IF ALTERED, THE ALTERING PERSON SHALL COMPLY WITH THE REQUIREMENTS OF NEW YORK EDUCATION, LAW, SECTION, 7209.2."


NEW YORK CITY ENVIRONMENTAL PROTECTION BUREAU OF ENGINEERING DESIGN & CONSTRUCTION 96-05 HORACE HARDING EXPRESSWAY 5th FLOOR CORONA, NEW YORK 11368 www.nyc.gov/dep


ST	FORM ST	RUCTUF	RE TABLE
NUMBER	NORTHING	EASTING	REFERENCE
CB #5	822824.03	691368.42	KSPP-C-709, 1
CB #6	822866.68	691371.05	KSPP-C-709, 1
CB #7	822874.84	691404.24	KSPP-C-709, 1
CB #8	822871.87	691457.62	KSPP-C-709, 1
CB #9	822825.50	691491.65	KSPP-C-709, 1
CB #10	822854.78	691590.59	KSPP-C-709, 2 WITH STORMRAX PEAK GRATE OR APPROVED EQUAL
CB #11	822811.88	691670.07	KSPP-C-709, 2 WITH STORMRAX PEAK GRATE OR APPROVED EQUAL
CO #8	822936.17	691566.42	KSPP-C-762, 3
CO #9	822943.94	691406.94	KSPP-C-762, 3
CO #10	822934.60	691567.77	KSPP-C-762, 3
CO #11	822866.22	691564.99	KSPP-C-762, 3
CO #13	822796.53	691839.68	KSPP-C-762, 3
MH #4	822845.34	691372.28	KSPP-C-707, 1
MH #5	822844.71	691385.15	KSPP-C-707, 1
MH #6	822839.40	691488.06	KSPP-C-707, 1
MH #7	822836.22	691567.26	KSPP-C-707, 1
MH #8	822830.84	691664.08	KSPP-C-707, 1
Outfall #3	822792.35	691413.21	Concrete Flared End Section


D

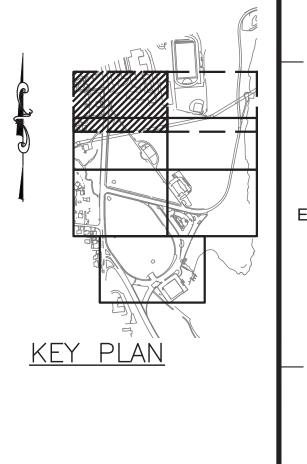

10

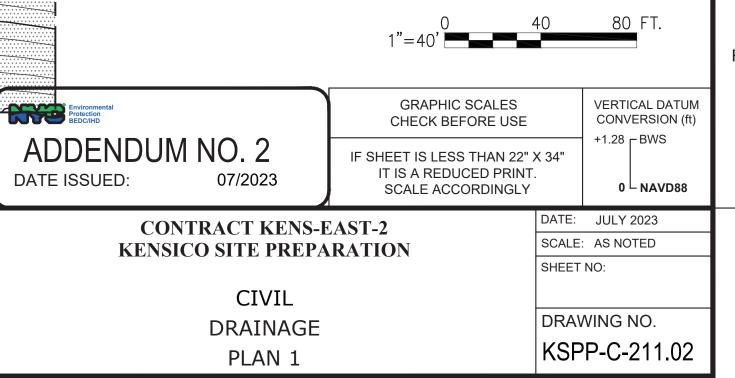


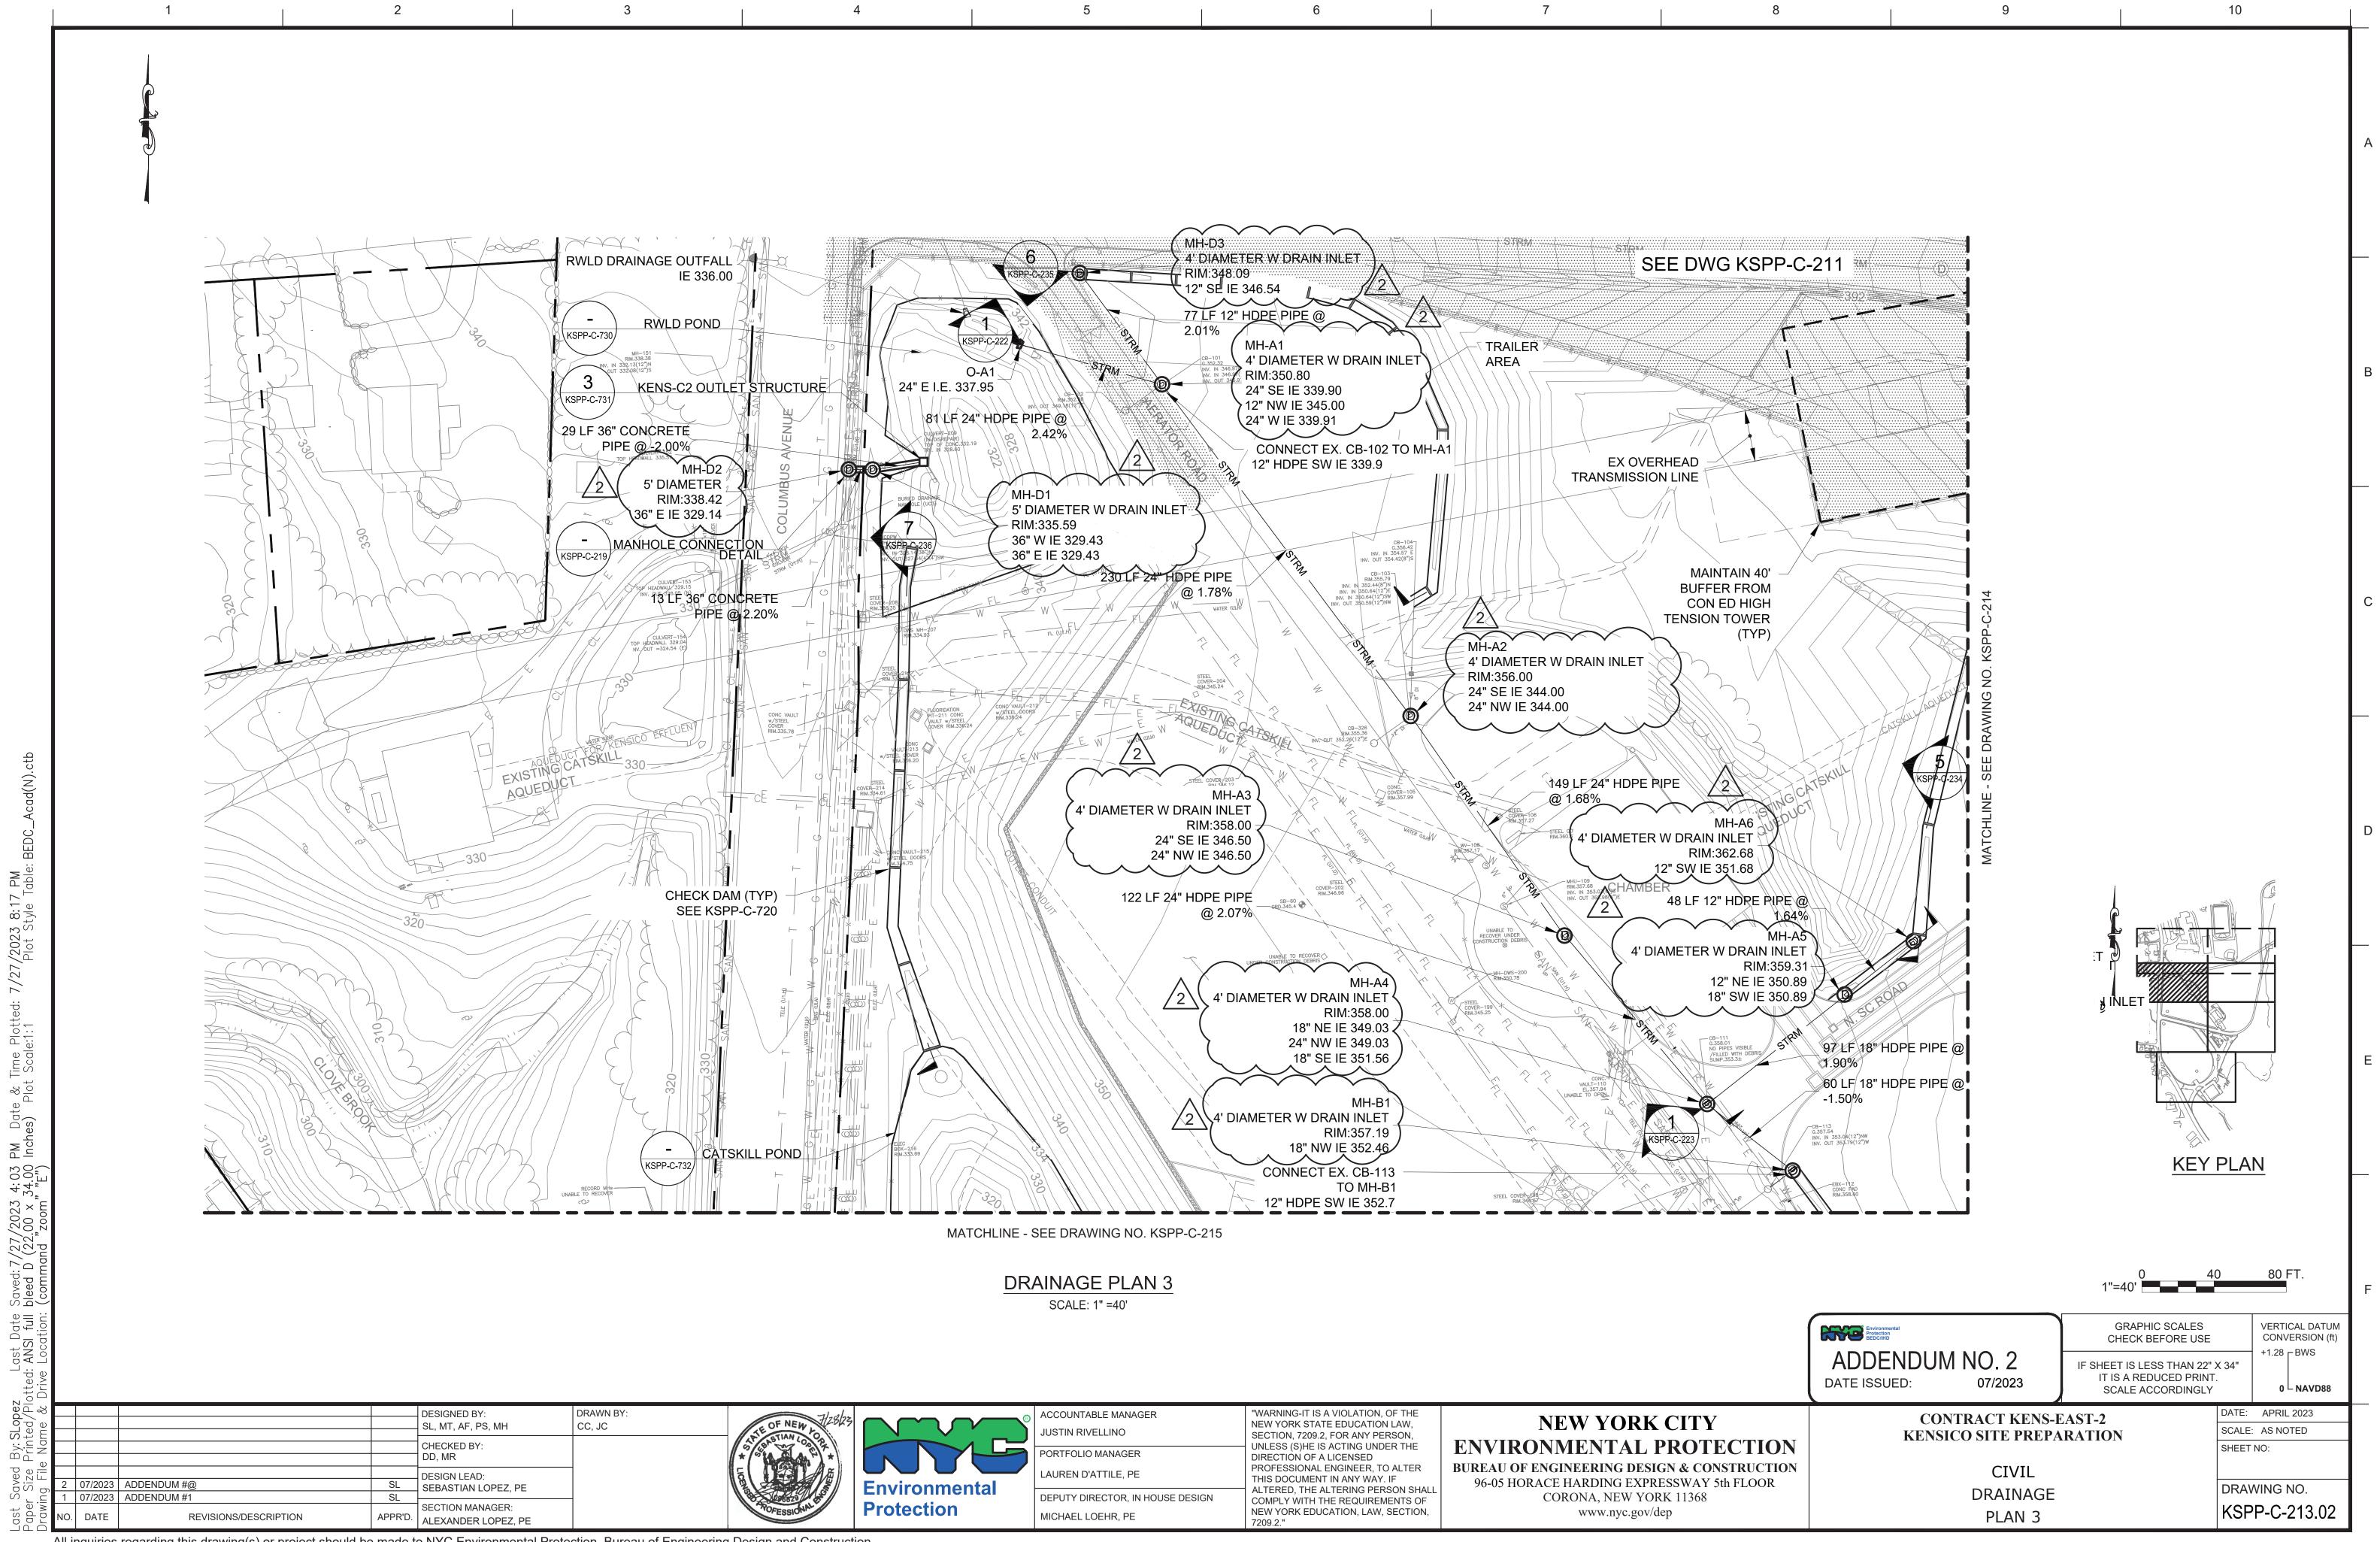

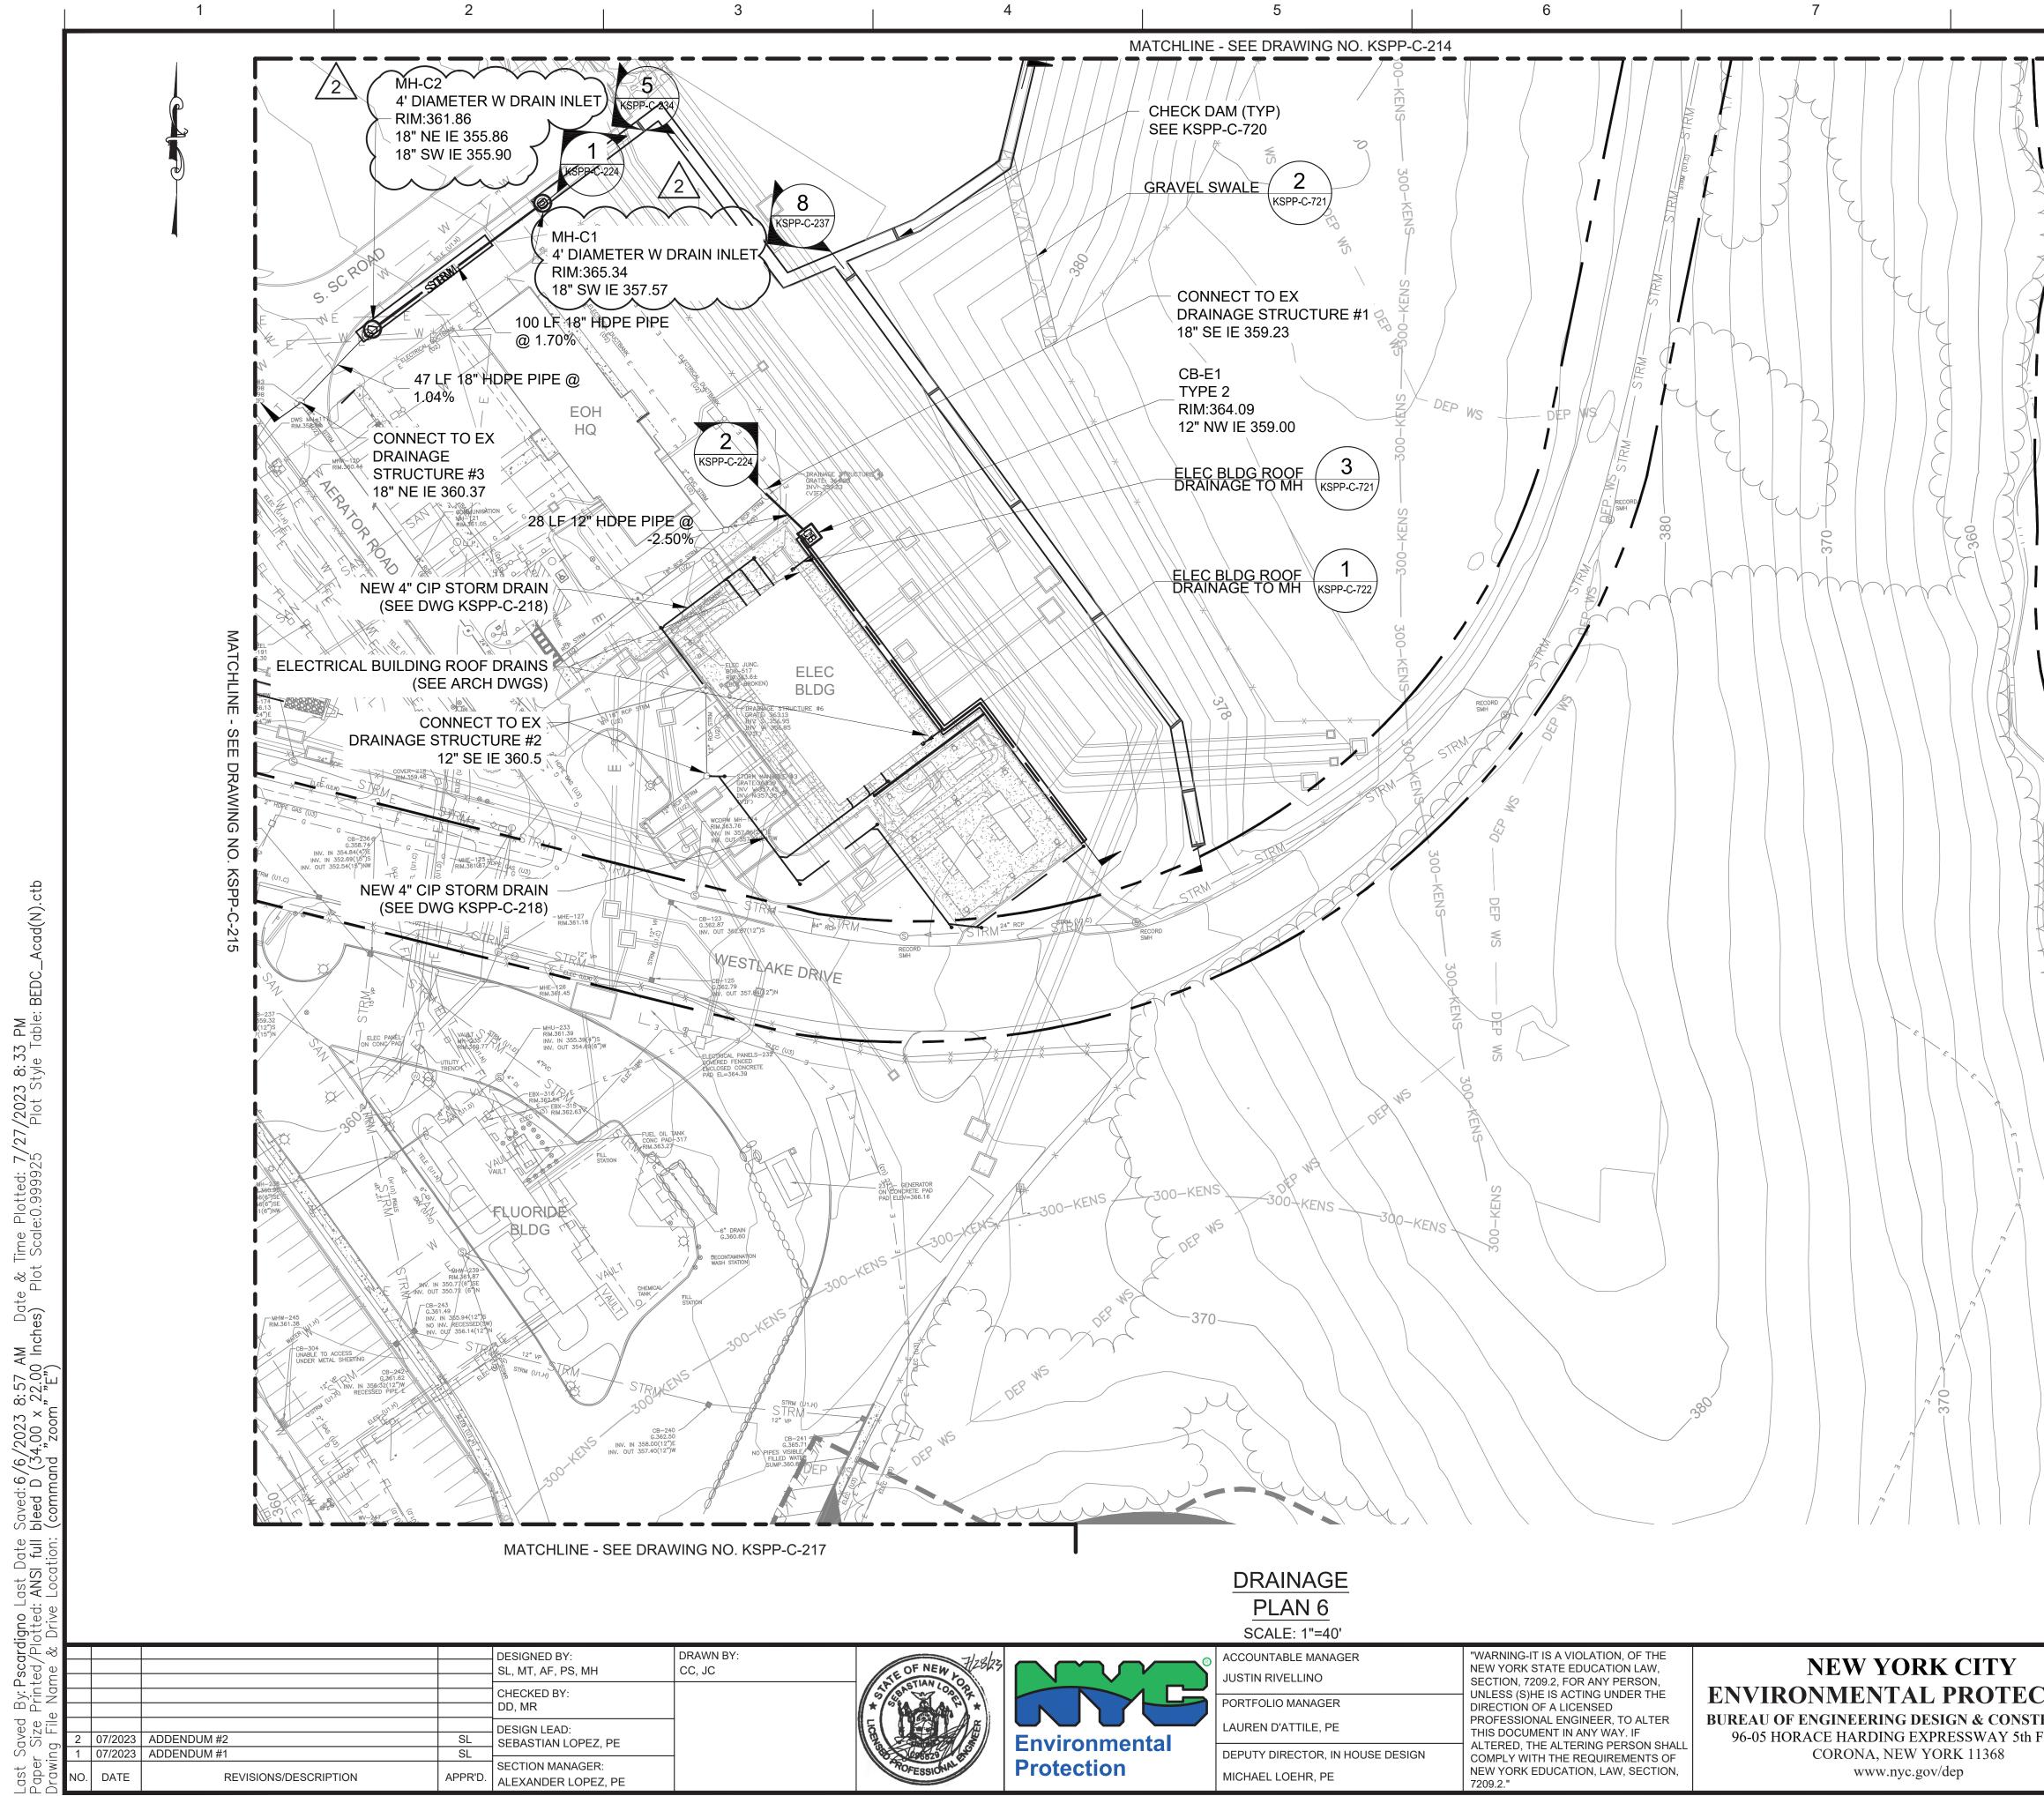

96-05 HORACE HARDING EXPRESSWAY 5th FI


8	9		10		
					A
					В
	ERVOIR				С
	KENSICO RESERVOIR				
					D
			KEY PLA	<u>N</u>	
360		0 1"=40'	40	80 FT.	F
	ADDENDUM NO. 2 DATE ISSUED: 07/2023	CHECK BE IF SHEET IS LES IT IS A REDI	C SCALES FORE USE S THAN 22" X 34" JCED PRINT. CORDINGLY	VERTICAL DATUM CONVERSION (ft) +1.28 BWS 0 NAVD88	
CTION	CONTRACT KENS-E KENSICO SITE PREPA	CAST-2	DATE:	APRIL 2023 AS NOTED NO:	
RUCTION FLOOR	CIVIL DRAINAGE PLAN 6			VING NO. P-C-216.02	

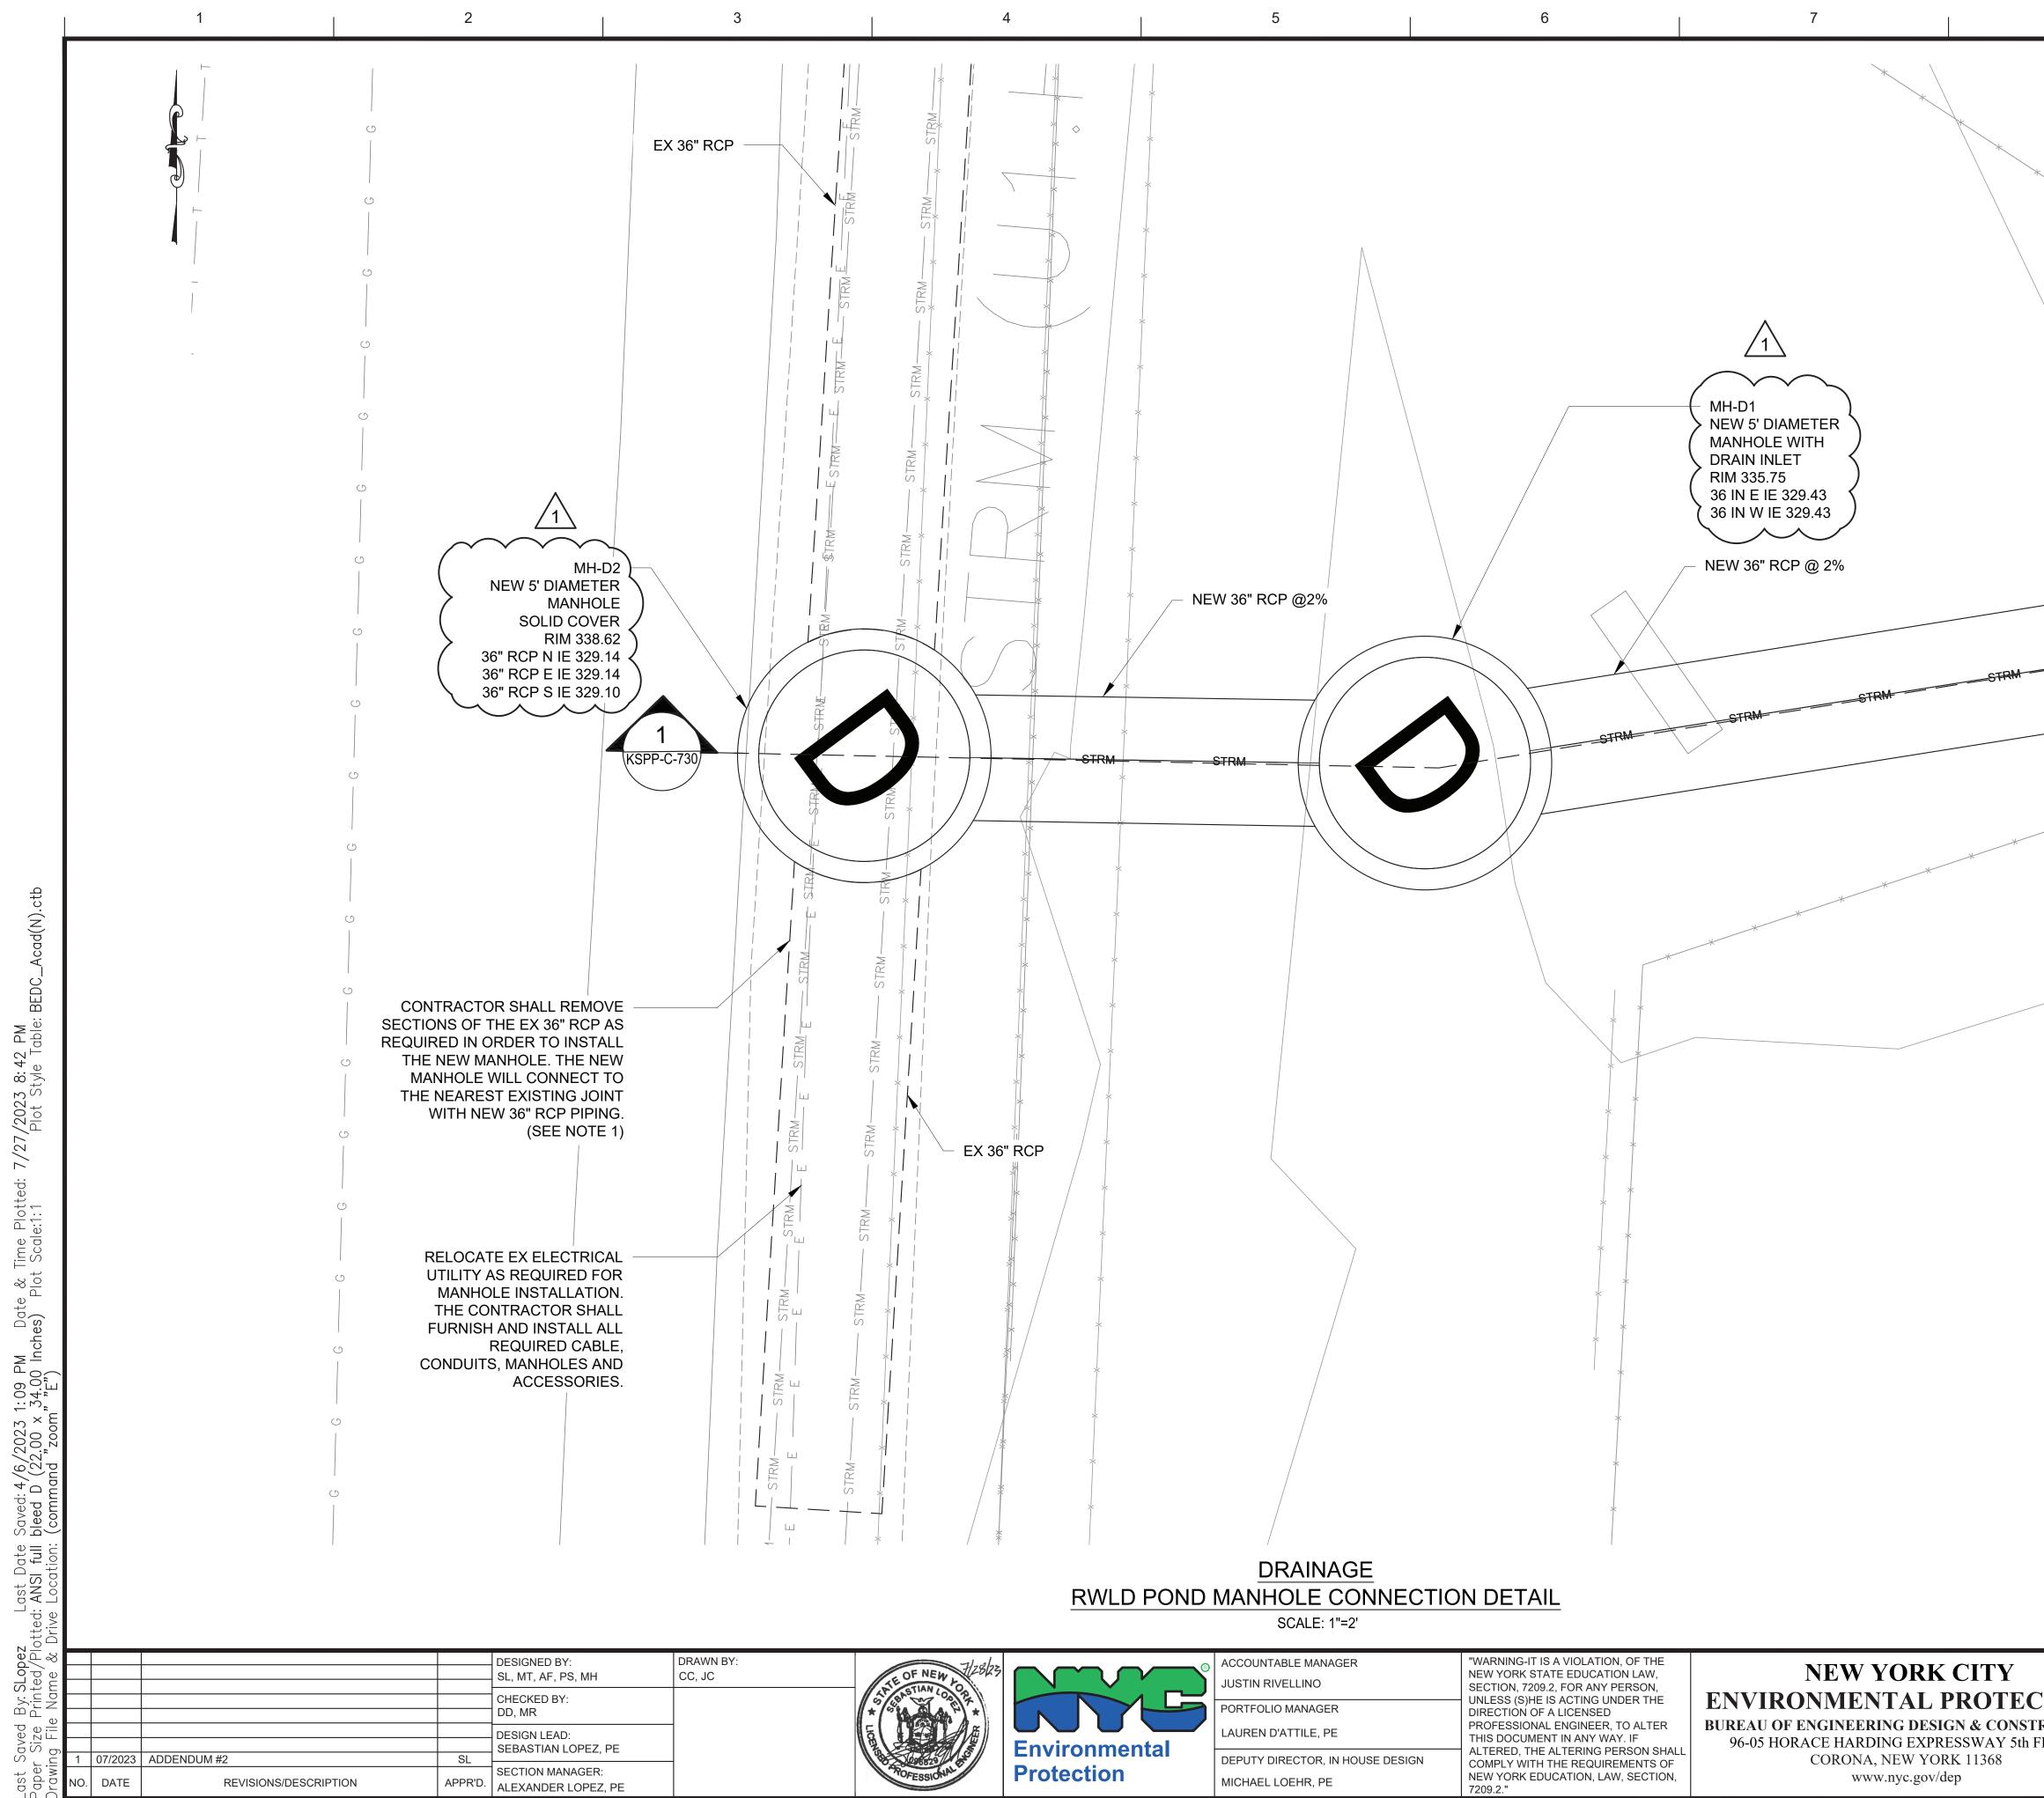



All inquiries regarding this drawing(s) or project should be made to NYC Environmental Protection, Bureau of Engineering Design and Construction.

96-05 HORACE HARDING EXPRESSWAY 5th Fl


8	9		10	
	NOTE	ES:		
		CONTRACTOR SHALL MAK CONNECTION IN ACCORDA	ANCE WITH THE	
		BWSO STANDARD SEWER SPECIFICATIONS - SECTIO REINFORCED CONCRETE I	N 21.05 PRECAST	
*				A
×	*			
A				
				В
				⊢
				С
*	×			
				┢
				D
				⊢
				E
				⊢
		0 2'	4' FT	
		1" = 2'		F
		GRAPHIC SCALES CHECK BEFORE USE	VERTICAL DATUM CONVERSION (ft) +1.28 r BWS	
	ADDENDUM NO. 2 DATE ISSUED: 07/2023	IF SHEET IS LESS THAN 22" IT IS A REDUCED PRINT SCALE ACCORDINGLY	X 34"	
	CONTRACT KENS- KENSLCO SITE DDED	EAST-2	DATE: APRIL 2023 SCALE: AS NOTED	
CTION RUCTION	KENSICO SITE PREP. CIVIL	AKAHUN	SHEET NO:	1
LOOR	DRAINAGE		DRAWING NO.	1
	MANHOLE CONNECTI	ON DETAIL	KSPP-C-219.01	1

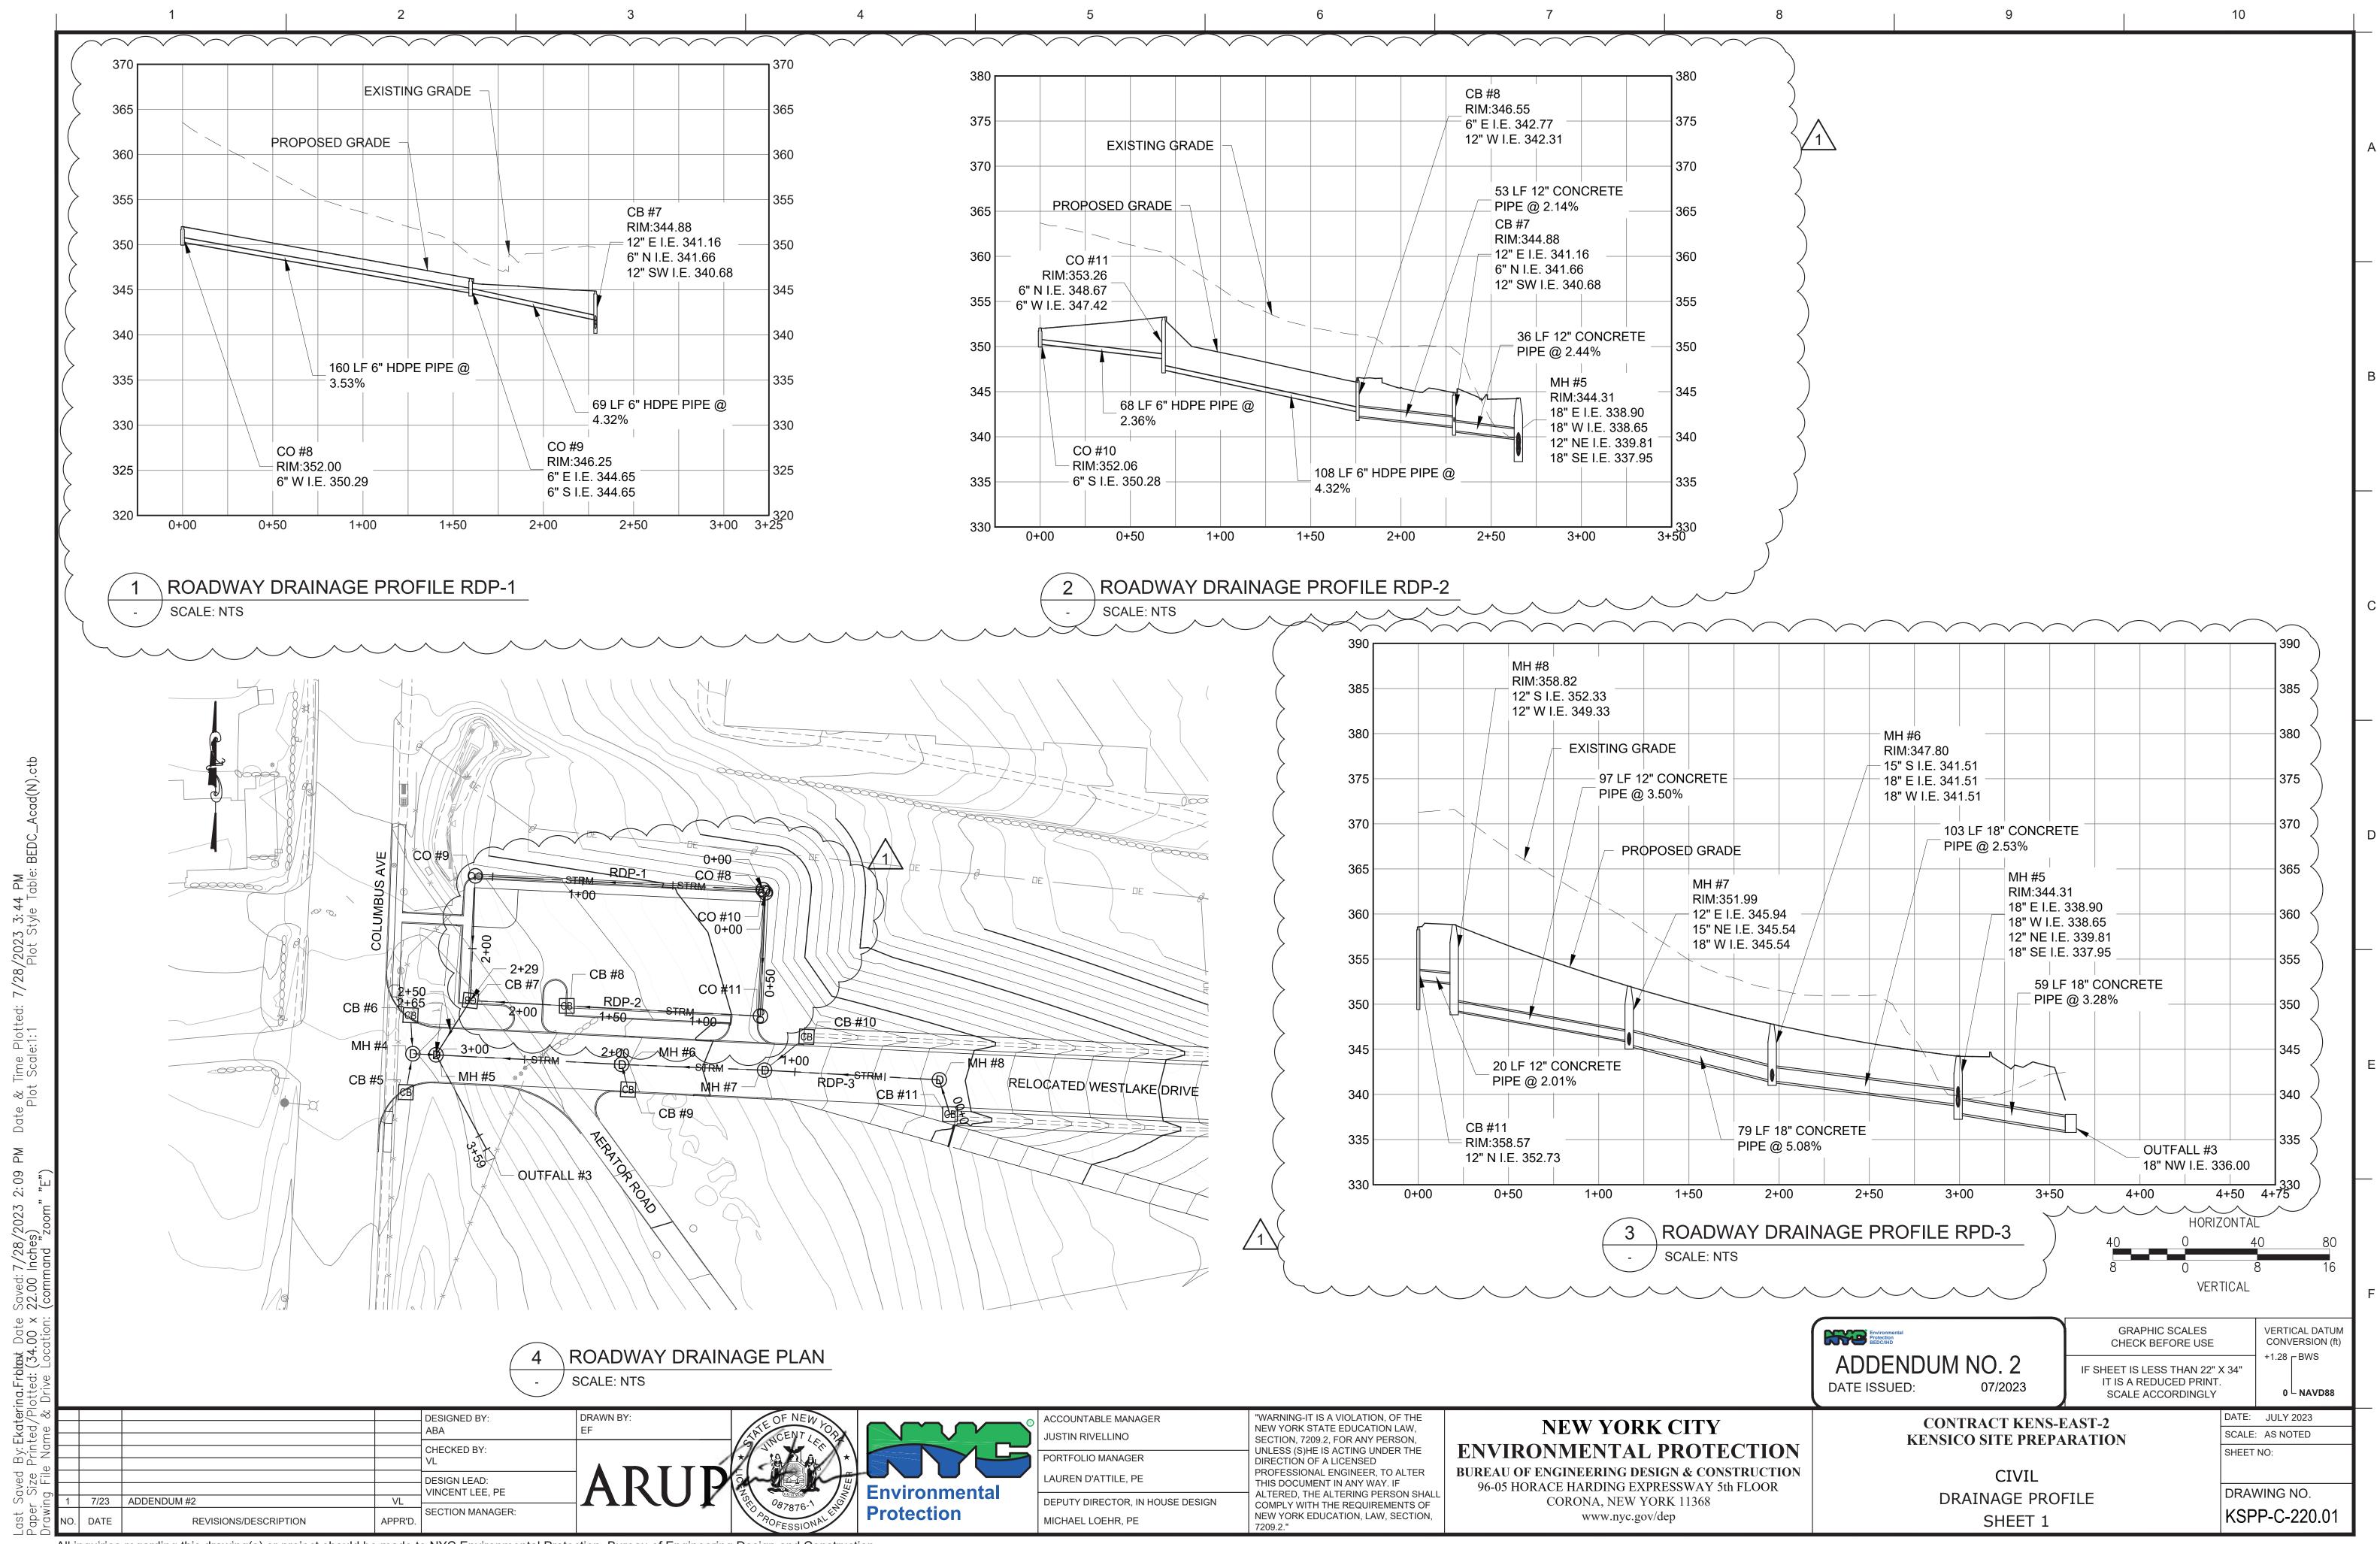

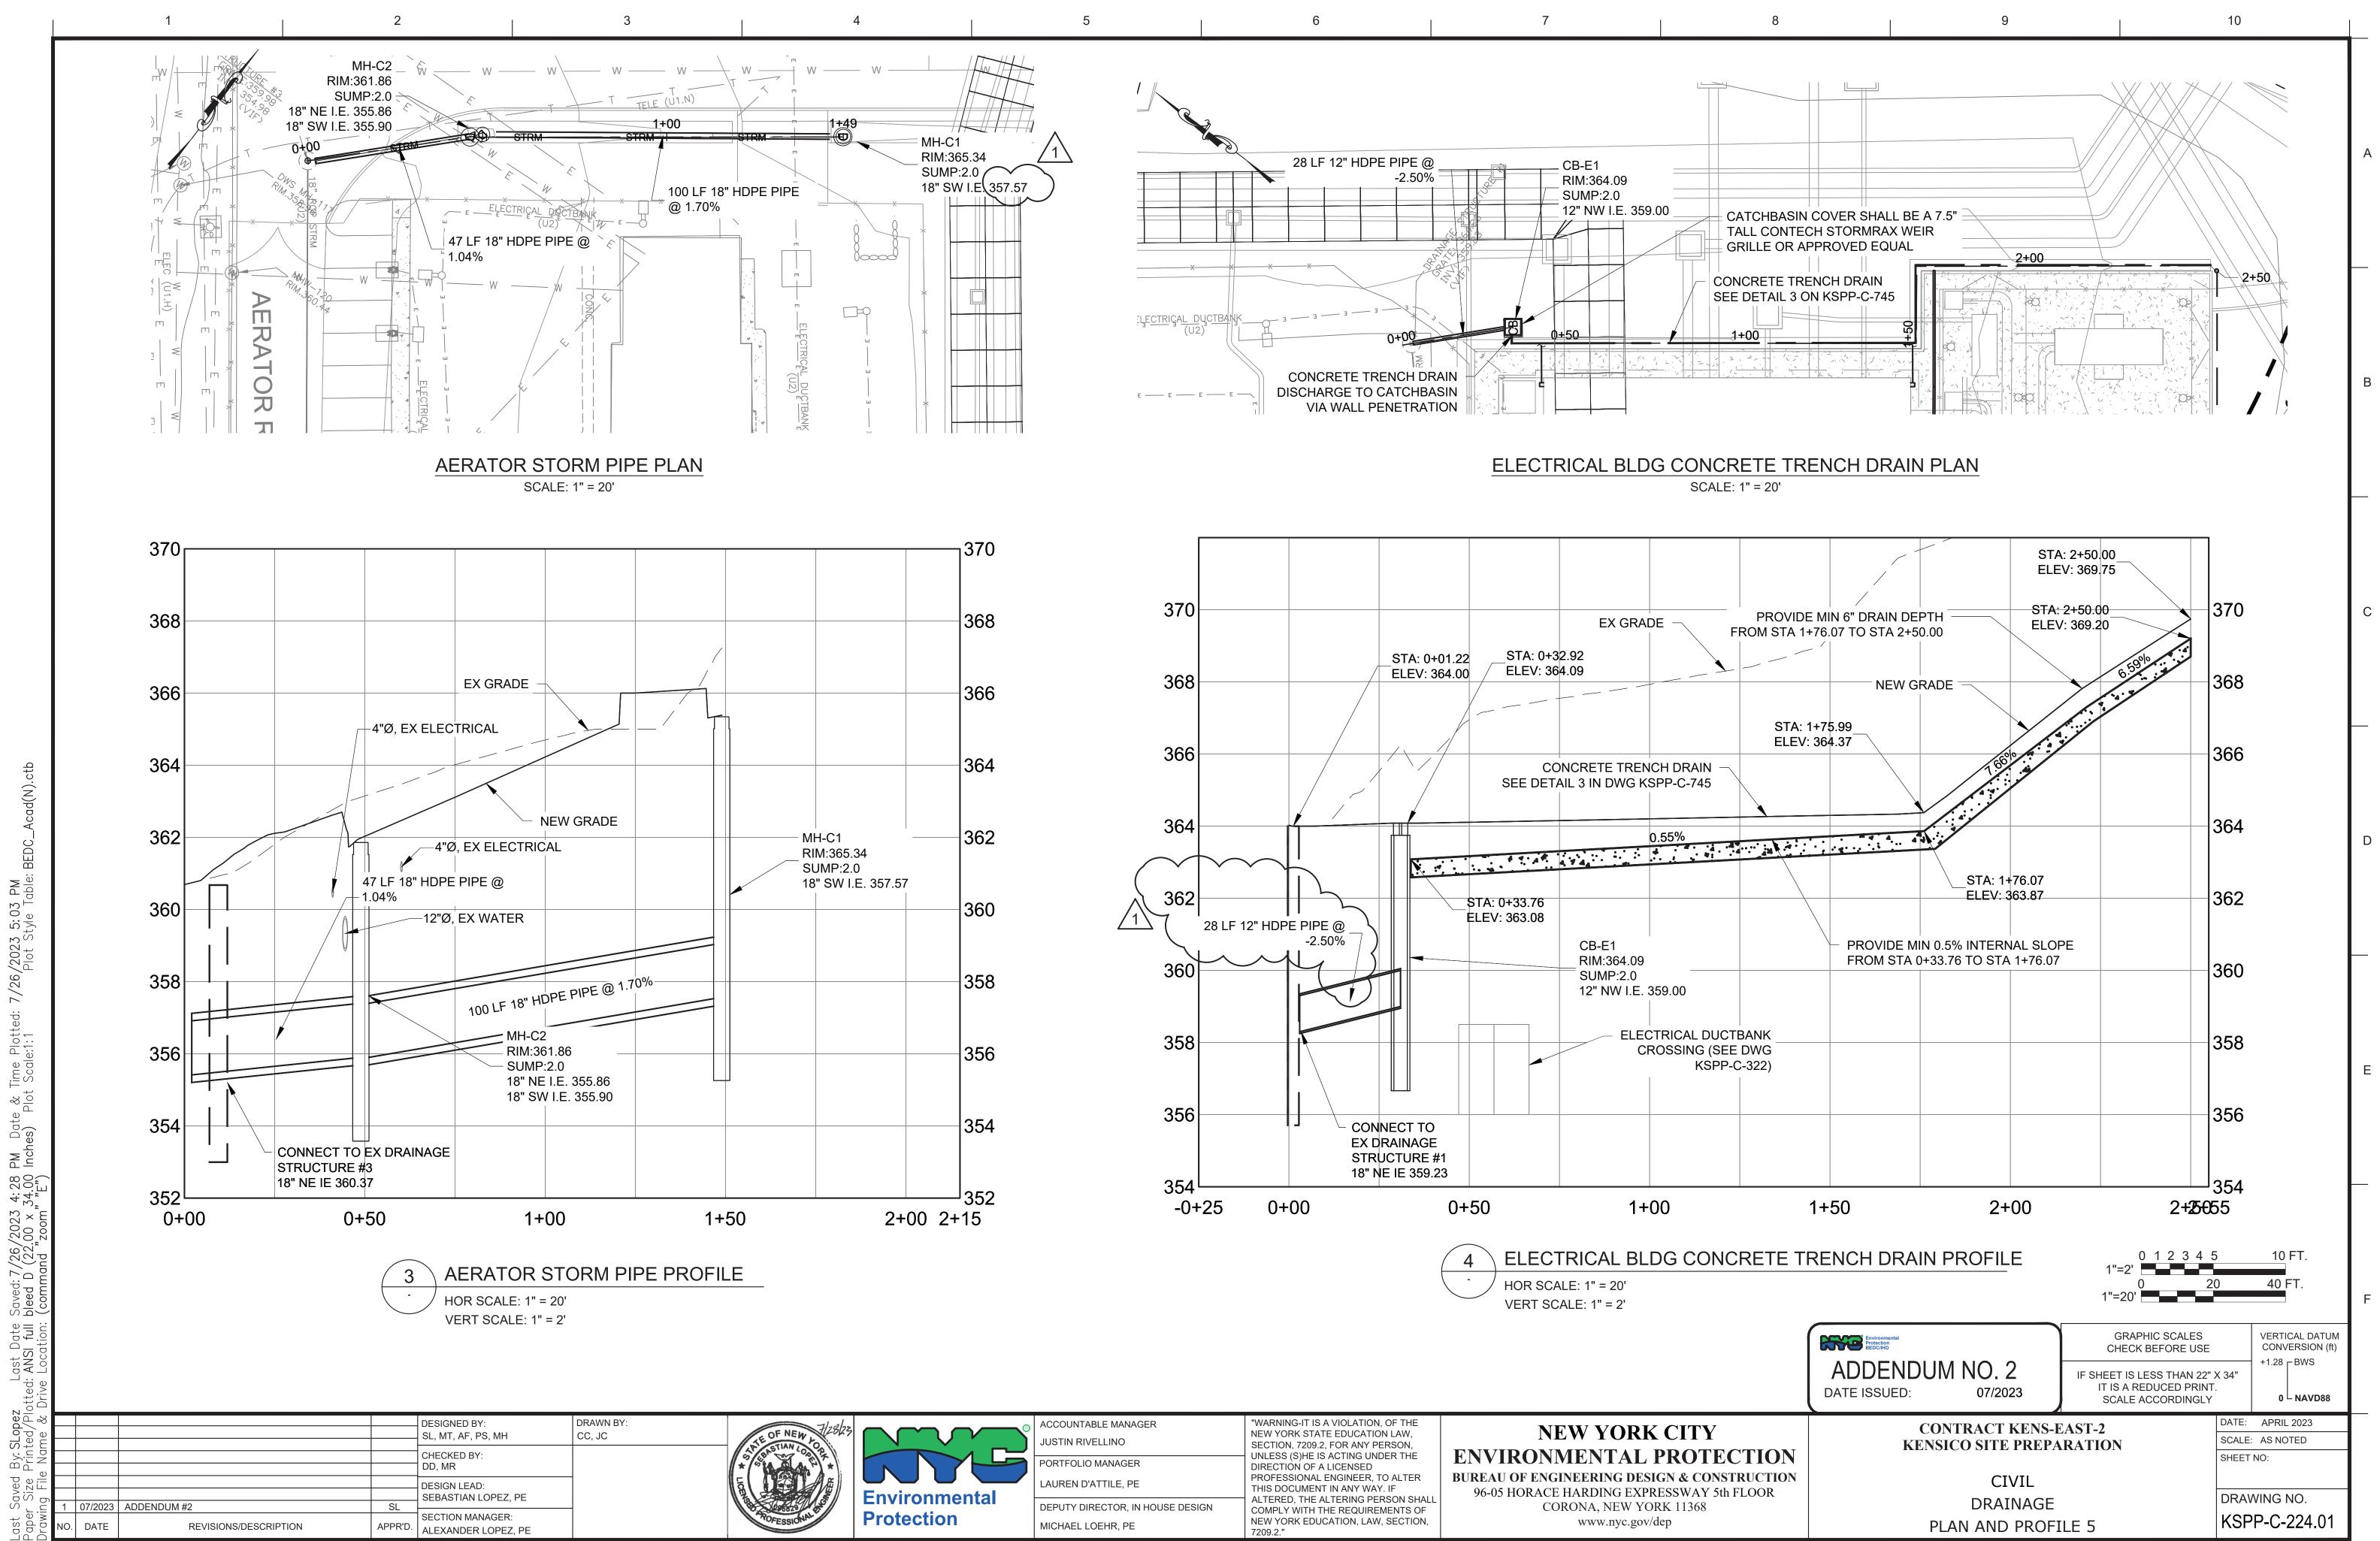


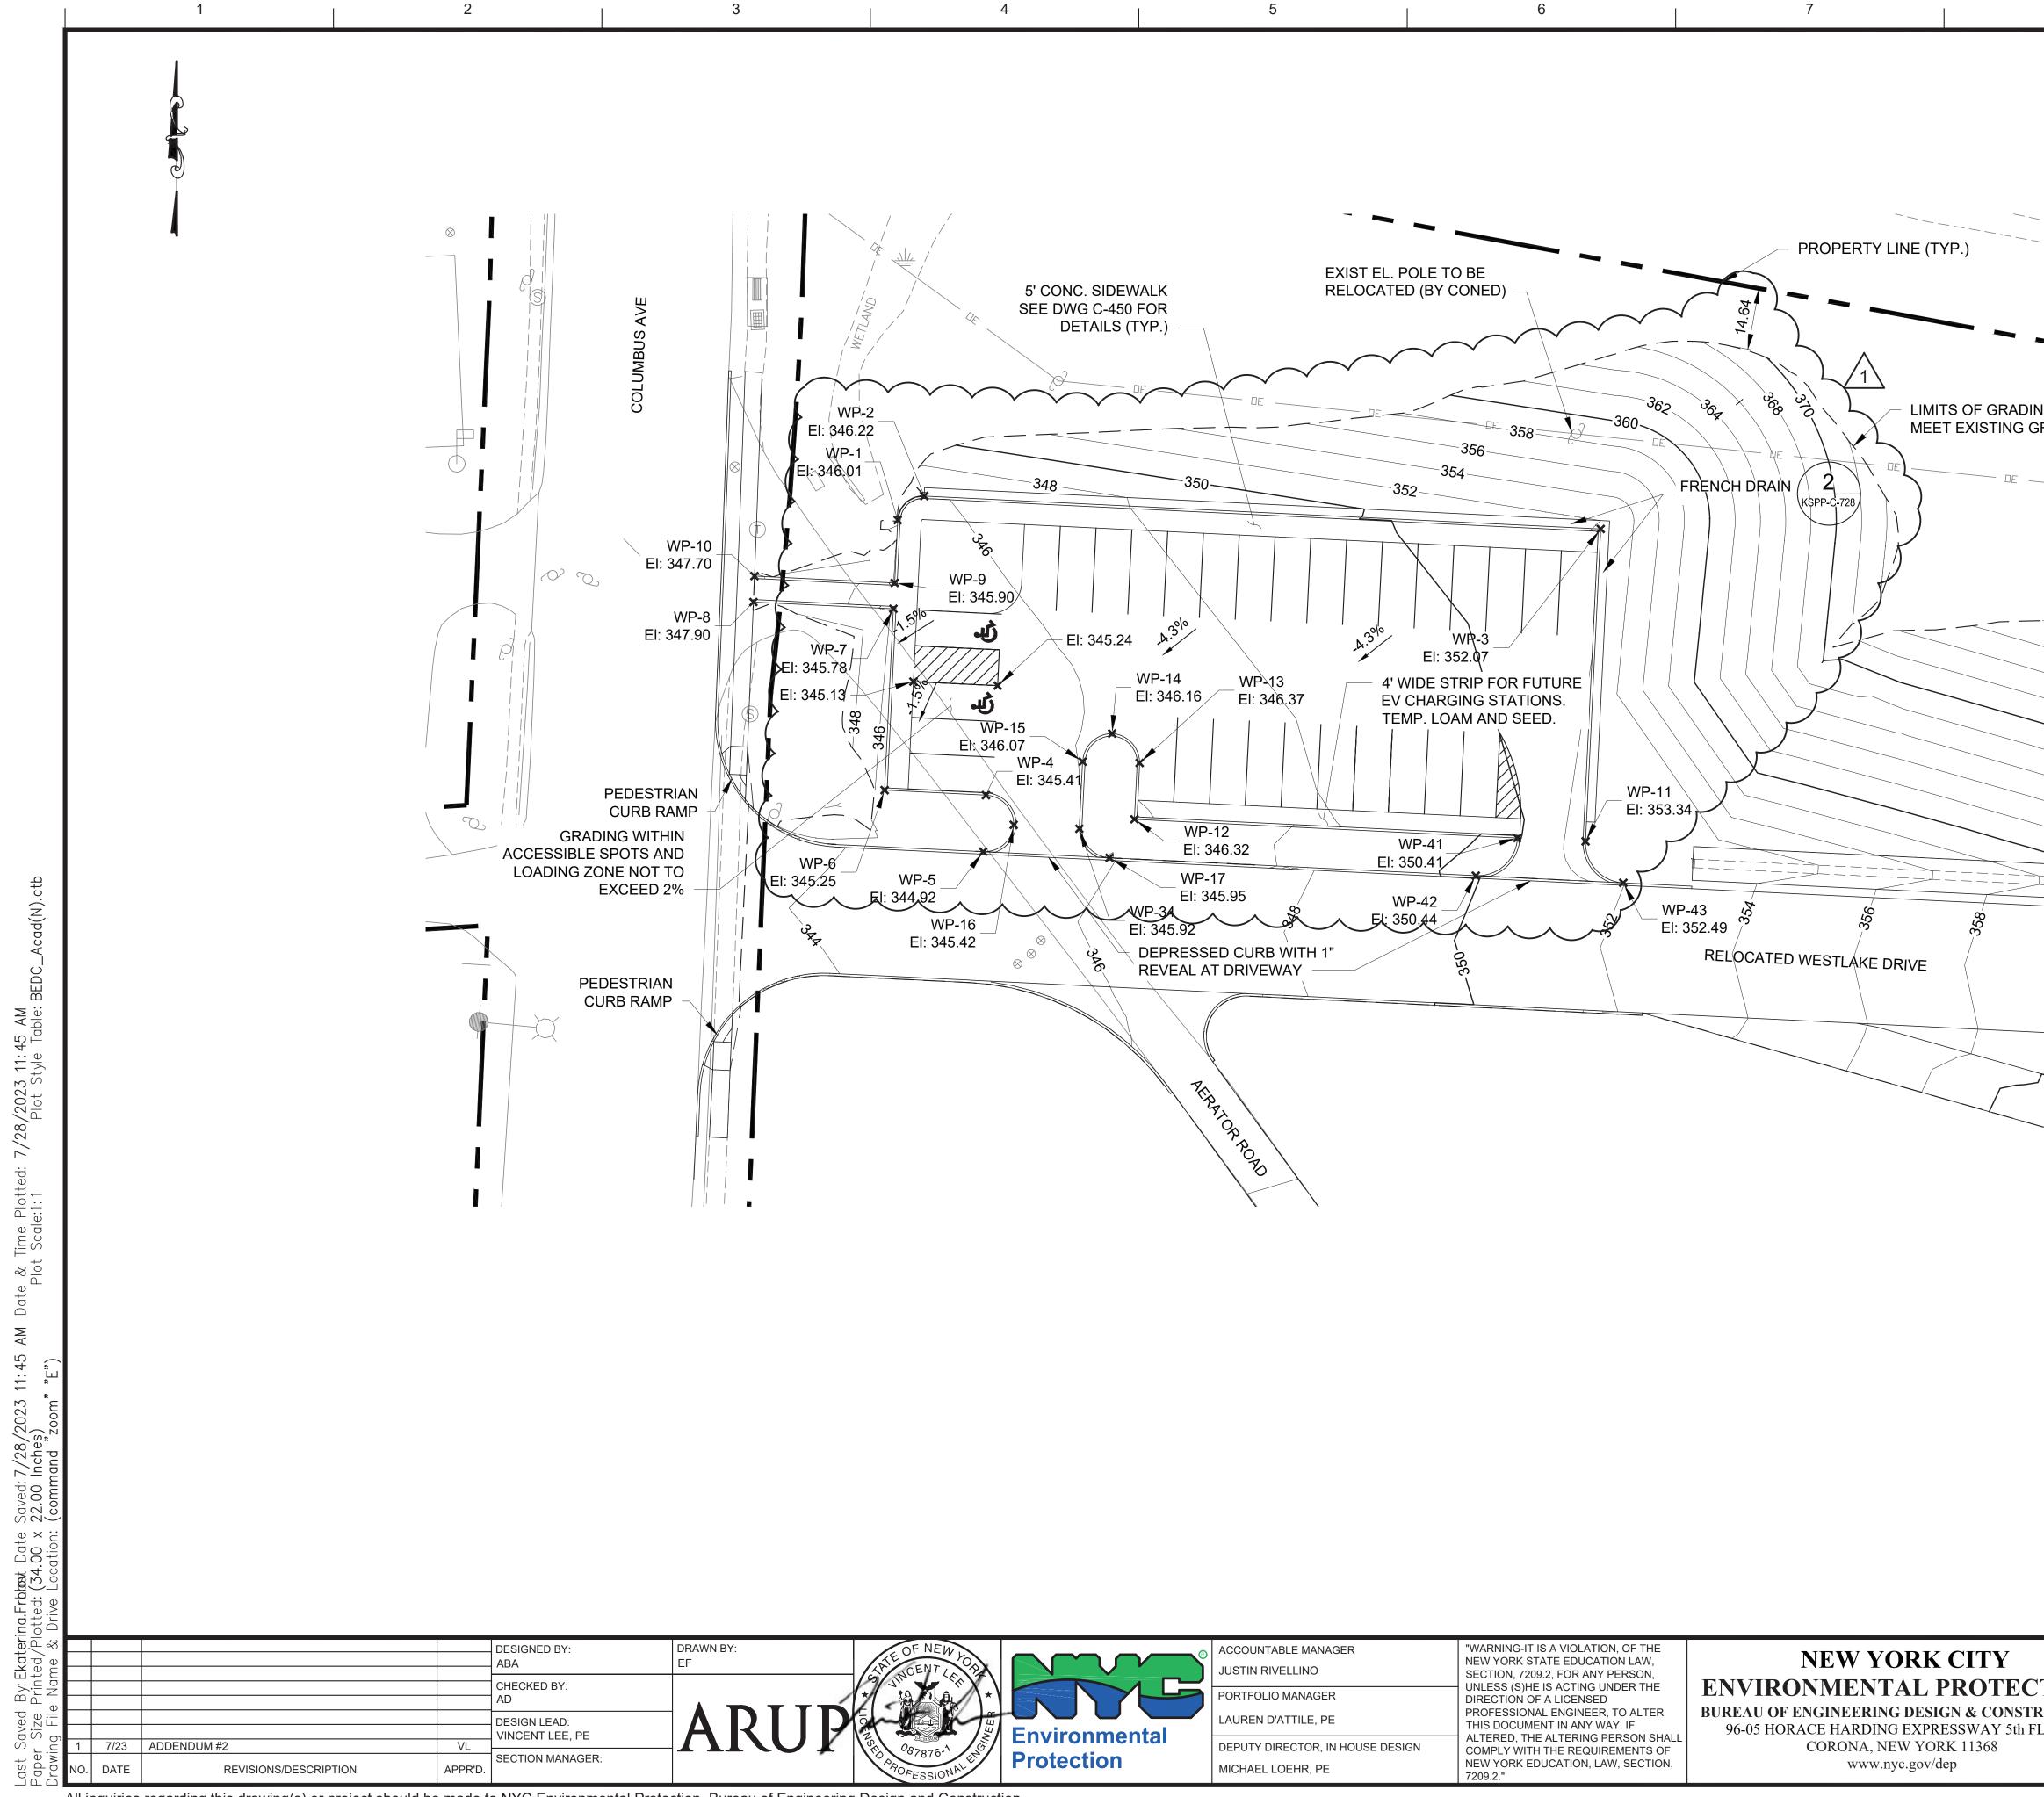

8	9		10	
	1. 2. 3.	FOR WP POINT COORDINA POINT TABLE ON DWG KSP ALL WP ELEVATIONS PRES FOR PARKING LOT SIGNIN PLAN REFER TO DWG KSP FOR PARKING LOT LIGHTIN ELECTRICAL WIRING REFE KFSC-E-420.	PP-C-402. SENT TOP OF CURB. G AND STRIPING PP-C-482. NG AND	А
_				-
ING (3:1 MAX GRADE	- K <u>(</u>			В
ð				
				С
				D
				E
	Evironmental Protection Protection	0 20 1"=20' GRAPHIC SCALES CHECK BEFORE USE	0 40 FT.	F
	ADDENDUM NO. 2 DATE ISSUED: 07/2023	IF SHEET IS LESS THAN 22". IT IS A REDUCED PRINT SCALE ACCORDINGLY	X 34" +1.28 BWS . 0 NAVD88	
CTION TRUCTION FLOOR	CONTRACT KENS KENSICO SITE PREP CIVIL PARKING LO GRADING	PARATION	DATE: JULY 2023 SCALE: AS NOTED SHEET NO: DRAWING NO. KSPP-C-225.01	

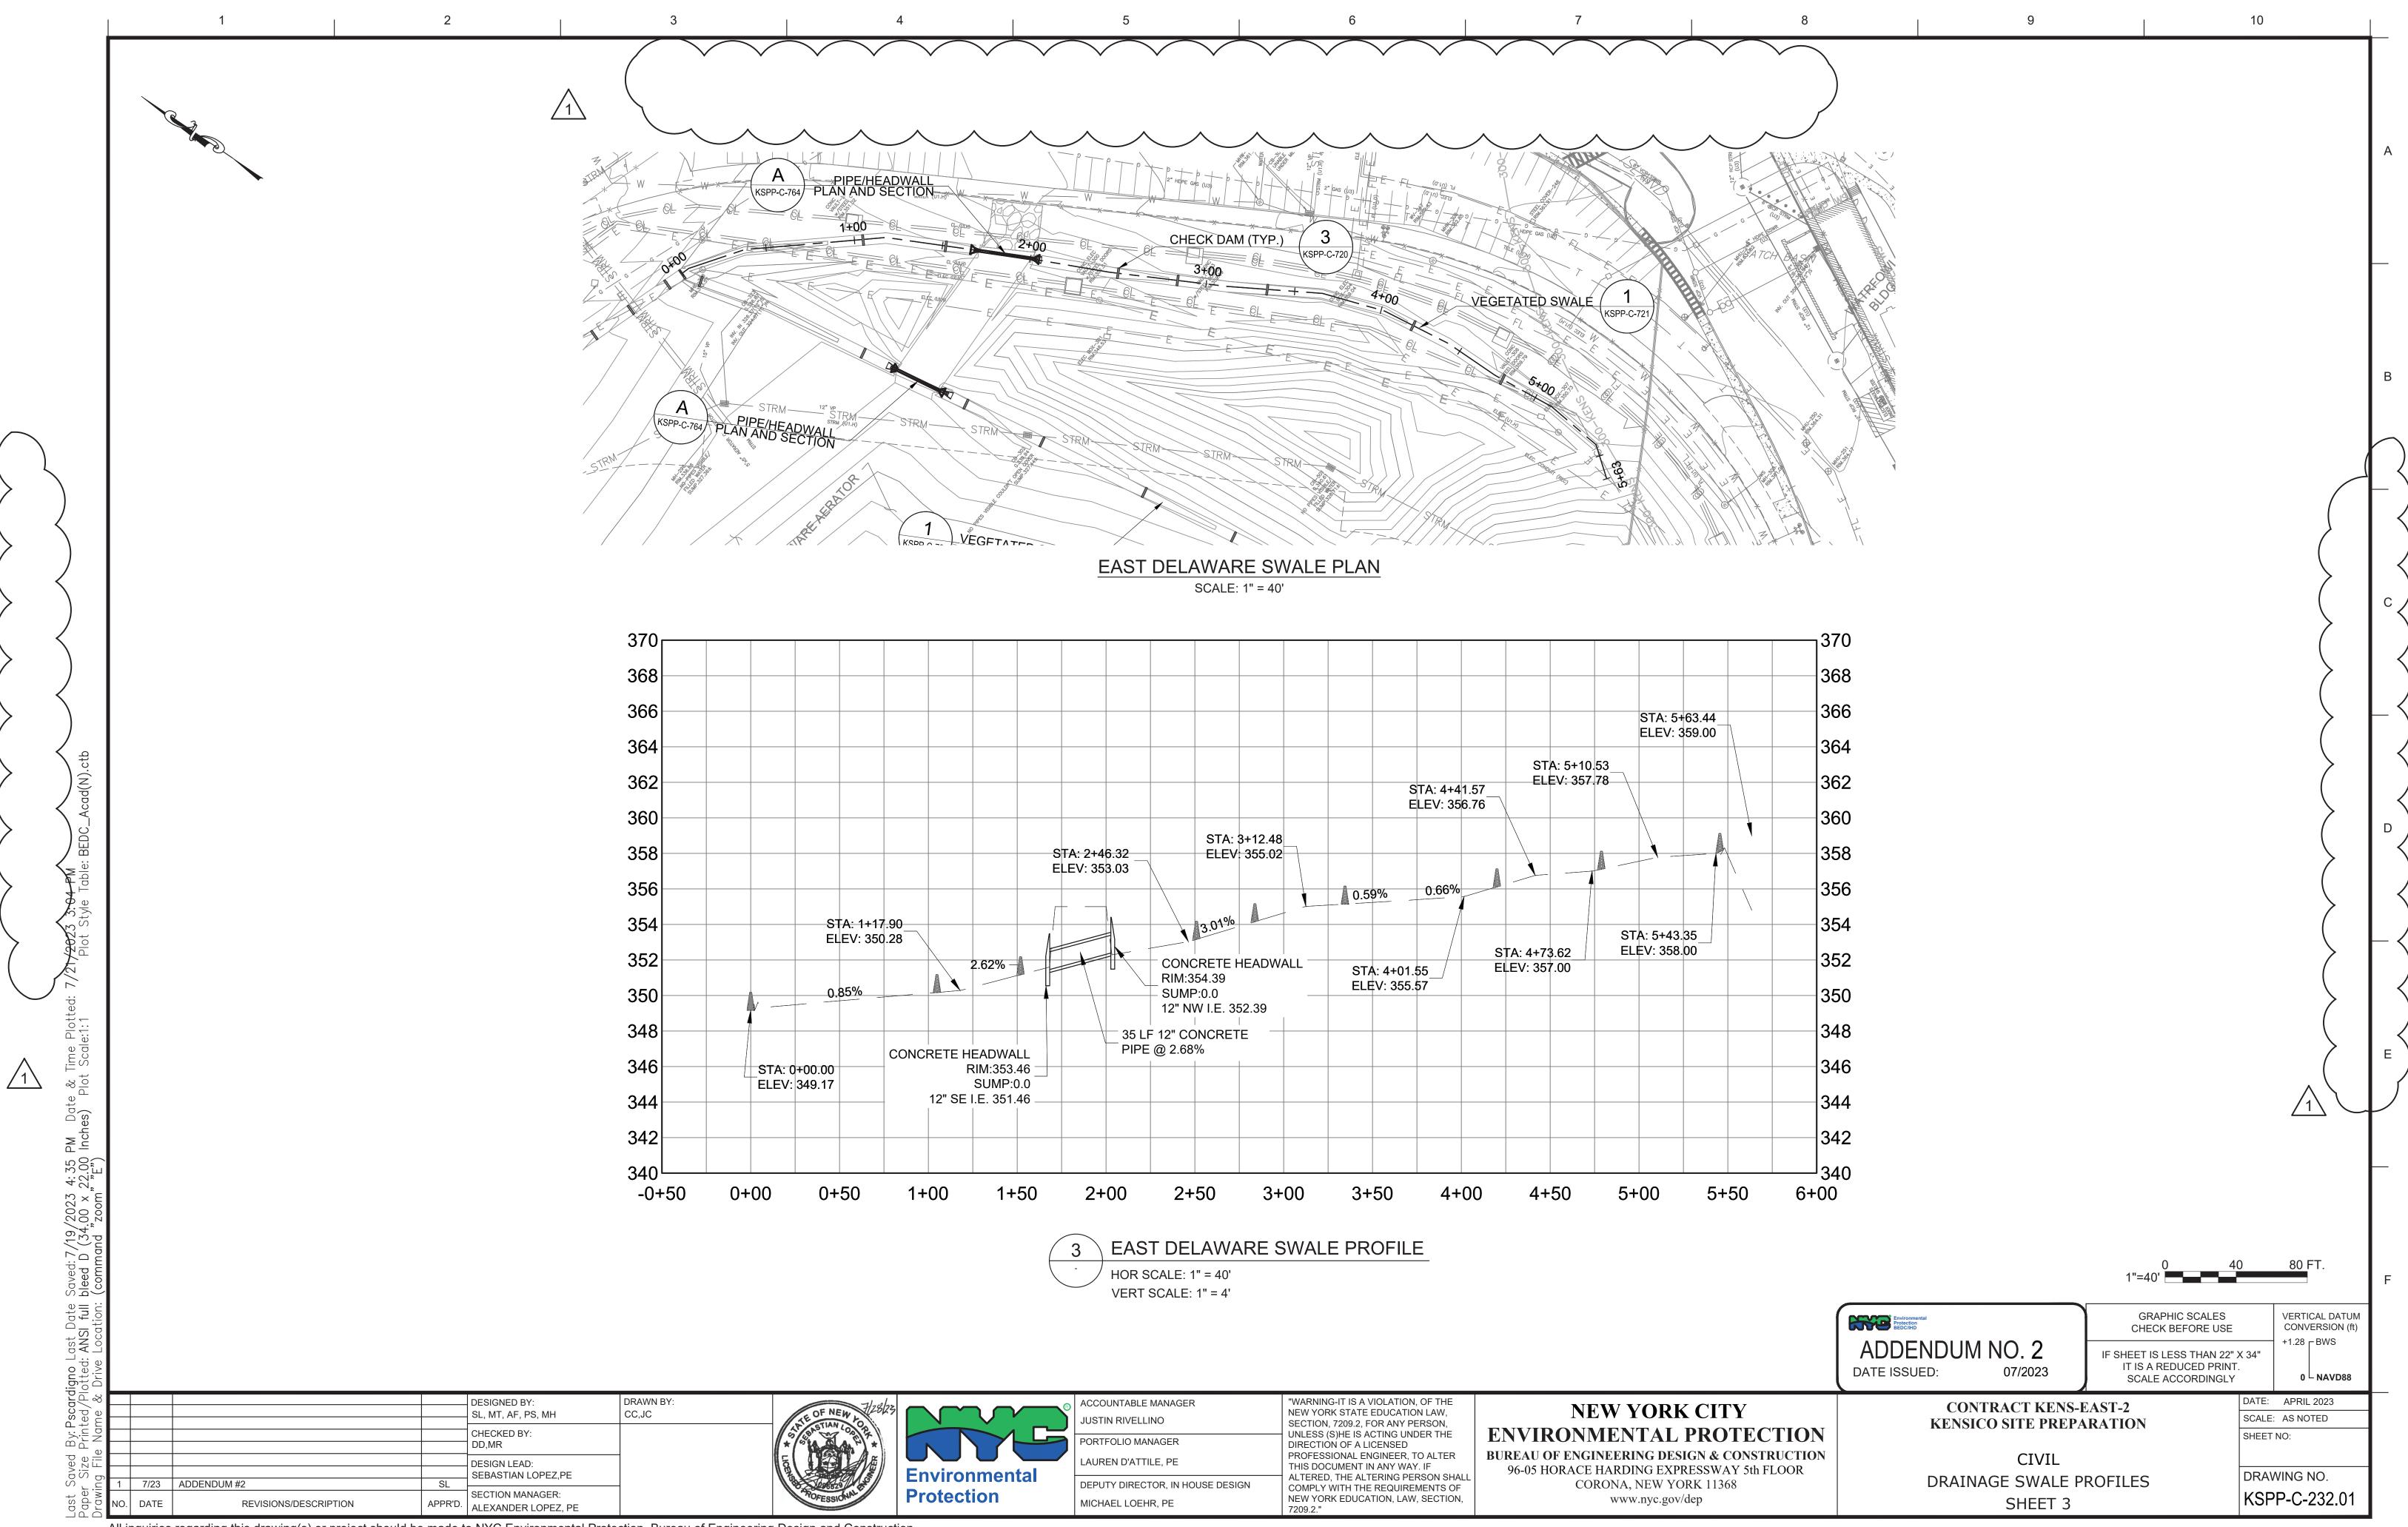


DRAINAGE SWALE
SHEET 3

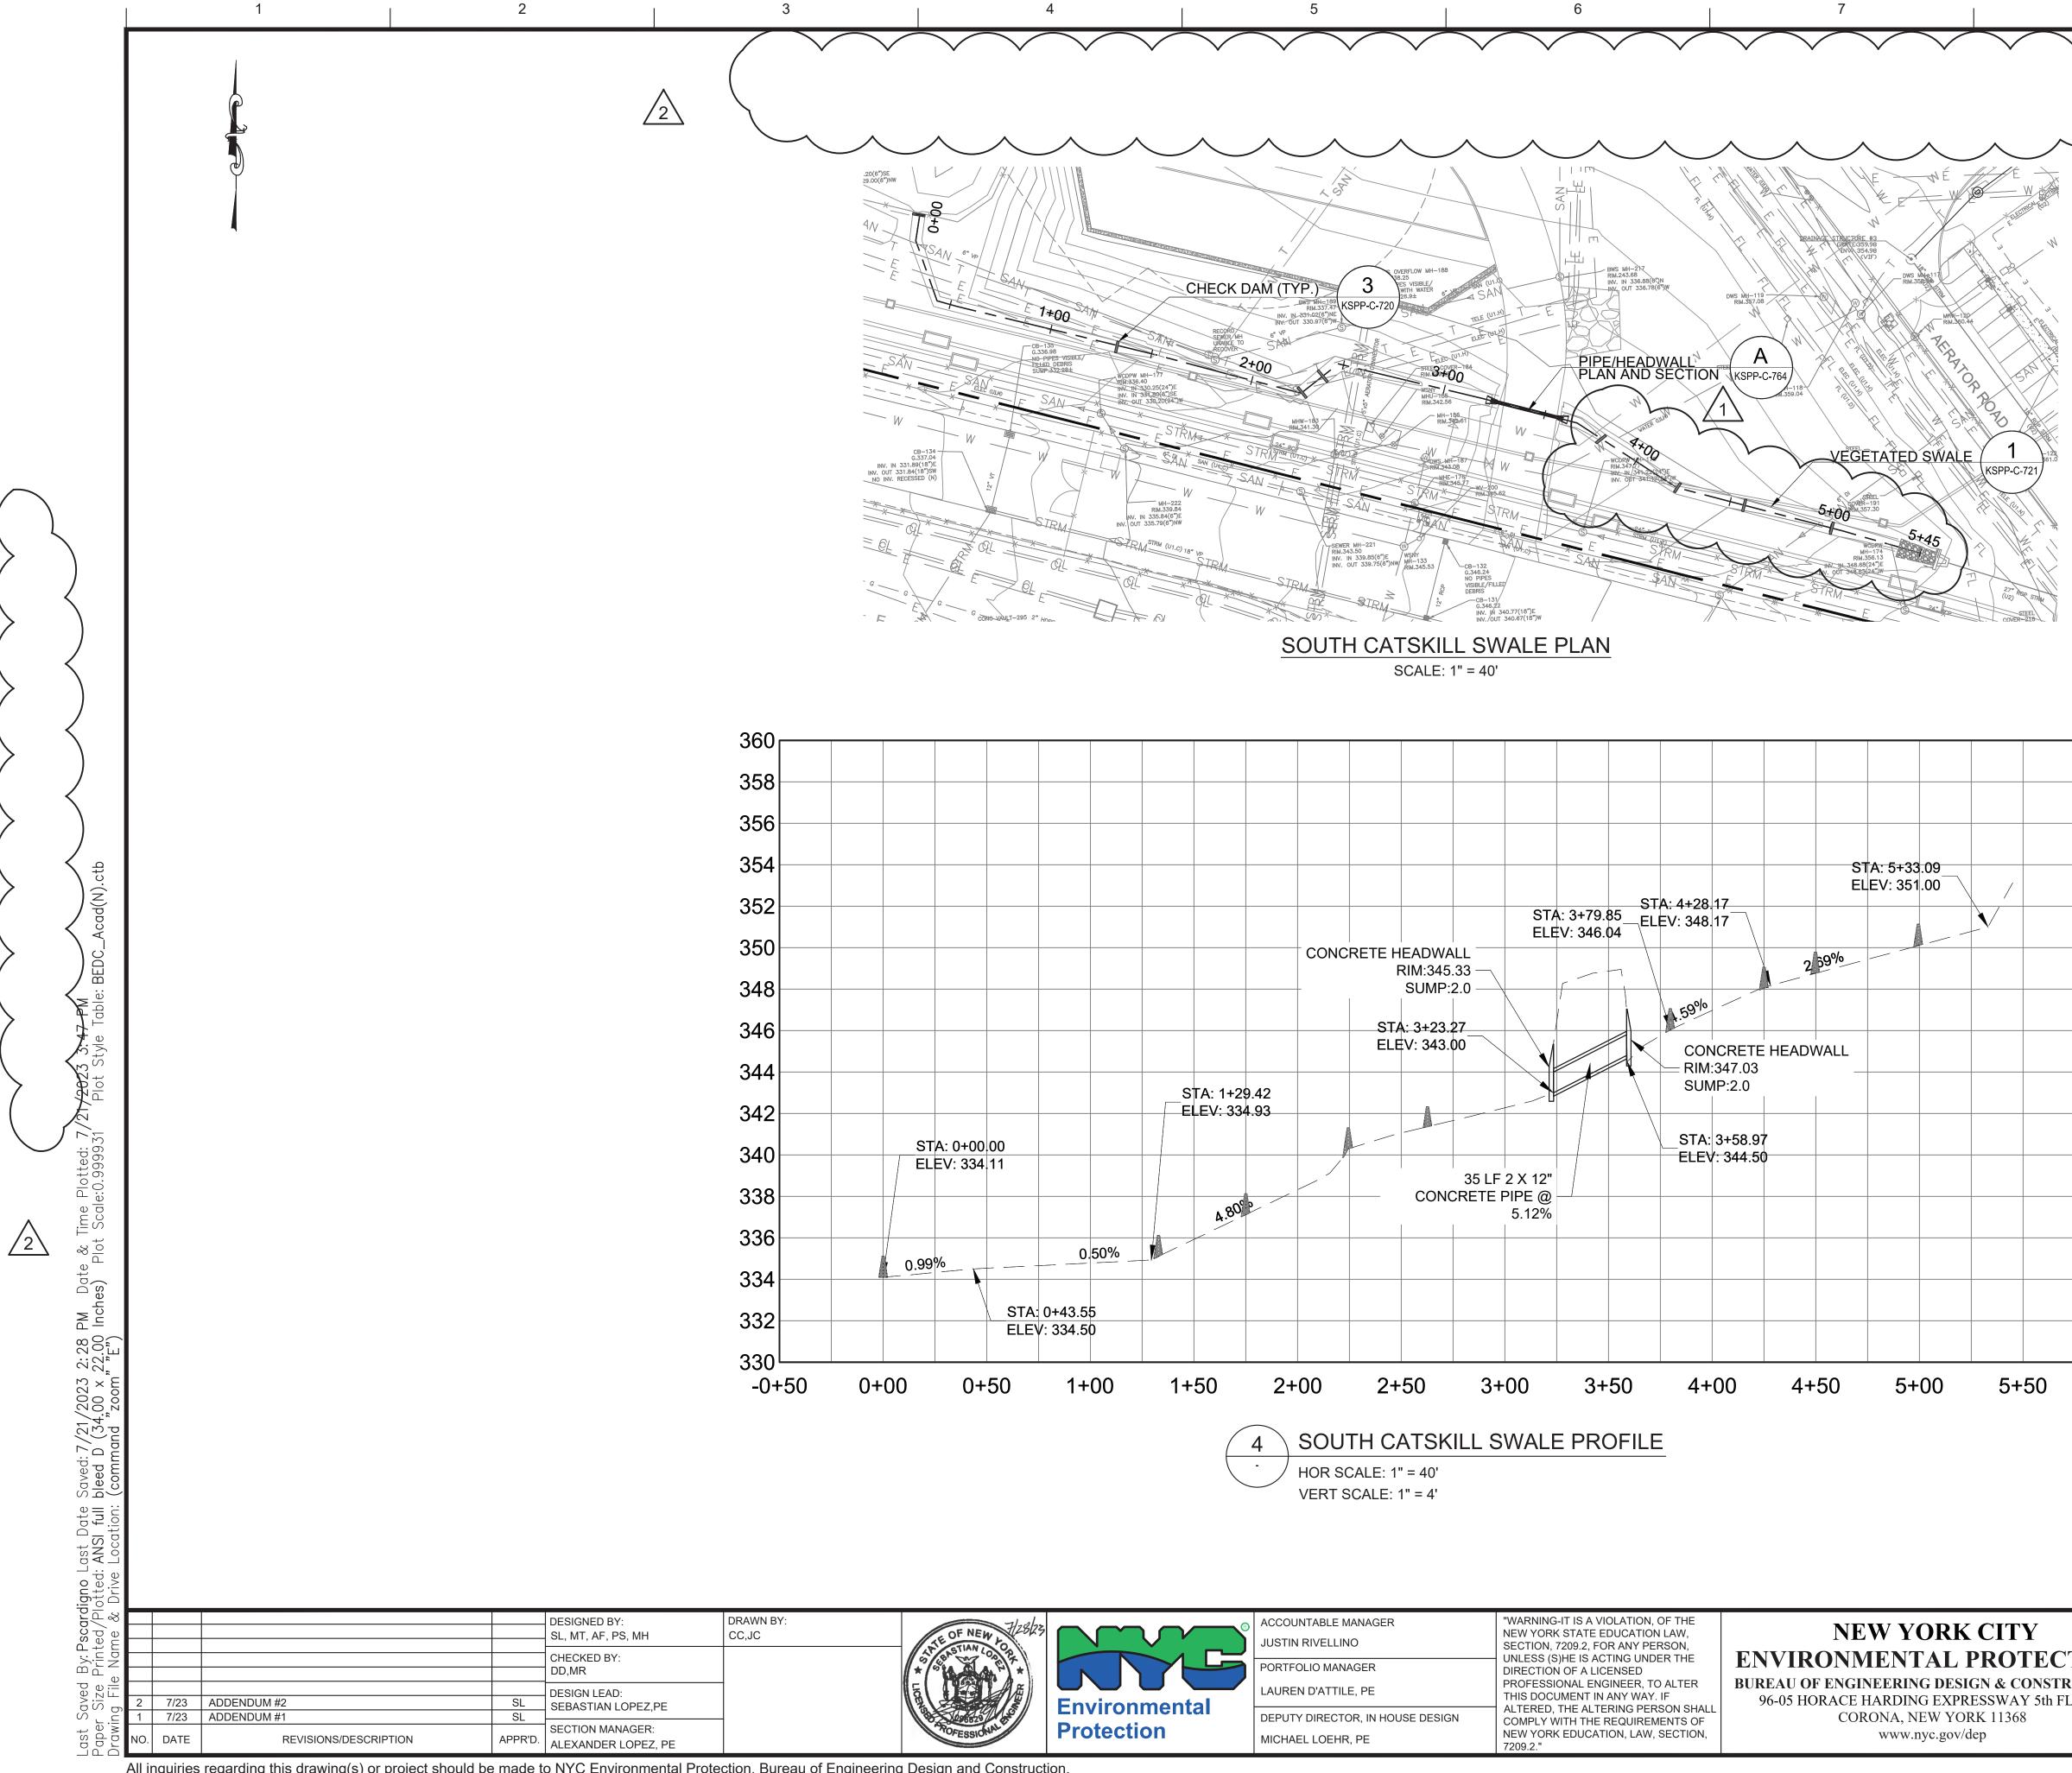


All inquiries regarding this drawing(s) or project should be made to NYC Environmental Protection, Bureau of Engineering Design and Construction.


8		9			10		
$\overline{}$							
							A
							В
							\bigcap
						X	
						\geq	
							°<
	60 50						<
	58 56						_ <
	54						
	52						
3	50					$\left\langle \right\rangle$	D
	48					\geq	
	46					\geq	
	44 42						- <
	40						
	38						_<
3	36						E
	34				Z	2	
	32						
6+0	30 D						
			1"=4	0 40) 80) FT.	F
			СН	RAPHIC SCALES ECK BEFORE USE	+1.2	TICAL DATUM NVERSION (ft) 8 ┌ ^{BWS}	
	DATE ISSUE	NDUM NO. 2 ED: 07/2023	IT IS	IS LESS THAN 22" > A REDUCED PRINT. LE ACCORDINGLY		0 – NAVD88	
ΤΙΛΝ		CONTRACT KENS- KENSICO SITE PREPA			SCALE: AS N	RIL 2023 NOTED	
CTION TRUCTION FLOOR		CIVIL			SHEET NO:		
		DRAINAGE SWALL FROTILLS				-233.02	

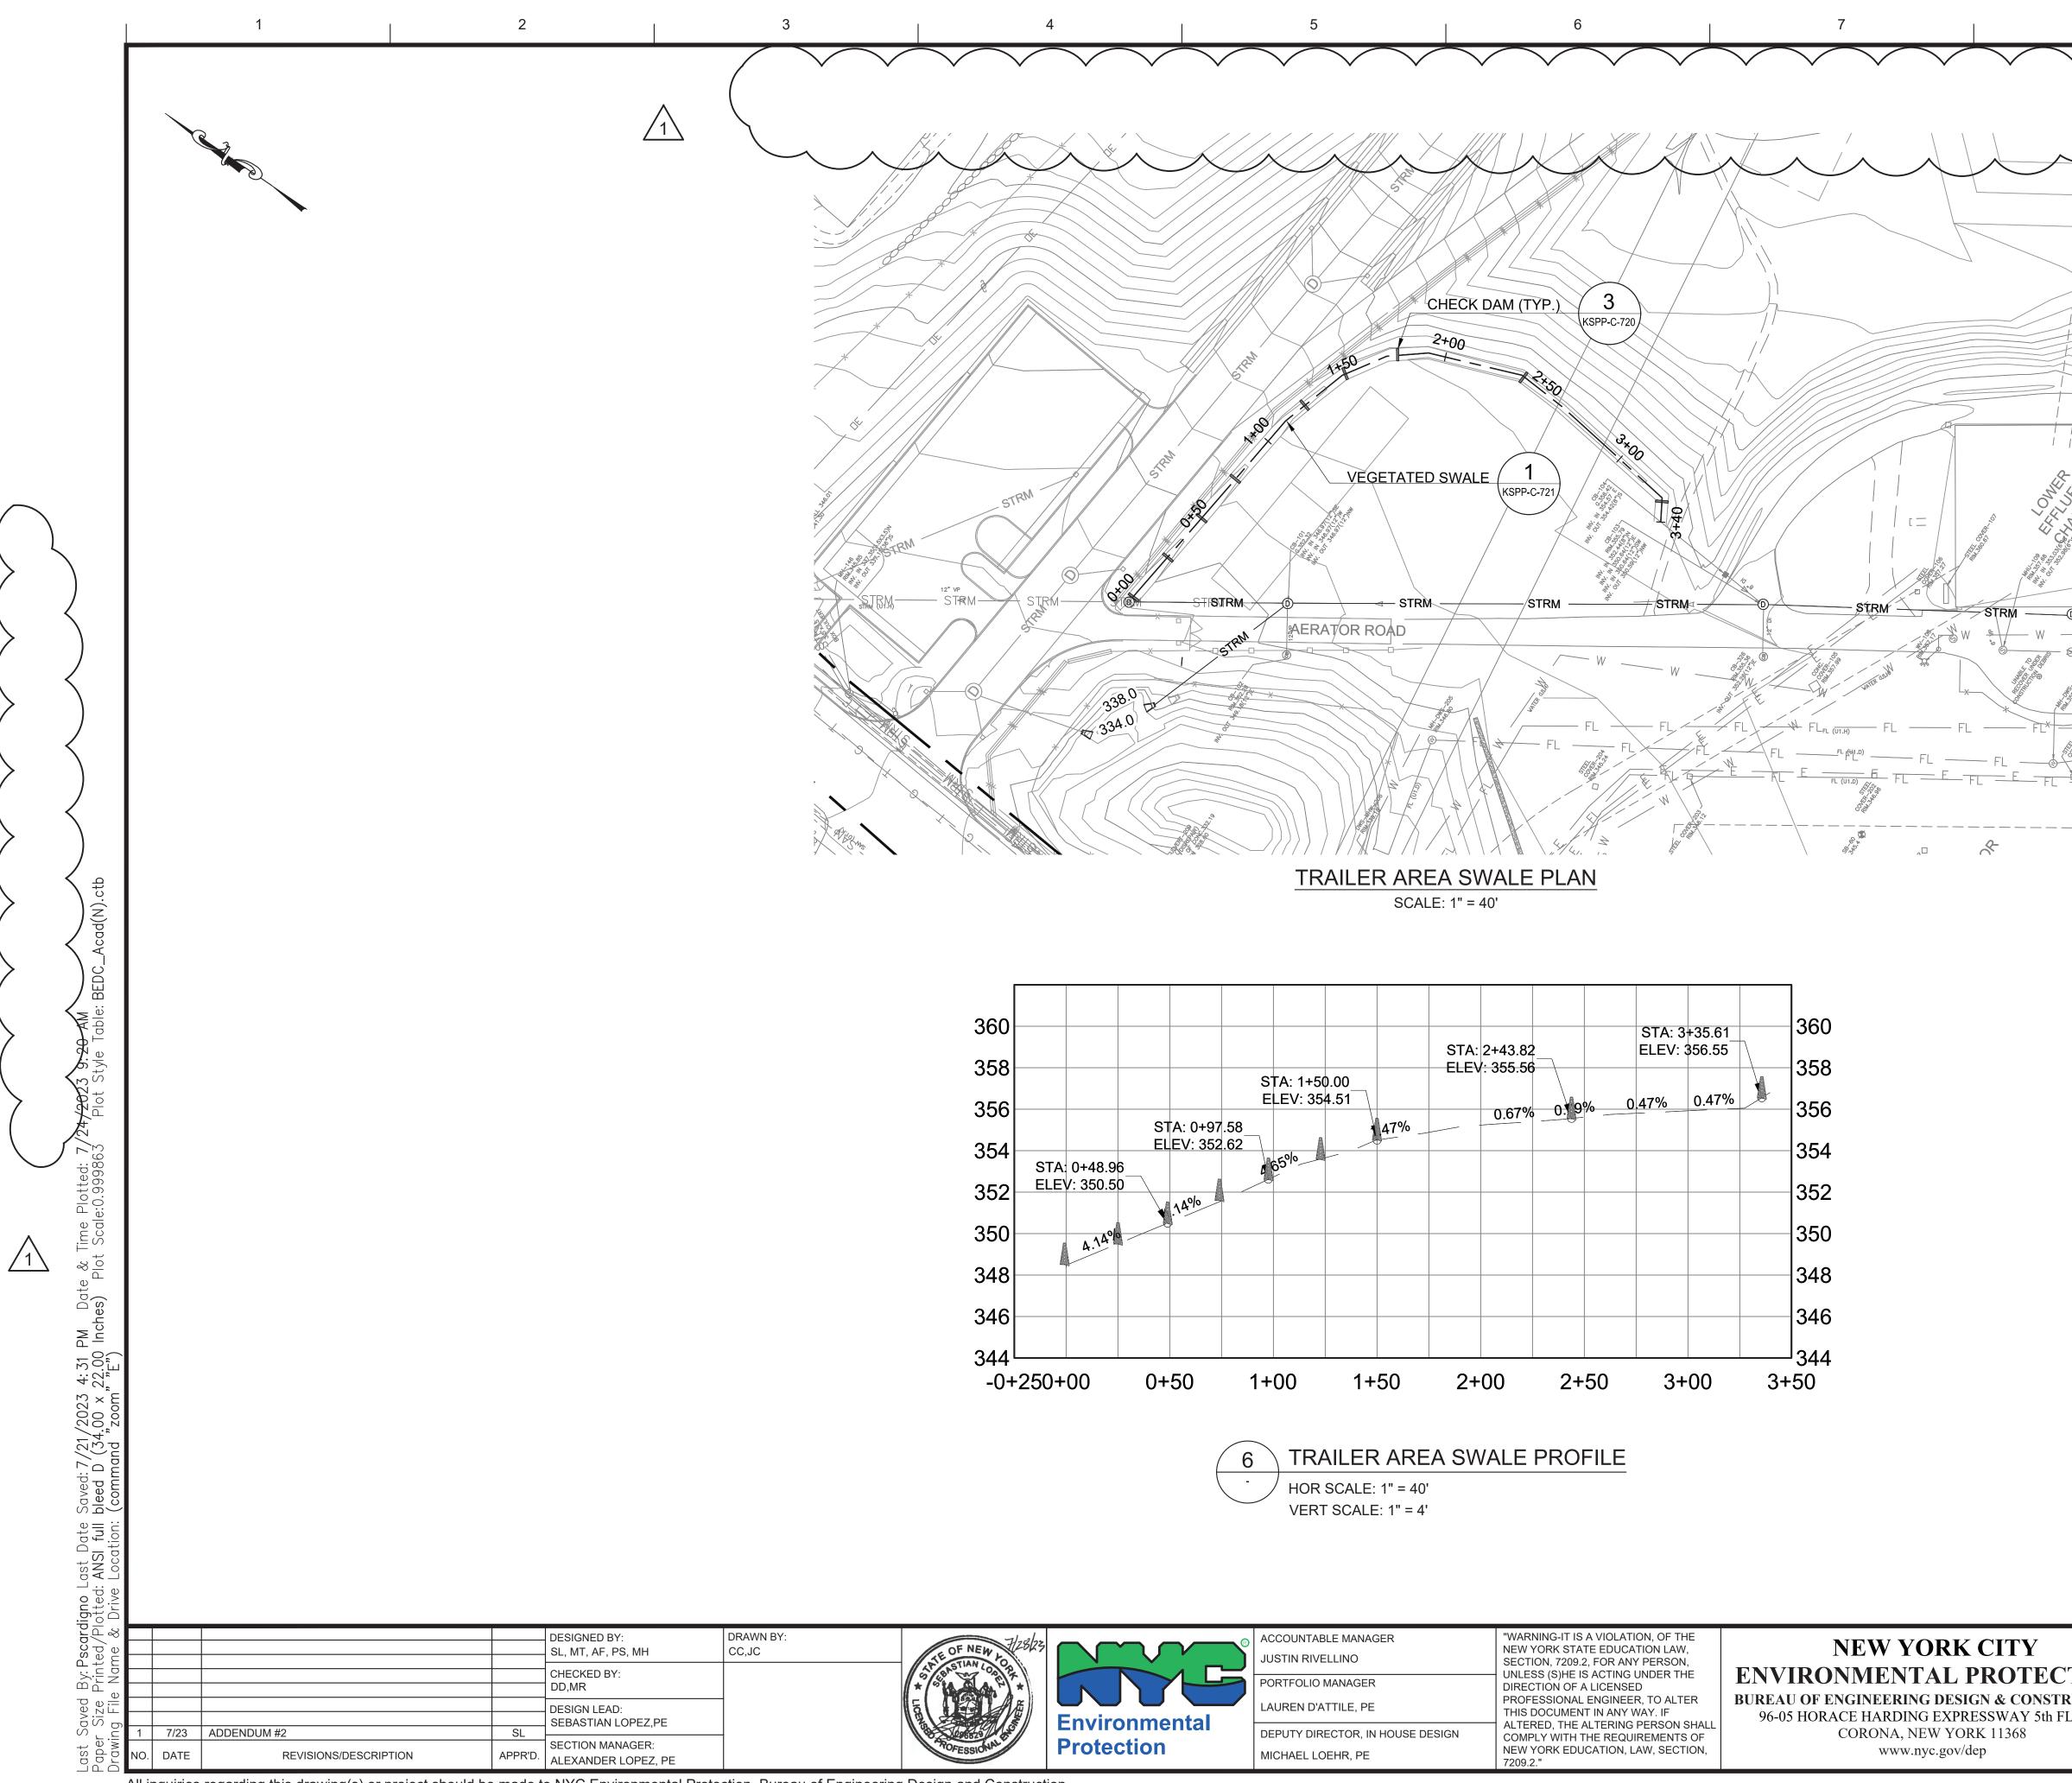

OUNTABLE MANAGER	"WARNIN
TIN RIVELLINO	NEW YOR
TFOLIO MANAGER	UNLESS (DIRECTIC
REN D'ATTILE, PE	PROFESS THIS DOC
UTY DIRECTOR, IN HOUSE DESIGN	ALTERED COMPLY
	NEW YOR

8			9			10		
								A
0 1 2000								В
1		ndu NOUM NO		СН	GRAPHIC SCALE	SE	80 FT. VERTICAL DATUM CONVERSION (ft) +1.28 GBWS	F
CTION RUCTION FLOOR	DATE ISSU	DED: 07. CONTRAC KENSICO SI DRAINAGE S	7/2023 CT KENS-F TE PREPA CIVIL	EAST-2		RINT. GLY DATE: SCALE: SHEET I DRAW	0 NAVD88 APRIL 2023 AS NOTED NO: VING NO. P-C-235.01	

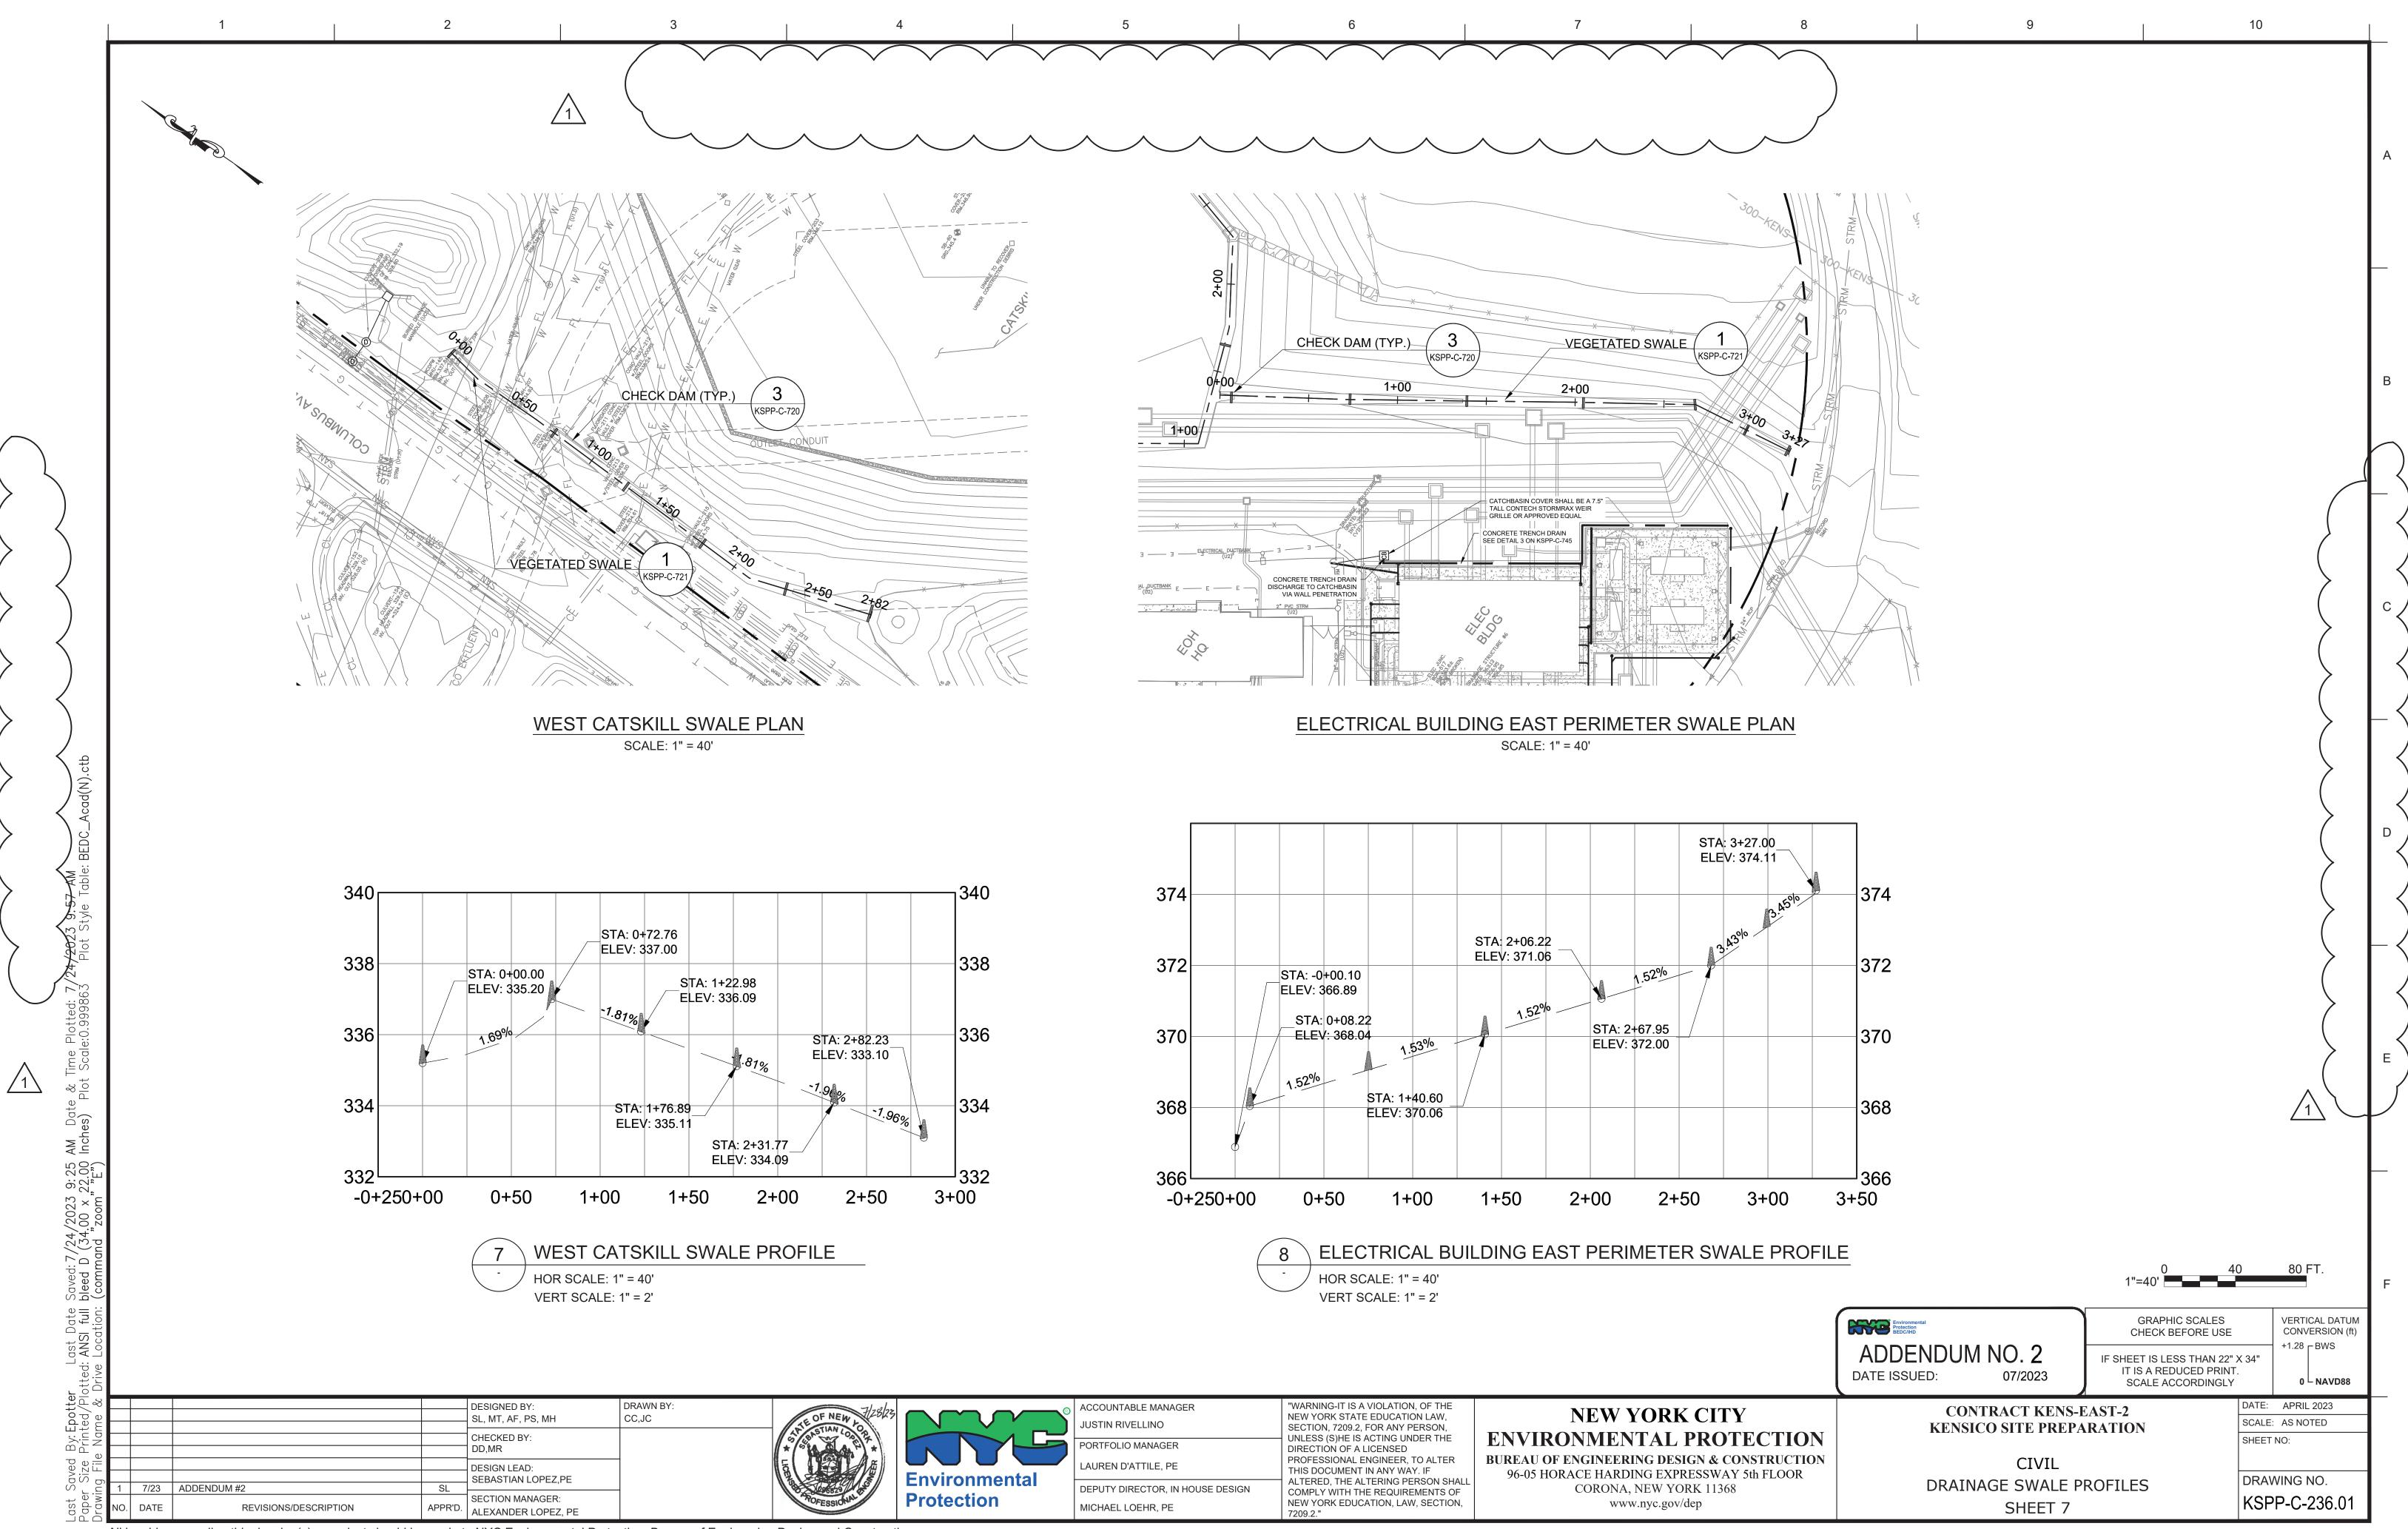

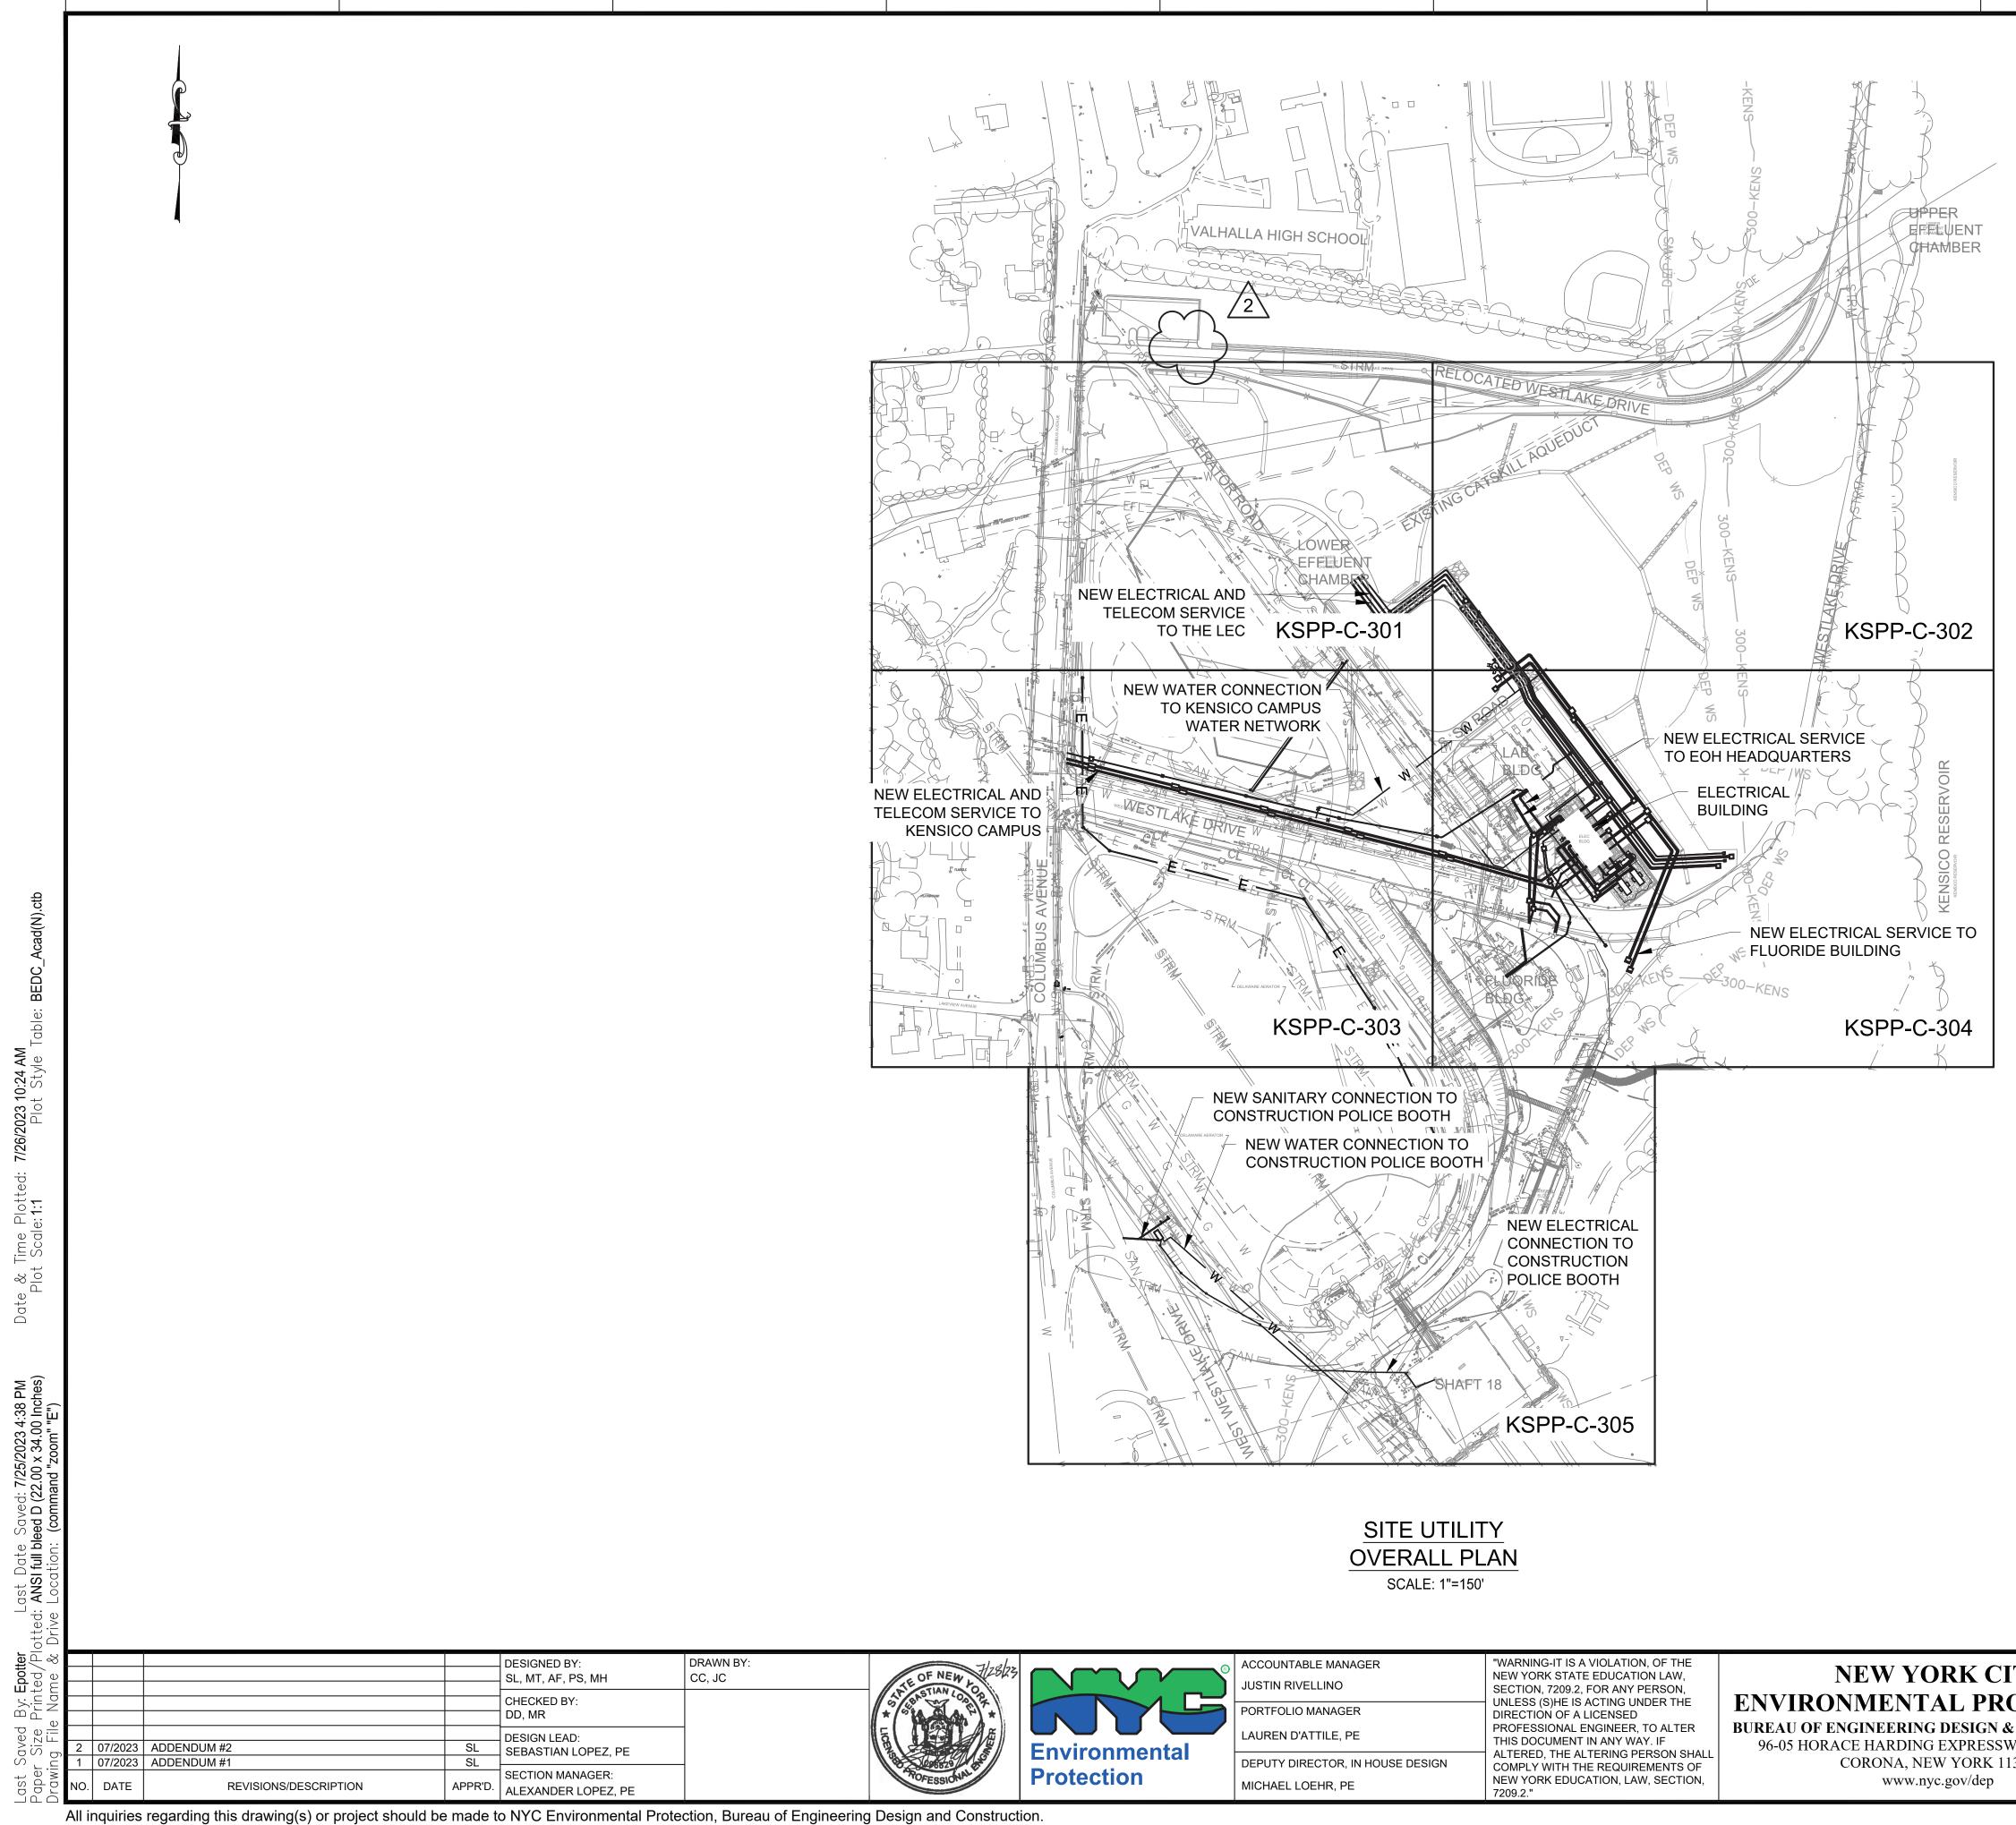

2


)	ACCOUNTABLE MANAGER
	JUSTIN RIVELLINO
	PORTFOLIO MANAGER
	LAUREN D'ATTILE, PE
	DEPUTY DIRECTOR, IN HOUSE DESIG


NEW YORK CITY ENVIRONMENTAL PROTEC BUREAU OF ENGINEERING DESIGN & CONSTR 96-05 HORACE HARDING EXPRESSWAY 5th Fl CORONA, NEW YORK 11368


		0 15 1"=150' 11 150	50	300 FT.	F
	ADDENDUM NO. 2 DATE ISSUED: 07/2023	GRAPHIC SCALES CHECK BEFORE USE IF SHEET IS LESS THAN 22" 2 IT IS A REDUCED PRINT SCALE ACCORDINGLY		VERTICAL DATUM CONVERSION (ft) +1.28 BWS 0 NAVD88	
TION RUCTION LOOR	CONTRACT KENS-E KENSICO SITE PREPA CIVIL SITE UTILITY OVERALL PLA	RATION	SHEET	APRIL 2023 AS NOTED NO: WING NO. P-C-300.02	

10

D

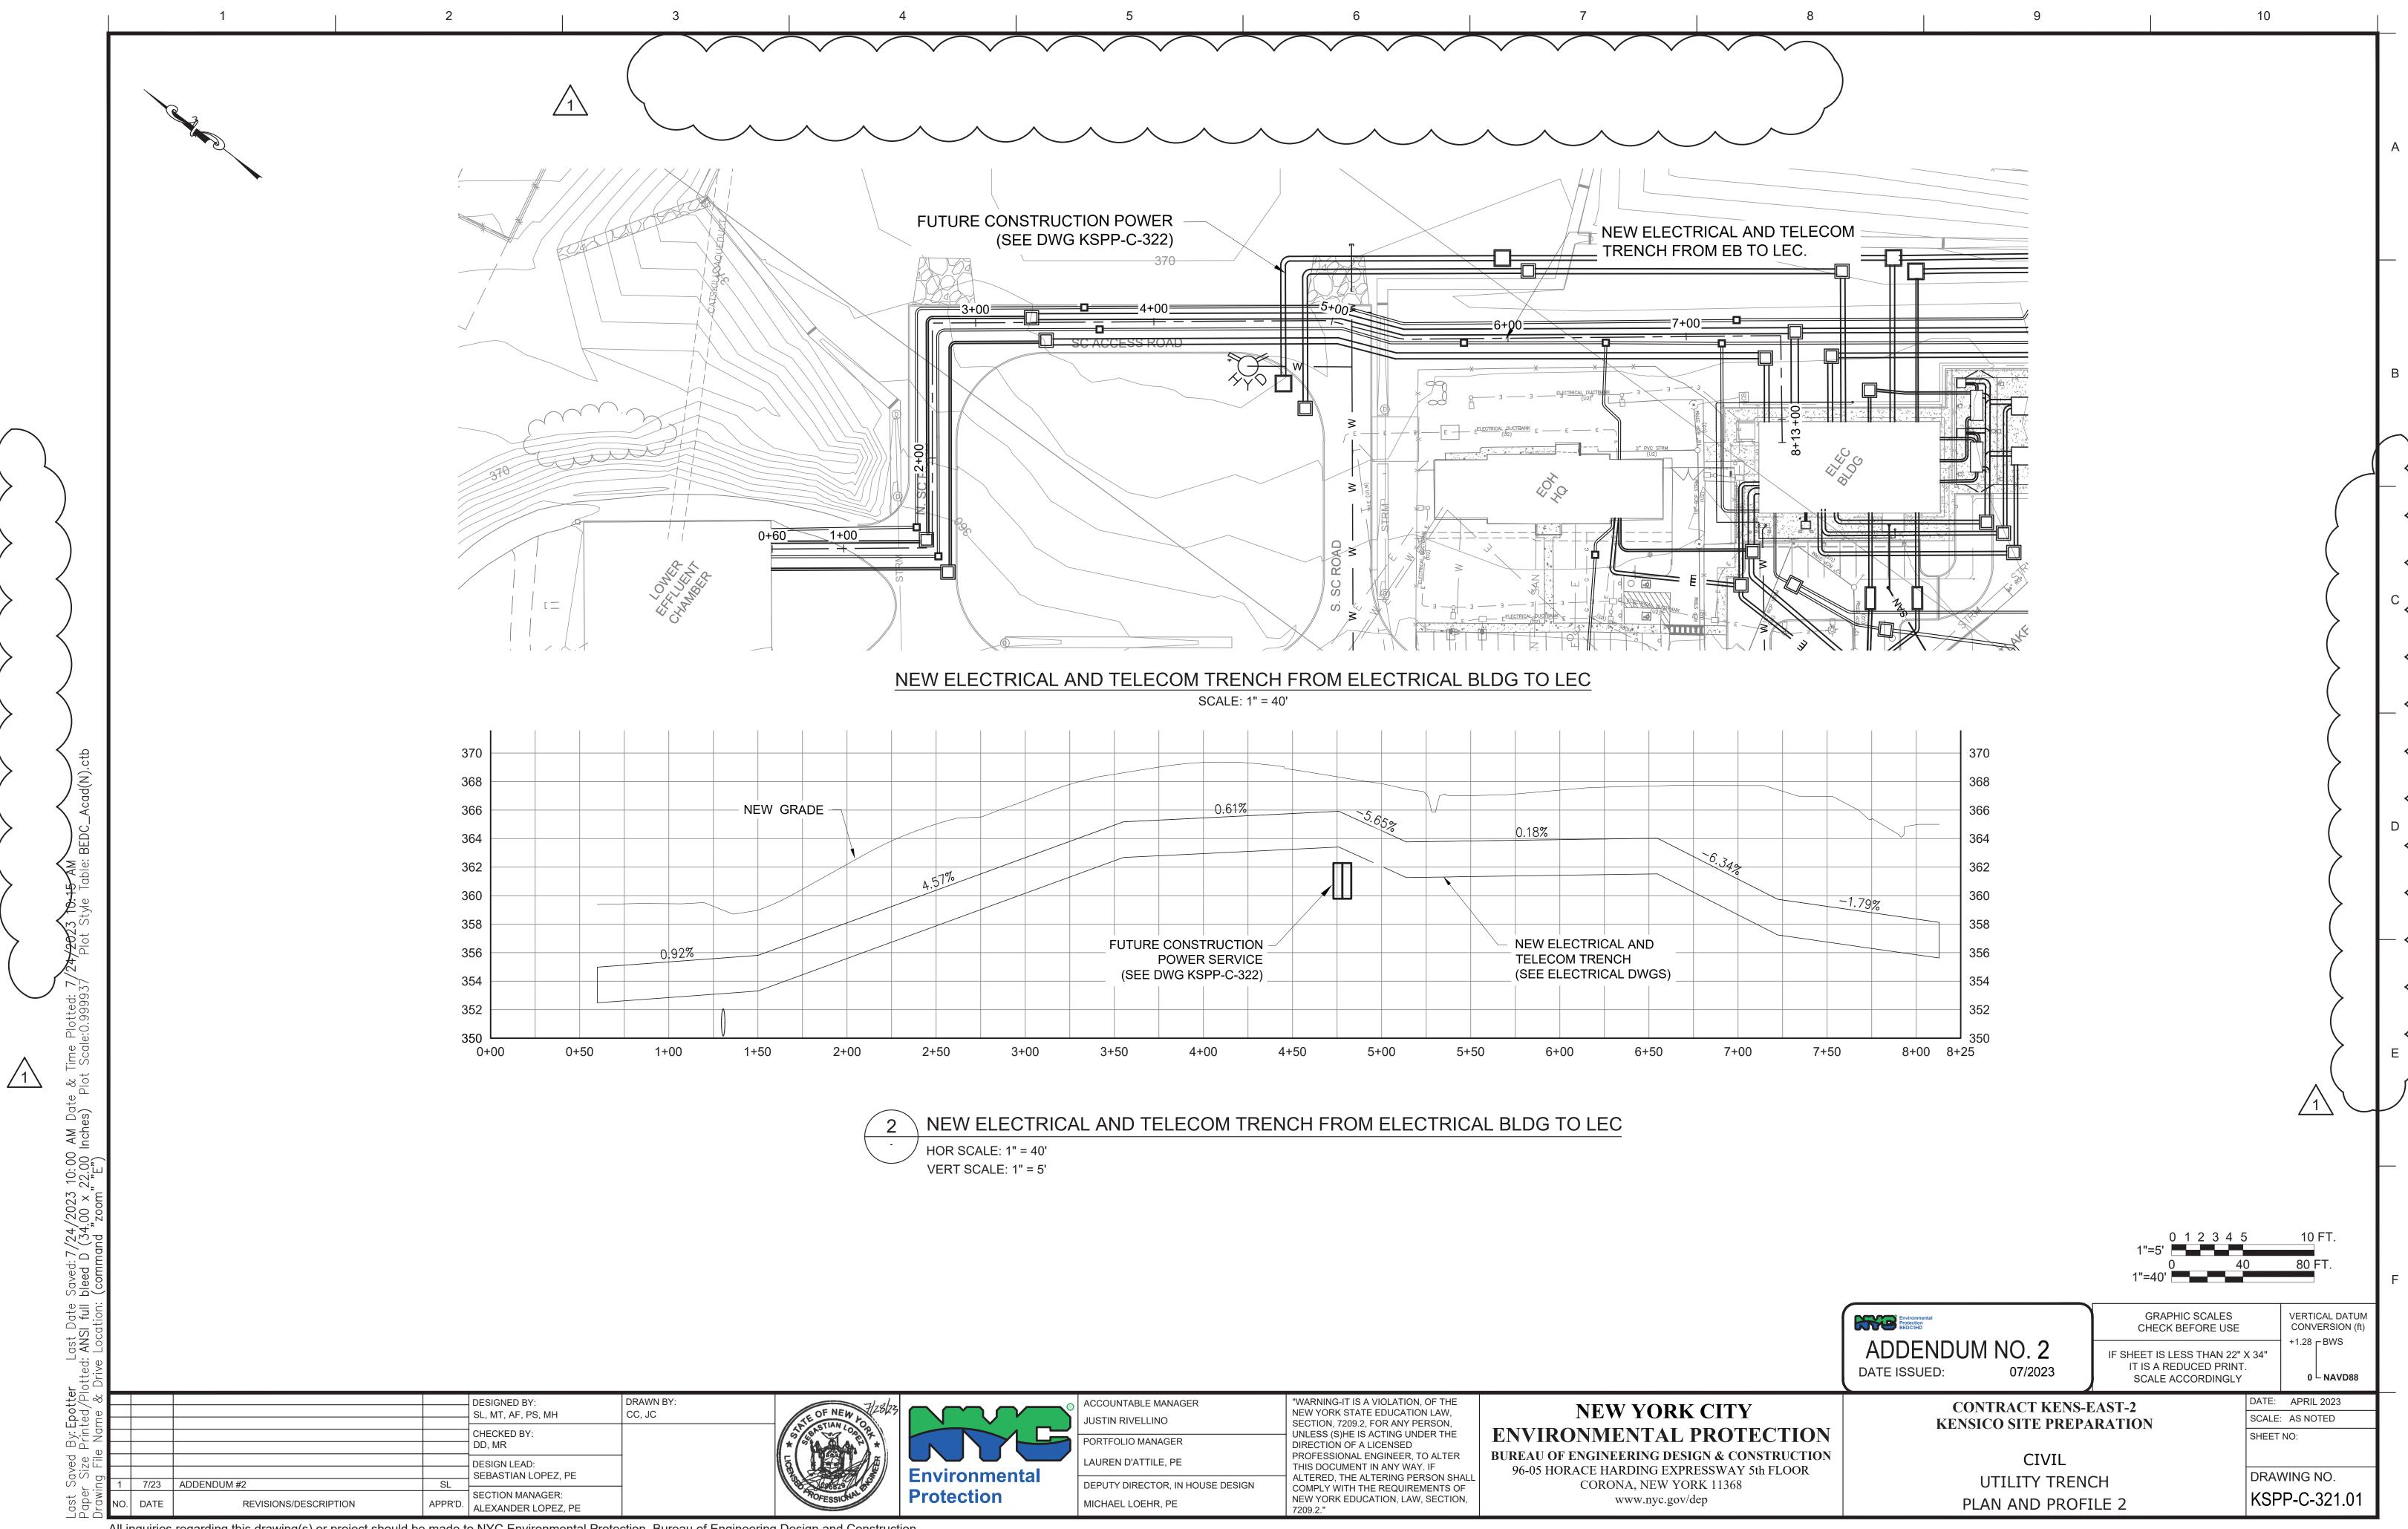

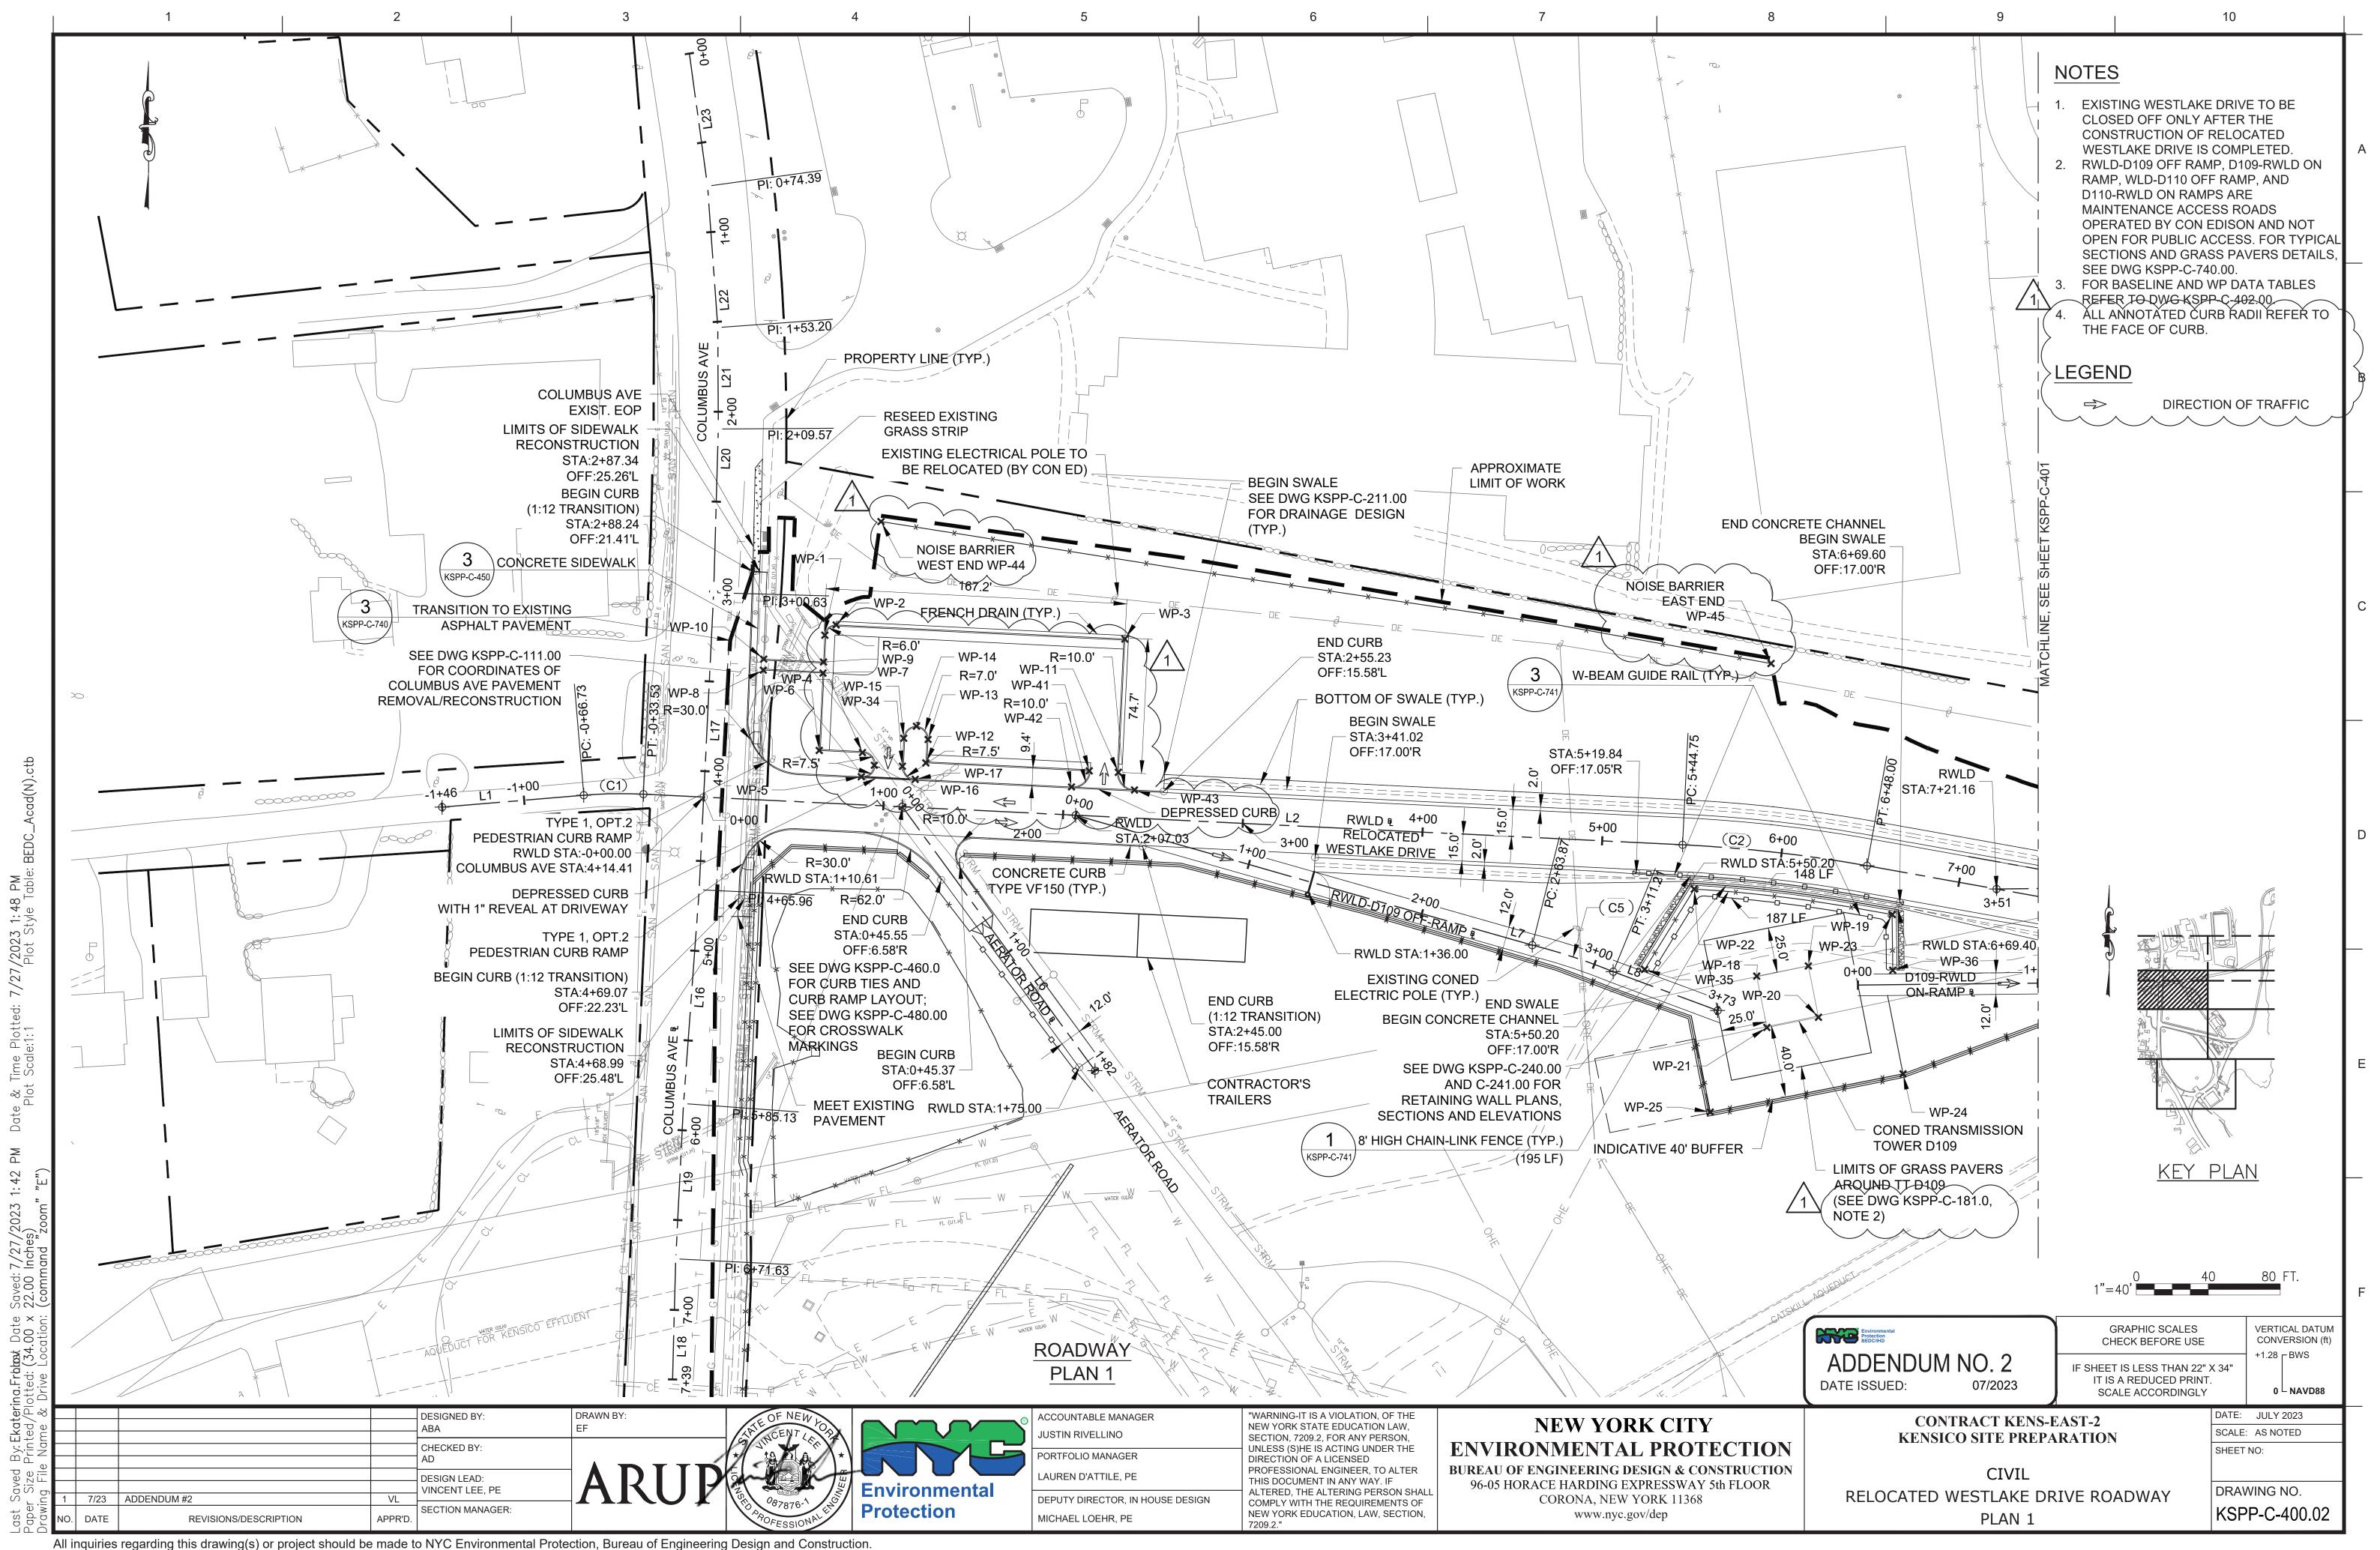

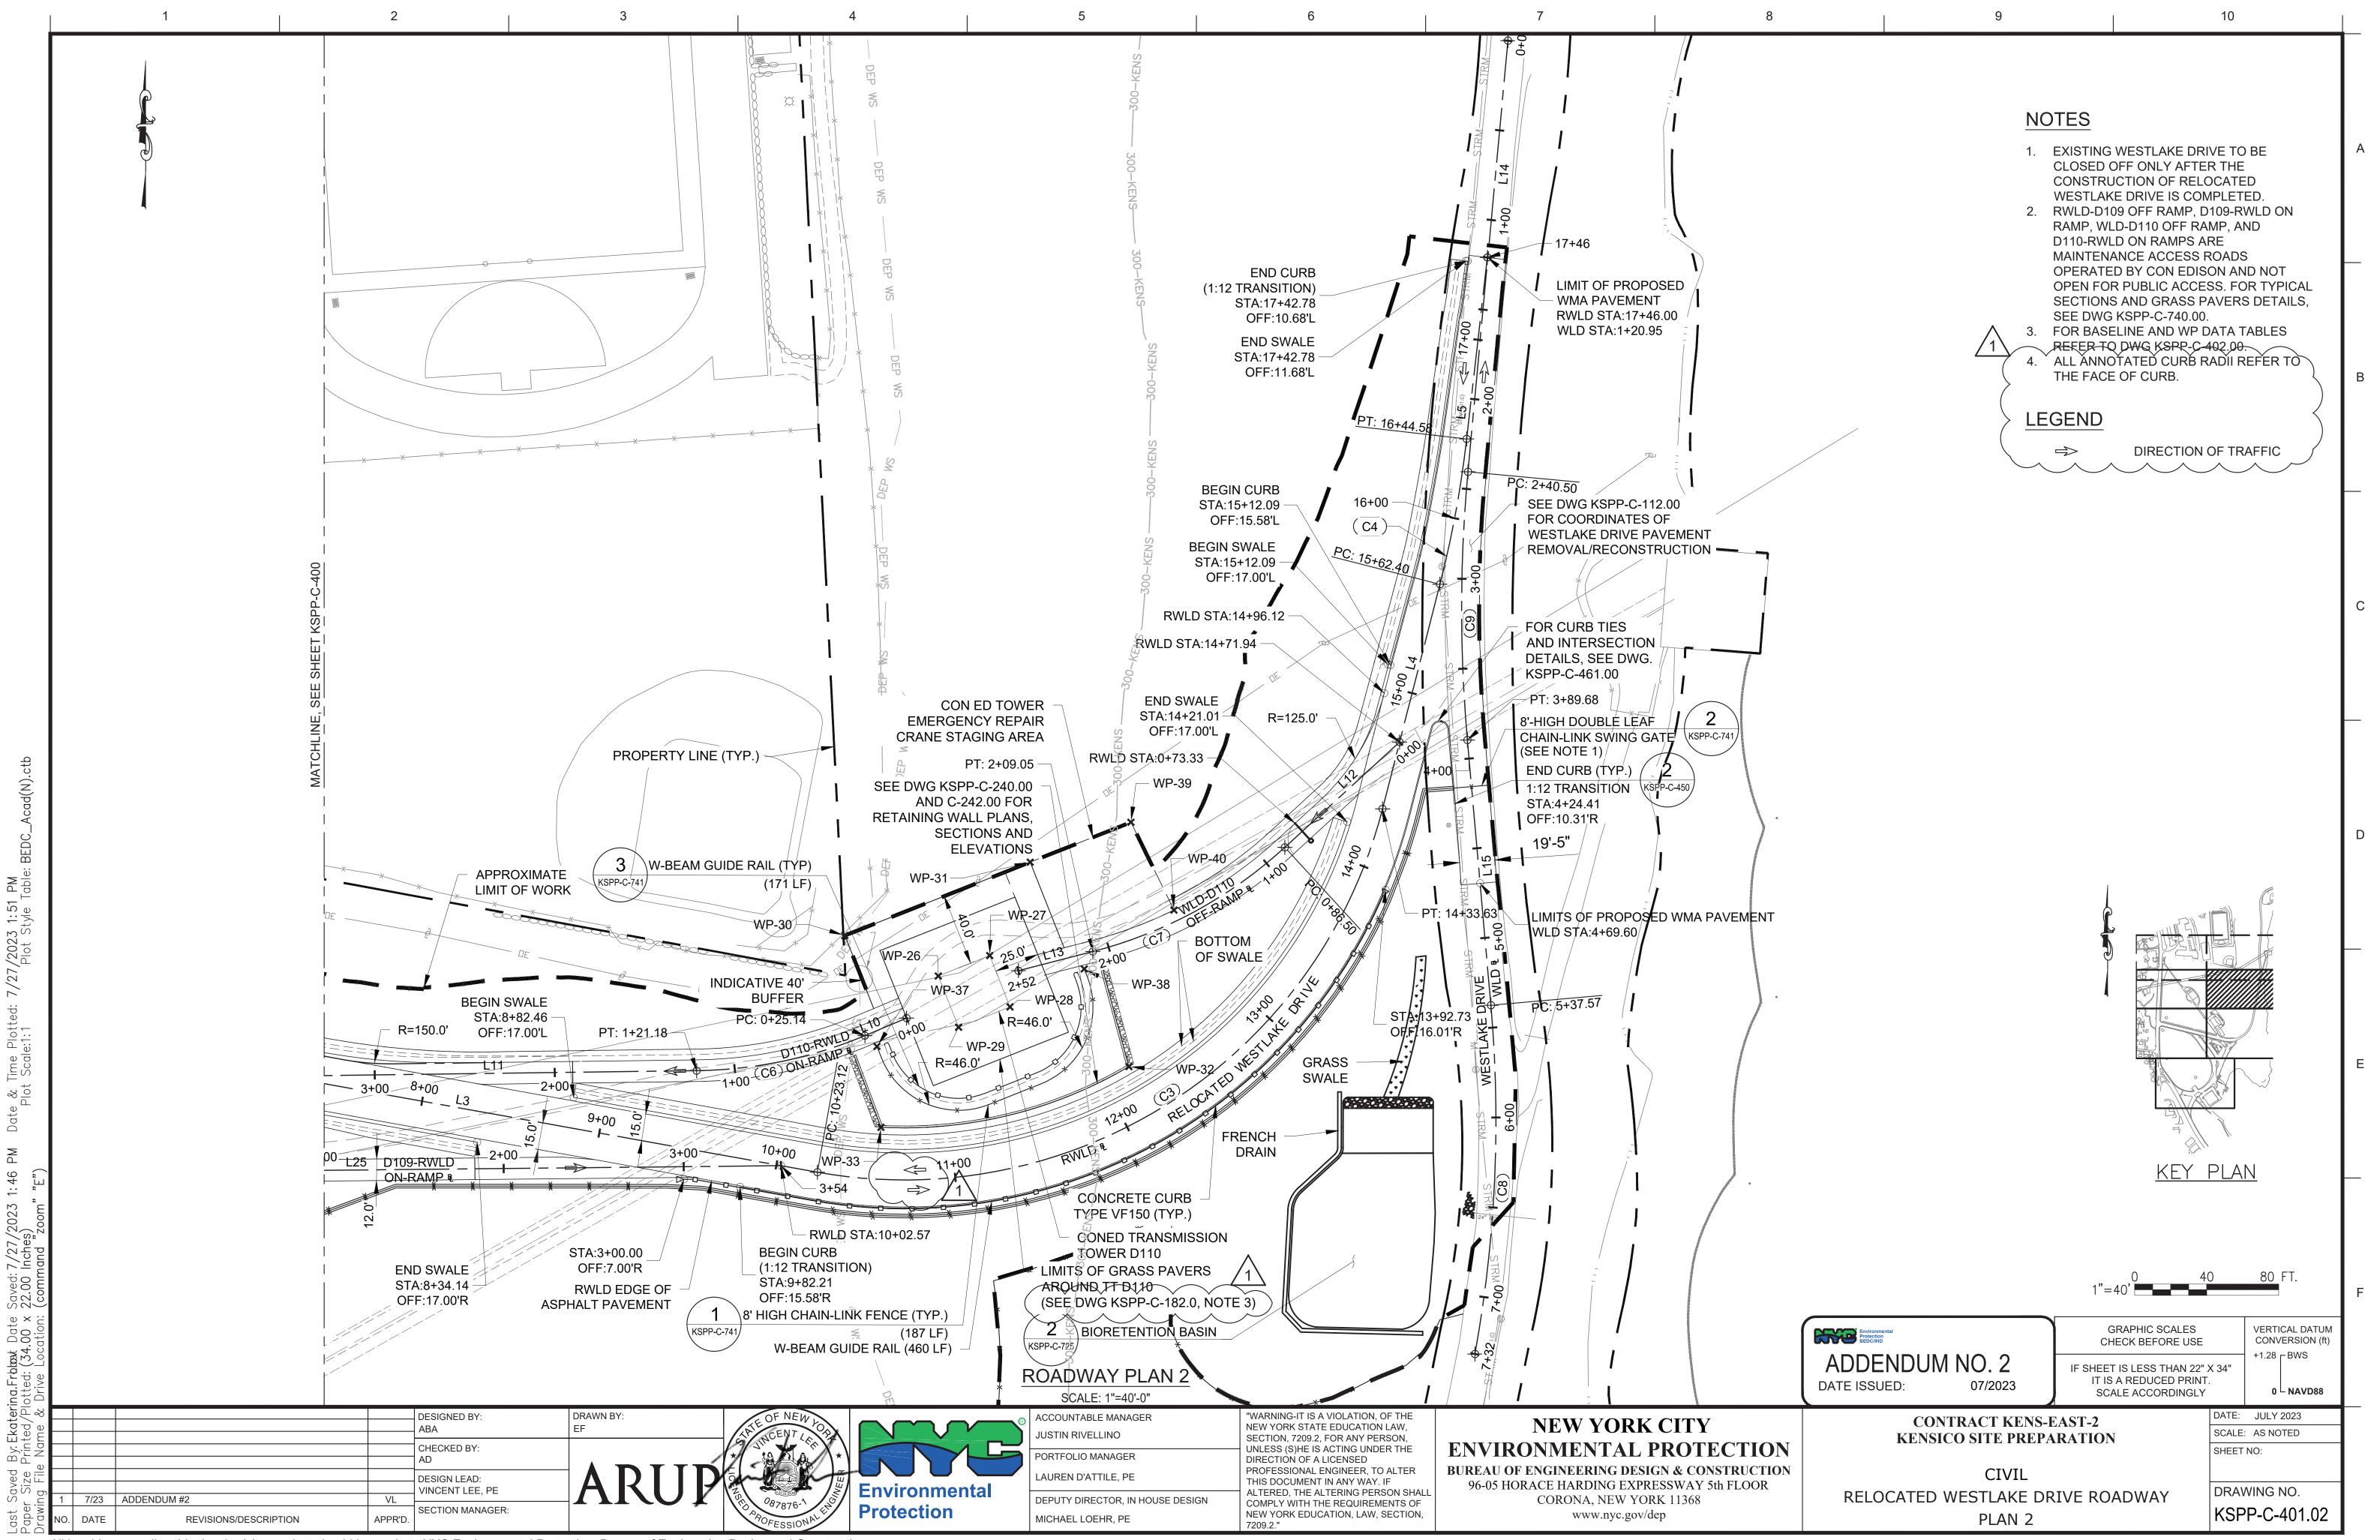

All inquiries regarding this drawing(s) or project should be made to NYC Environmental Protection, Bureau of Engineering Design and Construction.

POINT #	NORTHING	EASTING
WP-1	822937.2385	691400.611 ²
WP-2	822942.9430	691406.896 ⁻
WP-3	822935.1245	691567.3698
WP-4	822871.9804	691421.5323
WP-5	822858.5787	691420.8795
WP-6	822873.1805	691397.488 ²
WP-7	822916.1841	691399.5846
WP-8	822917.8022	691366.3735
WP-9	822922.3428	691399.8849
WP-10	822923.9633	691366.625 ⁻
WP-11	822861.0464	691563.7609
WP-12	822866.2595	691456.7626
WP-13	822879.2903	691457.981 ²
WP-14	822886.6077	691451.559 ²
WP-15	822879.9493	691444.456 ⁻
WP-16	822864.9429	691428.1112
WP-17	822857.1187	691450.8527
WP-18	822747.7027	691918.5664
WP-19	822753.3840	691947.2666
WP-20	822724.8458	691952.9158
WP-21	822719.1646	691924.2156
WP-22	822796.1119	691883.855 ⁻
WP-23	822781.9302	691993.8743
WP-24	822693.3745	691999.9224
WP-25	822672.1588	691892.7444
WP-26	822851.7763	692416.2495
WP-27	822863.0795	692444.8064
WP-28	822834.5893	692456.0832
WP-29	822823.2858	692427.5264
WP-30	822874.2475	692364.3356
WP-31	822914.9933	692467.2776
WP-32	822801.4096	692522.1556
WP-33	822767.7201	692384.3658
WP-34	822864.3921	691443.6982
WP-35	822751.4394	691856.2805
WP-36	822750.9715	691994.1836
WP-37	822812.6197	692382.1684
WP-38	822855.6971	692497.3084
WP-39	822937.1468	692523.2470
WP-39	822888.3635	692547,1609
WP-41	822861.8341	691547.5859
WP-41	822852.8870	691537.7223
WP-42	822852.8870	691572.7083
WP-44	823000.4221	691431.8137
WP-45	822921.5015	691926.5542

Date & Time Plotted: 7/28/2023 11:54 Plot Scale:1:1 Plot Style To

RELO	RELOCATED WESTLAKE DRIVE										
LINE #	DI	RECTION		LE	NGTH	START POINT	END POINT				
L1	N8	5°10'43"E		7	9.00	N:822841.65, E:691187.88	N:822848.29, E:691266.60				
L2	S8	7°12'40"E		5	78.28	N:822848.88, E:691299.78	N:822820.74, E:691877.38				
L3	S7	9°48'59"E		3	75.11	N:822809.08, E:691979.89	N:822742.76, E:692349.10				
L4	N1	4°20'28"E		128.77		N:822944.58, E:692663.01	N:823069.33, E:692694.90				
L5	NO	6°29'37"E		101.42		N:823150.09, E:692709.75	N:823250.86, E:692721.22				
				-							
CURVE #	Δ	RADIUS	LENGTH	CHORD LENGTH	CHORD DIRECTION	START POINT	END POINT				
C1	007°36'36.5"	250.00	33.21	33.18	N88°59'02"E	N:822848.29, E:691266.60	N:822848.88, E:691299.78				
C2	007°23'41.2"	800.00	103.25	103.18	S83°30'49"E	N:822820.74, E:691877.38	N:822809.08, E:691979.89				
C3	085°50'32.9"	274.00	410.52	373.18 N57°15'45"E		N:822742.76, E:692349.10	N:822944.58, E:692663.01				
C4	007°50'50.8"	600.00	82.18	82.11	N10°25'03"E	N:823069.33, E:692694.90	N:823150.09, E:692709.75				
	1	1	1	1	1	1	1				

RWLD-D109 OFF-RAMP											
DIF	RECTION		LE	NGTH	START POINT	END POINT					
S74°06'33"E			263.87		N:822837.17, E:691540.06	N:822764.92, E:691793.84					
S69°35'27"E			61.96		N:822750.19, E:691838.79	N:822728.58, E:691896.87					
			-								
CURVE # A RADIUS LENGTH CHORD LENGTH CHORD DIRECTION START POINT END POINT											
008°11'54.2" 330.87 47.34 47.30 S71				S71°51'00"E	N:822764.92, E:691793.84	N:822750.19, E:691838.79					
	DIF S74 S69	DIRECTION S74°06'33"E S69°35'27"E Δ RADIUS	DIRECTION S74°06'33"E S69°35'27"E Δ RADIUS LENGTH	DIRECTION LE S74°06'33"E 26 S69°35'27"E 66 Δ RADIUS LENGTH CHORD LENGTH	$\begin{array}{ c c c } \hline DIRECTION & LENGTH \\ \hline S74^{\circ}06'33''E & 263.87 \\ \hline S69^{\circ}35'27''E & 61.96 \\ \hline \\ $	$\begin{array}{ c c c c } \hline DIRECTION & LENGTH & START POINT \\ \hline S74^{\circ}06'33''E & 263.87 & N:822837.17, E:691540.06 \\ \hline S69^{\circ}35'27''E & 61.96 & N:822750.19, E:691838.79 \\ \hline & \\ \hline \hline \\ \hline & \\ \hline \hline \hline \hline \\ \hline \hline \hline \hline \hline \\ \hline \hline$					

AERA	AERATOR ROAD									
LINE #	LINE # DIRECTION LENGTH START POINT END POINT									
L6	S36°06'10"E	181.63	N:822841.86, E:691443.74	N:822695.11, E:691550.77						

D109-	D109-RWLD ON-RAMP									
LINE #	LINE # DIRECTION LENGTH START POINT END POINT									
L25	N89°24'50"E	354.04	N:822742.77, E:691974.85	N:822746.39, E:692328.88						

WEST	WESTLAKE DRIVE										
LINE #	DIF	RECTION		LE	NGTH	START POINT	END POINT				
L14	4 S05°17'58"W 240.50 N:823371.26, E:692732.67		N:823371.26, E:692732.67	N:823131.79, E:692710.45							
L15	SO	5°03'41"E		14	17.89	N:822982.81, E:692710.15	N:822835.50, E:692723.19				
CURVE #	Δ	RADIUS	LENGTH	CHORD LENGTH	CHORD DIRECTION	START POINT	END POINT				
C8	015°22'16.6"	725.00	194.50	N:822835.50, E:692723.19	N:822641.78, E:692714.31						
C9 010°21'38.8" 825.00 149.18 148.98 S00°07'08"W N:823131.79, E:692710.45 N:822982.81, E							N:822982.81, E:692710.15				

AM			WP-38	822855.6971	692497.3084		C9	010°21'38.8"	825.00	149.18	148.98	
11:46 / "E")		-	WP-39	822937.1468	692523.2470							
3 11: n""[WP-40	822888.3635	692547.1609							
/202, s) zoor			WP-41	822861.8341	691547.5859	$\backslash \bigwedge$						
//21/ nche: and			WP-42	822852.8870	691537.7223							
Saved: 7/21/2023 1 22.00 Inches) (command zoom"			WP-43	822851.1827	691572.7083							
- Sa (cc.			WP-44	823000.4221	691431.8137	$\left\{ \right\}$						
Dat∈ .00 ; ation			WP-45	822921.5015	691926.5542	}						
blook : (34 Loc			$\wedge \wedge$									
na.Fr otted Drive												
By: Ekaterina.Frbkmt Date Printed/Plotted: (34.00 x Name & Drive Location:							DESIGNED BY: ABA		RAWN BY: F		TE OF NEW FO	\sim
By: E Print: Nan							CHECKED BY: AD				* SINO A	X.
ved ize File							DESIGN LEAD: VINCENT LEE, PE		AR [†]	IID		
sc er (s	1	7/23	ADDENDUM	#2		VL –	,			VX	087876-1	CN GINER
Last Say Paper S Drawing	NO.	DATE		REVISIONS/DESCF		APPR'D.	SECTION MANAGE	=K:			POFESSIONAL	Ŷ

All inquiries regarding this drawing(s) or project should be made to NYC Environmental Protection, Bureau of Engineering Design and Construction.

4	5	
	1	

COL	UMB	IS	AV/F

COLU	COLUMBUS AVE									
LINE #	DIRECTION	LENGTH	START POINT	END POINT						
L16	S04°11'08"W	119.18	N:822795.76, E:691330.77	N:822676.90, E:691322.07						
L17	S02°46'56"W	165.33	N:822960.89, E:691338.79	N:822795.76, E:691330.77						
L18	S01°31'54"W	67.03	N:822590.51, E:691317.74	N:822523.51, E:691315.95						
L19	S02°51'54"W	86.50	N:822676.90, E:691322.07	N:822590.51, E:691317.74						
L20	S01°38'46"W	91.06	N:823051.92, E:691341.41	N:822960.89, E:691338.79						
L21	S00°19'07"E	56.37	N:823108.29, E:691341.09	N:823051.92, E:691341.41						
L22	S04°07'26"E	78.80	N:823186.89, E:691335.43	N:823108.29, E:691341.09						
L23	S07°49'51"E	74.39	N:823260.59, E:691325.29	N:823186.89, E:691335.43						

D110-RWLD ON-RAMP										
LINE #	DII	RECTION		LE	NGTH	START POINT	END POINT			
L10	S67°14'24"W			25.14		N:822828.33, E:692398.64	N:822818.61, E:692375.46			
L11	S89°15'01"W			230.13		N:822799.16, E:692282.02	N:822796.15, E:692051.90			
				-						
CURVE #	CURVE # Δ RADIUS LENGTH CHORD LENGTH CHORD DIRECTION START POINT END POINT									
C6	022°00'37.5"	250.00	96.04	95.45	S78°14'42"W	N:822818.61, E:692375.46	N:822799.16, E:692282.02			

WLD-D110 OFF-RAMP								
LINE #	DIRECTION			LENGTH		START POINT	END POINT	
L12	S4	S47°28'17"W		86.50		N:822981.69, E:692672.49	N:822923.22, E:692608.75	
L13	S75°33'27"W		42.73		N:822865.36, E:692502.11	N:822854.70, E:692460.73		
CURVE #	Δ	RADIUS	LENGTH	CHORD LENGTH	CHORD DIRECTION	START POINT	END POINT	
C7	028°05'10.0"	250.00	122.55	121.33	S61°30'52"W	N:822923.22, E:692608.75	N:822865.36, E:692502.11	



ACCOUNTABLE MANAGER JUSTIN RIVELLINO PORTFOLIO MANAGER LAUREN D'ATTILE, PE DEPUTY DIRECTOR, IN HOUSE DESIGN MICHAEL LOEHR, PE

"WARNING-IT IS A VIOLATION, OF THE NEW YORK STATE EDUCATION LAW, SECTION, 7209.2, FOR ANY PERSON, UNLESS (S)HE IS ACTING UNDER THE DIRECTION OF A LICENSED PROFESSIONAL ENGINEER, TO ALTER THIS DOCUMENT IN ANY WAY. IF ALTERED, THE ALTERING PERSON SHALL COMPLY WITH THE REQUIREMENTS OF NEW YORK EDUCATION, LAW, SECTION, 7209.2."


NEW YORK CITY ENVIRONMENTAL PROTECT BUREAU OF ENGINEERING DESIGN & CONSTR 96-05 HORACE HARDING EXPRESSWAY 5th FI CORONA, NEW YORK 11368 www.nyc.gov/dep


8	9	


	ADDENDUM NO. 2 DATE ISSUED: 07/2023	GRAPHIC SCALES CHECK BEFORE USE IF SHEET IS LESS THAN 22" IT IS A REDUCED PRINT SCALE ACCORDINGLY	-	VERTICAL DATUM CONVERSION (ft) +1.28 BWS 0 - NAVD88
TION	CONTRACT KENS-EAST-2 KENSICO SITE PREPARATION			JULY 2023 AS NOTED NO:
RUCTION LOOR	CIVIL ROADWAY BASELINE DA	ATA TABLES		ving no. P-C-402.01


Е


F

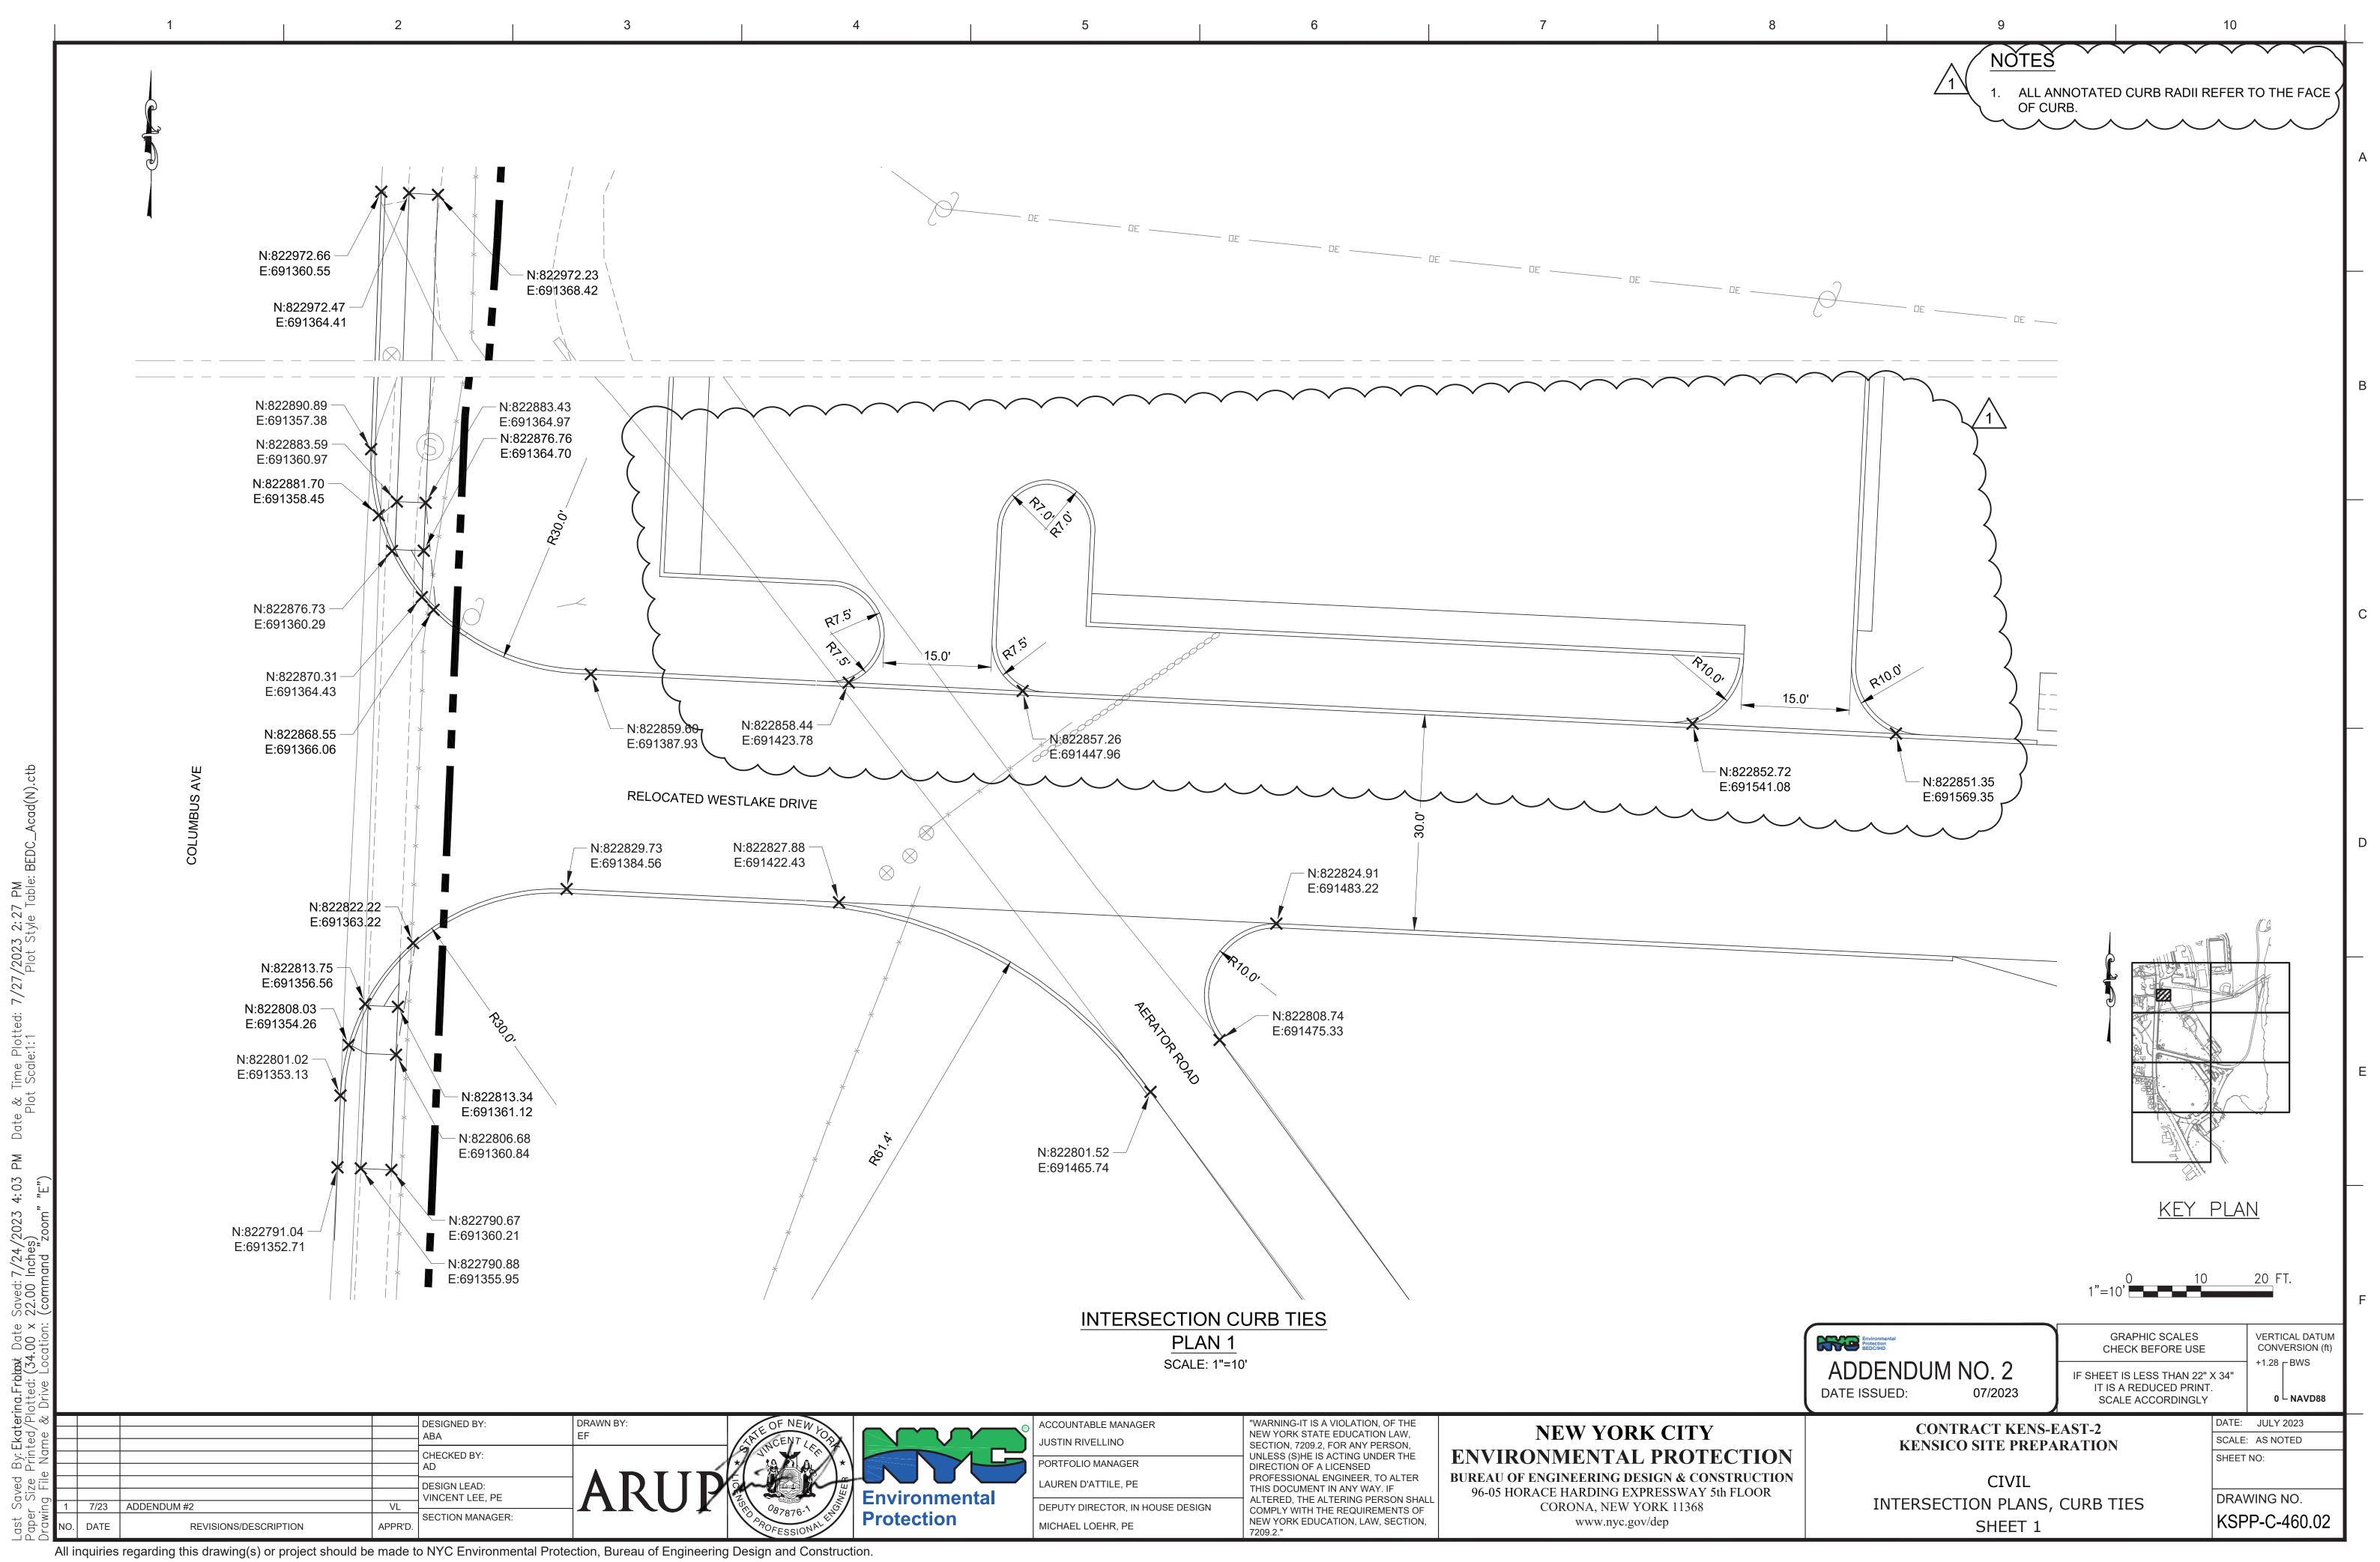


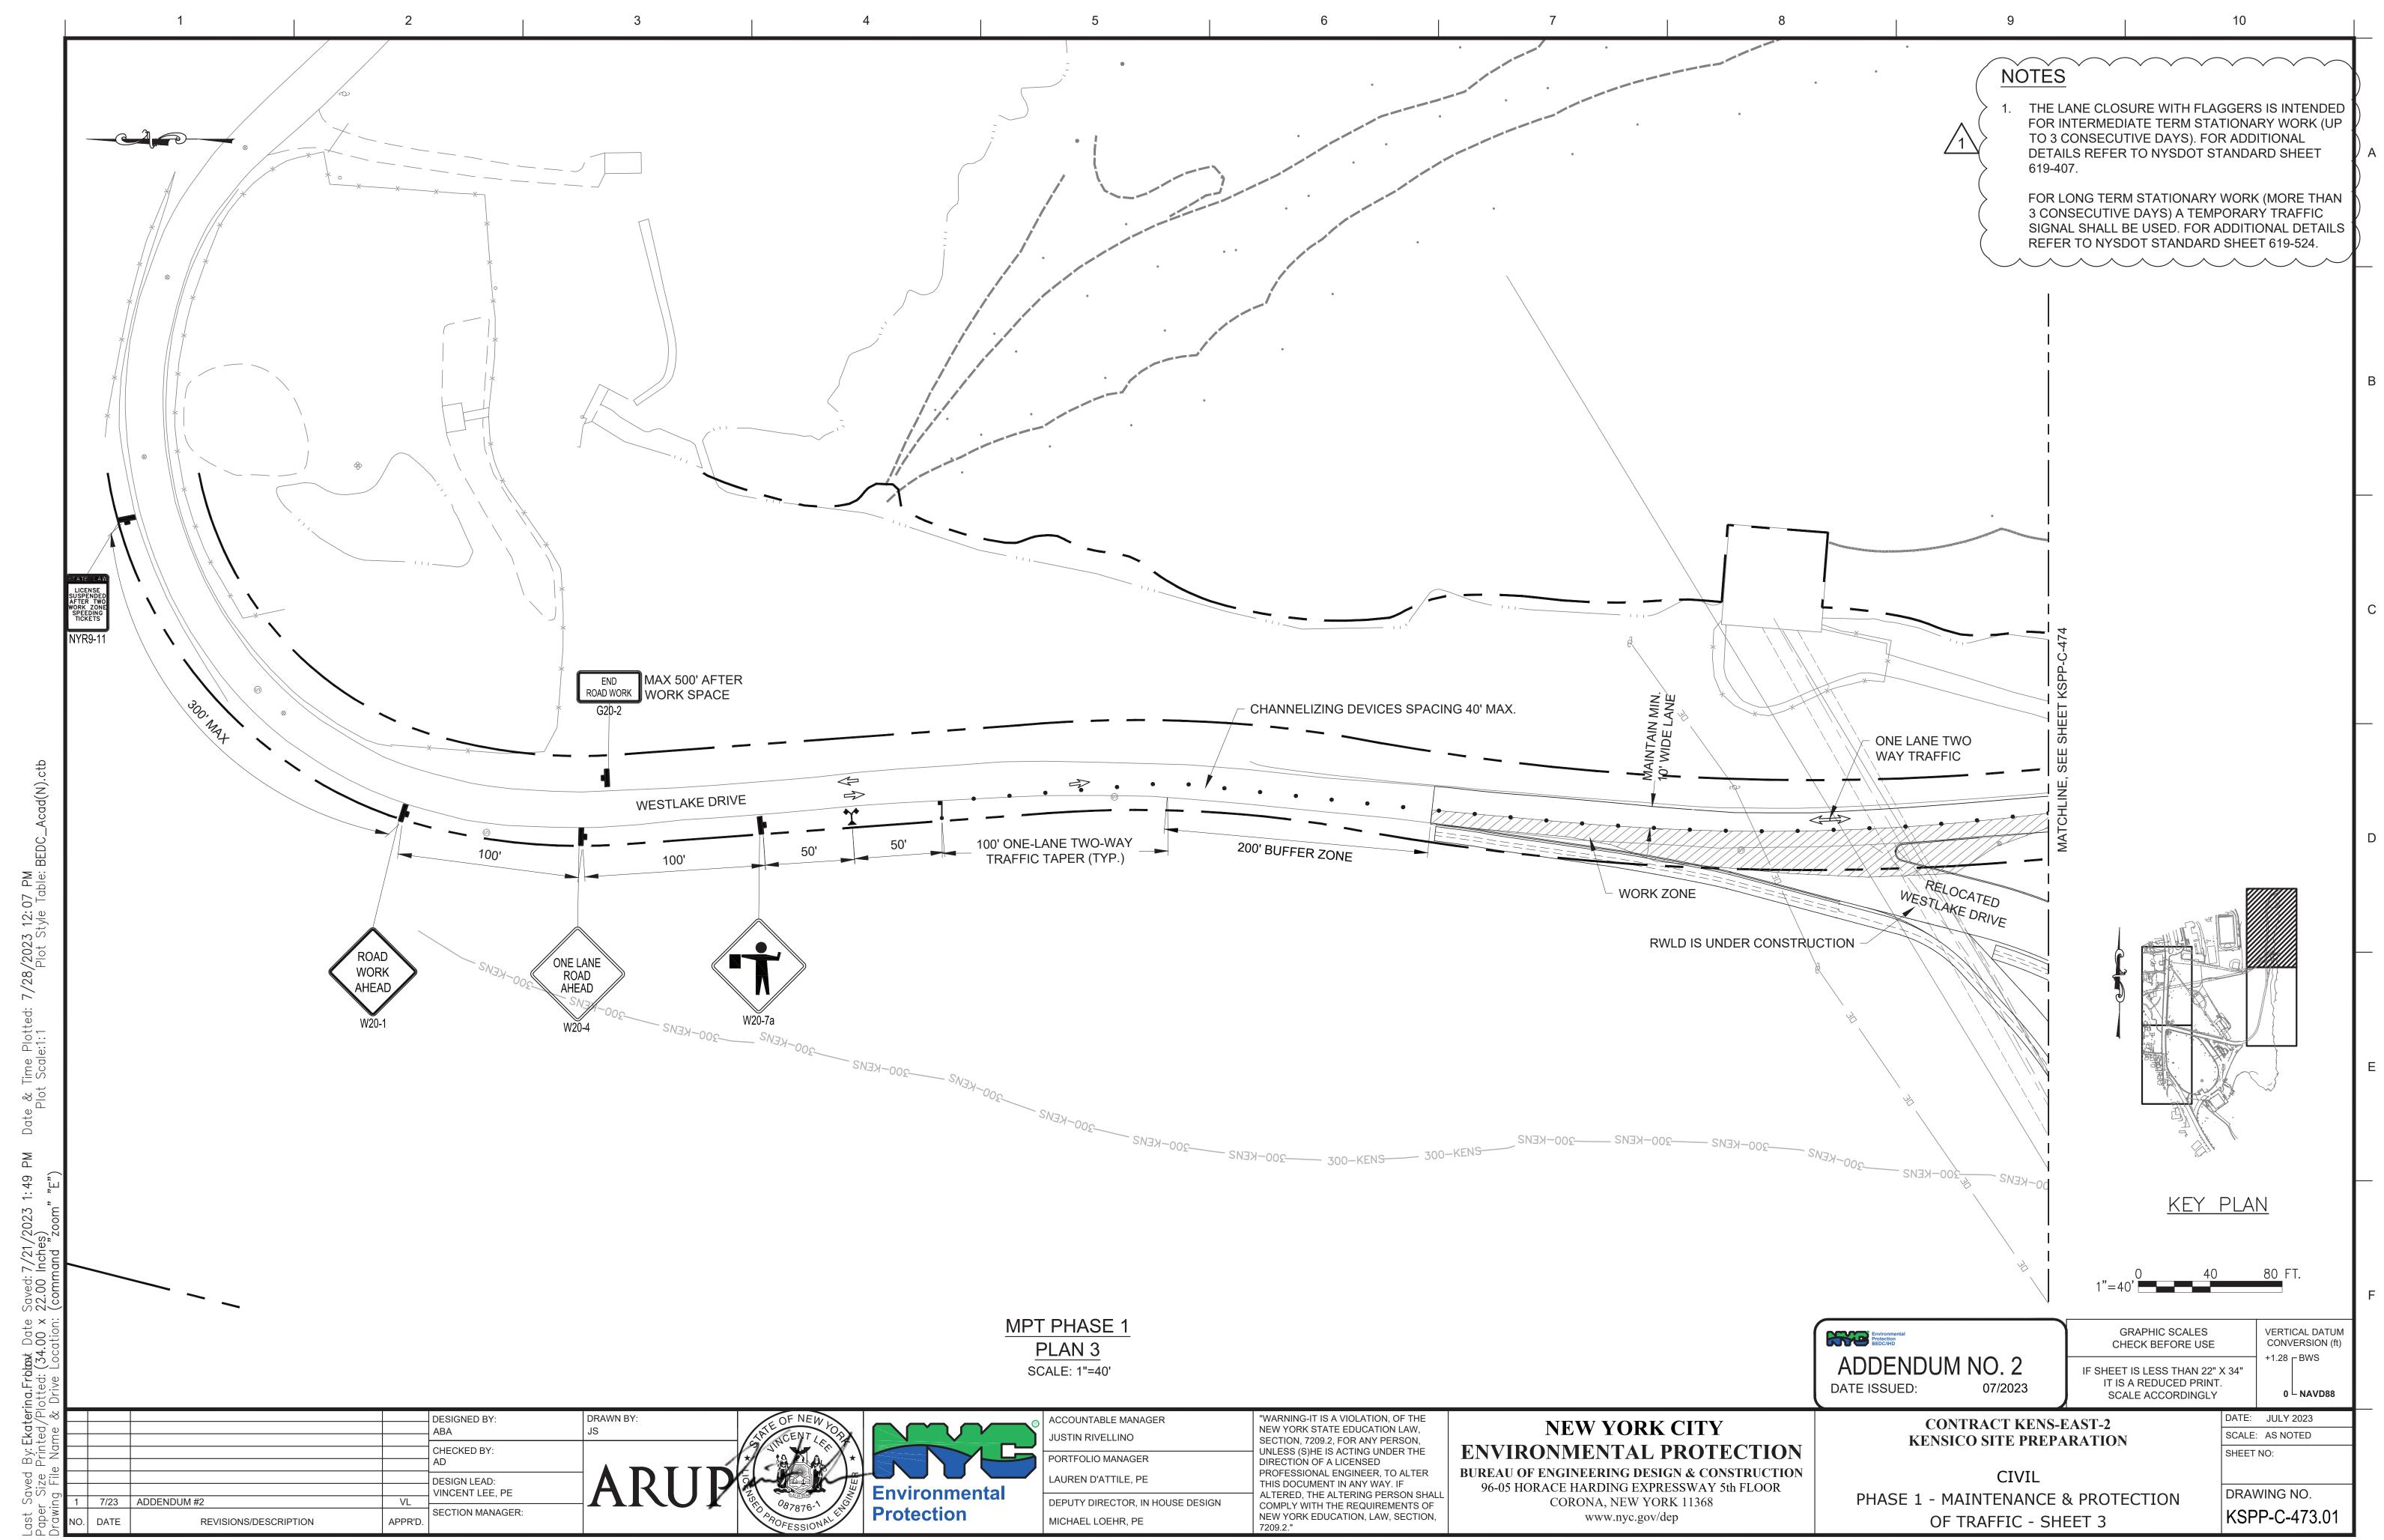


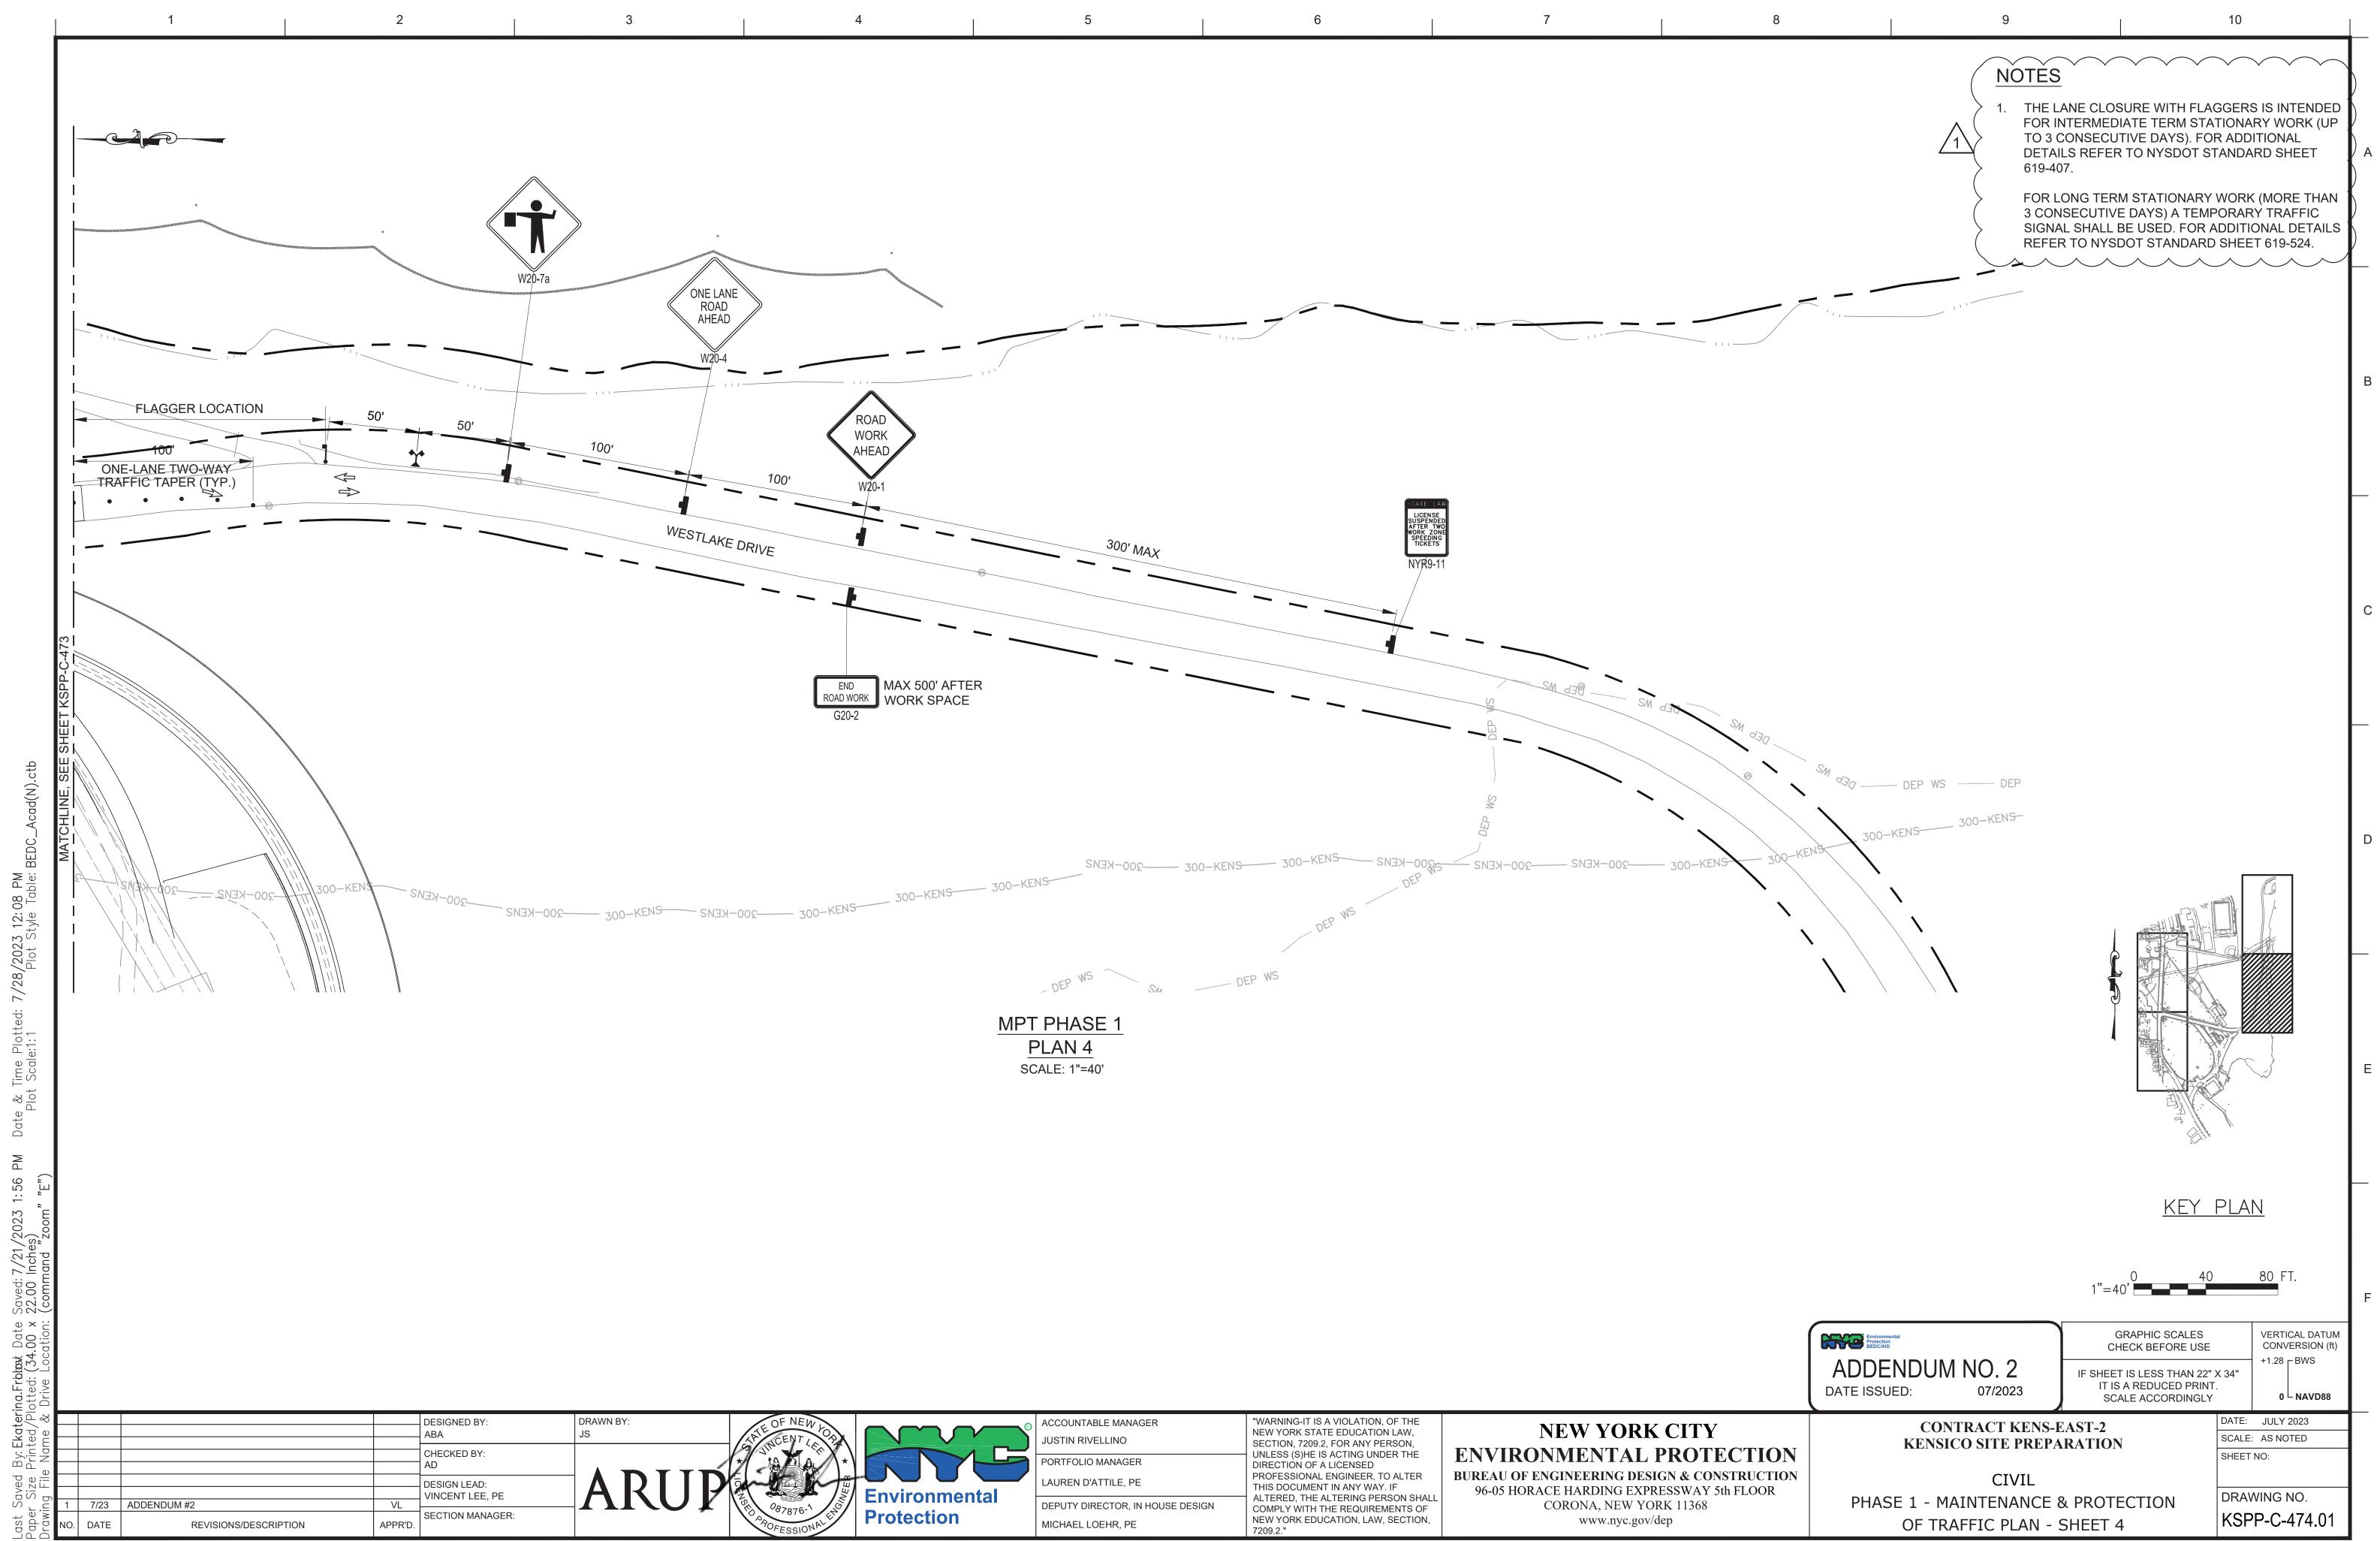

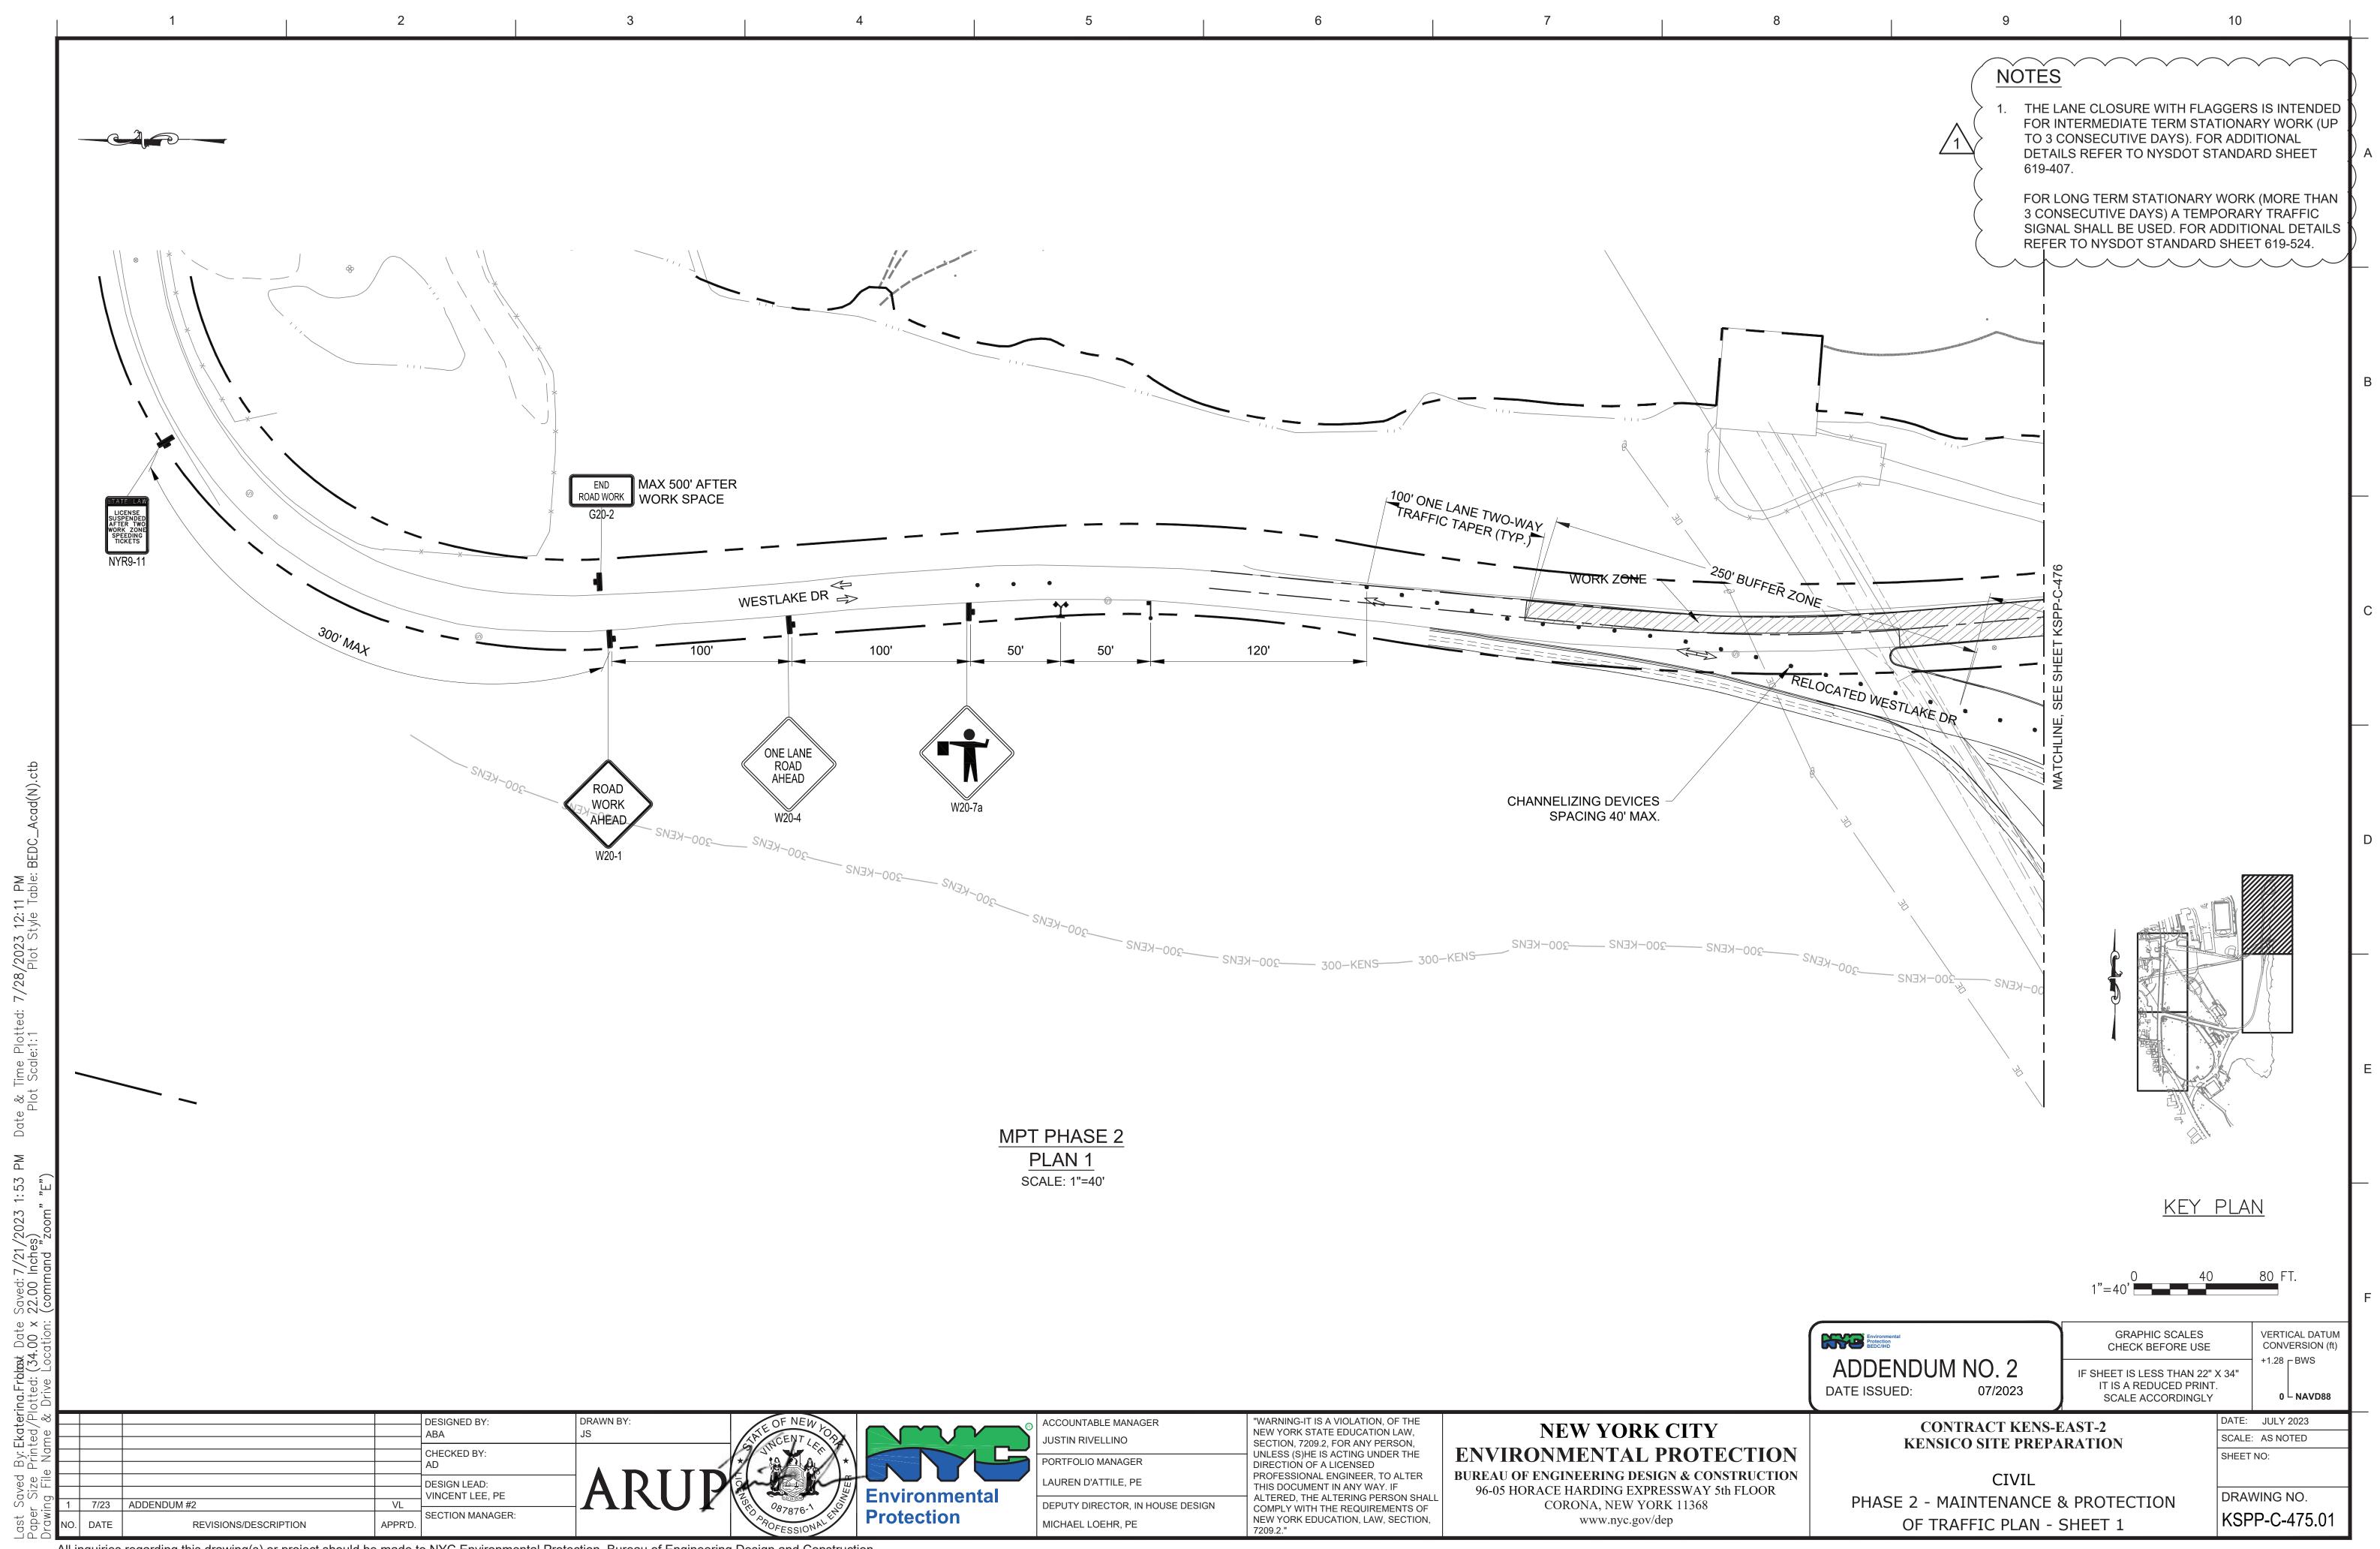

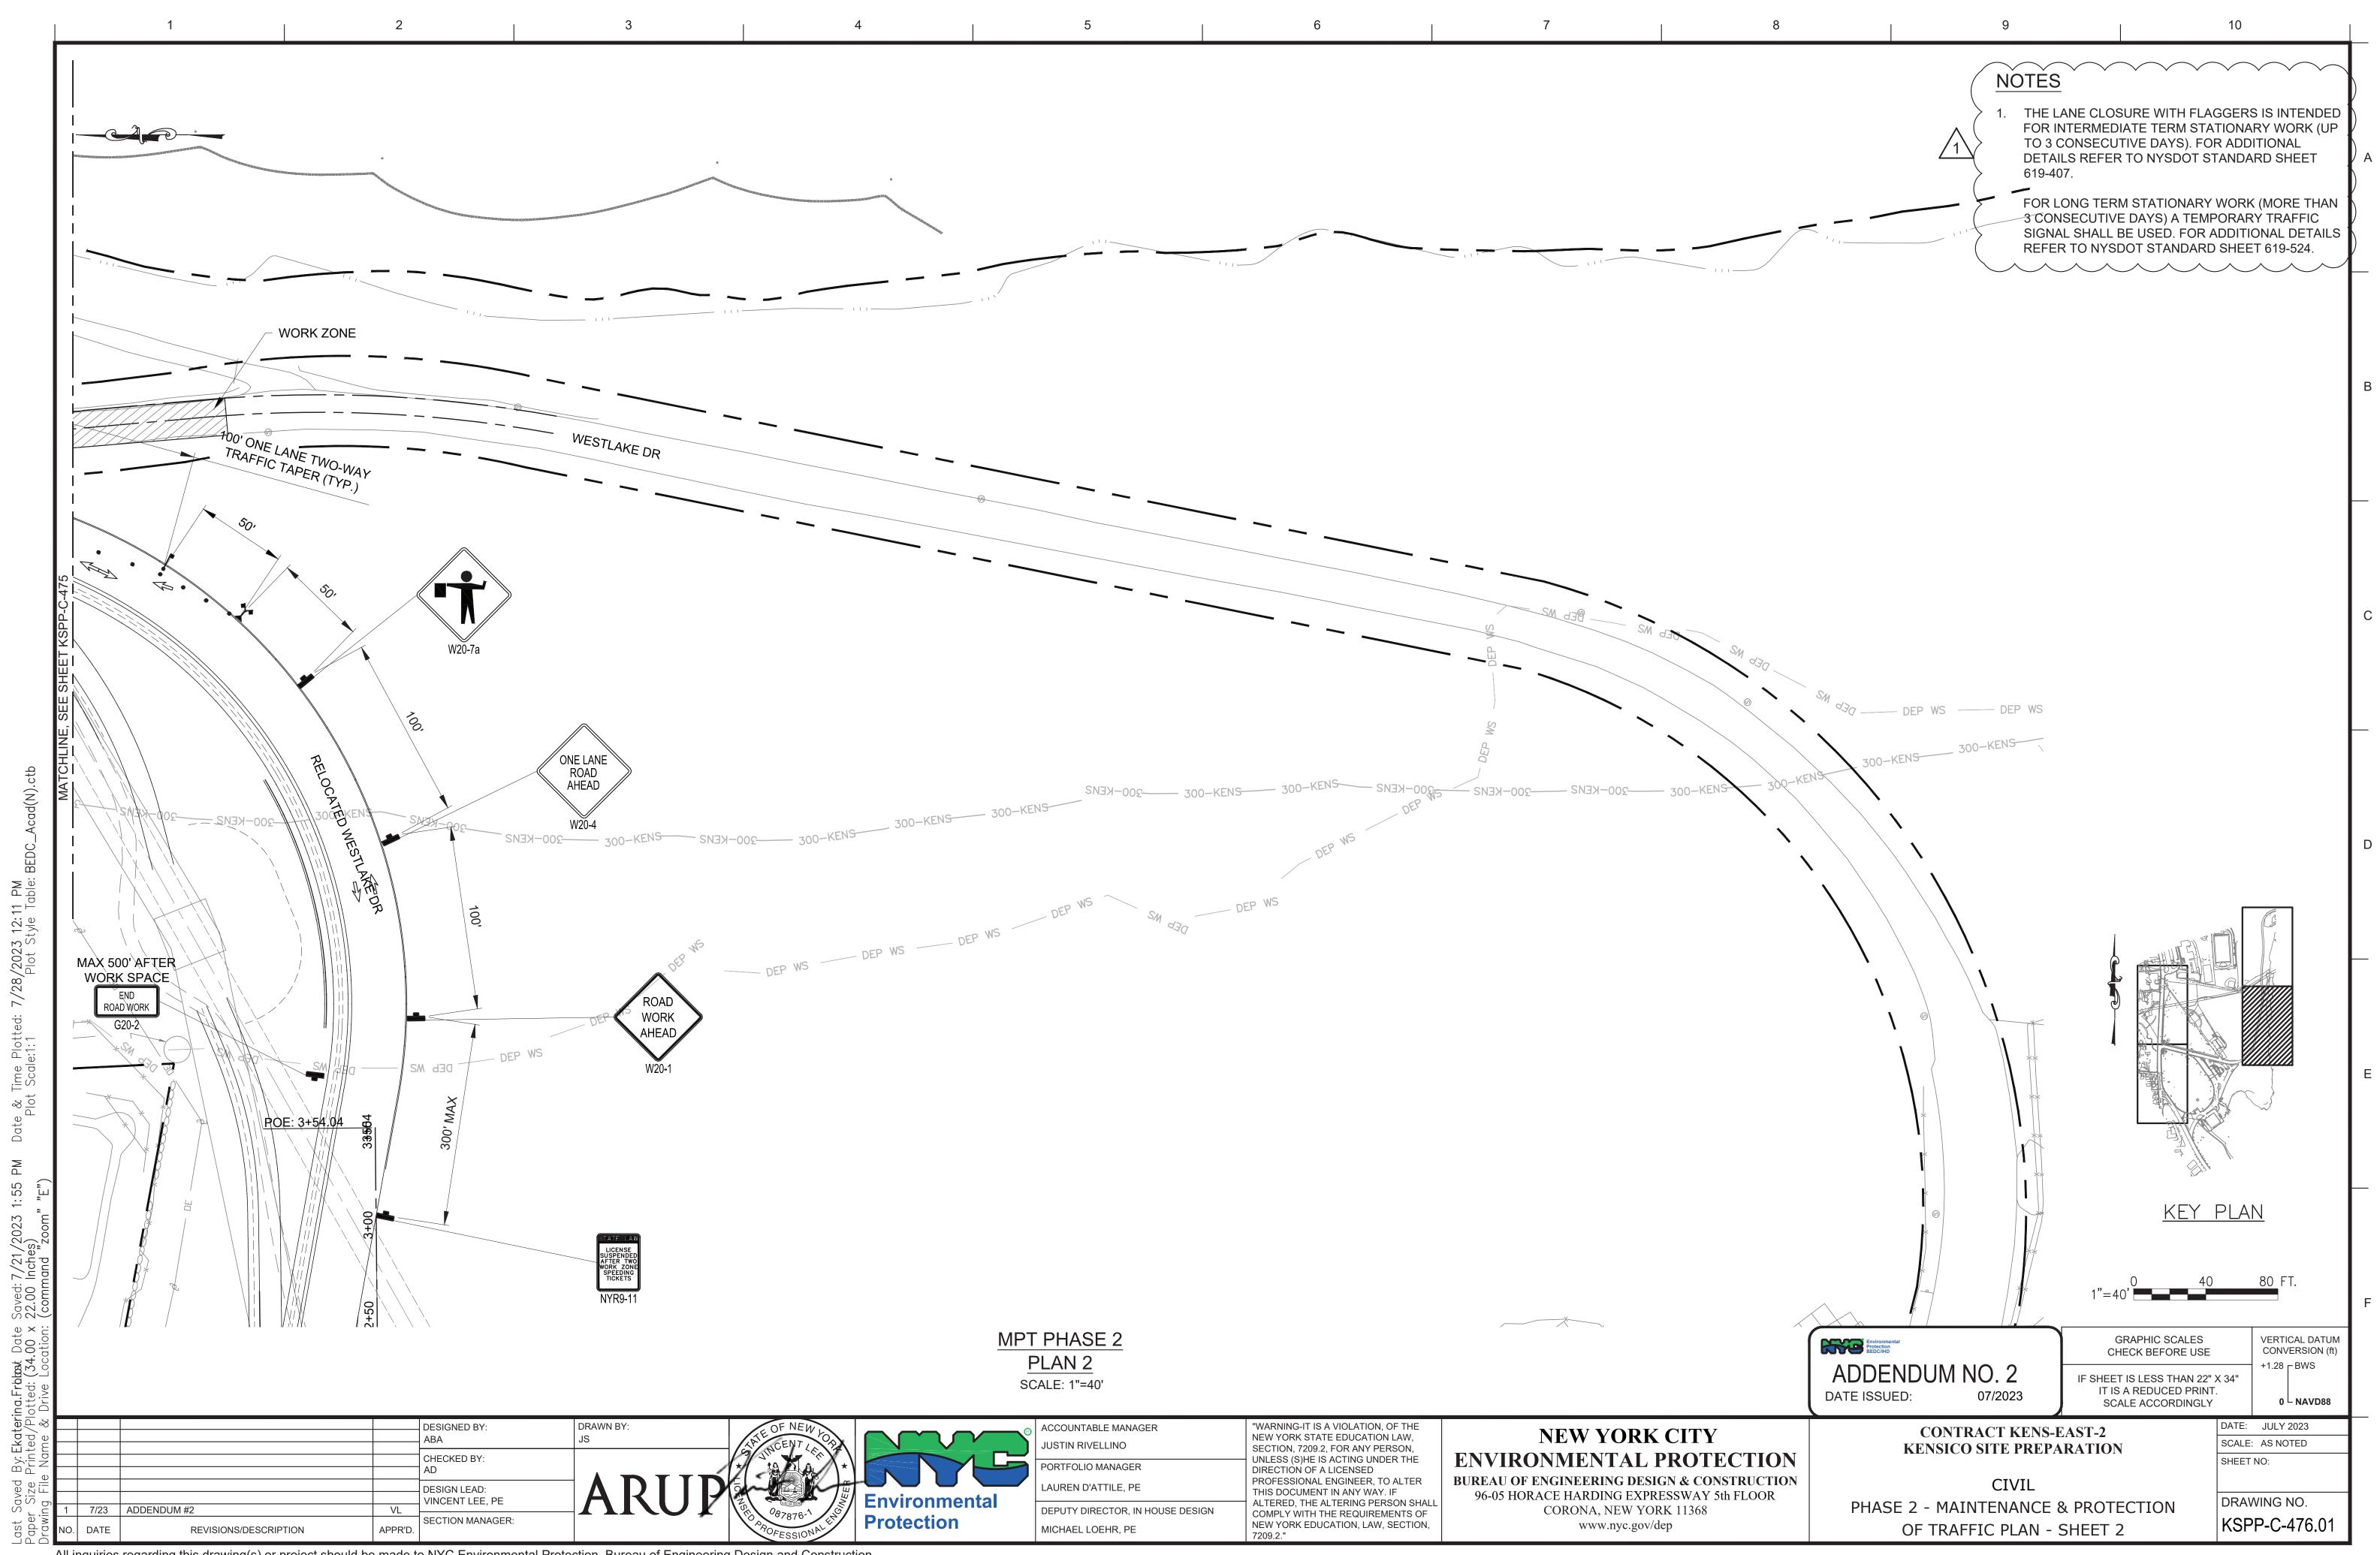

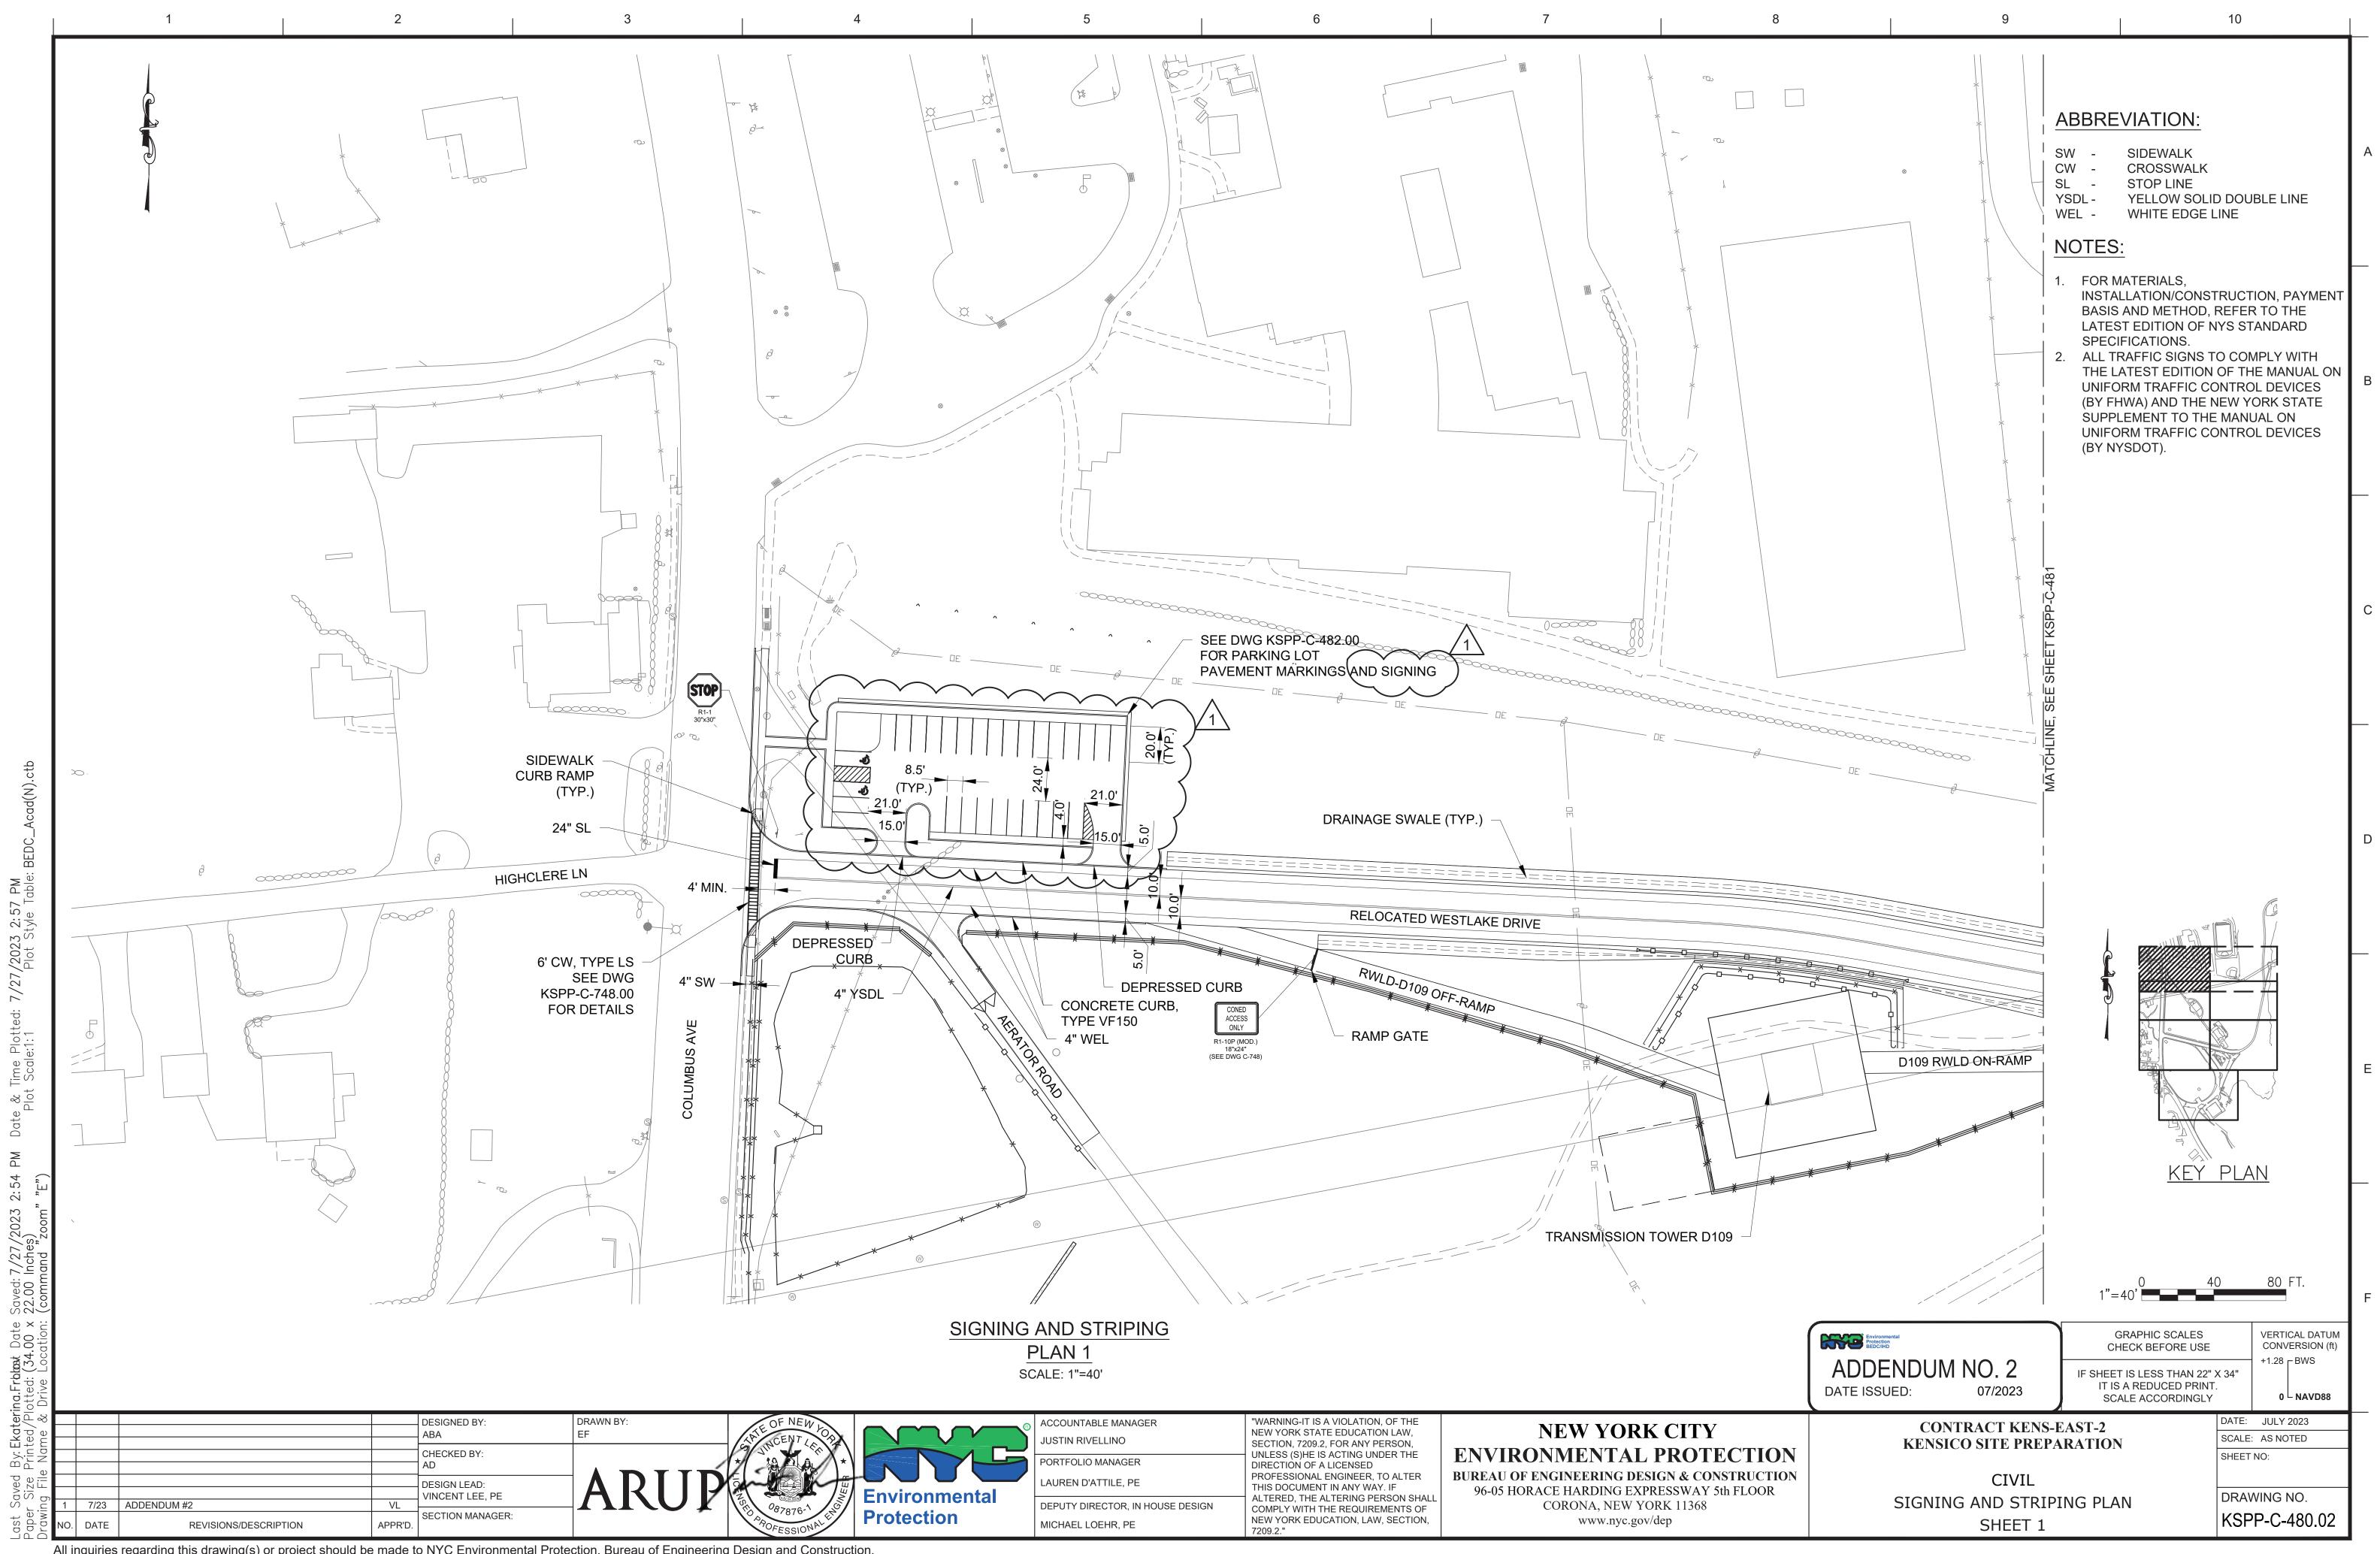

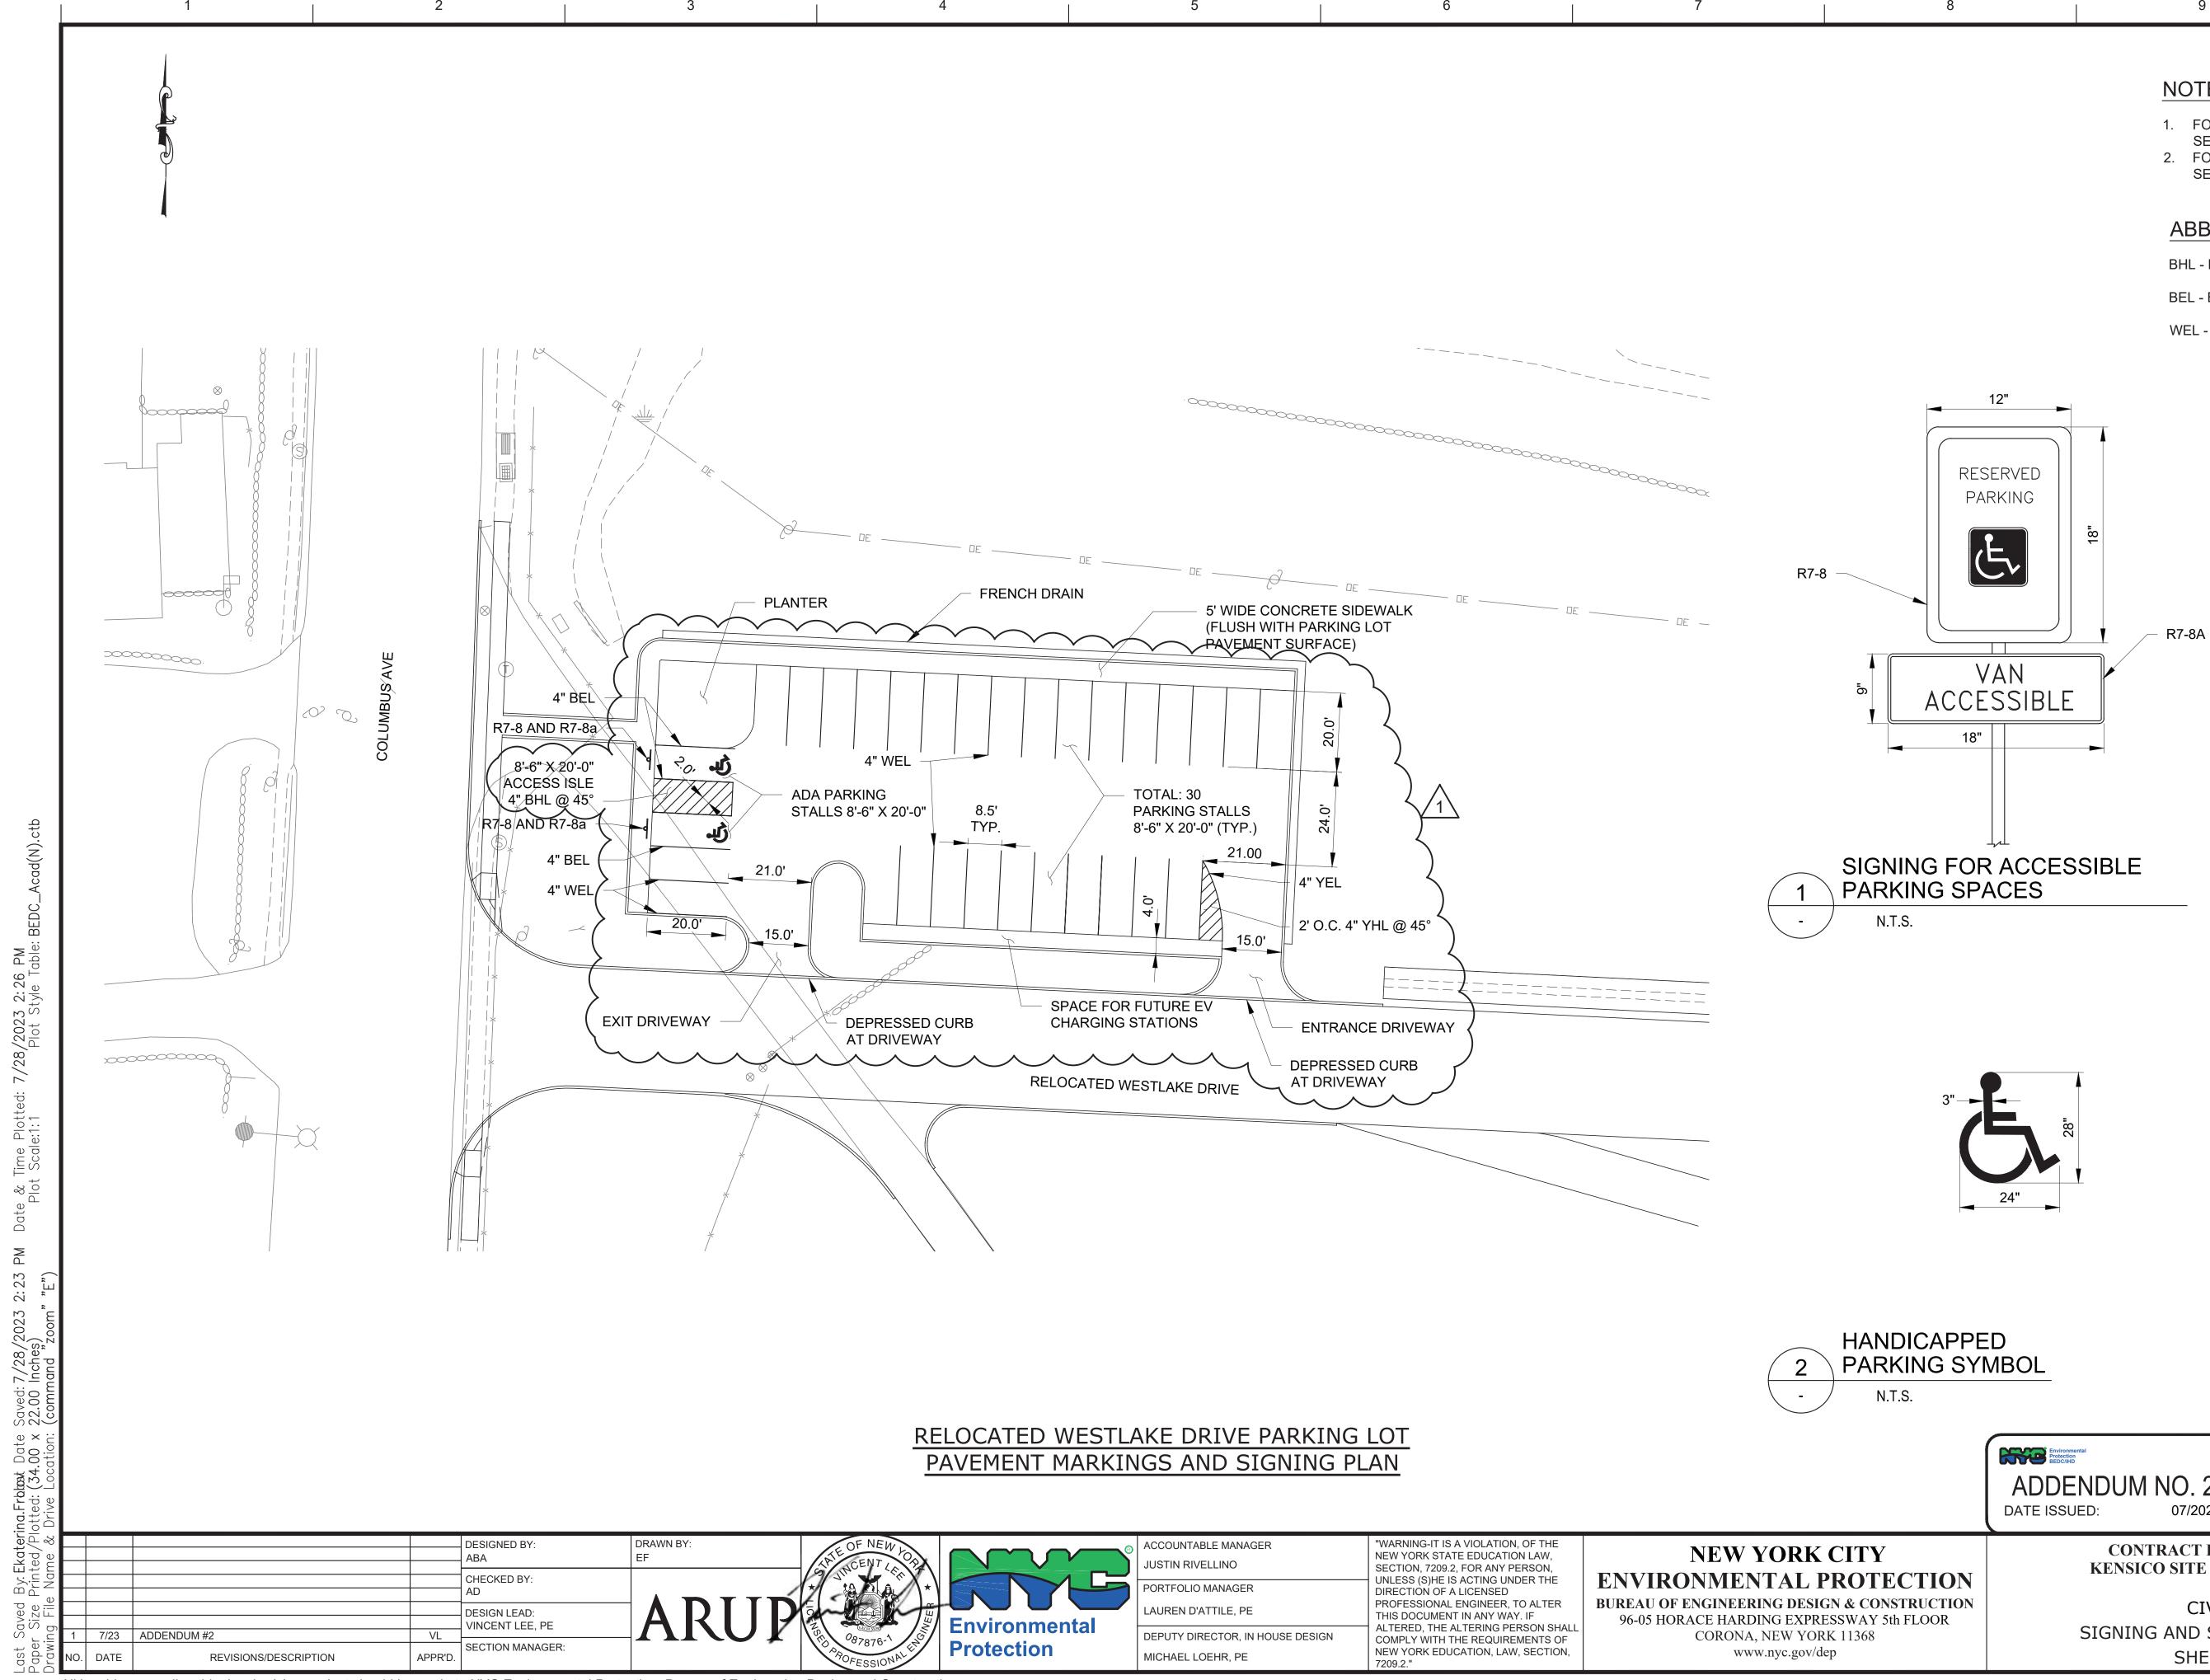

С

D

Е

NOTES

- 1. FOR ADDITIONAL PAVEMENT MARKINGS DETAILS SEE NYSDOT STANDARD SHEET 685-01.
- 2. FOR ADDITIONAL ACCESSIBLE PARKING DETAILS SEE NYSDOT STANDARD SHEET 608-02.


ABBREVIATIONS


BHL - BLUE HATCH LINE


BEL - BLUE EDGE LINE

WEL - WHITE EDGE LINE


S.		1"=20'	0	40 FT.	F
	Environmental Protection BEDC/IHD	GRAPHIC SCALES CHECK BEFORE USE		VERTICAL DATUM CONVERSION (ft)	
	ADDENDUM NO. 2 DATE ISSUED: 07/2023	IF SHEET IS LESS THAN 22" IT IS A REDUCED PRINT SCALE ACCORDINGLY		+1.28 BWS 0 NAVD88	
	CONTRACT KENS-F	EAST-2	DATE: JULY 2023		
CTION	KENSICO SITE PREPA	RATION	SCALE: AS NOTED SHEET NO:		
RUCTION	CIVIL	ONLET			
FLOOR	SIGNING AND STRIPI	DRAWING NO.			
	SHEET 3		KSPP-C-482.02		
			I		1

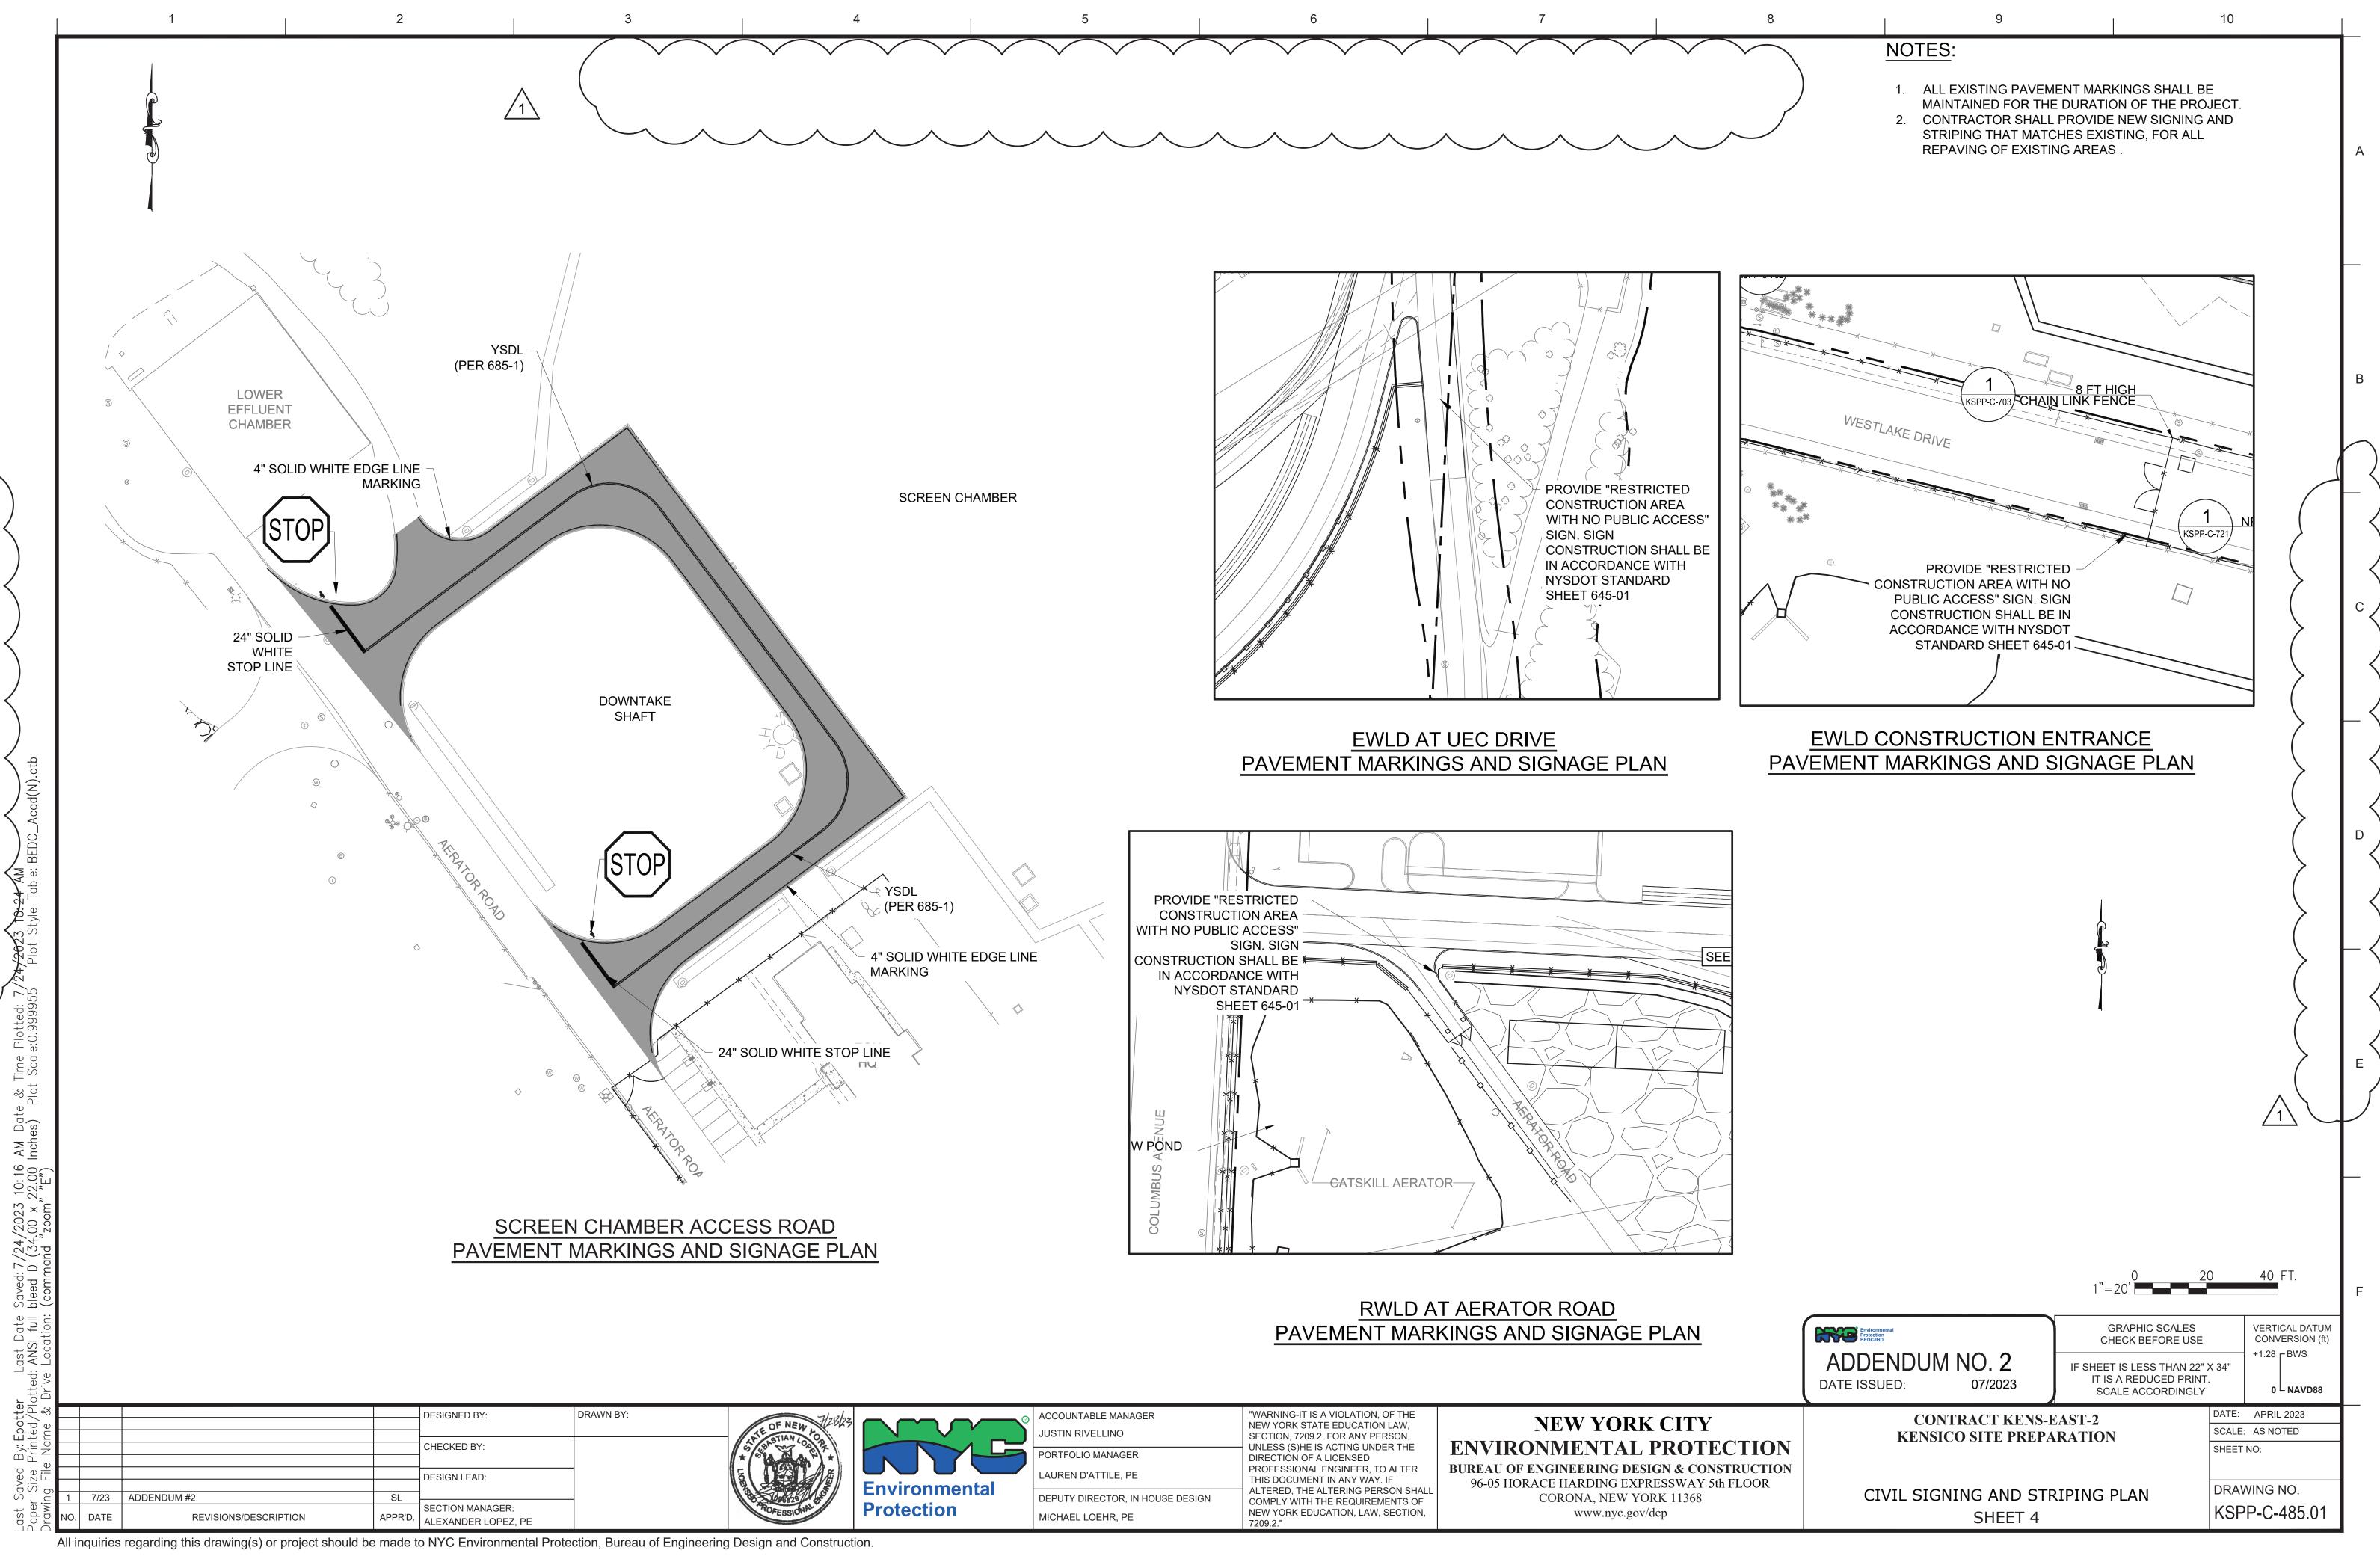


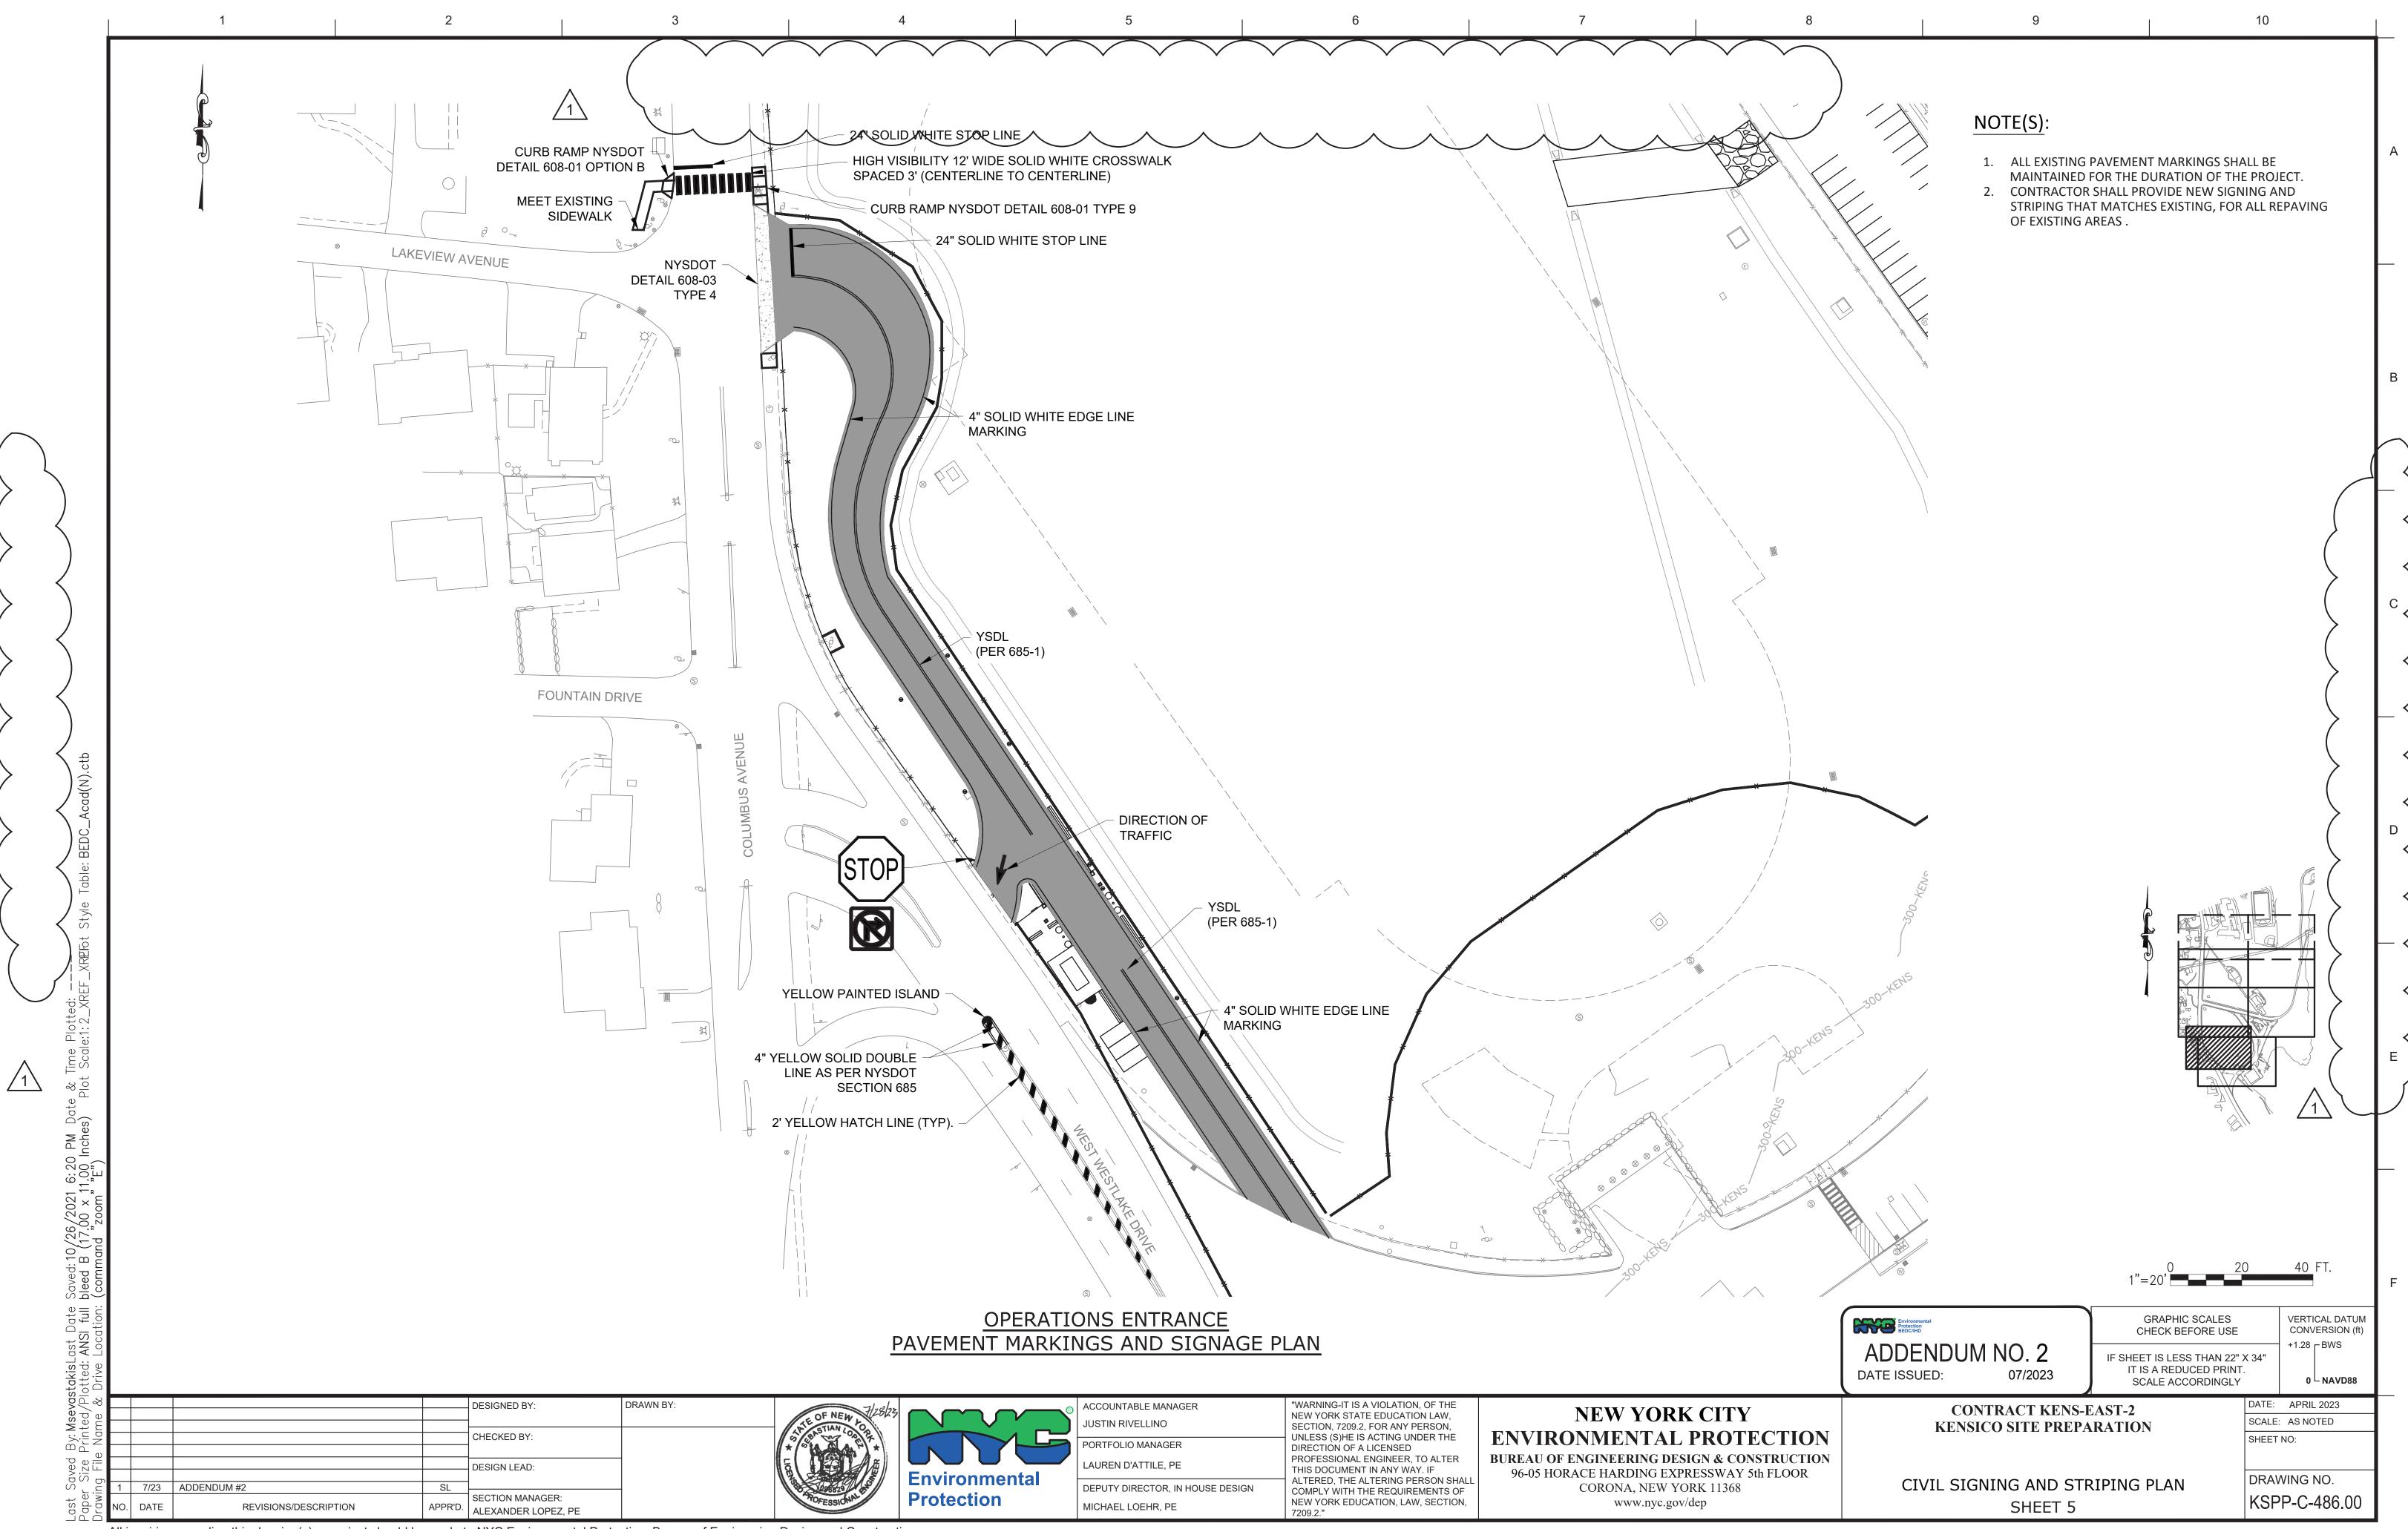


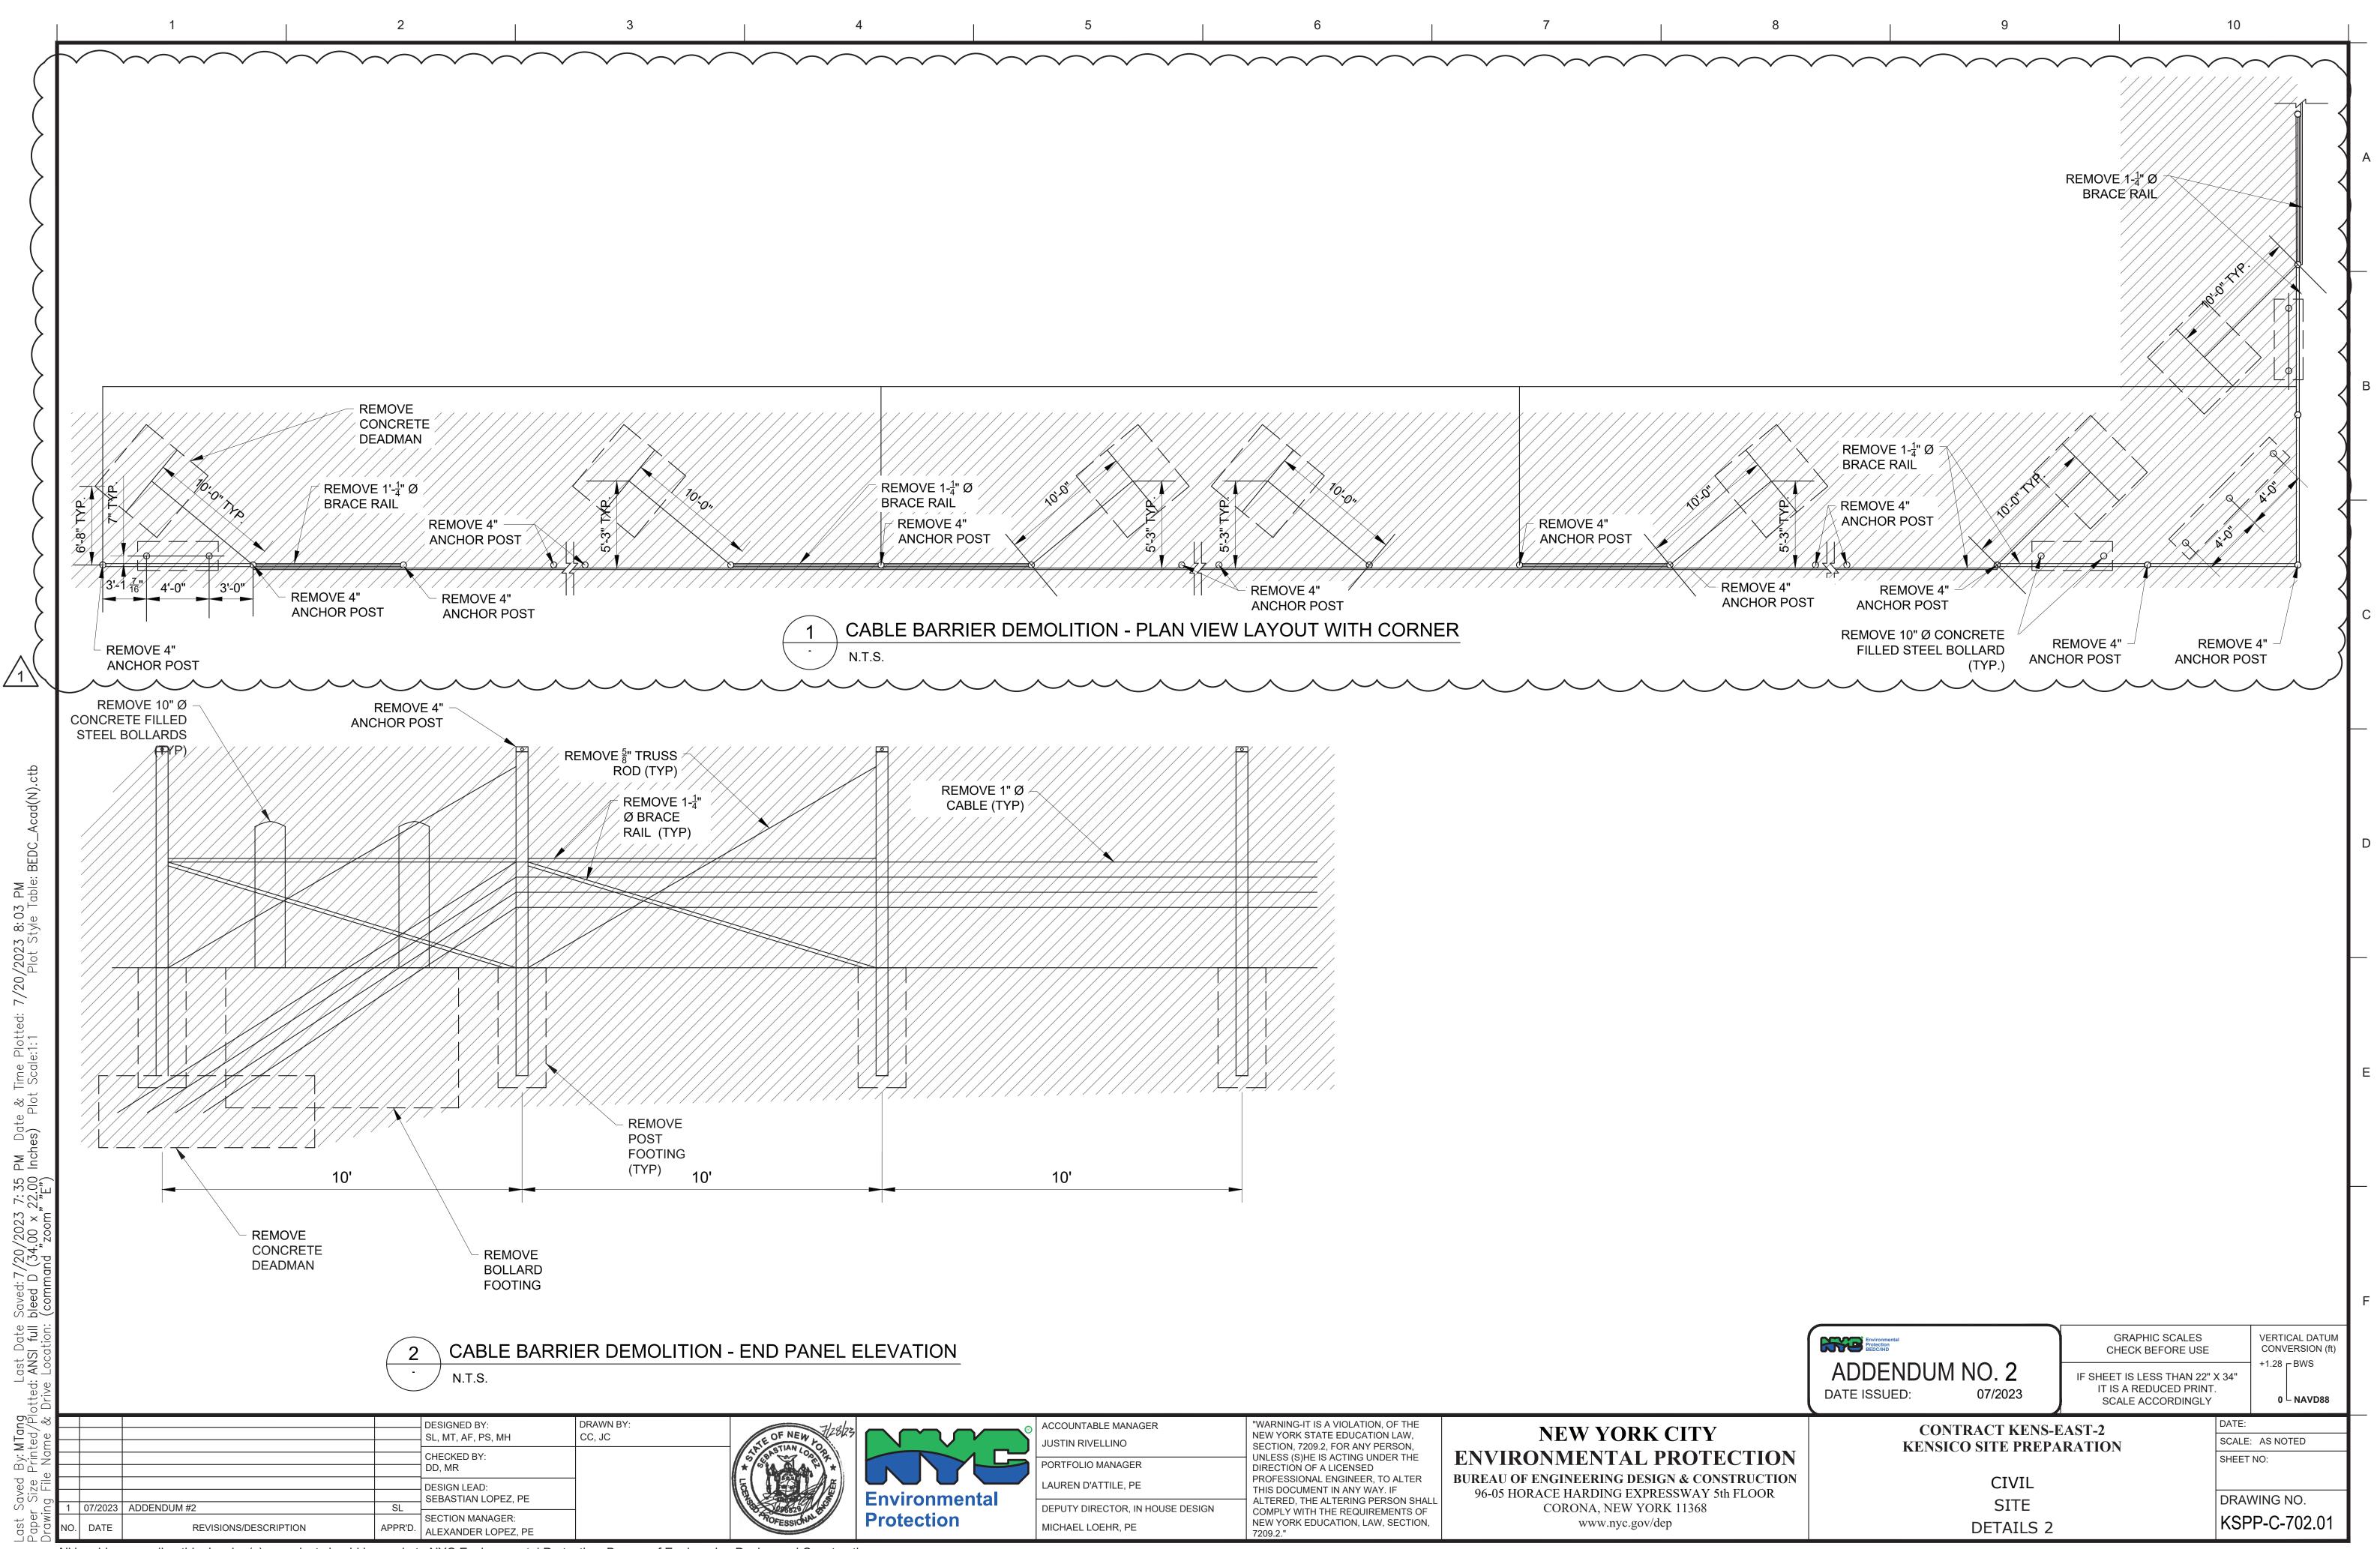

ĺ	Environmental Protection BEDC/IHD	GRAPHIC SCALES CHECK BEFORE USE		VERTICAL DATUM CONVERSION (ft)	
	ADDENDUM NO. 2 DATE ISSUED: 07/2023	IF SHEET IS LESS THAN 22" IT IS A REDUCED PRINT SCALE ACCORDINGLY	-	CONVERSION (ft) +1.28 BWS 0 NAVD88 E: AS NOTED T NO: WING NO.	
	CONTRACT KENS-E KENSICO SITE PREPA		DATE: SCALE	: AS NOTED	
ΓΙΟΝ	KENSICO SITE I KEI A	KATION	SHEET	NO:	
LOOR	CIVIL				
	SITE				

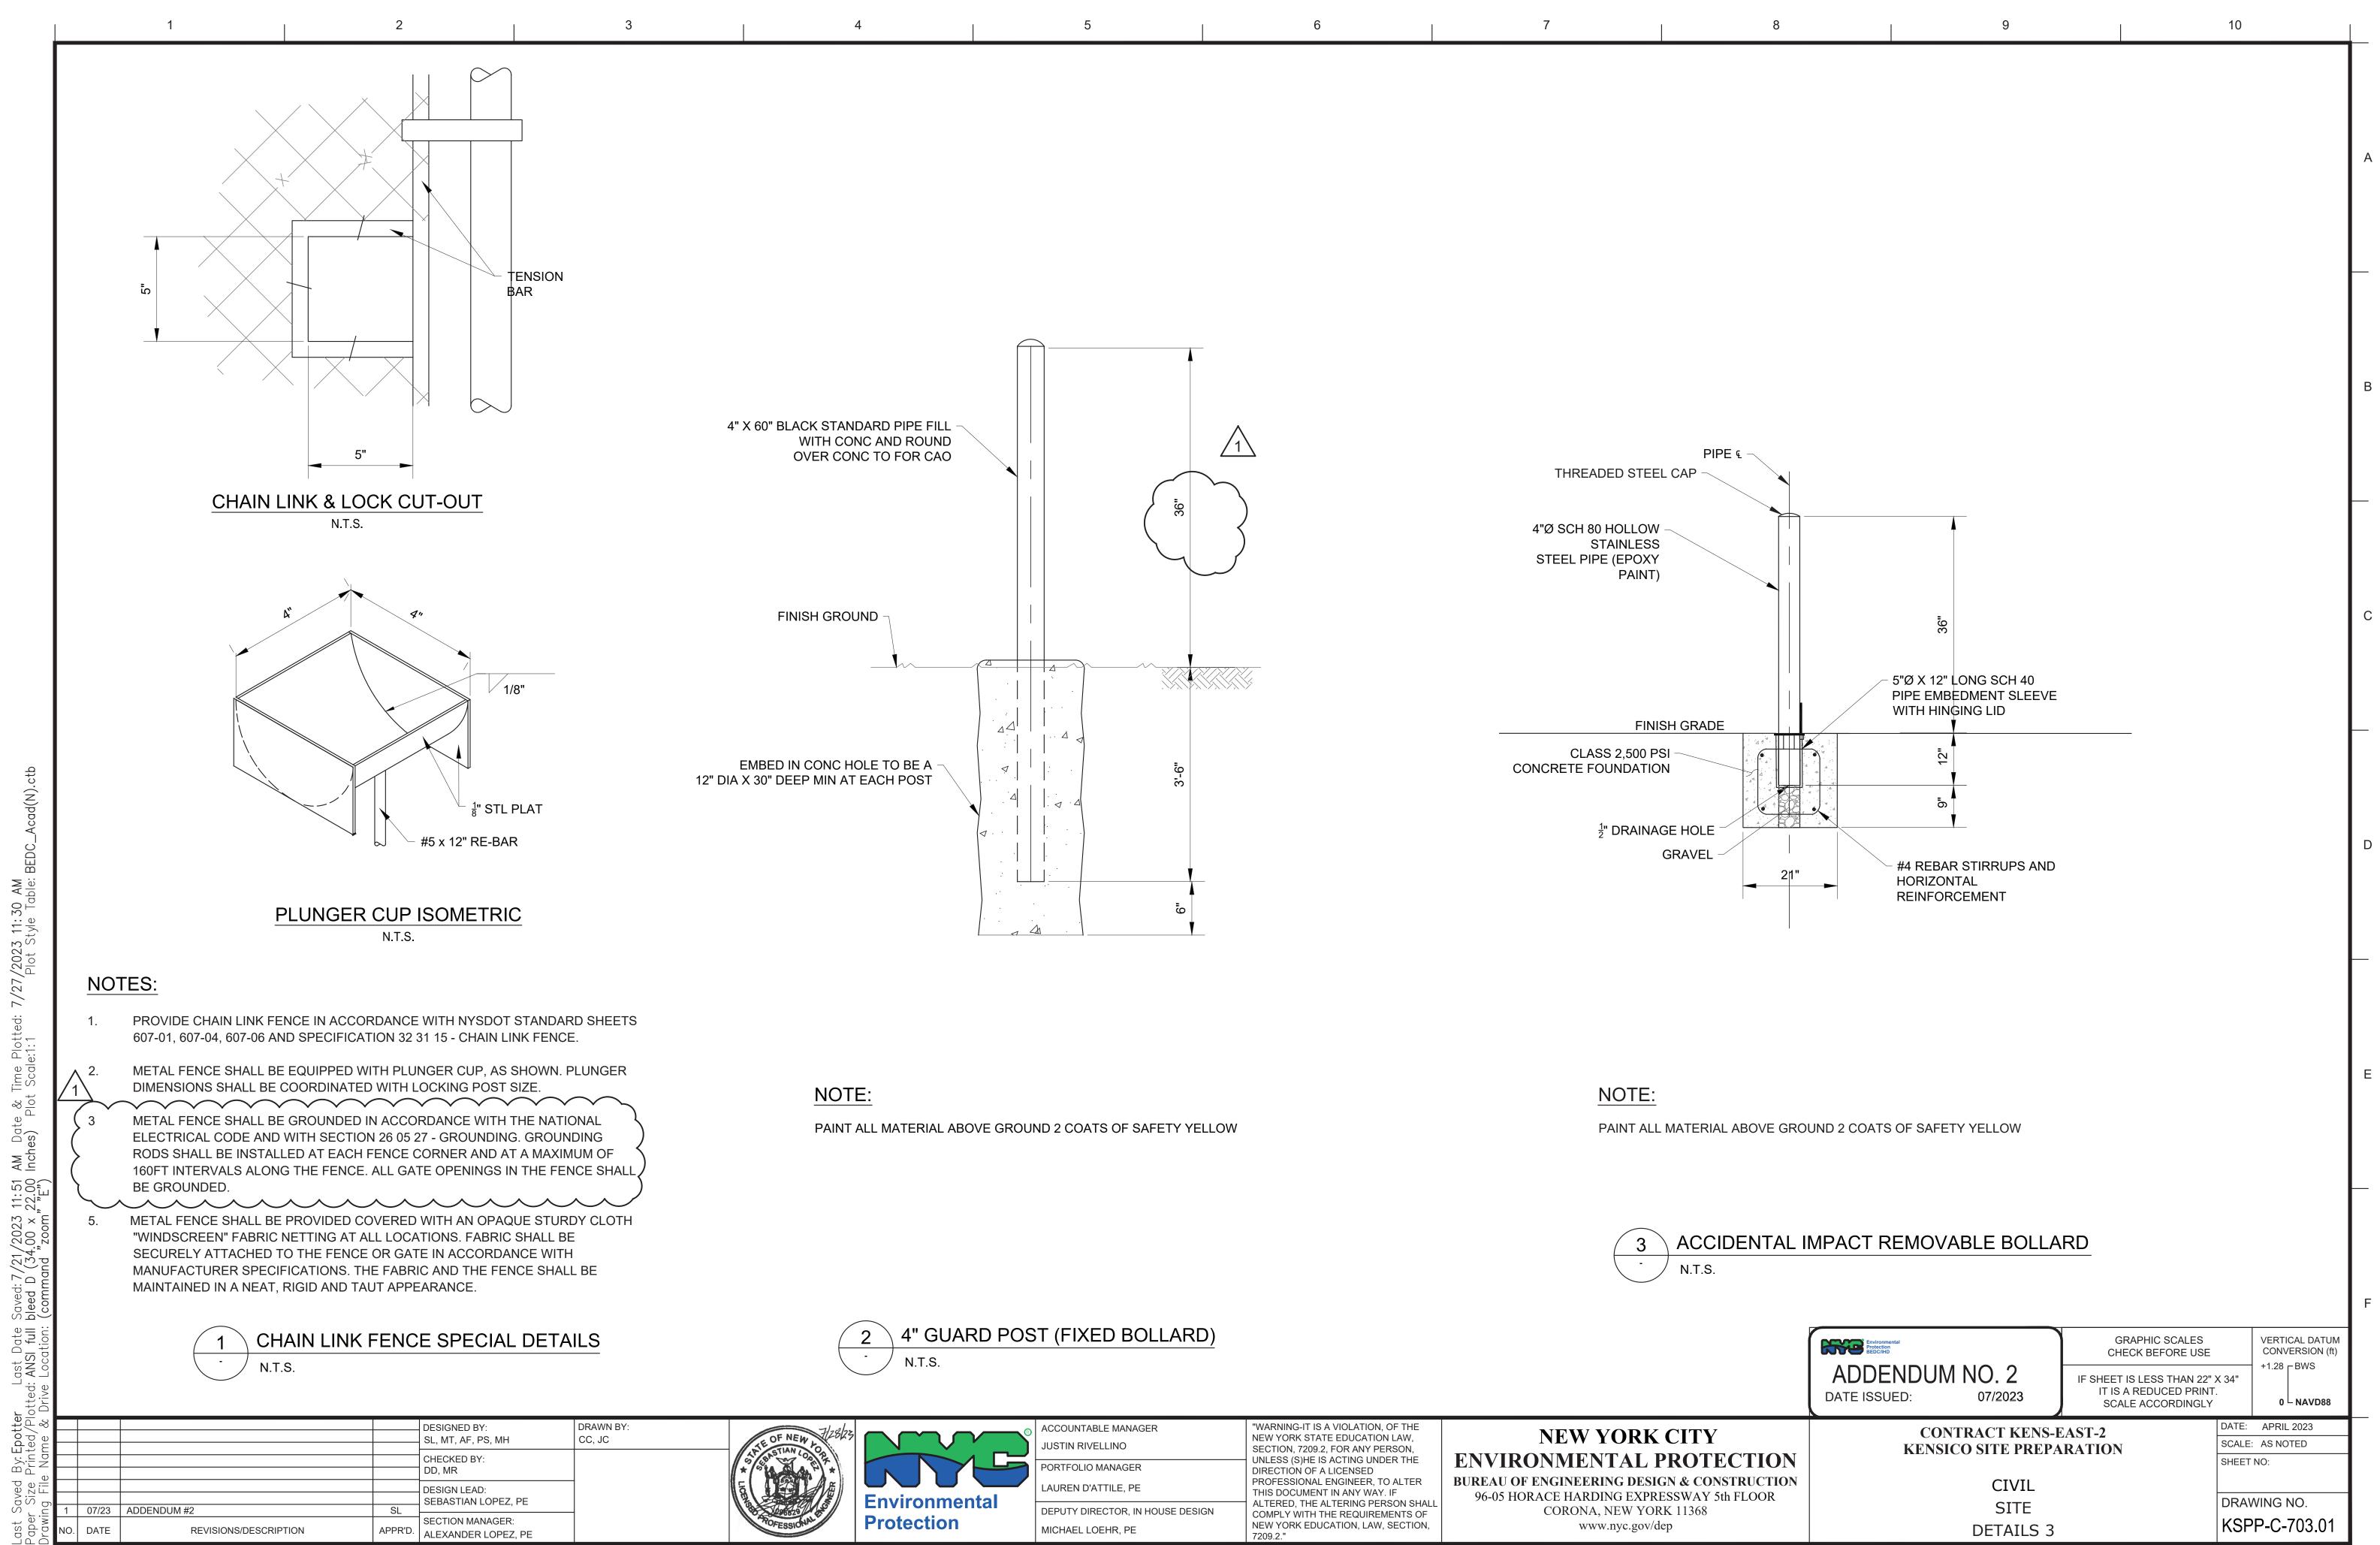

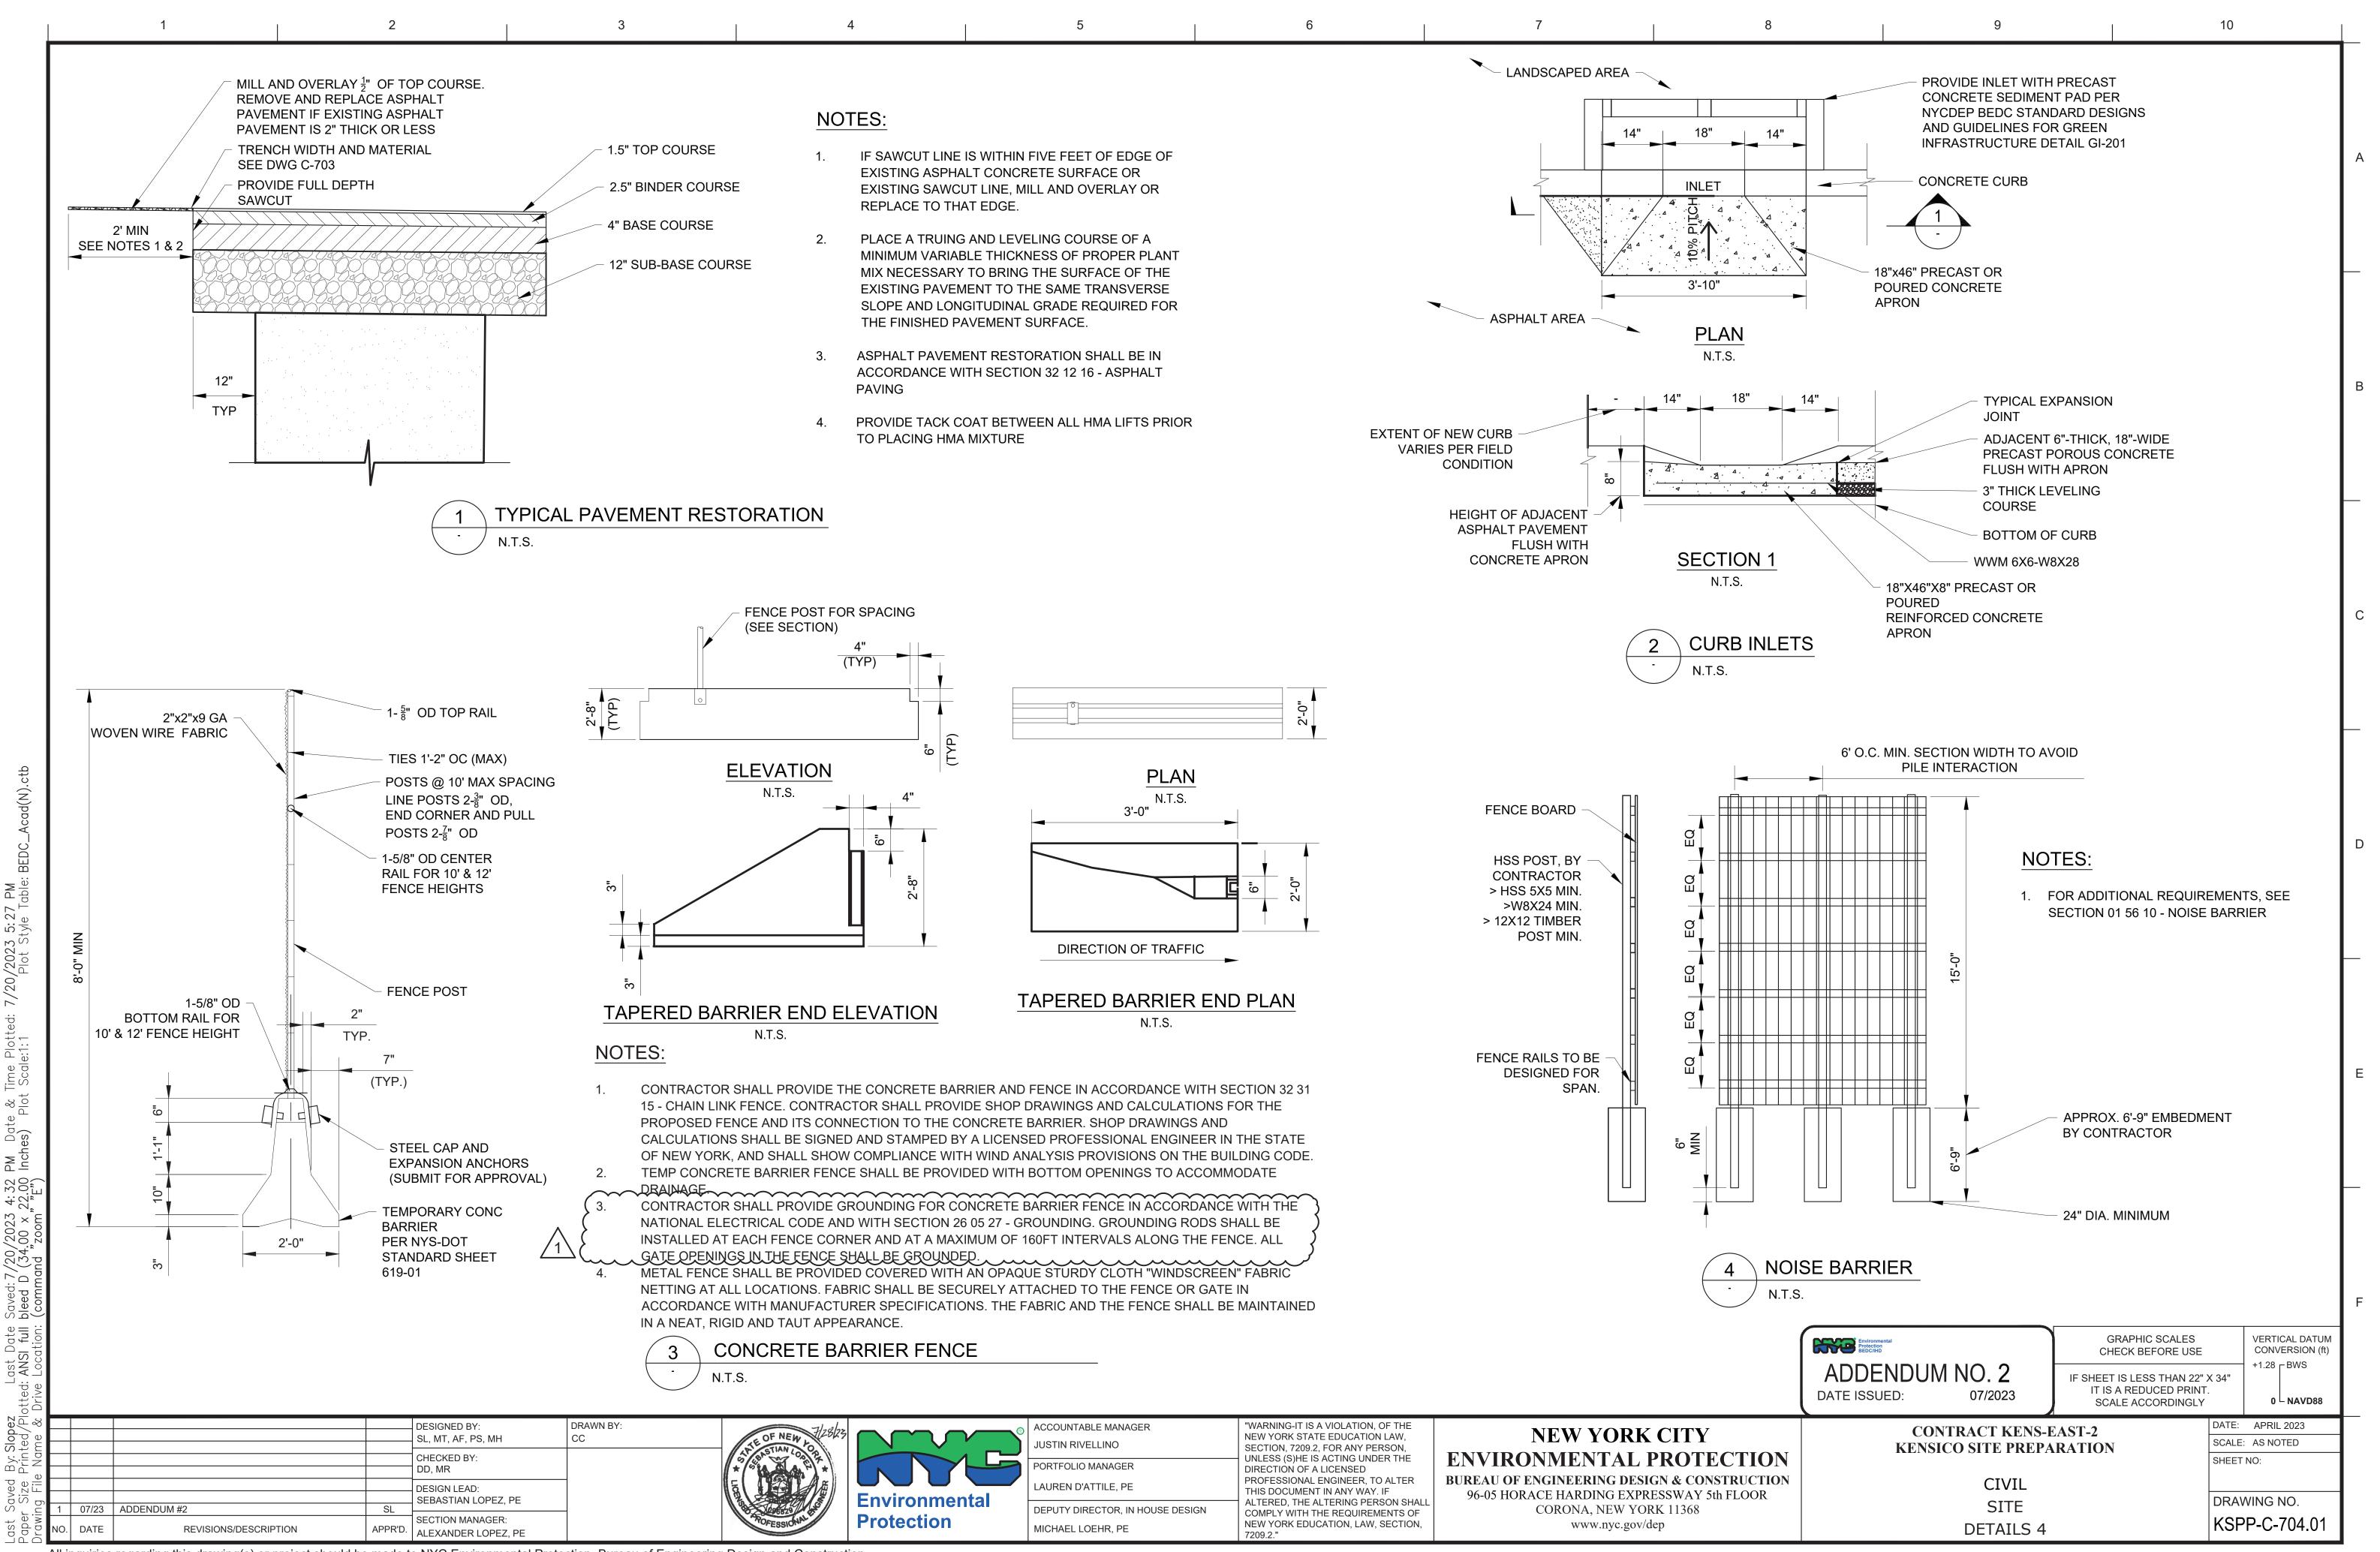

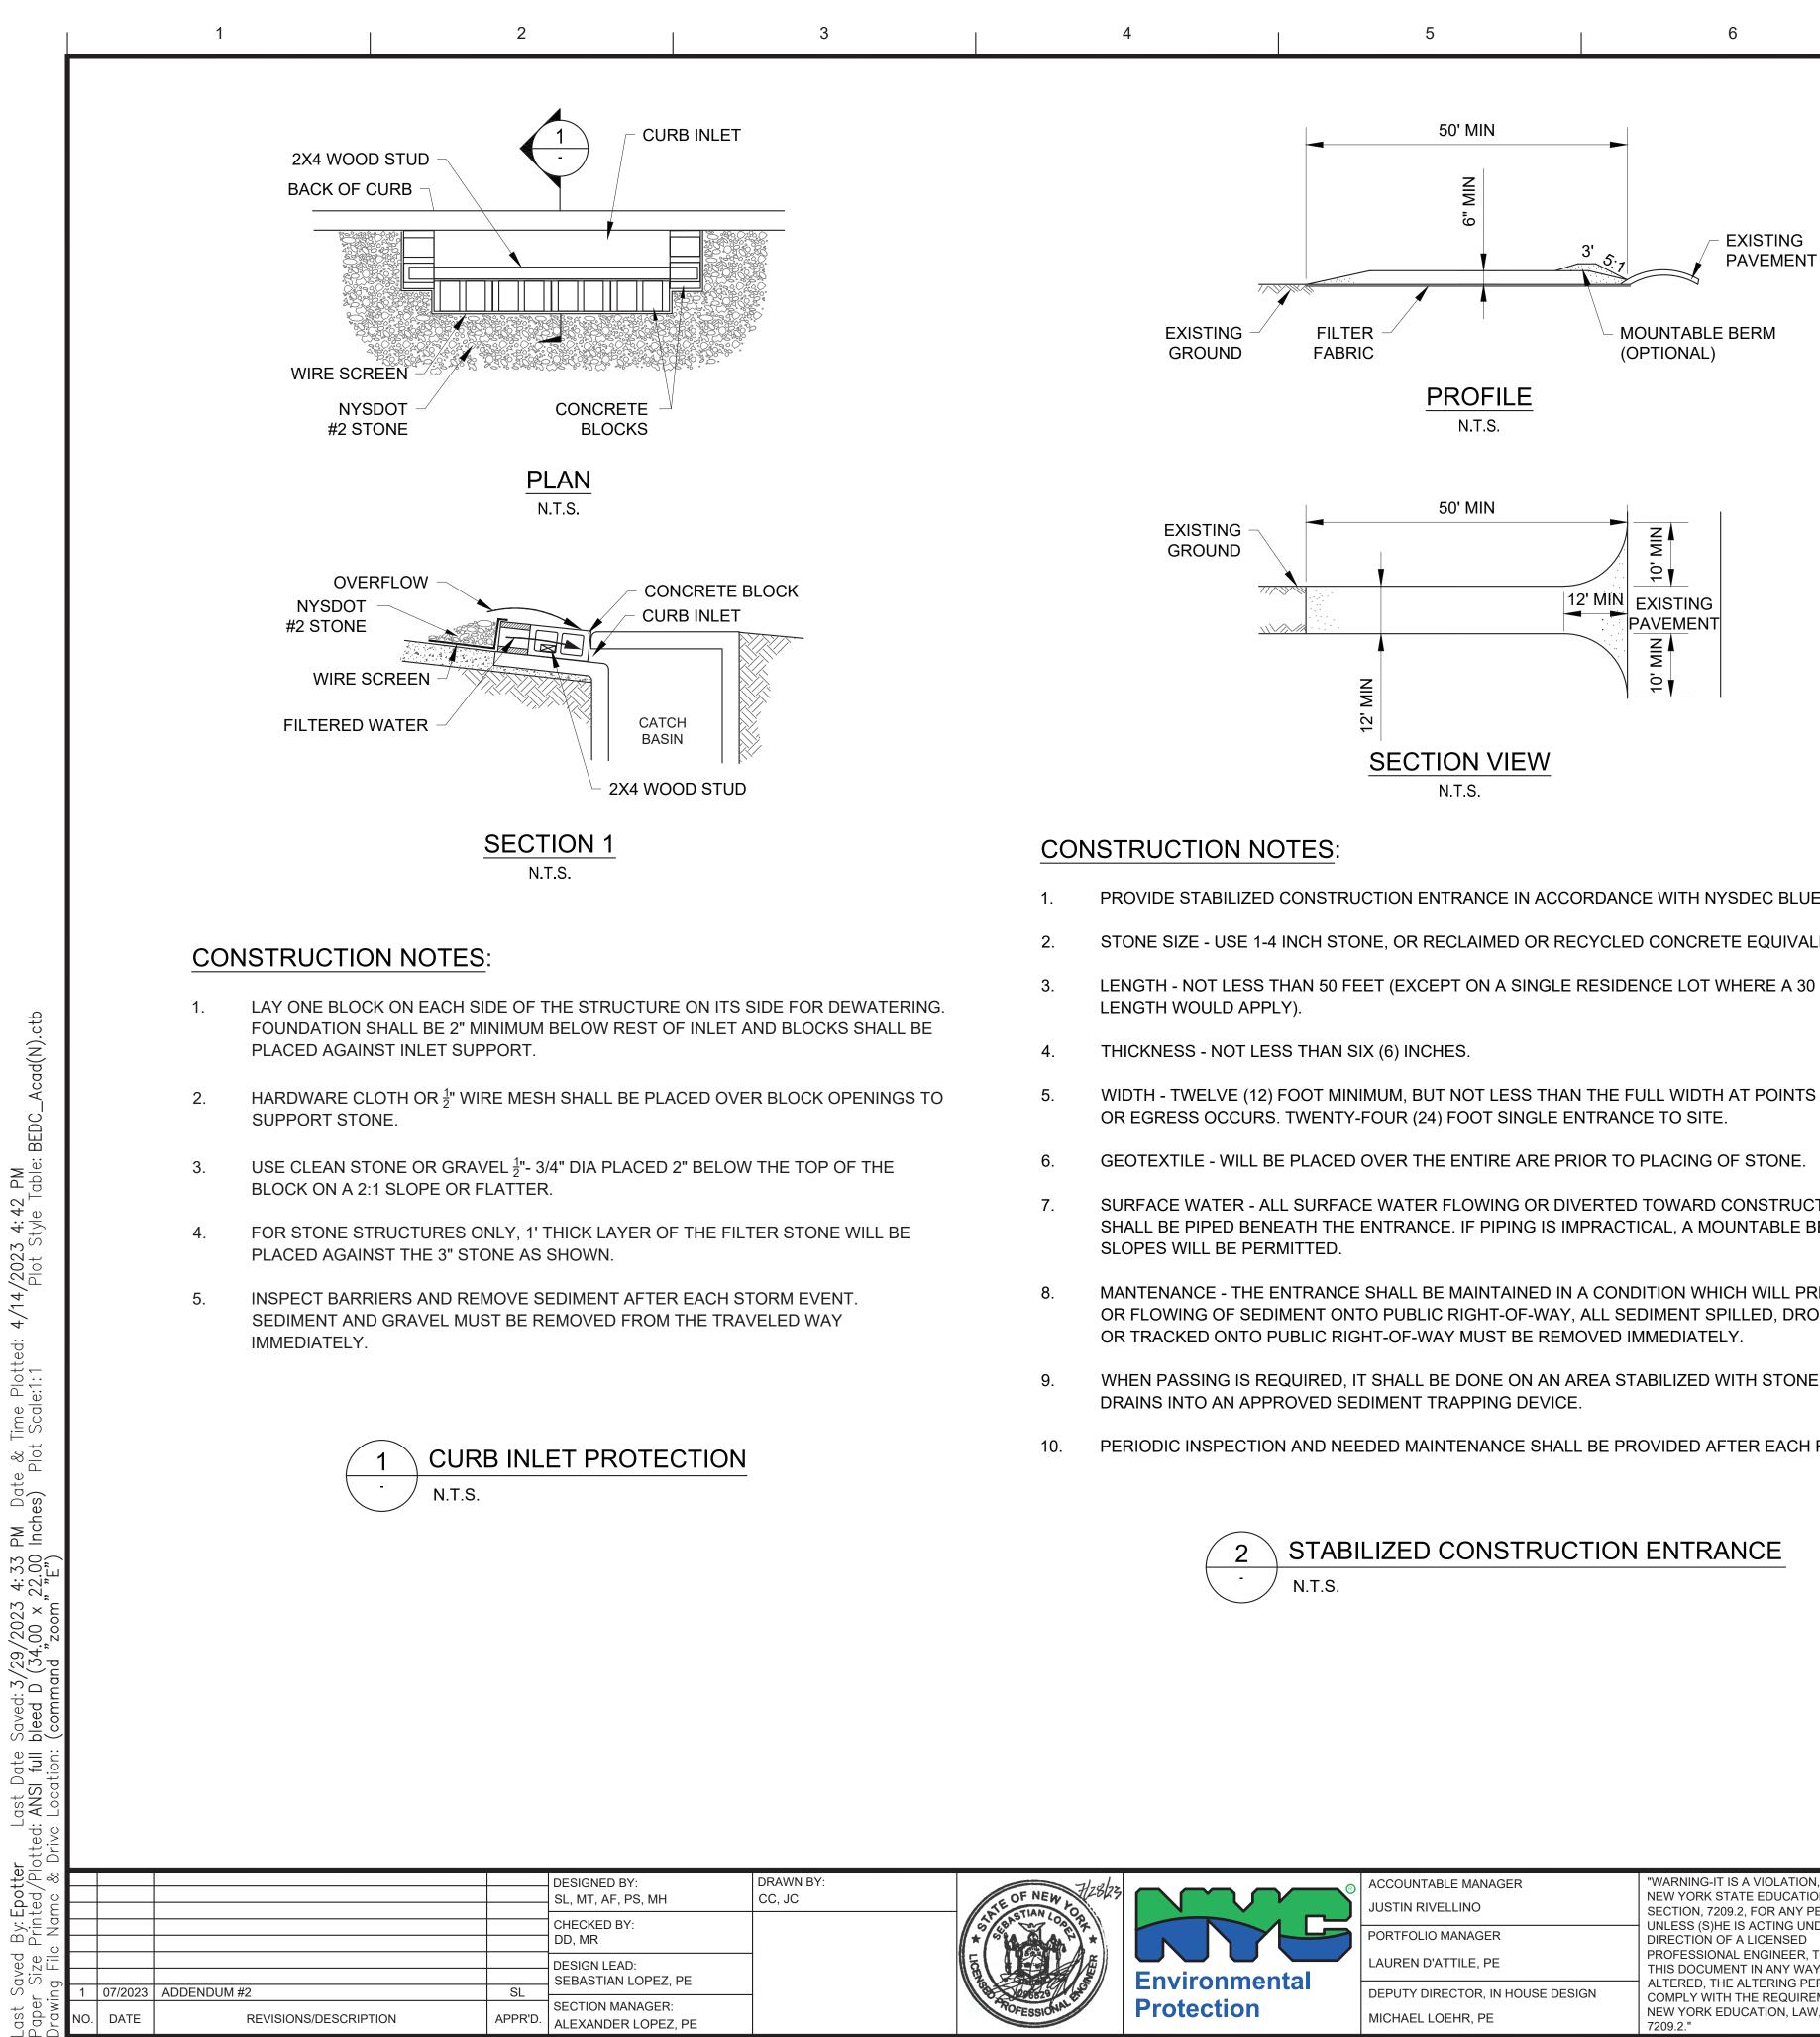





PROVIDE STABILIZED CONSTRUCTION ENTRANCE IN ACCORDANCE WITH NYSDEC BLUE BOOK

STONE SIZE - USE 1-4 INCH STONE, OR RECLAIMED OR RECYCLED CONCRETE EQUIVALENT.

LENGTH - NOT LESS THAN 50 FEET (EXCEPT ON A SINGLE RESIDENCE LOT WHERE A 30 FOOT MINIMUM


WIDTH - TWELVE (12) FOOT MINIMUM, BUT NOT LESS THAN THE FULL WIDTH AT POINTS WHERE INGRESS


SURFACE WATER - ALL SURFACE WATER FLOWING OR DIVERTED TOWARD CONSTRUCTION ACCESS SHALL BE PIPED BENEATH THE ENTRANCE. IF PIPING IS IMPRACTICAL. A MOUNTABLE BERM WITH 5:1


MANTENANCE - THE ENTRANCE SHALL BE MAINTAINED IN A CONDITION WHICH WILL PREVENT TRACKING OR FLOWING OF SEDIMENT ONTO PUBLIC RIGHT-OF-WAY, ALL SEDIMENT SPILLED, DROPPED, WASHED

WHEN PASSING IS REQUIRED, IT SHALL BE DONE ON AN AREA STABILIZED WITH STONE AND WHICH

PERIODIC INSPECTION AND NEEDED MAINTENANCE SHALL BE PROVIDED AFTER EACH RAIN.

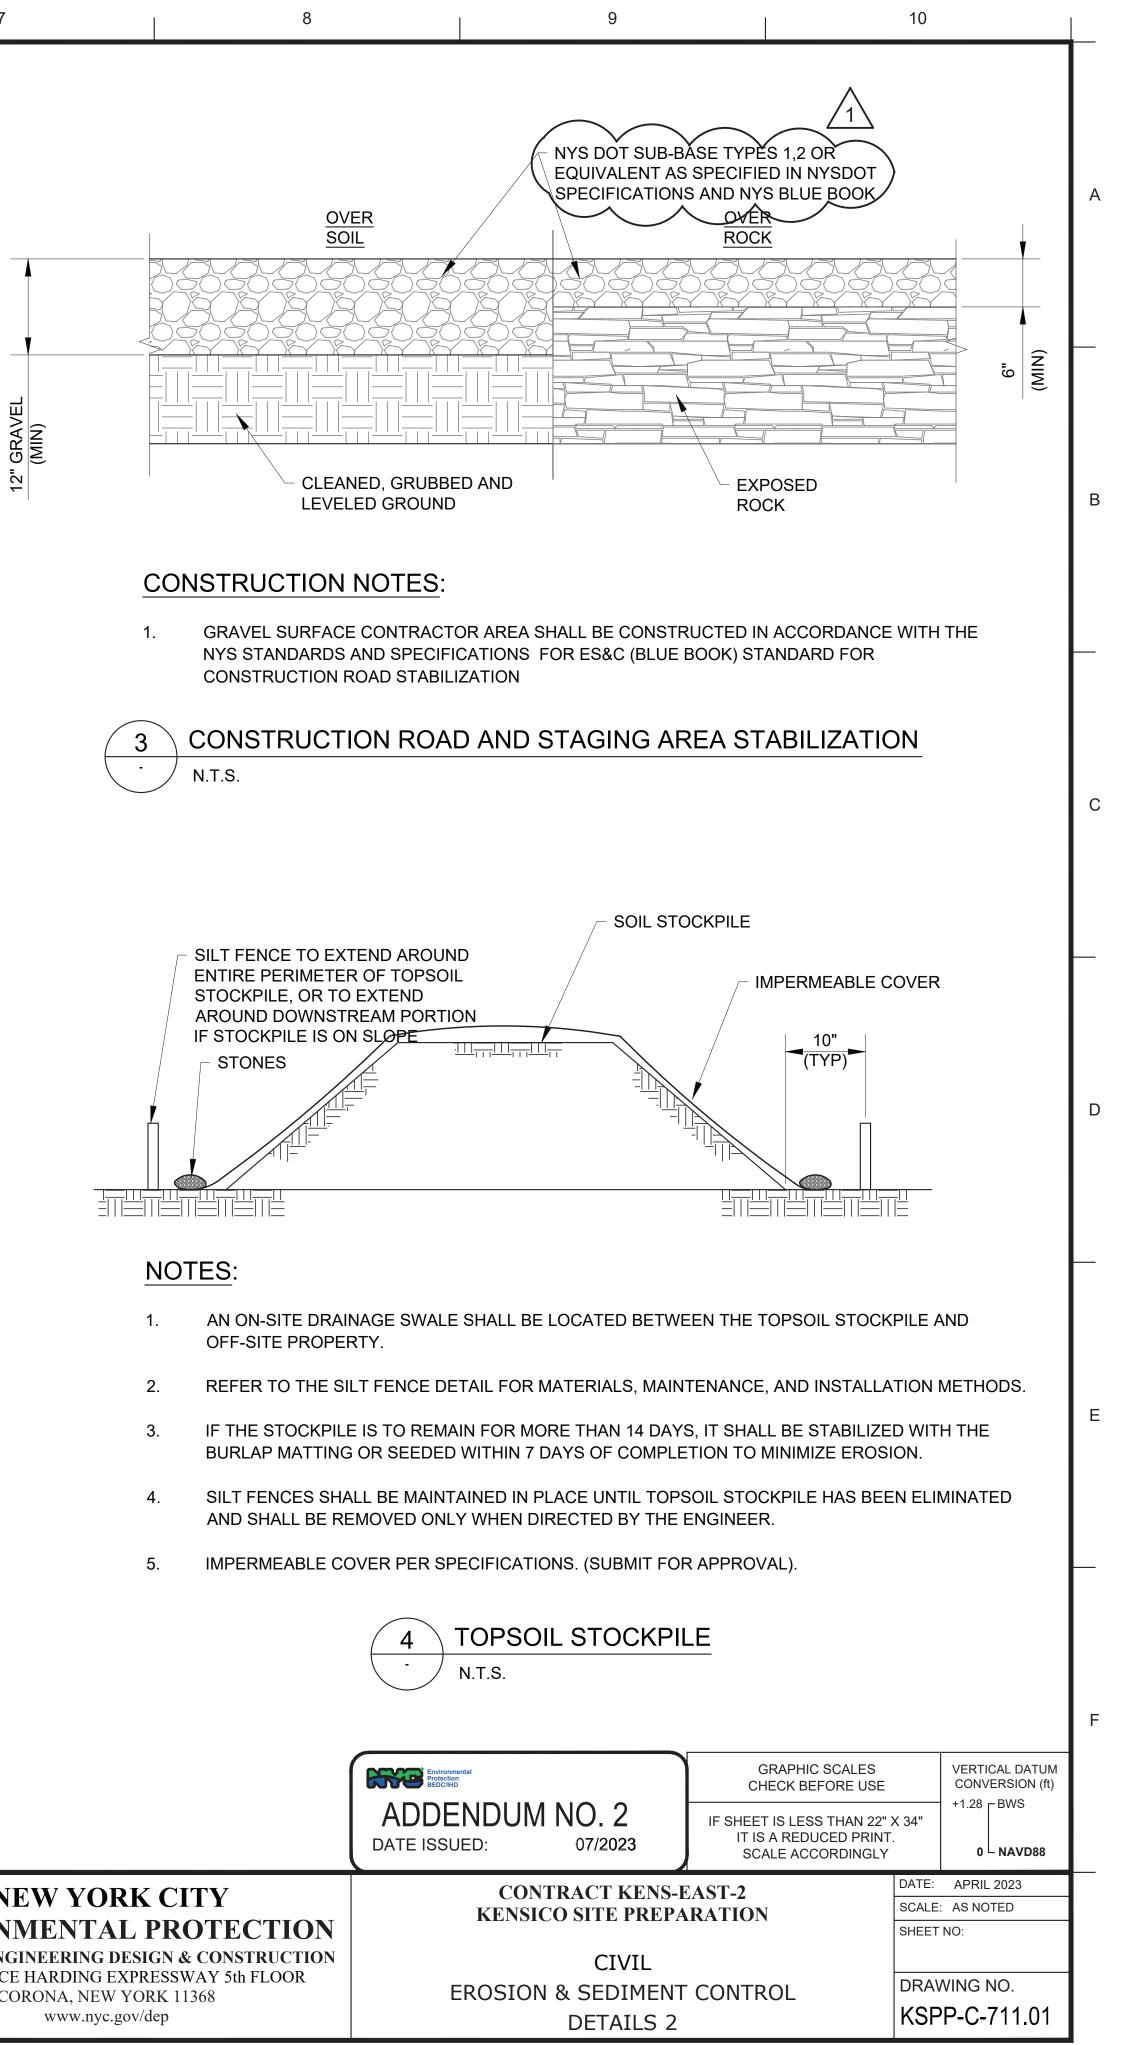

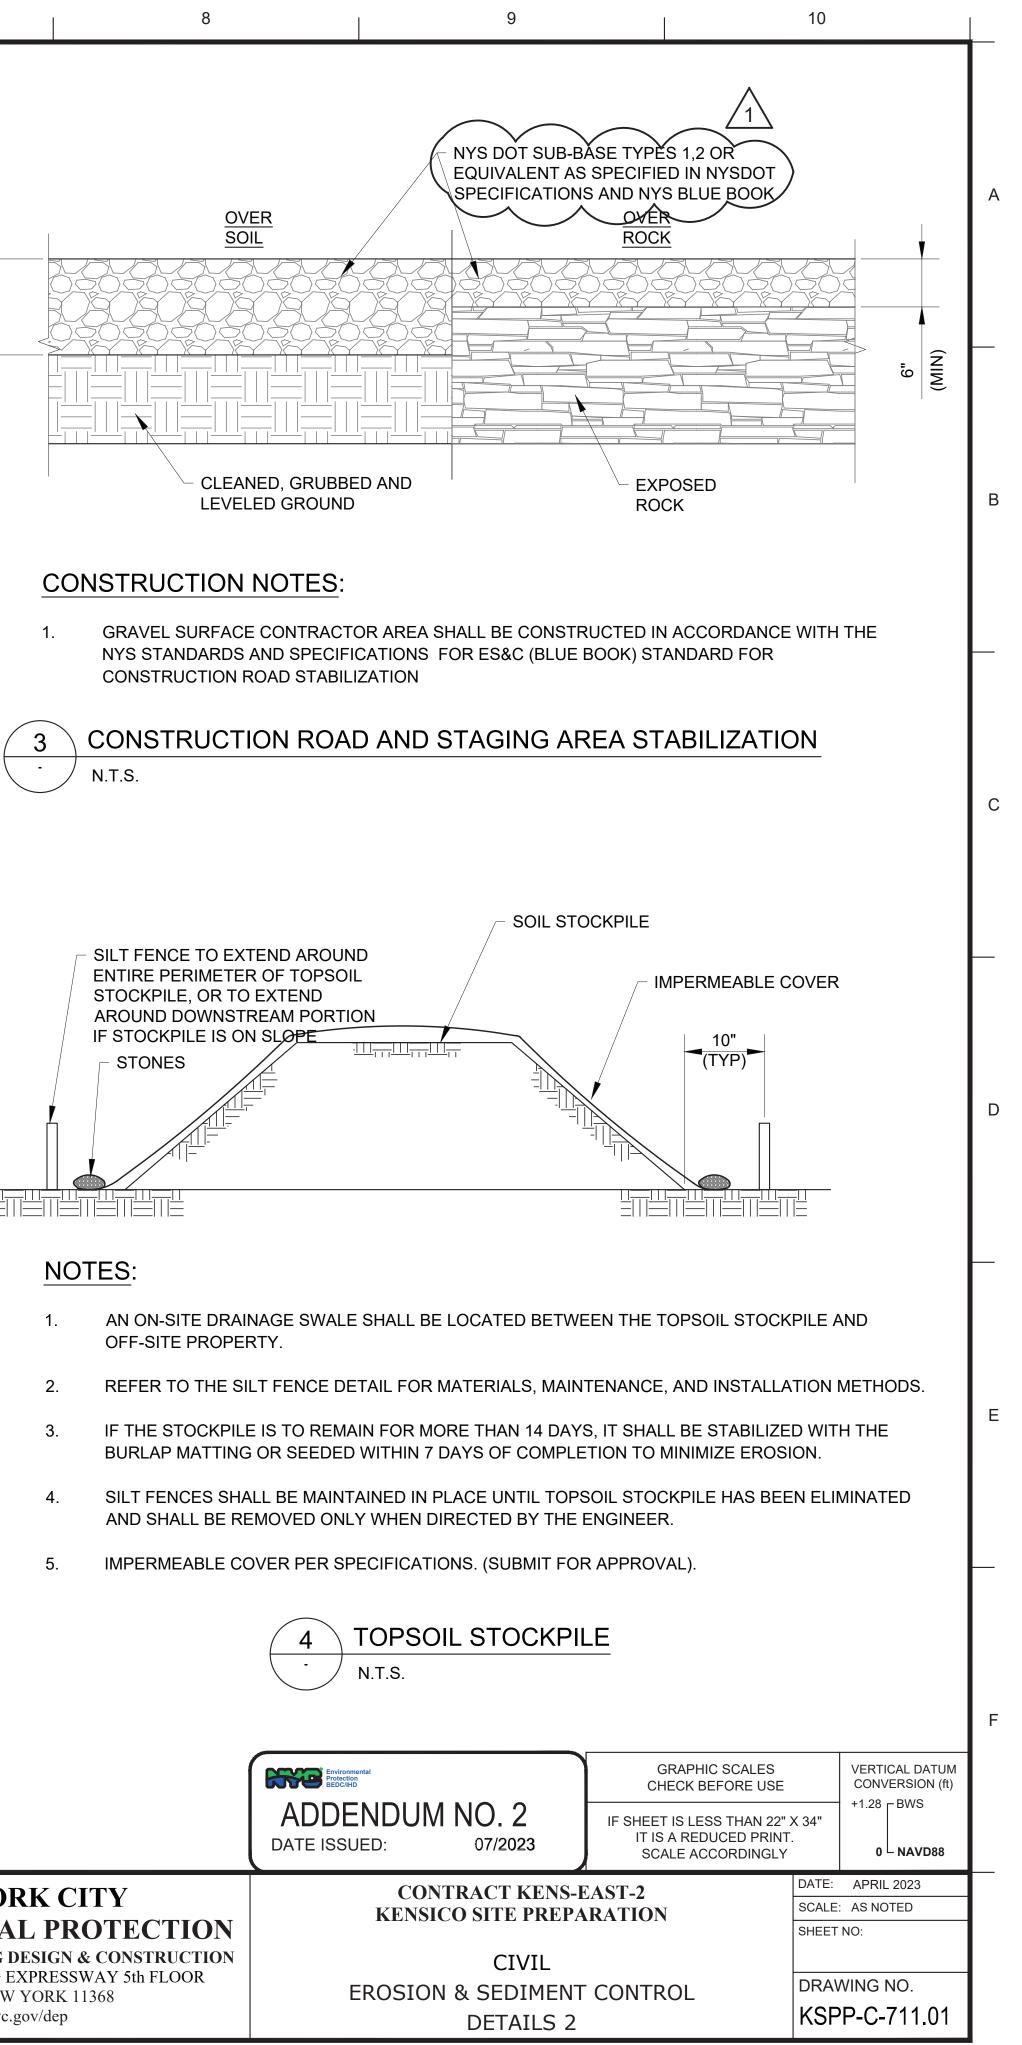

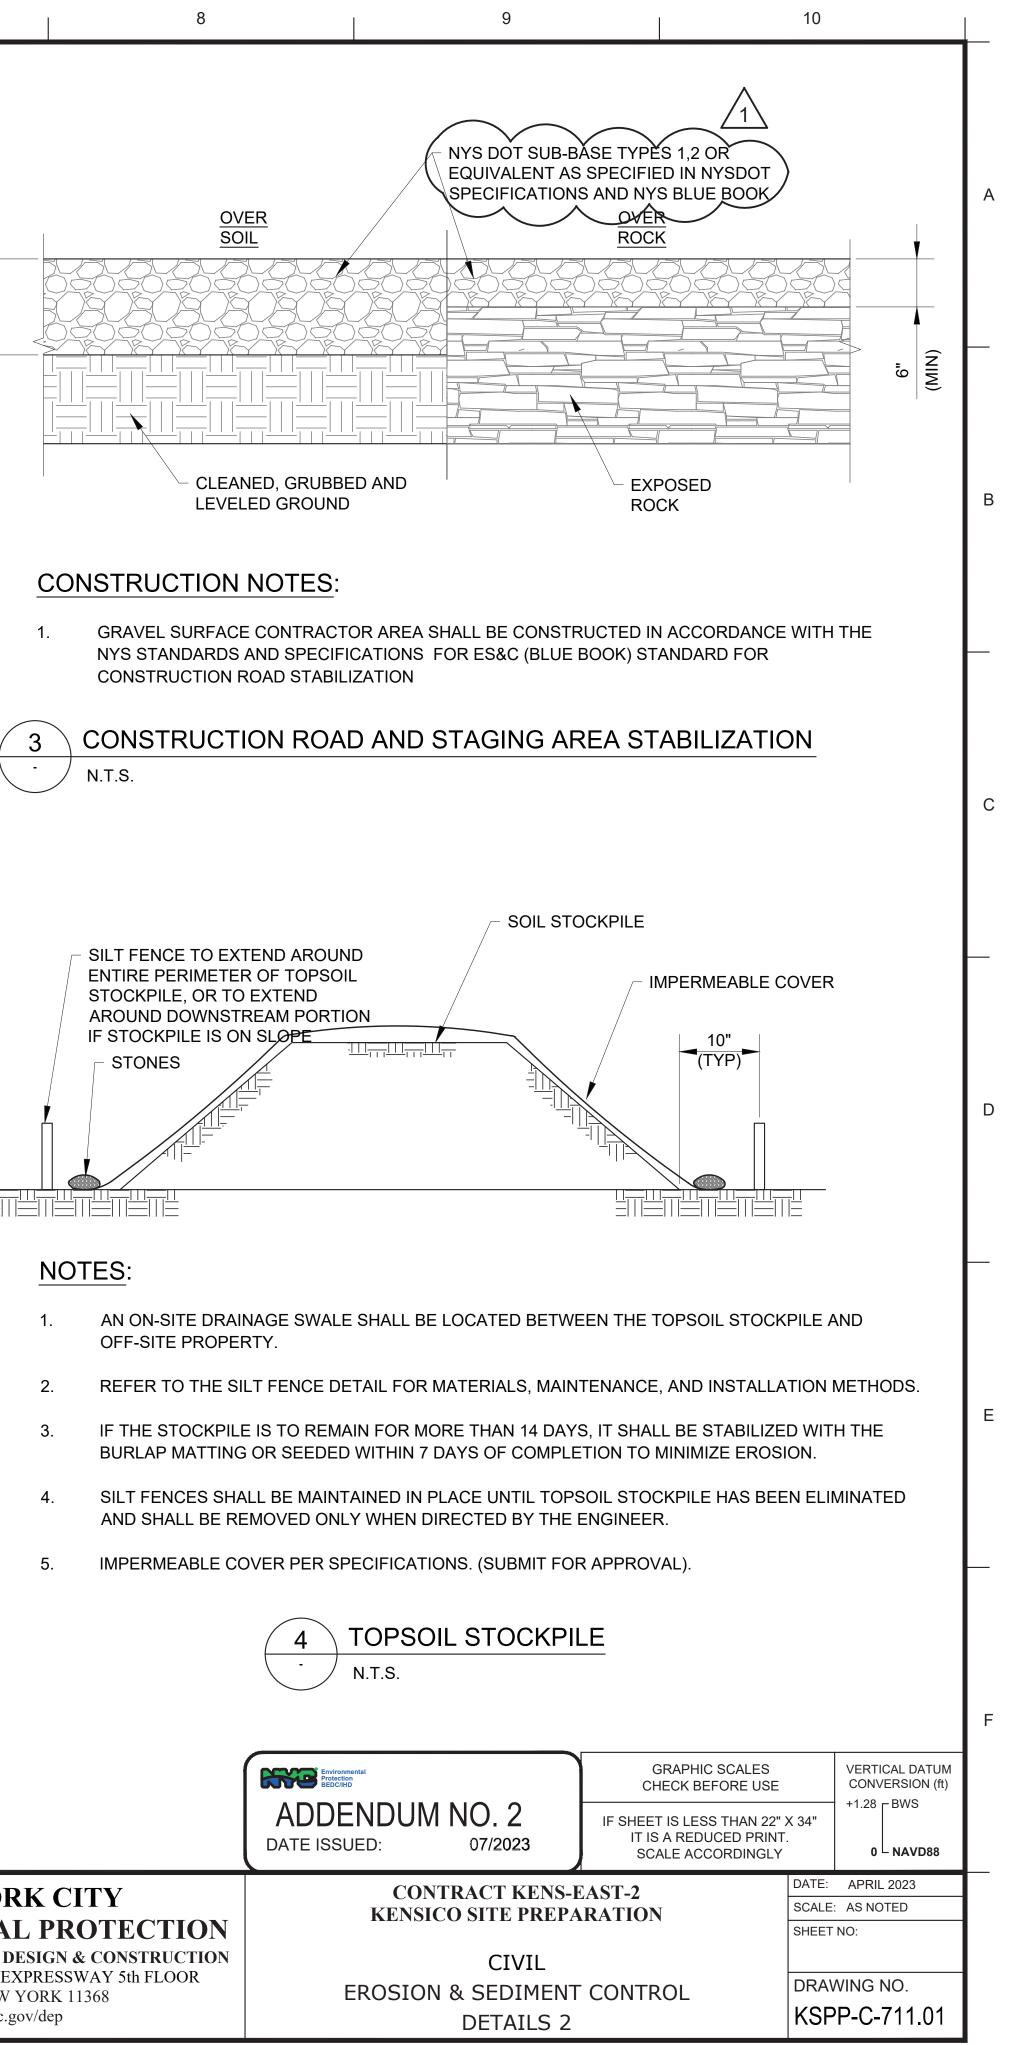


NOT	ES:

	OFF-SIT
2.	REFER
3.	IF THE S BURLAF
4.	SILT FE AND SH


ACCOUNTABLE MANAGER
JUSTIN RIVELLINO
PORTFOLIO MANAGER
LAUREN D'ATTILE, PE
DEPUTY DIRECTOR, IN HOUSE DESIGN

"WARNING-IT IS A VIOLATION, OF THE NEW YORK STATE EDUCATION LAW, SECTION, 7209.2, FOR ANY PERSON, UNLESS (S)HE IS ACTING UNDER THE DIRECTION OF A LICENSED PROFESSIONAL ENGINEER, TO ALTER THIS DOCUMENT IN ANY WAY. IF ALTERED, THE ALTERING PERSON SHALL COMPLY WITH THE REQUIREMENTS OF NEW YORK EDUCATION, LAW, SECTION,


NEW YORK CITY ENVIRONMENTAL PROTECTION BUREAU OF ENGINEERING DESIGN & CONSTRUCTION 96-05 HORACE HARDING EXPRESSWAY 5th FLOOR CORONA, NEW YORK 11368

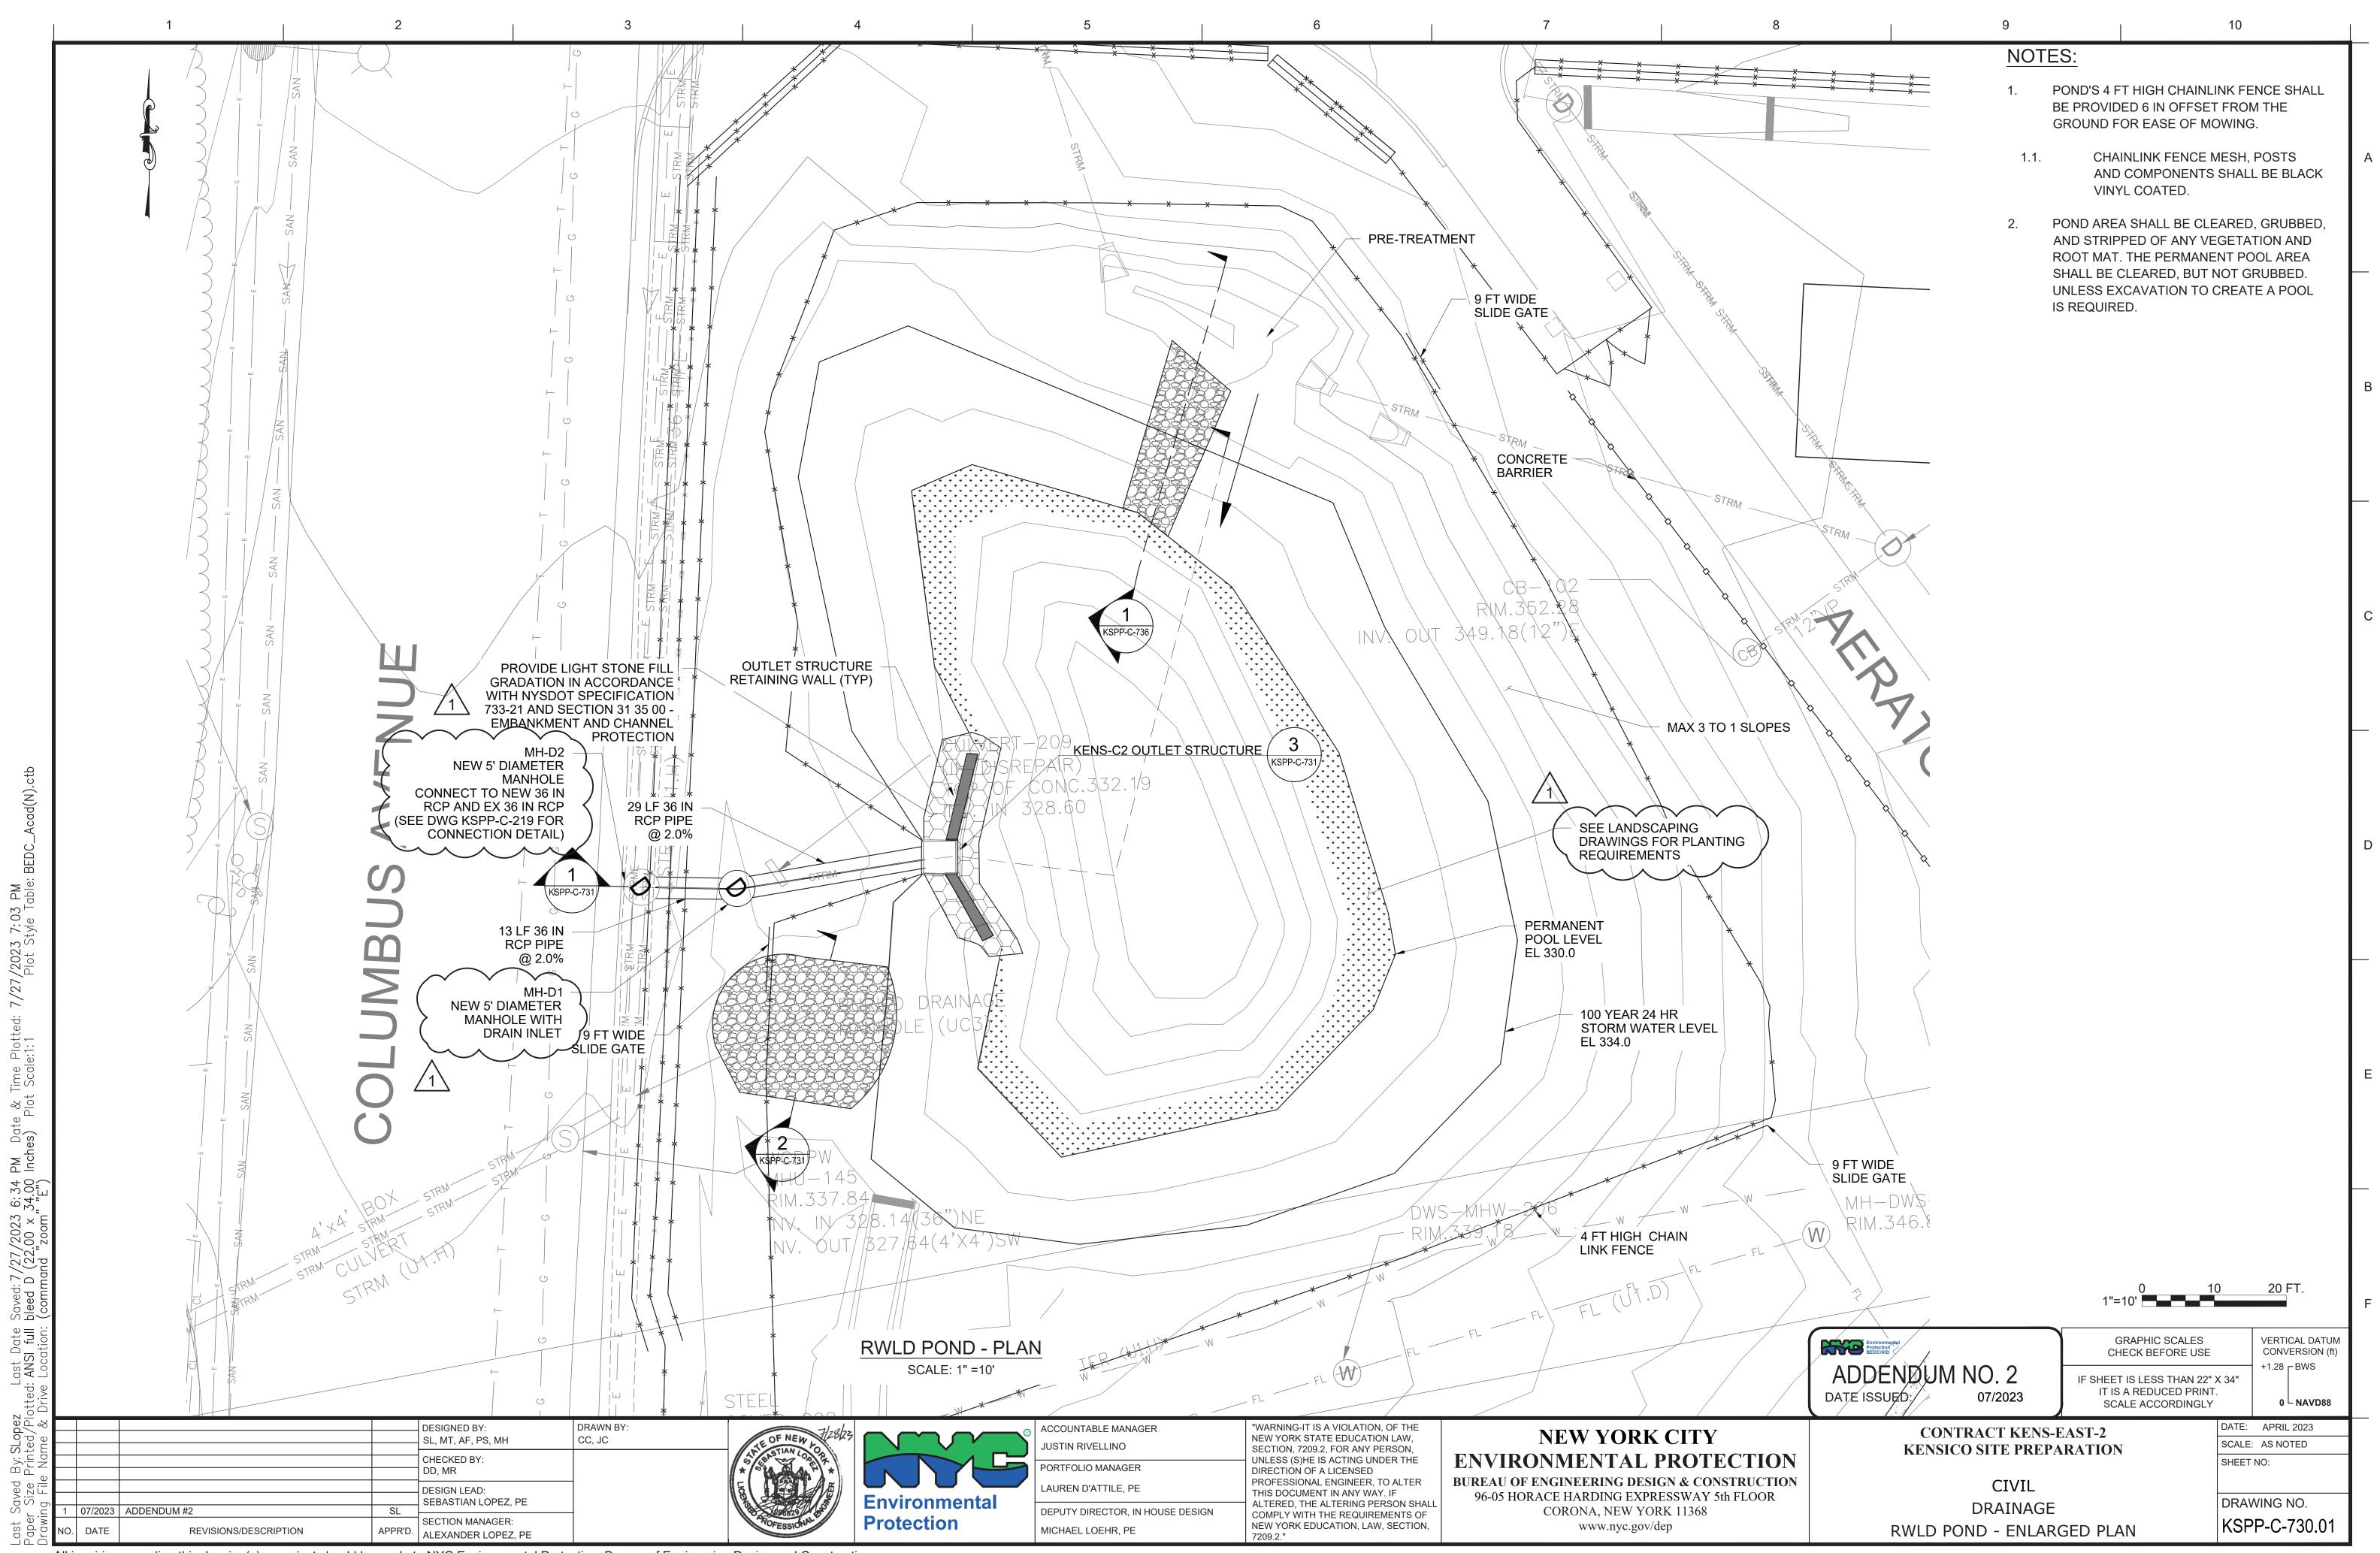


All inquiries regarding this drawing(s) or project should be made to NYC Environmental Protection, Bureau of Engineering Design and Construction.

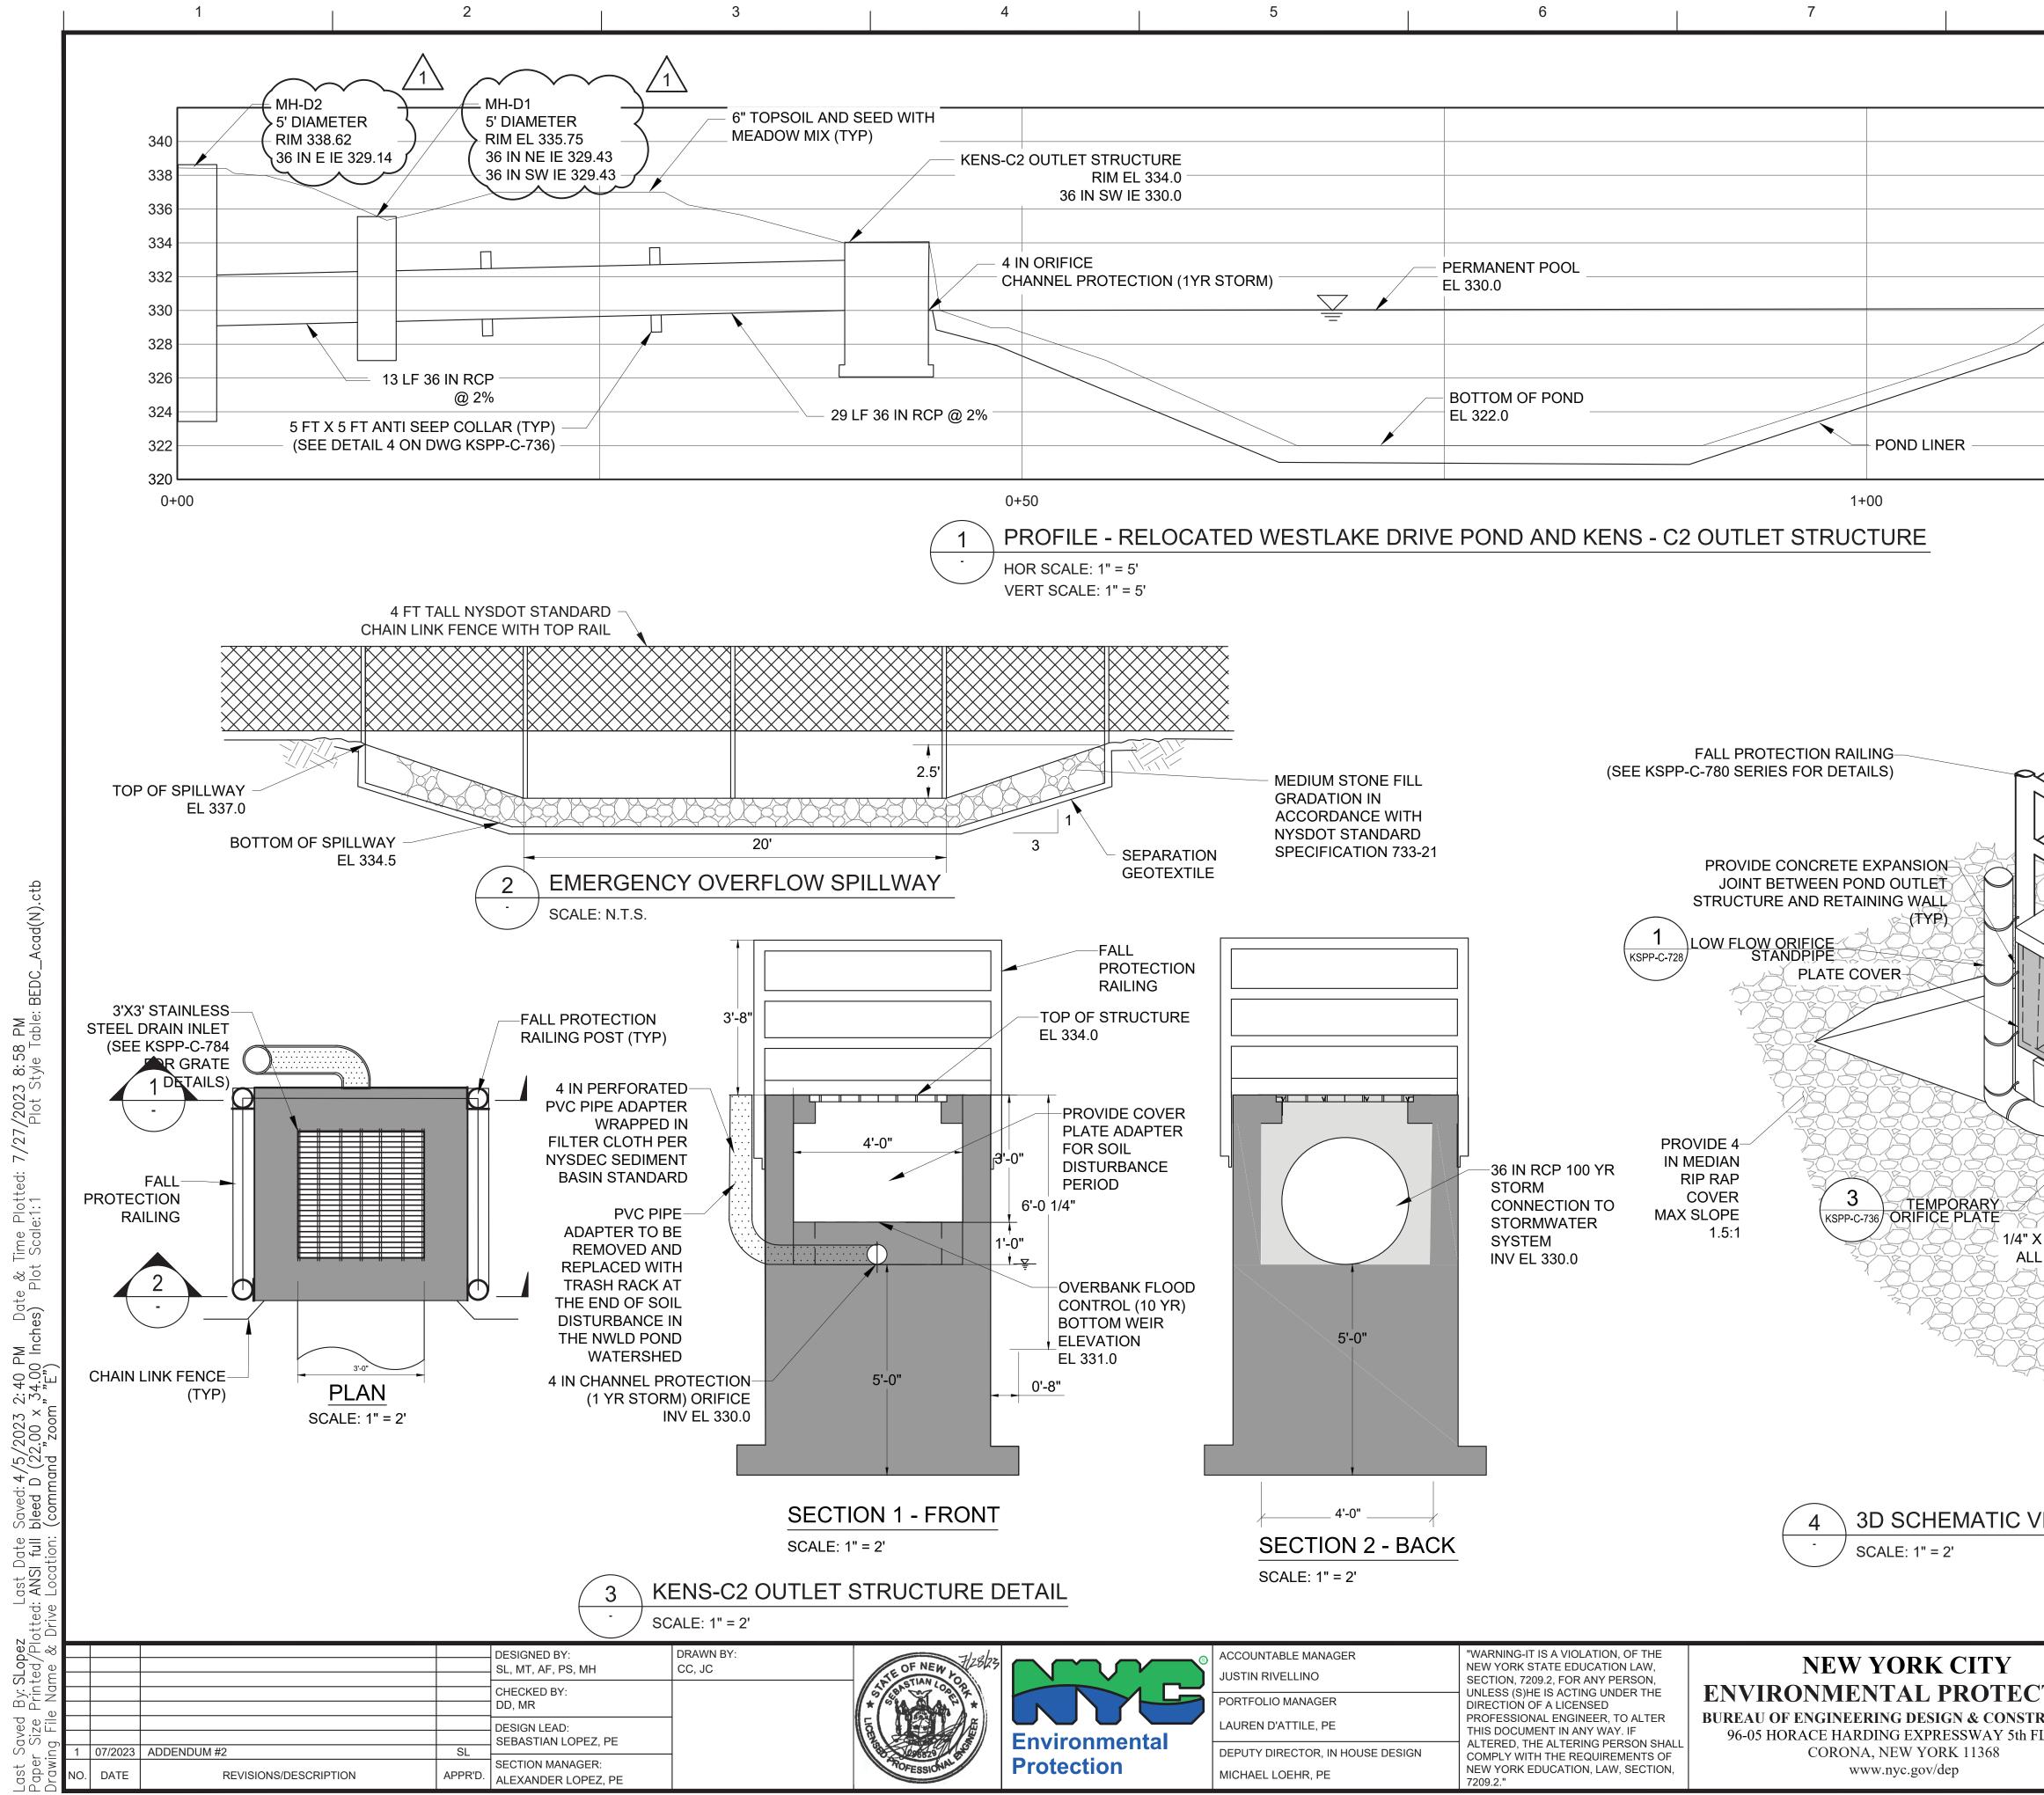


8		9		10	
	33	FC C/ 40 NE 38 PF 36 W 36 W 34 SE 32 PI	S: ONTRACTOR SHALL PREF OR APPROVAL SHOP DRA ALCULATIONS, SIGNED A EW YORK STATE LICENSE LL POND OUTLET STRUC ROTECTION RAILINGS, IN TTH OSHA STANDARDS 29 HE NYC BUILDING CODE A ECTION 33 39 10 - SANITA EWER AND SECTION 05 55 PE RAILING. SEE SHEETS 39 FOR ADDITIONAL INFO	WINGS AND ND SEALED BY A ED ENGINEER FOR TURES AND FALL CONFORMANCE 9 CFR 1910.23, AND ACI 318. SEE RY AND STORM 2 30 - WELDED 5 KSPP-C-780 TO	Α
	3 3 3	28 26 24 22 20 5			В
					С
KENS-C OUTLET STRUCT		RETA	AINING WALL 2 KSPP-C-736		
X 4" STEEL LL AROUND	SERIES				E
VIEW	FOOTING FOOTING FOOTING FOOTING FOOTING FOOTING FOOTING FOOTING FOOTING	G DETAILS NO. 2 07/2023	0 1 2 3 4 5 1"=5' GRAPHIC SCALES CHECK BEFORE USE IF SHEET IS LESS THAN 22" > IT IS A REDUCED PRINT. SCALE ACCORDINGLY	VERTICAL DATUM CONVERSION (ft) +1.28 BWS { 34"	F
CTION FRUCTION FLOOR		RACT KENS-E O SITE PREPA CIVIL DRAINAGE - PROFILE A	RATION	DATE: APRIL 2023 SCALE: AS NOTED SHEET NO: DRAWING NO. KSPP-C-731.01	

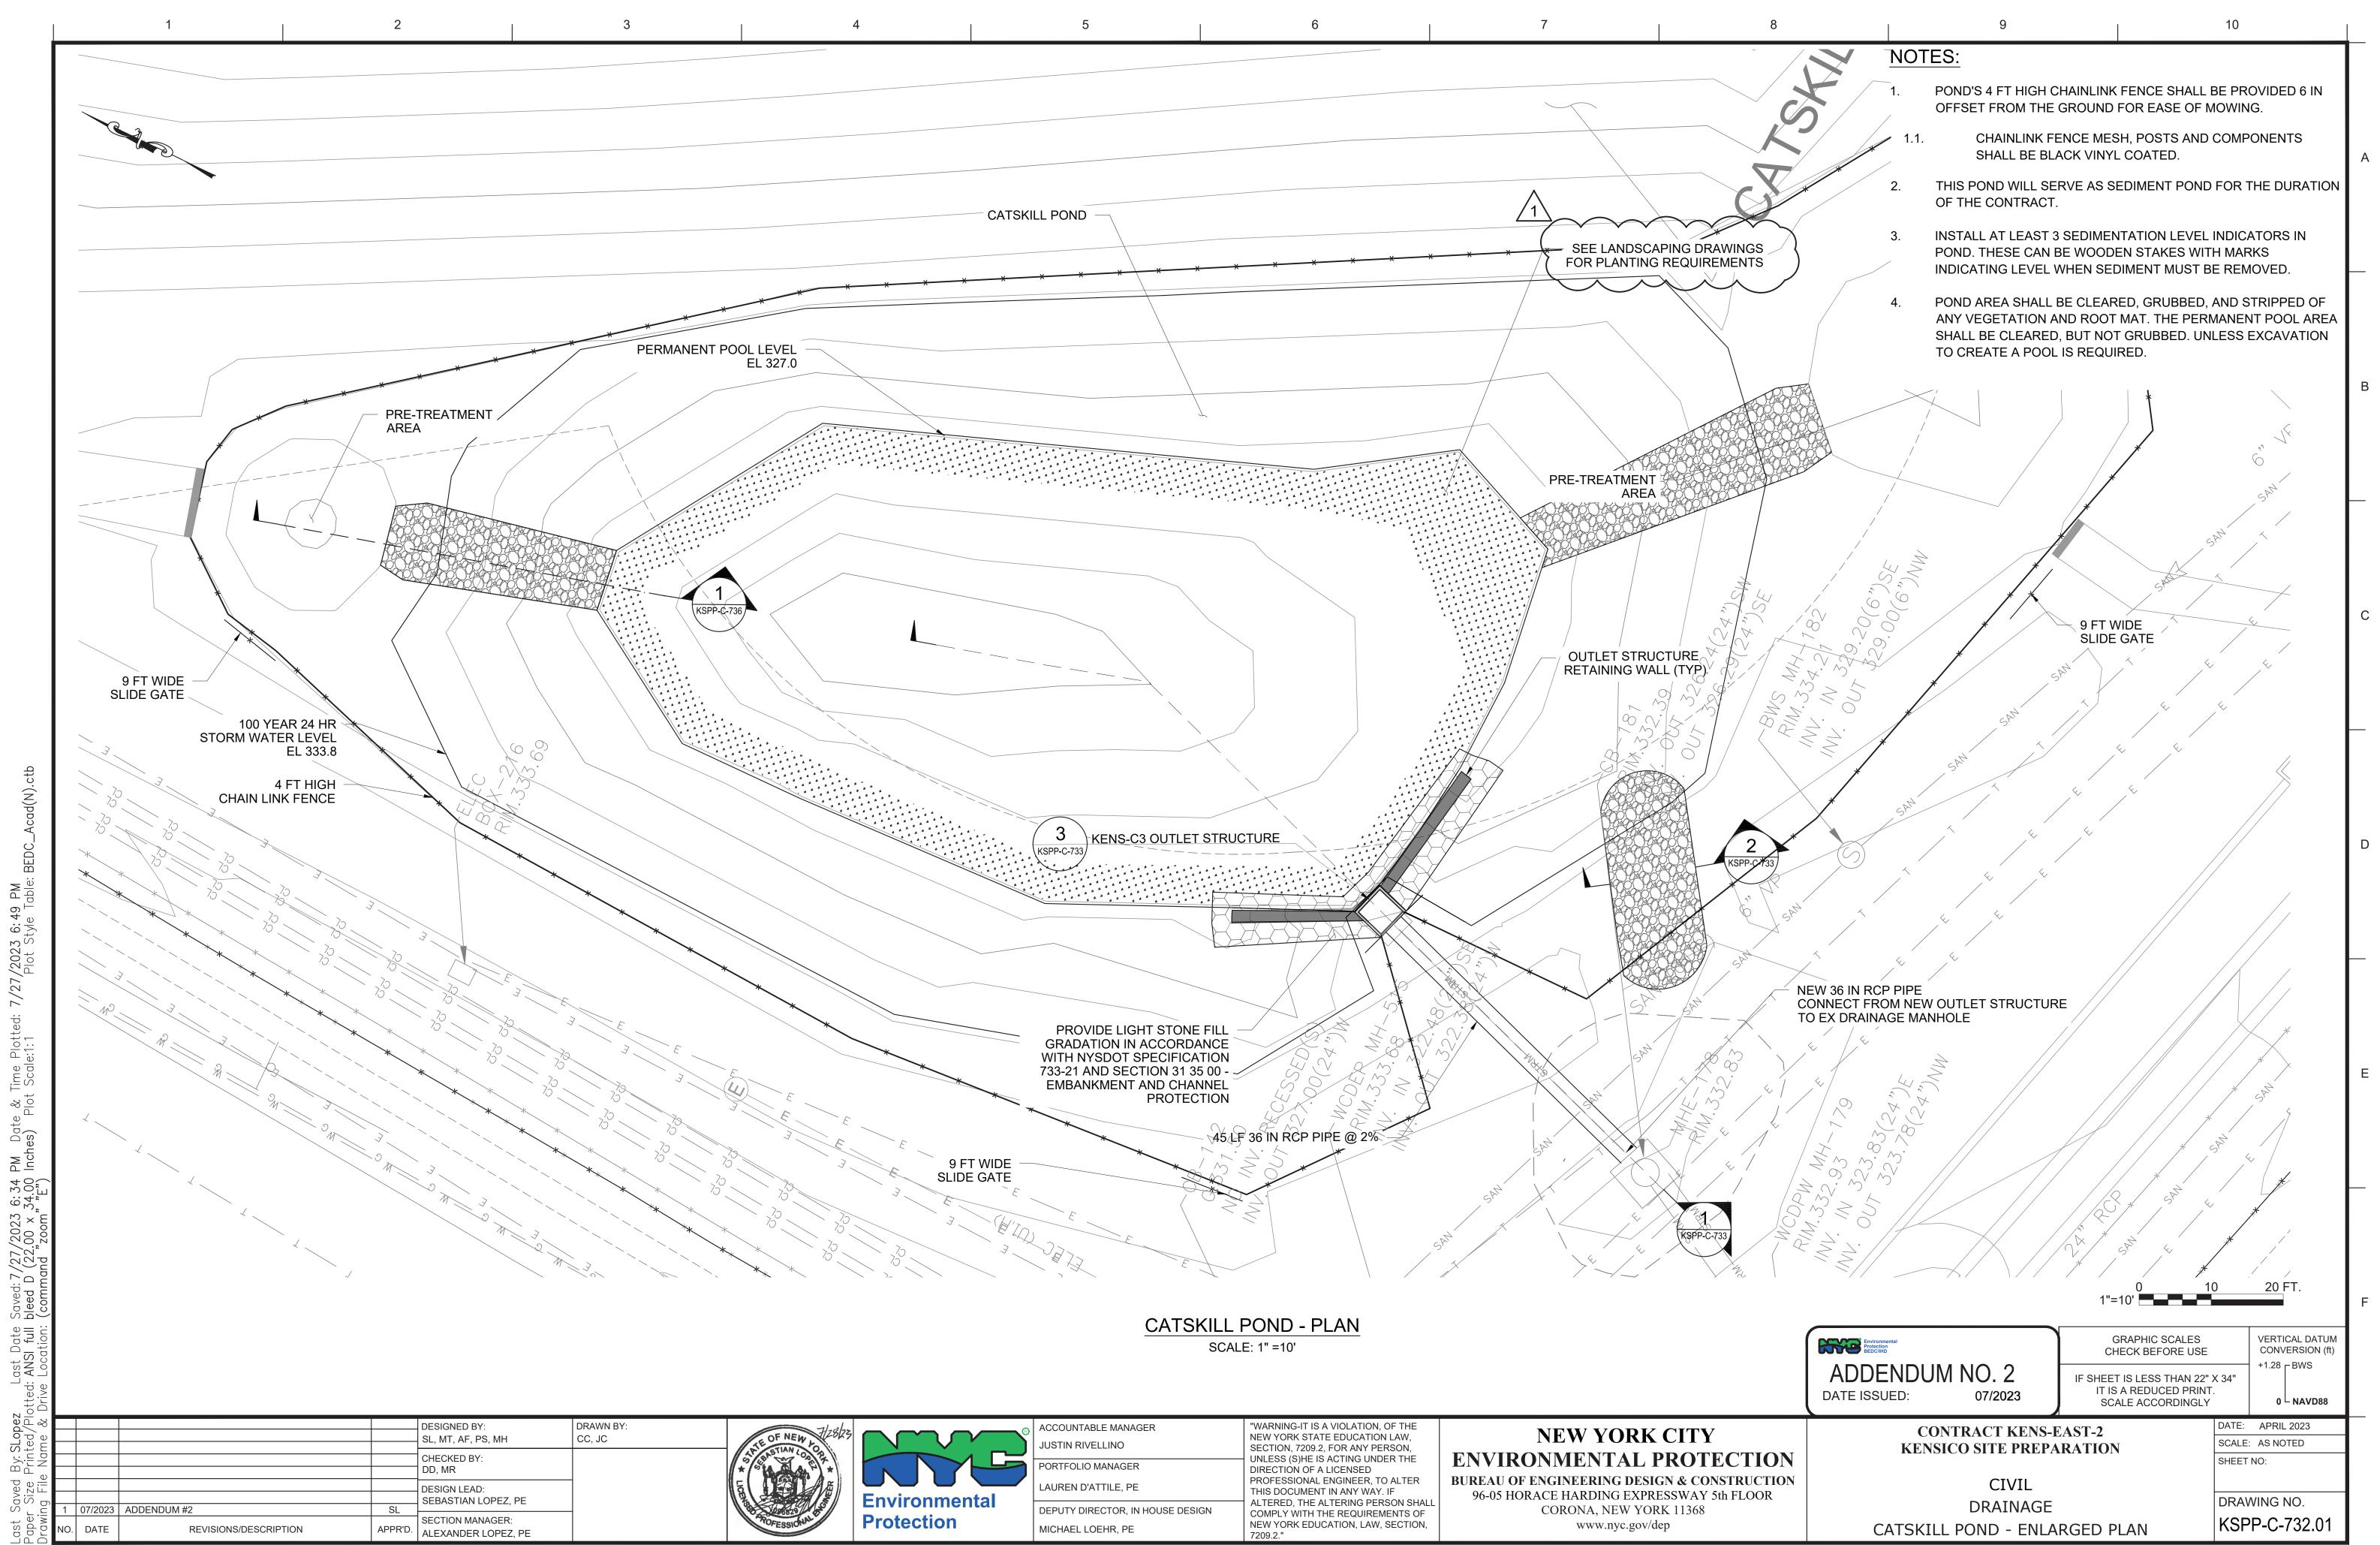


ACCOUNTABLE MANAGER
JUSTIN RIVELLINO
PORTFOLIO MANAGER
LAUREN D'ATTILE, PE
DEPUTY DIRECTOR, IN HOUSE DESIGN

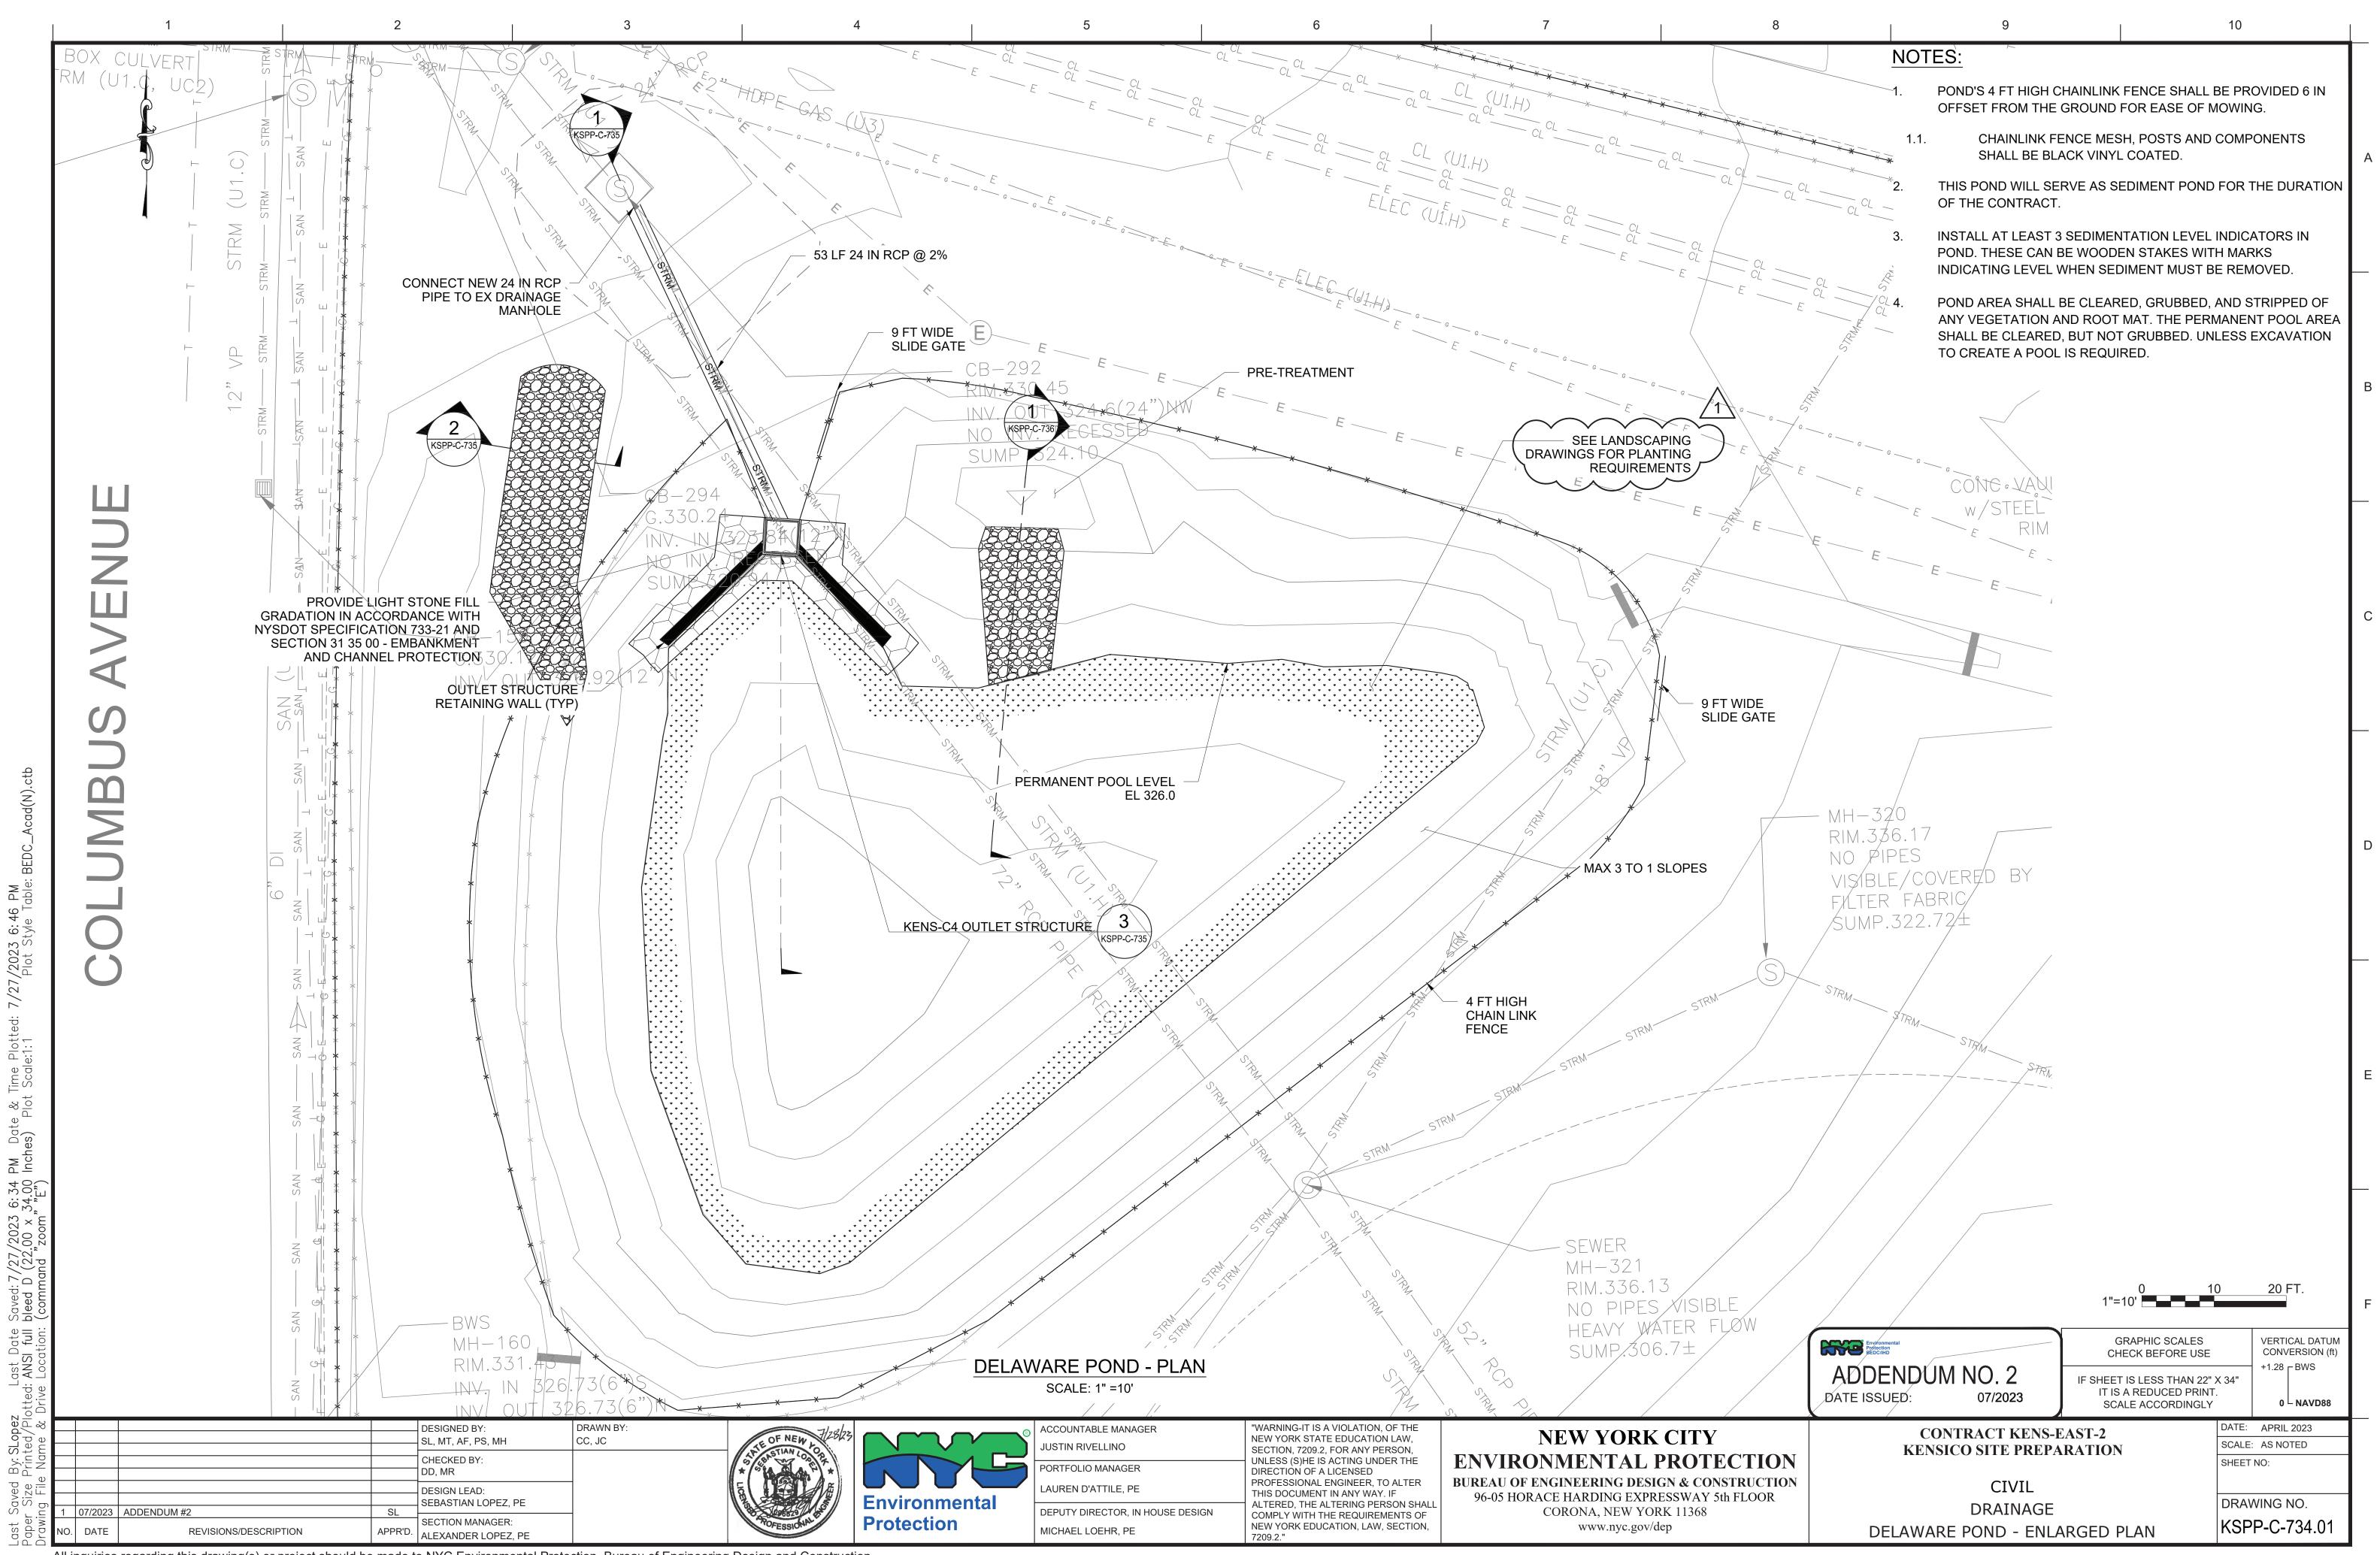

ed:

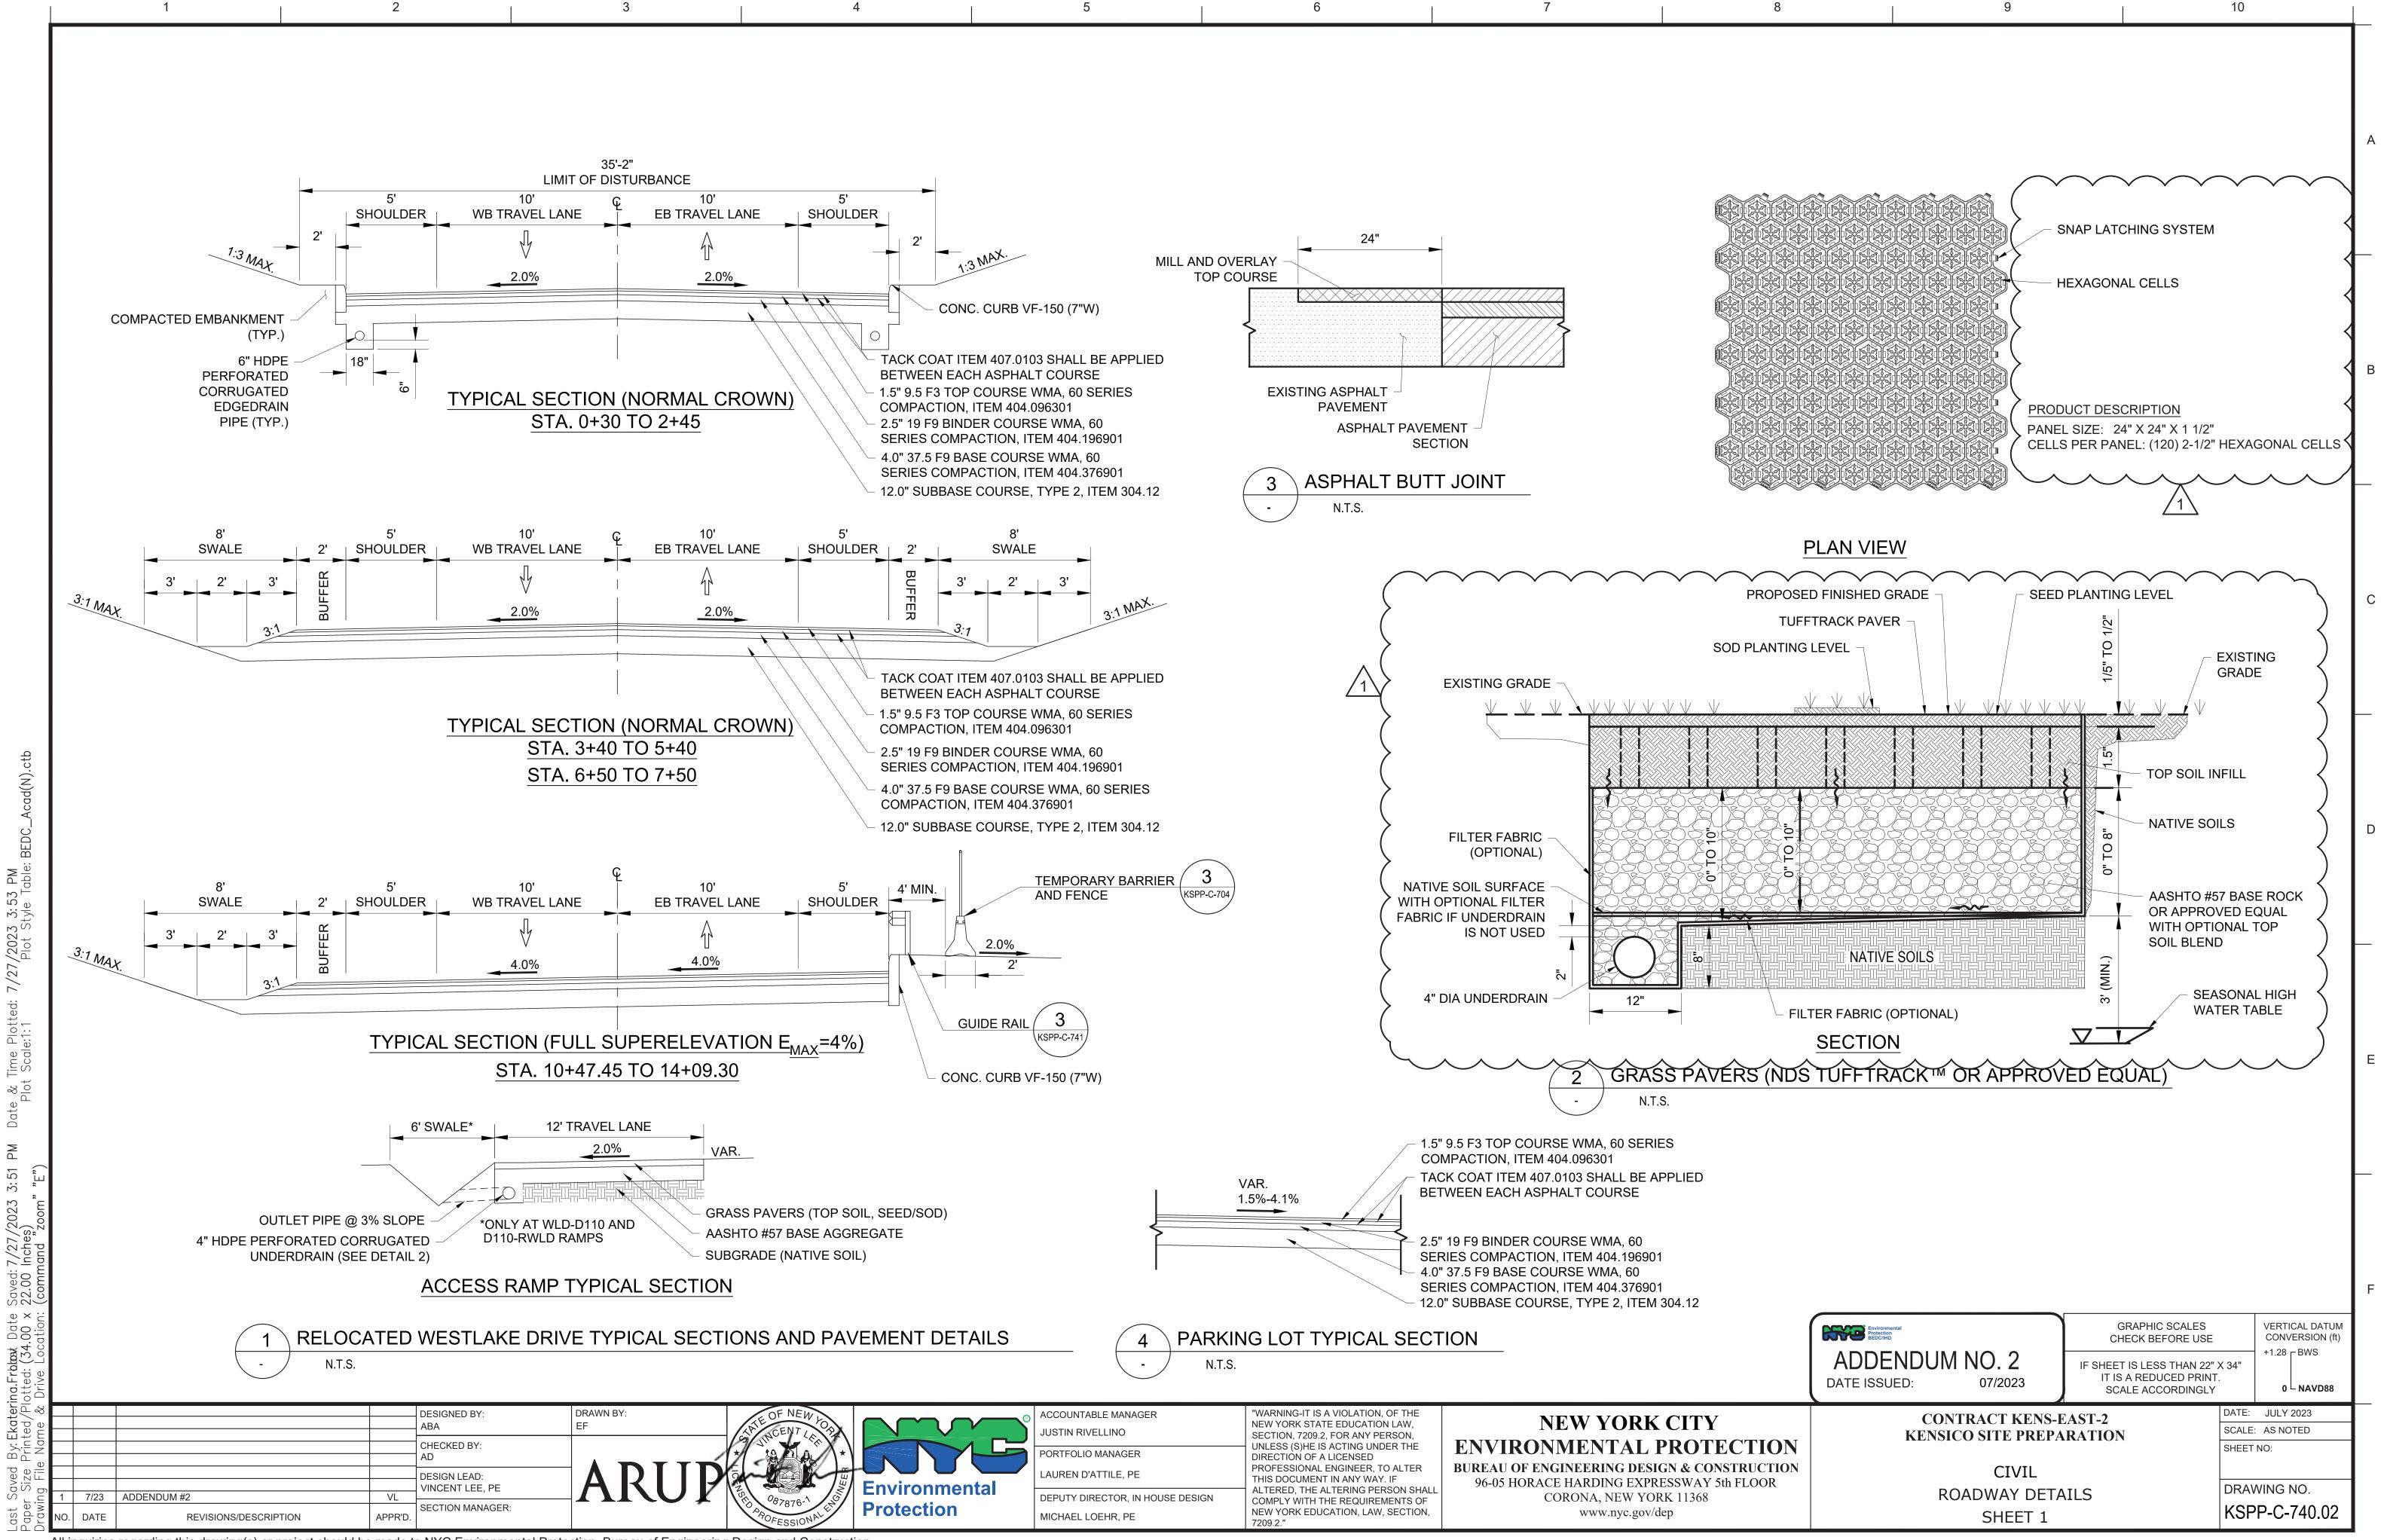

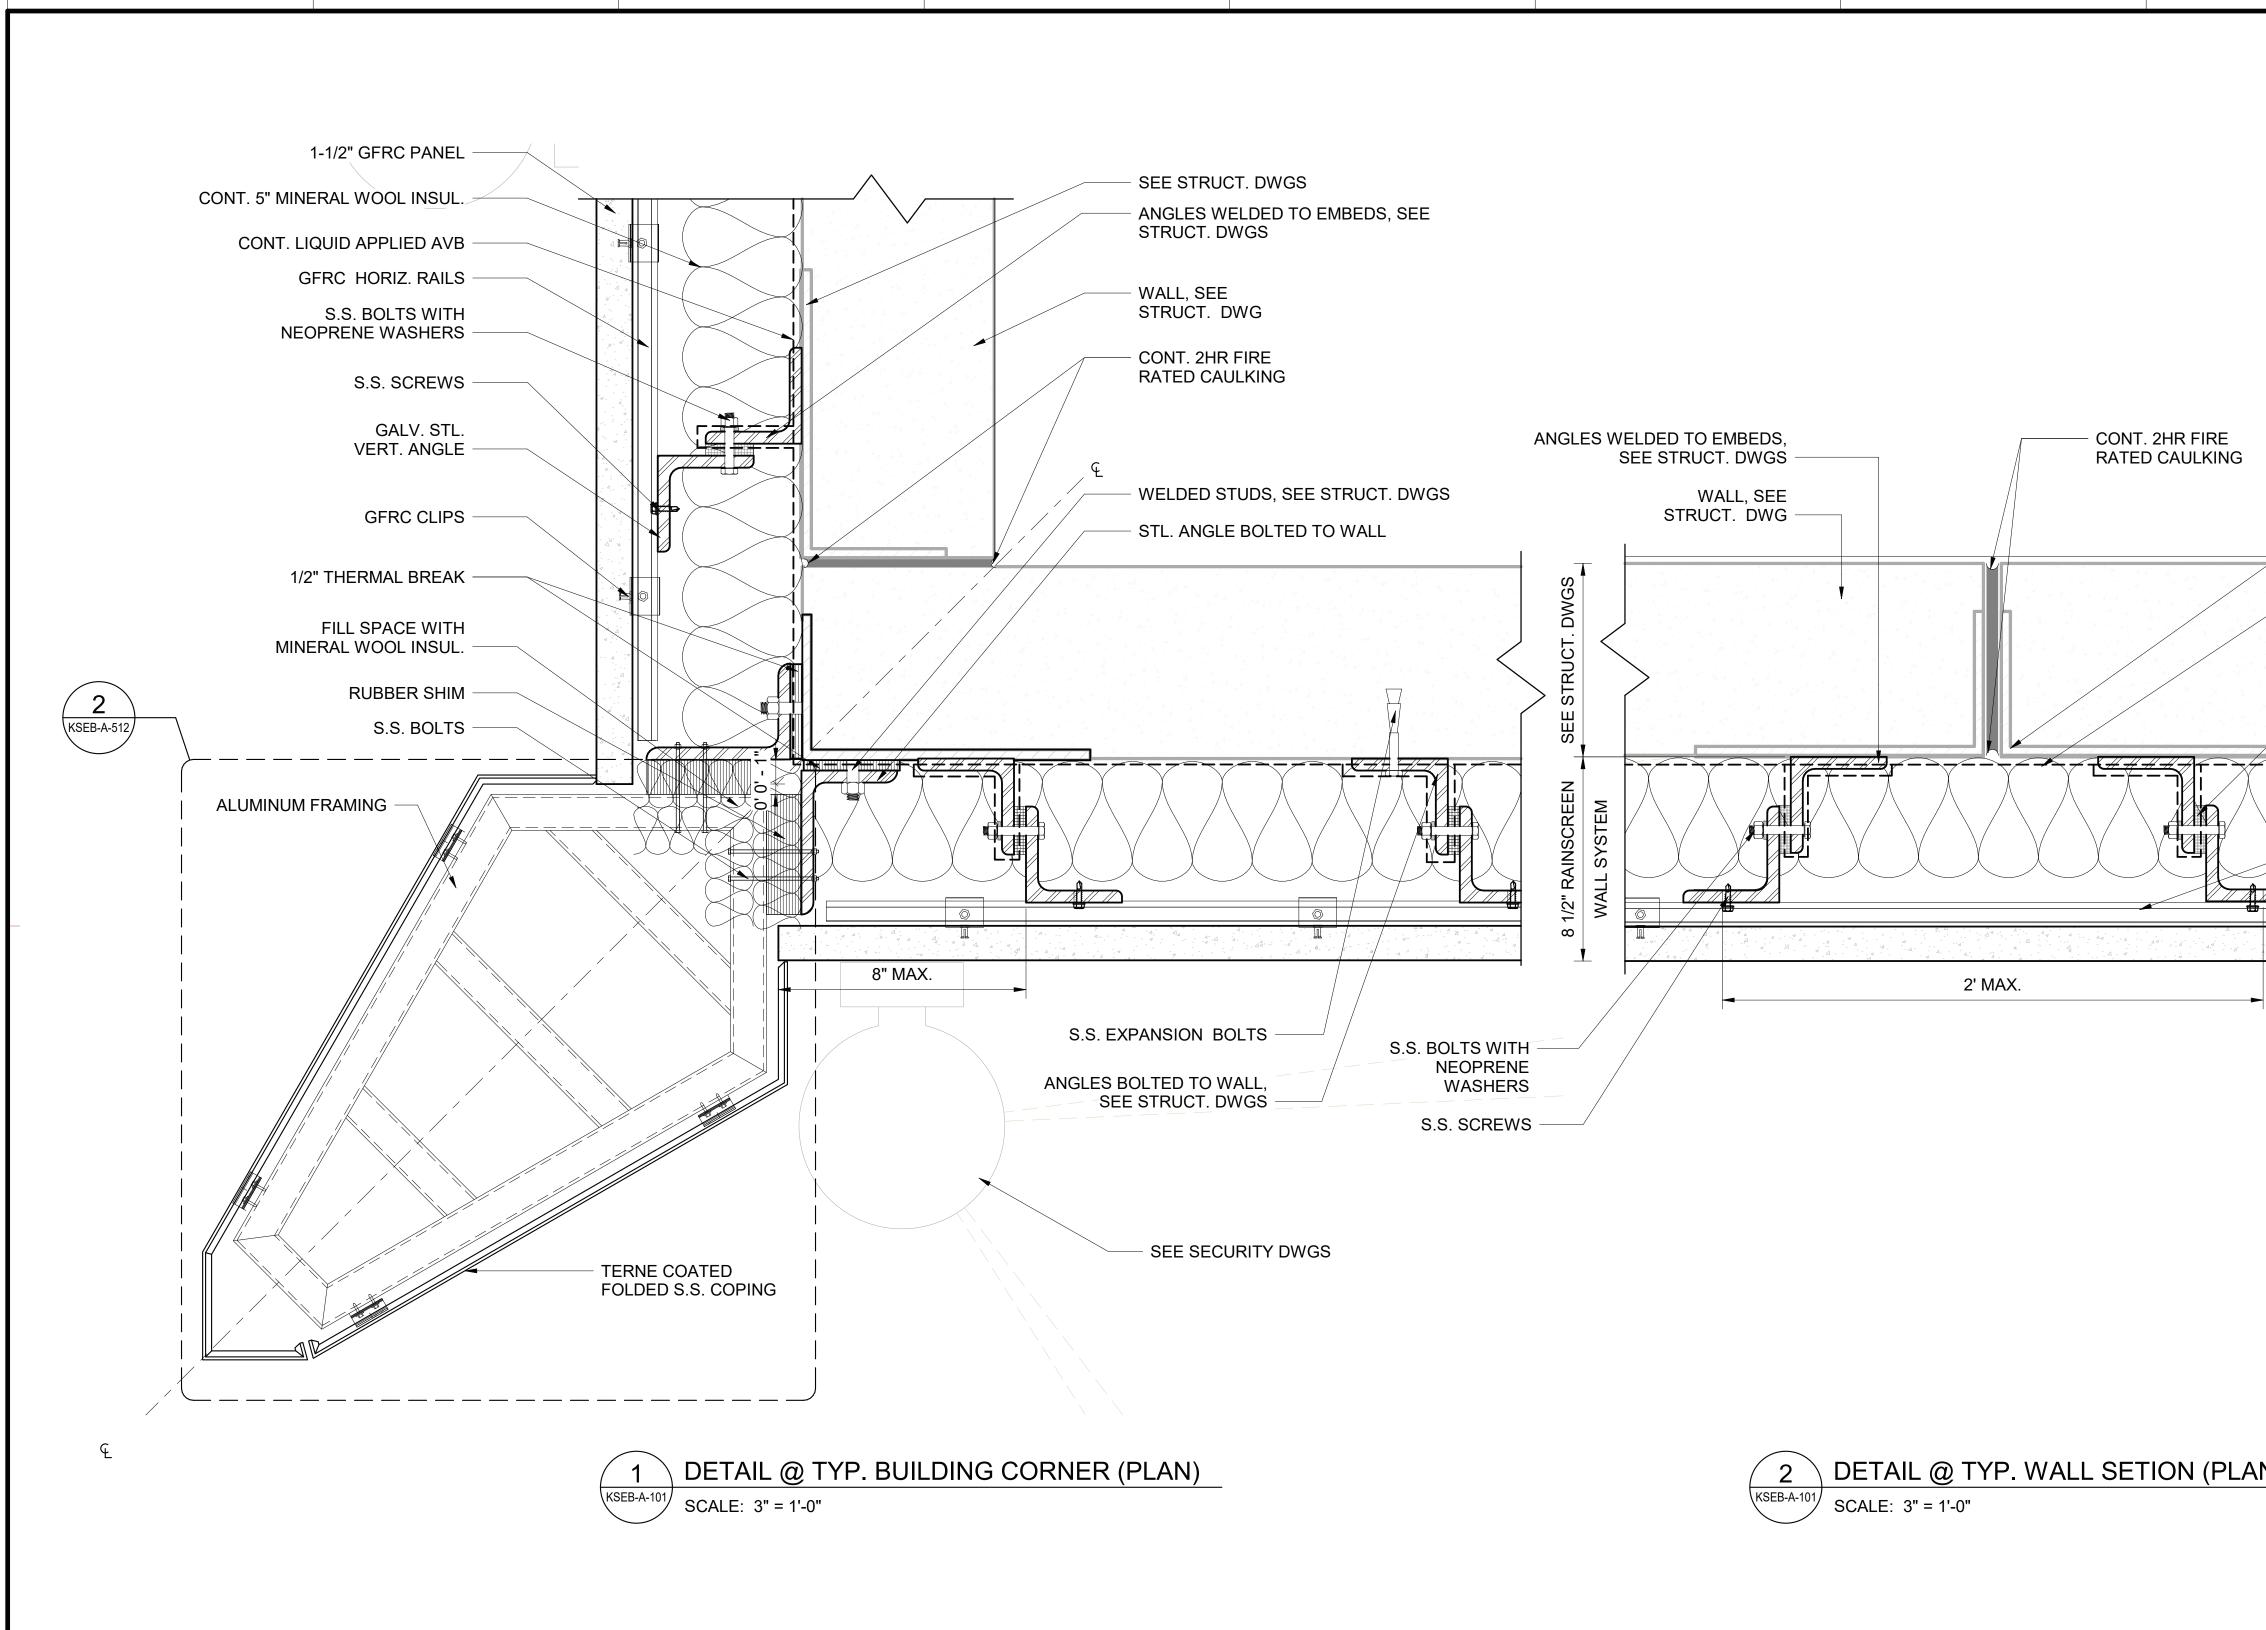

				DESIGNED BY:	DRAWN BY:	REDARO
				R.C. & H.F.	HOWARD FRIEDMAN	STE DENIS CHIA
				CHECKED BY:		G St and the C
				ROBERT CUEVAS, R.A.		ES BOR NI
				DESIGN LEAD:		
1	07/23	ADDENDUM NO.2	RC	HOWARD FREIDMAN	-	Contract 10
NO.	DATE	REVISIONS/DESCRIPTION	APPR'D.	SECTION MANAGER: ROBERT CUEVAS, R.A.		F OF NEW

1

All inquiries regarding this drawing(s) or project should be made to NYC Environmental Protection, Bureau of Engineering Design and Construction.




ACCOUNTABLE MANAGER JUSTIN RIVELLINO ORTFOLIO MANAGER LAUREN D'ATTILE, PE DEPUTY DIRECTOR, IN HOUSE DESIGN MICHAEL LOEHR, PE

"WARNING-IT IS A VIOLATION, OF THE NEW YORK STATE EDUCATION LAW, SECTION, 7209.2, FOR ANY PERSON, UNLESS (S)HE IS ACTING UNDER THE DIRECTION OF A LICENSED PROFESSIONAL ENGINEER, TO ALTER THIS DOCUMENT IN ANY WAY. IF ALTERED, THE ALTERING PERSON SHALL COMPLY WITH THE REQUIREMENTS OF NEW YORK EDUCATION, LAW, SECTION, 7209.2."

NEW YORK CITY ENVIRONMENTAL PROTI BUREAU OF ENGINEERING DESIGN & CON 96-05 HORACE HARDING EXPRESSWAY CORONA, NEW YORK 11368 www.nyc.gov/dep

8		9		10	
	NOT 1.	ES: FOR ALL GFRC SUP	PORT STEEL. THE C	CONTRACTOR SHA	LL
	2.	REFER TO STRUCT	DWGS.		
		REFER TO STRUCT	DWGS.		A
\bigwedge	3.	THE CONTRACTOR METALS ARE USED	`~~~~~~~~~~~~~~~~~~~~~~~~~~~~~~~~~~~~		\sim
<u>Z_1</u>	4.	THE CONTRACTOR AROUND THE ANGL STRUCTURE.			
	5.	THE CONTRACTOR AVB PENETRATION BOLT/SCREWS AND COMPLETELY FROM	S, INCLUDING AROL THERMAL BREAKS	JND ALL	
		- SEE STRUCT. DWGS			В
		- CONT. LIQUID APPLIED AVB			
		– 1/2" THERMAL BRE	AK		
		- CONT. 5" MINERAL WOOL INSUL.			
		- GFRC HORIZ. RAIL	S		С
\neg	\	- GFRC CLIPS			
	\	 GALV. STL. VERT. ANGLE 			D
	\	- 1-1/2" GFRC PANEL			
					E
N)					
····/					
			Ο	3 6	9 IN.
			3"=1'-0"		F
	ironmental tection DC/IHD		GRAPHIC SCA CHECK BEFOR		
ADDE DATE ISS		M NO. 2 07/2023	IF SHEET IS LESS TH IT IS A REDUCED SCALE ACCORD) PRINT. DINGLY	
				DATE: AUGUST 2	2023

ECTION	CONTRACT KENS-EAST-2 KENSICO SITE PREPARATION	DATE: AUGUST 2023 SCALE: AS NOTED SHEET NO:
NSTRUCTION 5th FLOOR	ARCHITECTURAL ELECTRICAL BUILDING TYP. WALL (PLAN) DETAILS	DRAWING NO. KSEB-A-500.01

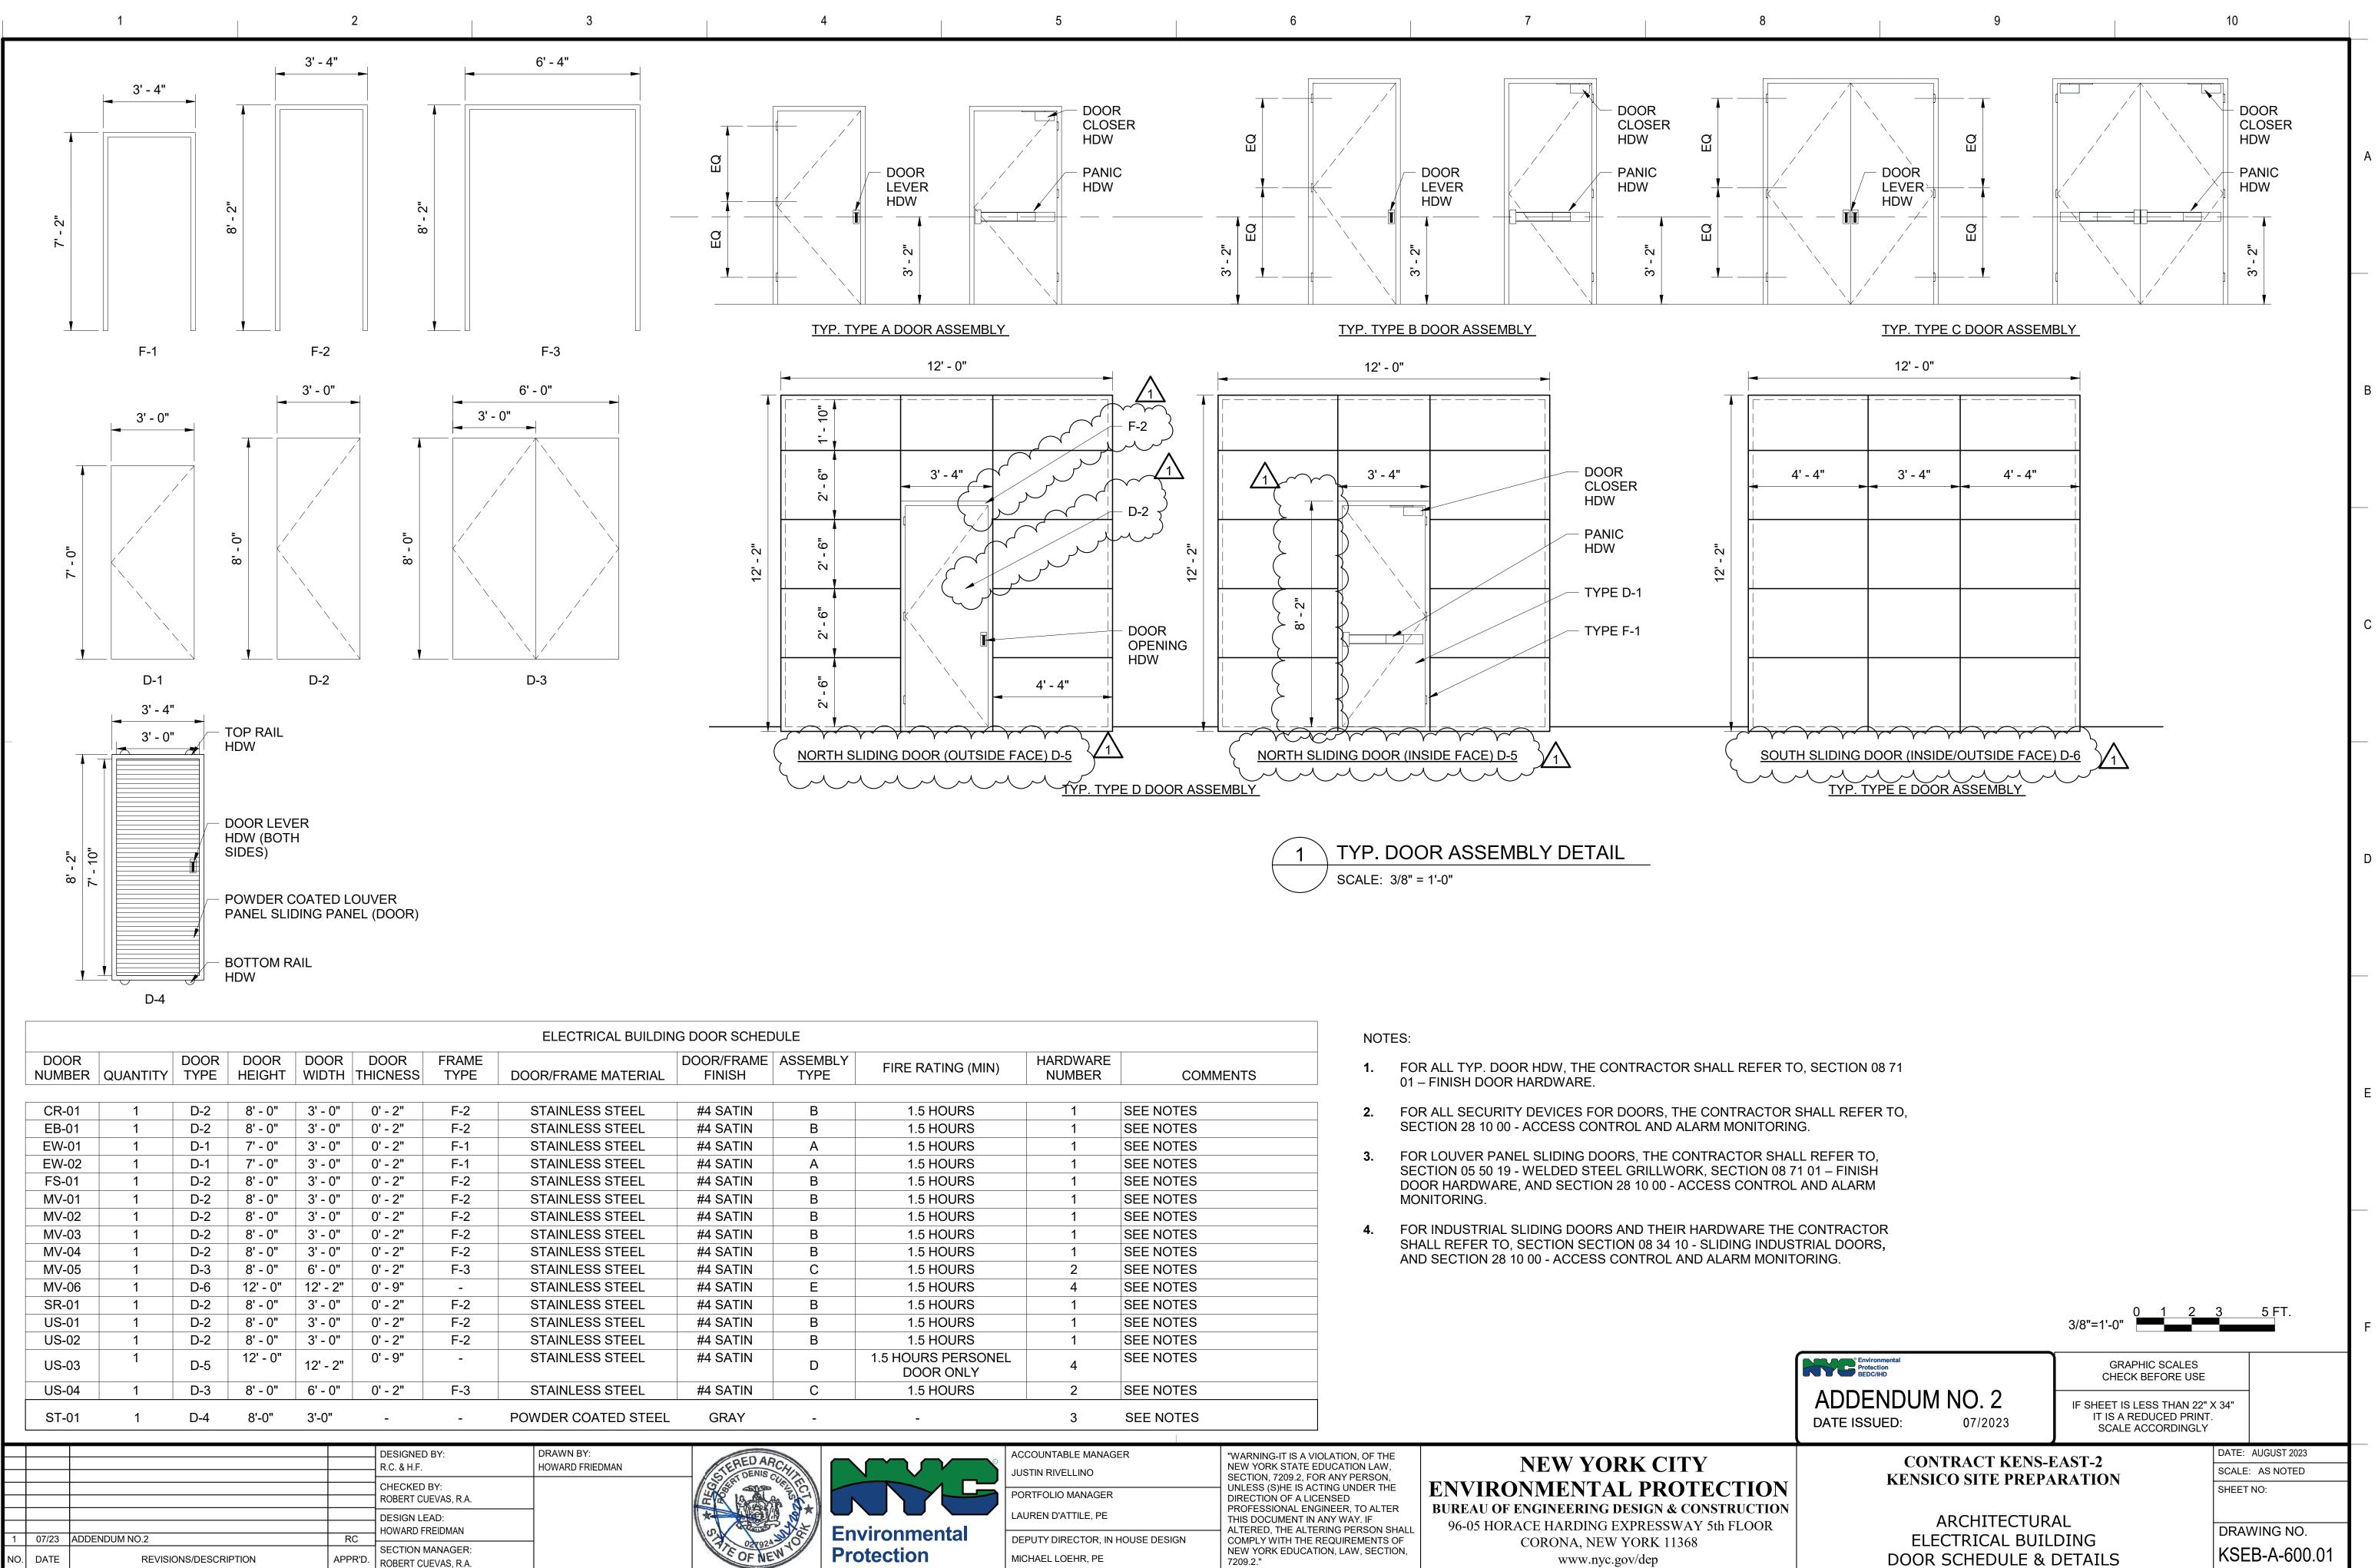

DOOR NUMBER	QUANTITY	DOOR TYPE	DOOR HEIGHT	DOOR WIDTH	DOOR THICNESS	FRAME TYPE	DOOR/FRAME MATERIAL	DOOR/FRAME FINISH	ASSEMBLY TYPE	FIRE RATING (MIN)	HARDWARE NUMBER	COMMENTS
CR-01	1	D-2	8' - 0"	3' - 0"	0' - 2"	F-2	STAINLESS STEEL	#4 SATIN	В	1.5 HOURS	1	SEE NOTES
EB-01	1	D-2	8' - 0"	3' - 0"	0' - 2"	F-2	STAINLESS STEEL	#4 SATIN	B	1.5 HOURS	1	SEE NOTES
EW-01	1	D-1	7' - 0"	3' - 0"	0' - 2"	F-1	STAINLESS STEEL	#4 SATIN	A	1.5 HOURS	1	SEE NOTES
EW-02	1	D-1	7' - 0"	3' - 0"	0' - 2"	F-1	STAINLESS STEEL	#4 SATIN	Α	1.5 HOURS	1	SEE NOTES
FS-01	1	D-2	8' - 0"	3' - 0"	0' - 2"	F-2	STAINLESS STEEL	#4 SATIN	В	1.5 HOURS	1	SEE NOTES
MV-01	1	D-2	8' - 0"	3' - 0"	0' - 2"	F-2	STAINLESS STEEL	#4 SATIN	В	1.5 HOURS	1	SEE NOTES
MV-02	1	D-2	8' - 0"	3' - 0"	0' - 2"	F-2	STAINLESS STEEL	#4 SATIN	В	1.5 HOURS	1	SEE NOTES
MV-03	1	D-2	8' - 0"	3' - 0"	0' - 2"	F-2	STAINLESS STEEL	#4 SATIN	В	1.5 HOURS	1	SEE NOTES
MV-04	1	D-2	8' - 0"	3' - 0"	0' - 2"	F-2	STAINLESS STEEL	#4 SATIN	В	1.5 HOURS	1	SEE NOTES
MV-05	1	D-3	8' - 0"	6' - 0"	0' - 2"	F-3	STAINLESS STEEL	#4 SATIN	С	1.5 HOURS	2	SEE NOTES
MV-06	1	D-6	12' - 0"	12' - 2"	0' - 9"	-	STAINLESS STEEL	#4 SATIN	E	1.5 HOURS	4	SEE NOTES
SR-01	1	D-2	8' - 0"	3' - 0"	0' - 2"	F-2	STAINLESS STEEL	#4 SATIN	В	1.5 HOURS	1	SEE NOTES
US-01	1	D-2	8' - 0"	3' - 0"	0' - 2"	F-2	STAINLESS STEEL	#4 SATIN	В	1.5 HOURS	1	SEE NOTES
US-02	1	D-2	8' - 0"	3' - 0"	0' - 2"	F-2	STAINLESS STEEL	#4 SATIN	В	1.5 HOURS	1	SEE NOTES
US-03	1	D-5	12' - 0"	12' - 2"	0' - 9"	-	STAINLESS STEEL	#4 SATIN	D	1.5 HOURS PERSONEL DOOR ONLY	4	SEE NOTES
US-04	1	D-3	8' - 0"	6' - 0"	0' - 2"	F-3	STAINLESS STEEL	#4 SATIN	С	1.5 HOURS	2	SEE NOTES
ST-01	1	D-4	8'-0"	3'-0"	-	-	POWDER COATED STEEL	GRAY	-	-	3	SEE NOTES

AR :45:30 ö 3 5

₽

APPR'D. ROBERT CUEVAS, R.A. NO. DATE **REVISIONS/DESCRIPTION**

All inquiries regarding this drawing(s) or project should be made to NYC Environmental Protection, Bureau of Engineering Design and Construction.



MICHAEL LOEHR, PE

7209.2."

www.nyc.gov/dep

1

WINDOW AND							
	GLAZING TREATMENT	MATERIAL FINISH	FRAME MATERIAL	Width	Height	QUANTITY	ITEM NUMBER
CONTRACTOR SHALL	-	#4 SATIN	STAINLESS STEEL	1' - 4"	1' - 4"	1	L-1
CONTRACTOR SHALL	-	#4 SATIN	STAINLESS STEEL	1' - 8"	1' - 8"	1	L-2
CONTRACTOR SHALL	UV PROTECTION, BIRD PROTECTION	#4 SATIN	STAINLESS STEEL	6' - 4"	4' - 0"	16	W-1


NAME	CEILING FINISH	FLOOR FINISH	
FIRE SUPPRESSION ROOM	PRIMED AND PAINTED WITH WHITE PAINT	NON-SLIP AND ABRASION RESISTANT FLOOR FINISH, IN GREY	CONCRETE WALLS PRIM A 5"X10" LIGHT BLUE GL
COMMUNICATION ROOM	PRIMED AND PAINTED WITH WHITE PAINT AND DROP CEILING	NON-SLIP AND ABRASION RESISTANT FLOOR FINISH, IN GREY	CONCRETE WALLS PRIM A 5"X10" LIGHT BLUE GL
BATTERY ROOM	-	-	-
UNIT SUBSTATION ROOM	PRIMED AND PAINTED WITH WHITE PAINT	NON-SLIP AND ABRASION RESISTANT FLOOR FINISH, IN GREY	CONCRETE WALLS PRIM A 5"X10" LIGHT BLUE GL
MEDIUM VOLTAGE SWITCHGEAR ROOM	PRIMED AND PAINTED WITH WHITE PAINT	NON-SLIP AND ABRASION RESISTANT FLOOR FINISH, IN GREY	CONCRETE WALLS PRIM A 5"X10" LIGHT BLUE GL
SECURITY ROOM	PRIMED AND PAINTED WITH WHITE PAINT AND DROP CEILING	NON-SLIP AND ABRASION RESISTANT FLOOR FINISH, IN GREY	CONCRETE WALLS PRIM A 5"X10" LIGHT BLUE GL
EYEWASH ENCLOSURE	PRIMED AND PAINTED WITH WHITE PAINT	NON-SLIP AND ABRASION RESISTANT FLOOR FINISH, IN GREY	CONCRETE WALLS PRIM A 5"X10" LIGHT BLUE GL
-			
-			
-			




				DEGIONED DV	DRAWN BY:	
				DESIGNED BY: R.C. & H.F.	HOWARD FRIEDMAN	ERED ARCH
				CHECKED BY: ROBERT CUEVAS, R.A.		S SHT DENIS CUT ITC
				DESIGN LEAD:		
1	07/23	ADDENDUM NO.2	RC	HOWARD FREIDMAN		02024
NO.	DATE	REVISIONS/DESCRIPTION	APPR'D.	SECTION MANAGER: ROBERT CUEVAS, R.A.		F OF NEW Y

All inquiries regarding this drawing(s) or project should be made to NYC Environmental Protection, Bureau of Engineering Design and Construction.

4 5	6 7	8
VER SCHEDULE		$\left\{ \right\}$
COMMENTS		$\left\{ \right\}$
TALL ALL LOUVERS AS PER CONTRACT DOCUMENTS UNLESS OTHERW	SE INDICATED BY THE MANUFACTURE	$\left\{ \right.$
FALL ALL LOUVERS AS PER CONTRACT DOCUMENTS UNLESS OTHERW	SE INDICATED BY THE MANUFACTURE	$\overline{\langle}$
TALL ALL WINDOWS AS PER CONTRACT DOCUMENTS UNLESS OTHERW	ISE INDICATED BY THE MANUFACTURE	$\frac{\sqrt{1}}{\sqrt{1}}$
	MMMMM	
WALL FINISH		COMMENTS
MED AND PAINTED WITH WHITE PAINT, TILE OVER CMU BLOCKS WITH LAZED CERAMIC TILE	SEE SPECIFICATIONS: 09 91 00 - Painting, 09 30 13 Finishing	3 - Ceramic Tiling, and 03 35 16 - Heavy-Duty Concrete Floor
MED AND PAINTED WITH WHITE PAINT, TILE OVER CMU BLOCKS WITH LAZED CERAMIC TILE	SEE SPECIFICATIONS: 09 91 00 - Painting, 09 30 13 03 35 16 - Heavy-Duty Concrete Floor Finishing	3 - Ceramic Tiling, 09 51 01- Suspended Acousatical Ceiling, and
MED AND PAINTED WITH WHITE PAINT, TILE OVER CMU BLOCKS WITH LAZED CERAMIC TILE	- SEE SPECIFICATIONS: 09 91 00 - Painting, 09 30 13 Finishing	3 - Ceramic Tiling, 03 35 16 - Heavy-Duty Concrete Floor
MED AND PAINTED WITH WHITE PAINT, TILE OVER CMU BLOCKS WITH LAZED CERAMIC TILE	SEE SPECIFICATIONS: 09 91 00 - Painting, 09 30 13 Finishing	3 - Ceramic Tiling ,and 03 35 16 - Heavy-Duty Concrete Floor
MED AND PAINTED WITH WHITE PAINT, TILE OVER CMU BLOCKS WITH LAZED CERAMIC TILE	SEE SPECIFICATIONS: 09 91 00 - Painting, 09 30 13 03 35 16 - Heavy-Duty Concrete Floor Finishing	3 - Ceramic Tiling, 09 51 01- Suspended Acousatical Ceiling, and
MED AND PAINTED WITH WHITE PAINT, TILE OVER CMU BLOCKS WITH LAZED CERAMIC TILE	SEE SPECIFICATIONS: 09 91 00 - Painting, 09 30 13 Finishing	3 - Ceramic Tiling ,and 03 35 16 - Heavy-Duty Concrete Floor

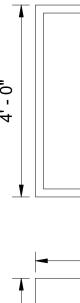

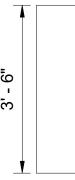


TYPE A WINDOW ASSEMBLY




ACCOUNTABLE MANAGER JUSTIN RIVELLINO PORTFOLIO MANAGER LAUREN D'ATTILE, PE DEPUTY DIRECTOR, IN HOUSE DESIGN MICHAEL LOEHR, PE

"WARNING-IT IS A VIOLATION, OF THE NEW YORK STATE EDUCATION LAW, SECTION, 7209.2, FOR ANY PERSON, UNLESS (S)HE IS ACTING UNDER THE DIRECTION OF A LICENSED PROFESSIONAL ENGINEER, TO ALTER THIS DOCUMENT IN ANY WAY. IF ALTERED, THE ALTERING PERSON SHALL COMPLY WITH THE REQUIREMENTS OF NEW YORK EDUCATION, LAW, SECTION, 7209.2."


NEW YORK CITY ENVIRONMENTAL PROTECTION BUREAU OF ENGINEERING DESIGN & CONSTRUCTION 96-05 HORACE HARDING EXPRESSWAY 5th FLOOR CORONA, NEW YORK 11368 www.nyc.gov/dep

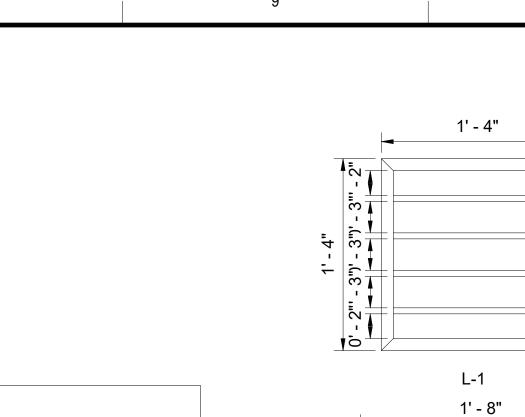

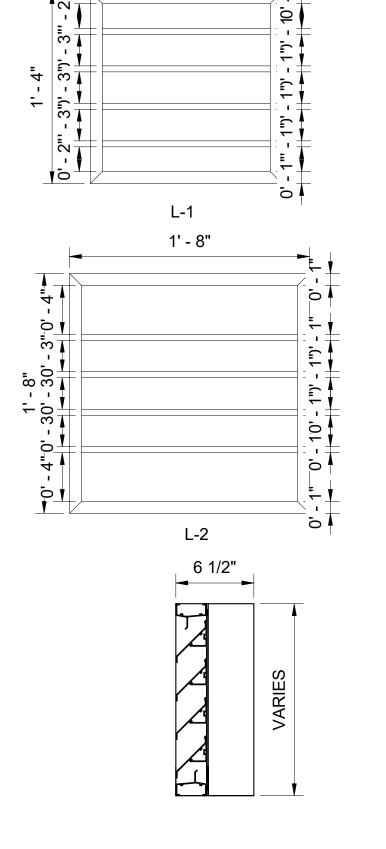


LOUVER SCHEDULE DETAILS SCALE: N.T.S.

5 16 - Heavy-Duty Concrete Floor 6' - 4"

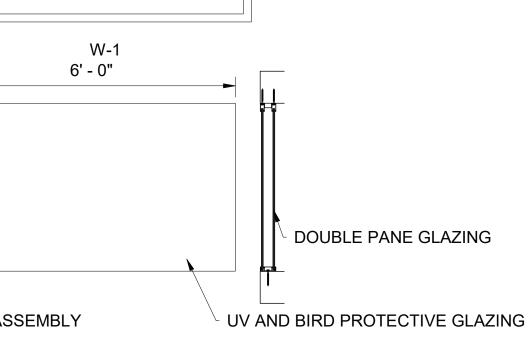

WINDOW SCHEDULE DETAILS

SCALE: N.T.S.

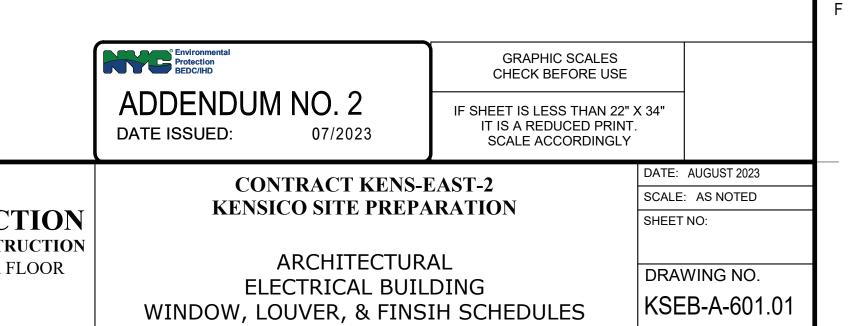

10

Α

В

С

D

Е

	1	2		3			4
				ST	RUCTUR	E SPECIF	FIC FC
SE 1. 2. 3.	CODES AND STANDARDS SUMMA GENERAL NOTES STRUCTURAL NOTES		[.		STRIP FOUND SOIL APPROV SUITABLE SC BE IMMEDIAT RECOMMEND ALLOWABLE ENGINEERIN	DATION, FOO /ED BY THE (DIL IS NOT FO ELY NOTIFIE DATIONS FOF BEARING CA	DTINGS, A GEO-TEO DUND AT ED, AND R IMPRO APACITY.
4. 5. 7. 8. 9. 10.	CONTRACTOR'S SHOP DRAWING GENERAL NOTES FOR CONCRET NOTES FOR STRUCTURAL NON-S NOTES FOR ANCHORING TO HAR GENERAL NOTES FOR STUD CON GENERAL NOTES FOR NON-STRU ABBREVIATIONS AND SYMBOLS	E HRINK GROUT DENED CONCRETE		2.	STRIP FOUNE SHALL BEAR PER PROJEC EXCAVATE A FOUNDATION COMPACTED	DATIONS. DATION FOR ON SOIL WIT T GEO-TECH MINIMUM DE I TO REMOVE	THE ELE TH A MIN INICAL E EPTH OF E UNSUI
	<u>RUCTURE SPECIFIC AI ANDARDS SUMMARY:</u>	DDITIONAL CODES AND	-	3.	MAT FOUNDA ON THESE DE CAPACITY OF EXCAVATED	RAWINGS SH ⁻ 0.75 TSF. S	HALL BEA
1.	BUILDING CODE REQUIREMENTS STRUCTURES, TMS 402/602-16, TH	AND SPECIFICATION FOR MASONR HE MASONRY SOCIETY.	Y	4.	BACKFILL SH UNLESS SUP ARE ADEQUA	PORTING SL	ABS ANI
2.	PCI DESIGN HANDBOOK, 8TH EDI CONCRETE INSTITUTE.	TION, PCI MNL-120-17, PRECAST/PR	ESTRESSED	_	SHALL NOT E 03 30 00 - CAS	ST-IN-PLACE	CONCR
3. 4.	PRECAST CONCRETE PRODUCTS CONCRETE INSTITUTE.	ARDS AND GUIDELINES FOR THE E 5, PCI MNL-127-99, PRECAST/PREST S OF CONNECTIONS FOR PRECAS	RESSED	5.	DEWATERING OF THE CON TO UNDERMI CALCULATIO OF THE CON	TRACTOR. P NE EXISTING NS FOR THE	PRECAUT G FOUND
	PRESTRESSED CONCRETE, PCI N INSTITUTE.	/INL-123-88, PRECAST/PRESTRESSE	D CONCRETE	6.	PROVIDE DO AND PIERS O REINFORCEM	F THE SAME	E NUMBE
5.	INSTITUTE, ACI 533R-11.	WALL PANELS, AMERICAN CONCR		7.	PROVIDE WA	TERSTOPS I	ÍN ALL VI
6.	CONCRETE INSTITUTE, ACI 550.2-			8.	ALL SOIL ANE A GEOTECHN	O ROCK BEAF	RING SU
7.	CONCRETE INSTITUTE, ACI 550R-			9.	DO NOT POU	R CONCRET	E ON FR
8. 9.		O. RDDM2. STEEL DECK INSTITUTE NO. SPD2. STEEL DECK INSTITUTE			COMPACTED D <u>15</u> 57):		CENT MO
		O. DDM04. STEEL DECK INSTITUTE		Ľ Á		CKNESS OF	SELECT FORMATI
11.	ASCE 32-01	FROST-PROTECTED SHALLOW FO	JINDATIONS,	10.	THE FOLLOW NON-FROST A. EXTERIC B. EXTERIC C. SPIRAL S D. EYE WAS E. KENSICC SEE SECTION	SUSCEPTIBL OR PADS FOR OR PADS FOR STAIR MAT FO SH ENCLOSU O SITE ELECT	E STRUG R DOMES R THE EL OUNDAT JRE MAT TRICAL H
				11.	THE FOLLOW SUSCEPTIBLI A. EXTERIC B. EXTERIC C. EXTERIC ENCLOS SEE SECTION	E STRUCTUR PR PADS FOR PR PADS FOR PR PADS FOR URE, SEE DE	RAL FILL R TERMII R ELECT R THE EX ETAILS F
				12.	UNLESS OTH SLABS ON GF DETAILS.		
				13.	STRIP FOUND SHOWN ON T REPORT. AC CONDITIONS FOR ADDITIO	HE DRAWIN TUAL BEARII REFER TO	GS HÁVE NG ELEV THE PRO
				14.	FLOWABLE F WEIGHT (MAX ADDITIONAL	K. 115 PCF), \	WITH MII

				DESIGNED BY: CC, AM	DRAWN BY: CC, AM, XX	OF NEW YORK
				CHECKED BY: CC, PMB, LERA		5 3 4 1 0 7 2012
				DESIGN LEAD: CLEMENT CHAN, PE		* E
1	07/23	ADDENDUM #2	CC			Cr. len as -
NO.	DATE	REVISIONS/DESCRIPTION	APPR'D.	SECTION MANAGER: ALEXANDER LOPEZ, PE		OFO PROFESSION

4 5	6 7 8	
C FOUNDATION NOTES:	STRUCTURE SPECIFIC RAILING NOTES:	STRUCTURE S
NGS, AND MAT FOUNDATIONS SHALL BEAR ON SUITABLE CO-TECHNICAL ENGINEER, AS NOTED BELOW.) WHERE ND AT THE SPECIFIED ELEVATION, THE ENGINEER SHALL	 ALL RAILING POSTS, RAILS, AND THEIR CONNECTIONS FOR STAIRS, ELEVATED PLATFORMS, AND THE ROOF SHALL BE STAINLESS STEEL, U.O.N. SEE GENERAL NOTES FOR STRUCTURAL STEEL FOR STAINLESS STEEL GRADES. 	1. ALL STRUCTURAL
AND THE GEO-TECHNICAL ENGINEER IS TO PROVIDE MPROVING AREAS THAT DO NOT MEET THE MINIMUM ACITY. REFER TO THE PROJECT GEO-TECHNICAL & ADDITIONAL INFORMATION, REQUIREMENTS, AND	 ALL PIPES FOR RAILS AND POSTS AS INDICATED ON THE DRAWINGS SHALL BE SCHEDULE 80 (X-STRONG), U.O.N. SEE DRAWINGS FOR CONFIGURATION AND DIAMETERS. 	WITH THE STEEL RECOMMENDED F
E ELECTRICAL BUILDING SHOWN ON THESE DRAWINGS A MINIMUM ALLOWABLE BEARING CAPACITY OF 3 TSF. CAL ENGINEERING REPORT, THE CONTRACTOR SHALL TH OF 4 FT BELOW BOTTOM OF PROPOSED STRIP JNSUITABLE SOFT SILTY LAYERS AND REPLACE WITH	 ALL RAILING POSTS FOR STAIRS, ELEVATED PLATFORMS, AND THE ROOF SHALL BE CONTINUOUS FROM BOTTOM SUPPORT BRACKET OR SOCKET TO THE TOP RAILING, SPLICING OF RAILING POSTS AT MID-RAILS SHALL NOT BE PERMITTED. CONTRACTOR SHALL DESIGN BRACKET OR SOCKET FOR A BASE REACTION (LRFD) IN BOTH ORTHOGONAL DIRECTIONS OF V=1.0 K, M=1.0 K-FT, AND A C OR T =1.0 K, U.O.N. 	 ALL STRUCTURAL CONSTRUCTION. MINIMUM STRUCT THICKNESS AS IN CAPACITY SHALL INSTITUTE LOAD
E SPIRAL STAIRS AND EYEWASH ENCLOSURE SHOWN L BEAR ON SOIL WITH A MINIMUM ALLOWABLE BEARING L BELOW THE PROPOSED ELEVATION SHALL BE D WITH NON-FROST SUSCEPTIBLE STRUCTURAL FILL.	4. ALL GALVANIZED RAILING POST SOCKETS SHALL BE SIZED SUCH THAT THE INNER DIAMETER OF THE SOCKET SHALL BE 1/8" LARGER THAN THE OUTER DIAMETER OF THE CONNECTING STAINLESS STEEL RAILING POSTS TO ENSURE ADEQUATE GAP FOR THE BITUMINOUS PAINT BETWEEN DISSIMILAR METALS, AND BEARING CONTACT FOR THE TRANSFER OF CONNECTION FORCES.	 ON THE DRAWING 4. STRUCTURAL ROG GALVANIZED G90 5. STRUCTURAL ROG
ACED AGAINST FOUNDATION OR RETAINING WALLS S AND STRUCTURE IS IN PLACE AND SET OR THE WALLS . LEVELS OF BACKFILL AGAINST CONCRETE WALLS E THAN 2'-0" ON EITHER SIDE OF WALLS. SEE SECTION ONCRETE FOR ADDITIONAL INFORMATION.	 5. BITUMINOUS PAINT AS REQUIRED BETWEEN DISSIMILAR METALS SHALL BE COLD- APPLIED ASPHALT EMULSION COMPLYING WITH ASTM D1187. THE CONTRACTOR SHALL ENSURE THAT BITUMINOUS PAINT IS NOT DAMAGED DURING INSTALLATION OF RAILING POSTS. 6. THE CONTRACTOR SHALL BE RESPONSIBLE FOR THE COMPLETE DESIGN, 	THE DRAWINGS S A. PLACED IN TH B. PROVIDE MIN C. PAINT & PRIM D. WELDED THR MEMBERS WI
DURING CONSTRUCTION IS THE SOLE RESPONSIBILITY ECAUTIONS SHALL BE TAKEN BY THE CONTRACTOR NOT OUNDATIONS. METHOD OF DEWATERING AND PPROPRIATE SYSTEM ARE THE SOLE RESPONSIBILITY DATIONS FOR ALL CAST-IN-PLACE WALLS, COLUMNS, UMBER, SIZE, AND SPACING AS THE VERTICAL	6. THE CONTRACTOR SHALL BE RESPONSIBLE FOR THE COMPLETE DESIGN, FURNISHING, AND INSTALLATION OF ALL HARDWARE (I.E. FITTINGS, SPLICES, BRACKETS, SOCKETS, ETC.) AS REQUIRED FOR CONNECTING ALL RAILING POSTS AND RAILS TOGETHER, AND THE RAILING OR POSTS TO THE BASE STRUCTURE. THE DESIGN SHALL TAKE INTO ACCOUNT ALL VERTICAL AND LATERAL LOADS REQUIRED IN THE DESIGN OF ALL CONNECTIONS BETWEEN RAILING POSTS, RAILS, SOCKETS, AND BRACKETS. THE CONTRACTOR SHALL SUBMIT SIGNED AND SEALED SHOP DRAWINGS AND CALCULATIONS BY A LICENSED PROFESSIONAL ENGINEER REGISTERED IN THE STATE OF NEW YORK FOR ALL RAILING CONNECTIONS AS WELL AS RAILING POST CONNECTIONS TO THE BASE STRUCTURE, U.O.N.	ACTUATED DI FASTENERS. E. ALL DECK SIE NO GREATER F. ROOF METAL SELFWEIGHT ON THE LOAD G. SEE ARCHITE WATERPROO
ALL VERTICAL CONSTRUCTION JOINTS IN BELOW GRADE	7. CONTRACTOR SHALL REFER TO ARCHITECTURAL DRAWINGS AND SPECIFICATIONS FOR ALL COATINGS AND FINISHINGS FOR ALL RAILS AND THEIR SUPPORTING POSTS.	H. FIREPROOFIN
I CONTACT WITH LIQUID. NG SURFACES SHALL BE INSPECTED AND APPROVED BY R IMMEDIATELY PRIOR TO THE POURING OF CONCRETE.	 HANDRAILS SHALL BE CONTINUOUS WITHIN THE FULL LENGTH OF EACH STAIR FLIGHT OR RUN. INSIDE HANDRAILS ON SWITCHBACK OR DOGLEG STAIRS SHALL BE CONTINUOUS BETWEEN FLIGHTS OR RUNS, U.O.N. 	SHOWN ON THE D A. PROVIDE MIN B. PAINT & PRIM C. WELDED THR
ON FROZEN GROUND. GRADE SHALL BE PLACED ON SELECT GRANULAR FILL IT MODIFIED PROCTOR MAXIMUM DRY DENSITY (ASTM	9. ALL WELDS SHALL BE GROUND SMOOTH. ALL STEEL EDGES SHALL BE GROUND SMOOTH.	MEMBERS WI O.C. USE ON D. ALL DECK SIE SPACING NO
HE ELECTRICAL BUILDING ELECT FILL SHALL BE 6" THICK. SEE SECTION 31 23 23 - RMATION.	 STAIR HANDRAIL GRIPPING SURFACES SHALL BE CONTINUOUS ALONG THEIR LENGTH AND SHALL NOT BE OBSTRUCTED ALONG THEIR TOPS OR SIDES. THE BOTTOMS OF STAIR HANDRAIL GRIPPING SURFACES SHALL NOT BE OBSTRUCTED FOR MORE THAN 20% OF THEIR LENGTH. 	E. ROOF METAL GRAVITY AND CRITERIAS. F. SEE ARCHITE
GRADE SHALL BE PLACED ON RIGID INSULATION OVER STRUCTURAL FILL: OMESTIC WATER ENCLOSURE	11. TERMINATE RAIL ENDS WITH RADIUSED RETURNS, NEWEL POSTS, OR SAFETY TERMINALS PER BUILDING CODE REQUIREMENTS, U.O.N.	WATERPROO REQUIREMEN
HE ELECTRICAL GENERATOR ENCLOSURE INDATION E MAT FOUNDATION	 ALL MECHANICAL FASTENERS SHALL BE CONCEALED. CONTRACTOR SHALL VERIFY FINAL DIMENSIONS OF ALL RAILINGS, POSTS, AND 	7. DECK SUPPLIER S RUBBER CLOSUR
CAL HOUSE PAD FOR ADDITIONAL INFORMATION.	THEIR CONNECTIONS PRIOR TO FABRICATION. 14. REMOVABLE RAILINGS SHALL BE DETAILED IN SHORT LENGTHS THAT WEIGH NO	8. PROVIDE 2" MINIM PROVIDE 1.5" MIN PROVIDE 3" MINIM
GRADE SHALL BE PLACED ON NON-FROST _ FILL WITHOUT RIGID INSULATION: ERMINAL BOX/LOAD BANK	MORE THAN 50 LBS. 15. CONTRACTOR SHALL PROVIDE MOVEMENT JOINTS AT RAIL CONNECTIONS TO THE	9. WELDING OF SIDE METAL DECKS.
LECTRICAL EQUIPMENT ENCLOSURE HE EXTERNAL STAIRS TO THE ELECTRICAL GENERATOR AILS FOR ADDITIONAL INFORMATION. FOR ADDITIONAL INFORMATION.	BASE STRUCTURE AS INDICATED ON THE DETAILS THAT ALLOW FOR EXPANSION AND CONTRACTION AS A RESULT OF THERMAL MOVEMENTS BY PREVENTING BUCKLING, OPENING OF JOINTS, OVERSTRESSING OF COMPONENTS, FAILURE OF	10. NO PIPES, FANS, HUNG FROM THE
D, CONTROL JOINTS ARE REQUIRED FOR EXTERIOR RY 400 SQUARE FT. IN AREA. REFER TO TYPICAL	CONNECTIONS, AND OTHER DETRIMENTAL EFFECTS. 16. CONTRACTOR SHALL PROVIDE FOR EXPANSION AND CONTRACTION IN RAILS AS A RESULT OF THERMAL MOVEMENTS. CONTRACTOR SHALL PROVIDE MECHANICAL	11. UNFRAMED OPEN STRUCTURAL ROO RECOMMENDATIO
NG, AND MAT FOUNDATION BEARING ELEVATIONS HAVE BEEN ESTIMATED USING THE GEOTECHNICAL ELEVATIONS WILL BE DETERMINED BY FIELD E PROJECT GEO-TECHNICAL ENGINEERING REPORT	SLIP-JOINT INTERNAL SPLICE CONNECTORS IN THE RAILS. SLIP-JOINTS SHALL BE A MINIMUM OF 6" AWAY FROM RAILING POSTS. SLIP-JOINTS SHALL BE MINIMUM OF 10'-0" O.C. SPLICING INSIDE A SINGLE SET SCREW TEE CONFIGURATION IS STRICTLY PROHIBITED, U.O.N. CONTRACTOR TO SUBMIT LOCATIONS AND DETAILS FOR REVIEW AND APPROVAL PRIOR TO FABRICATION.	 12. THE USE OF EXPA PROHIBITED. 13. ALL PUDDLE WEL
TION AND RECOMMENDATIONS.	17. CONTRACTOR TO PROVIDE DRAINAGE HOLES WITHIN RAIL ASSEMBLIES TO PREVENT ANY ACCUMULATION OF WATER. SUBMIT LOCATIONS FOR REVIEW AND APPROVAL PRIOR TO FABRICATION.	
TH MIN. f'c=100 PSI. SEE SECTION 31 23 23 - FILL FOR	18. THE DESIGN OF ALL RAILING POSTS, RAILS, AND THEIR CONNECTIONS FOR STAIRS, ELEVATED PLATFORMS, AND THE ROOF, AND TOE BOARDS ARE BASED ON OSHA 29 CFR 1910.29.	
		Protection BEDC/IHD
		ADDENDU DATE ISSUED:
ACCOUNTABLE MANAGER	"WARNING-IT IS A VIOLATION, OF THE NEW YORK STATE EDUCATION LAW, NEW YORK CITY	C



CCOUNTABLE MANAGE JUSTIN RIVELLINO PORTFOLIO MANAGER LAUREN D'ATTILE, PE DEPUTY DIRECTOR, IN HOUSE DESIGN

NEW YORK STATE EDUCATION LAW, SECTION, 7209.2, FOR ANY PERSON, UNLESS (S)HE IS ACTING UNDER THE DIRECTION OF A LICENSED PROFESSIONAL ENGINEER, TO ALTER THIS DOCUMENT IN ANY WAY. IF ALTERED, THE ALTERING PERSON SHALL COMPLY WITH THE REQUIREMENTS OF NEW YORK EDUCATION, LAW, SECTION, 7209.2."

NEW YORK CITY ENVIRONMENTAL PROTEC BUREAU OF ENGINEERING DESIGN & CONSTI 96-05 HORACE HARDING EXPRESSWAY 5th CORONA, NEW YORK 11368 www.nyc.gov/dep

8		9			10		
		RUCTURE SPECIFIC NOTE	S FOR STR	UCTUF	RAL	-	
E .	1.	ALL STRUCTURAL ROOF METAL DECK S WITH THE STEEL DECK INSTITUTE SPE RECOMMENDED PRACTICES, AND SEC	CIFICATIONS, TH	E MANUF	ACTL	JRER'S	
LBE	2.	ALL STRUCTURAL ROOF METAL DECK	TO BE DESIGNED	FOR UNS	SHOR	ED	A
ING, FD) IN J.O.N. ER	3.	MINIMUM STRUCTURAL ROOF METAL D THICKNESS AS INDICATED ON THE DRA CAPACITY SHALL SATISFY THE MINIMU INSTITUTE LOAD TABLES. ROOF META ON THE DRAWINGS.	AWINGS. DECK T MS ESTABLISHED	HICKNES D BY THE	S AN STEE	D LOAD EL DECK	
OF AP ITACT	4.	STRUCTURAL ROOF METAL DECKING S GALVANIZED G90 MIN.), U.O.N.	HALL BE ASTM A	653 (F _y =3	3 KSI,		
.D- R ON TS	5.	STRUCTURAL ROOF METAL DECKING B THE DRAWINGS SHALL CONSIST OF TH A. PLACED IN THE VERTICAL POSITIC B. PROVIDE MINIMUM 36 INCH COVER C. PAINT & PRIME EXPOSED PORTION D. WELDED THROUGH THE BOTTOM O MEMBERS WITH 5/8" DIA. PUDDLE V ACTUATED DECK FASTENERS. US FASTENERS.	IE FOLLOWING: N. RAGE WIDTHS. NS. OF THE RIBS TO A WELDS AT 6" O.C. E ONLY FACTORY	ALL SUPP . OR APP Y MUTUA	PORTI ROVE L APF	NG D POWDER- PROVED	В
THE IRED TS, WELL		 E. ALL DECK SIDE LAPS SHALL BE ME NO GREATER THAN 3'-0" O.C. F. ROOF METAL DECK IS DESIGNED A SELFWEIGHT AND COMPONENTS & ON THE LOADING CRITERIA. G. SEE ARCHITECTURAL DRAWINGS A WATERPROOFING AND INSULATIO H. FIREPROOFING OF THIS VERTICAL 	AS VERTICAL SIDI & CLADDING WINE AND SPECIFICATI N REQUIREMENT	NG, SUPI D LOADS ONS FOF S.	PORT AS IN R ALL	ING	
ONS OSTS. LL BE	6.	 STRUCTURAL ROOF METAL DECKING F SHOWN ON THE DRAWINGS SHALL COI A. PROVIDE MINIMUM 24 INCH COVEF B. PAINT & PRIME TOP PORTIONS. C. WELDED THROUGH THE BOTTOM ON MEMBERS WITH APPROVED POWE O.C. USE ONLY FACTORY MUTUAL D. ALL DECK SIDE LAPS SHALL BE FA SPACING NO GREATER THAN 2'-0" 	NSIST OF THE FO AGE WIDTHS. OF THE RIBS TO A DER-ACTUATED D APPROVED FAS ^T STENED WITH #1	ALL SUPP ECK FAS TENERS.	G: PORTI TENE	NG RS AT 8"	с
ED		 E. ROOF METAL DECK IS DESIGNED A GRAVITY AND MWFRS WIND LOAD CRITERIAS. F. SEE ARCHITECTURAL DRAWINGS A WATERPROOFING, INSULATION, VA REQUIREMENTS. 	AS A FLEXIBLE DIA S, AS INDICATED AND SPECIFICATI	ON THE I	LÓAD R ALL	ING	
	7.	DECK SUPPLIER SHALL FURNISH ANY A RUBBER CLOSURES, ETC. AS REQUIRE					D
D	8.	PROVIDE 2" MINIMUM LAPS FOR ALL DE PROVIDE 1.5" MINIMUM END BEARING L PROVIDE 3" MINIMUM INTERIOR BEARIN	ENGTH FOR ALL				
HE	9.	WELDING OF SIDE LAPS SHALL NOT BE METAL DECKS.	PERMITTED ON	20-GA. OI	r thi	NNER	
N OF	10.	NO PIPES, FANS, DUCTS, LIGHTS, CON HUNG FROM THE STRUCTURAL ROOF I		R HEAVY	LOAD	S CAN BE	
S A AL	11.	UNFRAMED OPENINGS, LARGER THAN STRUCTURAL ROOF METAL DECK SHAI RECOMMENDATIONS. SUBMIT REINFOR	L BE REINFORCE	ED PER M	IANUF		
BE A)F ICTLY	12.	THE USE OF EXPANSION ANCHORS IN PROHIBITED.	THE STRUCTURA	L ROOF N	/ETAI	_ DECK IS	E
EVENT VAL	13.	ALL PUDDLE WELD BLOWOUTS SHALL	BE PATCHED BY	THE CON	TRAC	CTOR.	
IRS, A 29							-
	G	^o Environmental	GRAPHIC S]		F
		ADDENDUM NO. 2 DATE ISSUED: 07/2023	IF SHEET IS LESS IF SHEET IS A REDUC SCALE ACCO	DRE USE THAN 22" X ED PRINT.	34"		
		CONTRACT KENS-E KENSICO SITE PREPA				JULY 2023 AS NOTED	
CTIO TRUCTIC th FLOOR		STRUCTURAL ELECTRICAL BUIL STRUCTURE SPECIFIC CODI	DING	-		^{NO:} VING NO. B-S-001.01	

STRUCTURE SPECIFIC CODES AND NOTES

	SYMBOLS
SYMBOL	DESCRIPTION
S	SANITARY PIPING BELOW GRADE
<u> </u>	SANITARY PIPING ABOVE GRADE
	VENT PIPING
	COLD WATER PIPING
	HOT WATER PIPING
bd	SHUT-OFF VALVE
ī	CHECK VALVE
k	PRESSURE REDUCING VALVE
 ק	VALVE IN VERTICAL
î	PIPE DROP, RISE OR DOWN
	PIPE CONNECTION, TOP
	PIPE CONNECTION, BOTTOM
0	PIPE UP
œ—	"P" TRAP
~~~~~~~~~~~~~~~~~~~~~~~~~~~~~~~~~~~~~~	CLEANOUT
۰ <b>۲</b>	CLEANOUT DECK PLATE
	CAPPED OUTLET
E	
<b>0</b>	FLOOR DRAIN, AREA DRAIN
<u></u>	
4	PRESSURE GAUGE W/VALVE
-BFP-	
	FLOOR, AREA DRAIN (RISER)
	FRESH AIR INLET (FAI)
M	METER
	DIRECTION OF FLOW
<del>,</del>	PIPE BREAK
*	EQUIPMENT DESIGNATION
— -FAI	FRESH AIR INLET
IW	INDIRECT WASTE PIPING
<b>A</b>	ANGLE VALVE
<b>i</b>	OS & Y VALVE
<b>ф</b> ——	OS & Y VALVE IN VERTICAL
- <b>00</b>	HOUSE TRAP
	CONCENTRIC REDUCER
- <del>\y</del>	STRAINER Y-TYPE
_=	WATERTIGHT PIPE SLEEVE, BEAM PENETRATION

ŀ	ABBREVIATIONS
SYMBOL	DESCRIPTION
ARCH	ARCHITECTURAL
BFP	BACKFLOW PREVENTER
BLDG	BUILDING
CLG	CEILING
CO	CLEANOUT
CODP	CLEANOUT DECK PLATE
COWP	CLEANOUT WALL PLATE
CONN	CONNECTION
CONT	CONTINUATION
CW	DOMESTIC COLD WATER
DCV	DOUBLE CHECK VALVE
DET	
DFU	DRAINAGE FIXTURE UNIT
DIA	DIAMETER
	DIMENSION
DN DR	DOWN
DWG	DRAIN
EA	EACH
EL	ELEVATION
EQ	EQUAL
EWH	ELECTRIC WATER HEATER
FAI	FRESH AIR INLET
FCO	FLOOR CLEANOUT
FD	FLOOR DRAIN
FS	FLOOR SINK
F.F.	FINISH FLOOR
FL	FLOOR
GAL	GALLON
GPM	GALLON PER MINUTE
HB	HOSE BIBB
HW	DOMESTIC HOT WATER
I.E.	INVERT ELEVATION
IW	INDIRECT WASTE
MAX	MAXIMUM
MECH	MECHANICAL
MIN	MINIMUM
NC	NORMALLY CLOSED
NO	NORMALLY OPEN
NTS	NOT TO SCALE
RPZ	REDUCED PRESSURE ZONE
S	SANITARY WASTE
SF	SQUARE FEET
ST	STORM DRAINAGE
TP	
TYP	TYPICAL VENT
UON	UNLESS OTHERWISE NOTED
VIF	VERIFY IN FIELD
VIF	VALVE
VLV	VALVE VENT THROUGH ROOF
W	WASTE
	WITH
WC	WATER CLOSET
WCO	WALL CLEANOUT
W/O	WITHOUT
WH	WALL HYDRANT
WHA	WATER HAMMER ARRESTOR
-	

GRATE OR STRAINER

MATERIAL

CAST IRON

DUTY

MEDIUM

**TOP COVER** 

DUCO CAST 12" ROUND IRON

6. ANY PIPE THAT PASSES UNDER A FOOTING SHALL BE PROVIDED WITH A RELIEVING ARCH. 7. ALL EQUIPMENT SHALL BE INSTALLED IN STRICT ACCORDANCE WITH THE EQUIPMENT MANUFACTURER'S RECOMMENDATIONS AND APPLICABLE CODES. PROVIDE ALL FITTINGS, TRANSITIONS, VALVES, AND OTHER DEVICES REQUIRED FOR A COMPLETE WORKABLE INSTALLATION.

PROVIDED TO OWNER. 9. THE CONTRACTOR SHALL VISIT THE JOB SITE TO DETERMINE EXISTING CONDITIONS, BECOME FULLY FAMILIAR WITH PLUMBING INSTALLATION. COMPARE SAME WITH DRAWINGS AND SPECIFICATIONS AND SATISFY HIMSELF OF ALL CONDITIONS PRIOR TO SUBMISSION OF A BID PROPOSAL. SUBMISSION OF A COST PROPOSAL (BID) WILL BE JUDGED AS EVIDENCE THAT SITE EXAMINATION HAS BEEN MADE. CLAIMS FOR EXTRA COSTS FOR LABOR, EQUIPMENT, OR MATERIALS REQUIRED, OR FOR DIFFICULTIES ENCOUNTERED WHICH COULD HAVE BEEN FORESEEN HAD SUCH EXAMINATION BEEN MADE WILL NOT BE RECOGNIZED.

**T**)

NOTES:

ITEN TYPE Μ

ITEN TYPE RPZ

> ITEN TYPE PRV

TYPE HBE

ITEM TYPE N EWH

NOTES: 1. CONTRACTOR SHALL PROCURE COMBINATION EMERGENCY SHOWER AND EYE/FACE WASH UNIT AS A PACKAGED SYSTEM WITH ELECTRIC WATER HEATER, COMPLETE WITH INSULATION ON ALL EXPOSED PIPING.

ITEM

TYPE NO.

FD

NOTES:

DESCRIPTION

FLOOR DRAIN

1. PROVIDE W/ TRAP SEAL DEVICE ZURN MODEL # Z1072

ЫΝ 52 17 Ω. 23

DESIGNED BY: DRAWN BY: ER FR CHECKED BY: ARUP DESIGN LEAD: RICHARD POTTER, PE 07/23 ADDENDUM #2 RPRF SECTION MANAGER: **REVISIONS/DESCRIPTION** NO. DATE APPR'D.

**DRAIN SCHEDULE** 

BASIS OF DESIGNMODELMANUFACTURERNO.BODY MATERIAL

Z505

ZURN

All inquiries regarding this drawing(s) or project should be made to NYC Environmental Protection, Bureau of Engineering Design and Construction.

4 5 6 7	

## RAL NOTES

1. ALL MATERIALS AND WORKMANSHIP SHALL CONFORM TO 2020 NYS PLUMBING CODE AND APPLICABLE LOCAL CODES AND REGULATIONS.

2. DRAWINGS ARE DIAGRAMMATIC AND INDICATE GENERAL ARRANGEMENT OF SYSTEMS AND WORK INCLUDED. FOLLOW DRAWINGS IN LAYING OUT WORK AND CHECK DRAWINGS OF OTHER TRADES RELATING TO WORK TO VERIFY SPACE IN WHICH WORK WILL BE INSTALLED. MAINTAIN HEADROOM AND SPACE CONDITIONS AT ALL TIMES.

3. COORDINATE PLUMBING SYSTEMS WITH WORK OF ALL OTHER TRADES PRIOR TO ANY FABRICATION OR INSTALLATION. PROVIDE ALL FITTINGS, OFFSETS, AND TRANSITIONS AS REQUIRED FOR A COMPLETE WORKABLE INSTALLATION.

4. FOR EXACT LOCATION OF PLUMBING FIXTURES REFER TO ARCHITECTURAL DRAWINGS AND DETAILS.

5. PRIOR TO BURYING ANY PIPING, PIPES MUST BE INSPECTED BY THE ENGINEER.

8. MAINTENANCE LABEL SHALL BE AFFIXED TO ALL PLUMBING EQUIPMENT AND A MAINTENANCE MANUAL SHALL BE

10. CONTRACTOR SHALL BE RESPONSIBLE FOR ALL NECESSARY PERMITS INCLUDING BUT NOT LIMITED TO ENTERING MANHOLES, USE OF WATER FROM LOW PRESSURE HYDRANTS, DEMOLITION AND NEW WORK, ETC. PRIOR TO COMMENCE OF WORK.

				PLU		URE SCHEDULE	
ITEN	Λ	DECODIDITION	CW		TEMPERED		
TYPE	NO.	DESCRIPTION	INTLET SIZE	TEMPERED WATER	WATER TEMPERATURE	FLOW RATE (GPM)	MANUFAC
ES	1	EMERGENCY SHOWER AND EYE/FACE WASH UNIT	-	1 1/4"	80°F	27	BRAD CORPOF
YH	1	NON-FREEZE YARD HYDRANT	1"	-			ZUF

1. COMBINATION EMERGENCY SHOWER AND EYE/FACE WASH UNIT SHALL BE PROVIDED WITH INTEGRAL POWER AND ALARMS. 2. CONTRACTOR SHALL PROCURE COMBINATION EMERGENCY SHOWER AND EYE/FACE WASH UNIT AS A PACKAGED SYSTEM WITH ELECTRIC WATER I

	WATER METER SCHEDULE											
EN	/I NO.	DESCRIPTION	SIZE	MANUFACTURER	MODEL NO.			NOTE	S			
	1	DOMESTIC WATER METER 2'		HONEYWELL	EVOQ4-LF	LOW FLOW EL	W FLOW ELECTROMAGNETIC METER, STAINLESS			STAINLESS S	STEEL BOD	Y, LCD D
_					BACKFLOW PREVENTION SCHEDU				HEDULE			
EN	/I NO.	DESCRIPTION	S	SERVICE		LOCATION		SIZE [IN]	] MANUF	ACTURER	MODEL NO.	APPROVA
	1	REDUCED PRESSURE ZONE	DOMES	STIC WATER	OUTDOOR H	IEATED ENCLO	SURE	2	ZURN -	WILKINS	375XL-AG	ASSE
							PRE	SSURE	REDUCING	VALVE SC	HEDULE	
EN	/I NO.	DESCRIPTION	S	BERVICE	LOC	ATION	SIZE [	IN] MAI	NUFACTURER	MODEL NO.	APPROVALS	
	1	WATER PRESSURE REDUCING VALVE		STIC COLD		R HEATED OSURE	2		ZURN	600XL-C-H LR	ASSE	TAPPE
		1	1									

**PLUMBING - EQUIPMENT SCHEDULE** 

ITEM				D	IMENSIO	NS		ELECTF	RICAL	_
NUMBER	DESCRIPTION	MANUFACTURER	MODEL NO.	LENGTH	WIDTH	HEIGHT	SYSTEM SERVED	Watts	V	
1	HEATED BACKFLOW PREVENTER ENCLOSURE	HUBELL	DURAFOLD CUSTOM	1'-9"	7'-4"	3'-4 1/2"	DOMESTIC WATER	1500.0	120	

							WATER HEATER	SCHEDULE	
N				l	ELECTRICAL				
NO.	EQUIPMENT DESCRIPTION	TEMP. IN [°F]	TEMP. OUT [°F]	POWER [kW]	VOLTAGE [V]	PHASE [PH]	MANUFACTURER	MODEL NO.	
1	ELECTRIC TANKLESS WATER HEATER	40	80	126	480	3	BRADLEY CORPORATION	SNA-126 3/480 D-N4X-D-AL3-SL-FDS-GF- PRS-YSS	PROVIDE WITH DIGIT CONSTROL SYSTEM I FAULT PACAKGE, ASM


		ACCOUNTABLE MANAGER	"WARNING-IT IS A VIOLATION, OF THE	NEW VODE CITY
		JUSTIN RIVELLINO	NEW YORK STATE EDUCATION LAW, SECTION, 7209.2, FOR ANY PERSON,	NEW YORK CITY
		PORTFOLIO MANAGER	UNLESS (S)HE IS ACTING UNDER THE DIRECTION OF A LICENSED	<b>ENVIRONMENTAL PROTECT</b>
	LAUREN D'ATTILE, PE	PROFESSIONAL ENGINEER, TO ALTER	BUREAU OF ENGINEERING DESIGN & CONSTR	
	Environmental	,,	THIS DOCUMENT IN ANY WAY. IF ALTERED, THE ALTERING PERSON SHALL	96-05 HORACE HARDING EXPRESSWAY 5th FI
		DEPUTY DIRECTOR, IN HOUSE DESIGN	COMPLY WITH THE REQUIREMENTS OF	CORONA, NEW YORK 11368
Protection		MICHAEL LOEHR, PE	NEW YORK EDUCATION, LAW, SECTION, 7209.2."	www.nyc.gov/dep

- PLUMBING CODE NE
- 1. ALL PLUMBING SYS EQUIPMENT SHALL THE 2020 NEW YOF ACCORDANCE WIT
- 2. INSPECTION AND T PC312.
- 3. MATERIALS USED II PC303. 4. RODENT PROOFING
- 5. PROTECTION OF PL
- 6. INSTALLATION OF U PC305 AND PC306.
- 7. TRENCHING, EXCA 8. VERTICAL AND HOP SECTION PC308.
- 9. FLOOD HAZARD RE
- 10. FIXTURES, FAUCET
- 11. WATER SUPPLY SY PC CHAPTER 6.
- 12. EQUIPMENT CONNI SECTION PC605.
- 13. DISINFECTION OF F
- 14. INDIRECT WASTE F


8		9		10	
W YORK S	STATE NOTES				
. BE INSTAL RK STATE P	NITARY, WASTE, VENT AND W LED, OPERATED AND MAINTA PLUMBING CODE. POTABLE AN NYS SECTION 608.	AINED IN AC	CORDANCE WITH T	HE REQUIREMENTS OF	Α
ESTING OF	PLUMBING PIPING SYSTEMS	SHALL BE	IN ACCORDANCE W	TH SECTION PC107 AND	)
N PLUMBIN	IG SYSTEMS SHALL BE IN ACC	CORDANCE	WITH THE REQUIRE	MENTS OF SECTION	
G AS PER P	PC304. PIPING SYSTEM COMPONENTS			SASPER PC3054	
	OUND PIPING SHALL BE IN AC				$\vdash$
	D BACKFILL AS PER PC306. PIPING SHALL BE SUPPORTED	) IN ACCOR	DANCE WITH THE R	EQUIREMENTS OF	
SISTANCE	AS PER SECTION PC309.				В
_	TURE FITTINGS AS PER PC CH	HAPTER 4.			
	ALL BE INSTALLED AND MAIN		ACCORDANCE WITH	THE REQUIREMENTS OI	F
ECTIONS A	ND JOINING OF PIPING SHALL	BE IN ACC	ORDANCE WITH THI	E REQUIREMENTS OF	
POTABLE W	ATER SYSTEM AS PER SECT	ION PC810.			
PIPING AS F	PER SECTION PC802.				
					_
				<u></u>	_
	MODEL				
DLEY DRATION		316SS BAL	L VALVE, ABS PLAS	TOP SUPPLY, 304SS PIPE TIC SHOWER HEAD WITH	нЦ
	S19314BB2CFEB	304 SS YO	KE, 304SS BOWL AN	E WASH W/ DUST COVER D COVER, 316SS HANDL	.E
				EA LIGHT, PROVIDE WITI SIGNALING SYSTEM	
JRN	Z1397XL				
HEATER C	OMPLETE WITH INSULATION		OSED PIPING		
D DISPLAY					
OVALS			TES		
SE THR	EADED CONNECTIONS, QUAF	TER-TURN	BALL VALVES, AIRG	AP ASSEMBLY REQUIRE	
		NOTES			
PED WITH (	GAUGE, COPPER SWEAT CON		0 PSI TO 125 PSI SP	RING RANGE, OUTLET	
	PRESSU	RE SET TO 8	80 PSI		
LOC	CATION		NOTES		
	EXTERIOR DURAFOLD A		INGED ENCLOSURE Y 1500 WATT, 120V S		
			HEATER		
		]			
ITAL CONTF	NOTES ROL, STACK LIGHT WITH DISTI	RIBUTED			
Л LINK, INTE	ERNAL FUSED DISCONNECT, ( SURE RELIEF VALVE, STAINLES	GROUND			
	STRAINER		<b>N</b>		
	Protection BEDC/IHD		GRAPHIC SC/ CHECK BEFOR	E USE CONVERSION	
	ADDENDUM NO.	2	IF SHEET IS LESS TH		
	DATE ISSUED: 07/2023		IT IS A REDUCED SCALE ACCORE		8
			EAST-2	DATE: JULY 2023 SCALE: AS NOTED	1
CTION	<b>KENSICO SI</b>	TE PREPH	ERATION }	SHEET NO:	-
RUCTION FLOOR	$\angle 1 \land \neg \neg PL$	UMBING			
		CAL BUIL	DING	DRAWING NO.	

SYMBOL LIST, NOTES, LEGENDS & SCHEDULES

KSEB-P-001.01

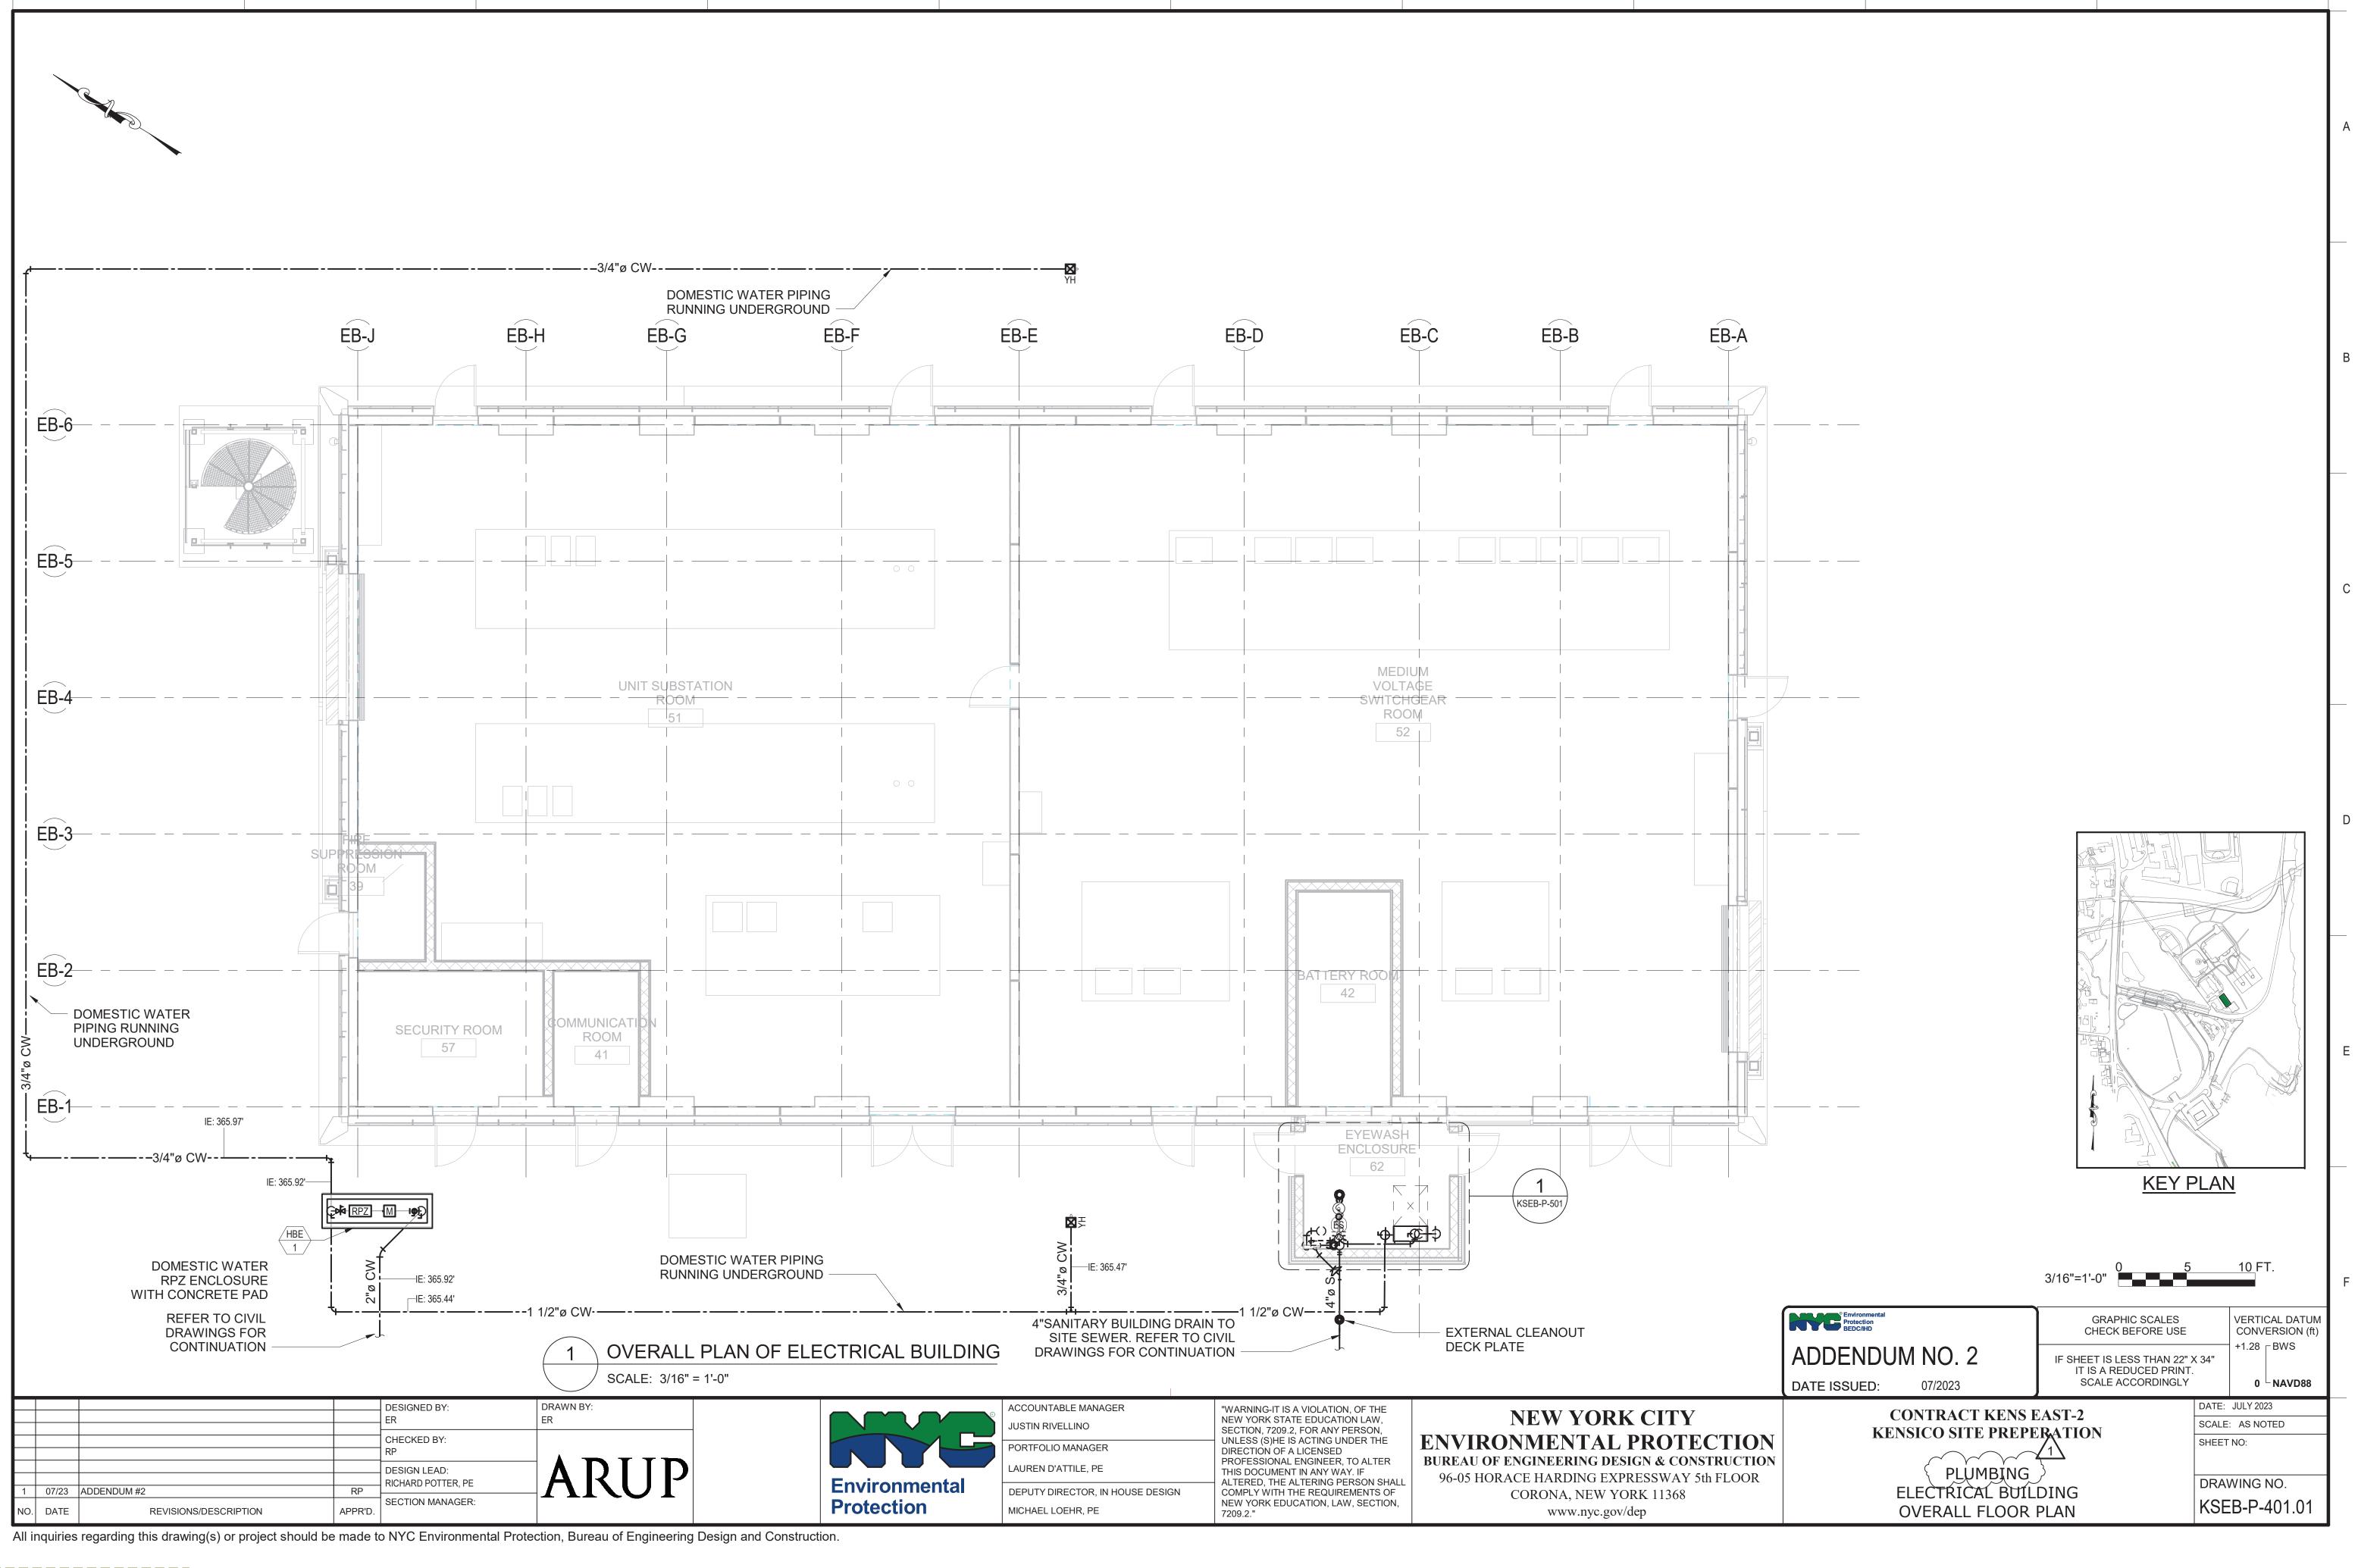

ЫΝ 52 17 ы. ŝ

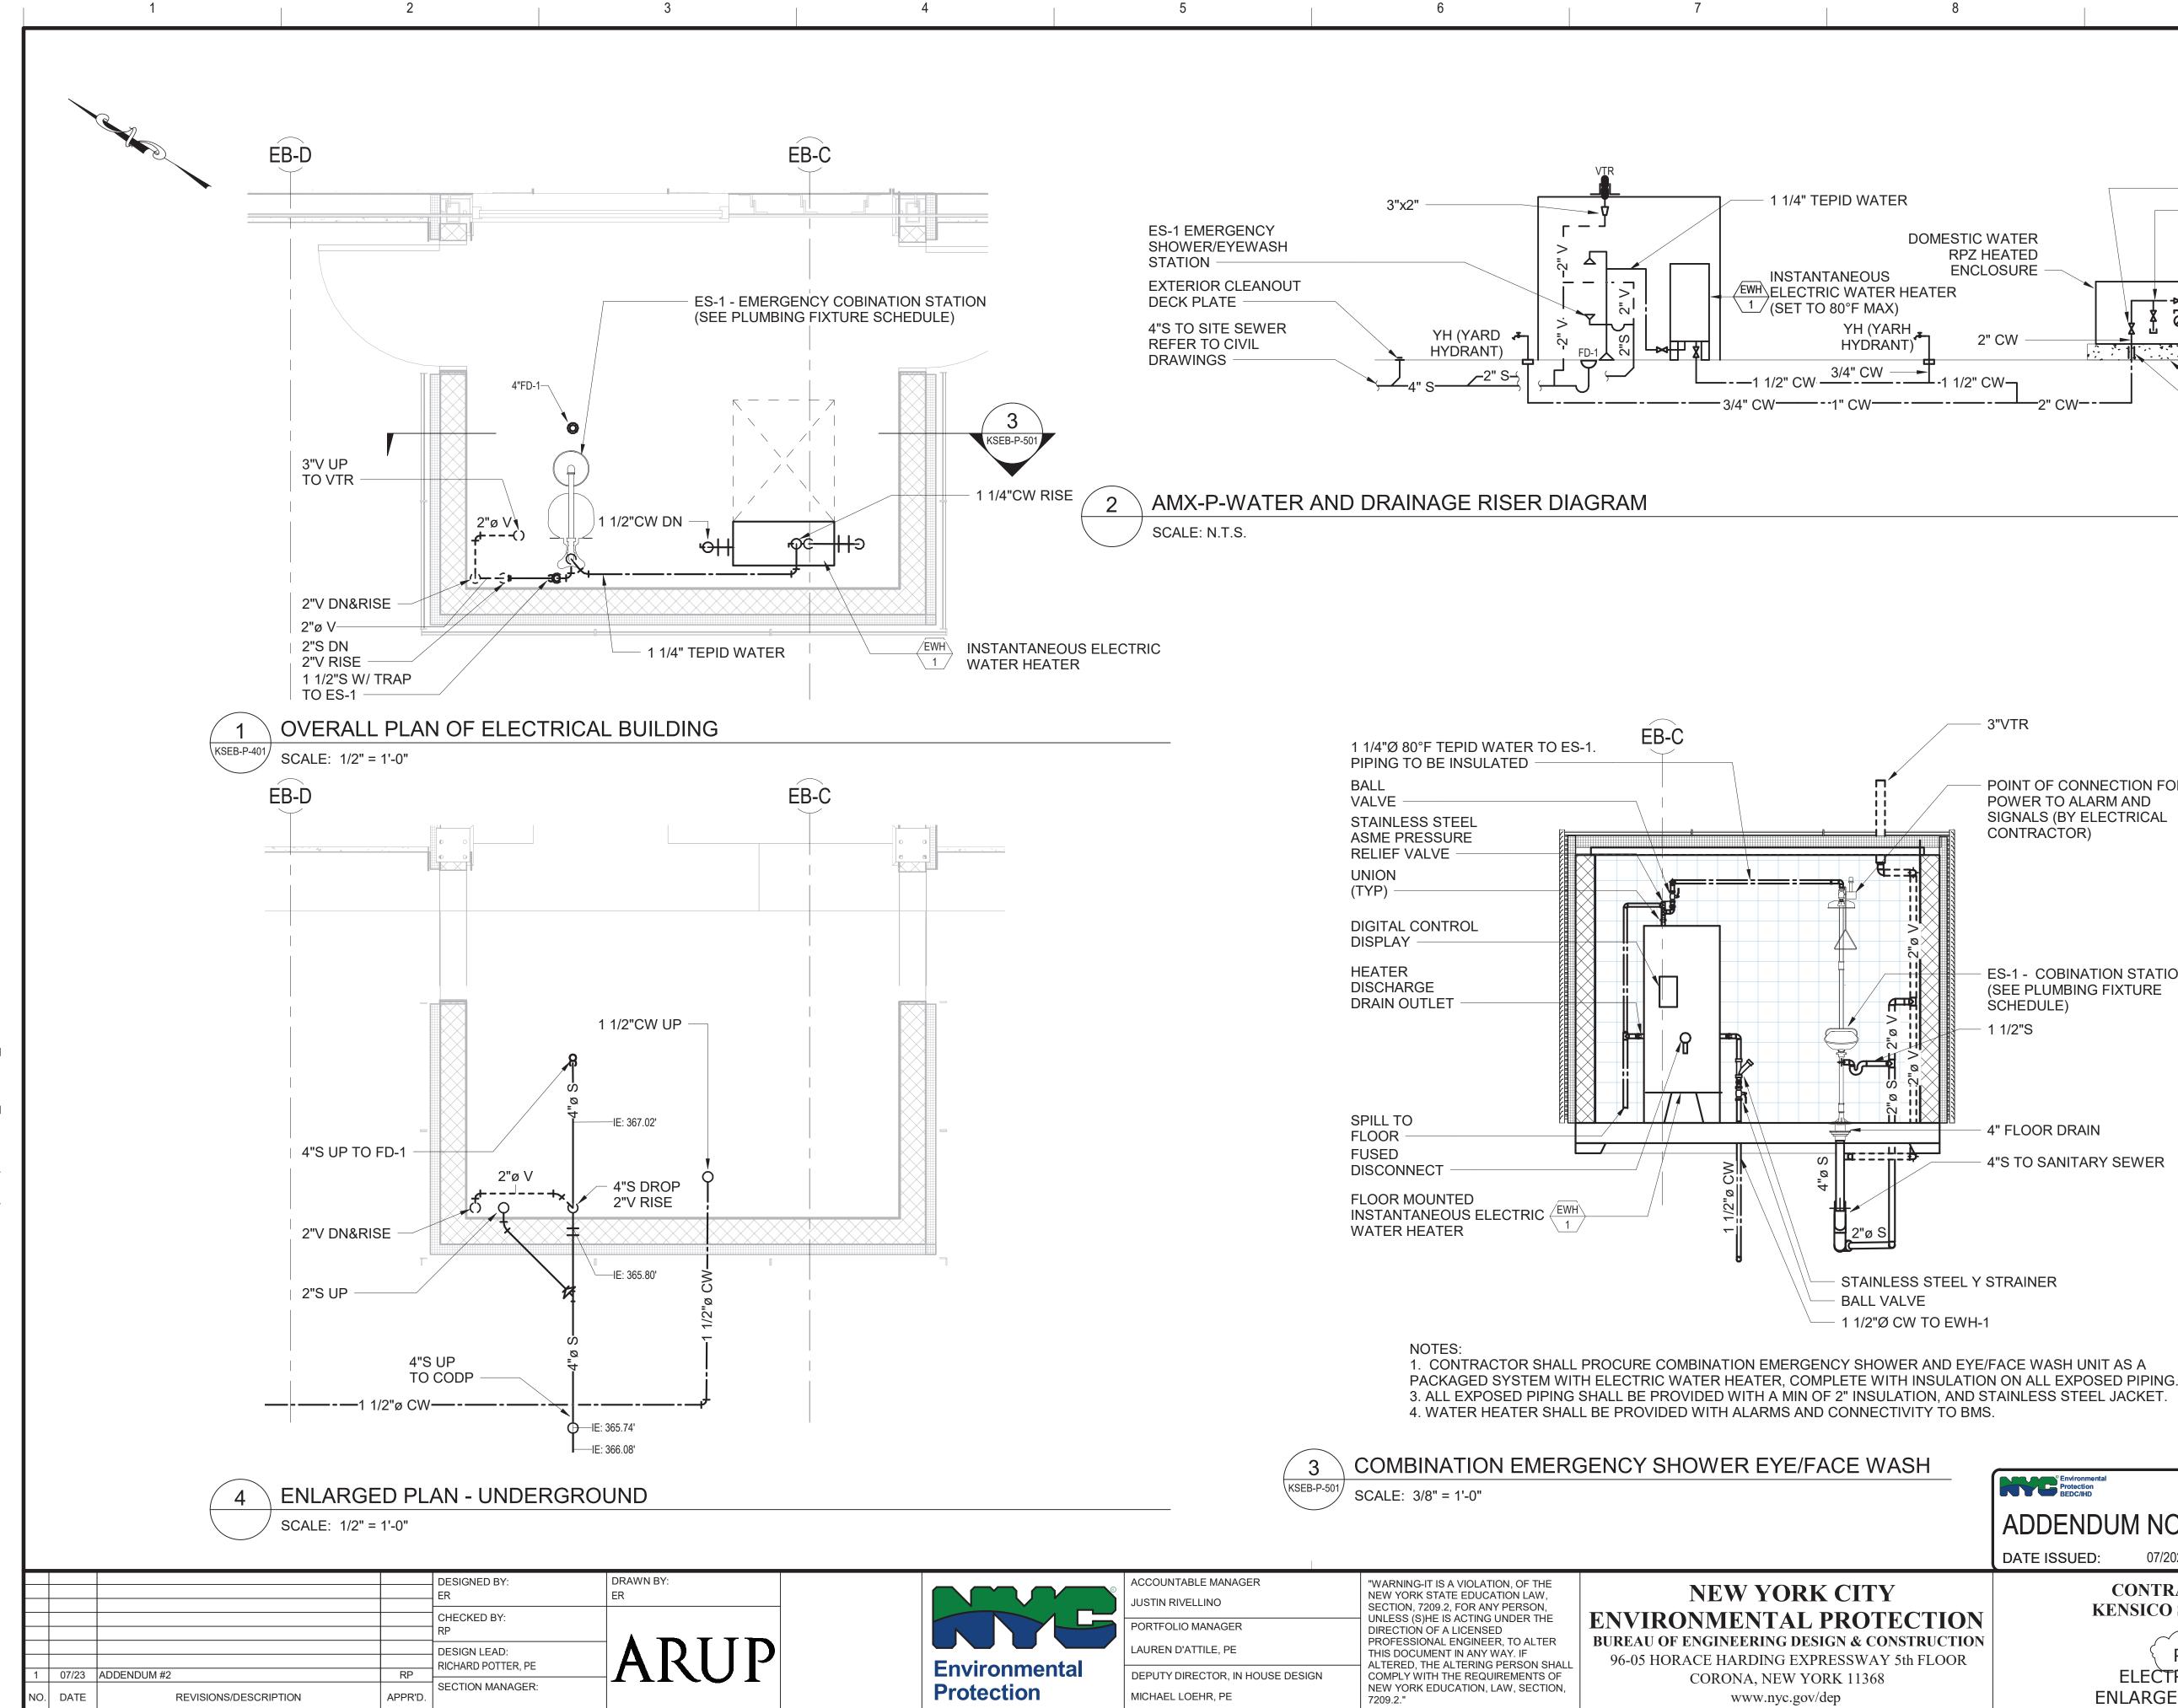

ЫΜ 54 5:17 23

All inquiries regarding this drawing(s) or project should be made to NYC Environmental Protection, Bureau of Engineering Design and Construction.


8	9	10
MESTIC WATER RPZ HEATED ENCLOSURE TER 2" CW 1 1/2" CW 2" CW		ETER OUTLET VALVE EST TEE W/CAPPED VALVE RV W/ GAUGE ACKFLOW PREVENTER ATER METER ATER INLET CONTROL VALVE JILDING CONTROL VALVE GRADE 2" DOMESTIC WATER SERVICE - INDIRECT SPILL TO FLOOR - CONCRETE PAD - PROVIDE WATERTIGHT SLEEVE THROUGH SLAB
3"VTR		
POWER TO A SIGNALS (BY CONTRACTO	ELECTRICAL R) ATION STATION	
4" FLOOR DR		

STAINLESS STEEL Y STRAINER

H				
· · ·	Protection BEDC/IHD		VERTICAL DATUM CONVERSION (ft)	
	ADDENDUM NO. 2	IF SHEET IS LESS THAN 22" 2 IT IS A REDUCED PRINT.		+1.28 - BWS
	DATE ISSUED: 07/2023	SCALE ACCORDINGLY		0 [└] NAVD88
	CONTRACT KENS F	CAST-2	DATE:	JULY 2023
	KENSICO SITE PREPE	SCALE	: AS NOTED	
<b>CTION</b> RUCTION		SHEET	NO:	
FLOOR	ELECTRICAL BUIL	DRA	WING NO.	
	ENLARGED PLANS &	KSE	B-P-501.01	

1/2"=1'-0"


Е

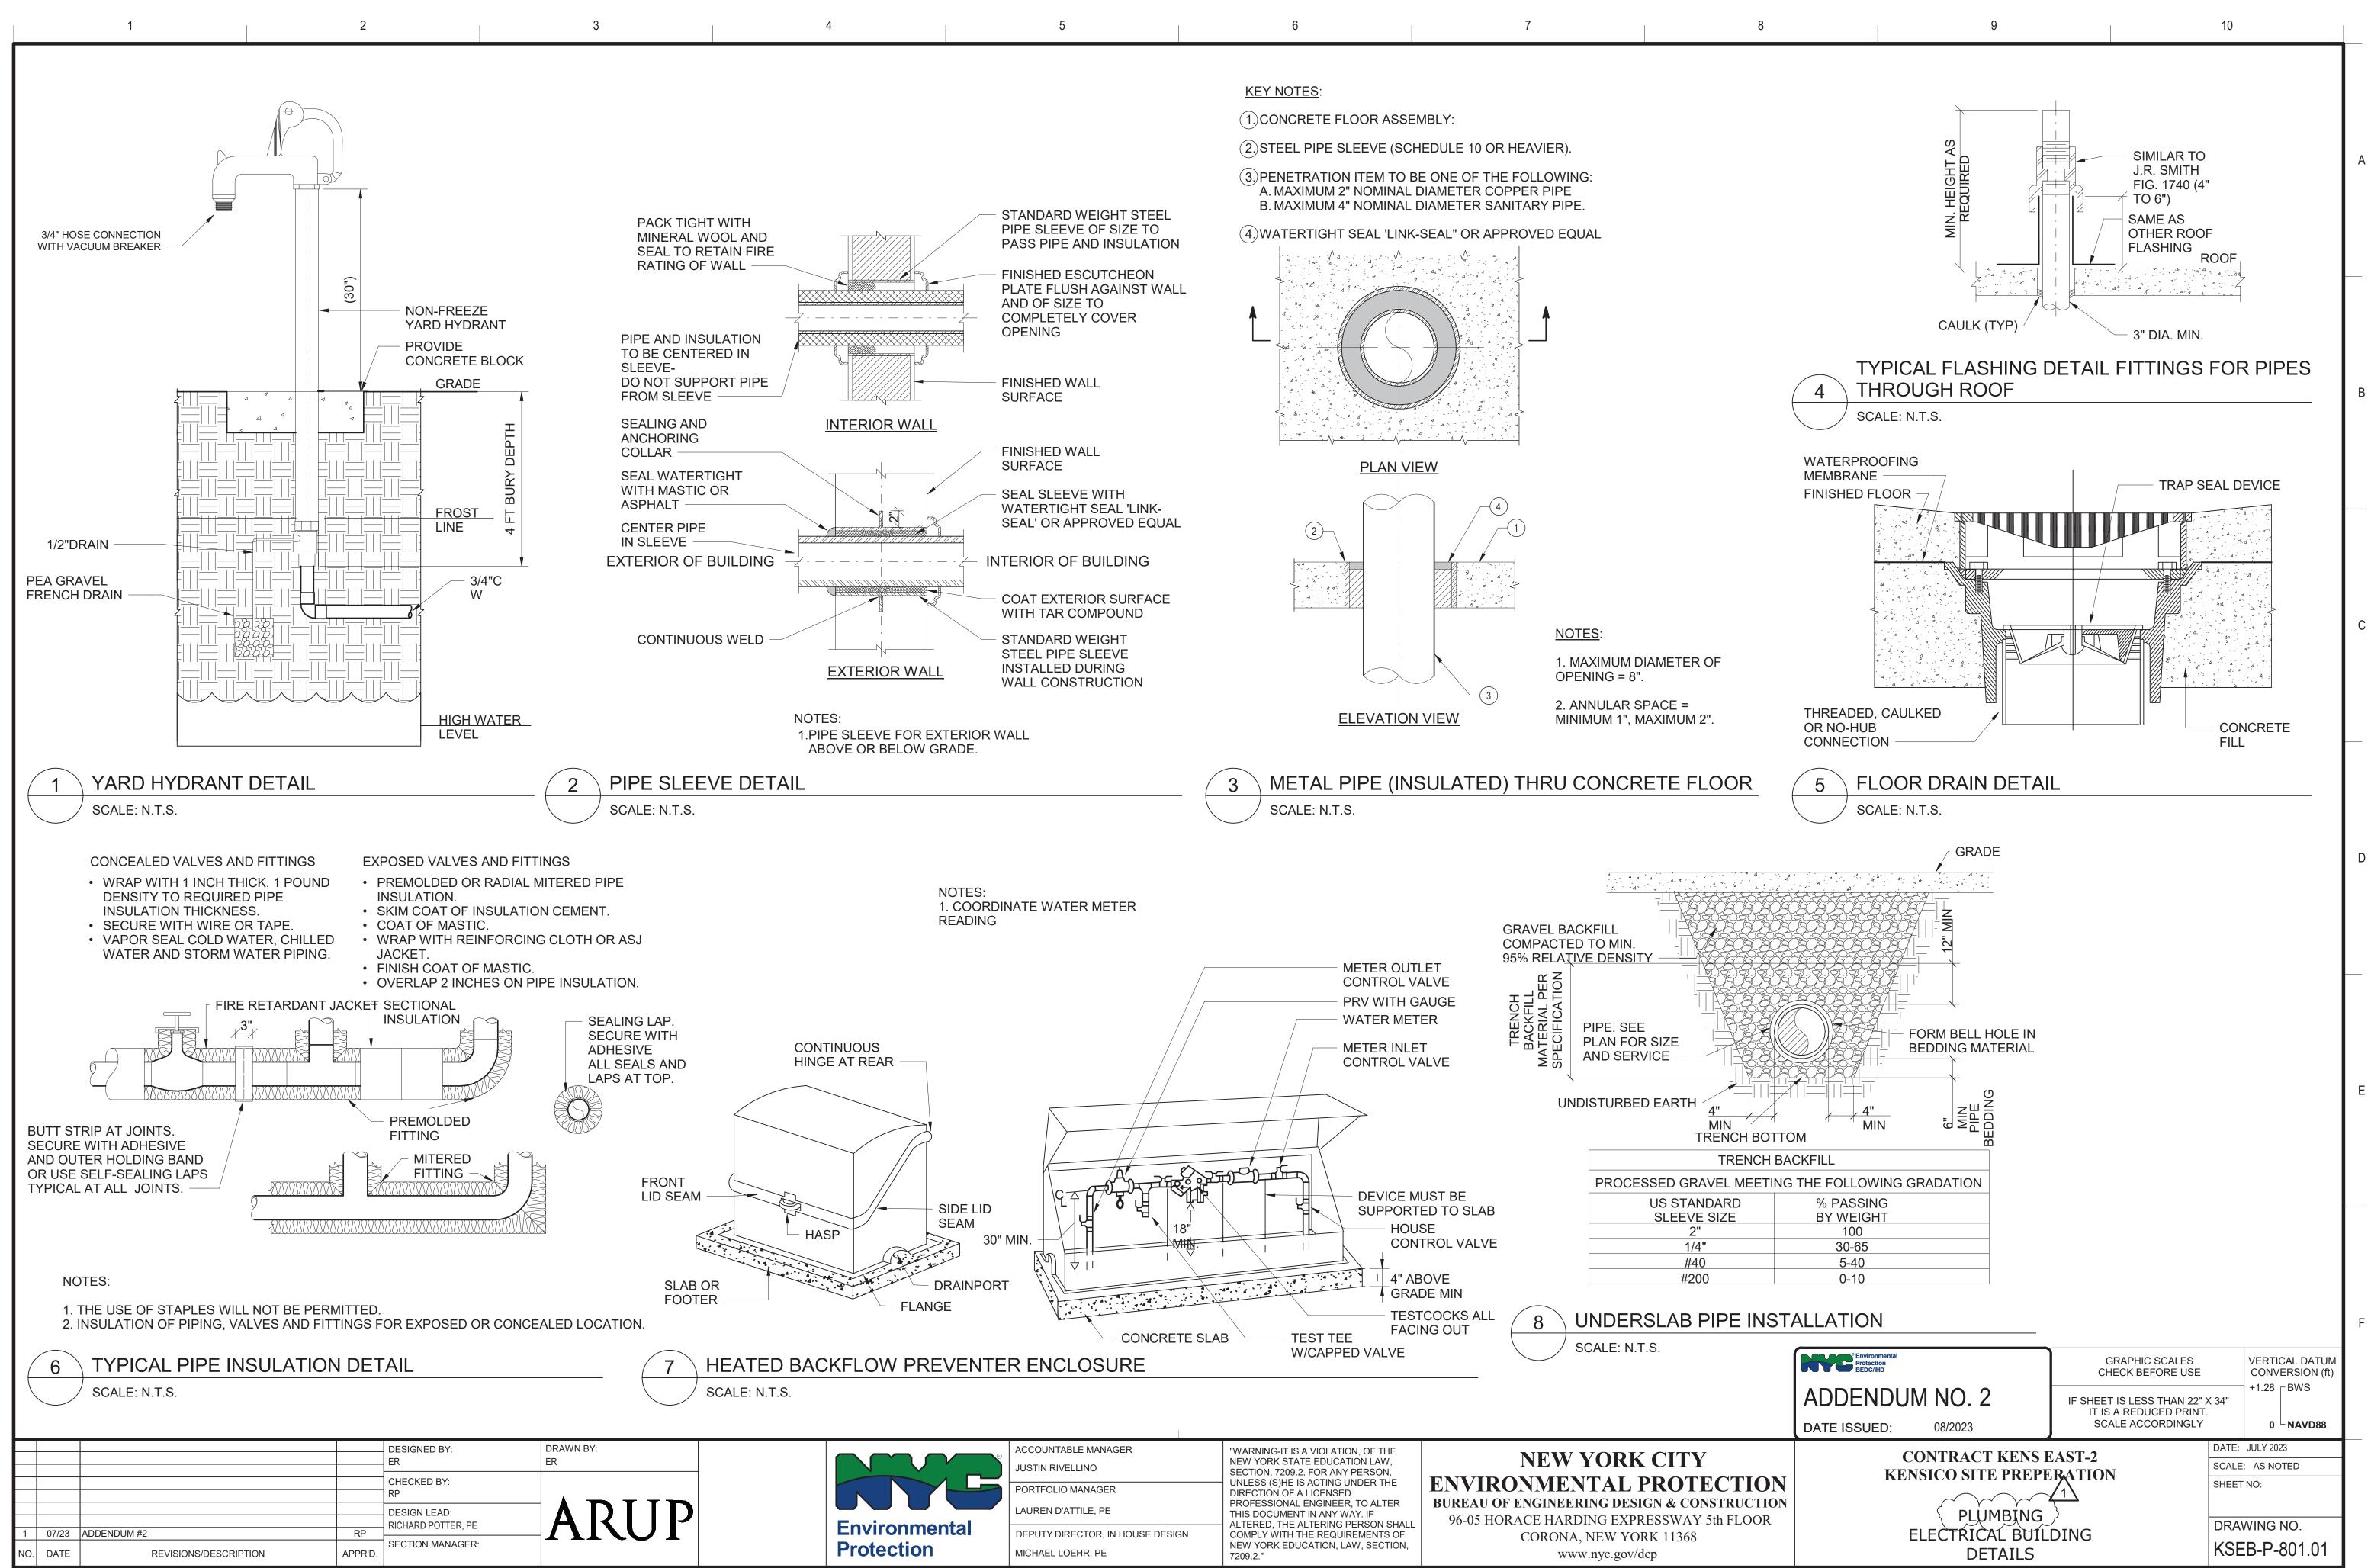

ЪЧ 53 ŝ



ACCOUNTABLE MANAGER JUSTIN RIVELLINO PORTFOLIO MANAGER LAUREN D'ATTILE, PE DEPUTY DIRECTOR, IN HOUSE D MICHAEL LOEHR, PE	"WARNING-IT IS A VIOLATION, OF THE NEW YORK STATE EDUCATION LAW, SECTION, 7209.2, FOR ANY PERSON, UNLESS (S)HE IS ACTING UNDER THE DIRECTION OF A LICENSED PROFESSIONAL ENGINEER, TO ALTER THIS DOCUMENT IN ANY WAY. IF ALTERED, THE ALTERING PERSON SHALL COMPLY WITH THE REQUIREMENTS OF NEW YORK EDUCATION, LAW, SECTION, 7209.2."	NEW YORK CITY ENVIRONMENTAL PROTECT BUREAU OF ENGINEERING DESIGN & CONSTR 96-05 HORACE HARDING EXPRESSWAY 5th F CORONA, NEW YORK 11368 www.nyc.gov/dep
-----------------------------------------------------------------------------------------------------------------------------------------	---------------------------------------------------------------------------------------------------------------------------------------------------------------------------------------------------------------------------------------------------------------------------------------------------------------------------------------------------------------------	-----------------------------------------------------------------------------------------------------------------------------------------------------------------------

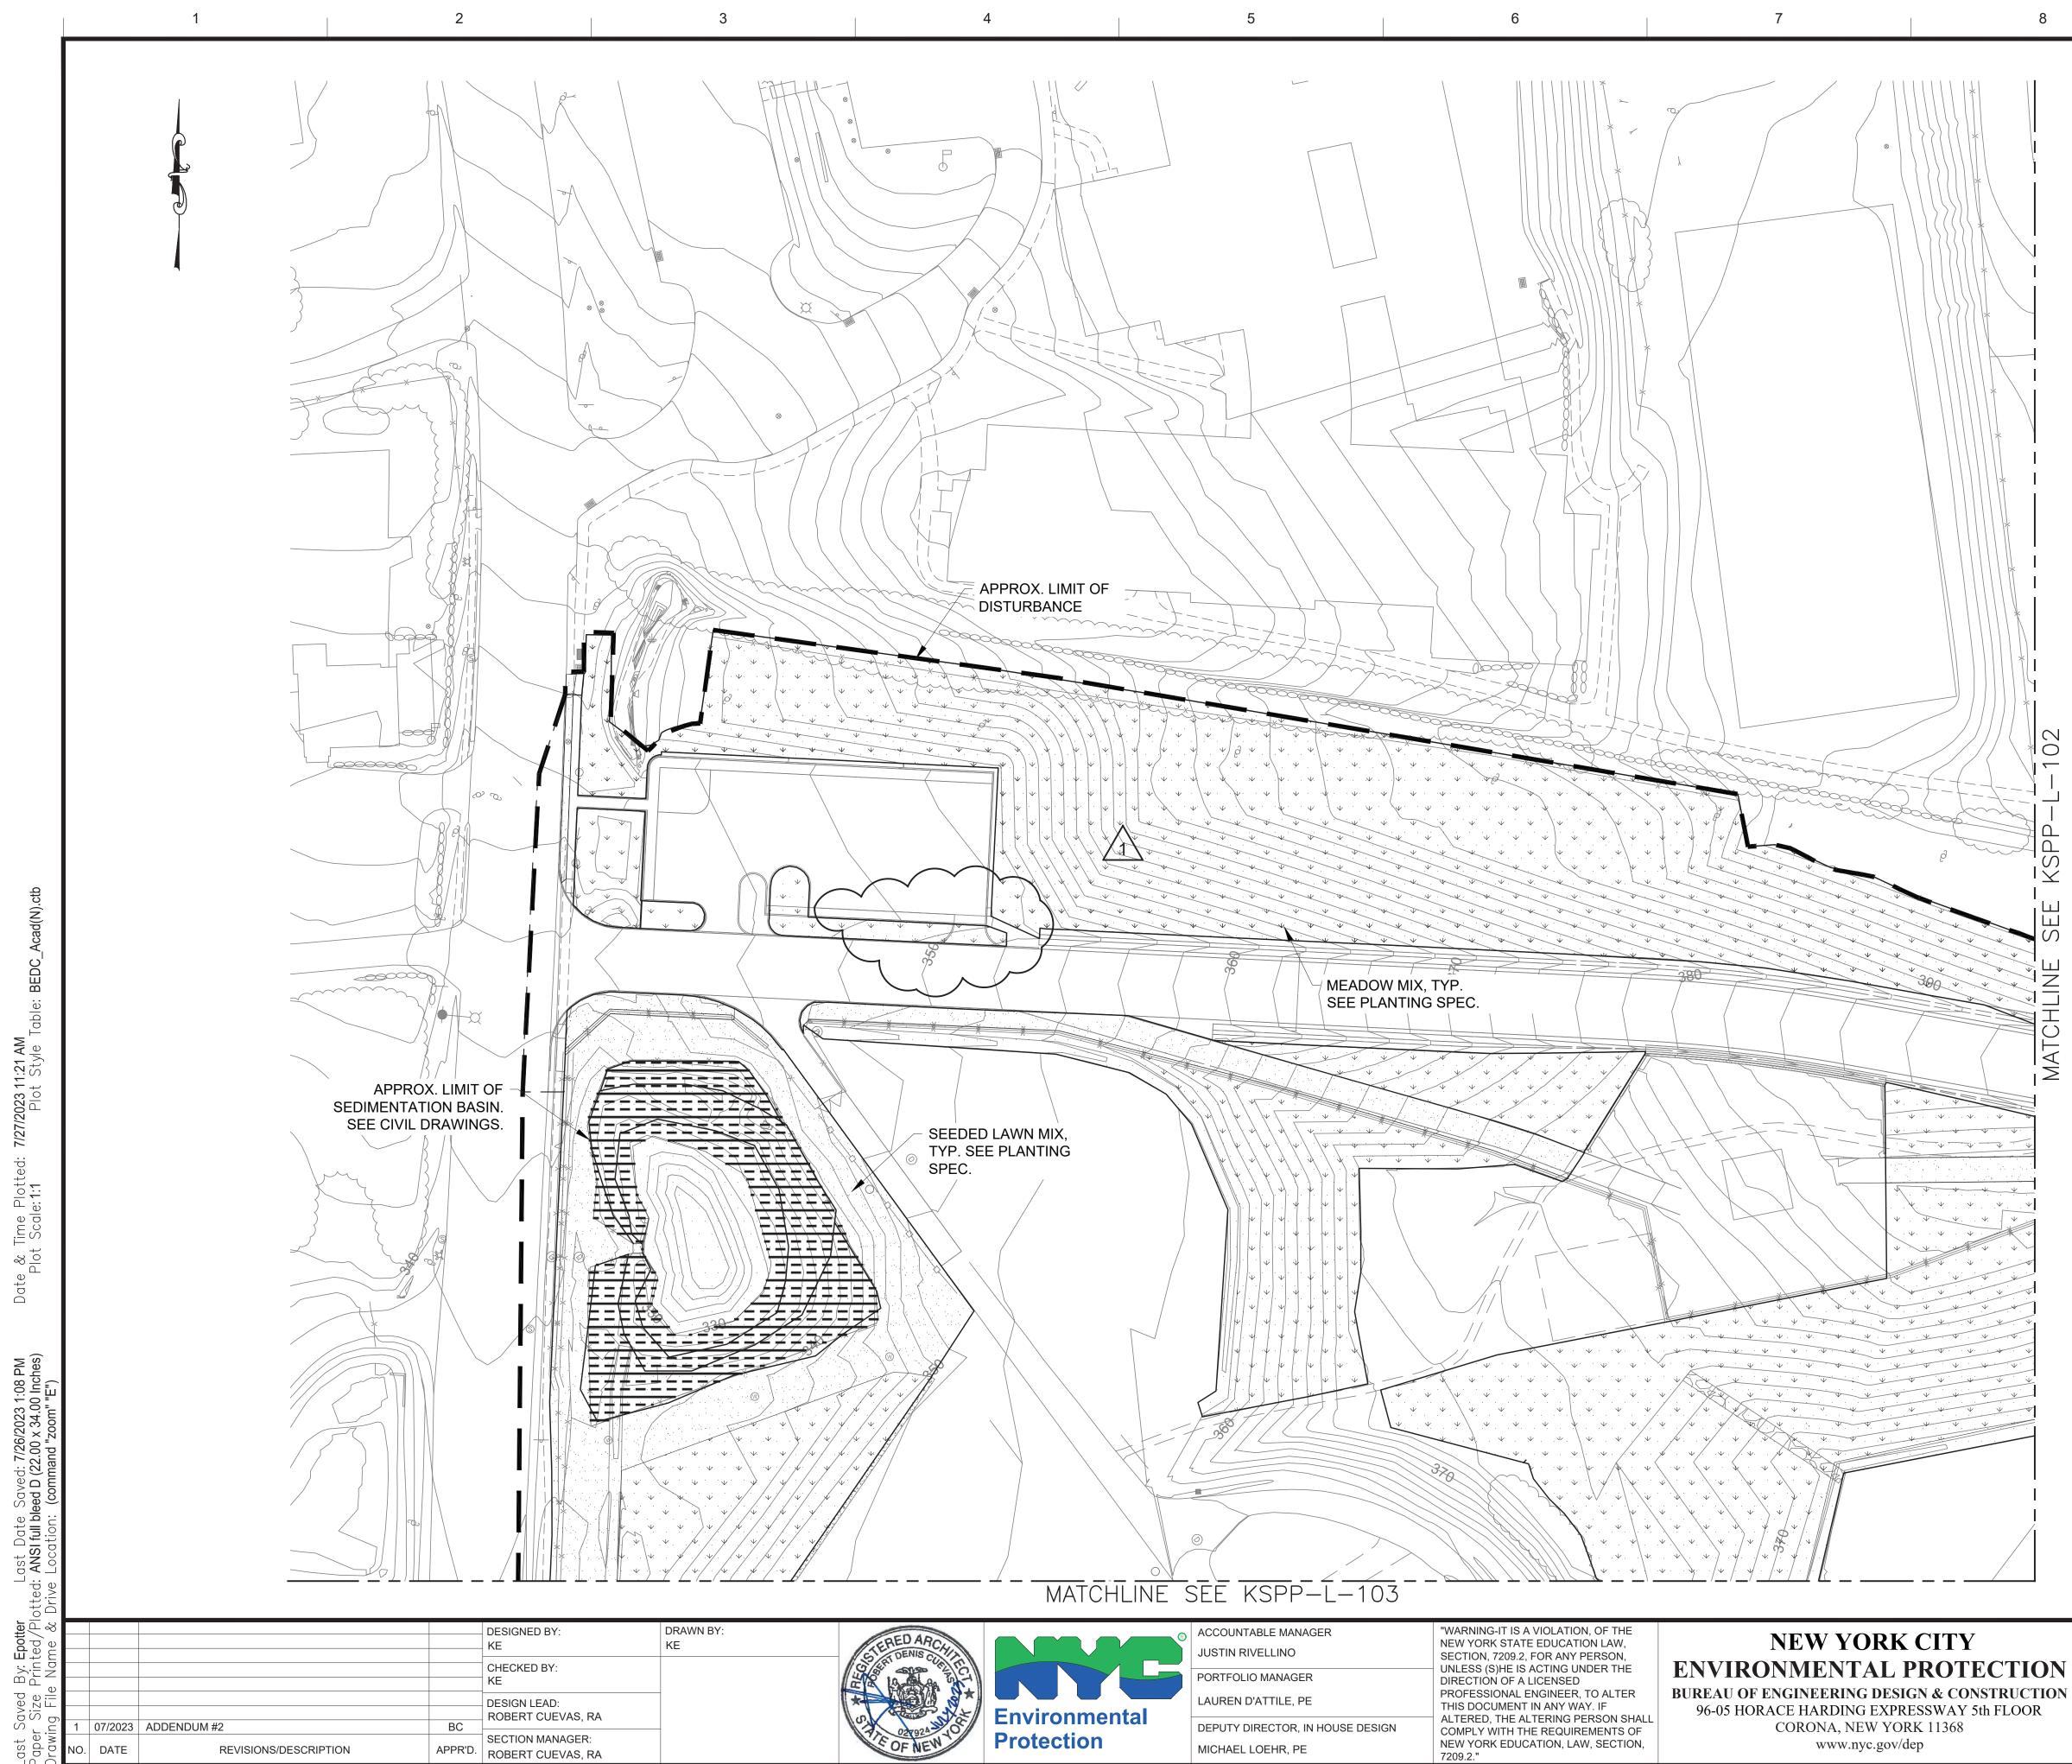

All inquiries regarding this drawing(s) or project should be made to NYC Environmental Protection, Bureau of Engineering Design and Construction.

D

**NOTES:** 


1. SEE DWG KSPP-L-100 FOR OVERALL LANDSCAPE PLAN


- 2. SEE SPECIFICATIONS FOR SITE PREPARATION, SOIL MIXES, AND AMENDMENTS.
- 3. SOIL MIXES TO BE PLACED IN 6 INCH LIFTS.

4. MINIMUM DEPTH OF SOIL MIX FOR ALL TREE AND SHRUB AREAS TO BE 18 INCHES. MINIMUM DEPTH OF SOIL MIX FOR ALL TURF AND MEADOW MIX AREAS TO BE 6 INCHES.

5. LAYOUT OF PLANT MATERIAL TO BE APPROVED BY THE ENGINEER/ARCHITECT PRIOR TO INSTALLATION.

PLANTING LEGEND	
MOWED TURF	
MEADOW MIX	
RETENTION AND POND MIX	

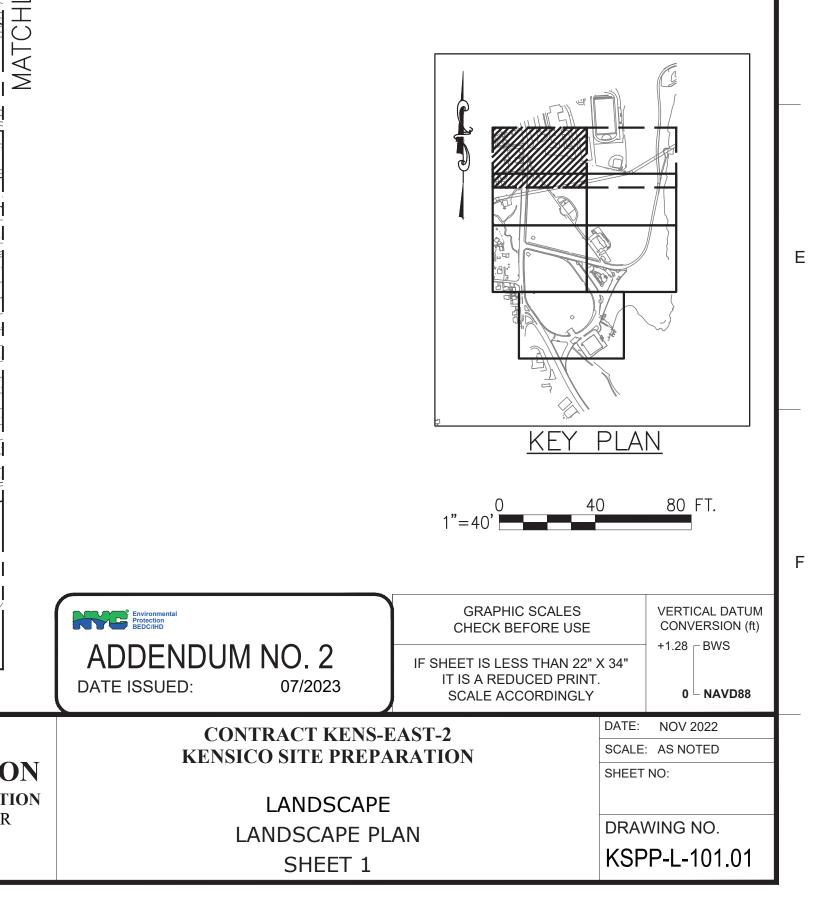

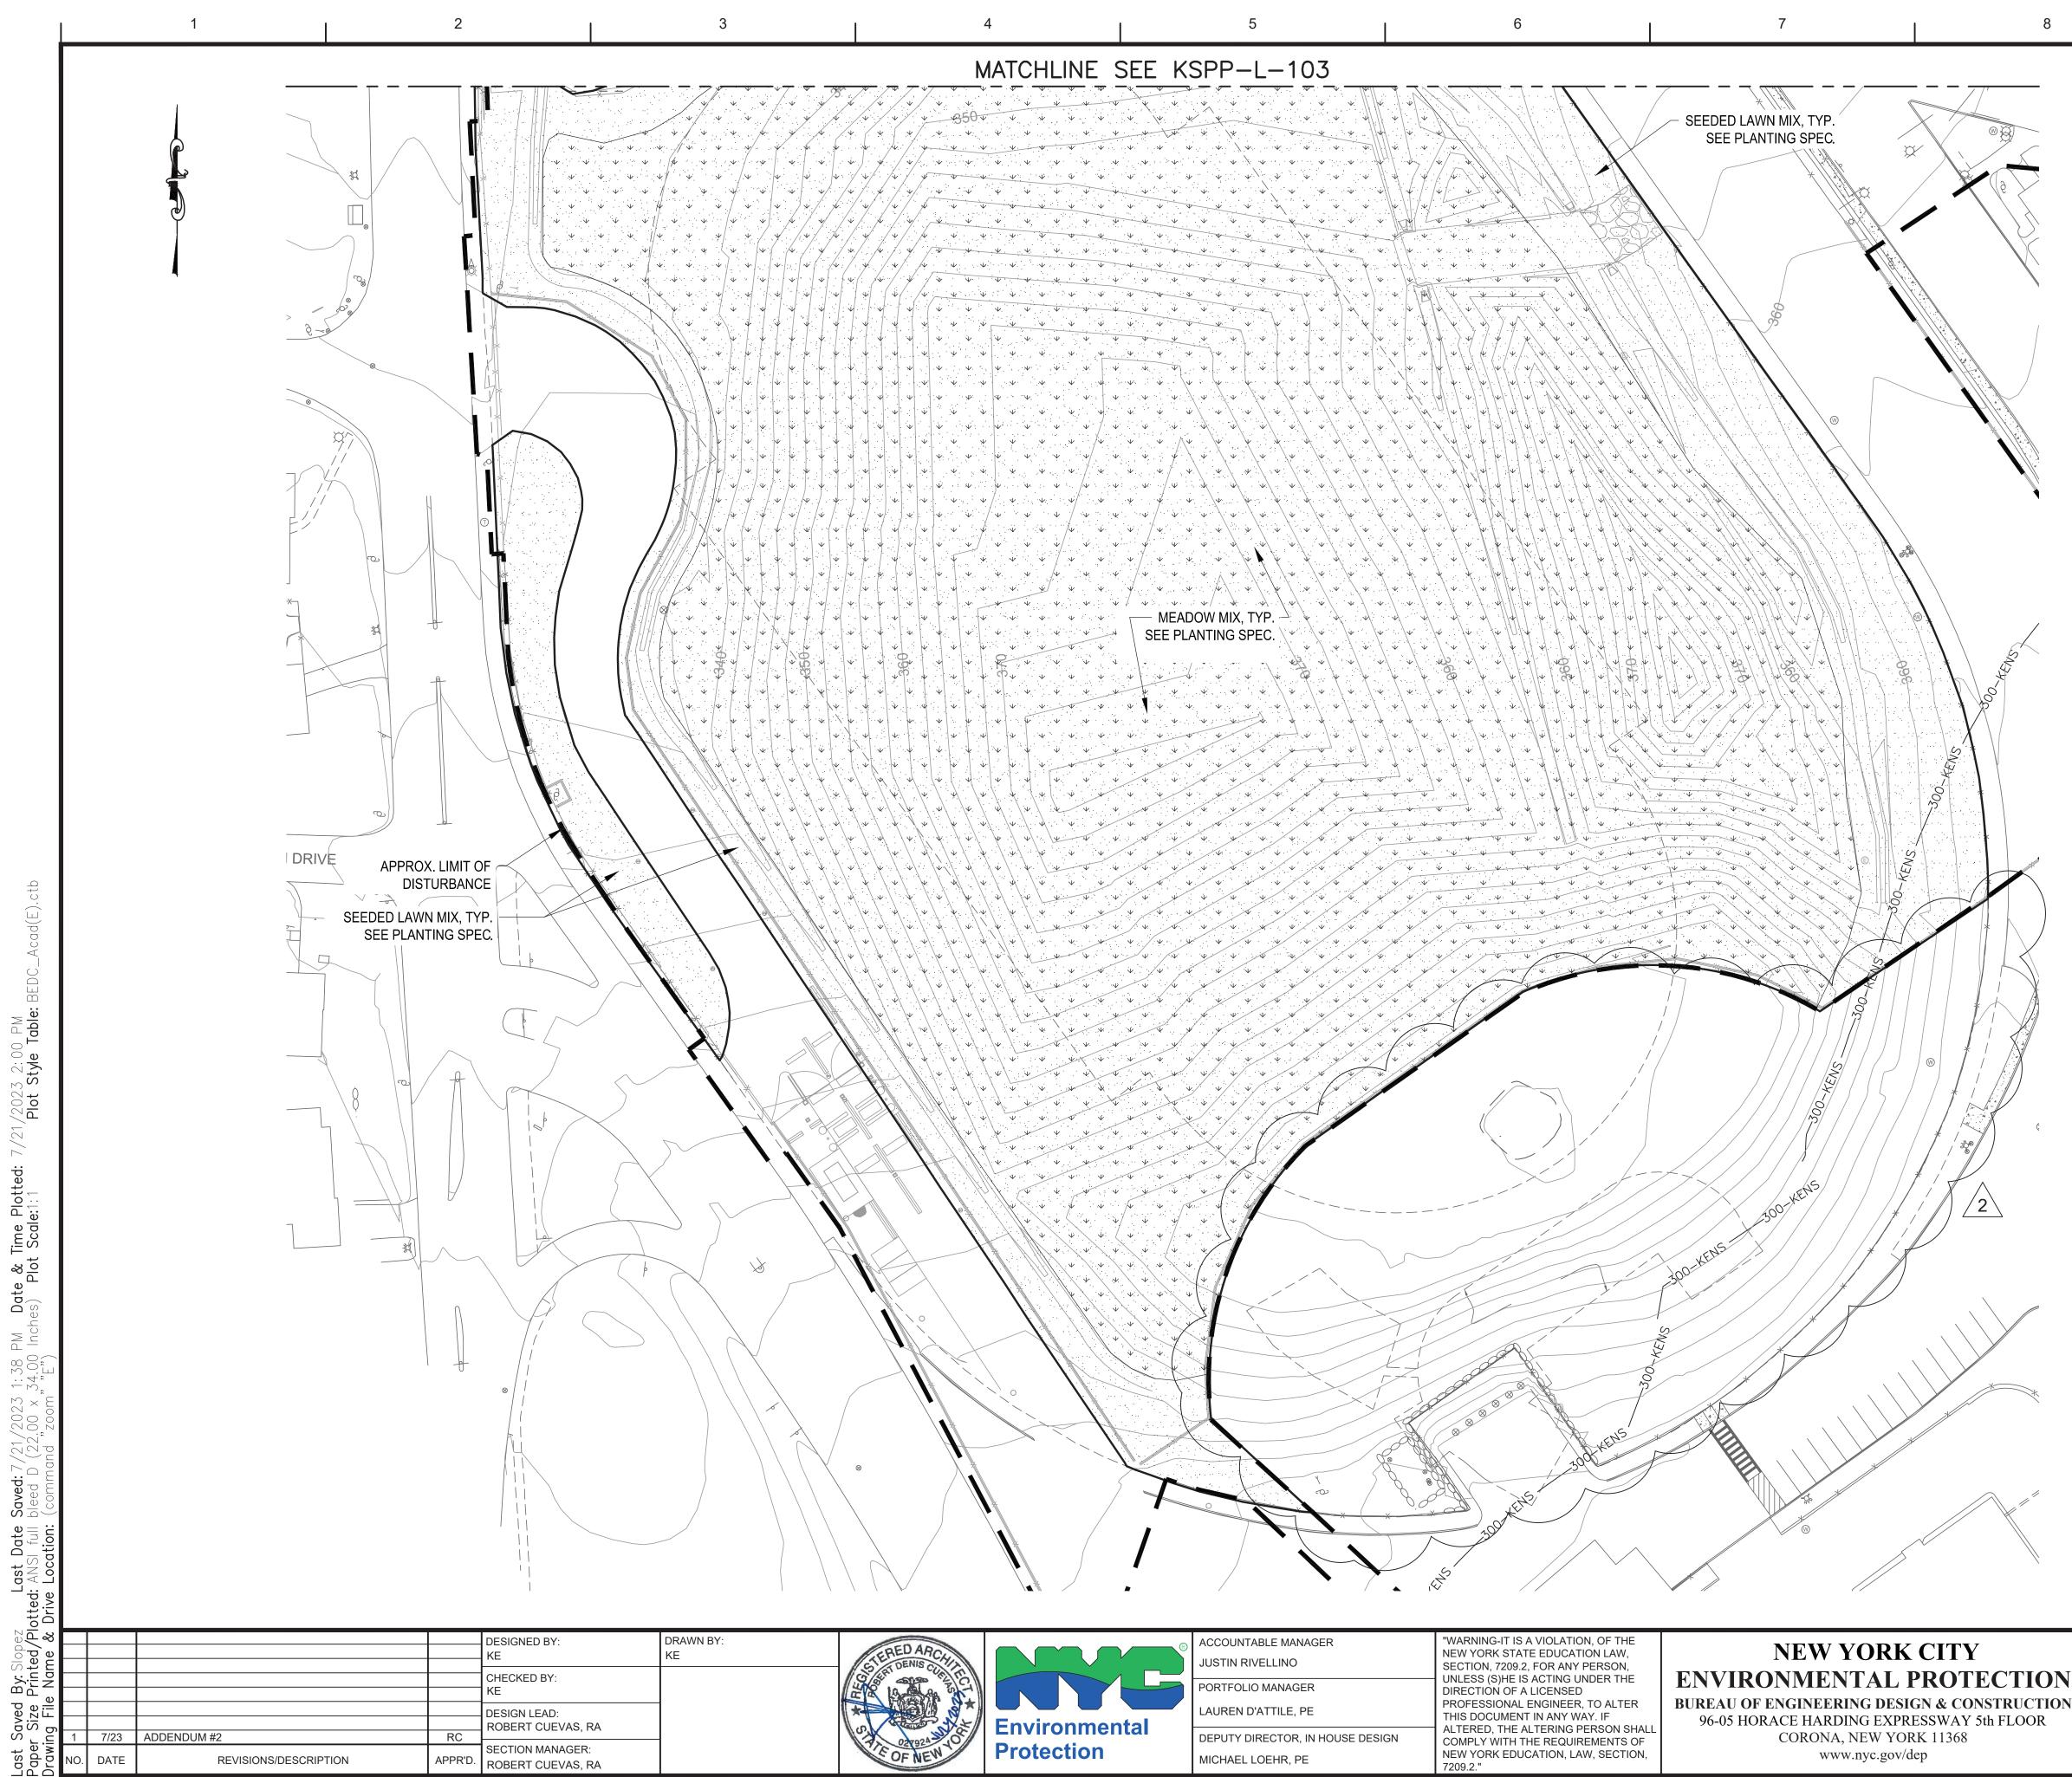

96-05 HORACE HARDING EXPRESSWAY 5th FLOOR

		1"=40' <u>4</u>	0	80 FT.
ĺ	Environmental Protection BEDC/IHD	GRAPHIC SCALES CHECK BEFORE USE		
	ADDENDUM NO. 2 DATE ISSUED: 07/2023	IF SHEET IS LESS THAN 22" IT IS A REDUCED PRINT SCALE ACCORDINGLY		+1.28 BWS 0 NAVD88
N	CONTRACT KENS-EAST-2		DATE: NOV 2022	
	<b>KENSICO SITE PREPA</b>	RATION	SCALE: AS NOTED SHEET NO:	
N	LANDSCAPE			
	LANDSCAPE PLAN SHEET 5		DRAWING NO.	
			KSPP-L-105.01	

NOTES:

1. SEE DWG KSPP-L-100 FOR OVERALL LANDSCAPE PLAN

- 2. SEE SPECIFICATIONS FOR SITE PREPARATION, SOIL MIXES, AND AMENDMENTS.
- 3. SOIL MIXES TO BE PLACED IN 6 INCH LIFTS.

4. MINIMUM DEPTH OF SOIL MIX FOR ALL TREE AND SHRUB AREAS TO BE 18 INCHES. MINIMUM DEPTH OF SOIL MIX FOR ALL TURF AND MEADOW MIX AREAS TO BE 6 INCHES.

5. LAYOUT OF PLANT MATERIAL TO BE APPROVED BY THE ENGINEER/ARCHITECT PRIOR TO INSTALLATION.

PLANTING LEGEND	
MOWED TURF	
MEADOW MIX	↓ ↓ ↓ ↓ ↓ ↓ ↓ ↓ ↓ ↓
RETENTION AND POND MIX	

Е

KEY PLAN

10