



ASBESTOS ABATEMENT LEGEND

VENTILATOR REPLACEMENTS.

VENTILATOR REPLACEMENTS.

REMOVE AND DISPOSE OF ASBESTOS CONTAINING (ACM) FLOOR TILES & ASSOCIATED MASTIC TO FACILITATE UNIT

REMOVE AND DISPOSE OF ASBESTOS CONTAINING PIPE INSULATION AND/OR MUDDED JOINTS TO FACILITATE UNIT

REMOVE AND DISPOSE OF ASBESTOS CONTAINING INTERNAL


REMOVE AND DISPOSE OF FIBERGLASS DUCT INSULATION


REFER TO ASBESTOS SPECIFICATIONS SECTION 020800 - SECTION 3.17 FOR A MORE


WITH ASBESTOS CONTAINING PIN MASTIC.

Unit Ventilators - (water and electrical disconnects / UV removal & abatement of floor tile. July 17th through August 2nd

New Floor tile / New UV installation - August 5th through August 23rd

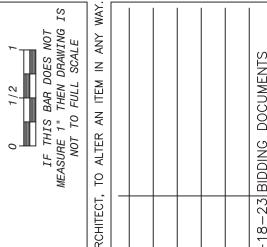


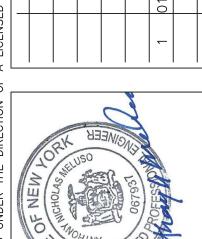


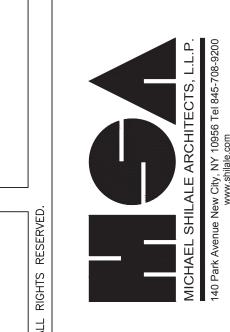

# CONSTRUCTION SEQUENCE PLAN



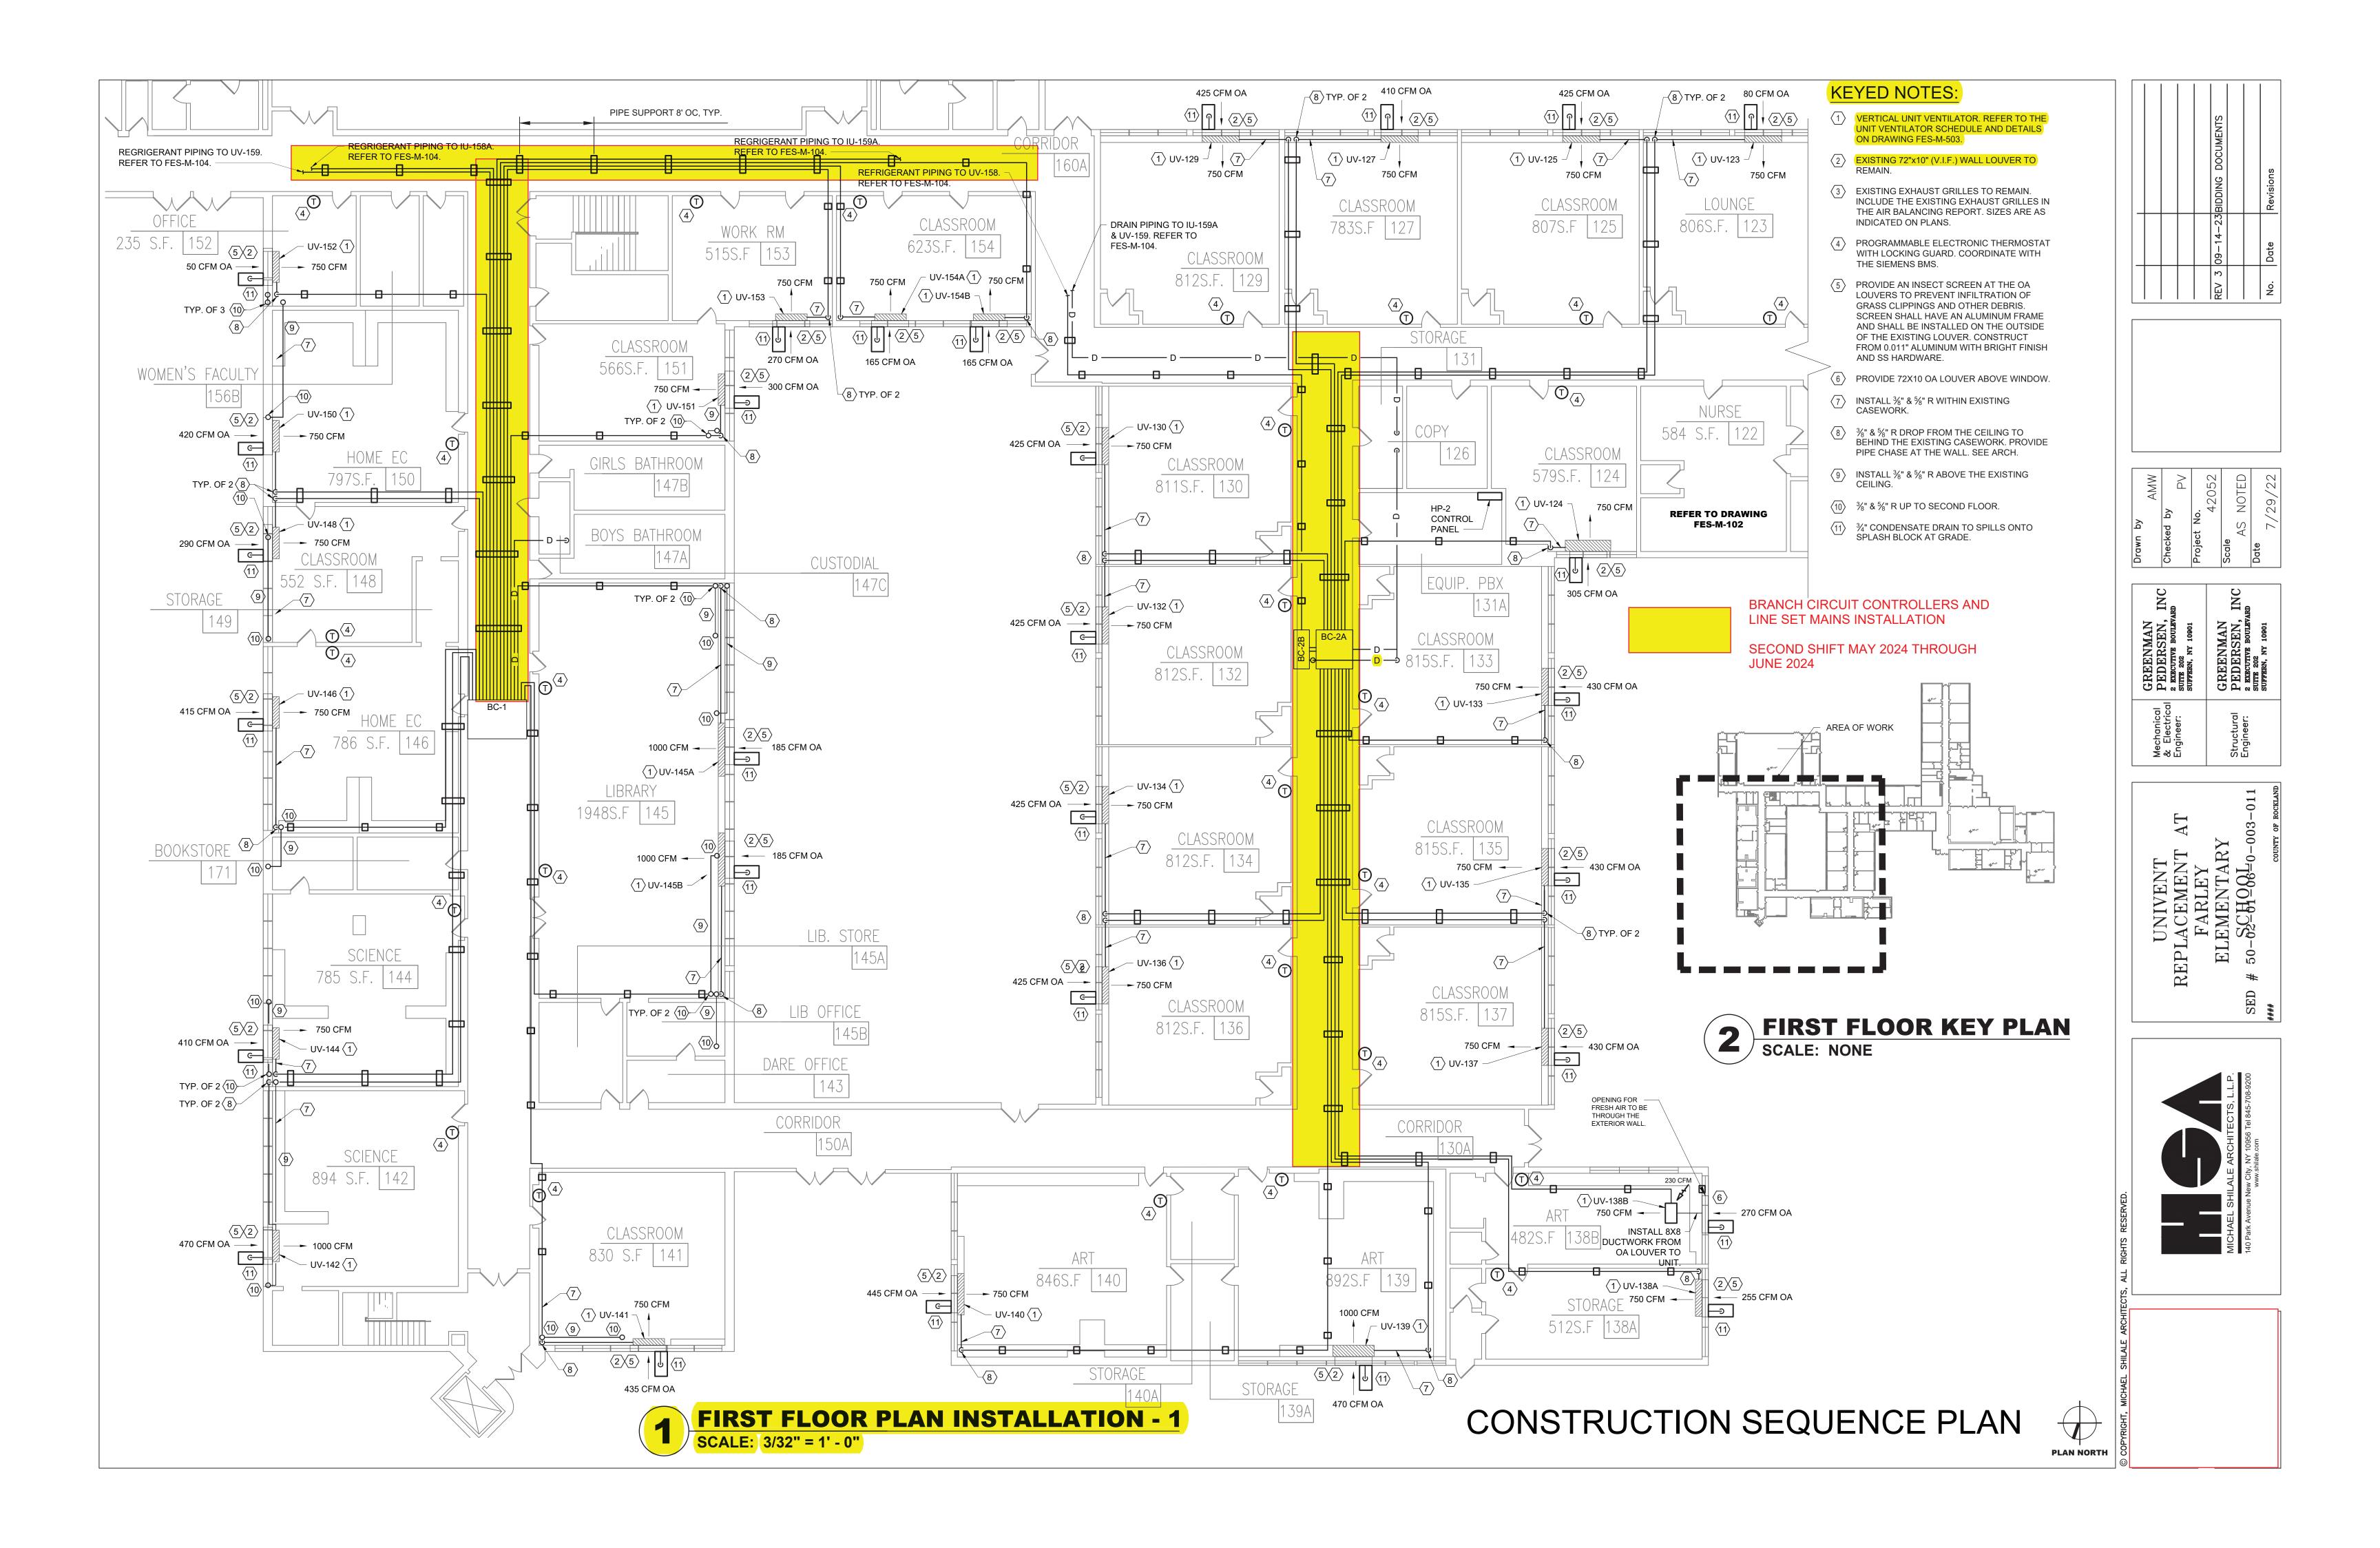

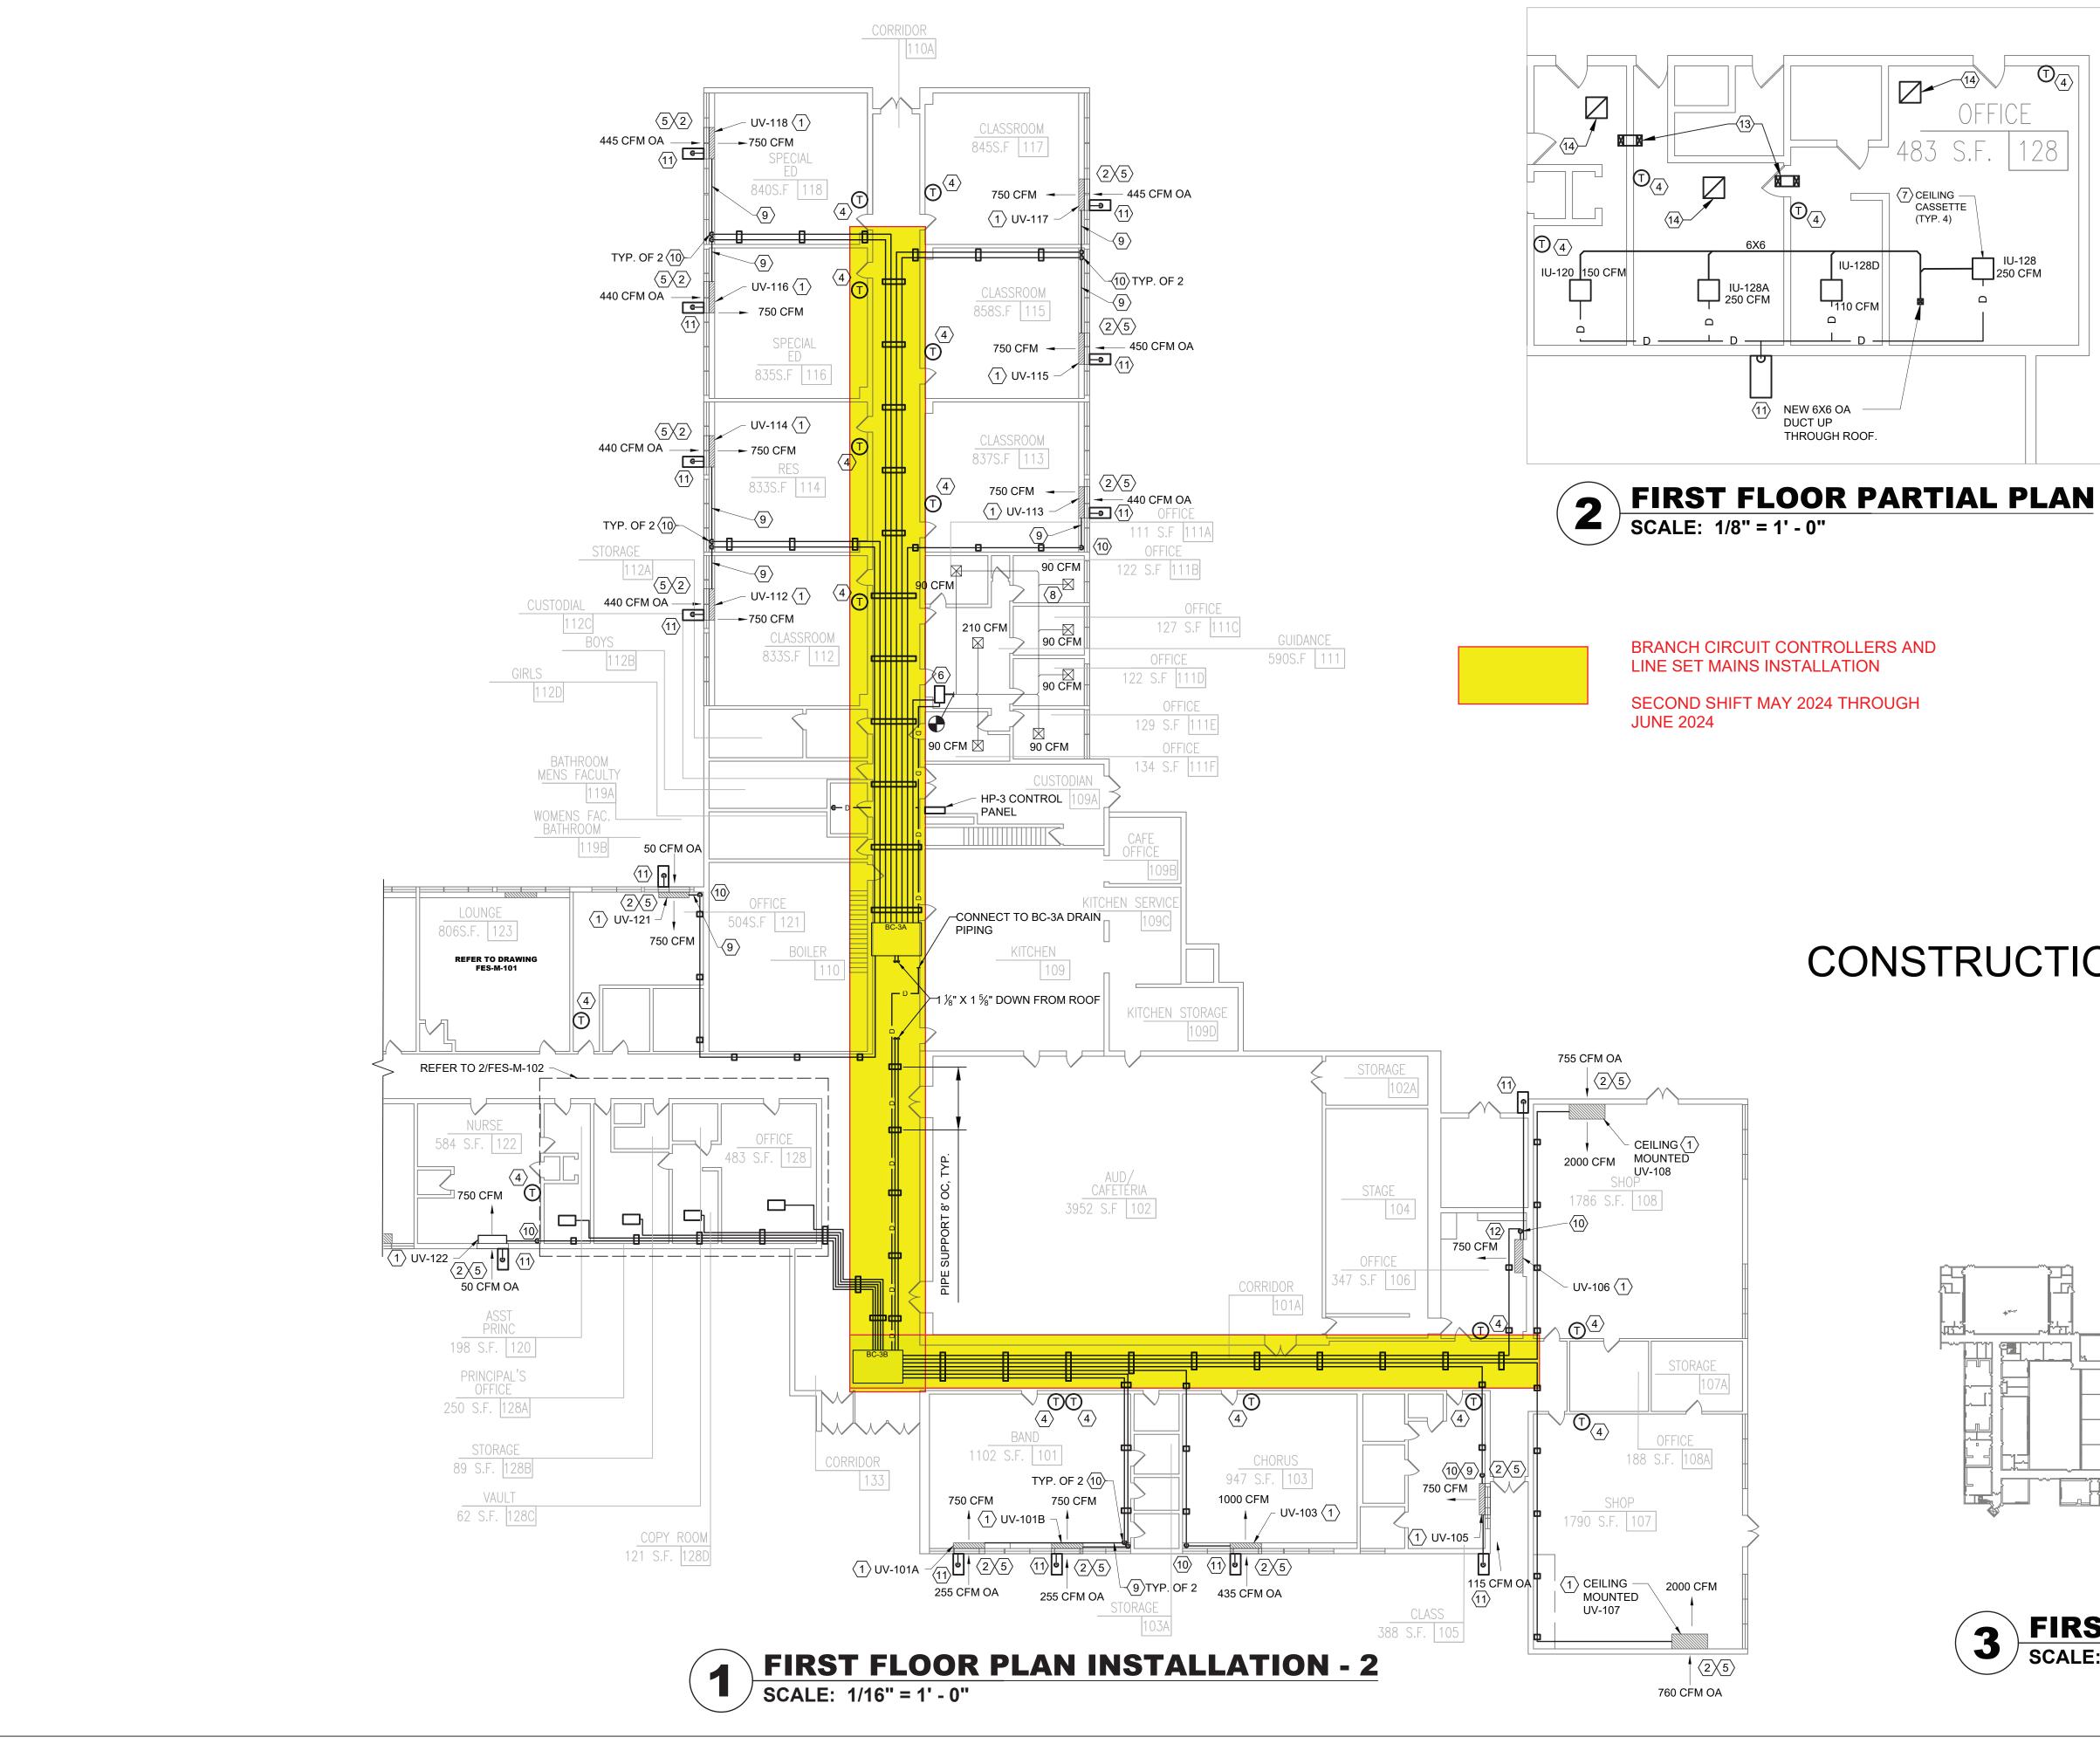

### **KEYED NOTES:**

7 CEILING —

CASSETTE

**□** IU-128

\_\_\_\_250 CFM


- (1) VERTICAL UNIT VENTILATOR. REFER TO THE UNIT VENTILATOR SCHEDULE AND DETAILS ON DRAWING FES-M-503.
- (2) EXISTING 72"x10" (V.I.F.) WALL LOUVER TO REMAIN.
- (3) EXISTING EXHAUST GRILLES TO REMAIN. INCLUDE THE EXISTING EXHAUST GRILLES IN THE AIR BALANCING REPORT. SIZES ARE AS INDICATED ON PLANS.
- PROGRAMMABLE ELECTRONIC THERMOSTAT WITH LOCKING GUARD. COORDINATE WITH THE SIEMENS BMS.
- PROVIDE AN INSECT SCREEN AT THE OA LOUVERS TO PREVENT INFILTRATION OF GRASS CLIPPINGS AND OTHER DEBRIS. SCREEN SHALL HAVE AN ALUMINUM FRAME AND SHALL BE INSTALLED ON THE OUTSIDE OF THE EXISTING LOUVER. CONSTRUCT FROM 0.011" ALUMINUM WITH BRIGHT FINISH AND SS HARDWARE.
- 6 UV-111 TO TIE INTO THE EXISTING SUPPLY & OUTSIDE AIR DUCTWORK.
- (7) CEILING CASSETTE AT CEILING.
- (8) EXISTING CEILING SUPPLY DIFFUSER TO REMAIN. TYPICAL (7).
- 9 INSTALL 3/8" & 5/8" R WITHIN EXISTING CASEWORK.
- 3/8" & 5/8" R DROP FROM THE CEILING TO BEHIND THE EXISTING CASEWORK. PROVIDE PIPE CHASE AT THE WALL. SEE ARCH.
- (11) 3/4" CONDENSATE DRAIN TO SPILLS ONTO SPLASH BLOCK AT GRADE.
- PROVIDE UNIT VENTILATOR WITH CONDENSATE LIFT PUMP.
- 12"x6" TRANSFER DUCT ABOVE CEILING (PRICE CROSS TALK SILENCER XT OR EQUAL)
- (14) 24'x24' RG AT CEILING.

# AW AW ED ED 22

AN	Checked by	Project No.	420	Scale	AS NOTE	Date	7/29/
ر	ر			7	<u>۔</u>		


GREENMAN PEDERSEN, INC 2 EXECUTIVE BOULEVARD SUITE 202 SUFFERN, NY 10901	GREENMAN PEDERSEN, INC 2 EXECUTIVE BOULEVARD SUITE 202 SUFFERN, NY 10901
Mechanical & Electrical Engineer:	Structural Engineer:

### CONSTRUCTION SEQUENCE PLAN

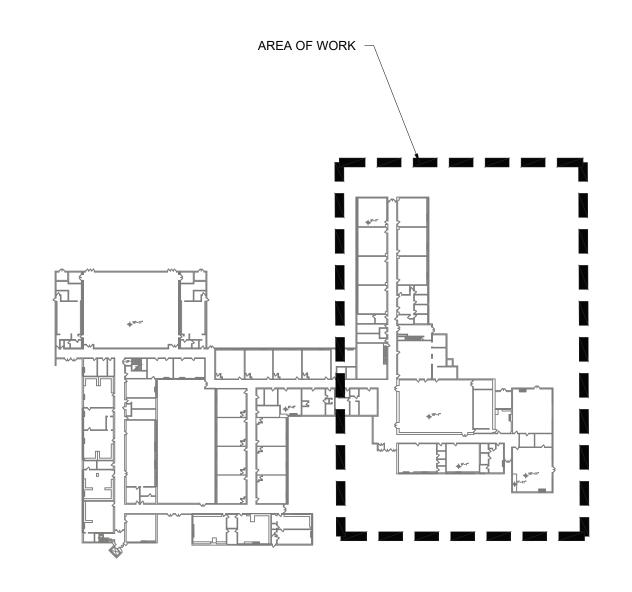







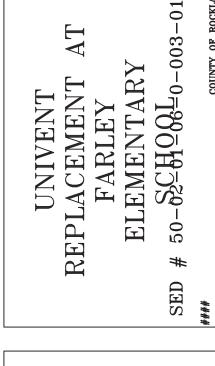




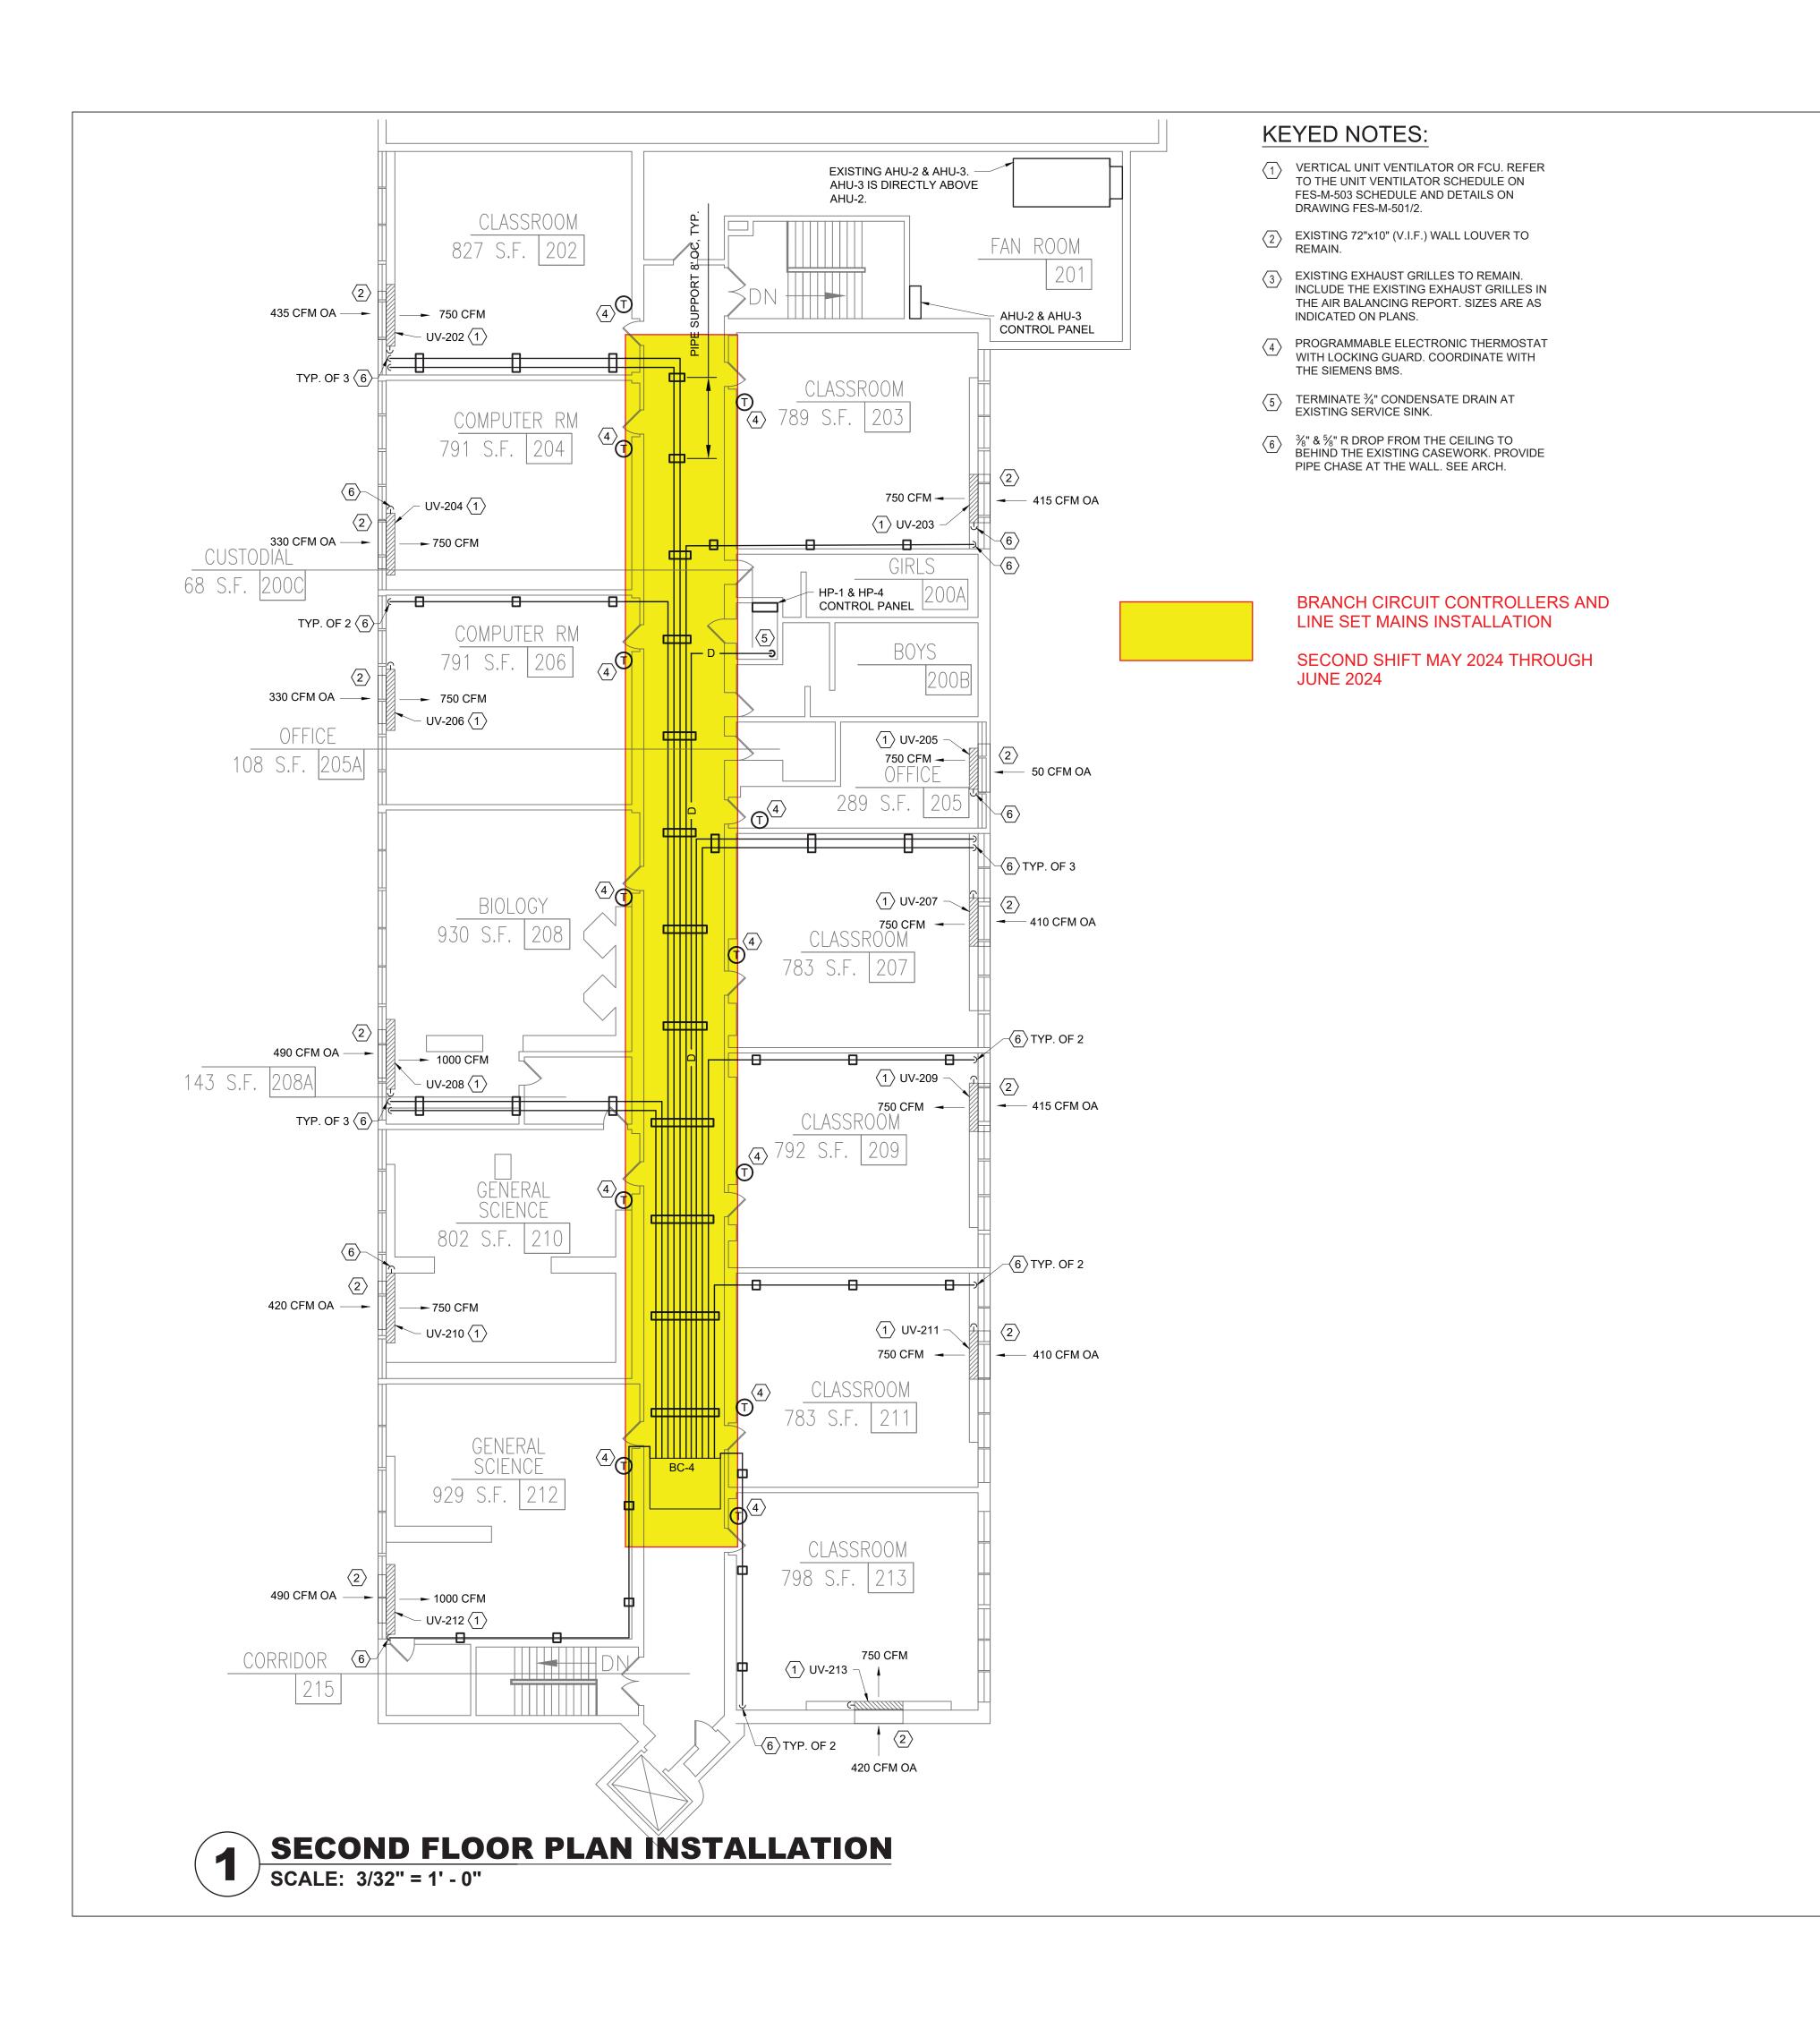


# CONSTRUCTION SEQUENCE PLAN

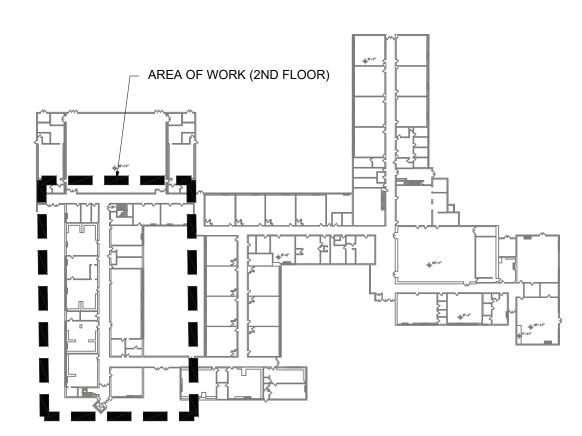



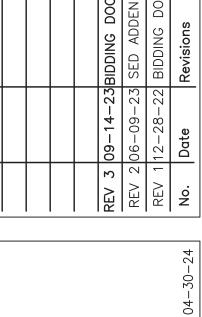

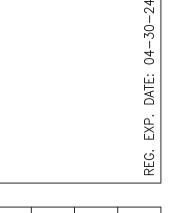

Checked by
PV
Project No.
42052
Scale
AS NOTED
Date


Mechanical
& Electrical
Engineer:
Structural
Structural
Engineer:
Surren, ny 10901


GREENMAN
GREENMAN
Structural
PEDERSEN, INC
2 EXECUTIVE BOULEVARD
SURFERN, ny 10901
SURFERN, ny 10901


UNIVENT
REPLACEMENT AT
FARLEY
ELEMENTARY
SED # 50-&CHQ&L0-003-011







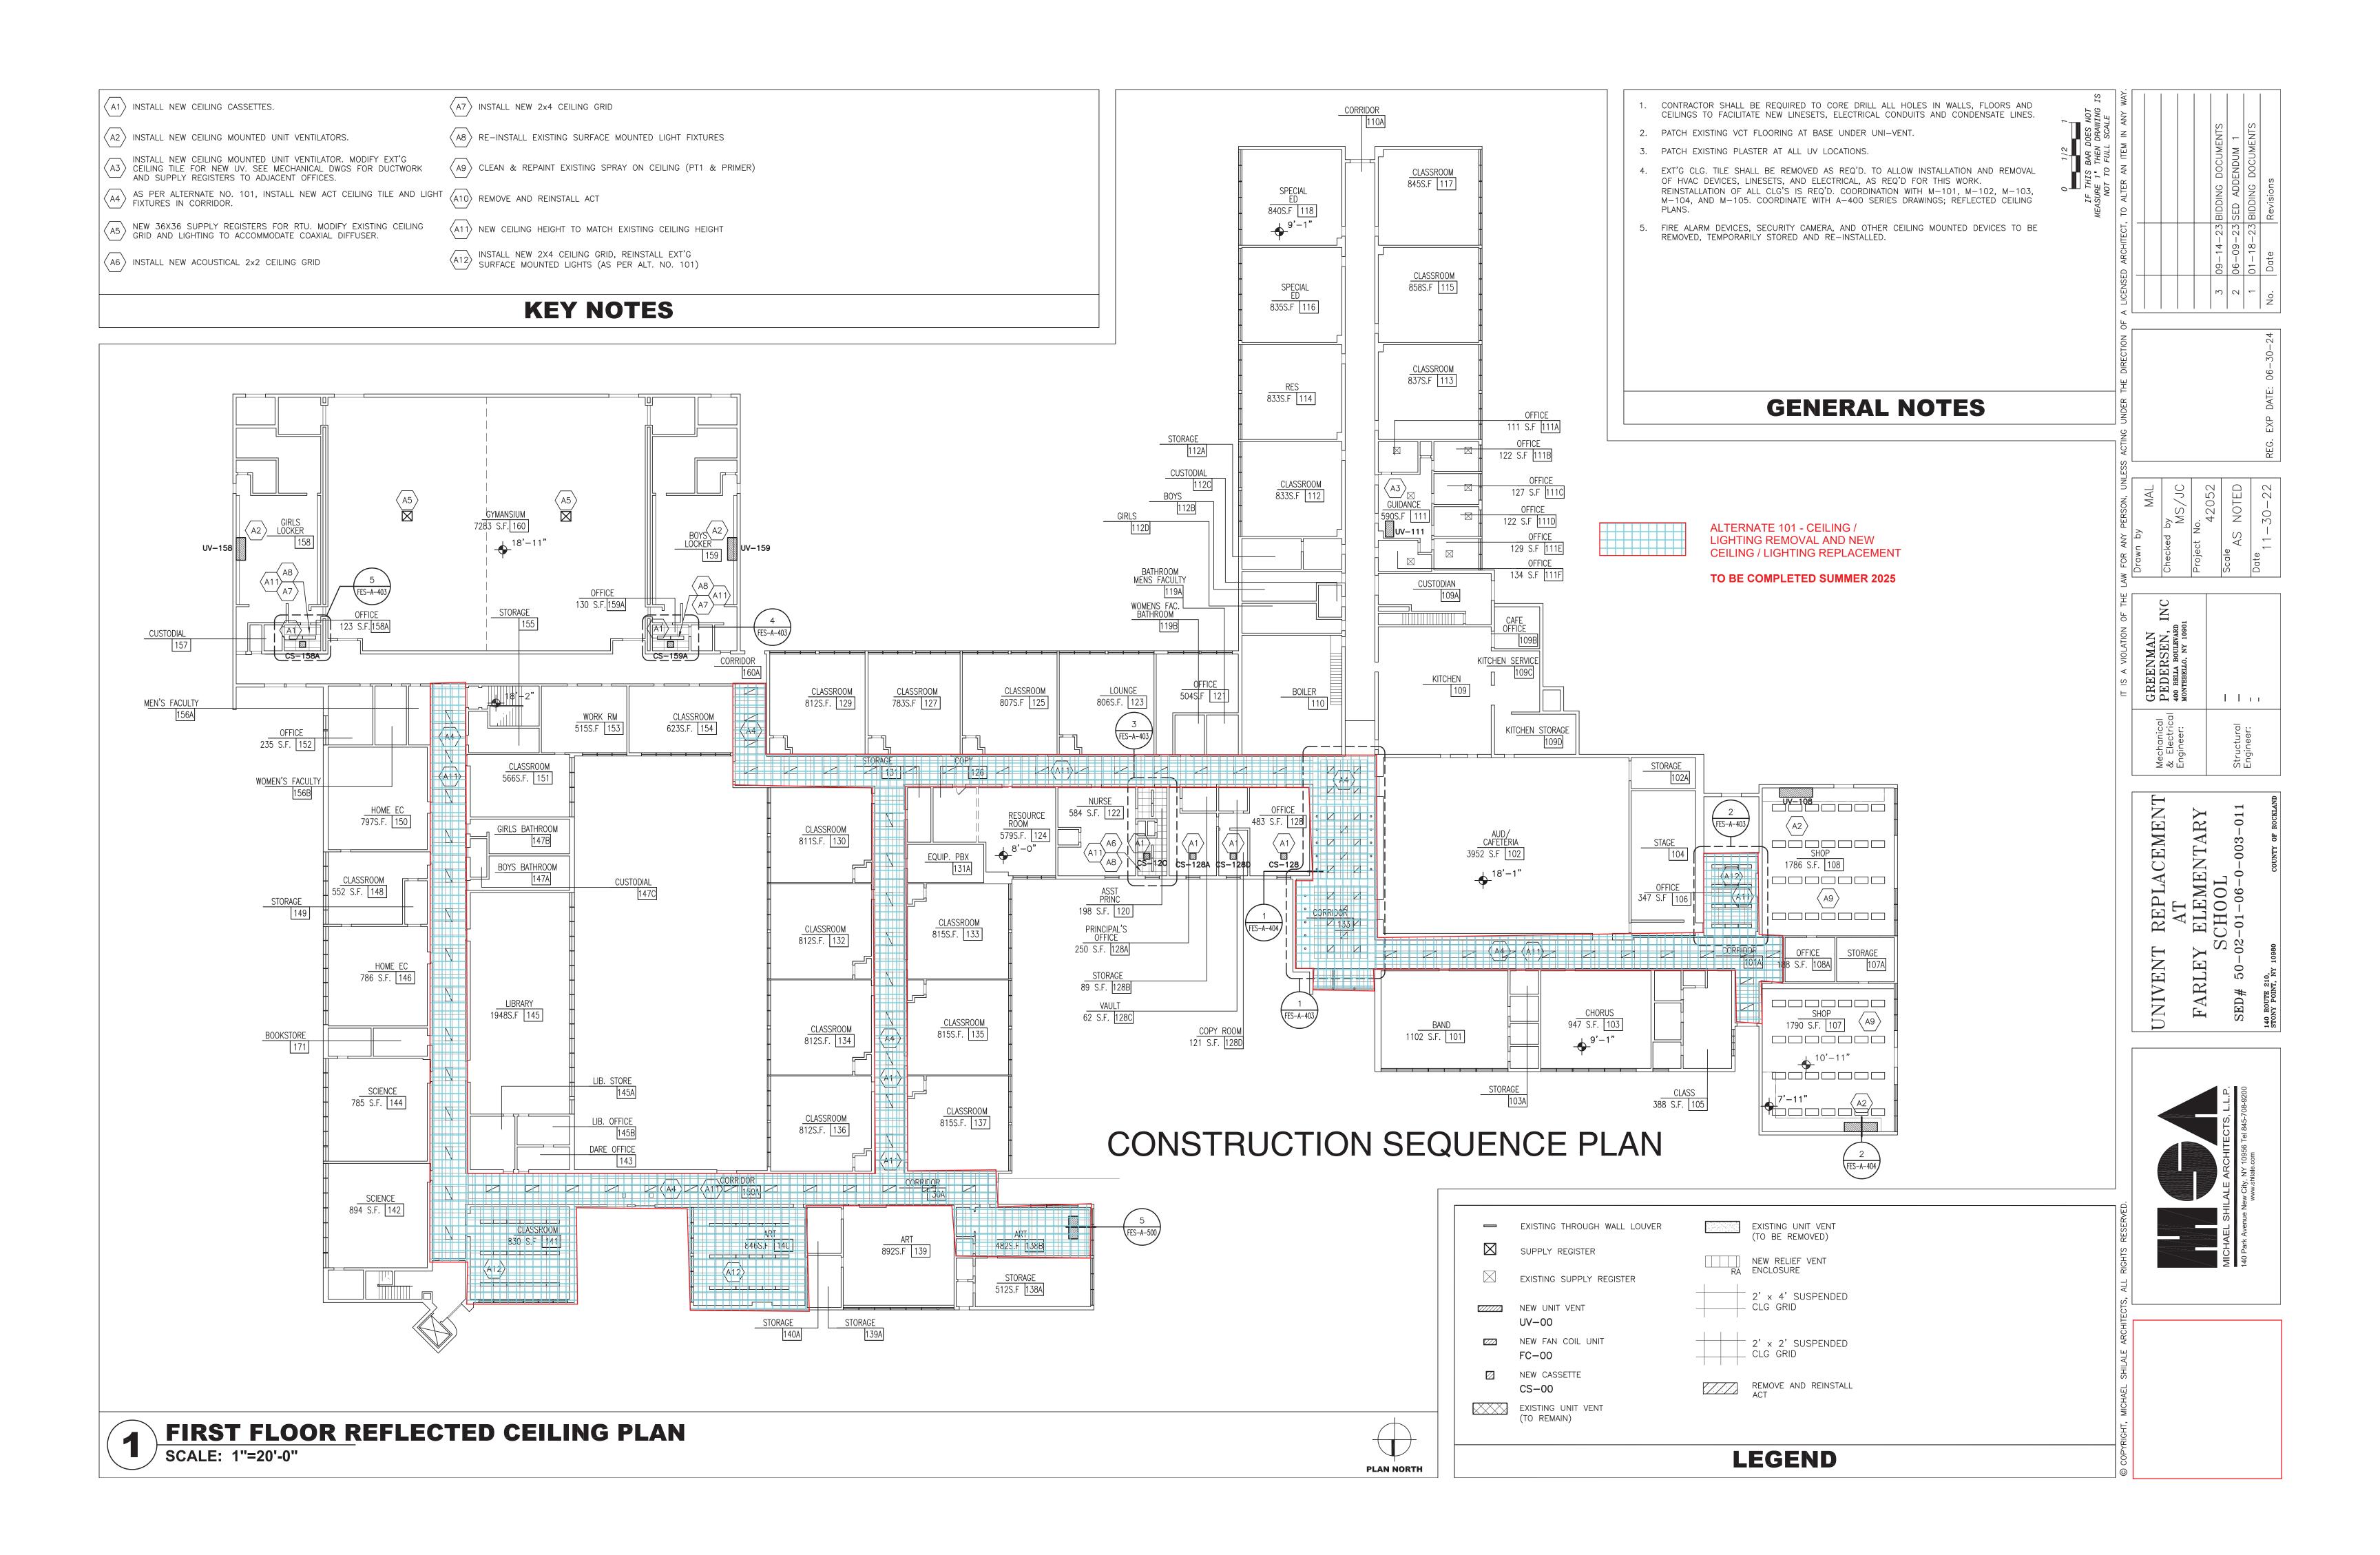

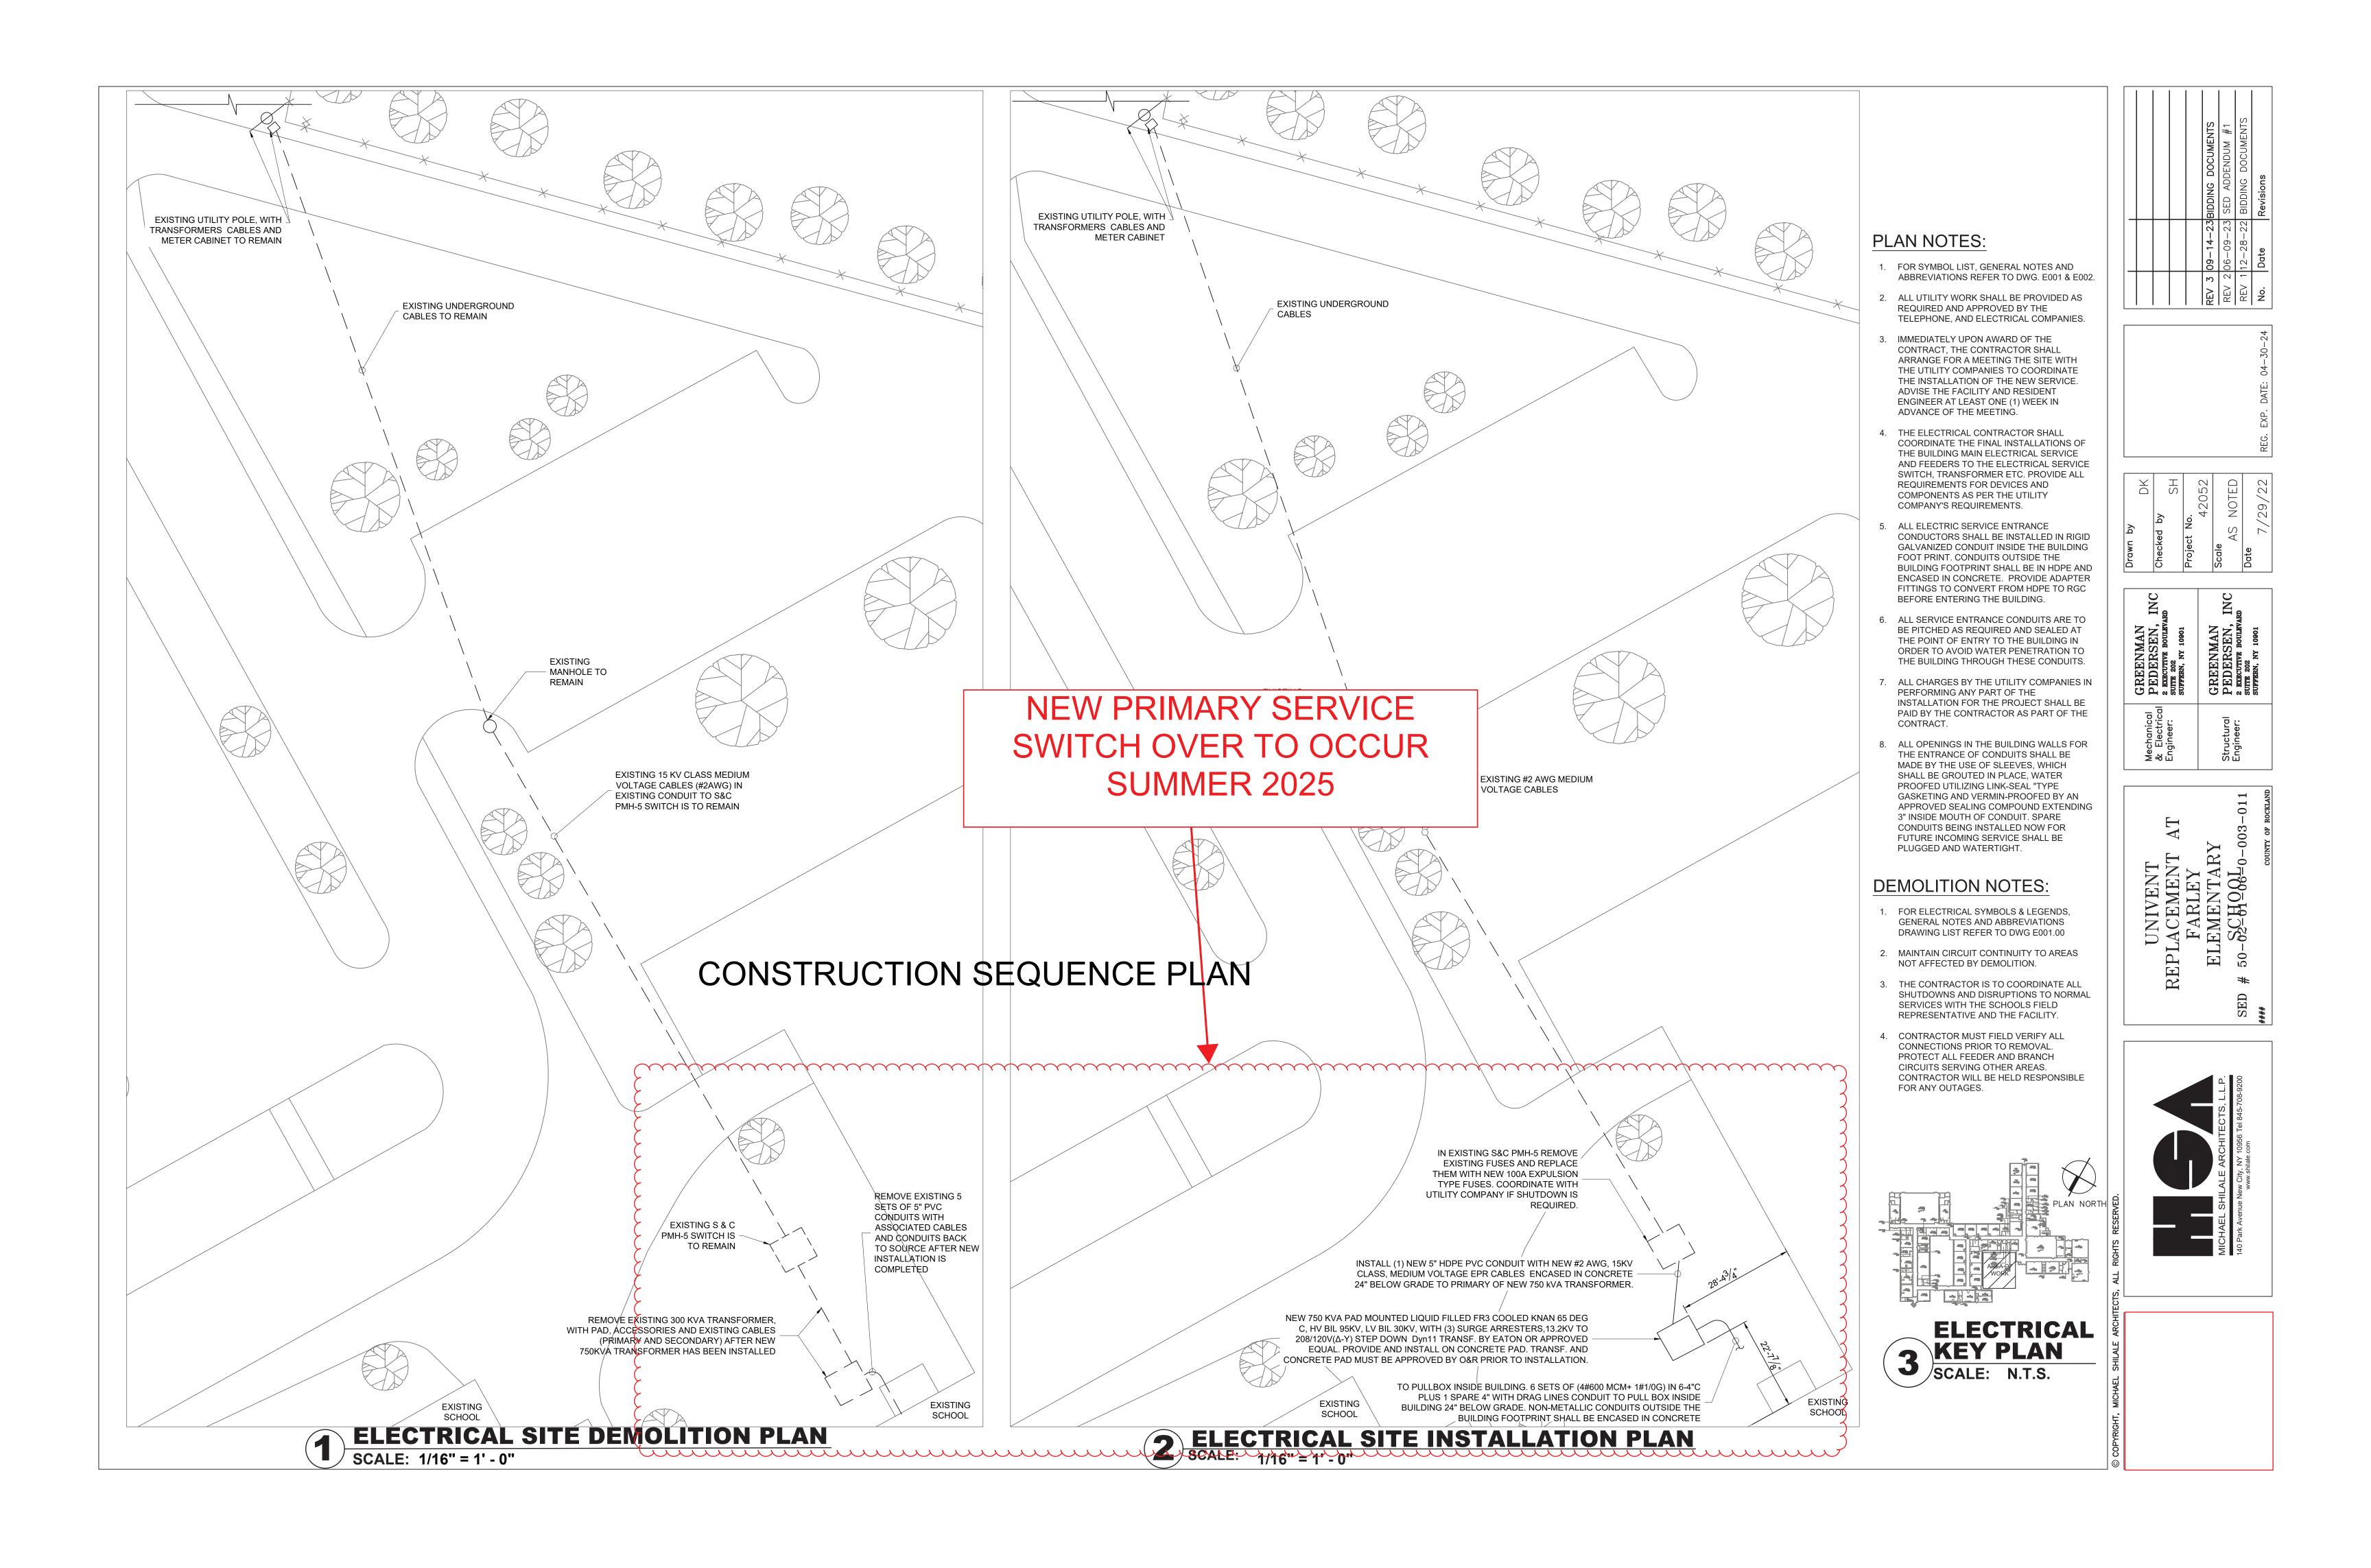


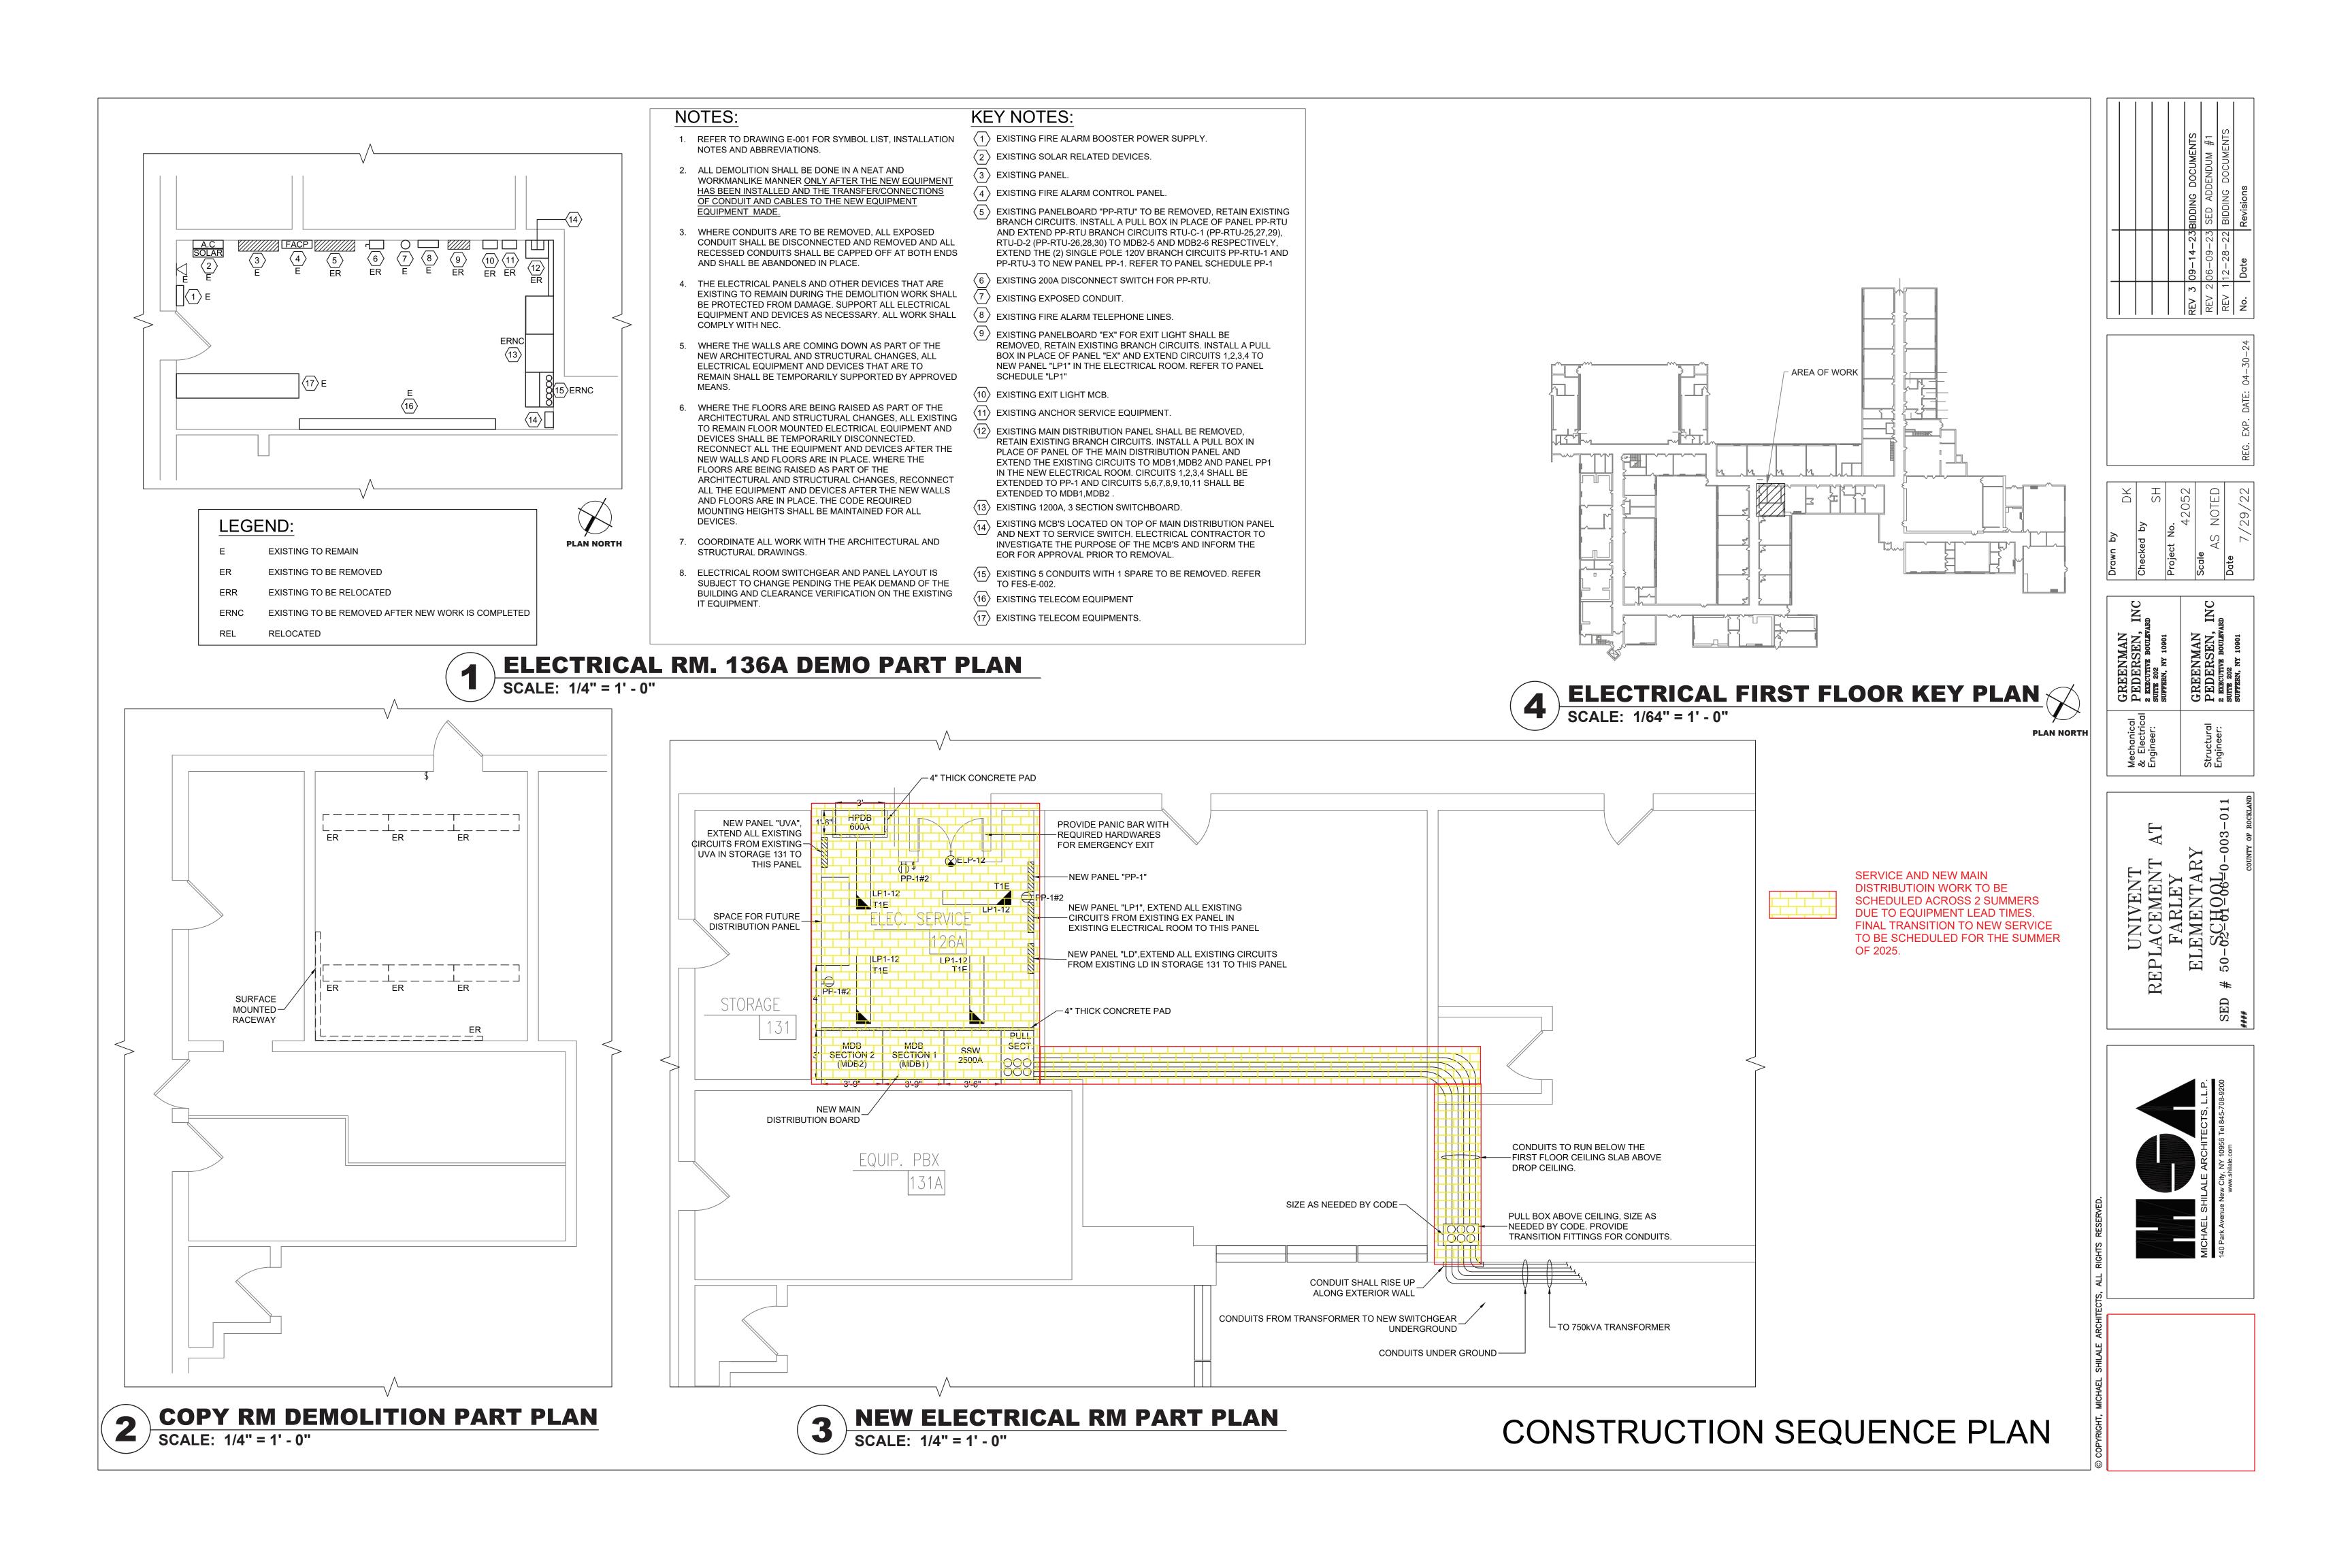

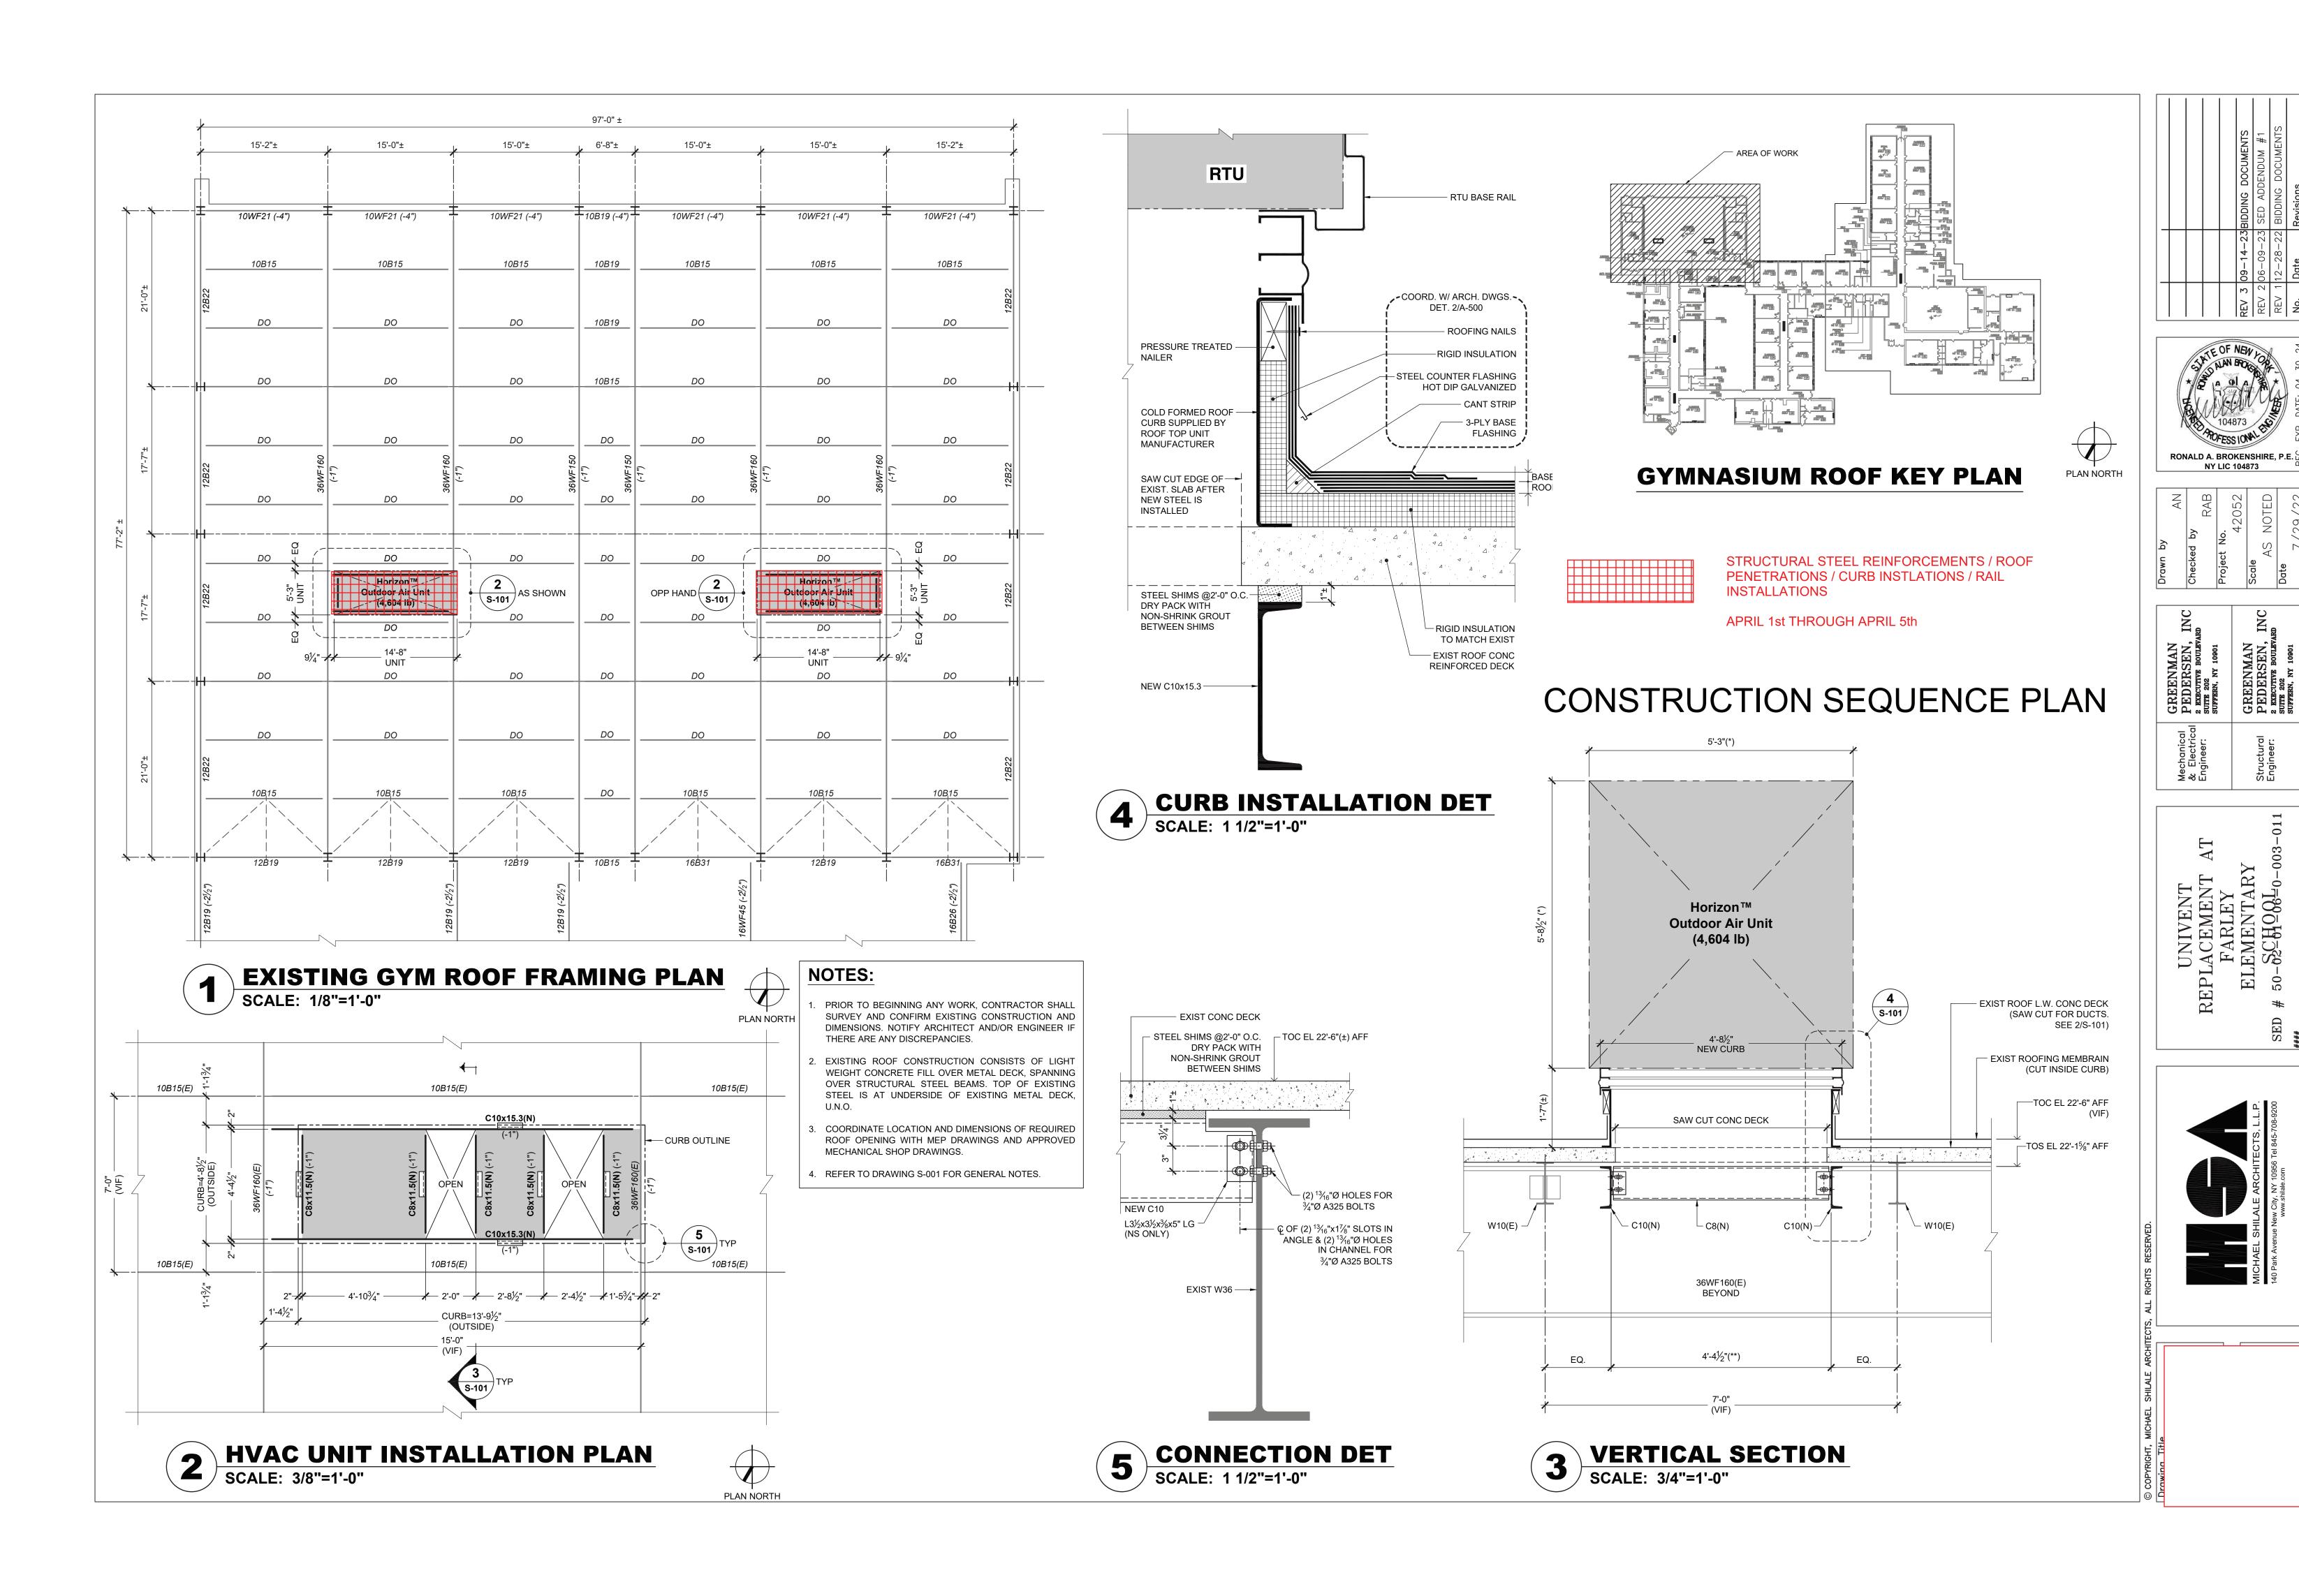

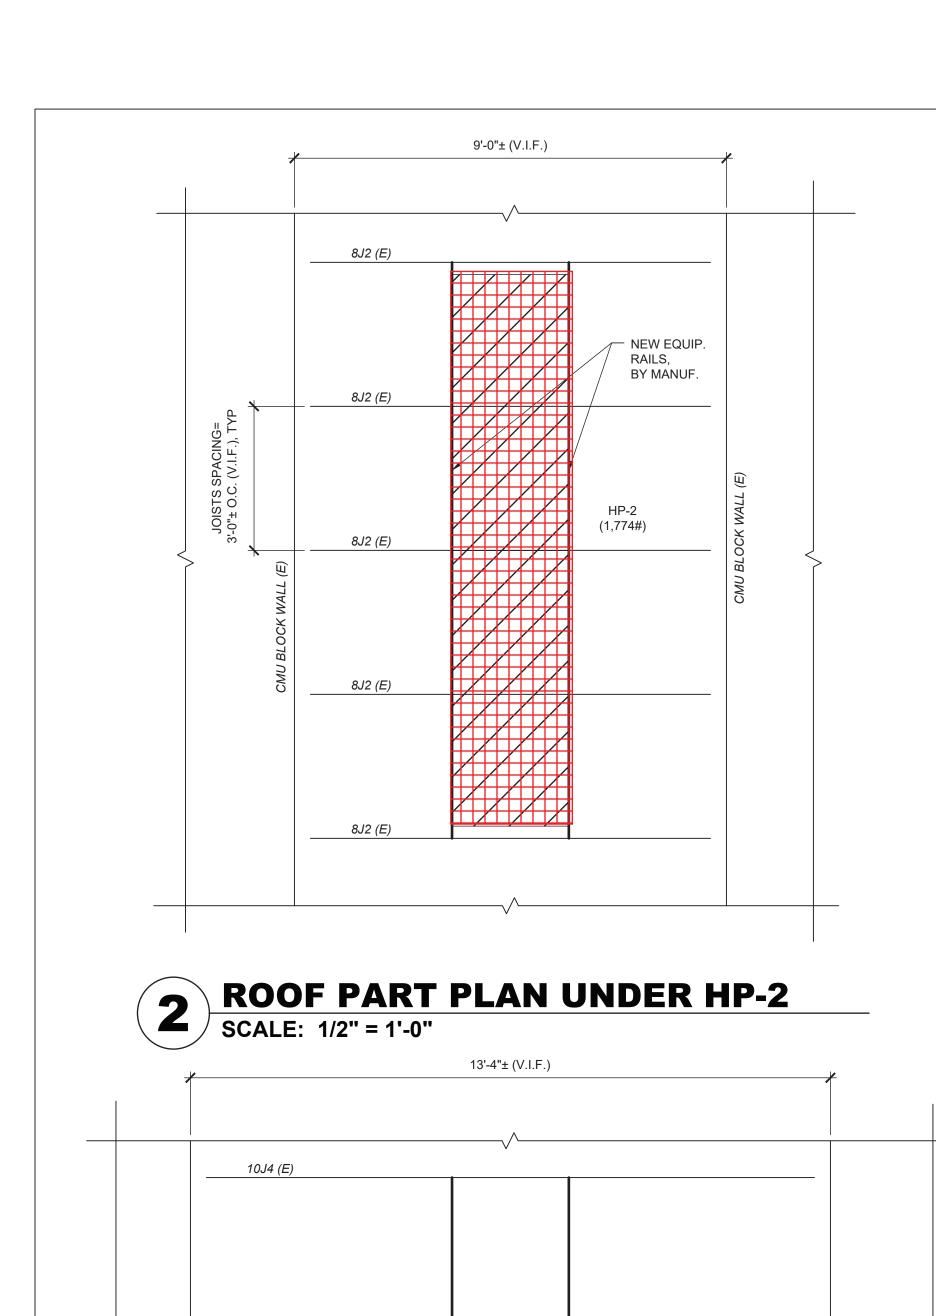

ROOF PART PLAN UNDER HP-1
SCALE: 1/2" = 1'-0"

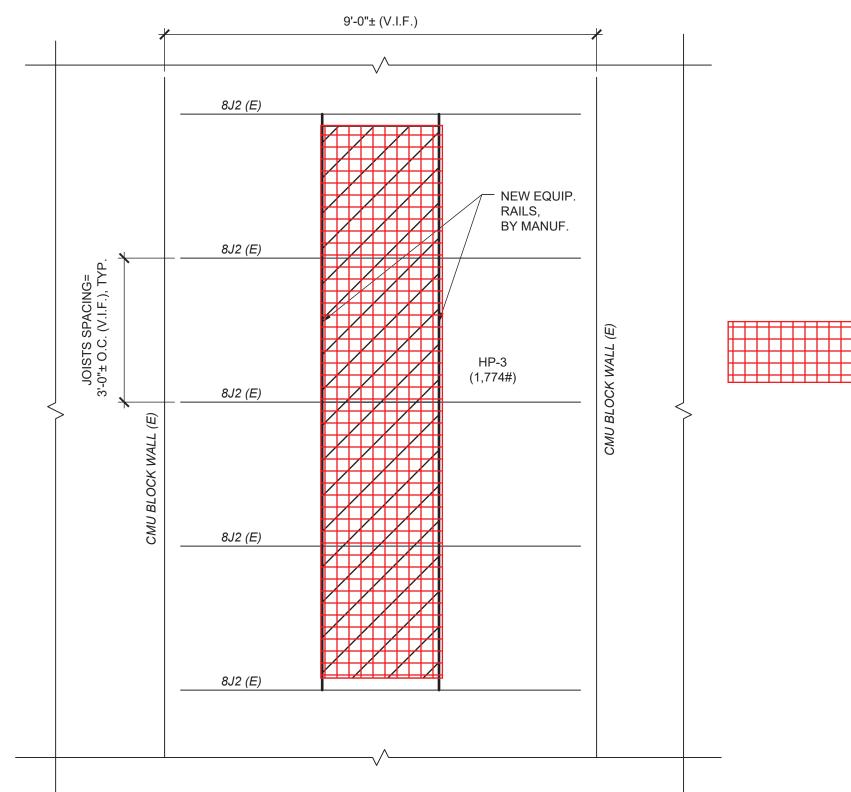

**ROOF PART PLAN UNDER HP-3** 

13'-4"± (V.I.F.)

SCALE: 1/2" = 1'-0"

10J4 (E)

10J4 (E)

10J4 (E)


10J4 (E)

# **NOTES:**

- 1. ALL UNITS SHALL BE CENTERED ON EXISTING JOISTS.
- 2. ALL EQUIPMENT RAILS SHALL SPAN OVER FIVE (5) EXISTING JOISTS,
- 3. ALL JOISTS SUPPORTING EQUIPMENT RAILS SHALL BE REINFORCED
- PER DETAIL 5/FES-S-102. 4. ALL DIMENSIONS SHALL BE VERIFIED IN FIELD. NOTIFY ENGINEER OF
- RECORD IF ANY DISCREPANCIES ARE FOUND.
- 5. NO OTHER MECHANICAL OR ELECTRICAL UNITS OR EQUIPMENT SHALL BE LOCATED ON JOISTS SUPPORTING THE NEW UNITS.


STRUCTURAL STEEL REINFORCEMENTS / ROOF PENETRATIONS / CURB INSTLATIONS / RAIL **INSTALLATIONS** 

APRIL 1st THROUGH APRIL 5th

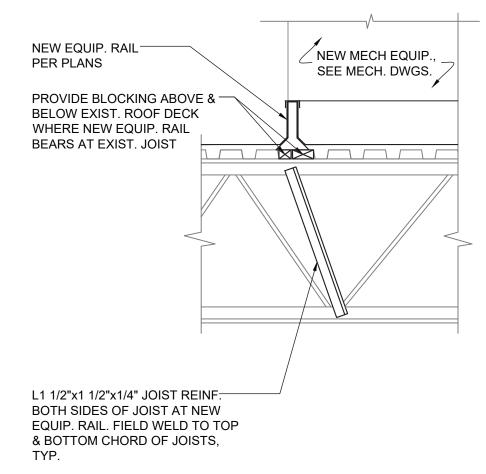





# CONSTRUCTION SEQUENCE PLAN

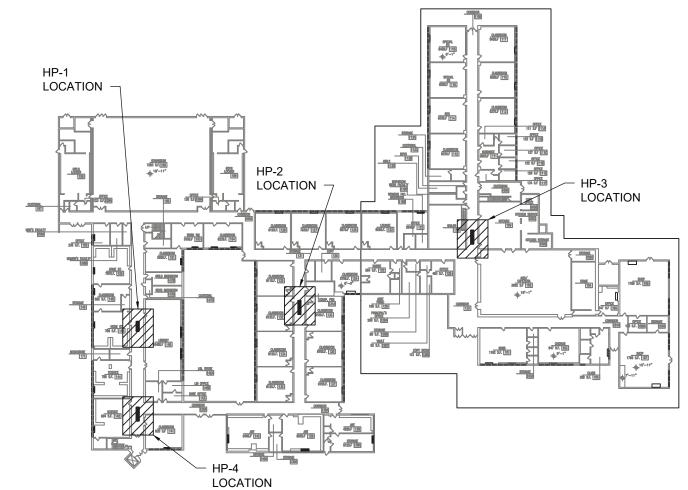

**ROOF KEY PLAN** 




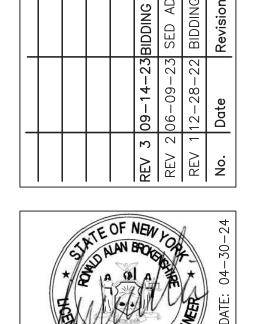

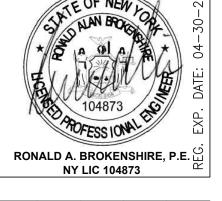


Drawn by	Checked by RAB	Project No. 42052	Scale AS NOTED	Date 7/29/22	
<u> </u>	<u>5</u>	م ا	ഗ്	ă	

GREENMAN PEDERSEN, INC 2 EXECUTIVE BOULEVARD SUITE 202 SUFFERN, NY 10901	GREENMAN PEDERSEN, INC 2 EXECUTIVE BOULEVARD SUITE 202 SUFFERN, NY 10901
Mechanical & Electrical Engineer:	Structural Engineer:

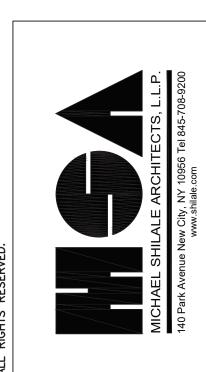



ROOF PART PLAN UNDER HP-4
SCALE: 1/2" = 1'-0"

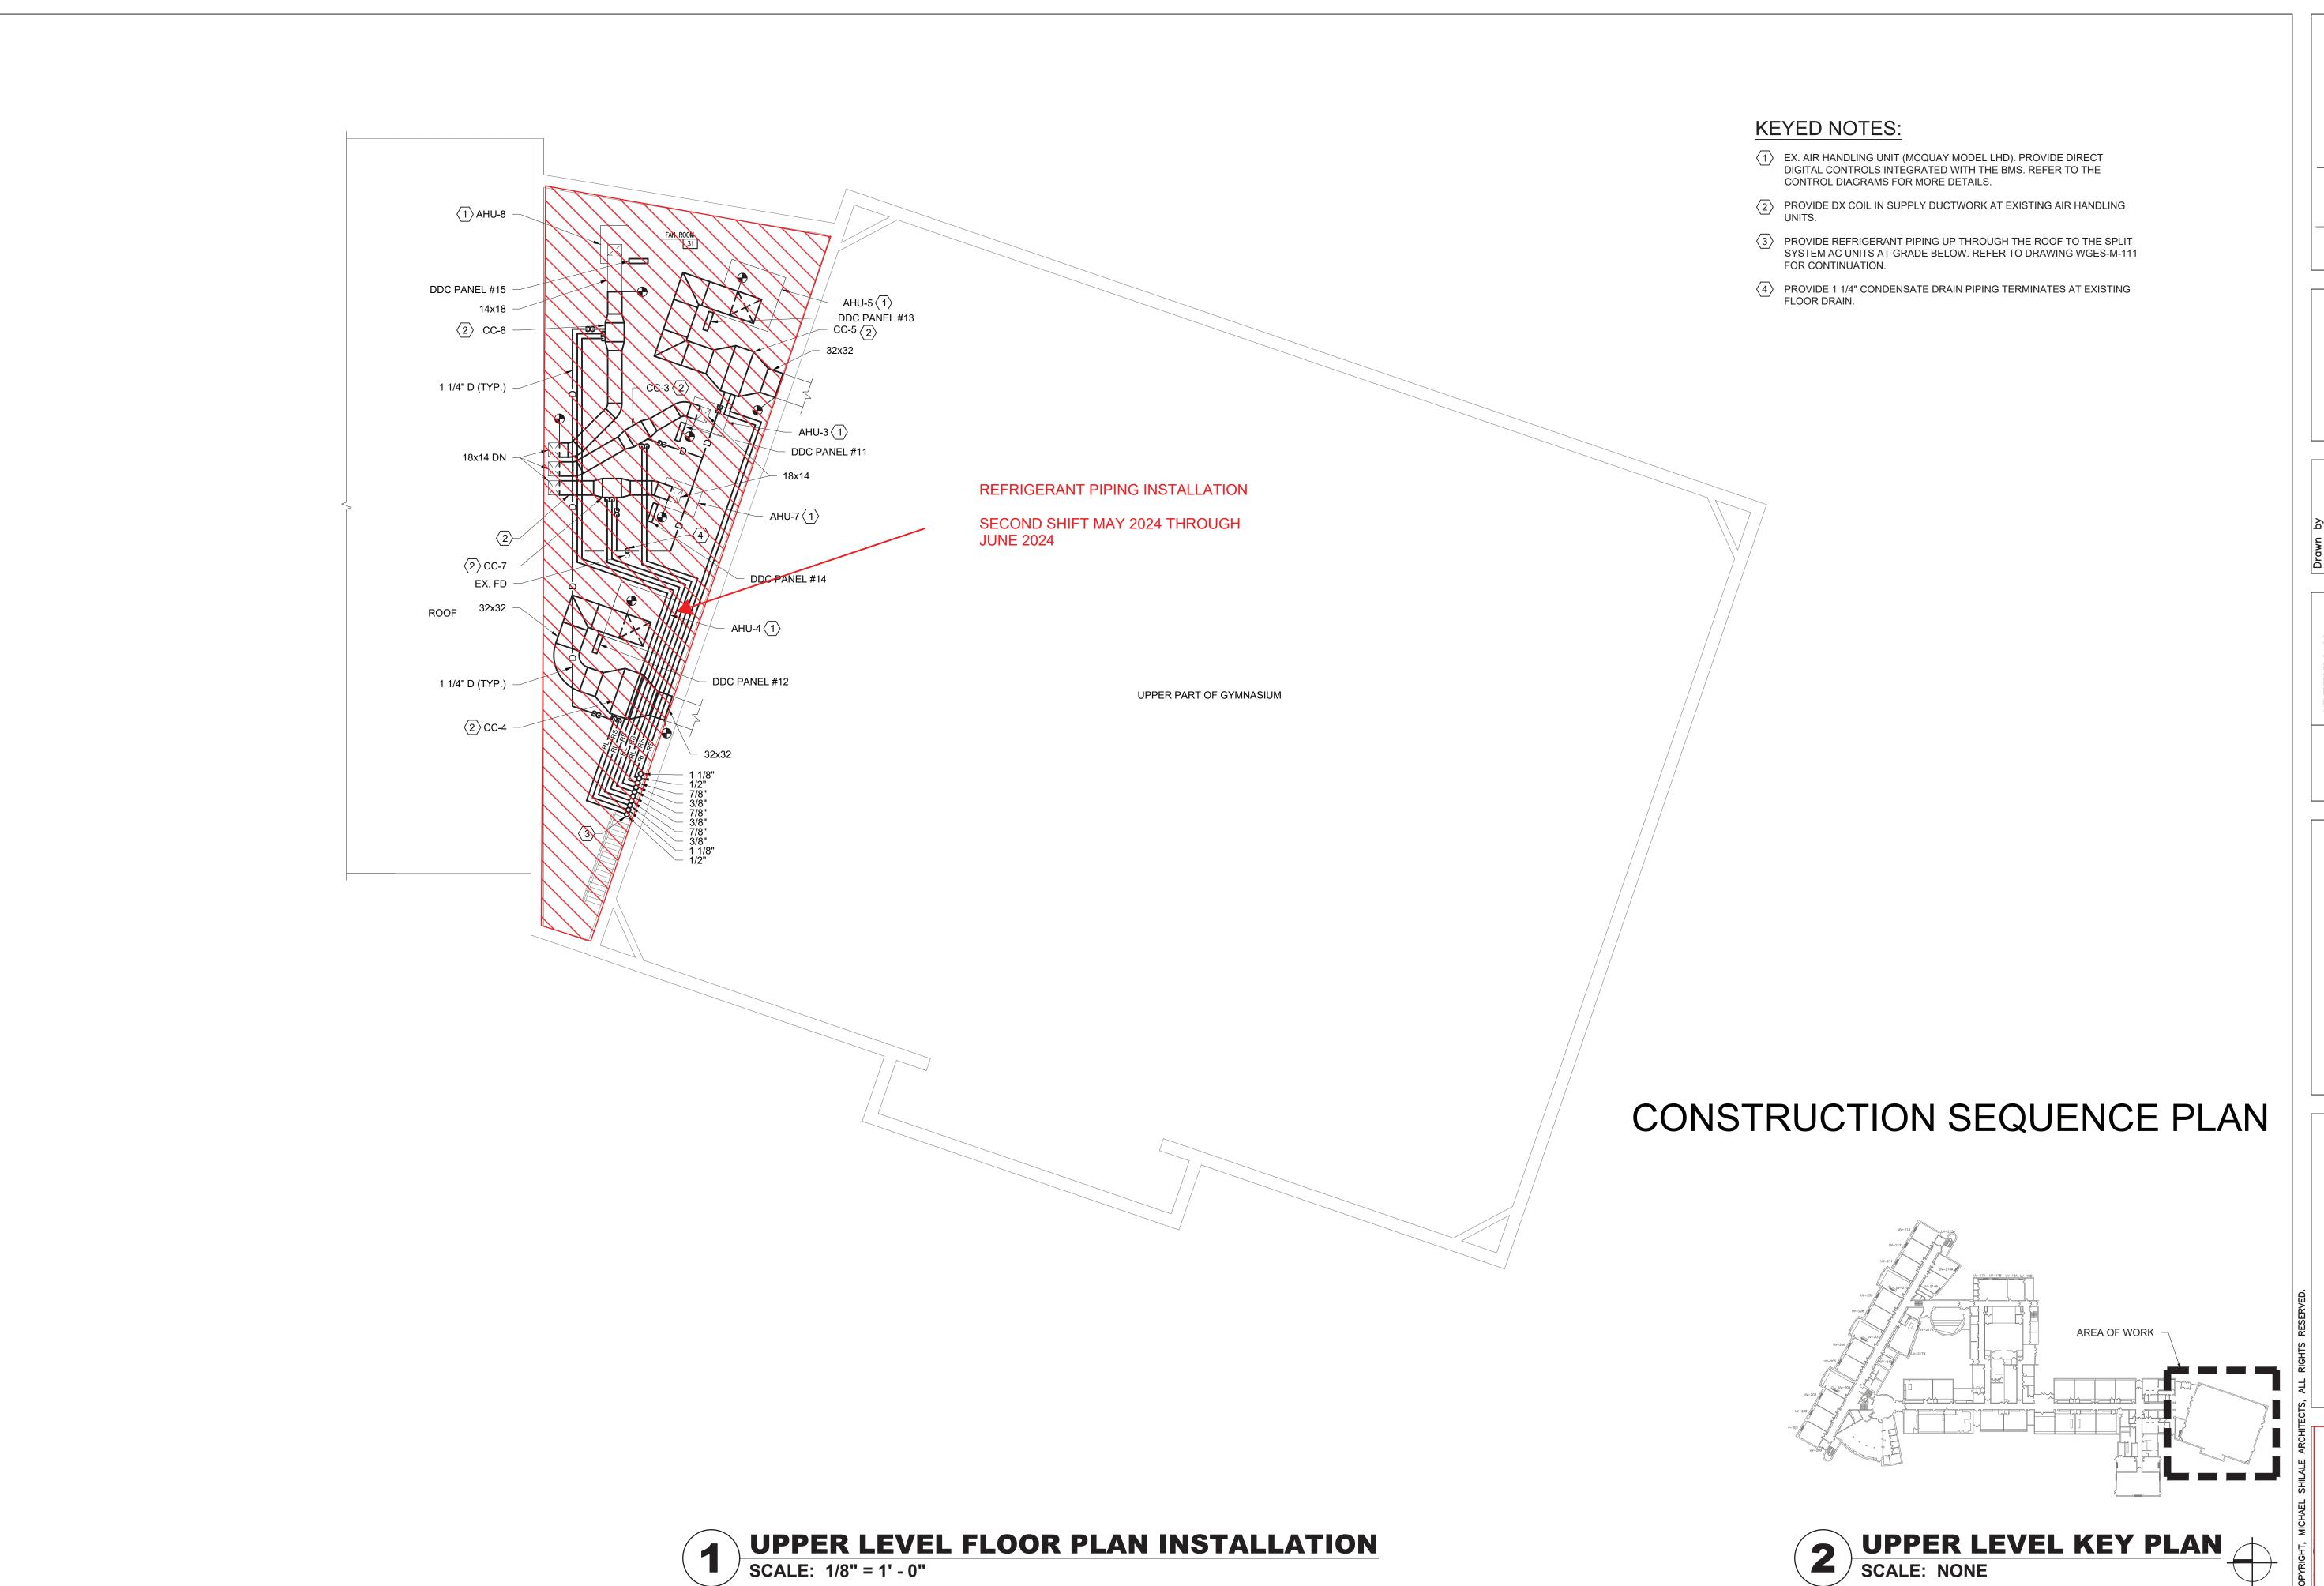





MEP	
Project No.	
42054	
Scale	
AS NOTED	
Date	
09-14-23	


GREENMAN PEDERSEN, INC 2 EXECUTIVE BOULEVARD SUITE 202 SUFFERN, NY 10901	GREENMAN PEDERSEN, INC 2 EKECUTIVE BOULEVARD SUITE 202 SUFFERN, NY 10901
Mechanical & Electrical Engineer:	Structural Engineer:




UPPER LEVEL KEY PLAN
SCALE: NONE

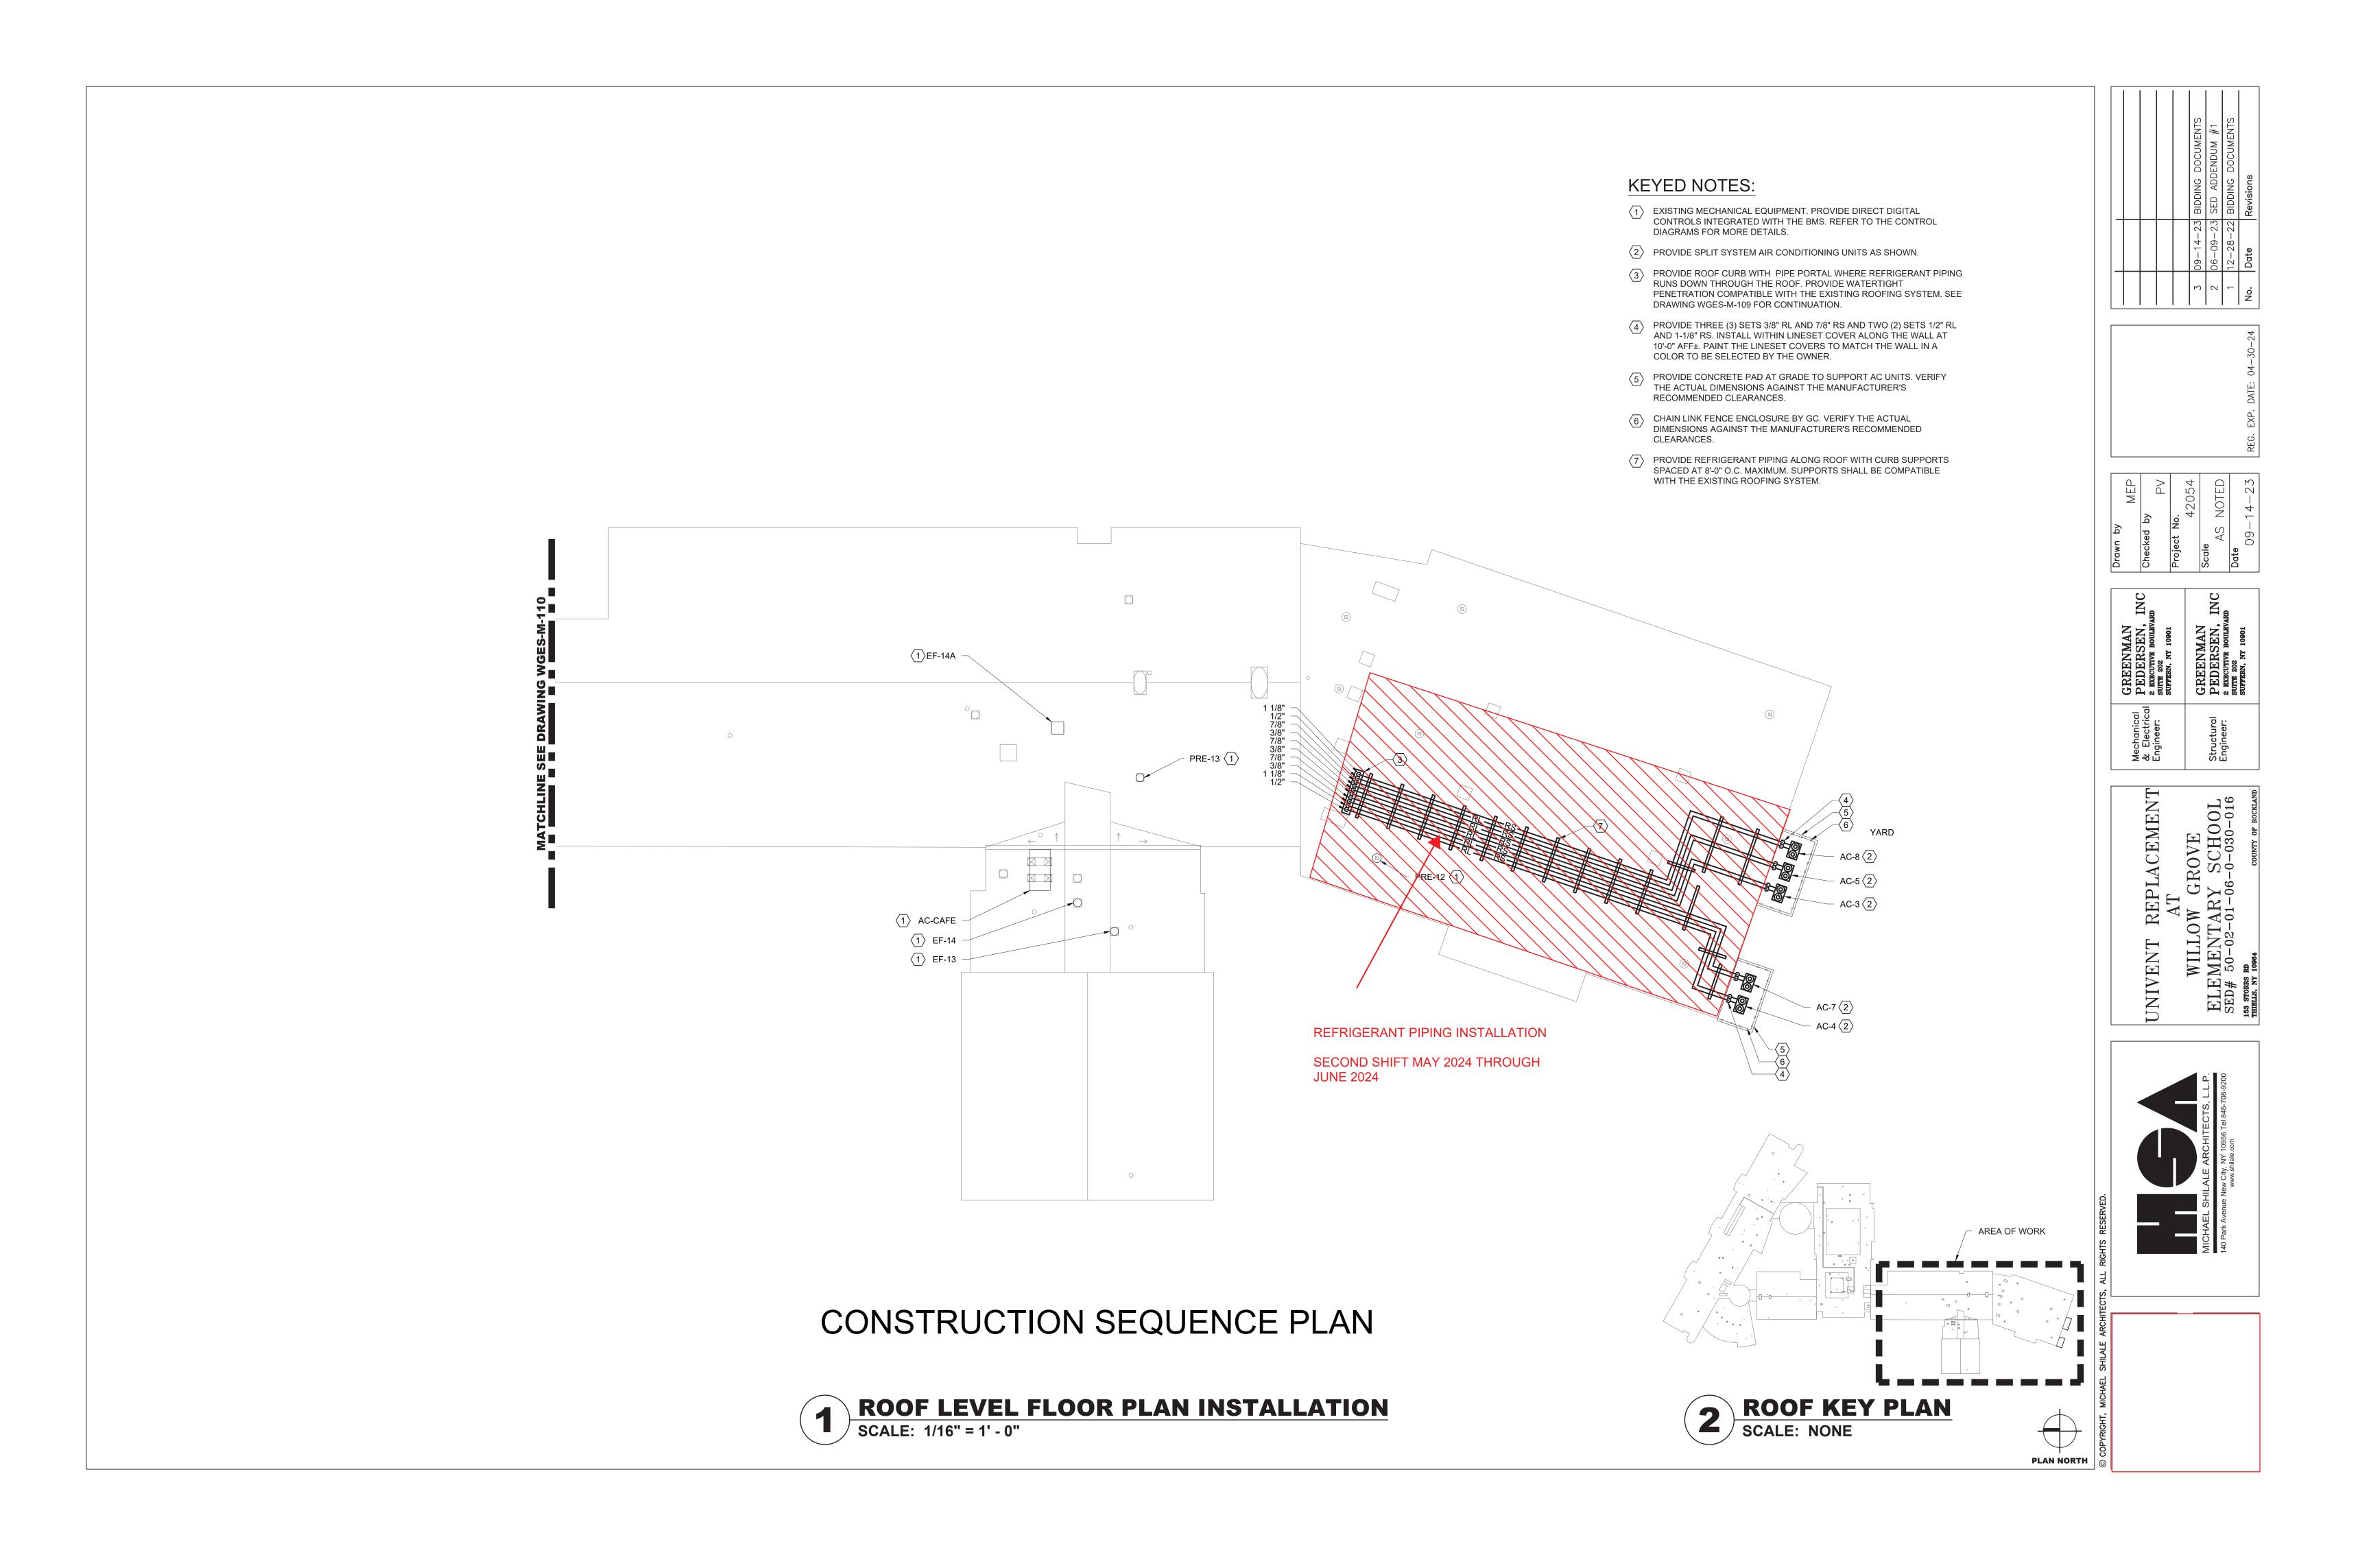

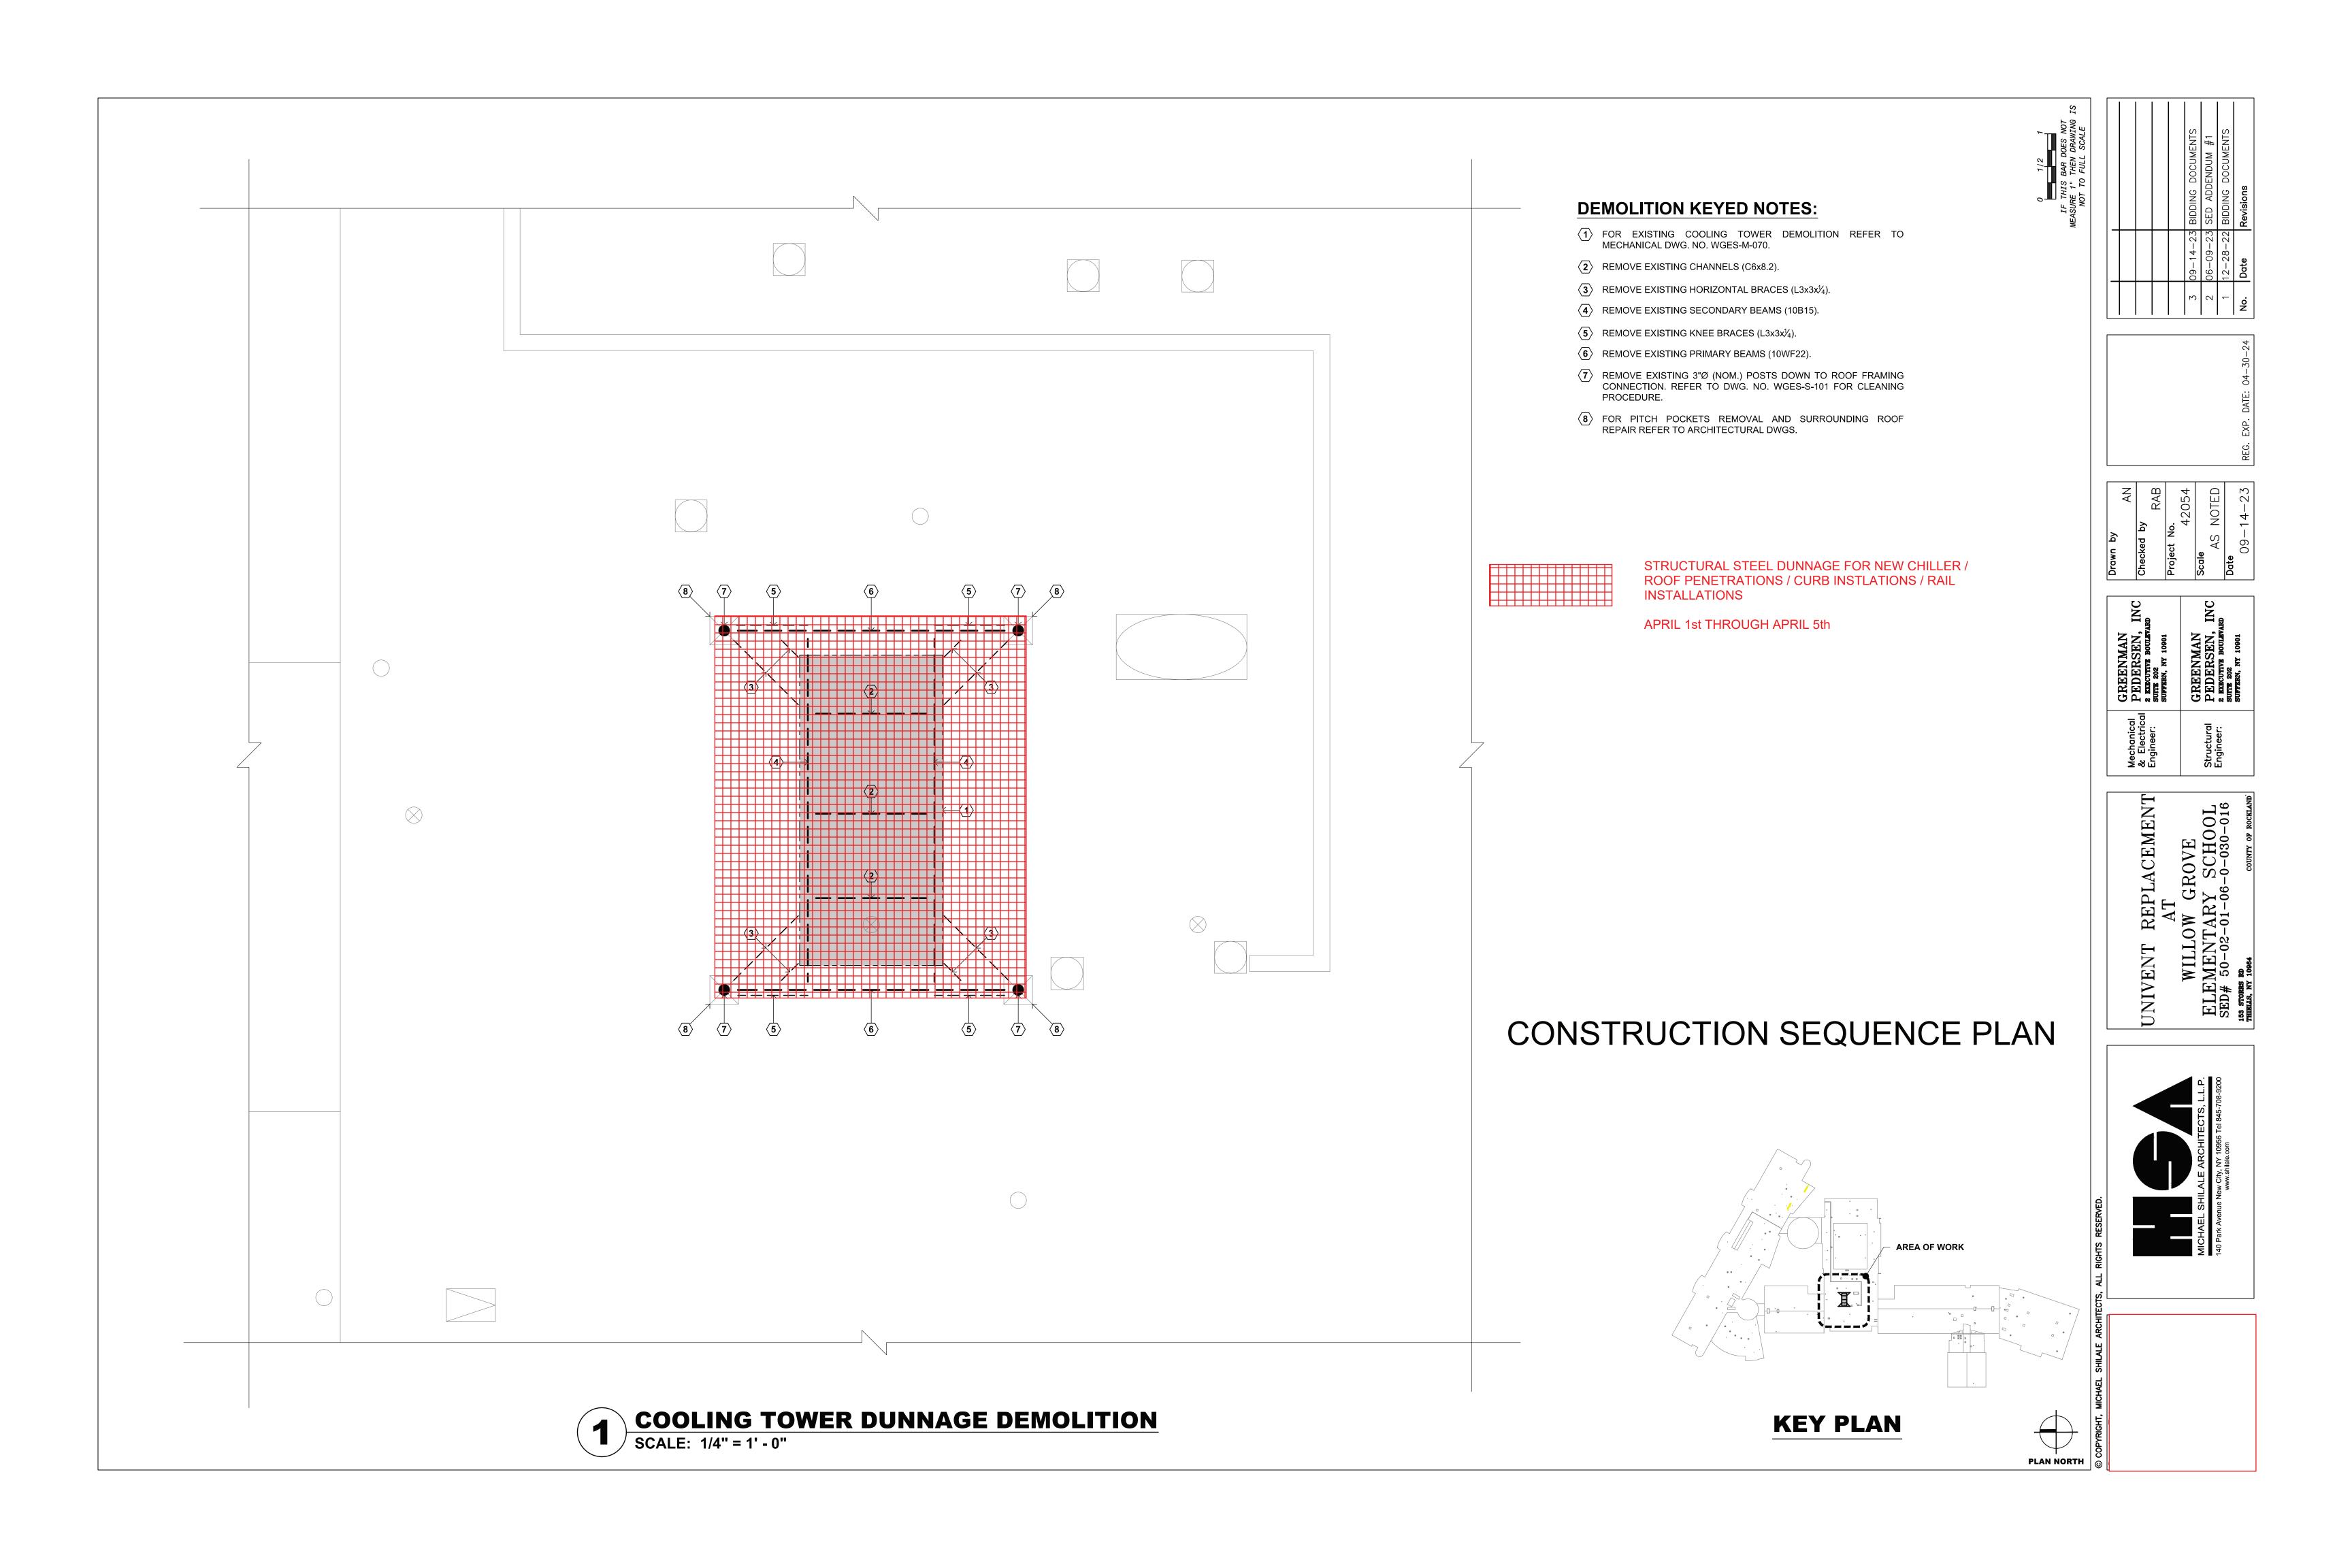

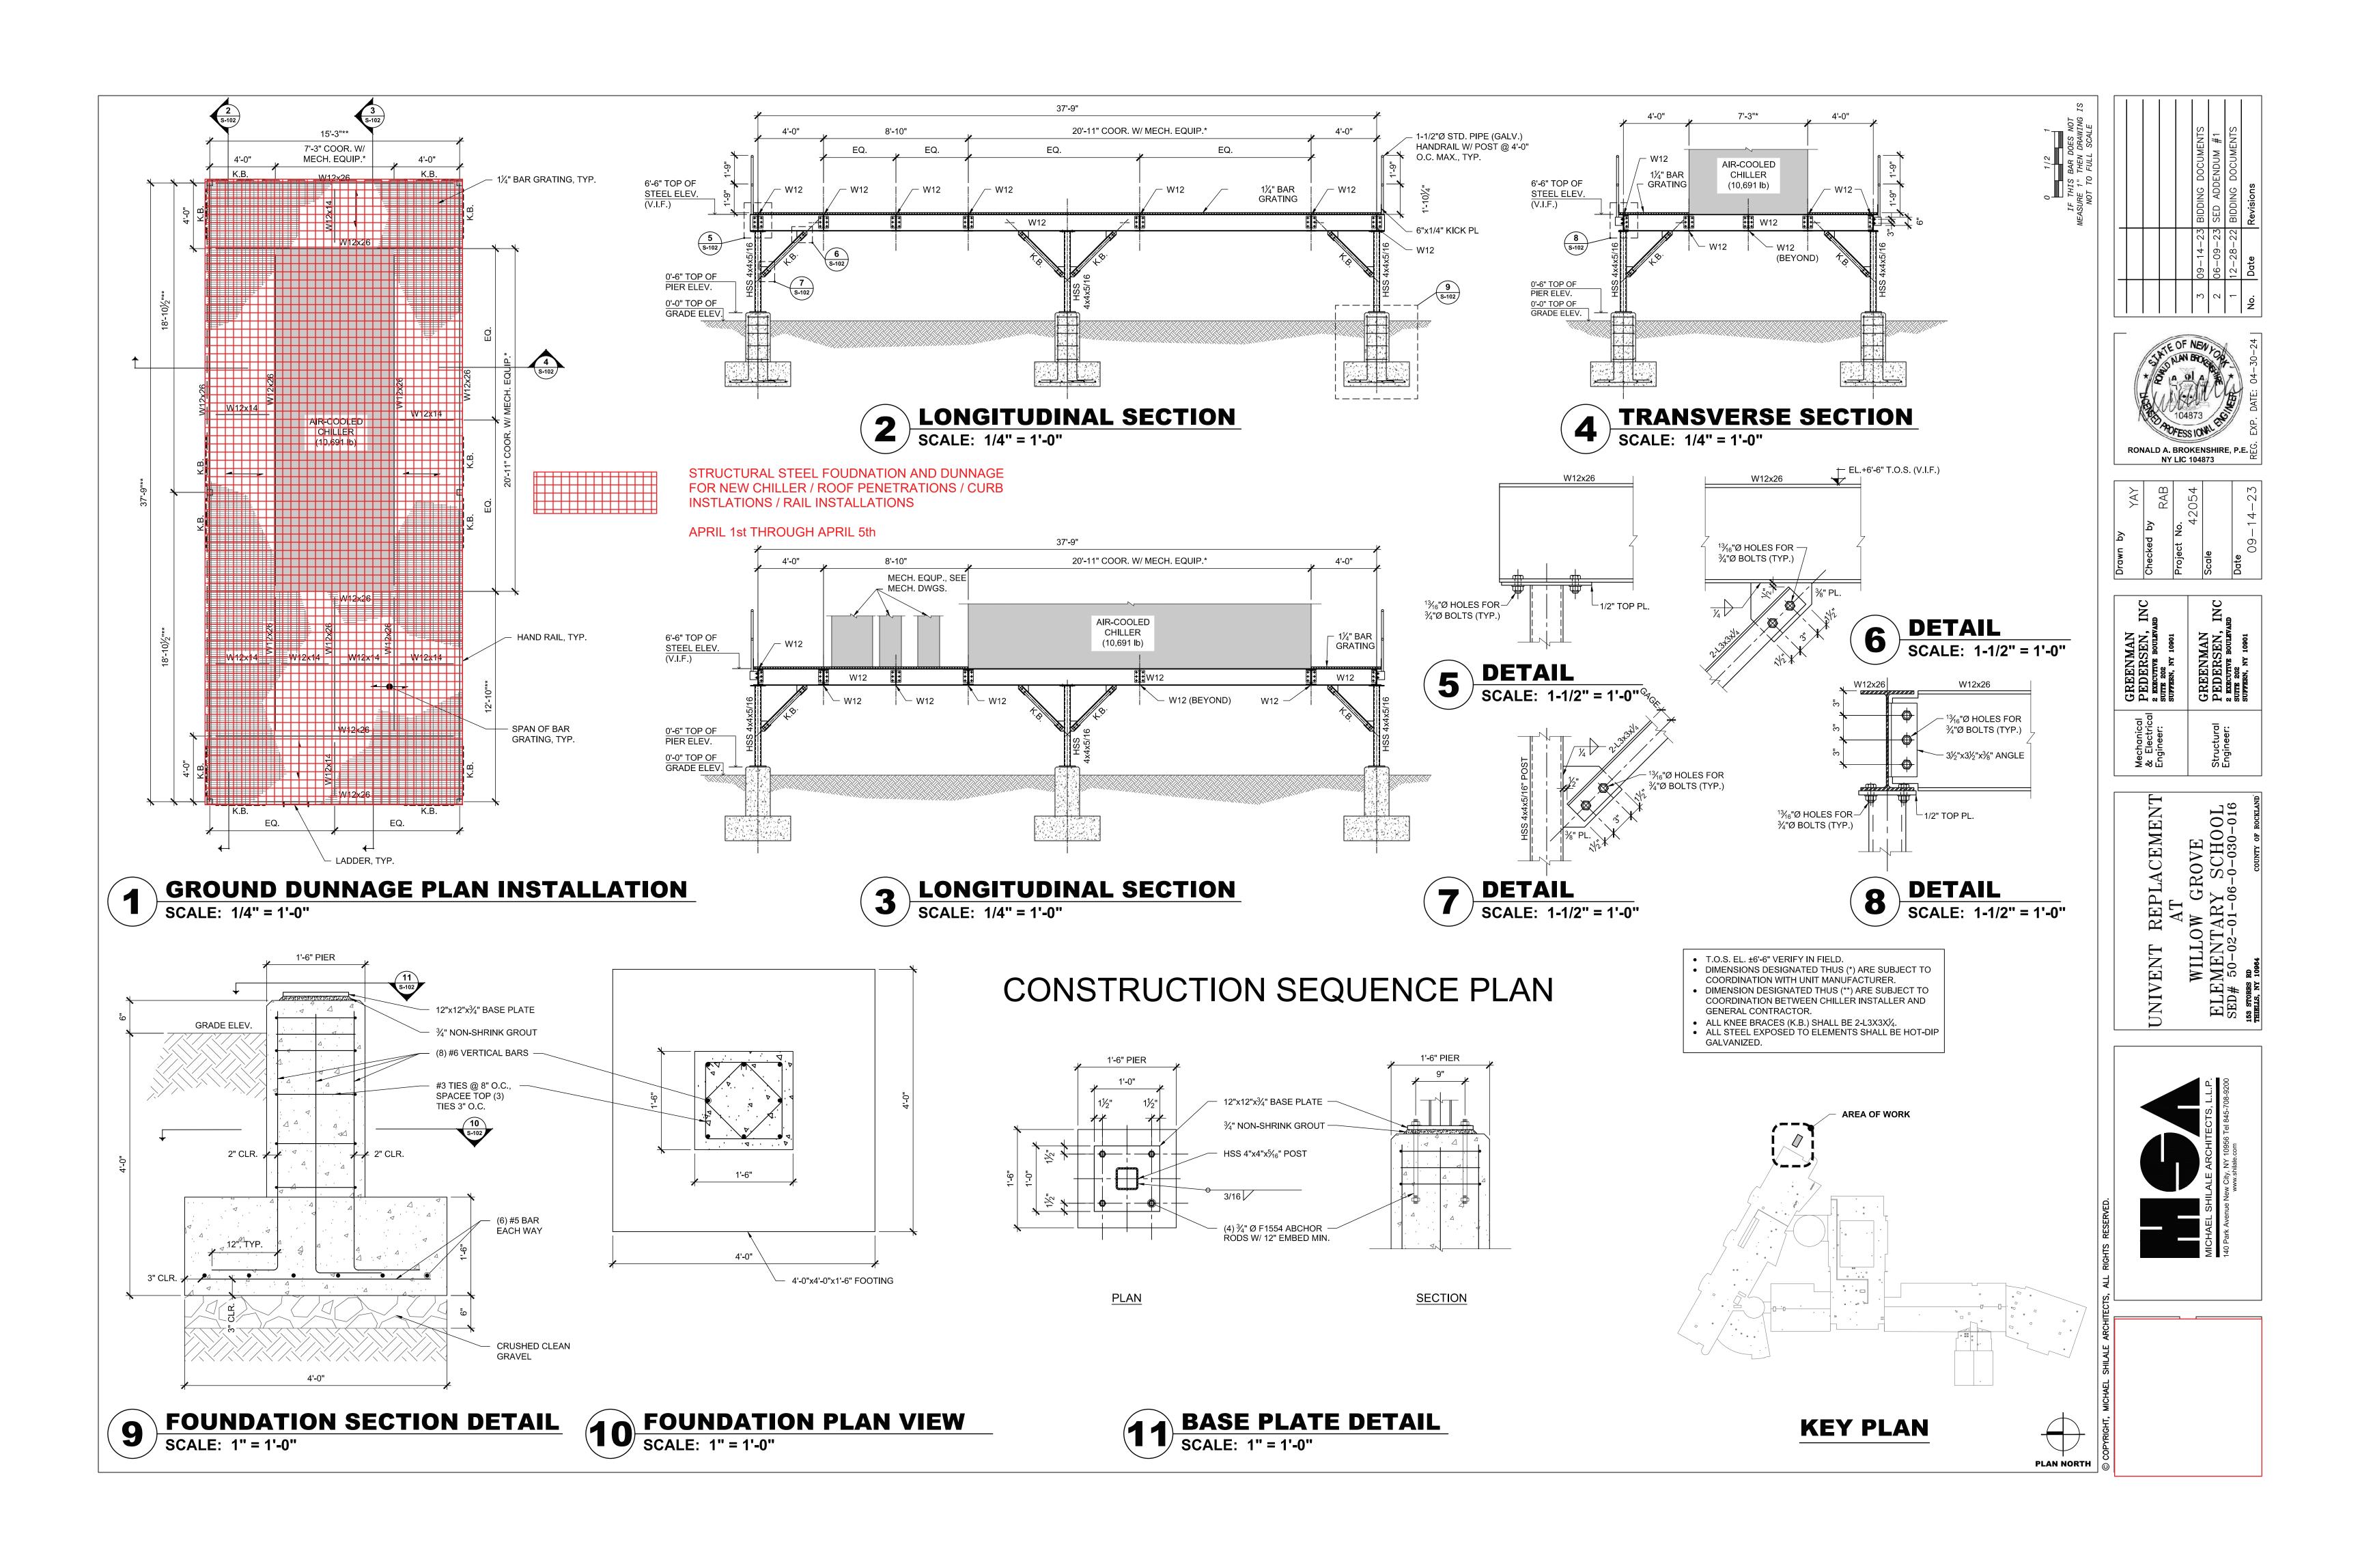

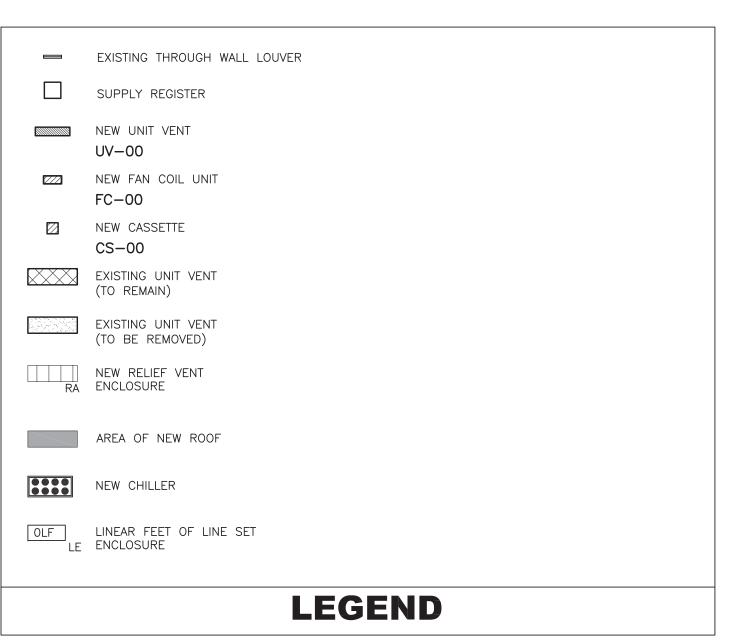



## $\langle$ A1 $\rangle$ INSTALL NEW UNIT VENTILATOR AS PART OF ALTERNATE NO. 200. $\langle$ A2 $\rangle$ INSTALL NEW CEILING MOUNTED UNIT VENTILATOR AS PART OF ALTERNATE NO. 200. (A3) PATCH EXISTING FLOOR AND WALL WHERE EXISTING UV IS REMOVED. A4 INSTALL NEW WINDOW ASSEMBLY. VERIFY ALL DIMENSIONS IN FIELD. SEE DRAWING WGES-A-510 FOR WINDOW ELEVATIONS AS ALTERNATE NO. 203. NEW INTAKE TO BE RAISED AWAY FROM GRADE. INSTALL NEW BRICK AND BLOCK WALL BELOW INTAKE. A5 BRICK TO MATCH EXISTING, SEE DETAIL 3/A-101 & 4/A-101. SUBMIT BRICK SAMPLES FOR APPROVALS. A6 INSTALL NEW SPLIT SYSTEM UNITS, PROVIDE EQUIPMENT SUPPORT RAILS, SEE MEP DRAWINGS & DETAIL 1/WGES-A-500 A7 PROVIDE NEW CHILLER, SEE MEP DRAWINGS $\langle$ A8 $\rangle$ MODIFY EXISTING DUNNAGE AS REQ'D., SEE STRUCTURAL DRAWINGS PROVIDE PITCH POCKET OR THROUGH ROOF BOOT/FLASHING ASSEMBLY @ ALL PIPE & CONDUIT ROOF A9 PENETRATIONS. NEW ASSEMBLY TO BE COMPATIBLÉ W. EXISTING ROOFING SYSTEM. SEE DETAIL 2/WGES-A-500 (A10) PERFORM MODIFICATIONS TO EXISTING UV AS NOTED ON MECHANICAL DRAWINGS. Unit Ventilators - (water and electrical disconnects) / UV removal. June 27th through July 5th. New UV installation July 8th through July 19th. Removals of existing chillers - April 1st through April 5th.


### **KEY NOTES**


- 1. CONTRACTOR SHALL BE REQUIRED TO CORE DRILL ALL HOLES IN WALLS, FLOORS AND CEILINGS TO FACILITATE NEW CHILLER LINES, CONDUITS AND CONDENSATE LINES. FIRE STOP ALL PENETRATIONS.
- 2. PATCH EXISTING VCT FLOORING AT BASE UNDER UNI-VENT.
- 3. PATCH EXISTING PLASTER AND CASE WORK AT ALL UNI-VENT LOCATIONS.

### **GENERAL NOTES**

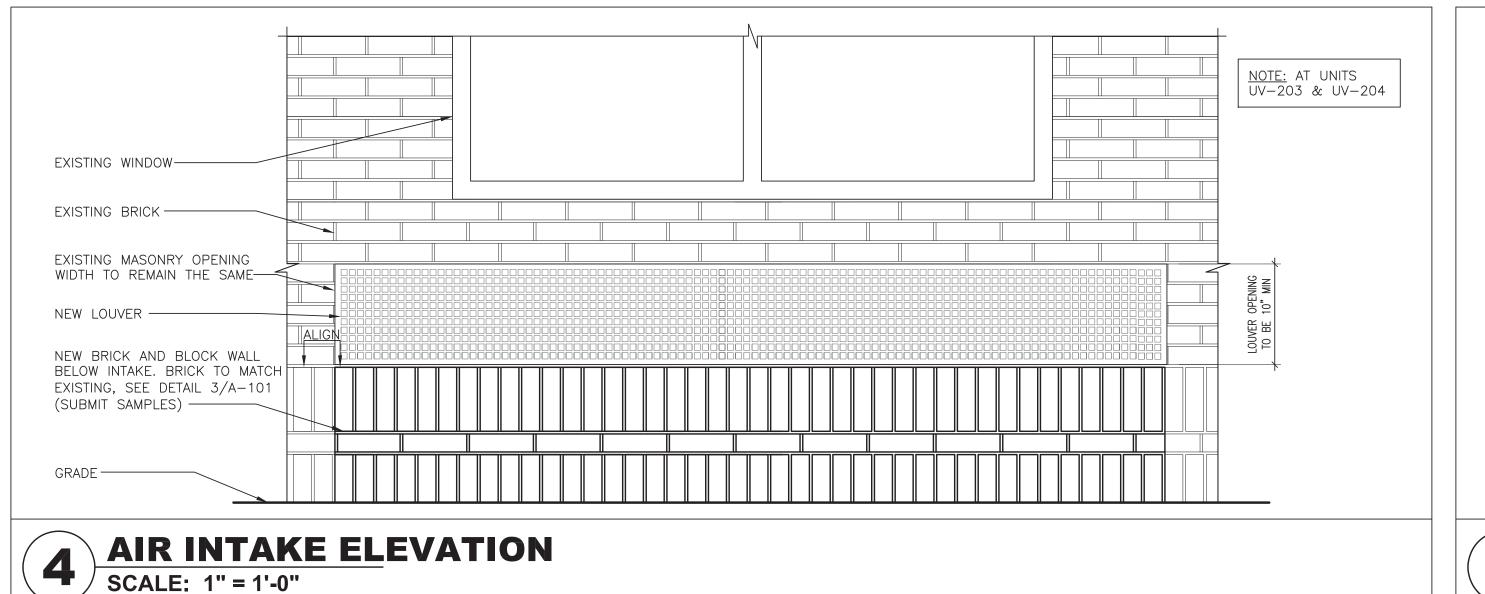

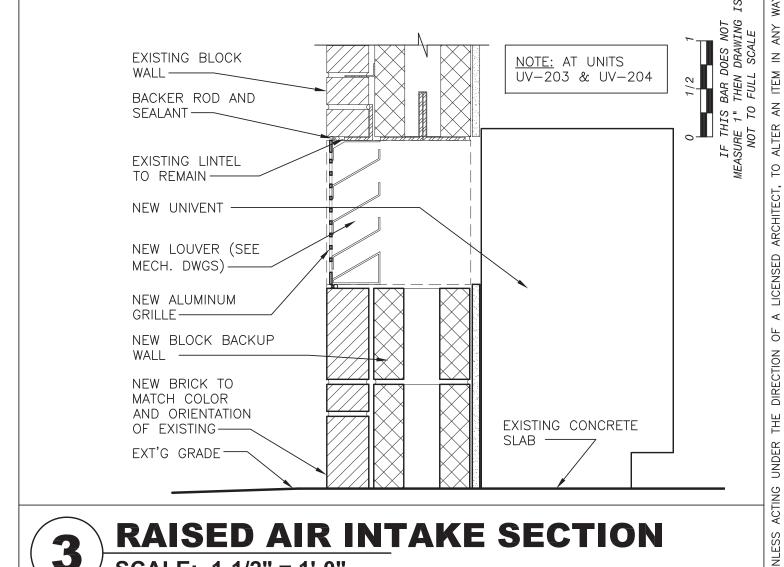

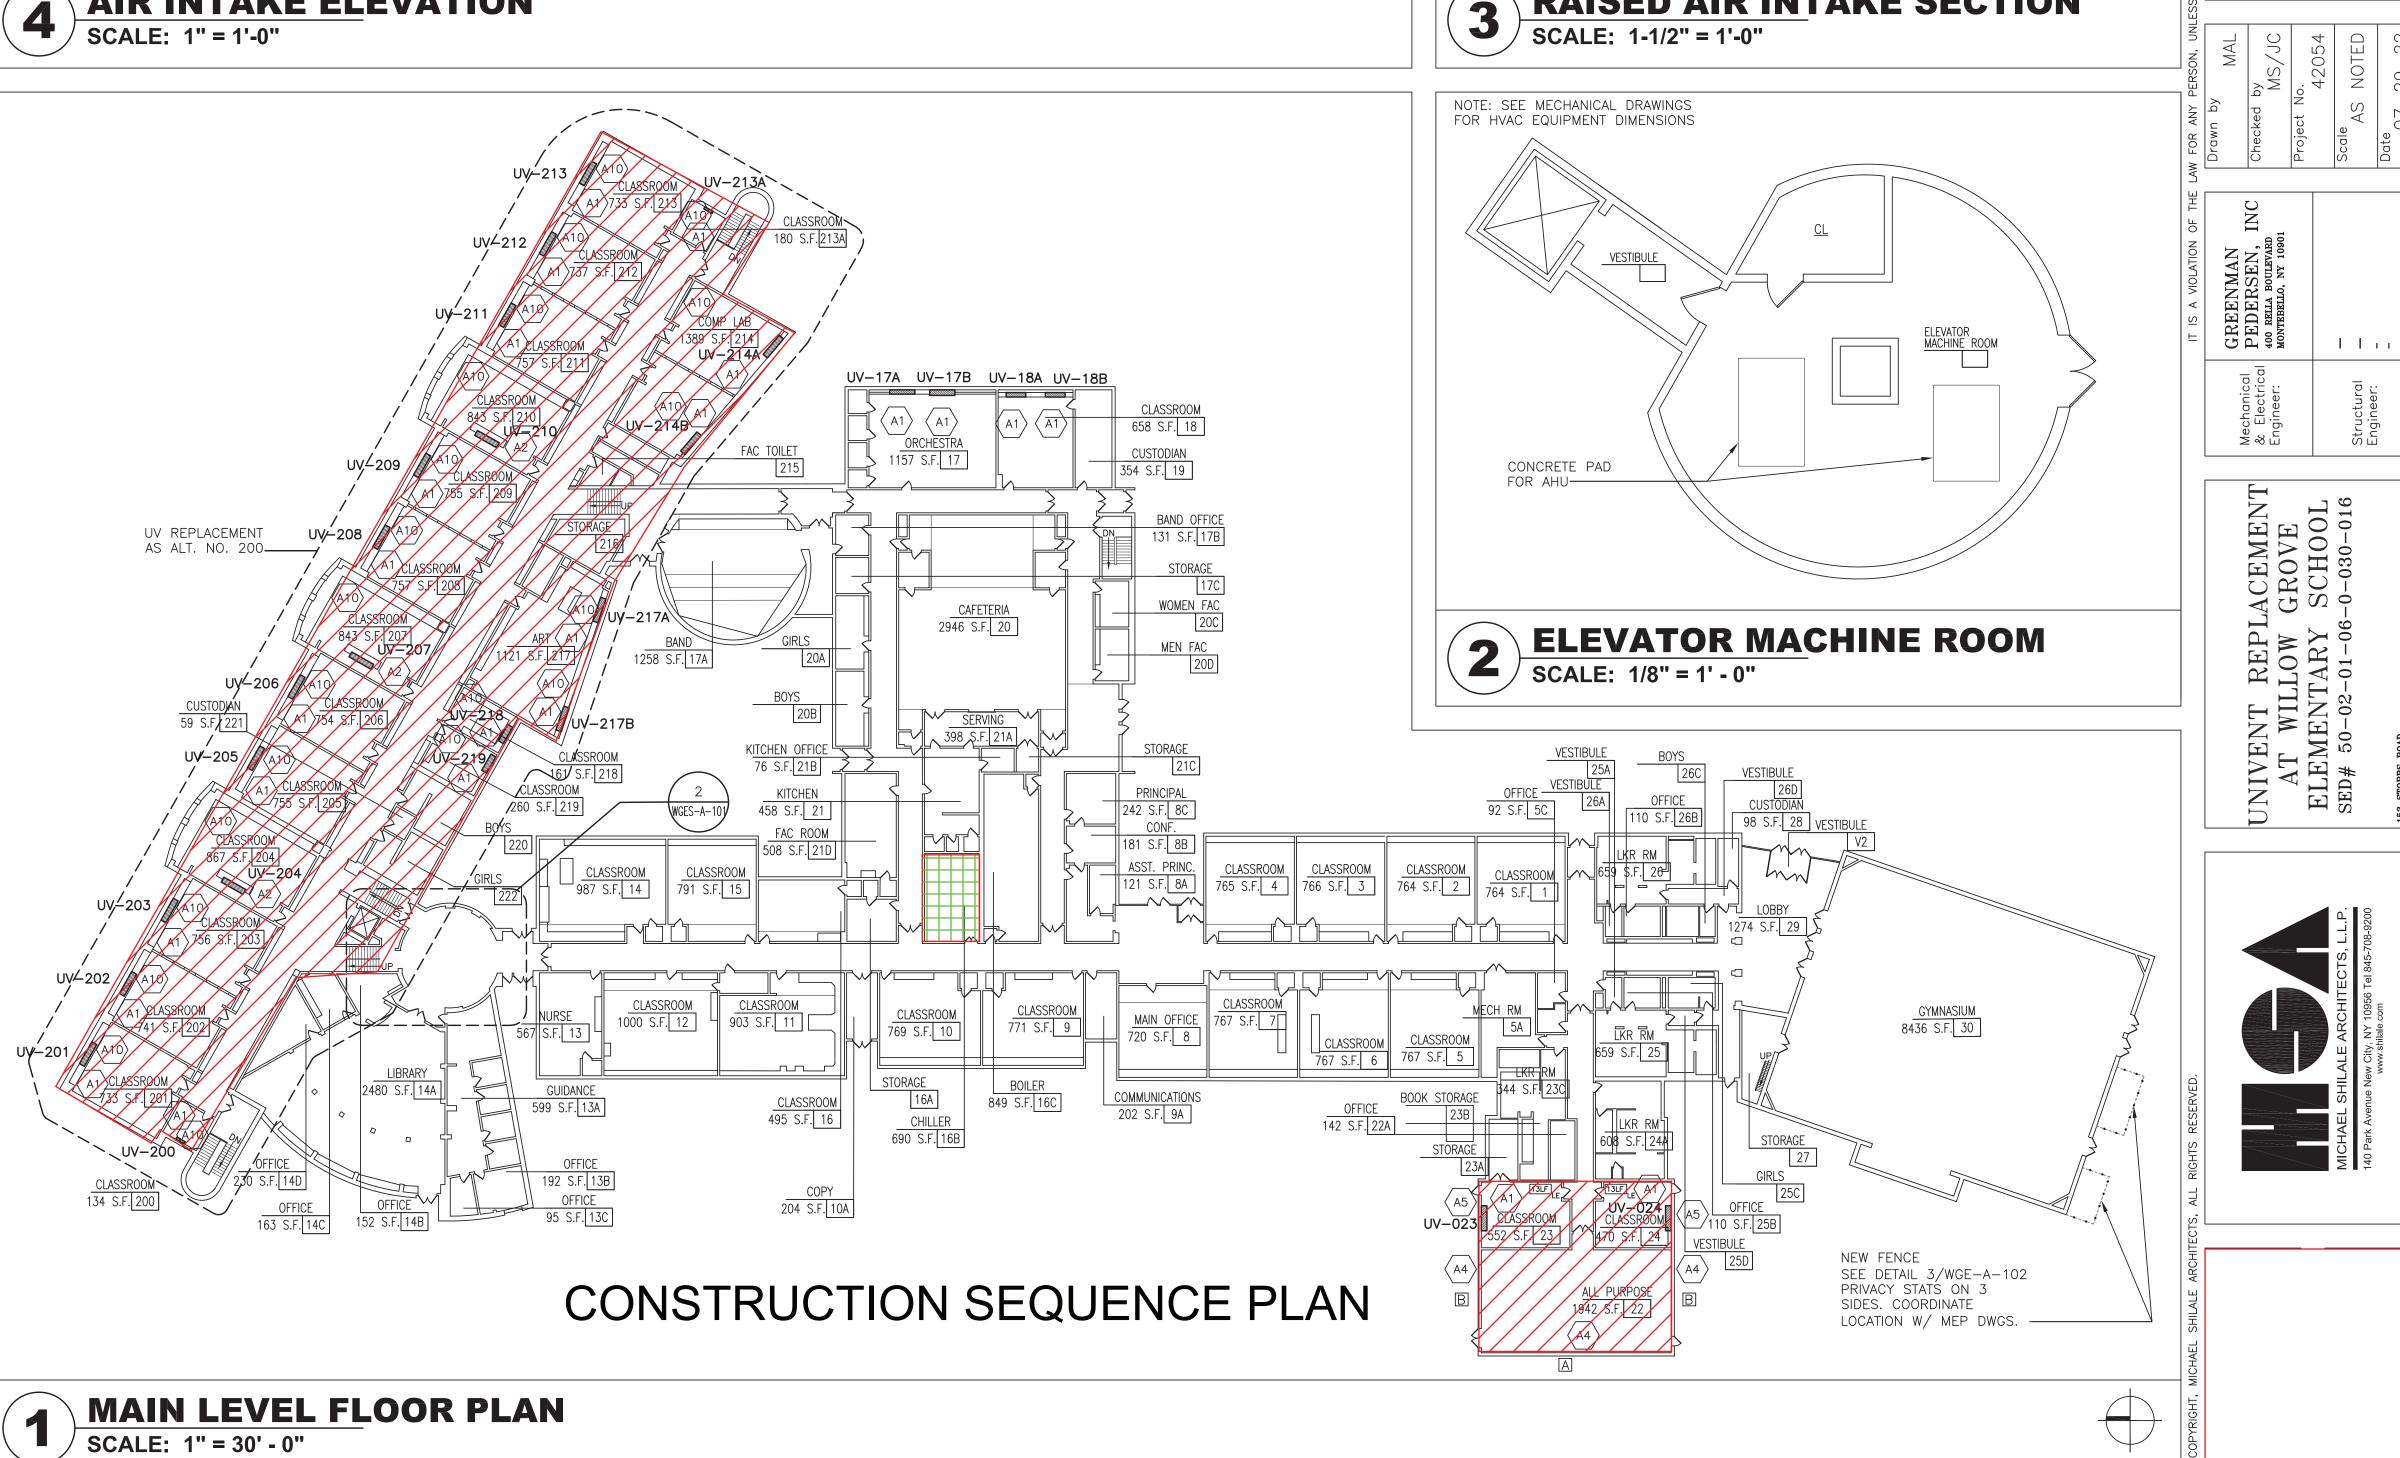

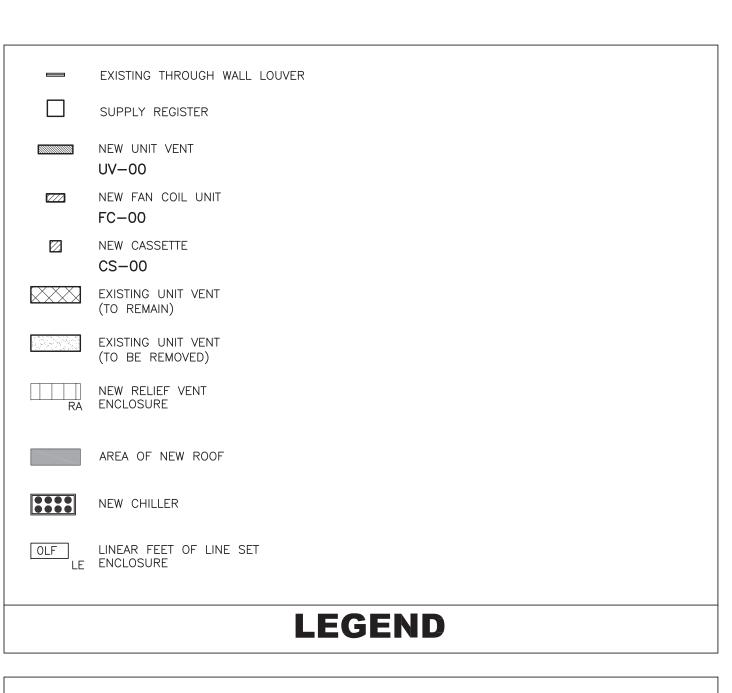




Unit Ventilators - (water and electrical disconnects) /


New UV installation July 18th through August 1st.


Chiller foundation and dunnage installation - Spring Break

Chiller installation Mid August 2024, dependent on Chiller

UV removal. July 8th through July 17th.

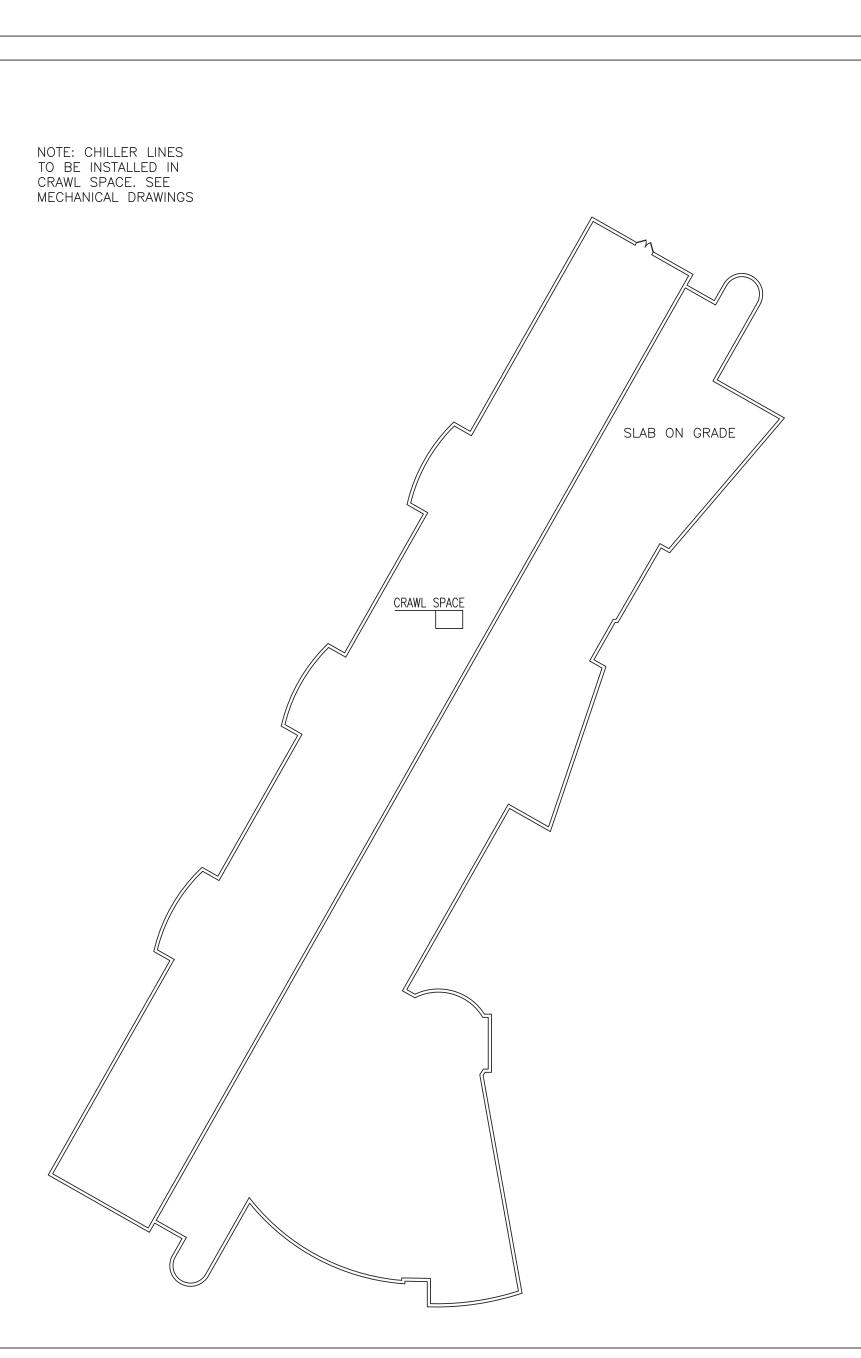

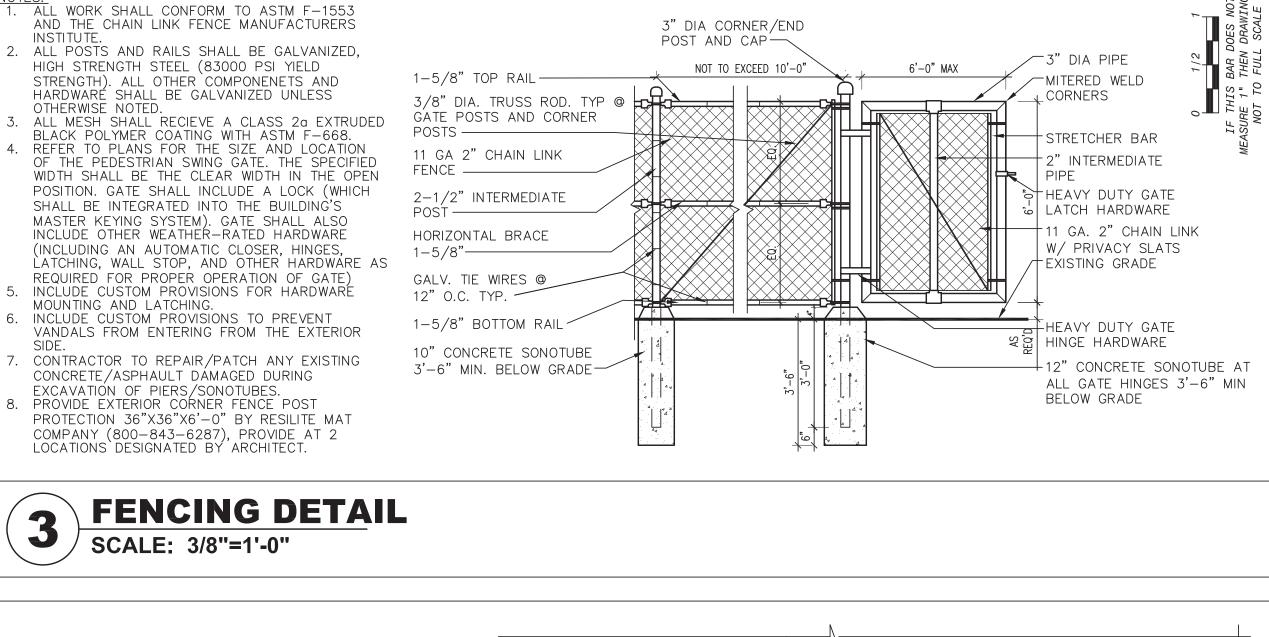

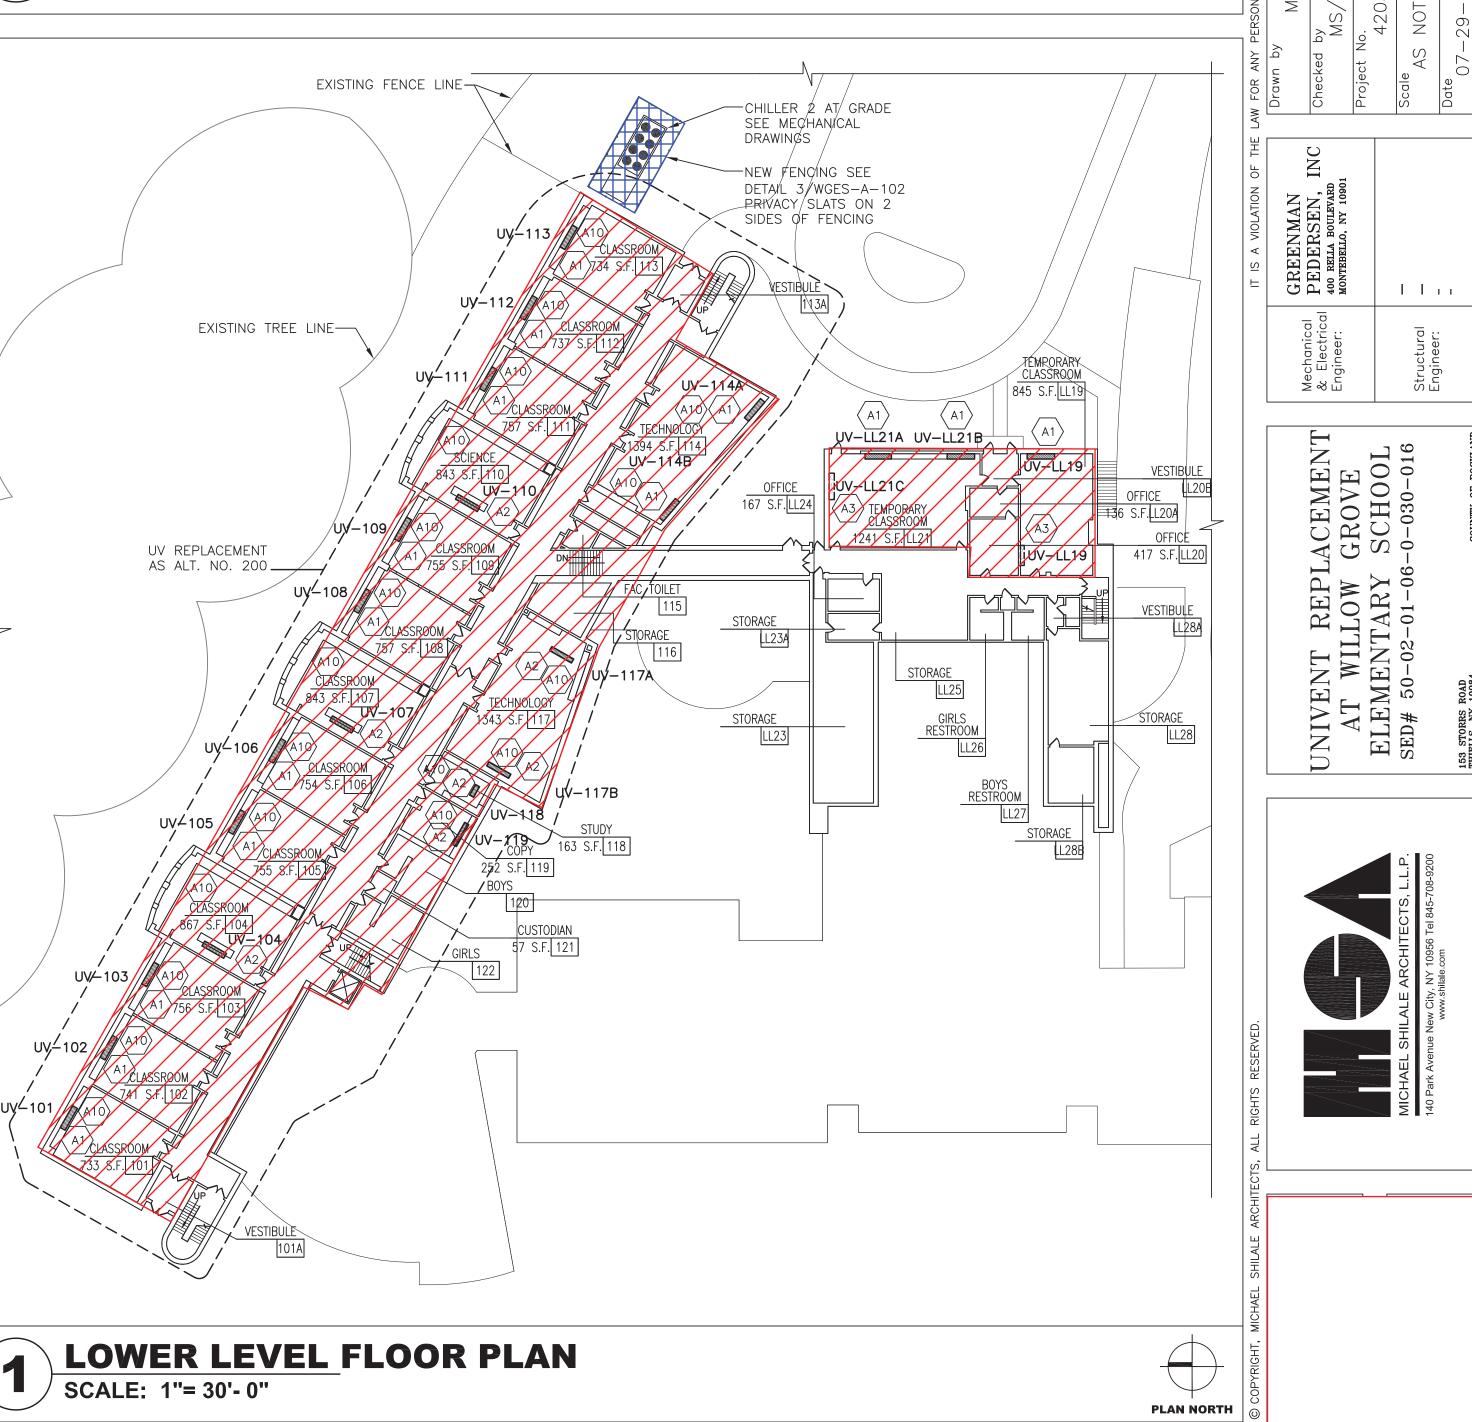

- $\langle$  A1 $\rangle$  INSTALL NEW UNIT VENTILATOR AS PART OF ALTERNATE NO. 200.  $\langle A2 \rangle$  install new ceiling mounted unit ventilator as part of alternate no. 200. (A3) PATCH EXISTING FLOOR AND WALL WHERE EXISTING UV IS REMOVED.
- A4 INSTALL NEW WINDOW ASSEMBLY. VERIFY ALL DIMENTO FOR WINDOW ELEVATIONS AS ALTERNATE NO. 203. INSTALL NEW WINDOW ASSEMBLY. VERIFY ALL DIMENSIONS IN FIELD. SEE DRAWING WGES-A-510 NEW INTAKE TO BE RAISED AWAY FROM GRADE. INSTALL NEW BRICK AND BLOCK WALL BELOW INTAKE.
- BRICK TO MATCH EXISTING, SEE DETAIL 3/A-101 & 4/A-101. SUBMIT BRICK SAMPLES FOR APPROVALS.
- A6 INSTALL NEW SPLIT SYSTEM UNITS, PROVIDE EQUIPMENT SUPPORT RAILS, SEE MEP DRAWINGS & DETAIL 1/WGES-A-500
- A7 PROVIDE NEW CHILLER, SEE MEP DRAWINGS
- (A8) MODIFY EXISTING DUNNAGE AS REQ'D., SEE STRUCTURAL DRAWINGS
- PROVIDE PITCH POCKET OR THROUGH ROOF BOOT/FLASHING ASSEMBLY @ ALL PIPE & CONDUIT ROOF A9 PENETRATIONS. NEW ASSEMBLY TO BE COMPATIBLE W. EXISTING ROOFING SYSTEM. SEE DETAIL 2/WGES-A-500
- (A10) PERFORM MODIFICATIONS TO EXISTING UV AS NOTED ON MECHANICAL DRAWINGS.

### **KEY NOTES**

- CONTRACTOR SHALL BE REQUIRED TO CORE DRILL ALL HOLES IN WALLS, FLOORS AND CEILINGS TO FACILITATE NEW CHILLER LINES, CONDUITS AND CONDENSATE LINES. FIRE STOP ALL PENETRATIONS.
- 2. PATCH EXISTING VCT FLOORING AT BASE UNDER UNI-VENT.
- 3. PATCH EXISTING PLASTER AND CASE WORK AT ALL UNI-VENT LOCATIONS.

### **GENERAL NOTES**



**CRAWL SPACE PLAN** SCALE: 1"= 30'- 0"

# UNIVENT REPLACEMENT AT FARLEY ELEMENTARY SCHOOL


FARLEY ELEMENTARY SCHOOL **140 ROUTE 210** STONY POINT, NY 10980 SED# 50-02-01-06-0-003-011


**OWNER:** 

**NORTH ROCKLAND** CENTRAL SCHOOL DISTRICT 65 Chapel Street Garnerville, NY 10923


**ARCHITECT:** MICHAEL SHILALE ARCHITECTS, LLP 140 Park Avenue New City, NY 10956

> PME ENGINEER: GREENMAN-PEDERSON, INC. 400 Rella Boulevard, Suite 207 Montabello, NY 10901

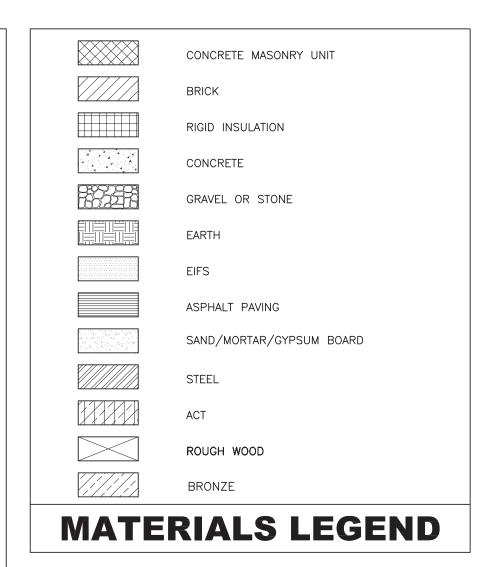

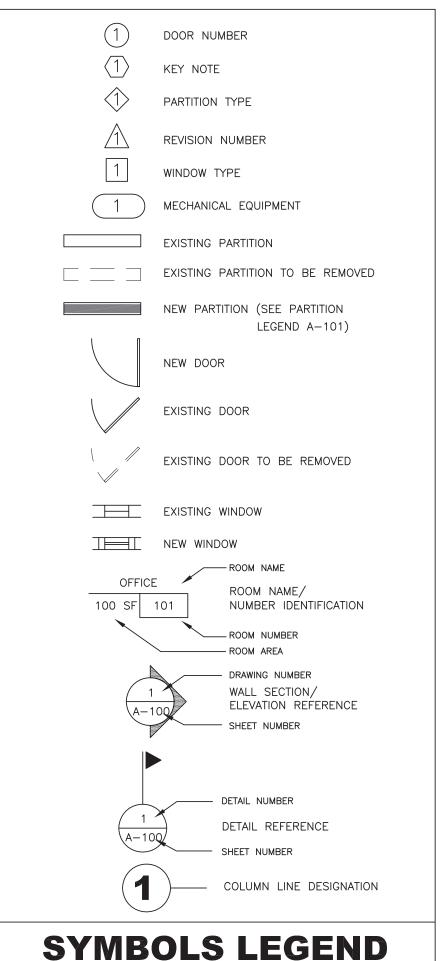

DRAWING No.	DRAWING TITLE	DATE 4	4
FES-A-000	COVER SHEET	11-09-23	
FES-B-100	CODE ANALYSIS	09-14-23	,
FES-AA-000	ABATEMENT NOTES	01-18-23	
FES-AA-100	FIRST FLOOR ABATEMENT PLAN	01-18-23	
FES-AA-200	SECOND FLOOR ABATEMENT PLAN	01-18-23	$\setminus$
FES-S-001	STRUCTURAL NOTES AND LEGEND ABBREVATIONS	09-14-23/	4
FES-S-101	GYM ROOF FRAMING PLAN AND DETAILS	09-14-23	)
FES-S-102	ROOF PART PLANS UNDER HP UNITS	(11-09-23)	
FES-D-101	FIRST FLOOR DEMO PLAN	09-14-23	
FES-D-102	SECOND FLOOR DEMO PLAN	09-14-23	
FES-D-103	ROOF DEMO PLAN	09-14-23	
FES-A-101	PROPOSED FIRST FLOOR PLAN	09-14-23	
FES-A-102	PROPOSED SECOND FLOOR PLAN	09-14-23	
FES-A-103	PROPOSED ROOF PLAN	09-14-23	
FES-A-104	PROPOSED ELECTRICAL ROOM PLAN	09-14-23	
FES-A-401	FIRST FLOOR REFLECTED CEILING PLAN	09-14-23	
FES-A-402	SECOND FLOOR REFLECTED CEILING PLAN	09-14-23	
FES-A-403	REFLECTED CEILING PLAN	09-14-23	
FES-A-404	REFLECTED CEILING PLAN DETAILS	09-14-23	
FES-A-500	ROOF DETAILS	09-14-23	
FES-A-600	UV ELEVATIONS	09-14-23	
FES-A-601	UV ELEVATIONS	09-14-23	
FES-A-602	UV ELEVATIONS	09-14-23	
FES-A-610	INTERIOR DETAILS	09-14-23	$\wedge$
FES-M-001	MECHANICAL GENERAL NOTES, ABBREVIATIONS, & SYMBOL LIST	09-14-23/	4\
FES-M-002	MECHANICAL SCHEDULES -1	09-14-23	)
FES-M-003	MECHANICAL SCHEDULES -2	(11-09-23)	
FES-M-061	HVAC DEMO FIRST FLOOR PLAN -1	09-14-23	
FES-M-062	HVAC DEMO FIRST FLOOR PLAN -2	09-14-23	
FES-M-063	HVAC DEMO SECOND FLOOR PLAN	09-14-23/2	\
FES-M-064	HVAC DEMO GYMNASIUM PLAN		+
		09-14-23	
FES-M-101	HVAC INSTALLATION FIRST FLOOR PLAN -1	(11-09-23)	
FES-M-102	HVAC INSTALLATION FIRST FLOOR PLAN -2	11-09-23	$\wedge$
FES-M-103	HVAC INSTALLATION SECOND FLOOR PLAN	09-14-23	$\stackrel{/}{\leftarrow}$
FES-M-104	HVAC INSTALLATION GYMNASIUM PLAN	(11-09-23)	
FES-M-105	MECHANICAL ROOF PLAN	\11-09-23 \(\frac{1}{2}	
FES-M-501	MECHANICAL DETAILS -1	(11-09-23)	)
FES-M-502	MECHANICAL DETAILS -2	11-09-23	
FES-M-503	MECHANICAL DETAILS -3	11-09-23	1
FES-M-504	HVAC REFRIGERANT PIPING DIAGRAMS	<b>V</b>	$\rangle$
FES-E-001	ELECTRICAL NOTES & SCHEDULES	11-09-23	,
		09-14-23	
FES-E-002	ELECTRICAL SITE PLAN	09-14-23	
FES-E-061	ELECTRICAL FIRST FLOOR DEMO PLAN SHEET 1	09-14-23	\
FES-E-062	ELECTRICAL FIRST FLOOR DEMO PLAN SHEET 2	09-14-23/4	1
FES-E-063	ELECTRICAL SECOND FLOOR DEMO PLAN	09-14-23	
FES-E-101	ELECTRICAL FIRST FLOOR PLAN -1	11-09-23	
FES-E-102	ELECTRICAL FIRST FLOOR PLAN -2	11-09-23	^
FES-E-103	ELECTRICAL SECOND FLOOR PLAN	09-14-23	/4\
		$\sim$	$\longrightarrow$
FES-E-104	ELECTRICAL ROOF PLAN -1	(11-09-23)	
FES-E-105	ELECTRICAL ROOF PLAN -2	11-09-23	
FES-E-106	ELECTRICAL PART PLAN	09-14-23	^
FES-E-201	ELECTRICAL FIRST FLOOR PART PLAN -1	09-14-23	4
FES-E-202	ELECTRICAL FIRST FLOOR PLAN -2	09-14-23	
FES-E-400	ELECTRICAL ONE LINE DIAGRAM, DISTRIBUTION BOARD SCHEDULE	09-14-23	
FES-E-401	ELECTRICAL PANEL SCHEDULES #1	11-09-23	,
FES-E-402	ELECTRICAL PANEL SCHEDULES #2	09-14-23	
	"		
FES-E-403	ELECTRICAL PANEL SCHEDULES #3	09-14-23	
FES-E-404	ELECTRICAL PANEL SCHEDULES #4	09-14-23	
FES-E-405	ELECTRICAL PANEL SCHEDULES #5	09-14-23	^
		09-14-23 /	4\
FES-E-406	ELECTRICAL PANEL SCHEDULES #6		$\overline{}$
		09-14-23	)
FES-E-406 FES-E-407	ELECTRICAL PANEL SCHEDULES #6 ELECTRICAL PANEL SCHEDULES #7		
FES-E-406 FES-E-407 FES-E-408	ELECTRICAL PANEL SCHEDULES #6 ELECTRICAL PANEL SCHEDULES #7 ELECTRICAL PANEL SCHEDULES #8	(11-09-23)	
FES-E-406 FES-E-407 FES-E-408 FES-E-409	ELECTRICAL PANEL SCHEDULES #6 ELECTRICAL PANEL SCHEDULES #7 ELECTRICAL PANEL SCHEDULES #8 ELECTRICAL PANEL SCHEDULES #9	11-09-23	
FES-E-406 FES-E-407 FES-E-408 FES-E-409 FES-E-500	ELECTRICAL PANEL SCHEDULES #6 ELECTRICAL PANEL SCHEDULES #7 ELECTRICAL PANEL SCHEDULES #8 ELECTRICAL PANEL SCHEDULES #9 ELECTRICAL DETAILS -1	11-09-23 09-14-23 09-14-23	
FES-E-406 FES-E-407 FES-E-408 FES-E-409 FES-E-500 FES-E-501	ELECTRICAL PANEL SCHEDULES #6 ELECTRICAL PANEL SCHEDULES #7 ELECTRICAL PANEL SCHEDULES #8 ELECTRICAL PANEL SCHEDULES #9 ELECTRICAL DETAILS -1 ELECTRICAL DETAILS -2	11-09-23 09-14-23 09-14-23 09-14-23	
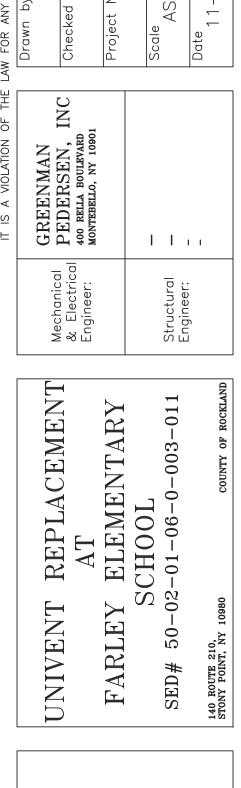

1. ALL PLAN DIMENSIONS ARE NOMINAL U.O.N. DIMENSIONS TO THE FINISHED FACE OF AN ELEMENT OR WALL WILL BE DESIGNATED WITH AN "F" AS SHOWN.

2. G.C. TO VERIFY ALL DIMENSIONS IN THE FIELD AND IS TO

NOTIFY ARCHITECT IF THERE ARE ANY DISCREPANCIES.

**GENERAL NOTES** 

PROVIDE A UNIT PRICE TO REPLACE ADDITIONAL EXISTING SUPPLY AND RETURN PIPING AND INSULATION. PRICE IS PER 10 LINEAR FEET. (THIS AMOUNT WILL ADD OR REDUCE ALLOWANCE NO. 100). UNIT PRICE NO. 101:

PROVIDE A UNIT PRICE FOR THE INSTALLATION OF 10 LF OF LINE SET ENCLOSURE. (THIS AMOUNT WILL ADD OR REDUCE ALLOWANCE NO.

UNIT PRICE NO. 102:

ELECTRICAL CONTRACTOR TO PROVIDE A UNIT PRICE TO RELOCATE AN EXISTING ELECTRICAL DEVICE THAT IS REQUIRED TO BE RELOCATED. PRICE PER 1 DEVICE. (THIS AMOUNT WILL ADD OR REDUCE ALLOWANCE NO. 102).

UNIT PRICE NO. 103:

ELECTRICAL CONTRACTOR TO PROVIDE NEW POWER CONNECTION TO EXISTING UV LOCATION WHERE EXISTING FEEDER CANNOT BE REUSED. PRICE PER 1 FEED. (THIS AMOUNT WILL ADD OR REDUCE ALLOWANCE NO. 103).

**UNIT PRICES** 

ALT. NO. 100: REMOVE EXISTING UNUSED FAN GEAR AND DUCTWORK IN FAN ROOM 201. FILL AND CLOSE EXISTING 2 HR BLOCK WALL WITH NEW BLOCK AT OLD DUCT LOCATIONS.

ALT. NO. 101: INCLUDE CEILING AND LIGHTING REPLACEMENT IN CORRIDORS. SEE FES-D-101, FES-D-102, FES-D-105, FES-A-401, FES-A-402, FES-A-403

ALT. NO. 102: REMOVE EXISTING 12"X12" CONCEALED SPLINE  $\frac{1}{4}$ CEILING. PROVIDE NEW ACT AND REINSTALL LIGHTING. ALT. NO. 104: CONTRACTOR TO INSTALL ONE SWING SET AND TWO ADD A SWING KITS WITH LOCATION TO BE DETERMINED IN THE FIELD BY OWNER. SWING SET TO BE ADA GAMETIME — POWERSCAPE SWINQ/ MODEL # 81598. ADD A BAY TO BE ADA GAMETIME - POWERSCAPE SWING ADD A BAY MODEL # 81599. SWING SET AND ADD A BAYS WILL BE PROVIDED TO THE CONTRACTOR BY THE OWNER

ALT. NO. 105: PROVIDE 1/4" THICK SOLID SURFACE MATERIAL AT ALL UV'S BUILT INTO CASE WORK.

ALT. NO. 106: PROVIDE INSTALLATION FOR NEW CANOPY. CANOPY BE PROVIDED TO THE CONTRACTOR BY THE OWNER. CANOPY MODEL NUMBER RC201810IN. ATTACHED CUT SHEETS HAVE BEEN PROVIDED, FOR THE CONTRACTOR'S REFERENCE. G.C. SHALL INCLUDE NYS P.E SIGNED AND SEALED DRAWINGS FOR FOOTING DESIGN.

**ALTERNATES** 

RETURN PIPING AND INSULATION FOR 30 LINEAR FEET PER EACH UNIT VENTILATOR ALLOWANCE NO. 101: CONTRACTOR TO INCLUDE AN ALLOWANCE FOR THE LF OF LINE

SET ENCLOSURE NOTED ON THE ALLOWANCE NO. 102: PROVIDE ALLOWANCE FOR THE RELOCATION OF 40 ELECTRICAL

ALLOWANCE NO. 103: ELECTRICAL CONTRACTOR TO PROVIDE NEW POWER CONNECTIONS TO 10 EXISTING UV LOCATIONS WHERE EXISTING CANNOT BE REUSED.

DEVICES THAT REQUIRE

RELOCATION DUE TO NEW UV SIZE

ALLOWANCE NO. 104: HAZARDOUS MATERIALS ALLOWANCE.

**ALLOWANCES** 

**LIST OF DRAWINGS** INDIVIDUAL TREATMENT ROOM ABOVE FINISH FLOOR LAMINATE LINEAR FEET

ASPH BLK BLK'G BLOCKING BLK G BUR CLG CONC CONT C.J. DN DIA DWG E.F. EIFS BUILT UP ROOFING CEILING CONCRETE CONTINUOUS CONTROL JOINT DIAMETER DRAWING EACH FACE OPN'G PBC PLAS.LAM EXTERIOR INSULATION AND FINISH SYSTEM ELECTRICAL WATER COOLER PL PLY'D RAD ELECTRICAL CONTRACTOR **EXPANSION EXISTING EXTERIOR** FIREPROOF FINISH(ED) GENERAL CONTRACTOR GALV GALVANIZED

HIGH POINT

U.O.N. V.I.F. UNLESS OTHERWISE NOTED GYPSUM WALL BOARD VERIFY IN FIELD HOLLOW METAL VINYL COMPOSITE TILE HEATING & A/C CONTRACTOR

**ABBREVIATIONS** 

LOW POINT

MANUFACTURER

MASONRY OPENING

PLASTIC LAMINATE

REFLECTED CEILING


SUSPENDED CEILING

TOP OF MASONRY TOP OF STEEL

ROUGH OPENING


MAXIMUM


**PLYWOOD** 

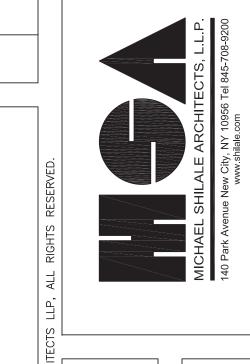


COVER SHEET

000-쁜

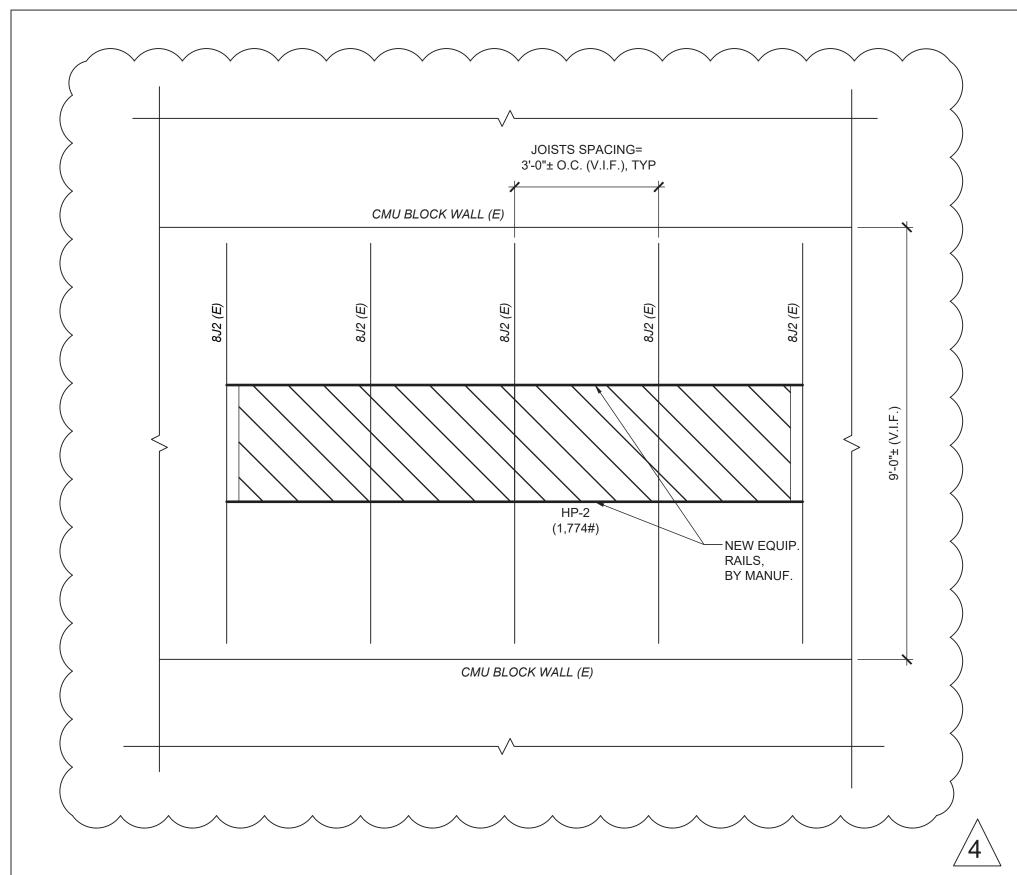


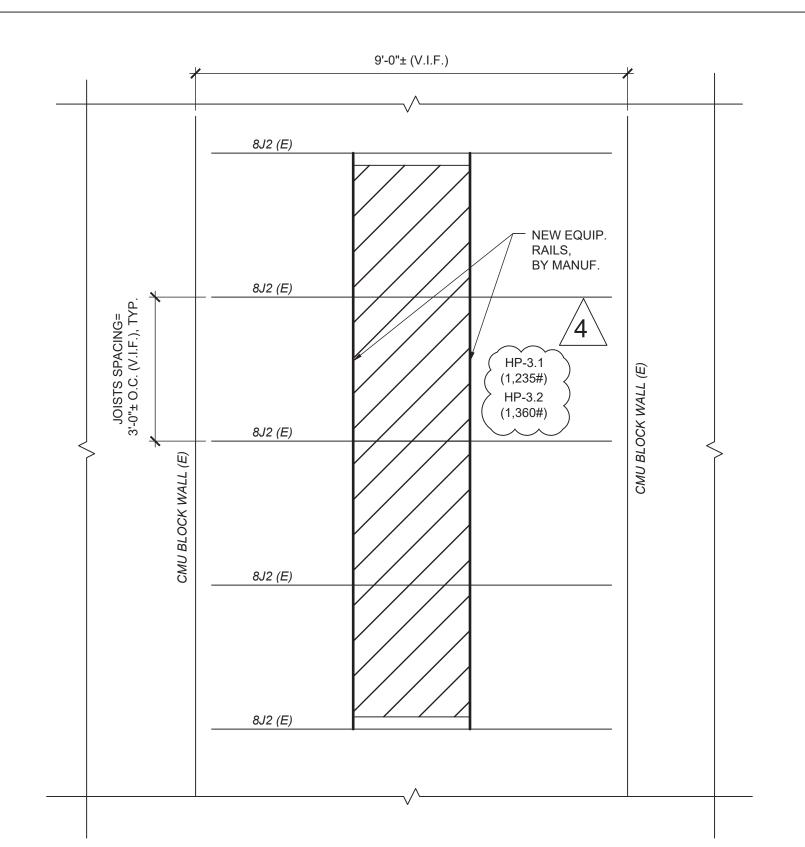

# ROOF PART PLAN UNDER HP-2 SCALE: 1/2" = 1'-0"

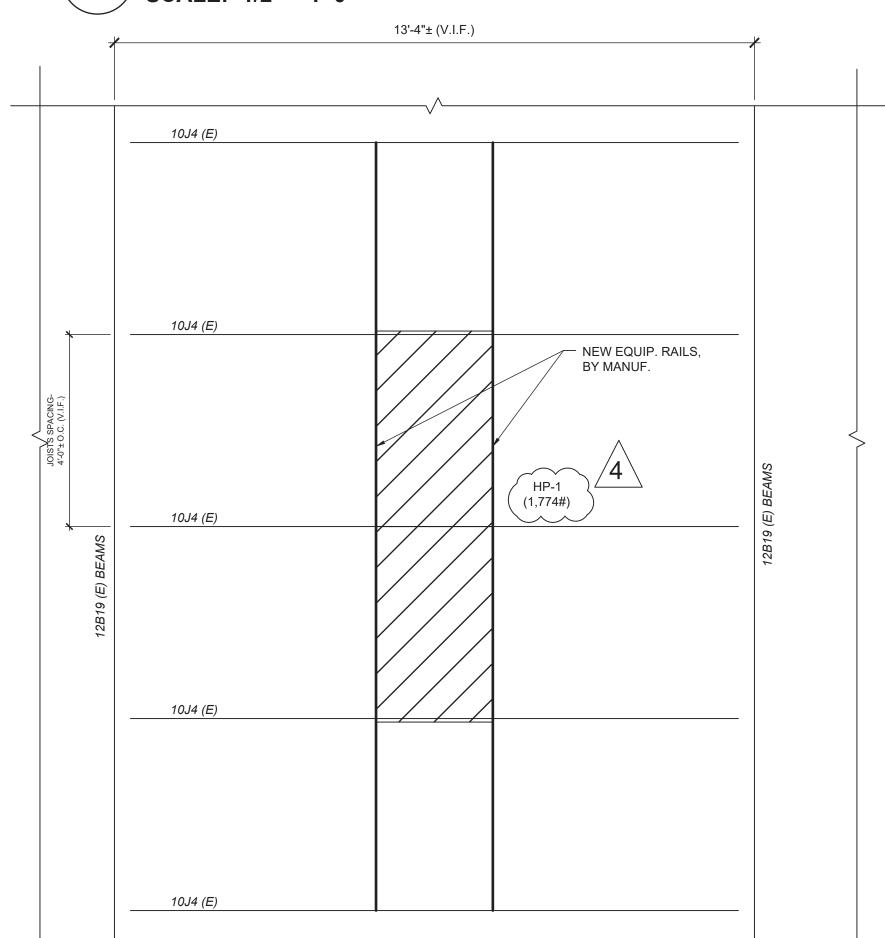

### **ROOF PART PLAN UNDER HP-3.1 & HP3.2** SCALE: 1/2" = 1'-0"

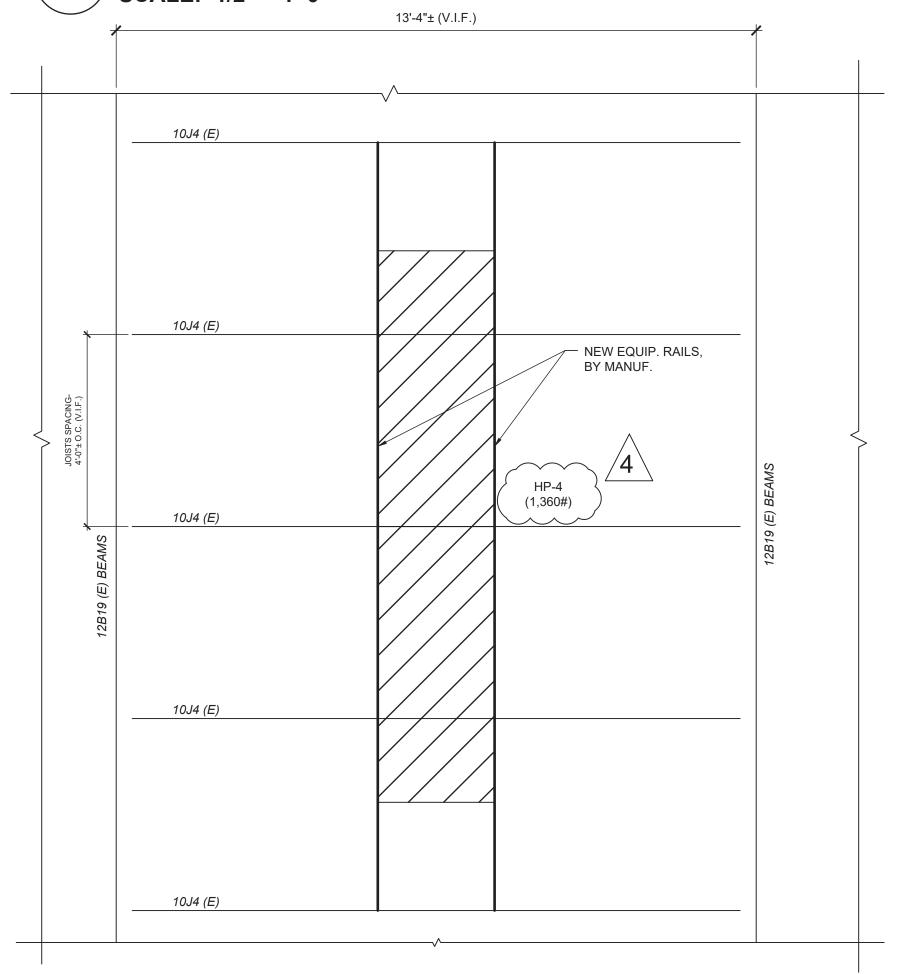


# ROOF PART PLAN UNDER HP-1 SCALE: 1/2" = 1'-0"


# ROOF PART PLAN UNDER HP-4 SCALE: 1/2" = 1'-0"

### **NOTES:**

- 1. ALL UNITS SHALL BE CENTERED ON EXISTING JOISTS.
- 2. ALL EQUIPMENT RAILS SHALL SPAN OVER FIVE (5) EXISTING JOISTS,
- 3. ALL JOISTS SUPPORTING EQUIPMENT RAILS SHALL BE REINFORCED PER DETAIL 5/FES-S-102.
- 4. ALL DIMENSIONS SHALL BE VERIFIED IN FIELD. NOTIFY ENGINEER OF RECORD IF ANY DISCREPANCIES ARE FOUND.
- 5. NO OTHER MECHANICAL OR ELECTRICAL UNITS OR EQUIPMENT
- SHALL BE LOCATED ON JOISTS SUPPORTING THE NEW UNITS.

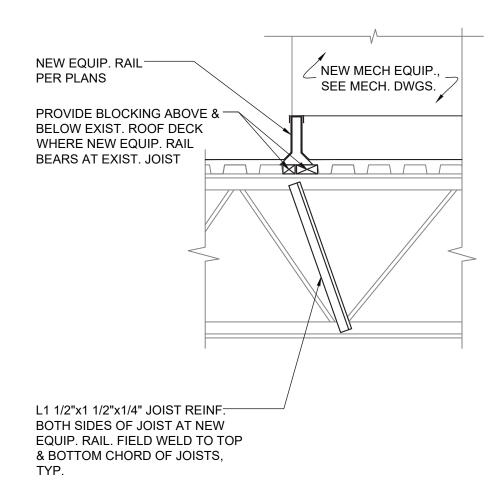



### TYP. EXIST. JOIST REINF. DETAIL SCALE: 3/4" = 1'-0"

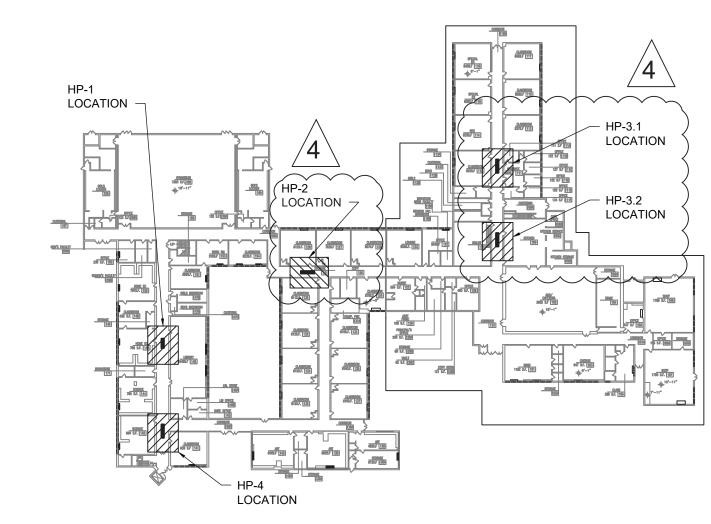

### **ROOF KEY PLAN**



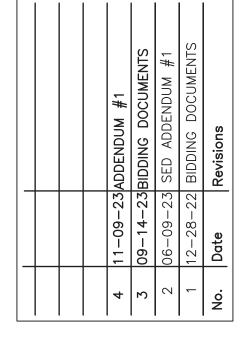

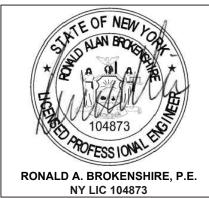

YAY	Checked by RAB	Project No. 42052	Scale AS NOTED	Date 7/29/22

GREENMAN PEDERSEN, INC 2 EXECUTIVE BOULEVARD SUITE 202 SUFFERN, NY 10901	GREENMAN PEDERSEN, INC 2 EXECUTIVE BOULEVARD SUITE 202 SUFFERN, NY 10901
Mechanical & Electrical Engineer:	Structural Engineer:



UNIT VENTILATOR SCHEDULE NOTES:

 PROVIDE WITH CONDENSATE PUMP.
 ELECTRICAL CONTRACTOR TO PROVIDE ALL UNIT VENTILATORS WITH FACTORY MADE DISCONNECT SWITCH.

											UNI	T VENTI	LATOR S	CHED	ULE											
	ASSOCI-			TOTAL		OUTSIDE FLOW	MAXIMUM			COOLI	NG			ŀ	HEATING			FILTER		ELECTR	CAL	UNIT WEIGHT LBS		UNIT DEPTH (IN)	BASIS OF DESIGN	NOTES
UNIT TAG	ATED OUTDOO	LOCATION	CONFIGURATION	SUPPLY AIRFLOW			OUTSIDE AIRFLOW	EADD	E AVA/D	LADD	1 A\A/D	MIN	REQUIRED	HEAT	PUMP	HOT W	ATER			MAX			- UNIT DIMENSIONS (LxH, IN) (V.I.F.)			
	R UNIT			(CFM)	COOLING	HEATING	(CFM)	EADB (°F)	EAWB (°F)	LADB (°F)	LAWB (°F)	TOTAL CAPACITY (BTU/H)	TOTAL CAPACITY (BTU/H)	EADB (°F)	LADB (°F)	EWT LW	I GPW	MERV	MCA	FUSE SIZE	V/PH/HZ		(**************************************		MODEL NUMBER	
UV-141	HP-1	RM 141	VERTICAL	750	435	435	750	82.9	67.0	55	54	22,300	44,200	35.5	90	140 120	4.42	13	4.38	16	115/1/60	320	69x30	21.25	TRANE VUVE075	
UV-142 UV-144	HP-1 HP-1	RM 142 RM 144	VERTICAL VERTICAL	1000 750	470 410	470 410	1000 750	82.0 82.6	67.0 67.0	55 55	54 54	29,700 22,300	51,400 42,500	42.4 37.6	90 90	140 120 140 120			4.38 4.38	16 16	115/1/60 115/1/60	405 320	81x30 69x30	21.25	TRANE VUVE100 TRANE VUVE075	
UV-145A	HP-1	RM 145	VERTICAL	1000	185	185	1000	79.6	67.0	55	54	29,700	32,000	60.3	90	140 120	_	13	4.38	16	115/1/60	405	81x30	21.25	TRANE VUVE100	
UV-145B	HP-1	RM 145	VERTICAL	1000	185	185	1000	79.6	67.0	55	54	29,700	32,000	60.3	90	140 120	3.2	13	4.38	16	115/1/60	405	81x30	21.25	TRANE VUVE100	
UV-146 UV-148	HP-1 HP-1	RM 146 RM 148	VERTICAL VERTICAL	750 750	415 290	415 290	750 750	82.7 81.3	67.0 67.0	55 55	54 54	22,300 22,300	42,800 34,300	37.1 47.6	90 90	140 120 140 120	_		4.38	16	115/1/60 115/1/60	320 320	69x30 69x30	21.25	TRANE VUVE075 TRANE VUVE075	
UV-140	HP-1	RM 150	VERTICAL	750	420	420	750	82.8	67.0	55	54	22,300	43,200	36.7	90	140 120	_		4.38	16 16	115/1/60	320	69x30	21.25	TRANE VUVE075	
UV-151	HP-1	RM 151	VERTICAL	750	300	300	750	81.4	67.0	55	54	22,300	35,000	46.8	90	140 120		13	4.38	16	115/1/60	320	69x30	21.25	TRANE VUVE075	
UV-152	HP-1	RM 152	VERTICAL	750	50	50	750 750	78.6	67.0	55 55	54	22,300	18,000	67.8	90	140 120	_	13	4.38	16	115/1/60	320	69x30	21.25	TRANE VUVE075	
UV-153 UV-154A	HP-1 HP-1	RM 153 RM 154	VERTICAL VERTICAL	750 750	270 165	270 165	750 750	81.1 79.9	67.0 67.0	55 55	54 54	22,300 22,300	33,000 25,800	49.3 58.1	90 90	140 120 140 120	_	13 13	4.38	16 16	115/1/60 115/1/60	320 320	69x30 69x30	21.25	TRANE VUVE075 TRANE VUVE075	
UV-154B	HP-1	RM 154	VERTICAL	750	165	165	750	79.9	67.0	55	54	22,300	25,800	58.1	90	140 120	_		4.38	16	115/1/60	320	69x30	21.25	TRANE VUVE075	
UV-158	HP-1	RM 158	HORIZONTAL	1250	450	450	1250	81.1	67.0	55	54	37,100	54,900	49.3	90	140 120	_		12	16	115/1/60	435	94.25x38	21.25	TRANE HUVC125	1
UV-123 UV-124	HP-2 HP-2	RM 123 RM 124	VERTICAL VERTICAL	750 750	80 305	80 305	750 750	78.9 81.5	67.0 67.0	55 55	54 54	22,300 22,300	20,000 35,300	65.3 46.4	90 90	140 120 140 120		13 13	4.38 4.38	16 16	115/1/60 115/1/60	320 320	69x30 69x30	21.25	TRANE VUVE075 TRANE VUVE075	
UV-125	HP-2	RM 125	VERTICAL	750	425	425	750	82.8	67.0	55	54	22,300	43,500	36.3	90	140 120		_	4.38	16	115/1/60	320	69x30	21.25	TRANE VUVE075	
UV-127	HP-2	RM 127	VERTICAL	750	410	410	750	82.6	67.0	55	54	22,300	42,500	37.6	90	140 120	_	13	4.38	16	115/1/60	320	69x30	21.25	TRANE VUVE075	
UV-129 UV-130	HP-2 HP-2	RM 129 RM 130	VERTICAL VERTICAL	750 750	425 425	425 425	750 750	82.8 82.8	67.0 67.0	55 55	54 54	22,300 22,300	43,500 43,500	36.3 36.3	90 90	140 120 140 120	4.35 4.35		4.38 4.38	16	115/1/60 115/1/60	320 320	69x30 69x30	21.25	TRANE VUVE075 TRANE VUVE075	
UV-132	HP-2	RM 132	VERTICAL	750	425	425	750	82.8	67.0	55	54	22,300	43,500	36.3	90	140 120		_	4.38	16	115/1/60	320	69x30	21.25	TRANE VUVE075	
UV-133	HP-2	RM 133	VERTICAL	750	430	430	750	82.9	67.0	55	54	22,300	43,800	35.9	90	140 120	_	13	4.38	16	115/1/60	320	69x30	21.25	TRANE VUVE075	
UV-134 UV-135	HP-2 HP-2	RM 134 RM 135	VERTICAL VERTICAL	750 750	425 430	425 430	750 750	82.8 82.9	67.0 67.0	55 55	54 54	22,300 22,300	43,500 43,800	36.3 35.9	90	140 120 140 120		13 13	4.38	16	115/1/60 115/1/60	320 320	69x30 69x30	21.25	TRANE VUVE075 TRANE VUVE075	
UV-136	HP-2	RM 136	VERTICAL	750	425	425	750	82.8	67.0	55	54	22,300	43,500	36.3	90 90	140 120	_	_	4.38	16 16	115/1/60	320	69x30	21.25	TRANE VUVE075	
UV-137	HP-2	RM 137	VERTICAL	750	430	430	750	82.9	67.0	55	54	22,300	43,800	35.9	90	140 120			4.38	16	115/1/60	320	69x30	21.25	TRANE VUVE075	
UV-138A	HP-2	RM 138A	VERTICAL	750	255	255	750	80.9	67.0	55 55	54	22,300	31,900	50.6	90	140 120	_	13	4.38	16	115/1/60	320	69x30	21.25	TRANE VUVE075	
UV-138B UV-139	HP-2 HP-2	RM 138B RM 139	HORIZONTAL VERTICAL	750 1000	270 470	270 470	750 1000	82.0	67.0 67.0	55 55	54 54	22,300 29,700	33,000 51,400	49.3 42.4	90 90	140 120 140 120		13 13	4.38	16 16	115/1/60 115/1/60	340 405	70.25x36 81x30	21.25	TRANE HUVC075 TRANE VUVE100	
UV-140	HP-2	RM 140	VERTICAL	750	445	445	750	83.0	67.0	55	54	22,300	44,900	34.6	90	140 120	_	13	4.38	16	115/1/60	320	69x30	21.25	TRANE VUVE075	
UV-159	HP-1	RM 159	HORIZONTAL	1250	400	400	1250	80.7	67.0	55	54	37,100	51,500	51.8	90	140 120	_		12	16	115/1/60	435	94.25x38	21.25	TRANE HUVC125	1
UV-101A UV-101B	HP-3 HP-3	RM 101 RM 101	VERTICAL VERTICAL	750 750	255 255	255 255	750 750	80.9 80.9	67.0 67.0	55 55	54 54	22,300 22,300	31,900 31,900	50.6 50.6	90 90	140 120 140 120		13 13	4.38	16 16	115/1/60 115/1/60	320 320	69x30 69x30	21.25	TRANE VUVE075 TRANE VUVE075	
UV-103	HP-3	RM 103	VERTICAL	1000	435	435	1000	81.7	67.0	55	54	29,700	49,000	44.6	90	140 120	_	13	4.38	16	115/1/60	405	81x30	21.25	TRANE VUVE100	
UV-105	HP-3	RM 105	VERTICAL	750	115	115	750	79.3	67.0	55	54	22,300	22,400	62.3	90	140 120		13	4.38	16	115/1/60	320	69x30	21.25	TRANE VUVE075	
UV-106 UV-107	HP-3 HP-3	RM 106 RM 107	VERTICAL HORIZONTAL	750 2000	760	760	750 2000	78.5 81.2	67.0 67.0	55 55	54 54	22,300 59,400	17,300 90,600	68.6 48.1	90 90	140 120 140 120		13 13	4.38	16 16	115/1/60 115/1/60	320 600	69x30 106.25x43	21.25	TRANE VUVE075 TRANE HUVC200	1
UV-108	HP-3	RM 108	HORIZONTAL	2000	755	755	2000	81.2	67.0	55	54	59,400	90,300	48.2	90	140 120			12	16	115/1/60	600	106.25x43	21.25	TRANE HUVC200	1
UV-111	HP-3	RM 111	HORIZONTAL	750	250	250	750	80.8	67.0	55	54	22,300	31,600	51.0	90	140 120		13	12	16	115/1/60	340	70.25x36	21.25	TRANE HUVC075	1
UV-112 UV-113	HP-3 HP-3	RM 112 RM 113	VERTICAL VERTICAL	750 750	440	440	750 750	83.0 83.0	67.0 67.0	55 55	54 54	22,300 22,300	44,500 44,500	35.0 35.0	90 90	140 120 140 120			4.38	16 16	115/1/60 115/1/60	320 320	69x30 69x30	21.25	TRANE VUVE075 TRANE VUVE075	
UV-114	HP-3	RM 114	VERTICAL	750	440	440	750	83.0	67.0	55	54	22,300	44,500	35.0	90	140 120			4.38	16	115/1/60	320	69x30	21.25	TRANE VUVE075	
UV-115	HP-3	RM 115	VERTICAL	750	450	450	750	83.1	67.0	55	54	22,300	45,200	34.2	90	140 120	_		4.38	16	115/1/60	320	69x30	21.25	TRANE VUVE075	
UV-116 UV-117	HP-3 HP-3	RM 116 RM 117	VERTICAL VERTICAL	750 750	440	440 445	750 750	83.0 83.0	67.0 67.0	55 55	54 54	22,300 22,300	44,500 44,900	35.0 34.6	90 90	140 120 140 120			4.38	16 16	115/1/60 115/1/60	320 320	69x30 69x30	21.25	TRANE VUVE075 TRANE VUVE075	
UV-117	HP-3	RM 118	VERTICAL	750	445	445	750	83.0	67.0	55	54	22,300	44,900	34.6	90	140 120			4.38	16	115/1/60	320	69x30	21.25	TRANE VUVE075	
UV-121	HP-3	RM 121	VERTICAL	750	50	50	750	78.6	67.0	55	54	22,300	18,000	67.8	90	140 120		13	4.38	16	115/1/60	320	69x30	21.25	TRANE VUVE075	
UV-122 IU-120	HP-3 HP-3	RM 122 RM 120	VERTICAL CEILING CASSETTE	750 280	60	60	750 280	78.7 78.6	67.0 67.0	55 55	54 54	22,300 12,000	18,700 13,500	67.0 67.5	90 90	140 120 N/A N//	<del>/                                     </del>	13	4.38 0.29	16	115/1/60 208/1/160	320 31.3	69x30 22.44x8.2	21.25	TRANE VUVE075  RANE TPLFYP012FM14	400
IU-128	HP-3		CEILING CASSETTE	280	35	35	280	79.1	67.0	55	54	12,000	13,500	64.1	90	N/A N/A			0.29	15	208/1/160		22.44x8.3		RANE TPLFYP012FM14	/
IU-128A	HP-3		CEILING CASSETTE	280	35	35	280	79.1	67.0	55	54	12,000	13,500	64.1	90	N/A N/	_	13	0.29		208/1/160	31.3	22.44x8.4	22.4 T	RANE TPLFYP012FM14	40A
IU-128D	HP-3		CEILING CASSETTE	280	35	35	280	79.1	67.0	55 55	54	12,000	13,500	64.1	90	N/A N/		13	0.29	15	208/1/160	+	22.44x8.5		RANE TPLFYP012FM14	\
IU-158A IU-159A	HP-1 HP-1		CEILING CASSETTE   CEILING CASSETTE	280 280	35	35 35	280 280	79.1 79.1	67.0 67.0	55 55	54 54	12,000 12,000	13,500 13,500	64.1 64.1	90 90	N/A N// N/A N//		13 13	0.29	15 15	208/1/160	31.3 31.3	22.44x8.6 22.44x8.7		RANE TPLFYP012FM14 RANE TPLFYP012FM14	<u> </u>
ÚV-202	HP-4	RM 202	VERTICAL		435	435	750	82.9	67.0	<b>55</b>	54	22,300	44,200	35.5	<del>90</del>		4.42		4.38		115/1/60			21.25	TRANE VUVE075	
UV-203	HP-4	RM 203	VERTICAL	750 750	415	415	750 750	82.7	67.0	55 55	54 54	22,300	42,800	37.1	90	140 120	_	_	4.38	16	115/1/60	320	69x30	21.25	TRANE VUVE075	
UV-204 UV-205	HP-4 HP-4	RM 204 RM 205	VERTICAL VERTICAL	750 750	330 50	330 50	750 750	81.7 78.6	67.0 67.0	55 55	54 54	22,300 22,300	37,000 18,000	44.3 67.8	90 90	140 120 140 120		13 13	4.38	16 16	115/1/60 115/1/60	320 320	69x30 69x30	21.25	TRANE VUVE075 TRANE VUVE075	
UV-206	HP-4	RM 206	VERTICAL	750	330	330	750	81.7	67.0	55	54	22,300	37,000	44.3	90	140 120		13	4.38	16	115/1/60	320	69x30	21.25	TRANE VUVE075	
UV-207	HP-4	RM 207	VERTICAL	750	410	410	750	82.6	67.0	55 55	54	22,300	42,500	37.6	90	140 120	_	_	4.38	16	115/1/60	320	69x30	21.25	TRANE VUVE075	
UV-208 UV-209	HP-4 HP-4	RM 208 RM 209	VERTICAL VERTICAL	1000 750	490 415	490 415	1000 750	82.2 82.7	67.0 67.0	55 55	54 54	29,700 22,300	52,800 42,800	41.1 37.1	90 90	140 120 140 120		_	4.38 4.38	16 16	115/1/60 115/1/60	405 320	81x30 69x30	21.25	TRANE VUVE100 TRANE VUVE075	
UV-210	HP-4	RM 210	VERTICAL	750	420	420	750	82.8	67.0	55	54	22,300	43,200	36.7	90	140 120	_	-	4.38	16	115/1/60	320	69x30	21.25	TRANE VUVE075	
UV-211	HP-4	RM 211	VERTICAL	750	410	410	750	82.6	67.0	55	54	22,300	42,500	37.6	90	140 120	4.25	13	4.38	16	115/1/60	320	69x30	21.25	TRANE VUVE075	
UV-212	HP-4	RM 212	VERTICAL VERTICAL	1000	490	490	1000	82.2 82:8	67.0	55 <del>55</del>	54 54	29,700	52,800	41.1	90	140 120	5.28		4.38	16	115/1/60	405 320	81x30 69x30	21.25	TRANE VUVE100  TRANE VUVE075	
UV-213*	IIF <b>-4</b> `	TAIVIZ 13 Y	VENTIOAL · ·	750.	420	420	150 - 7	UZ:U *	01.0	- JJ ·	J <del>T</del> *	<u>کک</u> ,۵00	13,200	JU.1'	a0 ,	140   120	, <sub> </sub> 4.32	13 *	4.30	10 *	1 13/1/00	320*	T OBYOU , ,	21.20	CIUDVUV JAINTI	

							D	UCTL	ESS HEAT	PUMP C	OUTDOO	R UN	IIT SC	HE	DULE					
UNIT#	LOCATION	TOTAL COOLING	HEATING CAPACITY	EER	IEER	REFRIG-		REFRIG CHARGE	HEATING TYPE	CONDENSER	COMPRESSOR (QUANTITY)		I	ELECTF	RICAL		UNIT WEIGHT	BASIS	OF DESIGN	REMARKS
		CAPACITY (MBH)	(MBH)			ERANT	SAFETY CLASS	(LBS)		EA DB °F (COOLING/ HEATING)	TYPE	VOLTS	PHASE	Hz	MOCP (A)	MCA (A)	(LBS)	MANUFACTURER	MODEL#	
HP-1	ROOF	432.0	480.0	9.95	15.0	R410A	A1	52.125	HEAT PUMP	95/0	SCROLL (2)	208	3	60	90 / 90	73.0 / 73.0	1,774	TRANE	TURYE4323BN40A(N/B)	SEE NOTES
HP-2	ROOF	432.0	480.0	9.95	15.0	R410A	A1	52.125	HEAT PUMP	95/0	SCROLL (2)	208	3	60	90 / 90	73.0 / 73.0	1,774	TRANE	TURYE4323BN40A(N/B)	SEE NOTES
HP-3.1	ROOF	216.0	243.0	12.85	27.5	R410A	A1	34.375	HEAT PUMP	95/0	SCROLL (2)	208	3	60	60 / 45	41.0 / 31.0	1,235	TRANE	TURYE216BN40A(N/B)	SEE NOTES
HP-3.2	ROOF	288.0	320.0	11.2	23.6	R410A	A1	46.750	HEAT PUMP	95/0	SCROLL (2)	208	3	60	60 / 60	49.0 / 49.0	1,360	TRANE	TURYE2883BN40A(N/B)	SEE NOTES
HP-4	ROOF	288.0	320.0	11.2	23.6	R410A	A1	46.750	HEAT PUMP	95/0	SCROLL (2)	208	3	60	60 / 60	49.0 / 49.0	1,360	TRANE	TURYE2883BN40A(N/B)	SEE NOTES

DUCTLESS SPLIT-SYSTEM OUTDOOR UNIT SCHEDULE NOTES:

1. REFER TO THE DUCTLESS HEAT PUMP INDOOR UNIT SCHEDULE FOR CORRESPONDING INDOOR UNITS. ALL UNITS SHALL BE A PRODUCT OF ONE MANUFACTURER. 2. FURNISH DISCONNECT SWITCH TO BE INSTALLED AND WIRED BY ELECTRICAL CONTRACTOR.

3. PROVIDE STAND ALONE FACTORY INSTALLED DIRECT DIGITAL CONTROLS AS NECESSARY TO SATISFY THE SEQUENCE OF OPERATIONS.

4. PROVIDE VIBRATION ISOLATION.
5. PROVIDE MANUFACTURER'S STANDARD OUTDOOR UNIT DRAIN PAN WITH BASE PAN HEATER AND PIPE TO NEARBY DRAIN.
6. PROVIDE WIND BAFFLE AND OTHER ASCESSORIES AS REQUIRED BY THE MANUFACTURER FOR LOW AMBIENT SOOLING AND THEATING TO 84 OUTDOOR DRY BULB TEMPERATURE.

### VRF HEAT RECOVERY BRANCH CIRCUIT CONTROLLER SCHEDULE

TAG REFERENCE	MODEL NUMBER	TYPE (DOUBLE / MAIN / SUB)	NUMBER OF PORTS	CONNECTED CAPACITY TO BC	VOLTAGE / PHASE	POWER COOLING 208V/230V (KW)	POWER HEATING 208V/230V (KW)	MCA 208/230	NOTES / OPTIONS
BC-1A	TCMBM1016KA11N4	MAIN	16	450,000	208/230V/1-PHASE	0.258/0.333	0.137/0.176	1.6/1.8	1, 2, 3, 4, 5
BC-1B	TCMBS0108KB11N4	SUB	8	108,000	208/230V/1-PHASE	0.122/0.157	0.061/0.078	0.7/0.9	1, 2, 3, 4,
BC-2A	TCMBM1016KA11N4	MAIN	16	390,000	208/230V/1-PHASE	0.258/0.333	0.137/0.176	1.6/1.8	1, 2, 3, 4,
BC-2B	TCMBS0108KB11N4	SUB	8	96,000	208/230V/1-PHASE	0.122/0.157	0.061/0.078	0.7/0.9	1, 2, 3, 4, 5
BC-2C	TCMBS0108KB11N4	SUB	8	102,000	208/230V/1-PHASE	0.122/0.157	0.061/0.078	0.7/0.9	1, 2, 3, 4, 5
BC-3A	TCMBM1012JA11N4	MAIN	12	243,000	208/230V/1-PHASE	0.198/0.255	0.106/0.137	1.2/1.4	1, 2, 3, 4, 5
BC-3B	TCMBM1016KA11N4	MAIN	16	363,000	208/230V/1-PHASE	0.258/0.333	0.137/0.176	1.6/1.8	1, 2, 3, 4,
BC-4	TCMBM1016KA11N4	MAIN	16	339,000	208/230V/1-PHASE	0.258/0.333	0.137/0.176	1.6/1.8	1, 2, 3, 4, 5

BC CONTROLLER SCHEDULE NOTES:

1. INCLUDE DIAMONDBACK BALL VALVES BV-SERIES, 700PSIG WORKING PRESSURE, FULL PORT, 410A RATED.

2. A SUB BC CONTROLLER IS NOT REQUIRED FOR THIS PROJECT. FOR SUB BC CONTROLLER INFO, SEE MANUFACTURER'S INSTALLATION INSTRUCTIONS.


3. PROVIDE REFRIGERATION BALL VALVE-BRAZE/SCHRADER/INSULATED - 3/8" SIZE PROVIDE REFRIGERATION BALL VALVE-BRAZE/SCHRADER/INSULATED - 5/8 SIZE


4. PROVIDE REFRIGERATION BALL VALVE-BRAZE/SCHRADER/INSULATED - 5/8" SIZE


5. PROVIDE 3/4" NPT DRAIN PIPE TO LOCATIONS SHOWN ON PLANS.

4	11-09-23	11-09-23ADDENDUM #1
8	09-14-23	09-14-23 BIDDING DOCUMENTS
2	06-09-23	06-09-23 SED ADDENDUM #1
	12-28-22	12-28-22 BIDDING DOCUMENTS
Š	Date	Revisions

	ш		0,		_
GREENMAN PEDERSEN, INC 2 EXECUTIVE BOULEVARD SUITE 202 SUFFERN, NY 10901		CPFFNWAN	PEDERSEN, INC	2 EXECUTIVE BOULEVARD	SUITE 202
Mechanical & Electrical Engineer:			Structural	Engineer:	

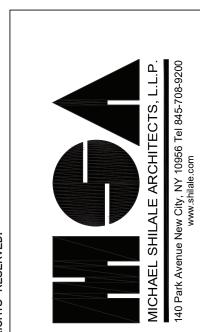

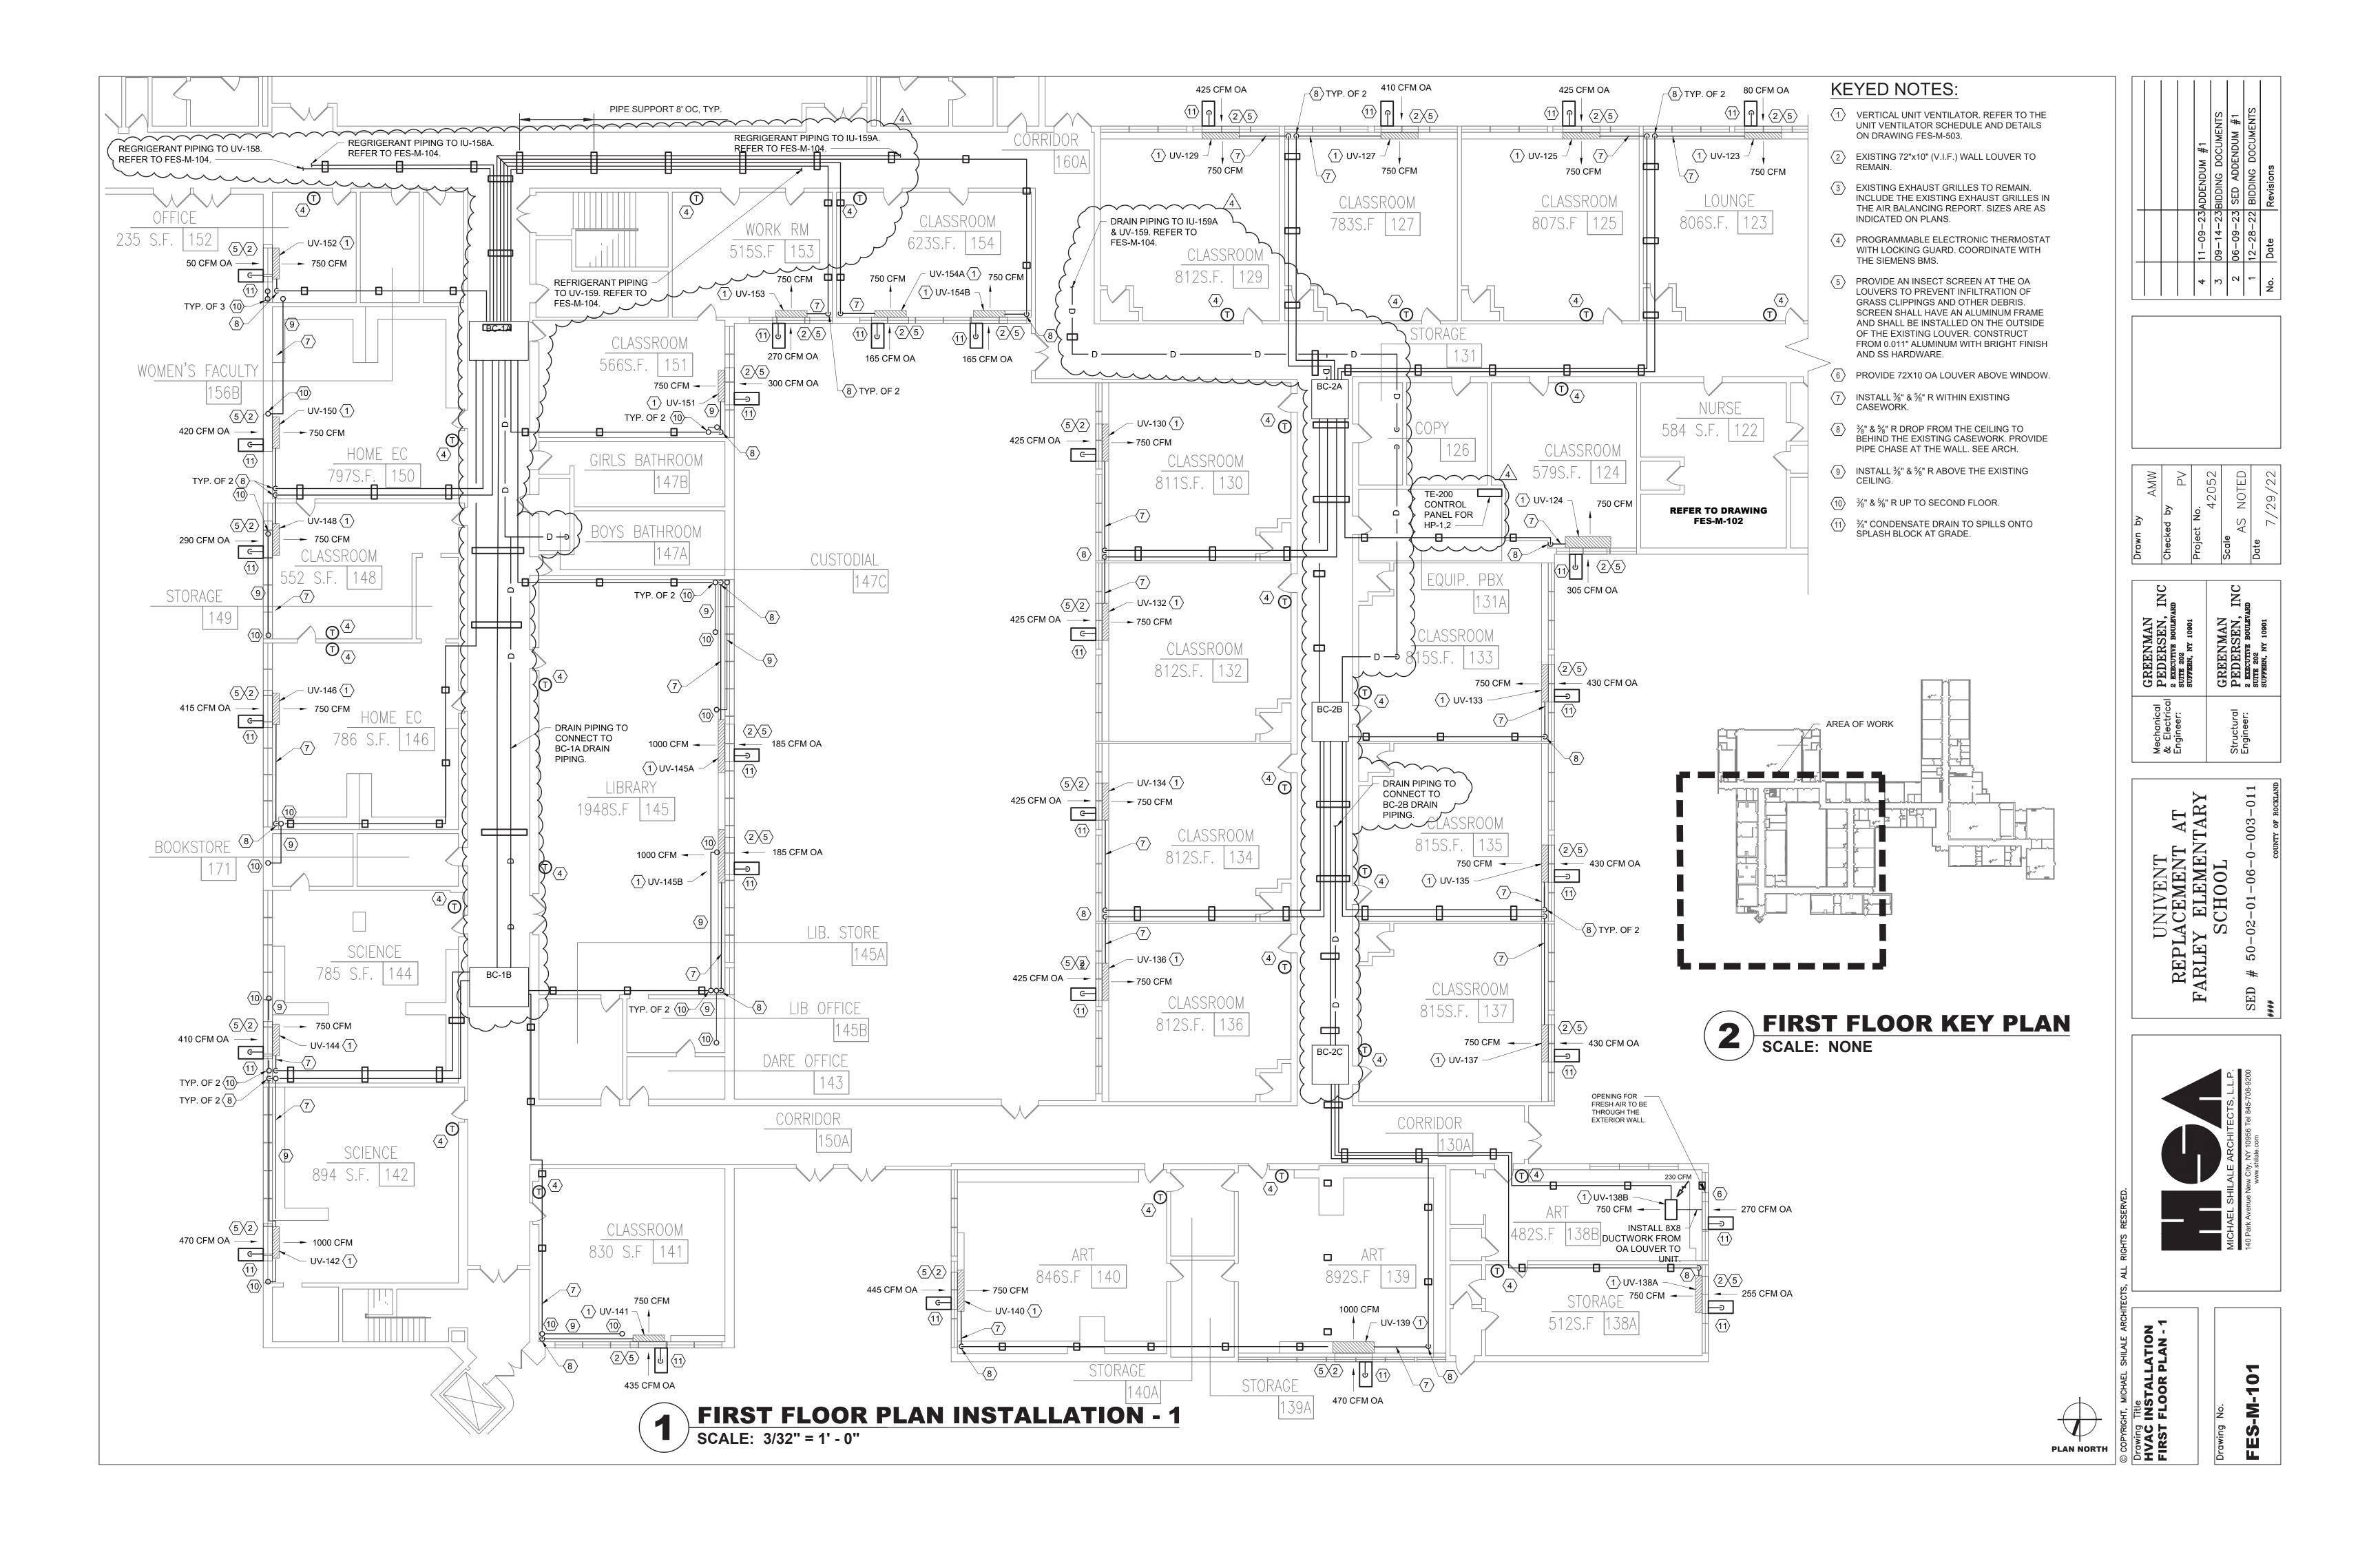

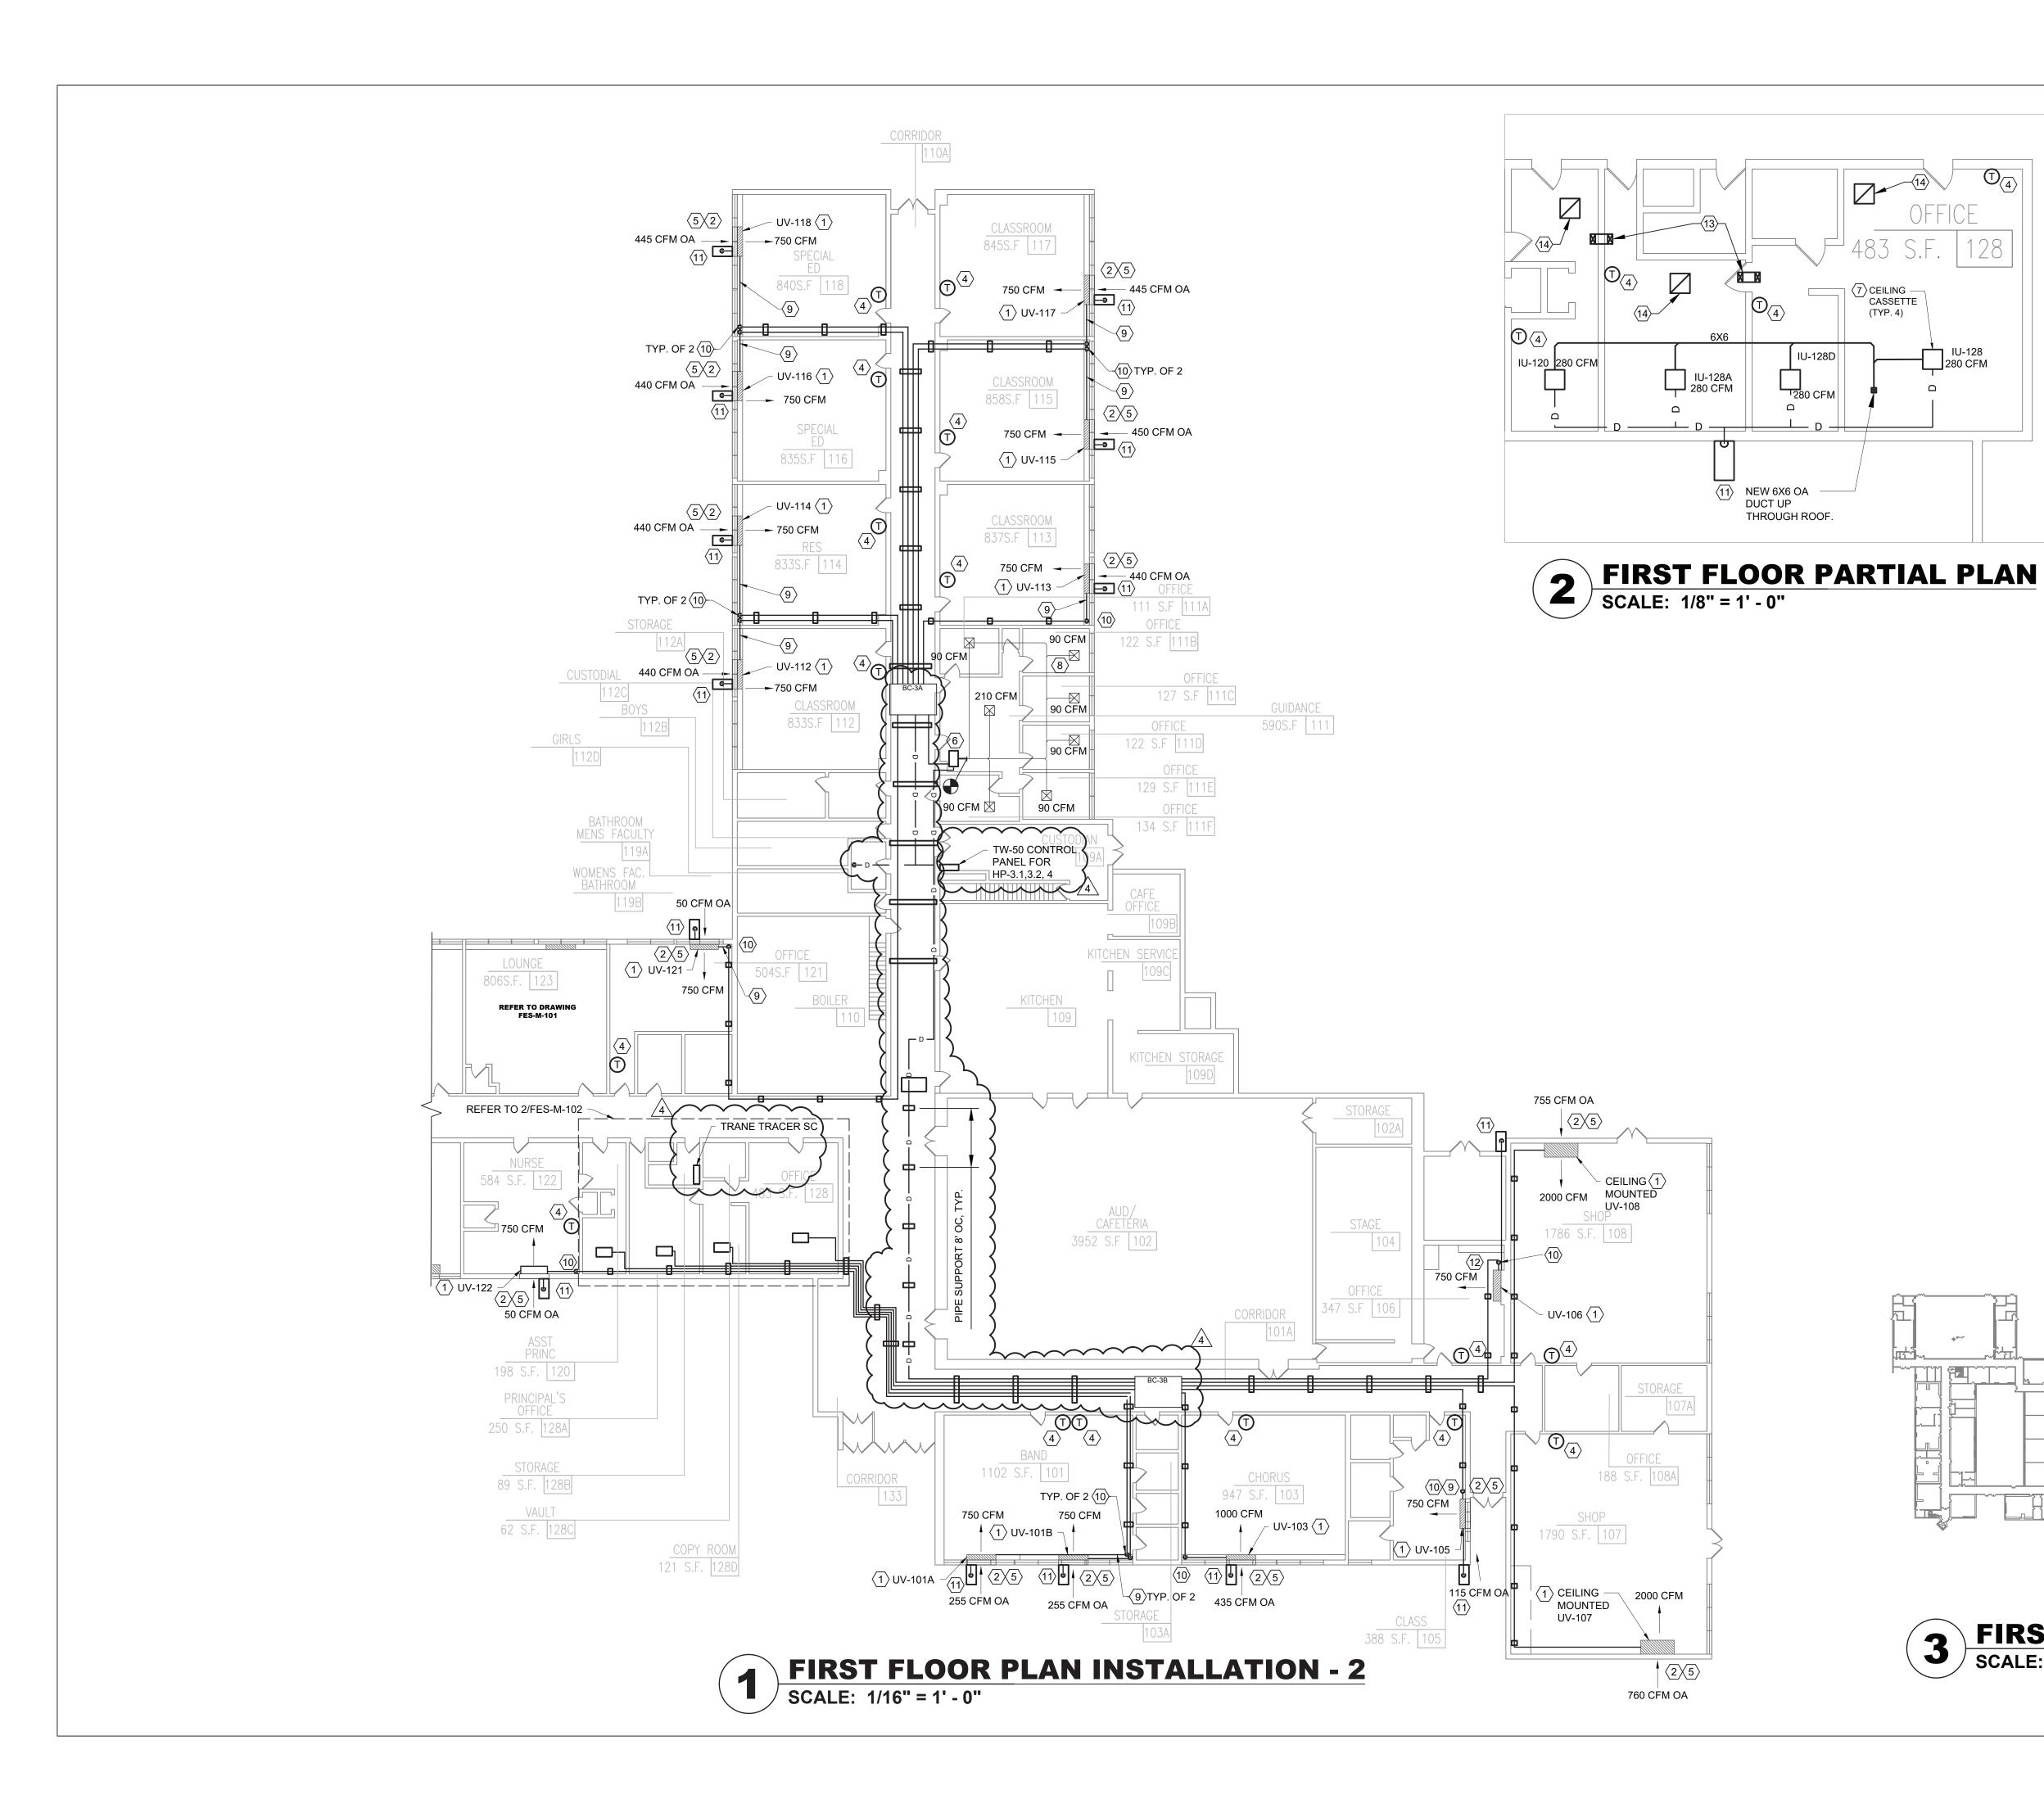

### **KEYED NOTES:**

**□** IU-128


\_\_\_\_280 CFM

- (1) VERTICAL UNIT VENTILATOR. REFER TO THE UNIT VENTILATOR SCHEDULE AND DETAILS ON DRAWING FES-M-503.
- 2 EXISTING 72"x10" (V.I.F.) WALL LOUVER TO REMAIN.
- (3) EXISTING EXHAUST GRILLES TO REMAIN. INCLUDE THE EXISTING EXHAUST GRILLES IN THE AIR BALANCING REPORT. SIZES ARE AS INDICATED ON PLANS.
- $\overline{\langle 4 \rangle}$  PROGRAMMABLE ELECTRONIC THERMOSTAT WITH LOCKING GUARD. COORDINATE WITH THE SIEMENS BMS.
- (5) PROVIDE AN INSECT SCREEN AT THE OA LOUVERS TO PREVENT INFILTRATION OF GRASS CLIPPINGS AND OTHER DEBRIS. SCREEN SHALL HAVE AN ALUMINUM FRAME AND SHALL BE INSTALLED ON THE OUTSIDE OF THE EXISTING LOUVER. CONSTRUCT FROM 0.011" ALUMINUM WITH BRIGHT FINISH AND SS HARDWARE.
- (6) UV-111 TO TIE INTO THE EXISTING SUPPLY & OUTSIDE AIR DUCTWORK.
- $\overline{\langle 7 \rangle}$  CEILING CASSETTE AT CEILING.
- (8) EXISTING CEILING SUPPLY DIFFUSER TO REMAIN. TYPICAL (7).
- 9 INSTALL 3/8" & 5/8" R WITHIN EXISTING CASEWORK.
- 38" & 58" R DROP FROM THE CEILING TO BEHIND THE EXISTING CASEWORK. PROVIDE PIPE CHASE AT THE WALL. SEE ARCH.
- (11) 3/4" CONDENSATE DRAIN TO SPILLS ONTO SPLASH BLOCK AT GRADE.
- PROVIDE UNIT VENTILATOR WITH CONDENSATE LIFT PUMP.
- 12"x6" TRANSFER DUCT ABOVE CEILING (PRICE CROSS TALK SILENCER XT OR EQUAL)
- $\langle 14 \rangle$  24'x24' RG AT CEILING.

AREA OF WORK






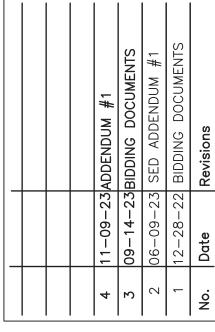



РУ	052	TED	/22	


\ \ \ \ \ \ \ \ \ \ \ \ \ \ \ \ \ \ \	Checked by	<u>d</u>	Project No.	42052	Scale	AS NOTEI	Date	70/60/7
7 '	<u> </u>				7			

GREENMAN PEDERSEN, INC 2 EXECUTIVE BOULEVARD SUITE 202 SUFFERN, NY 10901	GREENMAN PEDERSEN, INC 2 EXECUTIVE BOULEVARD SUITE 202 SUITERN, NY 10901
Mechanical & Electrical Engineer:	Structural Engineer:

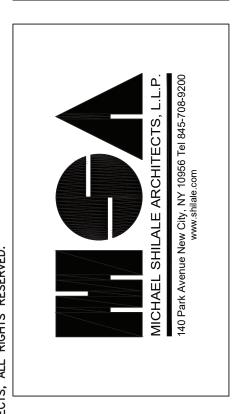


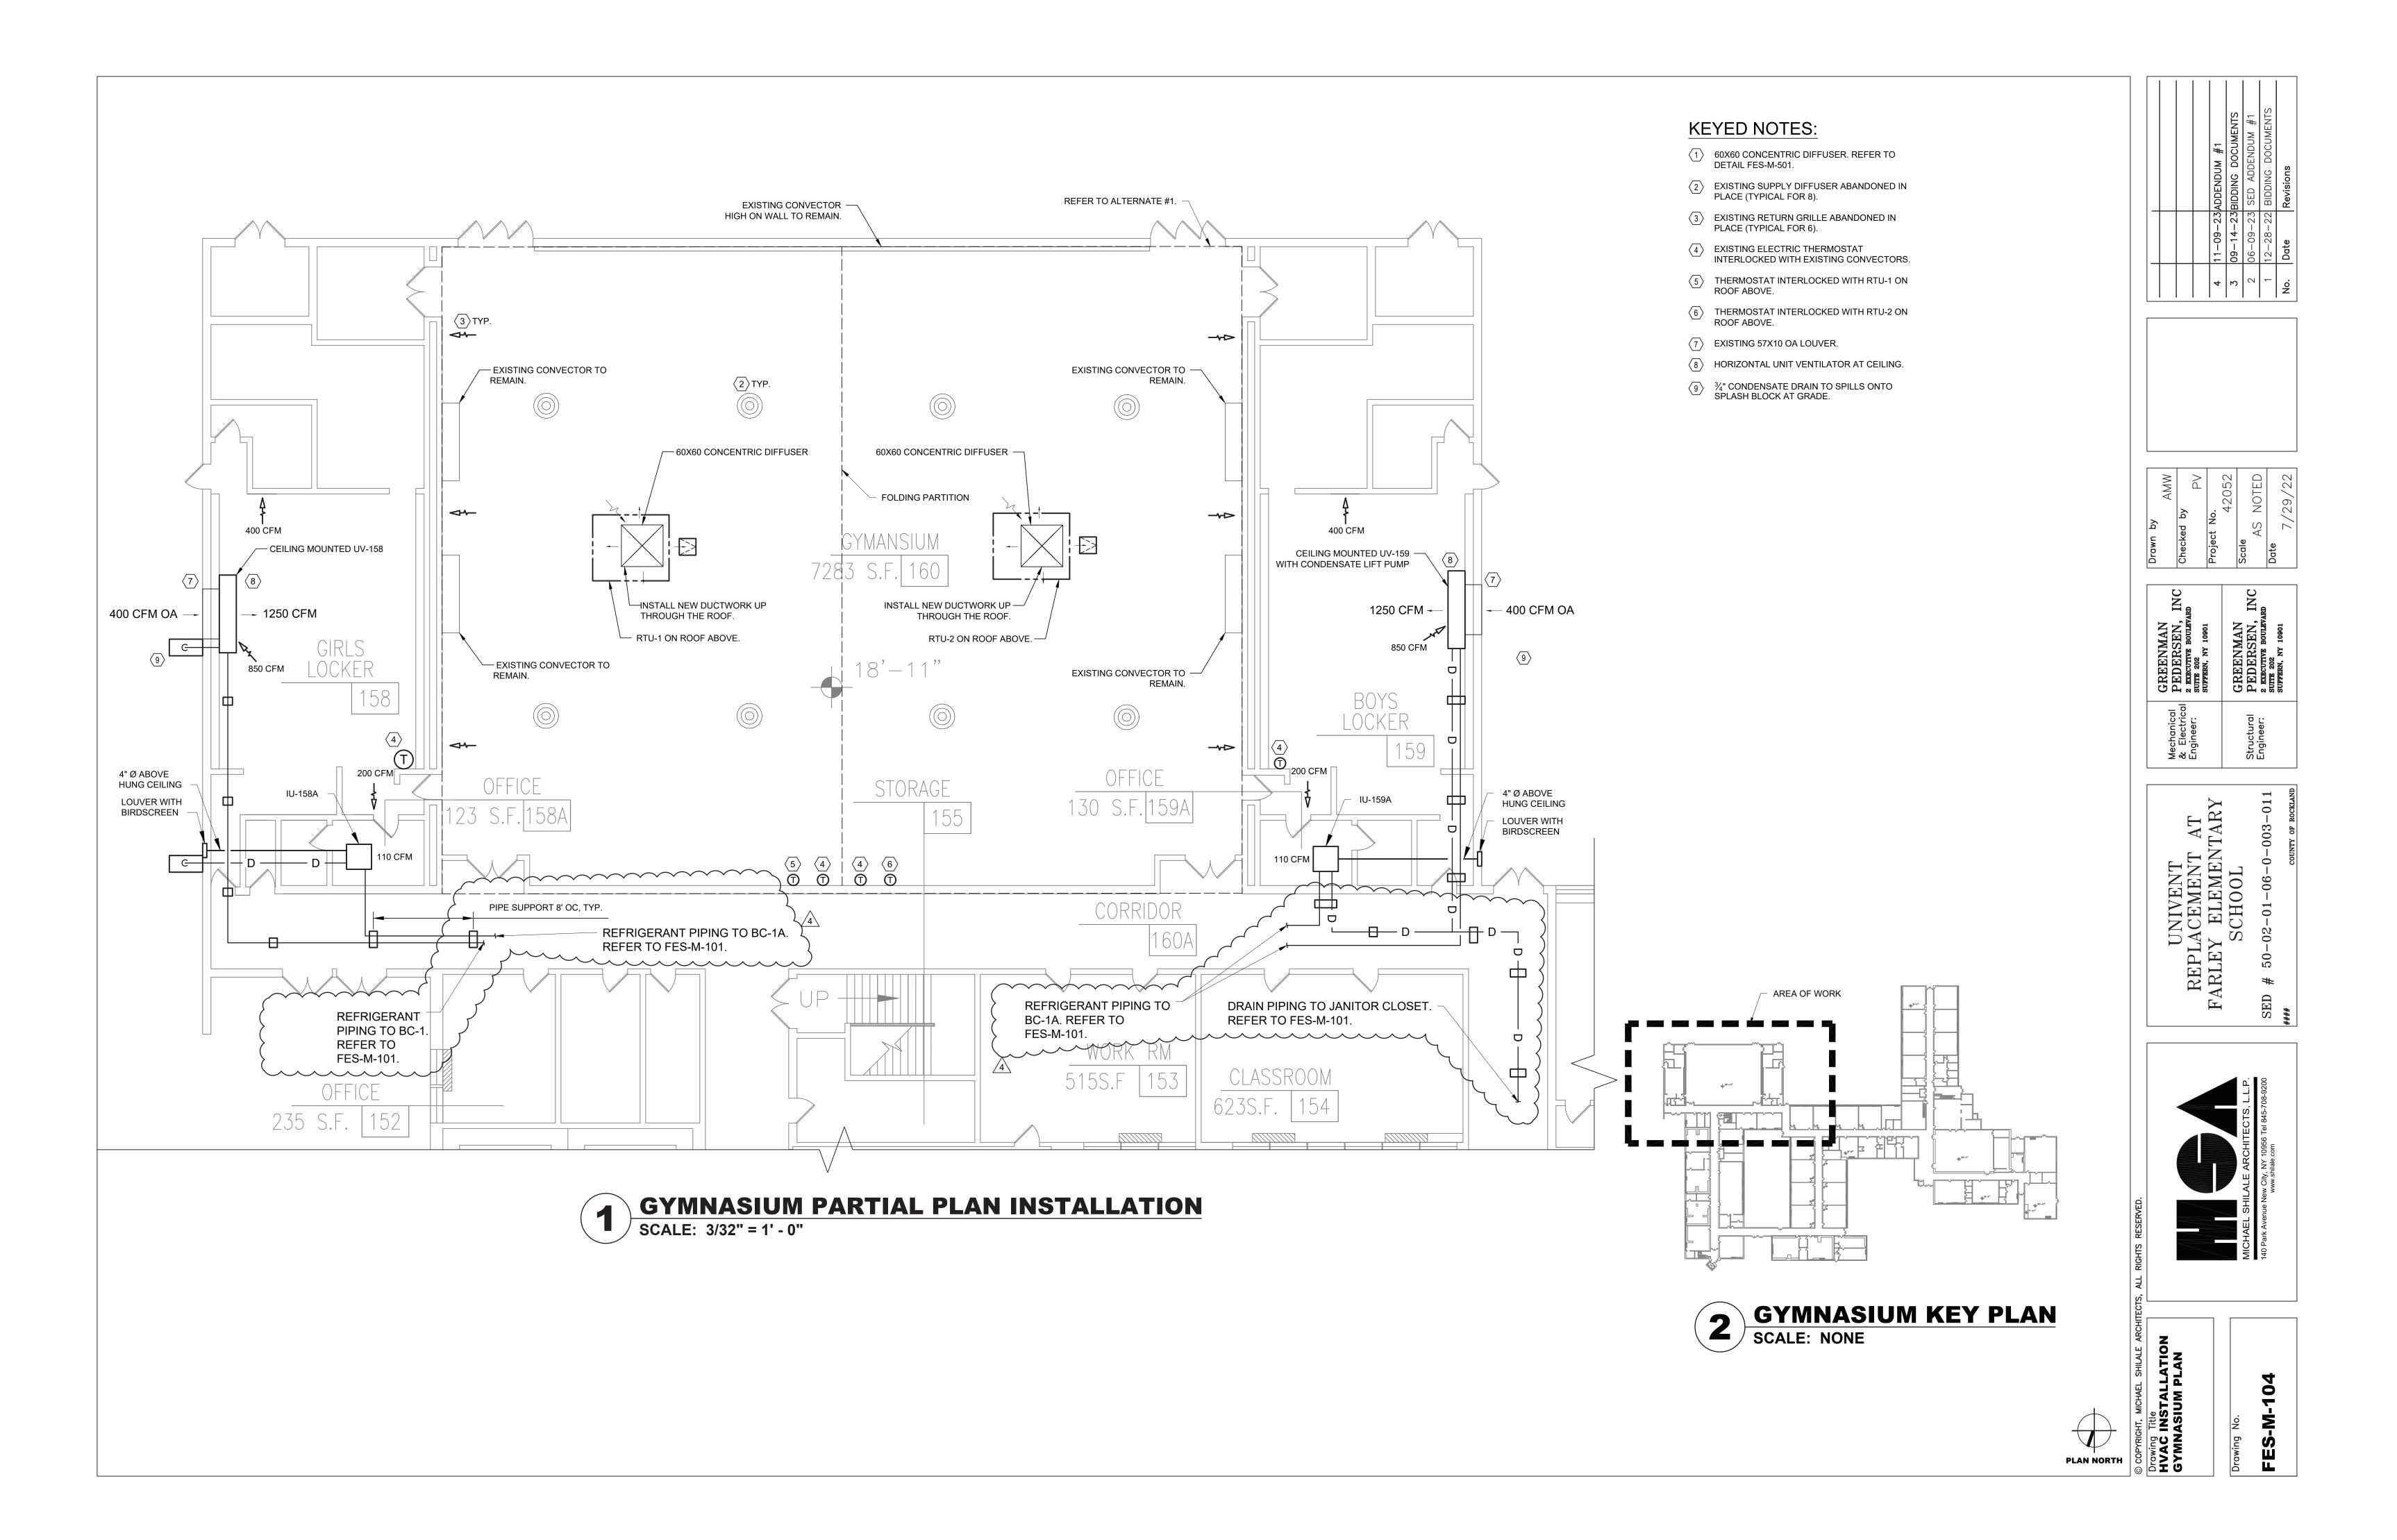


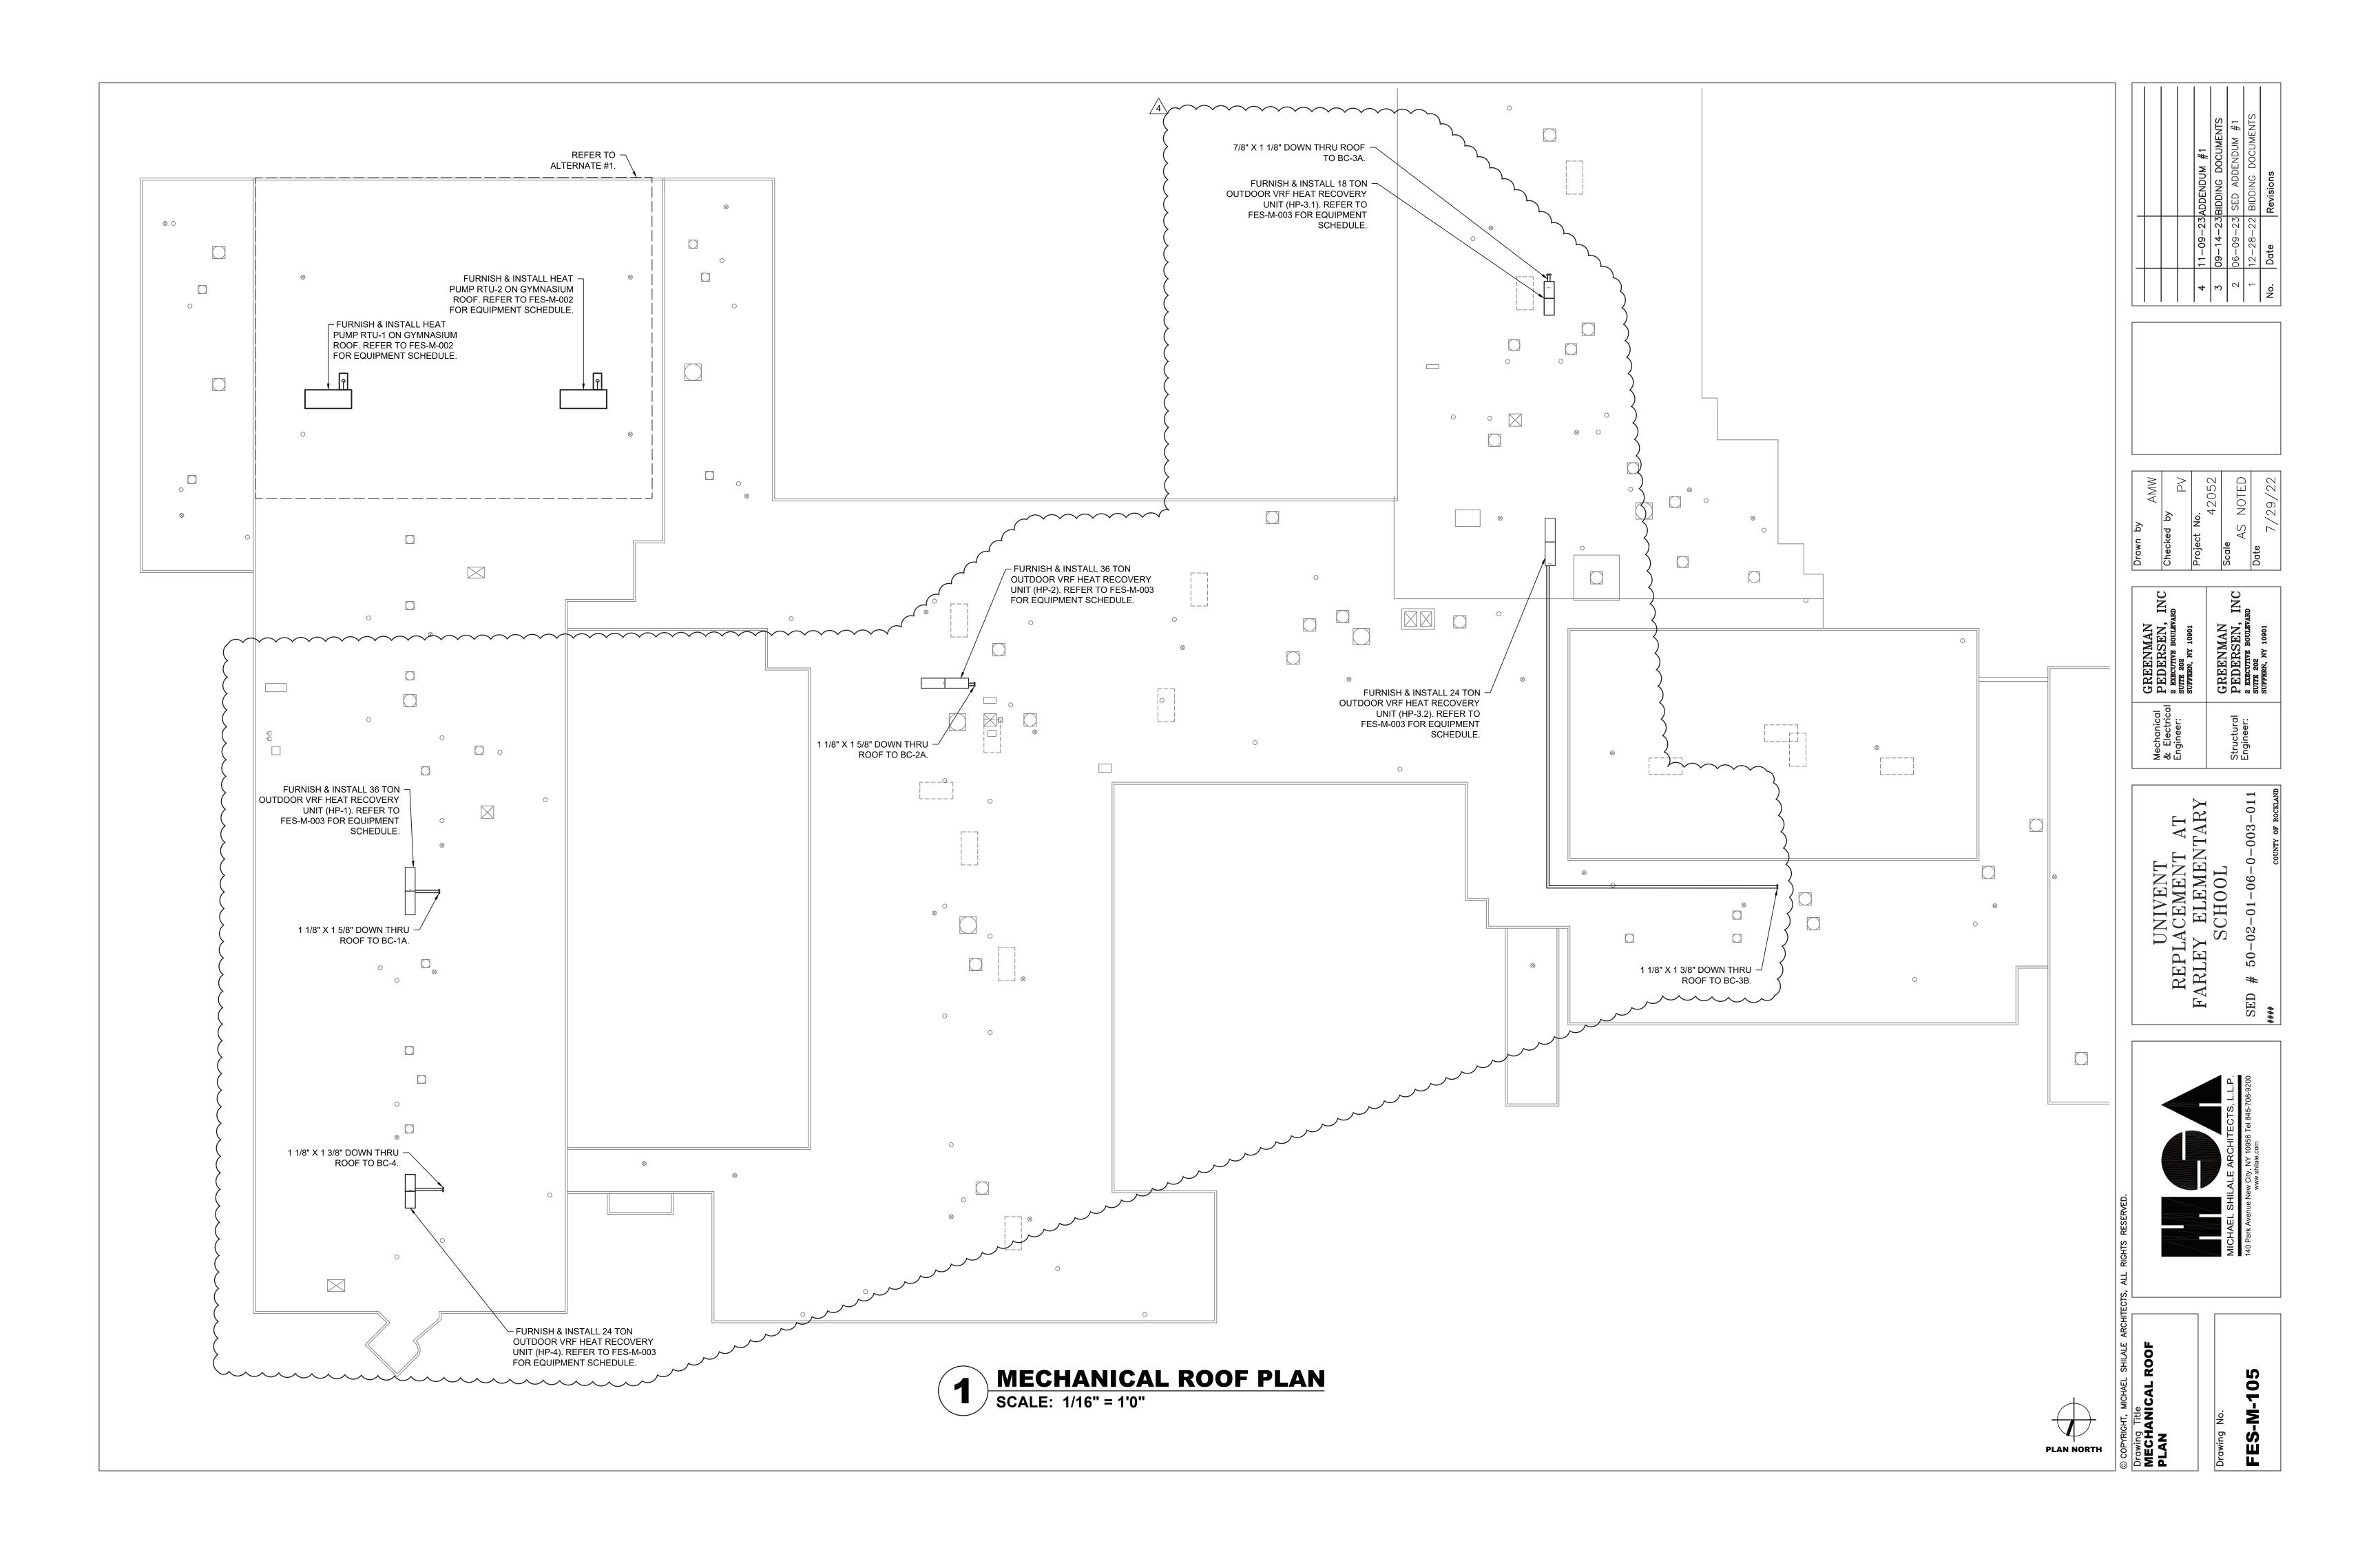


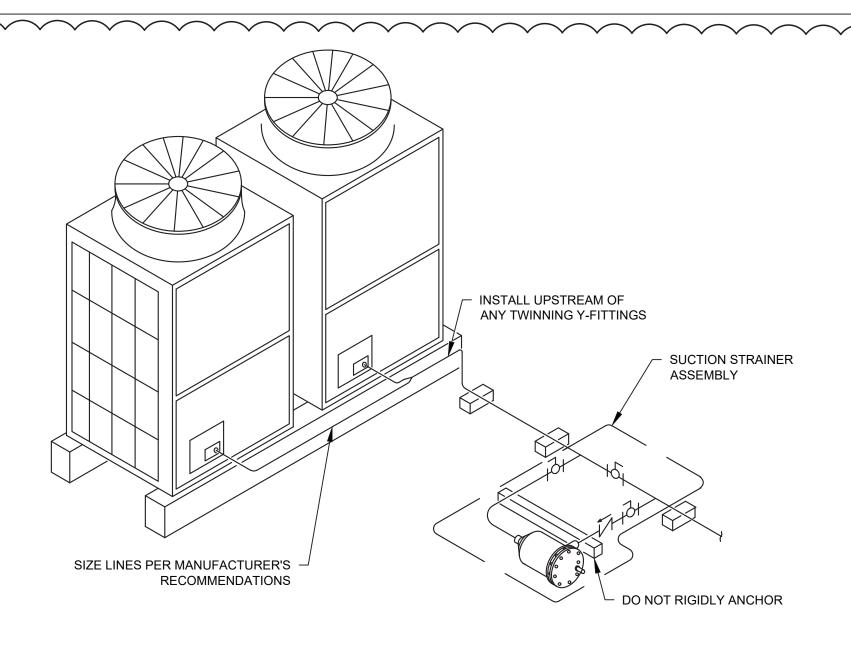


# PIPING AT HP-1, HP-2, HP-3,1, HP-3.2 & HP-4 SCALE: N.T.S.

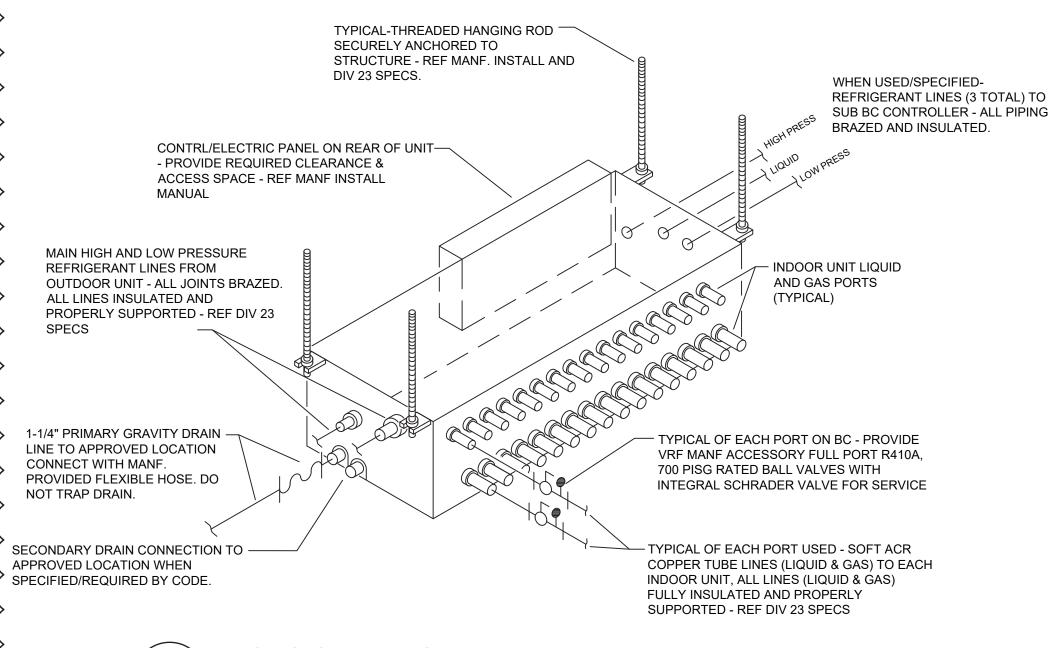

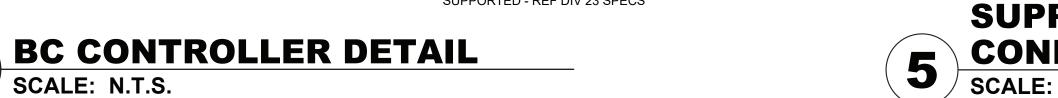


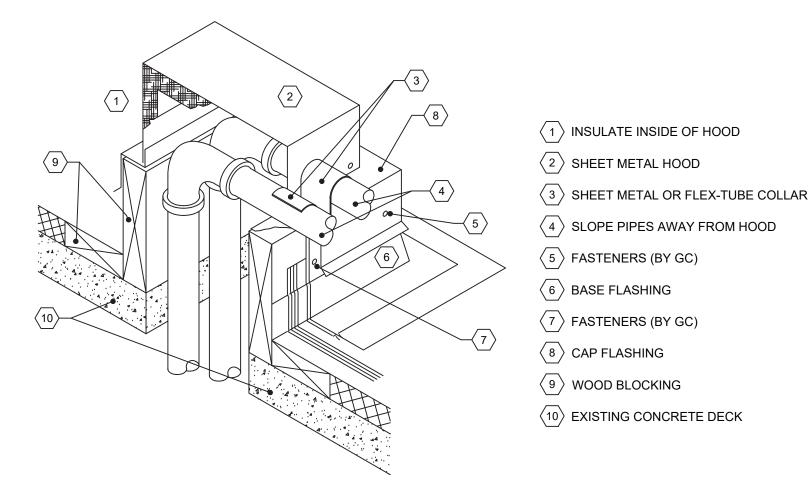

**ROOFTOP PIPE PENETRATION** SCALE: N.T.S.

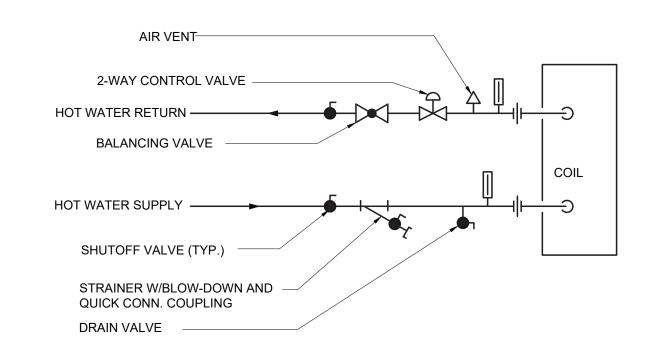


**PIPING AT UNIT VENTILATOR** SCALE: N.T.S.

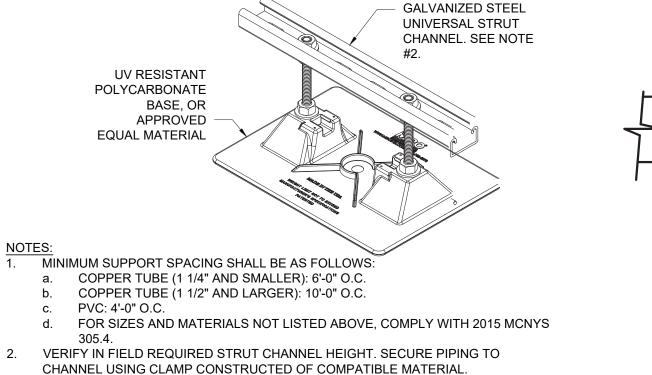


**SUPPORT FOR ROOFTOP CONDENSATE PIPING** SCALE: N.T.S.

3. BASIS OF DESIGN: MIRO IND. MODEL 2.5-CS.

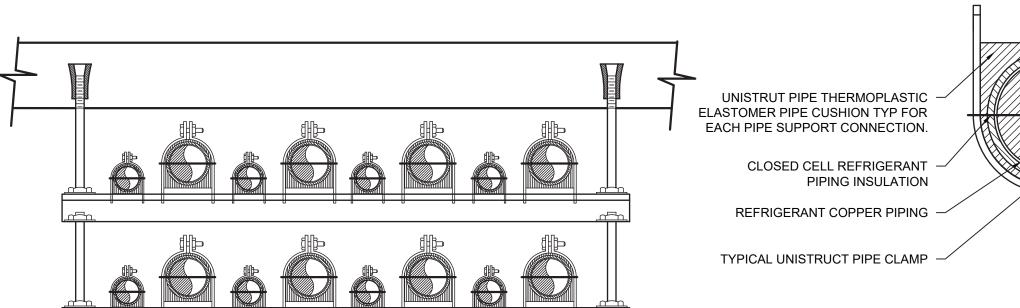



REFRIGERANT PIPING DETAIL SCALE: N.T.S. NOTE: PROVIDE SUPPORT 12 FT ON CENTER

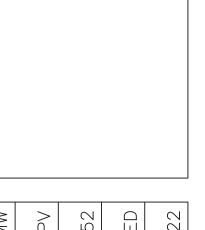


Checked by	PV	Project No.	42052	Scale	AS NOTED	Date	7 / 00 / 00


GREENMAN PEDERSEN, INC 2 EXECUTIVE BOULEVARD SUITE 202 SUFFERN, NY 10901	GREENMAN PEDERSEN, INC 2 EXECUTIVE BOULEVARD SUITE 202 SUFFERN, NY 10901
GREE] PEDE] 2 EXECUTI SUITE 202 SUFFERN,	GREE] PEDE] 2 EXECUTI SUITE 202 SUITE 202 SUITE 202
Mechanical & Electrical Engineer:	Structural Engineer:

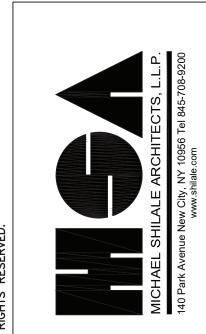

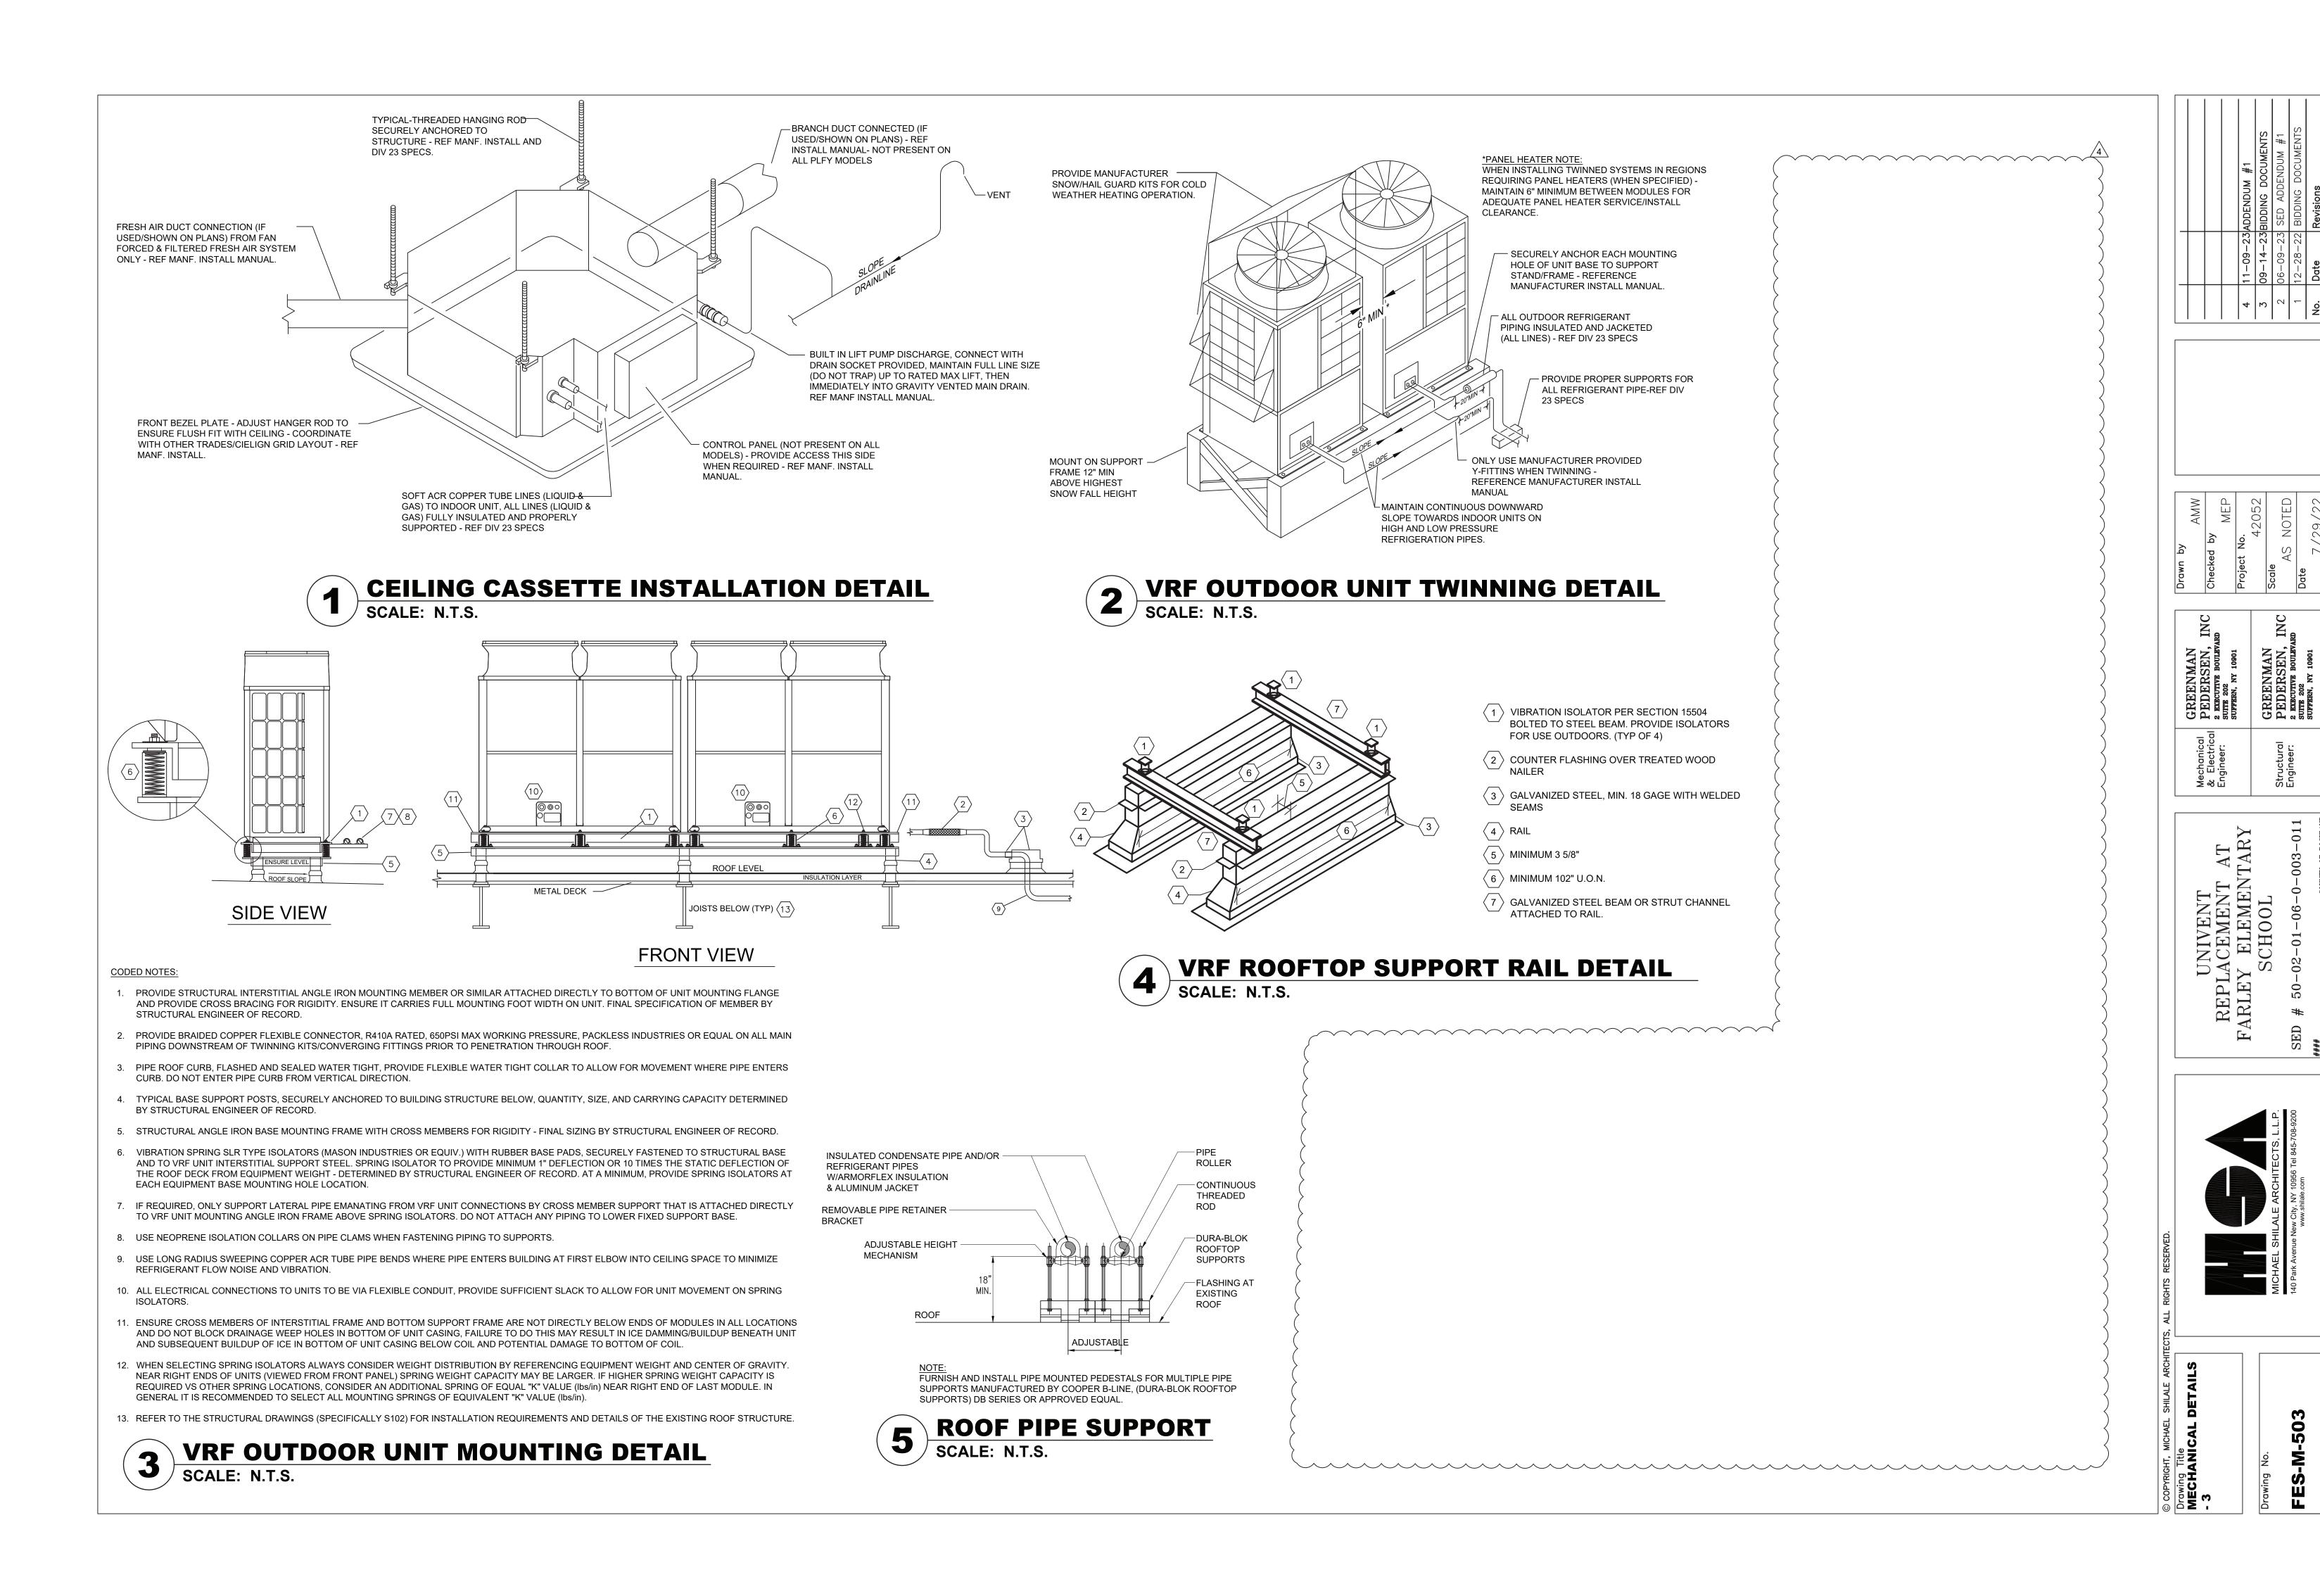

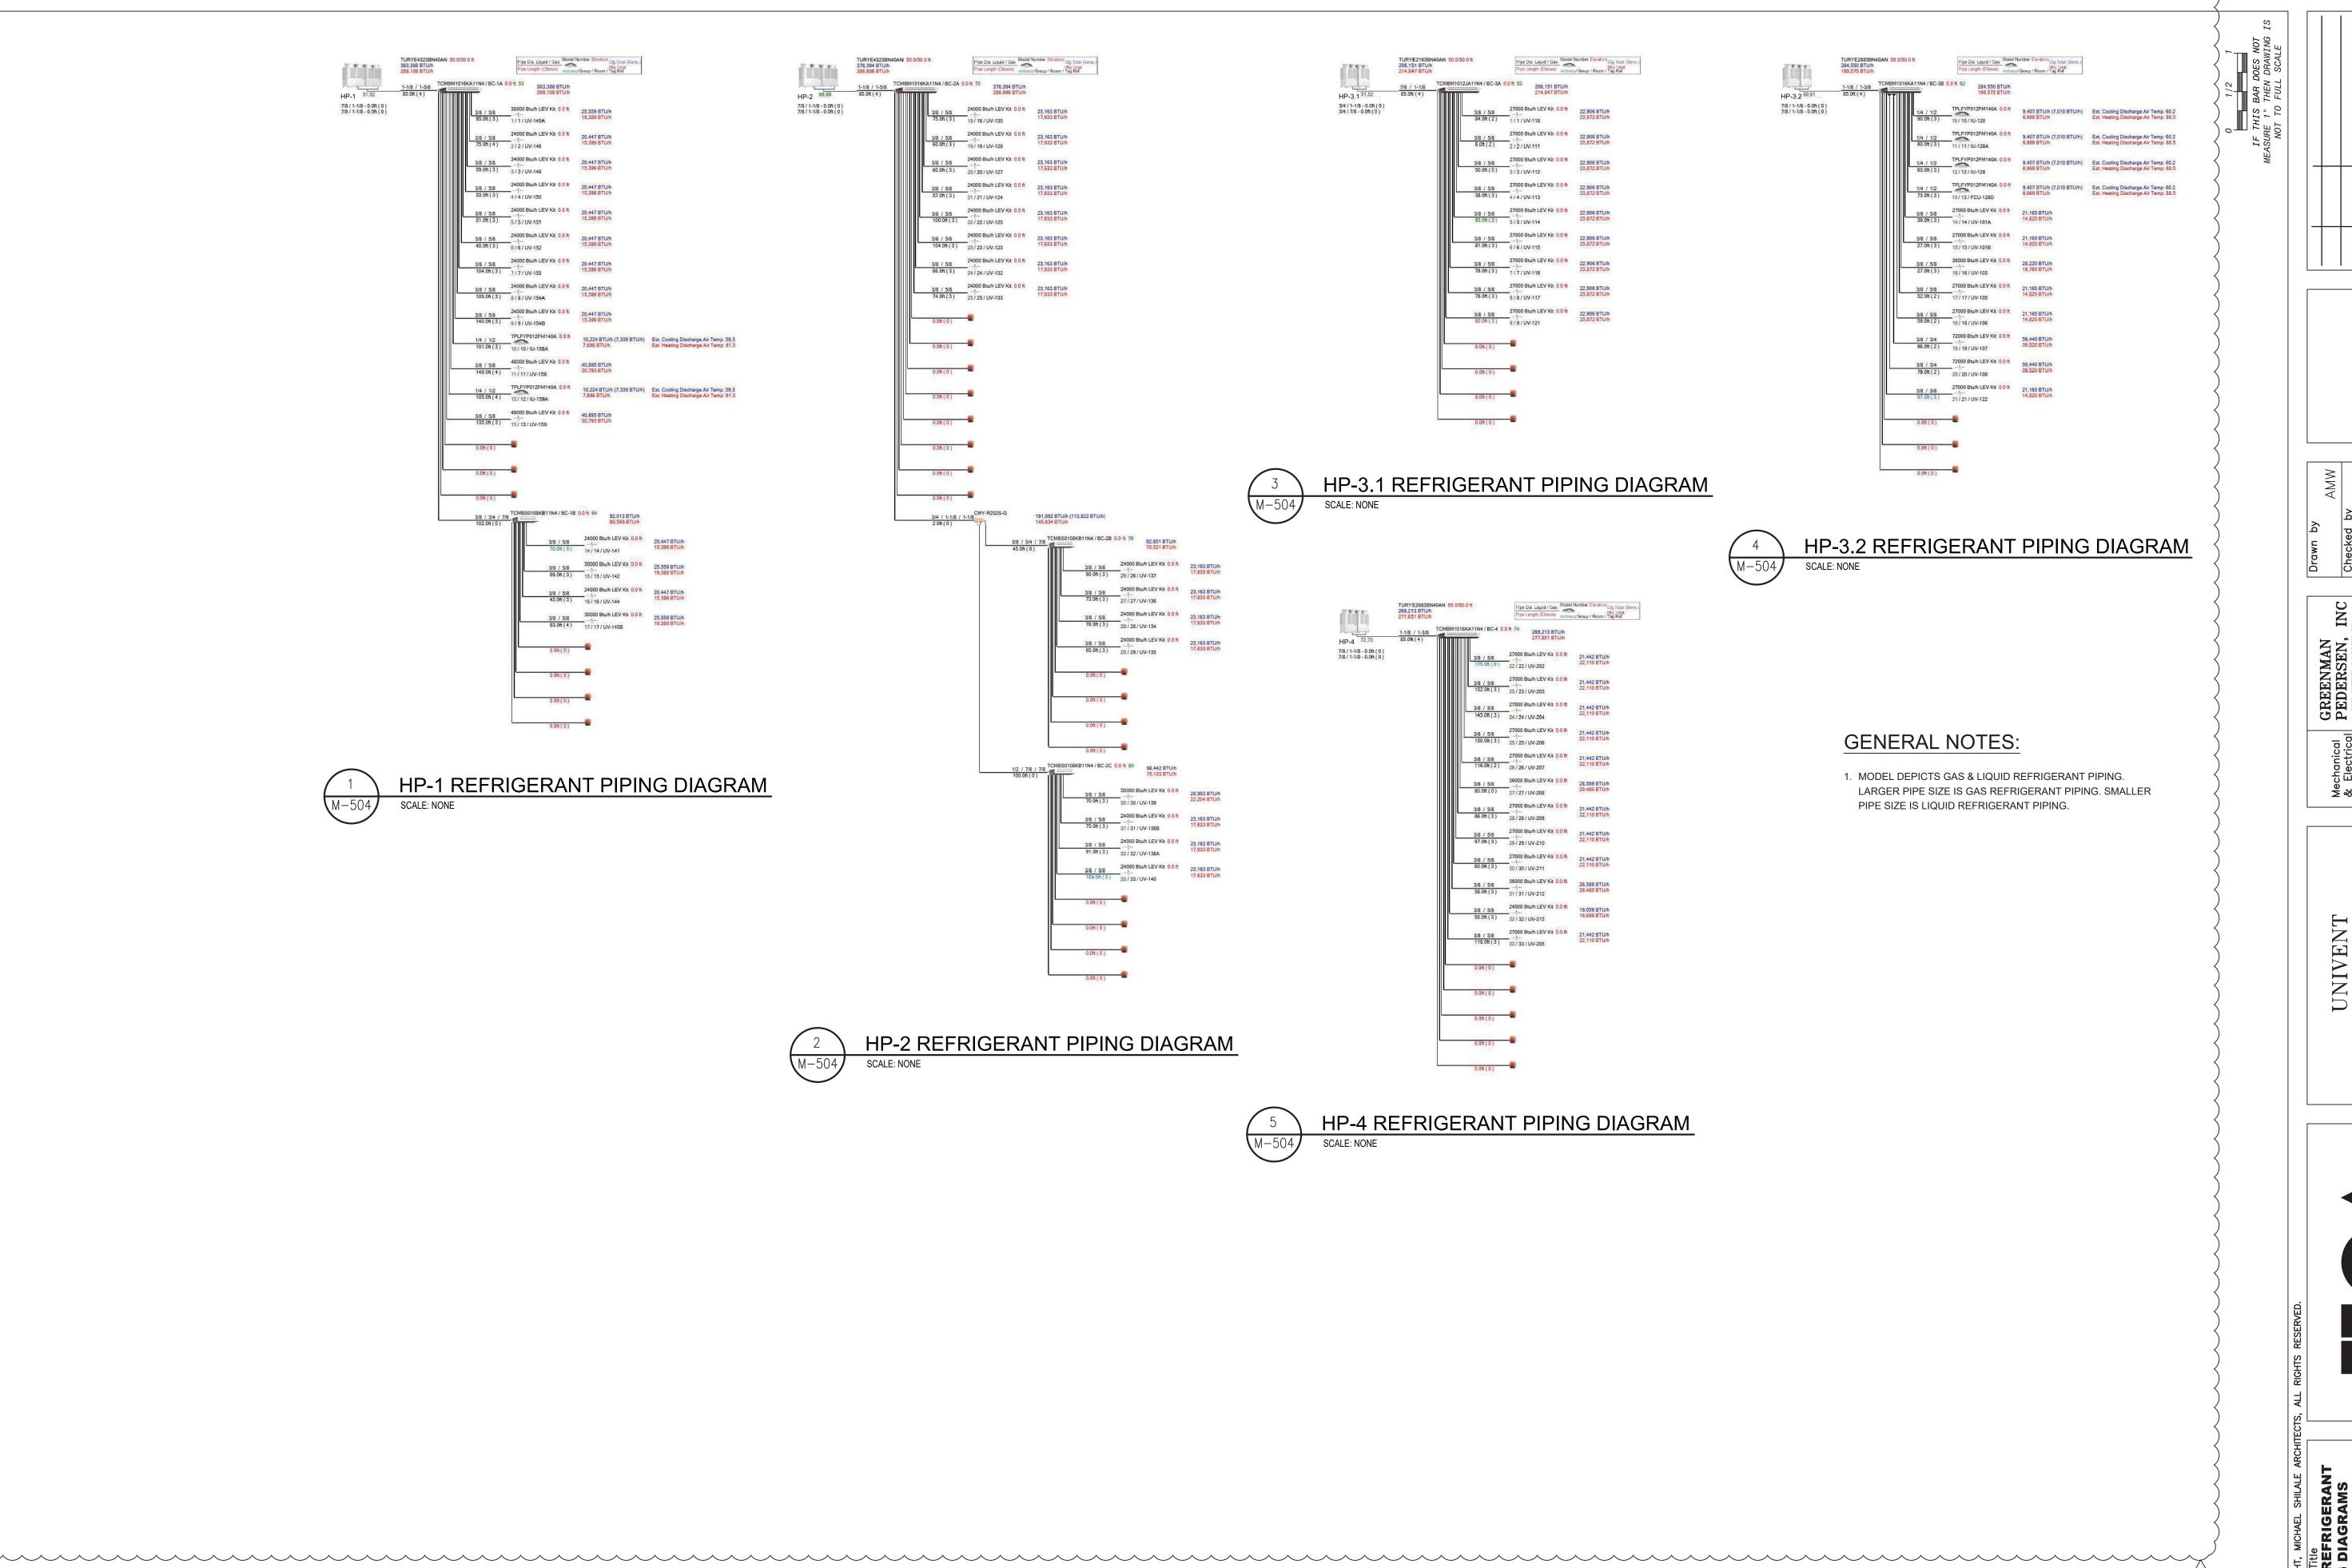




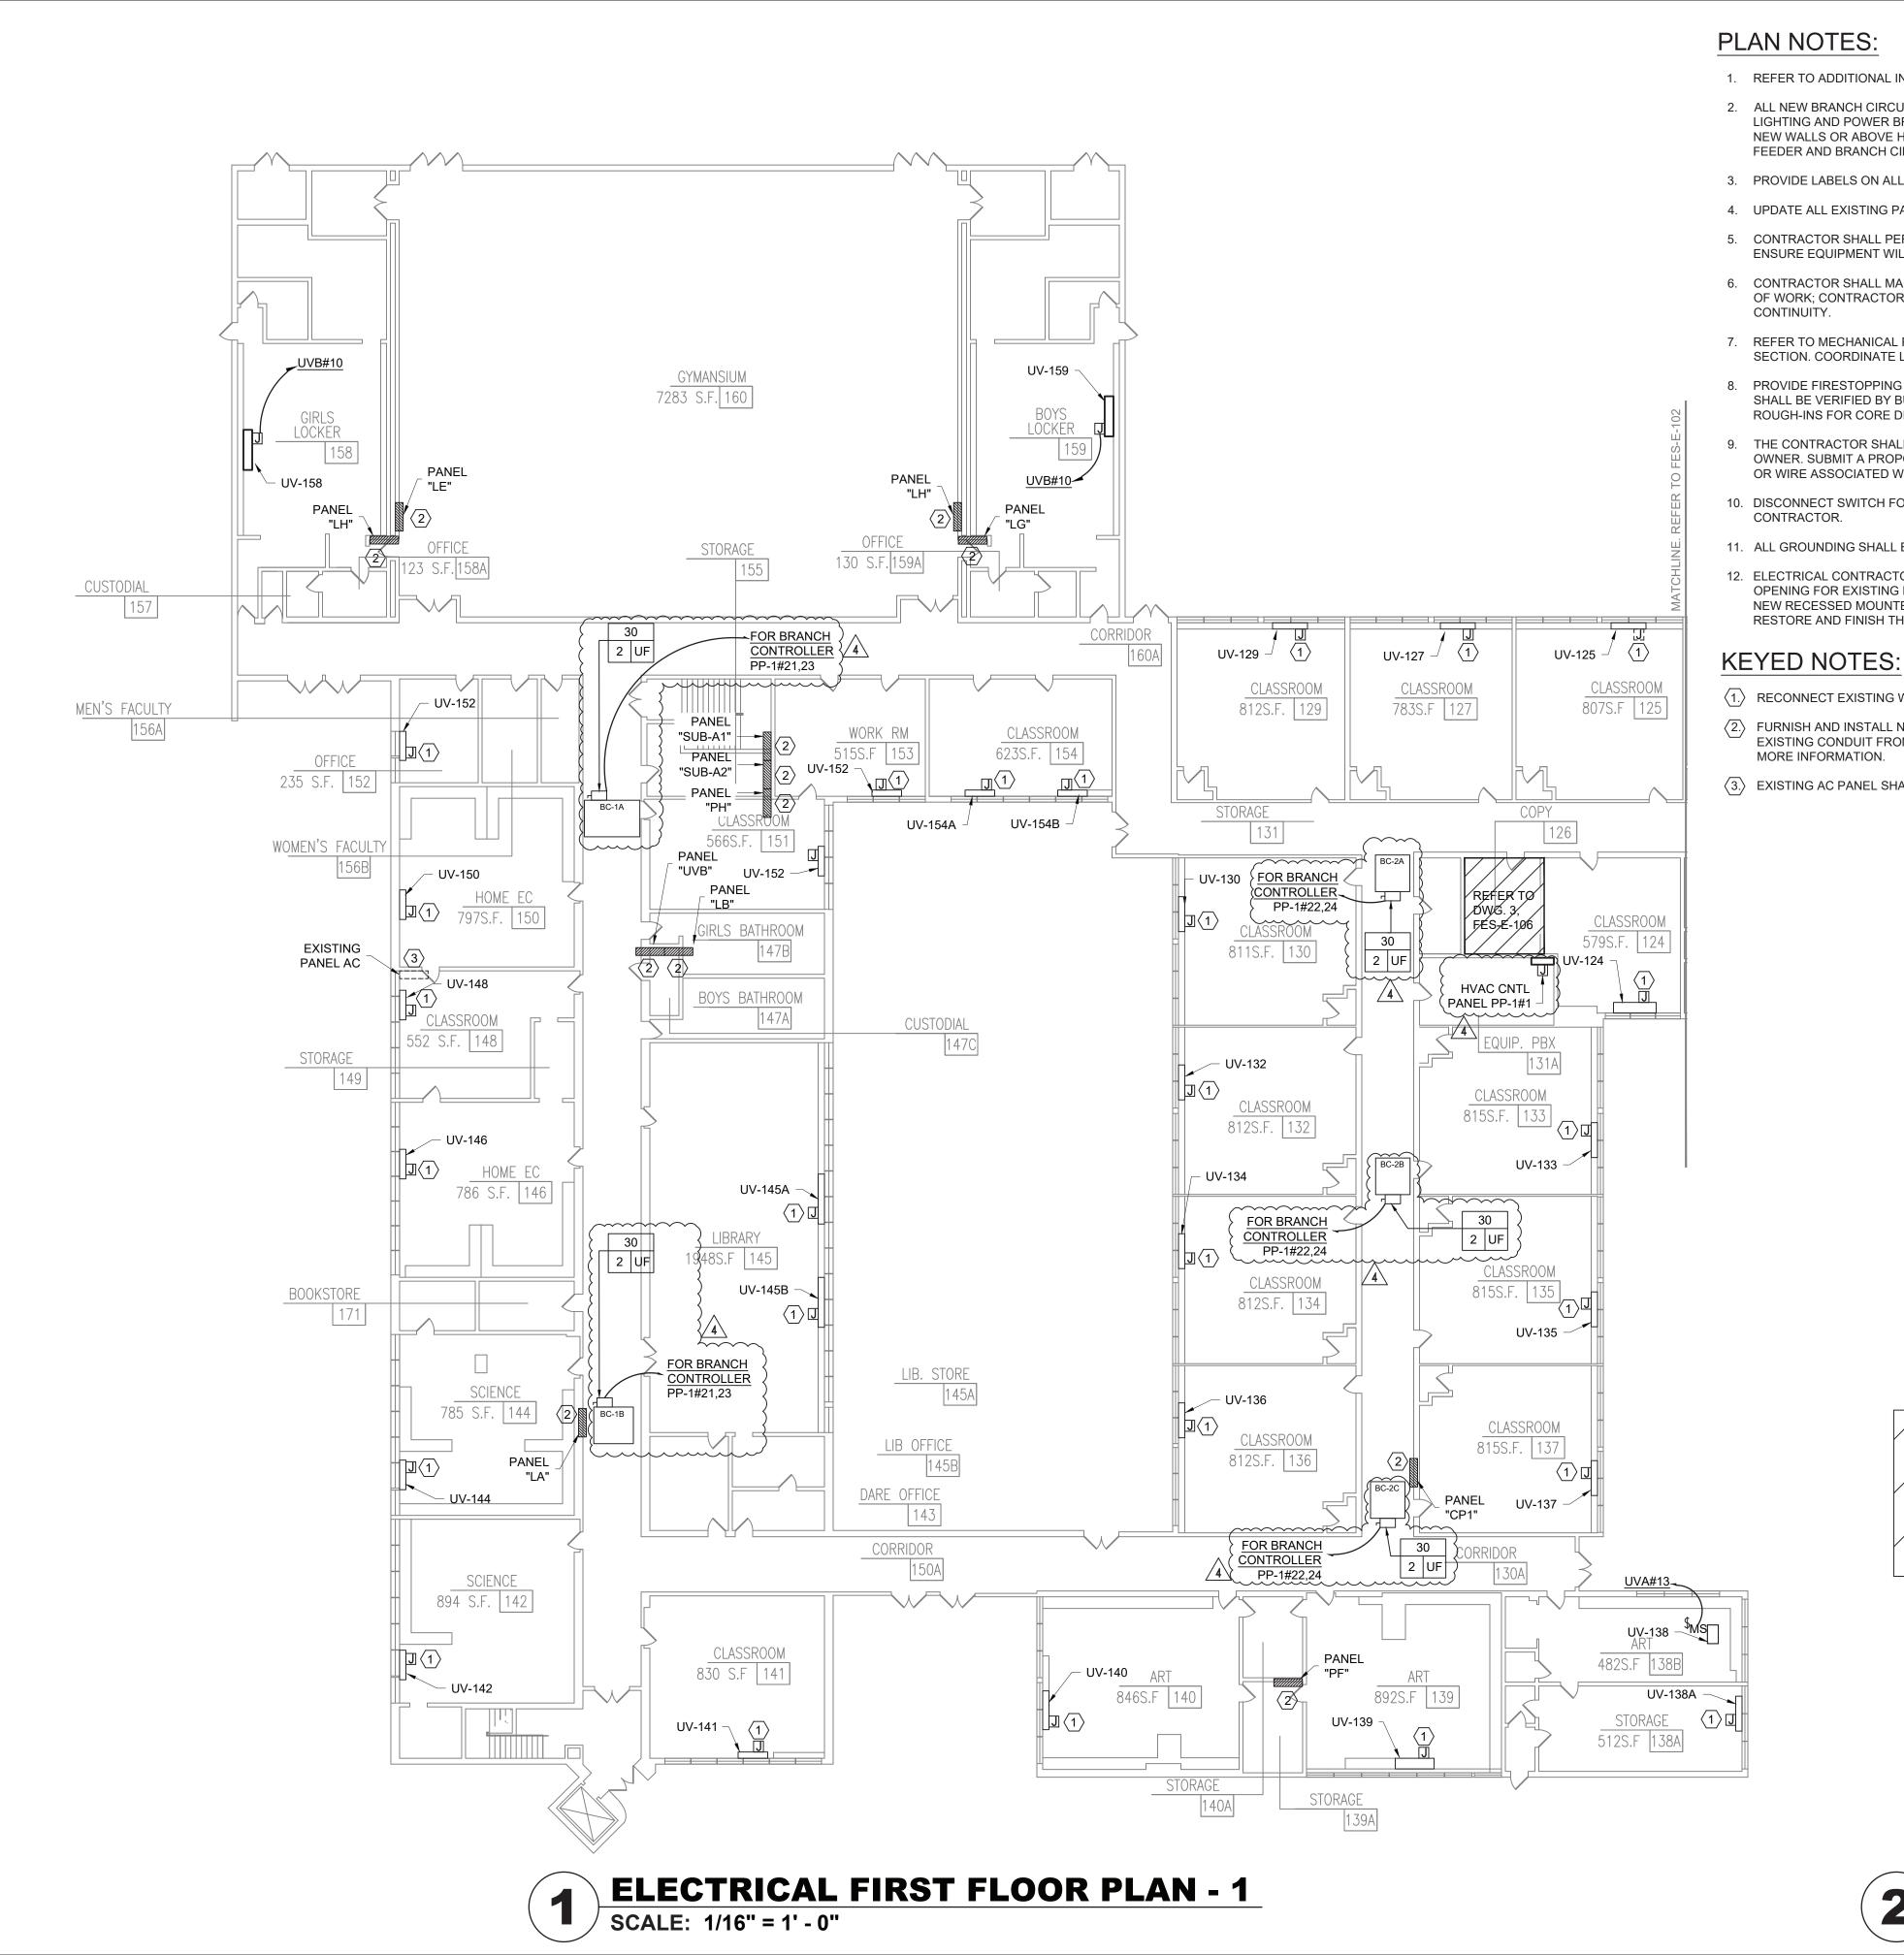


- 1. REFER TO ADDITIONAL INSTALLATION NOTES ON DRAWING E-001.
- 2. ALL NEW BRANCH CIRCUIT SHALL BE RUN WITH MINIMUM OF 2#12+1#12G IN 3/4" CONDUIT, UNLESS OTHERWISE NOTED. FOR LIGHTING AND POWER BRANCH CIRCUIT, MC CABLE SHALL BE INSTALLED FOR RECESSED INSTALLATION ONLY, EITHER IN NEW WALLS OR ABOVE HUNG CEILING WHERE POSSIBLE. REFER TO PANEL SCHEDULES IN DRAWING E-201 FOR ALL OTHER FEEDER AND BRANCH CIRCUIT SIZE INFORMATION.
- 3. PROVIDE LABELS ON ALL ELECTRICAL EQUIPMENT INDICATING CIRCUIT ORIGINATION.
- 4. UPDATE ALL EXISTING PANEL DIRECTORIES AFFECTED BY NEW WORK.
- 5. CONTRACTOR SHALL PERFORM AMP PROBE READINGS ON EXISTING SERVICE EQUIPMENT BEFORE AND AFTER WORK TO ENSURE EQUIPMENT WILL NOT BE LOADED BEYOND ITS MAX AMPACITY.
- 6. CONTRACTOR SHALL MAINTAIN CONTINUITY TO ALL EXISTING CIRCUITRY TO REMAIN WHICH ARE AFFECTED BY THE SCOPE OF WORK; CONTRACTOR SHALL FURNISH ALL NECESSARY JUNCTION BOXES, CONDUIT, AND WIRES AS REQUIRED TO KEEP
- 7. REFER TO MECHANICAL PLANS FOR EQUIPMENT TO BE SUPPLIED BY OTHER TRADES AND INSTALLED/WIRED UNDER THIS SECTION. COORDINATE LOCATION OF DEVICES WITH OTHER CONTRACTORS.
- 8. PROVIDE FIRESTOPPING FOR ALL PENETRATIONS TO MATCH EXISTING FIRE RATING WHERE APPLICABLE. ALL CORE DRILLS SHALL BE VERIFIED BY BUILDING REPRESENTATIVE PRIOR TO COMMENCING WORK. XRAY ALL FLOOR SLABS PRIOR TO ROUGH-INS FOR CORE DRILL WORK.
- 9. THE CONTRACTOR SHALL FIELD ROUTE FEEDER FOR NEW POWER PANELS. COORDINATE EXACT ROUTING PATH WITH OWNER. SUBMIT A PROPOSED ROUTING PATH TO ENGINEER OF RECORD FOR APPROVAL PRIOR TO RUNNING ANY CONDUIT OR WIRE ASSOCIATED WITH THIS FEEDER.
- 10. DISCONNECT SWITCH FOR UNIT VENTILATORS IS PROVIDED BY HVAC CONTRACTOR. COORDINATE WITH HVAC
- 11. ALL GROUNDING SHALL BE PROVIDED BY THE CONTRACTOR AS PER NEC 2017.
- 12. ELECTRICAL CONTRACTOR SHALL COORDINATE WITH THE GENERAL CONTRACTOR TO ENLARGE AND FUR OUT EXISTING OPENING FOR EXISTING PANELS AND WHERE REQUIRED. ACCOMMODATE THE NEW BACK BOXES AND HOUSING OF THE NEW RECESSED MOUNTED PANELS TO BE INSTALLED. THE ELECTRICAL CONTRACTOR SHALL ALSO ENGAGE THE GC TO RESTORE AND FINISH THE WALLS TO MATCH THE SURROUNDING WALLS OF THE AREA.

- 1.) RECONNECT EXISTING WIRING TO THE NEW UNIT VENTILATORS. EXTEND WIRING AND CONDUIT IF NECESSARY.
- (2.) FURNISH AND INSTALL NEW PANEL TO MATCH EXISTING SIZE AND RATING. RUN NEW FEEDER TO MATCH EXISTING SIZE, IN EXISTING CONDUIT FROM SOURCE. RECONNECT ALL EXISTING BRANCH TO NEW PANEL. REFER TO PANEL SCHEDULE FOR
- (3.) EXISTING AC PANEL SHALL BE RE-FEED TO MDB2. REFER TO RISER DIAGRAM FOR MORE INFORMATION.

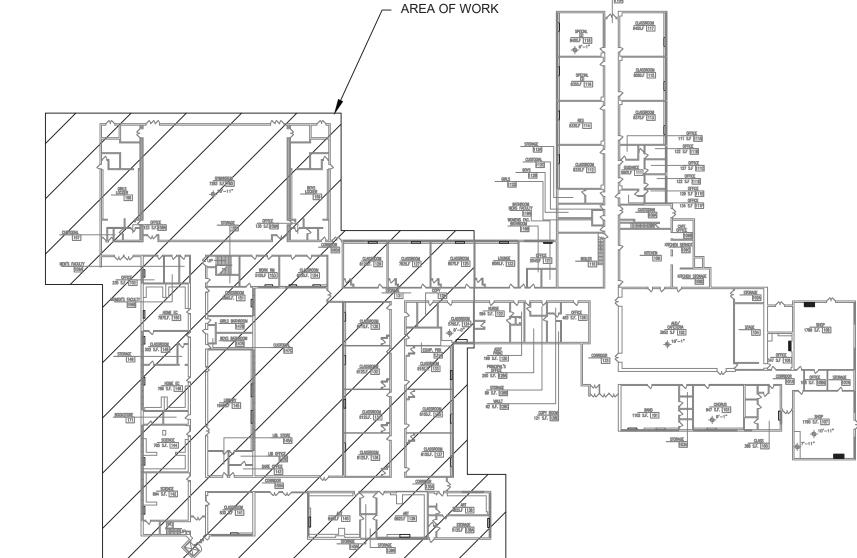



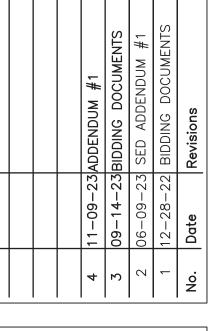



,	SH	42052	NOTED	129/22
	Checked by	Project No.	Scale AS	Date 7/


GREENMAN PEDERSEN, INC 2 EXECUTIVE BOULEVARD SUITE 202 SUFFERN, NY 10901	GREENMAN PEDERSEN, INC 2 EXECUTIVE BOULEVARD SUITE 202 SUFFERN, NY 10901
Mechanical & Electrical Engineer:	Structural Engineer:

UNIVENT REPLACEMENT AT FARLEY ELEMENTARY SCHOOL



Drawing Title
ELECTRICAL F
FLOOR PLAN



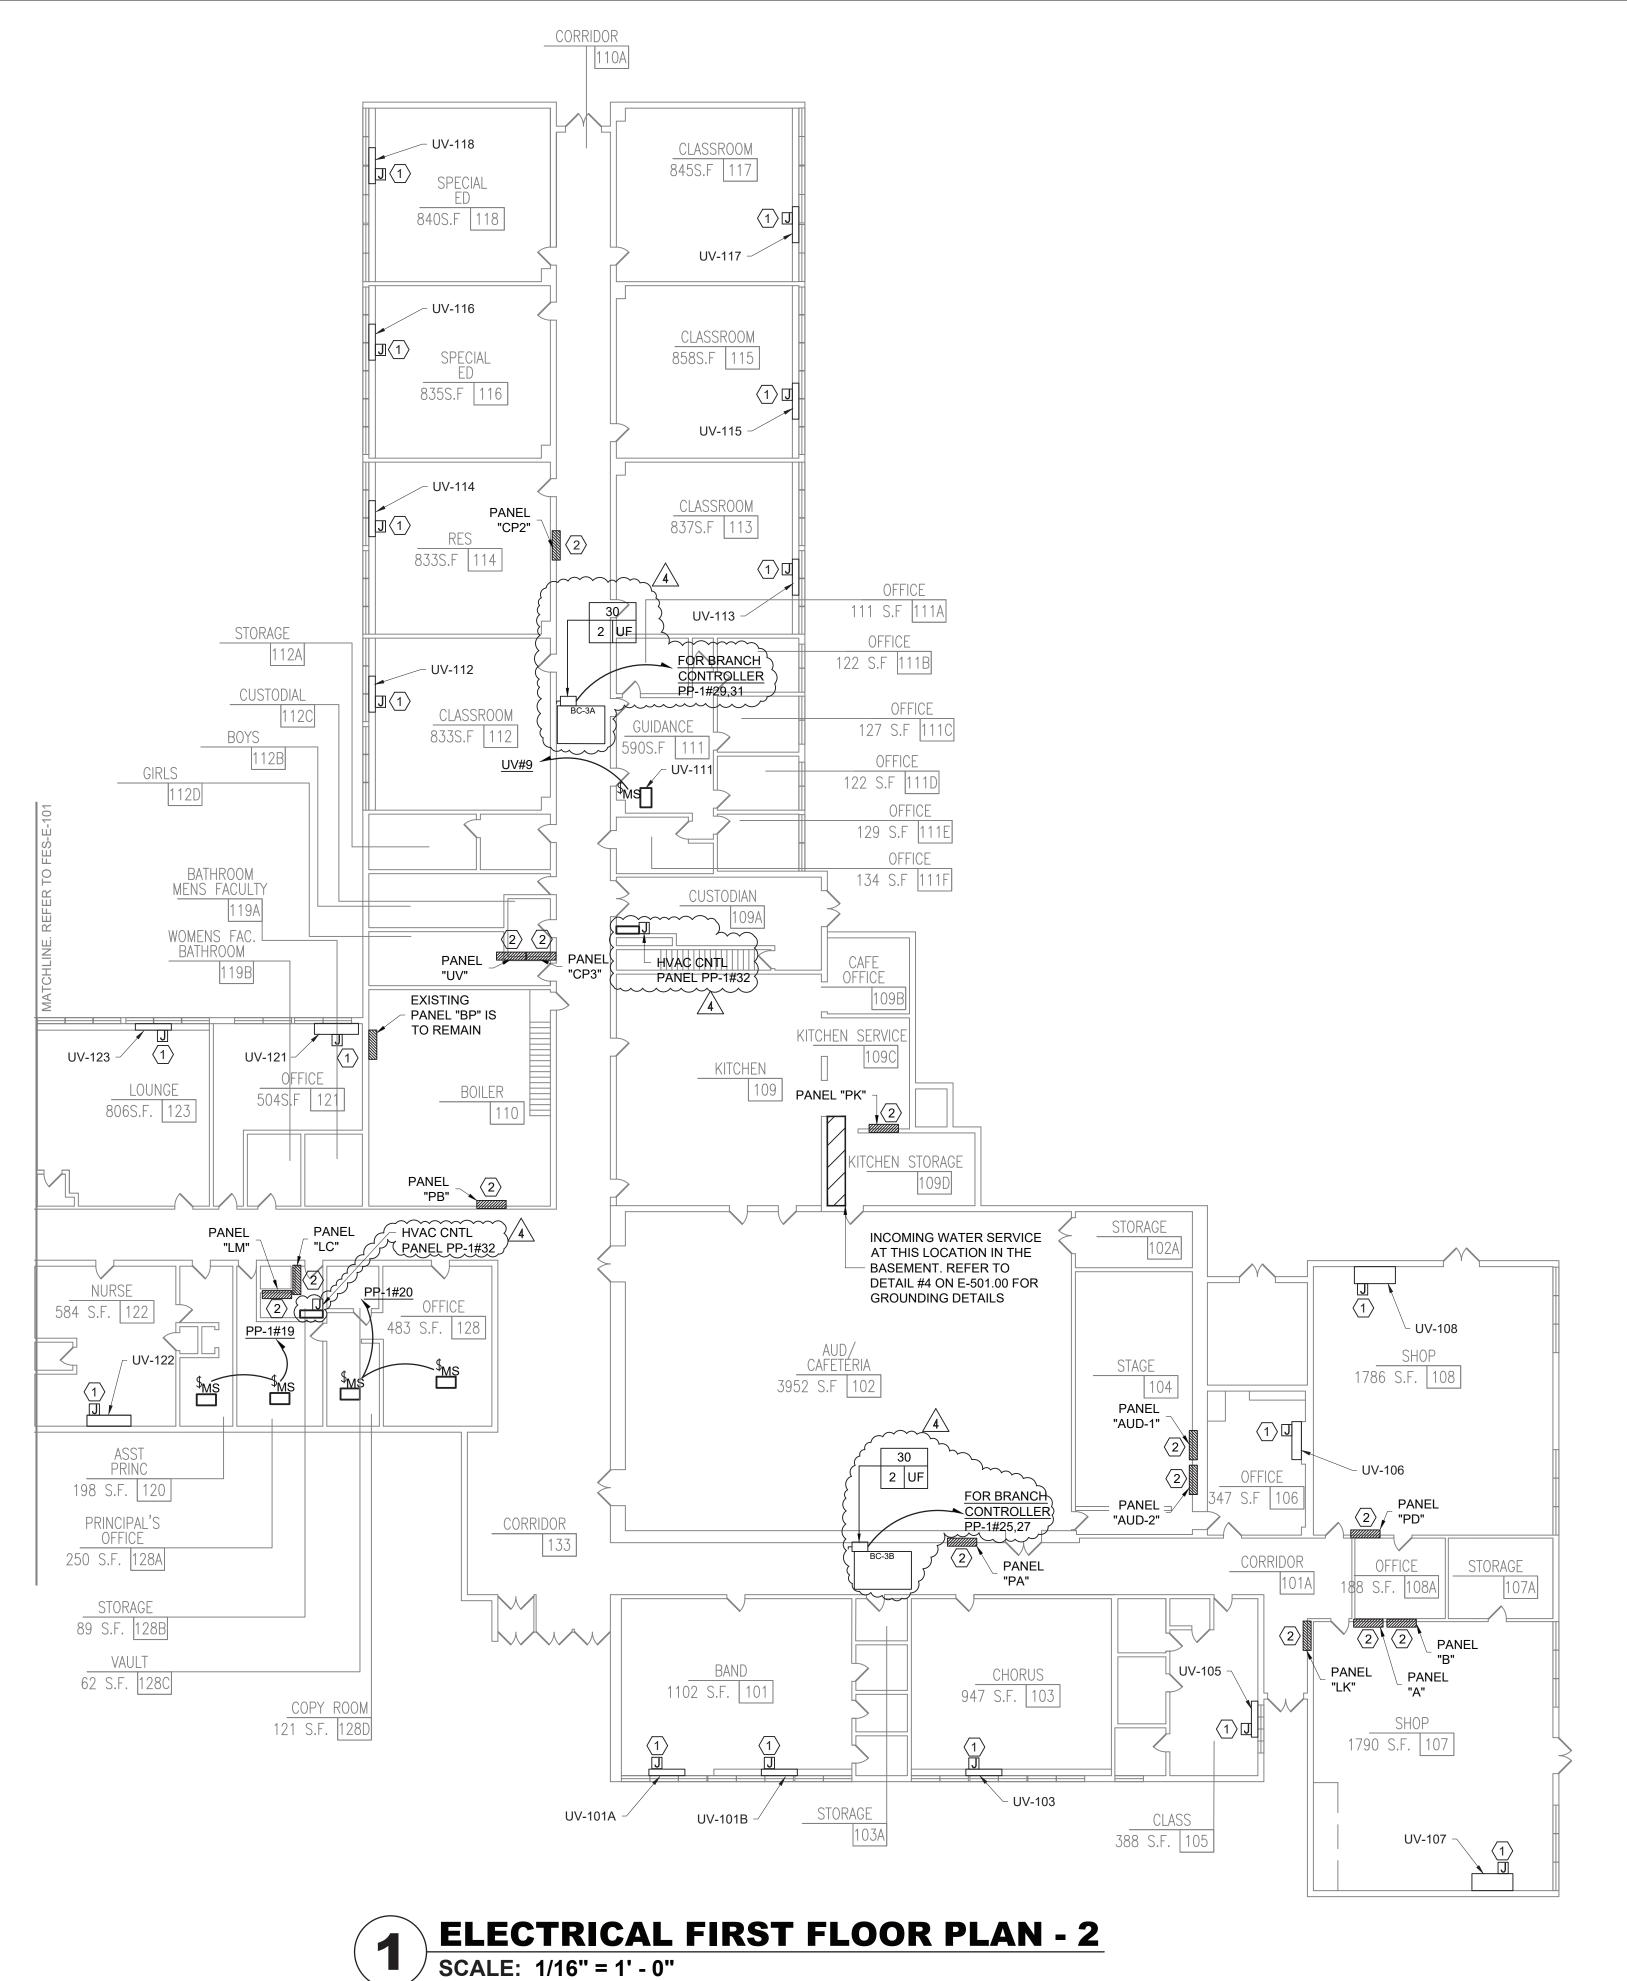


### **PLAN NOTES:**


- 1. REFER TO ADDITIONAL INSTALLATION NOTES ON DRAWING E-001.
- 2. ALL NEW BRANCH CIRCUIT SHALL BE RUN WITH MINIMUM OF 2#12+1#12G IN 3/4" CONDUIT, UNLESS OTHERWISE NOTED. FOR LIGHTING AND POWER BRANCH CIRCUIT, MC CABLE SHALL BE INSTALLED FOR RECESSED INSTALLATION ONLY, EITHER IN NEW WALLS OR ABOVE HUNG CEILING WHERE POSSIBLE. REFER TO PANEL SCHEDULES IN DRAWING E-201 FOR ALL OTHER FEEDER AND BRANCH CIRCUIT SIZE INFORMATION.
- 3. PROVIDE LABELS ON ALL ELECTRICAL EQUIPMENT INDICATING CIRCUIT ORIGINATION.
- 4. UPDATE ALL EXISTING PANEL DIRECTORIES AFFECTED BY NEW WORK.
- 5. CONTRACTOR SHALL PERFORM AMP PROBE READINGS ON EXISTING SERVICE EQUIPMENT BEFORE AND AFTER WORK TO ENSURE EQUIPMENT WILL NOT BE LOADED BEYOND ITS MAX AMPACITY.
- 6. CONTRACTOR SHALL MAINTAIN CONTINUITY TO ALL EXISTING CIRCUITRY TO REMAIN WHICH ARE AFFECTED BY THE SCOPE OF WORK; CONTRACTOR SHALL FURNISH ALL NECESSARY JUNCTION BOXES, CONDUIT, AND WIRES AS REQUIRED TO KEEP CONTINUITY.
- 7. PROVIDE FIRESTOPPING FOR ALL PENETRATIONS TO MATCH EXISTING FIRE RATING WHERE APPLICABLE. ALL CORE DRILLS SHALL BE VERIFIED BY BUILDING REPRESENTATIVE PRIOR TO COMMENCING WORK. XRAY ALL FLOOR SLABS PRIOR TO ROUGH-INS FOR CORE DRILL WORK.
- 8. THE CONTRACTOR SHALL FIELD ROUTE FEEDER FOR NEW POWER PANELS. COORDINATE EXACT ROUTING PATH WITH OWNER. SUBMIT A PROPOSED ROUTING PATH TO ENGINEER OF RECORD FOR APPROVAL PRIOR TO RUNNING ANY CONDUIT OR WIRE ASSOCIATED WITH THIS FEEDER.
- 9. DISCONNECT SWITCH FOR UNIT VENTILATORS IS PROVIDED BY HVAC CONTRACTOR. COORDINATE WITH HVAC CONTRACTOR.
- 10. ALL GROUNDING SHALL BE PROVIDED BY THE CONTRACTOR AS PER NEC 2017.
- 11. ELECTRICAL CONTRACTOR SHALL COORDINATE WITH THE GENERAL CONTRACTOR TO ENLARGE AND FUR OUT EXISTING OPENING FOR EXISTING PANELS AND WHERE REQUIRED. ACCOMMODATE THE NEW BACK BOXES AND HOUSING OF THE NEW RECESSED MOUNTED PANELS TO BE INSTALLED. THE ELECTRICAL CONTRACTOR SHALL ALSO ENGAGE THE GC TO RESTORE AND FINISH THE WALLS TO MATCH THE SURROUNDING WALLS OF THE AREA.

### **KEYED NOTES:**

- 1. RECONNECT EXISTING WIRING TO THE NEW UNIT VENTILATORS. EXTEND WIRING AND CONDUIT IF NECESSARY.
- (2) FURNISH AND INSTALL NEW PANEL TO MATCH EXISTING SIZE AND RATING. RUN NEW FEEDER TO MATCH EXISTING SIZE, IN EXISTING CONDUIT FROM SOURCE. RECONNECT ALL EXISTING BRANCH TO NEW PANEL. REFER TO PANEL SCHEDULE FOR MORE INFORMATION.

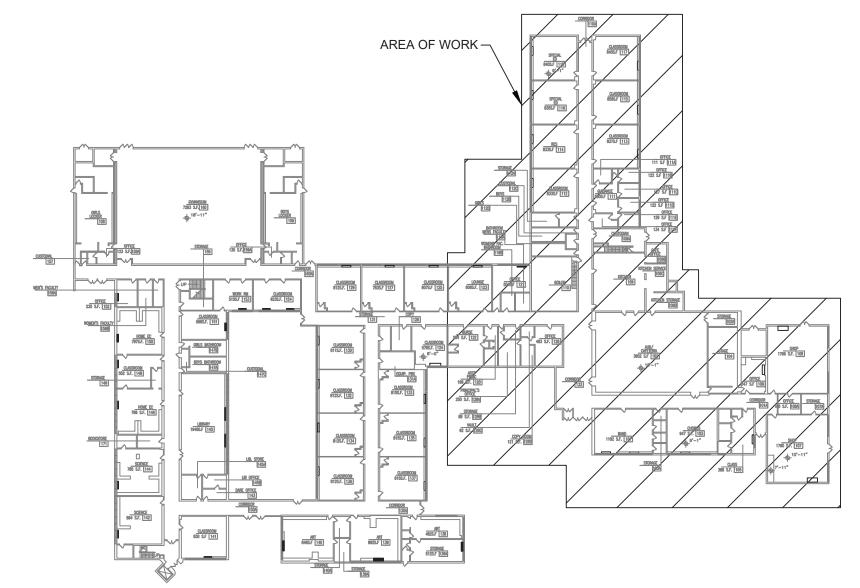



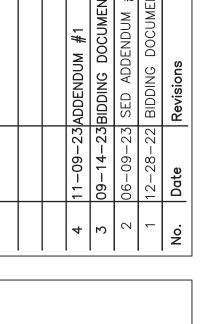



Checked by	
SH	
Project No.	
42052	
Scale	
AS NOTED	
Date	
7/29/22	_


GREENMAN PEDERSEN, INC 2 EXECUTIVE BOULEVARD SUITE 202 SUFFERN, NY 10901	GREENMAN PEDERSEN, INC 2 EXECUTIVE BOULEVARD SUITE 202 SUFFERN, NY 10901
Mechanical & Electrical Engineer:	Structural Engineer:

UNIVENT
REPLACEMENT AT
FARLEY ELEMENTARY
SCHOOL



Drawing Title
ELECTRICAL F
FLOOR PLAN


**PLAN NORTH** 

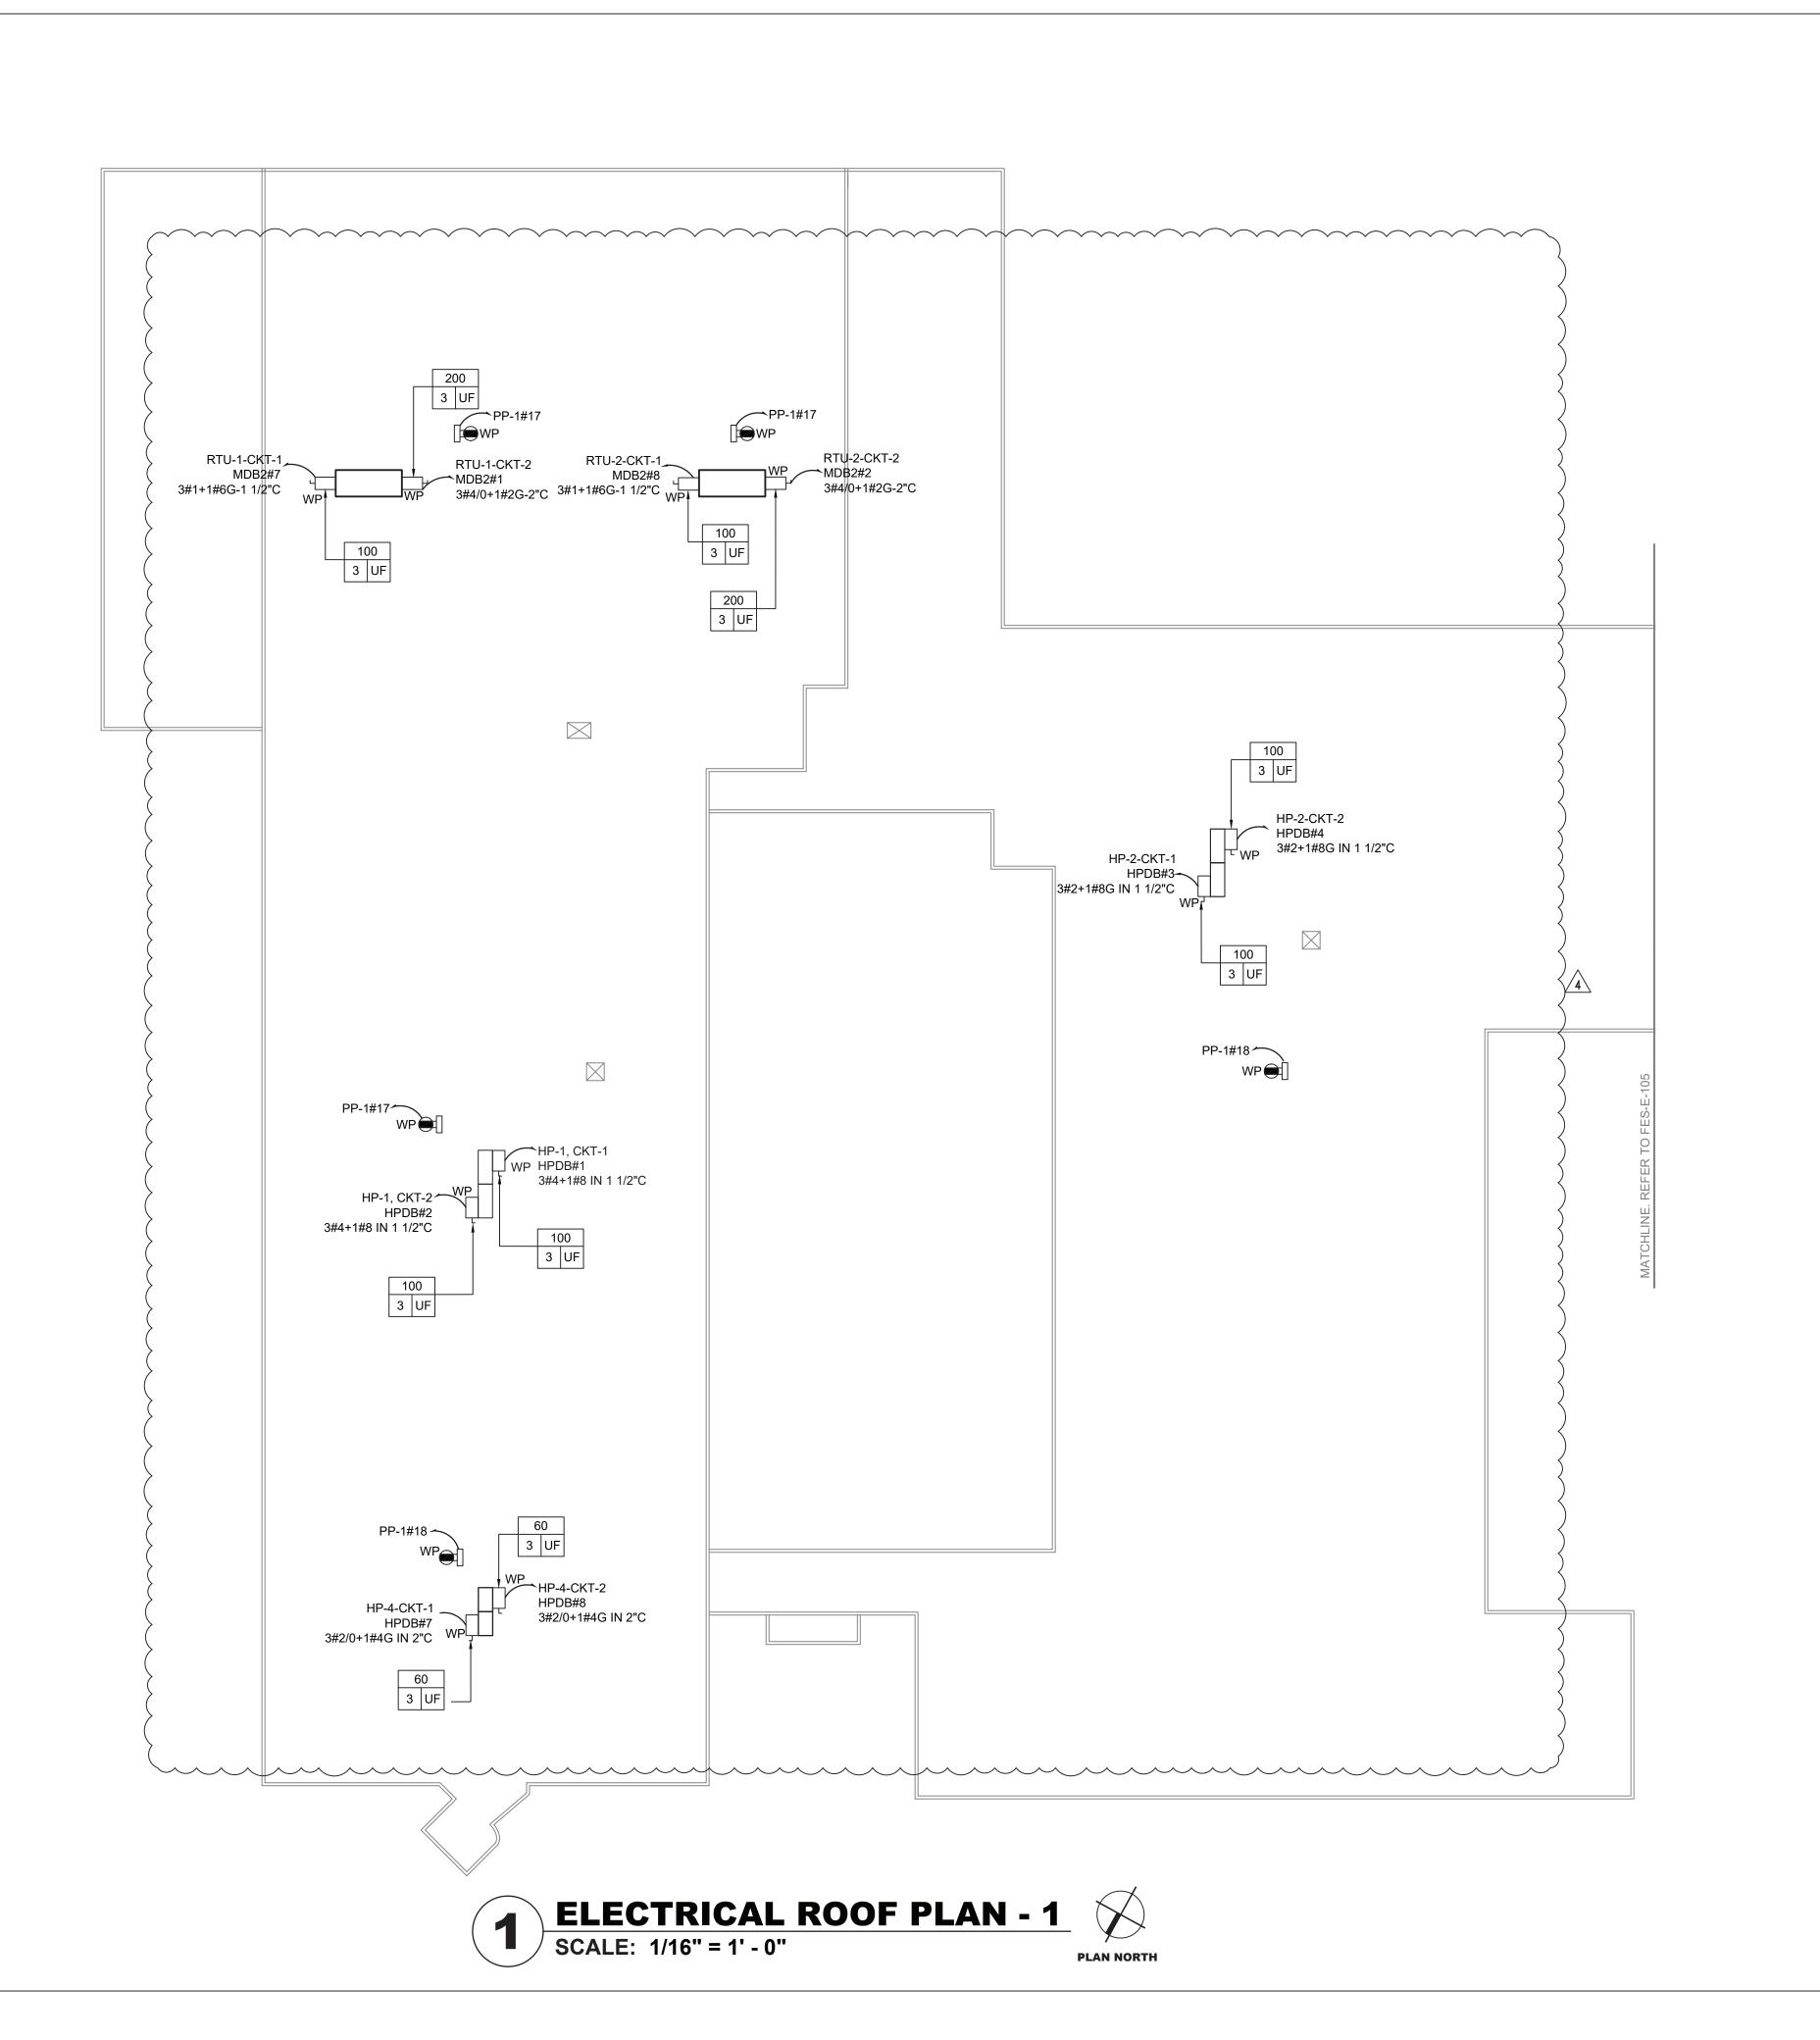

### PLAN NOTES:

- 1. REFER TO ADDITIONAL INSTALLATION NOTES ON DRAWING E-001.
- 2. ALL NEW BRANCH CIRCUIT SHALL BE RUN WITH MINIMUM OF 2#12+1#12G IN 3/4" CONDUIT, UNLESS OTHERWISE NOTED. FOR LIGHTING AND POWER BRANCH CIRCUIT, MC CABLE SHALL BE INSTALLED FOR RECESSED INSTALLATION ONLY, EITHER IN NEW WALLS OR ABOVE HUNG CEILING WHERE POSSIBLE. REFER TO PANEL SCHEDULES IN DRAWING E-201 FOR ALL OTHER FEEDER AND BRANCH CIRCUIT SIZE INFORMATION.
- 3. PROVIDE LABELS ON ALL ELECTRICAL EQUIPMENT INDICATING CIRCUIT ORIGINATION.
- 4. UPDATE ALL EXISTING PANEL DIRECTORIES AFFECTED BY NEW WORK.
- 5. CONTRACTOR SHALL PERFORM AMP PROBE READINGS ON EXISTING SERVICE EQUIPMENT BEFORE AND AFTER WORK TO ENSURE EQUIPMENT WILL NOT BE LOADED BEYOND ITS MAX AMPACITY.
- 6. CONTRACTOR SHALL MAINTAIN CONTINUITY TO ALL EXISTING CIRCUITRY TO REMAIN WHICH ARE AFFECTED BY THE SCOPE OF WORK; CONTRACTOR SHALL FURNISH ALL NECESSARY JUNCTION BOXES, CONDUIT, AND WIRES AS REQUIRED TO KEEP CONTINUITY.
- 7. REFER TO MECHANICAL PLANS FOR EQUIPMENT TO BE SUPPLIED BY OTHER TRADES AND INSTALLED/WIRED UNDER THIS SECTION. COORDINATE LOCATION OF DEVICES WITH OTHER CONTRACTORS.
- 8. PROVIDE FIRESTOPPING FOR ALL PENETRATIONS TO MATCH EXISTING FIRE RATING WHERE APPLICABLE. ALL CORE DRILLS SHALL BE VERIFIED BY BUILDING REPRESENTATIVE PRIOR TO COMMENCING WORK. XRAY ALL FLOOR SLABS PRIOR TO ROUGH-INS FOR CORE DRILL WORK.
- 9. THE CONTRACTOR SHALL FIELD ROUTE FEEDER FOR NEW POWER PANELS. COORDINATE EXACT ROUTING PATH WITH OWNER. SUBMIT A PROPOSED ROUTING PATH TO ENGINEER OF RECORD FOR APPROVAL PRIOR TO RUNNING ANY CONDUIT OR WIRE ASSOCIATED WITH THIS FEEDER.
- 10. DISCONNECT SWITCH FOR UNIT VENTILATORS IS PROVIDED BY HVAC CONTRACTOR. COORDINATE WITH HVAC CONTRACTOR.
- 11. ALL GROUNDING SHALL BE PROVIDED BY THE CONTRACTOR AS PER NEC 2017.12. ALL EXTERIOR CONDUITS SHALL BE RIGID GALVANIZED CONDUIT.

Revisions	Date	O
12-28-22 BIDDING DOCUMENT	12-28-22	-
06-09-23 SED ADDENDUM #1	06-09-23	2
09-14-23BIDDING DOCUMENTS	09-14-23	3
11-09-23ADDENDUM #1	11-09-23	4

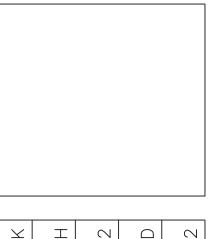



UK	Checked by	SH	Project No.	42052	Scale	AS NOTED	Date	7/29/22

GREENMAN PEDERSEN, INC 2 EXECUTIVE BOULEVARD SUITE 202	SUFFERN, NY 10901 GREENMAN	PEDERSEN, INC 2 EXECUTIVE BOULEVARD SUITE 202 SUFFERN, NY 10901	
Mechanical & Electrical Engineer:		Structural Engineer:	


UNIVENT
REPLACEMENT AT
ARLEY ELEMENTARY
SCHOOL
# 50-02-01-06-0-003-011



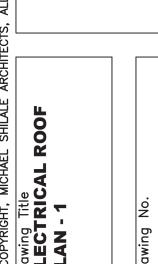

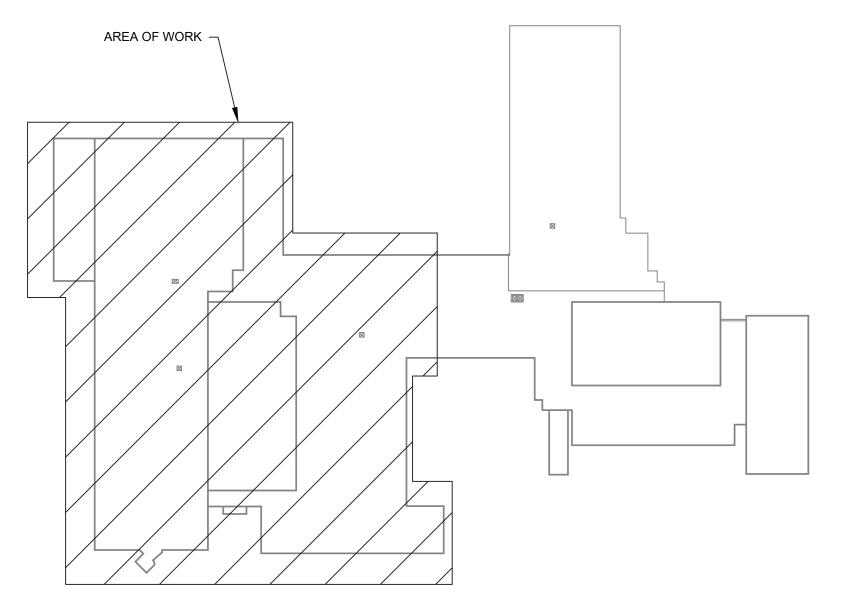



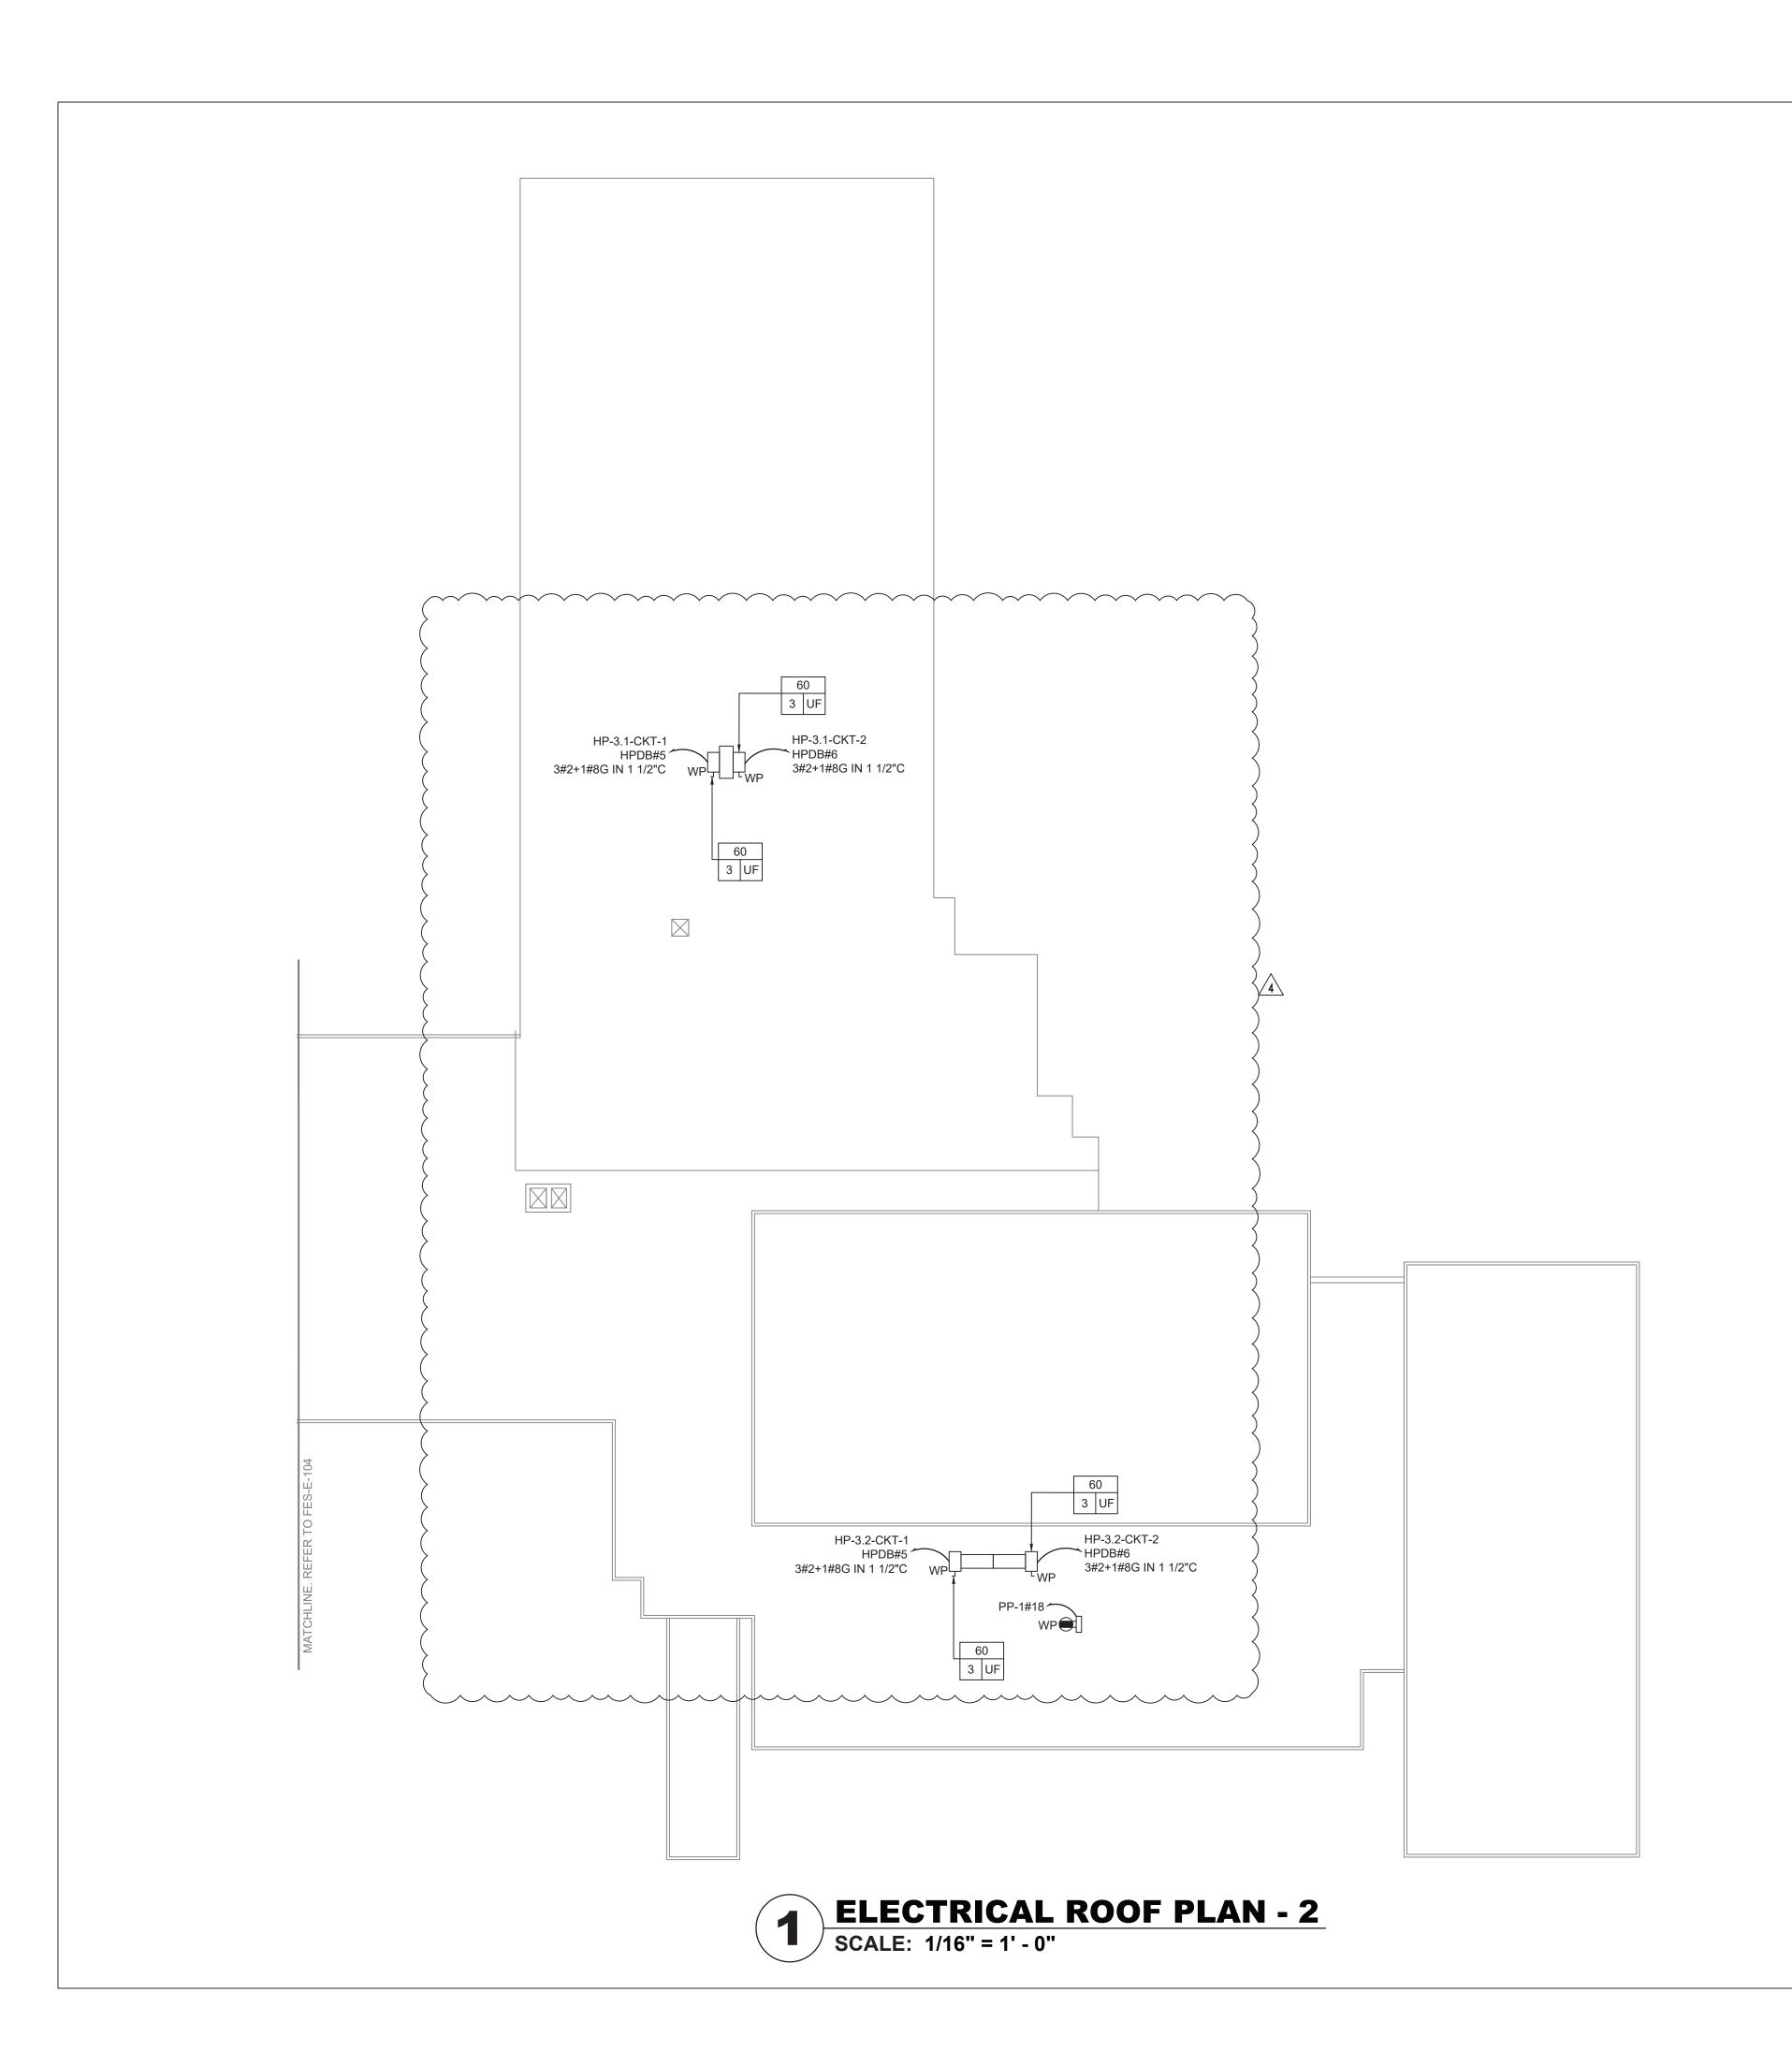

### PLAN NOTES:

- 1. REFER TO ADDITIONAL INSTALLATION NOTES ON DRAWING E-001.
- 2. ALL NEW BRANCH CIRCUIT SHALL BE RUN WITH MINIMUM OF 2#12+1#12G IN 3/4" CONDUIT, UNLESS OTHERWISE NOTED. FOR LIGHTING AND POWER BRANCH CIRCUIT, MC CABLE SHALL BE INSTALLED FOR RECESSED INSTALLATION ONLY, EITHER IN NEW WALLS OR ABOVE HUNG CEILING WHERE POSSIBLE. REFER TO PANEL SCHEDULES IN DRAWING E-201 FOR ALL OTHER FEEDER AND BRANCH CIRCUIT SIZE INFORMATION.
- 3. PROVIDE LABELS ON ALL ELECTRICAL EQUIPMENT INDICATING CIRCUIT ORIGINATION.
- 4. UPDATE ALL EXISTING PANEL DIRECTORIES AFFECTED BY NEW WORK.
- 5. CONTRACTOR SHALL PERFORM AMP PROBE READINGS ON EXISTING SERVICE EQUIPMENT BEFORE AND AFTER WORK TO ENSURE EQUIPMENT WILL NOT BE LOADED BEYOND ITS MAX AMPACITY.
- 6. CONTRACTOR SHALL MAINTAIN CONTINUITY TO ALL EXISTING CIRCUITRY TO REMAIN WHICH ARE AFFECTED BY THE SCOPE OF WORK; CONTRACTOR SHALL FURNISH ALL NECESSARY JUNCTION BOXES, CONDUIT, AND WIRES AS REQUIRED TO KEEP CONTINUITY.
- REFER TO MECHANICAL PLANS FOR EQUIPMENT TO BE SUPPLIED BY OTHER TRADES AND INSTALLED/WIRED UNDER THIS SECTION. COORDINATE LOCATION OF DEVICES WITH OTHER CONTRACTORS.
- 8. PROVIDE FIRESTOPPING FOR ALL PENETRATIONS TO MATCH EXISTING FIRE RATING WHERE APPLICABLE. ALL CORE DRILLS SHALL BE VERIFIED BY BUILDING REPRESENTATIVE PRIOR TO COMMENCING WORK. XRAY ALL FLOOR SLABS PRIOR TO ROUGH-INS FOR CORE DRILL WORK.
- 9. THE CONTRACTOR SHALL FIELD ROUTE FEEDER FOR NEW POWER PANELS. COORDINATE EXACT ROUTING PATH WITH OWNER. SUBMIT A PROPOSED ROUTING PATH TO ENGINEER OF RECORD FOR APPROVAL PRIOR TO RUNNING ANY CONDUIT OR WIRE ASSOCIATED WITH THIS FEEDER.
- 10. DISCONNECT SWITCH FOR UNIT VENTILATORS IS PROVIDED BY HVAC CONTRACTOR. COORDINATE WITH HVAC CONTRACTOR.
- 11. ALL GROUNDING SHALL BE PROVIDED BY THE CONTRACTOR AS PER NEC 2017.

12. ALL EXTERIOR CONDUITS SHALL BE RIGID GALVANIZED CONDUITS.


			0.1		0
	DK	L S	42052	NOTED	/29/22
	ρά	b S	No.	S	7/2

GREENMAN PEDERSEN, INC 2 EXECUTIVE BOULEVARD SUITE 202 SUFFERN, NY 10901	GREENMAN PEDERSEN, INC 2 EXECUTIVE BOULEVARD SUITE 202 SUFFERN, NY 10901
Mechanical & Electrical Engineer:	Structural Engineer:


UNIVENT
REPLACEMENT AT
FARLEY ELEMENTARY
SCHOOL
SED # 50-02-01-06-0-003-011



– AREA OF WORK

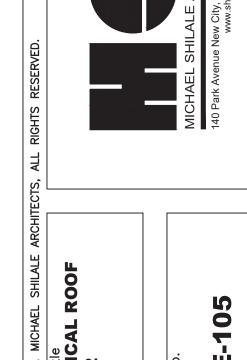



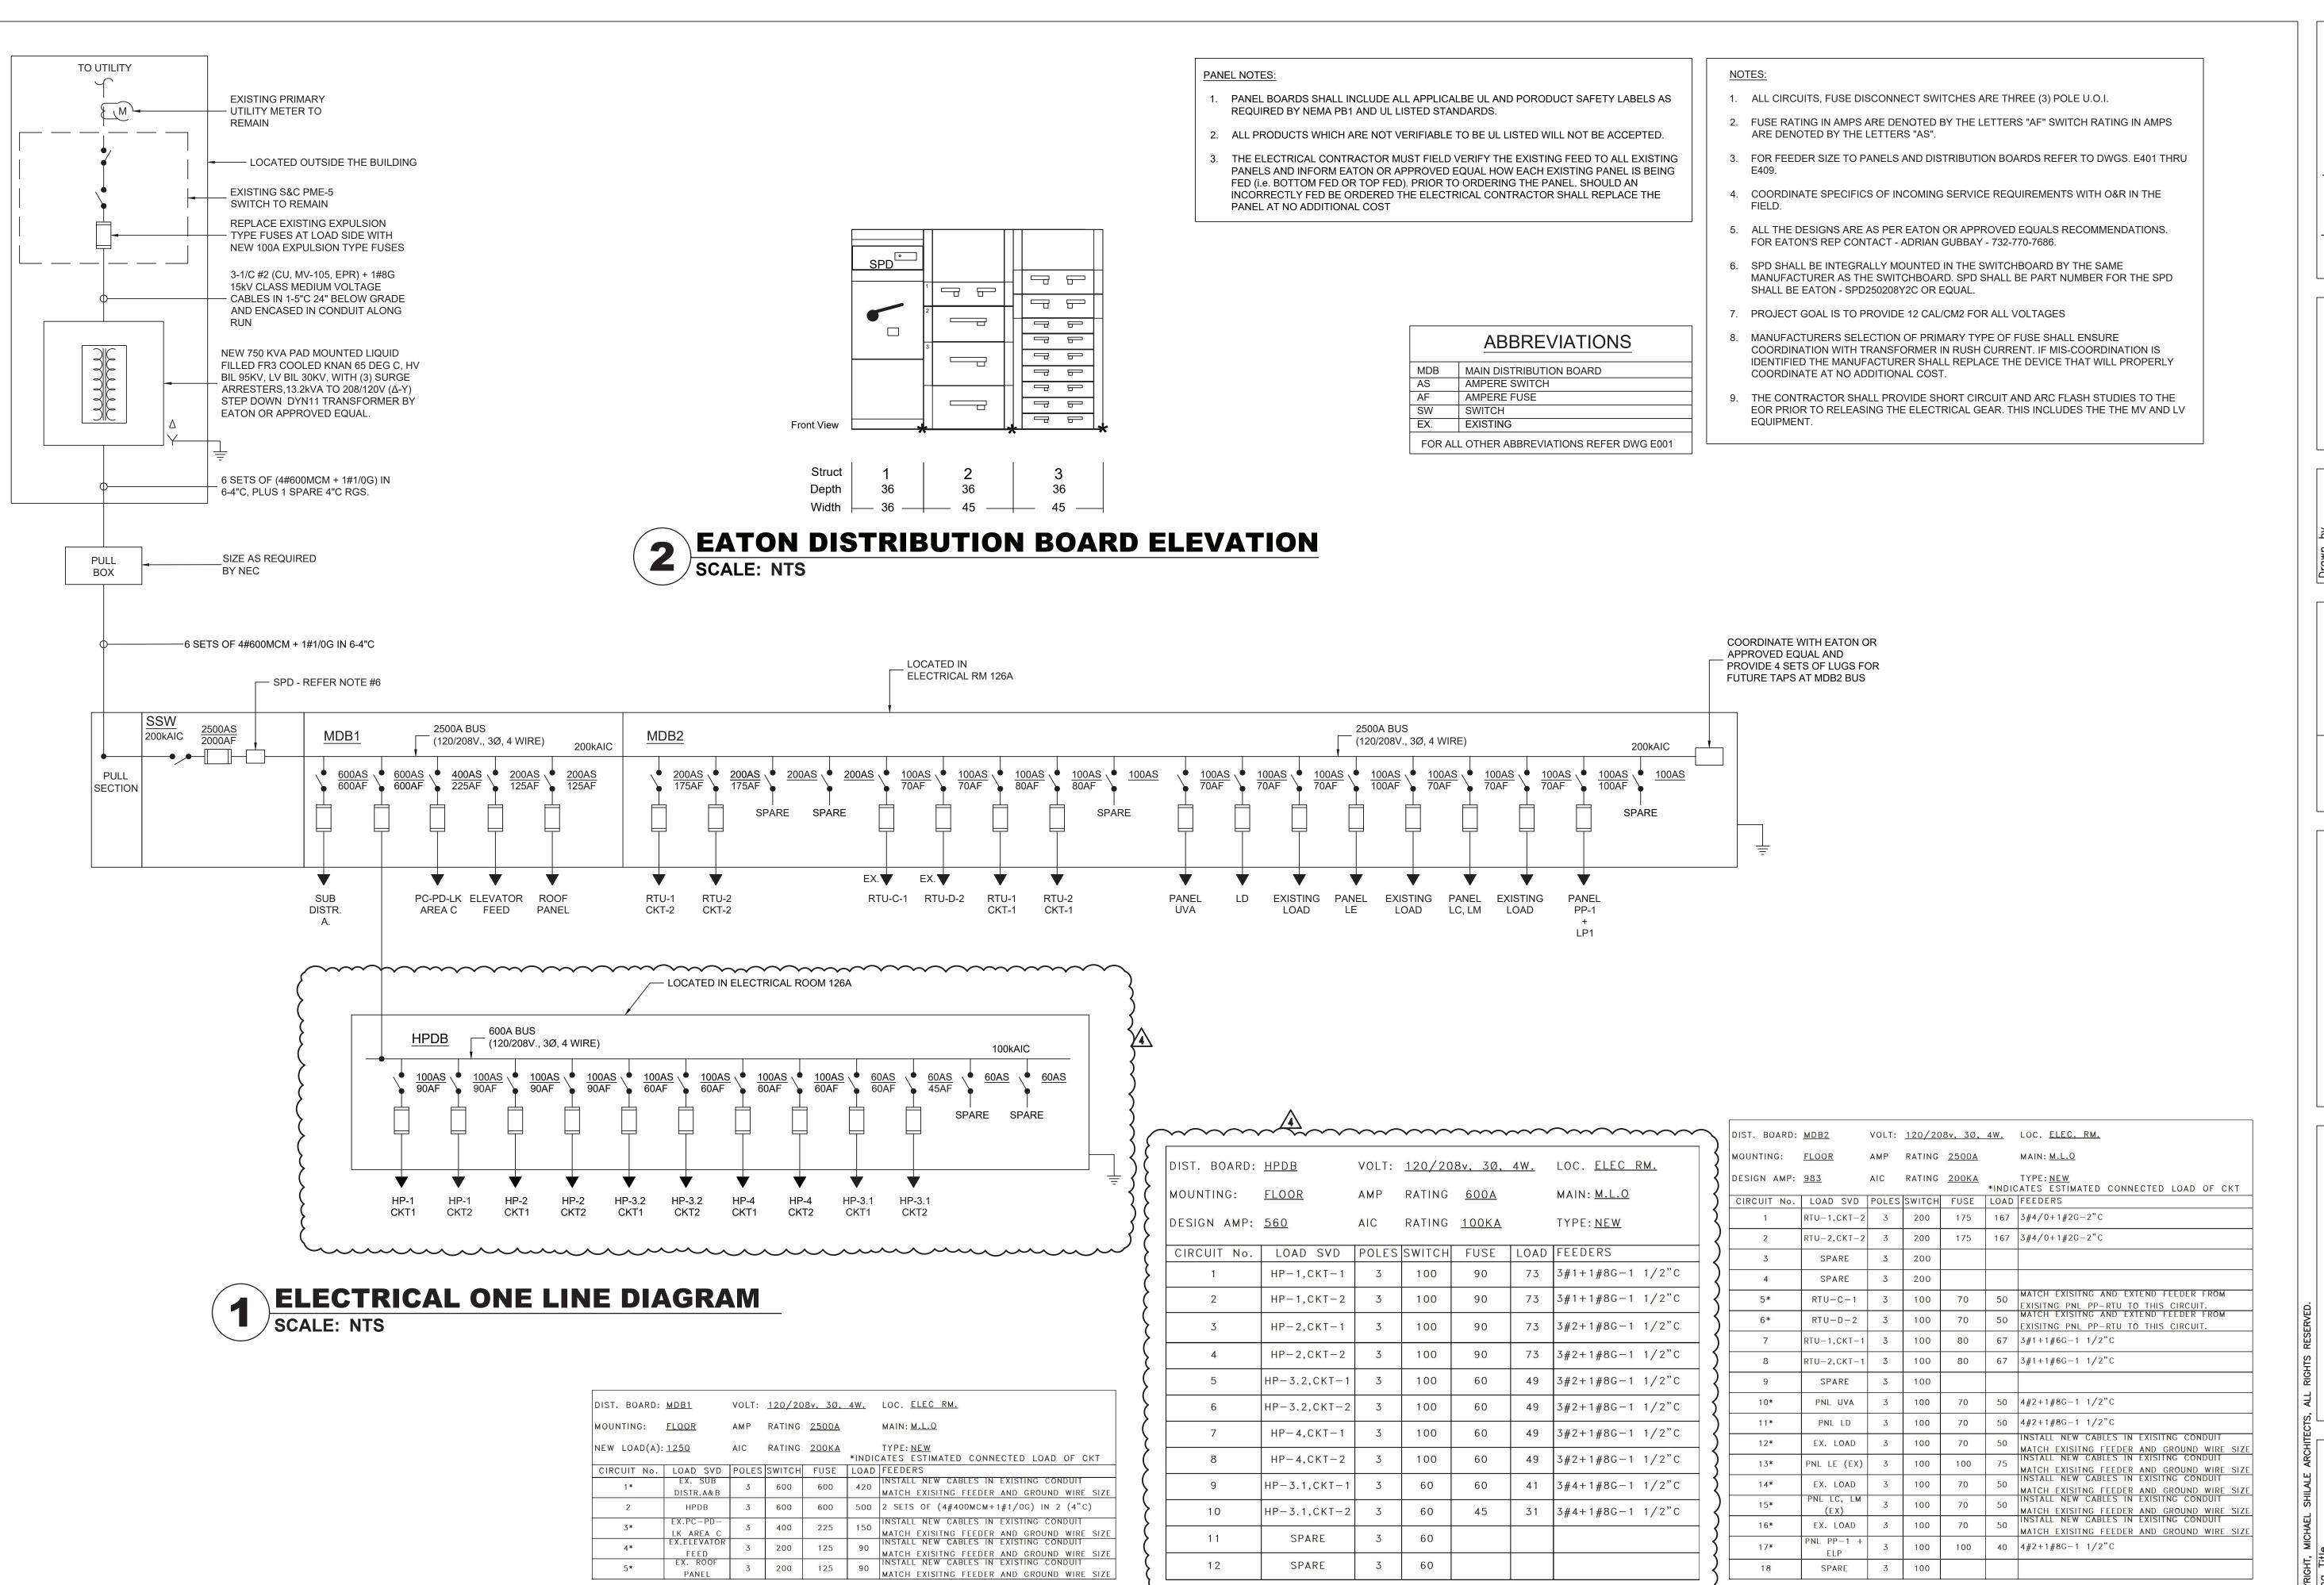

AT TAR UNIVENT REPLACEMENT FARLEY ELEMENT SCHOOL



BOARD ONE

Drawing Title
ELECTRICAL ON
DIAGRAM,
DISTRIBUTION I

	~~~~~				EL SCHE						}
PANEL NAME:	New Panel "PP-1"	L	OCAT	ION:	E	ec. Service	e 126/	4	MOUNTING:	Surface	PANE
VOLTAGE/PHASE:	120/208V, 3 Phase, 4W & G	РА	NEL (	AMP)		100A			FREQUENCY:	60 Hz	VOLTA
PANEL SHORT CIRCUIT RATING(KA):	22 KA	FE	EDER	SIZE	4#	#3+1#8G-1	1/2"0	:	FEEDING SOURCE:	MDB2	PANEL SH
MAIN BREAKER TYPE	MLO		N BRE	EAKER 5 (A):		MLO			BRANCH C.B TYPE	MCB	MAIN BR
Load Designation	Wiring	C/B (A)		•	se Load in	r VA CØ	СТ	C/B (A)	Wiring	Load Designation	Load D
HVAC CONTROL PANEL	2#12+1#12G-3/4"C	20	<b>NO</b> 1	200		CØ	NO	<b>C/B (A)</b>	2#12+1#12G-3/4"C	RECPT AT 126A	CORRID
HVAC CONTROL FANEL	2#12+1#120-3/4-0	20	3				2	20	2#12+1#120-3/4-0	RECFT AT 120A	CEIL.
(EXISTING MDB CKT#1)	MATCH EXISTING	20	5				4	20	(EXISTING MDB CKT#2)MATCH	FAN#4	CEIL.
FAN#7			7				8		EXISTING		CEILING LIG
			9				10			(CKT#4) FROM EXIST.	CEIL.
(EXISTING MDB CKT#3) EXISTING FAN#3	MATCH EXISTING	20	11	-			10	20	MATCH EXISTING	MDB. ELEC. CONTRACTOR TO TRACE CIRCUIT AND	CEIL.
EXISTING FAN#S			13				14			UPDATE CIRCUIT INFO.	CEIL.
EXIST. CKT FROM PP-RTU	2#12+1#12G-3/4"C	20	15	-			16	20	2#12+1#12G-3/4"C	EXIST. CKT FROM PP-RTU	CEIL.
STANCION RECEPTACLES	2#10+1#10G-1"C	20	17			360 180	18	20	2#10+1#10G-1"C	STANCION RECEPTACLES	RECP. TO
FOR CEILING CASSETTE	2#12+1#12G-3/4"C	20	19	480 480			20	20	2#12+1#12G-3/4"C	FOR CEILING CASSETTE	REC. ON
BRANCH CONTROLLER	2#12+1#12G-3/4"C	20	21	•	100 100		22	20	2#12+1#12G-3/4"C	BRANCH CONTROLLER	CEIL.
BRANCH CONTROLLER	2#12+1#126-3/4 6	20	23	-		100 100	24	20	Z#   Z+   #   ZG = 3/ 4 C	BRANCH CONTROLLER	CEIL.
BRANCH CONTROLLER	2#12+1#12G-3/4"C	20	25 27	100 100	100		26	20	2#12+1#12G-3/4"C	BRANCH CONTROLLER	EXISTI
			29	-	100	100	28				ROOM 11
BRANCH CONTROLLER	2#12+1#12G-3/4"C	20		100		100	30	20	2#12+1#12G-3/4"C	LTG @ 158A, 159A	EXISTI
			31	100 100			32	20	2#12+1#12G-3/4°C	HVAC CONTROL PANEL	\ \ \ \ \ \ \ \ \ \ \ \ \ \ \ \ \ \ \
SPARE		20	33	-			34	20		SPARE	SI
SPARE		20	35				36	20		SPARE	SI
SPARE		20	37				38				SI
SPARE		20	39				40	40	4#6+1#8-1 1/4"C	PANEL "LP1"	<b>∤</b>
SPARE		20	41				42				SI
CONN	ECTED LOAD PER PHA	SE IN	VA	1560	400	840				OUNTING: SURFACE	SI
T	OTAL CONNECTED LOA	D IN	KVA		2.8			PER BUS R: INDO(	6, EQUIP. GROUND BAR OR TYPE		<b>}</b>

UNIVENTS RM. 212 MATCH EXISTING  UNIVENTS RM. 217 MATCH EXISTING  UNIVENT RM. 206 MATCH EXISTING  EXISTING LOAD MATCH EXISTING  EXISTING LOAD MATCH EXISTING  SPARE  SPARE	PA FE MAI	ATING	(AMP) SIZE EAKER G (A):		100A #4+1#6G-1 40A n VA	1 1/2"(	<b>C/B (A)</b>	MOUNTING: FREQUENCY: FEEDING SOURCE: BRANCH C.B TYPE Wiring MATCH EXISTING	Recessed on Wall 60 Hz  MCB  Load Designation  UNIVENTS RM. 214-216
PANEL SHORT CIRCUIT RATING(KA):  MAIN BREAKER TYPE  Load Designation  Wiring  UNIVENTS RM. 212  MATCH EXISTING  UNIVENT RM. 217  MATCH EXISTING  UNIVENT RM. 206  EXISTING LOAD  EXISTING LOAD  SPARE  SPARE	FE MAI R/	EEDER N BREATING NO 1 3	SIZE EAKER G (A):	ase Load in	#4+1#6G-1 40A n VA	1 1/2"0	<b>C/B (A)</b>	FEEDING SOURCE:  BRANCH C.B TYPE  Wiring	MCB  Load Designation
RATING(KA):  MAIN BREAKER TYPE  MCB  Load Designation  Wiring  C  UNIVENTS RM. 212  MATCH EXISTING  UNIVENT RM. 217  MATCH EXISTING  UNIVENT RM. 206  EXISTING LOAD  MATCH EXISTING  EXISTING LOAD  MATCH EXISTING  EXISTING LOAD  MATCH EXISTING  SPARE  SPARE	MAI R/	CT NO	EAKER 3 (A): Pha	ase Load in	40A n <b>VA</b>	CT NO	<b>C/B (A)</b>	BRANCH C.B TYPE Wiring	Load Designation
Load Designation  Wiring  UNIVENTS RM. 212  MATCH EXISTING  UNIVENTS RM. 217  MATCH EXISTING  UNIVENT RM. 206  EXISTING LOAD  EXISTING LOAD  MATCH EXISTING  EXISTING LOAD  SPARE  SPARE	C/B (A) 20 20	ATING  CT  NO  1	€ (A): Pha		n VA	CT NO	20	Wiring	Load Designation
UNIVENTS RM. 212 MATCH EXISTING  UNIVENTS RM. 217 MATCH EXISTING  UNIVENT RM. 206 MATCH EXISTING  EXISTING LOAD MATCH EXISTING  EXISTING LOAD MATCH EXISTING  SPARE  SPARE	20	3	Out Werkdeen		1000 GH E 100	NO	20		
UNIVENTS RM. 212 MATCH EXISTING  UNIVENTS RM. 217 MATCH EXISTING  UNIVENT RM. 206 MATCH EXISTING  EXISTING LOAD MATCH EXISTING  EXISTING LOAD MATCH EXISTING  SPARE  SPARE	20	3	AØ	BØ	CØ	NO	20		UNIVENTS RM. 214-216
UNIVENTS RM. 217 MATCH EXISTING  UNIVENT RM. 206 MATCH EXISTING  EXISTING LOAD MATCH EXISTING  EXISTING LOAD MATCH EXISTING  SPARE  SPARE	20	1. 330		-		2		MATCH EXISTING	UNIVENTS RM. 214-216
UNIVENT RM. 206 MATCH EXISTING  EXISTING LOAD MATCH EXISTING  EXISTING LOAD MATCH EXISTING  SPARE  SPARE		1. 330			]				
EXISTING LOAD MATCH EXISTING  EXISTING LOAD MATCH EXISTING  SPARE  SPARE	20	5			1	4	20	MATCH EXISTING	UNIVENTS RM. 202-203
EXISTING LOAD MATCH EXISTING  SPARE  SPARE						6	20	MATCH EXISTING	UNIVENTS RM. 204
SPARE SPARE	20	7		]		8	20	MATCH EXISTING	EXISTING LOAD
SPARE	20	9			-	10	20		SPARE
	20	11				12	20		SPARE
CDADE	20	13				14	20		SPARE
SPARE	20	15				16	20		SPARE
SPARE	20	17				18	20		SPARE
CONNECTED LOAD PER PHASE	E IN	VA	0	0	0		NEL TYPE:		IOUNTING: RECESSED
TOTAL CONNECTED LOAD  TOTAL DEMAND LOAD I				0		COF	PPER BUS		

5					PAI	NEL SCHE	ULE				
Ź	PANEL NAME:	New Panel "LD2"	LC	CATI	ON:		Custodial 2	200C		MOUNTING:	Recessed on Wall
3	VOLTAGE/PHASE:	120/208V, 3 Phase, 4W & G	PAI	NEL (	AMP)		225A			FREQUENCY:	60 Hz
\ \	PANEL SHORT CIRCUIT RATING(KA):	22 KA	FE	EDER	SIZE		4#2+1#6G	-2"C		FEEDING SOURCE:	
{	MAIN BREAKER TYPE	МСВ		N BRE	AKER		70A			BRANCH C.B TYPE	MCB
\ \ \			100			⊥ ıse Load ir	VA				
3	Load Designation	Wiring	C/B (A)	CT NO	AØ	BØ	CØ	CT NO	C/B (A)	Wiring	Load Designation
3	CORRIDOR LGTS.	EXISTING TO REMAIN	20	1				2	20	EXISTING TO REMAIN	CORRIDOR LGTS.
3	CEIL. RM. 203	EXISTING TO REMAIN	20	3				4	20	EXISTING TO REMAIN	CEIL. RM. 203
>	CEIL. RM. 203	EXISTING TO REMAIN	20	5				6	20	EXISTING TO REMAIN	OVERHEAD AND TOILET
Z	CEILING LIGHTS RM. 210	EXISTING TO REMAIN	20	7				8	20	EXISTING TO REMAIN	CEIL. LGTS 206
{	CEIL. LGTS 206	EXISTING TO REMAIN	20	9				10	20	EXISTING TO REMAIN	CEIL. LGTS 206
<	CEIL. RM. 203	EXISTING TO REMAIN	20	11				12	20	EXISTING TO REMAIN	CEIL. RM. 203
5	CEIL. RM. 203	EXISTING TO REMAIN	20	13		-		14	20	EXISTING TO REMAIN	CEIL. RM. 202
{	CEIL. RM. 202	EXISTING TO REMAIN	20	15				16	20	EXISTING TO REMAIN	CEIL. RM. 202
>	RECP. TO RM 203-203	EXISTING TO REMAIN	20	17				18	20	EXISTING TO REMAIN	RECP. TO RM 203-20
3	REC. ON DEPT. 210	EXISTING TO REMAIN	20	19				20	20	EXISTING TO REMAIN	REC. IN CORRIDOR
\ <	CEIL. LGTS 211	EXISTING TO REMAIN	20	21				22	20	EXISTING TO REMAIN	CEIL. LGTS 211
3	CEIL. LGTS 211	EXISTING TO REMAIN	20	23				24	20	EXISTING TO REMAIN	CEIL. LGTS FAN ROOM
3	EXISTING LOAD	EXISTING TO REMAIN	20	25				26	20	EXISTING TO REMAIN	REC. IN FAN RM & 20
<b>ا</b>	ROOM 111 LIGHTING	EXISTING TO REMAIN	20	27				28	20	EXISTING TO REMAIN	EXISTING LOAD
3	EXISTING LOAD	EXISTING TO REMAIN	20	29				30	20	EXISTING TO REMAIN	COMPUTER RECEP.
$\langle$	EXISTING LOAD	EXISTING TO REMAIN	20	31				32	20	EXISTING TO REMAIN	COMPUTER RECEP.
く	SPARE		20	33				34	20		SPARE
}	SPARE		20	35				36	20		SPARE
\ {	SPARE		20	37				38	20		SPARE
{	SPARE		20	39				40	20		SPARE
<	SPARE		20	41				42	20		SPARE

				PAI	NEL SCHE	DULE				
PANEL NAME:	NEW PANEL "LP1"	LC	CAT	ION:	E	ec. Service	e 126	A	MOUNTING:	Surface
VOLTAGE/PHASE:	120/208V, 3 Phase, 4W & G	PAI	NEL (	AMP)		100A			FREQUENCY:	60 Hz
PANEL SHORT CIRCUIT RATING(KA):	22 KA	FEI	EDER	SIZE	47	#6+1#8G-1	1/4"(	0	FEEDING SOURCE:	PANEL PP-1
MAIN BREAKER TYPE	MLO	0	N BRE	EAKER S (A):		MLO			BRANCH C.B TYPE	MCB
					se Load ir	ı VA				
Load Designation	Wiring	C/B (A)	CT NO	AØ	BØ	CØ	CT NO	C/B (A)	Wiring	Load Designation
GYM, LABEL, KITCHEN & NORTH CORRIDORS	EXISTING TO REMAIN	20	1				2	20	EXISTING TO REMAIN	CORR. SOUTH BLDGS
CORR. NEAR ROOM 152	EXISTING TO REMAIN	20	3				4	20	EXISTING TO REMAIN	EXISTING LOAD
CORRIDOR	2#10+1#12G-3/4"C	20	5			400 400	6	20	2#10+1#12G-3/4"C	CORRIDOR
CORRIDOR	2#10+1#12G-3/4"C	20	7	400 400			8	20	2#10+1#12G-3/4"C	CORRIDOR
CORRIDOR	2#10+1#12G-3/4"C	20	9		400 400		10	20	2#10+1#12G-3/4"C	CORRIDOR
CORRIDOR	2#10+1#12G-3/4"C	20	11			400 160	12	20	2#12+1#12G-3/4"C	ELECTRICAL ROOM
EXIT LIGHT	2#10+1#12G-3/4"C	20	13	30		,	14	20		SPARE
EXIT LIGHT	2#10+1#12G-3/4"C	20	15		30		16	20		SPARE
SPARE		20	17				18	20		SPARE
SPARE		20	19				20	20		SPARE
SPARE		20	21				22	20		SPARE
SPARE		20	23				24	20		SPARE
SPARE		20	25				26	20		SPARE
SPARE		20	27				28	20		SPARE
SPARE		20	29				30	20		SPARE
	ECTED LOAD PER PHA DTAL CONNECTED LOAI			830	830 3.02	1360	COF	NEL TYPE:	, EQUIP. GROUND BAR	DUNTING: SURFACE

8.38


DOOR: INDOOR TYPE

DOOR: INDOOR TYPE

TOTAL DEMAND LOAD IN AMPS

TOTAL DEMAND LOAD IN AMPS

4 k 2	11-09-23 09-14-23 06-09-23	11-09-23ADDENDUM #1 09-14-23BIDDING DOCUMENTS 06-09-23 SED ADDENDUM #1
<u>-</u>	12-28-22	12-28-22 BIDDING DOCUMENTS
No.	Date	Revisions

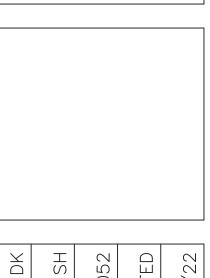

, X	bd by	NS	t No.	42052		AS NOTED
	Checked by		Project No.		Scale	¥ 

<u>م</u>	ਹ	م	ഗ്	۵
	FELLERSEIN, IINC 2 EXECUTIVE BOULEVARD SUITE 202 STIFFERN NY 10001		PEDERSEN, INC	Z EKECUTIVE BOULEVARD SUITE 202 SUFFERN, NY 10901
Mechanical	& Electrical Engineer:		Structural	

UNIVENT
REPLACEMENT AT
FARLEY ELEMENTARY
SCHOOL
SED # 50-02-01-06-0-003-01



### PANEL NOTES:

- 1. PANEL BOARDS SHALL INCLUDE ALL APPLICALBE UL AND PORODUCT SAFETY LABELS AS REQUIRED BY NEMA PB1 AND UL LISTED STANDARDS.
- ALL PRODUCTS WHICH ARE NOT VERIFIABLE TO BE UL LISTED WILL NOT BE ACCEPTED.
- 3. THE ELECTRICAL CONTRACTOR MUST FIELD VERIFY THE EXISTING FEED TO ALL EXISITNG PANELS AND INFORM EATON OR APPROVED EQUAL HOW EACH EXISTING PANEL IS FED (i.e. BOTTOM FED OR TOP FED). PRIOR TO ORDERING THE PANEL. SHOULD AN INCORRECTLY FED BE ORDERED THE ELECTRICAL CONTRACTOR SHALL REPLACE THE PANEL AT NO ADDITIONAL COST

# UNIVENT REPLACEMENT AT WILLOW GROVE ELEMENTARY SCHOOL

**WILLOW GROVE ELEMENTARY SCHOOL 153 STORRS ROAD** THIELLS, NY 10984 SED# 50-02-01-06-0-030-016

**OWNER: NORTH ROCKLAND CENTRAL SCHOOL DISTRICT** 65 Chapel Street Garnerville, NY 10923

ARCHITECT: MICHAEL SHILALE ARCHITECTS, LLP 140 Park Avenue New City, NY 10956


> PME ENGINEER: GREENMAN-PEDERSON, INC. 400 Rella Boulevard, Suite 207 Montabello, NY 10901

REUSE EXISTING UV'S SPECIFIED FOR REPLACEMENT AS PER ALT. NO. 200. REMOVE EXISTING COIL, FLIP AND CONNECT HEAT

INCLUDE AN ALLOWANCE TO REPLACE EXISTING HEAT SUPPLY & RETURN PIPING AND INSULATION FOR 20 LINEAR FEET PER

ALT. NO. 200: REPLACE EXISTING UV'S IN LOCATION SPECIFIED ON DRAWINGS WGES-A-100 AND WGES-A-101. SEE PLANS FOR LOCATIONS

ALT. NO. 202: REFURBISH EXISTING PLENUM MOUNTED HVAC UNIT AND PROVIDE NEW ACCESS PANELS AND MAINTENANCE PLATFORMS FOR

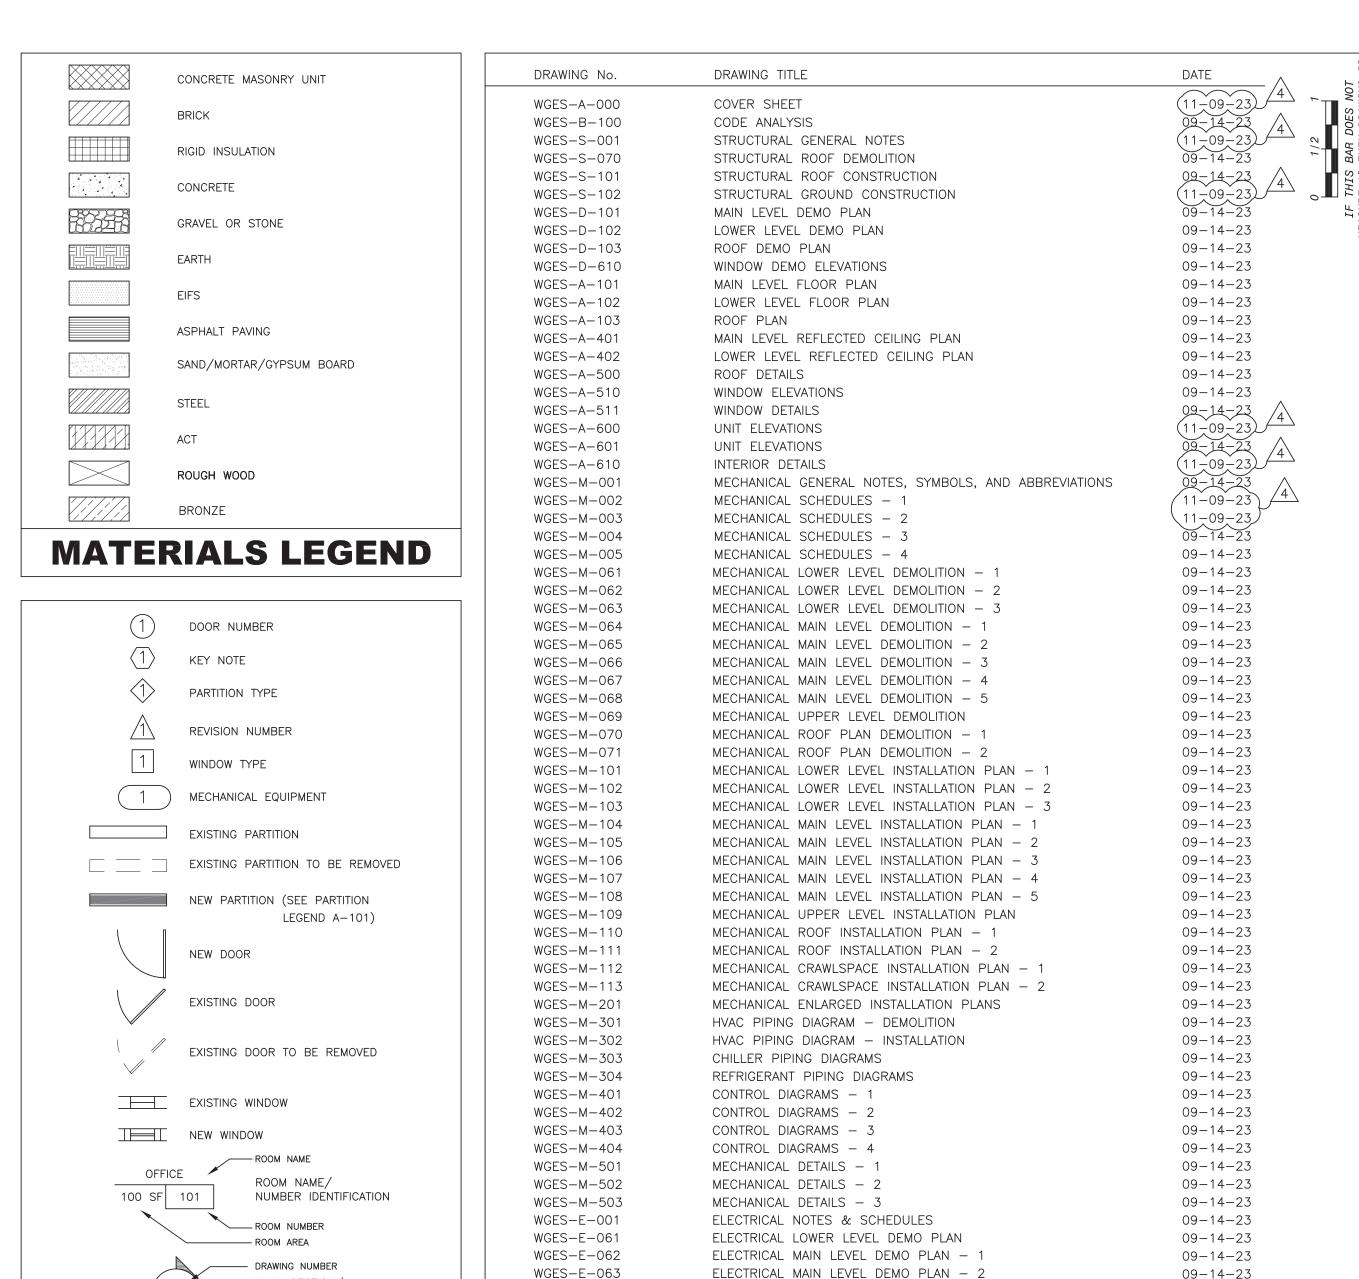

### LIST OF DRAWINGS

ELECTRICAL LOWER LEVEL PLAN

ELECTRICAL ROOF PLAN - 1

ELECTRICAL ROOF PLAN - 2


ELECTRICAL DETAILS - 1

ELECTRICAL DETAILS - 2

ELECTRICAL MAIN LEVEL PLAN - 1

ELECTRICAL MAIN LEVEL PLAN - 2

ELECTRICAL SCHEDULES & RISERS

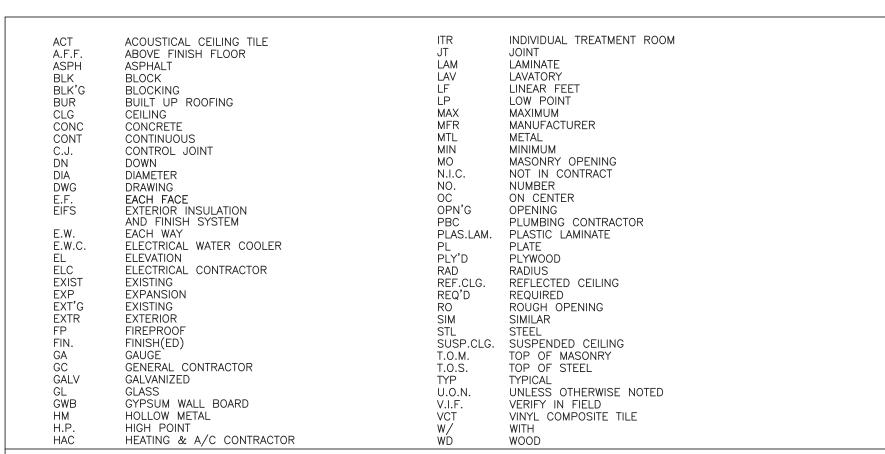

ALLOWANCE NO. 200: REPLACE EXISTING HEAT & CHILLED WATER SUPPLY & RETURN PIPING AND INSULATION FOR 40 LINEAR FEET PER EACH UNIT VENTILATOR TO BE REPLACED.

**SYMBOLS LEGEND** 

WALL SECTION/

SHEET NUMBER

ELEVATION REFERENCE

# **ALLOWANCES**

**ABBREVIATIONS** 

WGES-E-101

WGES-E-102

WGES-E-103

WGES-E-104

WGES-E-105

WGES-E-400

WGES-E-500

WGES-E-501

COVER

INC

III ii

EMEI 00VE 1H00 030-01

T REPI VILLOW INTARY

UNIVENT AT W ELEMEN SED# 50-0

09-14-23

09-14-23

09-14-23

11-09-23 09-14-23

09-14-23

09-14-23

00 П MG

1. ALL PLAN DIMENSIONS ARE NOMINAL U.O.N. DIMENSIONS TO THE FINISHED FACE OF AN ELEMENT OR WALL WILL BE DESIGNATED WITH AN "F" AS SHOWN. 2. G.C. TO VERIFY ALL DIMENSIONS IN THE FIELD AND IS TO NOTIFY ARCHITECT IF THERE ARE ANY DISCREPANCIES.

### **GENERAL NOTES**

PROVIDE A PRICE TO REPLACE 10 LINEAR FEET OF EXISTING HEAT OR CHILLED WATER PIPE. (THIS AMOUNT WILL ADD OR REDUCE ALLOWANCE NO. 200).

### **UNIT PRICES**


AHU-1 AND AHU-2. ALT. NO. 203: REMOVE EXISTING GLASS BLOCK AND INSTALL NEW WINDOWS ALT. NO. 204: CONTRACTOR TO INSTALL ONE SWING SET AND TWO ADD A SWING KITS WITH LOCATION TO BE DETERMINED IN THE FIELD BY OWNER. SWING SET TO BE ADA GAMETIME - POWERSCAPE SWING MODEL # 81598. ADD A BAY TO BE ADA GAMETIME -POWERSCAPE SWING ADD A BAY MODEL # 81599. SWING SET AND ADD A BAYS WILL BE PROVIDED TO THE CONTRACTOR BY ALT NO. 205: PROVIDE 1/4" THICK SOLID SURFACE MATERIAL AT ALL UV'S BUILT INTO CASE WORK. ALT NO. 206: PROVIDE INSTALLATION FOR NEW CANOPY. CANOPY TO BE PROVIDED TO THE CONTRACTOR BY THE OWNER. CANOPY MODEL NUMBER RC201810IN. ATTACHED CUT SHEETS HAVE BEEN PROVIDED FOR THE CONTRACTOR'S REFERENCE. G.C. SHALL INCLUD NYS P.E. SIGNED AND SEALED DRAWINGS FOR FOOTING DESIGN


EACH UNIT VENTILATOR TO BE REPLACED.


ALT. NO. 201: REMOVE AND REPLACE CAFETERIA UNIT, SEE MECHANICAL DWGS.


& CHILLER LINES TO PROPER COILS. ALL OTHER EXISTING UV'S TO BE REPLACED WITH NEW.


**ALTERNATES** 

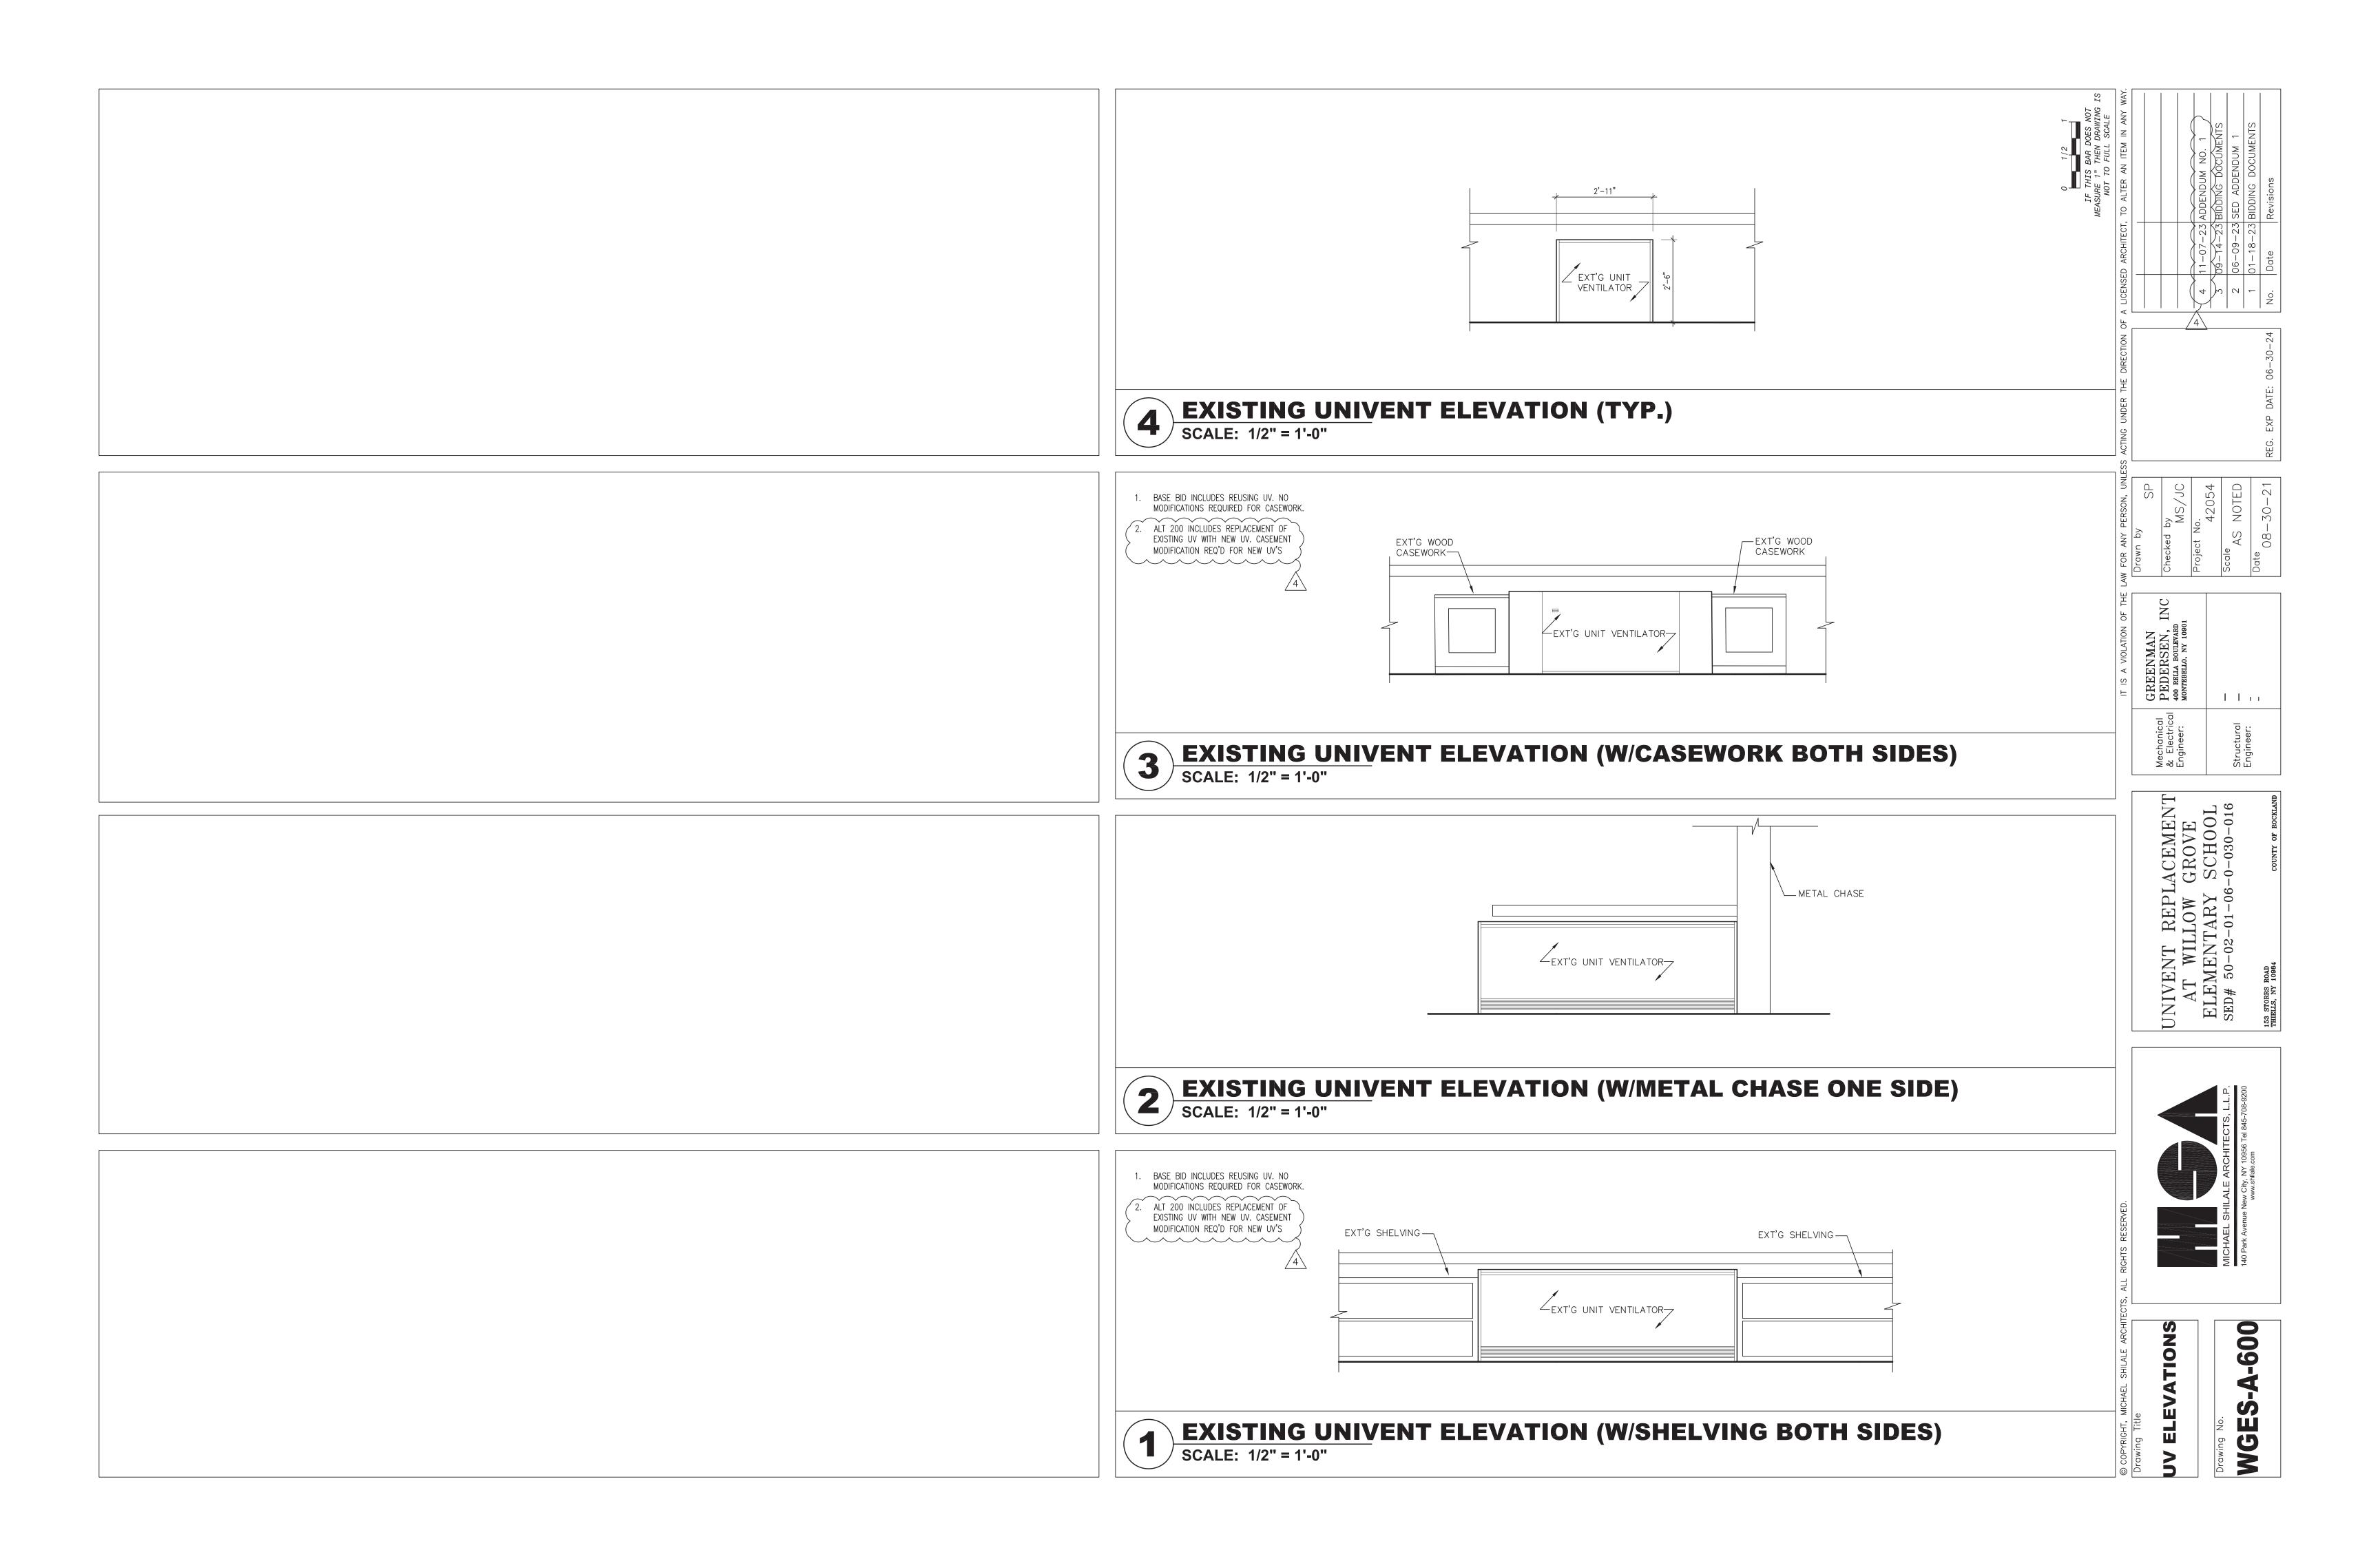

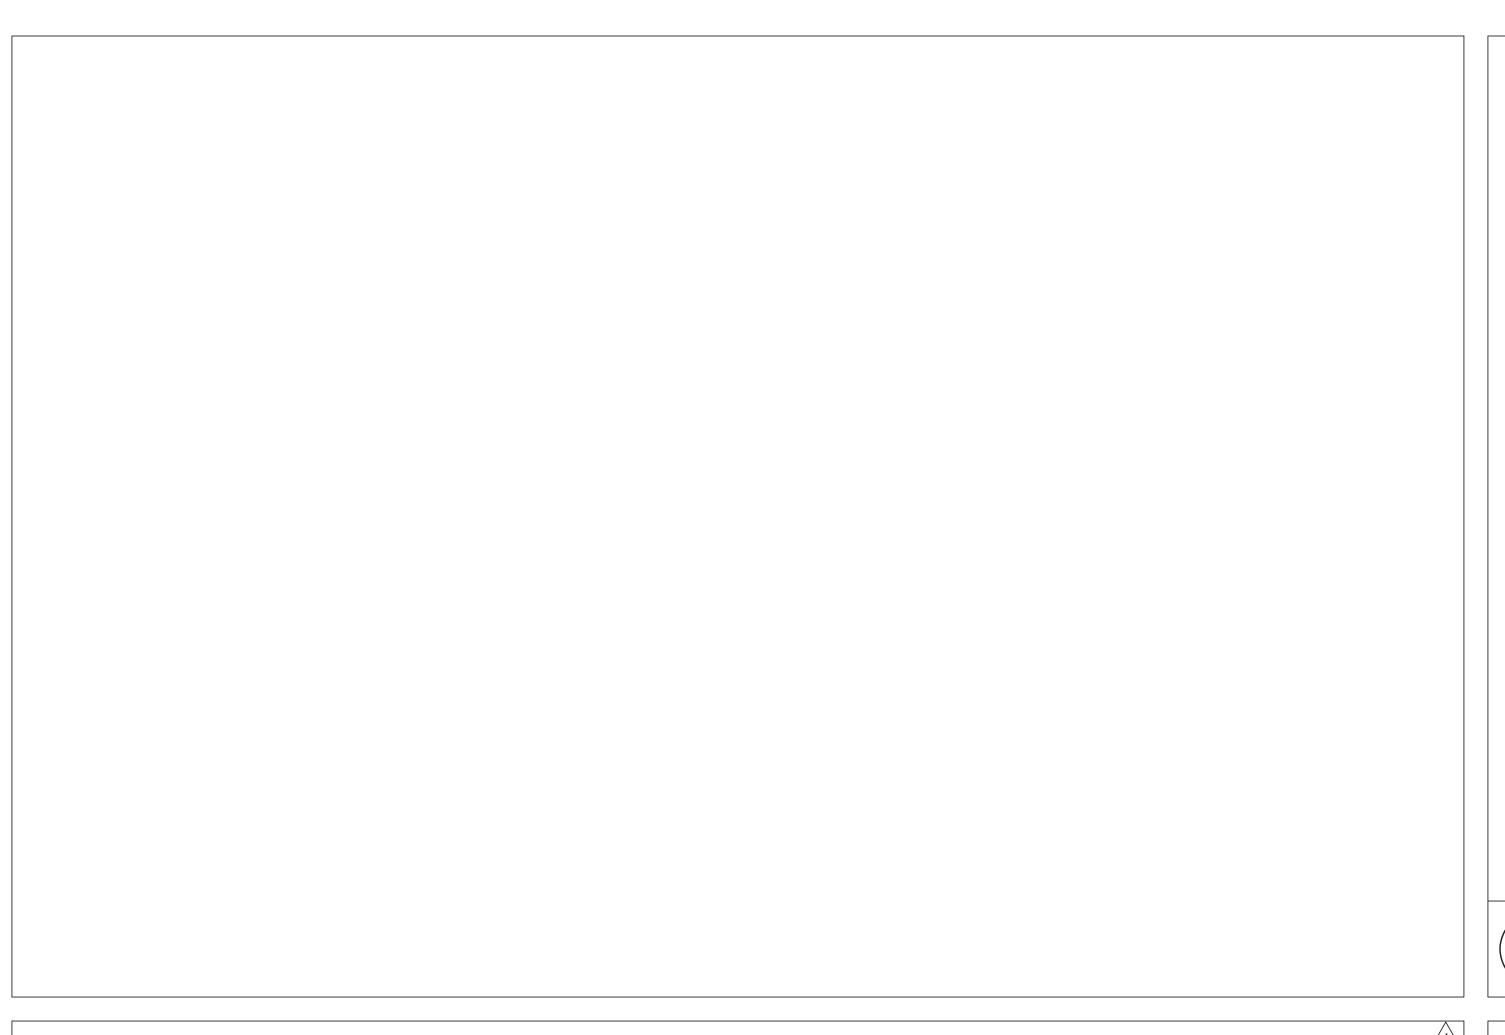


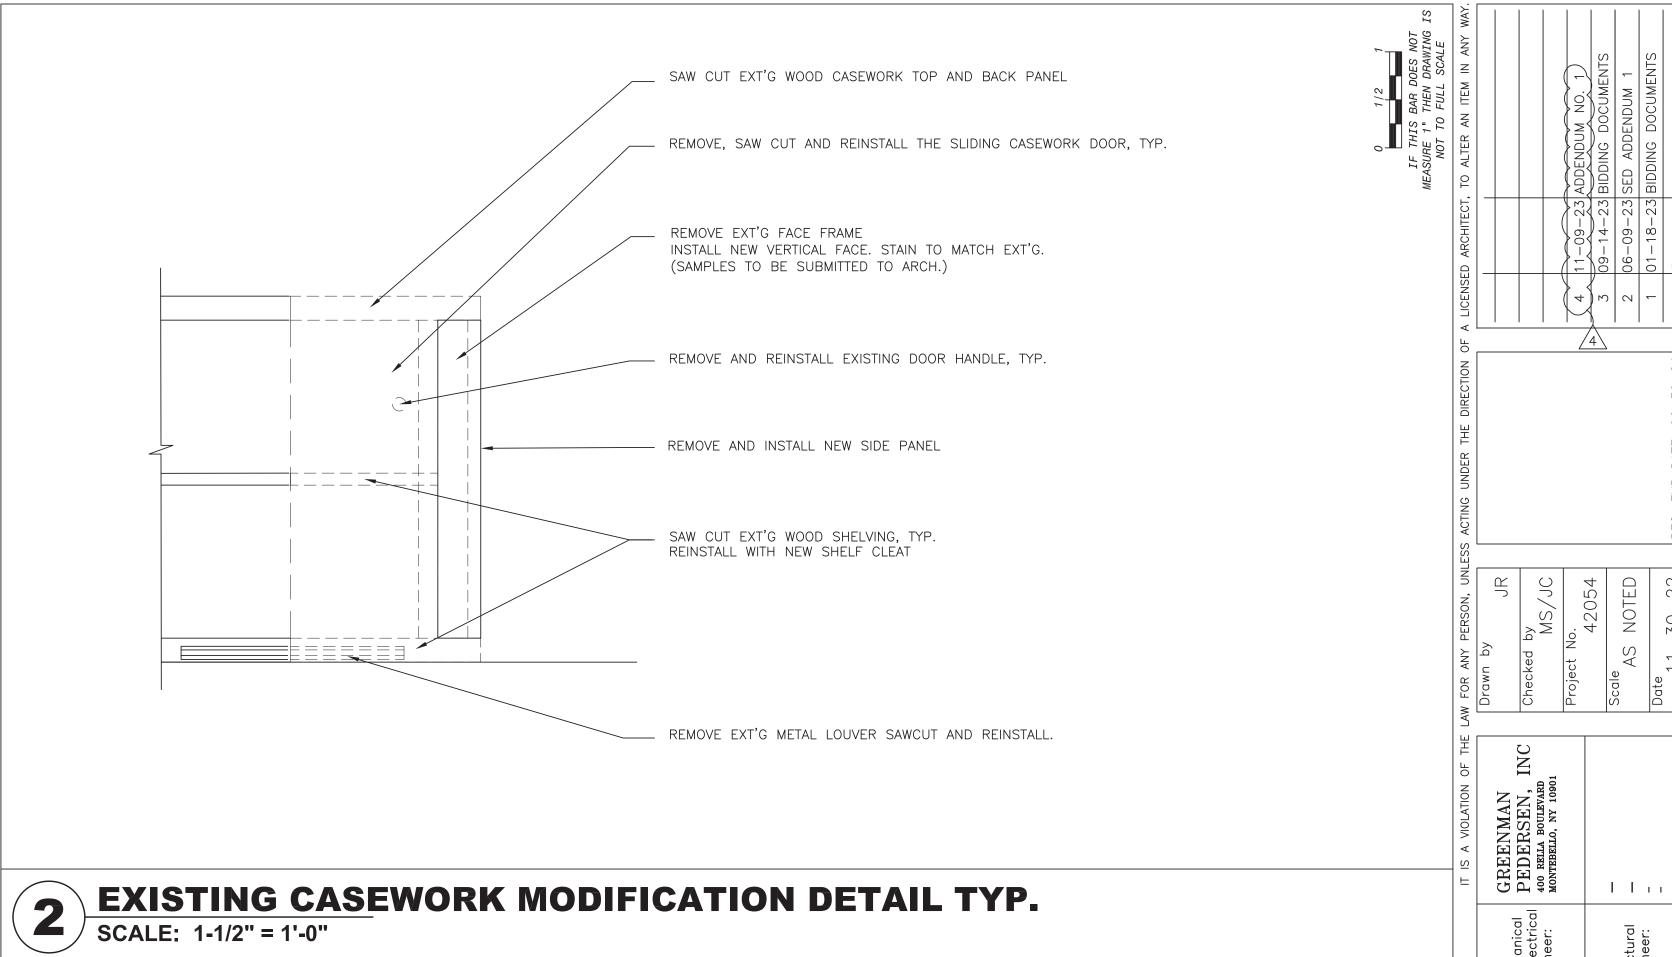

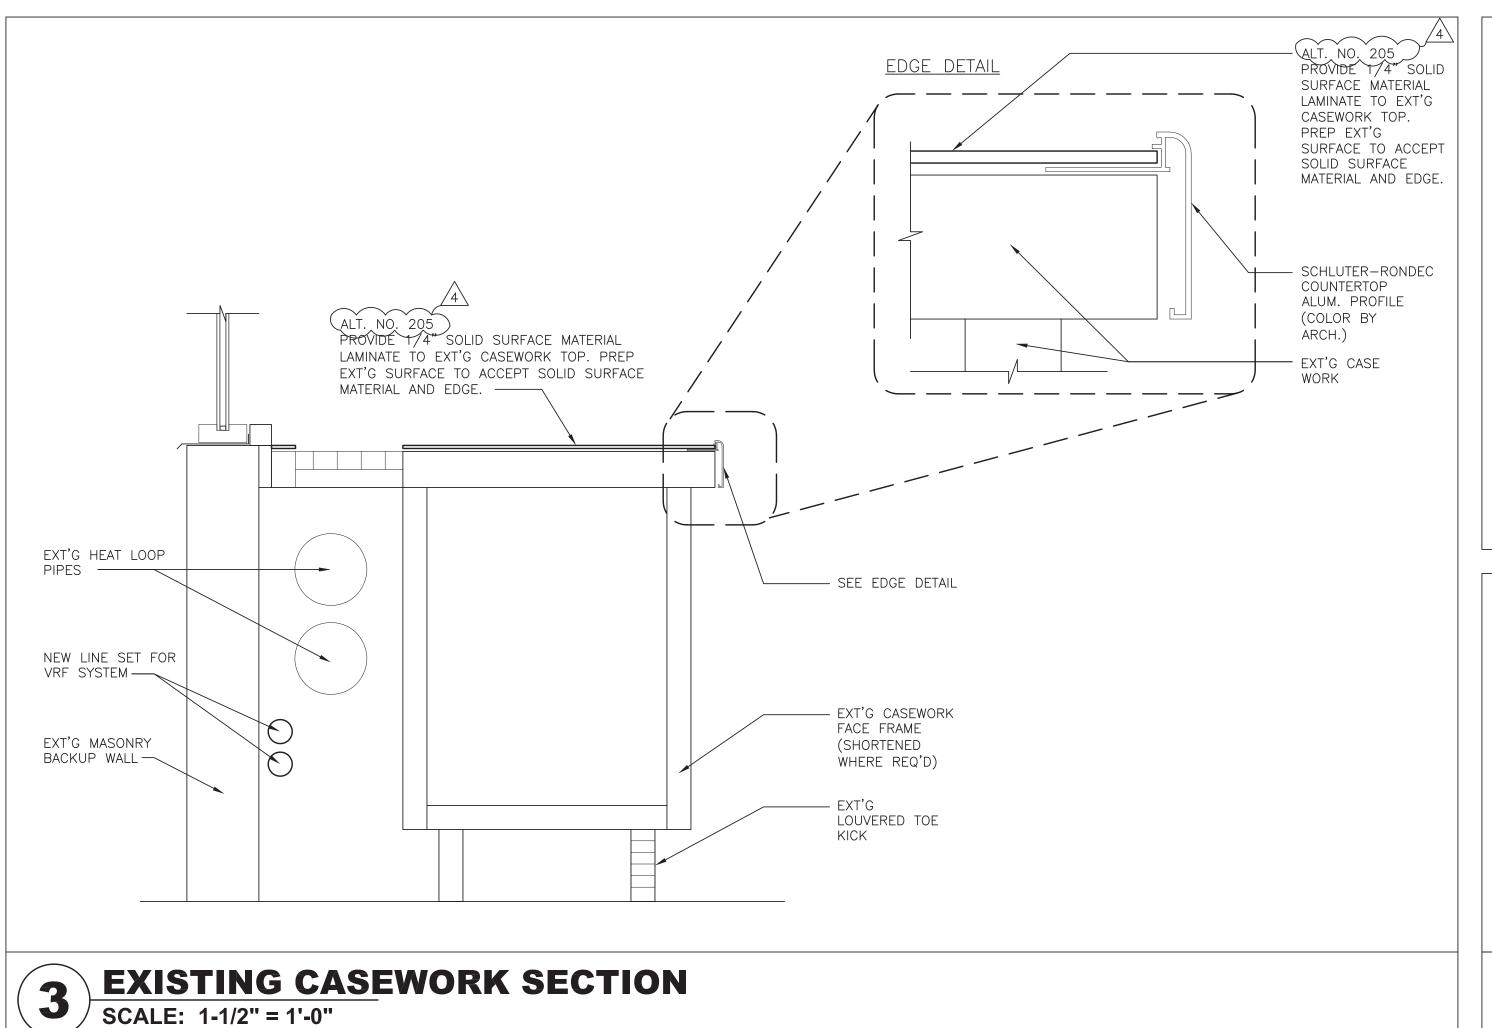

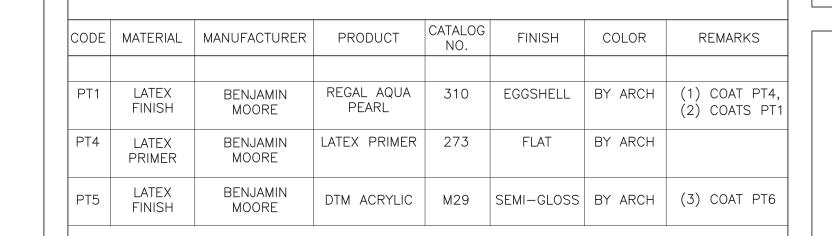



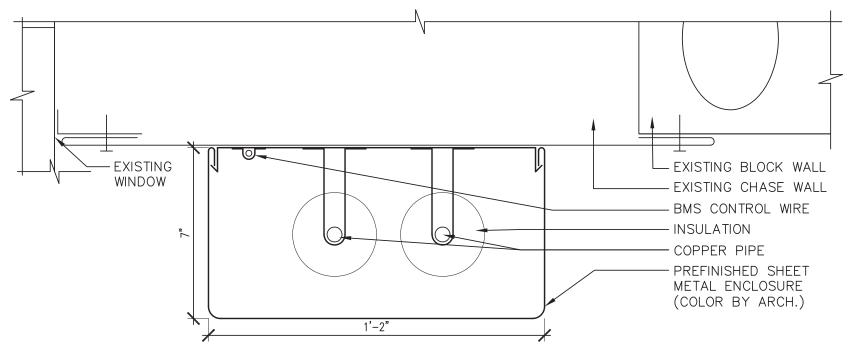

NOTE: PROVIDE PT1 AT ALL DISTURBED AREAS. COLOR TO MATCH EXISTING. ALL NEW SURFACES TO RECEIVE PT1.

MICHAEL SHILALE ARCHITECTS, L.L.I www.shilale.com

UNIVENT REPLACEMENT
AT WILLOW GROVE
ELEMENTARY SCHOOL
SED# 50-02-01-06-0-030-016

INTERIOR
DETAILS

DETAILS

Drawing No.

WGES-A-610

1 LINE SET ENCLOSURE
SCALE: 3" = 1'-0"

	WATER PUMP SCHEDULE																					
							PUM	P DATA						MOTOR							BASIS C	OF DESIGN
UNIT# SERVICE	LOCATION	TYPE	FLUID	IMPELLER DIA. (IN)	CAPACITY (GPM)	TOTAL HEAD (FT H2O)	DUTY POINT POWER (HP)	NPSHr (FT H2O)	PART LOAD EFF. (PLEVV)	DUTY POINT EFF.	MAX. WWP (PSIG)	WATER TEMP. (°F)	TYPE	ENCLOSURE TYPE	HP	RPM	V/PH/Hz	SPEED CONTROL	BASE DIMENSIONS (LxW, IN)	OPERATING WEIGHT (LBS)	MANUFACTURER	MODEL#
CHWP-1 CHILLED WATER	OUTDOORS	BASE MOUNTED, END SUCTION	30% PROPYLENE GLYCOL	8.625	320	50	6.13	9.2	70.3	67.5	175	44	NEMA PREMIUM, VFD READY	TEFC	7.5	1800	208/3/60	VARIABLE	34x14	367	BELL & GOSSETT	e-1510 2.5BB
CHWP-2 CHILLED WATER	OUTDOORS	BASE MOUNTED, END SUCTION	30% PROPYLENE GLYCOL	8.625	320	50	6.13	9.2	70.3	67.5	175	44	NEMA PREMIUM, VFD READY	TEFC	7.5	1800	208/3/60	VARIABLE	34x14	367	BELL & GOSSETT	e-1510 2.5BB
CHWP-3 CHILLED WATER	CHILLER ROOM	BASE MOUNTED, END SUCTION	30% PROPYLENE GLYCOL	5.25	320	80	9.12	11.8	70.9	72.4	175	44	NEMA PREMIUM, VFD READY	TEFC	10	1800	208/3/60	VARIABLE	34x14	328	BELL & GOSSETT	e-1510 2.5AC
CHWP-4 CHILLED WATER	CHILLER ROOM	BASE MOUNTED, END SUCTION	30% PROPYLENE GLYCOL	5.25	320	80	9.12	11.8	70.9	72.4	175	44	NEMA PREMIUM, VFD READY	TEFC	10	1800	208/3/60	VARIABLE	34x14	328	BELL & GOSSETT	e-1510 2.5AC

1. PROVIDE OPERATIONS AND MAINTENANCE MANUALS.

2. PROVIDE VARIABLE FREQUENCY DRIVE WITH HOA CONTROL.

3. PROVIDE INTERNALLY SELF-FLUSHING MECHANICAL SEALS.

CONDENSATE DRAIN PIPE SIZING SCHEDULE									
SIZE (IN)	MAXIMUM CONNECTED COOLING CAPACITY (TONS)								
3/4	20								
1	40								
1 1/4	90								
1 1/2	125								
2	250								
NOTES:	TE DRAIN DIDING DED THIS								

1. SIZE CONDENSATE DRAIN PIPING PER THIS SCHEDULE WHERE NOT OTHERWISE INDICATED IN THE CONTRACT DOCUMENTS.

	COOLING COIL SCHEDULE														
TAG	SERVICE	REFRIGERANT	TOTAL COOLING CAPACITY (BTU/H)	SENSIBLE COOLING CAPACITY (BTU/H)	SUPPLY AIRFLOW (CFM)	OUTSIDE AIRFLOW (CFM)	PRESS. DROP (IN WC)	EAT (°F DB)	EAT (°F WB)	LAT (°F DB)	LAT (°F WB)	MAX. FACE VELOCITY (FPM)	ROWS	OVERALL DIMENSIONS (WxH)(IN)	BASIS OF DESIGN
CC-3	AHU-3	R-410A	83430	52630	2000	1000	0.5	79.0	67.0	55.0	54.0	550	4	44x29	TRANE CSAA004
CC-4	AHU-4	R-410A	246610	153490	7000	1360	0.5	75.0	65.0	55.0	54.0	550	4	72x41.5	TRANE CSAA014
CC-5	AHU-5	R-410A	246610	153490	7000	1360	0.5	75.0	65.0	55.0	54.0	551	5	72x41.5	TRANE CSAA014
CC-7	AHU-7	R-410A	83430	52630	2000	1000	0.5	79.0	67.0	55.0	54.0	550	4	44x29	TRANE CSAA004
CC-8	AHU-8	R-410A	83430	52630	2000	1000	0.5	79.0	67.0	55.0	54.0	550	4	44x29	TRANE CSAA004

1. THE COILS SHALL BE FACTORY INSTALLED WITHIN A DOUBLE-WALLED, INSULATED HOUSING COMPLETE WITH ACCESS DOORS AND DRAIN PLAN.

2. PROVIDE LINEAR EXPANSION VALVE KITS FOR EACH COIL. THE EXPANSION VALVES SHALL BE A PRODUCT OF THE VRF SYSTEM MANUFACTURER (REFER TO THE SPLIT SYSTEM AIR CONDITIONING UNIT SCHEDULE). 3. PROVIDE WITH INTEGRAL BASE FRAME.

4. PROVIDE AE-200 CONTROLLER OR APPROVED EQUAL

	Lun		4							
WATER PIPE SIZING SCHEDULE										
SIZE (IN)	MATERIAL	MAXIMUM FLOW (GPM)	\ }							
3/4	TYPE L COPPER	3.5	<b>\</b>							
1	TYPE L COPPER	7.4	\							
1 1/4	TYPE L COPPER	13.2	\							
1 1/2	TYPE L COPPER	21	\							
2	TYPE L COPPER	44	\							
2 1/2	TYPE L COPPER	79	\							

1. SIZE HOT AND CHILLED WATER PIPING PER THIS SCHEDULE WHERE NOT OTHERWISE INDICATED IN THE CONTRACT DOCUMENTS.

SCHEDULE 40 STEEL

SCHEDULE 40 STEEL

SCHEDULE 40 STEEL

SCHEDULE 40 STEEL

131

270

360

620

SPLIT SYSTEM AIR CONDITIONING UNIT SCHEDULE
of Life of Of Live / till Conditionaling Graff Contiduction

UNIT#	LOCATION	TOTAL COOLING	EER	IEER	REFRIGERANT	CONDENSER	COMPRESSOR		ELE	ECTRICA	AL		UNIT WEIGHT	BASIS C	OF DESIGN		
	51411 #	200/111011	CAPACITY (MBH)		ILLIY	THE THISE WITH	EA DB °F (COOLING/ HEATING)	TYPE	VOLTS	PHASE	Hz	MOCP (A)	MCA (A)	(LBS)	MANUFACTURER	MODEL#	•
	AC-3	GRADE	96000	14.7	30.35	R410A	95/0	SCROLL	208	3	60	45	31	622	TRANE	TUHYE0963AN40AN	*
	AC-4	GRADE	240,000	10.6	20.4	R410A	95/0	SCROLL	208	3	60	100	79	874	TRANE	TUHYE2403AN40AN	•
	AC-5	GRADE	240,000	10.6	20.4	R410A	95/0	SCROLL	208	3	60	100	79	874	TRANE	TUHYE2403AN40AN	•
	AC-7	GRADE	96000	14.7	30.35	R410A	95/0	SCROLL	208	3	60	45	31	622	TRANE	TUHYE0963AN40AN	
	AC-8	GRADE	96000	14.7	30.35	R410A	95/0	SCROLL	208	3	60	45	31	622	TRANE	TUHYE0963AN40AN	4

1. PROVIDE DISCONNECT SWITCH.

2. PROVIDE LINEAR EXPANSION VALVE KIT FOR CONNECTION TO THE COOLING COILS (PAC-LV OR EQUAL).

3. PROVIDE AHU CONTROLLER (PAC0AH001-1 OR EQUAL).

4. PROVIDE TWINNING KIT WHERE REQUIRED BY THE MANUFACTURER. 5. PROVIDE FILTER DRIER KIT (PAC-SPRFCS OR EQUAL).

	\ _		
,		***********	<i></i>
}	CHILLER ACOUSTIC ACCESSORIES	}	GLYCOL MAKEUP UNIT

(	CHILLER	COMPRESSO	R ACOUSTIC BLANKETS	CHILLER NOISE REDUCTION SYSTEM							
(	TAG #	QUANTITY	BASIS OF DESIGN	BASIS OF DESIGN	DIMENSIONS (LxWxH)(IN)	WEIGHT (LBS)					
>	CH-1	2	BRD HUSH COVER	HUSHCORE UNITARY SM-SB	242x98	300					
(	CH-2	2	BRD HUSH COVER	NOT APPLICA	ABLE						

NOTES:

1. THE CHILLERS HAVE BEEN PRE-ORDERED WITHOUT THE ACOUSTIC ACCESSORIES SPECIFIED IN THIS SCHEDULE. COORDINATE WITH THE CHILLER MANUFACTURER AND PROVIDE THE ITEMS LISTED IN THIS SCHEDULE UNDER THIS

2. PAINT EXPOSED METAL TO MATCH THE CHILLER FINISH.

### **GLYCOL MAKEUP UNIT**

JNIT#	LOCATION	FLOW RATE (GPM)		MAX.	TANK		ELE	CTRICA	L		OVERALL	UNIT	BASIS OF [	DESIGN
			PRESS. (PSIG)		SIZE (GAL)	VOLTS	PHASE	Hz	MOP (A)	MCA (A)	DIMENSIONS (LxWxH, IN)	WEIGHT (LBS)	MANUFACTURER	MODEL#
MU-1	CHILLER RM	1.4	85	100	115	1	60	15	0.9	33x33x60	900	AXIOM INDUSTRIES	SF-100-PRV-HP-L	
OTEC.		-												

1. PROVIDE A PACKAGED MAKE-UP UNIT WHICH SHALL BE CAPABLE OF MAINTAINING THE SYSTEM FILL PRESSURE AT 30 PSIG. PROVIDE A POLYETHYLENE TANK WITH REMOVABLE LID, STRAINER, ISOLATION VALVES, PUMP, CHECK/BALANCING VALVE, EXPANSION TANK, DISCHARGE PRESSURE GAUGE, STEEL PIPING, LOW LEVEL CUT-OUT, AND CONTROL/ALARM PANEL WITH INDICATOR LIGHTS IN A NEMA 4 ENCLOSURE. 2. PROVIDE WITH DUAL PRVS AND CONTROLS CAPABLE OF SUPPLYING TWO SEPARATE SYSTEMS.

### CHEMICAL SHOT FEEDER SCHEDULE

	UNIT #	SERVICE	LOCATION	TYPE	SIZE (GAL)	MAX. PRESS.	WEIGHT (LBS)	BASIS OF D	BASIS OF DESIGN		
					(OAL)	(PSIG)	(LDO)	MANUFACTURER	MODEL#		
	CF-1	CHW	OUTDOORS	VERTICAL BY-PASS	5	300	38	NEPTUNE	DBF-5HP		
	CF-2	CHW	CHILLER RM	VERTICAL BY-PASS	5	300	38	NEPTUNE	DBF-5HP		

### **EXPANSION TANK SCHEDULE** TEMP. BASIS OF DESIGN ACCEPT- PIPE SIZE | WEIGHT APPROX. TANK RANGE SYSTEM VOLUME ANCE TO TANK WHEN UNIT# LOCATION SYSTEM PRESS (PSIG) VOLUME (GAL) MIN. MAX FULL (GAL) VOLUME (IN) MANUFACTURER MODEL# (LBS) (GAL) (°F) (°F) 2000 40 | 100 | 12 700 BELL & GOSSETT 200-L ET-1 OUTDOORS CHW 50 25 2000 ET-2 CHILLER RM CHW 40 100 50 25 700 BELL & GOSSETT 200-L <u>NOTES:</u> 1. PROVIDE VERTICAL ASME BLADDER EXPANSION TANK.

AIR SEPARATOR SCHEDULE	

			AIR SEPARA	IOF	(30	ПЕРС	JLE		
				AIR	R SEPAR	ATOR	OPERATING	BASIS OF D	DESIGN
JNIT #	SERVICE	LOCATION	TYPE	SIZE (IN)	FLOW (GPM)	PRESS. DROP (FT H20)	WEIGHT (LBS)	MANUFACTURER	MODEL#
AS-1	CHW	BASEMENT	COALESCING AIR & DIRT	6	320	0.81	366	BELL & GOSSETT	CRSN-6F
AS-2	CHW	BASEMENT	COALESCING AIR & DIRT	6	320	0.81	366	BELL & GOSSETT	CRSN-6F

	WATER FILTER SCHEDULE											
UNIT	SERVICE	LOCATION	TYPE	SIZE	FLOW	FILTER MEDIA	BASIS OF DESIGN					
#	SERVICE	LOCATION	1176	(IN)	(GPM)	(MICRON)	MANUFACTURER	MODEL#				
WF-1	VF-1 CHW OUTDOORS SIDE STREAM 1 10 5 AXIOM INDUSTRIES SFP-10											
WF-2	VF-2 CHW CHILLER RM SIDE STREAM 1 10 5 AXIOM INDUSTRIES SFP-10											
WATER	VATER FILTER SCHEDULE NOTES:											

1. PROVIDE WITH 304SS FILTER HOUSING WITH BRASS HEAD, SIGHT GLASS, BALL VALVES, BALANCING VALVE, BRASS DRAIN VALVE, AND BRASS NIPPLES. FILTER MEDIA SHALL BE COTTON WOUND WITH TIN CORE (25 MICRON). 2. REPLACE THE FILTER MEDIA WITH A NEW 25 MICRON CARTRIDGE AFTER SYSTEM START-UP AND BALANCING. PROVIDE ATTIC STOCK OF TWO 25 MICRON AND TWO 5 MICRON FILTERS.

CHILLER TAG			CH-1 AND CH-2
LOCATION			OUTDOORS
	LENGTH	I x WIDTH x HEIGHT (IN)	251 x 89 x 94
DIMENSIONS	HEIGHT	(IN)	94
	OPERAT	ING WEIGHT (LBS)	10691
REFRIGERATION	CAPACITY	Y (EACH CHILLER)(TONS)	116.81
COMPRESSORS	QUANTI	TY	2
(EACH MODULE)	CAPACI	TY CONTROL	VARIABLE
	RLA EAG	CH	98
	TEMP. E	NT F.	54
	TEMP. L	VG F.	44
EVAPORATOR	GPM		320
(TOTAL)	MAX. P.	DFT.	11.6
	FOULING	FACTOR	0.0001
	WORKIN	G FLUID	30% GLYCOL
	AMBIEN <sup>*</sup>	T AIR TEMP. °F	95
CONDENSER		QUANTITY	10
(EACH MODULE)	FANS	FLA EACH	2.5
		FAN TYPE	VARIABLE SPEED
	VOLTS/F	PH/HZ	208/3/60
	MCA (A)	CIRCUIT #1	310.72
ELECTRICAL	MOP (A)	CIRCUIT #1	500
	MCA (A)	CIRCUIT #2	298.56
	MOP (A)	CIRCUIT #2	500
	REFRIGI	ERANT	R-513A
	REFRIGI	ERANT CHARGE CKT #1 (LB)	86.6
REFRIGERANT DATA	REFRIGI	ERANT CHARGE CKT #2 (LB)	84.9
	REFRIGI	ERANT SAFETY CLASS	A1
A-WEIGHTED SOUND F	POWER (D	BA AT 30 FEET FULL LOAD)	100
TOTAL SYSTEM EER, F	FULL LOAD	), AHRI (BTU/W)	9.931
TOTAL OVOTEM SED 1	DLV (DTL)		

AIR COOLED WATER CHILLER SCHEDULE

TOTAL SYSTEM EER, IPLV (BTU/W)

1. PROVIDE OPERATIONS AND MAINTENANCE MANUALS.

2. PROVIDE MANUFACTURER'S STANDARD FREEZE PROTECTION PACKAGE AND SEPARATE 115V POWER SOURCE.

3. PROVIDE CONVENIENCE OUTLET WITH SEPARATE 115V POWER SOURCE.

4. THE POWER CONNECTIONS FOR EACH CIRCUIT SHALL BE PROVIDED IN TWO SEPARATE ENCLOSURES. 5. REFER TO THE CHILLER ACOUSTIC ACCESSORIES SCHEDULE BELOW FOR SOUND ATTENUATION TO BE PROVIDED UNDER THIS CONTRACT.

6. THE CHILLERS HAVE BE PRE-ORDERED (TRANE RTAF130EUAH) BY THE OWNER. INSTALL THE CHILLERS UNDER THIS CONTRACT.

### VAV BOX SCHEDULE CEM MAX NC DESIGN BASIS

TAG	SERVICE	INLET SIZE	CF	M	MAX NC	DESIGN BASIS	REMARKS
.,	02.1102		MAX	MIN	LEVEL	TRANE	1121177111110
V-01	CLASSROOM	12	1520	460	20	VCCF	SEE NOTES
V-02	CLASSROOM	10	1220	365	20	VCCF	SEE NOTES
V-03	CLASSROOM	10	1220	365	20	VCCF	SEE NOTES
V-04	CLASSROOM	10	1220	365	20	VCCF	SEE NOTES
V-05	CLASSROOM	10	1200	360	20	VCCF	SEE NOTES
V-06	CLASSROOM	10	1200	360	20	VCCF	SEE NOTES
V-07	CLASSROOM	10	1200	360	20	VCCF	SEE NOTES
V-08	CLASSROOM	10	1040	315	20	VCCF	SEE NOTES
V-09	CLASSROOM	10	1200	360	20	VCCF	SEE NOTES
V-10	CLASSROOM	10	1340	400	20	VCCF	SEE NOTES
V-11	CLASSROOM	14	2000	600	20	VCCF	SEE NOTES
V-12	CLASSROOM	10	950	285	20	VCCF	SEE NOTES
V-13	CLASSROOM	10	950	285	20	VCCF	SEE NOTES
V-14	CLASSROOM	12	1500	450	20	VCCF	SEE NOTES
V-15	CLASSROOM	10	1140	340	20	VCCF	SEE NOTES
V-16	CLASSROOM	8	400	120	20	VCCF	SEE NOTES
V-21	KITCHEN	14	1990	600	20	VCCF	SEE NOTES
V-21D	FAC ROOM	10	1230	365	20	VCCF	SEE NOTES
NOTES:							

1. PROVIDE CONTROLS CABINET WITH CONTROL TRANSFORMER AND 120V TO CONTROL VOLTAGE. 2. PROVIDE REMOVABLE FLOW SENSOR.

3. PROVIDE HANGER BRACKET SUPPORTS, SIDE ACCESS DOOR, FIBER-FREE LINER.

GREENMAN PEDERSEN, INC 2 EXECUTIVE BOULEVARD SUITE 202 SUFFERN, NY 10901	GREENMAN PEDERSEN, INC 2 EXECUTIVE BOULEVARD SUITE 202 SUITE 202 SUITE 202
Mechanical & Electrical Engineer:	Structural Engineer:

UNIVENT REPLACEMEN

AT

WILLOW GROVE

ELEMENTARY SCHOOL

SED# 50-02-01-06-0-030-016

16.10



																		UN	IIT VEI	NTILATO	R SCI	HEDULE								
		CONFIGUR-	TOTAL SUPPLY	MINIMUM C AIRFL		MAXIMUM OUTSIDE				COOI	LING						Н	IEATING			FILTER	ELECTRIC	UN	11.71	UNIT IMENSIONS	UNIT	BASIS OF		E COILS FOR THE EXISTING UNIT VENTILATOR IN NORTH WING A TING UNIT VENTILATOR TO REMAIN. ALL OTHER UNIT VENTILATOR TO BE REPLACED.	ll ll
UNII TAG	LOCATION	ATION	AIRFLOW (CFM)	COOLING	HEATING	AIRFLOW (CFM)	EADB EAV	VB LADB	LAWB (°F)	EWT	LWT	VATER PI FLOW (GPM) [	VATER RESS- URE DROP T H2O	MIN TOTAL CAPACITY (BTU/H)		ADB (°F)	WT LW	WATEI FLOW (GPM)	I	REQUIRED TOTAL CAPACITY (BTU/H)	MERV	MCA FUSE \	WEK LB PH/HZ	ן ואכ	(LxH, IN) (V.I.F.)	DEPTH (IN)	DESIGN	HANDING OF EX. COIL	HANDING OF NEW COIL EX. UNIT VENTILATOR MODEL NUMB (TRANE)	VENTILATORS IN NORTH WING
UV-101	RM 101	VERTICAL	1250	390	390	1250	80.7 69.	3 55	54	44	54	7.42	7.0	37,100	52.3	90 -	180 16	0 5.08	4.0	50,800	13	8.75 15	5/1/60 45	50	93x30	21.25	TRANE VUVE125		LH COOLING/RH HEATING VUVB12510G0DAD0000011CG100001	
UV-102	RM 102	VERTICAL	1250	390	390	1250	80.7 69.	3 55	54	44	54	7.42	7.0	37,100			180   16	0 5.08	4.0	50,800			5/1/60 45	50	93x30	21.25	TRANE VUVE125		LH COOLING/RH HEATING VUVB12510G0DAD0000011CG100001	
UV-103	RM 103	VERTICAL	1250	405	405	1250	80.8 69.	3 55	54	44	54	7.42	7.0	37,100		90 ′	180   16	0 5.19	4.0	51,900		8.75   15   1	5/1/60 45	50	93x30	21.25	TRANE VUVE125		LH COOLING/RH HEATING VUVB12510G0DAD0000011CG100001	
UV-104	RM 104	HORIZONTA	L 1500	460	460	1500	80.6 69.		54	44		8.92	7.0	44,600		90 ′	180   16	0 6.05	4.0	60,500	13	12 15 1	5/1/60 50	00 /	106.25x39	21.25	TRANE HUVC150	VIF	VIF HUV_150	REPLACE UNIT VENTILATOR
UV-105	RM 105	VERTICAL	1250	405	405	1250	80.8 69.	3 55	54	44	54	7.42	7.0	37,100	51.6	90 -	180   16	0 5.19	4.0	51,900	'		5/1/60 45	50	93x30	21.25	TRANE VUVE125		LH COOLING/RH HEATING VUVB12510G0DAD0000011CG100001	
UV-106	RM 106	VERTICAL	1250	400	400	1250	80.7 69.	3 55	54	44	54	7.42	7.0	37,100	51.8	90 /	180   16	0 5.15	4.0	51,500			5/1/60 45	50	93x30	21.25	TRANE VUVE125		LH COOLING/RH HEATING VUVB12510G0DAD0000011CG100001	
UV-107	RM 107	HORIZONTA	1	450	450	1500	80.6 69.	2 55	54	44	54	8.92	7.0	44,600			180   16	0 5.98	4.0	59,800	13	12 15 7		00 /	106.25x39	21.25	TRANE HUVC150	VIF	VIF HUV_150	REPLACE UNIT VENTILATOR
UV-108	RM 108	VERTICAL	1250	405	405	1250	80.8 69.	3 55	54	44	54	7.42	7.0	37,100		90 /	180   16	0 5.19	4.0	51,900	13	8.75 15 1	5/1/60   45	50	93x30	21.25	TRANE VUVE125		LH COOLING/RH HEATING VUVB12510G0DAD0000011CG100001	
UV-109	RM 109	VERTICAL	1250	405	405	1500	80.8 69.	3 55	54	44	54	7.42	7.0	37,100		90 -	180   16	0 5.19	4.0	51,900		8.75 15 1	5/1/60 45	50	93x30	21.25	TRANE VUVE125		LH COOLING/RH HEATING VUVB12510G0DAD0000011CG100001	
UV-110	RM 110	HORIZONTA		415	415	1250	80.4 69.	1 55	54	44		8.92	7.0	44,600	54.6	-	180   16	0 5.74	4.0	57,400	13	12 15 1	5/1/60 50	00 /	106.25x39	21.25	TRANE HUVC150	VIF	VIF HUV_150	REPLACE UNIT VENTILATOR
UV-111	RM 111	VERTICAL	1250	405	405	1250	80.8 69.	3 55	54	44	54	7.42	7.0	37,100	51.6	90 ′	180   16	0 5.19	4.0	51,900	13	8.75   15   1	5/1/60 45	50	93x30	21.25	TRANE VUVE125		LH COOLING/RH HEATING VUVB12510G0DAD0000011CG100001	
UV-112	RM 112	VERTICAL	1250	390	390	1250	80.7 69.	3 55	54	44	54	7.42	7.0	37,100		90	180   16	0 5.08	4.0	50,800	<del>-                                    </del>	8.75   15   1	15/1/60 45	50	93x30	21.25	TRANE VUVE125		LH COOLING/RH HEATING VUVB12510G0DAD0000011CG100001	
UV-113	RM 113	VERTICAL	1250	390	390	1250	80.7 69.	3 55	54	44	54	7.42	7.0	37,100	52.3	90 -	180   16	0 5.08	4.0	50,800	13		5/1/60 45	50	93x30	21.25	TRANE VUVE125		LH COOLING/RH HEATING VUVB12510G0DAD0000011CG100001	
UV-114A	RM 114	VERTICAL	1250	365	365	1250	80.5 69.	2 55	54	44	54	7.42	7.0	37,100	53.6	90 ′	180   16	0 4.91	4.0	49,100	13	8.75   15   1	5/1/60 45	50	93x30	21.25	TRANE VUVE125		LH COOLING/RH HEATING VUVB12510G0DAD0000011CG100001	510 REPLACE UNIT VENTILATOR
UV-114B	RM 115	VERTICAL	1250	365	365	1250	80.5 69.	2 55	54	44	54	7.42	7.0	37,100	53.6	90 -	180   16	0 4.91	4.0	49,100	13	8.75 15 1	15/1/60 45	50	93x30	21.25	TRANE VUVE125	RH COOLING/LH HEATING		
UV-117A	RM 117	HORIZONTA		280	280	1250	79.9 68.	9 55	54	44	54	7.42	7.0	37,100	57.9	90 -	180   16	0 4.34	4.0	43,400	13	12 15 1	15/1/60 43	35	94.25x38	21.25	TRANE HUVC125	VIF	VIF HUV_150	REPLACE UNIT VENTILATOR
UV-117B	RM 117	HORIZONTA	L 1250	280	280	1250	79.9 68.	9 55	54	44	54	7.42	7.0	37,100	57.9	90 -	180   16	0 4.34	4.0	43,400	13	12 15 1	5/1/60 43	35	94.25x38	21.25	TRANE HUVC125	VIF	VIF HUV_150	REPLACE UNIT VENTILATOR
UV-118	RM 118	HORIZONTA	L 750	90	90	750	79.0 68.	5 55	54	44	54	4.46	7.0	22,300	64.4	90 -	180 16	0 2.07	4.0	20,700	13	12 15 1	5/1/60 34	10	70.25x36	21.25	TRANE HUVC075	VIF	VIF HUV_150	REPLACE UNIT VENTILATOR
UV-119	RM 119	HORIZONTA	L 750	195	195	750	80.2 69.	1 55	54	44	54	4.46	7.0	22,300	55.6	90 -	180   16	0 2.78	4.0	27,800	13	12   15   1	15/1/60 34	10	70.25x36	21.25	TRANE HUVC075	VIF	VIF HUV_150	REPLACE UNIT VENTILATOR
UV-LL19	RM LL19	VERTICAL	1500	450	450	1250	80.6 69.	2 55	54	44	54	8.92	7.0	44,600	53.1	90 -	180   16	0 5.98	4.0	59,800	13	8.75   15   1	5/1/60 47	70	105x30	21.25	TRANE VUVE150		REPLACE UNIT VENTILATOR	NOT APPLICABLE
UV-LL21A	RM LL21	VERTICAL	1500	325	325	1500	79.8 68.	9 55	54	44	54	8.92	7.0	44,600	58.4	90 -	180   16	0 5.13	4.0	51,300	13	8.75   15   1	5/1/60 47	70	105x30	21.25	TRANE VUVE150		REPLACE UNIT VENTILATOR	NOT APPLICABLE
UV-LL21B	RM LL21	VERTICAL	1500	325	325	1500	79.8 68.	9 55	54	44	54	8.92	7.0	44,600	58.4	90	180   16	0 5.13	5.0	51,300	14	8.75   15   1	5/1/60 47	70	105x30	21.25	TRANE VUVE150		REPLACE UNIT VENTILATOR	NOT APPLICABLE
UV-200	RM 200	VERTICAL	750	75	75	750	78.9 68.	4 55	54	44	54	4.46	7.0	22,300	65.7	90	180   16	0 1.97	6.0	19,700	15	4.38 15 7	5/1/60 32	20	69x30	21.25	TRANE VUVE075	RH COOLING/LH HEATING	LH COOLING/RH HEATING VUVB12510G0DAD0000011CG100001	510 REPLACE UNIT VENTILATOR
UV-201	RM 201	VERTICAL	1250	390	390	1250	80.7 69.	3 55	54	44	54	7.42	7.0	37,100	52.3	90 -	180   16	0 5.08	4.0	50,800	13	8.75   15   1	5/1/60 45	50	93x30	21.25	TRANE VUVE125	RH COOLING/LH HEATING	LH COOLING/RH HEATING VUVB12510G0DAD0000011CG100001	510 REPLACE UNIT VENTILATOR
UV-202	RM 202	VERTICAL	1250	390	390	1250	80.7 69.	3 55	54	44	54	7.42	7.0	37,100	52.3	90 -	180 16	0 5.08	4.0	50,800	13	8.75 15 1	5/1/60 45	50	93x30	21.25	TRANE VUVE125	RH COOLING/LH HEATING	LH COOLING/RH HEATING VUVB12510G0DAD0000011CG100001	510 REPLACE UNIT VENTILATOR
UV-203	RM 203	VERTICAL	1250	405	405	1250	80.8 69.	3 55	54	44	54	7.42	7.0	37,100	51.6	90	180 16	0 5.19	4.0	51,900	13	8.75 15 1	5/1/60 45	50	93x30	21.25	TRANE VUVE125	RH COOLING/LH HEATING	LH COOLING/RH HEATING VUVB12510G0DAD0000011CG100001	510 REPLACE UNIT VENTILATOR
UV-204	RM 204	HORIZONTA	L 1500	460	460	1500	80.6 69.	3 55	54	44	54	8.92	7.0	44,600	52.7	90	180 16	0 6.05	4.0	60,500	13	12 15	5/1/60 50	00 -	106.25x39	21.25	TRANE HUVC150	VIF	VIF HUV_150	REPLACE UNIT VENTILATOR
UV-205	RM 205	VERTICAL	1250	405	405	1250	80.8 69.	3 55	54	44	54	7.42	7.0	37,100	51.6	90	180 16	0 5.19	4.0	51,900	13	8.75 15 1	5/1/60 45	50	93x30	21.25	TRANE VUVE125	RH COOLING/LH HEATING	LH COOLING/RH HEATING VUVB12510G0DAD0000011CG100001	510 REPLACE UNIT VENTILATOR
UV-206	RM 206	VERTICAL	1250	400	400	1250	80.7 69.	3 55	54	44	54	7.42	7.0	37,100	51.8	90	180 16	0 5.15	4.0	51,500	13	8.75 15	5/1/60 45	50	93x30	21.25	TRANE VUVE125	RH COOLING/LH HEATING	LH COOLING/RH HEATING VUVB12510G0DAD0000011CG100001	510 REPLACE UNIT VENTILATOR
UV-207	RM 207	HORIZONTA	L 1500	450	450	1500	80.6 69.	2 55	54	44	54	8.92	7.0	44,600	53.1	90 -	180 16	0 5.98	4.0	59,800	13	12 15	5/1/60 50	00 -	106.25x39	21.25	TRANE HUVC150	VIF	VIF HUV 150	REPLACE UNIT VENTILATOR
UV-208	RM 208	VERTICAL	1250	405	405	1250	80.8 69.	3 55	54	44	54	7.42	7.0	37,100	51.6	90	180 16	0 5.19	4.0	51,900	13	8.75 15	5/1/60 45	50	93x30	21.25	TRANE VUVE125	RH COOLING/LH HEATING	LH COOLING/RH HEATING VUVB12510G0DAD0000011CG100001	510 REPLACE UNIT VENTILATOR
UV-209	RM 209	VERTICAL	1250	405	405	1250	80.8 69.	3 55	54	44	54	7.42	7.0	37,100	51.6		180 16	0 5.19	4.0	51,900			5/1/60 45	50	93x30	21.25			LH COOLING/RH HEATING VUVB12510G0DAD0000011CG100001	
UV-210	RM 210	HORIZONTA		450	450	1500	80.6 69.	2 55	54	44	54	8.92	7.0	44,600	53.1	90	180 16	0 5.98	4.0	59.800	13	12 15	5/1/60 50		106.25x39	21.25	TRANE HUVC150	VIF	VIF HUV 150	REPLACE UNIT VENTILATOR
UV-211	RM 211	VERTICAL	1250	405	405	1250	80.8 69.	3 55	54	44	54		7.0	37,100	51.6	90	180 16	0 5.19	4.0	51,900	13	8.75 15	5/1/60 45		93x30	21.25		RH COOLING/LH HEATING	LH COOLING/RH HEATING VUVB12510G0DAD0000011CG100001	
UV-212	RM 212	VERTICAL	1250	390	390	1250	80.7 69	3 55	54	44	54	7.42	7.0	37,100			180 16	0 5.08	4.0	50,800	<b>-</b>		5/1/60 45		93x30	21.25			LH COOLING/RH HEATING VUVB12510G0DAD0000011CG100001	
UV-213	RM 213	VERTICAL	1250	390	390	1250	80.7 69	3 55	54	44	54	7.42	7.0	37,100		90	180 16	0 5.08	4.0	50,800	<b>+</b>	8.75 15	5/1/60 45	50	93x30	21.25			LH COOLING/RH HEATING VUVB12510G0DAD0000011CG100001	
UV-213A	RM 213A	VERTICAL	750	105	105	750	79.2 68.	6 55	54	44		4.46	7.0	22,300			180 16	0 2.17	4.0	21,700			5/1/60 32	20	69x30	21 25			LH COOLING/RH HEATING VUVB12510G0DAD0000011CG100001	
UV-214A	RM 214	VERTICAL	1250	325	325	1250	80.2 69.	1 55	54	44	54	7.42	7.0	37,100		90	180 16	0 4 64	4 0	46.400	<del>                                     </del>		5/1/60 45	50	93x30	21 25			LH COOLING/RH HEATING VUVB12510G0DAD0000011CG100001	
UV-214B	RM 214	VERTICAL	1250	280	280	1250	79.9 68.	9 55	54	44	54	7.42	7.0	37,100		-	180 16	0 4.04	4.0	43.400			15/1/60 45	50	93x30	21.25			LH COOLING/RH HEATING VUVB12510G0DAD0000011CG100001	
UV-217A	RM 217	VERTICAL	1250	240	240	1250	79.6 68.		54	44		7.42	7.0	37,100	07.0	-	180 16	0 4.06	4.0	40,600	<del>                                     </del>		15/1/60 45	50	93x30	21.25			LH COOLING/RH HEATING VUVB12510G0DAD0000011CG100001	
UV-217B	RM 217	VERTICAL	1250	240	240	1250	79.6 68	8 55	54	44	54	7.42	7.0	37,100		-	180 16	0 4.06	4.0	40,600		8.75 15	15/1/60 45	50	93x30	21.25			LH COOLING/RH HEATING VUVB12510G0DAD0000011CG100001	
UV-217B	RM 218	VERTICAL	750	90	90	750	79.0 68.	5 55	54	44	:-	4.46	7.0	22,300			180 16	0 4.00	4.0	20,700			15/1/60 32	20	69x30	21.25			LH COOLING/RH HEATING VUVB12510G0DAD0000011CG100001	
UV-219	RM-219	VERTICAL	750	150	150	750	79.0 68.		54	44		4.46	7.0	22,300			180 16	0 2.48	4.0	24,800			15/1/60 32 15/1/60 32		69x30	21.20			LH COOLING/RH HEATING VUVB12510G0DAD0000011CG100001	
UV-17A	RIVF2 19 RM 17	VERTICAL	1250	270	270	1250	79.7 68.		54	44	54	7.42	7.0	37,100		90	180 16	0 2.46	4.0	42,700	_	8.75 15	15/1/60 32 15/1/60 45	50	93x30	21.25	TRANE VUVE125	TATIOOOLING/LITEATING	REPLACE UNIT VENTILATOR	NOT APPLICABLE
	RM 17	<b>+</b>	_	+		-	<u> </u>			44				· · · · · · · · · · · · · · · · · · ·			100 10		4.0	,	· · · ·	<u> </u>		10					REPLACE UNIT VENTILATOR  REPLACE UNIT VENTILATOR	
UV-17B		VERTICAL	1250	270	270	1250	79.8 68.	7 55	54	1 1		7.42	7.0	37,100			180 16	0 4.27	4.0	42,700			15/1/60 45	) <u> </u>	93x30		TRANE VUVE125			NOT APPLICABLE
UV-18A	RM 18	VERTICAL	1000	180	180	1000	70.5	7 55	54	44		5.94	7.0	29,700			180   16	0 3.17	4.0	31,700	H		15/1/60 40	)5 	81x30	21.25	TRANE VUVE100		REPLACE UNIT VENTILATOR	NOT APPLICABLE
UV-18B	RM 18	VERTICAL	1000	180	180	1000	70.7 08.	0 55	54	44	54	5.94	7.0	29,700			180   16	0 3.17	4.0	31,700		4.38 15 1	15/1/60 40	20	81x30	21.25	TRANE VUVE100		REPLACE UNIT VENTILATOR	NOT APPLICABLE
UV-23	RM 23	VERTICAL	1500	300	300	1250	79.7 68.	_	54	44		8.92	7.0	44,600			180 16		4.0	49,600	<b>-</b>		5/1/60 47  5/1/60 47	70	105x30	21.25	TRANE VUVE150		REPLACE UNIT VENTILATOR	NOT APPLICABLE
UV-24	RM 24	VERTICAL	1500	165	165	1250	78.9 68.	5 55	54	44	54	8.92	7.0	44,600	65.1	90 -	180   16	0 4.04	4.0	40,400	13	8.75   15   1	13/1/00 4/	υ <u> </u>	105x30	21.25	TRANE VUVE150		REPLACE UNIT VENTILATOR	NOT APPLICABLE

1. PROVIDE 4-PIPE COIL. VERFIY COIL HANDING IN FIELD FOR EACH UNIT PRIOR TO FABRICATION. INCLUDE COIL HANDING IN THE UNIT VENTILATOR SUBMITTAL.

2. PROVIDE ECM FAN MOTOR AND SZVAV CONTROL.

3. PROVIDE A 3-WAY MODULATING CONTROL VALVE FOR HOT WATER AND A 2-WAY MODULATING CONTROL VALVE FOR CHILLED WATER FOR ALL UNIT VENTILATORS, EXISTING AND NEW. 4. PROVIDE LOW-LEAKGE OUTSIDE AIR DAMPER.

5. PROVIDE ECONOMIZER WITH FAULT DETECTION DIAGNOSIS.

6. UNIT VENTILATORS SHALL BE SELECTED TO MATCH THE FOOTPRINT OF THE EXISTING UNIT VENTILATOR WHEREVER POSSIBLE. VERFIY IN FIELD THE PHYSICAL DIMENSIONS OF ALL EXISTING UNIT VENTILATORS AND SUBMIT FOR APPROVAL PRIOR TO FABRICATION.
7. INCLUDE THE REPLACEMENT OF THE COILS IN THE EXISTING UNIT VENTILATORS AS SCHEDULED ABOVE IN THE BASE BID. PROVIDE AN ALTERNATE PRICE FOR THE REPLACEMENT OF THE UNIT VENTILATOR AS INDICATED IN THE SCHEDULE.

8. PROVIDE WITH SIEMENS CONTROLS.

9. PROVIDE WITH AN INTERNAL DISCONNECT SWITCH.

																Alf	R HAI	NDLII	NG UN	IT SCHE	EDULE														
U	NIT# LOC	ATION / AREA SERVED	SUPPLY AIRFLOW	OUTSIDE AIRFLOW	OA DCV MIN	EXTERNAL STATIC	MOTOR	SUPPLY FAN	DRIVE	HOUSING	FACE	PRESSURE DROP	HOT V	VATER PREHE	WATER	FWT	LWT	AT LA	AT FACE	PRESSURE	MINIMUM	WATER	WATER PRESS FWT	- LWT EA	Γ EAT LAT	LAT		FILTER PRESSURE DROP,	PRESSURE DROP,	PRESSURE DROP.	ELE	CTRICAL	UNIT WEIGHT	BASIS OF DESIGN	
		AFETERIA	(CFM) 11,000	(CFM) 2,990	(CFM)	PRESSURE (IN WC)	HP (2X10)	CONTROL	TYPE	TYPE	VELOCITY (FPM) 500	DROP (IN WC)	(BTU/H)	FLOW RATE (GPM)	DROP (FT)	(°F)	(°F)	DB DE	B VELOCIT F) (FPM)	Y DROP (IN WC)	CAPACITY (BTU/H) 363,000	RATE (GPM)	DROP (°F)	(°F) DE	WB DB (°F) (°F)	WB MERV	TYPE	CLEAN (IN WC)	MID-LIFE (IN WC)	DIRTY (IN WC)	MCA FUS	E   VOLT/PH/HZ E   208/3/60	(LBS)	TRANE CSAA SIZE 25	ALT.

AIR HANDLING UNIT SCHEDULE NOTES:

1. PROVIDE A VARIABLE FREQUENCY DRIVE FOR SUPPLY FAN CONTROL, DISCONNECT SWITCH, AND CONTROLS.


2. PROVIDE BASE RAIL AND MOUNTING HARDWARE AS REQUIRED FOR MOUNTING ON VIBRATION ISOLATORS.
3. EACH SECTION SHALL BE PROVIDED WITH AN ACCESS DOOR. VERIFY ACCESS DOOR LOCATIONS AND CONFIGURATIONS IN FIELD AND SUBMIT FOR APPROVAL PRIOR TO FABRICATION AND INSTALLATION.
4. AHUS SHALL BE CUSTOM FABRICATED AND SHIPPED KNOCKED DOWN TO FIT THROUGH EXISTING BUILDING OPENINGS (36" WIDE x 80" HIGH EXISTING DOORWAYS TO BE VIF).


5. PROVIDE WITH THE FOLLOWING SECTIONS AT A MINIMUM: MIXING SECTION, FILTER SECTION, PREHEAT COIL, ACCESS SECTION, COOLING COIL, ACCESS SECTION, FAN SECTION.

6. PROVIDE SCHEDULED OCCUPANCY DEMAND CONTROLLED VENTILATION.
7. REPLACE AHU-20 PER THE SCHEDULE UNDER ALTERNATE NO. 201. RETROFIT CONTROLS AND PIPING TO THE COILS UNDER THE BASE BID.

		11-09-23 ADDENDUM #1	09-14-23 BIDDING DOCUMENTS	06-09-23 SED ADDENDUM #1	12-28-22 BIDDING DOCUMENTS	Revisions
		11-09-23	09-14-23	06-09-23	12-28-22	Date
		4	3	2	1	No.
						30-24

)	0	Δ.	- 0	א ב		
GREENMAN DEDEDSEN INC	2 EXECUTIVE BOULEVARD SUITE 202 SUITE ROLE S		CREENWAN	PEDERSEN, INC	2 EXECUTIVE BOULEVARD SUITE 202	SUFFERN, NY 10901
Mechanical	& Electrical Engineer:			Structural	Engineer:	

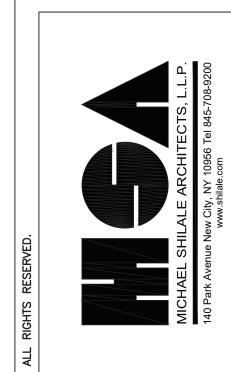

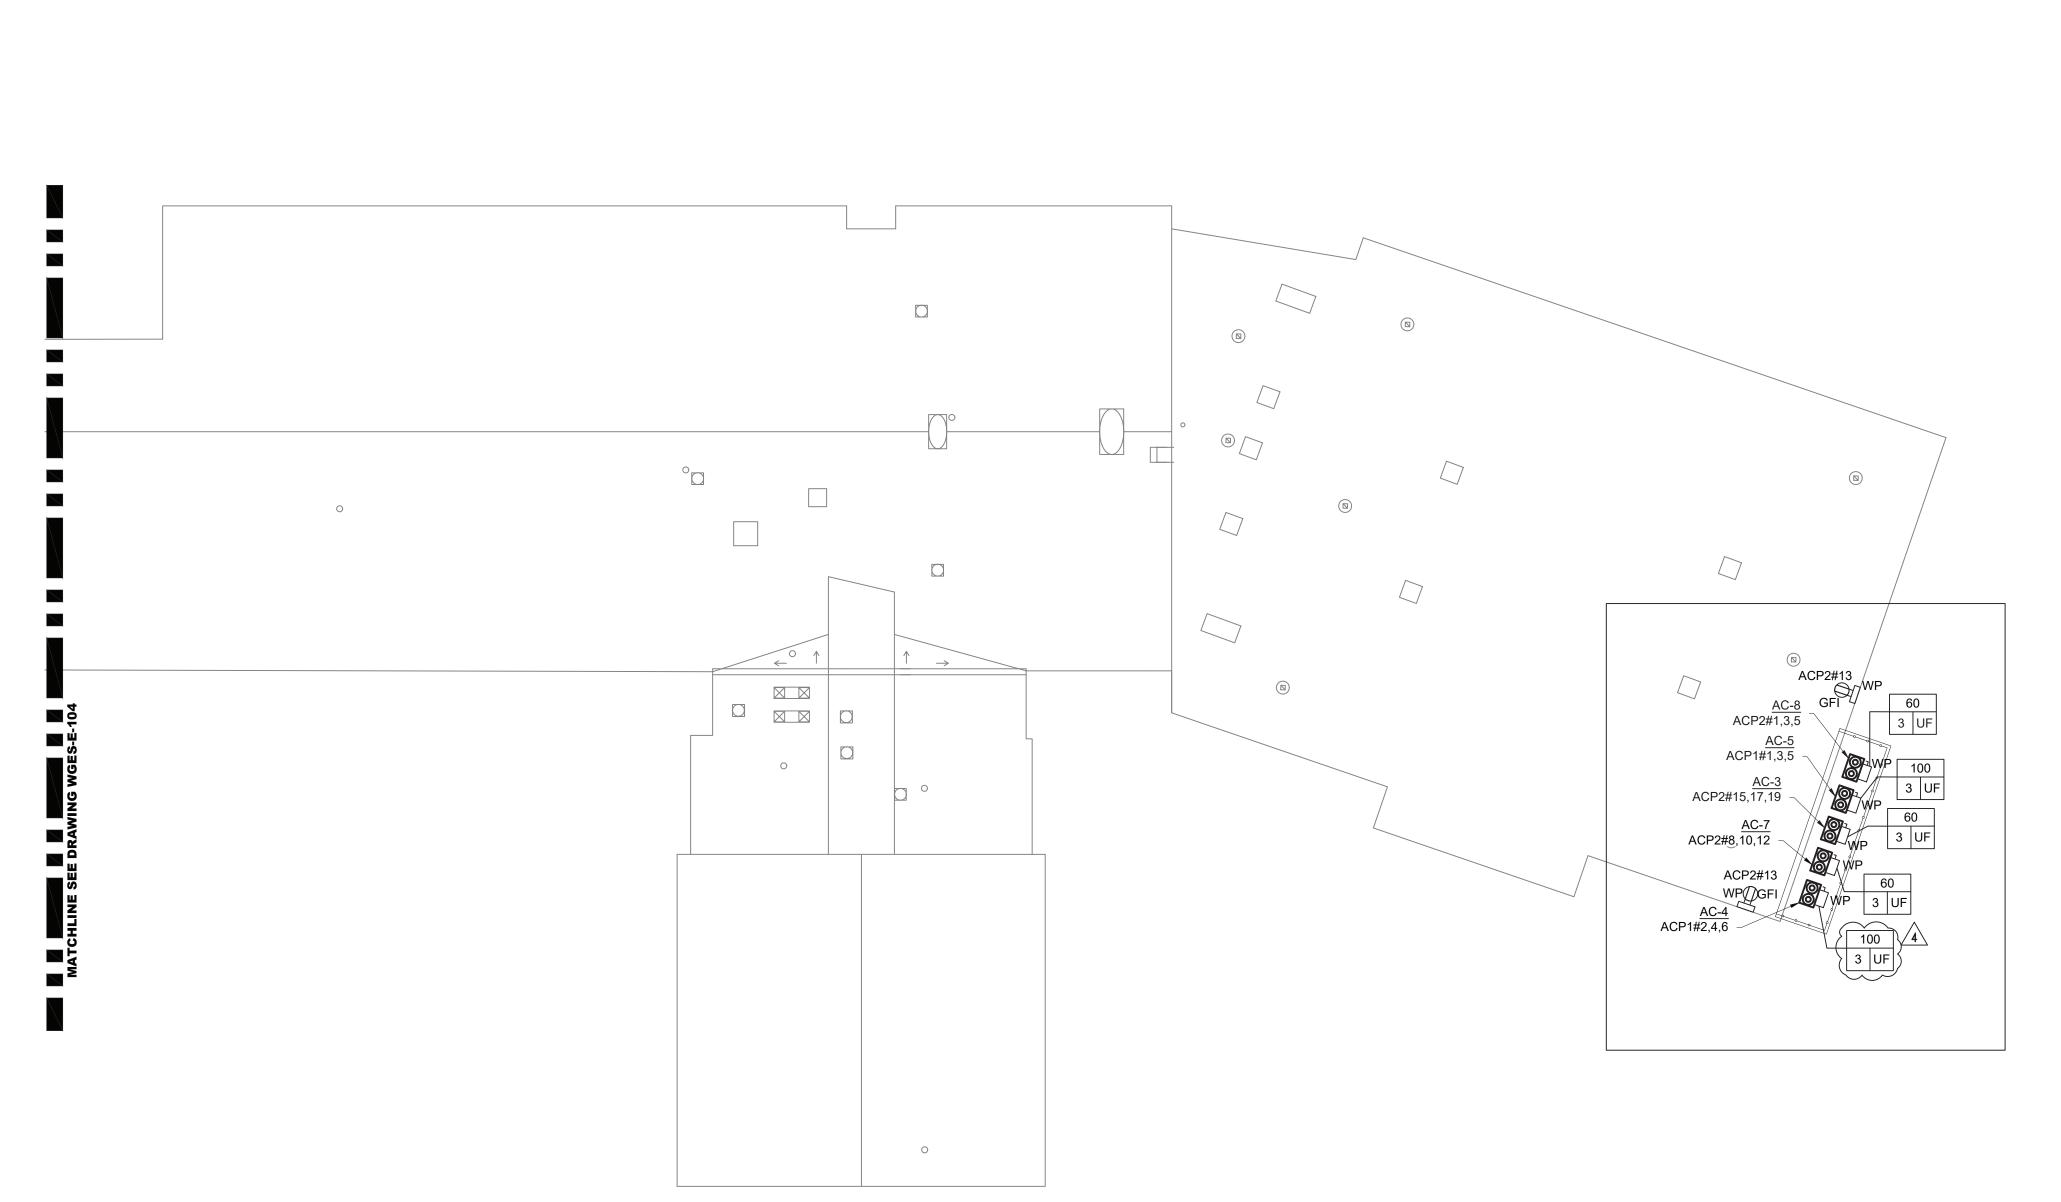


**ELECTRICAL ROOF PLAN - 2** 

SCALE: 1/16" = 1' - 0"

### PLAN NOTES:

- 1. REFER TO ADDITIONAL INSTALLATION NOTES ON DRAWING E-001.
- 2. ALL NEW BRANCH CIRCUIT SHALL BE RUN WITH MINIMUM OF 2#12+1#12G IN 3/4" CONDUIT, UNLESS OTHERWISE NOTED. FOR LIGHTING AND POWER BRANCH CIRCUIT, MC CABLE SHALL BE INSTALLED FOR RECESSED INSTALLATION ONLY, EITHER IN NEW WALLS OR ABOVE HUNG CEILING WHERE POSSIBLE. REFER TO PANEL SCHEDULES IN DRAWING E-201 FOR ALL OTHER FEEDER AND BRANCH CIRCUIT SIZE
- 3. PROVIDE LABELS ON ALL ELECTRICAL EQUIPMENT INDICATING CIRCUIT ORIGINATION.
- 4. INVESTIGATE ALL EXISTING BRANCH CIRCUITS AND UPDATE ALL EXISTING PANEL DIRECTORIES AFFECTED BY NEW WORK.
- 5. CONTRACTOR SHALL PERFORM AMP PROBE READINGS ON EXISTING SERVICE EQUIPMENT BEFORE AND AFTER WORK TO ENSURE EQUIPMENT WILL NOT BE LOADED BEYOND ITS MAX AMPACITY.
- 6. CONTRACTOR SHALL MAINTAIN CONTINUITY TO ALL EXISTING CIRCUITRY TO REMAIN WHICH ARE AFFECTED BY THE SCOPE OF WORK; CONTRACTOR SHALL FURNISH ALL NECESSARY JUNCTION BOXES, CONDUIT, AND WIRES AS REQUIRED TO KEEP CONTINUITY.
- 7. REFER TO MECHANICAL PLANS FOR EQUIPMENT TO BE SUPPLIED BY OTHER TRADES AND INSTALLED/WIRED UNDER THIS SECTION. COORDINATE LOCATION OF DEVICES WITH OTHER CONTRACTORS.
- 8. PROVIDE FIRESTOPPING FOR ALL PENETRATIONS TO MATCH EXISTING FIRE RATING WHERE APPLICABLE. ALL CORE DRILLS SHALL BE VERIFIED BY BUILDING REPRESENTATIVE PRIOR TO COMMENCING WORK. XRAY ALL FLOOR SLABS PRIOR TO ROUGH-INS FOR CORE DRILL WORK.
- 9. THE CONTRACTOR SHALL FIELD ROUTE FEEDER FOR NEW POWER PANELS. COORDINATE EXACT ROUTING PATH WITH OWNER. SUBMIT A PROPOSED ROUTING PATH TO ENGINEER OF RECORD FOR APPROVAL PRIOR TO RUNNING ANY CONDUIT OR WIRE ASSOCIATED WITH THIS FEEDER.
- 10. DISCONNECT SWITCH FOR UNIT VENTILATORS IS PROVIDED BY HVAC CONTRACTOR. COORDINATE WITH
- 11. ALL GROUNDING SHALL BE PROVIDED BY THE CONTRACTOR AS PER NEC 2017.


4	11-09-23	11-09-23 ADDENDUM #1
3	09-14-23	09-14-23 BIDDING DOCUMENTS
2	06-09-23	06-09-23 SED ADDENDUM #1
_	12-28-22	12-28-22 BIDDING DOCUMENTS
No.	Date	Revisions

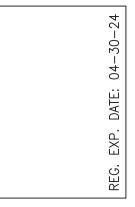



by	SH	Ġ	42054			14-23
Shecked I		Project No.		Scale	Jate	-60

١		
	GREENMAN PEDERSEN, INC 2 EXECUTIVE BOULEVARD SUITE 202 SUITE 202 SUITE 202	GREENMAN PEDERSEN, INC 2 EXECUTIVE BOULEVARD SUITE 202 SUFFERN, NY 10901
	Mechanical & Electrical Engineer:	Structural Engineer:



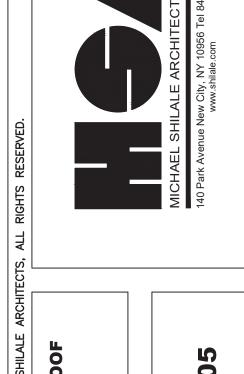

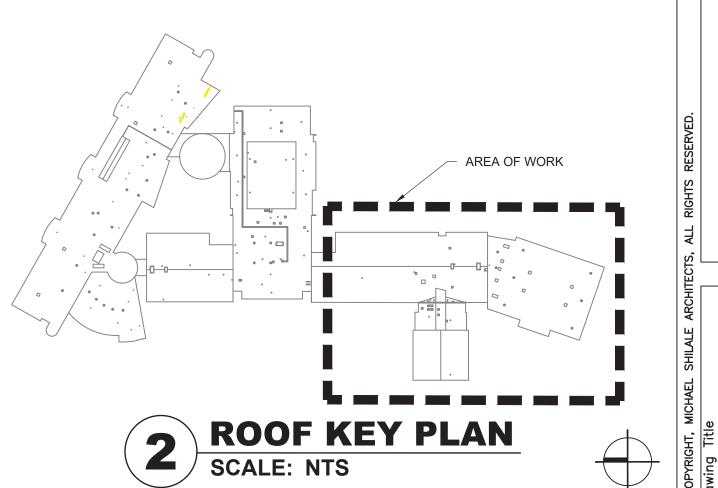

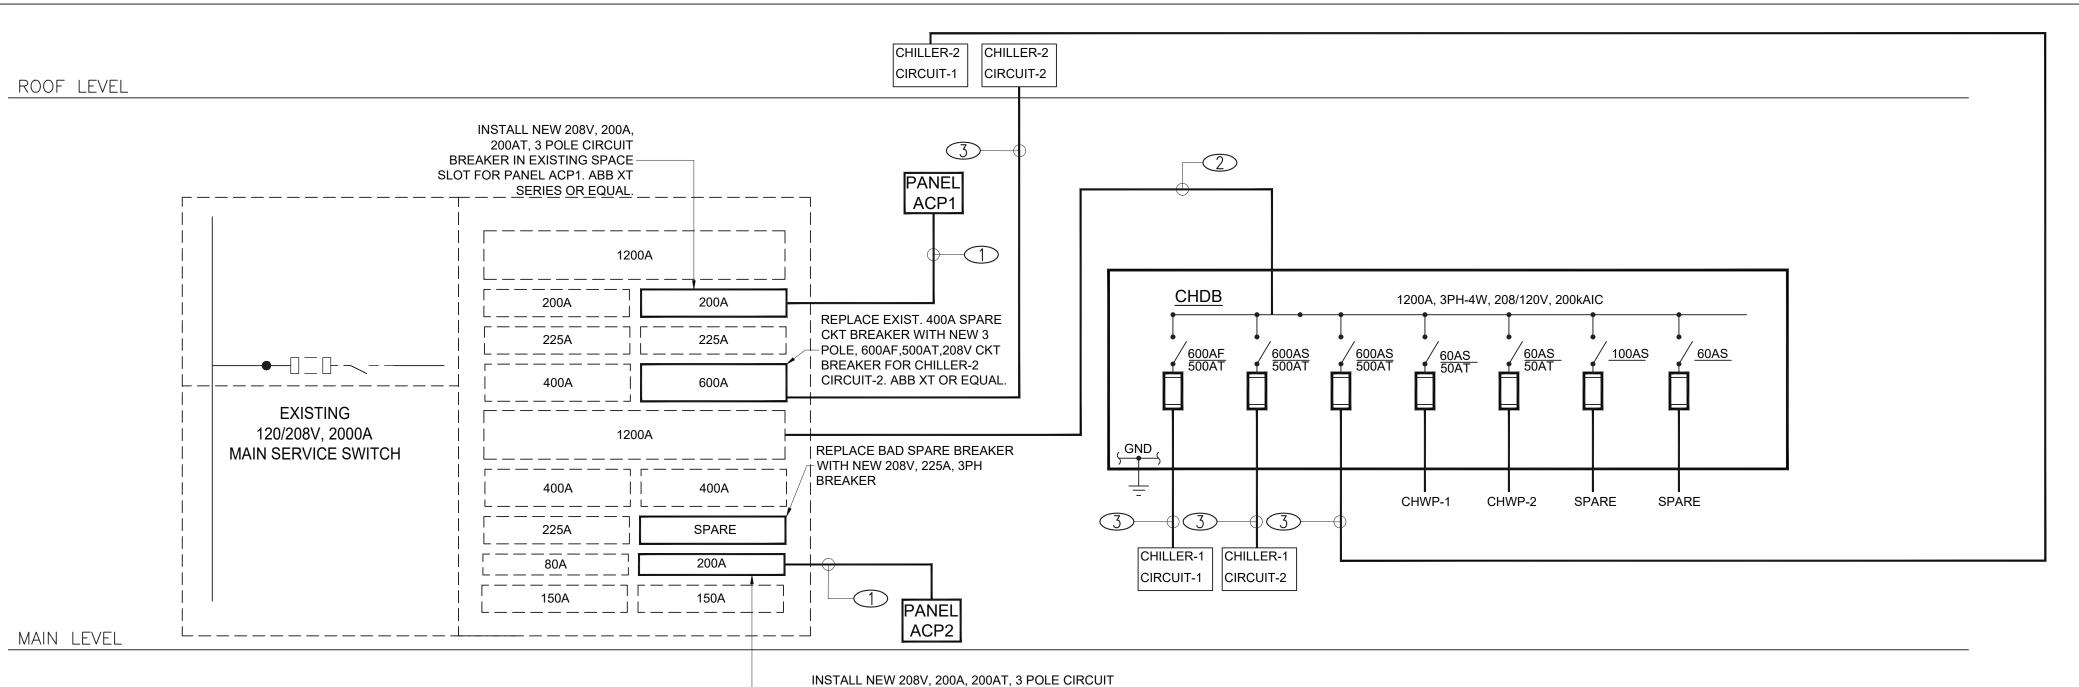

NOTES:

- 1. ALL EXTERIOR WIRING SHALL BE INSTALLED WITHIN RIGID GALVANIZED STEEL CONDUIT.
- 2. ALL NEW EQUIPMENT LOCATED OUTDOORS SHALL BE IN NEMA 3R ENCLOSURES.
- 3. PROVIDE AND INSTALL ALL PULL/JUNCTION BOXES FOR A CODE COMPLIANT INSTALLATION IN A NEAT AND WORKMANLIKE MANNER. ALL BOXES SHALL BE PROPERLY SIZED AS REQUIRED BY NEC.
- 4. PROVIDE TEMPORARY POWER AS REQUIRED TO MINIMIZE DISRUPTION AND ANY DOWNTIME FOR THE FACILITY OPERATION.
- 5. RUN ALL WIRING IN CONDUITS TERMINATED WITH BUSHINGS.

### WIRE SIZE LEGEND:

1 4#300MCM, 1#2G IN 3" C

2 3 SETS OF 4#600MCM, 1#2/0G IN EXISTING (3) 4" C

3 2 SETS OF 3#350MCM, 1#1/0G IN (2) 3" C

### LEGEND:

---- EXISTING TO REMAIN

**ELECTRICAL POWER RISER DIAGRAM** SCALE: N.T.S.

BREAKER IN EXISTING SPACE SLOT FOR PANEL ACP2.

				PAN	NEL SCHEE	DULE				
PANEL NAME:	ACP1	LOCATION:		STORAGE				MOUNTING:	SURFACE	
VOLTAGE/PHASE:	120/208V, 3 Phase, 4W & G	PANEL (AMP)		200A				FREQUENCY:	60 Hz	
PANEL SHORT CIRCUIT RATING(KA):	22 KA	FEI	FEEDER SIZE		4#300MCM + 1#2G IN 3"C			1 3"C	FEEDING SOURCE:	EXISTING SWITCHBOARD - NEW 200A CIRCUIT BREAKER
MAIN BREAKER TYPE	MLO	MAIN BREAKER RATING (A):		MLO		BRANCH C.B TYPE	MCB			
Load Designation	Wiring & Conduit			Pha	se Load ir	ı VA	VA		Wiring & Conduit	Load Pasignation
Load Designation	Wiring & Conduit	C/B (A)	CT NO	AØ	BØ	CØ	CT NO	C/B (A)	Wiring & Conduit	Load Designation
	7.110 . 4.1100 . 4		1	9480 9480			2		7.110 - 1.1100 - 1	
AC-5	3#2+1#8G-1 1/2"RGC	100	3		9480 9480		4	100	3#2+1#8G-1 1/2"RGC	AC-4
			5			9480 9480	6			
	SPARE		9	3864			8	,	3#3+1#8G-1 1/4"EMT	CHWP-4
SPARE		80	11		3864		10	60		
			13			3864	12			00.05
00405			15				14	20		SPARE
SPARE		60	17				16	20		SPARE
CDADE		0.0	19				18	20		SPARE
SPARE		20	21			-	20	20		SPARE
SPARE SPARE		20	23				22	20		SPARE SPARE
SPACE		20	25				24	20		SPACE
SPACE			27				26			SPACE
SPACE			29				28			SPACE
		20 2 20			100 mg		30		N=11.0 4	
	ECTED LOAD PER PHA OTAL CONNECTED LOA		1 11 12	22824	22824 68.472	22824		IEL TYPE: PPER BUS,	NEMA 1 I EQUIP. GROUND BAR	MOUNTING: SURFACE

190.06

DOOR: INDOOR TYPE

PANEL NAME:	ACP2	LOCATION:		STORAGE				MOUNTING:	SURFACE	
VOLTAGE/PHASE:	120/208V, 3 Phase, 4W & G	PANEL (AMP)		200A				FREQUENCY:	60 Hz	
PANEL SHORT CIRCUIT RATING(KA):	22 KA		FEEDER SIZE		4#300MCM + 1 # 2G IN 3"C			FEEDING SOURCE:	EXISITNG MAIN SWITCHBOARD NEW 200A CIRCUIT BREAKER	
MAIN BREAKER TYPE	MLO	MAIN BR RATIN		MLO		BRANCH C.B TYPE	MCB			
Load Designation	Wiring & Conduit			se Load in	ı VA			Wiring & Conduit	Load Designation	
Edua Besignation	Willing a Contain	C/B (A) CT		BØ	СØ	CT NO	C/B (A)	Willing & Conduit	Loud Designation	
		1	3720 3780		-	2		7.11.2 1.1 11.9.0 1		
AC-8	3#6+1#8G-1"RGC	45 3	-	3720 3780	7700	4	45	3#2+1#8G-1 1/4"EMT	AHU-20	
		5	3864	1	3720 3780	6				
CHWP-3	3#3+1#8G-1 1/4" EMT	60 9	3720	3864	1	8		3#6+1#8G-1"RGC	AC-7	
		60 11	†	3720	3864	10	45			
MAINT. REC	2#12+1#12G-3/4"C	20 13	540	]	3720	12				
MAINT. REC	2#1211#120 3/4 0	15		3720	1	14	60		SPARE	
AC-3	3#6+1#8G-1"RGC	45 17			3720	16			31 AIL	
ne e		19	3720	]		18				
SPARE		20 21	_		]	20	45		SPARE	
SPARE		20 23	_			24				
SPACE		25				26			SPACE	
SPACE		27				28			SPACE	
SPACE		29				30			SPACE	
CONI	NECTED LOAD PER PHA	SE IN VA	19344	18804	18804	PAN	IEL TYPE:	NEMA 1	IOUNTING: SURFACE	

158.09

DOOR: INDOOR TYPE

PANEL SCHEDULE


DIST. BOARD:	<u>CHDB</u>	VOLT:	120/208v,	30, 4W.		LOC. <u>EX. MECH RM.</u>
MOUNTING:	<u>FLOOR</u>	AMP	RATING:	<u>1200</u>		MAIN: M.L.O
DESIGN AMP:	969	AIC	RATING:	<u>65kA</u>		TYPE: <u>NEW</u>
CIRCUIT No.	LOAD SVD	POLES	FRAME (A)	TRIP (A)	LOAD (A)	FEEDERS
1	CHILLER-1 CIRCUIT 1	3	600	500	310	2 SETS OF (3#350MCM+1#1/0G) IN 2-3"C
2	CHILLER-1 CIRCUIT 2	3	600	500	298	2 SETS OF (3#350MCM+1#1/0G) IN 2-3"C
3	CHILLER-2 CIRCUIT-1	3	600	500	310	2 SETS OF (3#350MCM+1#1/0G) IN 2-3"C
4	CHWP-1	3	60	50	25	3#2+1#8G IN 1 1/4"C
5	CHWP-2	3	60	50	25	3#2+1#8G IN 1 1/4"C
6	SPARE	3	100			
7	SPARE	3	60			

TOTAL CONNECTED LOAD IN AMPS

LOWER LEVEL




TOTAL CONNECTED LOAD IN AMPS

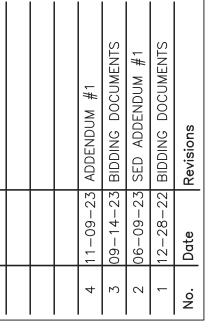




DK	Checked by	SH	Project No.	42054	Scale	NTS	Date	09-14-23

GREENMAN PEDERSEN, INC 2 EXECUTIVE BOULEVARD SUITE 202 SUITE 202 SUITERN, NY 10901	GREENMAN PEDERSEN, INC 2 EXECUTIVE BOULEVARD SUITE 202 SUFFERN, NY 10901
Mechanical & Electrical Engineer:	Structural Engineer:

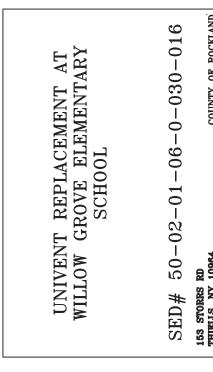

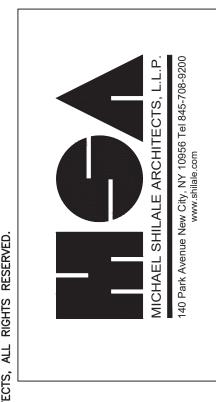

### **GENERAL NOTES:**

- 1. THE STRUCTURES HAVE BEEN DESIGNED IN COMPLIANCE WITH THE REQUIREMENTS OF 2020 BUILDING CODE OF NEW YORK STATE AND ASCE/SEI 7-16 "MINIMUM DESIGN LOADS AND ASSOCIATED CRITERIA FOR BUILDINGS AND OTHER STRUCTURES".
- CONTRACTOR AND SUBCONTRACTOR SHALL BE LICENSED BY NEW YORK STATE WHERE REQUIRED TO PERFORM THE SPECIFIED WORK. THE CONTRACTOR SHALL FURNISH ALL MATERIALS, LABOR AND EQUIPMENT NECESSARY TO ERECT / INSTALL ALL STRUCTURES AND ACCESSORIES AS REQUIRED IN ACCORDANCE WITH PLANS AND SPECIFICATIONS.
- THE CONTRACTOR SHALL GIVE ALL NOTICES AND COMPLY WITH ALL LAWS. ORDINANCES. REGULATIONS, AND ORDERS OF ANY PUBLIC AUTHORITY BEARING ON THE PERFORMANCE OF THE WORK INDICATED IN THE CONTRACT DOCUMENTS.
- 4. THE CONTRACTOR SHALL BE RESPONSIBLE FOR SECURING ALL NECESSARY PERMITS APPROVALS, AS WELL AS THEIR ASSOCIATED FEES, EXCEPT WHERE SPECIFIED AND AGREED UPON ELSEWHERE.
- THE CONTRACTOR SHALL BE RESPONSIBLE FOR ARRANGING HOISTING FACILITIES FOR HANDLING MATERIALS AND REMOVAL OF DEBRIS.
- THE CONTRACTOR SHALL VISIT THE SITE TO BECOME FAMILIAR WITH CONDITIONS THEREON AND TO DETERMINE THE EXTENT OF ALL FACILITIES AND SERVICES REQUIRED TO PERFORM THE WORK IN ACCORDANCE WITH THE CONTRACT DOCUMENTS.
- STRUCTURAL DRAWINGS SHALL BE USED IN CONJUNCTION WITH OTHER CONSTRUCTION DOCUMENTS. STRUCTURAL WORK SHALL BE COORDINATED WITH OTHER TRADES. ANY DISCREPANCIES IN THE CONTRACT DOCUMENTS SHALL BE BROUGHT TO THE ATTENTION OF THE ARCHITECT AND/OR ENGINEER FOR CLARIFICATION BEFORE COMMENCING THE WORK.
- 8. THE CONTRACTOR SHALL MAINTAIN ONE COPY OF THE LATEST CONTRACT DOCUMENTS INCLUDING ALL CHANGES AT THE JOB SITE FOR THE USE OF THE ARCHITECT & ENGINEER.
- THE CONTRACTOR SHALL BE RESPONSIBLE FOR THE ACTS AND OMISSIONS OF ALL THEIR EMPLOYEES AND ALL SUBCONTRACTORS, THEIR AGENTS AND EMPLOYEES, AND ALL OTHER PERSONS PERFORMING ANY OF THE WORK FOR THE CONTRACTOR.
- THE CONTRACTOR SHALL BE RESPONSIBLE FOR ANY DAMAGE INCURRED ANYWHERE WITHIN THE BOUNDARIES OF THE PROPERTY, AND ANY DAMAGE SHALL BE PROMPTLY REPAIRED TO ORIGINAL CONDITION TO THE SATISFACTION OF THE CLIENT'S REPRESENTATIVE AND/OR ARCHITECT AT NO COST TO THE CLIENT.
- 11. DURING THE COURSE OF THE WORK, THE CONTRACTOR SHALL REGULARLY REMOVE ALL UNUSED MATERIAL, RUBBISH AND DEBRIS FROM THE PROPERTY AND BROOM CLEAN DAILY. THE SITE AND PREMISES SHALL BE KEPT REASONABLY CLEAN, NEAT AND ORDERLY.
- 12. THE CONTRACTOR SHALL CONTROL CLEANING OPERATIONS TO PREVENT DIRT OR DUST FROM LEAVING THE JOB SITE AND INFILTRATING AREAS NOT INVOLVED IN THE PROJECT.
- 13. THE CONTRACTOR SHALL VERIFY ALL DIMENSIONS AND SITE CONDITIONS PRIOR TO SUBMITTING BIDS AND SHOP DRAWINGS AND/OR FABRICATION AND SHALL REPORT ANY DEVIATIONS OF DIMENSIONS, DISCREPANCIES AND/OR CONDITIONS WHICH WOULD INTERFERE WITH THE COMPLETION OF THE WORK TO THE ARCHITECT AND/OR ENGINEER OF RECORD FOR RESOLUTION AND BEFORE PERFORMING THE WORK. COMMENCEMENT OF THE WORK SHALL SIGNIFY ACCEPTANCE OF ANY AND ALL JOB SITE CONDITIONS.
- 14. WHEN "APPROVED EQUAL", "EQUAL TO", "APPROVED ALTERNATE", OR WHERE OTHER QUALIFYING TERMS ARE USED, SUBSTITUTIONS SHALL BE BASED SOLELY UPON THE REVIEW AND APPROVAL OF THE ARCHITECT AND/OR ENGINEER. THE BURDEN OF PROOF THAT A PRODUCT OR SYSTEM MEETS OR EXCEEDS THAT WHICH WAS SPECIFIED LIES ENTIRELY ON THE CONTRACTOR.
- 15. NOTATIONS ON ANY PLAN, ELEVATION, SECTION, OR DETAIL ARE APPLICABLE TO ALL PLANS, ELEVATIONS, SECTIONS, AND DETAILS. IF A CONFLICT ARISES ENGINEER AND/OR ARCHITECT OF RECORD SHALL BE INFORMED TO CLARIFY.
- 16. DO NOT SCALE DRAWINGS, USE DIMENSIONAL NOTATION ONLY.
- 17. LARGE SCALE DRAWINGS (I.E. SECTIONS, DETAILS, ETC.) TAKE PRECEDENCE OVER SMALL SCALE DRAWINGS. TYPICAL SECTIONS AND DETAILS SHOWN ON THE DRAWINGS SHALL APPLY TO ALL SIMILAR CONDITIONS.
- 18. CONTRACTOR SHALL BE RESPONSIBLE FOR MEANS AND METHODS OF CONSTRUCTION.
- 19. CONTRACTOR SHALL BE RESPONSIBLE FOR MAINTENANCE & STABILITY OF ALL STRUCTURES UNDER RENOVATION/CONSTRUCTION FOR THE WHOLE DURATION OF CONSTRUCTION.

### **CONCRETE NOTES:**

- DESIGN OF REINFORCED CONCRETE MEMBERS ARE IN ACCORDANCE WITH THE PROVISIONS OF THE BUILDING CODE REQUIREMENTS FOR REINFORCED CONCRETE (ACI 318-14), AND THE NEW YORK STATE BUILDING CODE 2020 EDITION SECTIONS BC 1901 AND 1906.
- 2. ALL EXTERIOR CONCRETE PADS SHALL BE NORMAL WEIGHT CONCRETE WITH A MINIMUM COMPRESSIVE STRENGTH OF 4000 PSI AT 28 DAYS, AND WITH A MAXIMUM WATER TO CEMENT RATIO OF 0.40. MAXIMUM CONCRETE SLUMP SHALL BE 4".
- 3. ALL EXPOSED CONCRETE SHALL BE AIR ENTRAINED, 5% TO 7% BY VOLUME.
- 4. PROPORTION, BATCH, AND MIX CONCRETE IN ACCORDANCE WITH SECTION BC 1903 OF THE 2020 NYS BUILDING CODE. MIXES SHALL HAVE INCLUDED ALL ADMIXTURES THAT WILL BE USED DURING THIS CONSTRUCTION.
- ROUGHENED SURFACE AT INTERFACE OF SEPARATE CONCRETE POURS (JOINTS) SHALL BE PREPARED AS FOLLOWS:
- a. ROUGHEN SURFACE TO A FULL AMPLITUDE OF APPROXIMATELY 1/4" WITH STIFF BROOM AFTER INITIAL SET.
- b. BEFORE PLACING FRESH CONCRETE, CLEAN SURFACE AND REMOVE LAITANCE WITH WIRE BRUSH c. IMMEDIATELY BEFORE NEW CONCRETE IS PLACED, WET SURFACE AND REMOVE STANDING
- WATER.

### 6. ALL EMBEDDED STEEL SHALL BE ASTM A36. ALUMINUM INSERTS ARE NOT PERMITTED.

### **CONCRETE REINFORCEMENT NOTES:**

- ALL REINFORCING SHALL BE WELDED WIRE FABRIC AND CONFIRM TO ASTM A1064.
- 2. PROVIDE WIRE FABRIC MESH IN FLAT SHEETS NOT ROLLS.
- WIRE FABRIC REINFORCING SHALL LAP 6" MINIMUM AND BE SECURELY WIRED AT EACH SIDE AND END.
- PROVIDE CHAIRS FOR SUPPORT OF ALL REINFORCEMENT. LIFTING OF BARS OR MESH DURING PLACEMENT OF CONCRETE IS NOT PERMITTED.
- 5. PLACE WIRE FABRIC MESH 2" FROM TOP OF SLAB ELEVATION.
- REINFORCED CONCRETE STRUCTURES SHALL MEET ALL THE REQUIREMENTS OF 2020 NYS BUILDING CODE CHAPTER 19 RELATED TO STRUCTURAL INTEGRITY

### **FOUNDATION CONSTRUCTION NOTES:**

- FOUNDATIONS FOR THIS PROJECT CONSIST OF SPREAD FOOTINGS DESIGNED TO BEAR ON STRUCTURALLY ENGINEERED COMPACTED FILL PLACED OVER UNDISTURBED VIRGIN SOIL HAVING A PRESUMED ALLOWABLE BEARING CAPACITY OF 1 TON PER SQUARE FOOT. A GEOTECHNICAL ENGINEER LICENSED IN THE STATE OF NEW YORK SHALL INSPECT AND VERIFY CAPACITY OF FOOTING SUBGRADE PRIOR TO PLACING FOOTING.
- DESIGN, FURNISH, AND PLACE ALL TEMPORARY OR PERMANENT SUPPORTS, WHETHER SHORING. SHEETING. OR BRACING. SO THAT NO HORIZONTAL MOVEMENT OR VERTICAL SETTLEMENT OCCURS TO EXISTING STRUCTURES, STREETS, OR UTILITIES ADJACENT TO PROJECT SITE.
- CONTROL SURFACE AND SUBSURFACE WATER DURING CONSTRUCTION SO THAT FOUNDATION WORK WILL BE PERFORMED IN DRY CONDITIONS AND ON UNDISTURBED SOIL.
- 4. EXCAVATIONS FOR FOUNDATIONS SHALL BE FINISHED BY HAND.
- 5. FOUNDATION CONCRETE SHALL NOT BE PLACED IN WATER OR ON FROZEN GROUND.
- 6. ALL STRUCTURAL COMPACTED FILL SHALL CONSIST OF CLEAN, WELL- GRADED GRANULAR MATERIAL CONTAINING NO MORE THAN 12% NOR LESS THAN 5% BY WEIGHT OF MATERIAL PASSING THE #200 SIEVE. MATERIAL SHALL BE FREE FROM CLAY LUMPS, ORGANICS AND DELETERIOUS MATERIAL. EXISTING ON SITE FILL/EXCAVATED MATERIAL MAY BE USED FOR BACKFILLING PROVIDED IT IS INSPECTED BY THE SOILS ENGINEER AND MEETS THE CRITERIA ABOVE.
- 7. ALL STRUCTURAL COMPACTED FILL AND BACKFILL SHALL BE PLACED IN 12" MAXIMUM LOOSE LIFTS AND COMPACTED WITH A HEAVY VIBRATORY COMPACTOR TO AT LEAST 95% OF THE MAXIMUM MODIFIED PROCTOR DENSITY AS PER ASTM D-1557 UNDER THE SUPERVISION OF A LICENSED SOILS ENGINEER.
- 8. ALL FILL AND BACKFILL SHALL BE PLACED ON VIRGIN SOIL THAT DOES NOT CONTAIN ANY ORGANIC MATERIAL. STRIP ALL TOP SOIL AS REQUIRED. PRIOR TO PLACING FILL OR BACKFILL, PROOF-COMPACT SUBGRADE WITH A HEAVY VIBRATORY COMPACTOR TO AT LEAST 95% OF THE MAXIMUM MODIFIED PROCTOR DENSITY AS PER ASTM D-1557 UNDER THE SUPERVISION OF A LICENSED SOILS ENGINEER.
- 9. CRUSHED STONE SHALL HAVE A GRADATION CONFORMING TO ASTM C33 NO. 57 STONE. CRUSHED STONE SHALL CONTAIN NO CLAY, SILT, OR ORGANIC MATERIAL.
- 10. NO FOOTINGS SHALL BE PLACED ABOVE 1 VERTICAL ON 2 HORIZONTAL SLOPE EXTENDED FROM THE CLOSEST EDGE OF ANY UNDISTURBED SOIL OR OTHER FOUNDATION STRUCTURE.

### **MISCELLANEOUS STRUCTURAL STEEL:**

- 1. STRUCTURAL STEEL DETAILING, FABRICATION AND ERECTION SHALL CONFORM TO THE AISC STEEL CONSTRUCTION MANUAL, 15TH EDITION, ANSI/AISC 360-16 "SPECIFICATION FOR STRUCTURAL STEEL BUILDINGS" AND ANSI/AISC 303-16 "CODE OF STANDARD PRACTICE FOR STEEL BUILDINGS AND BRIDGES".
- 2. MATERIALS SHALL CONFORM TO THE STANDARDS LISTED:
- a. W-SHAPES: ASTM A992 b. PLATES, ANGLES AND CHANNELS: ASTM A36
  - c. COLD-FORMED HSS: ASTM A500 GRADE B
  - d. ANCHOR RODS: ASTM F1554, GRADE 36
- e. STRUCTURAL BOLTS: ASTM A325
- 3. WELDING SHALL CONFORM TO THE AMERICAN WELDING SOCIETY STANDARD D1.1. ELECTRODES FOR SHOP AND FIELD WELDS SHALL CONFORM TO AWS, CLASS E70XX, LOW HYDROGEN.
- 4. SPLICING OF STRUCTURAL STEEL MEMBERS WHERE NOT DETAILED ON THE CONTRACT DOCUMENTS IS PROHIBITED WITHOUT THE PRIOR APPROVAL OF THE EOR AS FOR LOCATION, TYPE OF SPLICE AND CONNECTION TO BE MADE.
- 5. THE CONTRACTOR SHALL NOTIFY EOR OF ANY MISFABRICATED STRUCTURAL STEEL OR JOISTS PRIOR TO ERECTION OF SAME.
- 6. PENETRATIONS SHALL NOT BE CUT IN STRUCTURAL STEEL MEMBERS UNLESS SO INDICATED IN THE DRAWINGS OR AS APPROVED BY THE ENGINEER OF RECORD.
- 7. FILLET WELDS SHALL BE A MINIMUM OF 3/16".
- 8. ALL STEEL MEMBERS AND CONNECTIONS EXPOSED TO THE WEATHER SHALL BE HOT DIP GALVANIZED. STEEL MEMBERS, FABRICATIONS AND ASSEMBLIES INDICATED ON THE DRAWINGS TO BE GALVANIZED SHALL BE GALVANIZED AFTER FABRICATION BY HOT DIP PROCESS IN ACCORDANCE WITH ASTM A123. WEIGHT OF ZINC COATING TO CONFORM TO THE REQUIREMENTS SPECIFIED UNDER "WEIGHT OF COATING" IN ASTM A123 OR ASTM A386, AS APPLICABLE.
- 9. USE 3/8" MINIMUM GUSSET PLATE THICKNESS, UNLESS OTHERWISE NOTED.

### **STRUCTURAL STABILITY NOTE:**

THE STRUCTURES SHALL BE ADEQUATELY GUYED AND BRACED TO MAINTAIN SAFETY AND ALIGNMENT DURING ALL PHASES OF CONSTRUCTION. SUCH GUYING AND BRACING SHALL REMAIN IN PLACE UNTIL THE STRUCTURE HAS REACHED ADEQUATE STRENGTH AND/OR ALL PERMANENT BRACING IS IN PLACE. ENSURE THAT CONSTRUCTION OPERATIONS AND PROCEDURES IMPOSE NO LOADING GREATER THAN THE DESIGN LOADS ON ANY MEMBER.

### **SUBMITTALS REQUIRED:**

- THE FOLLOWING ITEMS REQUIRE SUBMITTAL OF SHOP AND ERECTION DRAWINGS FOR **REVIEW:**
- a. STRUCTURAL STEEL

FINAL INSPECTION:

- b. CONCRETE MIX DESIGN
- c. REINFORCING LAYOUT

### **SPECIAL AND PROGRESS INSPECTIONS:**

SPECIAL & PROGRESS INSPECTIONS REQUIRED BY THE 2020 BUILDING CODE OF NEW YORK STATE SHALL BE PERFORMED BY A TESTING AGENCY ENGAGED BY THE CONSTRUCTION MANAGER AT THEIR EXPENSE (NOT TO BE PERFORMED BY THE ENGINEER OF RECORD. EXCEPT FINAL INSPECTION) FOR THE FOLLOWING ITEMS:

INSPECTION	REF. STANDARD	BC REF.
STEEL CONSTRUCTION:		
<ul> <li>HIGH-STRENGTH BOLTS, NUTS, AND WASHERS MATERIAL VERIFICATION</li> </ul>	ANSI/AISC 360-16: Table N5.6-1	1705.2.1
HIGH-STRENGTH BOLTING	ANSI/AISC 360-16: Table N5.6-2 & Table N5.6-3	
MATERIAL VERIFICATION OF STRUCTURAL STEEL	ANSI/AISC 360-16: N5.1, N5.2	
<ul> <li>MATERIAL VERIFICATION OF WELD FILLER MATERIALS</li> </ul>	ANSI/AISC 360-16: Table N5.4-1	
INSPECTION OF WELDING	ANSI/AISC 360-16: Table N5.4-2 & Table N5.4-3	
<ul> <li>WELDER QUALIFICATION/CERTIFICATION AND WELDING PROCEDURES VERIFICATION</li> </ul>	ANSI/AISC 360-16: Table N5.4-1	
CONCRETE CONSTRUCTION:		
<ul> <li>INSPECTION OF REINFORCING STEEL AND PLACEMENT VERIFICATION</li> </ul>	ACI 318 Ch. 20, 25.2, 25.3, 26.6.1-26.6.3	1905, Table 1705.3 and 1908.4
INSPECTION OF ANCHORS CAST IN CONCRETE	ACI 318: 17.8.2	Table 1705.3
<ul> <li>INSPECTION OF ANCHORS POST-INSTALLED IN HARDENED CONCRETE MEMBERS</li> </ul>	ACI 318: 17.8.2.4 ACI 381: 17.8.2	Table 1705.3
VERIFYING USE OF REQUIRED DESIGN MIX	ACI 318: Ch. 19, 26.4.3, 26.4.4	1904.1 1904.2 1908.2 1908.3 Table 1705.3
<ul> <li>PRIOR TO CONCRETE PLACEMENT, FABRICATE SPECIMENS FOR STRENGTH TEST, PERFORM SLUMP AND AIR CONTENT TESTS, AND DETERMINE THE TEMP. OF THE CONCRETE</li> </ul>	ASTM C172, ASTM C31, ACI 318: 26.4, 26.12	1908.10 Table 1705.3
<ul> <li>INSPECTION OF CONCRETE PLACEMENT FOR PROPER APPLICATION TECHNIQUES</li> </ul>	ACI 318: 26.5	1908.6 1908.7 1908.8 Table 1705.3
<ul> <li>VERIFICATION OF THE MAINTENANCE OF SPECIFIED CURING TEMPERATURE AND TECHNIQUES</li> </ul>	ACI 318: 26.5.3 - 26.5.5	1908.9, Table 1705.3
<ul> <li>FORMWORK INSPECTION FOR SHAPE, LOCATION AND DIMENSIONS OF THE CONCRETE MEMBER BEING FORMED</li> </ul>	ACI 318: Ch. 26.11.1.2(b)	Table 1705.3
SOILS:		
<ul> <li>VERIFY MATERIALS BELOW SHALLOW FOUNDATIONS ARE ADEQUATE TO ACHIEVE DESIGN BEARING CAPACITY</li> </ul>		1705.6 Table 1705.6
<ul> <li>VERIFY EXCAVATIONS ARE EXTENDED TO PROPER DEPTH ANDHAVE REACHED PROPER MATERIAL</li> </ul>		
	l	1

### **GENERAL LEGEND & ABBREVIATIONS:**

W6x20	NEW STEEL MEMBER DESIGNATION (ON FRAMING PLANS & ELEVATIONS ONLY)
W10x22	EXISTING STEEL MEMBER DESIGNATION (ON FRAMING PLANS & ELEVATIONS ONLY)
	NEW STRUCTURAL STEEL

---- EXISTING STRUCTURAL STEEL

TOP OF CONCRETE

B.O.S. BOTTOM OF STEEL

T.O.G. **TOP OF GRATING** 

T.O.R. TOP OF RAIL

T.O.C.

EQ

V.I.F.

T.O.S. TOP OF STEEL EL. **ELEVATION** 

E.S. **EACH SIDE** F.S. FAR SIDE

N.S. **NEAR SIDE** (E) **EXISTING** 

(N) **NEW CENTERLINE** 

PL. PLATE DN DOWN

**EQUAL** 

OPP OPPOSITE HAND

> SIM SIMILAR TYP **TYPICAL**

### **DESIGN LOADS**

RISK CATEGORY

**VERIFY IN FIELD** 

**20 PSF** 2. ROOF LIVE LOAD 3. WIND LOAD PARAMETERS:

a. BASIC WIND SPEED 122 MPH b. EXPOSURE CATEGORY

4. SEISMIC LOAD PARAMETERS:

0.261 S1 0.061 b. SDS 0.300 C. 0.097 SD1 SITE CLASS 1.25 IMPORTANCE FACTOR SEISMIC DESIGN CATEGORY

5. SNOW LOAD PARAMETERS: a. GROUND SNOW LOAD b. IMPORTANCE FACTOR

EXPOSURE FACTOR

d. TEMPERATURE FACTOR

e. ROOF SLOPE FACTOR


30 PSF

1.1

1.0

1.2

1.0

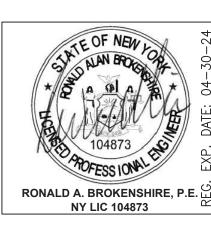

GREENMAN PEDERSEN, INC 2 EXECUTIVE BOULEVARD SUITE 202 SUFFERN, NY 10901	GREENMAN PEDERSEN, INC
Mechanical & Electrical Engineer:	Structural Engineer:

GROVE Y SCHC -06-0-030 REPL AT )W GI \TARY -01-06-WILLO MENT 50-02-0 ELE SED#

