

ADDENDUM NO. 03

PROJECT:	South Orangetown Central School District PHASE 1: 2022 BOND
CPL PROJECT NO.	14457.20
DATE:	November 9, 2023

Include this Addendum as part of the Contract Documents. It supplements portions of the original specifications and drawings, the extent of which shall remain, except as revised herein:

CLARIFICATIONS

- 1.1 Pre-bid walkthrough is at **9:00 AM** on 11/10/2023 at William O. Schaefer Elementary School.
- 1.2 CLE A100, A101, A102, A103: Unless otherwise noted, hatched regions indicate extent of ceiling system removal by GC.
- 1.3 Specification Section 064100 ARCHITECTURAL WOOD CASEWORK & 123200 MANUFACTURED WOOD CASEWORK are provided for reference only.

CORRECTIONS TO ADDENDA:

- 2.1 Addendum #2; Item 2.2: Omit revision.Section 224000; Part 2.4.A, Item 3 to read:3. Flush Operation: Sensor Operated
- 2.2 Addendum #2: Item 2.3: Omit removal. Refer to Item 3.2 below for revision.
- 2.3 Addendum #2; Item 2.4: Omit revision.Section 224000; Part 2.5.A, Item 3 to read:3. Flush Operation: Sensor Operated
- 2.4 Addendum #2: Item 2.5: Omit removal. Refer to Item 3.2 below for revision.

CHANGES TO THE SPECIFICATIONS

3.1 Omit Section 123100 MANUFACTURED METAL CASEWORK.

26 IBM Rd, Poughkeepsie, NY 12601 cplteam.com 845.567.6700 TEL 845.567.9614 FAX



- 3.2 Section 224000;
 - Part 2.4.B: Replace Item 1 to read:

1. Sensor-Operated Type: battery powered, infrared sensor with over-ride push button.

Part 2.5.C: Replace Item 1 to read:

1. Sensor-Operated Type: battery powered, infrared sensor with over-ride push button.

CHANGES TO THE DRAWINGS

- 4.1 Drawing GEN S801; Detail Section 2: Replace pier footing reference 'A513' with 'S804'
- 4.2 Drawing WOS A200: Replace with attached revised WOS A200
- 4.3 Drawing WOS A201: Replace with attached revised WOS A201
- 4.4 Drawing WOS A202: Revise Keynote 11 to read as follows:
 11. ALTERNATE 1/GC-01: INFILL DEMOLISHED UV LOCATION WITH NEW CASEWORK AS SCHEDULED. REFER TO A800 FOR DETAILS.
- 4.5 Drawing WOS A701: Replace with attached revised WOS A701
- 4.6 Drawing WOS A702: Replace with attached revised WOS A702
- 4.7 Drawing WOS A703: Replace with attached revised WOS A703
- 4.8 Drawing WOS A800: Replace with attached revised WOS A800
- 4.9 Drawing WOS A810: Replace with attached revised WOS A810
- 4.10 Drawings CLE A100 & A102: Revise Demolition Keynote C3 to read as follows: C3. REMOVE ACT CEILING SYSTEM IN ITS ENTIRETY. SALVAGE CEILING TILES.
- 4.11 Drawing CLE A101: Replace with attached revised CLE A101
- 4.12 Drawing CLE A103: Replace with attached revised CLE A103
- 4.13 Drawing CLE A202: New partition wall between room ST. 300E & ST. 300D – Revise wall tag to be S3i. New partition wall between room ST. 300D & Corridor – Revise wall tag to be S3ir.
- 4.14 Drawing CLE A601: Replace with attached revised CLE A601
- 4.15 Drawing CLE A603: Replace with attached revised CLE A603
- 4.16 Drawing CLE A701: Replace with attached revised CLE A701
- 4.17 Drawing CLE A702: Replace with attached revised CLE A702



Addendum No. 3 SOCSD – PH 1: 2022 BOND CPL Project No.14457.20 Page 3 of 4


- 4.18 Drawing CLE A800: Replace with attached revised CLE A800
- 4.19 Drawing CLE A810: Replace with attached revised CLE A810
- 4.20 Drawing CLE A900: DOOR SCHEDULE – NEW; Door 202A: Revise Panel Type to be PNL-N-WD DOOR FRAME TYPES; FRM-20 HM1: Sidelite Glazing to be type G2 - Fire Rated DOOR PANEL TYPES; PNL-G2-WD to be Glazing type G2 – Fire Rated
- 4.21 Drawing CLE A901: Replace with attached revised CLE A901
- 4.22 Drawing GEN 1000; PAINT (PT) Schedule: Remove row PT-5
- 4.23 Drawing WOS I200: Replace with attached revised WOS I200
- 4.24 Drawing WOS I201: Replace with attached revised WOS I201
- 4.25 Drawing WOS P000: Replace with attached revised WOS P000
- 4.26 Drawings WOS E100, E101 & E104: Revise Keynote 2 to read as follows:
 2. DISCONNECT AND REMOVE EXISTING LIGHT FIXTURES AND ALL CEILING MOUNTED DEVICES AS NECESSARY TO ACCOMMODATE ANY CEILING REMOVALS.
 PULL ALL CIRCUITRY BACK TO AN AREA OUTSIDE OF DEMOLITION AND TAG FOR RE-USE. REFER TO 300 SERIES DRAWINGS FOR REINSTALLATION LOCATIONS.
- 4.27 Drawing WOS E102: Replace with attached revised WOS E102
- 4.28 Drawing WOS E103: Revise Keynote 1 to read as follows:
 1. DISCONNECT AND REMOVE EXISTING LIGHT FIXTURES AND ALL CEILING MOUNTED DEVICES AS NECESSARY TO ACCOMMODATE ANY CEILING REMOVALS.
 PULL ALL CIRCUITRY BACK TO AN AREA OUTSIDE OF DEMOLITION AND TAG FOR RE-USE. REFER TO 300 SERIES DRAWINGS FOR REINSTALLATION LOCATIONS.
- 4.29 Drawing WOS E301: Replace with attached revised WOS E301
- 4.30 Drawing CLE E100: Revise Keynotes 1 & 2 to read as follows:
 1. NOT USED
 2. DISCONNECT AND REMOVE EXISTING LIGHT FIXTURES AND ALL CEILING MOUNTED DEVICES AS NECESSARY TO ACCOMMODATE ANY CEILING REMOVALS.
 PULL ALL CIRCUITRY BACK TO AN AREA OUTSIDE OF DEMOLITION AND TAG FOR RE-USE. REFER TO 300 SERIES DRAWINGS FOR REINSTALLATION LOCATIONS.
- 4.31 Drawing CLE E101: Replace with attached revised CLE E101
- 4.32 Drawing CLE E102: Replace with attached revised CLE E102
- 4.33 Drawing CLE E103: Replace with attached revised CLE E103




Addendum No. 3 SOCSD – PH 1: 2022 BOND CPL Project No.14457.20 Page 4 of 4


- 4.34 Drawing CLE E104: Revise Keynote 2 to read as follows:
 2. DISCONNECT AND REMOVE EXISTING LIGHT FIXTURES AND ALL CEILING MOUNTED DEVICES AS NECESSARY TO ACCOMMODATE ANY CEILING REMOVALS.
 PULL ALL CIRCUITRY BACK TO AN AREA OUTSIDE OF DEMOLITION AND TAG FOR RE-USE. REFER TO 300 SERIES DRAWINGS FOR REINSTALLATION LOCATIONS.
- 4.35 Drawing CLE E105: Replace with attached revised CLE E105
- 4.36 Drawing CLE E203: Replace with attached revised CLE E203
- 4.37 Drawing CLE E301: Replace with attached revised CLE E301
- 4.38 Drawing CLE E302: Replace with attached revised CLE E302
- 4.39 Drawing CLE E303: Replace with attached revised CLE E303
- 4.40 Drawing CLE E304: Replace with attached revised CLE E304
- 4.41 Drawing TZHS E200: Revise Keynote 9 to read as follows:
 9. PROVIDE 1" CONDUIT FROM SPEAKER LOCATION TO SPEAKER LOCATION AS INDICATED. PROVIDE 1" CONDUIT FROM FIRST SPEAKER LOCATION BACK TO EQUIPMENT RACK LOCATION. CONDUIT TO BE USED FOR SPEAKER WIRING.

END OF ADDENDUM NO. 03

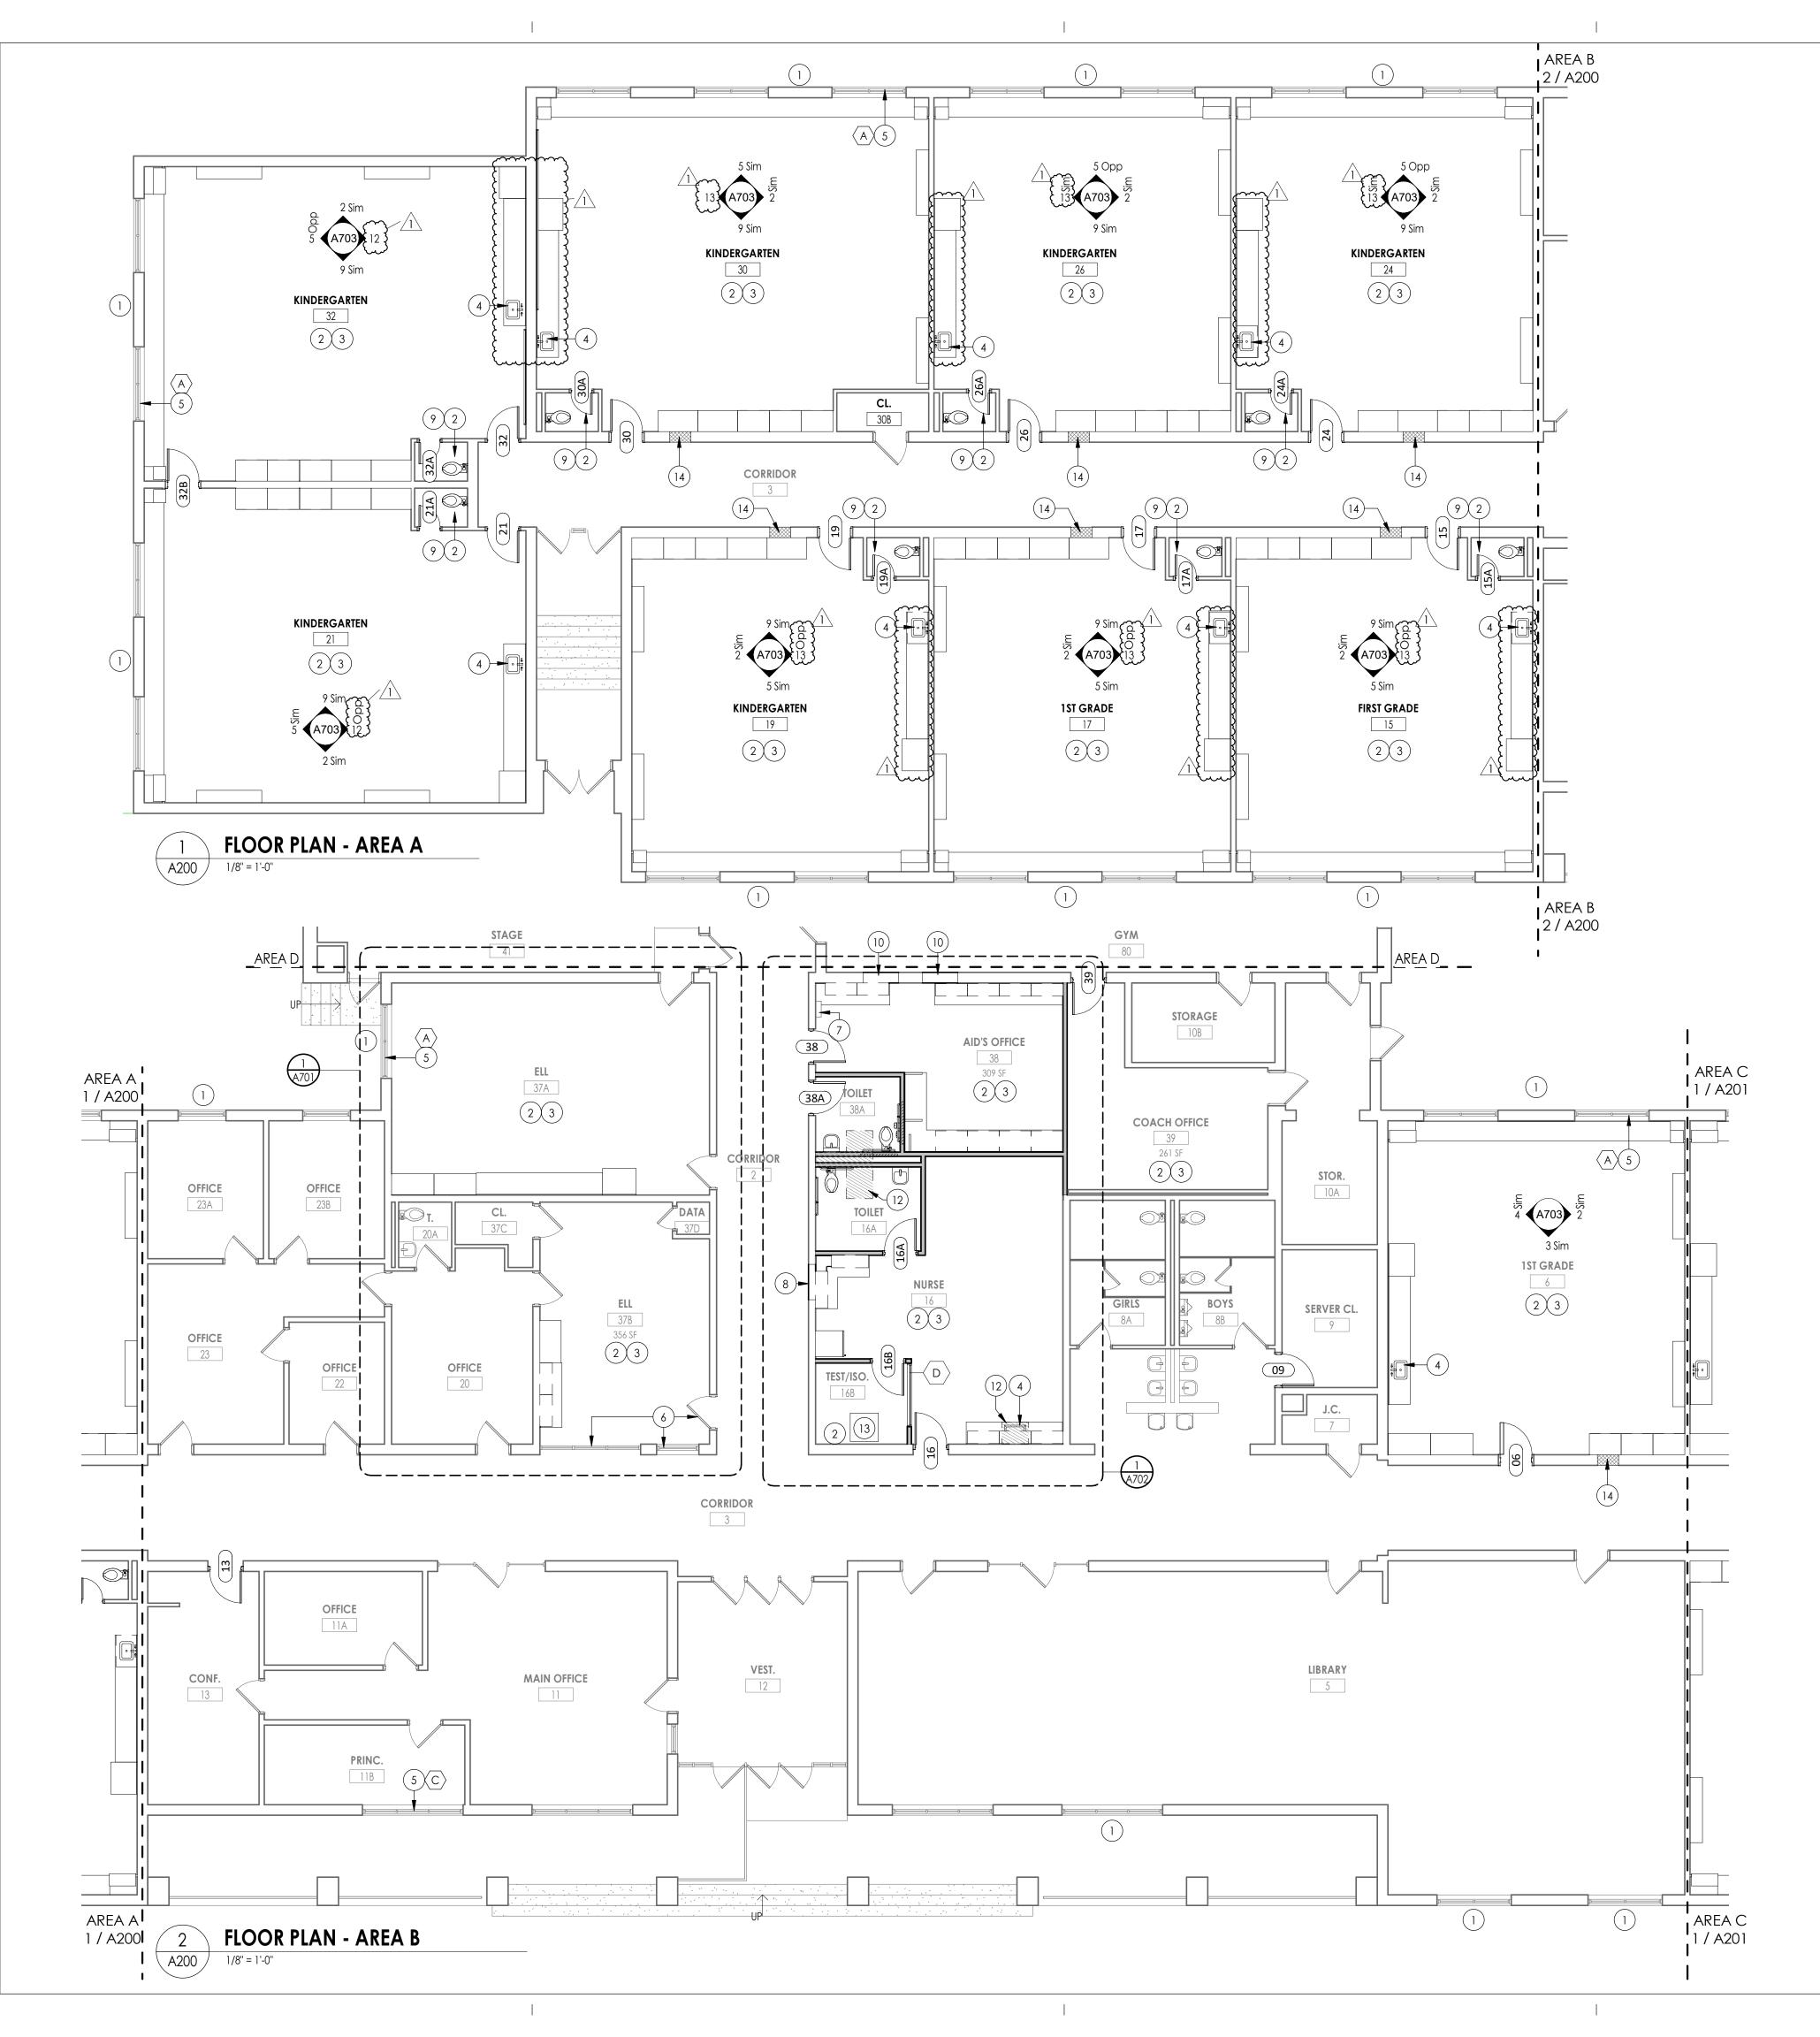




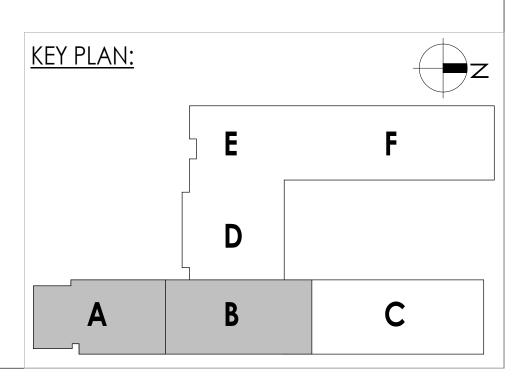

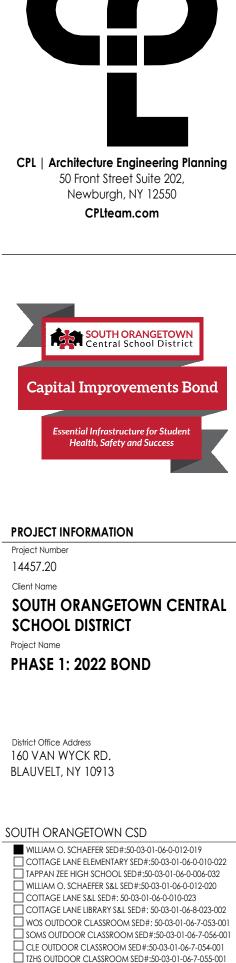

PROJECT ISSUE & REVISION SCHEDUL

PROFESSIONAL STAMPS

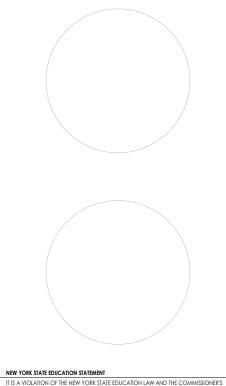



LATIONS FOR ANY PERSON, UNLESS ACTING UNDER THE DIRECTION BEARING THE SEAL OF AN ARCHITECT, ENGINEER OR SURVEYOR PARTY SHALL AFFIX TO THE ITEM THEIR SEAL AND THE NOTATION THEIR SIGNATURE AND THE DATE OF SUCH ALTERATION, AND A S

SHEET INFORMATION


Issued	Scale
10/18/23	As indicated
Project Status	
BID DOCUMENTS	
Drawn By	Checked By
LF	LT
Drawing Title	
NEW WORK PLAN	I - AREA A&B


Drawing Number WOS A200

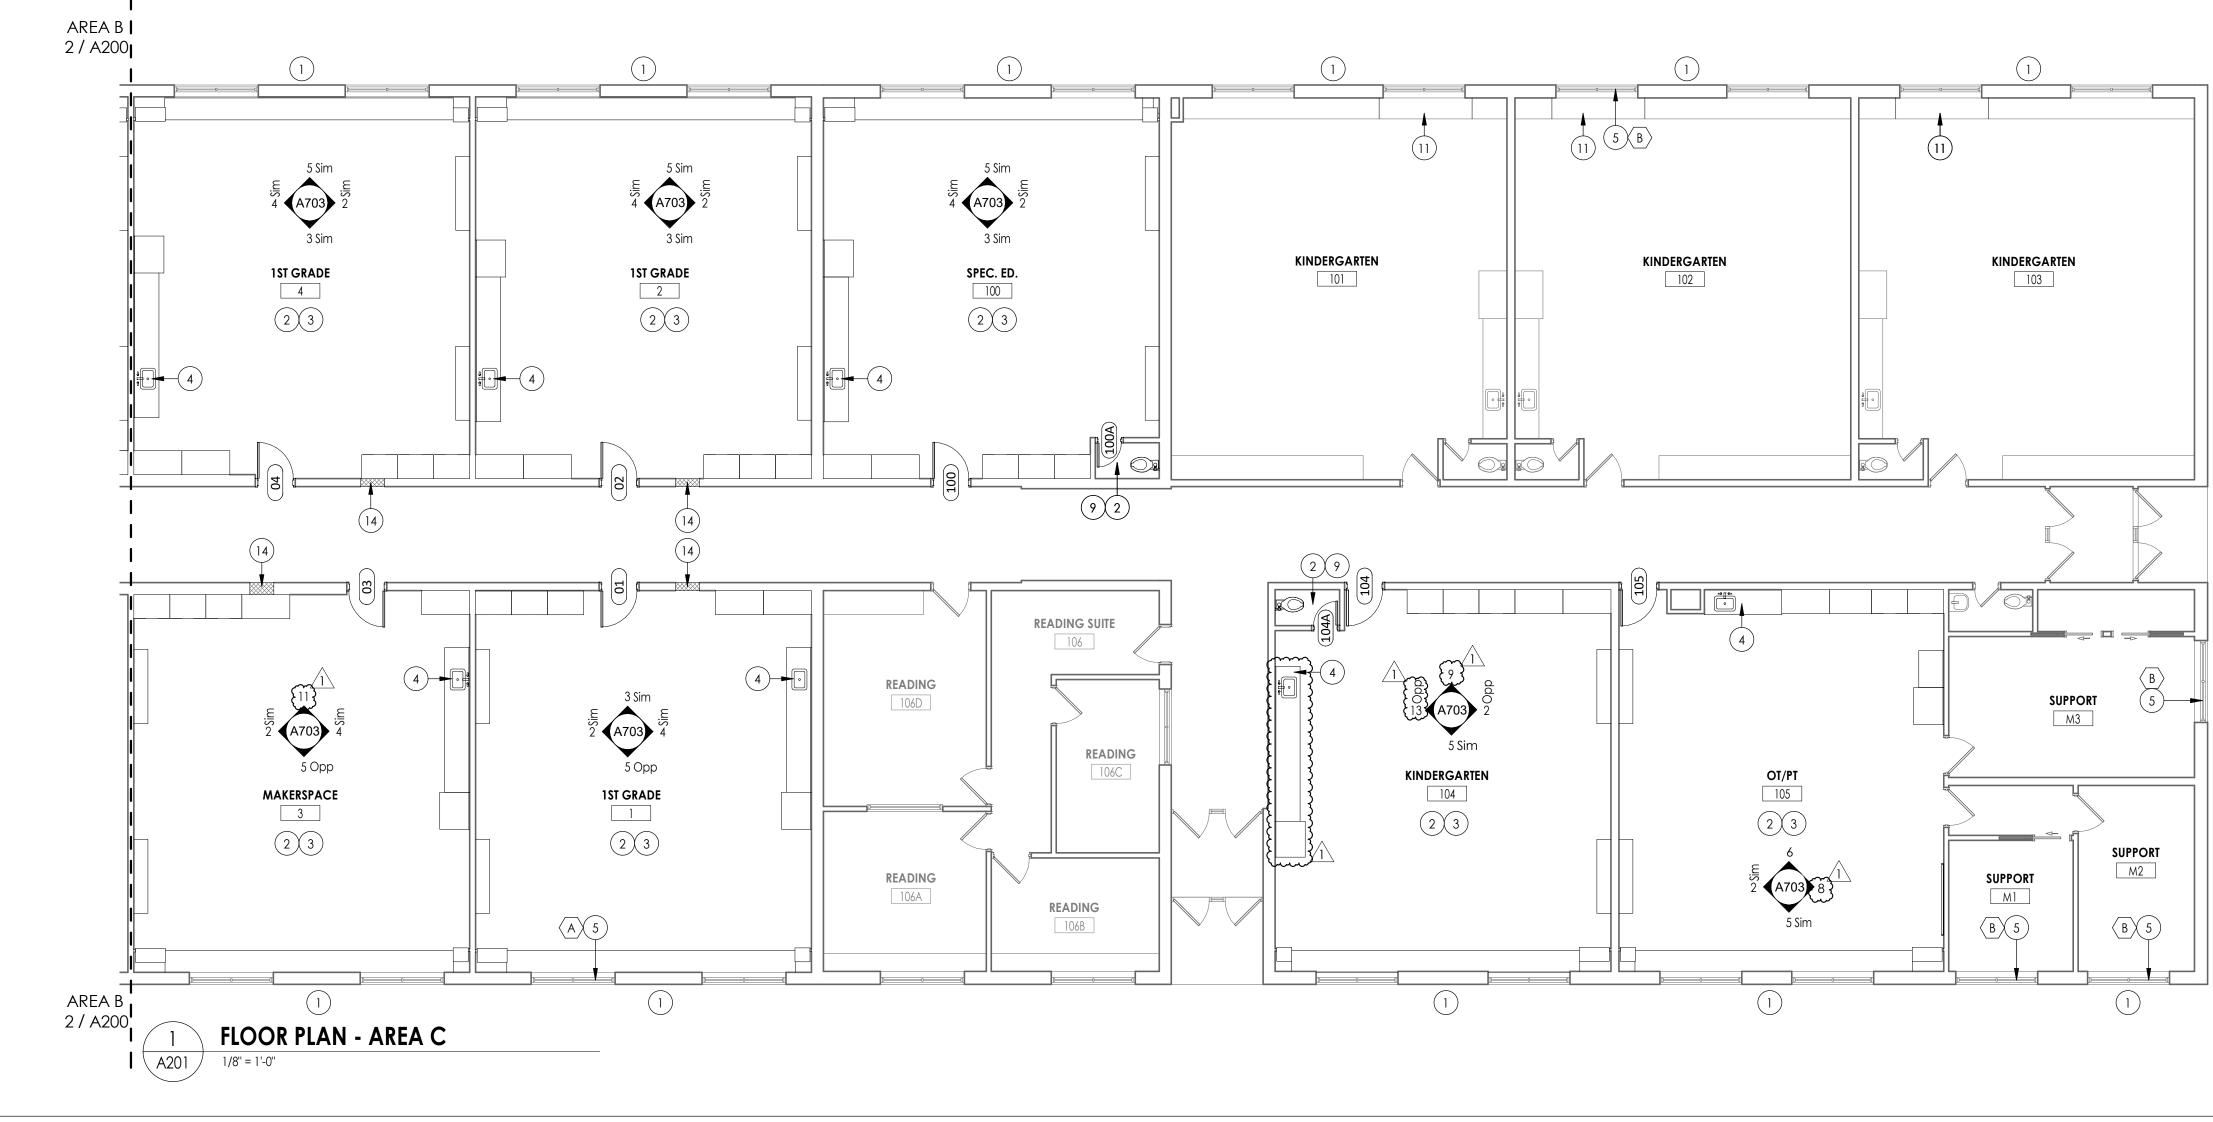

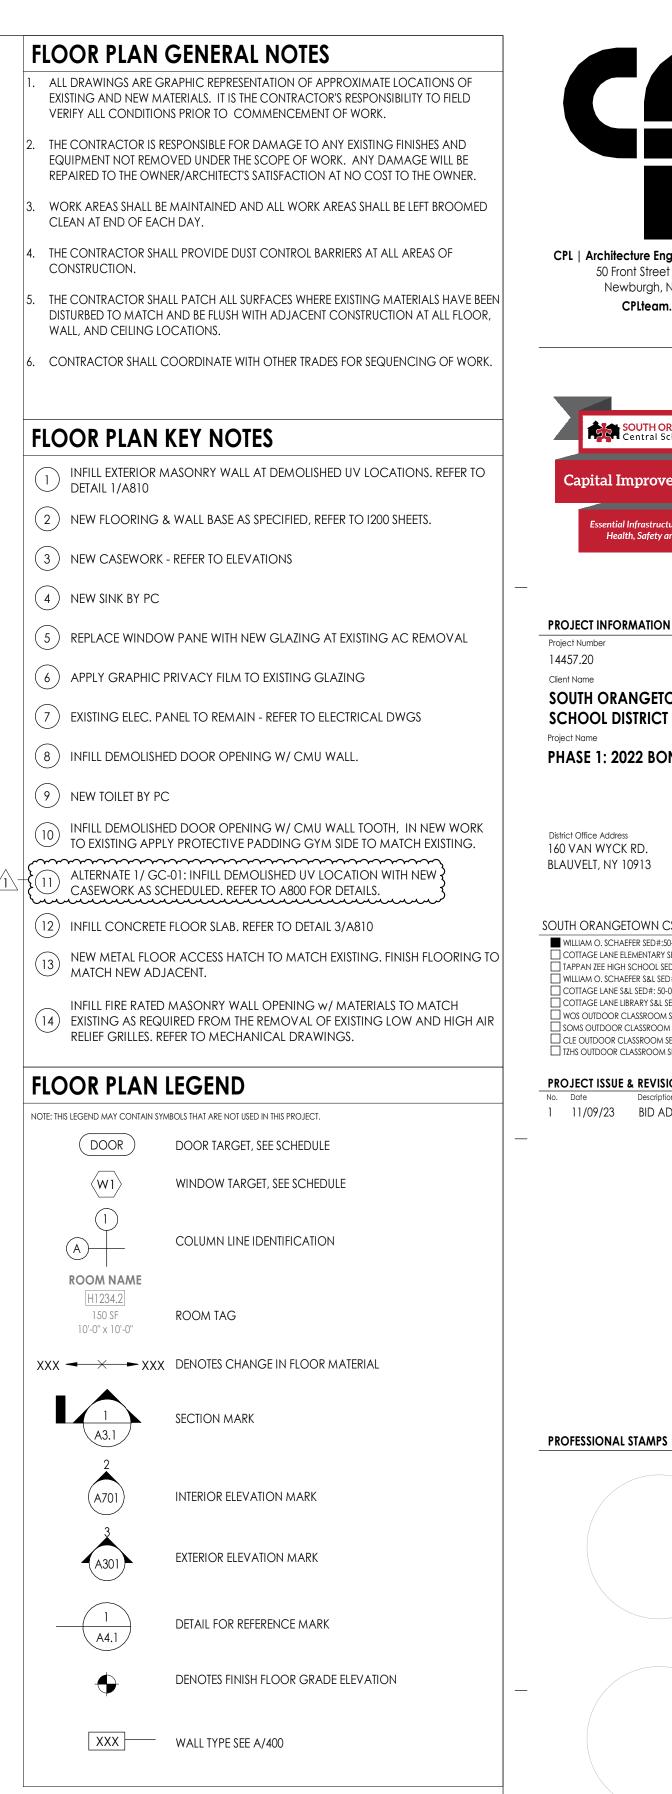

CPL | Architecture Engineering Planning 50 Front Street Suite 202, Newburgh, NY 12550 CPLteam.com SOUTH ORANGET Capital Improvements Bond Health, Safety and Success PROJECT INFORMATION Project Number 14457.20 Client Name SOUTH ORANGETOWN CENTRAL SCHOOL DISTRICT Project Name PHASE 1: 2022 BOND District Office Address 160 VAN WYCK RD. BLAUVELT, NY 10913 south orangetown CSD WILLIAM O. SCHAEFER SED#:50-03-01-06-0-012-019 COTTAGE LANE ELEMENTARY SED#:50-03-01-06-0-010-022] TAPPAN ZEE HIGH SCHOOL SED#:50-03-01-06-0-006-032 WILLIAM O. SCHAEFER S&L SED#:50-03-01-06-0-012-020 COTTAGE LANE S&L SED#: 50-03-01-06-0-010-023 COTTAGE LANE LIBRARY S&L SED#: 50-03-01-06-8-023-002 WOS OUTDOOR CLASSROOM SED#: 50-03-01-06-7-053-001 SOMS OUTDOOR CLASSROOM SED#:50-03-01-06-7-056-001 CLE OUTDOOR CLASSROOM SED#:50-03-01-06-7-054-001 TZHS OUTDOOR CLASSROOM SED#:50-03-01-06-7-055-001 **PROJECT ISSUE & REVISION SCHEDULE** 1 11/09/23 BID ADDENDUM #3

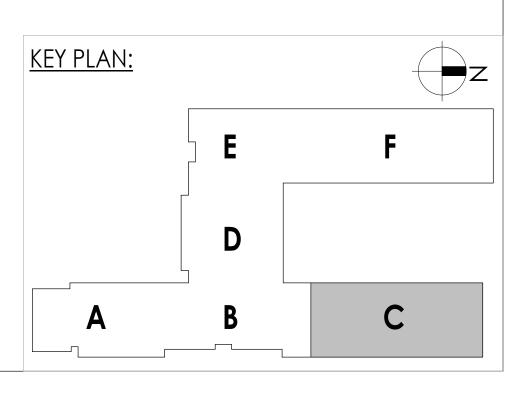

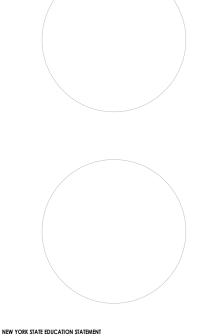


LATION OF THE NEW YORK STATE EDUCATION LAW AND THE Egulations for any person, unless acting under the direction of a licen RCHITECT, Engineer or land surveyor, to alter an item in any way. If an i BEARING THE SEAL OF AN ARCHITECT, ENGINE AN IEM IN ANY WAY. BEARING THE SEAL OF AN ARCHITECT, ENGINEER OR SURVEYOR SURVEYOR STATERED. T PARTY SHALL AFRIX TO THE ITEM THEIR SEAL AND THE NOTATION "ALTERED BY" I THEIR SIGNATURE AND THE DATE OF SUCH ALTERATION, AND A SPECIFIC DESC ALTERATION.


SHEET INFORMATION

Issued	Scale
10/18/23	As indicated
Project Status	
BID DOCUMENTS	
Drawn By	Checked By
LF	LT
Drawing Title	
NEW WORK PL	AN - AREA C







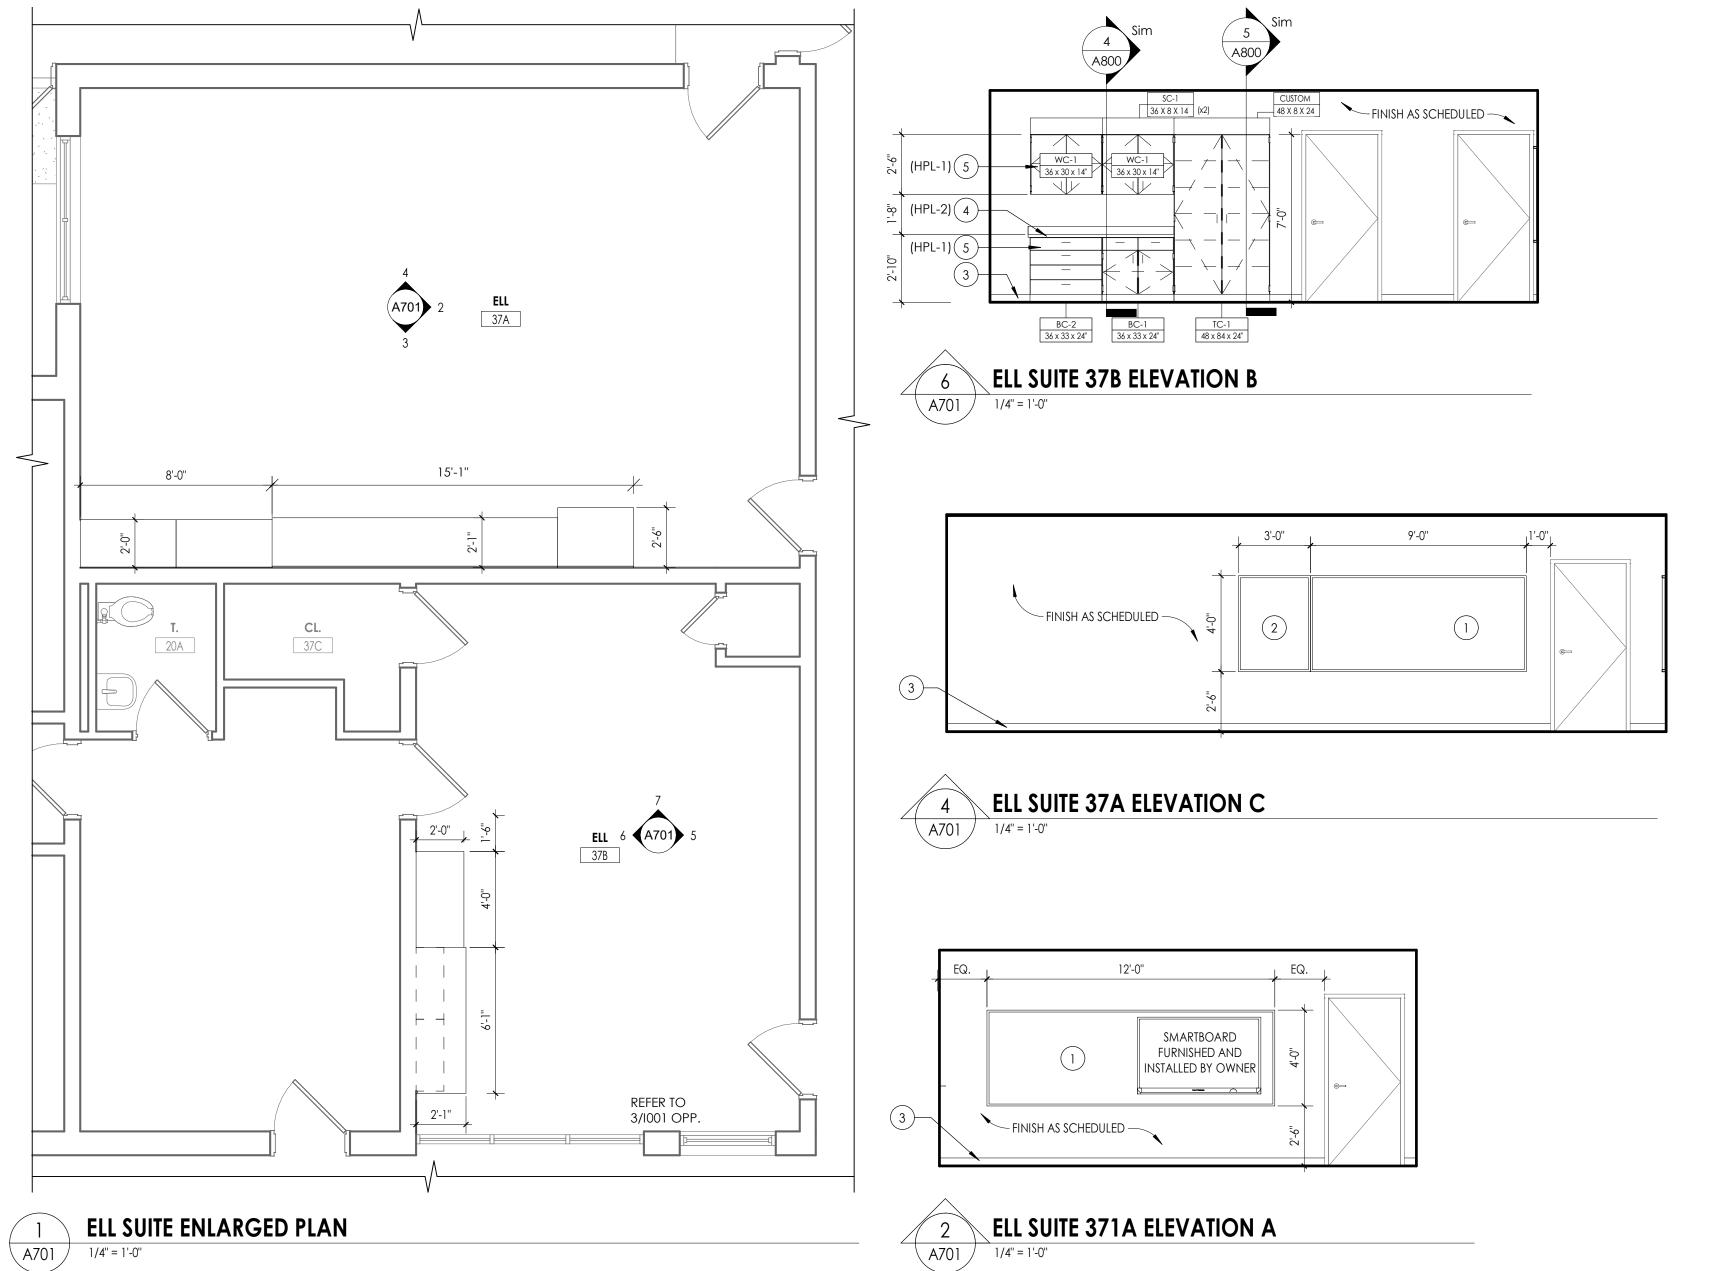


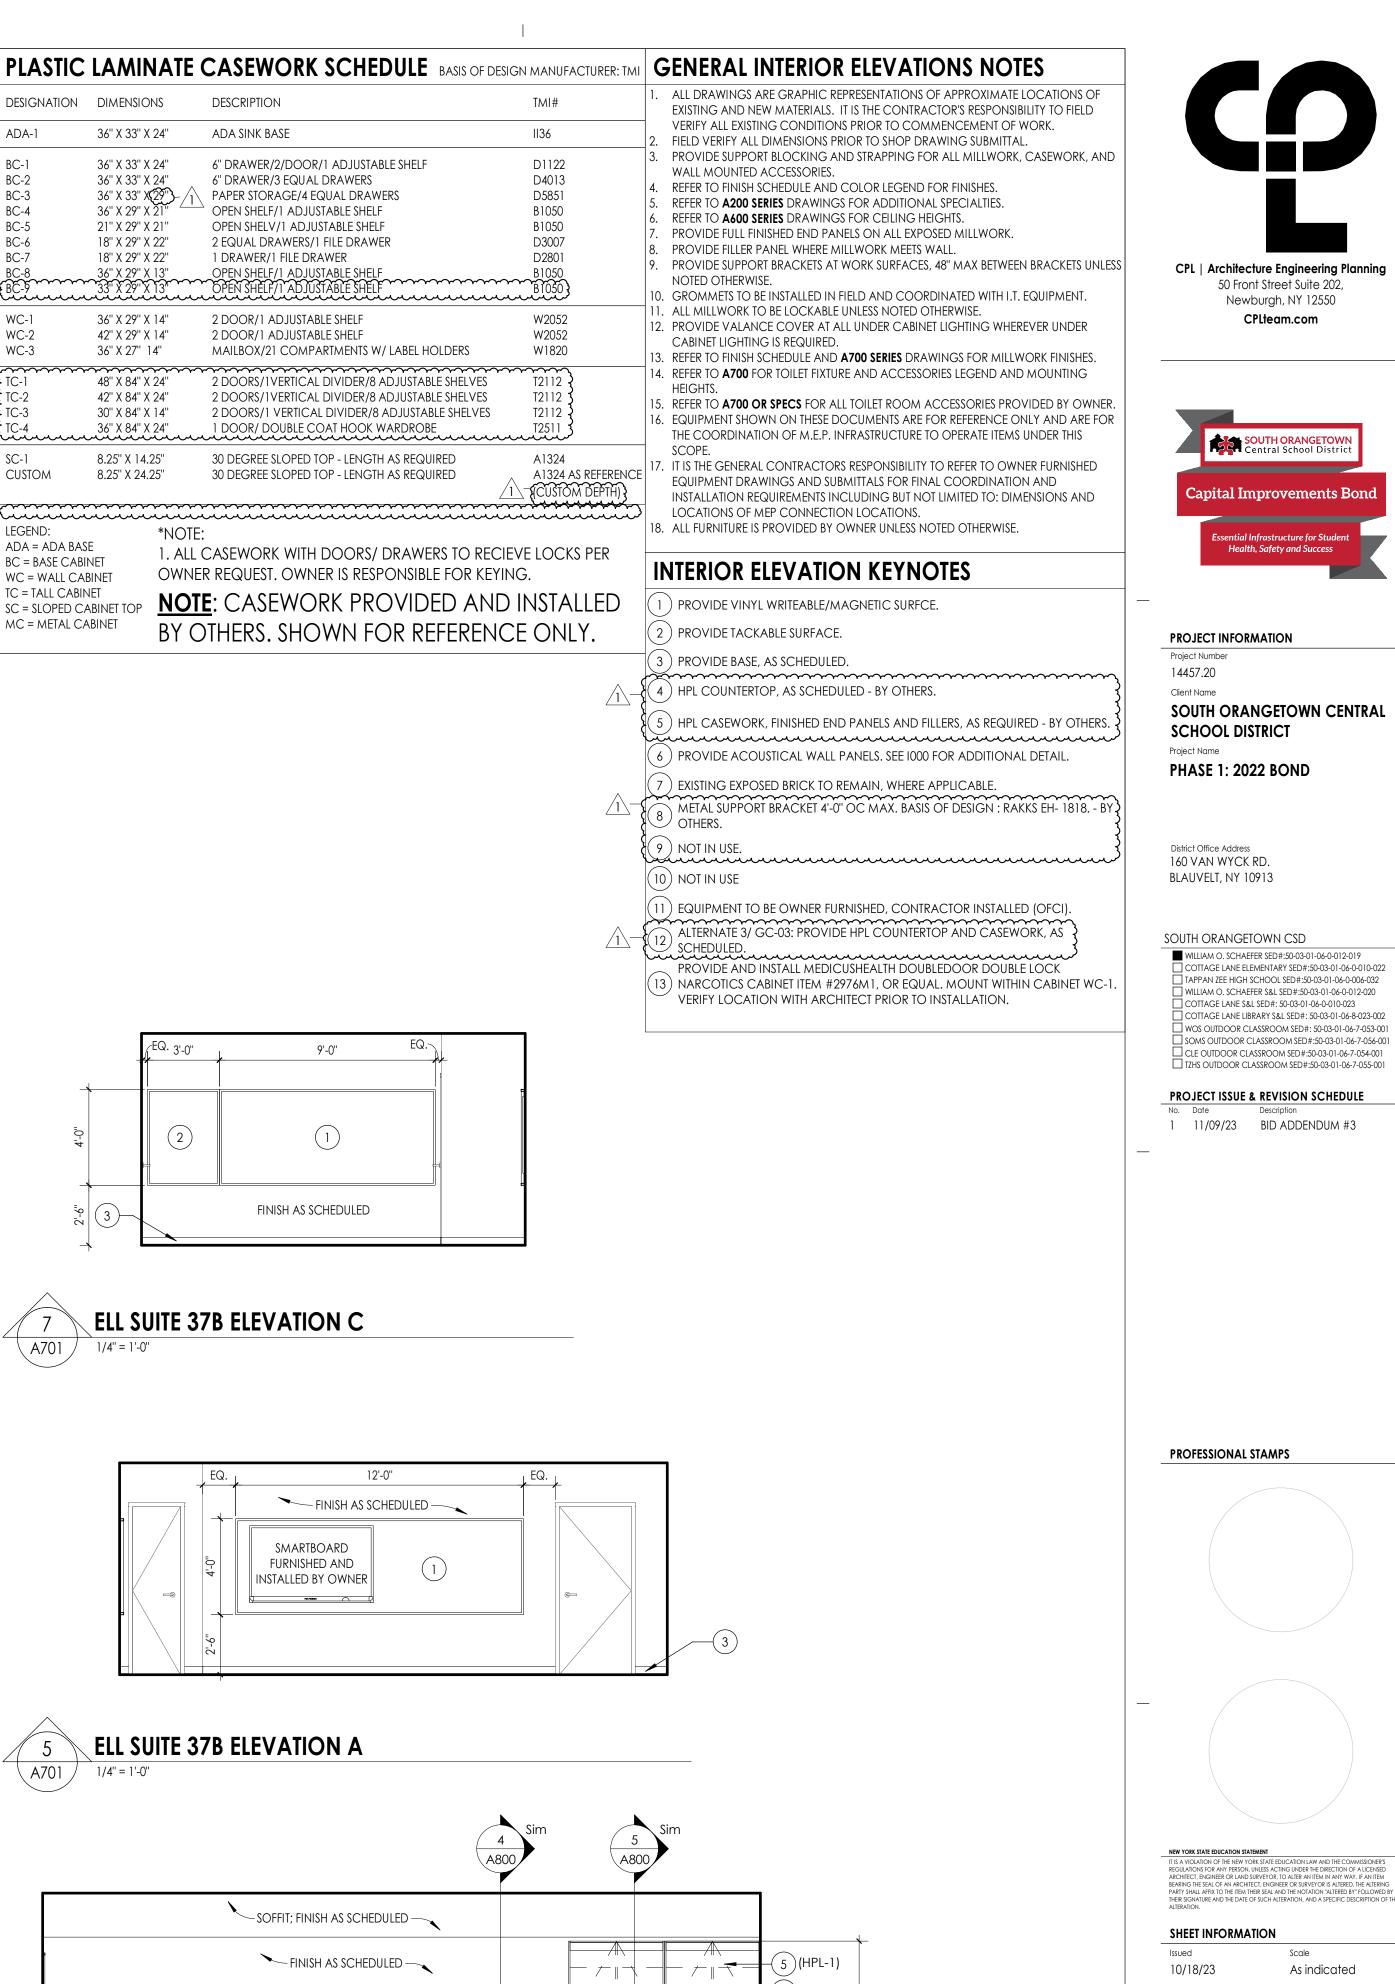



	DESIGNATION	DIMENSION	٩S	DESCRIPTION		
	ADA-1	36" X 33" X	24''	ADA SINK BASE		
	BC-1	36" X 33" X		6" DRAWER/2/DC		BLE
	BC-2	36" X 33" X		6" DRAWER/3 EQ		
	BC-3	36" X 33" X		PAPER STORAGE,		
	BC-4	36" X 29" X		OPEN SHELF/1 AD		
	BC-5	21" X 29" X		OPEN SHELV/1 A		
	BC-6	18" X 29" X		2 EQUAL DRAWE		/ER
	BC-7	18" X 29" X		1 DRAWER/1 FILE		
_	BC-8	36" X 29" X		OPEN SHELF/1 AE		
	BC-2	33" X 29" X	13"	OPEN SHELF/1 AL	DJUSTABLE SHEL	F
	WC-1	36" X 29" X		2 DOOR/1 ADJU	STABLE SHELF	
	WC-2	42" X 29" X		2 DOOR/1 ADJUS		
	WC-3	36" X 27" 1		MAILBOX/21 CO		
Δ	FTC-1	48" X 84" X		2 DOORS/1VERTI	CAL DIVIDER/8	
Ċ	TC-2	42" X 84" X	24''	2 DOORS/1VERTI	CAL DIVIDER/8	AD.
	TC-3	30" X 84" X	14"	2 DOORS/1 VERT	ICAL DIVIDER/8	3 AD
	LTC-4	36" X 84" X	24"	1 DOOR/ DOUBL	E COAT HOOK	WAF
	SC-1	8.25" X 14.2	25''	30 DEGREE SLOP	ED TOP - LENGT	Ή A
	CUSTOM	8.25" X 24.2	25''	30 DEGREE SLOP	ED TOP - LENGT	ΉA
\wedge	~~~~~~~~~~~~~~~~~~~~~~~~~~~~~~~~~~~~~~~	~~~~~	~~~~~	~~~~~~~	~~~~~~~~~~~~~~~~~~~~~~~~~~~~~~~~~~~~~~~	$\gamma\gamma$
	LEGEND:	······		·········		m
	ADA = ADA BASE		*NOTE:			
	BC = BASE CABIN		1. ALL C	CASEWORK W	ith doors/	' DF
	WC = WALL CAB			REQUEST. OV	WNER IS RES	PΟ
	TC = TALL CABIN					
	SC = SLOPED CA		NOTE	: CASEW	ORK PR	\bigcirc
	MC = METAL CAI					
			RA O	THERS. SH	IOWN F	O

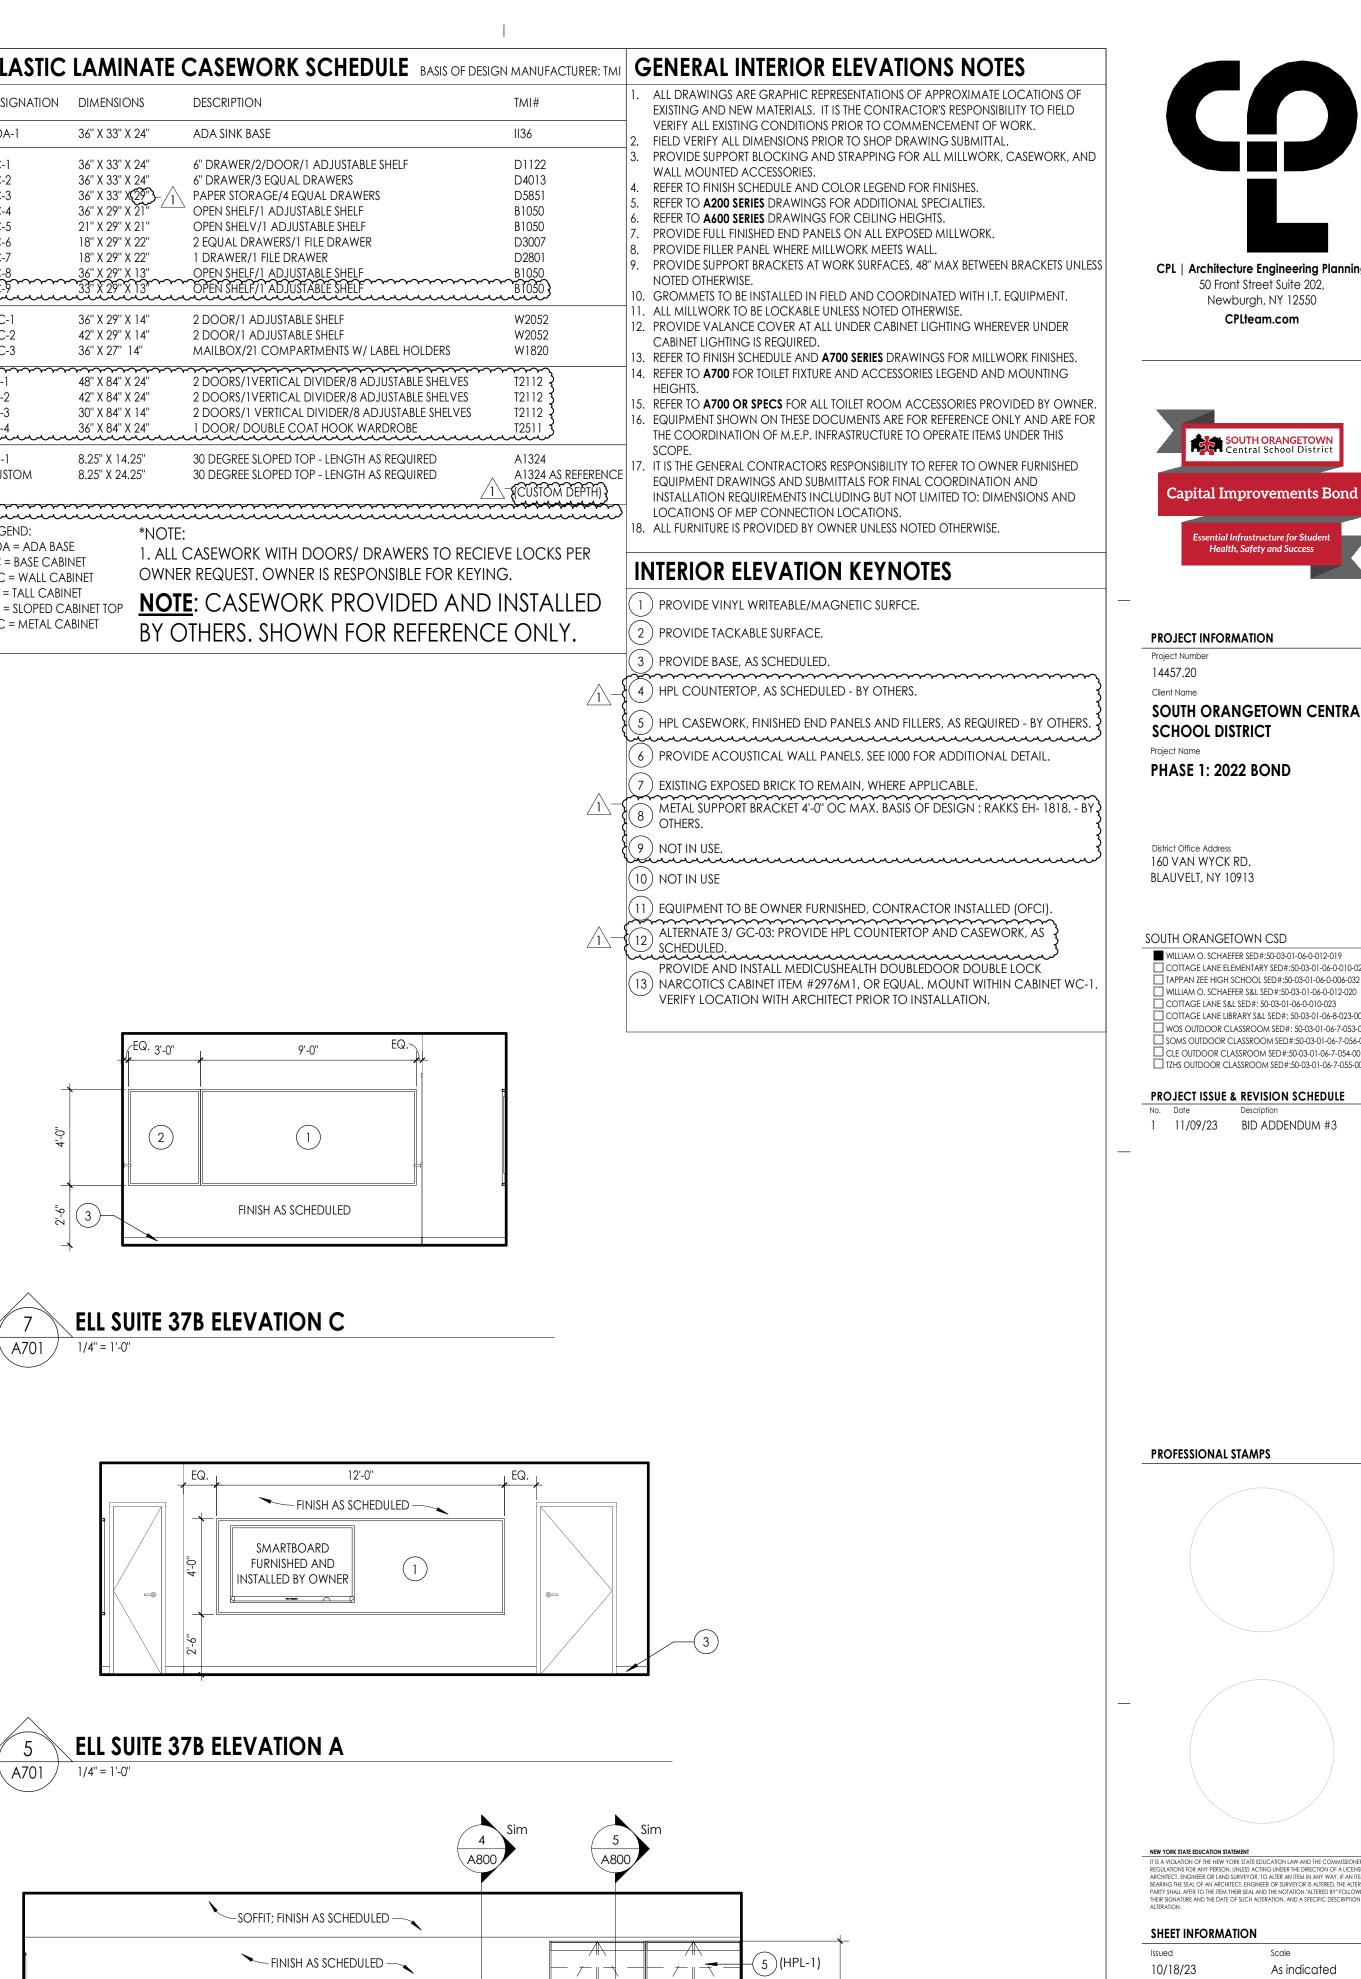

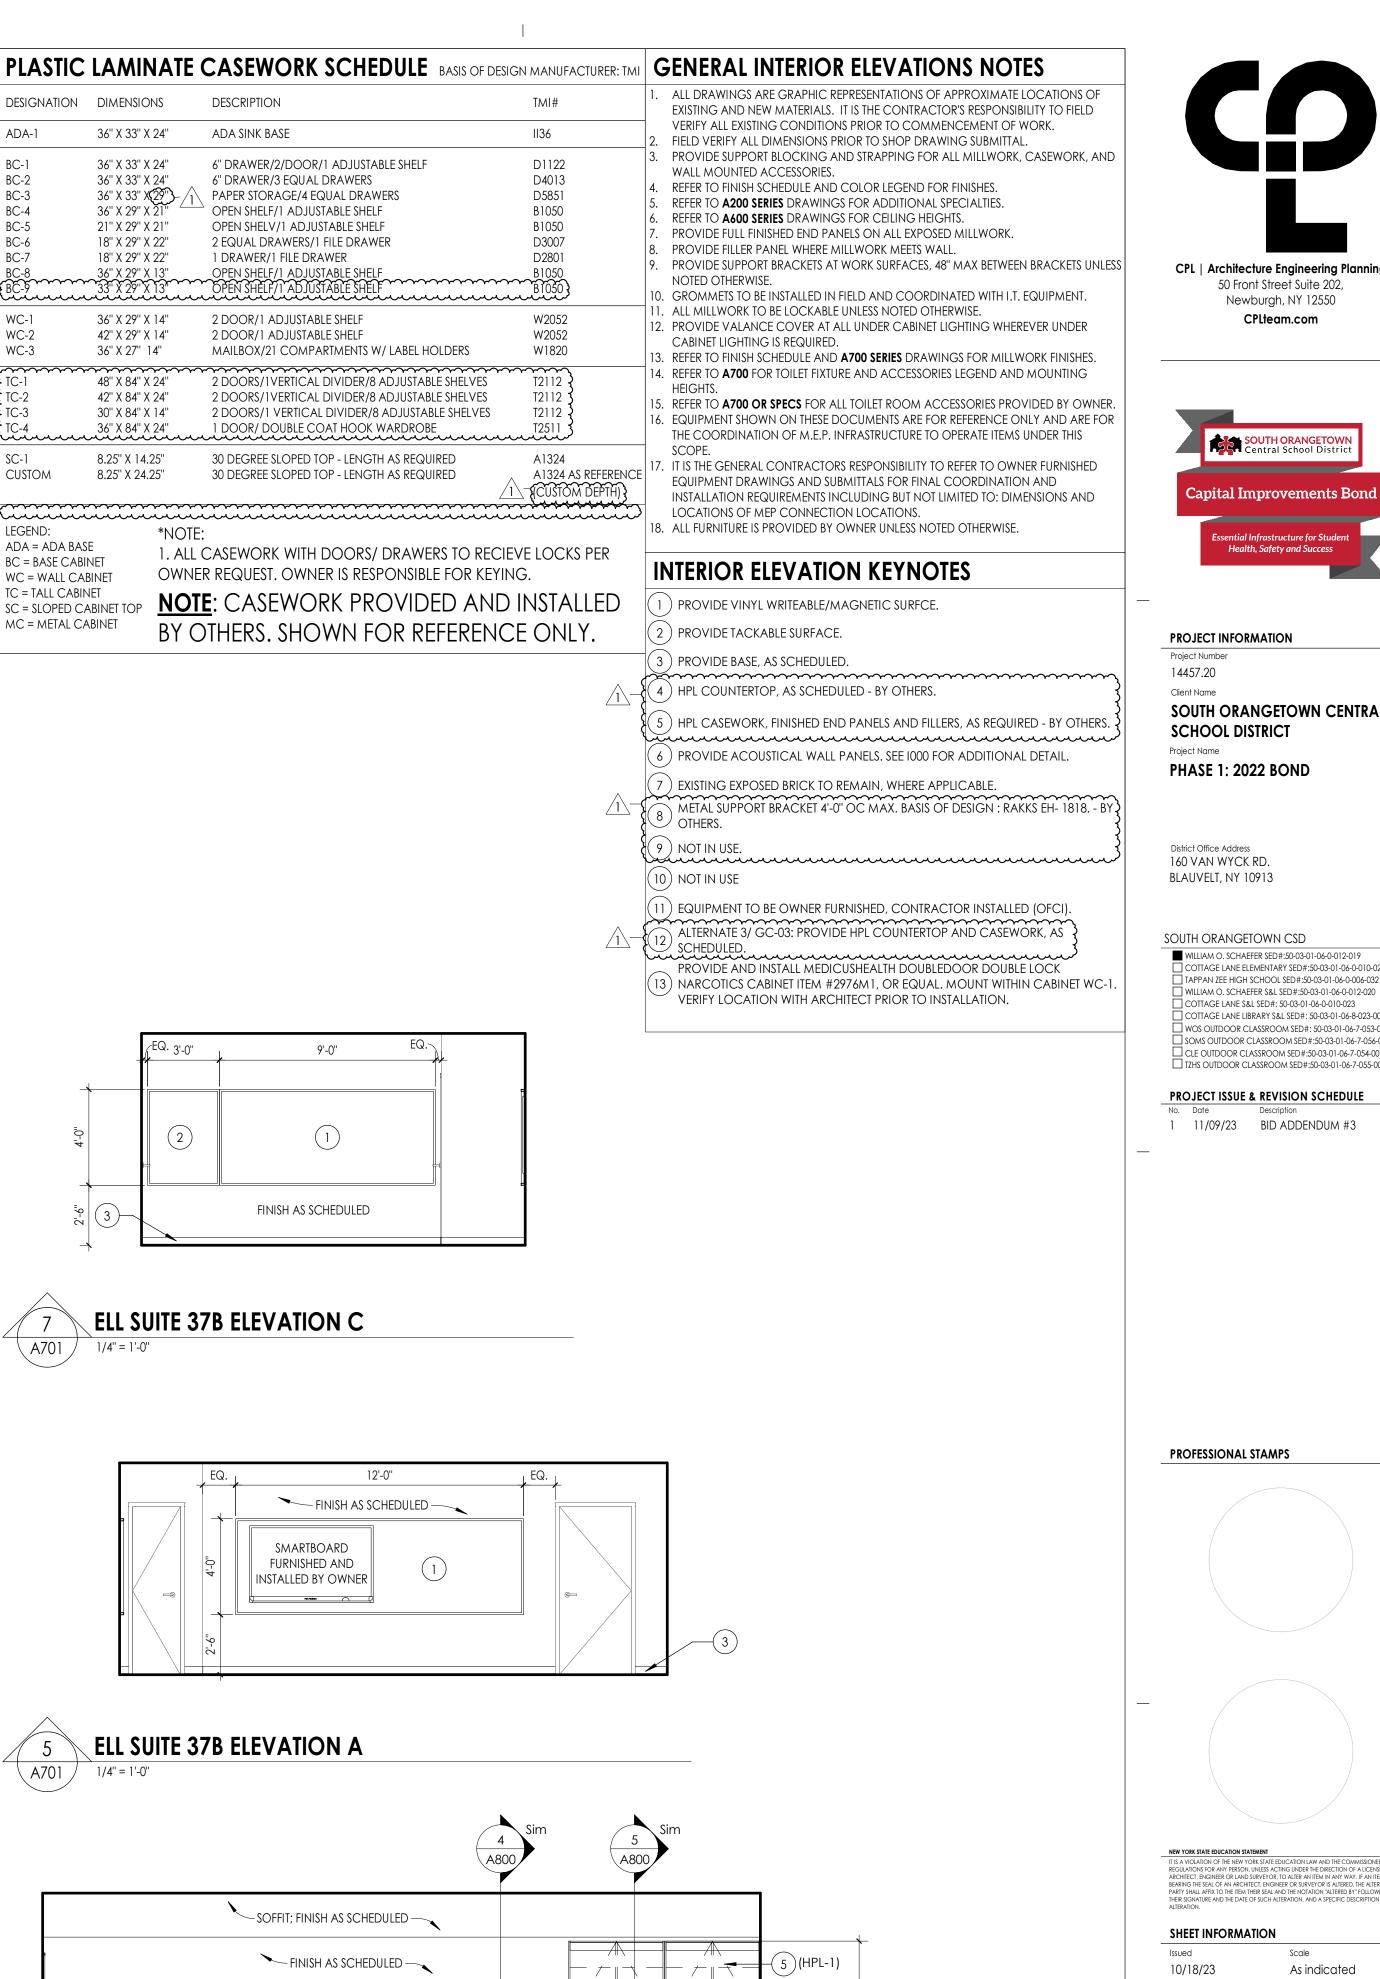

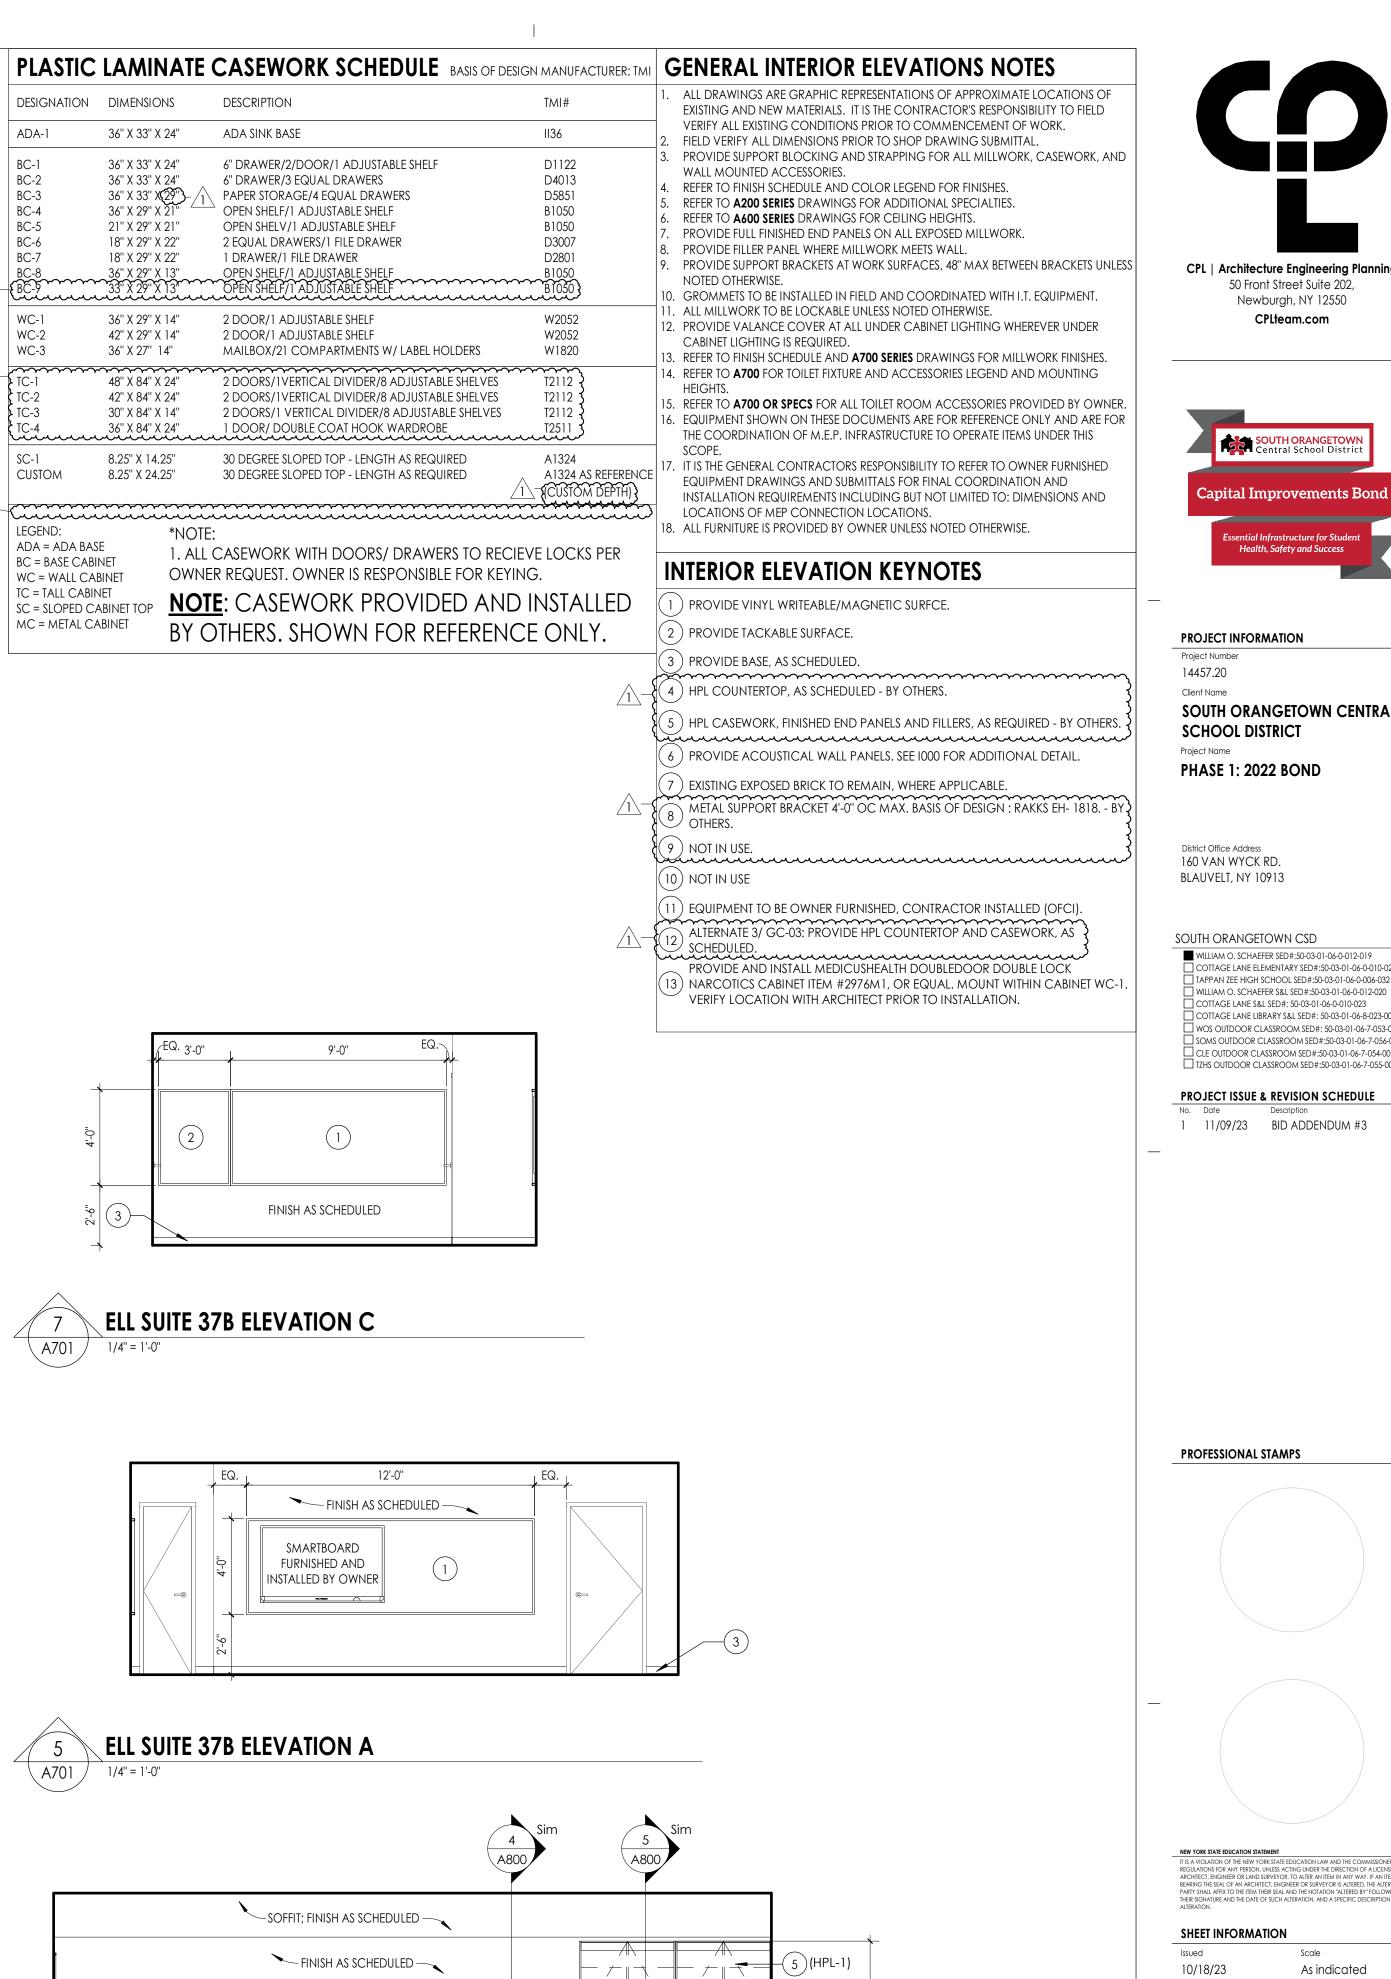

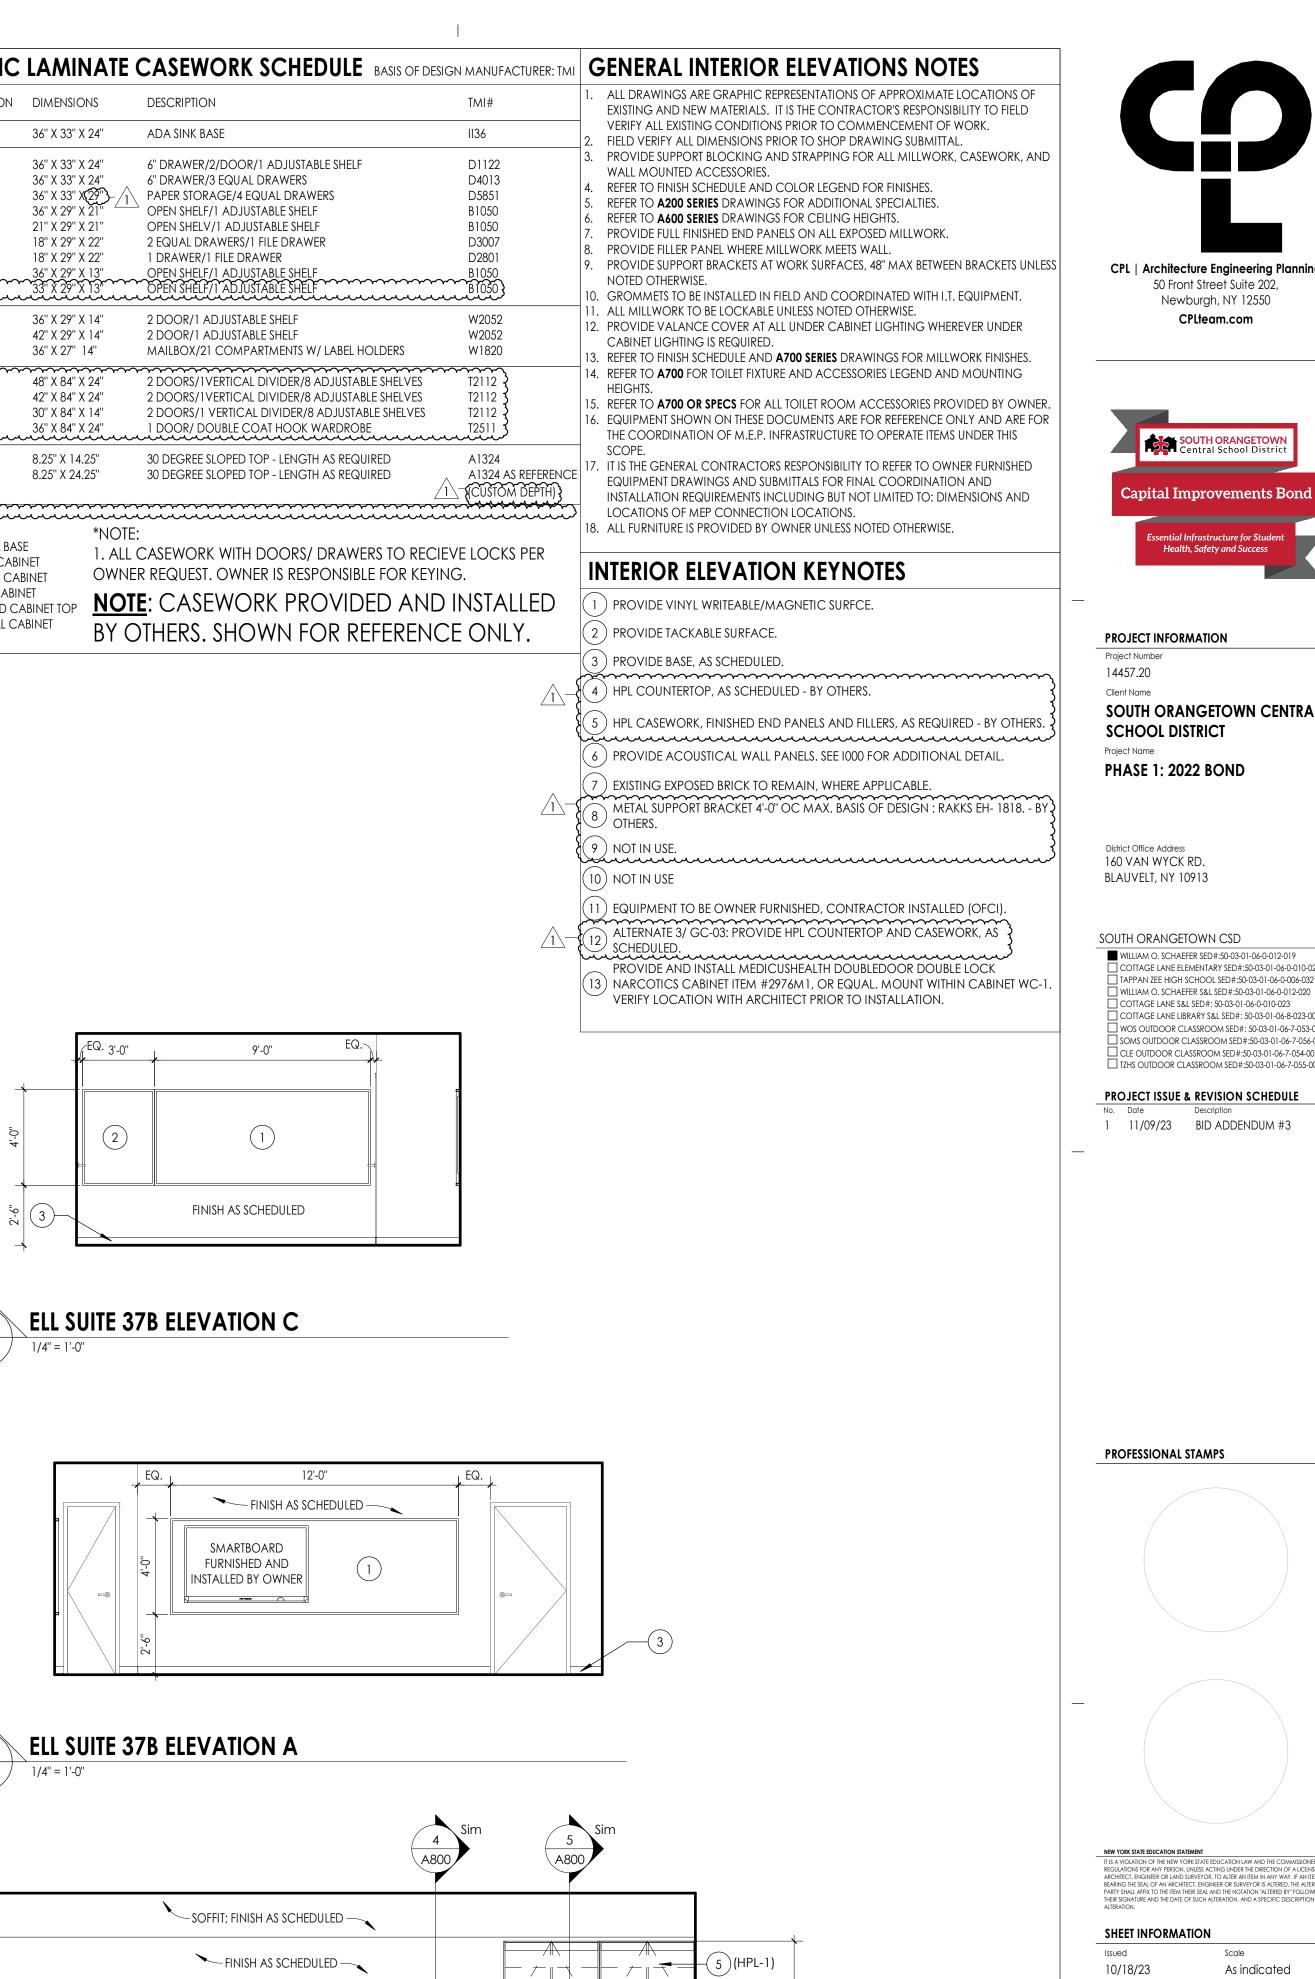


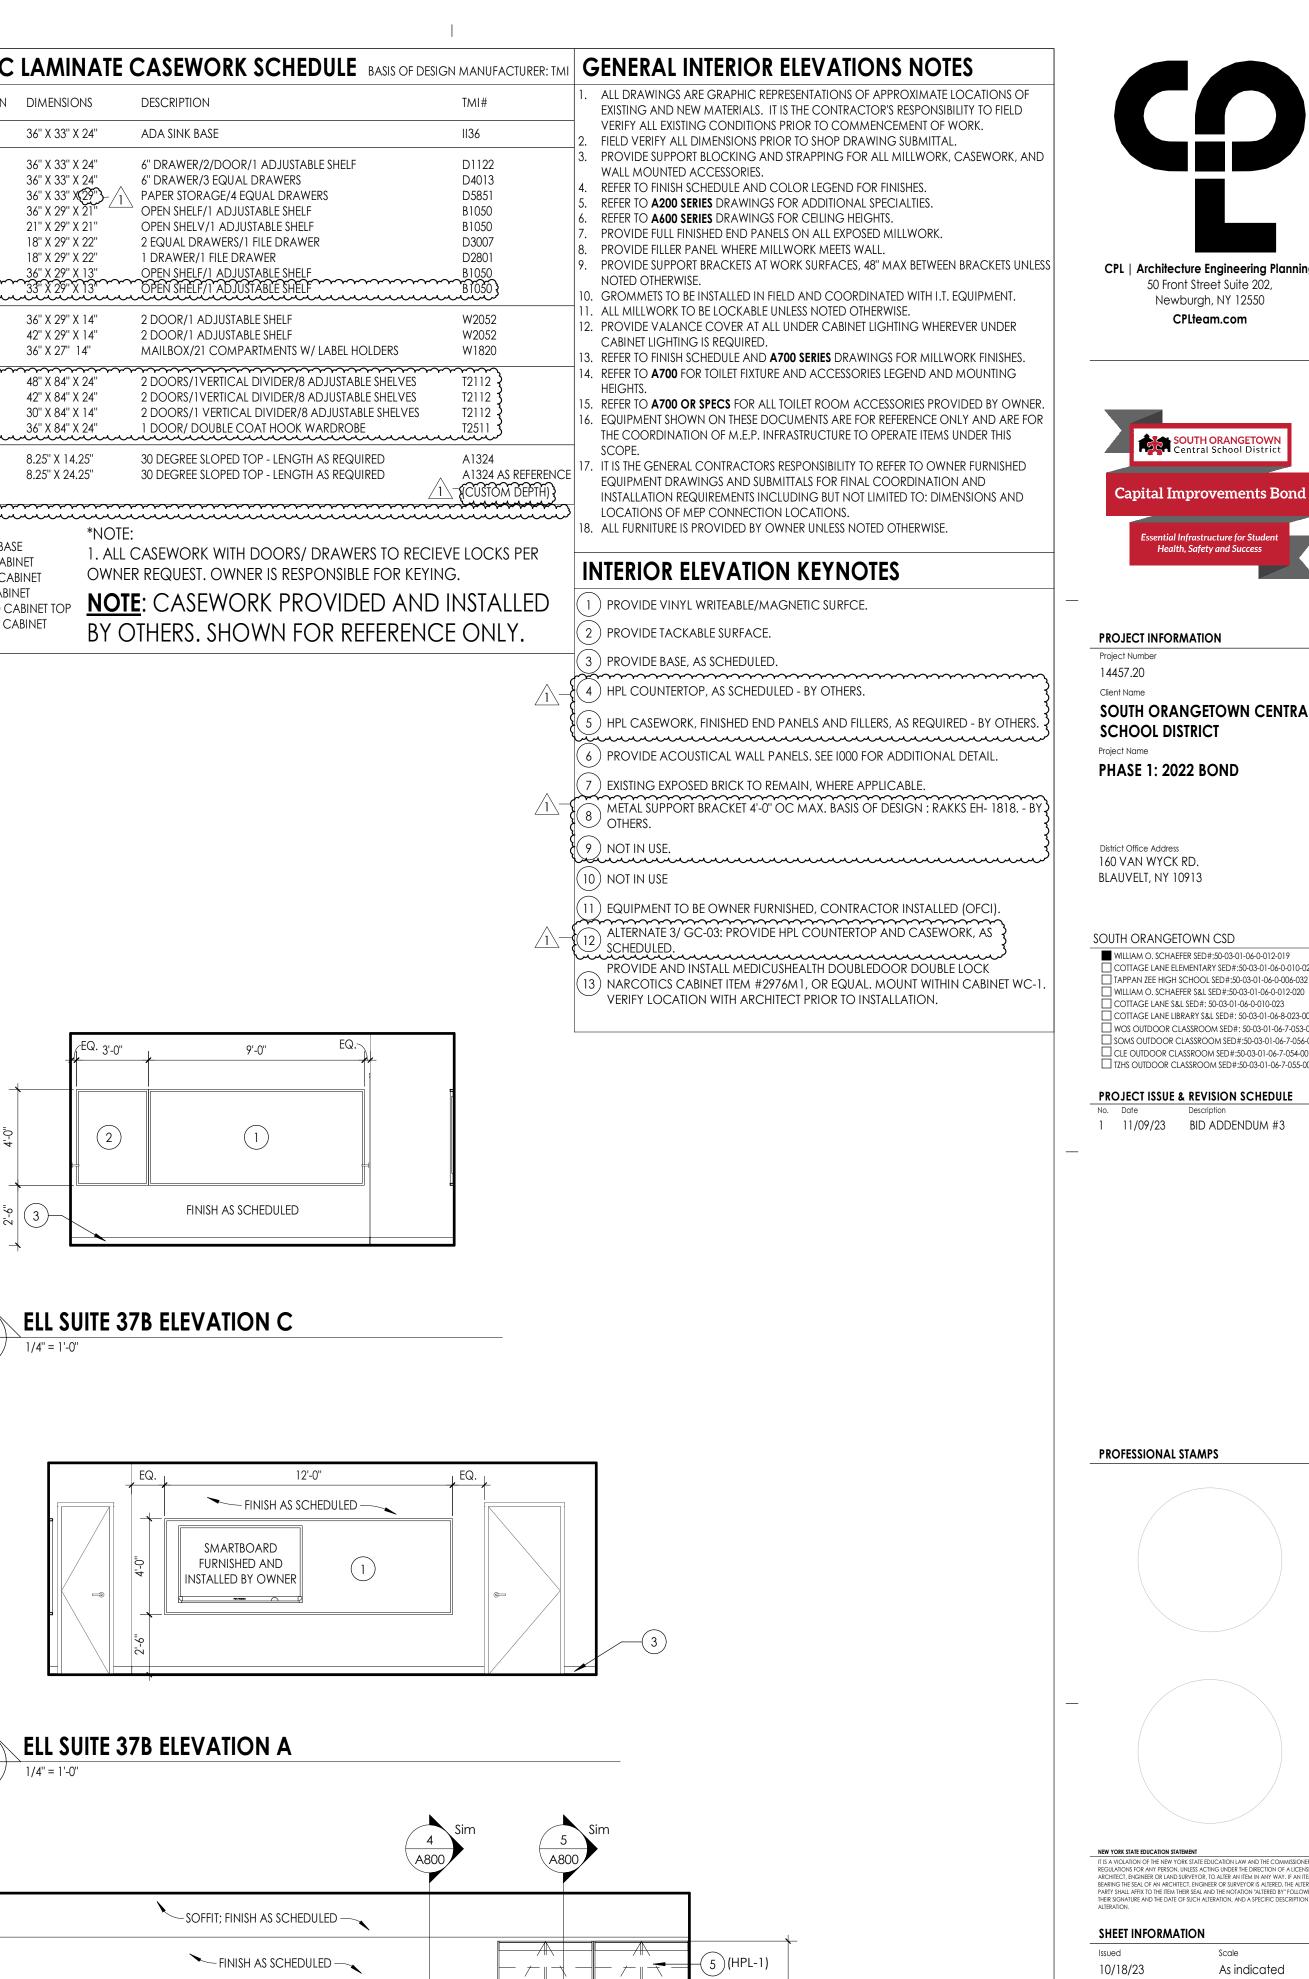


4)(HPL-2)

-(<u>5</u>)(HPL-1) ج

TC-1 48 x 84 x 24"

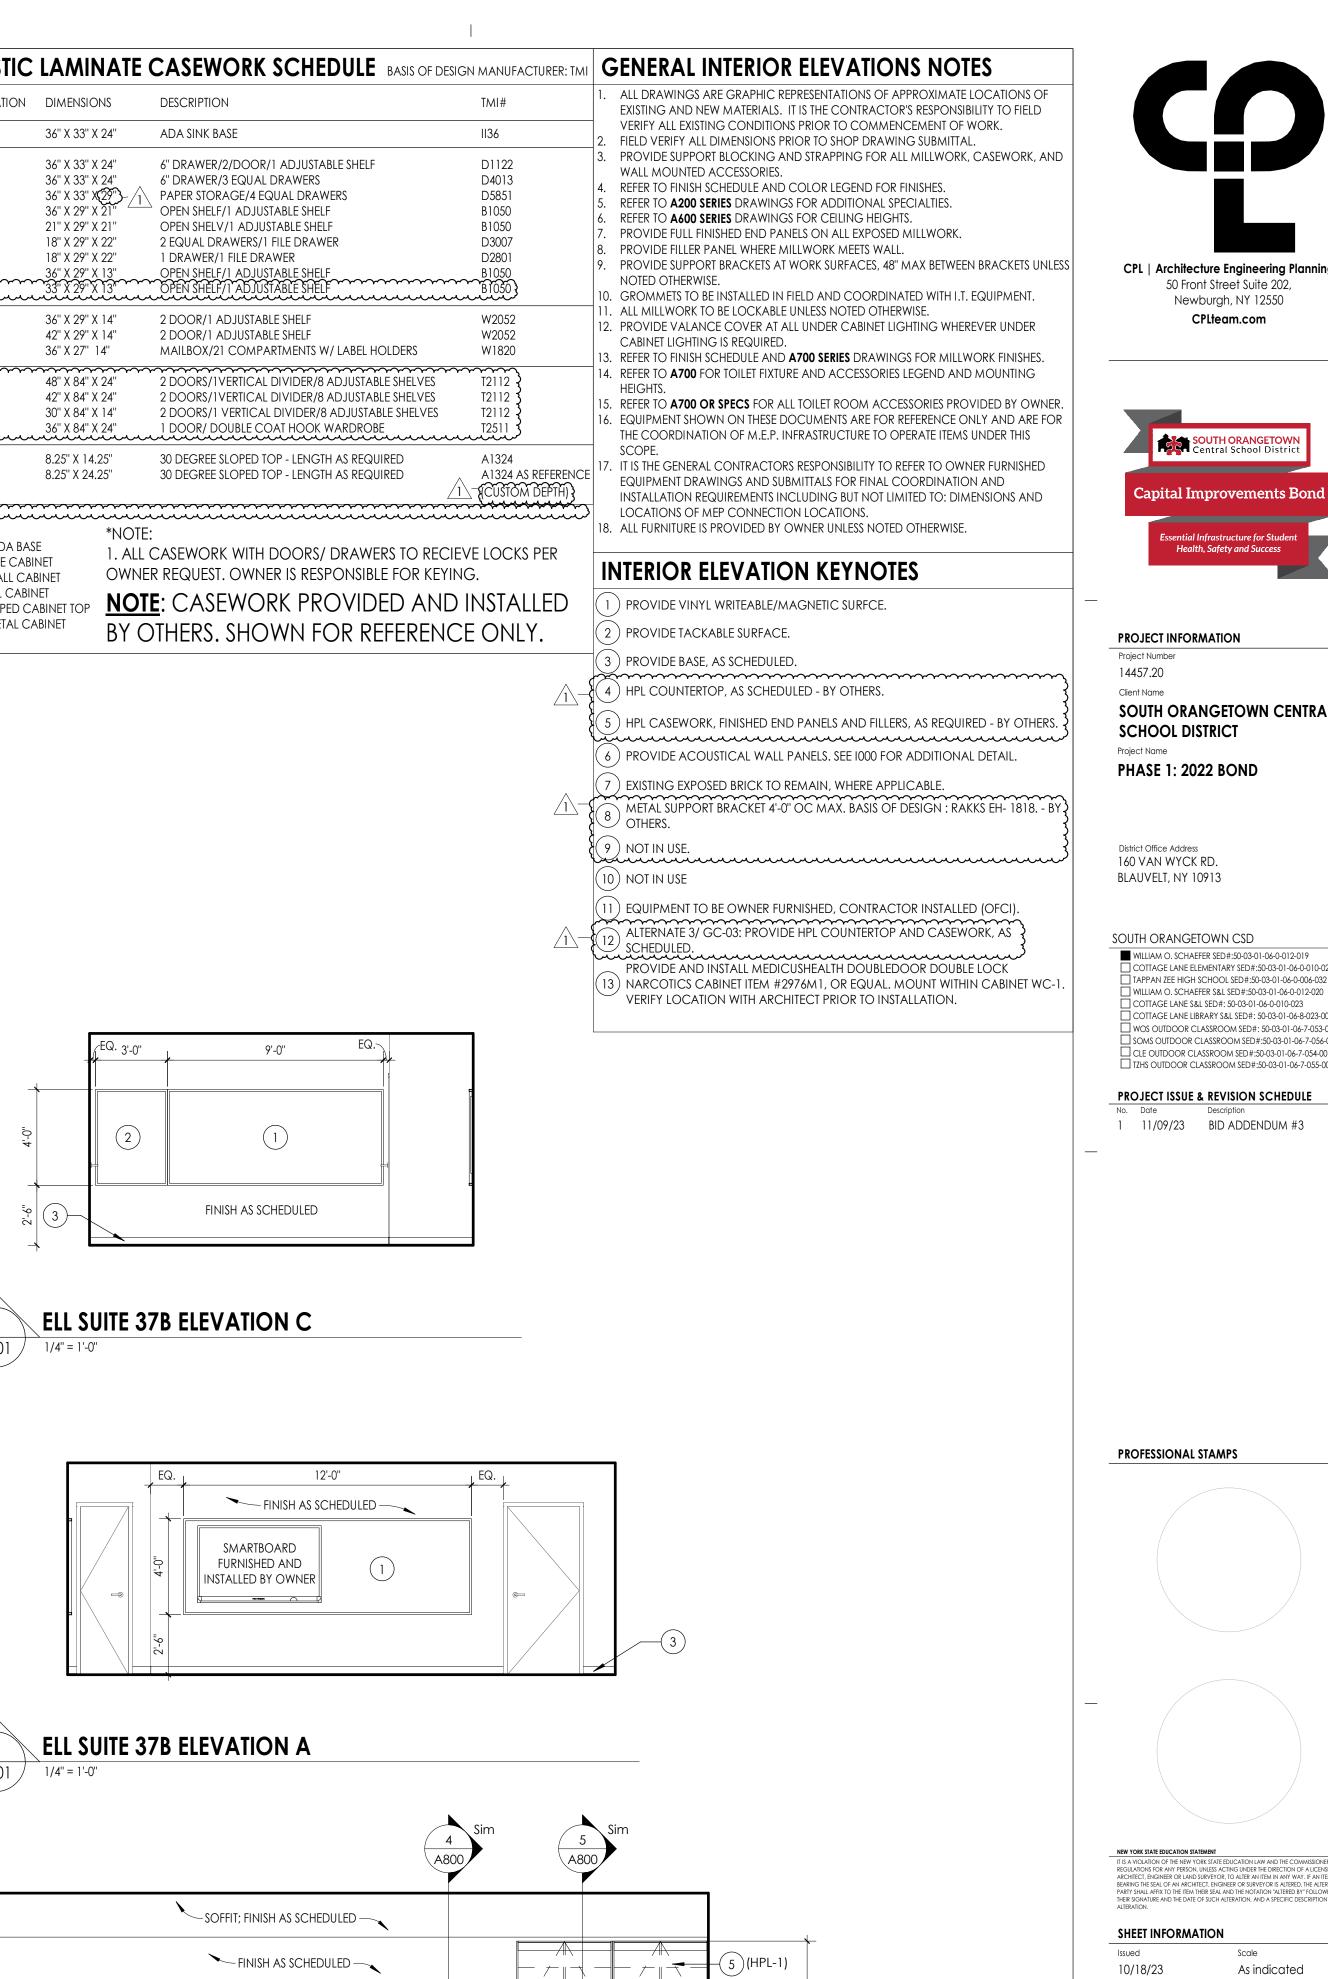

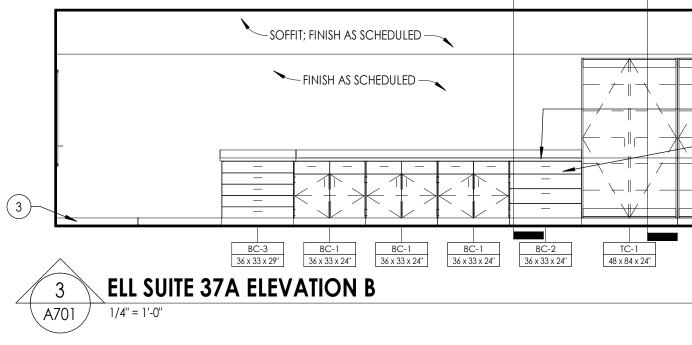

Drawn By


LF


Project Status BID DOCUMENTS

Checked By LT

Drawing Title ELL SUITE ENLARGED FLOOR PLANS AND INTERIOR Elevations

Drawing Number WOS A701

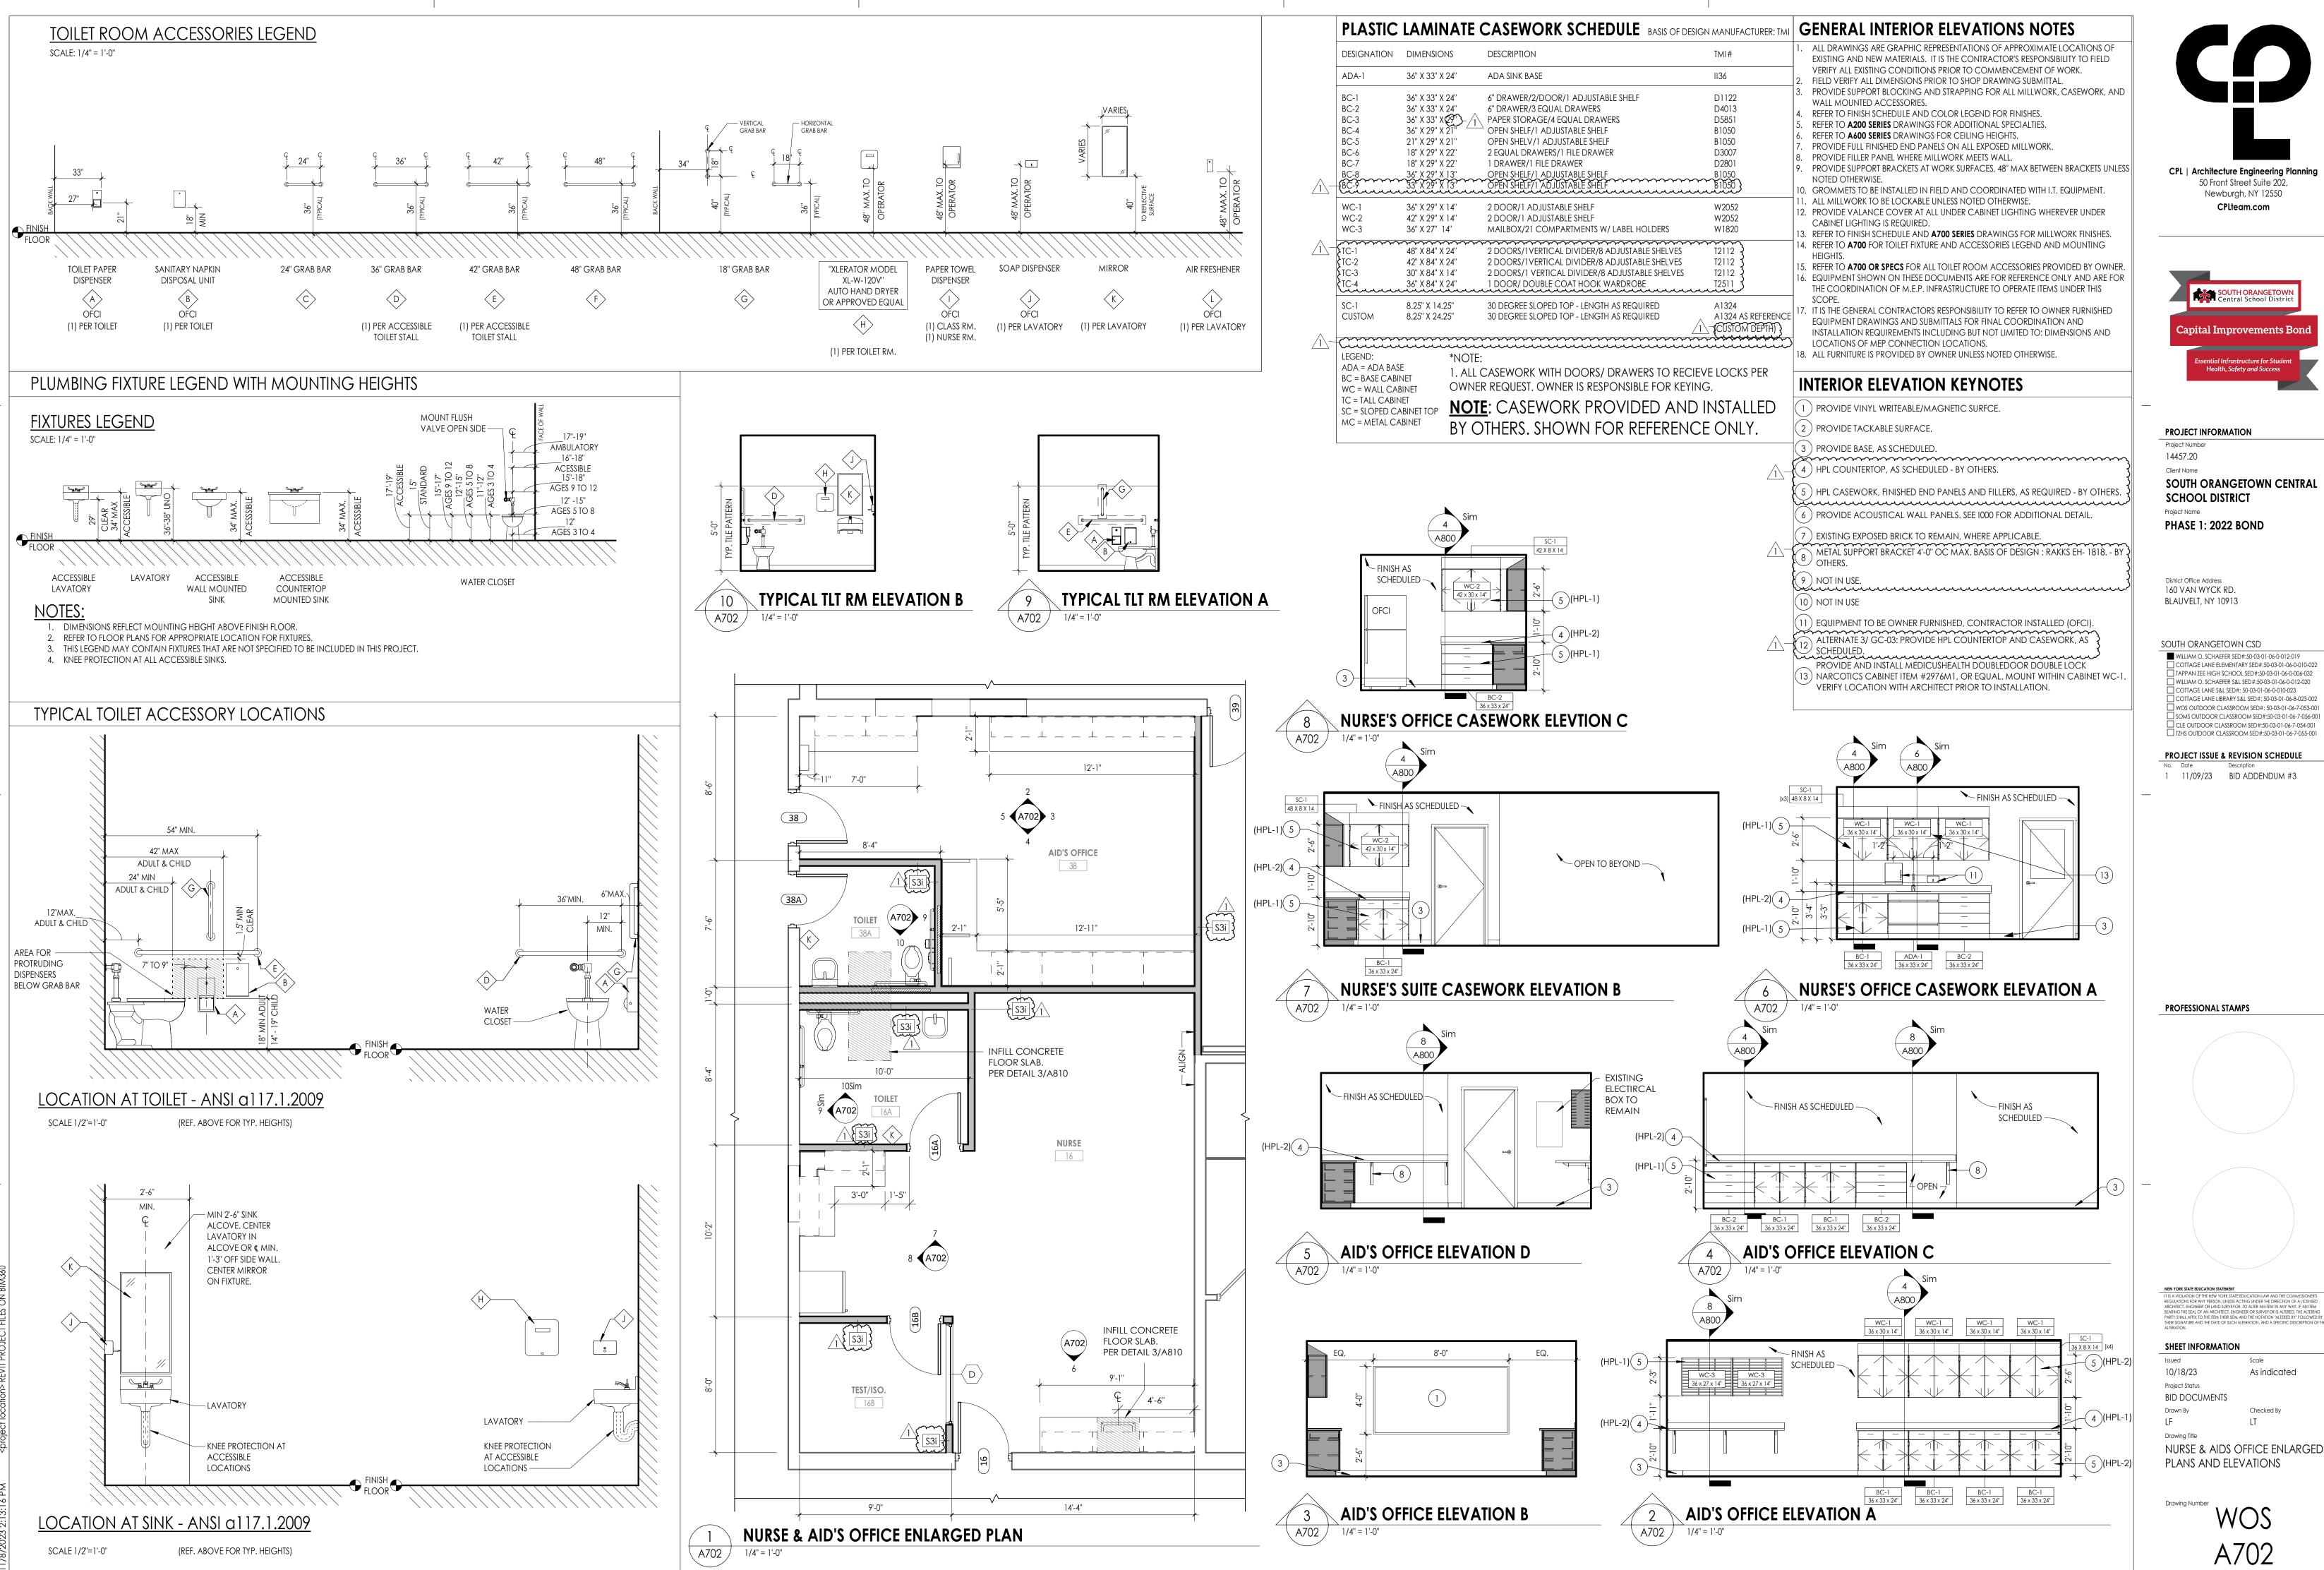

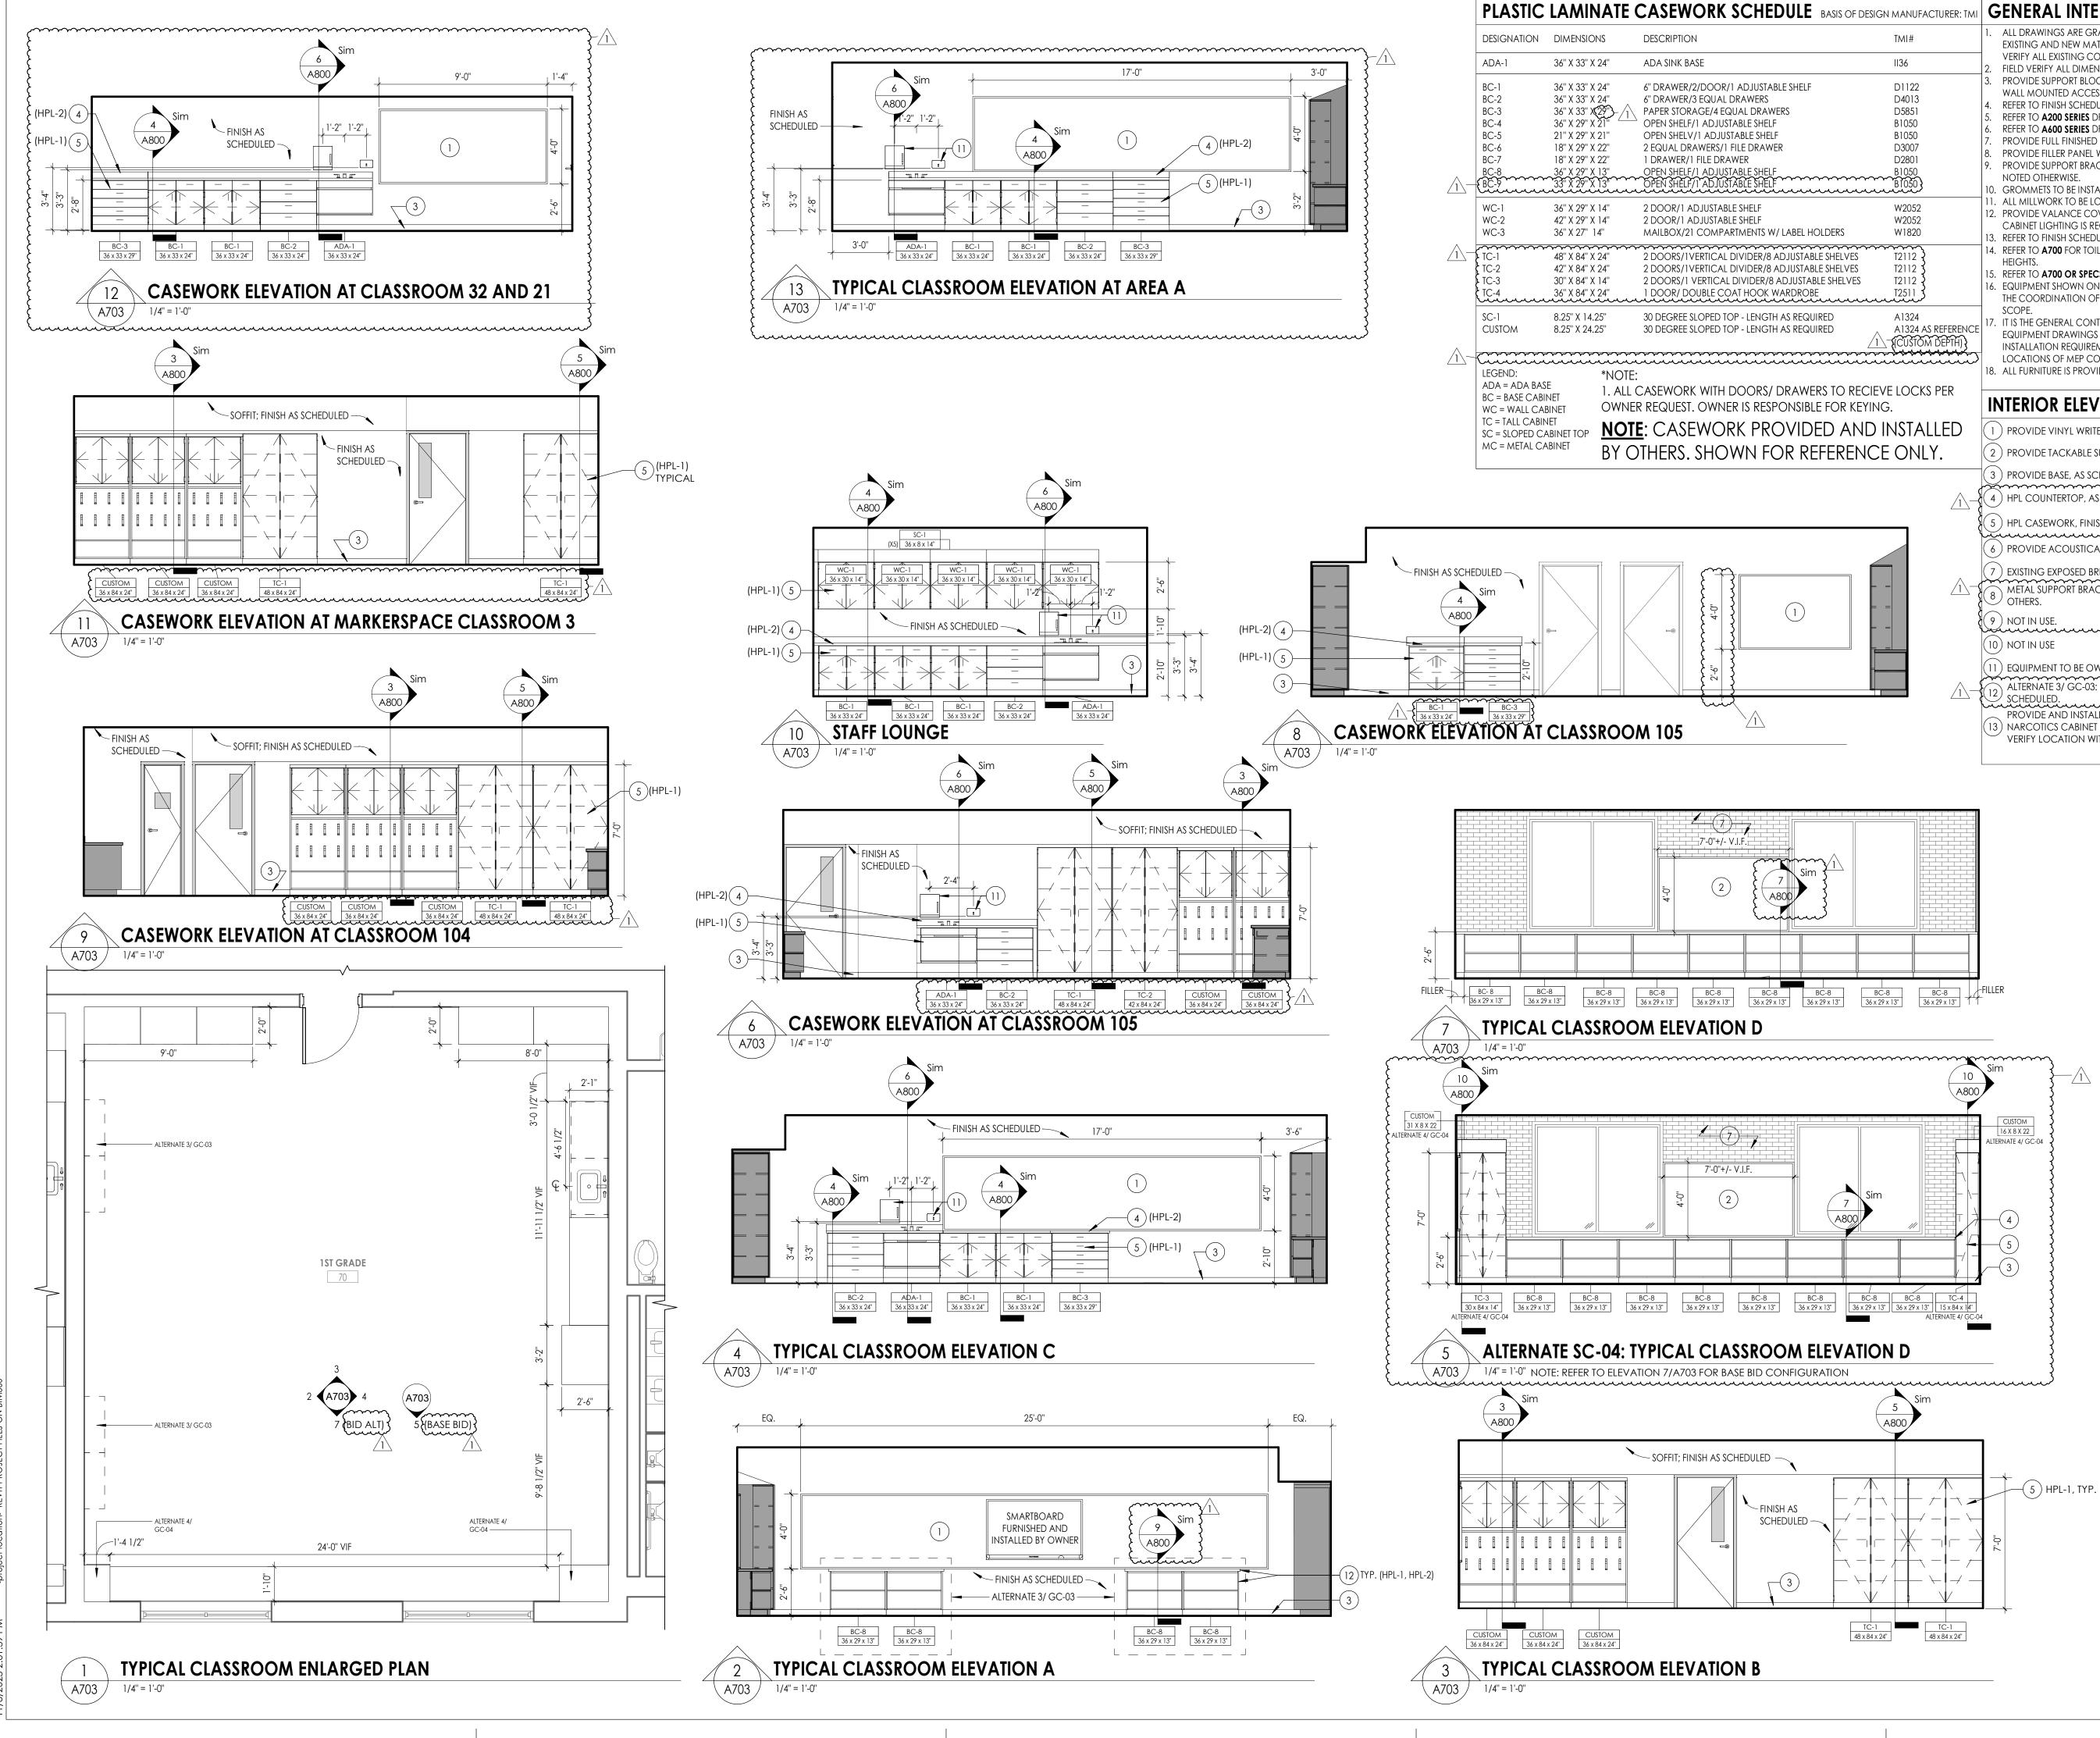

GENERAL INTERIOR ELEVATIONS NOTES

ALL DRAWINGS ARE GRAPHIC REPRESENTATIONS OF APPROXIMATE LOCATIONS OF EXISTING AND NEW MATERIALS. IT IS THE CONTRACTOR'S RESPONSIBILITY TO FIELD VERIFY ALL EXISTING CONDITIONS PRIOR TO COMMENCEMENT OF WORK.

- FIELD VERIFY ALL DIMENSIONS PRIOR TO SHOP DRAWING SUBMITTAL. PROVIDE SUPPORT BLOCKING AND STRAPPING FOR ALL MILLWORK, CASEWORK, AND WALL MOUNTED ACCESSORIES.
- REFER TO FINISH SCHEDULE AND COLOR LEGEND FOR FINISHES. REFER TO A200 SERIES DRAWINGS FOR ADDITIONAL SPECIALTIES.
- REFER TO A600 SERIES DRAWINGS FOR CEILING HEIGHTS. PROVIDE FULL FINISHED END PANELS ON ALL EXPOSED MILLWORK.
- PROVIDE FILLER PANEL WHERE MILLWORK MEETS WALL PROVIDE SUPPORT BRACKETS AT WORK SURFACES, 48" MAX BETWEEN BRACKETS UNLESS
- GROMMETS TO BE INSTALLED IN FIELD AND COORDINATED WITH I.T. EQUIPMENT.
- ALL MILLWORK TO BE LOCKABLE UNLESS NOTED OTHERWISE. PROVIDE VALANCE COVER AT ALL UNDER CABINET LIGHTING WHEREVER UNDER CABINET LIGHTING IS REQUIRED.
- . REFER TO FINISH SCHEDULE AND A700 SERIES DRAWINGS FOR MILLWORK FINISHES. 4. REFER TO A700 FOR TOILET FIXTURE AND ACCESSORIES LEGEND AND MOUNTING
- 5. REFER TO A700 OR SPECS FOR ALL TOILET ROOM ACCESSORIES PROVIDED BY OWNER. . EQUIPMENT SHOWN ON THESE DOCUMENTS ARE FOR REFERENCE ONLY AND ARE FOR THE COORDINATION OF M.E.P. INFRASTRUCTURE TO OPERATE ITEMS UNDER THIS
- IT IS THE GENERAL CONTRACTORS RESPONSIBILITY TO REFER TO OWNER FURNISHED EQUIPMENT DRAWINGS AND SUBMITTALS FOR FINAL COORDINATION AND INSTALLATION REQUIREMENTS INCLUDING BUT NOT LIMITED TO: DIMENSIONS AND LOCATIONS OF MEP CONNECTION LOCATIONS. ALL FURNITURE IS PROVIDED BY OWNER UNLESS NOTED OTHERWISE.

INTERIOR ELEVATION KEYNOTES

) PROVIDE VINYL WRITEABLE/MAGNETIC SURFCE.

- 2) PROVIDE TACKABLE SURFACE.
- 3) PROVIDE BASE, AS SCHEDULED.
- \leq) HPL COUNTERTOP, AS SCHEDULED - BY OTHERS.
-) HPL CASEWORK, FINISHED END PANELS AND FILLERS, AS REQUIRED BY OTHERS. (6) PROVIDE ACOUSTICAL WALL PANELS. SEE 1000 FOR ADDITIONAL DETAIL.
-) EXISTING EXPOSED BRICK TO REMAIN, WHERE APPLICABLE. ᠵᡬ᠊ᠬ᠇᠇᠇᠇᠇᠇᠇᠇᠇᠇᠇᠇᠇᠇᠇᠇᠇᠇᠇᠇᠇᠇᠇᠇᠇᠇᠇᠇᠇᠇᠇᠇᠇᠇ METAL SUPPORT BRACKET 4'-0" OC MAX. BASIS OF DESIGN : RAKKS EH- 1818. - BY

- 1) EQUIPMENT TO BE OWNER FURNISHED, CONTRACTOR INSTALLED (OFCI). $\overline{}$ ALTERNATE 3/ GC-03: PROVIDE HPL COUNTERTOP AND CASEWORK, AS
- SCHEDULED. PROVIDE AND INSTALL MEDICUSHEALTH DOUBLEDOOR DOUBLE LOCK 3) NARCOTICS CABINET ITEM #2976M1, OR EQUAL. MOUNT WITHIN CABINET WC-1. VERIFY LOCATION WITH ARCHITECT PRIOR TO INSTALLATION.



PROJECT INFORMATION Project Numbe 14457.20 Client Name SOUTH ORANGETOWN CENTRAL


SCHOOL DISTRICT Project Name **PHASE 1: 2022 BOND**

District Office Address 160 VAN WYCK RD. BLAUVELT, NY 10913

SOUTH ORANGETOWN CSD WILLIAM O. SCHAEFER SED#:50-03-01-06-0-012-019 COTTAGE LANE ELEMENTARY SED#:50-03-01-06-0-010-022 TAPPAN ZEE HIGH SCHOOL SED#:50-03-01-06-0-006-032 WILLIAM O. SCHAEFER S&L SED#:50-03-01-06-0-012-020 COTTAGE LANE S&L SED#: 50-03-01-06-0-010-023 OTTAGE LANE LIBRARY S&L SED#: 50-03-01-06-8-023-002 WOS OUTDOOR CLASSROOM SED#: 50-03-01-06-7-053-001 SOMS OUTDOOR CLASSROOM SED#:50-03-01-06-7-056-001 CLE OUTDOOR CLASSROOM SED#:50-03-01-06-7-054-001 TZHS OUTDOOR CLASSROOM SED#:50-03-01-06-7-055-001

PROJECT ISSUE & REVISION SCHEDUL 1 11/09/23 BID ADDENDUM #3

PROFESSIONAL STAMPS

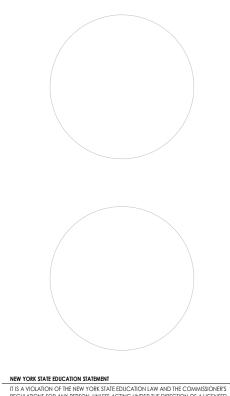

SHEET INFORMATION Issued

Drawn By

Drawing Title

LF


Scale 10/18/23 As indicated Project Status **BID DOCUMENTS**


Checked By


ΙT

ENLARGED FLOOR PLANS AND INTERIOR ELEVATIONS

Drawing Number WOS A703

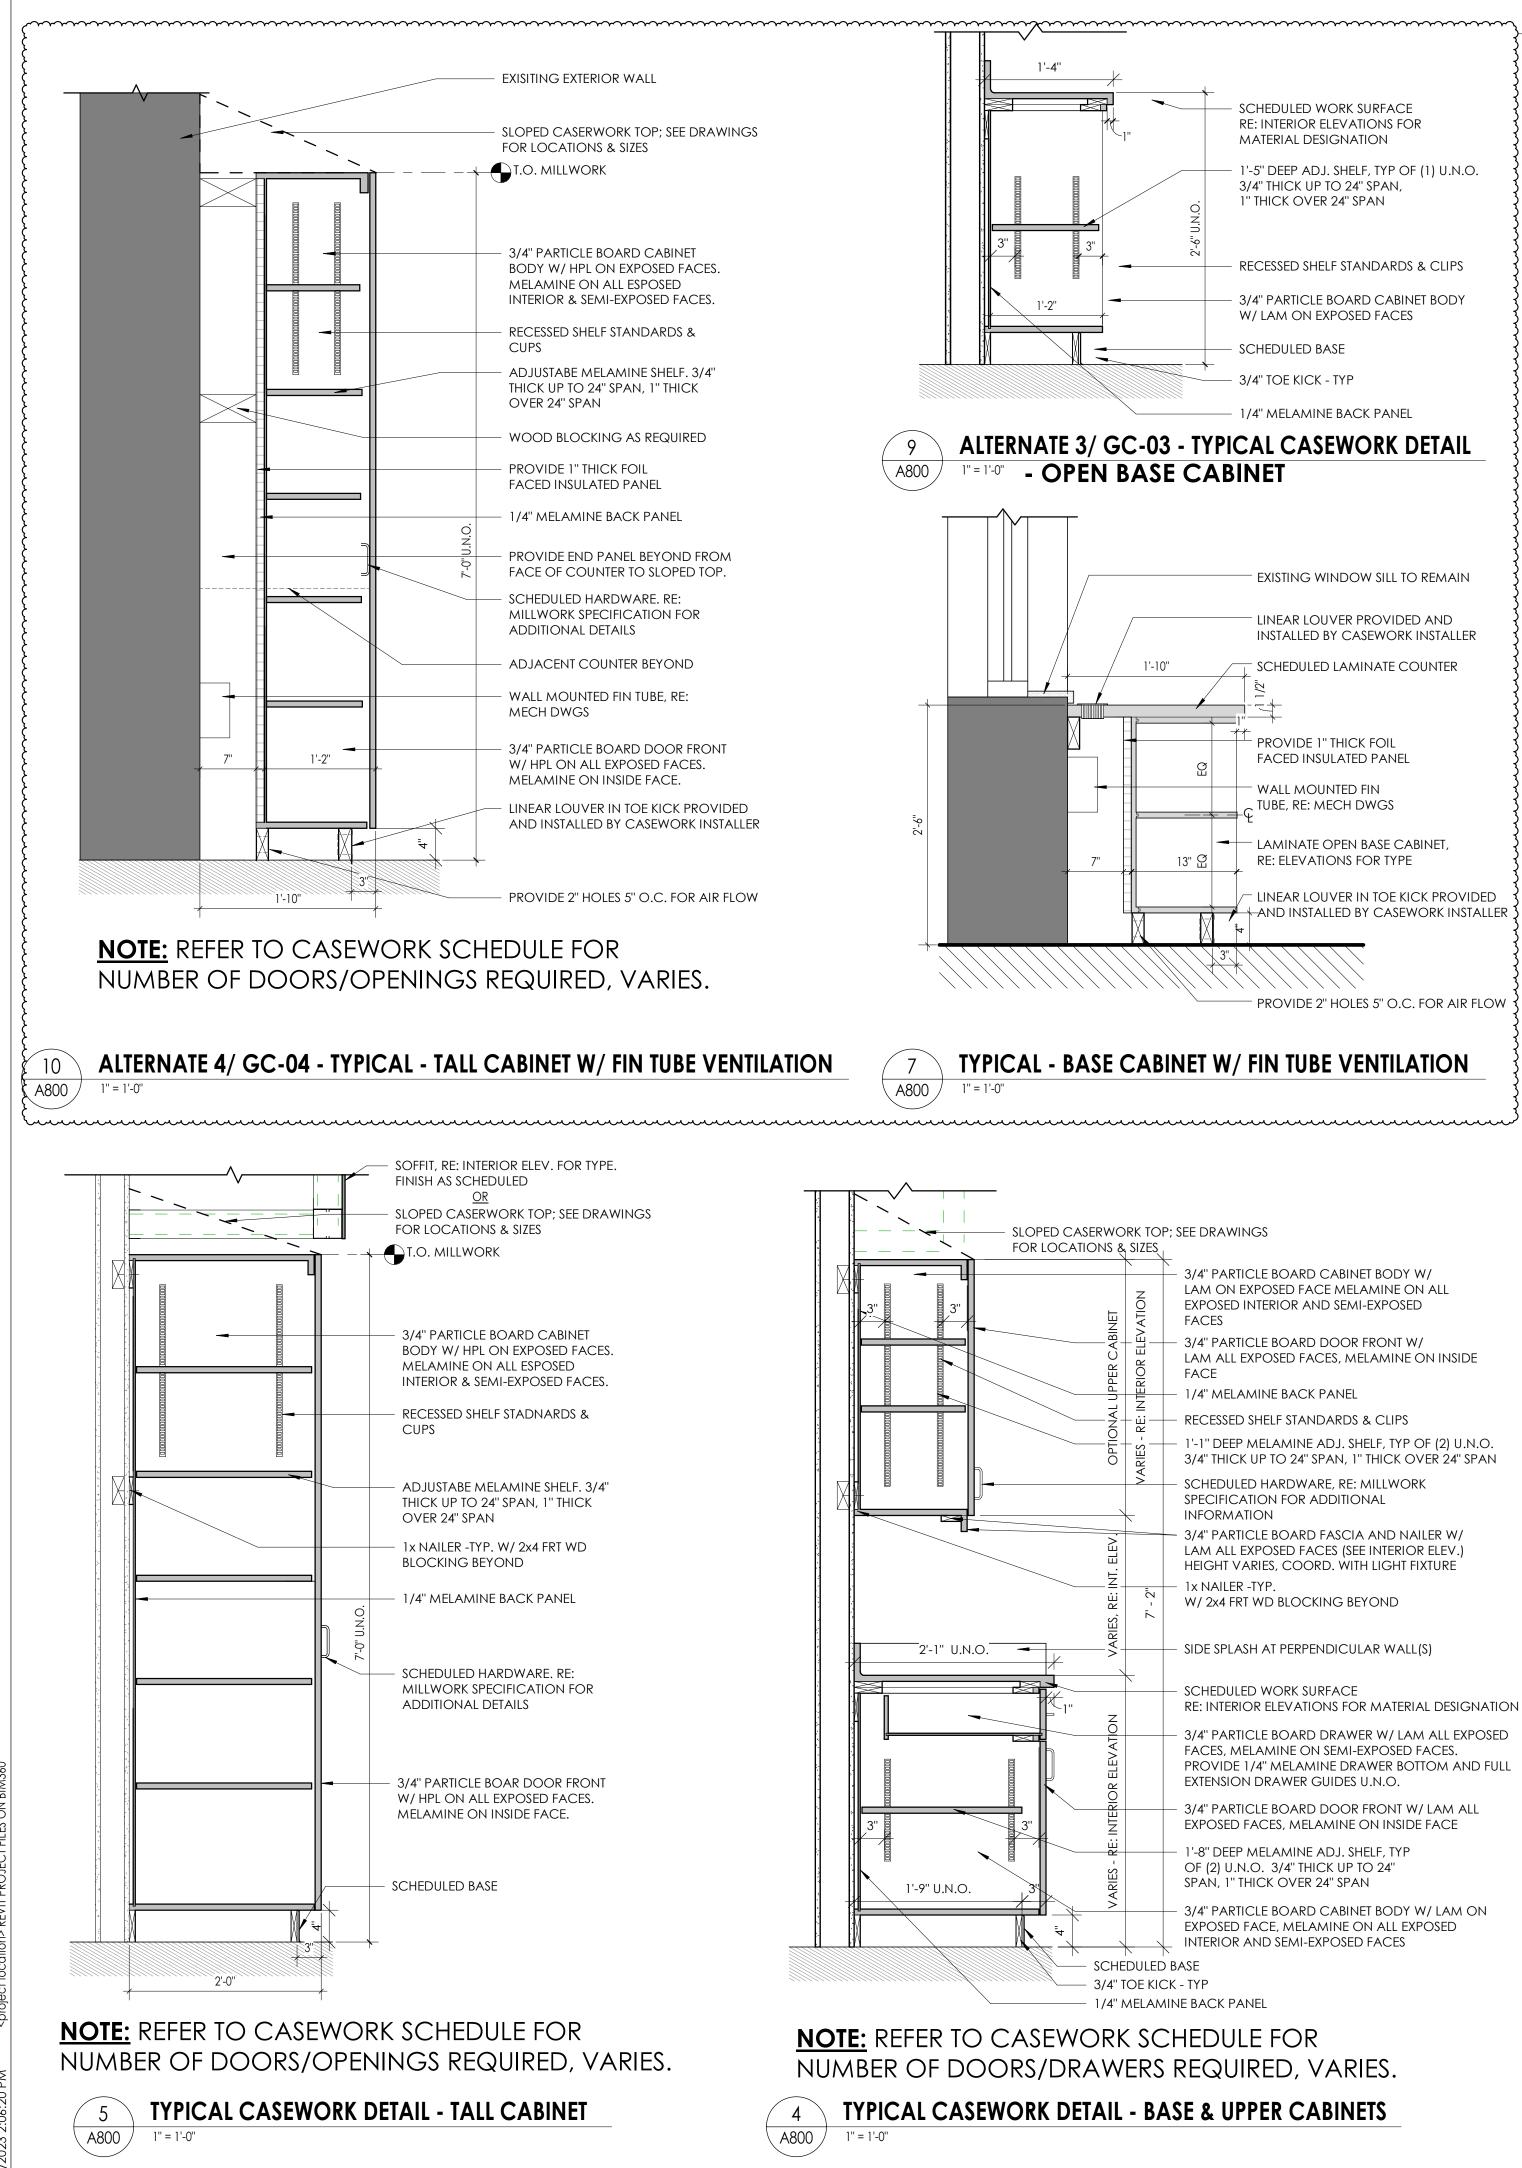

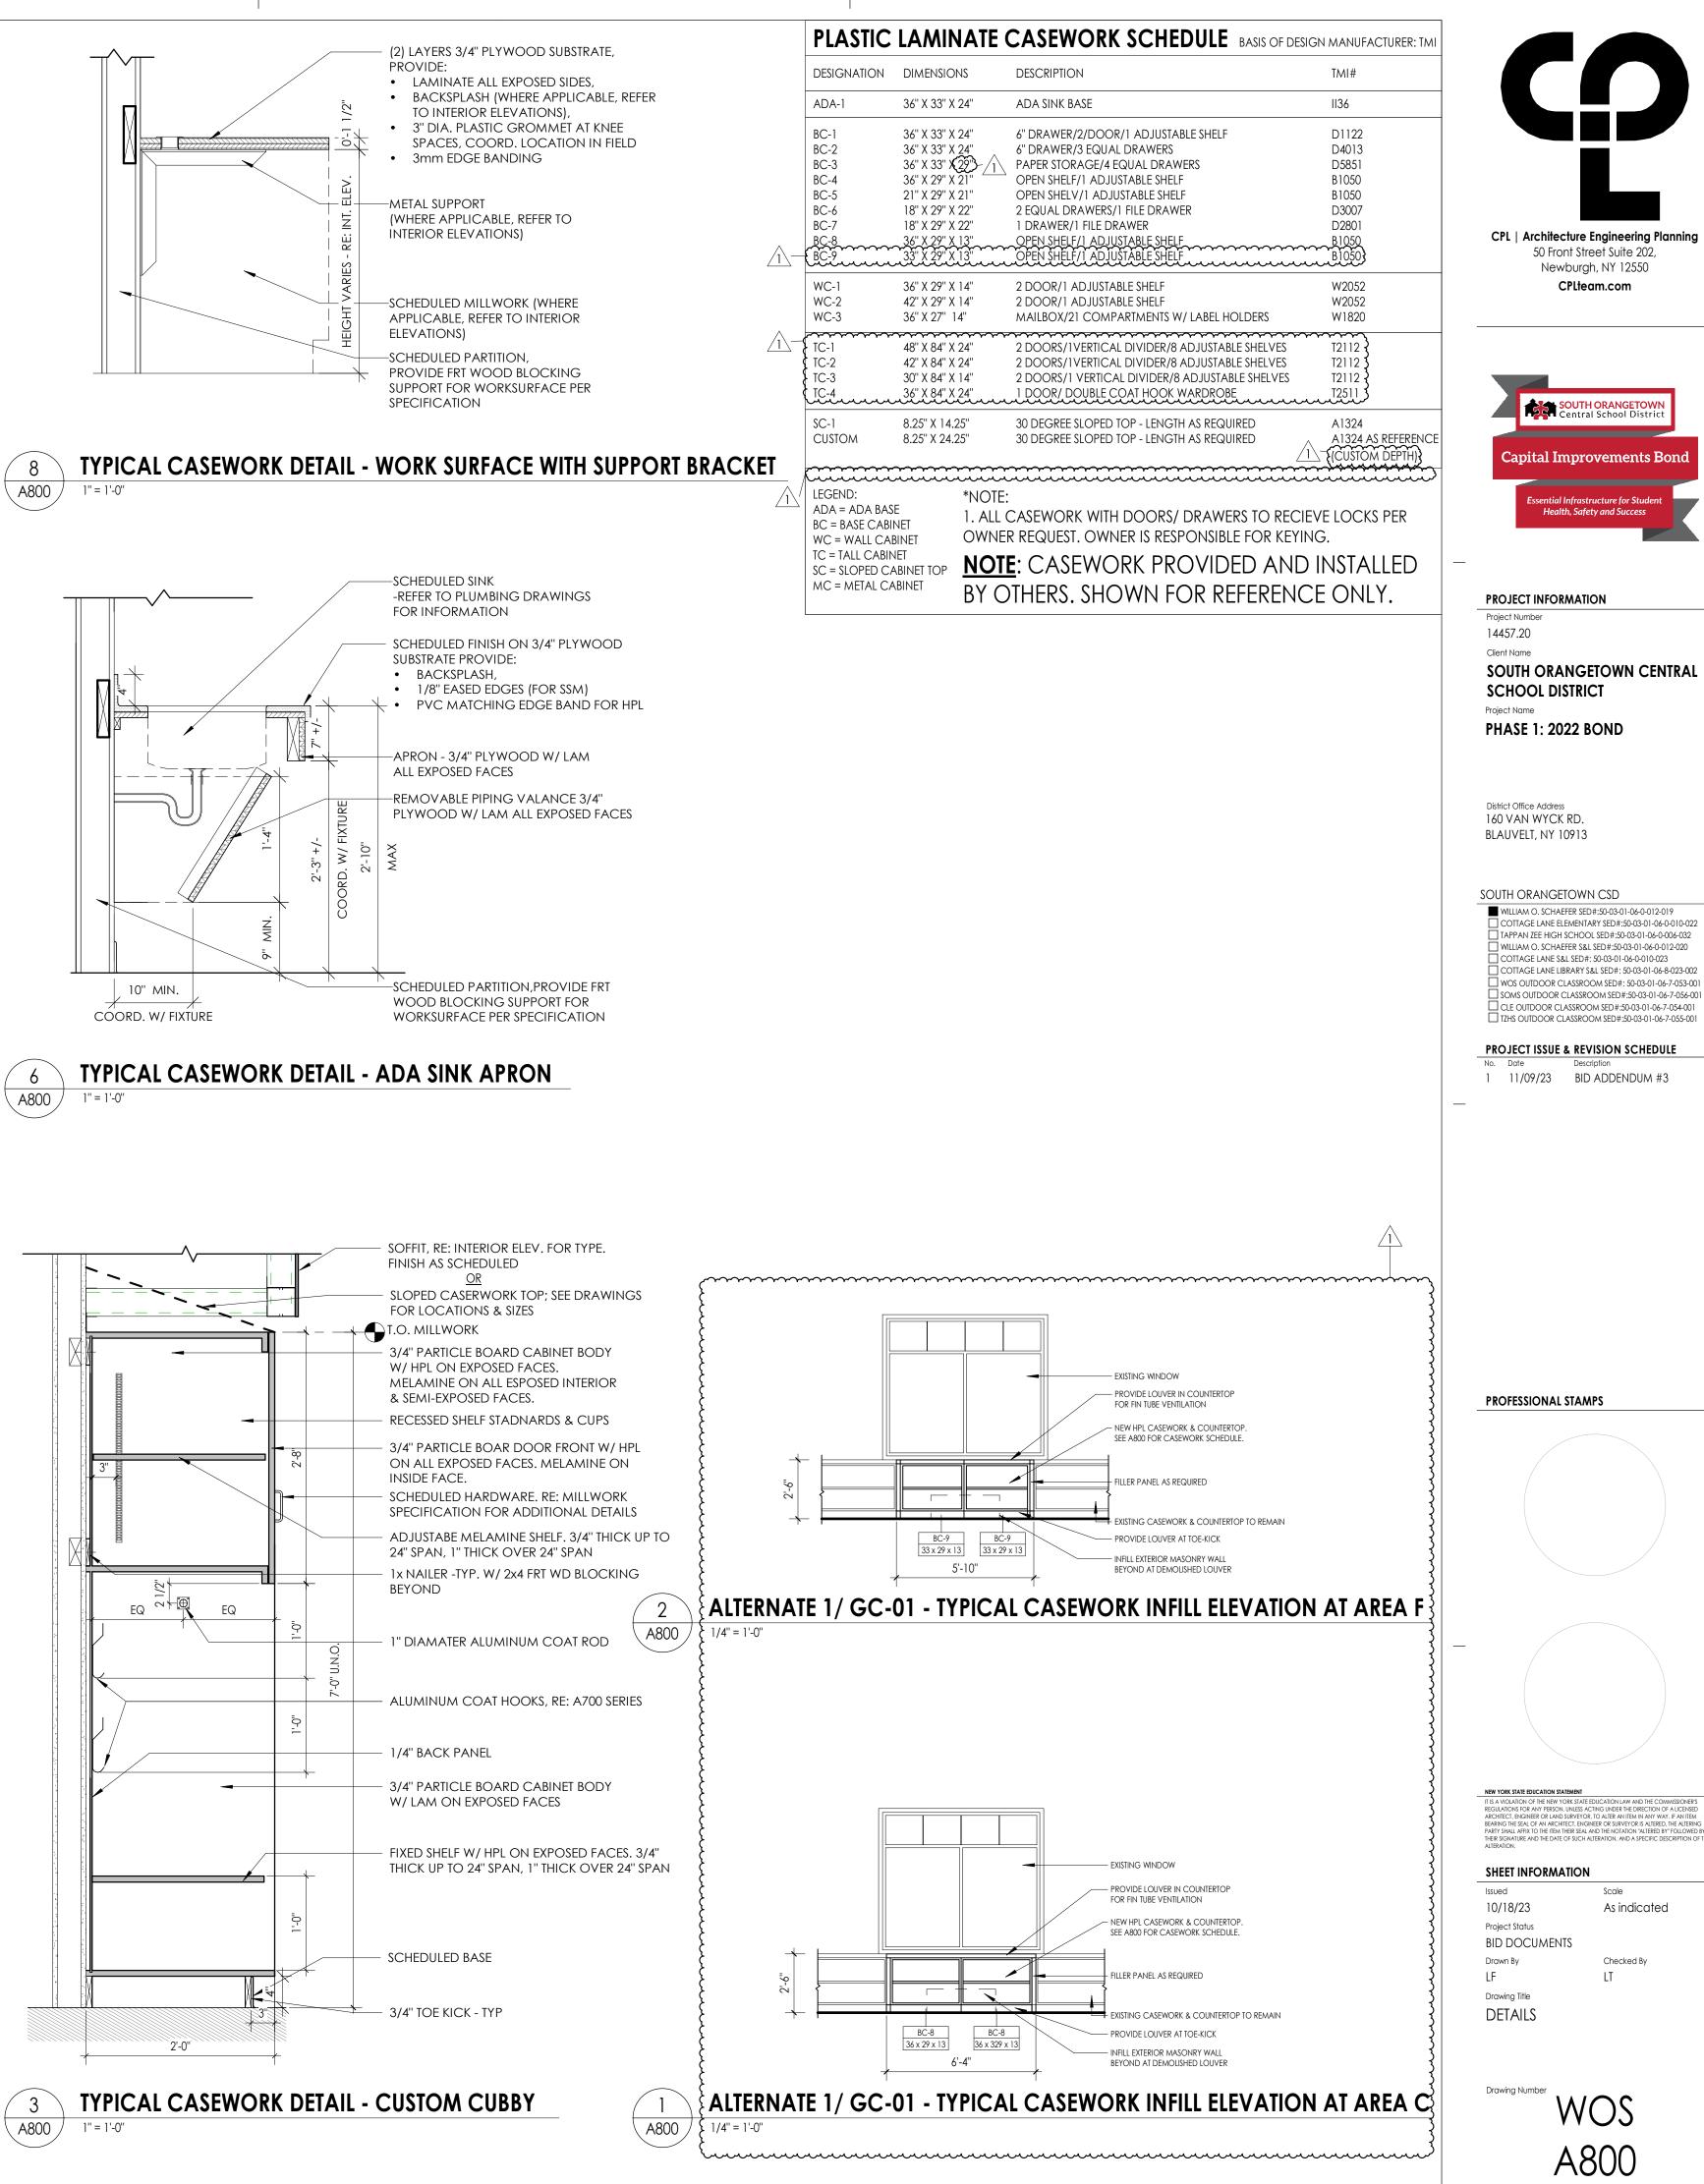


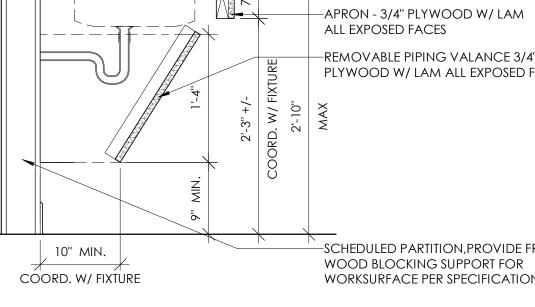


A800






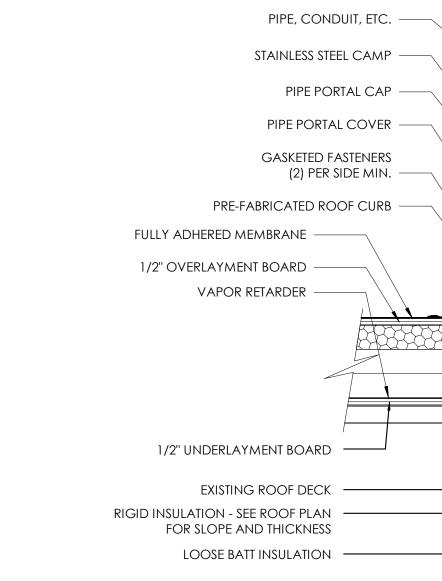



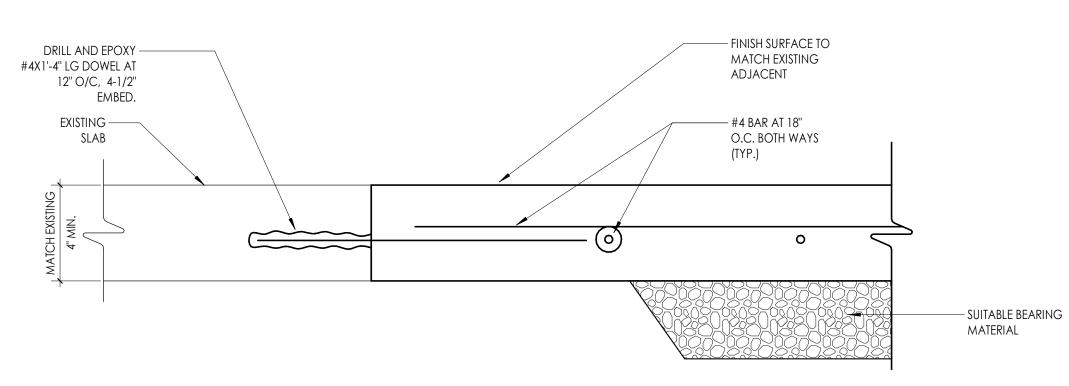





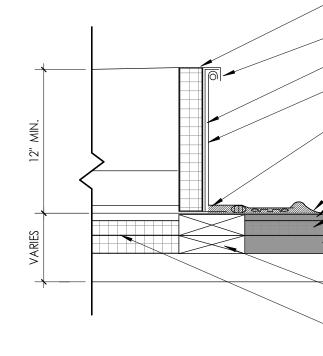





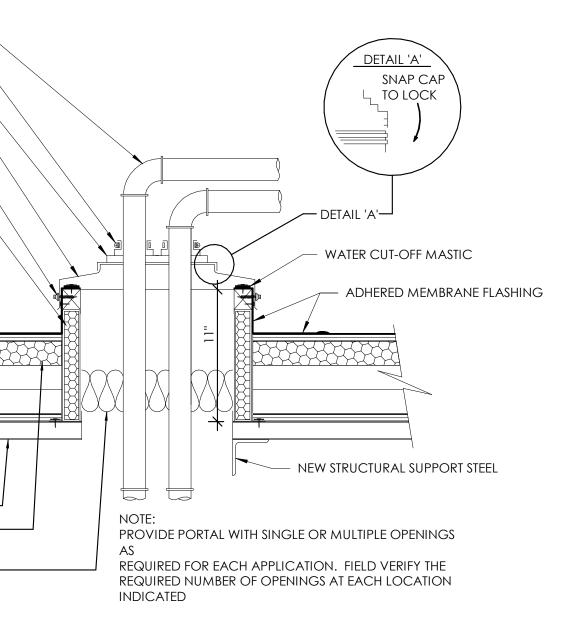

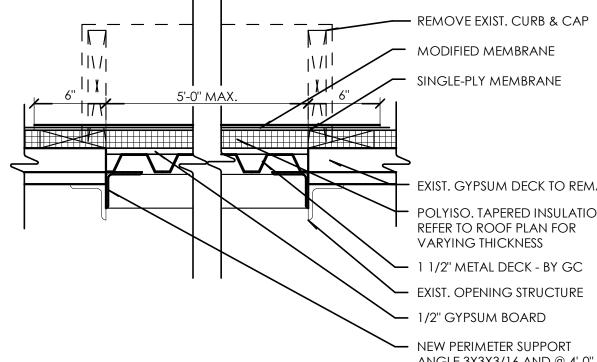


- MODIFIED MEMBRANE · SINGLE-PLY MEMBRANE

EXIST. GYPSUM DECK TO REMAIN - POLYISO. TAPERED INSULATION REFER TO ROOF PLAN FOR VARYING THICKNESS

→ 1 1/2" METAL DECK - BY GC EXIST. OPENING STRUCTURE ∽ 1/2" GYPSUM BOARD


- NEW PERIMETER SUPPORT ANGLE 3X3X3/16 AND @ 4'-0'' O.C. - WELD ANGLE TO EXIST. OPENING STRUCTURE

TYPICAL ROOF DECK INFILL DETAIL 4 A810 1 1/2" = 1'-0"

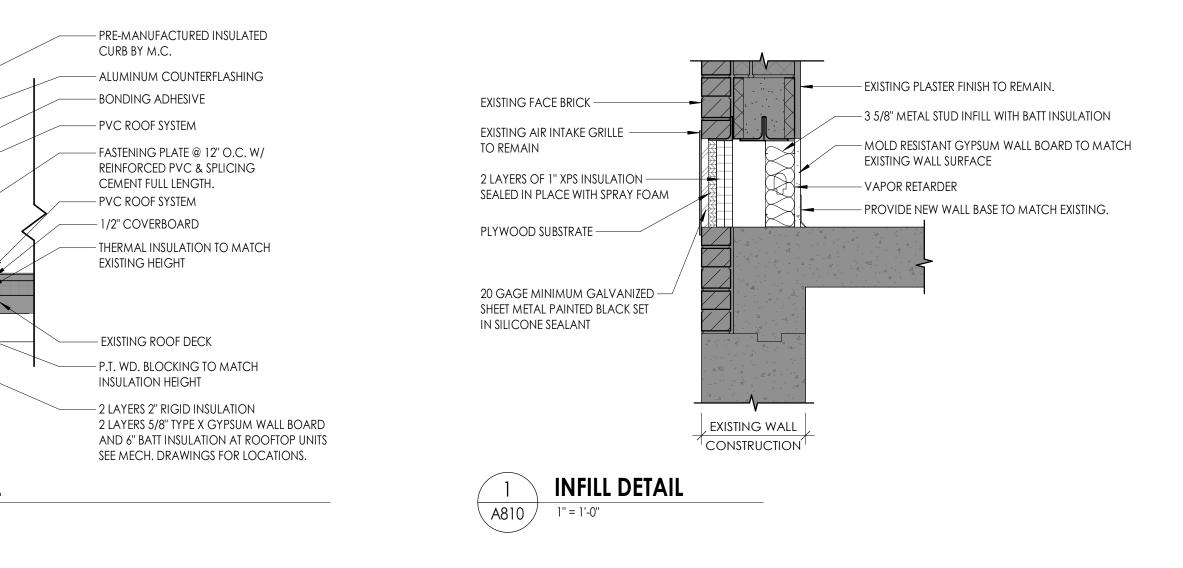

	PARTITION GENERAL NOTES	
	 ALL WALL TYPES MAY NOT BE USED ON THIS PROJECT. UNLESS NOTED OTHERWISE ALL PARTITIONS ARE FULL HEIGHT, EXTEND & SECURE TO UNDERSIDE OF CONCRETE OR METAL DECK ABOVE. 	
	 PROVIDE UL APPROVED JOINT AT ALL TOP OF WALL AND WALL TO WALL CONDITIONS AT ALL RATED WALLS. 	
	 PROVIDE DEFLECTION TRACKS AT METAL STUD PARTITIONS THAT TERMINATE AT THE UNDERSIDE OF STRUCTURE AND DECK. 	
	 REFER TO CODE/LIFE SAFETY DRAWINGS FOR RATED PARTITIONS AND UL ASSEMBLIES. REFER TO INTERIOR DRAWINGS FOR LOCATIONS OF WALL TILE, AND OTHER SPECIALTY WALL FINISHES. 	
	 REFER TO INTERNOR DRAWINGS FOR ECCATIONS OF WALL TIEL, AND OTHER SECOND THE SECOND STORE STATE TO A CONTRACT TO A CONTRACT OF THE SECOND STORE AND OTHER WALL THE SECOND STORE AND OTHER WET PROVIDE MOISTURE RESISTANT GYP. BD. AT ALL TOILET ROOMS, JANITOR'S CLOSETS AND OTHER WET 	
	LOCATIONS WHERE TILE AND TILE BACKER BOARD ARE NOT INSTALLED.	CPL Architecture Engineering Planning
	8. PARTITION TYPES WITH ONE SIDE OF DOUBLE DRYWALL TO BE PLACED SO THAT THE DOUBLE SIDE IS ON CORRIDOR AND/OR HIGH TRAFFIC SIDE OF WALL.	50 Front Street Suite 202, Newburgh, NY 12550
	 REFER TO SPECIFICATIONS FOR METAL STUD GAUGE REQUIREMENTS. COORDINATE ALL PARTITION ACCESSORIES (APPLIED FINISHES, RESILIENT CHANNEL, ADDITIONAL 	CPLteam.com
	LAYERS OF SHEATHING, SHIELDING, ETC.) ITEMS SHOWN IN TYPICAL WALL CONSTRUCTION DETAILS MAY HAVE TO BE ARRANGED ON DIFFERENT SIDES OF WALL ASSEMBLY TO ACHIEVE FLUSH	
	CONTINUOUS WALL SURFACES. ANY CONFLICTS SHOULD BE BROUGHT TO THE ATTENTION OF THE ARCHITECT.	
	11. FIRESTOP/ SMOKE STOP ALL REQUIRED WALL PARTITIONS, SLABS, AND PENETRATIONS THROUGH NEW AND EXISTING WALLS WITHIN THE PROJECT LIMITS IN COORDINATION WITH CODE PLAN, OR WHERE	
J	COORDINATED SYSTEMS CONNECTION POINTS ARE LOCATED OUTSIDE THE PROJECT LIMIT AREA. SEE ARCHITECTURAL, MECHANICAL, ELECTRICAL, PLUMBING DRAWINGS AND SPECIFICATION DIVISION	SOUTH ORANGETOWN Central School District
	7. 12. NOTIFY OWNER AND ARCHITECT IF EXISTING NON-COMPLIANT PENETRATIONS ARE DISCOVERED NOT	Conital Immunum onto Don d
	FIRESTOPPPED IN COORDINATION WITH CODE PLAN. 13. PROVIDE CONTROL JOINT WHERE NEW PARTITIONS BUTT EXISTING CONSTRUCTION.	Capital Improvements Bond
	 PROVIDE CONTROL JOINTS A MAXIMUM OF 30'-0" APART UNLESS NOTED OTHERWISE, PER ASTM C 840-17A. LOCATE ABOVE DOOR FRAMES WHERE POSSIBLE. 	Essential Infrastructure for Student Health, Safety and Success
	 PROVIDE SUPPORT BLOCKING AND STRAPPING FOR ALL MILLWORK, CASEWORK, AND WALL MOUNTED ACCESSORIES. 	
		—
		PROJECT INFORMATION
		Project Number 14457.20

		5"	10MINAL 4 7/8"	m
SECTION AT STRUCTURE			STRUCTURAL DECK	~~~~~~~~~~~~~~~~~~~~~~~~~~~~~~~~~~~~~~~
			3 5/8" DEFLECTION TRACK SECURED TO STRUCT. (RATED WALLS TO HAVE FIRE STOP TRACK)	m
			CHANNEL BRIDGING	m
SECTION AT CEILING			SCHED. CEILING	m
			3 1/2" SOUND ATTENUATING BATT INSULATION	~~~~~~~~~~~~~~~~~~~~~~~~~~~~~~~~~~~~~~~
			5/8" GWB FULL HEIGHT BOTH SIDES	1
TYPICAL PLAN			3 5/8" METAL STUDS @ 16" O.C. TO STRUCTURAL DECK ABOVE	m
Section at Floor			SCHEDULED BASE 3 5/8" FLOOR RUNNER SECURED TO FLOOR SCHEDULED FLOORING	m
STC TEST &/OR FIRE TYPE DESIGN TE	TEST LAB		NOTES	~~~~~~~~~~~~~~~~~~~~~~~~~~~~~~~~~~~~~~~
S3i NGC 2			SMOKE/ACOUSTICAL SEALANT AT TOP AND BOTTOM	3

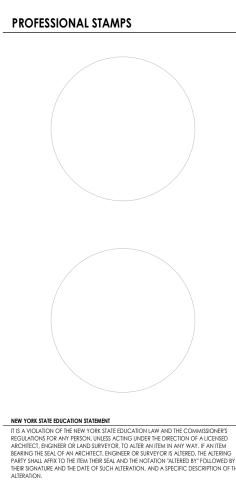

Client Name

Project Name

District Office Address 160 VAN WYCK RD. BLAUVELT, NY 10913

No. Date

SCHOOL DISTRICT

PHASE 1: 2022 BOND

south orangetown CSD

WILLIAM O. SCHAEFER SED#:50-03-01-06-0-012-019 COTTAGE LANE ELEMENTARY SED#:50-03-01-06-0-010-022 TAPPAN ZEE HIGH SCHOOL SED#:50-03-01-06-0-006-032 WILLIAM O. SCHAEFER S&L SED#:50-03-01-06-0-012-020 COTTAGE LANE S&L SED#: 50-03-01-06-0-010-023 COTTAGE LANE LIBRARY S&L SED#: 50-03-01-06-8-023-002 WOS OUTDOOR CLASSROOM SED#: 50-03-01-06-7-053-001 SOMS OUTDOOR CLASSROOM SED#:50-03-01-06-7-056-001

CLE OUTDOOR CLASSROOM SED#:50-03-01-06-7-054-001

TZHS OUTDOOR CLASSROOM SED#:50-03-01-06-7-055-001

PROJECT ISSUE & REVISION SCHEDULE

1 11/09/23 BID ADDENDUM #3


Description

SOUTH ORANGETOWN CENTRAL


SHEET INFORMATION

Issued	Scale	
10/18/23	As indicated	
Project Status		
BID DOCUMENTS		
Drawn By	Checked By	
LF	LT	
Drawing Title		
WALL TYPES & MI	SC. DETAILS	


Drawing Number WOS A810

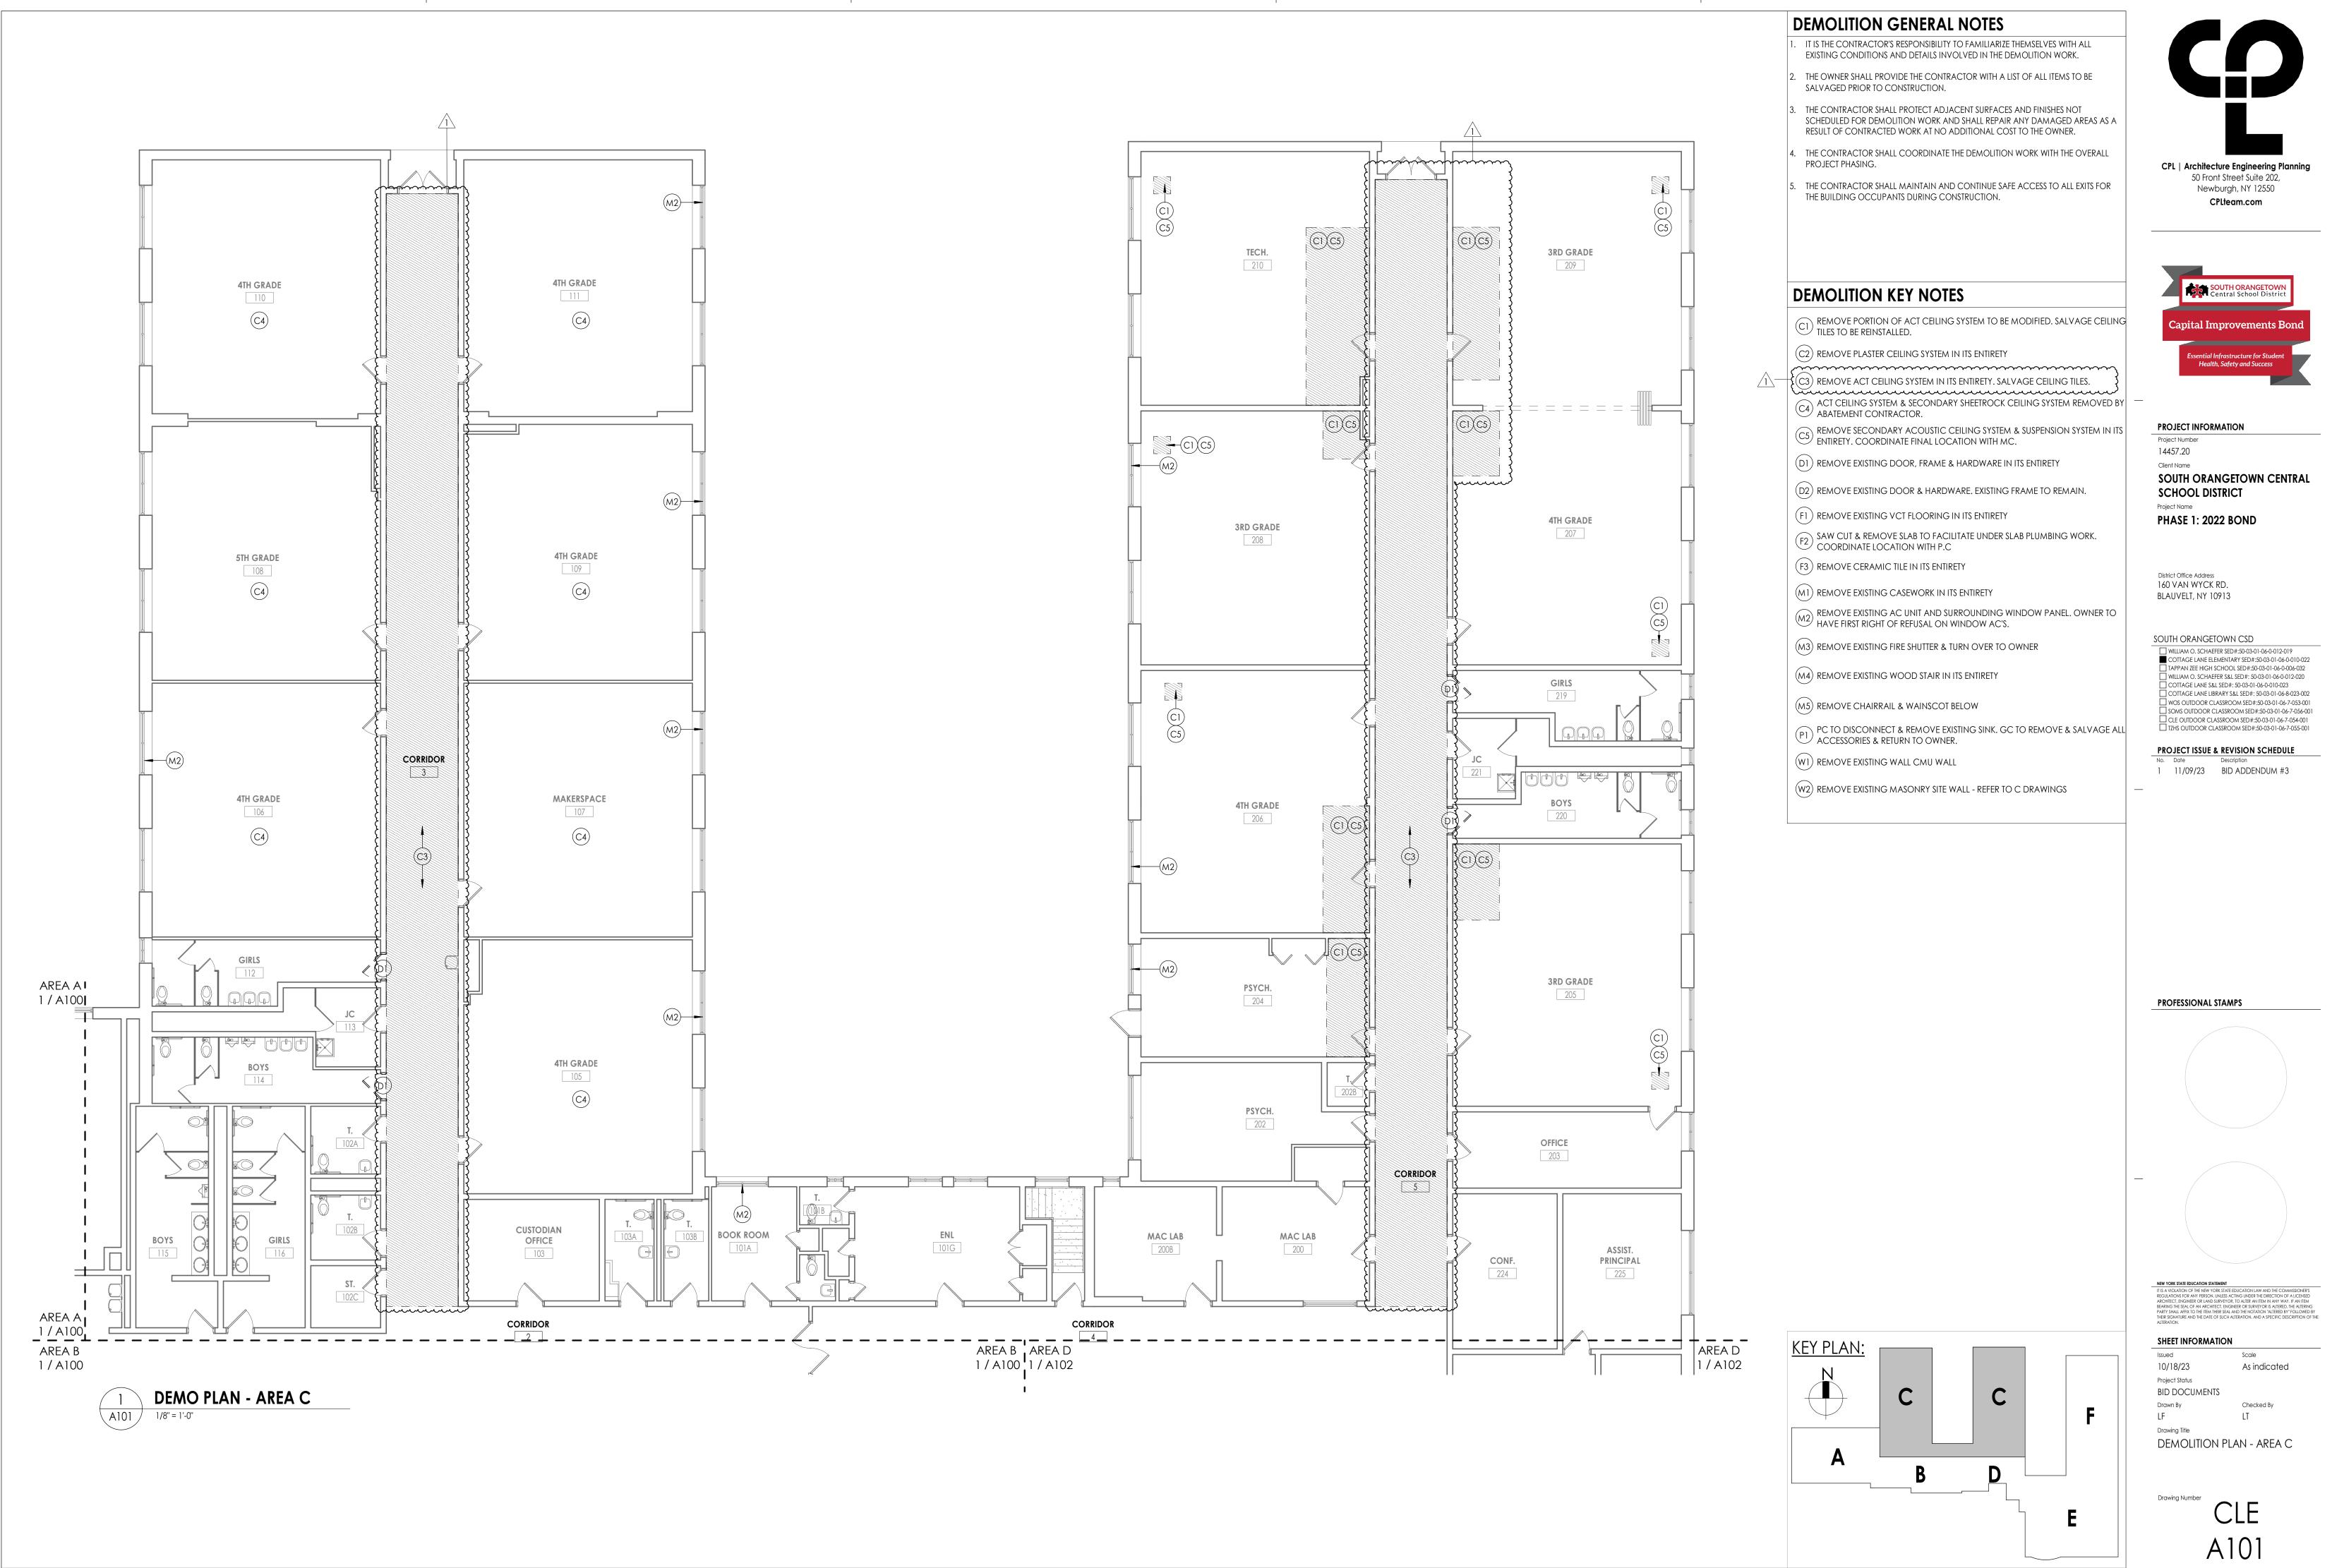

223 10:32:24 AM cproject location> REVIT PROJECT FILES ON BIM360

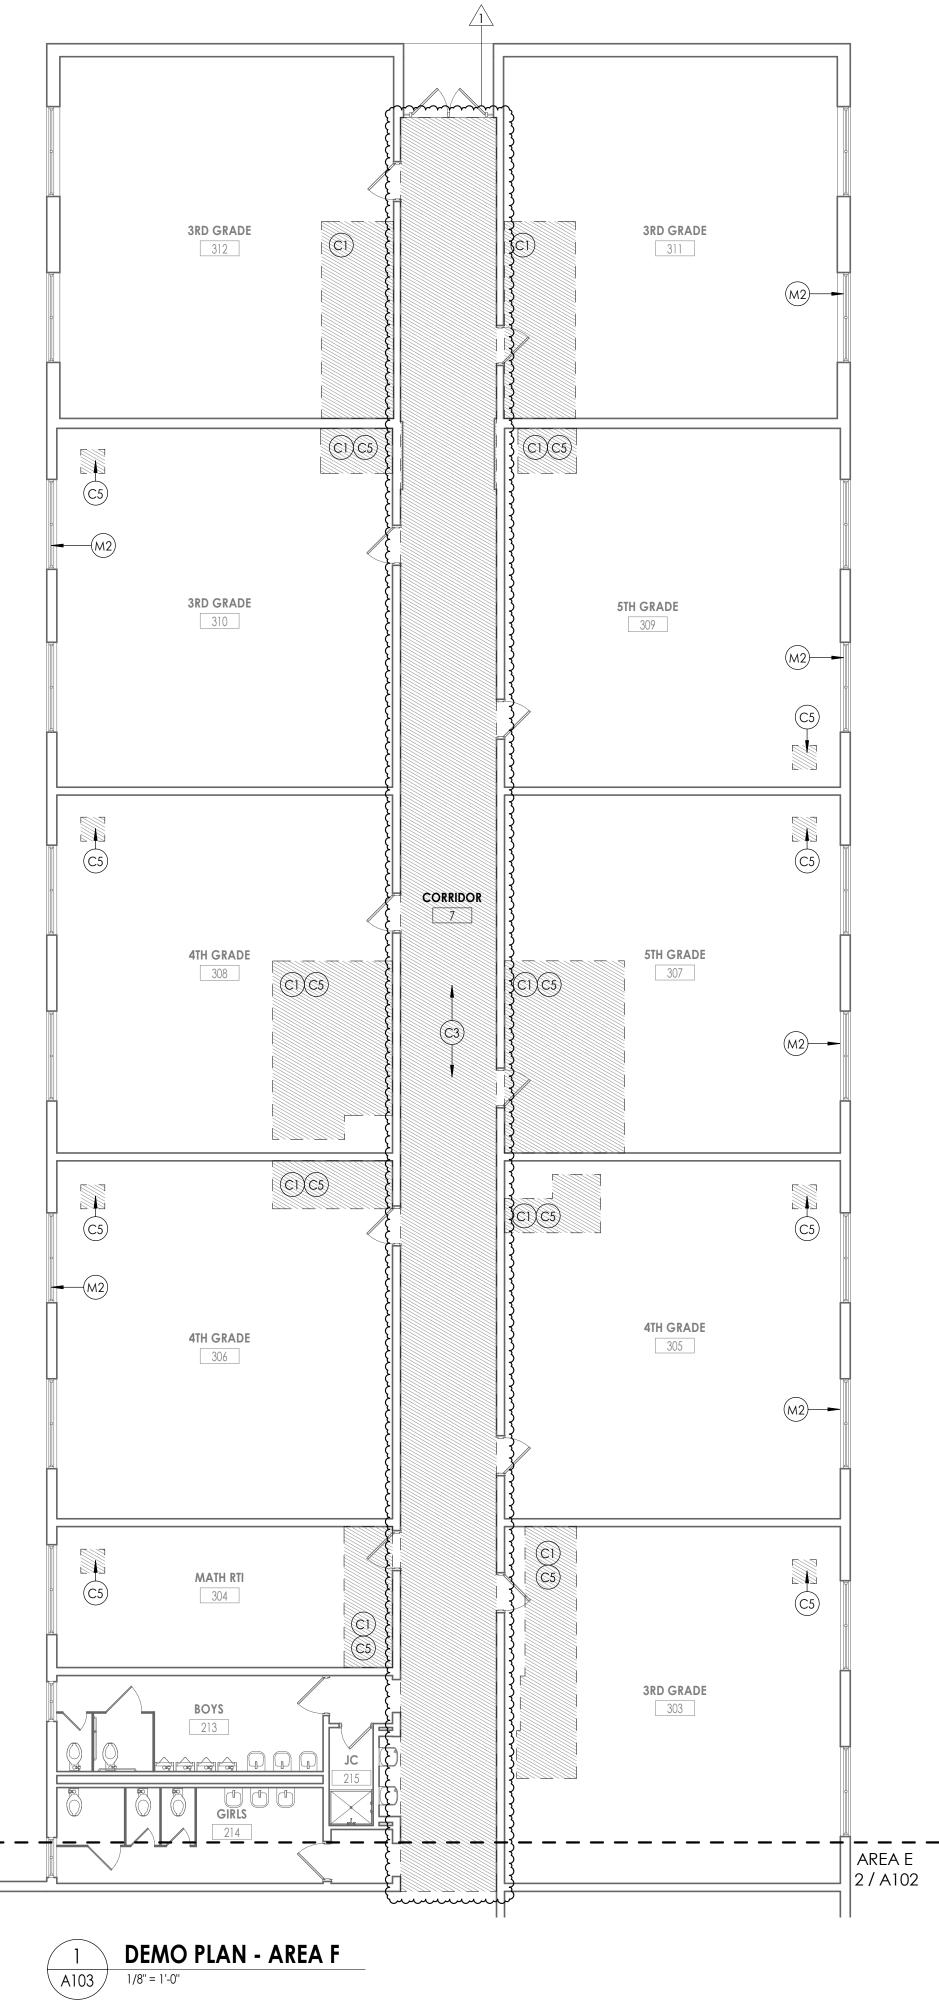

— -

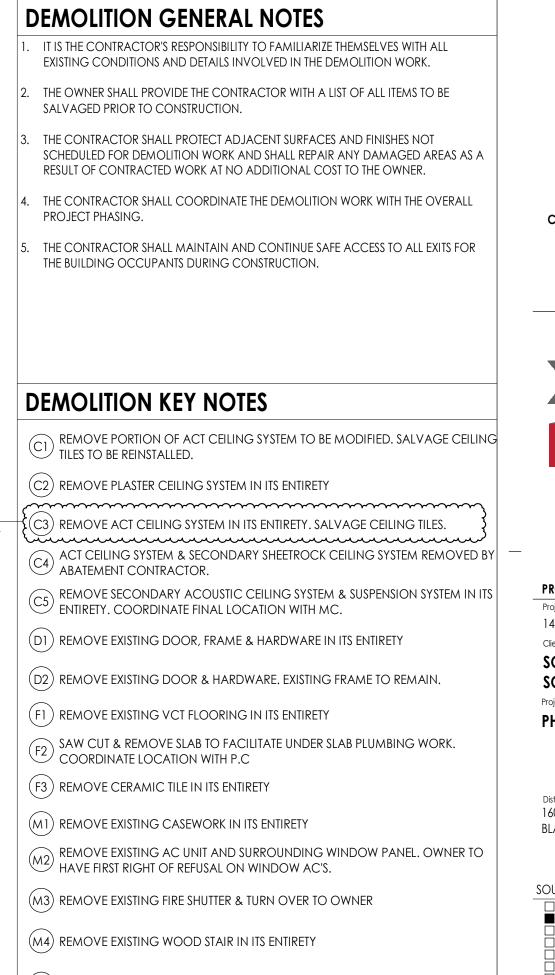

(M5) REMOVE CHAIRRAIL & WAINSCOT BELOW

PL TO DISCONNECT & REMOVE EXISTING SINK. GC TO REMOVE & SALVAGE ALL ACCESSORIES & RETURN TO OWNER.

- (W1) REMOVE EXISTING WALL CMU WALL
- (W2) REMOVE EXISTING MASONRY SITE WALL REFER TO C DRAWINGS

CPL | Architecture Engineering Planning 50 Front Street Suite 202, Newburgh, NY 12550 CPLteam.com SOUTH ORANGET Central School Dis Capital Improvements Bond Health, Safety and Success

PROJECT INFORMATION Project Number 14457.20 Client Name SOUTH ORANGETOWN CENTRAL SCHOOL DISTRICT Project Name PHASE 1: 2022 BOND


District Office Address 160 VAN WYCK RD. BLAUVELT, NY 10913

south orangetown CSD

WILLIAM O. SCHAEFER SED#:50-03-01-06-0-012-019 COTTAGE LANE ELEMENTARY SED#:50-03-01-06-0-010-022 TAPPAN ZEE HIGH SCHOOL SED#:50-03-01-06-0-006-032 WILLIAM O. SCHAEFER S&L SED#: 50-03-01-06-0-012-020 COTTAGE LANE S&L SED#: 50-03-01-06-0-010-023 COTTAGE LANE LIBRARY S&L SED#: 50-03-01-06-8-023-002 WOS OUTDOOR CLASSROOM SED#:50-03-01-06-7-053-001 SOMS OUTDOOR CLASSROOM SED#:50-03-01-06-7-056-001 CLE OUTDOOR CLASSROOM SED#:50-03-01-06-7-054-001 TZHS OUTDOOR CLASSROOM SED#:50-03-01-06-7-055-001

PROJECT ISSUE & REVISION SCHEDULE No. Date 1 11/09/23 BID ADDENDUM #3

PROFESSIONAL STAMPS

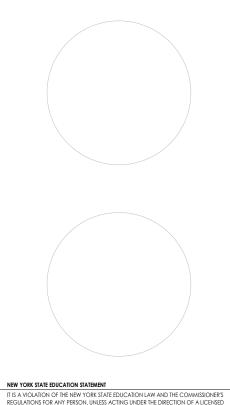


III 3 A VICATION OF THE NEW YORK STATE EDUCATION LAW AND THE COMMISSIONER REGULATIONS FOR ANY PERSON, UNIESS ACTING UNDER THE OTERCTION OF A LICENSEL ARCHITECT, ENGINEER OR LAND SURVEYOR, TO ALTER AN ITEM IN ANY WAY, IF AN ITEM BEARING THE SEAL OF AN ARCHITECT, ENGINEER OR SURVEYOR IS ALTERED, THE ALTERIN PARTY SHALL AFFIX TO THE TIEM THER SEAL AND THE NOTATION "ALTERED BY" FOLLOWED THEIR SIGNATURE AND THE DATE OF SUCH ALTERATION, AND A SPECIFIC DESCRIPTION OF ALTERATION.

SHEET INFORMATION

Issued	Scale
10/18/23	As indicated
Project Status	
BID DOCUMENTS	
Drawn By	Checked By
LF	LT
Drawing Title	
DEMOLITION PLA	N - AREA F

Drawing Number CLE A103

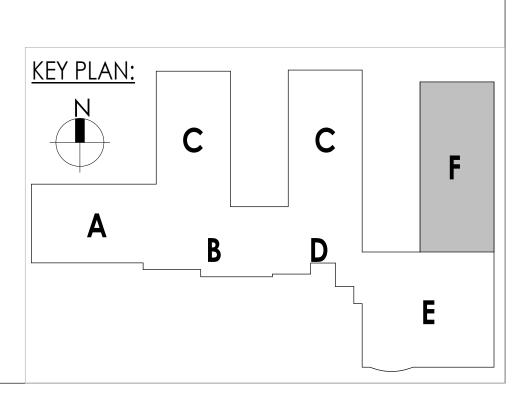




GENERAL CEILING NOTES


- 1. ALL DRAWINGS ARE GRAPHIC REPRESENTATION OF APPROXIMATE LOCATIONS OF NEW MATERIALS FOR CONSTRUCTION. IT IS THE CONTRACTOR'S RESPONSIBILITY TO FIELD VERIFY ALL CONDITIONS PRIOR TO COMMENCEMENT OF WORK. 2. REFER TO A200 SERIES FOR FLOOR PLAN.
- 3. FOR ANY DISCREPANCY BETWEEN THE REFLECTED CEILING PLAN AND THE FLOOR PLAN: THE FLOOR PLAN SHALL TAKE PRECEDENCE. ANY DISCREPANCY SHALL BE CALLED TO THE ATTENTION OF THE ARCHITECT.
- 4. FIRE STOP MECHANICAL, ELECTRICAL AND PLUMBING ITEMS, INCLUDING BUT NOT LIMITED TO DUCTWORK AND CONDUIT PENETRATIONS THROUGH FLOORS AND WALLS.
- 5. COORDINATE CEILING INSTALLATIONS WITH MECHANICAL, ELECTRICAL AND PLUMBING DRAWINGS.
- 6. REFER TO "H" SERIES DRAWINGS FOR DIFFUSERS AND GRILLE LOCATIONS. 7. REFER TO "E" SERIES DRAWINGS FOR LIGHTING TYPES AND CONTROLS.
- 8. REFER TO "P" OR "FP" SERIES DRAWINGS FOR SPRINKLER HEAD LOCATIONS. 9. WORK AREAS SHALL BE MAINTAINED AND ALL WORK AREAS SHALL BE LEFT
- BROOMED CLEAN AT THE END OF EACH DAY.
- 10. CENTER CEILING GRID (EACH WAY) IN ROOMS SCHEDULED TO RECEIVE ACOUSTICAL CEILING SYSTEMS UNLESS OTHERWISE NOTED.
- 11. VERIFY WITH ARCHITECT THE INSTALLATION OF ANY CEILING TILES LESS THAN 4" IN
- WIDTH. 12. PROVIDE MOISTURE RESISTANT GYP. BD. AT ALL TOILET ROOM, JANITOR'S CLOSET AND OTHER WET LOCATION CEILING ASSEMBLIES.
- 13. ALL GYP. BD. CEILINGS AND SOFFITS SHALL BE PRIMED AND PAINTED SCHEDULED COLOR ON ALL FACES AND UNDERSIDE SURFACE.
- 14. VERIFY SOFFIT SIZE WITH MILLWORK SHOP DRAWINGS. PROVIDE 2" OVERHANG ON EXPOSED EDGES UNLESS NOTED OTHERWISE.
- 15. WHERE APPLICABLE ALL FIXTURES AND DEVICES SHALL BE CENTERED ON A CEILING TILE.

16. INSTALL CONTROL JOINTS IN GYP. CEILINGS PER ASTM C 840.


CEILING SYMBOL LEGEND

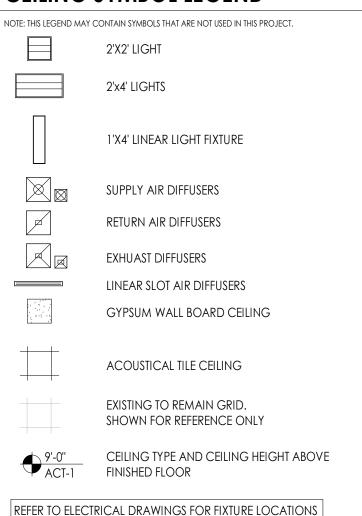

CEILING KEYNOTES

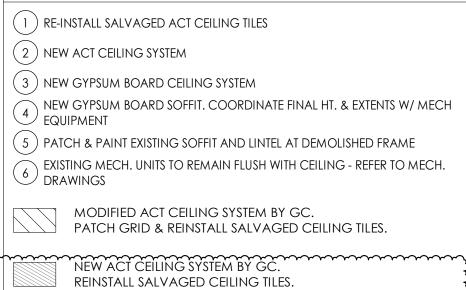

PROVIDE TOP OF WALL SMOKE SEAL. REFER TO A810 FOR DETAIL

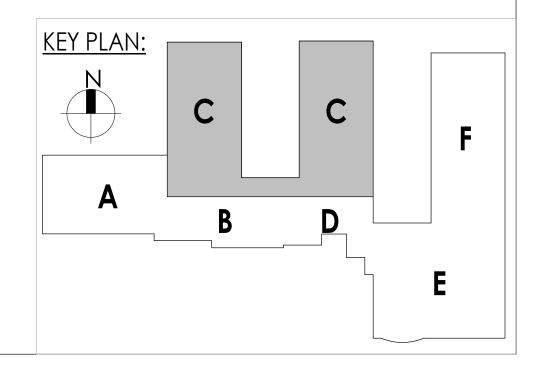




south orangetown CSD

- WILLIAM O. SCHAEFER SED#:50-03-01-06-0-012-019 COTTAGE LANE ELEMENTARY SED#:50-03-01-06-0-010-022 TAPPAN ZEE HIGH SCHOOL SED#:50-03-01-06-0-006-032 WILLIAM O. SCHAEFER S&L SED#: 50-03-01-06-0-012-020 COTTAGE LANE S&L SED#: 50-03-01-06-0-010-023 COTTAGE LANE LIBRARY S&L SED#: 50-03-01-06-8-023-002 WOS OUTDOOR CLASSROOM SED#:50-03-01-06-7-053-001 SOMS OUTDOOR CLASSROOM SED#:50-03-01-06-7-056-001 CLE OUTDOOR CLASSROOM SED#:50-03-01-06-7-054-001 TZHS OUTDOOR CLASSROOM SED#:50-03-01-06-7-055-001
- **PROJECT ISSUE & REVISION SCHEDULE** 1 11/09/23 BID ADDENDUM #3

PROFESSIONAL STAMPS

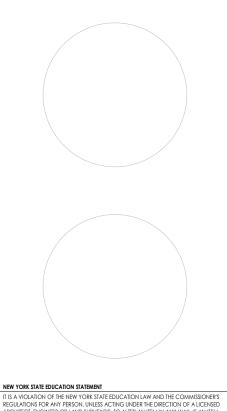


III IS A VIOLATION OF THE REW TORK STATE EDUCATION TAW AND THE COMMISSIONER REQUILATIONS FOR ANY PERSON, UNLESS ACTIONG UNDER THE DIRECTION OF A LICENSE ARCHITECT, ENGINEER OR LAND SURVEYOR, TO ALTER AN ITEM IN ANY WAY. IF AN ITEM BEARING THE SEAL OF AN ARCHITECT, ENGINEER OF SURVEYOR AS TATERED, THE ALTERN PARTY SHALL AFFIX TO THE ITEM THEIR SEAL AND THE NOTATION "ALTERED BY" FOLLOWED THEIR SIGNATURE AND THE DATE OF SUCH ALTERATION, AND A SPECIFIC DESCRIPTION (ALTERATION.

SHEET INFORMATION

Issued	Scale
10/18/23	As indicated
Project Status	
BID DOCUMENTS	
Drawn By	Checked By
LF	LT
Drawing Title	
REFLECTED CEILIN	NG PLAN - ARE
С	
-	

Drawing Number



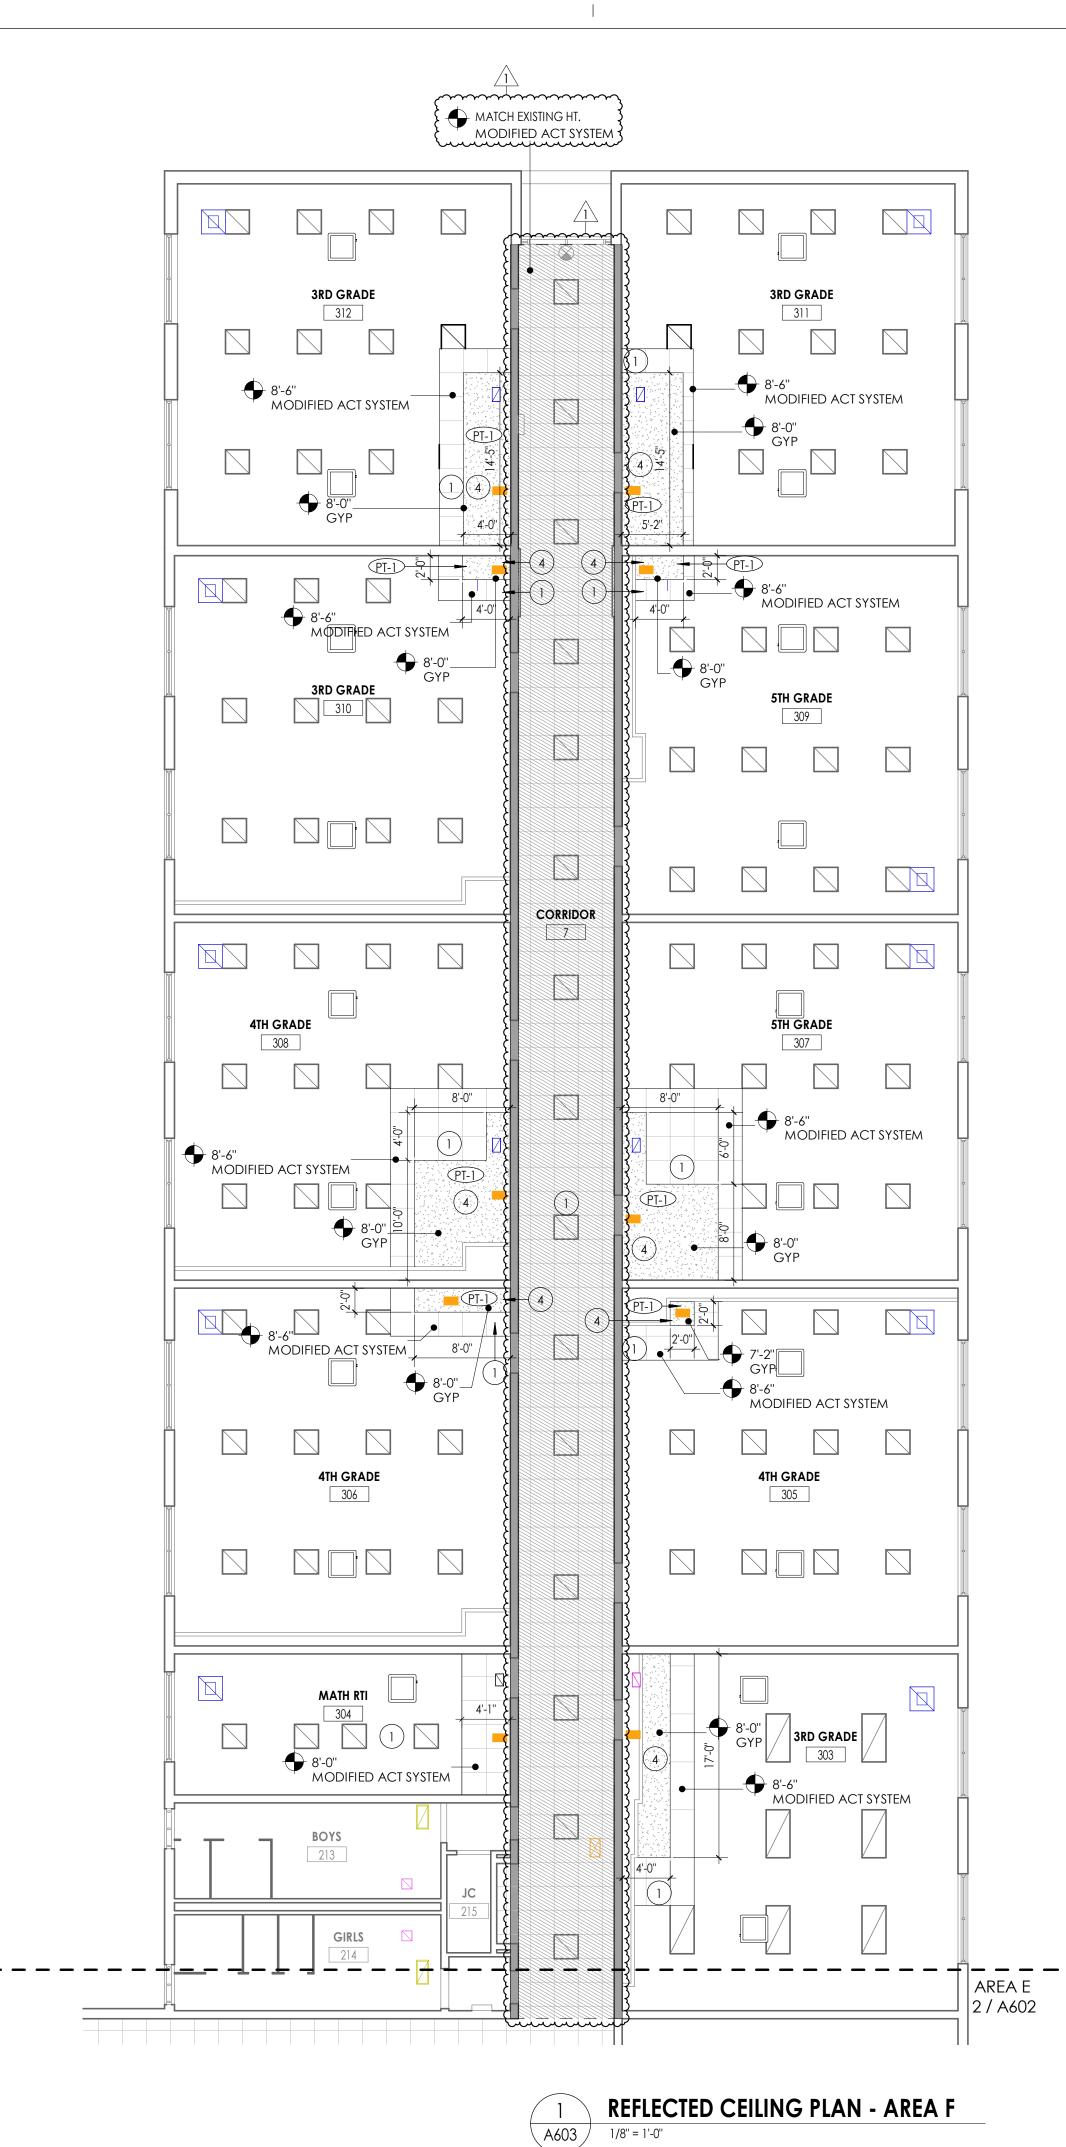

--


GENERAL CEILING NOTES

- ALL DRAWINGS ARE GRAPHIC REPRESENTATION OF APPROXIMATE LOCATIONS OF NEW MATERIALS FOR CONSTRUCTION. IT IS THE CONTRACTOR'S RESPONSIBILITY TO FIELD VERIFY ALL CONDITIONS PRIOR TO COMMENCEMENT OF WORK.
 REFER TO A200 SERIES FOR FLOOR PLAN.
- 3. FOR ANY DISCREPANCY BETWEEN THE REFLECTED CEILING PLAN AND THE FLOOR PLAN: THE FLOOR PLAN SHALL TAKE PRECEDENCE. ANY DISCREPANCY SHALL BE CALLED TO THE ATTENTION OF THE ARCHITECT.
- 4. FIRE STOP MECHANICAL, ELECTRICAL AND PLUMBING ITEMS, INCLUDING BUT NOT LIMITED TO DUCTWORK AND CONDUIT PENETRATIONS THROUGH FLOORS AND WALLS.
- COORDINATE CEILING INSTALLATIONS WITH MECHANICAL, ELECTRICAL AND PLUMBING DRAWINGS.
- 6. REFER TO "H" SERIES DRAWINGS FOR DIFFUSERS AND GRILLE LOCATIONS.
- REFER TO "E" SERIES DRAWINGS FOR LIGHTING TYPES AND CONTROLS.
 REFER TO "P" OR "FP" SERIES DRAWINGS FOR SPRINKLER HEAD LOCATIONS.
 WORK AREAS SHALL BE MAINTAINED AND ALL WORK AREAS SHALL BE LEFT
- 9. WORK AREAS SHALL BE MAINTAINED AND ALL WORK AREAS SHALL BROOMED CLEAN AT THE END OF EACH DAY.
- 10. CENTER CEILING GRID (EACH WAY) IN ROOMS SCHEDULED TO RECEIVE ACOUSTICAL CEILING SYSTEMS UNLESS OTHERWISE NOTED.
- VERIFY WITH ARCHITECT THE INSTALLATION OF ANY CEILING TILES LESS THAN 4" IN WIDTH.
- PROVIDE MOISTURE RESISTANT GYP. BD. AT ALL TOILET ROOM, JANITOR'S CLOSET AND OTHER WET LOCATION CEILING ASSEMBLIES.
- 13. ALL GYP. BD. CEILINGS AND SOFFITS SHALL BE PRIMED AND PAINTED SCHEDULED COLOR ON ALL FACES AND UNDERSIDE SURFACE.
- VERIFY SOFFIT SIZE WITH MILLWORK SHOP DRAWINGS. PROVIDE 2" OVERHANG ON EXPOSED EDGES UNLESS NOTED OTHERWISE.
 WHERE APPLICABLE ALL FIXTURES AND DEVICES SHALL BE CENTERED ON A CEILING
- TILE. 16. INSTALL CONTROL JOINTS IN GYP. CEILINGS PER ASTM C 840.

CEILING SYMBOL LEGEND

NOTE: THIS LEGEND MAY CONTAIN SYMBOLS THAT ARE NOT USED IN THIS PROJECT.					
	2'X2' LIGHT				
	2'x4' LIGHTS				
	1'X4' LINEAR LIGHT FIXTURE				
	SUPPLY AIR DIFFUSERS				
	RETURN AIR DIFFUSERS				
	EXHUAST DIFFUSERS				
	LINEAR SLOT AIR DIFFUSERS				
	GYPSUM WALL BOARD CEILING				
	ACOUSTICAL TILE CEILING				
	EXISTING TO REMAIN GRID. SHOWN FOR REFERENCE ONLY				
9'-0 AC					
REFER TO	ELECTRICAL DRAWINGS FOR FIXTURE LOCATIONS				
CEILIN	NG KEYNOTES				
1 RE-IN	NSTALL SALVAGED ACT CEILING TILES				
2 NEW ACT CEILING SYSTEM					
(3) NEW GYPSUM BOARD CEILING SYSTEM					
NEW GYPSUM BOARD SOFFIT. COORDINATE FINAL HT. & EXTENTS W/ MECH EQUIPMENT					
5 PATO					
6 EXISTING MECH. UNITS TO REMAIN FLUSH WITH CEILING - REFER TO MECH. DRAWINGS					
	MODIFIED ACT CEILING SYSTEM BY GC. PATCH GRID & REINSTALL SALVAGED CEILING TILES.				

 $\underline{1}$

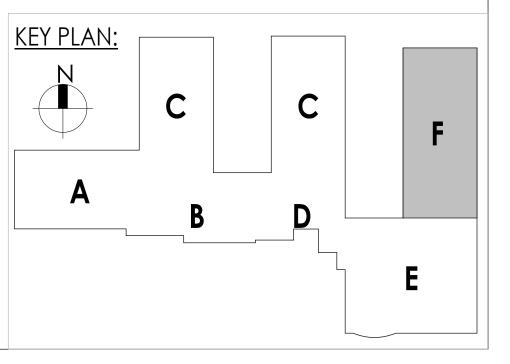

NEW ACT CEILING SYSTEM BY GC.

PROVIDE TOP OF WALL SMOKE SEAL. REFER TO A810 FOR DETAIL

REINSTALL SALVAGED CEILING TILES.



COTTAGE LANE LIBRARY S&L SED#: 50-03-01-06-8-023-002
 WOS OUTDOOR CLASSROOM SED#:50-03-01-06-7-053-001
 SOMS OUTDOOR CLASSROOM SED#:50-03-01-06-7-056-001

CLE OUTDOOR CLASSROOM SED#:50-03-01-06-7-054-001


TZHS OUTDOOR CLASSROOM SED#:50-03-01-06-7-055-001

PROJECT ISSUE & REVISION SCHEDULE

1 11/09/23 BID ADDENDUM #3

No. Date



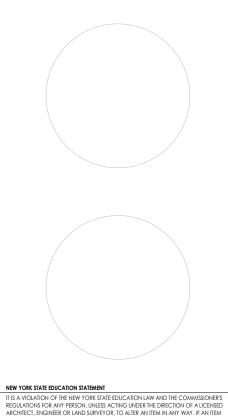


BEARING THE SEAL OF AN ARCHITECT, ENGINEE OR SURVEYOR & ATTREM THAT WAY, AND, IF AN THE PARTY SHALL AFFIX TO THE ITEM THEIR SEAL AND THE NOTATION "ALTERED BY" FOLLOWE THEIR SIGNATURE AND THE DATE OF SUCH ALTERATION, AND A SPECIFIC DESCRIPTION (ALTERATION.


SHEET INFORMATION Issued Scale 10/18/23 As indicated Project Status BID DOCUMENTS Drawn By Checked By LF LT Drawing Title REFLECTED CEILING PLAN - AREA F L

Drawing Number



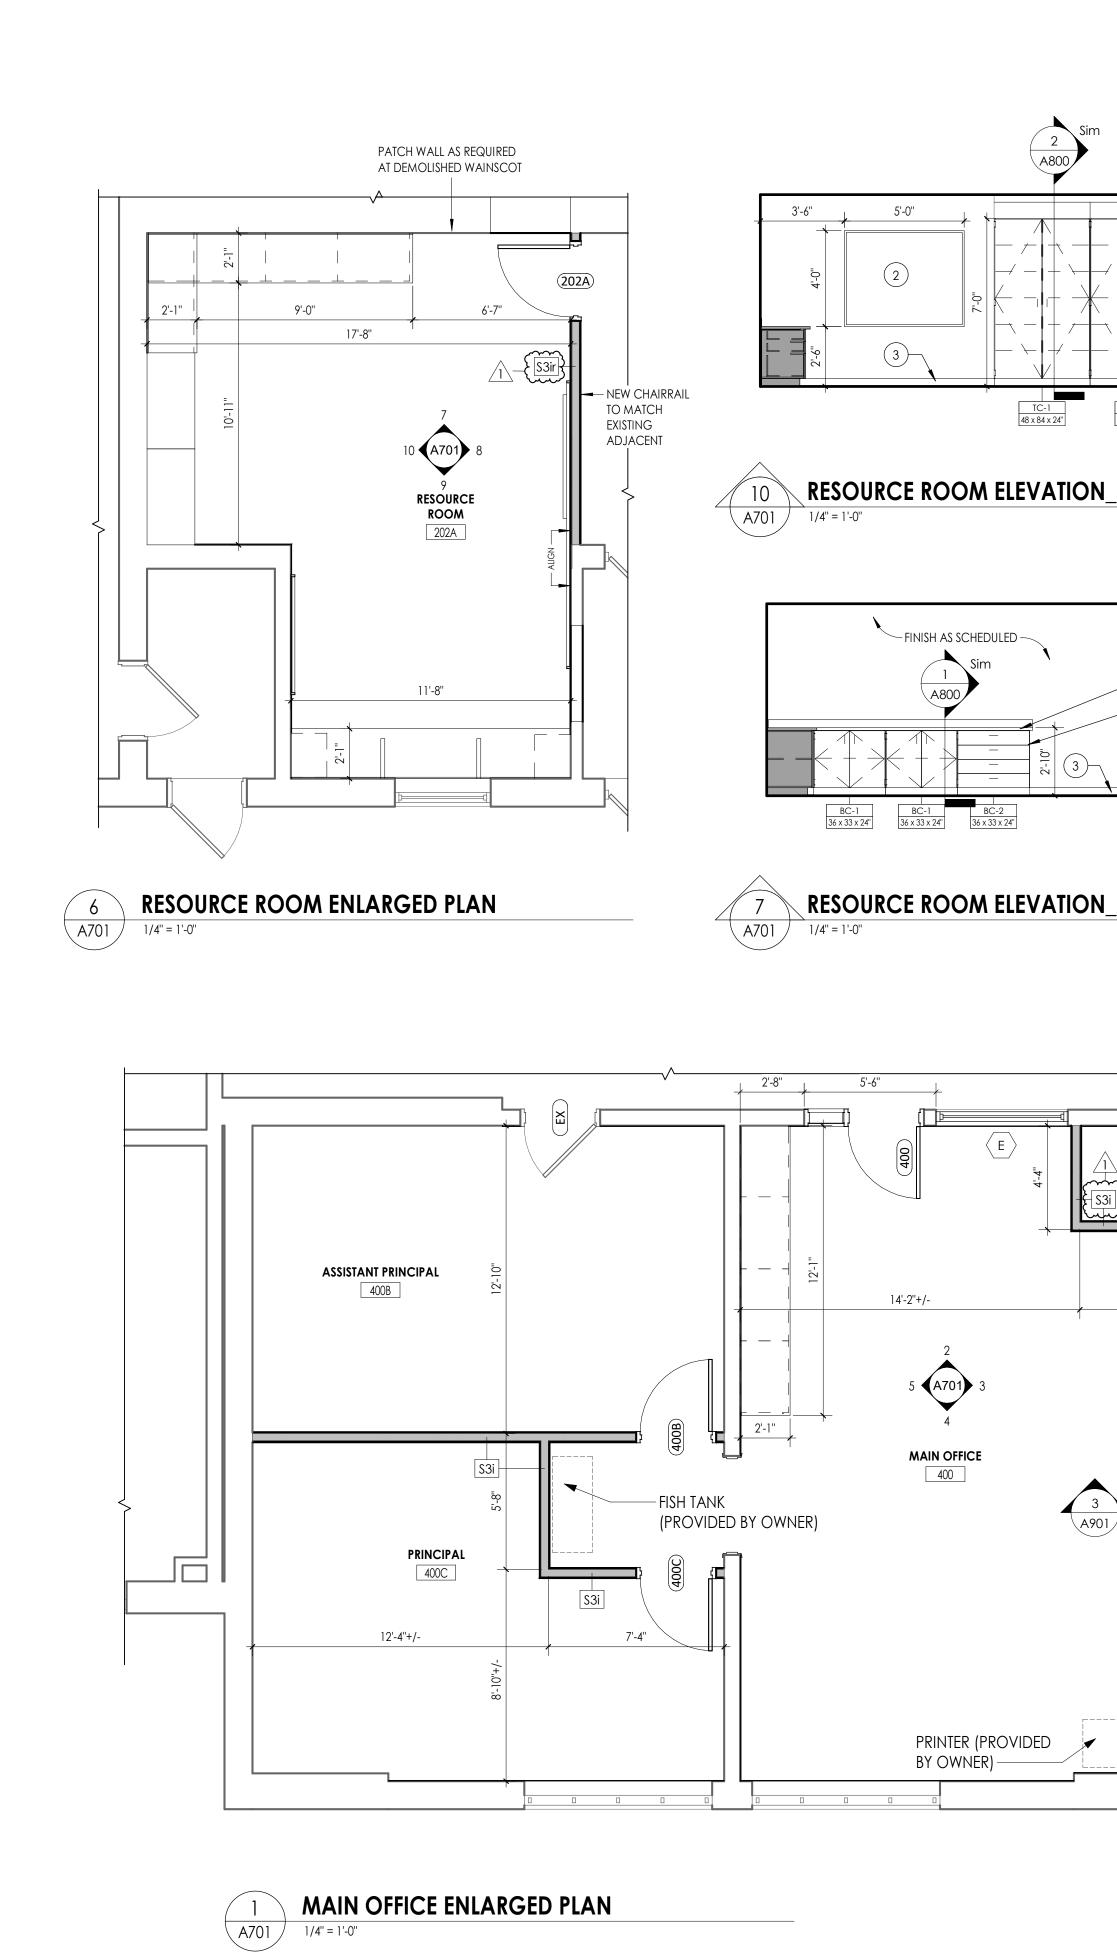


		AMINATE CASEWORK SCHEDU
		IMENSIONS DESCRIPTION "X 33" X 24" ADA SINK BASE
		6" DRAWER/2/DOOR/1 ADJUSTABLE S 6" X 33" X 24" 6" DRAWER/2 EQUAL DRAWERS
	BC-3 3 BC-4 3	5" X 33" X29" - 1 PAPER STORAGE/4 EQUAL DRAWERS 6" X 29" X 21" OPEN SHELF/1 ADJUSTABLE SHELF 1" X 29" X 21" OPEN SHELV/1 ADJUSTABLE SHELF
	BC-6 1 BC-7 1	3" X 29" X 22" 2 EQUAL DRAWERS/1 FILE DRAWER 3" X 29" X 22" 1 DRAWER/1 FILE DRAWER
	WC-1 3	5" X 29" X 13" OPEN SHELF/1 ADJUSTABLE SHELF 6" X 29" X 14" 2 DOOR/1 ADJUSTABLE SHELF
	WC-3 3	2" X 29" X 14" 2 DOOR/1 ADJUSTABLE SHELF 5" X 27" 14" MAILBOX/21 COMPARTMENTS W/ LAI
	<u>∠I</u> \ \ \ \ \ \ \ \ 	2 2 DOORS/IVERTICAL DIVIDER/8 ADJU 2" X 84" X 24" 2 DOORS/IVERTICAL DIVIDER/8 ADJU 2" X 84" X 24" 2 DOORS/IVERTICAL DIVIDER/8 ADJU 2" X 84" X 14" 2 DOORS/I VERTICAL DIVIDER/8 ADJU
Sim	TC-4 3	S" X 84" X 24" 1 DOOR/ DOUBLE COAT HOOK WARE
		25" X 14.25"30 DEGREE SLOPED TOP - LENGTH AS25" X 24.25"30 DEGREE SLOPED TOP - LENGTH AS
48 X 8 X 24 (X2) 5 (HPL-3)	LEGEND:	*NOTE:
✓ (HPL-4) ✓ (5)(HPL-3)	ADA = ADA BASE BC = BASE CABINET WC = WALL CABIN	
	TC = TALL CABINET SC = SLOPED CABIN MC = METAL CABIN	
		BY OTHERS. SHOWN FOR
TC-1 BC-1 48 x 84 x 24" 36 x 33 x 24"		
L_D		
	12'-0"	FINISH AS SPECIFIED
	AARTBOARD RNISHED AND LLED BY OWNER (HPL-4)	
	(HPL-4) ((HPL-3) (
	FINISH AS SPECIFIED	
		BC-7 18 x 29 x 22"
8 RESOURCE RO A701 1/4" = 1'-0"	OM ELEVATION_B	9 RESOURCE ROOM A701 1/4" = 1'-0"
CL 4000 5-6' 102B 50 50 50 50 50 50 50 50 50 50	GYP. SOFFIT AT TRANSOM SCHEDULED 3	
	4 ATO1 1/4" = 1'-0" I/4" = 1'-0" I/4" = 1'-0"	
	2 MAIN OFFICE ELEVATION_A A701 1/4" = 1'-0"	3 M A701 1/4

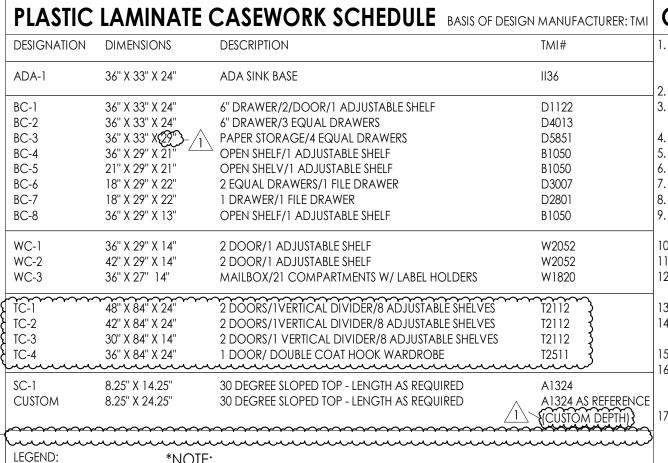

DRAWERS TO RECIEVE LOCKS PER ONSIBLE FOR KEYING. DVIDED AND INSTALLED

OR REFERENCE ONLY.

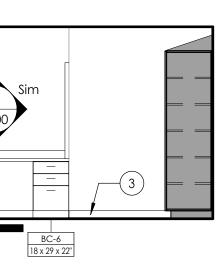

M ELEVATION_C




ALL DRAWINGS ARE GRAPHIC REPRESENTATIONS OF APPROXIMATE LOCATIONS OF EXISTING AND NEW MATERIALS. IT IS THE CONTRACTOR'S RESPONSIBILITY TO FIELD VERIFY ALL EXISTING CONDITIONS PRIOR TO COMMENCEMENT OF WORK. FIELD VERIFY ALL DIMENSIONS PRIOR TO SHOP DRAWING SUBMITTAL.

- PROVIDE SUPPORT BLOCKING AND STRAPPING FOR ALL MILLWORK, CASEWORK, AND WALL MOUNTED ACCESSORIES. REFER TO FINISH SCHEDULE AND COLOR LEGEND FOR FINISHES.
- REFER TO A200 SERIES DRAWINGS FOR ADDITIONAL SPECIALTIES. REFER TO A600 SERIES DRAWINGS FOR CEILING HEIGHTS.
- PROVIDE FULL FINISHED END PANELS ON ALL EXPOSED MILLWORK.
- PROVIDE FILLER PANEL WHERE MILLWORK MEETS WALL. PROVIDE SUPPORT BRACKETS AT WORK SURFACES, 48" MAX BETWEEN BRACKETS UNLESS
- NOTED OTHERWISE. . GROMMETS TO BE INSTALLED IN FIELD AND COORDINATED WITH I.T. EQUIPMENT. . ALL MILLWORK TO BE LOCKABLE UNLESS NOTED OTHERWISE. 12. PROVIDE VALANCE COVER AT ALL UNDER CABINET LIGHTING WHEREVER UNDER
- CABINET LIGHTING IS REQUIRED. 13. REFER TO FINISH SCHEDULE AND A700 SERIES DRAWINGS FOR MILLWORK FINISHES. 14. REFER TO A700 FOR TOILET FIXTURE AND ACCESSORIES LEGEND AND MOUNTING
- heights. 15. REFER TO A700 OR SPECS FOR ALL TOILET ROOM ACCESSORIES PROVIDED BY OWNER. . EQUIPMENT SHOWN ON THESE DOCUMENTS ARE FOR REFERENCE ONLY AND ARE FOR THE COORDINATION OF M.E.P. INFRASTRUCTURE TO OPERATE ITEMS UNDER THIS
- SCOPE. . IT IS THE GENERAL CONTRACTORS RESPONSIBILITY TO REFER TO OWNER FURNISHED EQUIPMENT DRAWINGS AND SUBMITTALS FOR FINAL COORDINATION AND INSTALLATION REQUIREMENTS INCLUDING BUT NOT LIMITED TO: DIMENSIONS AND LOCATIONS OF MEP CONNECTION LOCATIONS. 3. ALL FURNITURE IS PROVIDED BY OWNER UNLESS NOTED OTHERWISE.


INTERIOR ELEVATION KEYNOTES

- 1) PROVIDE VINYL WRITEABLE/MAGNETIC SURFCE.
- (2) PROVIDE TACKABLE SURFACE.
- $\langle 1 \rangle$ 3) PROVIDE BASE, AS SCHEDULED. \sim (4) HPL COUNTERTOP - BY OTHERS $(\ 5\)$ HPL CASEWORK, FINISHED END PANELS AND FILLERS, AS REQUIRED - BY OTHERS, \overline{s}
- (6) PROVIDE ACOUSTICAL WALL PANELS (AWP). SEE 1000 FOR ADDITIONAL DETAIL. (7) existing exposed brick to remain.
- 🏹 metal support bracket 4'-0" oc max. Basis of design: rakks eh-1818 - by 🤾 OTHERS.
- 9) NOT IN USE. Mannennennennennennennen (10) PATCH WALLS AS REQUIRED AT REMOVED WAINSCOT.
- (11) EQUIPMENT TO BE OWNER FURNISHED, CONTRACTOR INSTALLED (OFCI).

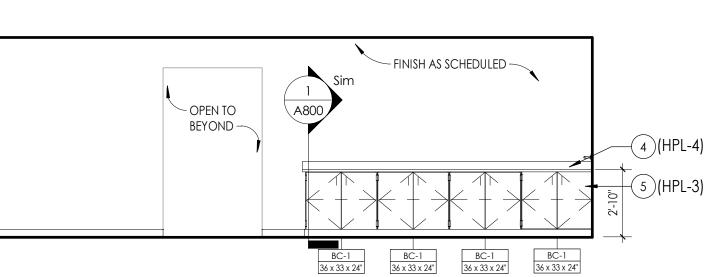

MAIN OFFICE ELEVATION_D

1/4" = 1'-0"

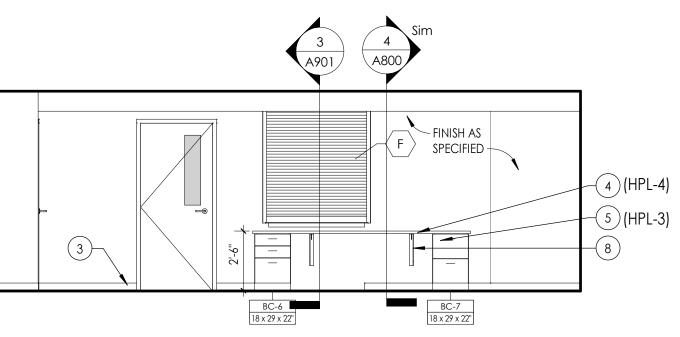

MAIN OFFICE ELEVATION_B

1/4" = 1'-0"



SOUTH ORANGETOWN CENTRAL SCHOOL DISTRICT Project Name

PHASE 1: 2022 BOND


District Office Address 160 VAN WYCK RD. BLAUVELT, NY 10913

south orangetown CSD

WILLIAM O. SCHAEFER SED#:50-03-01-06-0-012-019 COTTAGE LANE ELEMENTARY SED#:50-03-01-06-0-010-022 TAPPAN ZEE HIGH SCHOOL SED#:50-03-01-06-0-006-032 WILLIAM O. SCHAEFER S&L SED#: 50-03-01-06-0-012-020 COTTAGE LANE S&L SED#: 50-03-01-06-0-010-023 COTTAGE LANE LIBRARY S&L SED#: 50-03-01-06-8-023-002 WOS OUTDOOR CLASSROOM SED#:50-03-01-06-7-053-001 SOMS OUTDOOR CLASSROOM SED#:50-03-01-06-7-056-001 CLE OUTDOOR CLASSROOM SED#:50-03-01-06-7-054-001 TZHS OUTDOOR CLASSROOM SED#:50-03-01-06-7-055-001

PROJECT ISSUE & REVISION SCHEDULE No Date 1 11/09/23 BID ADDENDUM #3

PROFESSIONAL STAMPS

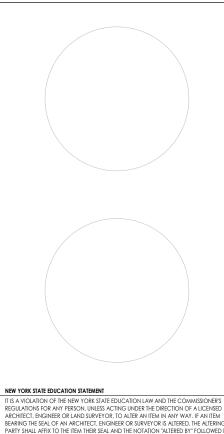


SHEET INFORMATION

Issued	Scale
10/18/23	As indicated
Project Status	
BID DOCUMENTS	
Drawn By	Checked By
LF	LT
Drawing Title	
MAIN OFFICE 8	RESOURCE

ROOM ENLARGED FLOOR PLAN AND INTERIOR ELEVATIONS






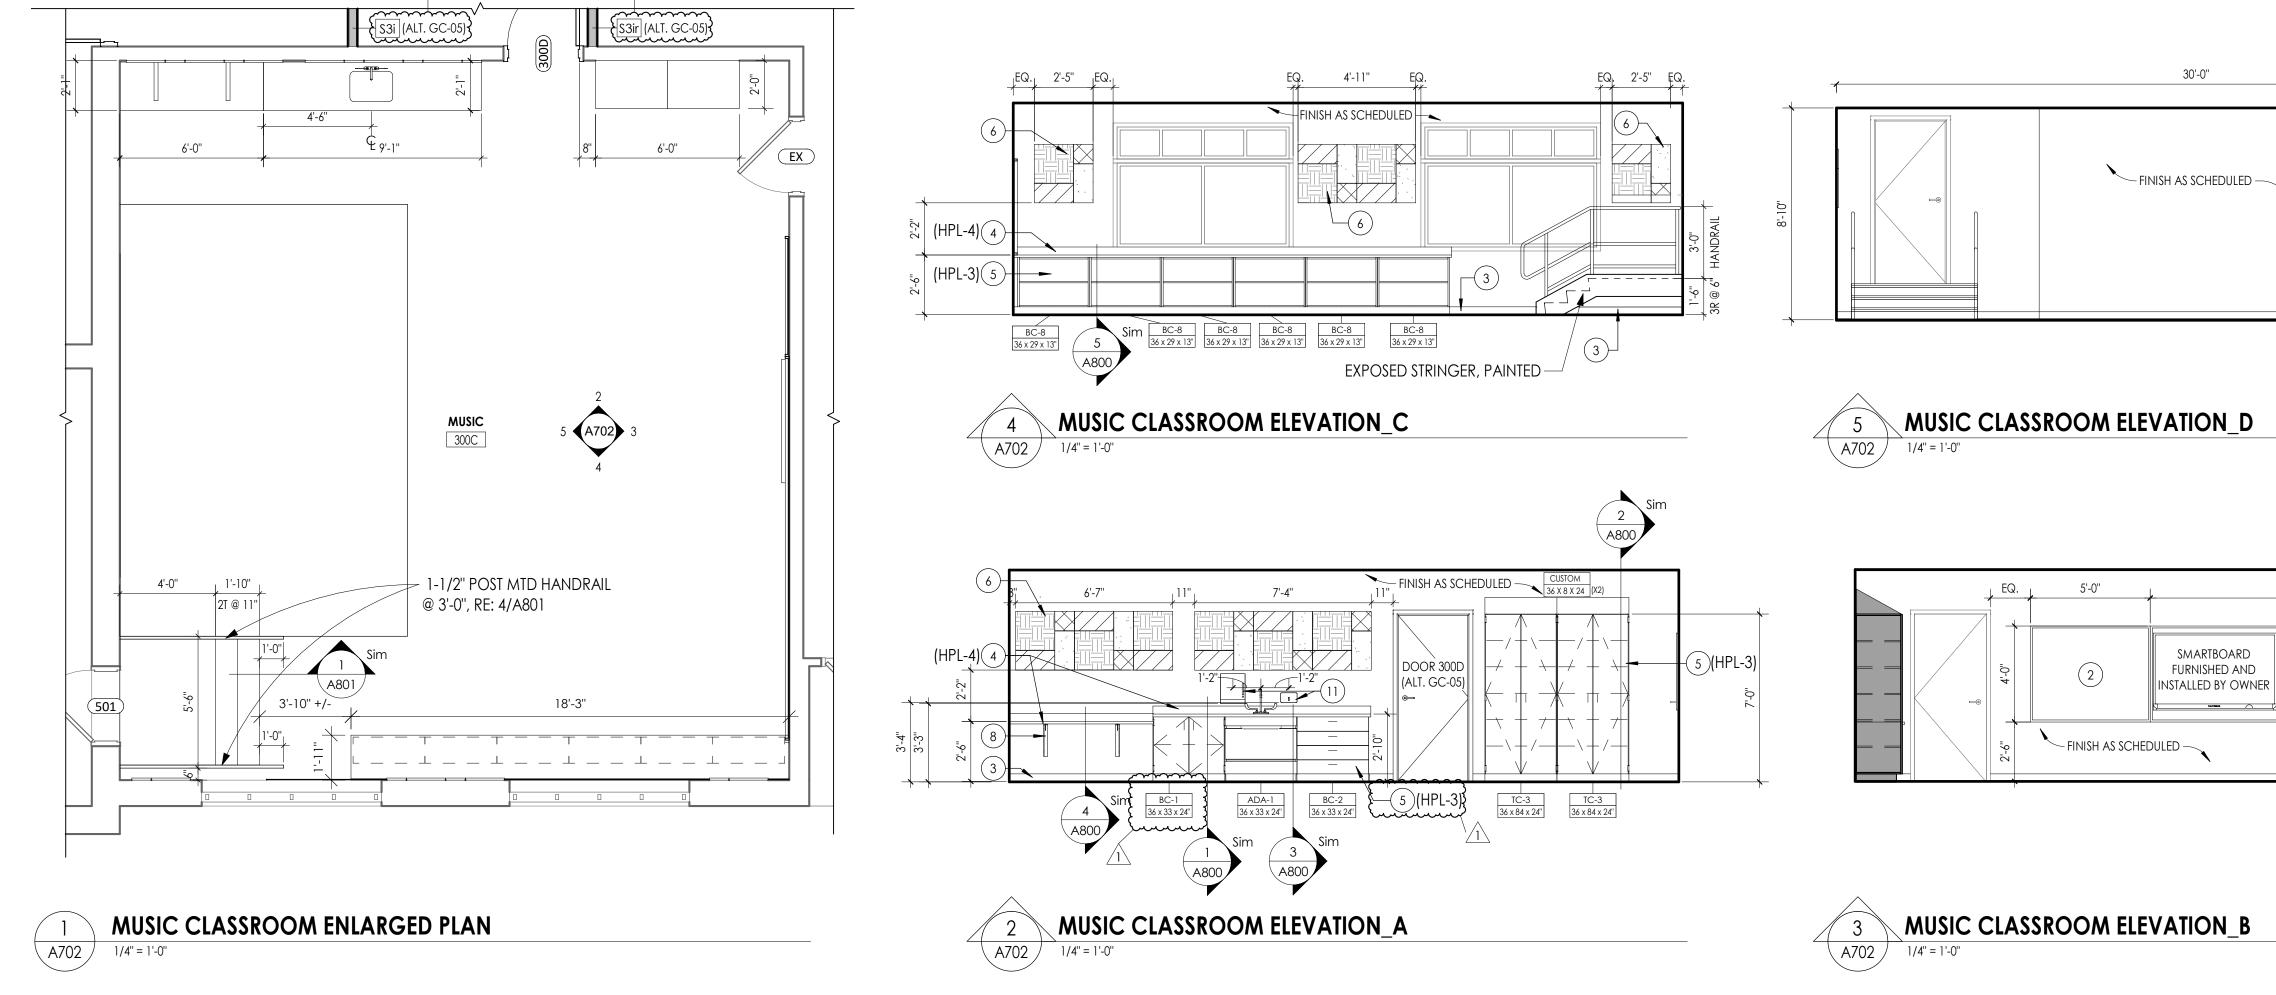


 $\underline{\land}$


PLASTIC	C LAMINATE	CASEWORK SCHED)(
DESIGNATION	DIMENSIONS	DESCRIPTION	
ADA-1	36" X 33" X 24"	ADA SINK BASE	
BC-1	36" X 33" X 24"	6" DRAWER/2/DOOR/1 ADJUSTABL	ES
BC-2	36" X 33" X 24"	6" DRAWER/3 EQUAL DRAWERS	
BC-3	36" X 33" X(29")_ /	PAPER STORAGE/4 EQUAL DRAWE	RS
BC-4	36" X 29" X 21"	OPEN SHELF/1 ADJUSTABLE SHELF	
BC-5	21" X 29" X 21"	OPEN SHELV/1 ADJUSTABLE SHELF	
BC-6	18" X 29" X 22"	2 EQUAL DRAWERS/1 FILE DRAWER	5
BC-7	18" X 29" X 22"	1 DRAWER/1 FILE DRAWER	
BC-8	36" X 29" X 13"	OPEN SHELF/1 ADJUSTABLE SHELF	
WC-1	36" X 29" X 14"	2 DOOR/1 ADJUSTABLE SHELF	
WC-2	42" X 29" X 14"	2 DOOR/1 ADJUSTABLE SHELF	
WC-3	36" X 27" 14"	MAILBOX/21 COMPARTMENTS W/	LA
	48" X 84" X 24"	2 DOORS/1 VERTICAL DIVIDER/8 A	ĎĴ
<u>∠1</u> _{ TC-2	42" X 84" X 24"	2 DOORS/1VERTICAL DIVIDER/8 A	DJ
🕻 TC-3	30" X 84" X 14"	2 DOORS/1 VERTICAL DIVIDER/8 A	۱D.
E TC-4	36" X 84" X 24"	1 DOOR/ DOUBLE COAT HOOK W	
SC-1	8.25" X 14.25"	30 DEGREE SLOPED TOP - LENGTH	
CUSTOM	8.25" X 24.25"	30 DEGREE SLOPED TOP - LENGTH	AS
	~~~~~~~~~~~~~~~~~~~~~~~~~~~~~~~~~~~~~~		<u>~</u>
LEGEND:	*NO1		-0
ADA = ADA BA	7 C E	L CASEWORK WITH DOORS/ [	٦P
BC = BASE CA	KINFI	-	
WC = WALL C	abinet OWN	NER REQUEST. OWNER IS RESPO	J
TC = TALL CAE	BINET NA		11
SC = SLOPED (		o <u>te</u> : Casework prc	<u>ر</u>
MC = METAL C	CABINET RY	OTHERS. SHOWN FC	)۴
	וט		/I`

DULE BASIS OF DESIGN MANUFACTURE TMI#	1. ALL DRAWINGS ARE GRAPHIC REPRESENTATIONS OF APPROXIMATE LOCATIONS OF EXISTING AND NEW MATERIALS. IT IS THE CONTRACTOR'S RESPONSIBILITY TO FIELD	
BLE SHELF D1122	<ul> <li>VERIFY ALL EXISTING CONDITIONS PRIOR TO COMMENCEMENT OF WORK.</li> <li>2. FIELD VERIFY ALL DIMENSIONS PRIOR TO SHOP DRAWING SUBMITTAL.</li> <li>3. PROVIDE SUPPORT BLOCKING AND STRAPPING FOR ALL MILLWORK, CASEWORK, AND</li> </ul>	
D4013 D851	<ul> <li>WALL MOUNTED ACCESSORIES.</li> <li>REFER TO FINISH SCHEDULE AND COLOR LEGEND FOR FINISHES.</li> </ul>	
B1050 B1050 B1050	<ol> <li>REFER TO A200 SERIES DRAWINGS FOR ADDITIONAL SPECIALTIES.</li> <li>REFER TO A600 SERIES DRAWINGS FOR CEILING HEIGHTS.</li> </ol>	
R D3007 D2801	<ol> <li>RELEKTO FUELS DRAWINGS FOR CELEMO HEIGHTS.</li> <li>PROVIDE FULL FINISHED END PANELS ON ALL EXPOSED MILLWORK.</li> <li>PROVIDE FILLER PANEL WHERE MILLWORK MEETS WALL.</li> </ol>	
B1050	<ul> <li>PROVIDE SUPPORT BRACKETS AT WORK SURFACES, 48" MAX BETWEEN BRACKETS UNLESS NOTED OTHERWISE.</li> </ul>	CPL   Architecture Engineering Planning
W2052 W2052	10. GROMMETS TO BE INSTALLED IN FIELD AND COORDINATED WITH I.T. EQUIPMENT. 11. ALL MILLWORK TO BE LOCKABLE UNLESS NOTED OTHERWISE.	50 Front Street Suite 202, Newburgh, NY 12550
/ LABEL HOLDERS W1820	12. PROVIDE VALANCE COVER AT ALL UNDER CABINET LIGHTING WHEREVER UNDER CABINET LIGHTING IS REQUIRED.	CPLteam.com
ADJUSTABLE SHELVES T2112 ADJUSTABLE SHELVES T2112	<ol> <li>REFER TO FINISH SCHEDULE AND A700 SERIES DRAWINGS FOR MILLWORK FINISHES.</li> <li>REFER TO A700 FOR TOILET FIXTURE AND ACCESSORIES LEGEND AND MOUNTING</li> </ol>	
ADJUSTABLE SHELVES T2112 ADJUSTABLE SHELVES T2112 (ARDROBE T2511	HEIGHTS. 15. REFER TO A700 OR SPECS FOR ALL TOILET ROOM ACCESSORIES PROVIDED BY OWNER.	
······	16. EQUIPMENT SHOWN ON THESE DOCUMENTS ARE FOR REFERENCE ONLY AND ARE FOR	
AS REQUIRED A1324 AS REFER	$\sim$	SOUTH ORANGETOWN Central School District
CL\STOM DEPT	EQUIPMENT DRAWINGS AND SUBMITTALS FOR FINAL COORDINATION AND INSTALLATION REQUIREMENTS INCLUDING BUT NOT LIMITED TO: DIMENSIONS AND	Capital Improvements Bond
	LOCATIONS OF MEP CONNECTION LOCATIONS.	
DRAWERS TO RECIEVE LOCKS PER PONSIBLE FOR KEYING.		Essential Infrastructure for Student Health, Safety and Success
OVIDED AND INSTALLEI	<b>INTERIOR ELEVATION KEYNOTES</b>	
OR REFERENCE ONLY.	1 PROVIDE VINYL WRITEABLE/MAGNETIC SURFCE.	_
	2 PROVIDE TACKABLE SURFACE.	PROJECT INFORMATION
	3 PROVIDE BASE, AS SCHEDULED.	Project Number 14457.20
	4 HPL COUNTERTOP - BY OTHERS	Client Name
	5 HPL CASEWORK, FINISHED END PANELS AND FILLERS, AS REQUIRED - BY OTHERS.	SOUTH ORANGETOWN CENTRAL SCHOOL DISTRICT
	6 PROVIDE ACOUSTICAL WALL PANELS (AWP). SEE 1000 FOR ADDITIONAL DETAIL.	Project Name PHASE 1: 2022 BOND
		T THESE T. ZUZZ BUND
	8 METAL SUPPORT BRACKET 4'-0" OC MAX. BASIS OF DESIGN: RAKKS EH-1818 - BY	
	9 NOT IN USE.	District Office Address 160 VAN WYCK RD.
	(10) PATCH WALLS AS REQUIRED AT REMOVED WAINSCOT.	BLAUVELT, NY 10913
	(11) EQUIPMENT TO BE OWNER FURNISHED, CONTRACTOR INSTALLED (OFCI).	SOUTH ORANGETOWN CSD
	ACOUSTIC WALL PANEL LEGEND	<ul> <li>WILLIAM O. SCHAEFER SED#:50-03-01-06-0-012-019</li> <li>COTTAGE LANE ELEMENTARY SED#:50-03-01-06-0-010-022</li> <li>TAPPAN ZEE HIGH SCHOOL SED#:50-03-01-06-0-006-032</li> </ul>
		WILLIAM O. SCHAEFER S&L SED#: 50-03-01-06-0-012-020           COTTAGE LANE S&L SED#: 50-03-01-06-0-010-023
		COTTAGE LANE LIBRARY S&L SED#: 50-03-01-06-8-023-002 WOS OUTDOOR CLASSROOM SED#:50-03-01-06-7-053-00 SOMS OUTDOOR CLASSROOM SED#:50-03-01-06-7-056-00
	AWP-1; SEE FINISH SCHEDULE FOR ADDITIONAL DETAIL	CLE OUTDOOR CLASSROOM SED#:50-03-01-06-7-054-001 TZHS OUTDOOR CLASSROOM SED#:50-03-01-06-7-055-00
		PROJECT ISSUE & REVISION SCHEDULE
	AWP-2; SEE FINISH SCHEDULE FOR ADDITIONAL DETAIL	No. Date Description 1 11/09/23 BID ADDENDUM #3
		_
	AWP-3; SEE FINISH SCHEDULE FOR ADDITIONAL DETAIL	
	AWP-4; SEE FINISH SCHEDULE FOR ADDITIONAL DETAIL	
30'-0"		
AS SCHEDULED		
		PROFESSIONAL STAMPS
TION_D		
		-
16'-0"	L EQ.	
		NEW YORK STATE EDUCATION STATEMENT
SMARTBOARD		REGULATIONS FOR ANY PERSON, UNLESS ACTING UNDER THE DIRECTION OF A LICENSE ARCHITECT, ENGINEER OR LAND SURVEYOR, TO ALTER AN ITEM IN ANY MAY. IF AN ITE BEARING THE SEAL OF AN ARCHITECT, ENGINEER OR SURVEYOR IS ALTERED, THE ALTERI PARTY SHALL AFRIX TO THE ITEM THERE SEAL AND THE NOTATION "ALTERED BY" FOLLOWE
URNISHED AND TALLED BY OWNER		THEIR SIGNATURE AND THE DATE OF SUCH ALTERATION, AND A SPECIFIC DESCRIPTION ALTERATION.
		SHEET INFORMATION Issued Scale
		10/18/23 As indicated
		Project Status BID DOCUMENTS
/		Drawn By Checked By LF LT
		Drawing Title
		MUSIC CLASSROOM ENLARGEE PLAN AND INTERIOR ELEVATION
		Drawing Number

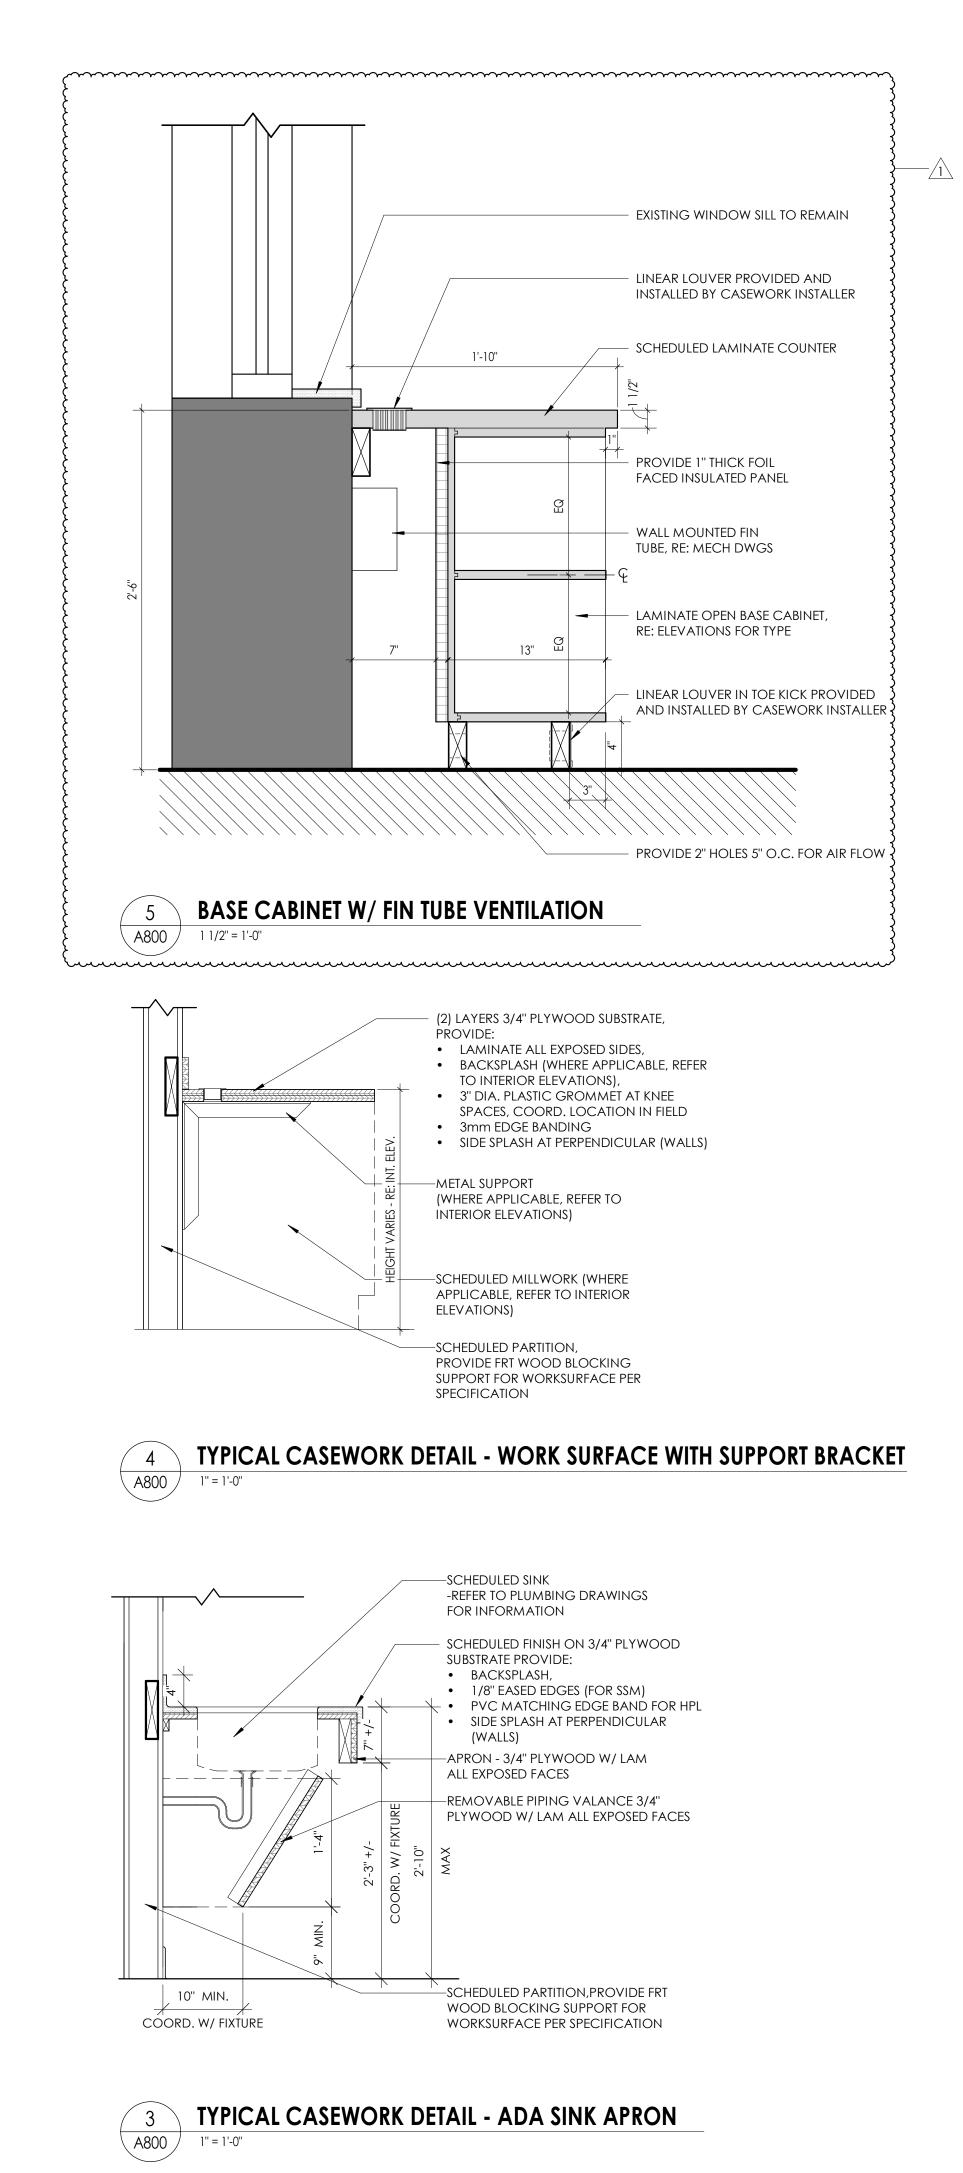

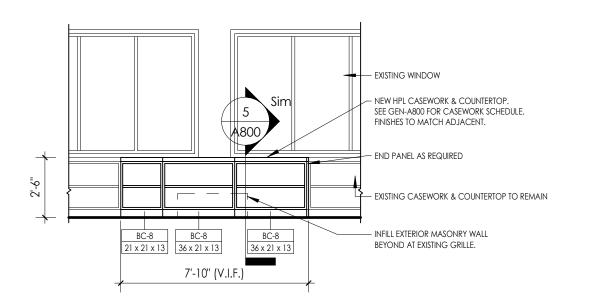




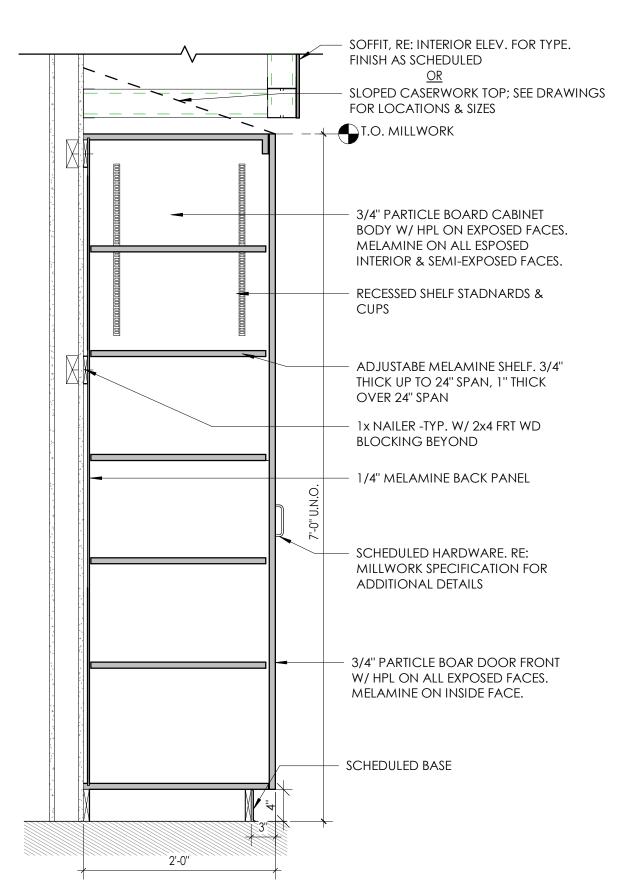


**NOTE:** REFER TO CASEWORK SCHEDULE FOR NUMBER OF DOORS/OPENINGS REQUIRED, VARIES.



**TYPICAL CASEWORK DETAIL - TALL CABINET** 1" = 1'-0"

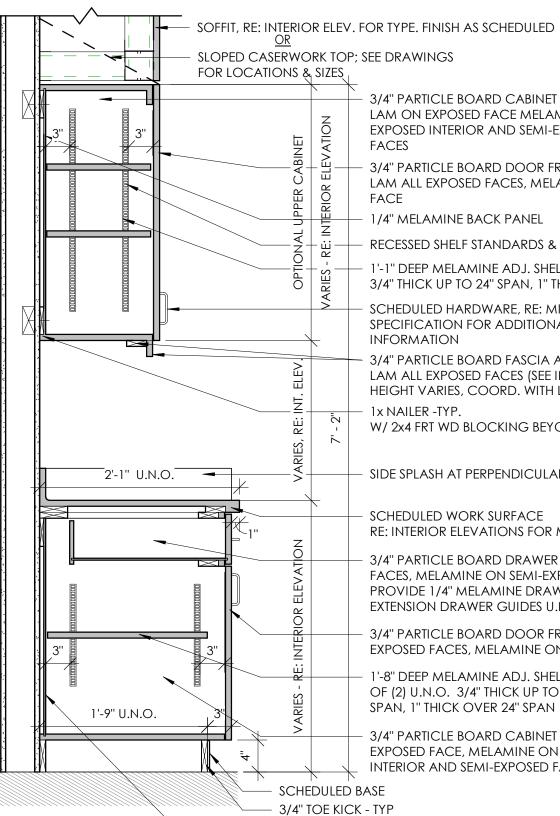

**NOTE:** REFER TO CASEWORK NUMBER OF DOORS/DRAWE

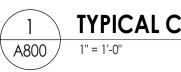

**TYPICAL CASEWORK DETAIL - BASE & UPPER CABINETS** 

36" X 33" X 24"		
	ADA SINK BASE	1136
36" X 33" X 24"	6" DRAWER/2/DOOR/1 ADJUSTABLE SHELF	D1122
36" X 33" X 24"	6" DRAWER/3 EQUAL DRAWERS	D4013
36" X 33" X 22 → 1	PAPER STORAGE/4 EQUAL DRAWERS	D5851
36" X 29" X 21"	→ OPEN SHELF/1 ADJUSTABLE SHELF	B1050
21" X 29" X 21"	OPEN SHELV/1 ADJUSTABLE SHELF	B1050
18" X 29" X 22"	2 Equal drawers/1 file drawer	D3007
18" X 29" X 22"	1 DRAWER/1 FILE DRAWER	D2801
36" X 29" X 13"	OPEN SHELF/1 ADJUSTABLE SHELF	B1050
36" X 29" X 14"	2 DOOR/1 ADJUSTABLE SHELF	W2052
42" X 29" X 14"	2 DOOR/1 ADJUSTABLE SHELF	W2052
36" X 27" 14"	MAILBOX/21 COMPARTMENTS W/ LABEL HOLDERS	W1820
48" X 84" X 24"	2 DOORS/IVERTICAL DIVIDER/8 ADJUSTABLE SHELVES	T2112
42" X 84" X 24"		T2112
30" X 84" X 14"		T2112 🔰
36" X 84" X 24"	1 DOOR/ DOUBLE COAT HOOK WARDROBE	T2511
		A1324
8.25" X 24.25"	30 DEGREE SLOPED TOP - LENGTH AS REQUIRED	A1324 AS REFERE
~~~~~~~~~~~~~~~~~~~~~~~~~~~~~~~~~~~~~~~		(CUSTOM DEPTH)
		······
`Г		
	. CASEWORK WITH DOORS/ DRAWERS TO REC	IEVE LOCKS PER
<u></u>	ER REQUEST. OWNER IS RESPONSIBLE FOR KEY	ING.
JET		
	36" X 33" X 24" 36" X 33" X 22" 36" X 29" X 21" 21" X 29" X 21" 18" X 29" X 22" 18" X 29" X 22" 18" X 29" X 22" 36" X 29" X 14" 42" X 29" X 14" 36" X 29" X 14" 36" X 27" 14" 48" X 84" X 24" 42" X 84" X 24" 42" X 84" X 24" 30" X 84" X 24" 30" X 84" X 24" 8.25" X 14.25" 8.25" X 14.25" 8.25" X 24.25" *NOTI SE 1. ALL BINET OWN	36" X 33" X 24" 6" DRAWER/3 EQUAL DRAWERS 36" X 33" X 22" PAPER STORAGE/4 EQUAL DRAWERS 36" X 29" X 21" OPEN SHELF/1 ADJUSTABLE SHELF 21" X 29" X 22" 2 EQUAL DRAWERS/1 FILE DRAWER 18" X 29" X 22" 1 DRAWER/1 FILE DRAWER 36" X 29" X 14" 2 DOOR/1 ADJUSTABLE SHELF 36" X 29" X 14" 2 DOOR/1 ADJUSTABLE SHELF 36" X 29" X 14" 2 DOOR/1 ADJUSTABLE SHELF 36" X 29" X 14" 2 DOOR/1 ADJUSTABLE SHELF 36" X 29" X 14" 2 DOOR/1 ADJUSTABLE SHELF 36" X 29" X 14" 2 DOOR/1 ADJUSTABLE SHELF 36" X 29" X 14" 2 DOOR/1 ADJUSTABLE SHELF 36" X 24" 1 DOOR/1 ADJUSTABLE SHELF 36" X 24" 2 DOORS/1 VERTICAL DIVIDER/8 ADJUSTABLE SHELVES 30" X 84" X 24" 2 DOORS/1 VERTICAL DIVIDER/8 ADJUSTABLE SHELVES 30" X 84" X 24" 1 DOOR/ DOUBLE COAT HOOK WARDROBE 8.25" X 14.25" 30 DEGREE SLOPED TOP - LENGTH AS REQUIRED 8.25" X 24.25" 30 DEGREE SLOPED TOP - LENGTH AS REQUIRED 8.25" X 24.25" 30 DEGREE SLOPED TOP - LENGTH AS REQUIRED 8.25" X 24.25" 30 DEGREE SLOPED TOP - LENGTH AS REQUIRED 8.25" X 24.25" 30 DEGREE SLOPED TOP - LENGTH AS REQUIRED

BY OTHERS. SHOWN FOR REFERENCE ONLY.

CPL | Architecture Engineering Planning 50 Front Street Suite 202, Newburgh, NY 12550 CPLteam.com pital Improvements Bon lealth. Safetv and Succes **PROJECT INFORMATION** Project Number 14457.20 Client Name SOUTH ORANGETOWN CENTRAL SCHOOL DISTRICT Project Name PHASE 1: 2022 BOND

District Office Address 160 VAN WYCK RD. BLAUVELT, NY 10913

south orangetown CSD


WILLIAM O. SCHAEFER SED#:50-03-01-06-0-012-019 COTTAGE LANE ELEMENTARY SED#:50-03-01-06-0-010-022 TAPPAN ZEE HIGH SCHOOL SED#:50-03-01-06-0-006-032 WILLIAM O. SCHAEFER S&L SED#: 50-03-01-06-0-012-020 COTTAGE LANE S&L SED#: 50-03-01-06-0-010-023 COTTAGE LANE LIBRARY S&L SED#: 50-03-01-06-8-023-002 WOS OUTDOOR CLASSROOM SED#:50-03-01-06-7-053-001 SOMS OUTDOOR CLASSROOM SED#:50-03-01-06-7-056-001 CLE OUTDOOR CLASSROOM SED#:50-03-01-06-7-054-001 TZHS OUTDOOR CLASSROOM SED#:50-03-01-06-7-055-001

PROJECT ISSUE & REVISION SCHEDULE No. Date 1 11/09/23 BID ADDENDUM #3

SLOPED CASERWORK TOP; SEE DRAWINGS

TIONS &		, SEE DRAWINGS			
NET		 3/4" PARTICLE BOARD CABINET BODY W/ LAM ON EXPOSED FACE MELAMINE ON ALL EXPOSED INTERIOR AND SEMI-EXPOSED FACES 			
UPPER CABINET	E: INTERIOR ELEV	 — 3/4" PARTICLE BOARD DOOR FRONT W/ LAM ALL EXPOSED FACES, MELAMINE ON INSIDE FACE 			
L UP	L L L L	— 1/4" MELAMINE BACK PANEL			
	- ш - ш	 RECESSED SHELF STANDARDS & CLIPS 			
	VARIES -	 — 1'-1" DEEP MELAMINE ADJ. SHELF, TYP OF (2) U.N.O. 3/4" THICK UP TO 24" SPAN, 1" THICK OVER 24" SPAN 			
	> \	 SCHEDULED HARDWARE, RE: MILLWORK SPECIFICATION FOR ADDITIONAL INFORMATION 			
T. ELEV.		 — 3/4" PARTICLE BOARD FASCIA AND NAILER W/ LAM ALL EXPOSED FACES (SEE INTERIOR ELEV.) HEIGHT VARIES, COORD. WITH LIGHT FIXTURE 			
ES, RE: INT.	7' - 2''	 1x NAILER -TYP. W/ 2x4 FRT WD BLOCKING BEYOND 			
VARIES,		 SIDE SPLASH AT PERPENDICULAR WALL(S) 			
Z		 SCHEDULED WORK SURFACE RE: INTERIOR ELEVATIONS FOR MATERIAL DESIGNATION 			
DR ELEVATION		 3/4" PARTICLE BOARD DRAWER W/ LAM ALL EXPOSED FACES, MELAMINE ON SEMI-EXPOSED FACES. PROVIDE 1/4" MELAMINE DRAWER BOTTOM AND FULL EXTENSION DRAWER GUIDES U.N.O. 			
INTERIOR		 3/4" PARTICLE BOARD DOOR FRONT W/ LAM ALL EXPOSED FACES, MELAMINE ON INSIDE FACE 			
VARIES - RE:		 1'-8" DEEP MELAMINE ADJ. SHELF, TYP OF (2) U.N.O. 3/4" THICK UP TO 24" SPAN, 1" THICK OVER 24" SPAN 			
>		 3/4" PARTICLE BOARD CABINET BODY W/ LAM ON EXPOSED FACE, MELAMINE ON ALL EXPOSED INTERIOR AND SEMI-EXPOSED FACES 			
– SCHE – 3/4'' T – 1/4'' N	OE KIC	-			
-		HEDULE FOR REQUIRED, VARIES.			

PROFESSIONAL STAMPS

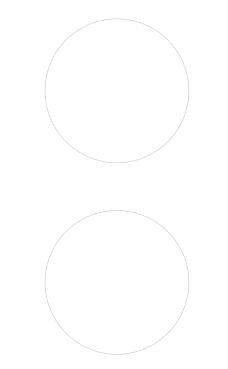

SHEET INFORMATION

LATION OF THE NEW YORK STATE EDUCATION LAW AND THE COM

REGULATIONS FOR ANY PERSON, UNLESS ACTING UNDER THE DIRECTION OF A LICENS ARCHITECT, ENGINEER OR LAND SURVEYOR, TO ALTER AN ITEM IN ANY WAY. IF AN ITE

BEARING THE SEAL OF AN ARCHITECT, ENGINEER OR SURVEYOR IS ALTERED, THE PARTY SHALL AFFIX TO THE ITEM THEIR SEAL AND THE NOTATION "ALTERED BY" FOI


NEW YORK STATE EDUCATION STATEME


Issued Scale 10/18/23 As indicated Project Status **BID DOCUMENTS** Drawn By Checked By CPL CPL


Drawing Title TYPICAL CASEWORK DETAILS


Drawing Number



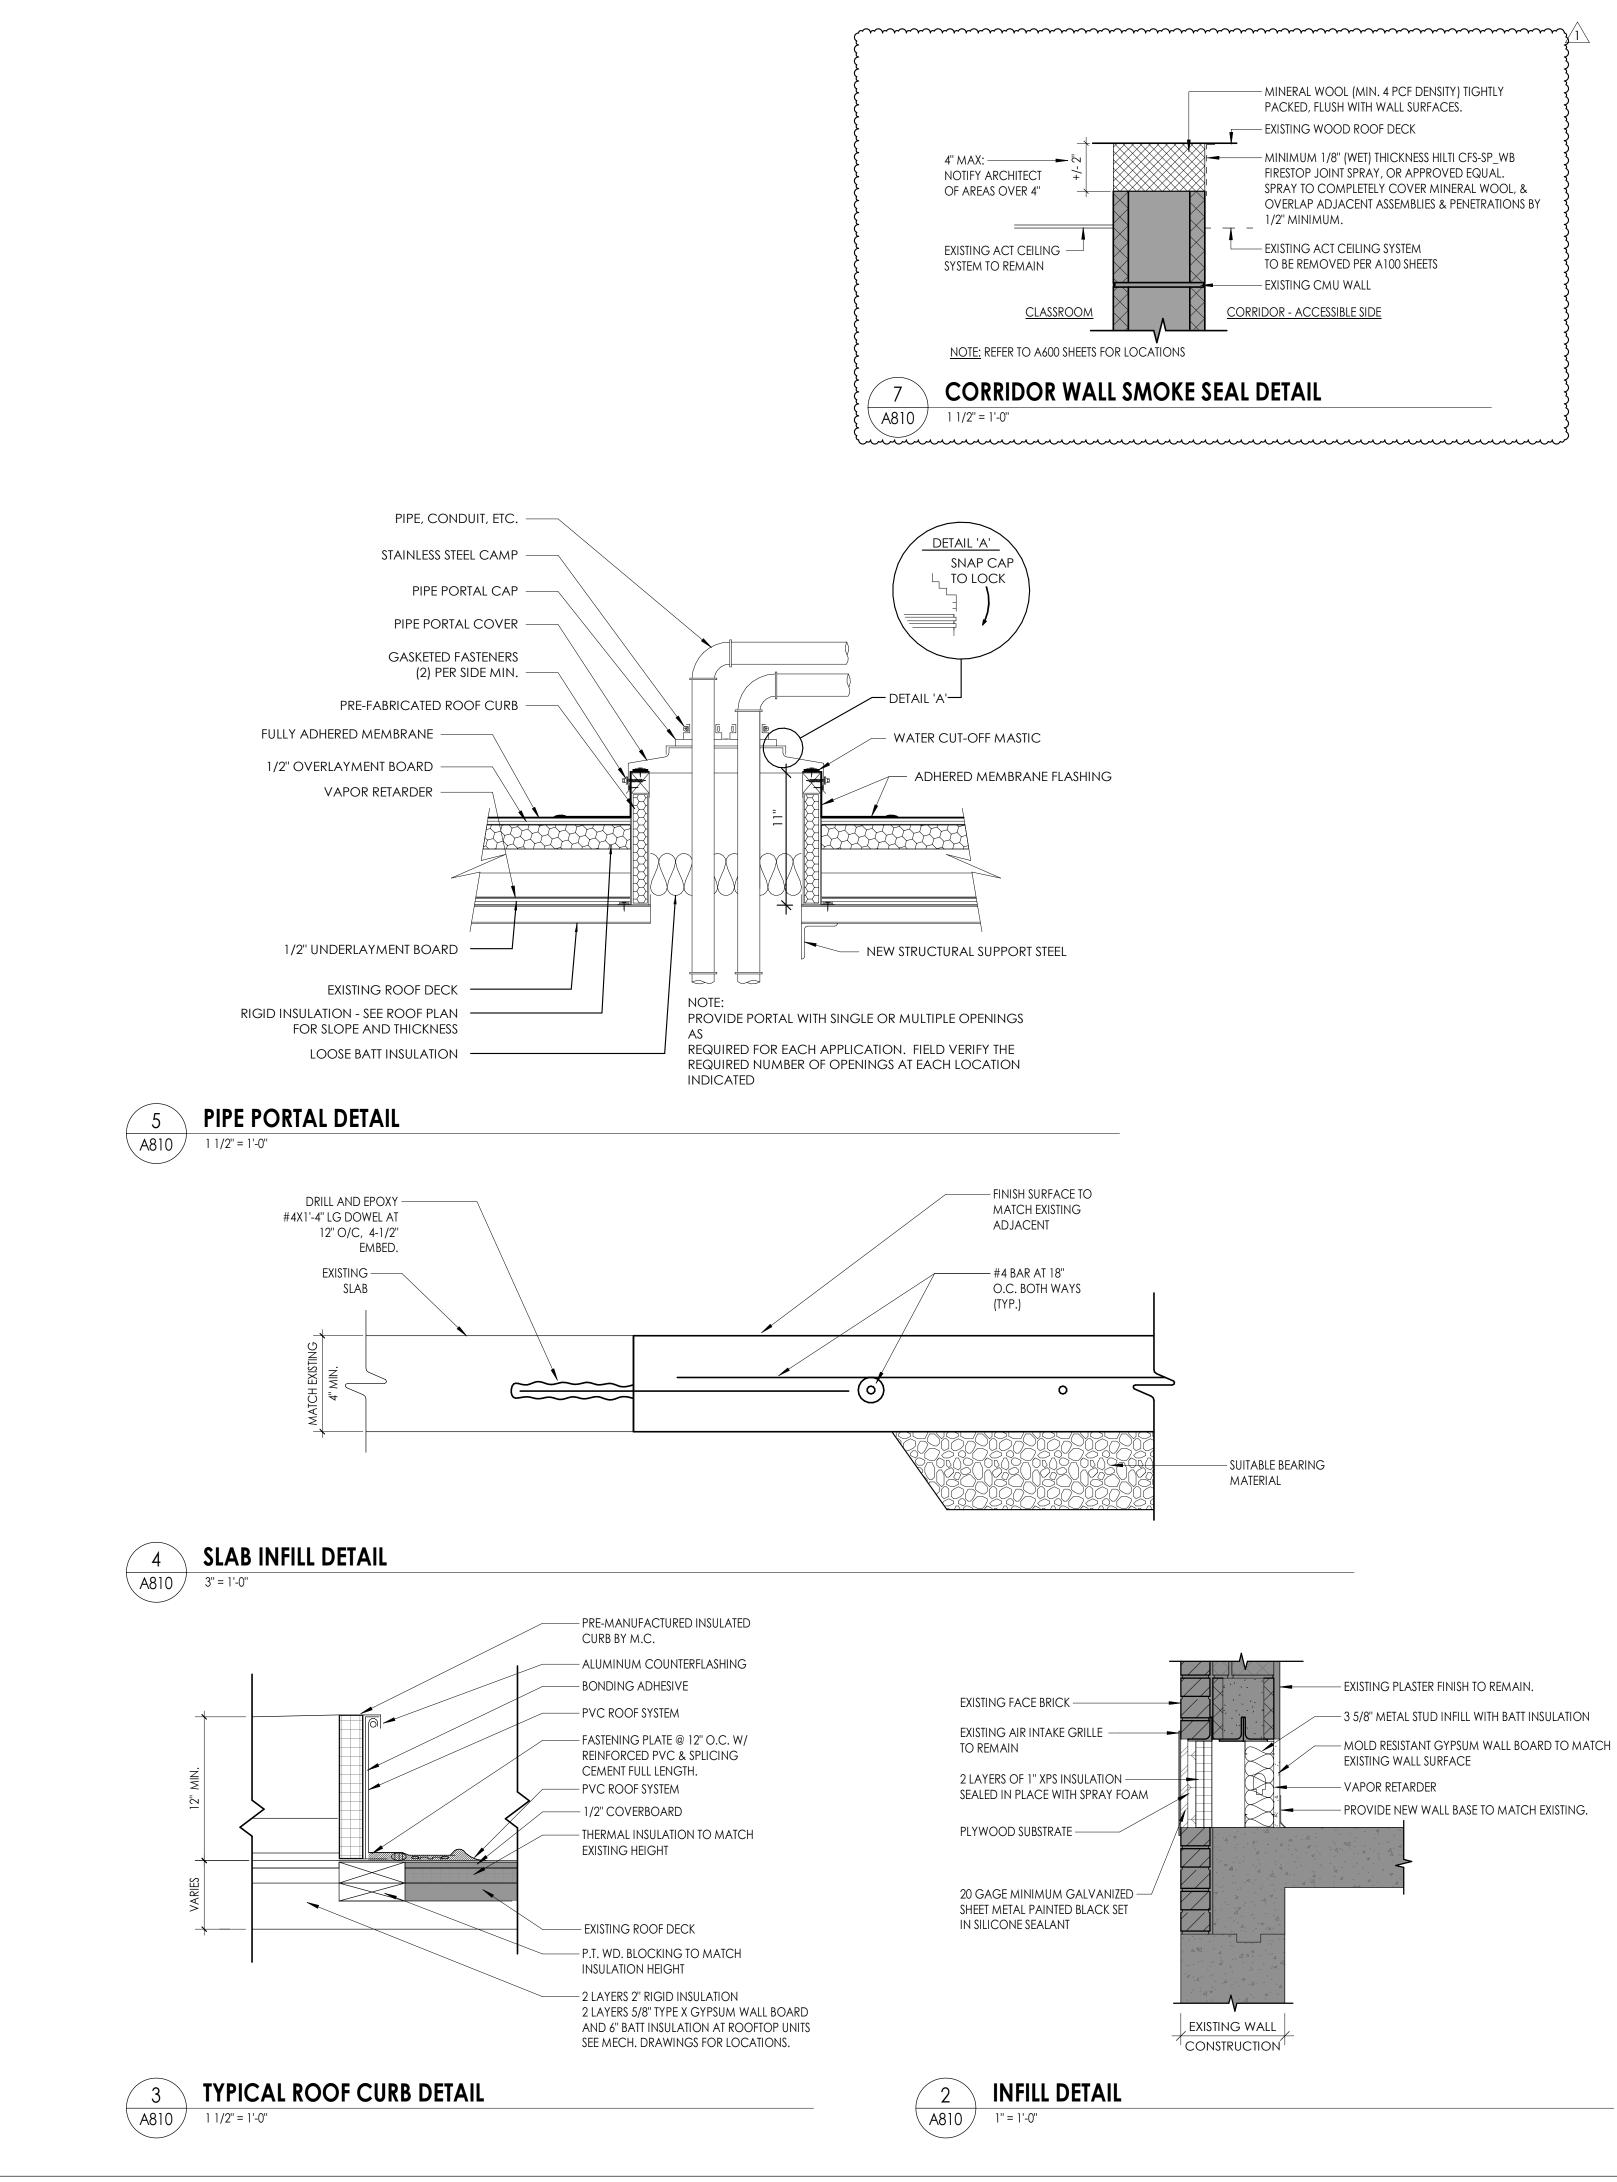


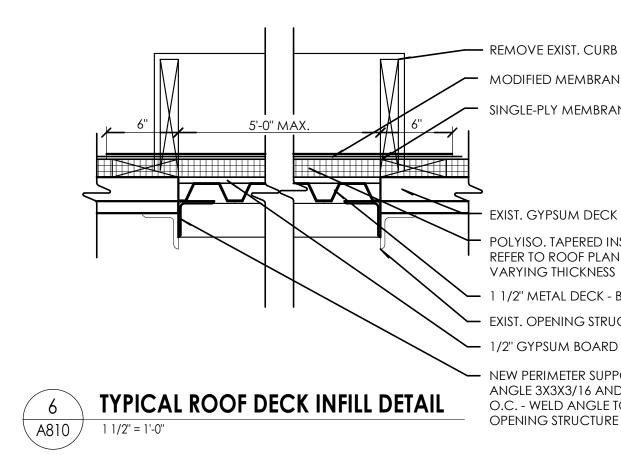

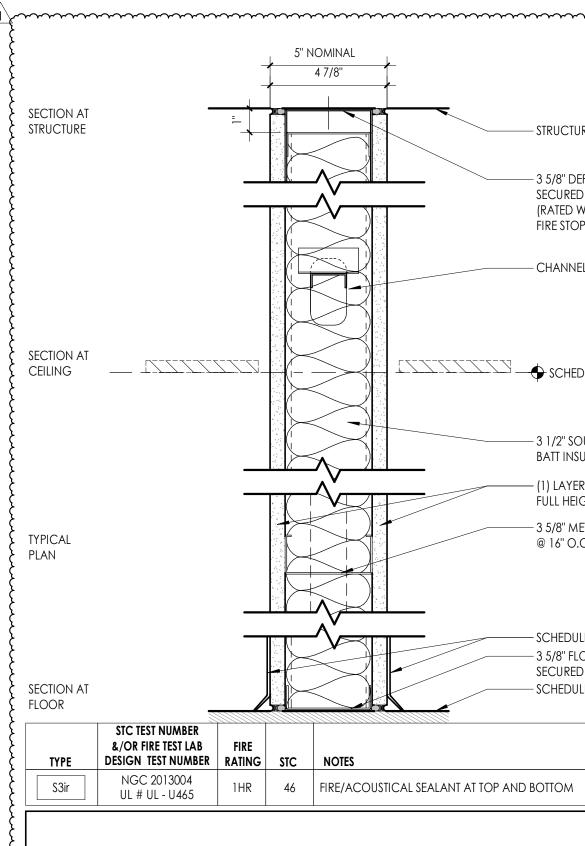

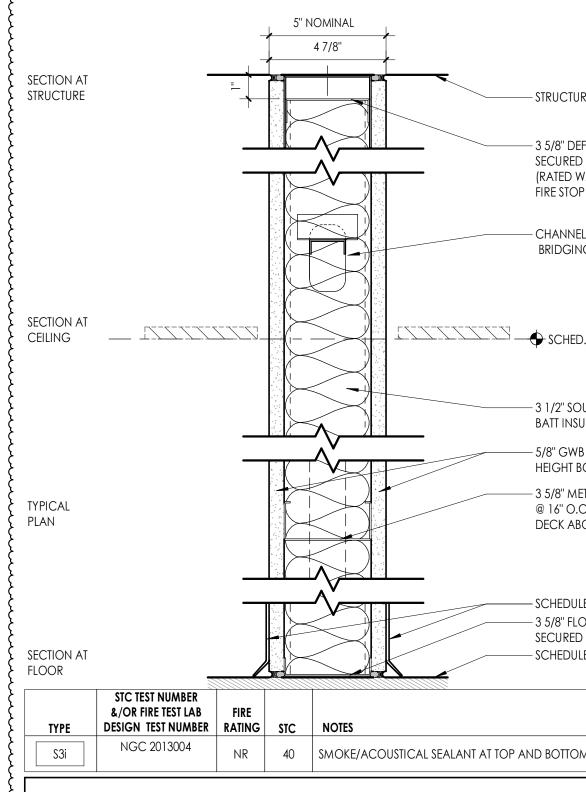

	PARTITION GENERAL NOTES	
6" REMOVE EXIST. CURB & CAP MODIFIED MEMBRANE SINGLE-PLY MEMBRANE	 ALL WALL TYPES MAY NOT BE USED ON THIS PROJECT. UNLESS NOTED OTHERWISE ALL PARTITIONS ARE FULL HEIGHT, EXTEND & SECURE TO UNDERSIDE OF CONCRETE OR METAL DECK ABOVE. PROVIDE UL APPROVED JOINT AT ALL TOP OF WALL AND WALL TO WALL CONDITIONS AT ALL RATED WALLS. PROVIDE DEFLECTION TRACKS AT METAL STUD PARTITIONS THAT TERMINATE AT THE UNDERSIDE OF STRUCTURE AND DECK. REFER TO CODE/LIFE SAFETY DRAWINGS FOR RATED PARTITIONS AND UL ASSEMBLIES. 	
EXIST. GYPSUM DECK TO REMAIN POLYISO. TAPERED INSULATION REFER TO ROOF PLAN FOR VARYING THICKNESS 1 1/2" METAL DECK - BY GC	 KELEK TO CODE/LITE SAFETT DRAWINGS FOR KARED FARMINGS AND GE ASSEMUELTS. REFER TO INTERIOR DRAWINGS FOR LOCATIONS OF WALL TILE, AND OTHER SPECIALTY WALL FINISHES. PROVIDE 5/8" TILE BACKER BOARD AT ALL WALLS RECEIVING TILE. PROVIDE MOISTURE RESISTANT GYP. BD. AT ALL TOILET ROOMS, JANITOR'S CLOSETS AND OTHER WET LOCATIONS WHERE TILE AND TILE BACKER BOARD ARE NOT INSTALLED. PARTITION TYPES WITH ONE SIDE OF DOUBLE DRYWALL TO BE PLACED SO THAT THE DOUBLE SIDE IS ON CORRIDOR AND/OR HIGH TRAFFIC SIDE OF WALL. REFER TO SPECIFICATIONS FOR METAL STUD GAUGE REQUIREMENTS. COORDINATE ALL PARTITION ACCESSORIES (APPLIED FINISHES, RESILIENT CHANNEL, ADDITIONAL LAYERS OF SHEATHING, SHIELDING, ETC.) ITEMS SHOWN IN TYPICAL WALL CONSTRUCTION DETAILS MAY HAVE TO BE ARRANGED ON DIFFERENT SIDES OF WALL ASSEMBLY TO ACHIEVE FLUSH CONTINUOUS WALL SURFACES. ANY CONFLICTS SHOULD BE BROUGHT TO THE ATTENTION OF THE 	CPL Architecture Engineering Planning 50 Front Street Suite 202, Newburgh, NY 12550 CPLteam.com
TYPICAL ROOF DECK INFILL DETAIL I 1/2" GYPSUM BOARD New PERIMETER SUPPORT ANGLE 3X3X3/16 AND @ 4'-0" O.C WELD ANGLE TO EXIST. OPENING STRUCTURE	 ARCHITECT. 11. FIRESTOP/ SMOKE STOP ALL REQUIRED WALL PARTITIONS, SLABS, AND PENETRATIONS THROUGH NEW AND EXISTING WALLS WITHIN THE PROJECT LIMITS IN COORDINATION WITH CODE PLAN, OR WHERE COORDINATED SYSTEMS CONNECTION POINTS ARE LOCATED OUTSIDE THE PROJECT LIMIT AREA. SEE ARCHITECTURAL, MECHANICAL, ELECTRICAL, PLUMBING DRAWINGS AND SPECIFICATION DIVISION 7. 12. NOTIFY OWNER AND ARCHITECT IF EXISTING NON-COMPLIANT PENETRATIONS ARE DISCOVERED NOT FIRESTOPPPED IN COORDINATION WITH CODE PLAN. 13. PROVIDE CONTROL JOINT WHERE NEW PARTITIONS BUTT EXISTING CONSTRUCTION. 14. PROVIDE CONTROL JOINTS A MAXIMUM OF 30'-0" APART UNLESS NOTED OTHERWISE, PER ASTM C 	Central School District
5" NOMINAL	840-17A. LOCATE ABOVE DOOR FRAMES WHERE POSSIBLE. 15. PROVIDE SUPPORT BLOCKING AND STRAPPING FOR ALL MILLWORK, CASEWORK, AND WALL MOUNTED ACCESSORIES.	Health, Safety and Success
	PARTITION TYPE TAG LEGEND	PROJECT INFORMATION Project Number
SECTION AT STRUCTURE STRUCTURAL DECK	PARTITION CONSTRUCTION TYPE RATING SUFFIX	14457.20 Client Name
3 5/8" DEFLECTION TRACK SECURED TO STRUCT. (RATED WALLS TO HAVE FIRE STOP TRACK)	ACCESSORY SUFFIX(S) SEE LEGEND BELOW	SOUTH ORANGETOWN CENTRAL SCHOOL DISTRICT Project Name PHASE 1: 2022 BOND
CHANNEL BRIDGING	PARTITION CONSTRUCTION TYPE & SIZE LEGEND	
SECTION AT CEILING SCHED. CEILING	S#STEEL STUDSM#CONCRETE MASONRY UNIT $fINISH BOTH SIDES$ $4 = 4" NOMINAL CMU$ $1 = 15/8" C STUD$ $6 = 6" NOMINAL CMU$ $2 = 21/2" C STUD$ $8 = 8" NOMINAL CMU$ $3 = 35/8" C STUD$ $10 = 10" NOMINAL CMU$ $4 = 4" C STUD$ $12 = 12" NOMINAL CMU$	District Office Address 160 VAN WYCK RD. BLAUVELT, NY 10913
	6 = 6" C STUD 8 = 8" C STUD F# STEEL STUD FURRING	SOUTH ORANGETOWN CSD UILIAM O. SCHAEFER SED#:50-03-01-06-0-012-019 COTTAGE LANE ELEMENTARY SED#:50-03-01-06-0-010-022 TAPPAN ZEE HIGH SCHOOL SED#:50-03-01-06-0-006-032
3 1/2" SOUND ATTENUATING BATT INSULATION (1) LAYER TYPE X 5/8" GWB	 FINISH ONE SIDE 1 = 1 5/8" C STUD 2 = 2 1/2" C STUD 3 = 3 5/8" C STUD 	 ☐ WILLIAM O. SCHAEFER S&L SED#: 50-03-01-06-0-012-020 ☐ COTTAGE LANE S&L SED#: 50-03-01-06-0-010-023 ☐ COTTAGE LANE LIBRARY S&L SED#: 50-03-01-06-8-023-002 ☐ WOS OUTDOOR CLASSROOM SED#:50-03-01-06-7-053-001 ☐ SOMS OUTDOOR CLASSROOM SED#:50-03-01-06-7-056-001
FULL HEIGHT BOTH SIDES 3 5/8" METAL STUDS @ 16" O.C.	 4 = 4" C STUD 6 = 6" C STUD 8 = 8" C STUD W# STEEL STUD SHAFT WALL ASSEMBLY FINISH ONE SIDE C# RESILIENT CHANNEL NON SELF SUPPORTING/ATTACHED TO OTHER STRUCTURE 1 = 1/2" RC-1 RESILIENT CHANNEL 2 = 1/2" RC-2 RESILIENT CHANNEL 	CLE OUTDOOR CLASSROOM SED#:50-03-01-06-7-054-001 T7HS OUTDOOR CLASSROOM SED#:50-03-01-06-7-055-001 PROJECT ISSUE & REVISION SCHEDULE No. Date Description
	 FINISH ONE SIDE 2 = 2 1/2" CH SHAFT WALL STUD 4 = 4" CH SHAFTWALL STUD H# HAT CHANNEL NON SELF SUPPORTING/ATTACHED TO OTHER 	1 11/09/23 BID ADDENDUM #3
SCHEDULED BASE 3 5/8" FLOOR RUNNER SECURED TO FLOOR SCHEDULED FLOORING SCHEDULED FLOORING SCHEDULED FLOORING SCHEDULED FLOORING	 6 = 6" CH SHAFTWALL STUD B# CONSTRUCTION BARRIER/TEMP WALL 1 = 1 5/8" C STUD 2 = 2 1/2" C STUD 3 = 3 5/8" C STUD 4 = 4" C STUD 6 = 6" C STUD 8 = 8" C STUD 2 = 2 1/2" C E FURRING 1 = 1" ZEE FURRING 1 = 1" ZEE FURRING 1 = 1" ZEE FURRING 2 = 2" ZEE FURRING 2 = 2" ZEE FURRING 	
S3ir NGC 2013004 UL # UL - U465 1HR 46 FIRE/ACOUSTICAL SEALANT AT TOP AND BOTTOM	 2.5 = 2 1/2" ZEE FURRING 3 = 3" ZEE FURRING 	
	ACCESSORIES SUFFIX:	
5" NOMINAL 4 7/8"	i - SOUND ATTENUATING BATT INSULATION (FIBERGLASS) FRICTION FIT BETWEEN STUDS TO FILL CAVITY w - SOUND ATTENUATING FIRE BATT INSULATION (ROCK WOOL) FRICTION FIT BETWEEN STUDS TO FILL	PROFESSIONAL STAMPS
SECTION AT STRUCTURE STRUCTURAL DECK	CAVITY † - CERAMIC WALL TILE (1) SIDE W/ THINSET MORTAR BED, 5/8" CEMENT BACKER BOARD IN LIEU OF 5/8" GYP. AT TILE LOCATIONS - SEE INTERIOR ELEVATIONS FOR TILE EXTENTS	
3 5/8" DEFLECTION TRACK SECURED TO STRUCT. (RATED WALLS TO HAVE	tt - CERAMIC WALL TILE (2) SIDES W/ THINSET MORTAR BED, 5/8" CEMENT BACKER BOARD IN LIEU OF 5/8" GYP. AT TILE LOCATIONS - SEE INTERIOR ELEVATIONS FOR TILE EXTENTS	
FIRE STOP TRACK)	b - INTERIOR VENEER MASONRY/STONE APPLIED FINISH, REFER TO DETAILS FOR CONSTRUCTION, AND INTERIOR ELEVATIONS FOR EXTENTS	
BRIDGING	g - CMU WALL GROUT CORES SOLID s - ADD 1/2" RC1 RESILIENT SOUND CHANNEL BEHIND SPECIFIED SHEATHING	
	k - ADD ADDITIONAL (1) LAYER OF 5/8" GYP BOARD, TO ONE SIDE OF WALL kk - ADD ADDITIONAL (2) LAYERS OF 5/8" GYP BOARD, (1) EA. SIDE OF WALL	
CEILING SCHED. CEILING	e - ADD ADDITIONAL (1) LAYER OF 5/8" FRT PLYWOOD BOLTED TO WALL FOR MOUNTING OF ELECTRICAL PANELS/ EQUIPMENT WHERE NOTED ON ELEC. DWGS.	
3 1/2" SOUND ATTENUATING BATT INSULATION	v - SUBSTITUE (1) LAYER OF 5/8" SOUNDBLOCK GYP. W/ INTEGRAL VISCOELASTIC POLYMER CORE FOR (1) LAYER OF SPECIFIED 5/8" TYPE X GYP.	NEW YORK STATE EDUCATION STATEMENT
5/8" GWB FULL HEIGHT BOTH SIDES	vv - SUBSTITUE 5/8" SOUNDBLOCK GYP. W/ INTEGRAL VISCOELASTIC POLYMER CORE FOR ALL LAYER OF SPECIFIED 5/8" TYPE X GYP.	IT IS A VIOLATION OF THE NEW YORK STATE EDUCATION LAW AND THE COMMISSIONERS REGULATIONS FOR ANY PERSON, UNLESS ACTING UNDER THE DIRECTION OF A LICENSED ARCHITECT, ENGINEER OR LAND SURVEYOR, TO ALTER AN ITEM IN ANY WAY. IF AN ITEM BEARING THE SEAL OF AN ARCHITECT, ENGINEER OR SURVEYOR IS ALTERED, THE ALTERING PARTY SHALL AFIR TO THE ITEM THER SEAL AND THE NOTATION "ALTERED BY "FOLLOWED BY THEIR SIGNATURE AND THE DATE OF SUCH ALTERATION, AND A SPECIFIC DESCRIPTION OF THE ALTERATION
TYPICAL PLAN 3 5/8" METAL STUDS @ 16" O.C. TO STRUCTURAL DECK ABOVE	p - LEAD SHIELDING REFER TO PHYSICIST REPORT FOR REQUIREMENTS x - COPPER MAGNETIC/RF SHIELDING REFER TO PHYSICIST REPORT FOR REQUIREMENTS	SHEET INFORMATION Issued Scale
	c - WALL FINISH TO TERMINATE 6" ABV. HIGHEST ADJACENT CEILING STUDS TO RUN TO UNDERSIDE OF DECK ABOVE.	10/18/23 As indicated Project Status BID DOCUMENTS
SCHEDULED BASE 3 5/8" FLOOR RUNNER SECURED TO FLOOR	y - WALL STRUCTURE TERMINATES 12" ABV. HIGHEST ADJACENT CEILING, PROVIDE STRUCTURAL BRACING AT TOP OF WALL AS REQUIRED.	Drawn By Checked By Author Checker Drawing Title
SECTION AT FLOOR STC TEST NUMBER	n - KNEE WALL, REFER TO INTERIOR ELEVATIONS FOR HEIGHT & SILL CONDITION, REFER TO STRUCTURAL DETAILS FOR REQUIRED SUPPLEMENTAL STEEL AND ANCHORING REQUIREMENTS	WALL TYPES & MISC. DETAILS
&/OR FIRE TEST LAB FIRE TYPE DESIGN TEST NUMBER RATING STC NOTES S3i NGC 2013004 NR 40 SMOKE/ACOUSTICAL SEALANT AT TOP AND BOTTOM	RATING SUFFIX: r - 1 HR RATED ASSEMBLY REFER TO UL DETAILS FOR RATED CONSTRUCTION REQUIREMENTS	
INK 40 SMOKE/ACOUSTICAL SEALANT AT TOP AND BUTTOM	d - 2 HR RATED ASSEMBLY REFER TO UL DETAILS FOR RATED CONSTRUCTION REQUIREMENTS	
		A810

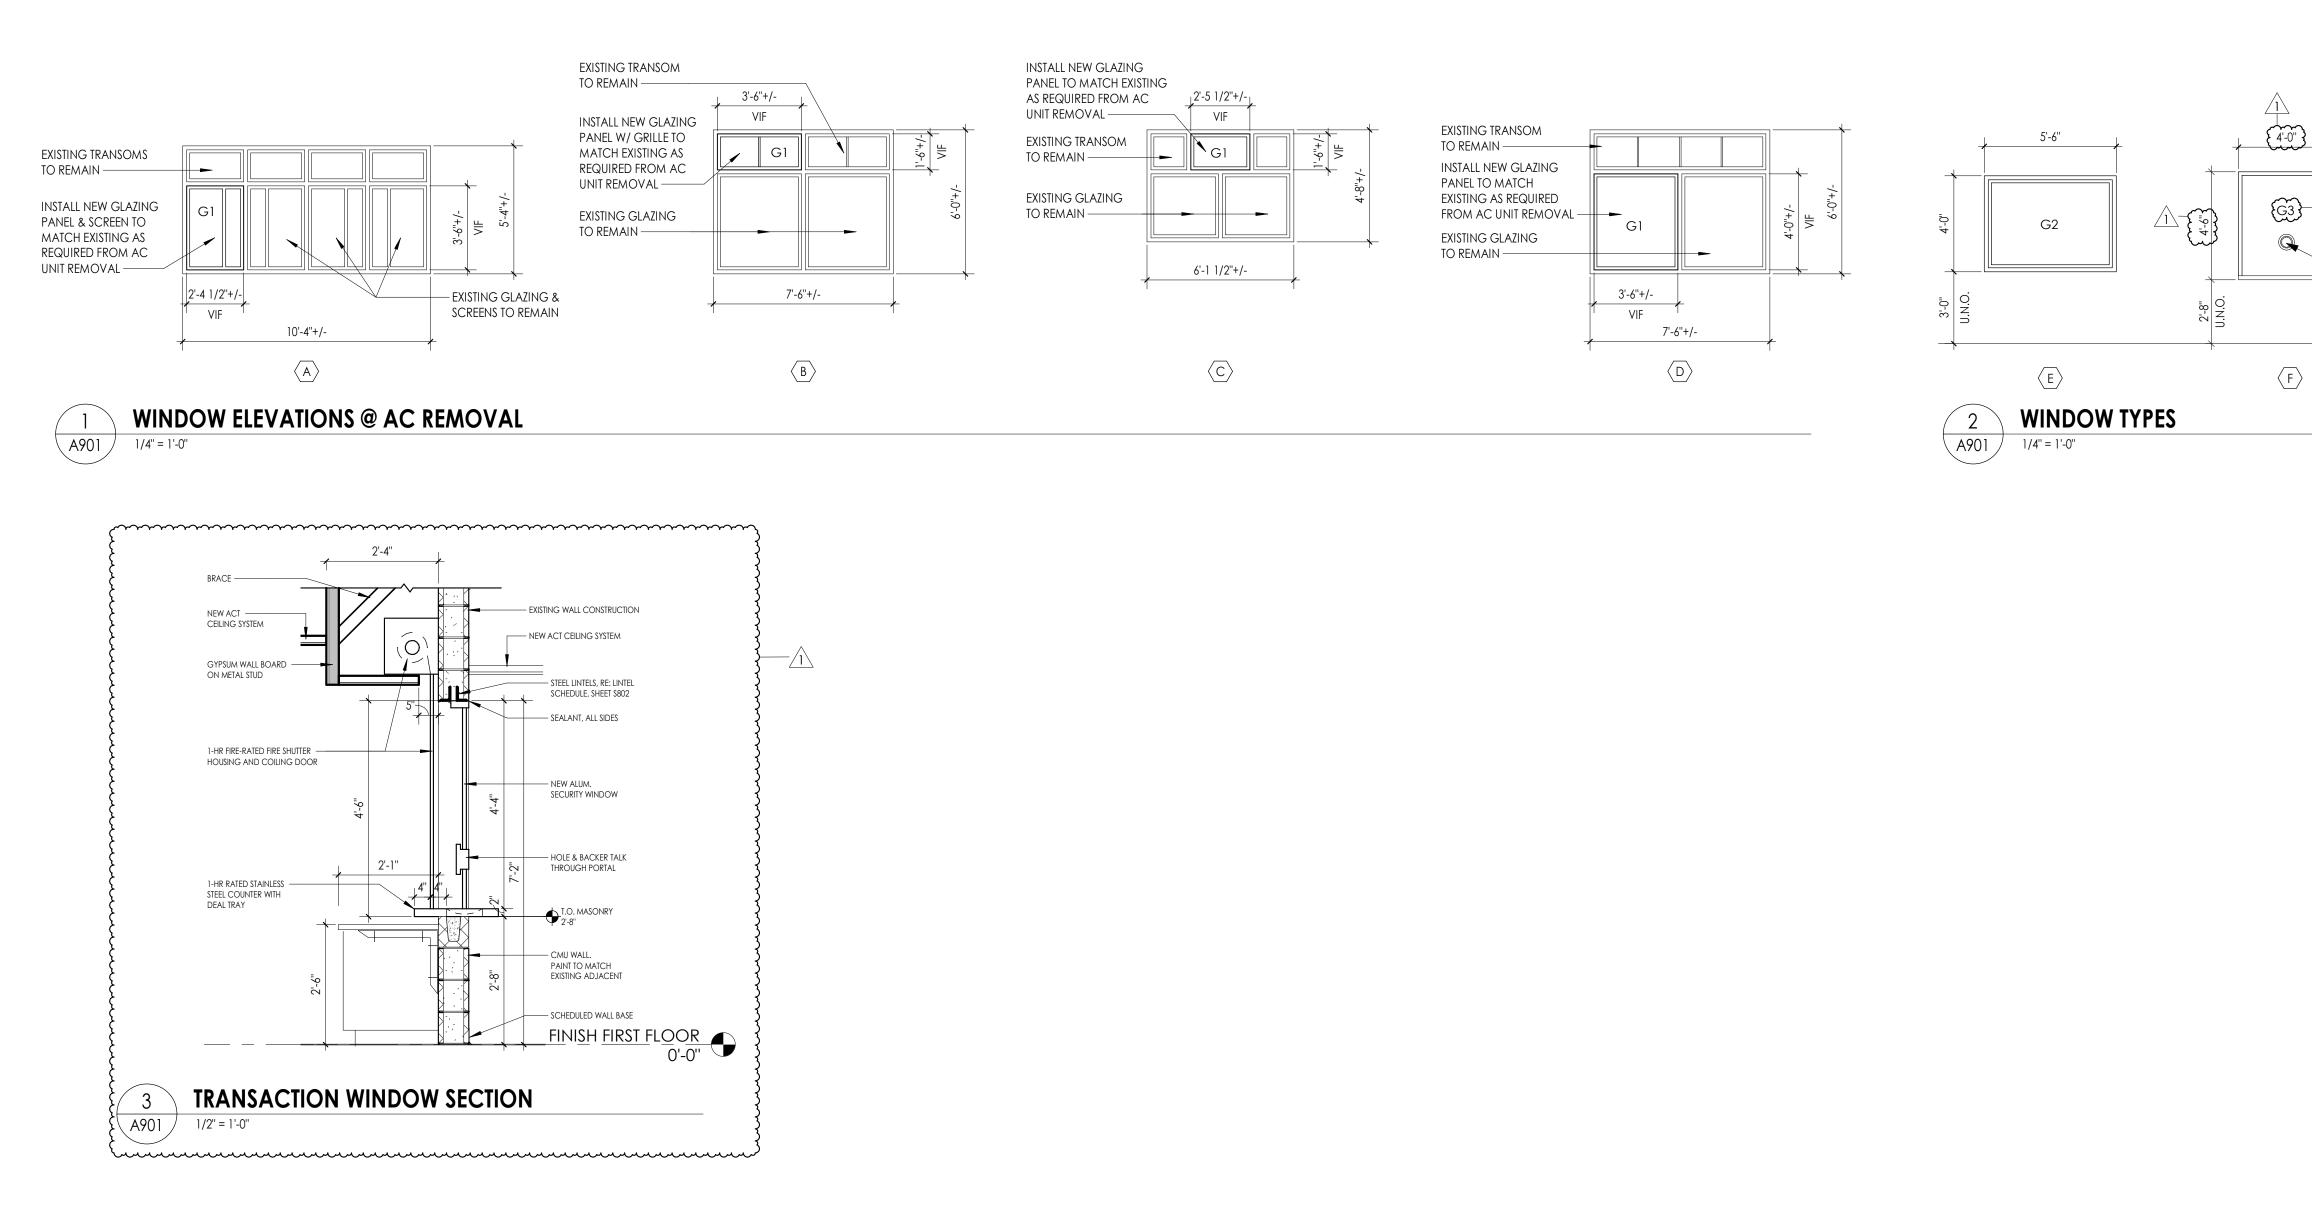

WINDOW GENERAL NOTES

- 1. COORDINATE ALL FRAME SIZES, TRIM EXTRUSIONS AND SILLS WITH WALL SECTIONS
- AND DETAILS. 2. ALL FRAMES ARE TO RECEIVE FULL PERIMETER SEALANT. INTERIOR AND EXTERIOR
- 3. ALL DOOR AND WINDOW DIMENSIONS ARE TO BE VERIFIED IN FIELD PRIOR TO FABRICATION.
- 4. REFER TO DIMENSION PLANS AND WALL SECTIONS FOR MULLION LAYOUT DIMENSIONS.

GLAZING TYPES

G1 - INSULATED GLAZING G2 - FIRE RATED GLAZING G3 - TEMPERED GLAZING

FINISH FLOOR

 $\langle F \rangle$

Q

CPL | Architecture Engineering Planning 50 Front Street Suite 202, Newburgh, NY 12550 CPLteam.com SOUTH ORANGETO Central School Dist Capital Improvements Bond Health, Safety and Success

PROJECT INFORMATION Project Number 14457.20

Client Name SOUTH ORANGETOWN CENTRAL SCHOOL DISTRICT Project Name

PHASE 1: 2022 BOND


District Office Address 160 VAN WYCK RD. BLAUVELT, NY 10913

south orangetown CSD

WILLIAM O. SCHAEFER SED#:50-03-01-06-0-012-019 COTTAGE LANE ELEMENTARY SED#:50-03-01-06-0-010-022 TAPPAN ZEE HIGH SCHOOL SED#:50-03-01-06-0-006-032 WILLIAM O. SCHAEFER S&L SED#: 50-03-01-06-0-012-020 COTTAGE LANE S&L SED#: 50-03-01-06-0-010-023 COTTAGE LANE LIBRARY S&L SED#: 50-03-01-06-8-023-002 WOS OUTDOOR CLASSROOM SED#:50-03-01-06-7-053-001 SOMS OUTDOOR CLASSROOM SED#:50-03-01-06-7-056-001 CLE OUTDOOR CLASSROOM SED#:50-03-01-06-7-054-001 TZHS OUTDOOR CLASSROOM SED#:50-03-01-06-7-055-001

PROJECT ISSUE & REVISION SCHEDULE No. Date Description 1 11/09/23 BID ADDENDUM #3

PROFESSIONAL STAMPS

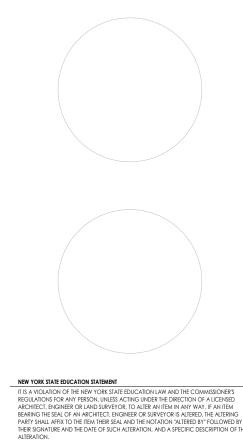

SHEET INFORMATION Issued

10/18/23

Project Status

Scale As indicated


BID DOCUMENTS Drawn By Checked By LF LT

Drawing Title WINDOW TYPES

Drawing Number



-TALK THROUGH PORTAL

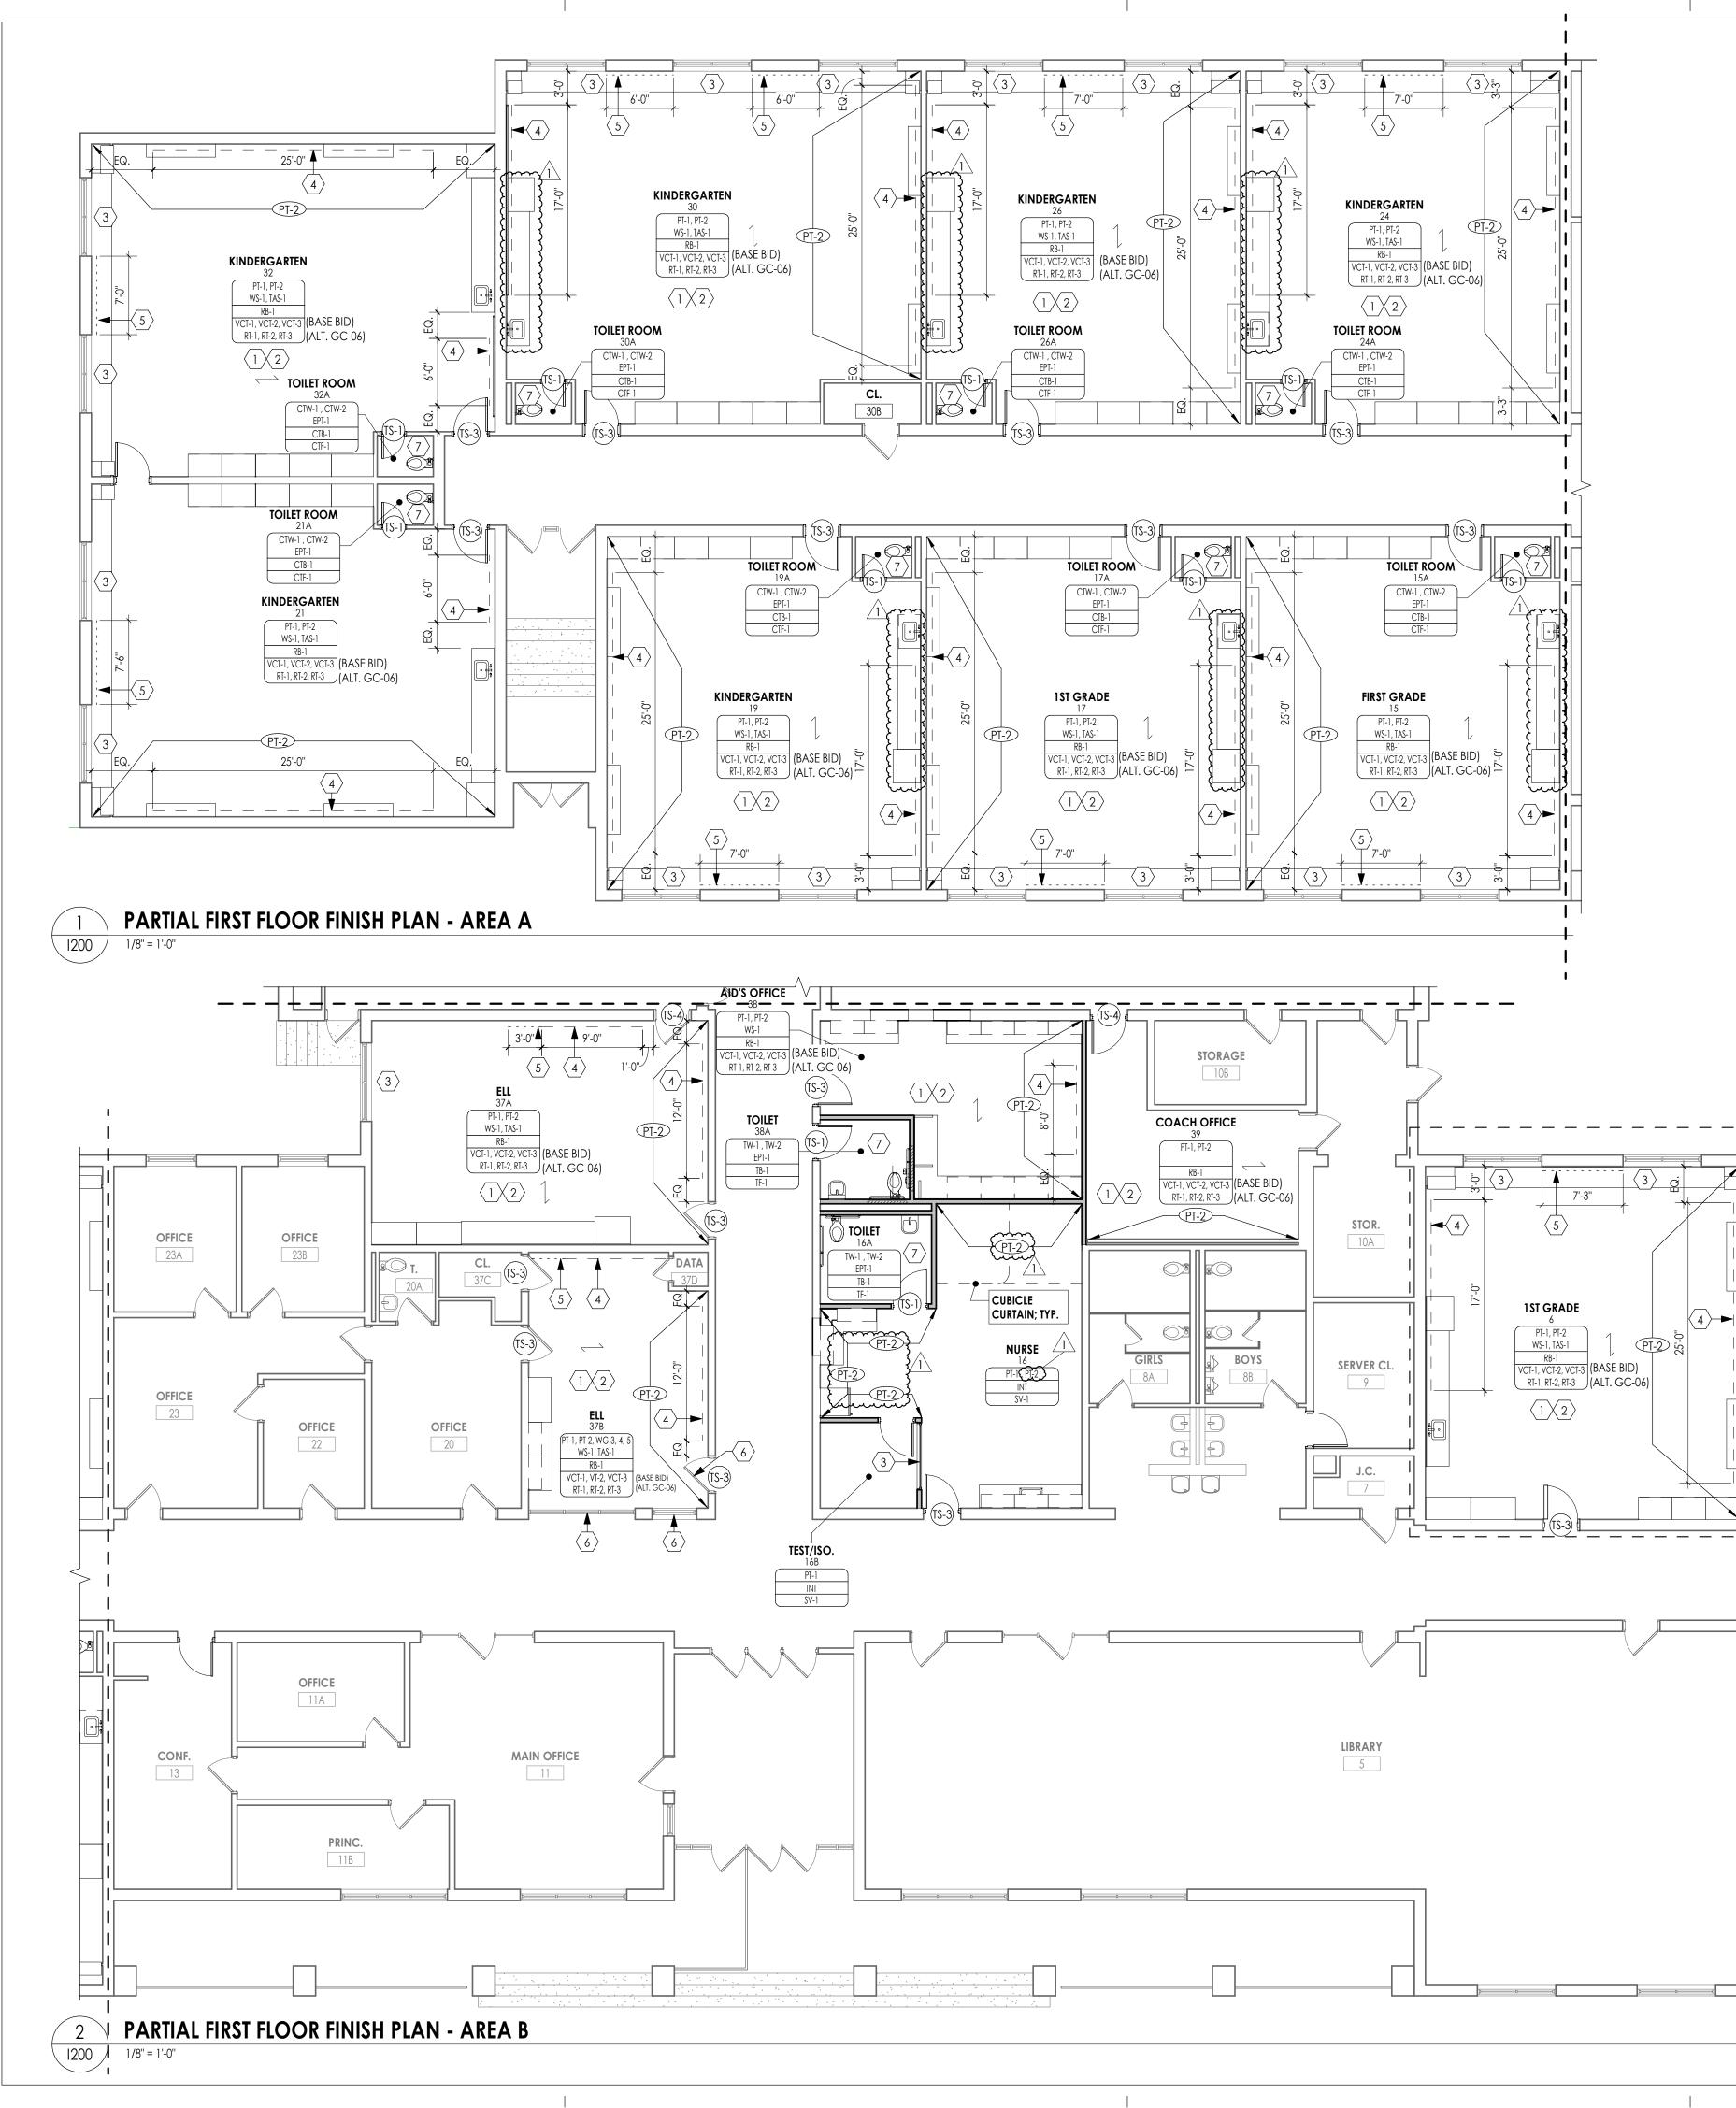

BASE BID: PROVIDE 3-COLOR PATTERN (VCT-1,2,3) WITH RESILIENT BASE. RANDOM PATTERN: 60% VCT-1, 20% VCT-2, 20% VCT-3. 2 <u>ALTERNATE BID # GC-06</u>: PROVIDE 3-COLOR PATTERN (RT-1,2,3) WITH RESILIENT BASE. RANDOM PATTERN: 60% RT-1, 20% RT-2, 20% RT-3. \rightarrow ADDITIONAL INFORMATION. PROVIDE WRITEABLE/MAGNETIC SURFACE (WS-1) 2-6" AFF. SEE A700 SERIES FOR ADDITIONAL INFORMATION. WALL TO RECEIVE LEVEL 5 FINISH. PROVIDE TACKABLE SURFACE (TAS-1) 2-6" AFF. SEE A700 SERIES FOR ADDITIONAL -/ INFORMATION. ⁶/ SCHEDULE & ADDITIONAL DETAIL. $^{-\!/}$ EPOXY PAINT (EPT-1) ABOVE. REFER TO TYPICAL TILE PATTERN "A" ON 1000 FOR DETAIL. $\overline{8}$ PROVIDE SCHEDULED LVT IN ASHLAR INSTALLATION. PROVIDE SCHEDULED CPT IN QUARTER-TURN INSTALLATION. $\overline{(10)}$ PROVIDE WOC-1 IN QUARTER-TURN INSTALLATION. ^{1/2} FOR GRAPHICS SCHEDULE & ADDITIONAL DETAIL. PROVIDE INTEGRAL RESILIENT STAIR TREAD (RST-1) & RISERS AT STAIR LOCATIONS. PAINT STRINGERS & RAILING PT-2. PROVIDE LVT-2 & RB-1 AT LANDING. $\overline{13}$ PROVIDE VCT-1 IN ASHLAR INSTALLATION. PROVIDE 2 COLOR PAINT PATTERN WITH VINYL ADHERED SIGNAGE. SEE 2-1200 FOR ADDITIONAL DETAIL. PROVIDE 4-COLOR PATTERN ACOUSTIC WALL PANELS (AWP). SEE A700 SERIES &

FINISH PLAN KEY NOTES

- \nearrow PROVIDE DIGITALLY PRINTED WALL GRAPHIC FULL HEIGHT OF WALL. REDER TO 1001
- $\frac{15}{2}$ finish schedule for additional information.

FINISH PLAN GENERAL NOTES

- ALL NEW AND EXISTING HOLLOW METAL DOORS, DOOR FRAMES AND WINDOW FRAMES IN PROJECT SCOPE SHALL BE PAINTED (PT-3), UNLESS NOTED OTHERWISE. ALL LOUVERS, VENTS, GRILLES AND OTHER MISCELLANEOUS MECHANICAL AND ELECTRICAL DEVICES ARE TO BE PAINTED TO MATCH THE SURFACE ON WHICH THEY
- APPEAR, UNLESS NOTED OTHERWISE. REFER TO A600 SERIES DRAWINGS FOR CEILING TYPES AND SOFFIT FINISHES. UNDERSIDE OF SOFFITS TO MATCH FACE OF SOFFIT. SEE A600 SERIES FOR PAINT ACCENT
- SPECIFICATIONS. PAINT GWB CEILINGS (PT-4), UNLESS NOTED OTHERWISE.
- REFER TO A700 SERIES INTERIOR ELEVATIONS FOR MILLWORK FINISHES. ALL WINDOW SILLS SHALL BE **SSM-1**, UNLESS OTHERWISE NOTED.
- HIGH PRESSURE PLASTIC LAMINATE ON VERTICAL SURFACES TO RUN VERTICALLY, UNLESS NOTED OTHERWISE.
- WHERE KICKSPACES OCCUR AT MILLWORK, FLOOR FINISH SHOWN ON PLANS SHALL RUN UNDERNEATH KICKSPACE AS WELL. . REFER TO **I300** FOR FLOOR PATTERN PLANS & DETAILS.
- . ALL FLOOR FINISHES SHALL TRANSITION AT THE CENTERLINE OF THE DOOR, UNLESS NOTED OTHERWISE. INSTALL TRANSITION STRIPS PER DETAILS ON 1000.
- PROVIDE CONCRETE FLOOR PREPARATION IN ACCORDANCE WITH FLOORING MANUFACTURER SPECIFICATION. . ALL NON-EPOXY GROUT TO BE SEALED A MINIMUM OF TWO TIMES PRIOR TO

FLOOR PATTERNING GENERAL NOTES

- ALL FLOOR FINISHES SHALL TRANSITION AT THE CENTERLINE OF THE DOOR, UNLESS OTHERWISE NOTED. INSTALL TRANSITION STRIPS PER DETAILS. PROVIDE ADA ACCESSIBLE MARBLE THRESHOLD AT ALL TOILET ROOM DOORS UNLESS
- OTHERWISE NOTED. ALL AREAS WITH INTEGRAL BASE SHALL BE AT 4" A.F.F. BASE SHALL BE THE SAME COLOR AS THE ADJACENT FLOORING MATERIAL, UNLESS OTHERWISE NOTED. WHERE KICKSPACES OCCUR AT MILLWORK, FLOOR FINISH SHOWN ON PLANS SHALL RUN UNDERNEATH KICKSPACE AS WELL.

FINISH ABBREVIATIONS

COMPLETION.


NOTE: THIS LEGEND MAY CONTAIN ABBREVIATIONS THAT ARE NOT IN THIS PROJECT


ACT	ACOUSTICAL CEILING TILE	RB	RESILIENT BASE
AGL	ART GLASS	RP	RESIN PANEL
AWP	ACOUSTICAL WALL PANEL	RS	RESILIENT SHEET
CC	CUBICLE CURTAIN	RST	RESILIENT STAIR TREAD
CG	CORNER GUARD	RT	RUBBER TILE
CHR	CHAIR RAIL	SC	SPECIALTY CEILING
CPT	CARPET	SCON	SEALED CONCRETE
CR	CRASH RAIL	SN	STAIR NOSING & RISER
DG	DIGITAL GRAPHIC	SSM	SOLID SURFACE MATERIAL
DS	DIVIDER STRIP	ST	STONE VENEER
DWC	DIGITAL WALL COVERING	SV	SHEET VINYL
DWP	DIGITAL WALL PANEL	SWP	SHEET WALL PROTECTION
EPT	EPOXY PAINT	ТВ	TILE BASE
ERF	EPOXY RESIN FLOOR	TER	TERRAZZO
ETR	existing to remain	TF	TILE FLOOR
EXP	EXPOSED	TR	TRIM
FILM	FILM	TAS	TACKABLE SURACE
FRP	FIBER REINFORCED PANEL	TS	TRANSITION STRIP
GRT	GROUT	TW	TILE WALL
HPL	HIGH PRESSURE PLASTIC LAMINATE	UPH	UPHOLSTERY
HR	HAND RAIL	VCT	VINYL COMPOSITION TILE
INT	INTEGRAL	VET	VINYL ENHANCED TILE
LVT	LUXURY VINYL TILE	VQT	VINYL QUARTZ TILE
PT	PAINT	WC	WALL COVERING
PTM	PATCH TO MATCH	WD	WOOD
QB	QUARRY TILE BASE	WG	WALL GUARD
QT	QUARRY TILE	WOC	WALK OFF CARPET
QTZ	QUARTZ	WS	WRITEABLE SURFACE

WT WINDOW TREATMENT

FINISH PLAN SYMBOLS LEGEND

NOTE: THIS LEGEND MAY CONTAIN SYMBOLS THAT ARE NOT IN THIS PROJECT

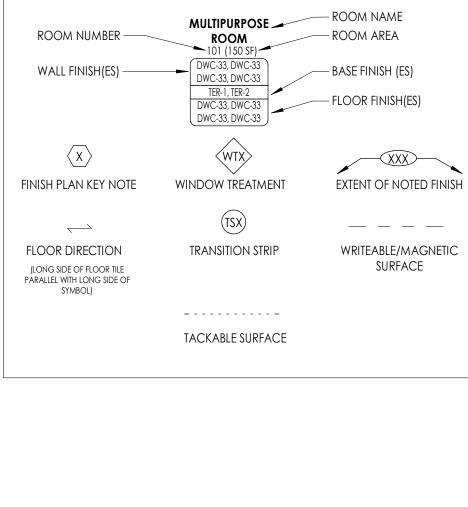


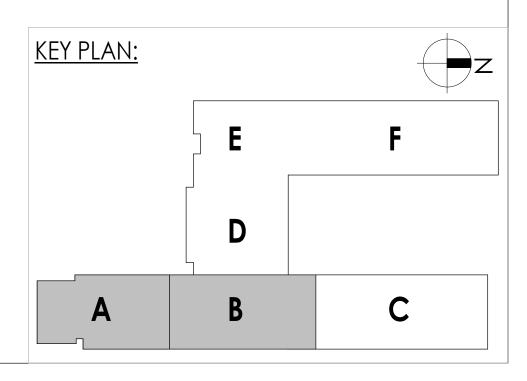




PROJECT INFORMATION Project Number 14457.20 Client Name SOUTH ORANGETOWN CENTRAL SCHOOL DISTRICT Project Name PHASE 1: 2022 BOND

District Office Address 160 VAN WYCK RD. BLAUVELT, NY 10913

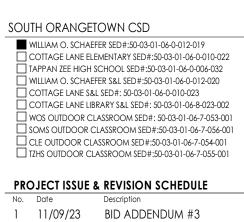

PROFESSIONAL STAMPS

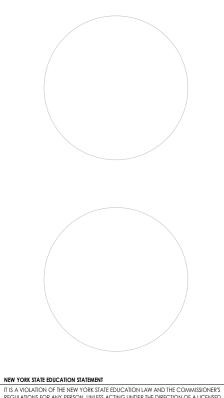

II IS A VIULATION OF THE NEW YORK STATE EDUCATION LAW AND THE COMMISSIONER REGULATIONS FOR ANY PERSON, UNLESS ACTING UNDER THE DIRECTION OF A LICENSEL ARCHTECT, ENGINEER OR LAND SURVEYOR, TO ALTER AN TEM IN ANY WAY, IF AN TEM BEARING THE SEAL OF AN ARCHTECT, ENGINEER OR SURVEYOR IS ALTERED, THE ALTERIN PARTY SHALL AFFIL OF AN ERCHTECT, ENGINEER OR SURVEYOR IS ALTERED, THE ALTERIN PARTY SHALL AFFIL TO THE ITEM TEM SEAL AND THE NOTATION 'ALTERED BY FOLLOWED THEIR SIGNATURE AND THE DATE OF SUCH ALTERATION, AND A SPECIFIC DESCRIPTION OF ALTERATION.


SHEET INFORMATION

Issued	Scale
10/18/23	As indicated
Project Status	
BID DOCUMENTS	
Drawn By	Checked By
ALS	CPL
Drawing Title	
PARTIAL FIRST FLC	OR FINISH PLA
	Р

AN - AREA A & AREA B

ng Number	WOS
	1200



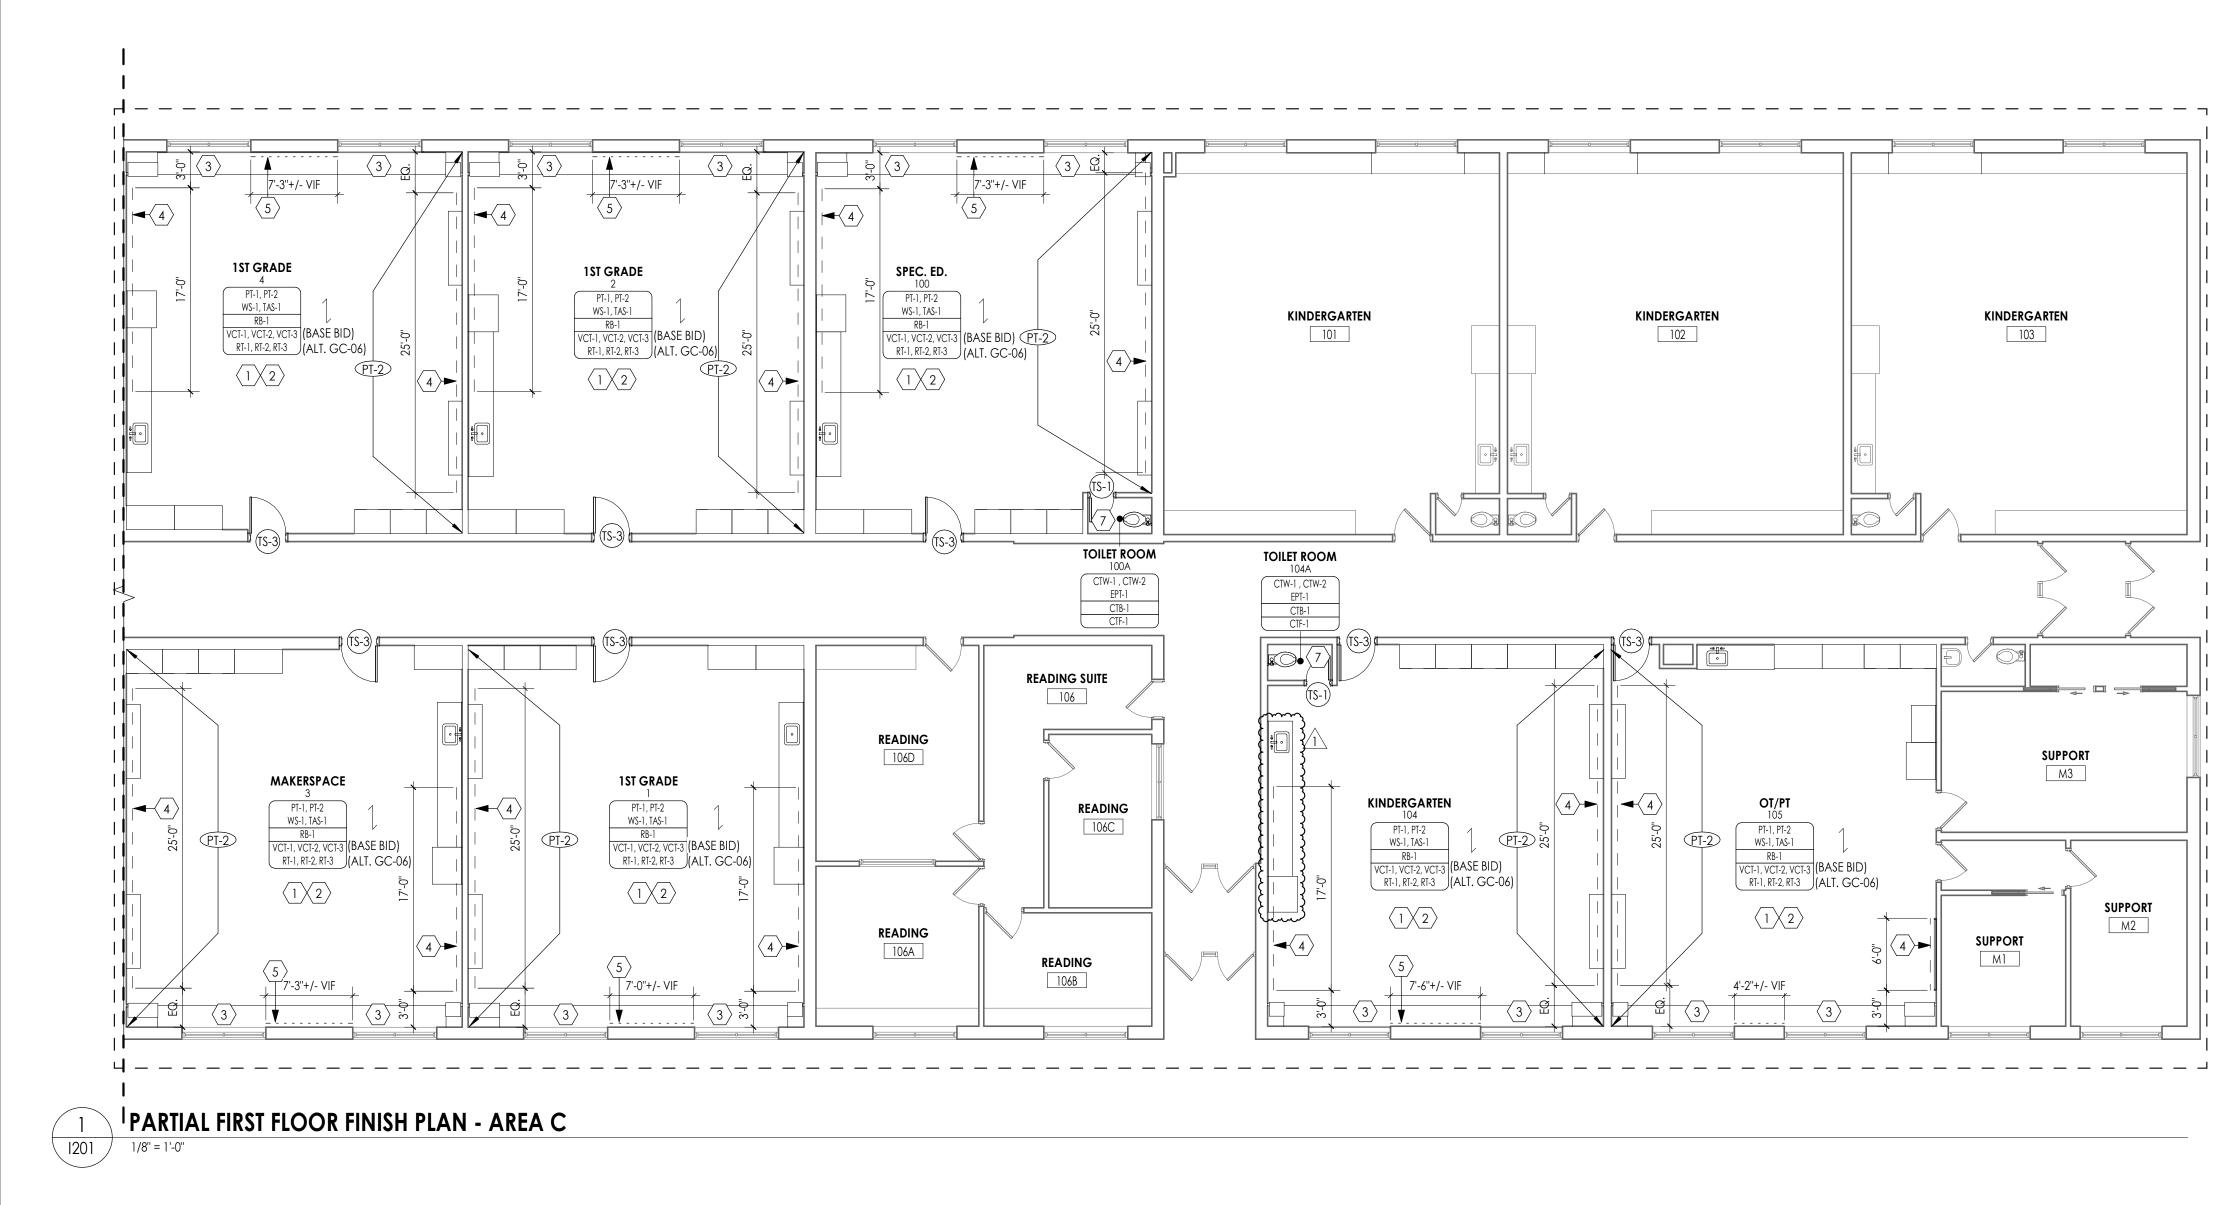

FINISH PLAN KEY NOTES

- <u>BASE BID:</u> PROVIDE 3-COLOR PATTERN (VCT-1,2,3) WITH RESILIENT BASE. RANDOM FRAMES IN PROJECT SCOPE SHALL BE PAINTED (PT-3), UNLESS NOTED OTHERWISE. ¹/ PATTERN: 60% VCT-1, 20% VCT-2, 20% VCT-3. ALL LOUVERS, VENTS, GRILLES AND OTHER MISCELLANEOUS MECHANICAL AND 2 ALTERNATE BID # GC-06: PROVIDE 3-COLOR PATTERN (RT-1,2,3) WITH RESILIENT BASE. RANDOM PATTERN: 60% RT-1, 20% RT-2, 20% RT-3. ELECTRICAL DEVICES ARE TO BE PAINTED TO MATCH THE SURFACE ON WHICH THEY APPEAR, UNLESS NOTED OTHERWISE. REFER TO A600 SERIES DRAWINGS FOR CEILING TYPES AND SOFFIT FINISHES. 3 PROVIDE WINDOW TREATMENT (WT-1). REFER TO INTERIOR FINISH SCHEDULE FOR ADDITIONAL INFORMATION. UNDERSIDE OF SOFFITS TO MATCH FACE OF SOFFIT. SEE A600 SERIES FOR PAINT ACCENT SPECIFICATIONS. PAINT GWB CEILINGS (PT-4), UNLESS NOTED OTHERWISE. PROVIDE WRITEABLE/MAGNETIC SURFACE (WS-1) 2-6" AFF. SEE A700 SERIES FOR ADDITIONAL INFORMATION. WALL TO RECEIVE LEVEL 5 FINISH. REFER TO A700 SERIES INTERIOR ELEVATIONS FOR MILLWORK FINISHES. ALL WINDOW SILLS SHALL BE **SSM-1**, UNLESS OTHERWISE NOTED. HIGH PRESSURE PLASTIC LAMINATE ON VERTICAL SURFACES TO RUN VERTICALLY, F PROVIDE TACKABLE SURFACE (TAS-1) 2-6" AFF. SEE A700 SERIES FOR ADDITIONAL UNLESS NOTED OTHERWISE. \checkmark INFORMATION. WHERE KICKSPACES OCCUR AT MILLWORK, FLOOR FINISH SHOWN ON PLANS SHALL RUN UNDERNEATH KICKSPACE AS WELL. PROVIDE DIGITALLY PRINTED WINDOW FILM. REFER TO 1001 FOR GRAPHICS 6 SCHEDULE & ADDITIONAL DETAIL. . REFER TO **I300** FOR FLOOR PATTERN PLANS & DETAILS. . ALL FLOOR FINISHES SHALL TRANSITION AT THE CENTERLINE OF THE DOOR, UNLESS > PROVIDE 2-COLOR PATTERN CERAMIC WALL TILE WAINSCOT UP TO 5'-0" AFF WITH NOTED OTHERWISE. INSTALL TRANSITION STRIPS PER DETAILS ON 1000. $^{\prime}$ EPOXY PAINT (EPT-1) ABOVE. REFER TO TYPICAL TILE PATTERN "A" ON 1000 FOR . PROVIDE CONCRETE FLOOR PREPARATION IN ACCORDANCE WITH FLOORING DETAIL. MANUFACTURER SPECIFICATION. $\overline{8}$ PROVIDE SCHEDULED LVT IN ASHLAR INSTALLATION. ALL NON-EPOXY GROUT TO BE SEALED A MINIMUM OF TWO TIMES PRIOR TO COMPLETION. $\overline{\langle 9 \rangle}$ PROVIDE SCHEDULED CPT IN QUARTER-TURN INSTALLATION. FLOOR PATTERNING GENERAL NOTES $\langle 10 \rangle$ PROVIDE WOC-1 IN QUARTER-TURN INSTALLATION. ALL FLOOR FINISHES SHALL TRANSITION AT THE CENTERLINE OF THE DOOR, UNLESS OTHERWISE NOTED. INSTALL TRANSITION STRIPS PER DETAILS. PROVIDE ADA ACCESSIBLE MARBLE THRESHOLD AT ALL TOILET ROOM DOORS UNLESS OTHERWISE NOTED. ○ PROVIDE DIGITALLY PRINTED WALL GRAPHIC FULL HEIGHT OF WALL. REDER TO 1001 ALL AREAS WITH INTEGRAL BASE SHALL BE AT 4" A.F.F. BASE SHALL BE THE SAME COLOR ¹ FOR GRAPHICS SCHEDULE & ADDITIONAL DETAIL. AS THE ADJACENT FLOORING MATERIAL, UNLESS OTHERWISE NOTED. 12) PROVIDE INTEGRAL RESILIENT STAIR TREAD (RST-1) & RISERS AT STAIR LOCATIONS. PAINT STRINGERS & RAILING PT-2. PROVIDE LVT-2 & RB-1 AT LANDING. WHERE KICKSPACES OCCUR AT MILLWORK, FLOOR FINISH SHOWN ON PLANS SHALL RUN UNDERNEATH KICKSPACE AS WELL. **FINISH ABBREVIATIONS** $\langle 13 \rangle$ PROVIDE VCT-1 IN ASHLAR INSTALLATION. NOTE: THIS LEGEND MAY CONTAIN ABBREVIATIONS THAT ARE NOT IN THIS PROJECT PROVIDE 2 COLOR PAINT PATTERN WITH VINYL ADHERED SIGNAGE. SEE 2-1200 FOR ADDITIONAL DETAIL.
- 15 PROVIDE 4-COLOR PATTERN ACOUSTIC WALL PANELS (AWP). SEE A700 SERIES & FINISH SCHEDULE FOR ADDITIONAL INFORMATION.

FINISH PLAN GENERAL NOTES


ALL NEW AND EXISTING HOLLOW METAL DOORS, DOOR FRAMES AND WINDOW


ACT	ACOUSTICAL CEILING TILE	RB	RESILIENT BASE
AGL	ART GLASS	RP	RESIN PANEL
AWP	ACOUSTICAL WALL PANEL	RS	RESILIENT SHEET
CC	CUBICLE CURTAIN	RST	RESILIENT STAIR TREAD
CG	CORNER GUARD	RT	RUBBER TILE
CHR	CHAIR RAIL	SC	SPECIALTY CEILING
CPT	CARPET	SCON	SEALED CONCRETE
CR	CRASH RAIL	SN	STAIR NOSING & RISER
DG	DIGITAL GRAPHIC	SSM	SOLID SURFACE MATERIAL
DS	DIVIDER STRIP	ST	STONE VENEER
DWC	DIGITAL WALL COVERING	SV	SHEET VINYL
DWP	DIGITAL WALL PANEL	SWP	SHEET WALL PROTECTION
EPT	EPOXY PAINT	ТВ	TILE BASE
ERF	EPOXY RESIN FLOOR	TER	TERRAZZO
ETR	existing to remain	TF	TILE FLOOR
EXP	EXPOSED	TR	TRIM
FILM	FILM	TAS	TACKABLE SURACE
FRP	FIBER REINFORCED PANEL	TS	TRANSITION STRIP
GRT	GROUT	TW	TILE WALL
HPL	HIGH PRESSURE PLASTIC LAMINATE	UPH	UPHOLSTERY
HR	HAND RAIL	VCT	VINYL COMPOSITION TILE
INT	INTEGRAL	VET	VINYL ENHANCED TILE
LVT	LUXURY VINYL TILE	VQT	VINYL QUARTZ TILE
PT	PAINT	WC	WALL COVERING
PTM	PATCH TO MATCH	WD	WOOD
QB	QUARRY TILE BASE	WG	WALL GUARD
QT	QUARRY TILE	WOC	WALK OFF CARPET
QTZ	QUARTZ	WS	WRITEABLE SURFACE

WT WINDOW TREATMENT

FINISH PLAN SYMBOLS LEGEND

NOTE: THIS LEGEND MAY CONTAIN SYMBOLS THAT ARE NOT IN THIS PROJECT

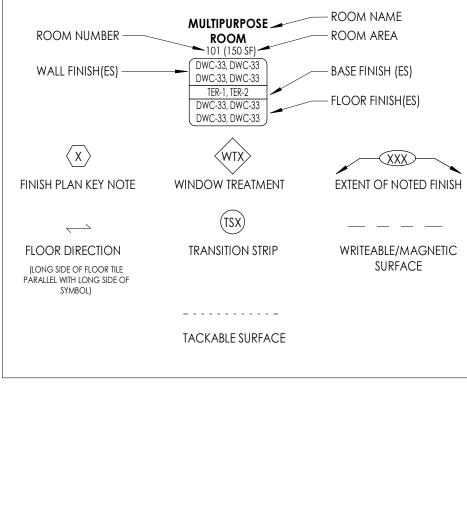


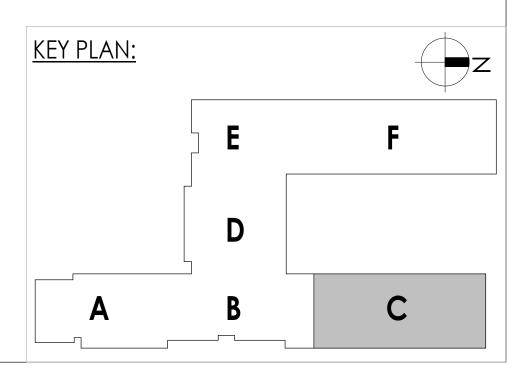




Project Number 14457.20 Client Name SOUTH ORANGETOWN CENTRAL SCHOOL DISTRICT Project Name PHASE 1: 2022 BOND

District Office Address 160 VAN WYCK RD. BLAUVELT, NY 10913

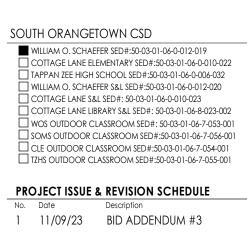

PROFESSIONAL STAMPS

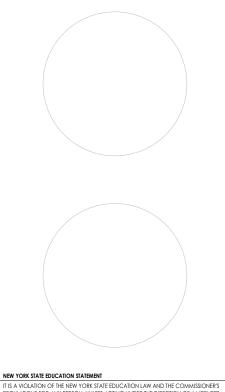

EGULATIONS FOR ANY PERSON, UNLESS ACTING UNDER THE DIRECTION OF A LICENSI RCHITECT, ENGINEER OR LAND SURVEYOR, TO ALTER AN ITEM IN ANY WAY. IF AN ITE BEARING THE SEAL OF AN ARCHITECT. ENGINEE OR SUPPORT AS ATTERD. IT ANT WAY TWA'T. FAN ITE BEARING THE SEAL OF AN ARCHITECT. ENGINEER OR SUPPEYOR AS ATTERD. THE ATER. PARTY SHALL AFFIX TO THE ITEM THEIR SEAL AND THE NOTATION "ALTERED BY" FOLLOWE THEIR SIGNATURE AND THE DATE OF SUCH ALTERATION, AND A SPECIFIC DESCRIPTION OF ALTERATION.


SHEET INFORMATION


Issued	Scale
10/18/23	As indicated
Project Status	
BID DOCUMENTS	
Drawn By	Checked By
ALS	Checker
Drawing Title	
PARTIAL FIRST FLC	OR FINISH PLAN


- AREA C





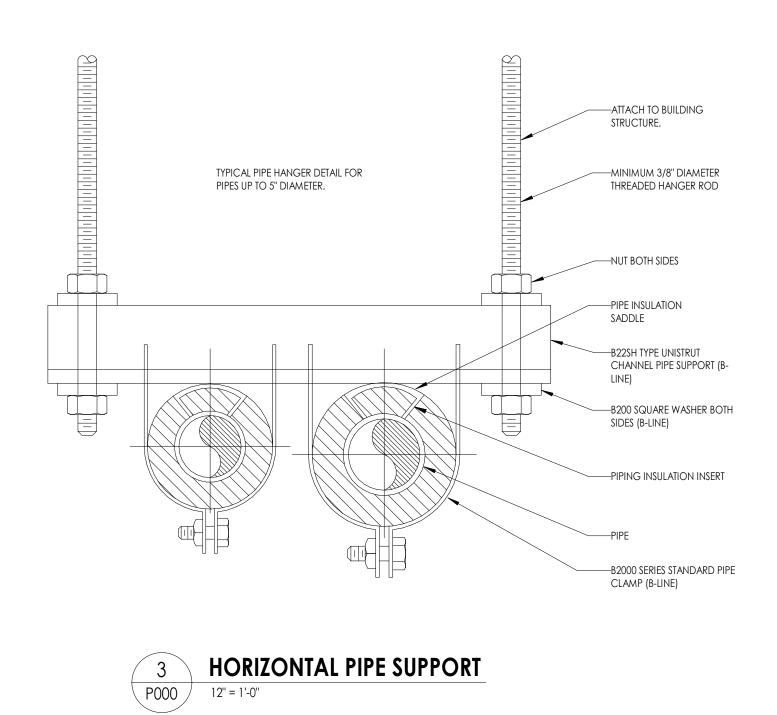

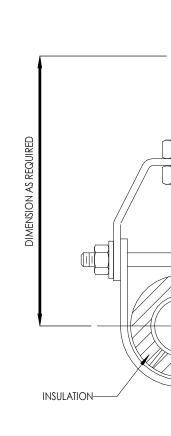


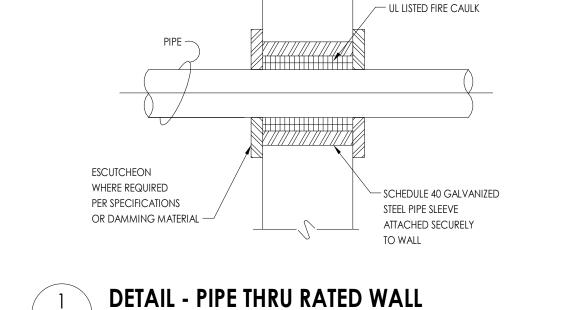

FIRE RATED WALL ------

1 P000

12" = 1'-0"

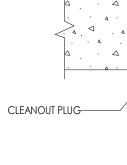



NO-HUB COUPLING

(TYPICAL)




- A. ALL WORK SHALL COMPLY WITH STATE AND LOCAL CODES.
- B. DOMESTIC WATER LINES SHALL BE TYPE L COPPER, LEAD FREE JOINTS. INSULATE ALL PIPING WITH 1" THICK PREFORMED FIBERGLASS PIPE INSULATION WITH ASJ COVER. ALL FITTINGS AND VALVES TO BE COVERED WITH PREFORMED PVC FITTING COVERS. ALL EXPOSED VERTICAL FIXTURE SUPPLY LINES TO BE COVERED WITH PVC JACKET TO 7' ABOVE FINISHED FLOOR.
- C. UNDERGROUND SANITARY AND VENT PIPING SHALL BE SERVICE WEIGHT CAST IRON, HUB AND SPIGOT WITH RUBBER GASKET PUSH JOINTS. ABOVE GROUND SANITARY AND VENT PIPING SHALL BE DWV COPPER WITH DWV COPPER FITTINGS OR NO-HUB CAST IRON.
- D. IT IS THE RESPONSIBILITY OF THE PLUMBING CONTRACTOR TO FIELD VERIFY EXISTING CONDITIONS WITHIN THE BUILDING PRIOR TO COMMENCEMENT OF ALL DEMOLITION AND NEW WORK.
- . IT IS THE RESPONSIBILITY OF THE PLUMBING CONTRACTOR TO REMOVE AND REPLACE EXISTING CEILINGS UNLESS OTHERWISE NOTED ON THE ARCHITECTURAL DRAWINGS, FOR PERFORMING DEMOLITION OR NEW WORK WITHIN THE BUILDING. THE CONTRACTOR SHALL REINSTALL THE CEILING SYSTEMS TO MATCH THE ORIGINAL INSTALLATION. ANY CEILING SYSTEM COMPONENT DAMAGED DURING DEMOLITION, STORAGE, OR RE-INSTALLATION SHALL BE REPLACED WITH A NEW AT NO EXPENSE TO THE OWNER.
- ALL PIPING AND CONDUIT PENETRATIONS THRU RATED WALLS OR FLOORS SHALL BE PROVIDED WITH FIRE/SMOKE STOPPING.
- G. UNLESS SHOWN ON THE ARCHITECTURAL DRAWINGS, IT IS THE RESPONSIBILITY OF THE PLUMBING CONTRACTOR TO PATCH AND FINISH ALL EXISTING PIPE PENETRATIONS AND TRENCHING THRU FLOOR AND WALLS AFTER DEMOLITION. IN ADDITION, ALL NEW PENETRATIONS AND TRENCHING SHALL BE PROVIDED FOR INSTALLATION OF PLUMBING SYSTEMS INCLUDING, BUT NOT LIMITED TO, EQUIPMENT, PIPING, ETC.

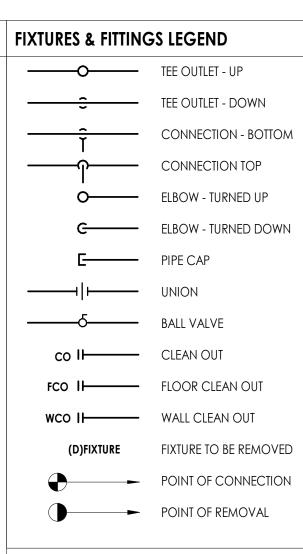

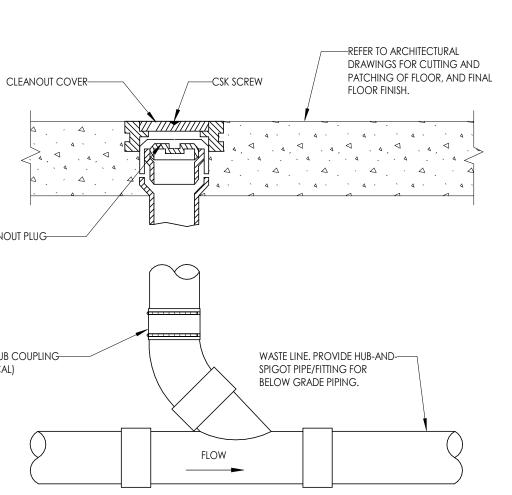



MARK	FIXTURE	CW	HW	SAN	V	MANUFACTURER	MODEL	DESCRIPTION	REMARKS
EP-1	EJECTOR PUMP			1 1/2"	1 1/2"	LIBERTY PUMPS	404	1/3 HP, 115 V, SINGLE PHASE	
FCO-1	FLOOR CLEANOUT			4''		ZURN	Z1400-В	FLOOR CLEANOUT, DURA-COATED CAST IRON BODY WITH BOTTOM OUTLET, WITH GAS AND WATER TIGHT THREADED ABS TAPERED PLUG, AND TOP ASSEMBLY	
FD-1	FLOOR DRAIN			4''	2	ZURN INDUSTRIES	Z415-4NH-6B	FLOOR DRAIN, 8" ROUND NICKEL BRONZE STRAINER, CAST IRON BODY, DEEL SEAL P TRAP	WITH TRAP SEAL
LAV-1	LAVATORY	1/2"	1/2"	1 1/4"	1 1/4"	AMERICAN STANDARD	0355.012	SINGLE STATION SLOAN STONE LAVATORY WITH ETF-80 FAUCET	
SK-1	SINK	1/2"	1/2"	1 1/2"	1 1/4"	JUST MANUFACTURING	SLADA17519A55-J	STAINLESS STEEL 19"X18"X5-1/2", SINGLE BOWL, DROP IN, 1 HOLE, 20 GAUGE, WITH	
SK-2	SINK	1/2"	1/2"	1 1/2"	1 1/2"	JUST MANUFACTURING	SLADA19219A55-J	STAINLESYSTEEL 22"X19-1/2"X5-1/2", SINGLE BOWL, DROP 14, 1 HOLE, 20 GAUGE, WITH GOOSNECK FAUCET	5
WC-1	WATER CLOSET (ADA WALL MOUNTED)]"		4''	2"	AMERICAN STANDARD	3351.101	TOILET, WALL MOUNTED, REAR DISCHARGE, TOP SUPPLY BATTERY POWERED SENSOR FLUSH VALVE. SLOAN OPTIMA PLUS G2 8111-1.28/1.1	\bigcirc
WC-2	WATER CLOSET (CHILD FLOOR MOUNTED)]"		4''	2"	AMERICAN STANDARD	2282.001	TOILET, FLOOR MOUNTED CHILD HEIGHT, REAR DISCHARGE, TOP SUPPLY BATTERY POWERED SENSOR FLUSH VALVE. SLOAN OPTIMA PLUS G2 8111-1.28/1.1	2

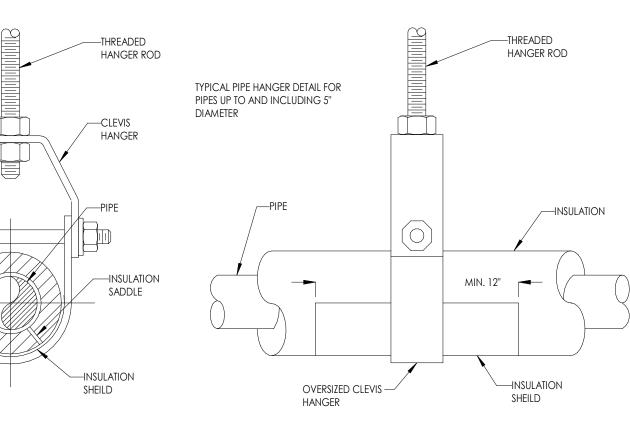



	LEGEND
FIFING	LEGEND

xx	PIPING
xx	PIPING BELOW (
X	EXISTING PIPING
CW	COLD WATER
HW	HOT WATER
HWR	HOT WATER REC
SAN	SANITARY SEWER
ST	STORM SEWER
V	VENT
·/////////////////////////////////////	PLUMBING TO B

	PIPING
	PIPING BELOW GRADE
	EXISTING PIPING
	COLD WATER
	HOT WATER
	HOT WATER RECIRCULATING
	SANITARY SEWER
	STORM SEWER
	VENT
///	PLUMBING TO BE REMOVED





PROJECT INFORMATION Project Number 14457.20

Client Name SOUTH ORANGETOWN CENTRAL SCHOOL DISTRICT Project Name

PHASE 1: 2022 BOND

District Office Address 160 VAN WYCK RD. BLAUVELT, NY 10913

south orangetown CSD


- WILLIAM O. SCHAEFER SED#:50-03-01-06-0-012-019 COTTAGE LANE ELEMENTARY SED#:50-03-01-06-0-010-022
- TAPPAN ZEE HIGH SCHOOL SED#:50-03-01-06-0-006-032 WILLIAM O. SCHAEFER S&L SED#: 50-03-01-06-0-012-020
- COTTAGE LANE S&L SED#: 50-03-01-06-0-010-023 COTTAGE LANE LIBRARY S&L SED#: 50-03-01-06-8-023-002
- WOS OUTDOOR CLASSROOM SED#: 50-03-01-06-7-053-001 SOMS OUTDOOR CLASSROOM SED#: 50-03-01-06-7-056-001 CLE OUTDOOR CLASSROOM SED#: 50-03-01-06-7-054-001

TZHS OUTDOOR CLASSROOM SED#: 50-03-01-06-7-055-001

PROJECT ISSUE & REVISION SCHEDULE

No. Date 1 11/09/2023 BID ADDENDUM #3

PROFESSIONAL STAMPS

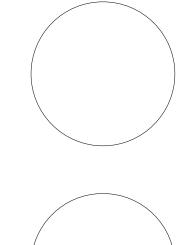

IT IS A VIOLATION OF THE NEW YORK STATE EDUCATION LAW AND THE COMMISSIONER'S REGULTIONS FOR ANY PERSON, UNLESS ACTING UNDER THE DIRECTION OF A LICENSED ARCHITECT, ENGINEER OR LAND SURVEYOR, TO ALTER AN ITEM IN ANY WAY. IF AN ITEM BEARING THE SEAL OF AN ARCHITECT, ENGINEER OR SURVEYOR IS ALTERED. THE ALTERING PARTY SHALL AFRIX TO THE ITEM THER SEAL AND THE NOTATION "ALTERED BY" FOLLOWED BY THE'R SGANATURE AND THE DATE OF SUCH ALTERATION, AND A SPECIFIC DESCRIPTION OF THE ALTERATION.

SHEET INFORMATION

MLS

NEW YORK STATE EDUCATION STATEMENT

Issued Scale 10/18/2023 As indicated Project Status **BID DOCUMENTS** Drawn By


Checked By JJM


Drawing Title PLUMBING LEGEND, NOTES, & DETAILS


Drawing Number WOS P000





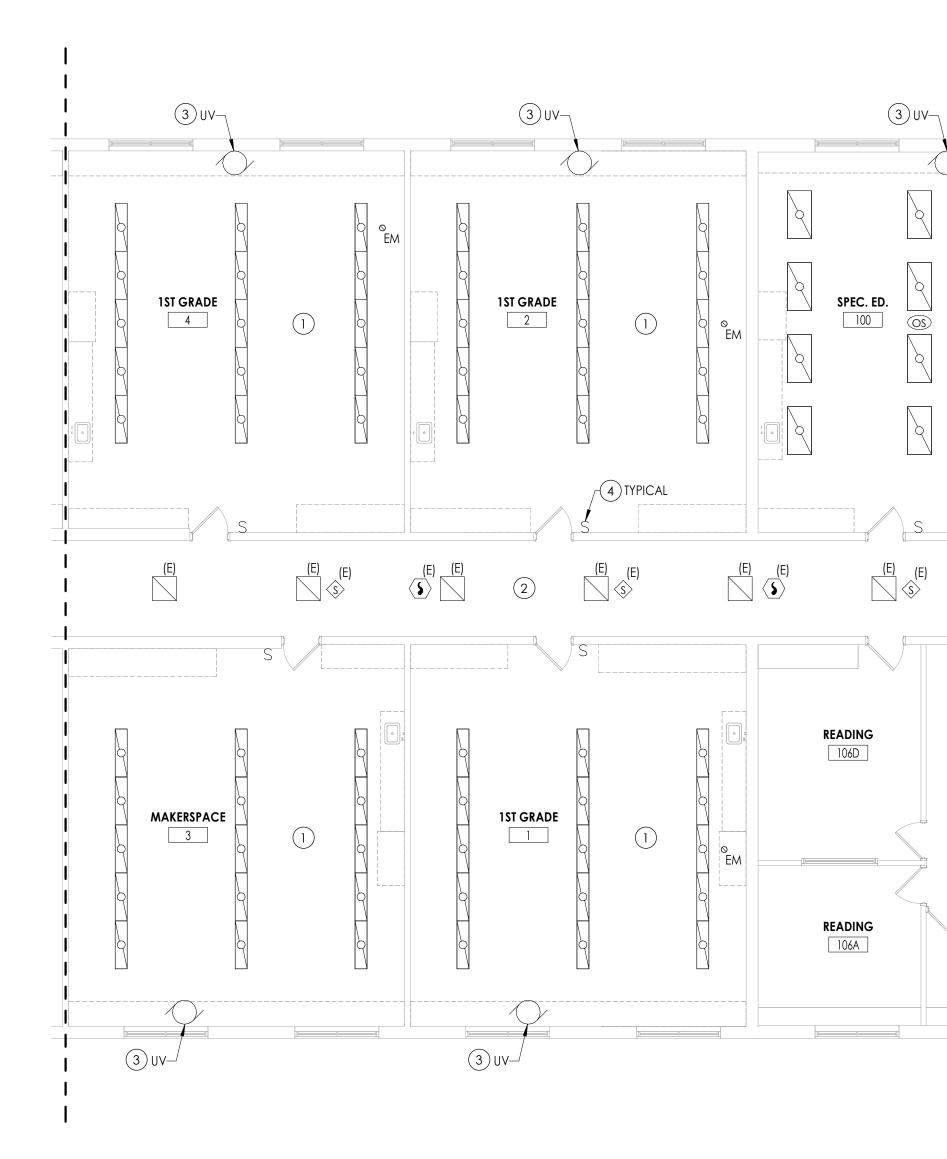

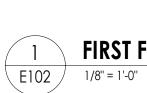

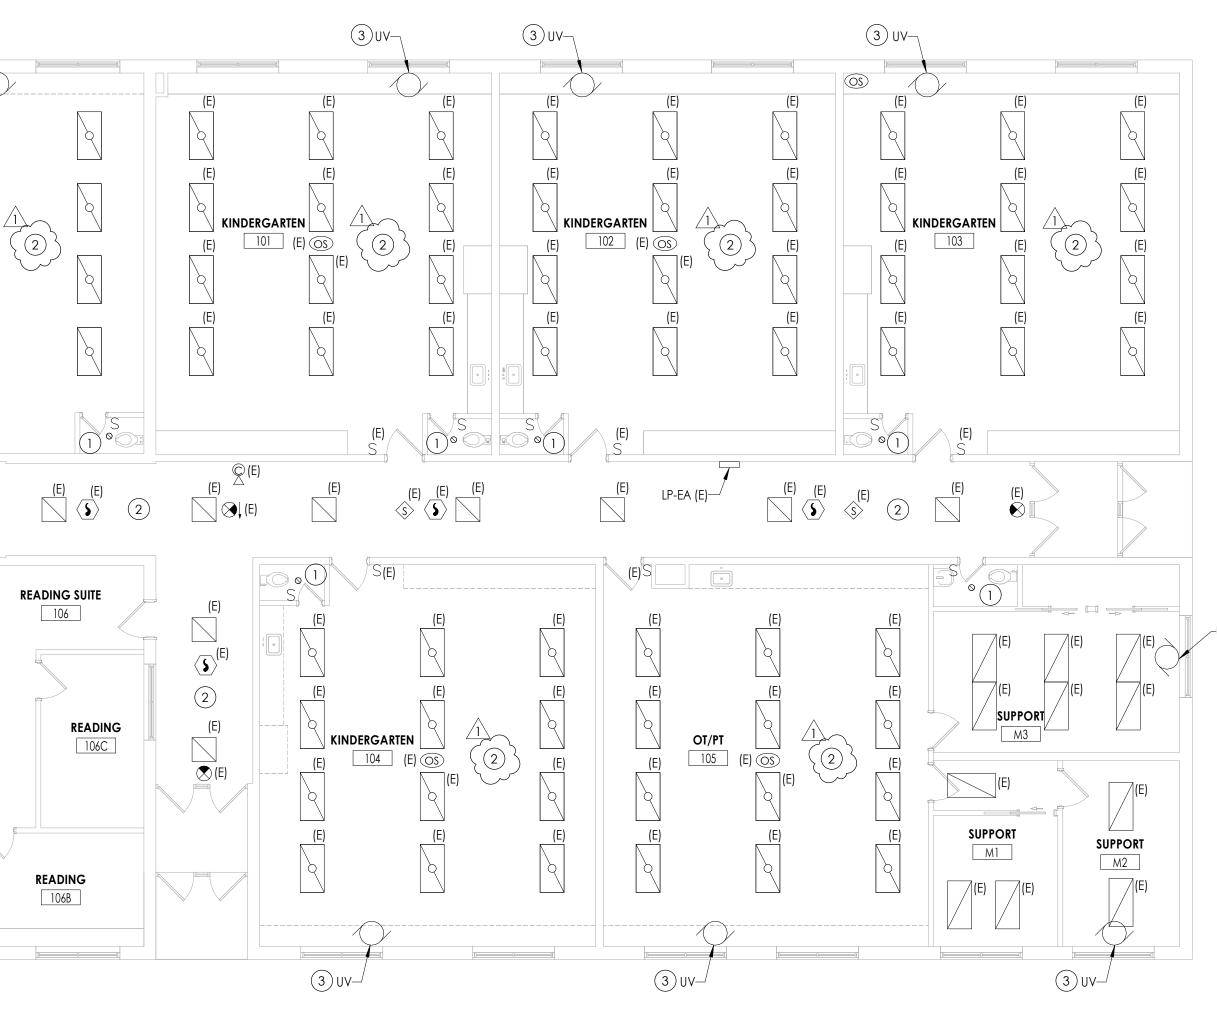


FIRST FLOOR DEMOLITION PLAN - AREA C

GENERAL NOTES

- A. ALL ITEMS SHOWN ARE TO BE REMOVED UNLESS LABELED AS (E) EXISTING. REMOVAL OF DEVICE INCLUDES ITS ASSOCIATED CABLING/BRANCH CIRCUIT WIRING, AND RACEWAY.
- B. ANY EXISTING DEVICE TO REMAIN, LABELED AS (E) SHALL REMAIN IN PLACE AS WELL AS ITS' ASSOCIATED CIRCUITING AND CONDUIT, UNLESS OTHERWISE NOTED.
- C. THE CONTRACTOR SHALL REMOVE THE EXISTING ELECTRIC IN AREAS OF NEW RENOVATIONS TO ACCOMMODATE NEW CONSTRUCTION. REROUTING OF EXISTING MAY BE REQUIRED AT NEW OPENINGS IN EXISTING CONSTRUCTION OR INTERFERENCE WITH OTHER NEW WORK AS NOTED IN THE FOLLOWING NOTES.
- D. DRAWINGS INDICATE SPECIFIC ITEMS TO BE REMOVED AND/OR RELOCATED IN ORDER TO INDICATE GENERAL SCOPE. ADDITIONAL ITEMS NOT INDICATED, BUT NECESSARY FOR PROJECT RENOVATIONS, SHALL BE REMOVED, RELOCATED AND/OR REROUTED. THE CONTRACTOR SHALL ASSUME WITHIN THE BASE BID A NOMINAL AMOUNT OF BRANCH CIRCUITS, FIXTURES, DEVICES, AND SYSTEMS WIRING WITHIN WALLS OR OPENINGS BEING REMOVED OR RELOCATED AS REQUIRED TO ACCOMMODATE THE NEW CONSTRUCTION.
- E. WHERE DEVICES, FIXTURES, ETC. ARE INDICATED TO BE REMOVED, THEY AND THEIR RELATED WIRING/CONDUIT SHALL BE REMOVED BACK TO THE SOURCE PANELBOARD UNLESS OTHERWISE NOTED. ON CIRCUITS WHERE OTHER DEVICES, FIXTURES, ETC. ARE FOUND THAT MUST REMAIN, MAINTAIN CIRCUIT CONTINUITY BY PROVIDING ADDITIONAL WIRING, TO FEED THROUGH TO THESE REMAINING ITEMS. RELOCATE ANY CIRCUITS THAT REMAIN, TO AVOID CONFLICT WITH NEW CONSTRUCTION AS REQUIRED. PROPERLY TERMINATE ALL WIRING.
- F. COORDINATE DEMOLITION OF EQUIPMENT, DEVICES, ETC. WITH OTHER DISCIPLINES AS APPLICABLE. REFER TO ARCHITECTURAL DEMOLITION DRAWINGS AND NOTES FOR COORDINATION.
- G. DRAWINGS ARE GRAPHICAL REPRESENTATIONS OF APPROXIMATE EQUIPMENT AND DEVICE LOCATIONS. CONTRACTOR SHALL VISIT THE SITE TO DETERMINE THE EXACT EXTENT OF ELECTRICAL WORK REQUIRED TO COMPLETE THE PROJECT. EXISTING CONDITIONS ARE TAKEN FROM FIELD OBSERVATION AND EXISTING BUILDING DOCUMENTS. OTHER ELECTRICAL ITEMS MAY EXIST FOR WHICH THE CONTRACTOR IS RESPONSIBLE.
- H. CONTRACTOR SHALL PROPERLY DISPOSE OF ALL ITEMS, EQUIPMENT, PANELS, LIGHT FIXTURES, ETC. BEING REMOVED AS PART OF THIS PROJECT. THE OWNER SHALL HAVE THE RIGHT OF RETAINING ANY ITEMS BEING REMOVED.
- I. CONTRACTOR SHALL PROVIDE NEW COVERPLATES ON ALL BOXES OF UNUSED AND/OR REMOVED FLUSH MOUNT DEVICES UPON COMPLETION OF PROJECT.
- J. FIREPROOFING AND/OR FIRE STOP MATERIALS REMOVED FROM FIRE RATED WALLS AND CEILINGS AS A RESULT OF DEMOLITION SHALL BE RE-INSTALLED USING AN APPROVED METHOD AS DESCRIBED IN ASSOCIATED PROJECT SPECIFICATIONS.

<u>KEY NOTES</u>

- 1 DISCONNECT AND REMOVING EXISTING LIGHT FIXTURES. PULL ALL CIRCUITRY BACK TO AN AREA OUTSIDE OF DEMOLITION AND TAG FOR REUSE.
- 2 DISCONNECT AND REMOVE EXISTING LIGHT FIXTURES AND ALL CEILING MOUNTED DEVICES AS NECESSARY TO ACCOMMODATE ANY CEILING REMOVALS. PULL ALL CIRCUITRY BACK TO AN AREA OUTSIDE OF DEMOLITION AND TAG FOR RE-USE. REFER TO 300 SERIES DRAWINGS FOR INSTALLATION LOCATIONS.
- 3 DISCONNECT AND REMOVE CONDUIT AND WIRING BACK TO SOURCE PANEL.
- 4 DISCONNECT AND REMOVE SWITCHES AND ALL SWITCH WIRING. BACKBOX AND CONDUIT TO REMAIN FOR NEW LOW-VOLTAGE SWITCHING.

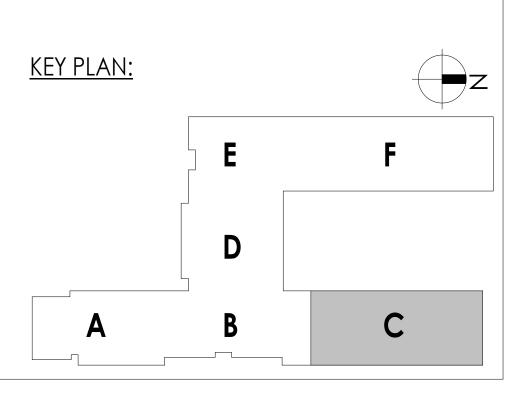



PROJECT INFORMATION
Project Number
14457.20
Client Name
SOUTH ORANGETOWN CENTRAL
SCHOOL DISTRICT
Project Name

PHASE 1: 2022 BOND

District Office Address 160 VAN WYCK RD. BLAUVELT, NY 10913

SOUTH ORANGETOWN CSD


- WILLIAM O. SCHAEFER SED#:50-03-01-06-0-012-019
 COTTAGE LANE ELEMENTARY SED#:50-03-01-06-0-010-022
- TAPPAN ZEE HIGH SCHOOL SED#:50-03-01-06-0-006-032
- COTTAGE LANE S&L SED#: 50-03-01-06-0-010-023 COTTAGE LANE LIBRARY S&L SED#: 50-03-01-06-8-023-002
- □ WOS OUTDOOR CLASSROOM SED#: 50-03-01-06-7-053-001 □ SOMS OUTDOOR CLASSROOM SED#: 50-03-01-06-7-056-001

CLE OUTDOOR CLASSROOM SED#: 50-03-01-06-7-054-001 TZHS OUTDOOR CLASSROOM SED#: 50-03-01-06-7-055-001

PROJECT ISSUE & REVISION SCHEDULE

1 11/09/2023 BID ADDENDUM #3

PROFESSIONAL STAMPS

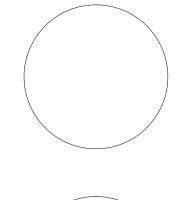

NEW YORK STATE EDUCATION STATEMENT IT IS A VIOLATION OF THE NEW YORK STATE EDUCATION LAW AND THE COMMISSIONER'S REGULATIONS FOR ANY PERSON, UNLESS ACTING UNDER THE DIRECTION OF A LICENSED ARCHITECT, ENGINEER OR LAND SURVEYOR, TO ALTER AN ITEM IN ANY WAY. IF AN ITEM BEARING THE SEAL OF AN ARCHITECT, ENGINEER OR SURVEYOR IS ALTERED, THE ATERING PARTY SHALL AFTRIX TO THE IN THEIR SEAL AND THE NOTATION "ALTERED BY FOLLOWED BY THEIR SIGNATURE AND THE DATE OF SUCH ALTERATION, AND A SPECIFIC DESCRIPTION OF TH ALTERATION.


SHEET INFORMATION

Issued	Scale
10/18/2023	AS NOTED
Project Status	
BID DOCUMENTS	
Drawn By	Checked By
Author	Checker
Drawing Title	

FIRST FLOOR DEMOLITION PLAN -AREA C





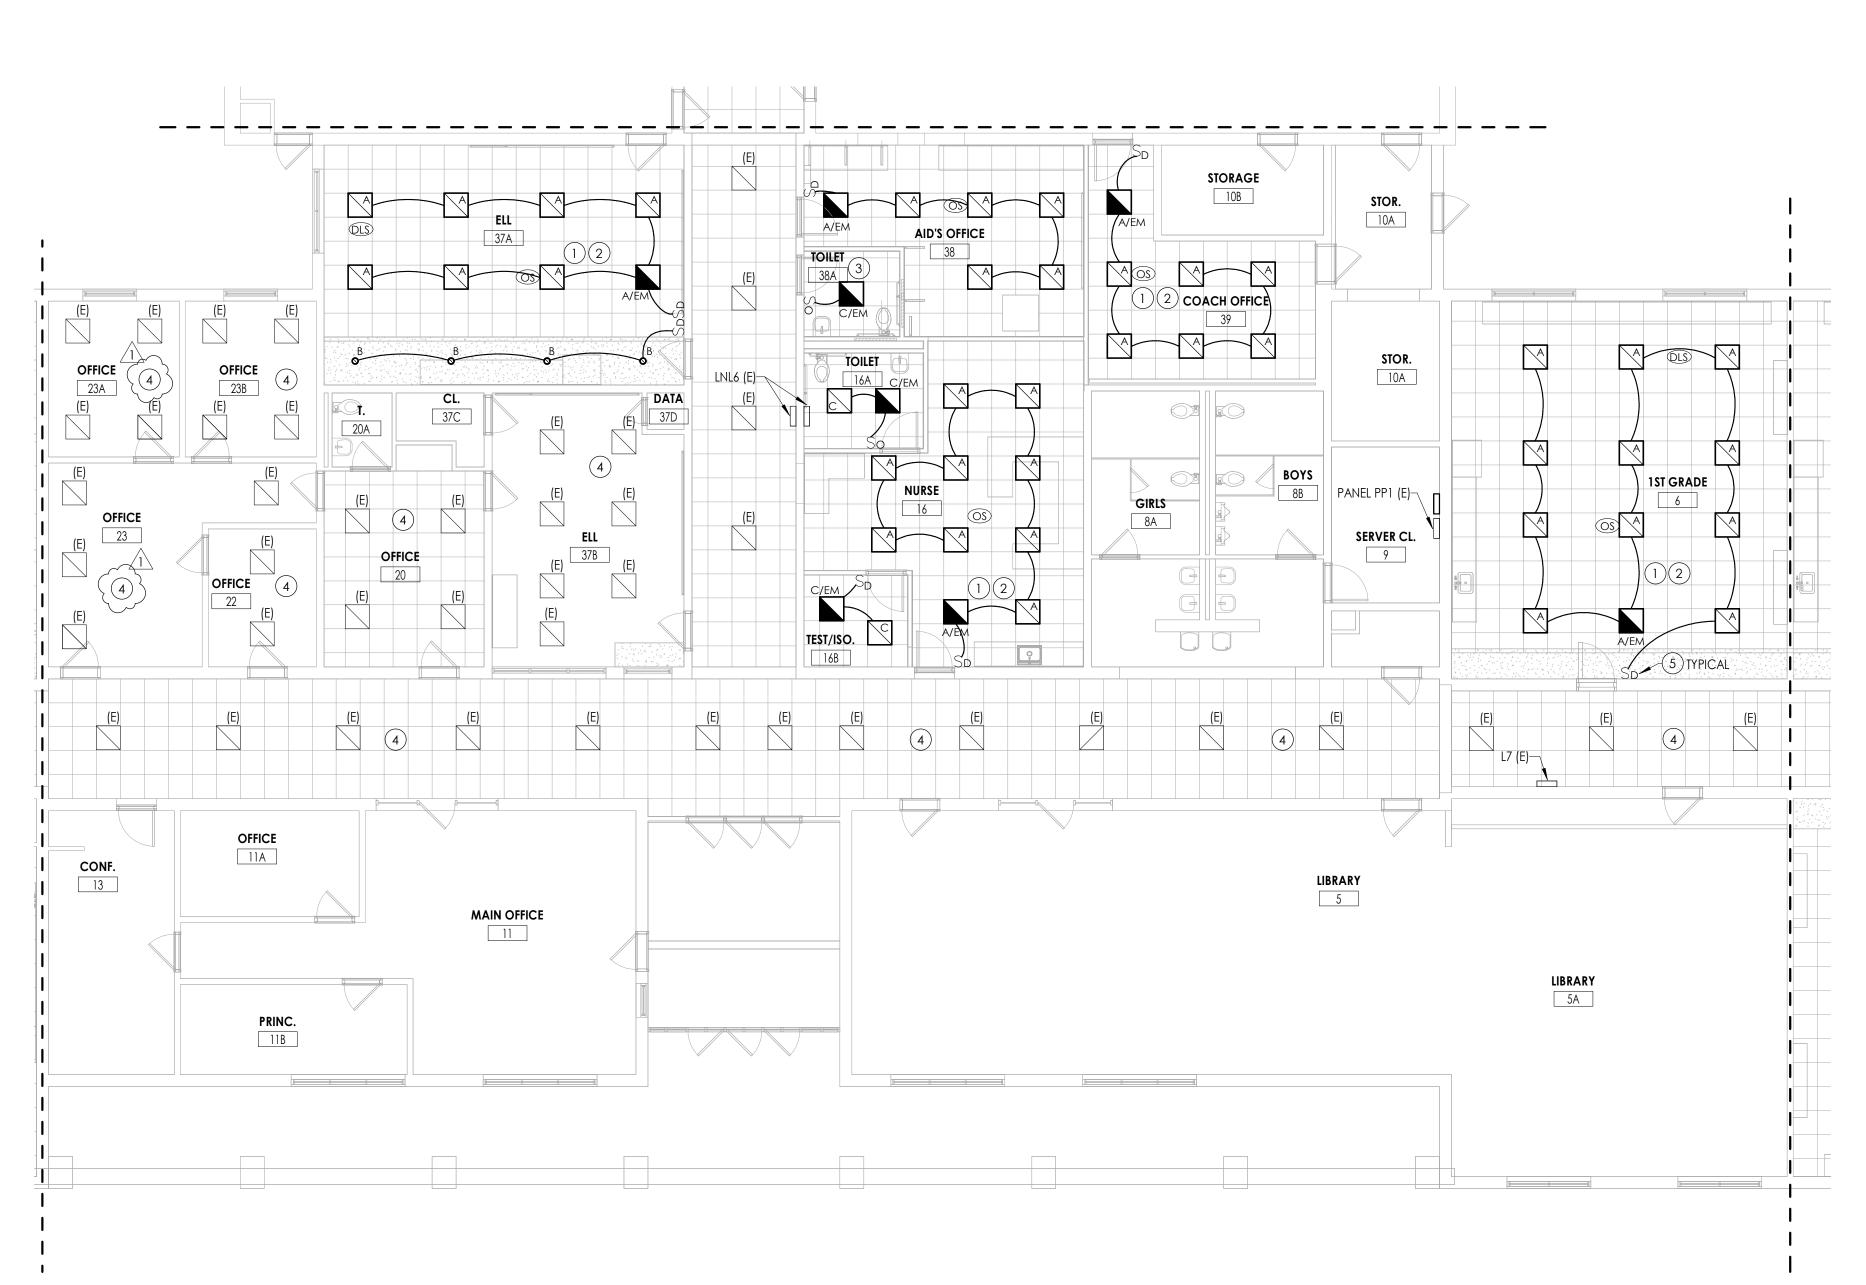

E301 1/8" = 1'-0"

FIRST FLOOR LIGHTING PLAN - AREA B

GENERAL NOTES

- A. FIXTURE TYPE MARK IS INDICATED ADJACENT TO NEW LIGHT FIXTURES. REFER TO LUMINAIRE SCHEDULE ON DRAWING WOS-E900 FOR FIXTURE DESCRIPTIONS AND NOTES.
- B. INSTALL LOW-VOLTAGE SENSORS AS SHOWN. PROVIDE ALL LOW-VOLTAGE WIRING BETWEEN SENSORS, SWITCHES, CONTROLLERS, AND LUMINAIRES.
- C. PROVIDE ANY ADDITIONAL POWER SUPPLIES OR OTHER MISCELLANEOUS COMPONENTS REQUIRED FOR A COMPLETE OPERATIONAL LIGHTING SYSTEM TO MEET INTENT OF LIGHTING SEQUENCE OF OPERATION AS SHOWN.
- D. ALL FIXTURES INDICATED WITH "EM" DESIGNATION SHALL HAVE EMERGENCY BATTERY BACKUP.

<u>KEY NOTES</u>

- 1 CONNECT NEW LIGHT FIXTURES TO EXISTING TAGGED CIRCUIT HOMERUN TO PANELBOARD. REWORK/EXTEND WIRING AS NECESSARY TO ACCOMMODATE FIXTURES.
- (2) NEW FIXTURES WITHIN ROOM TO BE WIRED TOGETHER USING (2) #12, (1) #12 GND.
- (3) NEW FIXTURES TO BE TIED INTO EXISTING CIRCUITRY WITH (2) #12, (1) #12 GND.
- (4) EXISTING LIGHT FIXTURES AND CEILING MOUNTED DEVICES TO BE RE-INSTALLED BACK IN CEILING AS NECCESSARY TO ACCOMMODATE ANY CEILING REMOVAL/REPLACEMENTS. CONNECT ALL FIXTURES AND DEVICES TO EXISTING TAGGED WIRING.
- 5 PROVIDE LOW VOLTAGE 4-BUTTON DIMMING SWITCH WITH ON/OFF AND RAISE/LOWER BUTTONS, UNLESS OTHERWISE NOTED.





PROJECT INFORMATION

Project Number 14457.20

Client Name SOUTH ORANGETOWN CENTRAL SCHOOL DISTRICT Project Name PHASE 1: 2022 BOND


District Office Address 160 VAN WYCK RD. BLAUVELT, NY 10913

south orangetown CSD

WILLIAM O. SCHAEFER SED#:50-03-01-06-0-012-019 COTTAGE LANE ELEMENTARY SED#:50-03-01-06-0-010-022 TAPPAN ZEE HIGH SCHOOL SED#:50-03-01-06-0-006-032 WILLIAM O. SCHAEFER S&L SED#: 50-03-01-06-0-012-020 COTTAGE LANE S&L SED#: 50-03-01-06-0-010-023 COTTAGE LANE LIBRARY S&L SED#: 50-03-01-06-8-023-002 WOS OUTDOOR CLASSROOM SED#: 50-03-01-06-7-053-001 SOMS OUTDOOR CLASSROOM SED#: 50-03-01-06-7-056-001 CLE OUTDOOR CLASSROOM SED#: 50-03-01-06-7-054-001 TZHS OUTDOOR CLASSROOM SED#: 50-03-01-06-7-055-001

PROJECT ISSUE & REVISION SCHEDULE No. Date 1 11/09/2023 BID ADDENDUM #3

PROFESSIONAL STAMPS

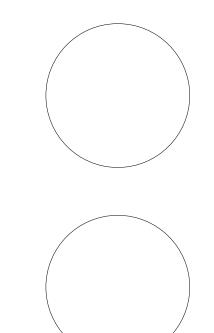

NEW YORK STATE EDUCATION STATEMENT THE A VICINITION OF THE NEW YORK STATE EDUCATION LAW AND THE COMMISSIONERS REGULATIONS FOR ANY PERSON, UNLESS ACTING UNDER THE DIRECTION OF A LICENSED ARCHITECT, ENGINEER OR LAND SURVEYOR, TO ALTER AN ITEM NAWY WAY, FAN ITEM BEARING THE SEAL OF AN ARCHITECT, ENGINEER OR SURVEYOR IS ALTERED, THE ALTERING PARY SHALL AFFILI OT HEIM THER SEAL AND THE NOTATION 'ALTERED BY FOLLOWED B THER SIGNATURE AND THE DATE OF SUCH ALTERATION, AND A SPECIFIC DESCRIPTION OF T


SHEET INFORMATION

_		
	Issued	Scale
	10/18/2023	1/8" = 1'-0"
	Project Status	
	BID DOCUMENTS	
	Drawn By	Checked By
	MAY	JBT
	Drawing Title	
	FIRST FLOOR LIGH AREA B	ITING PLAN



<u>KEY PLAN:</u>		Z
	E	F
	D	
A	В	С

1/8/2023 11:43:54 AM cproject location> REVIT PROJECT FILES ON BIM36

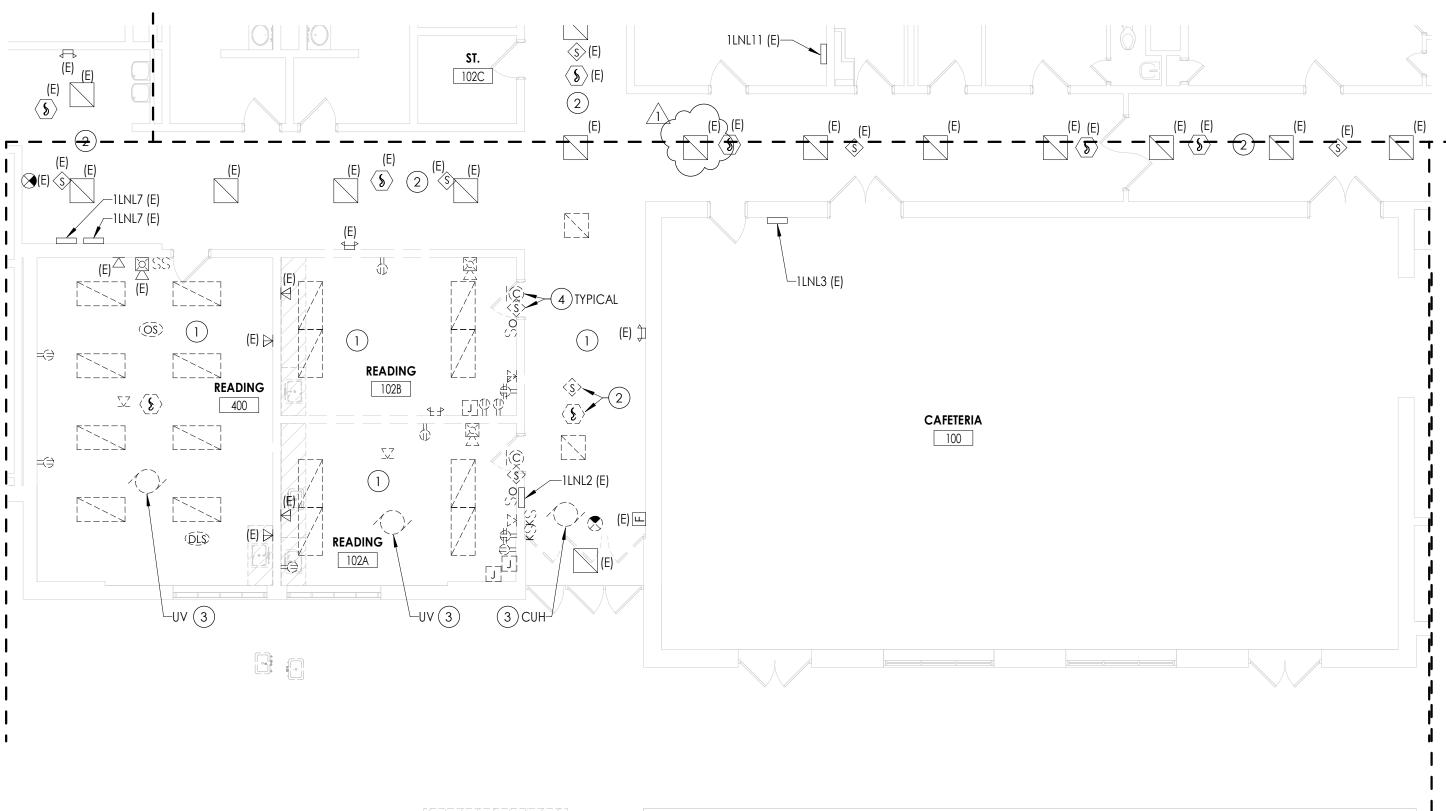



FIRST FLOOR ELECTRICAL DEMOLITION PLAN - AREA B


GENERAL NOTES


_ _

- A. ALL ITEMS SHOWN ARE TO BE REMOVED UNLESS LABELED AS (E) EXISTING. REMOVAL OF DEVICE INCLUDES ITS ASSOCIATED CABLING/BRANCH CIRCUIT WIRING, AND RACEWAY.
- B. ANY EXISTING DEVICE TO REMAIN, LABELED AS (E) SHALL REMAIN IN PLACE AS WELL AS ITS' ASSOCIATED CIRCUITING AND CONDUIT, UNLESS OTHERWISE NOTED.
- C. THE CONTRACTOR SHALL REMOVE THE EXISTING ELECTRIC IN AREAS OF NEW RENOVATIONS TO ACCOMMODATE NEW CONSTRUCTION. REROUTING OF EXISTING MAY BE REQUIRED AT NEW OPENINGS IN EXISTING CONSTRUCTION OR INTERFERENCE WITH OTHER NEW WORK AS NOTED IN THE FOLLOWING NOTES.
- D. DRAWINGS INDICATE SPECIFIC ITEMS TO BE REMOVED AND/OR RELOCATED IN ORDER TO INDICATE GENERAL SCOPE. ADDITIONAL ITEMS NOT INDICATED, BUT NECESSARY FOR PROJECT RENOVATIONS, SHALL BE REMOVED, RELOCATED AND/OR REROUTED. THE CONTRACTOR SHALL ASSUME WITHIN THE BASE BID A NOMINAL AMOUNT OF BRANCH CIRCUITS, FIXTURES, DEVICES, AND SYSTEMS WIRING WITHIN WALLS OR OPENINGS BEING REMOVED OR RELOCATED AS REQUIRED TO ACCOMMODATE THE NEW CONSTRUCTION.
- E. WHERE DEVICES, FIXTURES, ETC. ARE INDICATED TO BE REMOVED, THEY AND THEIR RELATED WIRING/CONDUIT SHALL BE REMOVED BACK TO THE SOURCE PANELBOARD UNLESS OTHERWISE NOTED. ON CIRCUITS WHERE OTHER DEVICES, FIXTURES, ETC. ARE FOUND THAT MUST REMAIN, MAINTAIN CIRCUIT CONTINUITY BY PROVIDING ADDITIONAL WIRING, TO FEED THROUGH TO THESE REMAINING ITEMS. RELOCATE ANY CIRCUITS THAT REMAIN, TO AVOID CONFLICT WITH NEW CONSTRUCTION AS REQUIRED. PROPERLY TERMINATE ALL WIRING.
- F. COORDINATE DEMOLITION OF EQUIPMENT, DEVICES, ETC. WITH OTHER DISCIPLINES AS APPLICABLE. REFER TO ARCHITECTURAL DEMOLITION DRAWINGS AND NOTES FOR COORDINATION.
- G. DRAWINGS ARE GRAPHICAL REPRESENTATIONS OF APPROXIMATE EQUIPMENT AND DEVICE LOCATIONS. CONTRACTOR SHALL VISIT THE SITE TO DETERMINE THE EXACT EXTENT OF ELECTRICAL WORK REQUIRED TO COMPLETE THE PROJECT. EXISTING CONDITIONS ARE TAKEN FROM FIELD OBSERVATION AND EXISTING BUILDING DOCUMENTS. OTHER ELECTRICAL ITEMS MAY EXIST FOR WHICH THE CONTRACTOR IS RESPONSIBLE.
- H. CONTRACTOR SHALL PROPERLY DISPOSE OF ALL ITEMS, EQUIPMENT, PANELS, LIGHT FIXTURES, ETC. BEING REMOVED AS PART OF THIS PROJECT. THE OWNER SHALL HAVE THE RIGHT OF RETAINING ANY ITEMS BEING REMOVED.
- I. CONTRACTOR SHALL PROVIDE NEW COVERPLATES ON ALL BOXES OF UNUSED AND/OR REMOVED FLUSH MOUNT DEVICES UPON COMPLETION OF PROJECT.
- J. FIREPROOFING AND/OR FIRE STOP MATERIALS REMOVED FROM FIRE RATED WALLS AND CEILINGS AS A RESULT OF DEMOLITION SHALL BE RE-INSTALLED USING AN APPROVED METHOD AS DESCRIBED IN ASSOCIATED PROJECT SPECIFICATIONS.


<u>KEY NOTES</u>

- 1) DISCONNECT AND REMOVING EXISTING LIGHT FIXTURES. PULL ALL CIRCUITRY BACK TO AN AREA OUTSIDE OF DEMOLITION AND TAG FOR RE-USE.
- (2) DISCONNECT AND REMOVE EXISTING LIGHT FIXTURES AND ALL CEILING MOUNTED DEVICES AS NECESSARY TO ACCOMMODATE ANY CEILING REMOVALS. PULL ALL CIRCUITRY BACK TO AN AREA OUTSIDE OF DEMOLITION AND TAG FOR RE-USE. REFER TO 300 SERIES DRAWINGS FOR REINSTALLATION LOCATIONS.
- 3 DISCONNECT AND REMOVE CONDUIT AND WIRING BACK TO SOURCE PANEL.
- 4 DISCONNECT AND REMOVE EXISTING CLOCK AND SPEAKERS AND STORE FOR RE-USE. PULL WIRING BACK AND TAG FOR RE-USE.

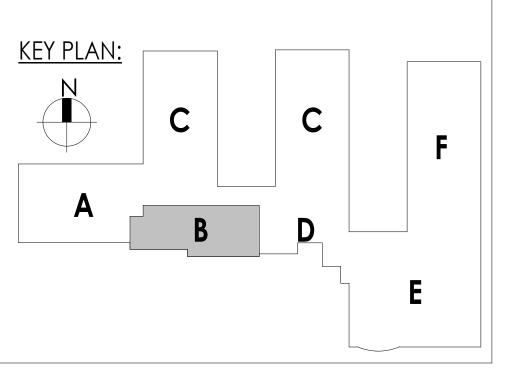

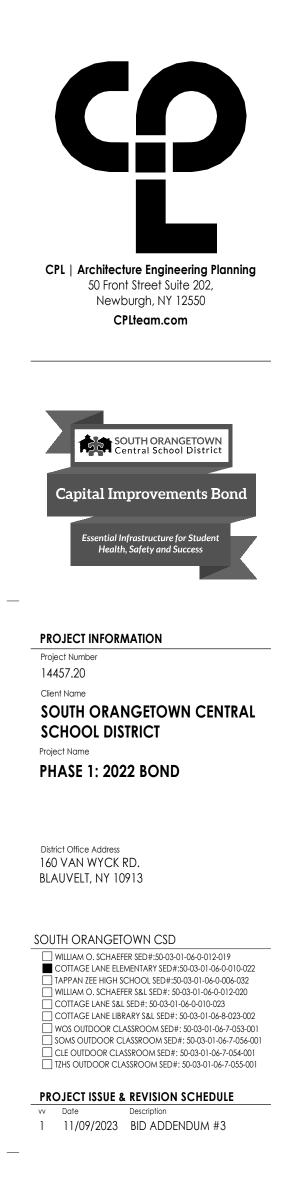

PROFESSIONAL STAMPS

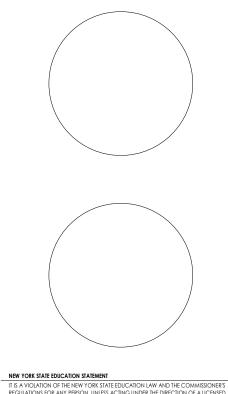


THE YORK STATE EDUCATION STATEMENT IT IS A VIOLATION OF THE NEW YORK STATE EDUCATION LAW AND THE COMMISSIONER'S REGULTIONS FOR ANY PERSON, UNLESS ACTING UNDER THE DIRECTION OF A LICENSED ARCHITECT, ENGINEER OR LAND SURVEYOR, TO ALTER AN ITEM IN ANY WAY, IF AN ITEM BEARING THE SEAL OF AN ARCHITECT, ENGINEER OR SURVEYOR IS ALTERED. THE ALTERING PARTY SHALL AFFIX TO THE ITEM THER SEAL AND THE NOTATION "ALTERED BY" FOLLOWED BY THEIR SIGNATURE AND THE DATE OF SUCH ALTERATION, AND A SPECIFIC DESCRIPTION OF THE ALTERATION.

SHEET INFORMATION

Issued	Scale
10/18/23	1/8" = 1'-0"
Project Status	
BID DOCUMENTS	
Drawn By	Checked By
MAY	JBT
Drawing Title	
FIRST FLOOR DEM	OLITION PLAN -
AREA B	



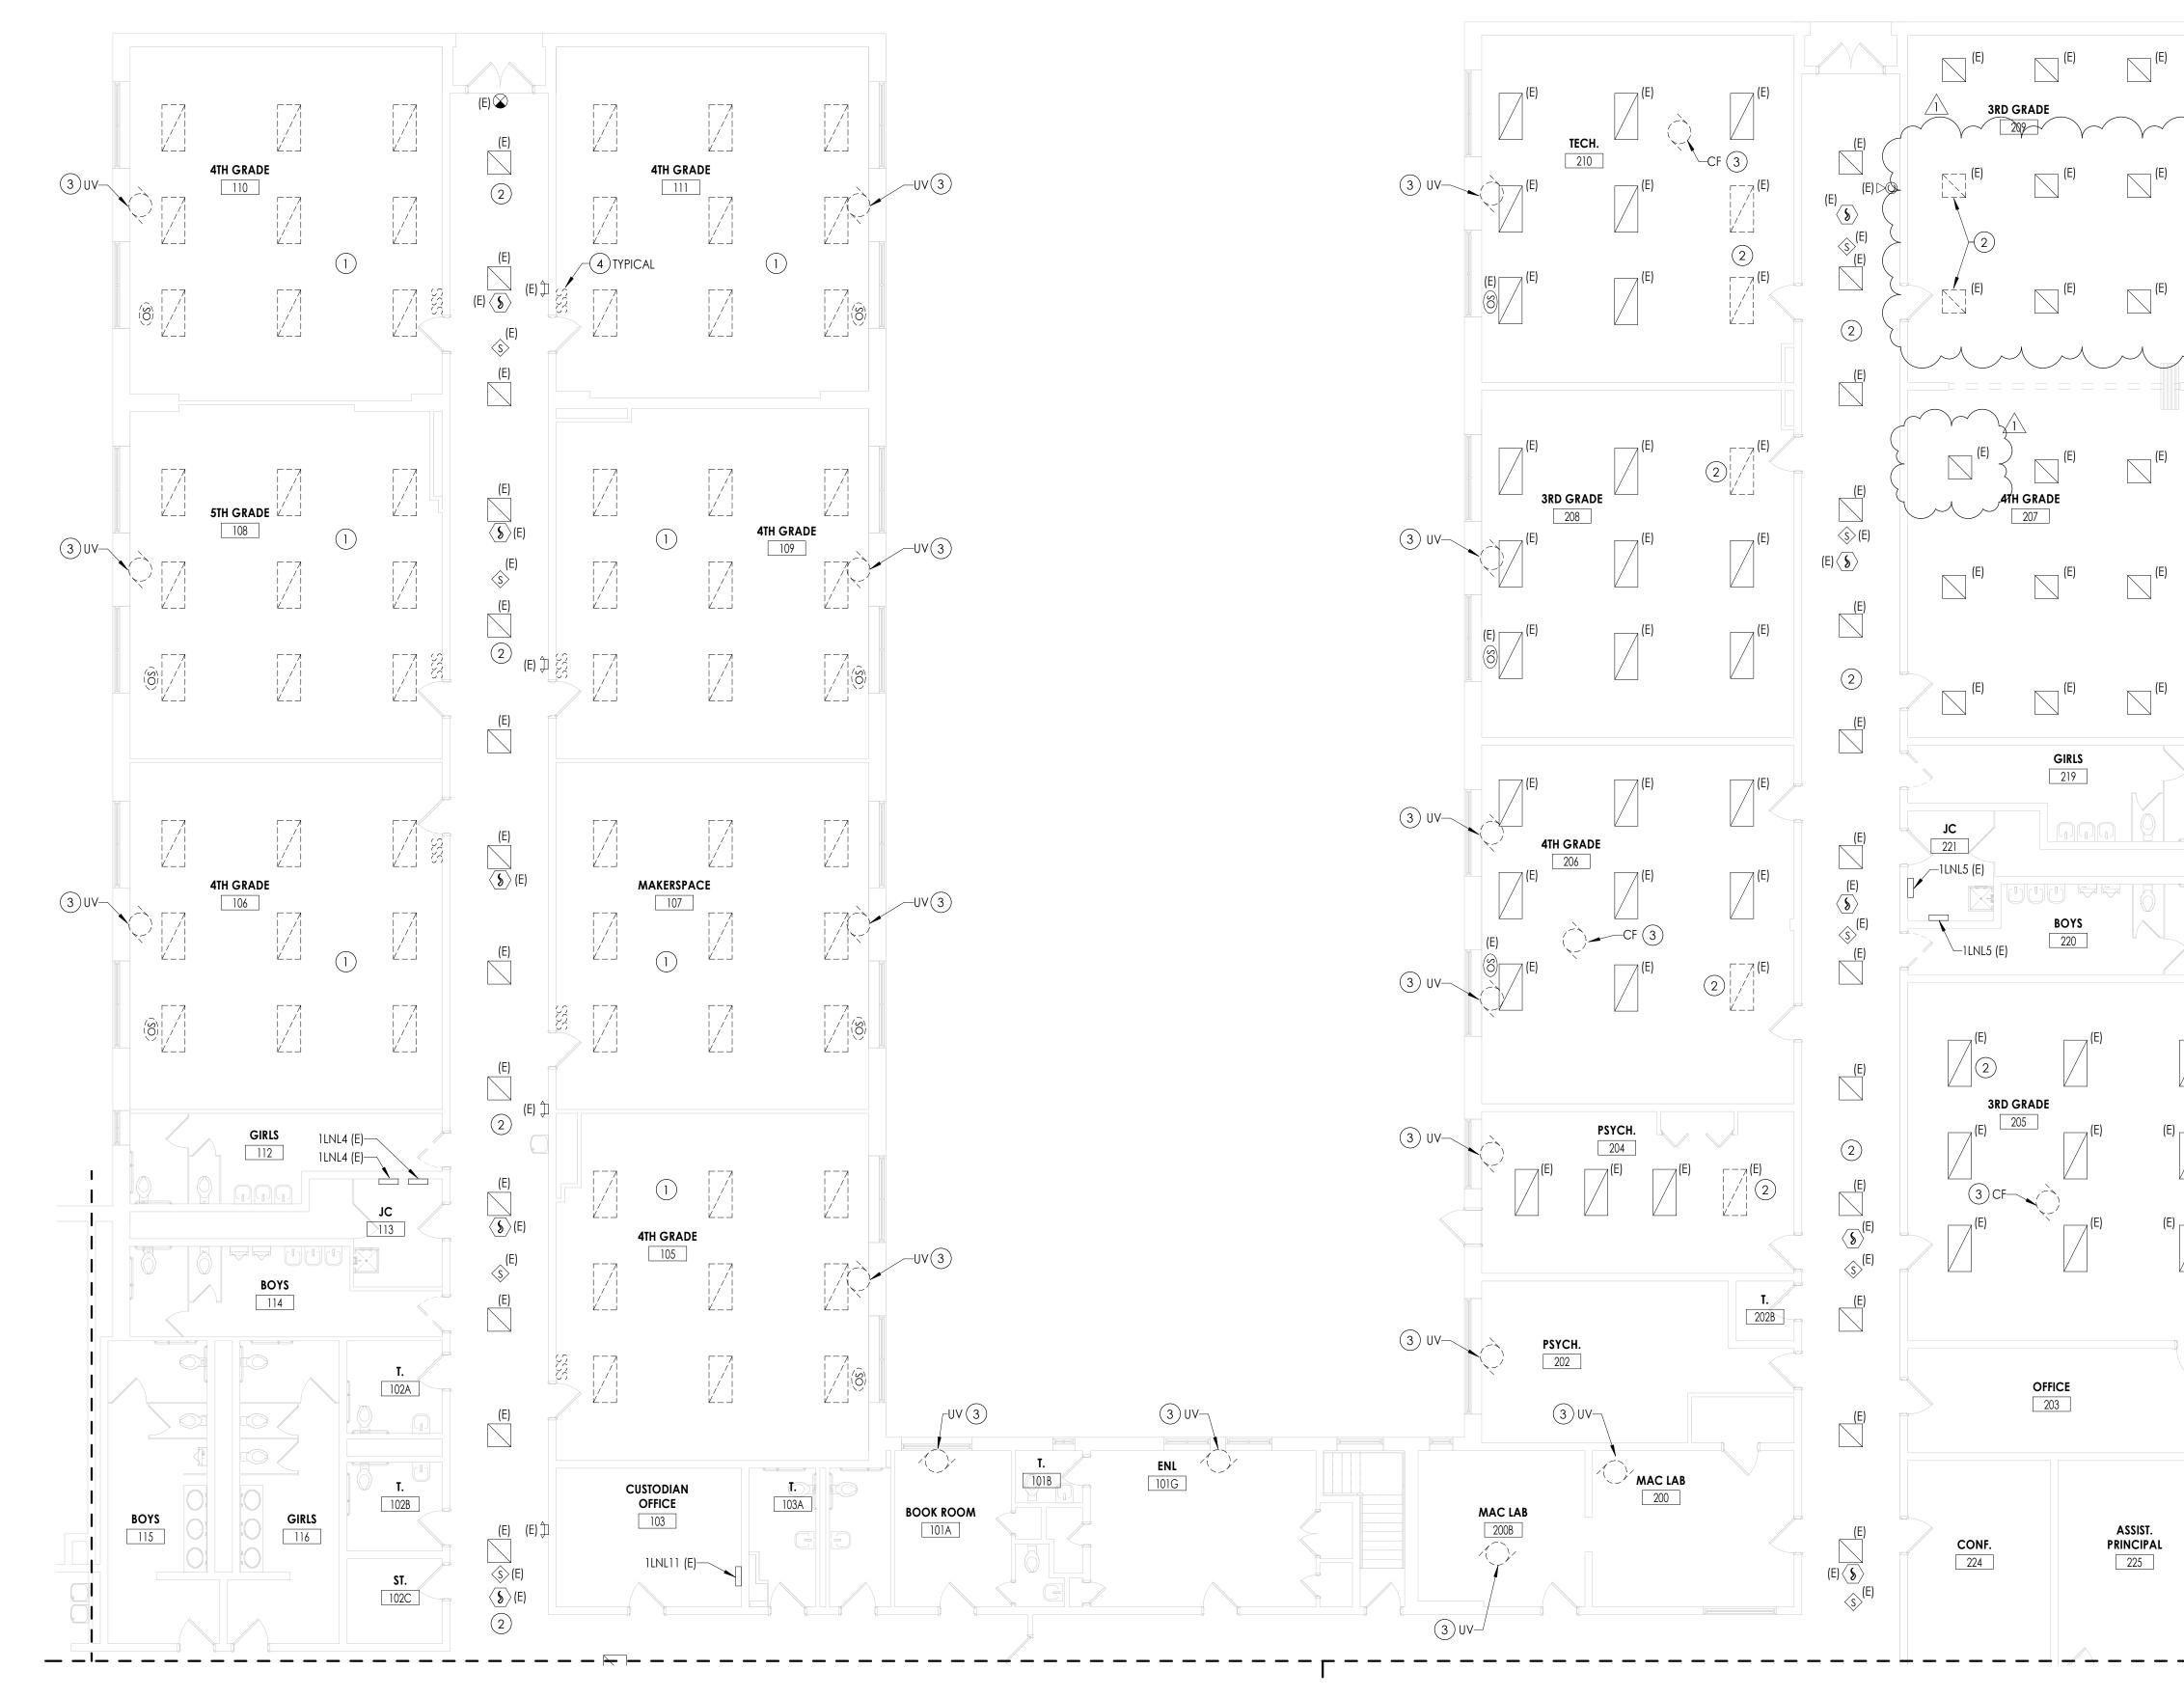

2023 11:43:57 AM <project location> REVIT PROJECT FILES C

E102 1/8" = 1'-0"

FIRST FLOOR ELECTRICAL DEMOLITION PLAN - AREA C

GENERAL NOTES

—UV(3)


- A. ALL ITEMS SHOWN ARE TO BE REMOVED UNLESS LABELED AS (E) EXISTING. REMOVAL OF DEVICE INCLUDES ITS ASSOCIATED CABLING/BRANCH CIRCUIT WIRING, AND RACEWAY.
- B. ANY EXISTING DEVICE TO REMAIN, LABELED AS (E) SHALL REMAIN IN PLACE AS WELL AS ITS' ASSOCIATED CIRCUITING AND CONDUIT, UNLESS OTHERWISE NOTED.
- C. THE CONTRACTOR SHALL REMOVE THE EXISTING ELECTRIC IN AREAS OF NEW RENOVATIONS TO ACCOMMODATE NEW CONSTRUCTION. REROUTING OF EXISTING MAY BE REQUIRED AT NEW OPENINGS IN EXISTING CONSTRUCTION OR INTERFERENCE WITH OTHER NEW WORK AS NOTED IN THE FOLLOWING NOTES.
- D. DRAWINGS INDICATE SPECIFIC ITEMS TO BE REMOVED AND/OR RELOCATED IN ORDER TO INDICATE GENERAL SCOPE. ADDITIONAL ITEMS NOT INDICATED, BUT NECESSARY FOR PROJECT RENOVATIONS, SHALL BE REMOVED, RELOCATED AND/OR REROUTED. THE CONTRACTOR SHALL ASSUME WITHIN THE BASE BID A NOMINAL AMOUNT OF BRANCH CIRCUITS, FIXTURES, DEVICES, AND SYSTEMS WIRING WITHIN WALLS OR OPENINGS BEING REMOVED OR RELOCATED AS REQUIRED TO ACCOMMODATE THE NEW CONSTRUCTION.
- E. WHERE DEVICES, FIXTURES, ETC. ARE INDICATED TO BE REMOVED, THEY AND THEIR RELATED WIRING/CONDUIT SHALL BE REMOVED BACK TO THE SOURCE PANELBOARD UNLESS OTHERWISE NOTED. ON CIRCUITS WHERE OTHER DEVICES, FIXTURES, ETC. ARE FOUND THAT MUST REMAIN, MAINTAIN CIRCUIT CONTINUITY BY PROVIDING ADDITIONAL WIRING, TO FEED THROUGH TO THESE REMAINING ITEMS. RELOCATE ANY CIRCUITS THAT REMAIN, TO AVOID CONFLICT WITH NEW CONSTRUCTION AS REQUIRED. PROPERLY TERMINATE ALL WIRING.
- F. COORDINATE DEMOLITION OF EQUIPMENT, DEVICES, ETC. WITH OTHER DISCIPLINES AS APPLICABLE. REFER TO ARCHITECTURAL DEMOLITION DRAWINGS AND NOTES FOR COORDINATION.
- G. DRAWINGS ARE GRAPHICAL REPRESENTATIONS OF APPROXIMATE EQUIPMENT AND DEVICE LOCATIONS. CONTRACTOR SHALL VISIT THE SITE TO DETERMINE THE EXACT EXTENT OF ELECTRICAL WORK REQUIRED TO COMPLETE THE PROJECT. EXISTING CONDITIONS ARE TAKEN FROM FIELD OBSERVATION AND EXISTING BUILDING DOCUMENTS. OTHER ELECTRICAL ITEMS MAY EXIST FOR WHICH THE CONTRACTOR IS RESPONSIBLE.
- H. CONTRACTOR SHALL PROPERLY DISPOSE OF ALL ITEMS, EQUIPMENT, PANELS, LIGHT FIXTURES, ETC. BEING REMOVED AS PART OF THIS PROJECT. THE OWNER SHALL HAVE THE RIGHT OF RETAINING ANY ITEMS BEING REMOVED.
- I. CONTRACTOR SHALL PROVIDE NEW COVERPLATES ON ALL BOXES OF UNUSED AND/OR REMOVED FLUSH MOUNT DEVICES UPON COMPLETION OF PROJECT.
- J. FIREPROOFING AND/OR FIRE STOP MATERIALS REMOVED FROM FIRE RATED WALLS AND CEILINGS AS A RESULT OF DEMOLITION SHALL BE RE-INSTALLED USING AN APPROVED METHOD AS DESCRIBED IN ASSOCIATED PROJECT SPECIFICATIONS.


KEY NOTES

7(E)


 $\langle | \mathfrak{S} |$

- 1) DISCONNECT AND REMOVING EXISTING LIGHT FIXTURES. PULL ALL CIRCUITRY AND SWITCHING BACK TO AN AREA OUTSIDE OF DEMOLITION AND TAG FOR RE-USE.
- 2 DISCONNECT AND REMOVE EXISTING LIGHT FIXTURES AND ALL CEILING MOUNTED DEVICES AS NECESSARY TO ACCOMMODATE ANY CEILING REMOVALS. PULL ALL CIRCUITRY BACK TO AN AREA OUTSIDE OF DEMOLITION AND TAG FOR RE-USE. REFER TO 300 SERIES DRAWINGS FOR REINSTALLATION LOCATIONS.
 3 DISCONNECT AND REMOVE CONDUIT AND WIRING BACK TO SOURCE PANEL.
- (4) DISCONNECT AND REMOVE SWITCHES AND ALL SWITCH WIRING. BACKBOX AND CONDUIT TO REMAIN FOR NEW LOW-VOLTAGE SWITCHING.

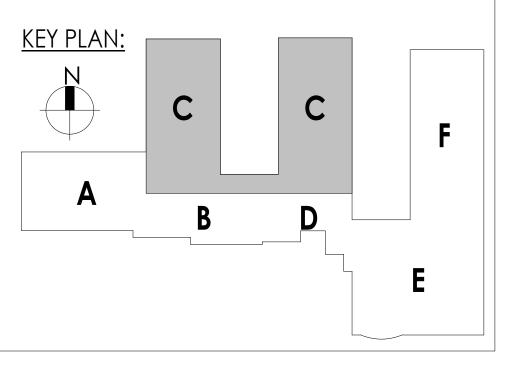

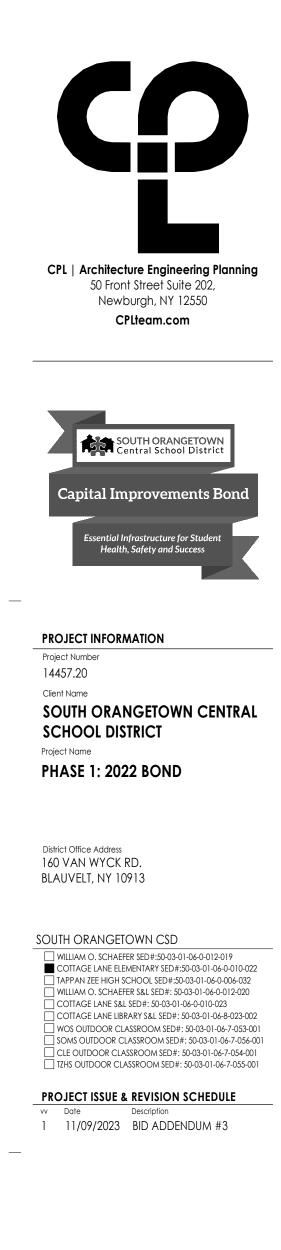

PROFESSIONAL STAMPS

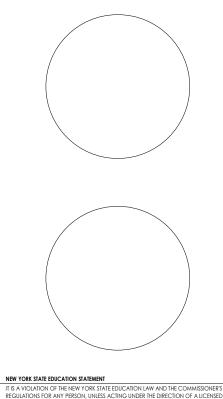


ARCHITECT, ENGINEER OR LAND SURVEYOR, TO ALTER AN ITEM IN ANY WAY, IF AN ITEM BEARING THE SEAL OF AN ARCHITECT, ENGNEER OR SURVEYOR IS ALTERED, THE ALTERING PARTY SHALL AFTIX TO THE ITEM THIRE SEAL AND THE NOTATION "ALTERED BY "FOLOWED BY THEIR SIGNATURE AND THE DATE OF SUCH ALTERATION, AND A SPECIFIC DESCRIPTION OF TH ALTERATION.


SHEET INFORMATION

ued	Scale
0/18/23	AS NOTED
oject Status	
ID DOCUMENTS	
rawn By	Checked By
1AY	JBT
rawing Title	
IRST FLOOR DEM	OLITION PLAN

FIRST FLOOR DEMOLITION PLAN -AREA C



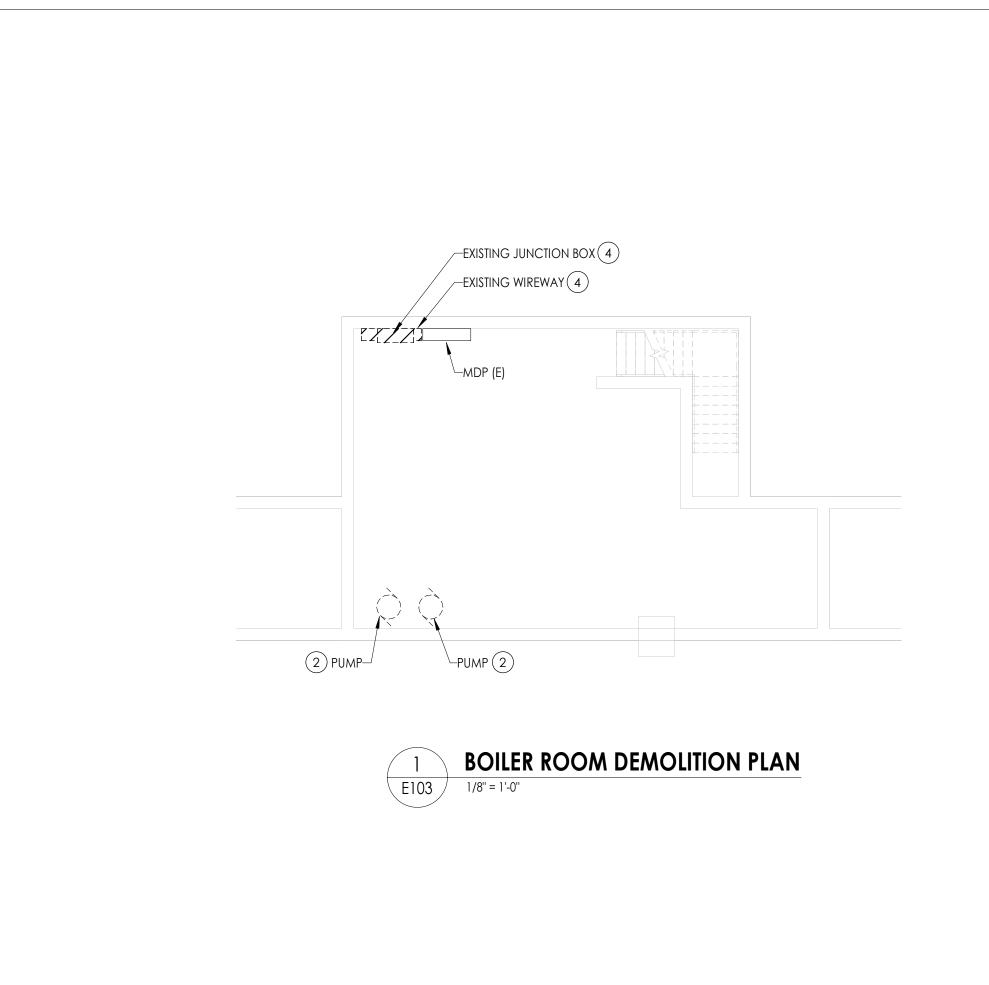

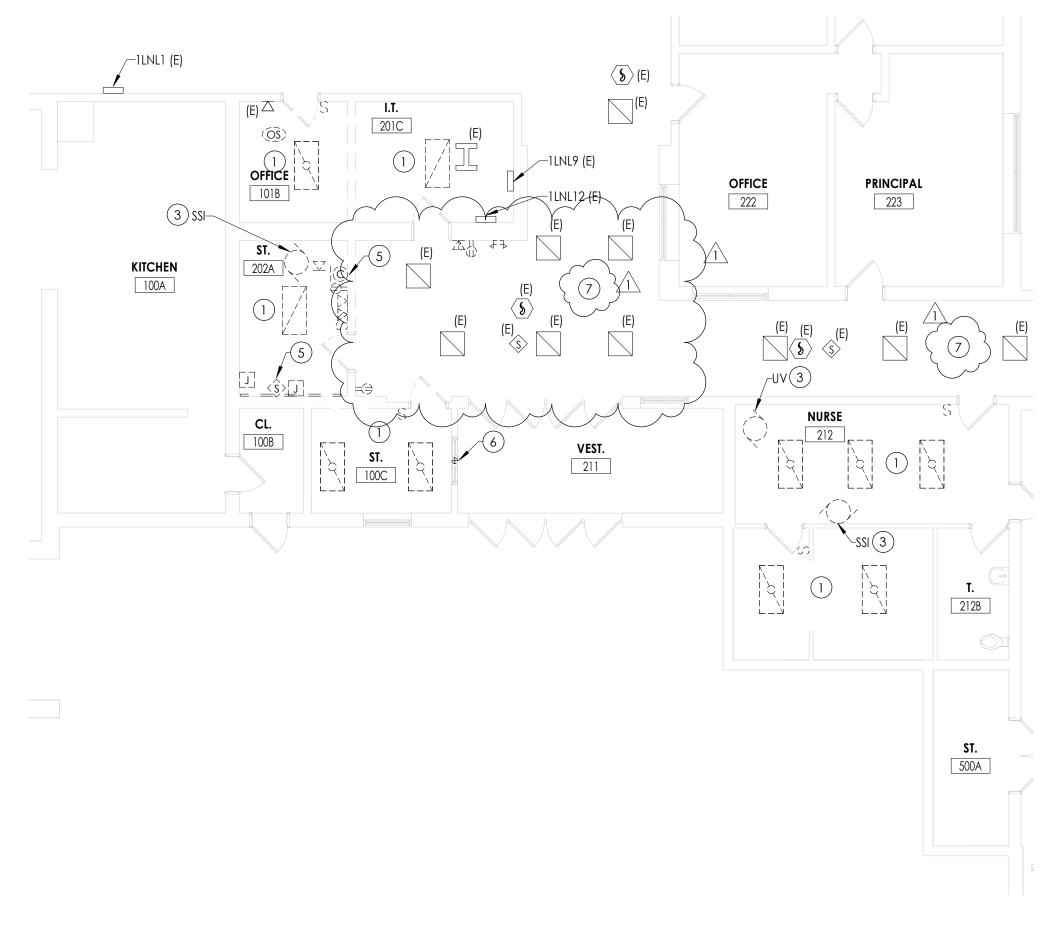





GENERAL NOTES

- A. ALL ITEMS SHOWN ARE TO BE REMOVED UNLESS LABELED AS (E) EXISTING. REMOVAL OF DEVICE INCLUDES ITS ASSOCIATED CABLING/BRANCH CIRCUIT WIRING, AND RACEWAY.
- B. ANY EXISTING DEVICE TO REMAIN, LABELED AS (E) SHALL REMAIN IN PLACE AS WELL AS ITS' ASSOCIATED CIRCUITING AND CONDUIT, UNLESS OTHERWISE NOTED.
- C. THE CONTRACTOR SHALL REMOVE THE EXISTING ELECTRIC IN AREAS OF NEW RENOVATIONS TO ACCOMMODATE NEW CONSTRUCTION. REROUTING OF EXISTING MAY BE REQUIRED AT NEW OPENINGS IN EXISTING CONSTRUCTION OR INTERFERENCE WITH OTHER NEW WORK AS NOTED IN THE FOLLOWING NOTES.
- D. DRAWINGS INDICATE SPECIFIC ITEMS TO BE REMOVED AND/OR RELOCATED IN ORDER TO INDICATE GENERAL SCOPE. ADDITIONAL ITEMS NOT INDICATED, BUT NECESSARY FOR PROJECT RENOVATIONS, SHALL BE REMOVED, RELOCATED AND/OR REROUTED. THE CONTRACTOR SHALL ASSUME WITHIN THE BASE BID A NOMINAL AMOUNT OF BRANCH CIRCUITS, FIXTURES, DEVICES, AND SYSTEMS WIRING WITHIN WALLS OR OPENINGS BEING REMOVED OR RELOCATED AS REQUIRED TO ACCOMMODATE THE NEW CONSTRUCTION.
- E. WHERE DEVICES, FIXTURES, ETC. ARE INDICATED TO BE REMOVED, THEY AND THEIR RELATED WIRING/CONDUIT SHALL BE REMOVED BACK TO THE SOURCE PANELBOARD UNLESS OTHERWISE NOTED. ON CIRCUITS WHERE OTHER DEVICES, FIXTURES, ETC. ARE FOUND THAT MUST REMAIN, MAINTAIN CIRCUIT CONTINUITY BY PROVIDING ADDITIONAL WIRING, TO FEED THROUGH TO THESE REMAINING ITEMS. RELOCATE ANY CIRCUITS THAT REMAIN, TO AVOID CONFLICT WITH NEW CONSTRUCTION AS REQUIRED. PROPERLY TERMINATE ALL WIRING.
- F. COORDINATE DEMOLITION OF EQUIPMENT, DEVICES, ETC. WITH OTHER DISCIPLINES AS APPLICABLE. REFER TO ARCHITECTURAL DEMOLITION DRAWINGS AND NOTES FOR COORDINATION.
- G. DRAWINGS ARE GRAPHICAL REPRESENTATIONS OF APPROXIMATE EQUIPMENT AND DEVICE LOCATIONS. CONTRACTOR SHALL VISIT THE SITE TO DETERMINE THE EXACT EXTENT OF ELECTRICAL WORK REQUIRED TO COMPLETE THE PROJECT. EXISTING CONDITIONS ARE TAKEN FROM FIELD OBSERVATION AND EXISTING BUILDING DOCUMENTS. OTHER ELECTRICAL ITEMS MAY EXIST FOR WHICH THE CONTRACTOR IS RESPONSIBLE.
- H. CONTRACTOR SHALL PROPERLY DISPOSE OF ALL ITEMS, EQUIPMENT, PANELS, LIGHT FIXTURES, ETC. BEING REMOVED AS PART OF THIS PROJECT. THE OWNER SHALL HAVE THE RIGHT OF RETAINING ANY ITEMS BEING REMOVED.
- I. CONTRACTOR SHALL PROVIDE NEW COVERPLATES ON ALL BOXES OF UNUSED AND/OR REMOVED FLUSH MOUNT DEVICES UPON COMPLETION OF PROJECT.
- J. FIREPROOFING AND/OR FIRE STOP MATERIALS REMOVED FROM FIRE RATED WALLS AND CEILINGS AS A RESULT OF DEMOLITION SHALL BE RE-INSTALLED USING AN APPROVED METHOD AS DESCRIBED IN ASSOCIATED PROJECT SPECIFICATIONS.


KEY NOTES

- 1 DISCONNECT AND REMOVING EXISTING LIGHT FIXTURES. PULL ALL CIRCUITRY BACK TO AN AREA OUTSIDE OF DEMOLITION AND TAG FOR RE-USE.
- 2 DISCONNECT EXISTING CONDUIT AND WIRE FROM PUMPS AND TAG FOR RE-USE. ANY MOTOR STARTERS/CONTROLLERS TO REMOVE.
- (3) DISCONNECT AND REMOVE CONDUIT AND WIRING BACK TO SOURCE PANEL.
- 4 DISCONNECT AND REMOVE EXISTING WALL MOUNTED JUNCTION BOX AND WIREWAY IN THEIR ENTIRETY, TO ACCOMMODATE NEW SWITCHGEAR. REMOVE ALL CONDUITS FROM WIREWAY AND JUNCTION BOX BACK, AND CUT BACK TO CEILING LEVEL. PULL ALL WIRING BACK AND TAG FOR RE-USE. REMOVE (2) OLD ORIGINAL CONDUITS IN THEIR ENTIRETY.
- 5 DISCONNECT EXISTING CLOCK AND SPEAKER AND STORE FOR RE-USE. TAG WIRING FOR RE-USE.
- 6 DISCONNECT AND REMOVE ALL CONDUIT AND WIRE TO EXISTING FIRE
- DISCONNECT AND REMOVE EXISTING LIGHT FIXTURES AND ALL CEILING MOUNTED DEVICES AS NECESSARY TO ACCOMMODATE ANY CEILING REMOVALS. PULL ALL CIRCUITRY BACK TO AN AREA OUTSIDE OF DEMOLITION AND TAG FOR RE-USE. REFER TO 300 SERIES DRAWINGS FOR REINSTALLATION LOCATIONS.

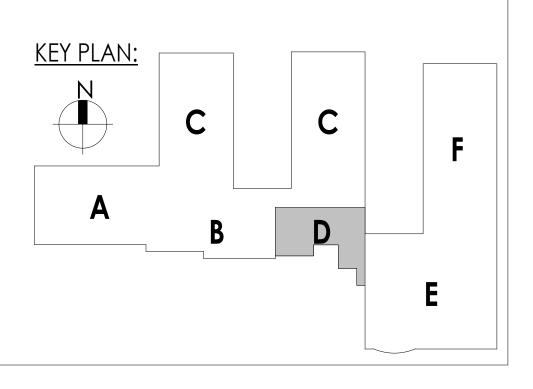

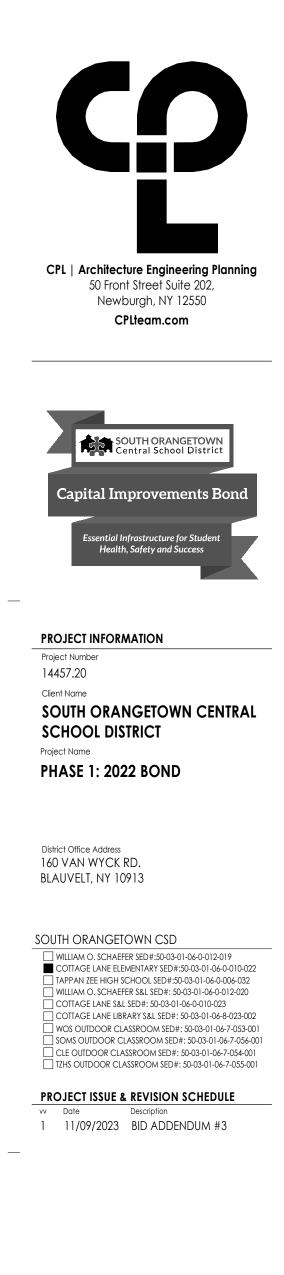

PROFESSIONAL STAMPS

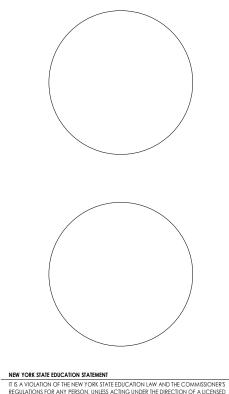

TEET TURE STATE EDUCATION STATEMENT IT IS A VIOLATION OF THE NEW YORK STATE EDUCATION LAW AND THE COMMISSIONER'S REGULATIONS FOR ANY PERSON, UNLESS ACTING UNDER THE DIRECTION OF A LICENSED ARCHITECT, ENGINEER OR LAND SURVEYOR, TO ALTER AN ITEM IN ANY WAY. IF AN ITEM BEARING THE SEAL OF AN ACHITECT, ENGINEER OR SURVEYOR IS ALTERED. THE ALTERING PARTY SHALL AFRIY TO THE ITEM THER SEAL AND THE NOTATION "ALTERED BY" FOLLOWED BY THEIR SIGNATURE AND THE DATE OF SUCH ALTERATION, AND A SPECIFIC DESCRIPTION OF THE ALTERATION.

SHEET INFORMATION


Issued	Scale
10/18/23	1/8" = 1'-0"
Project Status	
BID DOCUMENTS	
Drawn By	Checked By
MAY	JBT
Drawing Title	
FIRST FLOOR DEM	10LITION PLAN
ARFA D	



3 UV-

3 UV-

3 UV-

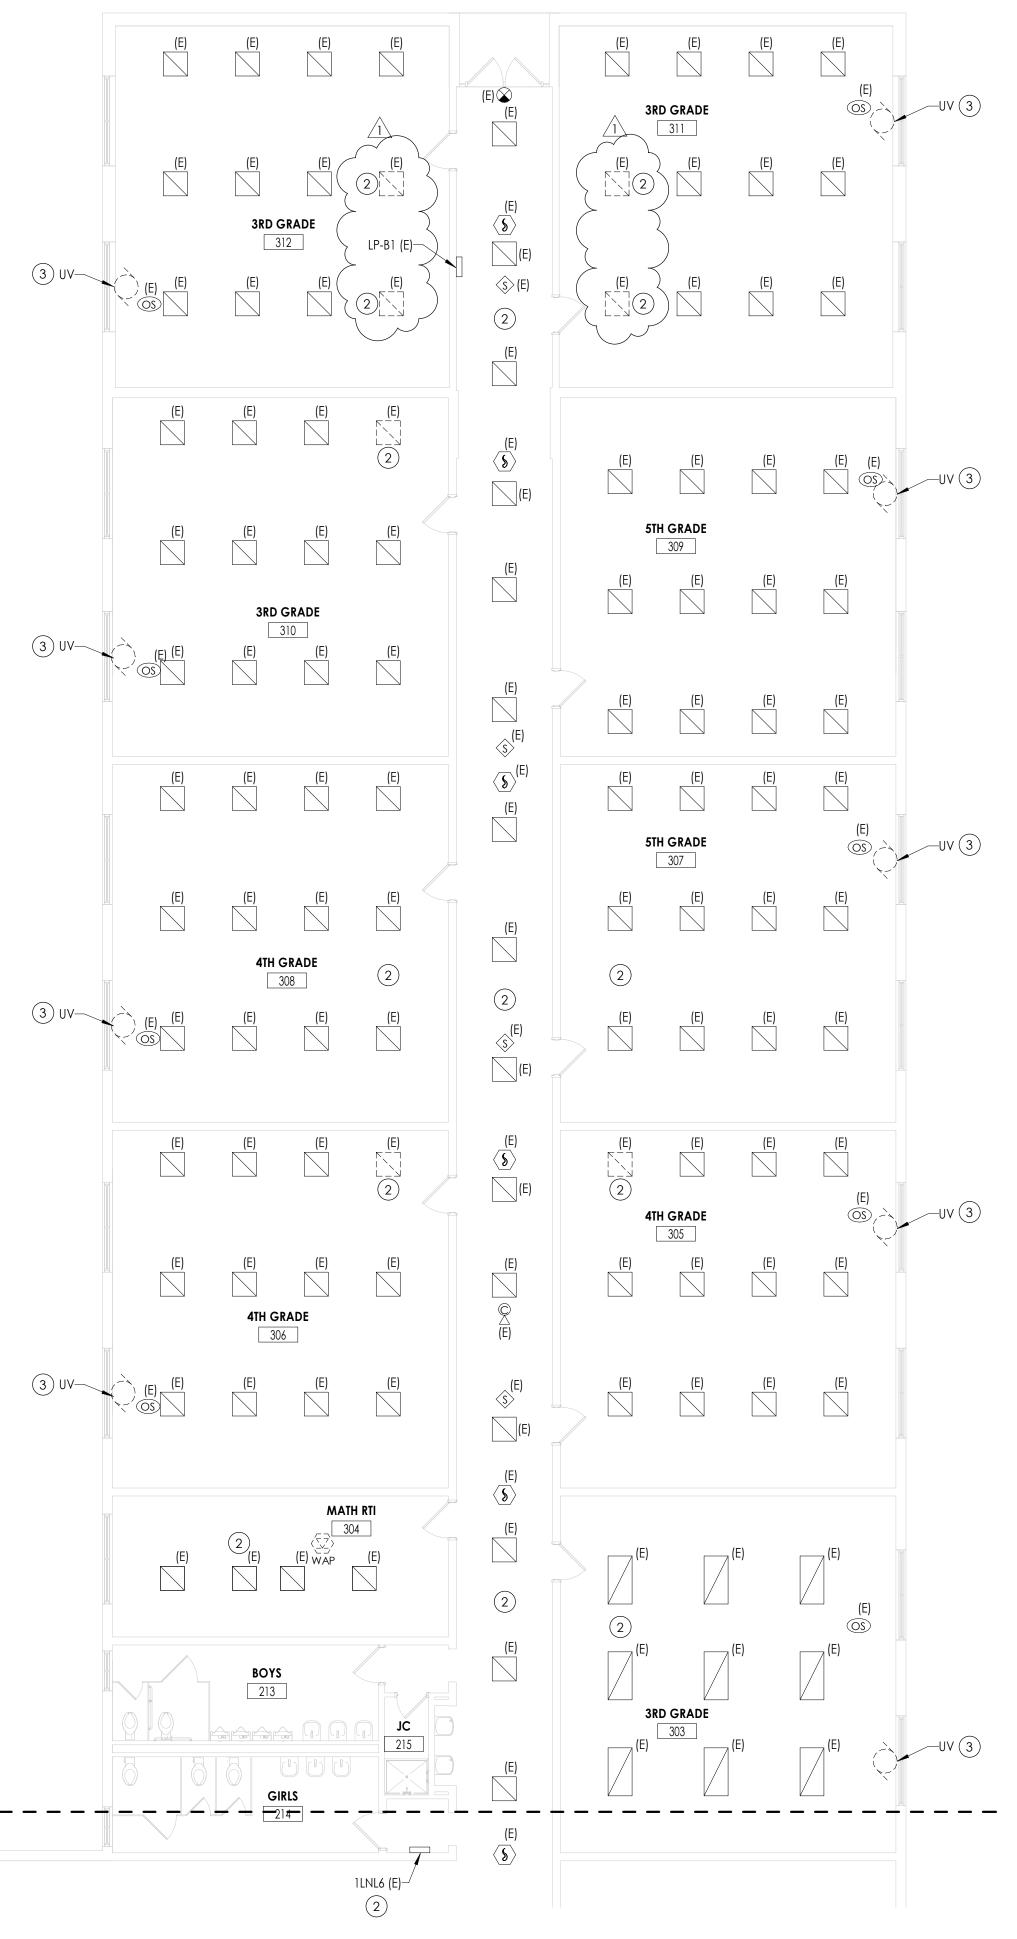

FIRST FLOOR ELECTRICAL DEMOLITION PLAN - AREA F E105 1/8" = 1'-0"

GENERAL NOTES

- A. ALL ITEMS SHOWN ARE TO BE REMOVED UNLESS LABELED AS (E) EXISTING. REMOVAL OF DEVICE INCLUDES ITS ASSOCIATED CABLING/BRANCH CIRCUIT WIRING, AND RACEWAY.
- B. ANY EXISTING DEVICE TO REMAIN, LABELED AS (E) SHALL REMAIN IN PLACE AS WELL AS ITS' ASSOCIATED CIRCUITING AND CONDUIT, UNLESS OTHERWISE NOTED.
- C. THE CONTRACTOR SHALL REMOVE THE EXISTING ELECTRIC IN AREAS OF NEW RENOVATIONS TO ACCOMMODATE NEW CONSTRUCTION. REROUTING OF EXISTING MAY BE REQUIRED AT NEW OPENINGS IN EXISTING CONSTRUCTION OR INTERFERENCE WITH OTHER NEW WORK AS NOTED IN THE FOLLOWING NOTES.
- D. DRAWINGS INDICATE SPECIFIC ITEMS TO BE REMOVED AND/OR RELOCATED IN ORDER TO INDICATE GENERAL SCOPE. ADDITIONAL ITEMS NOT INDICATED, BUT NECESSARY FOR PROJECT RENOVATIONS, SHALL BE REMOVED, RELOCATED AND/OR REROUTED. THE CONTRACTOR SHALL ASSUME WITHIN THE BASE BID A NOMINAL AMOUNT OF BRANCH CIRCUITS, FIXTURES, DEVICES, AND SYSTEMS WIRING WITHIN WALLS OR OPENINGS BEING REMOVED OR RELOCATED AS REQUIRED TO ACCOMMODATE THE NEW CONSTRUCTION.
- E. WHERE DEVICES, FIXTURES, ETC. ARE INDICATED TO BE REMOVED, THEY AND THEIR RELATED WIRING/CONDUIT SHALL BE REMOVED BACK TO THE SOURCE PANELBOARD UNLESS OTHERWISE NOTED. ON CIRCUITS WHERE OTHER DEVICES, FIXTURES, ETC. ARE FOUND THAT MUST REMAIN, MAINTAIN CIRCUIT CONTINUITY BY PROVIDING ADDITIONAL WIRING, TO FEED THROUGH TO THESE REMAINING ITEMS. RELOCATE ANY CIRCUITS THAT REMAIN, TO AVOID CONFLICT WITH NEW CONSTRUCTION AS REQUIRED. PROPERLY TERMINATE ALL WIRING.
- F. COORDINATE DEMOLITION OF EQUIPMENT, DEVICES, ETC. WITH OTHER DISCIPLINES AS APPLICABLE. REFER TO ARCHITECTURAL DEMOLITION DRAWINGS AND NOTES FOR COORDINATION.
- G. DRAWINGS ARE GRAPHICAL REPRESENTATIONS OF APPROXIMATE EQUIPMENT AND DEVICE LOCATIONS. CONTRACTOR SHALL VISIT THE SITE TO DETERMINE THE EXACT EXTENT OF ELECTRICAL WORK REQUIRED TO COMPLETE THE PROJECT. EXISTING CONDITIONS ARE TAKEN FROM FIELD OBSERVATION AND EXISTING BUILDING DOCUMENTS. OTHER ELECTRICAL ITEMS MAY EXIST FOR WHICH THE CONTRACTOR IS RESPONSIBLE.
- H. CONTRACTOR SHALL PROPERLY DISPOSE OF ALL ITEMS, EQUIPMENT, PANELS, LIGHT FIXTURES, ETC. BEING REMOVED AS PART OF THIS PROJECT. THE OWNER SHALL HAVE THE RIGHT OF RETAINING ANY ITEMS BEING REMOVED.
- I. CONTRACTOR SHALL PROVIDE NEW COVERPLATES ON ALL BOXES OF UNUSED AND/OR REMOVED FLUSH MOUNT DEVICES UPON COMPLETION OF PROJECT.
- J. FIREPROOFING AND/OR FIRE STOP MATERIALS REMOVED FROM FIRE RATED WALLS AND CEILINGS AS A RESULT OF DEMOLITION SHALL BE RE-INSTALLED USING AN APPROVED METHOD AS DESCRIBED IN ASSOCIATED PROJECT SPECIFICATIONS.

<u>KEY NOTES</u>

(1) NOT USED. (2) DISCONNECT AND REMOVE EXISTING LIGHT FIXTURES AND ALL CEILING MOUNTED DEVICES AS NECESSARY TO ACCOMMODATE ANY CEILING REMOVALS. PULL ALL CIRCUITRY BACK TO AN AREA OUTSIDE OF DEMOLITION AND TAG FOR RE-USE. REFER TO 300 SERIES DRAWINGS FOR REINSTALLATION loc_iations.

(3) DISCONNECT AND REMOVE CONDUIT AND WIRING BACK TO SOURCE PANEL.




South orangetown CSD WILLIAM O. SCHAEFER SED#:50-03-01-06-0-012-019

COTTAGE LANE ELEMENTARY SED#:50-03-01-06-0-010-022 TAPPAN ZEE HIGH SCHOOL SED#:50-03-01-06-0-006-032 WILLIAM O. SCHAEFER S&L SED#: 50-03-01-06-0-012-020 COTTAGE LANE S&L SED#: 50-03-01-06-0-010-023 COTTAGE LANE LIBRARY S&L SED#: 50-03-01-06-8-023-002 WOS OUTDOOR CLASSROOM SED#: 50-03-01-06-7-053-001 SOMS OUTDOOR CLASSROOM SED#: 50-03-01-06-7-056-001 CLE OUTDOOR CLASSROOM SED#: 50-03-01-06-7-054-001 TZHS OUTDOOR CLASSROOM SED#: 50-03-01-06-7-055-001

PROJECT ISSUE & REVISION SCHEDULE

1 11/09/2023 BID ADDENDUM #3

PROFESSIONAL STAMPS

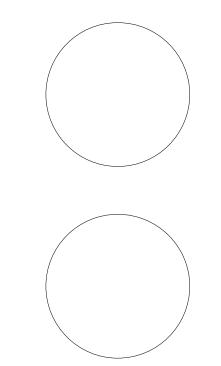


ARING THE SEAL OF AN ARCHITECT, ENGINEER OR SURVEYOR IS ALTERED, THE ALTER


SHEET INFORMATION

NEW YORK STATE EDUCATION STATEM


Issued	Scale
10/18/23	AS NOTED
Project Status	
BID DOCUMENTS	
Drawn By	Checked By
MAY	JBT
Drawing Title	
FIRST FLOOR DEM	OLITION PLAN
AREA F	



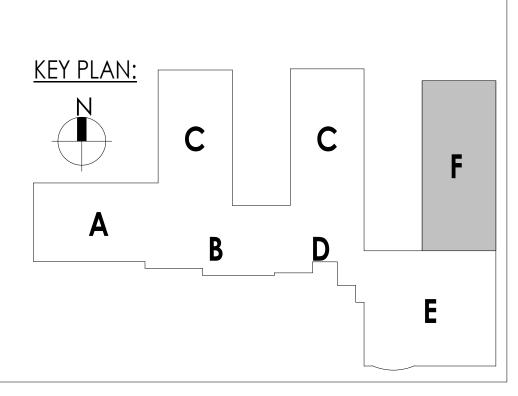

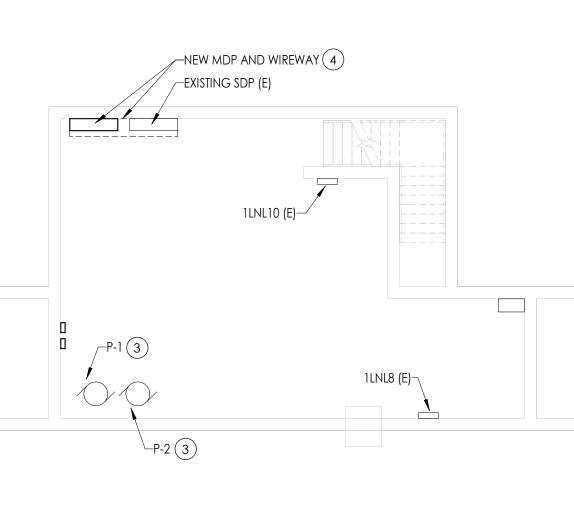



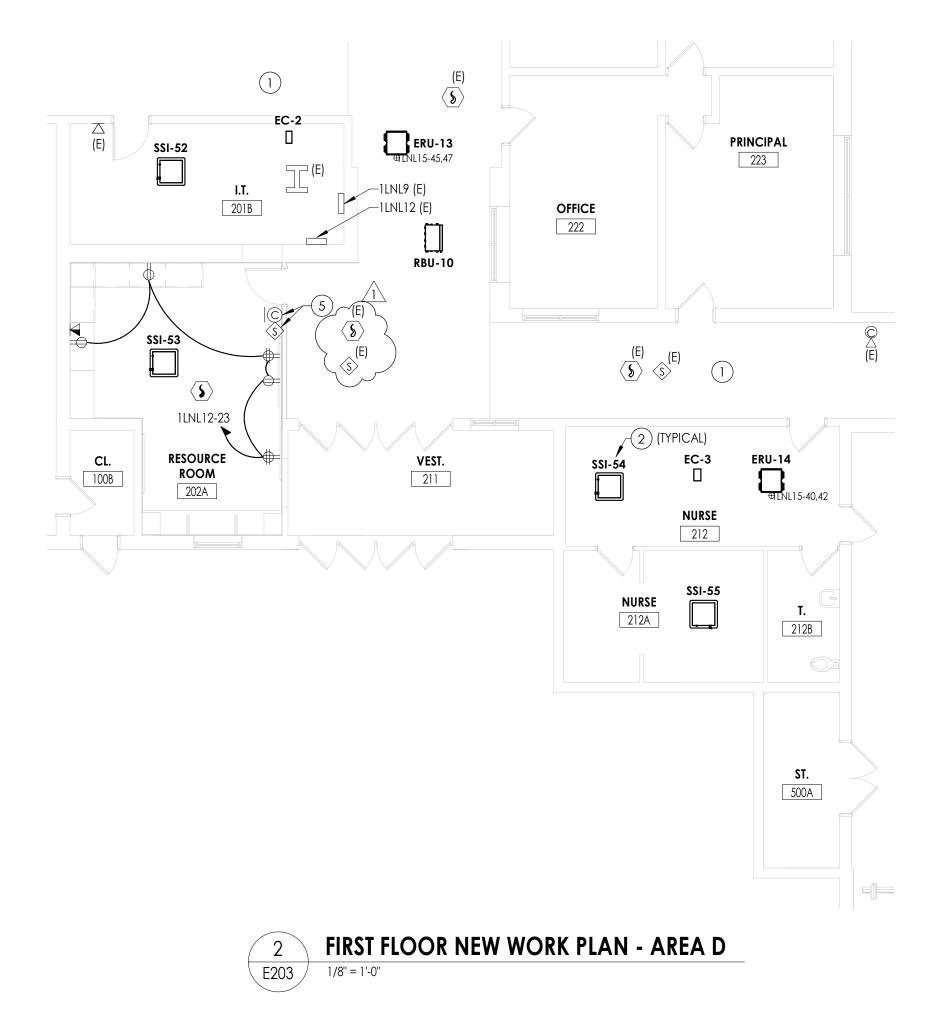



GENERAL NOTES

- A. FOR ALL 120V DEVICES SHOWN, WIRE WITH (2)#12, #12G IN 3/4"C AND CONNECT TO 20A/1P CIRCUIT BREAKER IN PANEL INDICATED TO CIRCUIT INDICATED ADJACENT TO DEVICE.
- B. ALL CIRCUITS OVER 100' SHALL BE WIRED WITH #10 THHN.

<u>KEY NOTES</u>

- 1) EXISTING CEILING MOUNTED DEVICES TO BE RE-INSTALLED BACK IN CEILING AS NECESSARY TO ACCOMMODATE ANY CEILING REMOVAL/REPLCAEMENTS. CONNECT TO EXISTING TAGGED WIRING.
- 2 ALL MECHANICAL EQUIPMENT POWER REQUIREMENTS ARE NOTED ON DRAWINGS E901, E902, AND E903. LABEL INDICATES EQUIPMENT TAG. REFER TO RESPECTIVE TAG ON DRAWINGS NOTED.
- (3) CONNECT NEW PUMPS TO EXISTING TAGGED CIRCUITRY. REWORK/EXTEND WIRING AS NECESSARY TO ACCOMMODATE NEW PUMPS. WIRE PUMPS THROUGH VFD'S. PROVIDE ADDITIONAL CONDUIT AND WIRING IN KIND.
- (4) PROVIDE NEW 2,000 AMP SWITCHGEAR AND NEW WIREWAY AT LOCATION INDICATED. WIREWAY TO BE 18"W, X 18"D, X 10" LONG, MOUNTED ABOVE NEW SWITCHGEAR AND EXISTING MDP. CONNECT EXISTING FEEDER CONDUITS THAT WERE CUT BACK TO NEW WIREWAY. PULL EXISTING TAGGED FEEDERS THROUGH WIREWAY TO EXISTING BREAKERS. REFER TO DRAWING CLE-E001 FOR FURTHER INFORMATION.
- 5 NEW LOCATION OF EXISTING CLOCK AND SPEAKER. CONNECT TO EXISTING TAGGED WIRING.

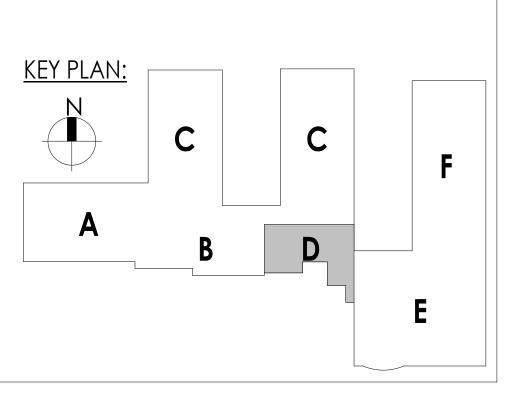


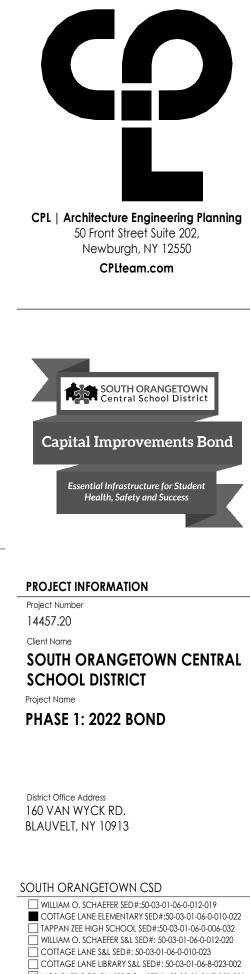

WOS OUTDOOR CLASSROOM SED#: 50-03-01-06-7-053-001 Soms outdoor classroom sed#: 50-03-01-06-7-056-001 CLE OUTDOOR CLASSROOM SED#: 50-03-01-06-7-054-001 TZHS OUTDOOR CLASSROOM SED#: 50-03-01-06-7-055-001 PROJECT ISSUE & REVISION SCHEDULE

vv Date Descriptio 1 11/08/2023 BID ADDENDUM #3

PROFESSIONAL STAMPS

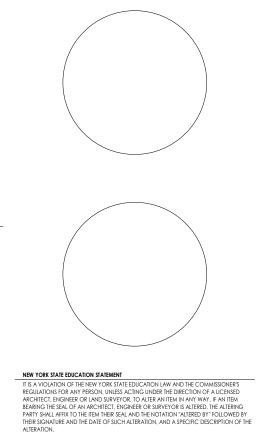


SHEET INFORMATION

Issued	Scale
10/18/23	AS NOTED
Project Status	
BID DOCUMENTS	
Drawn By	Checked By
MAY	JBT
Drawing Title	
FIRST FLOOR NE	W WORK PLAN
AREA D	



/8/2023 11:44:01 AM cproject location> REVIT PROJECT FILES ON BIM3

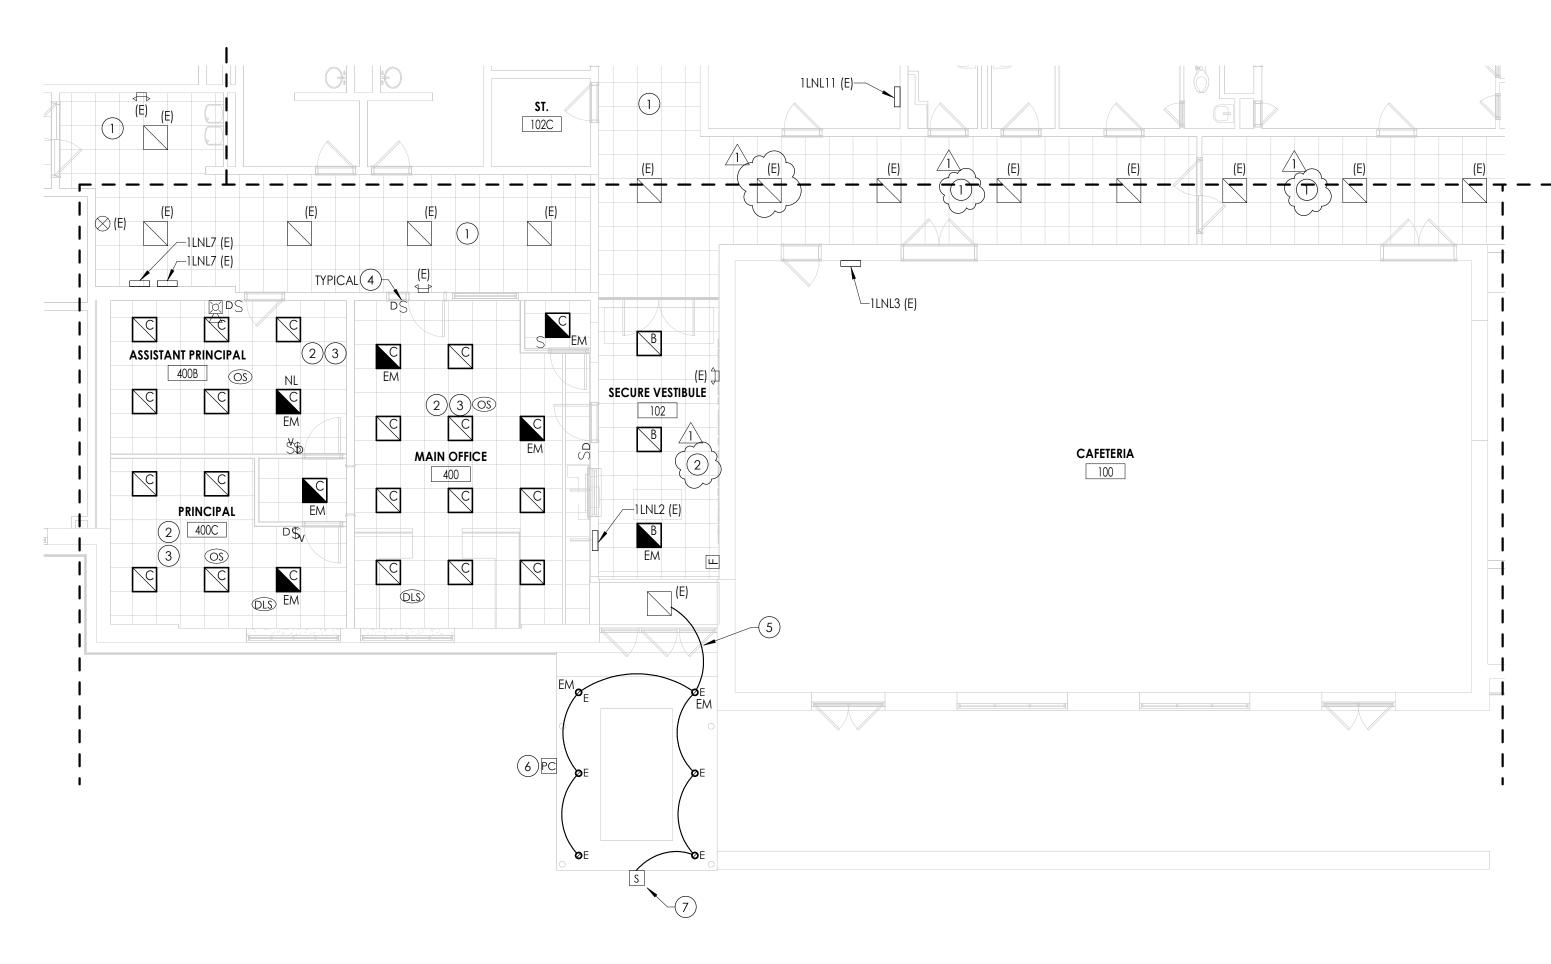





GENERAL NOTES

- A. FIXTURE TYPE MARK IS INDICATED ADJACENT TO NEW LIGHT FIXTURES. REFER TO LUMINAIRE SCHEDULE ON DRAWING WOS-E900 FOR FIXTURE DESCRIPTIONS AND NOTES.
- B. INSTALL LOW-VOLTAGE SENSORS AS SHOWN. PROVIDE ALL LOW-VOLTAGE WIRING BETWEEN SENSORS, SWITCHES, CONTROLLERS, AND LUMINAIRES.
- C. PROVIDE ANY ADDITIONAL POWER SUPPLIES OR OTHER MISCELLANEOUS COMPONENTS REQUIRED FOR A COMPLETE OPERATIONAL LIGHTING SYSTEM TO MEET INTENT OF LIGHTING SEQUENCE OF OPERATION AS SHOWN.
- D. ALL FIXTURES INDICATED WITH "EM" DESIGNATION SHALL HAVE EMERGENCY BATTERY BACKUP.
- E. ALL FIXTURES INDICATED WITH "NL" DESIGNATION SHALL BE NIGHT LIGHTING AND SHALL BE WIRED TO THE UNSWITCHED HOT-LEG OF THE LOCAL CIRCUIT.

<u>KEY NOTES</u>

- 1 EXISTING LIGHT FIXTURES AND CEILING MOUNTED DEVICES TO BE RE-INSTALLED BACK IN CEILING AS NECCESSARY TO ACCOMMODATE ANY CEILING REMOVAL/REPLACEMENTS. CONNECT ALL FIXTURES AND DEVICES TO EXISTING TAGGED WIRING.
- (2) CONNECT NEW LIGHT FIXTURES TO EXISTING TAGGED HOMERUN TO PANELBOARD. REWORK/EXTEND WIRING AS NECESSARY TO ACCOMMODATE FIXTURES.
- 3 NEW FIXTURES WITHIN ROOM TO BE WIRED TOGETHER USING (2) #12, (1) #12 GND.
- 4 PROVIDE LOW VOLTAGE 4-BUTTON DIMMING SWITCH WITH ON/OFF AND RAISE/LOWER BUTTONS, UNLESS OTHERWISE NOTED.
- 5 CONNECT NEW LIGHT FIXTURES AND BACKLIT SIGNAGE IN CANOPY TO INTERIOR CORRIDOR LIGHTING CIRCUIT. WIRE FIXTURES WITH (2) #12, (1) # 12GND IN 3/4" CONDUIT.
- 6 PROVIDE PHOTOCELL AT 12' A.F.G. ON CANOPY AT LOCATION INDICATED FOR CONTROL OF CANOPY LIGHTING AND BACKLIT SIGNAGE.
- (7) INDICATES CONNECTION TO BACKLIT SIGNAGE. CONNECT BACKLIT SIGNAGE TO INTERIOR LIGHTING CIRCUIT, AND TO PHOTOCELL FOR CONTROL OF SIGNAGE.



PROJECT INFORMATION

Project Number 14457.20

Client Name SOUTH ORANGETOWN CENTRAL SCHOOL DISTRICT Project Name PHASE 1: 2022 BOND

District Office Address 160 VAN WYCK RD. BLAUVELT, NY 10913

south orangetown csd

 WILLIAM O. SCHAEFER SED#:50-03-01-06-0-012-019

 COTTAGE LANE ELEMENTARY SED#:50-03-01-06-0-010-022

 TAPPAN ZEE HIGH SCHOOL SED#:50-03-01-06-0-006-032

 WILLIAM O. SCHAEFER S&L SED#: 50-03-01-06-0-012-020

 COTTAGE LANE S&L SED#: 50-03-01-06-0-012-020

 COTTAGE LANE S&L SED#: 50-03-01-06-0-012-020

 COTTAGE LANE S&L SED#: 50-03-01-06-0-012-023

 COTTAGE LANE LIBRARY S&L SED#: 50-03-01-06-8-023-002

 WOS OUTDOOR CLASSROOM SED#: 50-03-01-06-7-053-001

 SOMS OUTDOOR CLASSROOM SED#: 50-03-01-06-7-054-001


 CLE OUTDOOR CLASSROOM SED#: 50-03-01-06-7-054-001

 TISS OUTDOOR CLASSROOM SED#: 50-03-01-06-7-055-001

 vv
 Date
 Description

 1
 11/09/2023
 BID ADDENDUM #3

PROFESSIONAL STAMPS

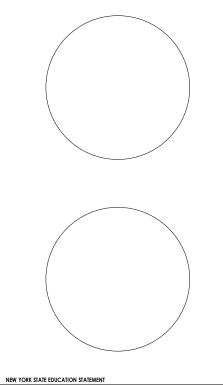



NEW YORK STATE EDUCATION STATEMENT IT IS A VIOLATION OF THE NEW YORK STATE EDUCATION LAW AND THE COMMISSIONER'S REGULATIONS FOR ANY PERSON, UNLESS ACTING UNDER THE DIRECTION OF A LICENSED ARCHITECT, ENGINEER OR LAND SURVEYOR, TO ALTER AN ITEM IN ANY WAY, IF AN ITEM BEARING THE STAL OF AN ARCHITECT, ENGINEER OR SURVEYOR IS ALTERED, THE ALTERING PARTY SHALL AFFLY TO THE ITEM THEIR SEAL AND THE NOTATION "ALTERED BY" FOLLOWED BY THEIR SIGNATURE AND THE DATE OF SUCH ALTERATION, AND A SPECIFIC DESCRIPTION OF THE ALTERATION.

SHEET INFORMATION

Issued	Scale
10/18/23	AS NOTED
Project Status	
BID DOCUMENTS	
Drawn By	Checked By
MAY	JBT
Drawing Title	
FIRST FLOOR L	IGHTING PLAN
AREA B	

Drawing Number CLE E301

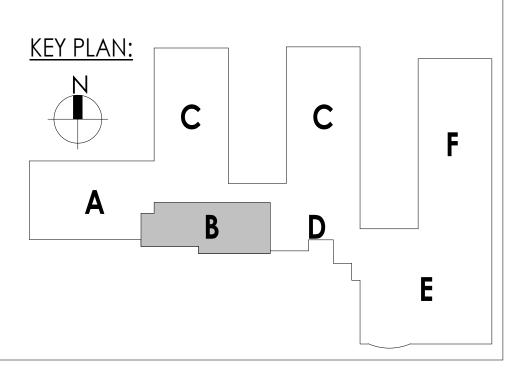

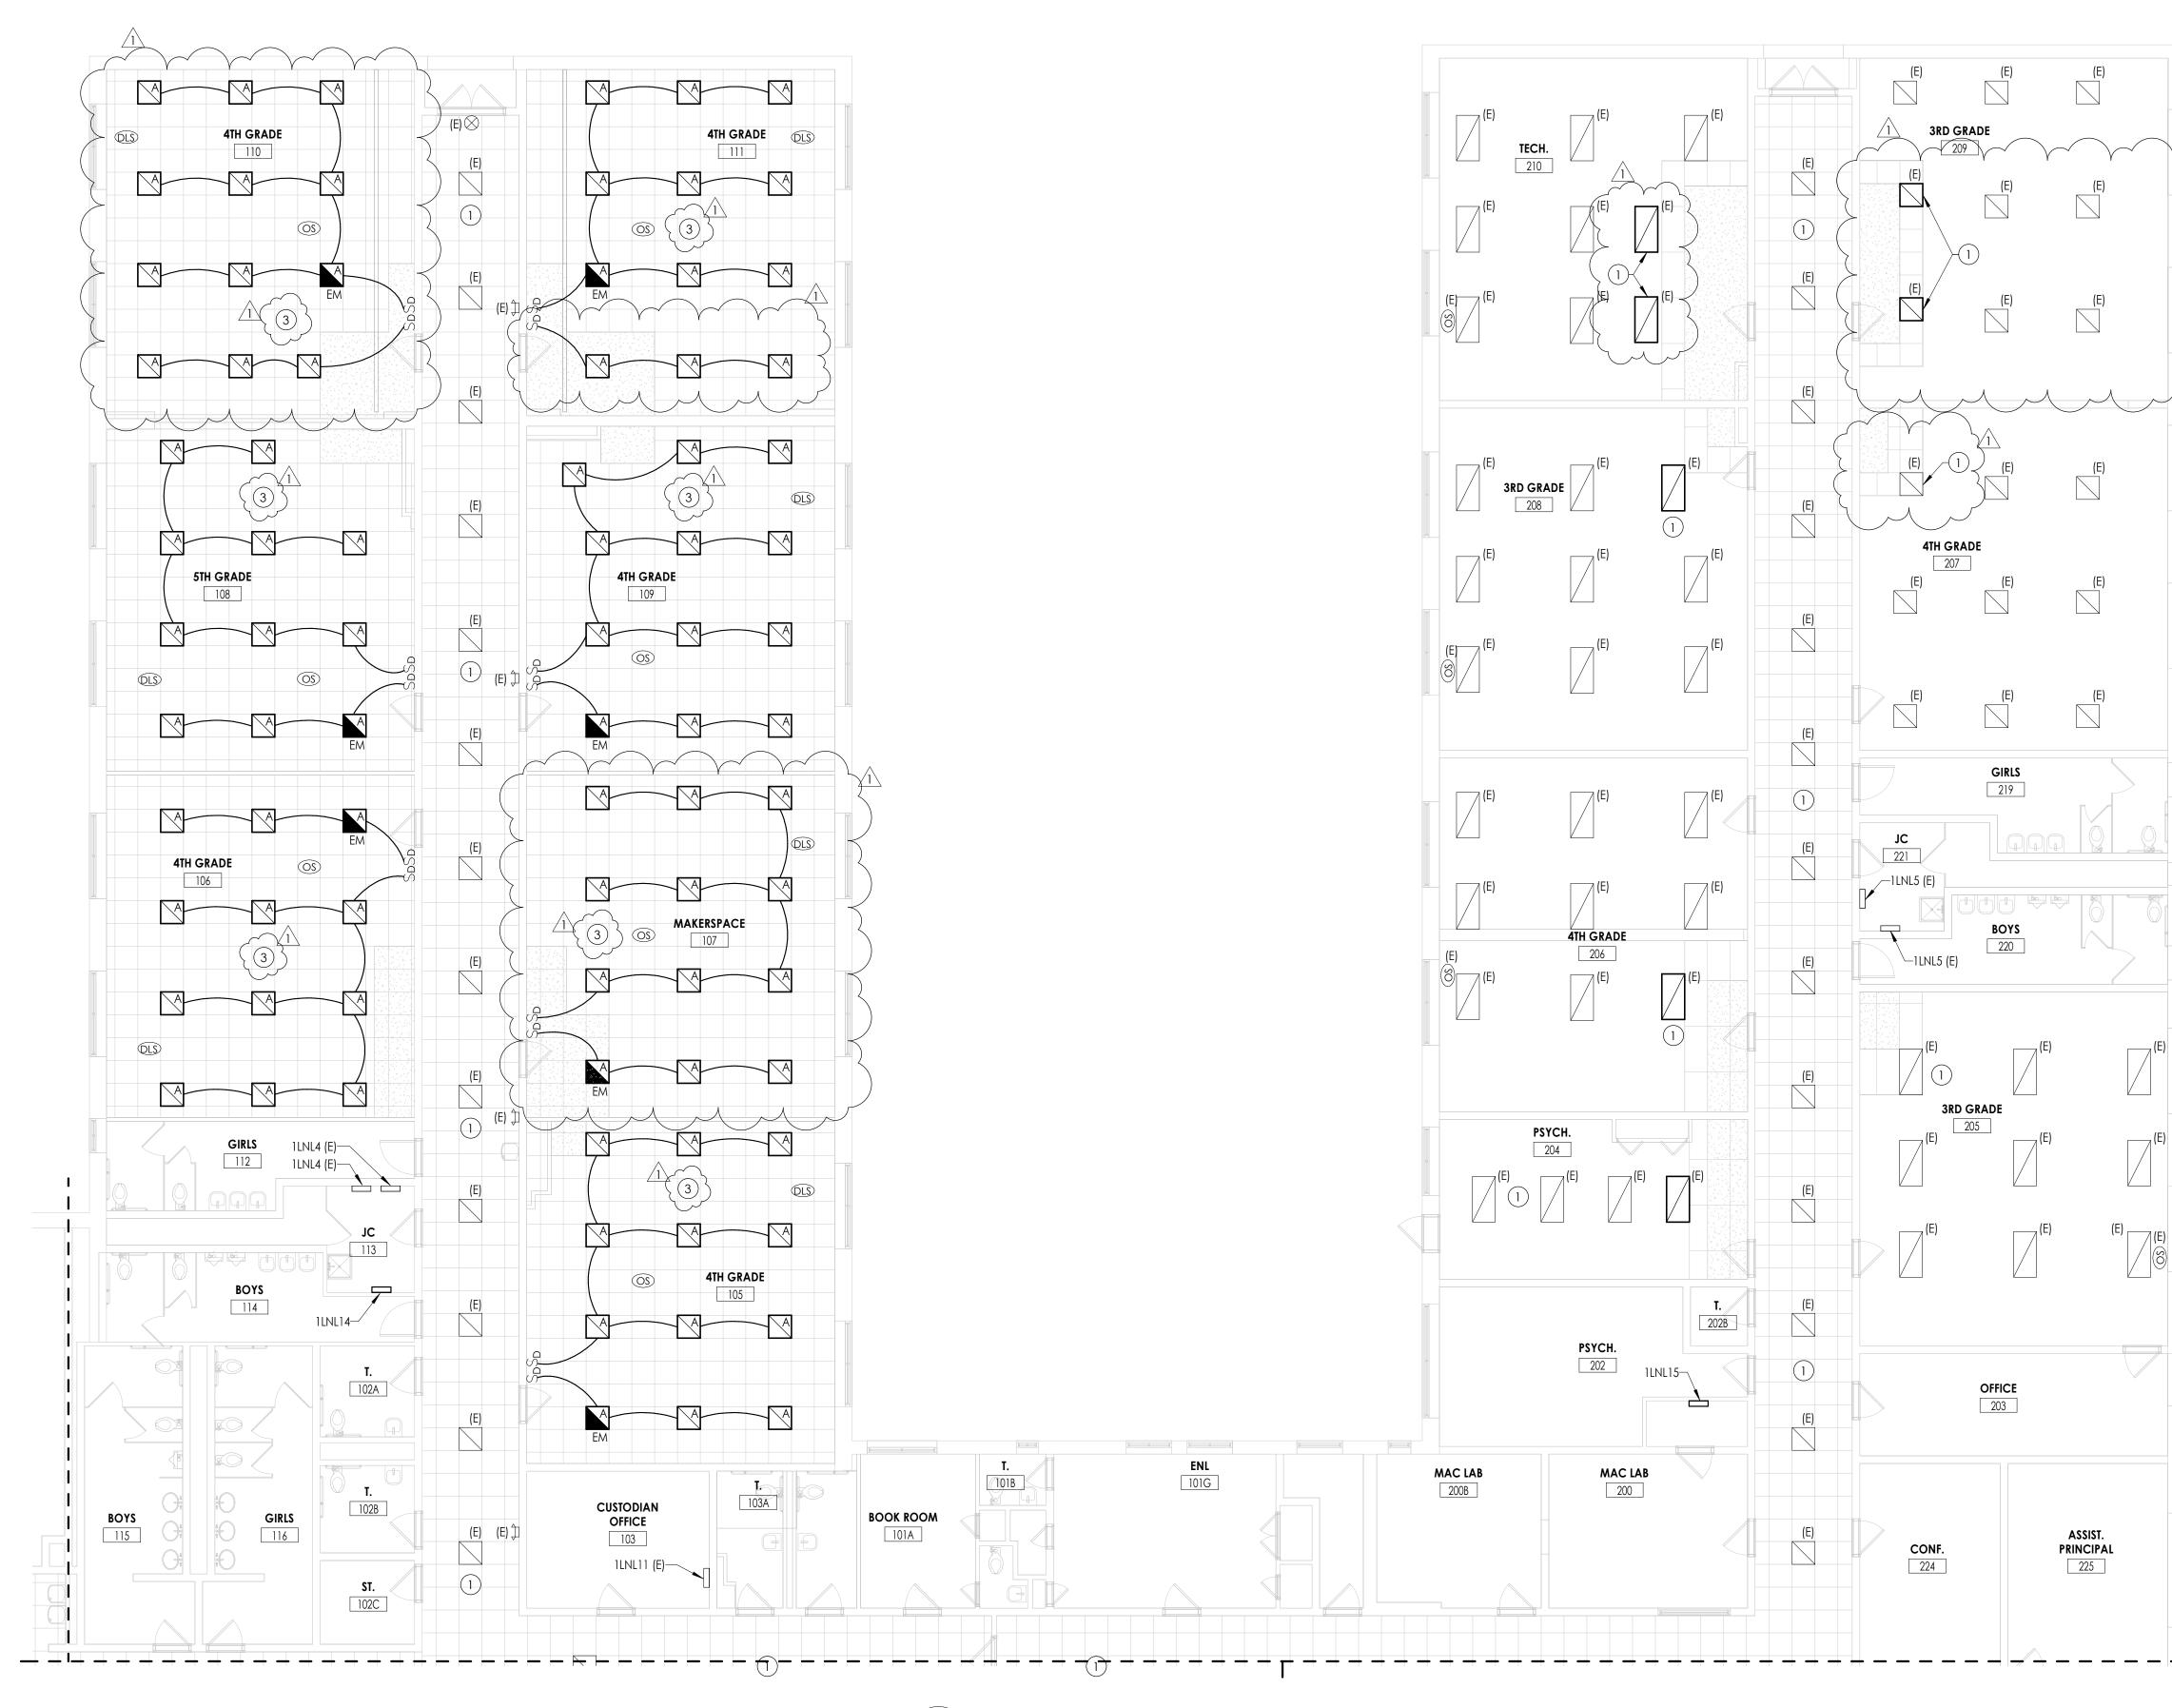

FIRST FLOOR LIGHTING PLAN - AREA C


E302

GENERAL NOTES

- A. FIXTURE TYPE MARK IS INDICATED ADJACENT TO NEW LIGHT FIXTURES. REFER TO LUMINAIRE SCHEDULE ON DRAWING WOS-E900 FOR FIXTURE DESCRIPTIONS AND NOTES.
- B. INSTALL LOW-VOLTAGE SENSORS AS SHOWN. PROVIDE ALL LOW-VOLTAGE WIRING BETWEEN SENSORS, SWITCHES, CONTROLLERS, AND LUMINAIRES.
- C. PROVIDE ANY ADDITIONAL POWER SUPPLIES OR OTHER MISCELLANEOUS COMPONENTS REQUIRED FOR A COMPLETE OPERATIONAL LIGHTING SYSTEM TO MEET INTENT OF LIGHTING SEQUENCE OF OPERATION AS SHOWN.
- D. ALL FIXTURES INDICATED WITH "EM" DESIGNATION SHALL HAVE EMERGENCY BATTERY BACKUP.
- E. ALL FIXTURES INDICATED WITH "NL" DESIGNATION SHALL BE NIGHT LIGHTING AND SHALL BE WIRED TO THE UNSWITCHED HOT-LEG OF THE LOCAL CIRCUIT.


KEY NOTES

- 1 EXISTING LIGHT FIXTURES AND CEILING MOUNTED DEVICES TO BE RE-INSTALLED BACK IN CEILING AS NECCESSARY TO ACCOMMODATE ANY CEILING REMOVAL/REPLACEMENTS. CONNECT ALL FIXTURES AND DEVICES TO EXISTING TAGGED WIRING.
- 2 PROVIDE LOW VOLTAGE 4-BUTTON DIMMING SWITCH WITH ON/OFF AND
- -RAISE/LOWER-BUTTONS_UNLESS OTHERWISE NOTED. 3 CONNECT NEW LIGHT FIXTURES TO EXISTING CIRCUIT WITHIN SPACE. PROVIDE ALL NEW LOW VOLTAGE WIRING FOR SWITCHING PATTERNS, AS SHOWN.

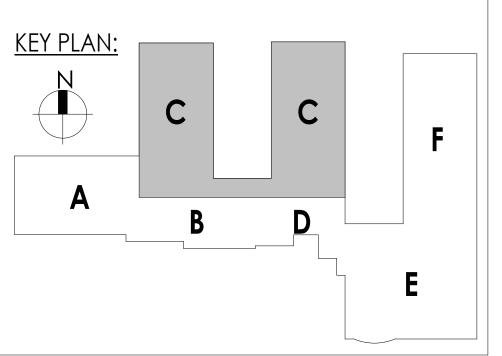

С	CPL Architecture Engineering Planning 50 Front Street Suite 202, Newburgh, NY 12550 CPLteam.com
	Exsential Infrastructure for Student Health, Safety and Success
Pro 14 Clie S(S(Proj	OJECT INFORMATION ject Number 457.20 ent Name OUTH ORANGETOWN CENTRAL CHOOL DISTRICT ject Name HASE 1: 2022 BOND
16	trict Office Address 0 VAN WYCK RD. AUVELT, NY 10913
	JTH ORANGETOWN CSD WILLIAM O. SCHAEFER SED#:50-03-01-06-0-012-019 COTTAGE LANE ELEMENTARY SED#:50-03-01-06-0-010-022 TAPPAN ZEE HIGH SCHOOL SED#:50-03-01-06-0-012-020 COTTAGE LANE SL SCH: 50-03-01-06-0-012-020 COTTAGE LANE SL SED#: 50-03-01-06-0-012-020 COTTAGE LANE SAL SED#: 50-03-01-06-0-023 COTTAGE LANE SL SED#: 50-03-01-06-0-023 COTTAGE LANE LIBRARY S&L SED#: 50-03-01-06-8-023-002 WOS OUTDOOR CLASSROOM SED#: 50-03-01-06-7-053-001 SOMS OUTDOOR CLASSROOM SED#: 50-03-01-06-7-054-001 CLE OUTDOOR CLASSROOM SED#: 50-03-01-06-7-054-001 TZHS OUTDOOR CLASSROOM SED#: 50-03-01-06-7-055-001
VV	
1	11/09/2023 BID ADDENDUM #3

PROFESSIONAL STAMPS

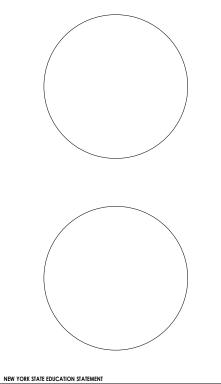


RING THE SEAL OF AN ARCHITECT, ENGINEER OR SURVEYOR IS ALTERED.

SHEET INFORMATION

Issued	Scale
10/18/23	AS NOTED
Project Status	
BID DOCUMENTS	
Drawn By	Checked By
MAY	JBT
Drawing Title	
FIRST FLOOR LIGHTING PLAN	
AREA C	



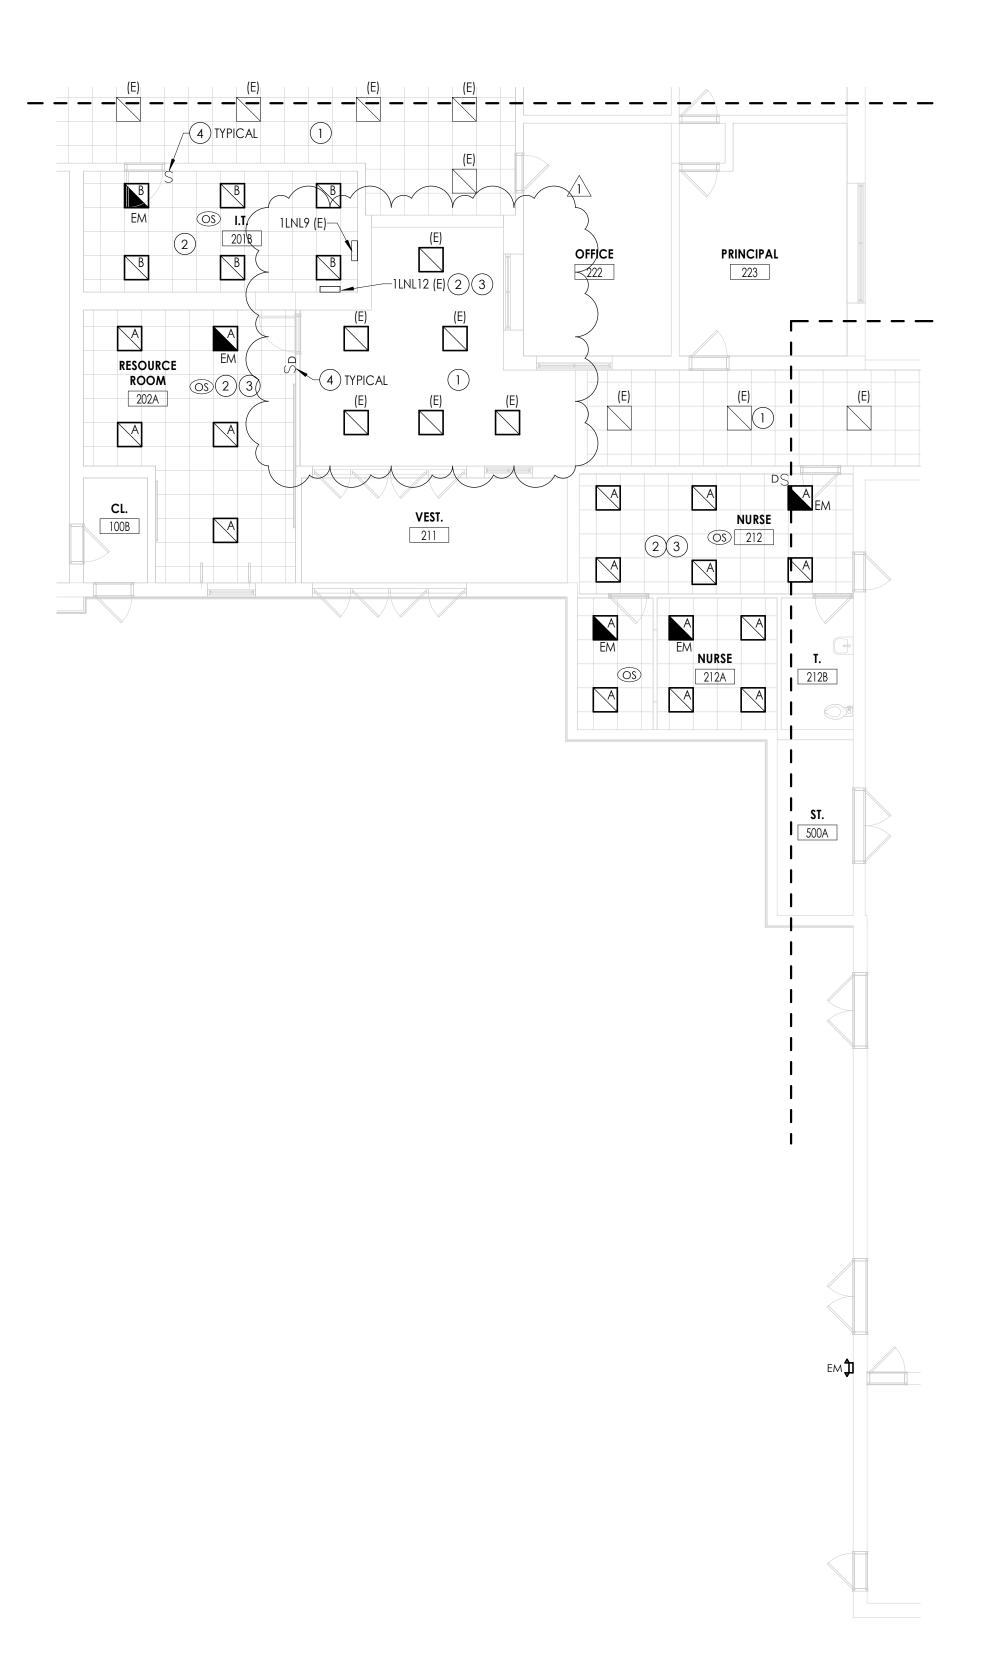



FIRST FLOOR LIGHTING PLAN - AREA D

<u>GENERAL NOTES</u>

- A. FIXTURE TYPE MARK IS INDICATED ADJACENT TO NEW LIGHT FIXTURES. REFER TO LUMINAIRE SCHEDULE ON DRAWING WOS-E900 FOR FIXTURE DESCRIPTIONS AND NOTES.
- B. INSTALL LOW-VOLTAGE SENSORS AS SHOWN. PROVIDE ALL LOW-VOLTAGE WIRING BETWEEN SENSORS, SWITCHES, CONTROLLERS, AND LUMINAIRES.
- C. PROVIDE ANY ADDITIONAL POWER SUPPLIES OR OTHER MISCELLANEOUS COMPONENTS REQUIRED FOR A COMPLETE OPERATIONAL LIGHTING SYSTEM TO MEET INTENT OF LIGHTING SEQUENCE OF OPERATION AS SHOWN.
- D. ALL FIXTURES INDICATED WITH "EM" DESIGNATION SHALL HAVE EMERGENCY BATTERY BACKUP.
- E. ALL FIXTURES INDICATED WITH "NL" DESIGNATION SHALL BE NIGHT LIGHTING AND SHALL BE WIRED TO THE UNSWITCHED HOT-LEG OF THE LOCAL CIRCUIT.

<u>KEY NOTES</u>

- 1 EXISTING LIGHT FIXTURES AND CEILING MOUNTED DEVICES TO BE RE-INSTALLED BACK IN CEILING AS NECCESSARY TO ACCOMMODATE ANY CEILING REMOVAL/REPLACEMENTS. CONNECT ALL FIXTURES AND DEVICES TO EXISTING TAGGED WIRING.
- 2 CONNECT NEW LIGHT FIXTURES TO EXISTING TAGGED CIRCUIT HOMERUN TO PANELBOARD. REWORK/EXTEND WIRING AS NECESSARY TO ACCOMMODATE FIXTURES.
- (3) NEW FIXTURES WITHIN ROOM TO BE WIRED TOGETHER USING (2) #12, (1) #12 GND.
- 4 PROVIDE LOW VOLTAGE 4-BUTTON DIMMING SWITCH WITH ON/OFF AND RAISE/LOWER BUTTONS, UNLESS OTHERWISE NOTED.



PROJECT INFORMATION

Project Number 14457.20

Client Name SOUTH ORANGETOWN CENTRAL SCHOOL DISTRICT Project Name PHASE 1: 2022 BOND

ssential Infrastructure for Stude Health, Safety and Success

District Office Address 160 VAN WYCK RD. BLAUVELT, NY 10913

South orangetown CSD

 WILLIAM O. SCHAEFER SED#:50-03-01-06-0-012-019

 COTTAGE LANE ELEMENTARY SED#:50-03-01-06-0-010-022

 TAPPAN ZEE HIGH SCHOOL SED#:50-03-01-06-0-012-020

 WILLIAM O. SCHAEFER S&L SED#: 50-03-01-06-0-012-020

 COTTAGE LANE S&L SED#: 50-03-01-06-0-012-020

 COTTAGE LANE S&L SED#: 50-03-01-06-0-012-020

 COTTAGE LANE S&L SED#: 50-03-01-06-0-012-023

 COTTAGE LANE LIBRARY S&L SED#: 50-03-01-06-7-012-023

 WOS OUTDOOR CLASSROOM SED#: 50-03-01-06-7-053-001

 SOMS OUTDOOR CLASSROOM SED#: 50-03-01-06-7-056-001


 CLE OUTDOOR CLASSROOM SED#: 50-03-01-06-7-054-001

 TZHS OUTDOOR CLASSROOM SED#: 50-03-01-06-7-055-001

 vv
 Date
 Description

 1
 11/09/2023
 BID ADDENDUM #3

PROFESSIONAL STAMPS

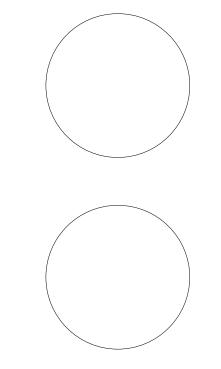


ARCHITECT, ENGINEER OR LAND SURVEYOR. TO ALTER AN ITEM IN ANY WAY. IF AN ITEM BEARING THE SEAL OF AN ARCHITECT, ENGINEER OR SURVEYOR IS ALTERED, THE ALTERN PARTY SHALL ARRYL TO THE ITEM THER SEAL AND THE NOTATION "ALTERED BY "FOLLOWED THEIR SIGNATURE AND THE DATE OF SUCH ALTERATION, AND A SPECIFIC DESCRIPTION C ALTERATION.

SHEET INFORMATION


NEW YORK STATE EDUCATION STATEMENT IT IS A VIOLATION OF THE NEW YORK STATE EDUCATION LAW AND TH REGULATIONS FOR ANY PERSON, UNLESS ACTING UNDER THE DIRECTI


Issued	Scale
10/18/23	AS NOTED
Project Status	
BID DOCUMENTS	
Drawn By	Checked By
MAY	JBT
Drawing Title	
FIRST FLOOR LIGHTING PLAN	
AREA D	



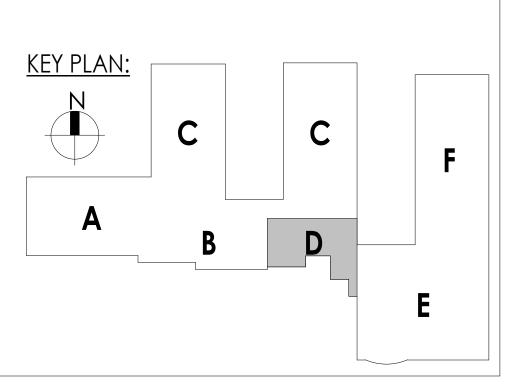

11/8/2023 11:44:04 AM cproject location> REVIT PROJECT FILES ON BIM3

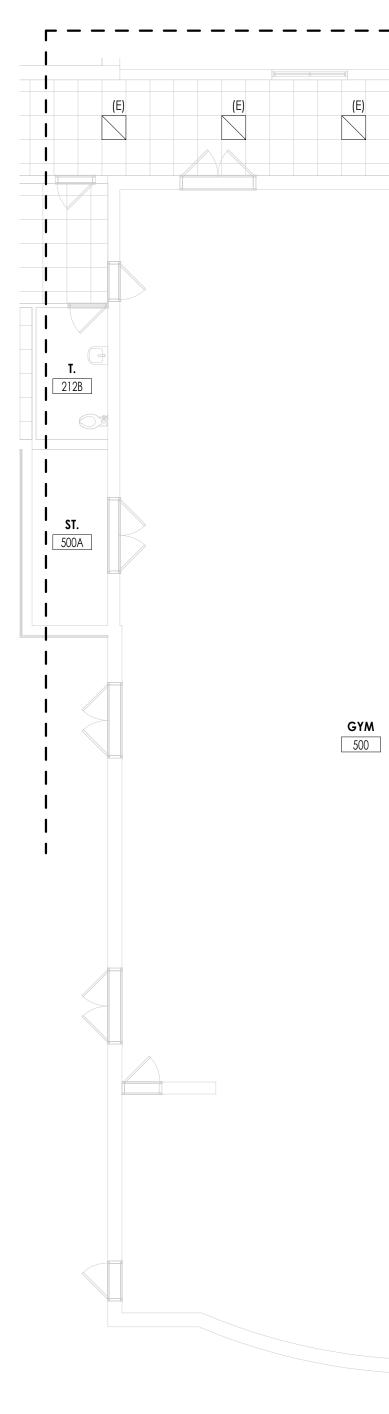

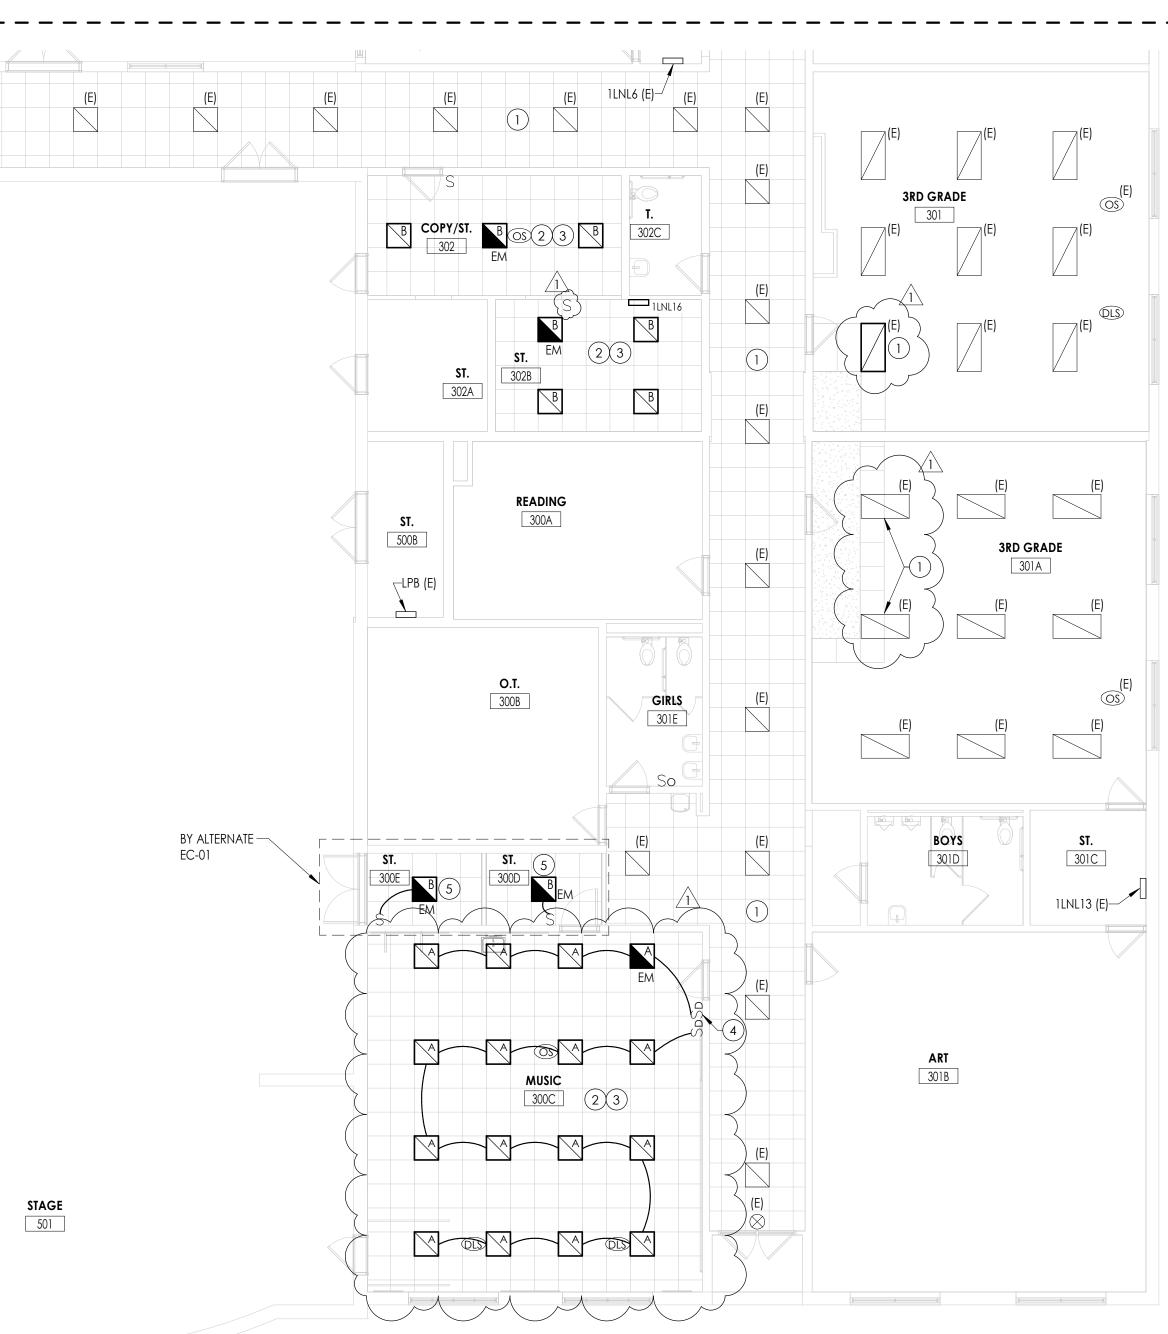




FIRST FLOOR LIGHTING PLAN - AREA E

GENERAL NOTES

- A. FIXTURE TYPE MARK IS INDICATED ADJACENT TO NEW LIGHT FIXTURES. REFER TO LUMINAIRE SCHEDULE ON DRAWING WOS-E900 FOR FIXTURE DESCRIPTIONS AND NOTES.
- B. INSTALL LOW-VOLTAGE SENSORS AS SHOWN. PROVIDE ALL LOW-VOLTAGE WIRING BETWEEN SENSORS, SWITCHES, CONTROLLERS, AND LUMINAIRES.
- C. PROVIDE ANY ADDITIONAL POWER SUPPLIES OR OTHER MISCELLANEOUS COMPONENTS REQUIRED FOR A COMPLETE OPERATIONAL LIGHTING SYSTEM TO MEET INTENT OF LIGHTING SEQUENCE OF OPERATION AS SHOWN.
- D. ALL FIXTURES INDICATED WITH "EM" DESIGNATION SHALL HAVE EMERGENCY BATTERY BACKUP.
- E. ALL FIXTURES INDICATED WITH "NL" DESIGNATION SHALL BE NIGHT LIGHTING AND SHALL BE WIRED TO THE UNSWITCHED HOT-LEG OF THE LOCAL CIRCUIT.

KEY NOTES

- 1 EXISTING LIGHT FIXTURES AND CEILING MOUNTED DEVICES TO BE RE-INSTALLED BACK IN CEILING AS NECCESSARY TO ACCOMMODATE ANY CEILING REMOVAL/REPLACEMENTS. CONNECT ALL FIXTURES AND DEVICES TO EXISTING TAGGED WIRING.
- 2 CONNECT NEW LIGHT FIXTURES TO EXISTING TAGGED CIRCUIT HOMERUN TO PANELBOARD. REWORK/EXTEND WIRING AS NECESSARY TO ACCOMMODATE FIXTURES.
- 3 NEW FIXTURES WITHIN ROOM TO BE WIRED TOGETHER USING (2) #12, (1) #12 GND.
- 4 PROVIDE LOW VOLTAGE 4-BUTTON DIMMING SWITCH WITH ON/OFF AND RAISE/LOWER BUTTONS, UNLESS OTHERWISE NOTED.
- 5 CONNECT NEW LIGHT FIXTURES TO EXISTING TAGGED CIRCUITRY. PROVIDE NEW LOW VOLTAGE WIRING FROM NEW SWITCHING TO NEW LIGHT FIXTURES.

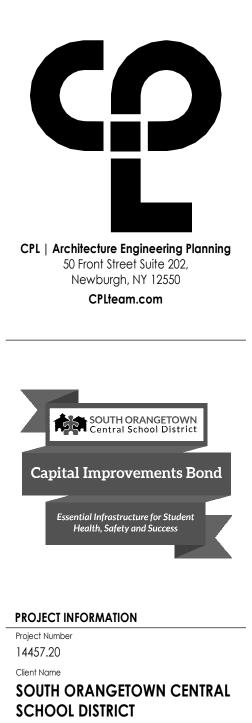

PHASE 1: 2022 BOND

160 VAN WYCK RD. BLAUVELT, NY 10913

Project Name

South orangetown CSD

 WILLIAM O. SCHAEFER SED#:50-03-01-06-0-012-019

 COTTAGE LANE ELEMENTARY SED#:50-03-01-06-0-010-022

 TAPPAN ZEE HIGH SCHOOL SED#:50-03-01-06-0-010-022

 WILLIAM O. SCHAEFER S&L SED#: 50-03-01-06-0-012-020

 COTTAGE LANE LIBRARY S&L SED#: 50-03-01-06-0-012-023

 COTTAGE LANE LIBRARY S&L SED#: 50-03-01-06-7-053-001


 SOMS OUTDOOR CLASSROOM SED#: 50-03-01-06-7-056-001

 CLE OUTDOOR CLASSROOM SED#: 50-03-01-06-7-054-001

 TZHS OUTDOOR CLASSROOM SED#: 50-03-01-06-7-055-001

vv Date Description 1 11/09/2023 BID ADDENDUM #3

PROFESSIONAL STAMPS

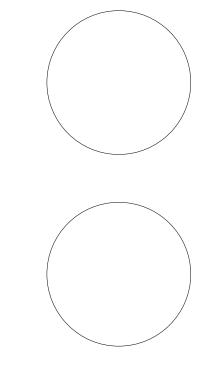

ARCHITECT, ENGINEER OR LAND SURVEYOR, TO ALTER AN ITEM IN ANY WAY, IF AN ITEM BERRING THE SEAL OF AN ARCHITECT, ENGINEER OF SURVEYOR IS ALTERED, THE ALTERIN PARTY SHALL AFFIX TO THE ITEM THEIR SEAL AND THE NOTATION "ALTERED BY" FOLLOWED THEIR SIGNATURE AND THE DATE OF SUCH ALTERATION, AND A SPECIFIC DESCRIPTION OI ALTERATION.

SHEET INFORMATION

NEW YORK STATE EDUCATION STATEM

Issued	Scale
10/18/23	AS NOTED
Project Status	
BID DOCUMENTS	
Drawn By	Checked By
MAY	JBT
Drawing Title	
FIRST FLOOR LIGHTING PLAN	
AREA E	



