


James Stewart Polshek

and Partners
Architect
320 West 13th St.,
New York, N.Y. 10014

Leroy Callender/P.C.
Structural Engineer
Syska & Hennessy
Mechanical Engineer
Joseph A. Sedlak
Mechanization Engineer
Quennell Rothschild Associates
Landscape Architect

Notes

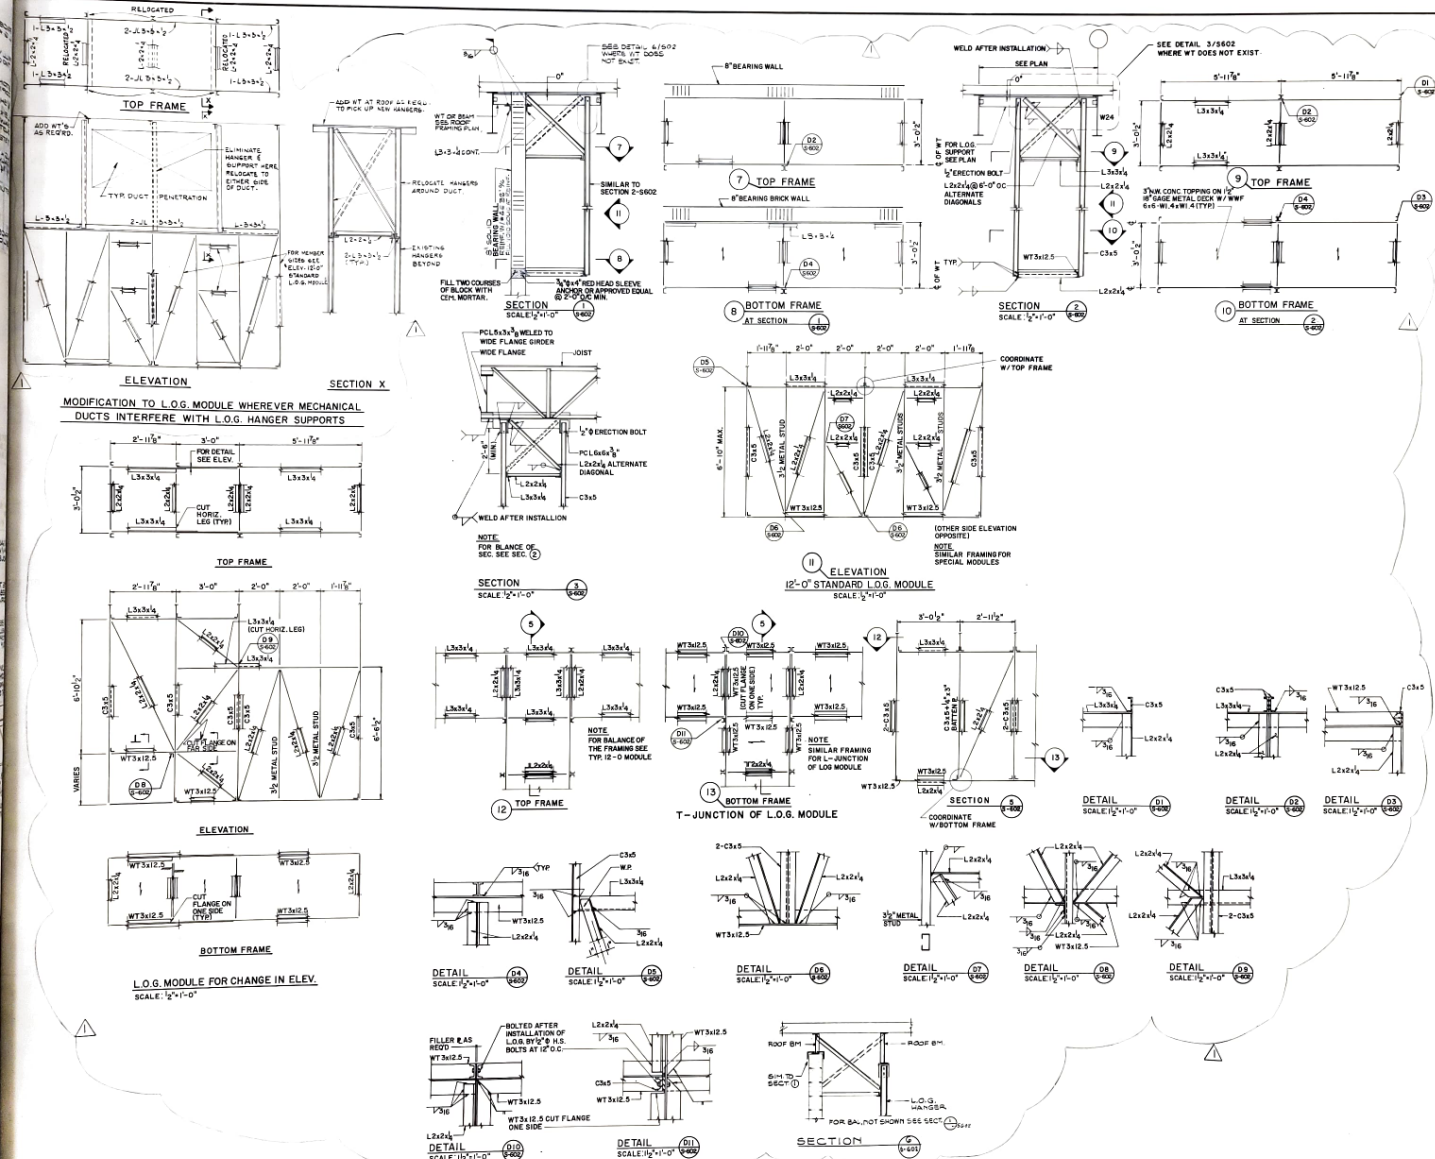

AS BUILT	2-17-88
MECH. WORK	2-17-88
No. Description	Check Date
Revisions	
Date 4-1-88	Drawn MR
Arch Job # 8834	Check HN
Graphic Scale	

Drawing Title

STEEL DETAILS
& SECTIONS II

Drawing No.	
-------------	--

S-602