



ADDENDUM NO. 2

FOR THE

CAESARS LANE

WASTEWATER TREATMENT PLANT EXPANSION

PHASE 2 PROJECT

TOWN OF NEW WINDSOR

ORANGE COUNTY, NEW YORK

PREPARED FOR:

Town of New Windsor
555 Union Avenue
New Windsor, NY 12553

PREPARED BY:

MHE Engineering, D.P.C.
111 Wheatfield Drive, Suite 1
Milford, PA 18337

NOTE: ANY UNAUTHORIZED ALTERATION OR
ADDITION TO THIS DOCUMENT IS A
VIOLATION OF SECTION 7209(2) OF THE
NEW YORK STATE EDUCATION LAW.

DATE: June 20, 2025
JOB #: 18-732

THIS ADDENDUM CONSISTS OF (7) PAGES & (13) ATTACHMENTS

NEW YORK OFFICE

33 Airport Center Drive, Suite 202, New Windsor, NY 12553
845-567-3100 | F: 845-567-3232 | mheny@mhepc.com

PENNSYLVANIA OFFICE

111 Wheatfield Drive, Suite 1, Milford, PA 18337
570-296-2765 | F: 570-296-2767 | mhepa@mhepc.com

Prospective bidders are advised of the following revisions, additions, deletions and/or clarifications to the contract documents:

Bid Opening Date:

THE BID OPENING DATE WILL BE CHANGED FROM JULY 10, 2024 AT 10:00AM TO JULY 24, 2024 AT 10:00 AM. FUTURE BID EXTENSIONS WILL BE CONTINUOUSLY ASSESSED. AS A REMINDER, THE CONTRACT TIME OF SUBSTANTIAL COMPLETION DATE IS A NYSDEC SPDES PERMIT REQUIREMENT AND WILL NOT BE CHANGED. FURTHER EXTENSION OF BID OPENING DATE BEYOND 7/24 MAY REDUCE TIME AVAILABLE FOR CONSTRUCTION COMPLETION.

Clarifications/Additional Information

1. RFI's received but not included in this addendum will continue to be reviewed and addressed in future addendums. We anticipate Addendum #3 to be released on 27 June 2025.
2. The basis of design for the proposed Autothermal Thermophilic Aerobic Digestion (ATAD) System is the Thermaer, SNDR, and Biofilter products by Thermal Process Systems, Inc. (TPS). As a optional benefit to bidders, redline drawings may be requested from TPS which clearly highlight TPS's scope of supply on the Project Plans. To be clear, TPS is considered an acceptable "Thermaer Supplier" as defined in Specification 467321, however it should be understood that TPS products are not sole sourced for the ATAD System. Alternate products may be submitted after award for review as an "acceptable equal" in accordance with the contract.

RFI's:

1. **Question:** Does the project have AIS (American Iron and Steel) Requirements?
Response: This project does not have AIS Requirements.
2. **Question:** Agreement between Owner and Contractor article 6.02 – in regard to retainage will the owner release partial retainage on portions of work in which it takes beneficial use of during the course of the project?
Response: Yes, portions of completed work will be eligible for partial retainage release. This will be subject to Engineer approval. Eligible work could include equipment, buildings, or systems that are fully installed and operational for use by the plant operator. For example, this may include a fully functional building that has obtained a Certificate of Occupancy.
3. **Question:** Please confirm that the only Build America, Buy America (BABA) requirement is for the Fine Screening Equipment listed under specification 46 21 00.

Response: Please disregard this reference to BABA in Specification 462100. BABA requirements do not apply to this project.

4. **Question:** Plan sheet C-554 Cross Section 3 calls out Flowmeter Typical of 4 (20-FV-622-x) this tag number is a butterfly valve on the Process Valve List. Please clarify.

Response: Correct tag ID number for the flow meter is 20-FIT-507 typical of 4. Plan sheet C-554 has been updated to reflect.

5. **Question:** Plan sheet C-602, can the Owner/Engineer verify piping schematic for the ATAD Cooling Water and the ATAD Return Water?

Response: Cooling Water Pump discharge piping arrangement revised on Plan Sheet C-602 for clarification.

6. **Question:** In the project specification Belt Dewatering Press 467621-7-E, “Unless otherwise specified herein, all metal parts in contact with or subject to splashing polyelectrolyte or sludge shall be type 304L stainless steel. All fasteners, pins, and anchor bolts shall be type 304L stainless steel.” Can the Owner/Engineer delineate the areas subject to splashing? Secondly, are any other areas required to have stainless bolts, for example exterior or submerged?

Response: fasteners, pins, anchor bolts etc. that are associated with the Belt Dewatering Press shall be 304L SS. All fasteners, pins, anchor bolts etc. that are submerged or subject to contact with liquid shall be 304L SS unless otherwise specified on the plans or specifications in accordance with manufacturers requirements.

7. **Question:** Specification 402323-2.3C, this seems to be a Ductile Iron specification and not a PV. Can the Owner/Engineer please clarify.

Response: Please disregard Specification 402323. It will be removed for clarification. Please refer to Specification 221005 for information on plumbing piping.

8. **Question:** Can the Owner/Engineer clarify if the 1” CPVC Citric Acid Feed is to be dual contained labeling differs from plan sheets C-551 to C-542.

Response: All chemical piping shall be dual contained per Chemical Piping specification 402400. All CPVC chemical piping has been removed and replaced with PVC.

9. **Question:** Can the Owner/Engineer verify on plan sheet C-550 the call out for 1” SS Air Supply.

Response: The call out for 1”SS Air Supply lines was relocated to Plan Sheet C-550 / B.

10. **Question:** Can the Owner/Engineer verify the Sodium Hypochlorite feed sizing. Plan sheet C-553 calls out 1 ½” and plan sheet C-554 detail 4 calls out 1”.

Response: Pipe diameter for Sodium Hypochlorite shall be 1” according to Veolia P&ID DS-111. Plan sheets C-551 and C-553 have been revised.

11. **Question:** Once Primary #4 and MBR are operational, can Primary's 1,2,3 be taken offline for a brief window to allow for work to be completed inside the Primary Sludge Pit, explicitly the valve and wye replacements?

Response: This can be further discussed and coordinated with the operator during construction, however, it is unlikely that Primary Tanks 1-3 can be taken offline at the same time for an extended period of time. Factors such as time of year, anticipated weather events, and plant staffing will dictate how many Primary Tanks need to remain in operation. For bid purposes, it should be assumed that Primary Tanks 1-3 need to be taken offline sequentially.

12. **Question:** Due to unknown quantity and occurrence of finding Asbestos Containing pipe when installing new buried process piping, would the Owner/Engineer entertain making an allowance for such instances?

Response: Contingency Item C-13 is included in the contract to obtain a Linear Foot unit price for work to remove asbestos containing pipe, if encountered. The quantity provided (500 LF) is an estimate for bidding purposes, however the unit price provided will be utilized for the actual length of asbestos containing pipe removed.

13. **Question:** Drawing E-042 calls out lighting schedule showing 3 types, A, I, EX, but these callouts do not appear next to some of the exit signs. Please advise as to what type of exit sign these shall be.

Response: Exit signs will be reviewed and correctly labeled on revised Plan Sheets in a future addendum.

14. **Question:** Plan Sheet CD-801 regarding the secondary settling tanks shows the existing concrete walls remaining and states "After Demolition is complete, backfill with accepted structural backfill material installed in compacted lifts in accordance with structural excavation, backfill and compaction specification." However, the new ATAD building and sludge holding tanks are located where one of the secondary tanks are located. Please advise.

Response: Note 1 under section 2/CD-801 indicates that the entire structure shall be removed to top of existing slab at approximately elevation 0.0'. The plan callouts and elevations on CD-801 have been revised for clarification.

15. **Question:** Trying to determine how much sludge is at the bottom of the settling tanks. Can you please provide the last date the settling tanks were cleaned.

Response: It is not anticipated that there will be sludge removal required. The Operator will handle the removal of sludge as part of their normal operation. Coordination between the Contractor and Operator will be required prior to taking the clarifiers offline. The Contractor is responsible to drain the clarifiers down and pump the effluent into the effluent discharge box or other location coordinated with the Operator. The Contractor will then clean the settling tanks and the remaining sludge will be directed into the hopper at the bottom of the tank which discharges to the sludge pump station. However, to account for unforeseen

conditions, a contingency item for liquid sludge removal was included in the bid form. This will be utilized in the event liquid sludge removal is required.

16. **Question:** Contract Documents and Technical Specifications, 6.3 Contractor's Insurance, G. 6., requires additional insured endorsements that include both ongoing operations and products and completed operations coverage through ISO Endorsements CG 20 10 10 01 and CG 20 37 10 01. Contractor uses the most current forms of these endorsements, CG 20 10 12 19 and CG 20 37 12 19. Please confirm the most recent ISO forms are acceptable.

Response: Yes, the updated ISO forms are acceptable provided the wording states completed and ongoing operations.

17. Piping Clarifications-

- a. **Question:** Please clarify the material origin requirement. Does AIS, BABA, or EFC apply, or is import acceptable?

Response: AIS and BABA requirements do not apply to the project. This project is receiving EFC funding, therefore EFC requirements apply as stated in the contract. In particular, see Exhibit A for more information.

- b. **Question:** Please verify the ductile iron buried fittings can be either C153 or C110.

Response: Buried ductile iron pipe shall include mechanical joint fittings meeting the requirements of ANSI/AWWA C110/A21.10 with the joint meeting the requirements of ANSI/AWWA C111/A21.11.

- c. **Question:** Please advise what gasket materials are for buried ductile iron.

Response: See Specification 331113.13 section 2.3.8. American Standard (A21.11). Acceptable manufacturers are Rainbow, Durable, Garlock. Gaskets shall comply with ANSI/AWWA C111/A21.11-23 Rubber Gasket Joints. Plain Rubber SBR is acceptable.

- d. **Question:** Please provide a specification for the buried ductile bolting. Is Corten acceptable?

Response: Mechanical joint T Bolts and nuts shall be BLU (Fluoropolymer coated) Corten steel and conform to AWWA C-111,11-7.5 and ANSI A21.11 for high strength low alloy steel.

- e. **Question:** Please provide a specification for the exposed ductile iron bolting material. Also for submerged flanged joints.

Response: Exposed flanged ductile iron nuts and bolting material shall conform with ANSI B18.2.1 and ANSI B18.2.2 respectively. Bolts and nuts of low-carbon steel conforming to ASTM A307 are specified in the Appendix of AWWA C110 and C115 for flanged pipe when rubber gaskets are used. Submerged flanged joints shall be 304L SS unless otherwise noted or specified on the plans in accordance with manufacturers recommendations.

- f. **Question:** Please provide a specification for exposed ductile iron flanged gaskets.
Response: Exposed ductile iron flanged gaskets shall conform with ANSI/AWWA C111/A21.11 Plain Rubber SBR.
- g. **Question:** Please clarify the OD requirements for HDPE Piping.
Response: More information on DR9 HDPE can be found in Specification 331050.
- h. **Question:** Please provide a specification for air piping flange gaskets. Is Viton or Neoprene acceptable?
Response: Air piping flange gaskets shall be of fluoroelastomer synthetic rubber by Fluorel, Viton, or acceptable equal.
18. **Question:** Please allow more time for the preparation of the bid by postponing the date 4 weeks.
Response: At this time, we are extending the bid opening date by 2 weeks, to 24 July 2025. We will continue to assess whether a further extension is warranted.
19. **Question:** Will current process plant sludge be utilized for MBR seed sludge?
Response: The existing plant sludge will not be utilized for MBR seed sludge. The source and quantity of required seed sludge will be identified in the next addendum.
20. **Question:** Specification section 462100 part 3.4.A states "The manufacture of equipment shall provide a warranty for 12 months commencing acceptance or beneficial use by Owner but no later than **90 days** from of shipment by the Manufacture". Please remove the 90 days from shipment as that is unrealistic time frame for warranty commencement with the amount of associated construction, construction sequence and coordination related to this project.
Response: Specification section 462100 section 3.4.A has been revised to remove reference to the shipment date by the manufacturer.
21. **Question:** Can the Owner/Engineer clarify which area is the Bypass Building referred to in specification 028300 in the table.
Response: This is referring to the Headworks Building.
22. **Question:** Can the Owner/Engineer identify the Camlock size for the numerous camlock connections points throughout the project.
Response: All Camlock connections are 4" male end as noted on the plans. Plan sheets C-502, C-510, C-520 and C-530 have been revised for clarification.
23. **Question:** Electrical: Notes 7 and 8 on drawing E-950 state that the access control and security cameras are by others and the contractor is only responsible for the conduit. Can you confirm if this is typical for the entire site and not just the garage on E-950?

Response: These notes were incorrect and removed as part of the re-issued Electrical Plan Set in Addendum #1.

24. **Question:** One of our door suppliers noted that elevations appear to show Steel Sectional Doors and the specifications call for aluminum. According to our supplier, the R value required by the specification would negate an aluminum door being used. Please advise on steel or aluminum, and if the R value is correct.

Response: The sectional door will be a sectional insulated steel door. See the revised Specification #083613 - R2 attached to this addendum.

Attachments:

Revised Plan sheets C-502, C-510, C-520, C-530, C-550, C-551, C-553, C-554, C-602, CD-801,
Revised Specification Section 462100
Revised Specification Section 083613
Revised Table of Contents for Specifications

**ALL BIDDERS MUST SUBMIT ACKNOWLEDGEMENT OF RECEIPT OF ALL
ADDENDUMS WITH BID**


ACKNOWLEDGEMENT OF RECEIPT OF ALL ADDENDUMS LISTED BELOW:

ADDENDUM No. 2: June 20, 2025 _____


SUBMIT THIS SHEET WITH YOUR BID

MHE Engineering, P.C.
111 Wheatfield Drive, Suite 1
Milford, PA 18337

(End of Addendum No. 2)

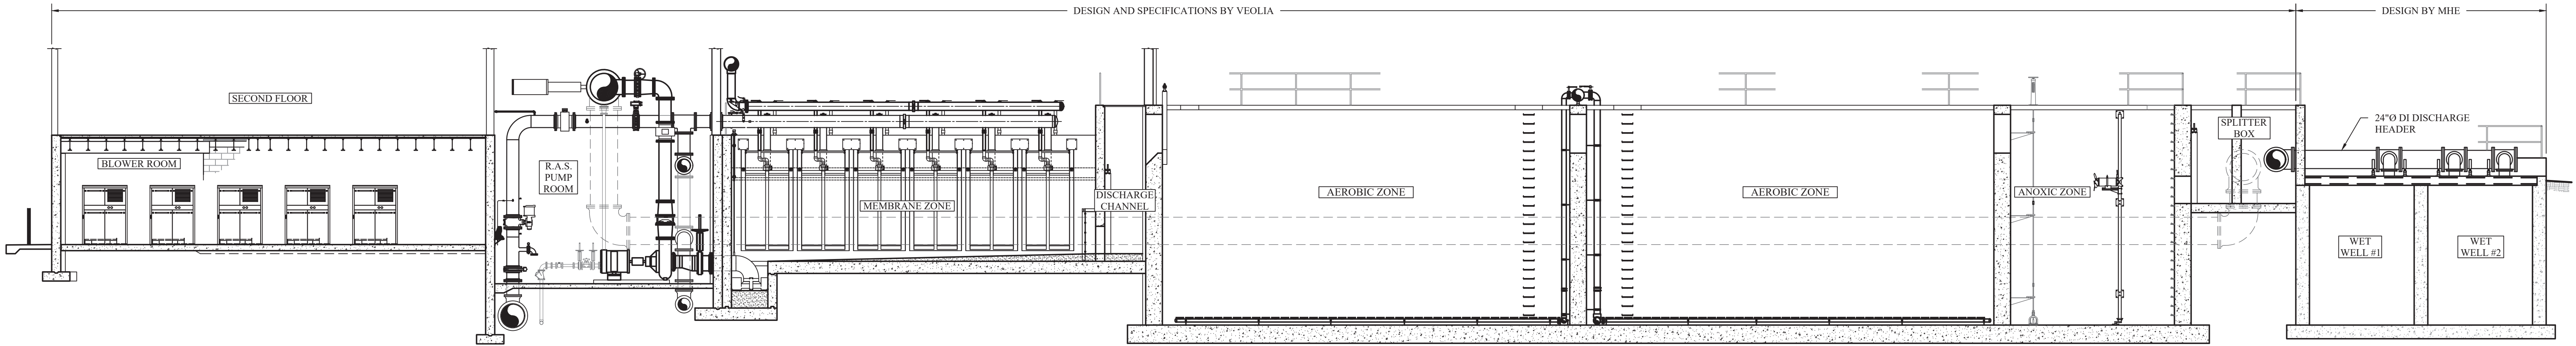

1
C-502
MBR - LONGITUDINAL SECTION
SCALE: 1/8" = 1'-0"

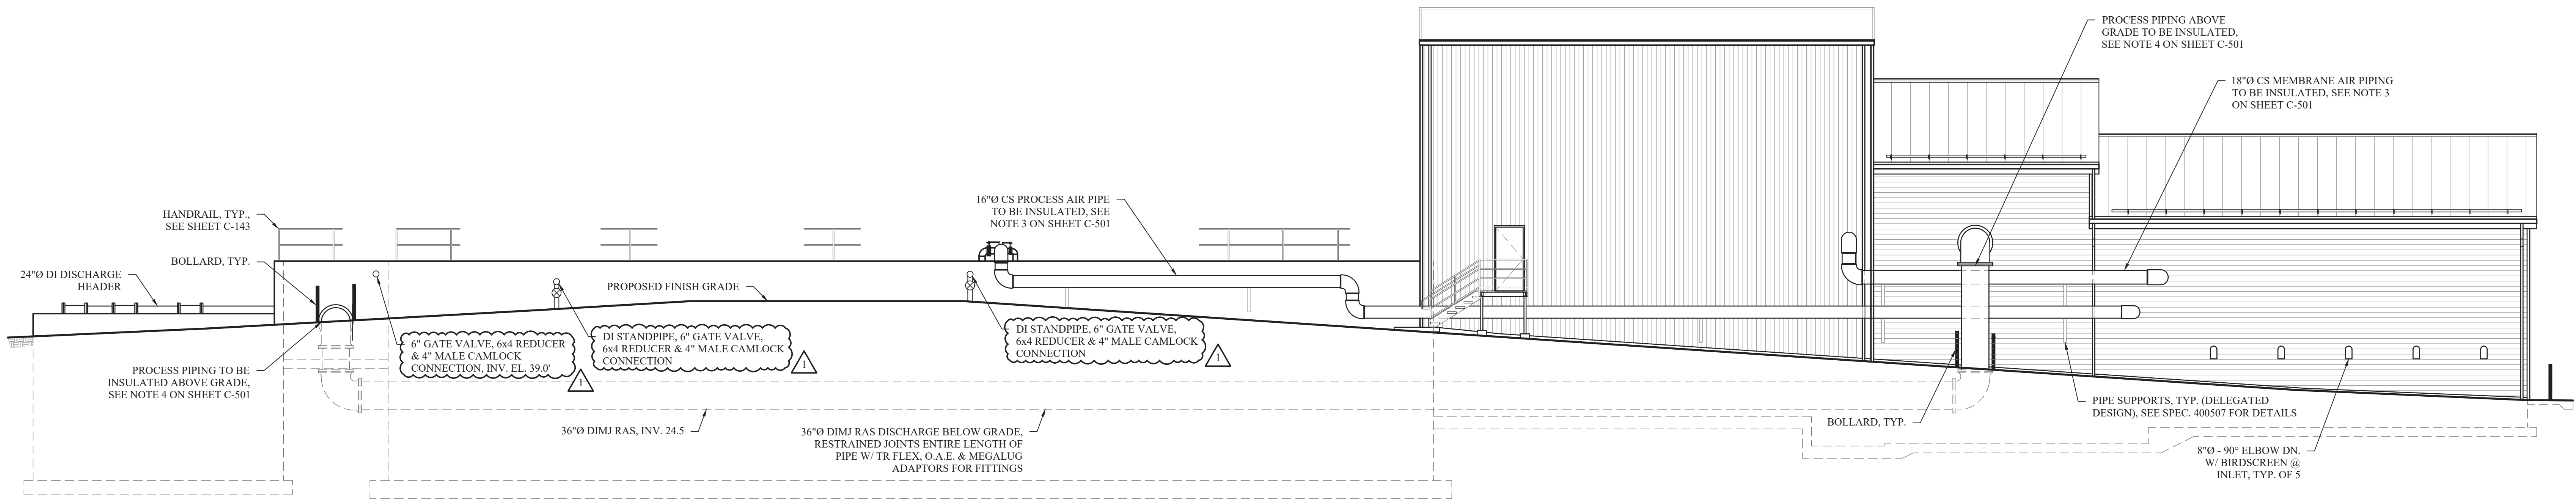

2
C-502
MBR - REAR ELEVATION
SCALE: 1/8" = 1'-0"

BID SET

HAZARDOUS MATERIAL NOTE:
THE SERVICES PROVIDED BY MHE, INCLUDING ALL WORK DEPICTED ON MHE PLANS, DO NOT INCLUDE SERVICES RELATED TO THE IDENTIFICATION, CONTROLS OR HANDLING OF HAZARDOUS MATERIALS, INCLUDING SUCH MATERIALS AS ASBESTOS AND LEAD PAINT. ALL TESTING, IDENTIFICATION, ABATEMENT, CONTROLS, AND HANDLING OF HAZARDOUS MATERIALS SHALL BE UNDERTAKEN BY A HAZARDOUS MATERIAL CONSULTANT AND CERTIFIED PROFESSIONALS. IF SUCH MATERIALS HAVE BEEN IDENTIFIED, CONTRACTOR WILL COMMUNICATE DIRECTLY WITH HAZARDOUS MATERIAL PROFESSIONAL FOR THE PERFORMANCE OF ANY WORK ON OR ADJACENT TO SAID MATERIALS. IF UNIDENTIFIED MATERIALS OF CONCERN ARE ENCOUNTERED WHILE UNDERTAKING THE WORK SHOWN HEREON, CONTRACTOR SHALL IMMEDIATELY NOTIFY ENGINEER AND OWNER, AND SHALL OBTAIN DIRECTION FROM THE HAZARDOUS MATERIAL CONSULTANT PRIOR TO THE CONTINUATION OF WORK INVOLVING SUSPECTED MATERIAL.

REVISIONS		
NO.	DESCRIPTION	DATE
1	ADDENDUM 2	06/20/25

ISSUED DATE:	18 APR. 2025
DESIGN BY:	JTW
DRAWN BY:	HPBjh
CHECKED BY:	MWW
REVIEWED BY:	MJS, JZ

BID SET

HAZARDOUS MATERIAL NOTE:
THE SERVICES PROVIDED BY MHE, INCLUDING ALL WORK DEPICTED ON MHE PLANS, DO NOT INCLUDE SERVICES RELATED TO THE IDENTIFICATION, CONTROLS OR HANDLING OF HAZARDOUS MATERIALS, INCLUDING SUCH MATERIALS AS ASBESTOS AND LEAD PAINT. ALL TESTING, IDENTIFICATION, ABATEMENT, CONTROLS, AND HANDLING OF HAZARDOUS MATERIALS SHALL BE UNDERTAKEN BY A HAZARDOUS MATERIAL CONSULTANT AND CERTIFIED PROFESSIONALS. IF SUCH MATERIALS HAVE BEEN IDENTIFIED, CONTRACTOR WILL COMMUNICATE DIRECTLY WITH HAZARDOUS MATERIAL PROFESSIONAL FOR THE PERFORMANCE OF ANY WORK ON OR ADJACENT TO SAID MATERIALS. IF UNIDENTIFIED MATERIALS OF CONCERN ARE ENCOUNTERED WHILE UNDERTAKING THE WORK SHOWN HEREON, CONTRACTOR SHALL IMMEDIATELY NOTIFY ENGINEER AND OWNER, AND SHALL OBTAIN DIRECTION FROM THE HAZARDOUS MATERIAL CONSULTANT PRIOR TO THE CONTINUATION OF WORK INVOLVING SUSPECTED MATERIAL.



UNAUTHORIZED ADDITION OR ALTERATION OF THIS PLAN IS A VIOLATION OF SECTION 7209(2) OF THE NEW YORK STATE EDUCATION LAW.

ALL PRODUCTION & INTELLECTUAL PROPERTY RIGHT RESERVED ©

**CAESARS LANE WWTP
EXPANSION PROJECT:
PHASE 2**
145 CAESARS LN.
NEW WINDSOR, NY 12553
FOR TOWN OF NEW WINDSOR
555 UNION AVE.
NEW WINDSOR, NY 12553

**MBR - INFLUENT PUMPS
& MICROSCREEN PLAN**


REVISIONS		
NO.	DESCRIPTION	DATE
1	ADDENDUM 2	06/20/25

ISSUED DATE:	18 APR. 2025
DESIGN BY:	JTW
DRAWN BY:	HPBH
CHECKED BY:	MWW
REVIEWED BY:	MJS, JZ


SHEET NO.

C-510

PROJECT # 18-732 PHASE #

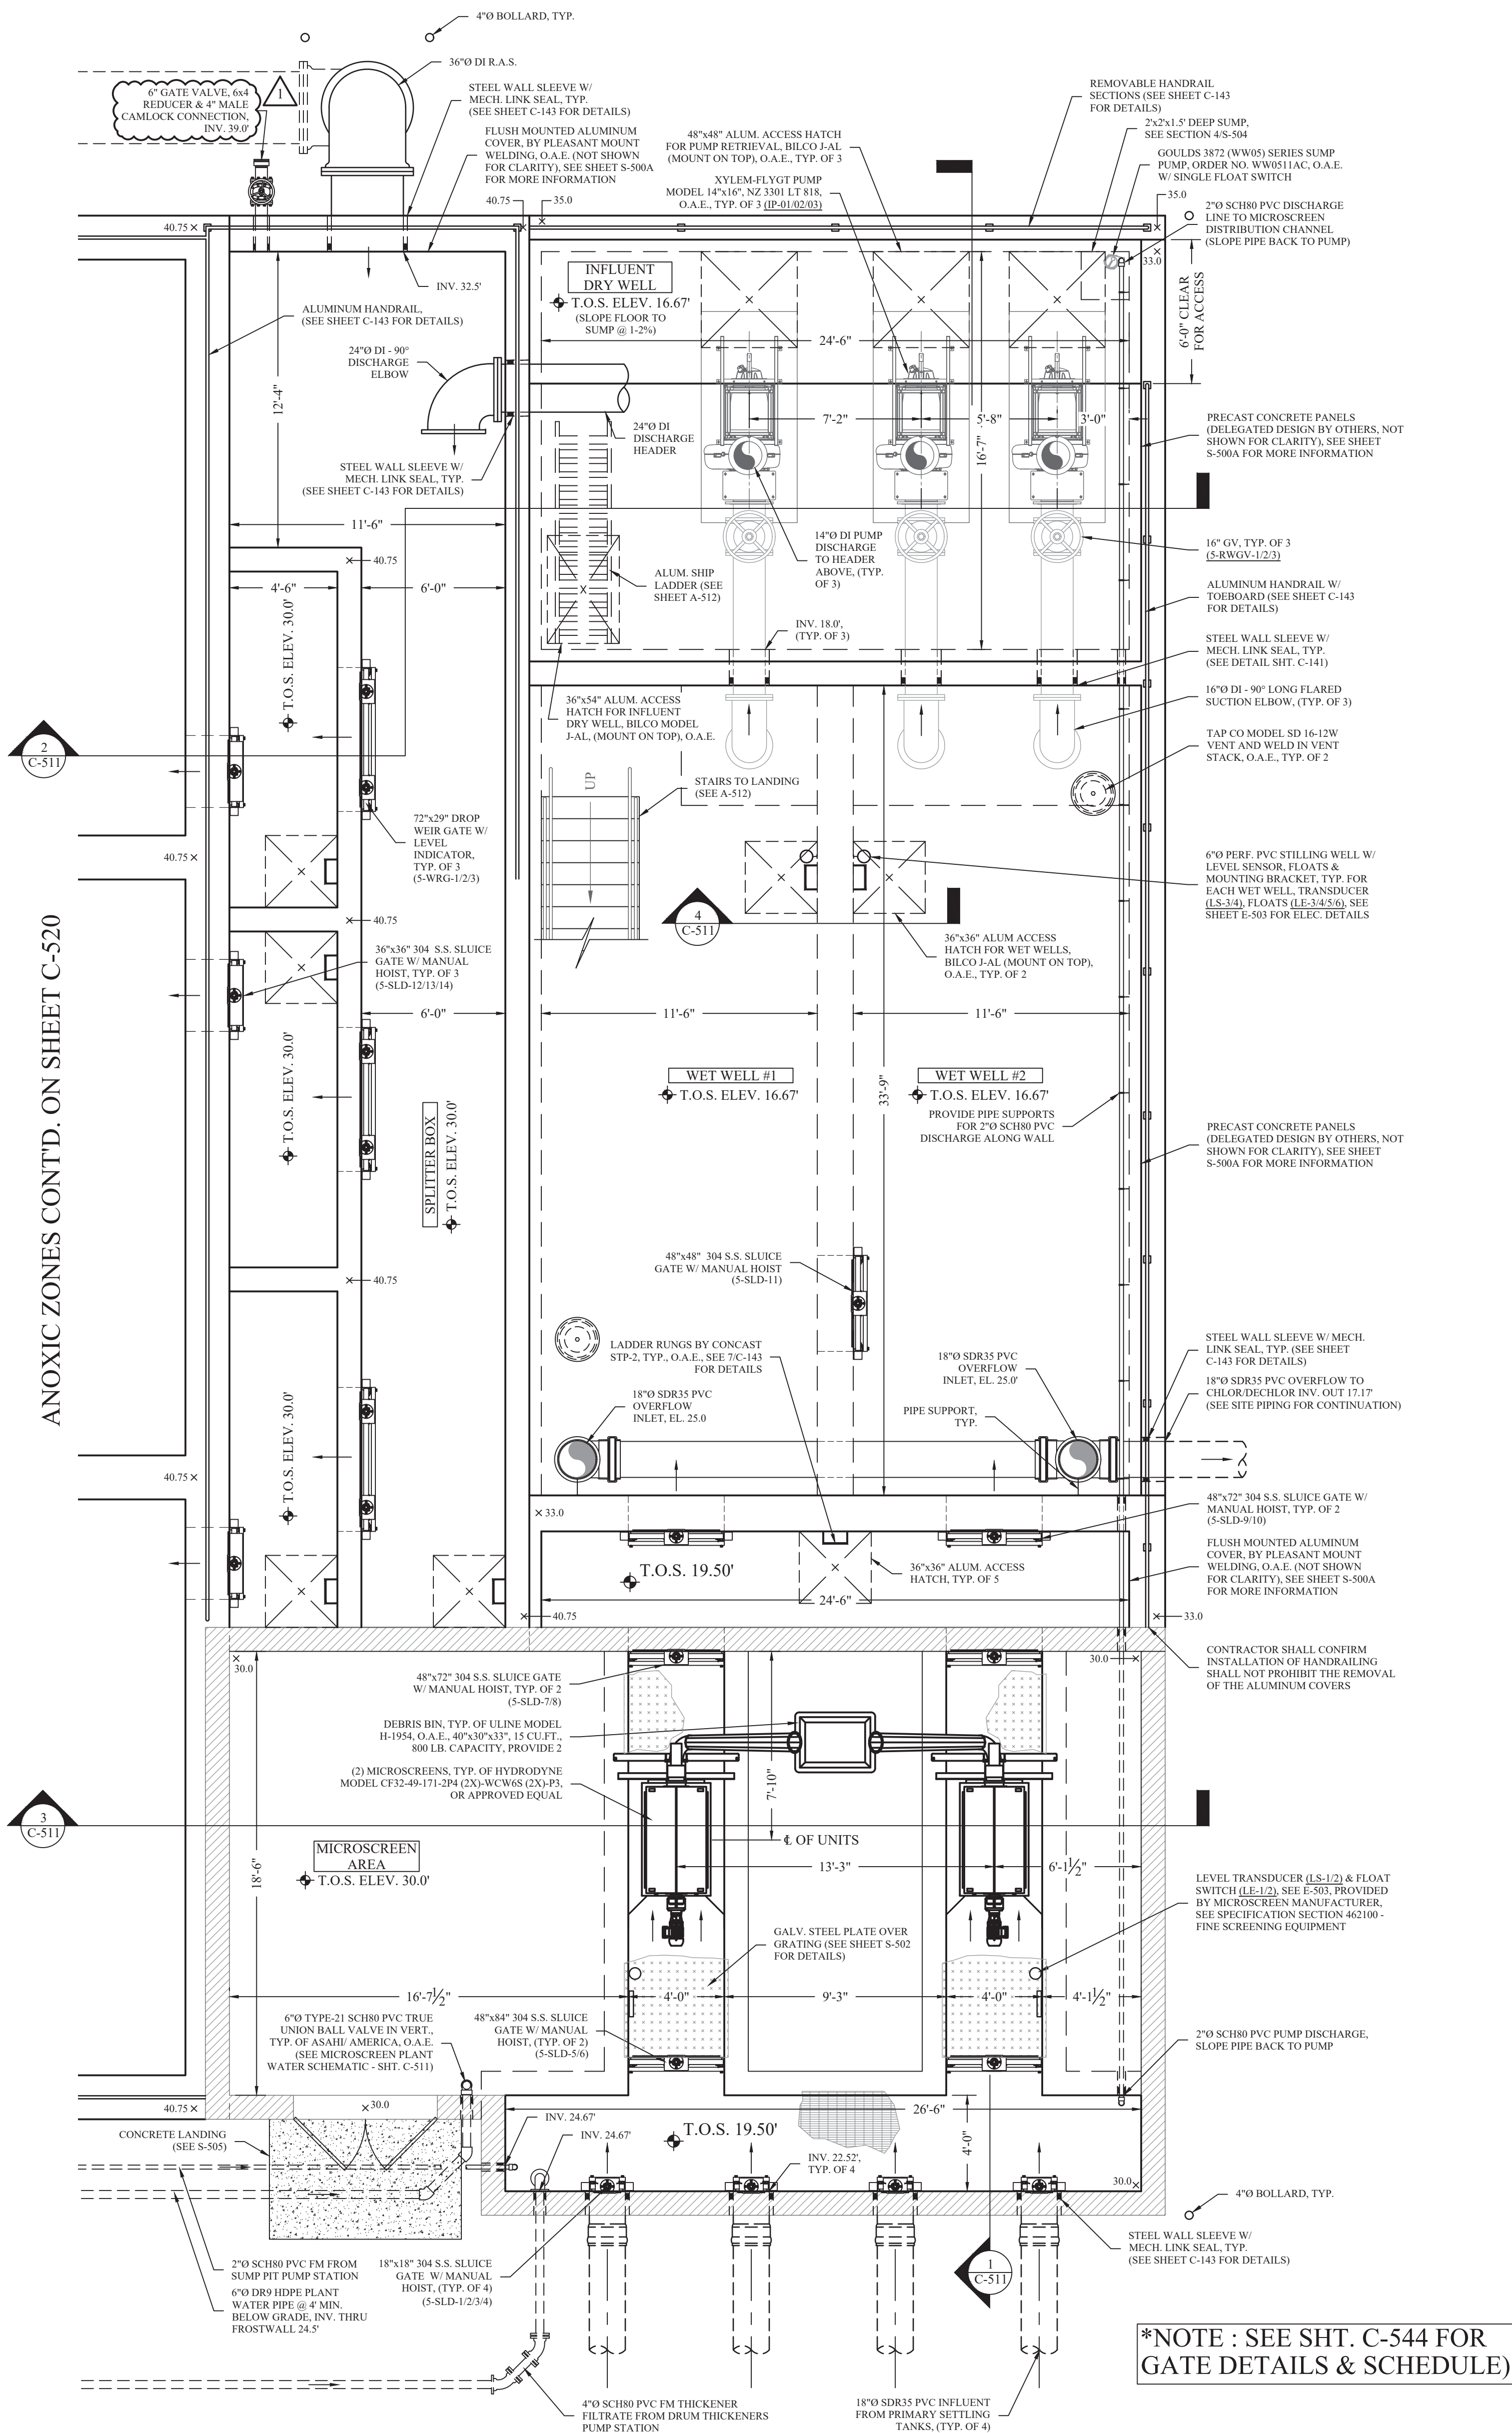

MBR - INFLUENT PUMPS & MICROSCREEN PLAN
SCALE: 1/4" = 1'-0"

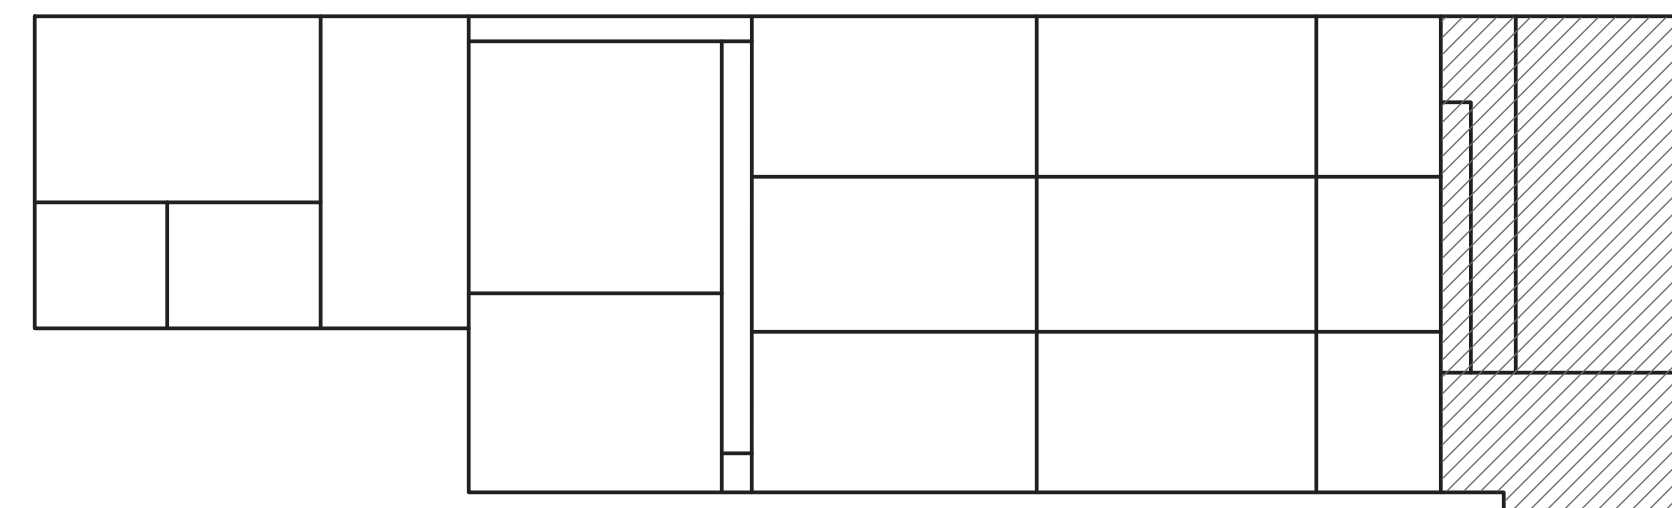

KEY PLAN
SCALE: 1/32" = 1'-0"

MHEENGINEERING

33 Airport Center Drive, Suite 202
New Windsor, NY 12553
(845) 567-3100

111 Wheatfield Drive, Suite 1
Millford, PA 18337
(610) 296-2765

BID SET

HAZARDOUS MATERIAL NOTE:
THE SERVICES PROVIDED BY MHE, INCLUDING ALL WORK DEPICTED ON MHE PLANS, DO NOT INCLUDE SERVICES RELATED TO THE IDENTIFICATION, CONTROLS OR HANDLING OF HAZARDOUS MATERIALS, INCLUDING SUCH MATERIALS AS ASBESTOS AND LEAD PAINT. ALL TESTING, IDENTIFICATION, ABATEMENT, CONTROLS, AND HANDLING OF HAZARDOUS MATERIALS SHALL BE UNDERTAKEN BY A HAZARDOUS MATERIAL CONSULTANT AND CERTIFIED PROFESSIONALS. IF SUCH MATERIALS HAVE BEEN IDENTIFIED, CONTRACTOR WILL COMMUNICATE DIRECTLY WITH HAZARDOUS MATERIAL PROFESSIONAL FOR THE PERFORMANCE OF ANY WORK ON OR ADJACENT TO SAID MATERIALS. IF UNIDENTIFIED MATERIALS OF CONCERN ARE ENCOUNTERED WHILE UNDERTAKING THE WORK SHOWN HEREON, CONTRACTOR SHALL IMMEDIATELY NOTIFY ENGINEER AND OWNER, AND SHALL OBTAIN DIRECTION FROM THE HAZARDOUS MATERIAL CONSULTANT PRIOR TO THE CONTINUATION OF WORK INVOLVING SUSPECTED MATERIAL.

**UDIG-NY**
SAFE DIGGING STARTS HERE
CALL 811

UNAUTHORIZED ADDITION OR ALTERATION OF THIS PLAN IS A VIOLATION OF SECTION 7209(2) OF THE NEW YORK STATE EDUCATION LAW.

ALL PRODUCTION & INTELLECTUAL PROPERTY RIGHT RESERVED ©

CAESARS LANE WWTP
EXPANSION PROJECT:
PHASE 2
145 CAESARS LN.
NEW WINDSOR, NY 12553
FOR TOWN OF NEW WINDSOR
555 UNION AVE.
NEW WINDSOR, NY 12553

MBR - ANOXIC ZONE
TANK PLAN, SECTIONS
& DETAILS

REVISIONS		
NO.	DESCRIPTION	DATE
1	ADDENDUM 2	06/20/25

ISSUED DATE: 18 APR, 2025

DESIGN BY: JTW

DRAWN BY: HPBH


CHECKED BY: MWW

REVIEWED BY: MJS, JZ


SHEET NO.

C-520


PROJECT # 18-732 PHASE #

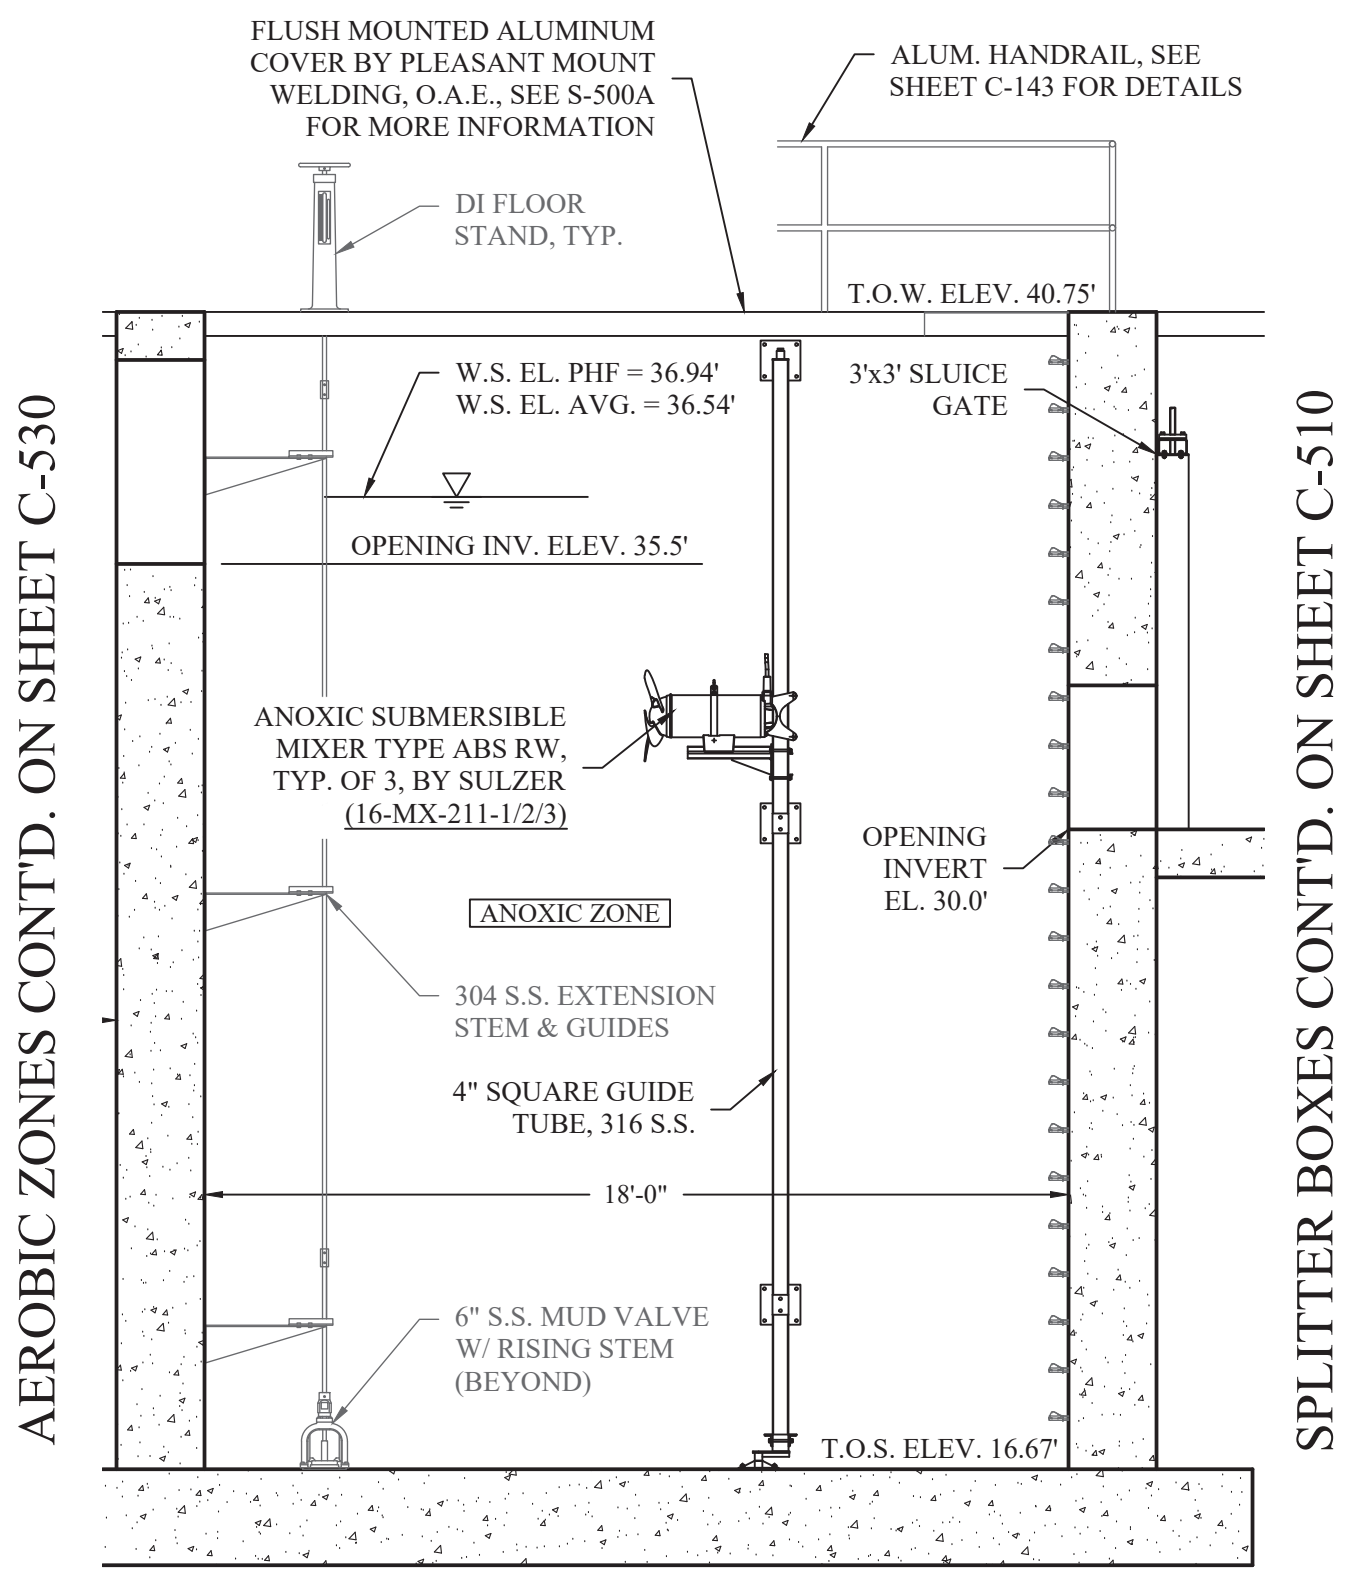

1
C-520
SECTION
SCALE: 1/4" = 1'-0"

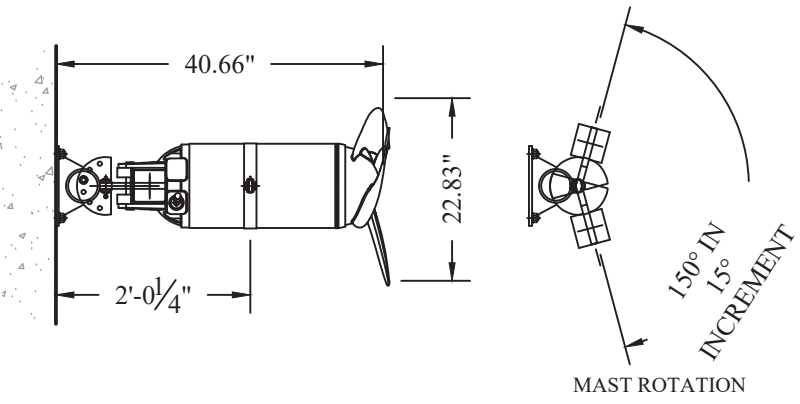


PLAN VIEW DETAILS

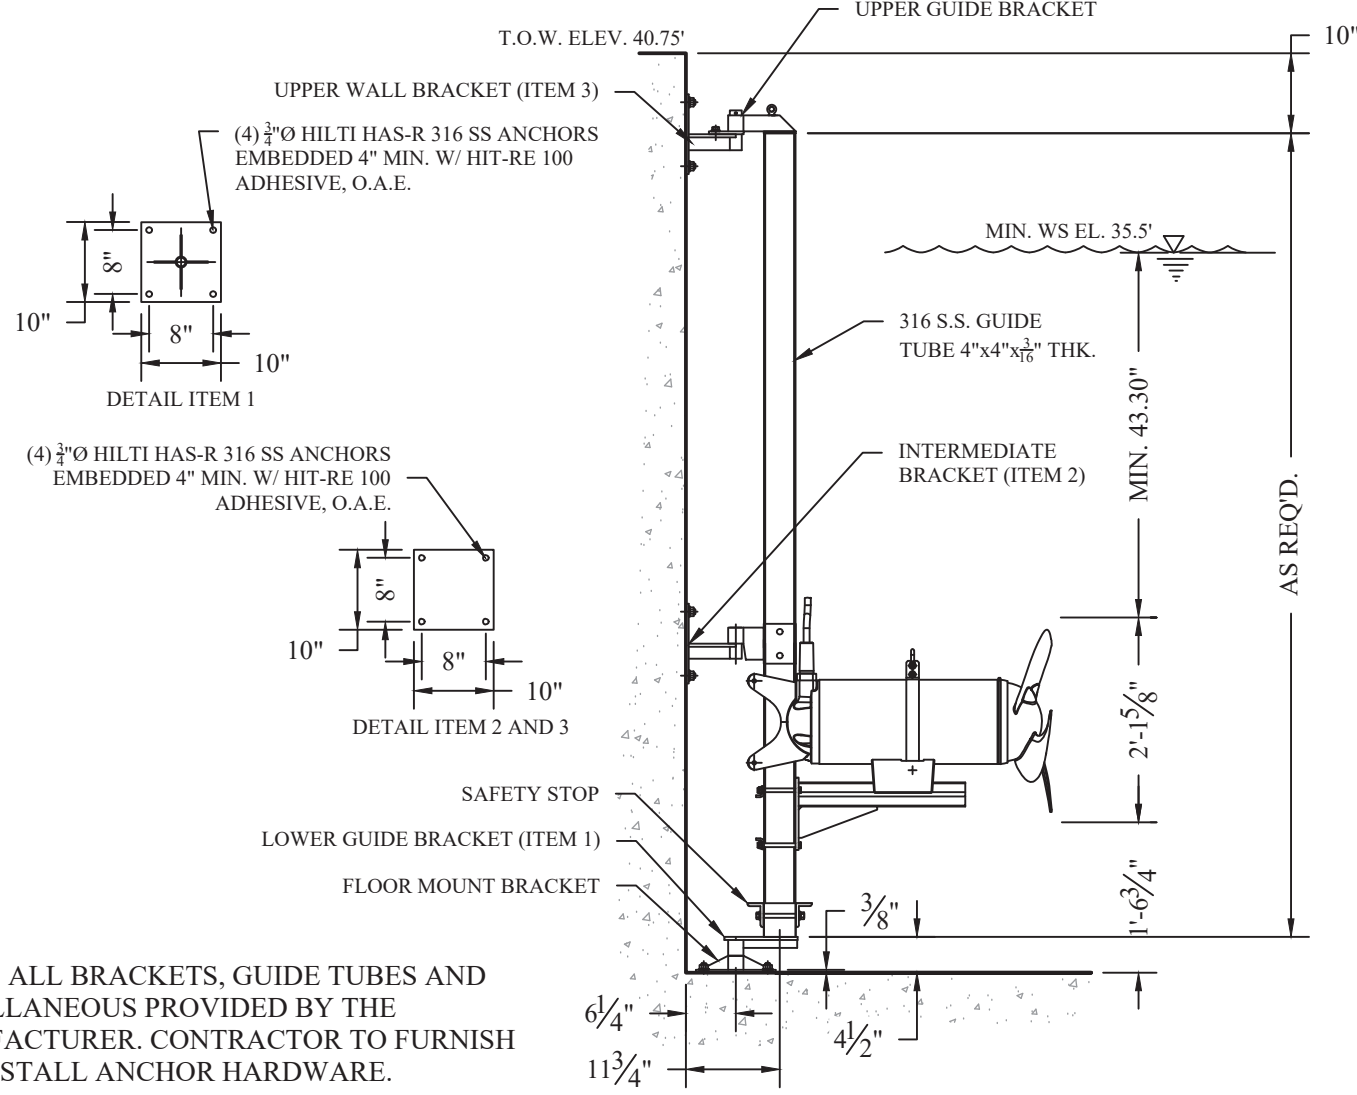


NOTES: ALL BRACKETS, GUIDE TUBES AND MISCELLANEOUS PROVIDED BY THE MANUFACTURER. CONTRACTOR TO FURNISH AND INSTALL ANCHOR HARDWARE.


2
C-520
ELEVATION VIEW DETAILS
SUBMERSIBLE MIXER INSTALLATION DETAIL
SCALE: 1/2" = 1'-0" (PROVIDED BY VEOLIA)

*NOTE : SEE SHT. C-544 FOR GATE DETAILS & SCHEDULE)

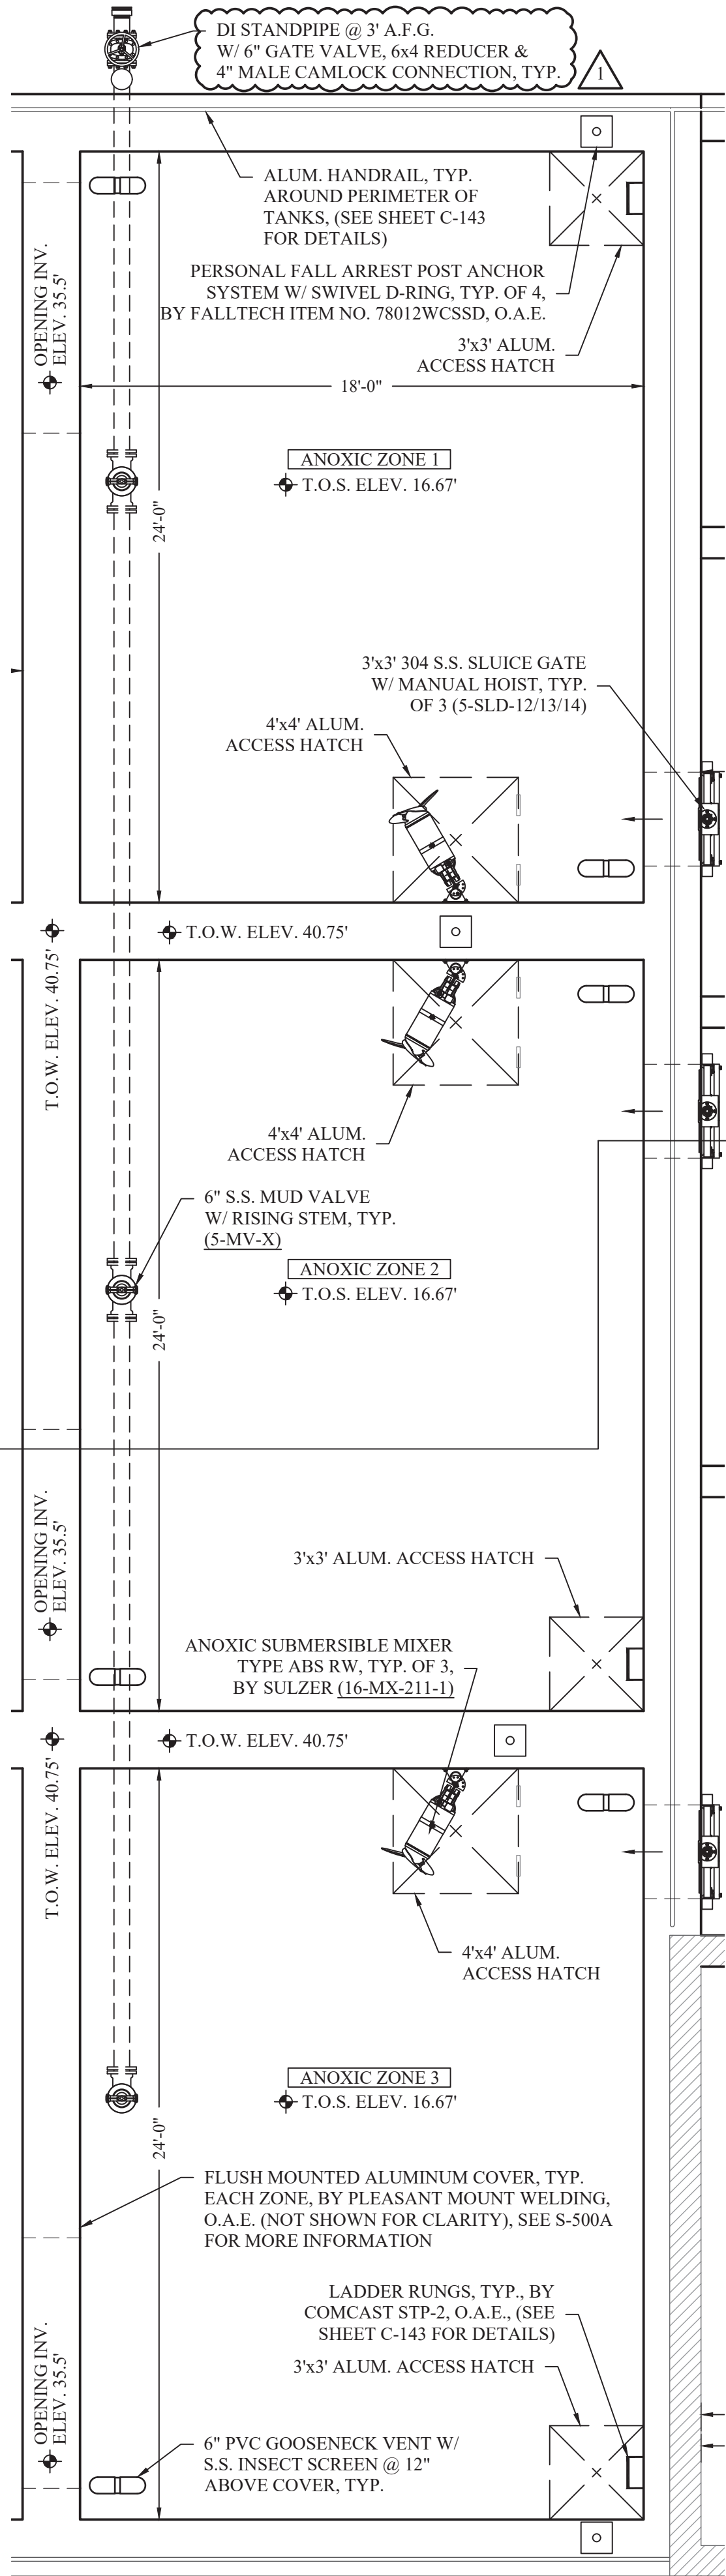

A
C-520
MBR - ANOXIC ZONE TANK PLAN
SCALE: 1/4" = 1'-0"

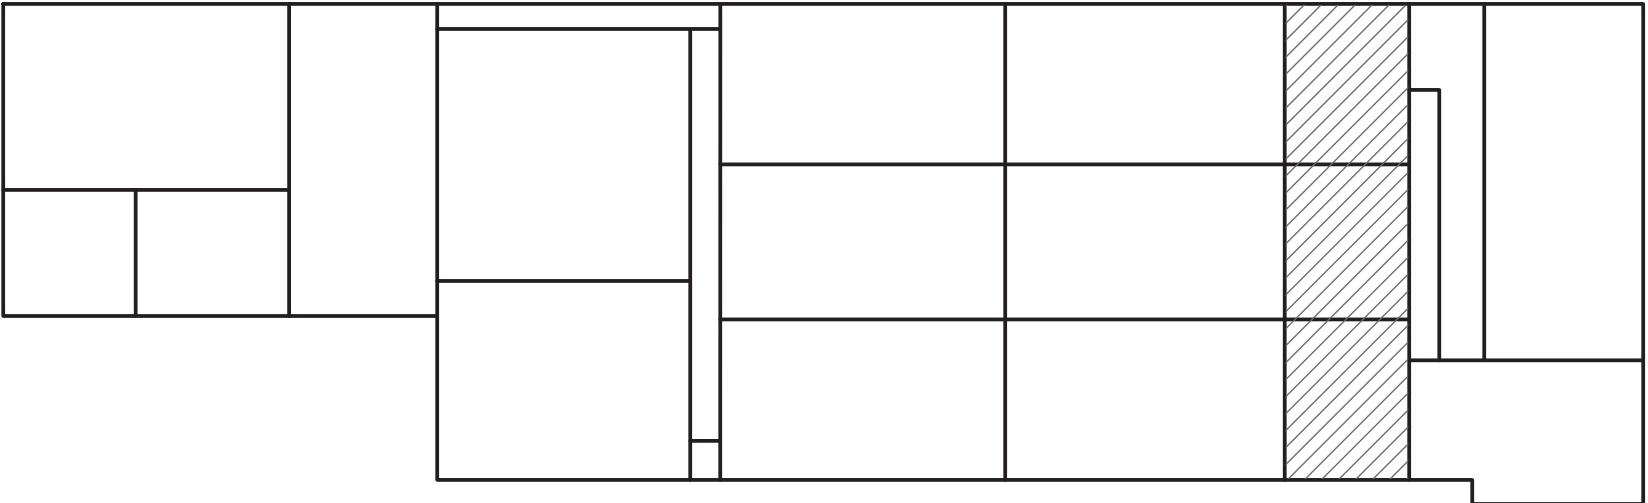

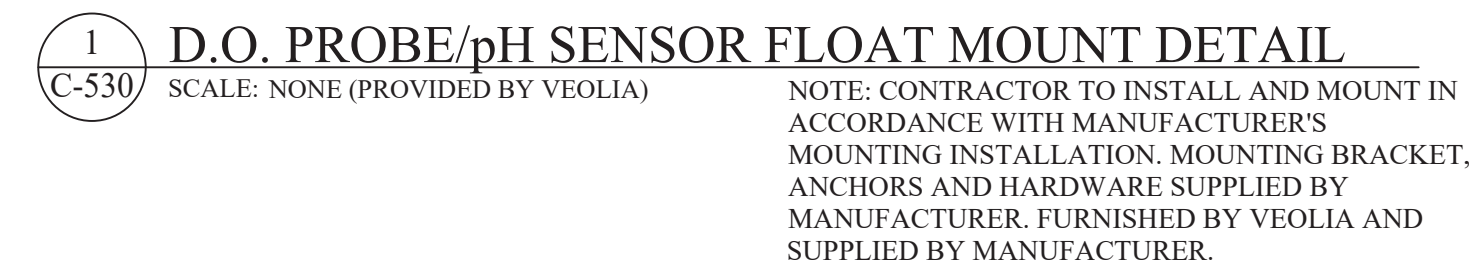


1. ALL CARBON STEEL AND STAINLESS STEEL PIPE SHALL COMPLY WITH ASTM A53.
2. ALL CARBON STEEL AND STAINLESS STEEL PIPE SHALL BE WELDED.
3. ALL FITTINGS SHALL COMPLY WITH ASTM A234-WPB.


*NOTE : SEE SHT. C-544 FOR
GATE DETAILS & SCHEDULE)




P:\2018\18-732 Caesars Lane WWTP Improvements\Expansion Phase\Drawings\ C-550\ C-550.dwg, C-550, 02/03/2025, 10:50:52 AM

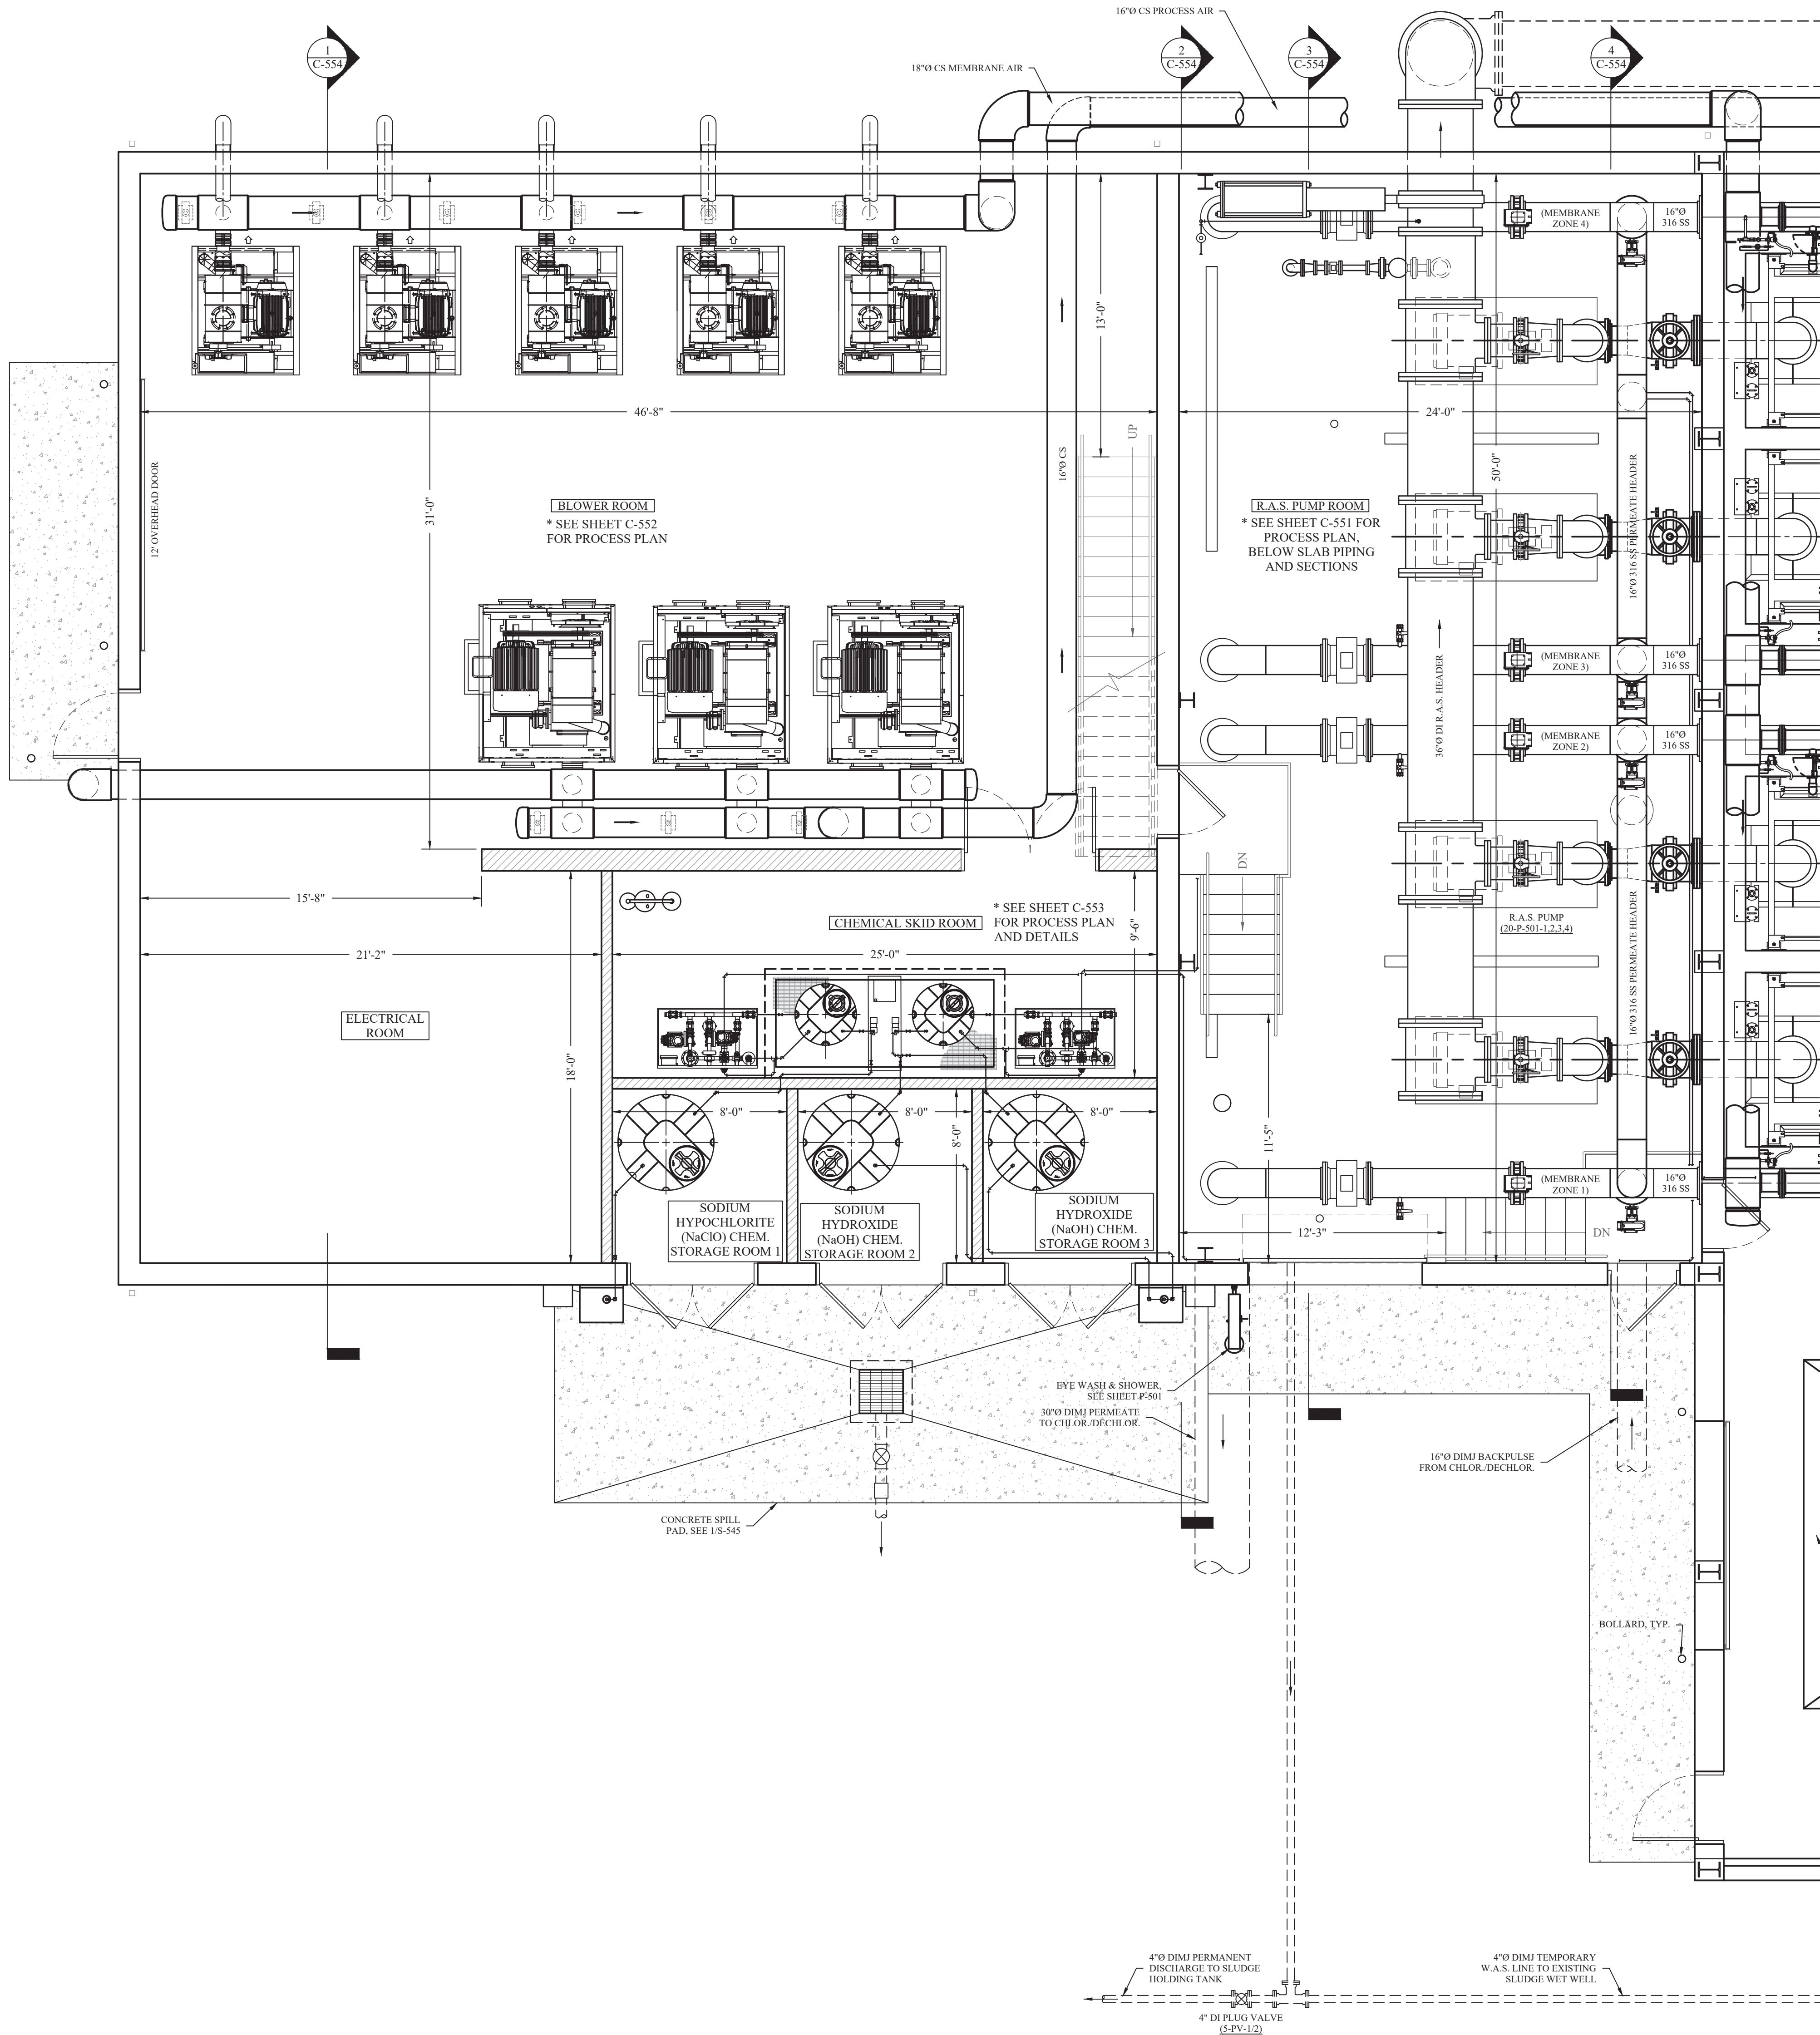

A
C-550
MBR - FIRST FLOOR PROCESS PLAN
SCALE: 1/4" = 1'-0"

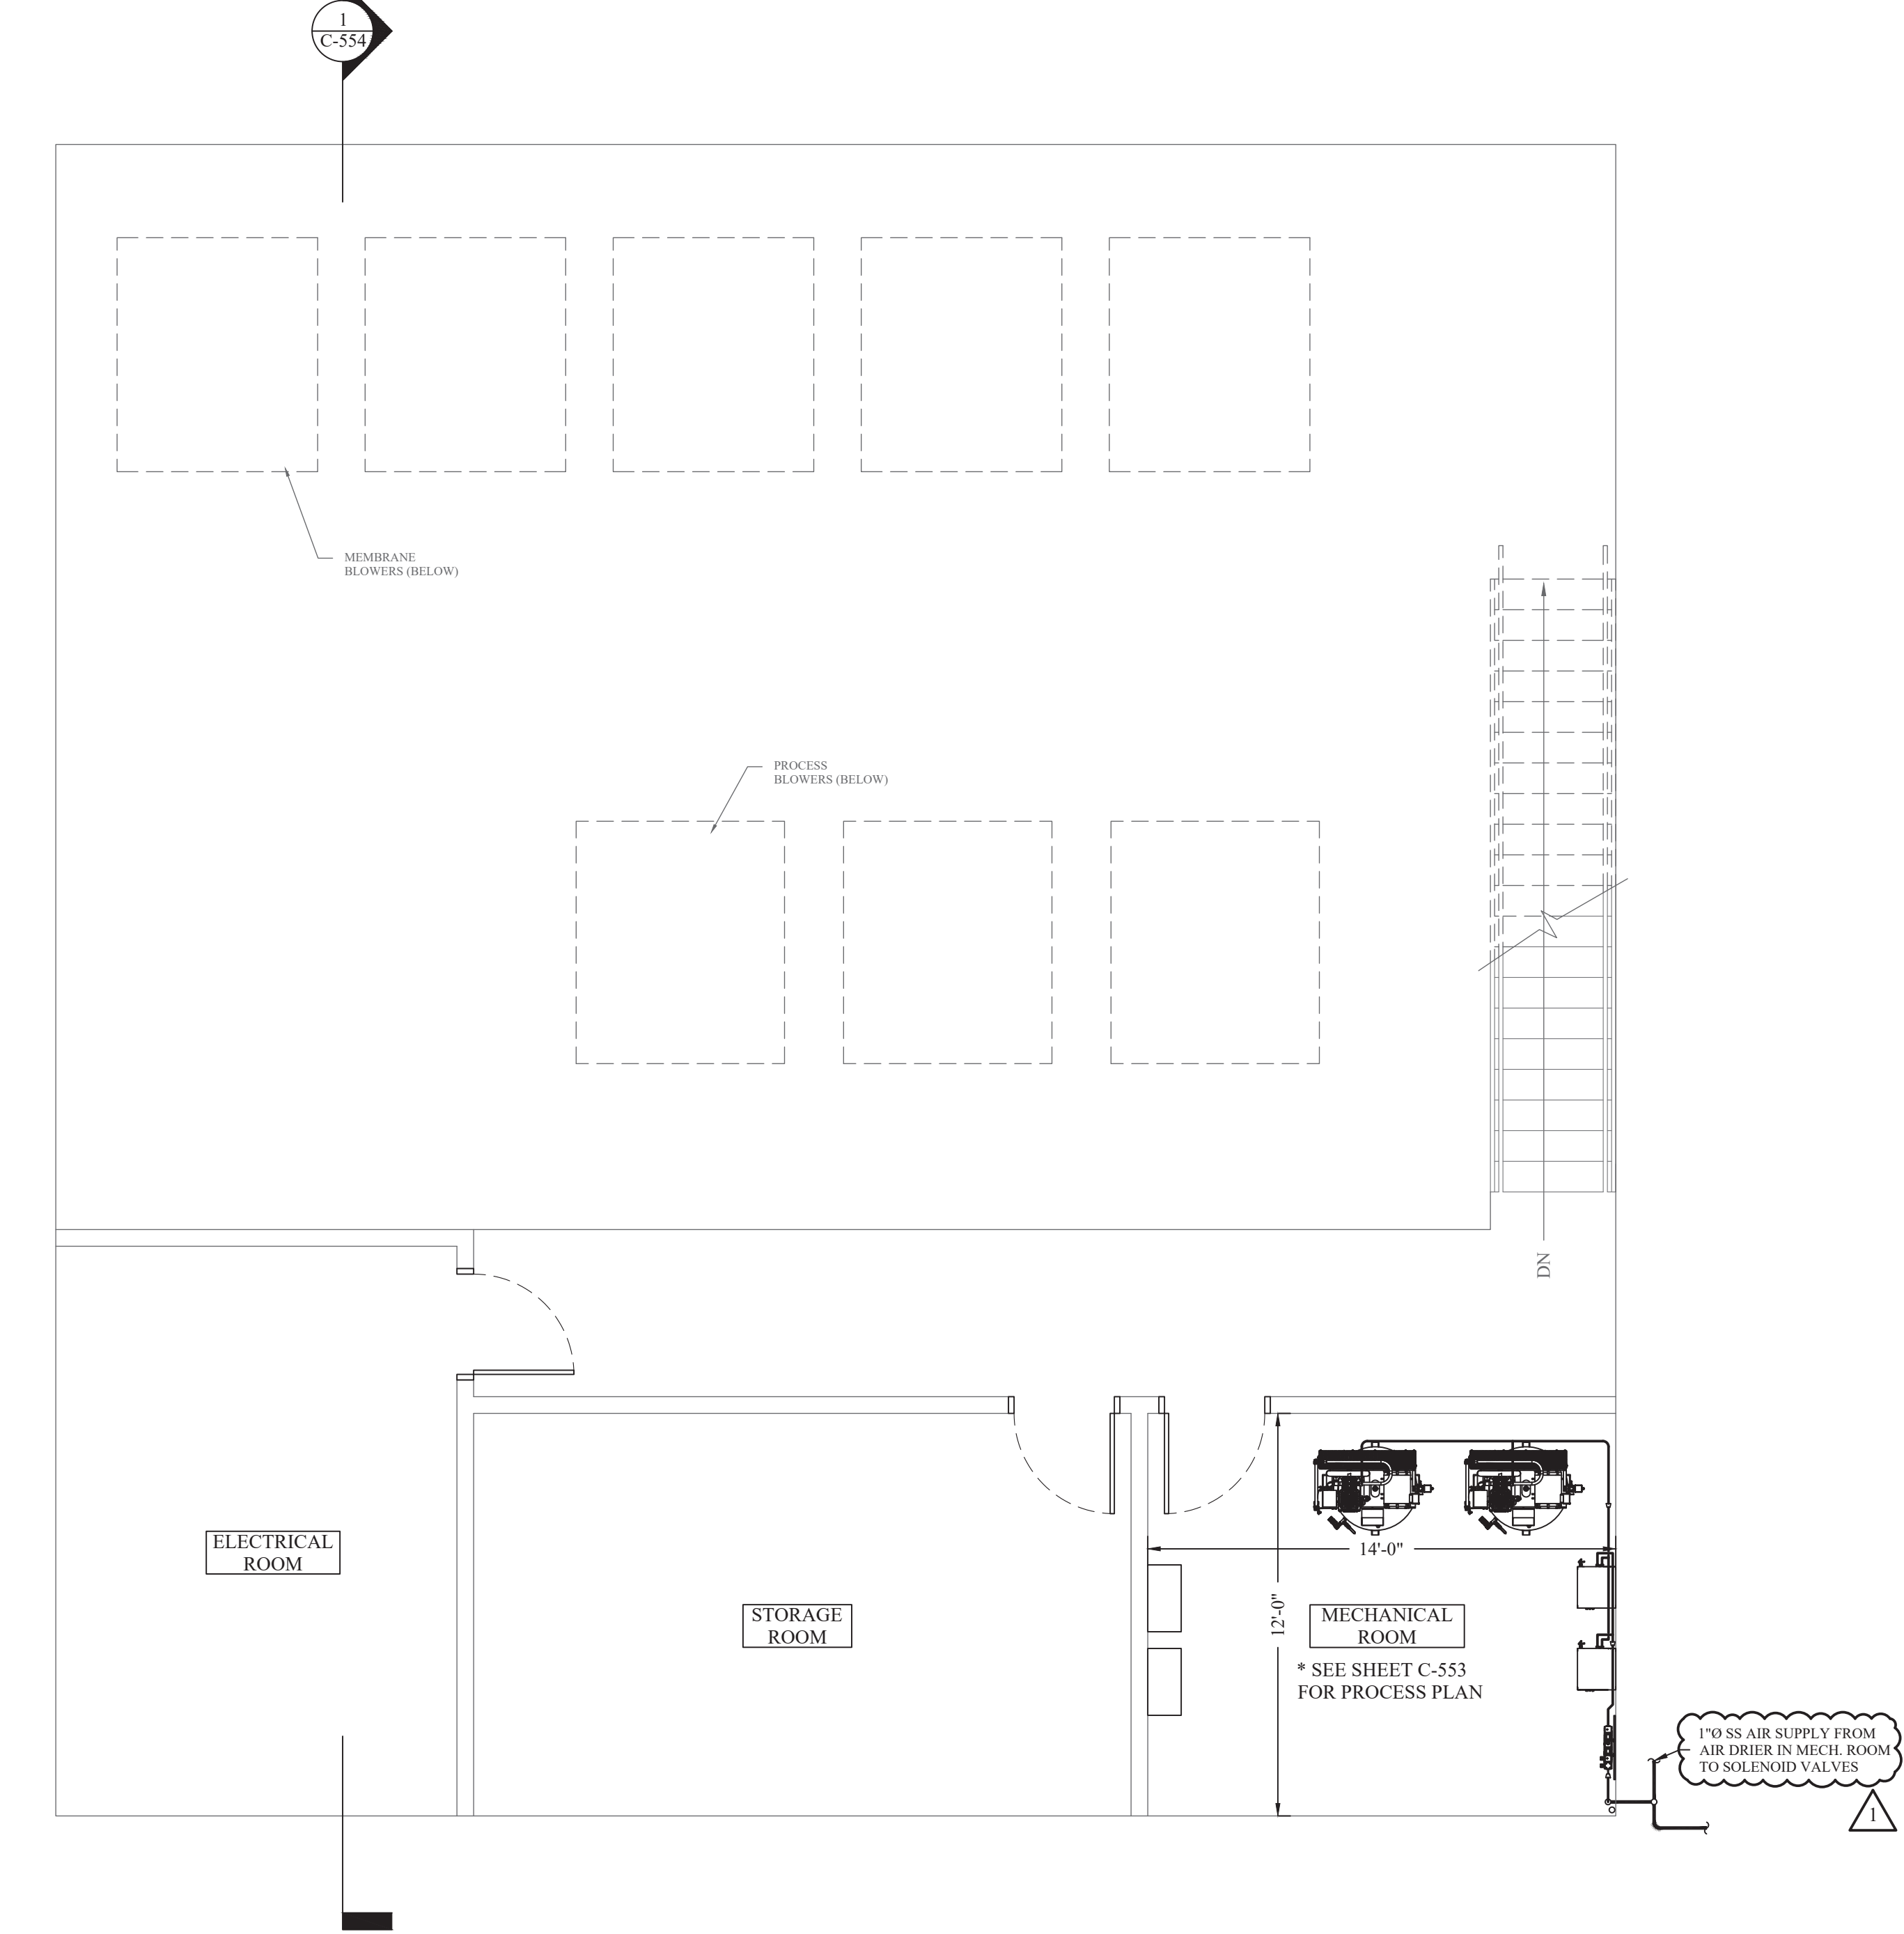

B
C-550
MBR - SECOND FLOOR PLAN
SCALE: 1/4" = 1'-0"

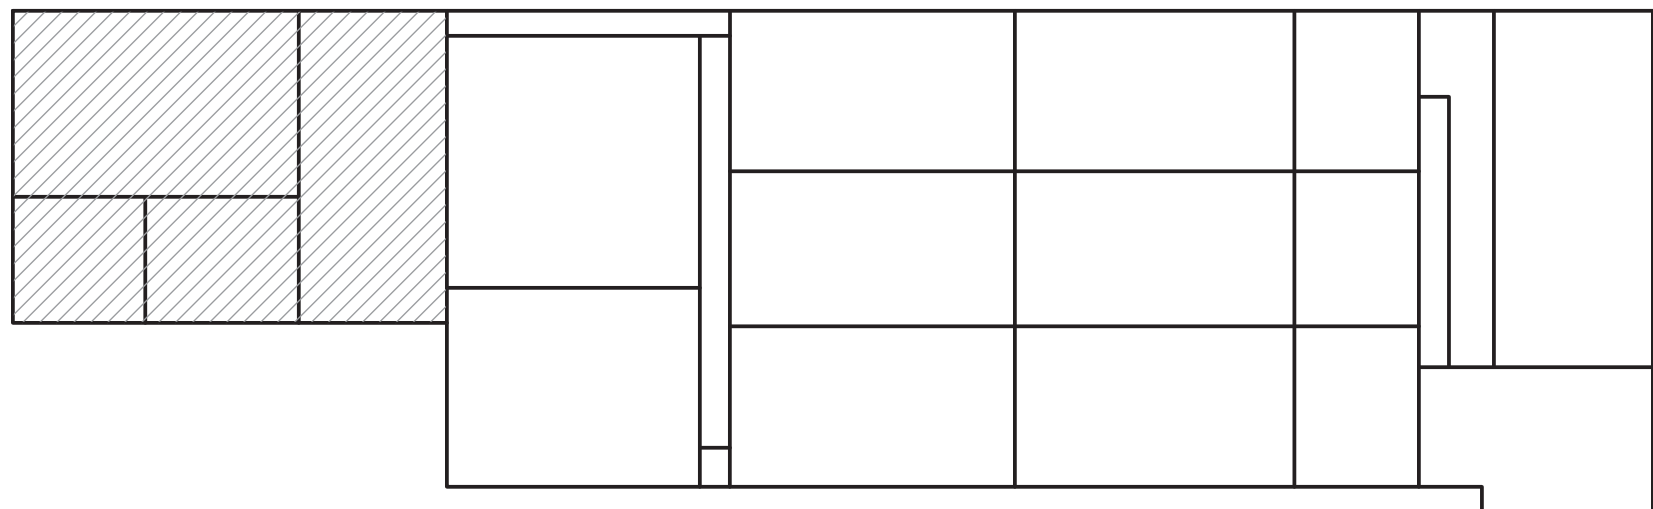

KEY PLAN
SCALE: 1/32" = 1'-0"

BID SET

HAZARDOUS MATERIAL NOTE:
THE SERVICES PROVIDED BY MHE, INCLUDING ALL WORK DEPICTED ON MHE PLANS, DO NOT INCLUDE SERVICES RELATED TO THE IDENTIFICATION, CONTROLS OR HANDLING OF HAZARDOUS MATERIALS, INCLUDING SUCH MATERIALS AS ASBESTOS AND LEAD PAINT. ALL TESTING, IDENTIFICATION, ABATEMENT, CONTROLS, AND HANDLING OF HAZARDOUS MATERIALS SHALL BE UNDERTAKEN BY A HAZARDOUS MATERIAL CONSULTANT AND CERTIFIED PROFESSIONALS. IF SUCH MATERIALS HAVE BEEN IDENTIFIED, CONTRACTOR WILL COMMUNICATE DIRECTLY WITH HAZARDOUS MATERIAL PROFESSIONAL FOR THE PERFORMANCE OF ANY WORK ON OR ADJACENT TO SAID MATERIALS. IF UNIDENTIFIED MATERIALS OF CONCERN ARE ENCOUNTERED WHILE UNDERTAKING THE WORK SHOWN HEREON, CONTRACTOR SHALL IMMEDIATELY NOTIFY ENGINEER AND OWNER, AND SHALL OBTAIN DIRECTION FROM THE HAZARDOUS MATERIAL CONSULTANT PRIOR TO THE CONTINUATION OF WORK INVOLVING SUSPECTED MATERIAL.



UNAUTHORIZED ADDITION OR ALTERATION OF THIS PLAN IS A VIOLATION OF SECTION 7209(2) OF THE NEW YORK STATE EDUCATION LAW.

ALL PRODUCTION & INTELLECTUAL PROPERTY RIGHT RESERVED ©

**CAESARS LANE WWTP
EXPANSION PROJECT:
PHASE 2**
145 CAESARS LN.
NEW WINDSOR, NY 12553
FOR TOWN OF NEW WINDSOR
555 UNION AVE.
NEW WINDSOR, NY 12553

MBR - FIRST FLOOR
PROCESS PLAN AND
SECOND FLOOR PLAN

REVISIONS		
NO.	DESCRIPTION	DATE
1	ADDENDUM 2	06/20/25

ISSUED DATE: 18 APR, 2025
DESIGN BY: JTW
DRAWN BY: HPBH
CHECKED BY: MWW
REVIEWED BY: MJS, JZ

SHEET NO.

C-550

PROJECT # 18-732 PHASE #



BID SET

HAZARDOUS MATERIAL NOTE:
THE SERVICES PROVIDED BY MHE, INCLUDING ALL WORK DEPICTED ON MHE PLANS, DO NOT INCLUDE SERVICES RELATED TO THE IDENTIFICATION, CONTROLS OR HANDLING OF HAZARDOUS MATERIALS, INCLUDING SUCH MATERIALS AS ASBESTOS AND LEAD PAINT. ALL TESTING, IDENTIFICATION, ABATEMENT, CONTROLS, AND HANDLING OF HAZARDOUS MATERIALS SHALL BE UNDERTAKEN BY A HAZARDOUS MATERIAL CONSULTANT AND CERTIFIED PROFESSIONALS. IF SUCH MATERIALS HAVE BEEN IDENTIFIED, CONTRACTOR WILL COMMUNICATE DIRECTLY WITH HAZARDOUS MATERIAL PROFESSIONAL FOR THE PERFORMANCE OF ANY WORK ON OR ADJACENT TO SAID MATERIALS. IF UNIDENTIFIED MATERIALS OF CONCERN ARE ENCOUNTERED WHILE UNDERTAKING THE WORK SHOWN HEREON, CONTRACTOR SHALL IMMEDIATELY NOTIFY ENGINEER AND OWNER, AND SHALL OBTAIN DIRECTION FROM THE HAZARDOUS MATERIAL CONSULTANT PRIOR TO THE CONTINUATION OF WORK INVOLVING SUSPECTED MATERIAL.



UNAUTHORIZED ADDITION OR ALTERATION OF THIS PLAN IS A VIOLATION OF SECTION 7209(2) OF THE NEW YORK STATE EDUCATION LAW.

ALL PRODUCTION & INTELLECTUAL PROPERTY RIGHT RESERVED ©

**CAESARS LANE WWTP
EXPANSION PROJECT:
PHASE 2**
145 CAESARS LN.
NEW WINDSOR, NY 12553
FOR TOWN OF NEW WINDSOR
555 UNION AVE.
NEW WINDSOR, NY 12553

**MBR SECTIONS &
PIPE ELEVATIONS**


REVISIONS		
NO.	DESCRIPTION	DATE
1	ADDENDUM 2	06/20/25

ISSUED DATE:	18 APR. 2025
DESIGN BY:	JTW
DRAWN BY:	HPBH
CHECKED BY:	MWW
REVIEWED BY:	MJS, JZ


SHEET NO.

C-554


PROJECT # 18-732 PHASE #

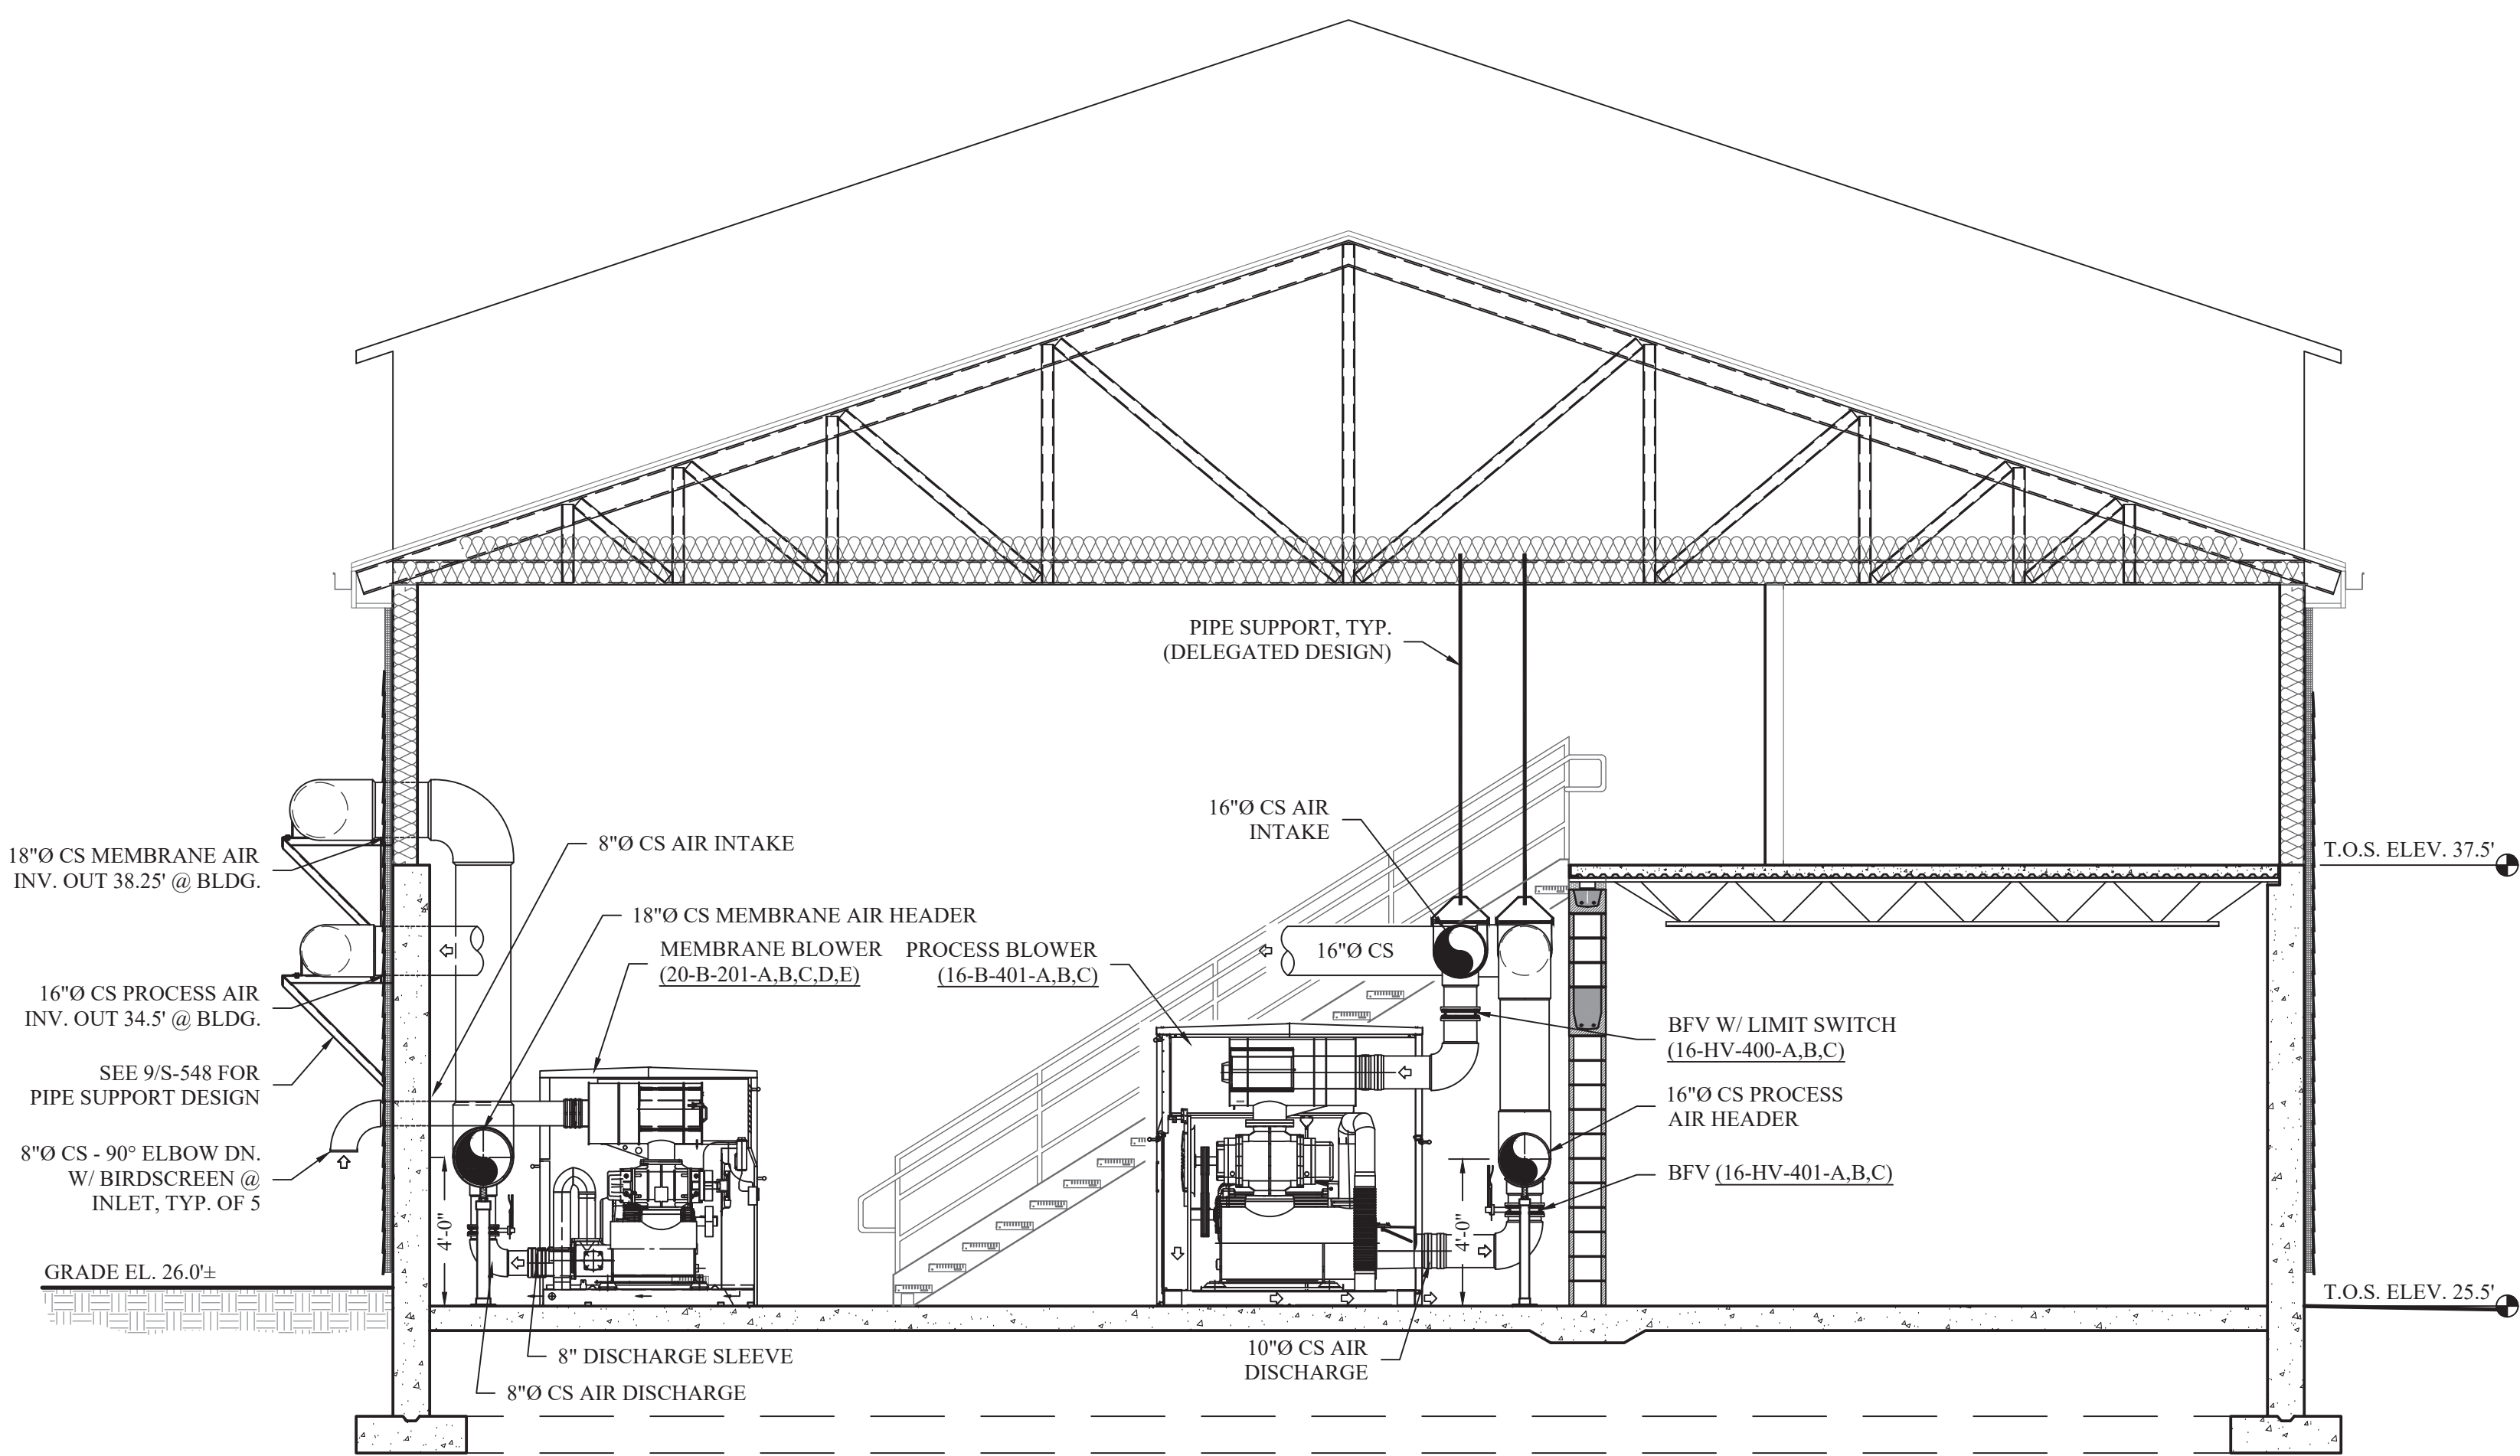


1 SECTION THRU BLOWER ROOM
SCALE: 1/4" = 1'-0"

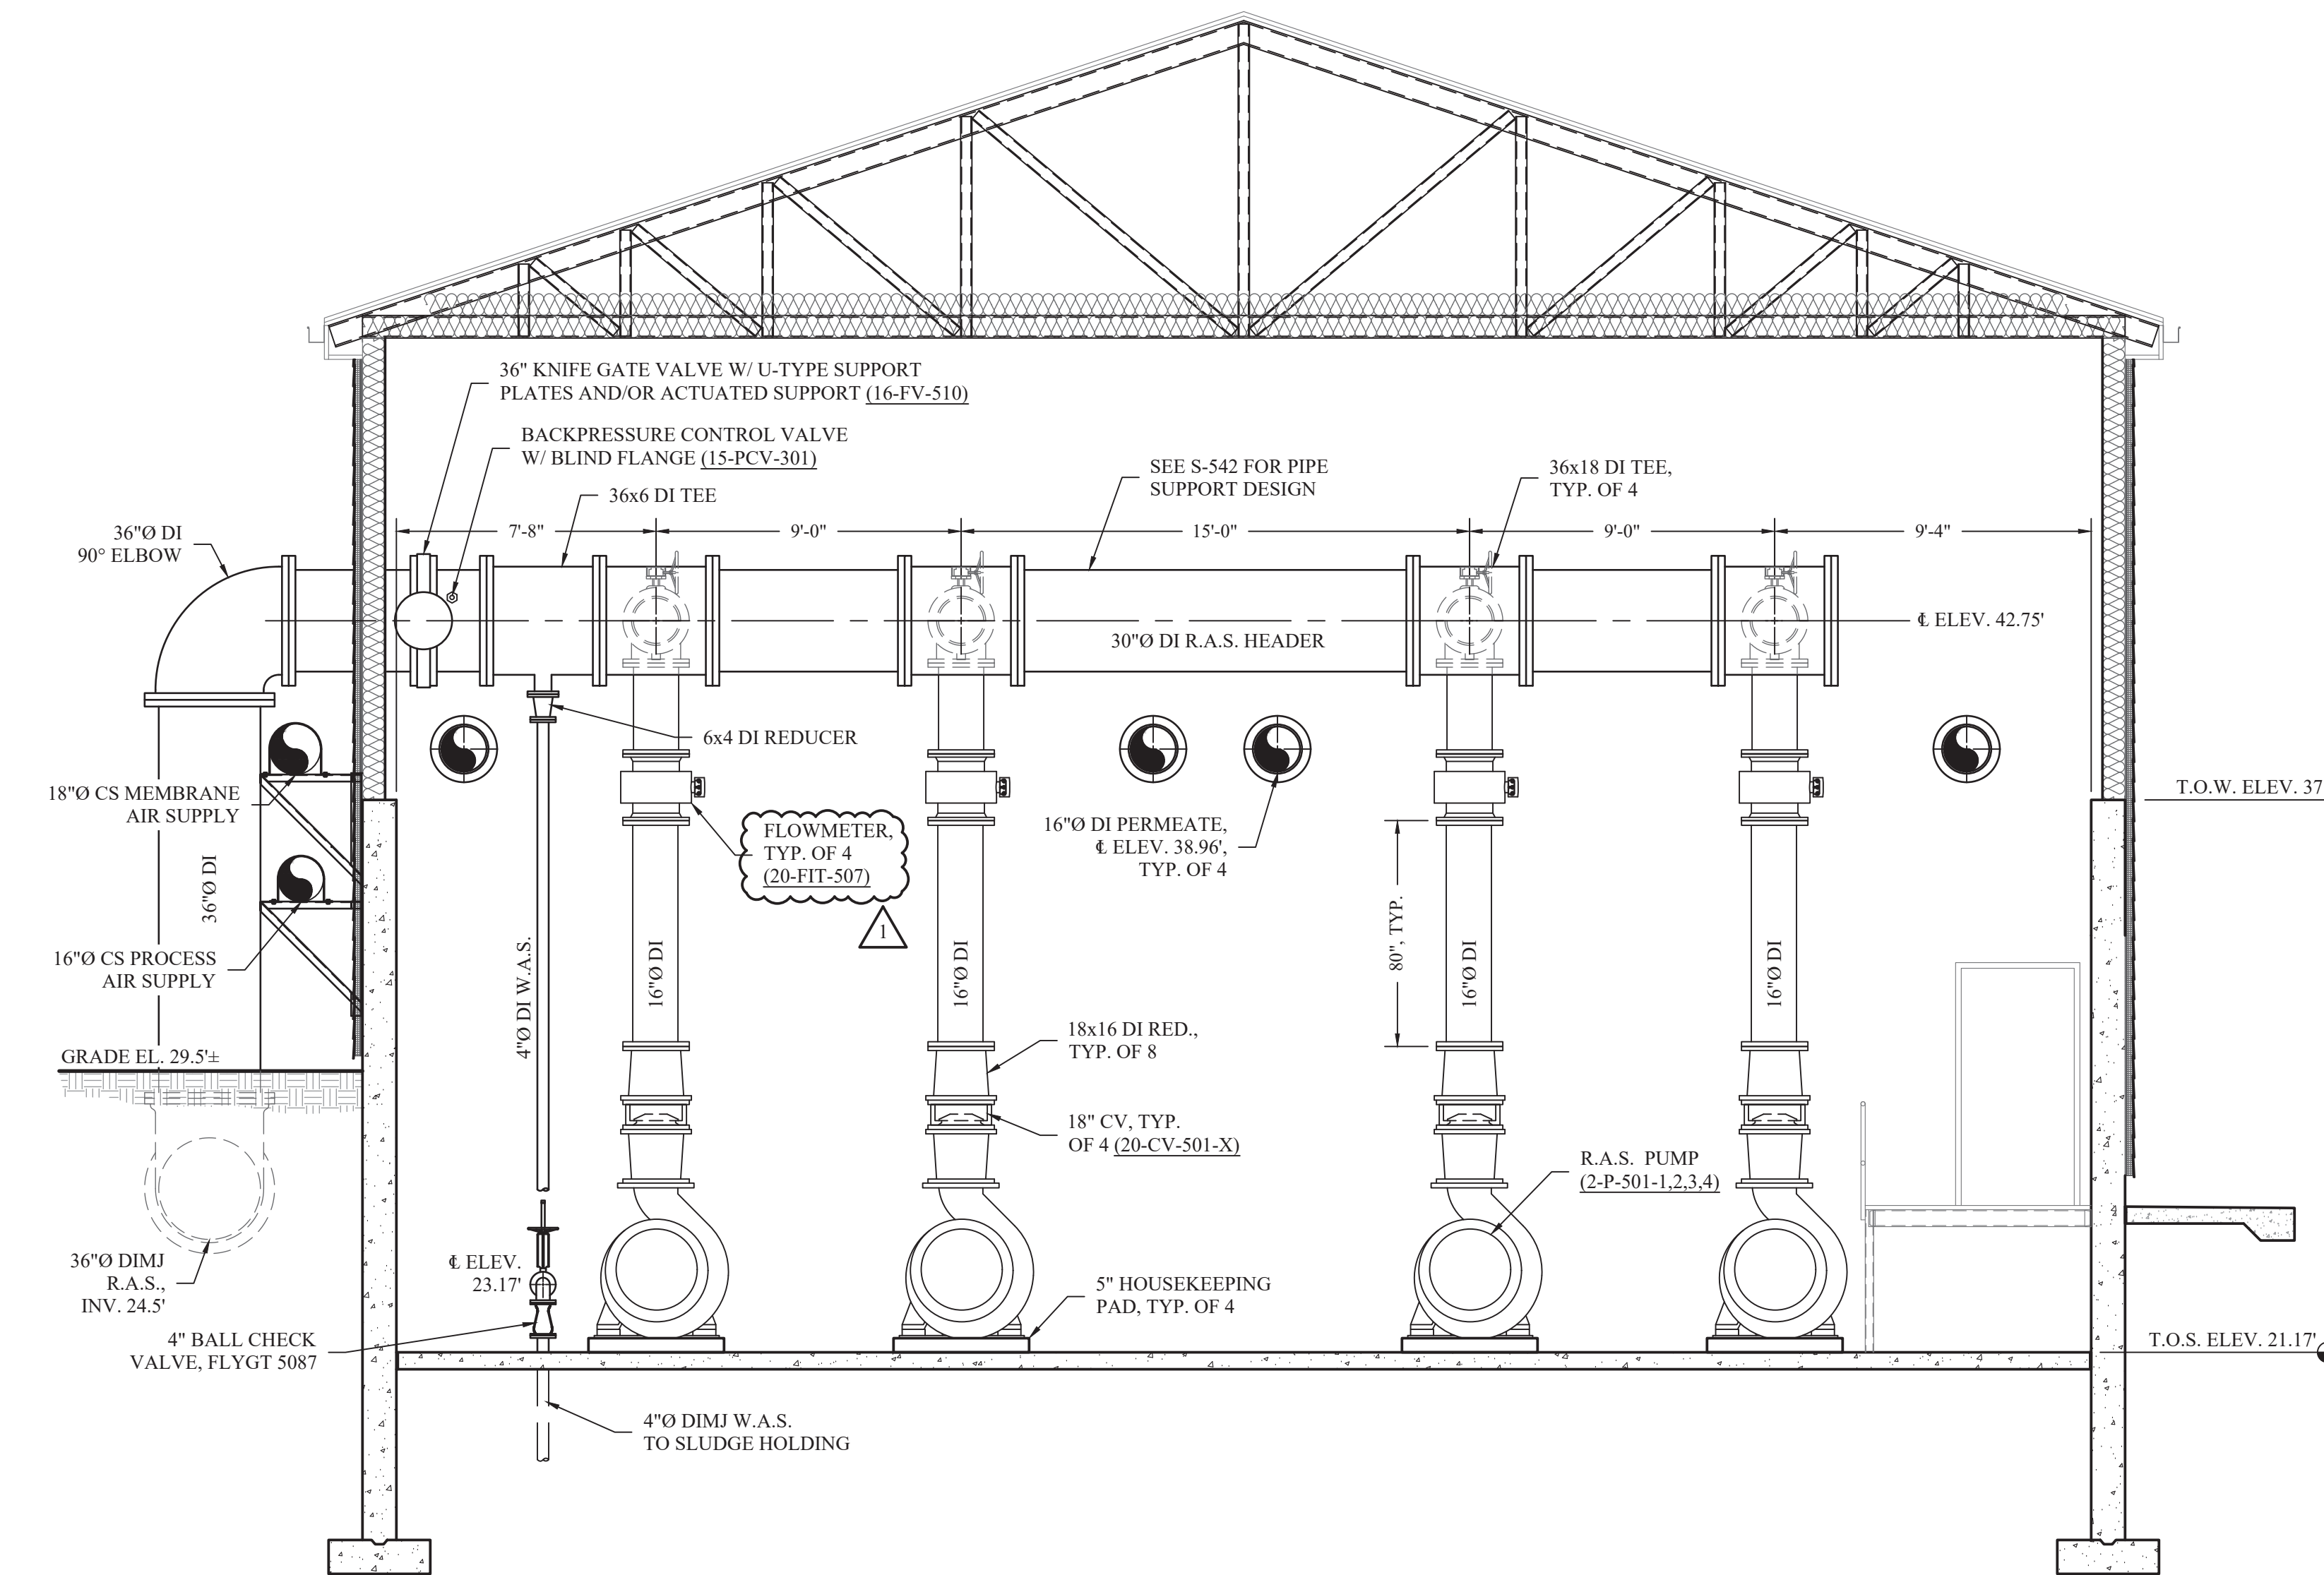

3 36\" R.A.S. PUMPS & PIPING HEADER ELEVATION
SCALE: 1/4" = 1'-0"

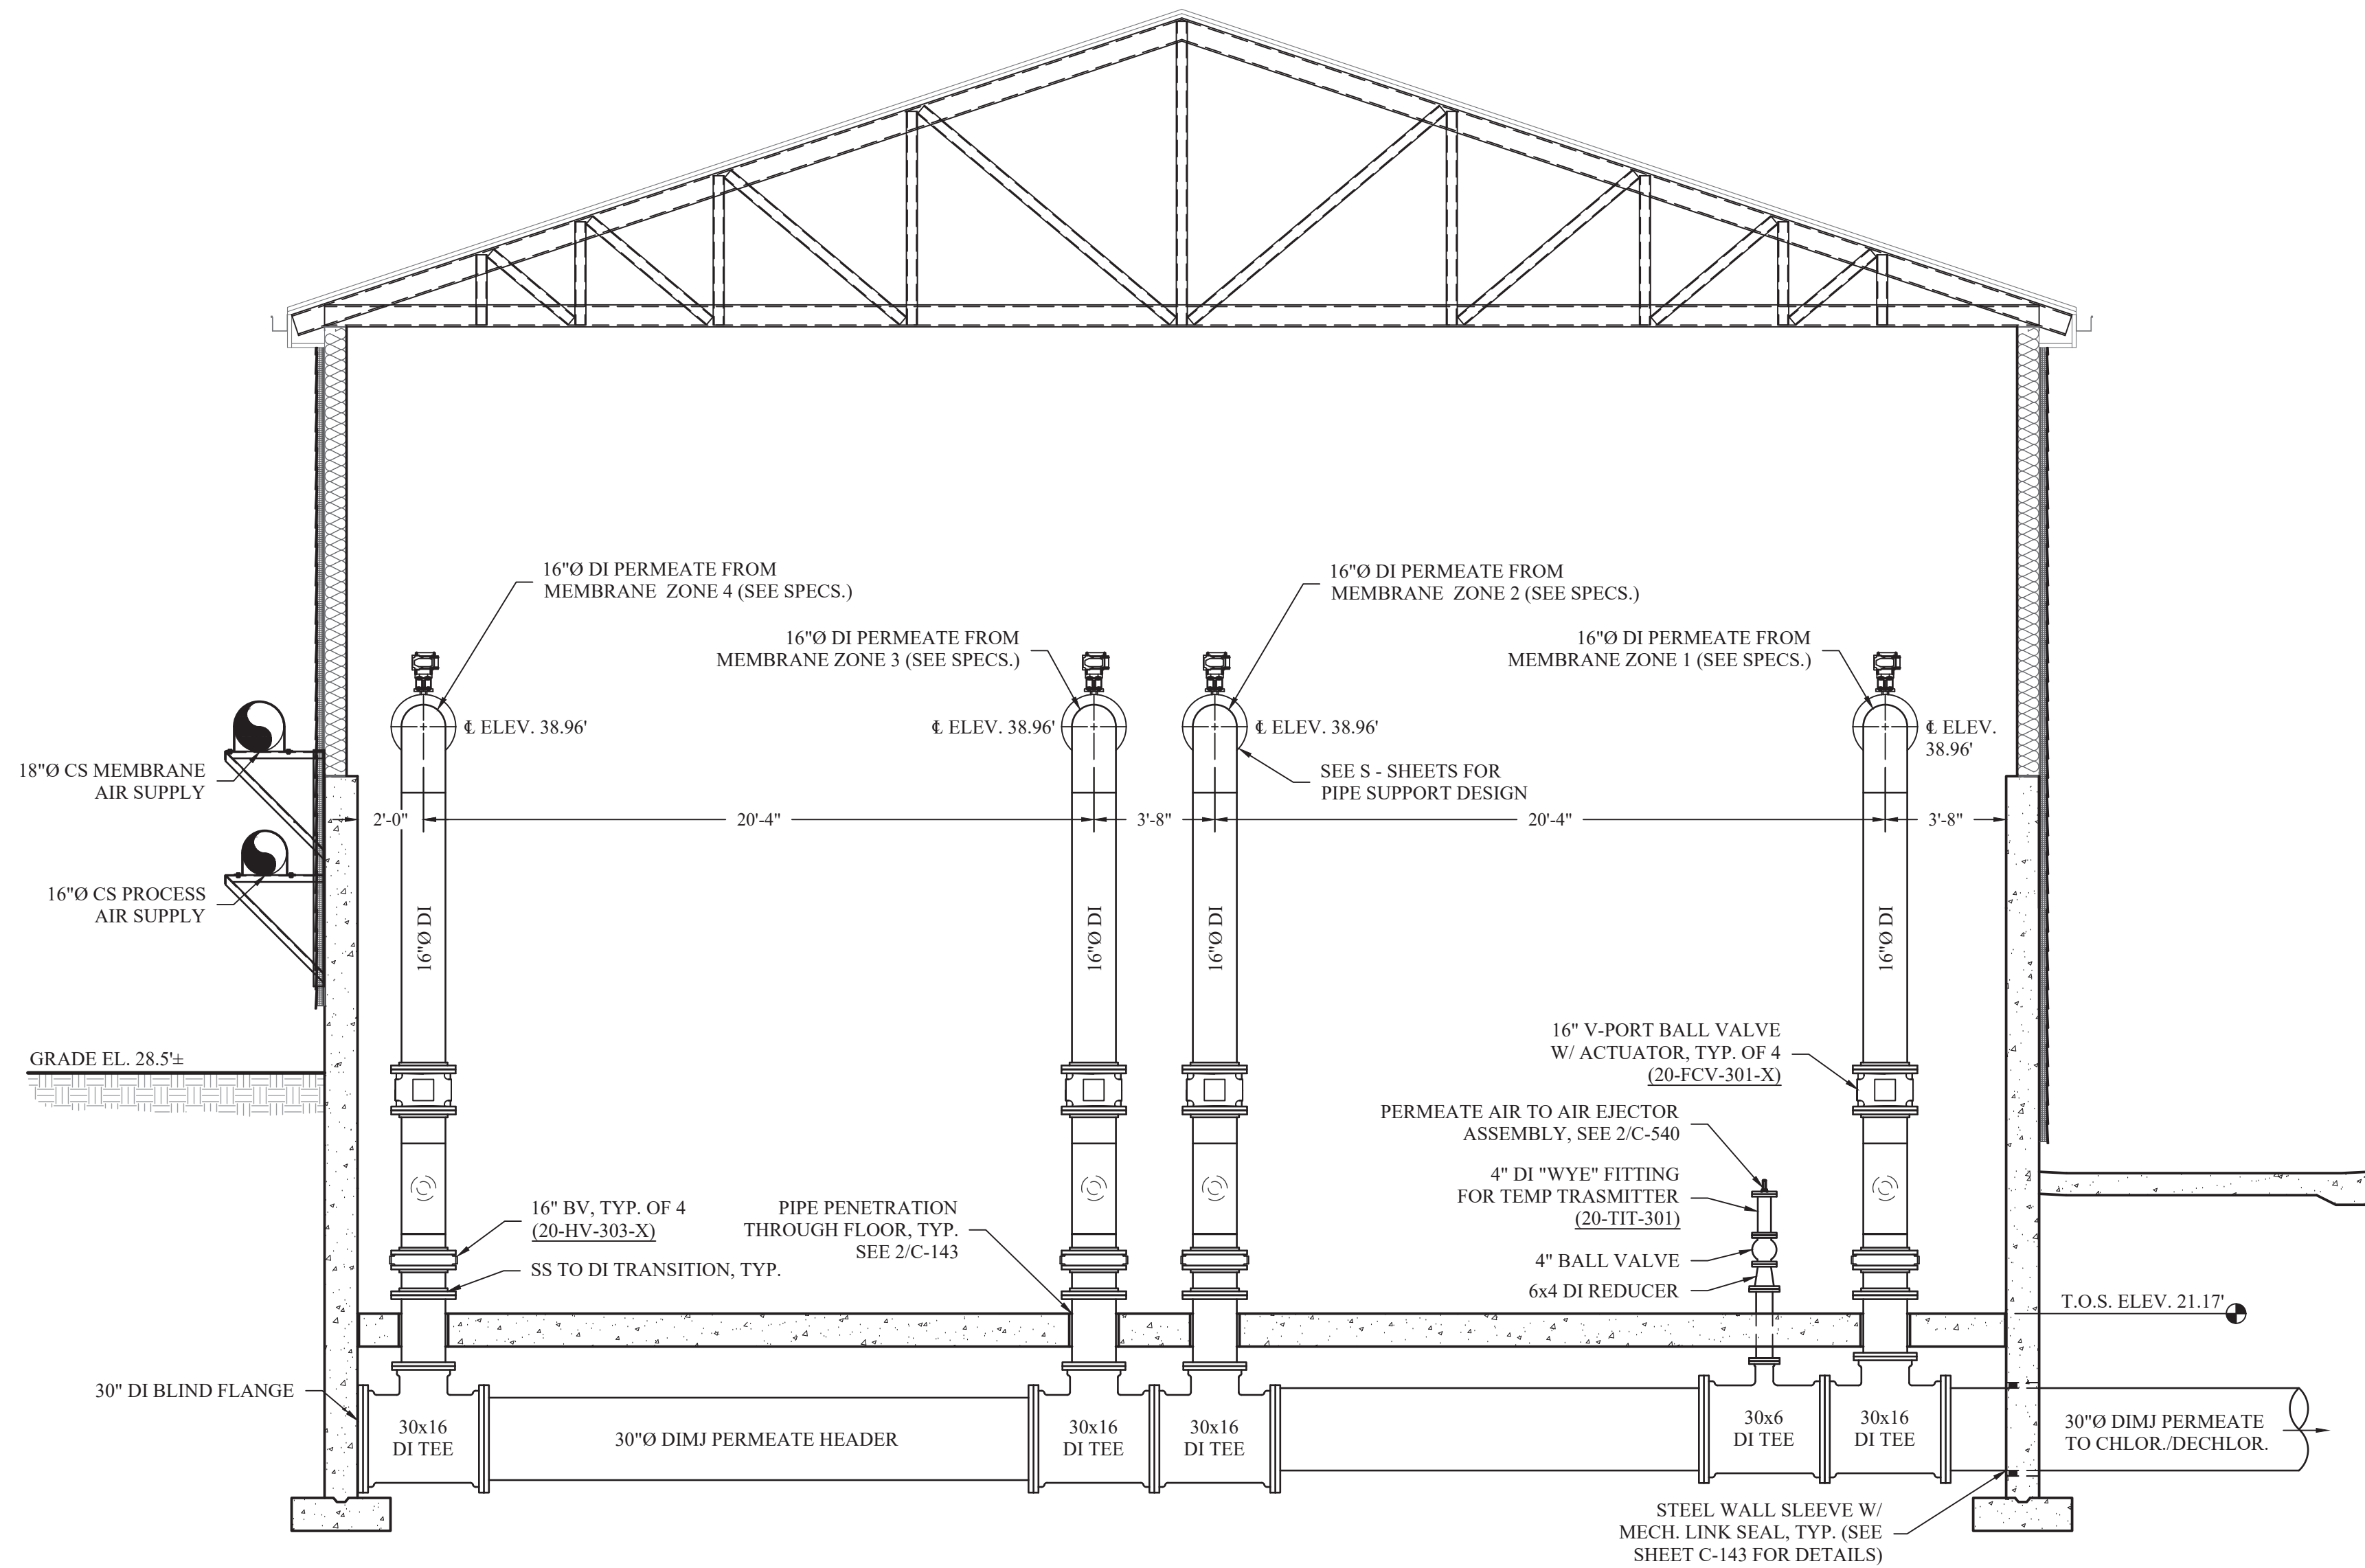

2 30\" PERMEATE PIPING ELEVATION
SCALE: 1/4" = 1'-0"

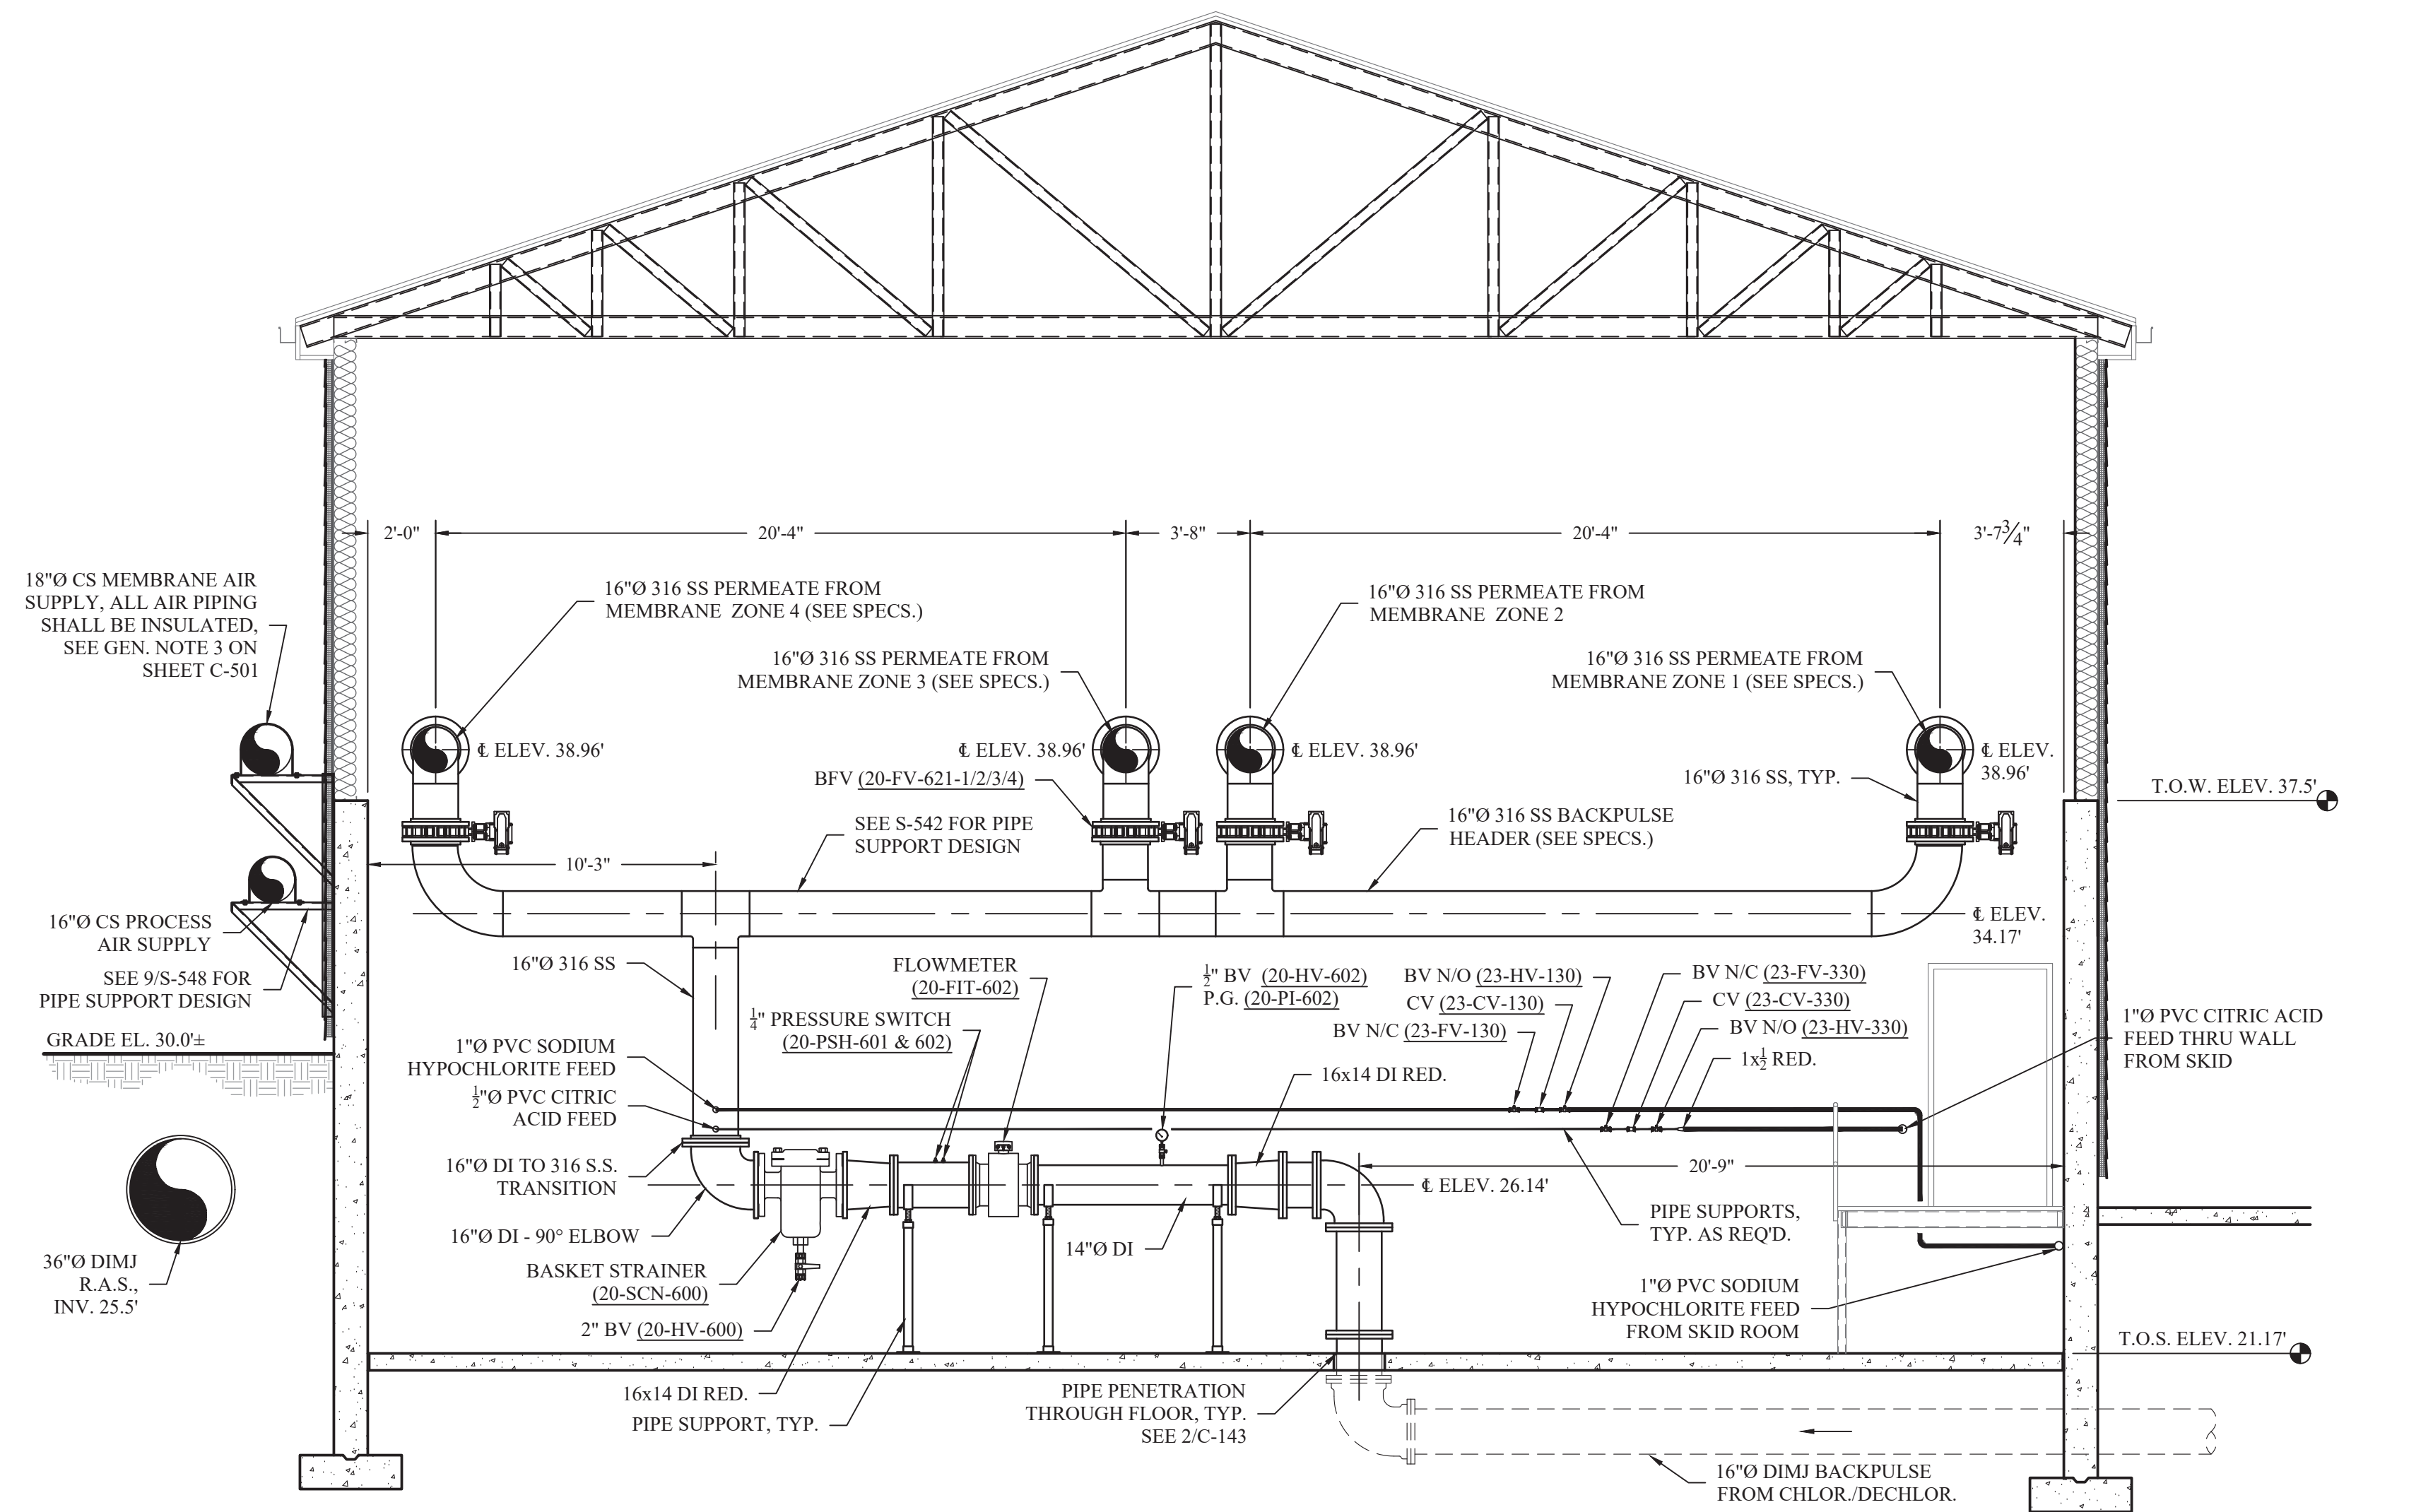

4 16\" BACKPULSE INFLUENT & HEADER ELEVATION
SCALE: 1/4" = 1'-0"

BID SET

HAZARDOUS MATERIAL NOTE:
THE SERVICES PROVIDED BY MHE, INCLUDING ALL WORK DEPICTED ON MHE PLANS, DO NOT INCLUDE SERVICES RELATED TO THE IDENTIFICATION, CONTROLS OR HANDLING OF HAZARDOUS MATERIALS, INCLUDING SUCH MATERIALS AS ASBESTOS AND LEAD PAINT. ALL TESTING, IDENTIFICATION, ABATEMENT, CONTROLS, AND HANDLING OF HAZARDOUS MATERIALS SHALL BE UNDERTAKEN BY A HAZARDOUS MATERIAL CONSULTANT AND CERTIFIED PROFESSIONALS. IF SUCH MATERIALS HAVE BEEN IDENTIFIED, CONTRACTOR WILL COMMUNICATE DIRECTLY WITH HAZARDOUS MATERIAL PROFESSIONAL FOR THE PERFORMANCE OF ANY WORK ON OR ADJACENT TO SAID MATERIALS. IF UNIDENTIFIED MATERIALS OF CONCERN ARE ENCOUNTERED WHILE UNDERTAKING THE WORK SHOWN HEREON, CONTRACTOR SHALL IMMEDIATELY NOTIFY ENGINEER AND OWNER, AND SHALL OBTAIN DIRECTION FROM THE HAZARDOUS MATERIAL CONSULTANT PRIOR TO THE CONTINUATION OF WORK INVOLVING SUSPECTED MATERIAL.



UNAUTHORIZED ADDITION OR ALTERATION OF THIS PLAN IS A VIOLATION OF SECTION 7209(2) OF THE NEW YORK STATE EDUCATION LAW.

ALL PRODUCTION & INTELLECTUAL PROPERTY RIGHT RESERVED ©

**CAESARS LANE WWTP
EXPANSION PROJECT:
PHASE 2**
145 CAESARS LN.
NEW WINDSOR, NY 12553
FOR TOWN OF NEW WINDSOR
555 UNION AVE.
NEW WINDSOR, NY 12553


POST AERATION
PROCESS PLAN

REVISIONS		
NO.	DESCRIPTION	DATE
1	ADDENDUM 2	06/20/25

ISSUED DATE:	18 APR. 2025
DESIGN BY:	JTW
DRAWN BY:	HPBJr
CHECKED BY:	MWW
REVIEWED BY:	MJS, JZ
SHEET NO.	

C-602

PROJECT # 18-732 PHASE #

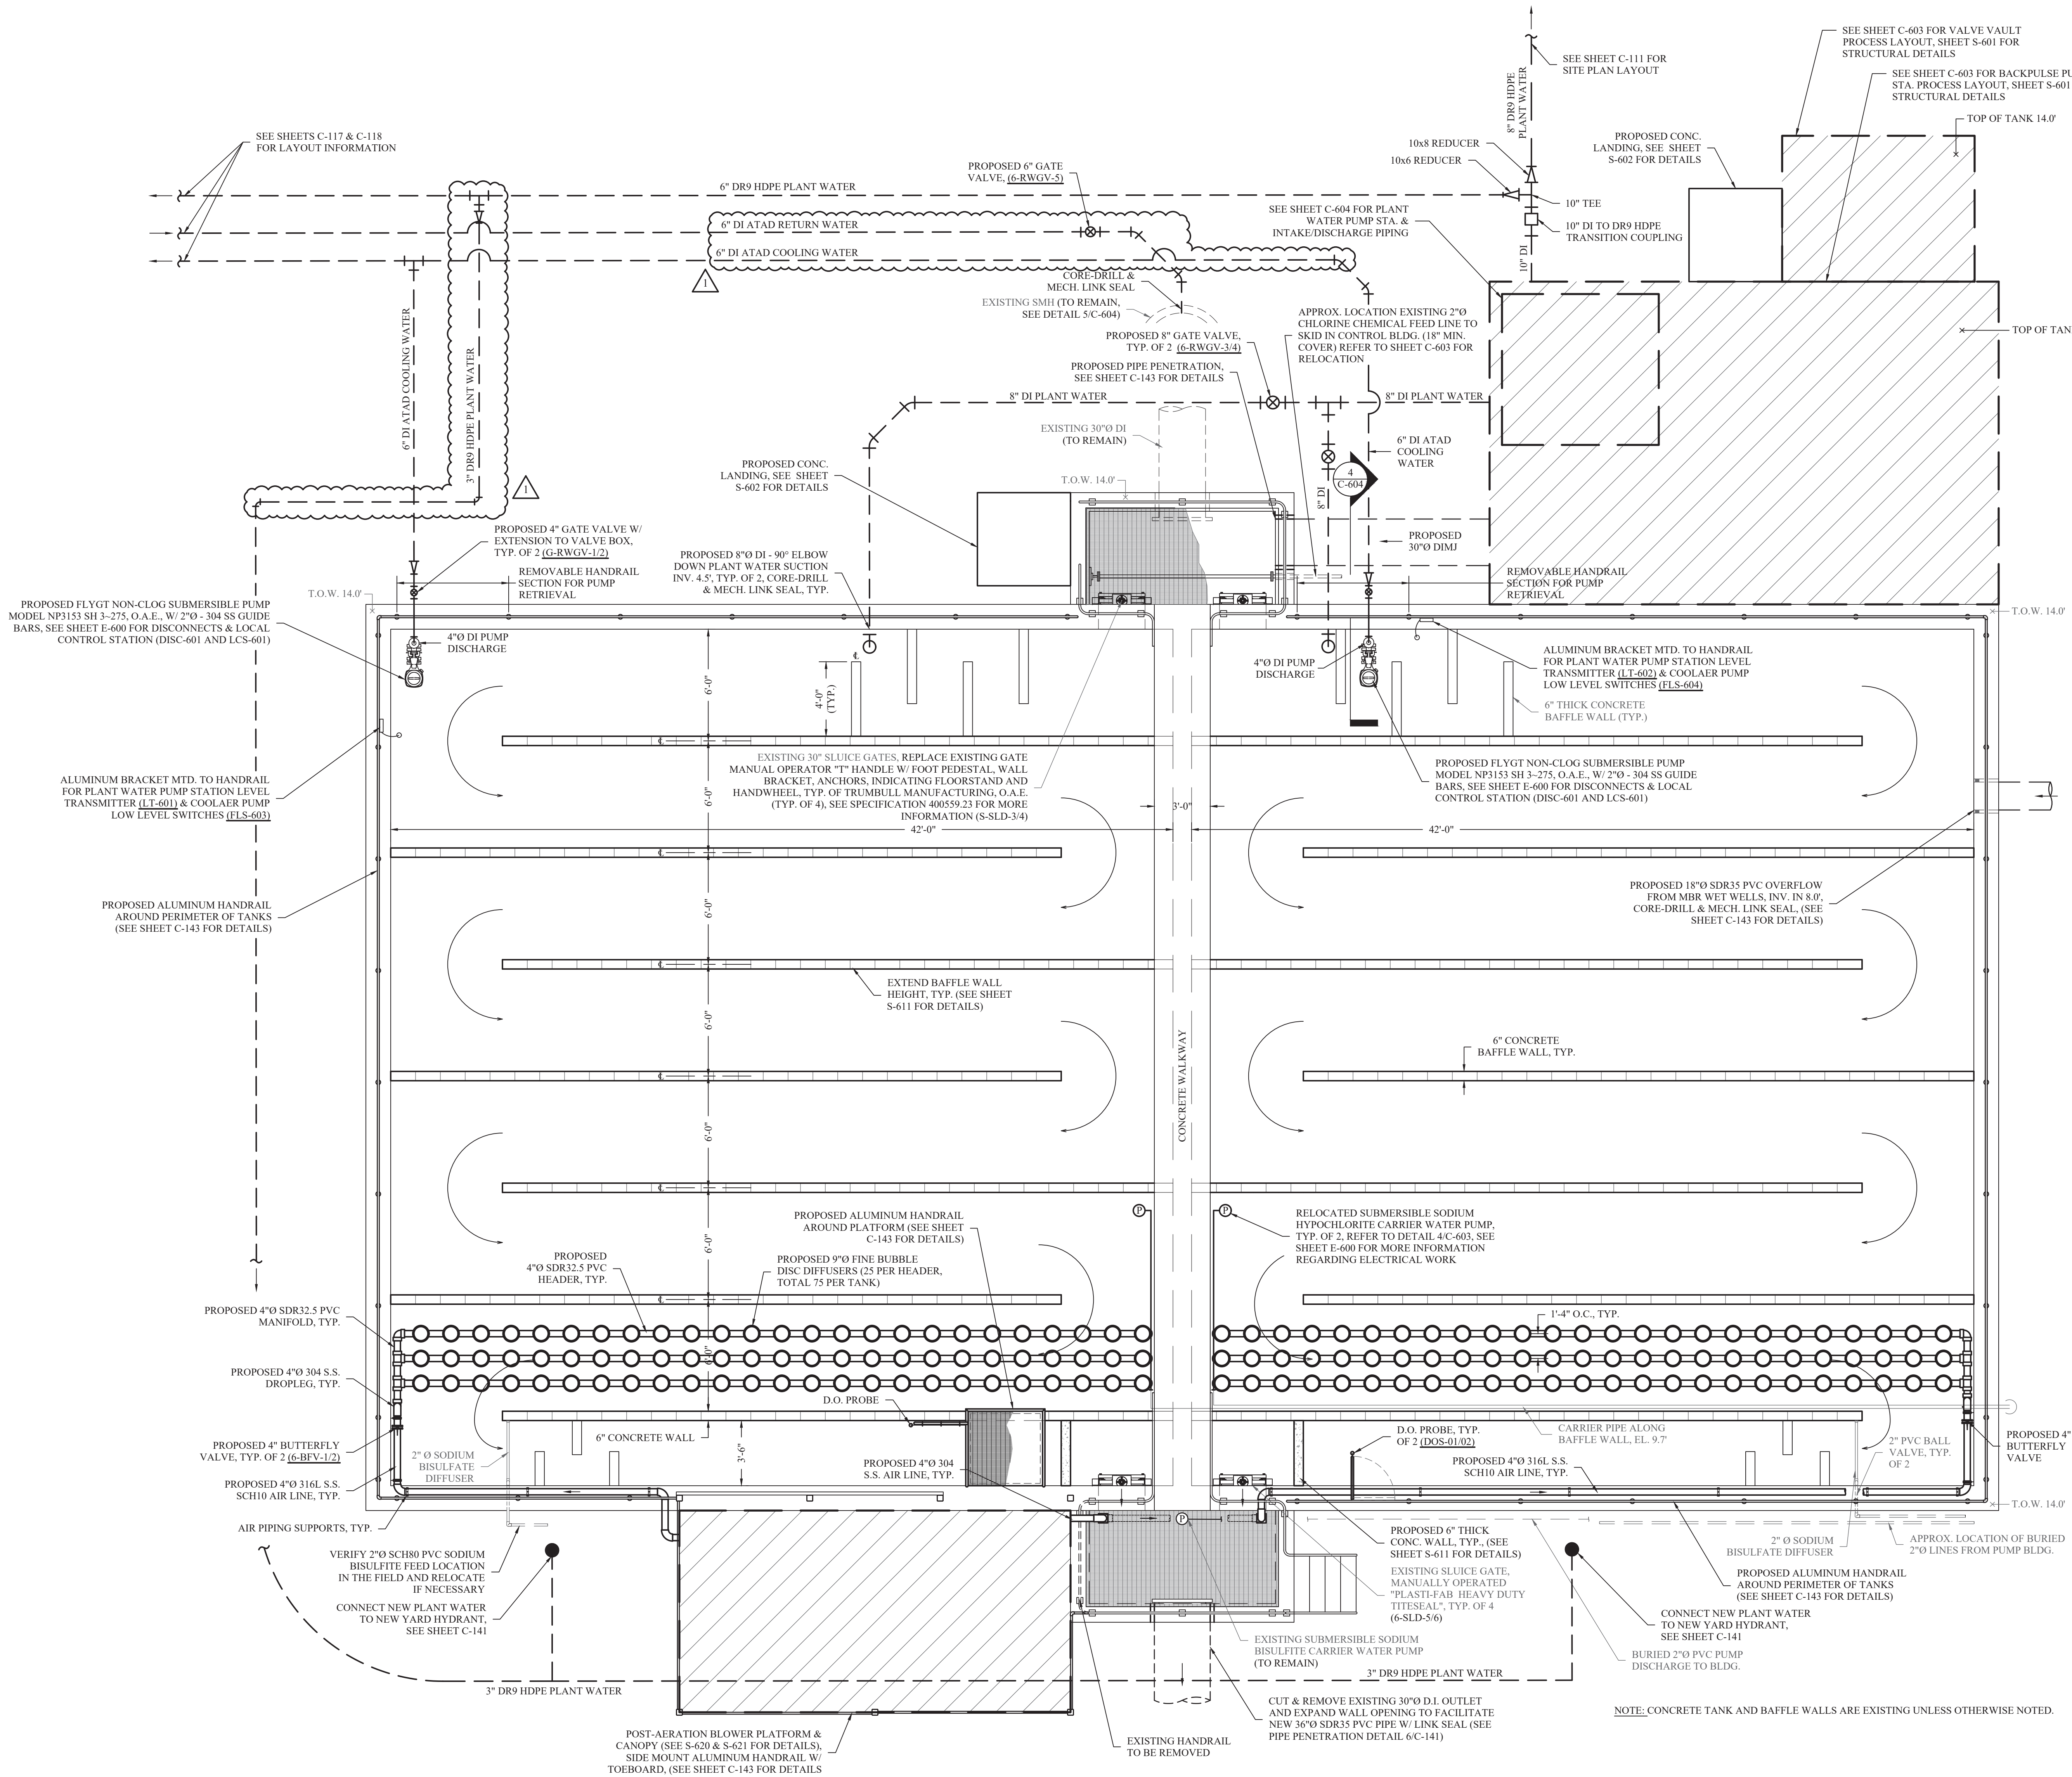

EXISTING DE-CHLORINATION
MODIFICATIONS PLAN FOR POST AERATION
A
C-602
SCALE: 1/4" = 1'-0"

BID SET

HAZARDOUS MATERIAL NOTE:
THE SERVICES PROVIDED BY MHE, INCLUDING ALL WORK DEPICTED ON MHE PLANS, DO NOT INCLUDE SERVICES RELATED TO THE IDENTIFICATION, CONTROLS OR HANDLING OF HAZARDOUS MATERIALS, INCLUDING SUCH MATERIALS AS ASBESTOS AND LEAD PAINT. ALL TESTING, IDENTIFICATION, ABATEMENT, CONTROLS, AND HANDLING OF HAZARDOUS MATERIALS SHALL BE UNDERTAKEN BY A HAZARDOUS MATERIAL CONSULTANT AND CERTIFIED PROFESSIONALS. IF SUCH MATERIALS HAVE BEEN IDENTIFIED, CONTRACTOR WILL COMMUNICATE DIRECTLY WITH HAZARDOUS MATERIAL PROFESSIONAL FOR THE PERFORMANCE OF ANY WORK ON OR ADJACENT TO SAID MATERIALS. IF UNIDENTIFIED MATERIALS OF CONCERN ARE ENCOUNTERED WHILE UNDERTAKING THE WORK SHOWN HEREON, CONTRACTOR SHALL IMMEDIATELY NOTIFY ENGINEER AND OWNER, AND SHALL OBTAIN DIRECTION FROM THE HAZARDOUS MATERIAL CONSULTANT PRIOR TO THE CONTINUATION OF WORK INVOLVING SUSPECTED MATERIAL.



UNAUTHORIZED ADDITION OR ALTERATION OF THIS PLAN IS A VIOLATION OF SECTION 7209(2) OF THE NEW YORK STATE EDUCATION LAW.

ALL PRODUCTION & INTELLECTUAL PROPERTY RIGHT RESERVED ©

**CAESARS LANE WWTP
EXPANSION PROJECT:
PHASE 2**
145 CAESARS LN.
NEW WINDSOR, NY 12553
FOR TOWN OF NEW WINDSOR
555 UNION AVE.
NEW WINDSOR, NY 12553

**TYPICAL EXISTING
SECONDARY
SETTLING TANK
DEMOLITION PLAN**


REVISIONS		
NO.	DESCRIPTION	DATE
1	ADDENDUM 2	06/20/25

ISSUED DATE: 18 APR. 2025
DESIGN BY: JTW
DRAWN BY: HPBjh
CHECKED BY: MWW
REVIEWED BY: MJS, JZ

SHEET NO.

CD-801


PROJECT # 18-732 PHASE #

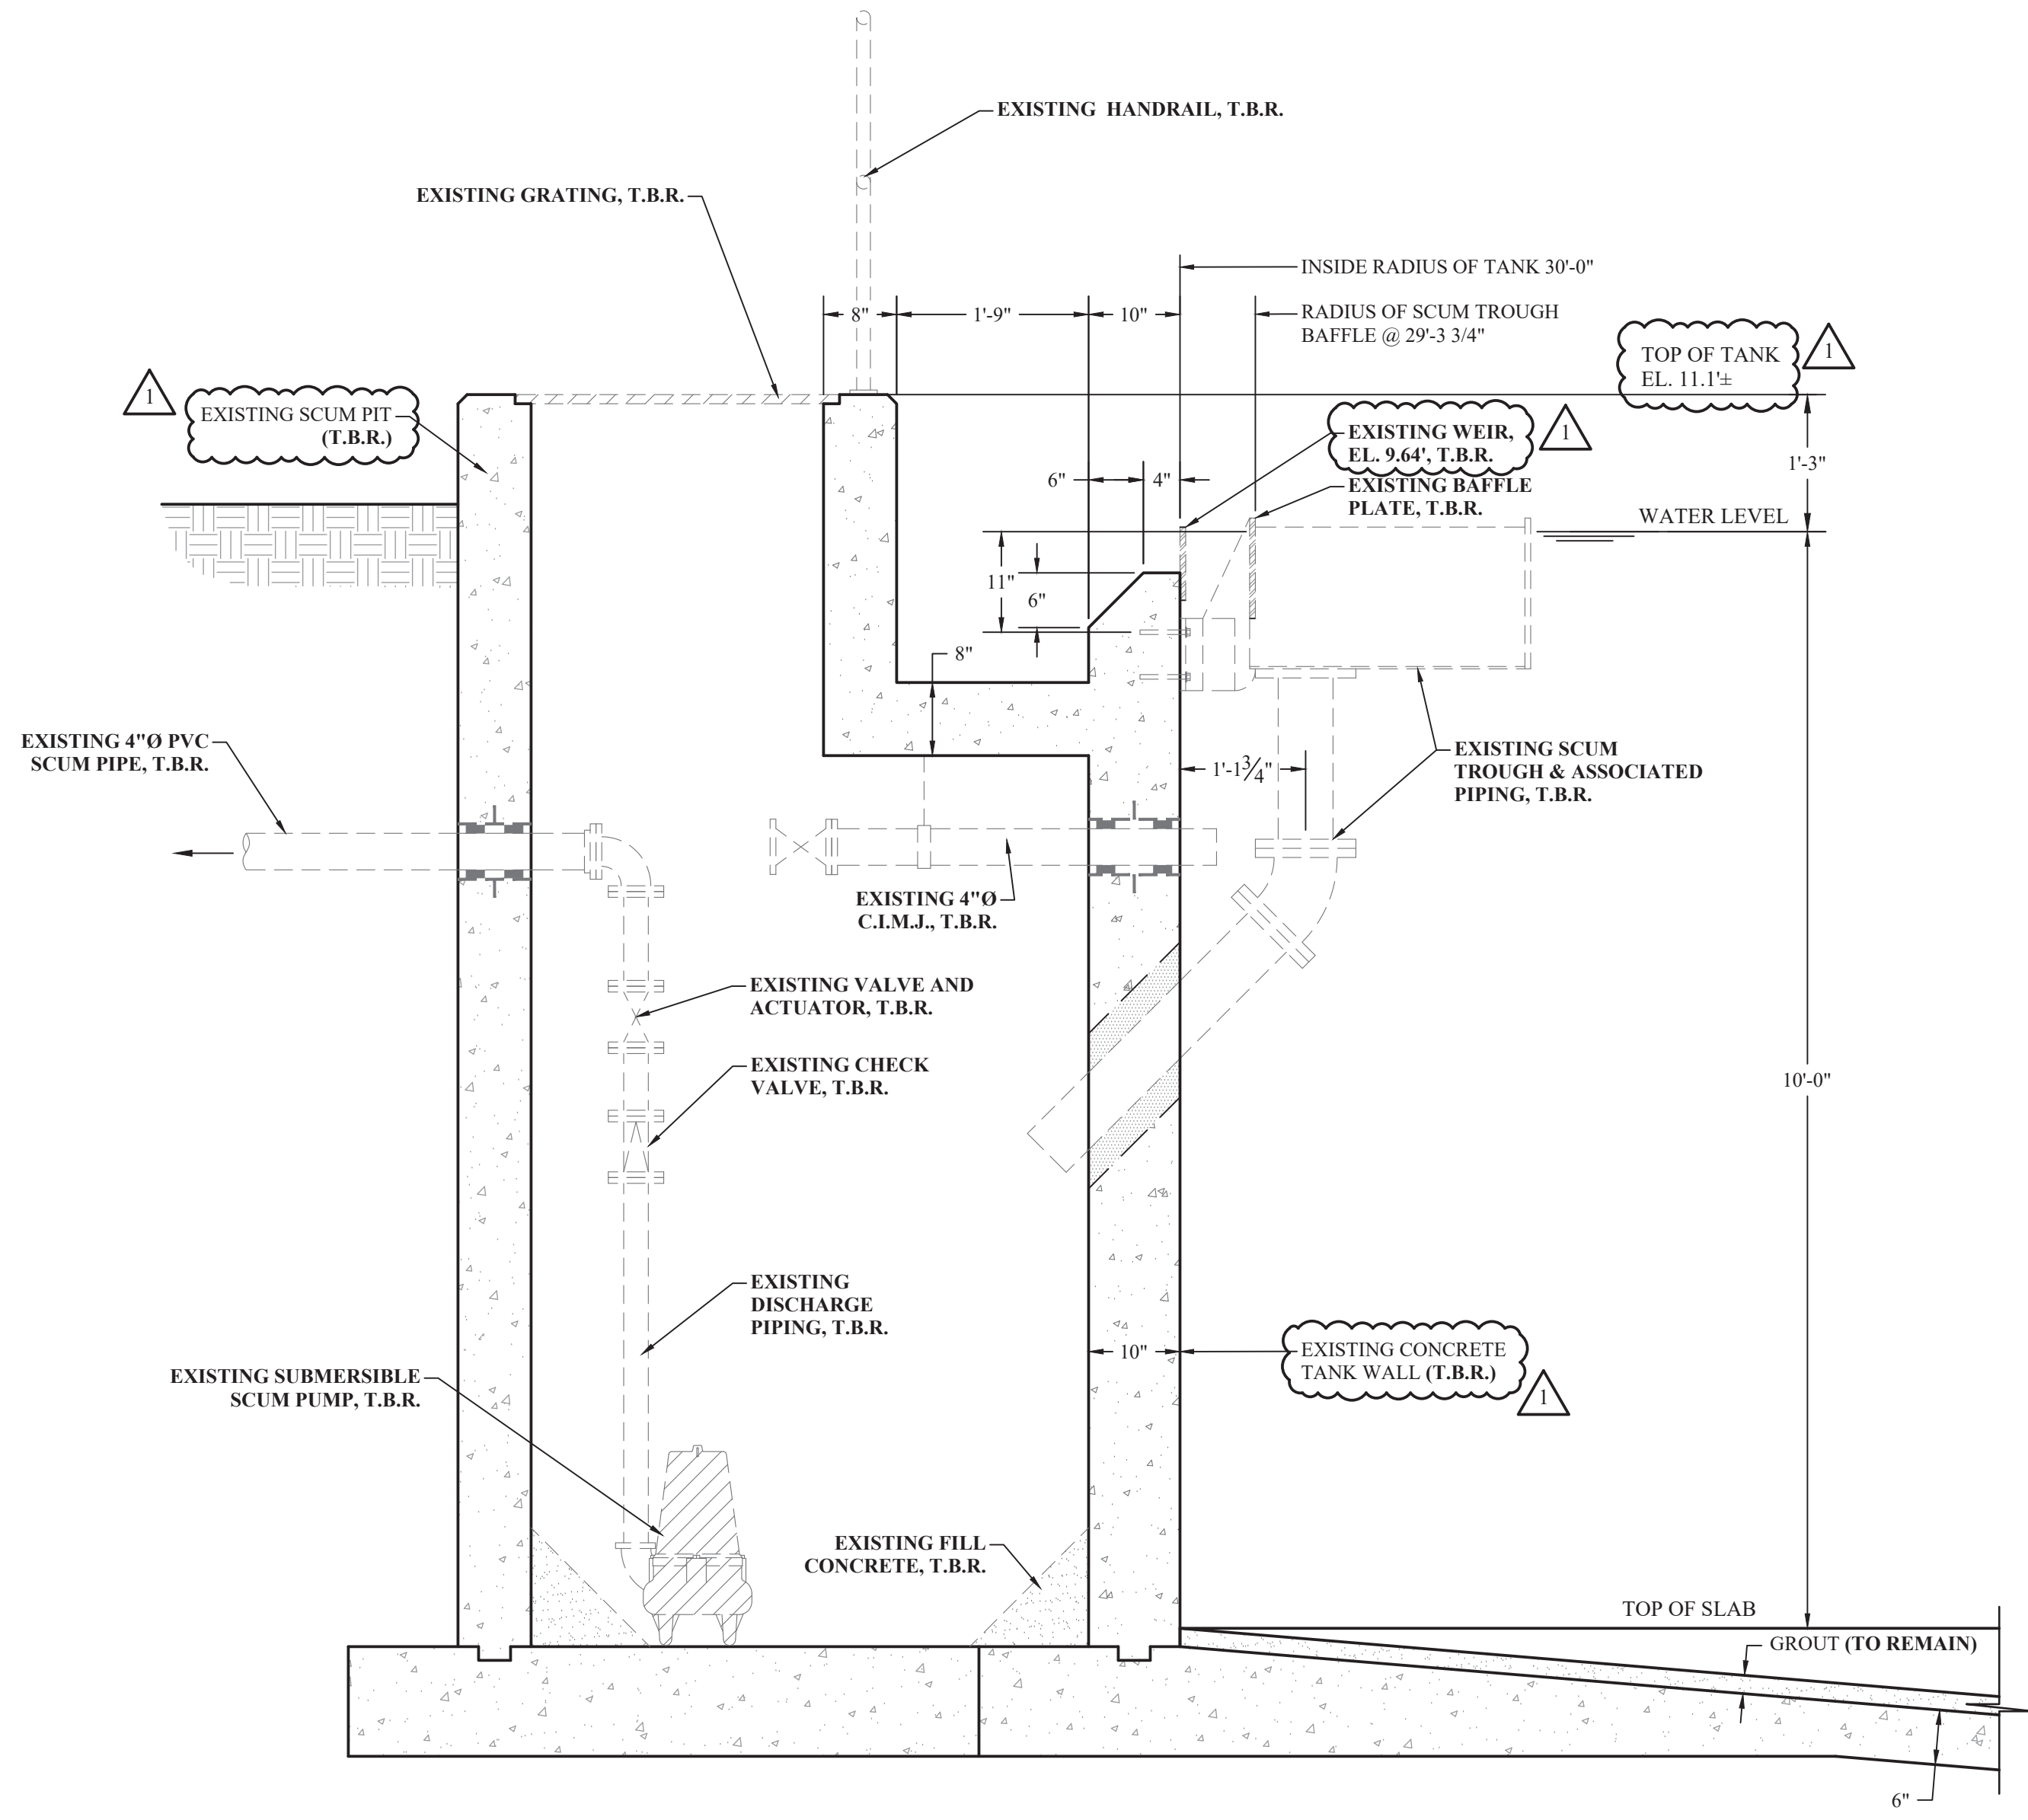


2
CD-801
TYPICAL SECONDARY SETTLING TANK DEMOLITION SECTION THRU SCUM PIT & TROUGH
SCALE: 3/4\"/>

NOTES:

1. ENTIRE STRUCTURE INCLUDING EQUIPMENT, PIPING, CONCRETE, ETC. TO BE REMOVED IN FULL TO TOP OF EXISTING SLAB (T.O.S.) AT APPROXIMATELY ELEVATION 0.0'.
2. DEMOLITION PLAN IS TYPICAL OF SECONDARY SETTLING TANKS 1 AND 2.
3. REFER TO SITE PLAN FOR ACTUAL PIPING, EFFLUENT TROUGH AND SCUM PIT ORIENTATION.
4. AFTER DEMOLITION IS COMPLETE, BACKFILL WITH ACCEPTED STRUCTURAL BACKFILL MATERIAL INSTALLED IN COMPACTED LIFTS IN ACCORDANCE WITH STRUCTURAL EXCAVATION, BACKFILL AND COMPACTION SPECIFICATION.
5. ALL ITEMS NOTED AS TO BE REMOVED, OR "T.B.R." SHALL BE COMPLETELY REMOVED BY THE CONTRACTOR AND PROPERLY DISPOSED OF. DISPOSAL MANIFESTS SHALL BE PROVIDED TO THE OWNER.
6. CONTENTS OF EXISTING SETTLING TANKS MAY BE DISPOSED OF BY PUMPING TO THE INFLUENT STRUCTURE ON THE GRAVITY THICKENERS AS COORDINATED WITH THE PLANT OPERATOR.
7. ALL POWER AND CONTROL WIRING AT THE SECONDARY SETTLING TANKS, INCLUDING CONDUIT SHALL BE REMOVED AND PROPERLY DISPOSED OF.
8. EXISTING BURIED PIPING NOT REMOVED SHALL BE FILLED WITH NON-SHRINK GROUT.

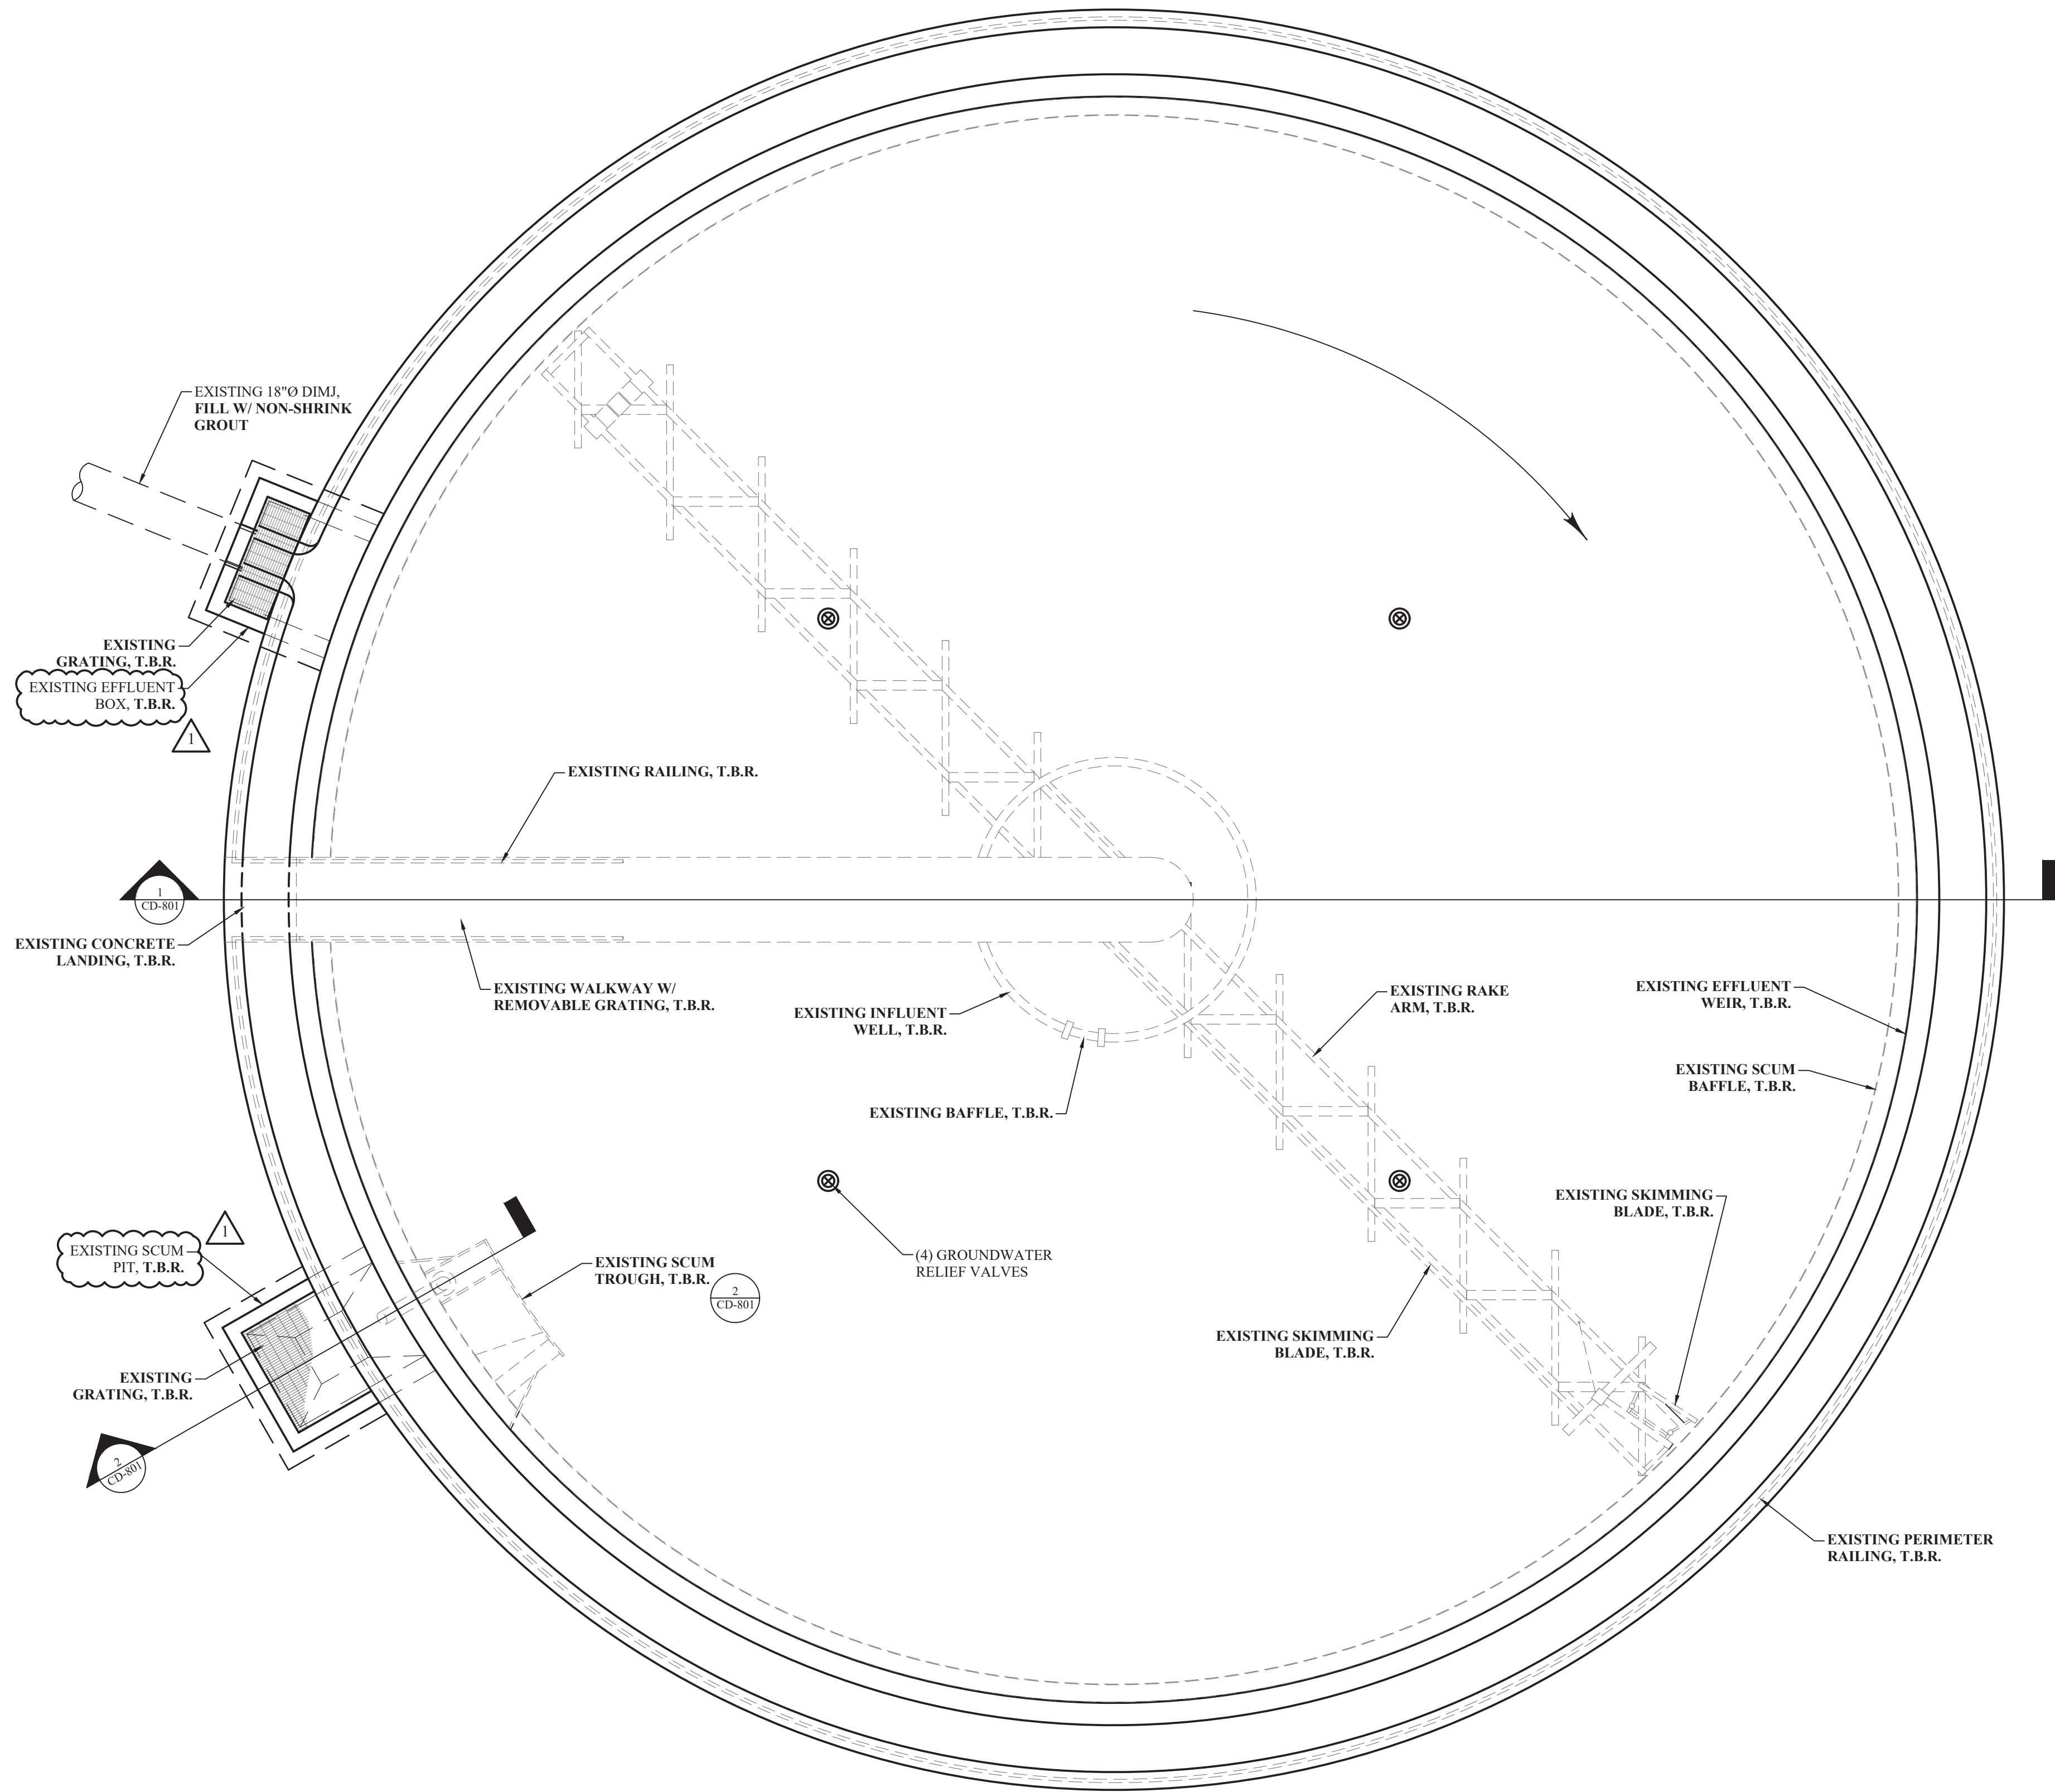

1
CD-801
TYPICAL SECONDARY SETTLING TANK DEMOLITION PLAN
SCALE: 1/4\"/>

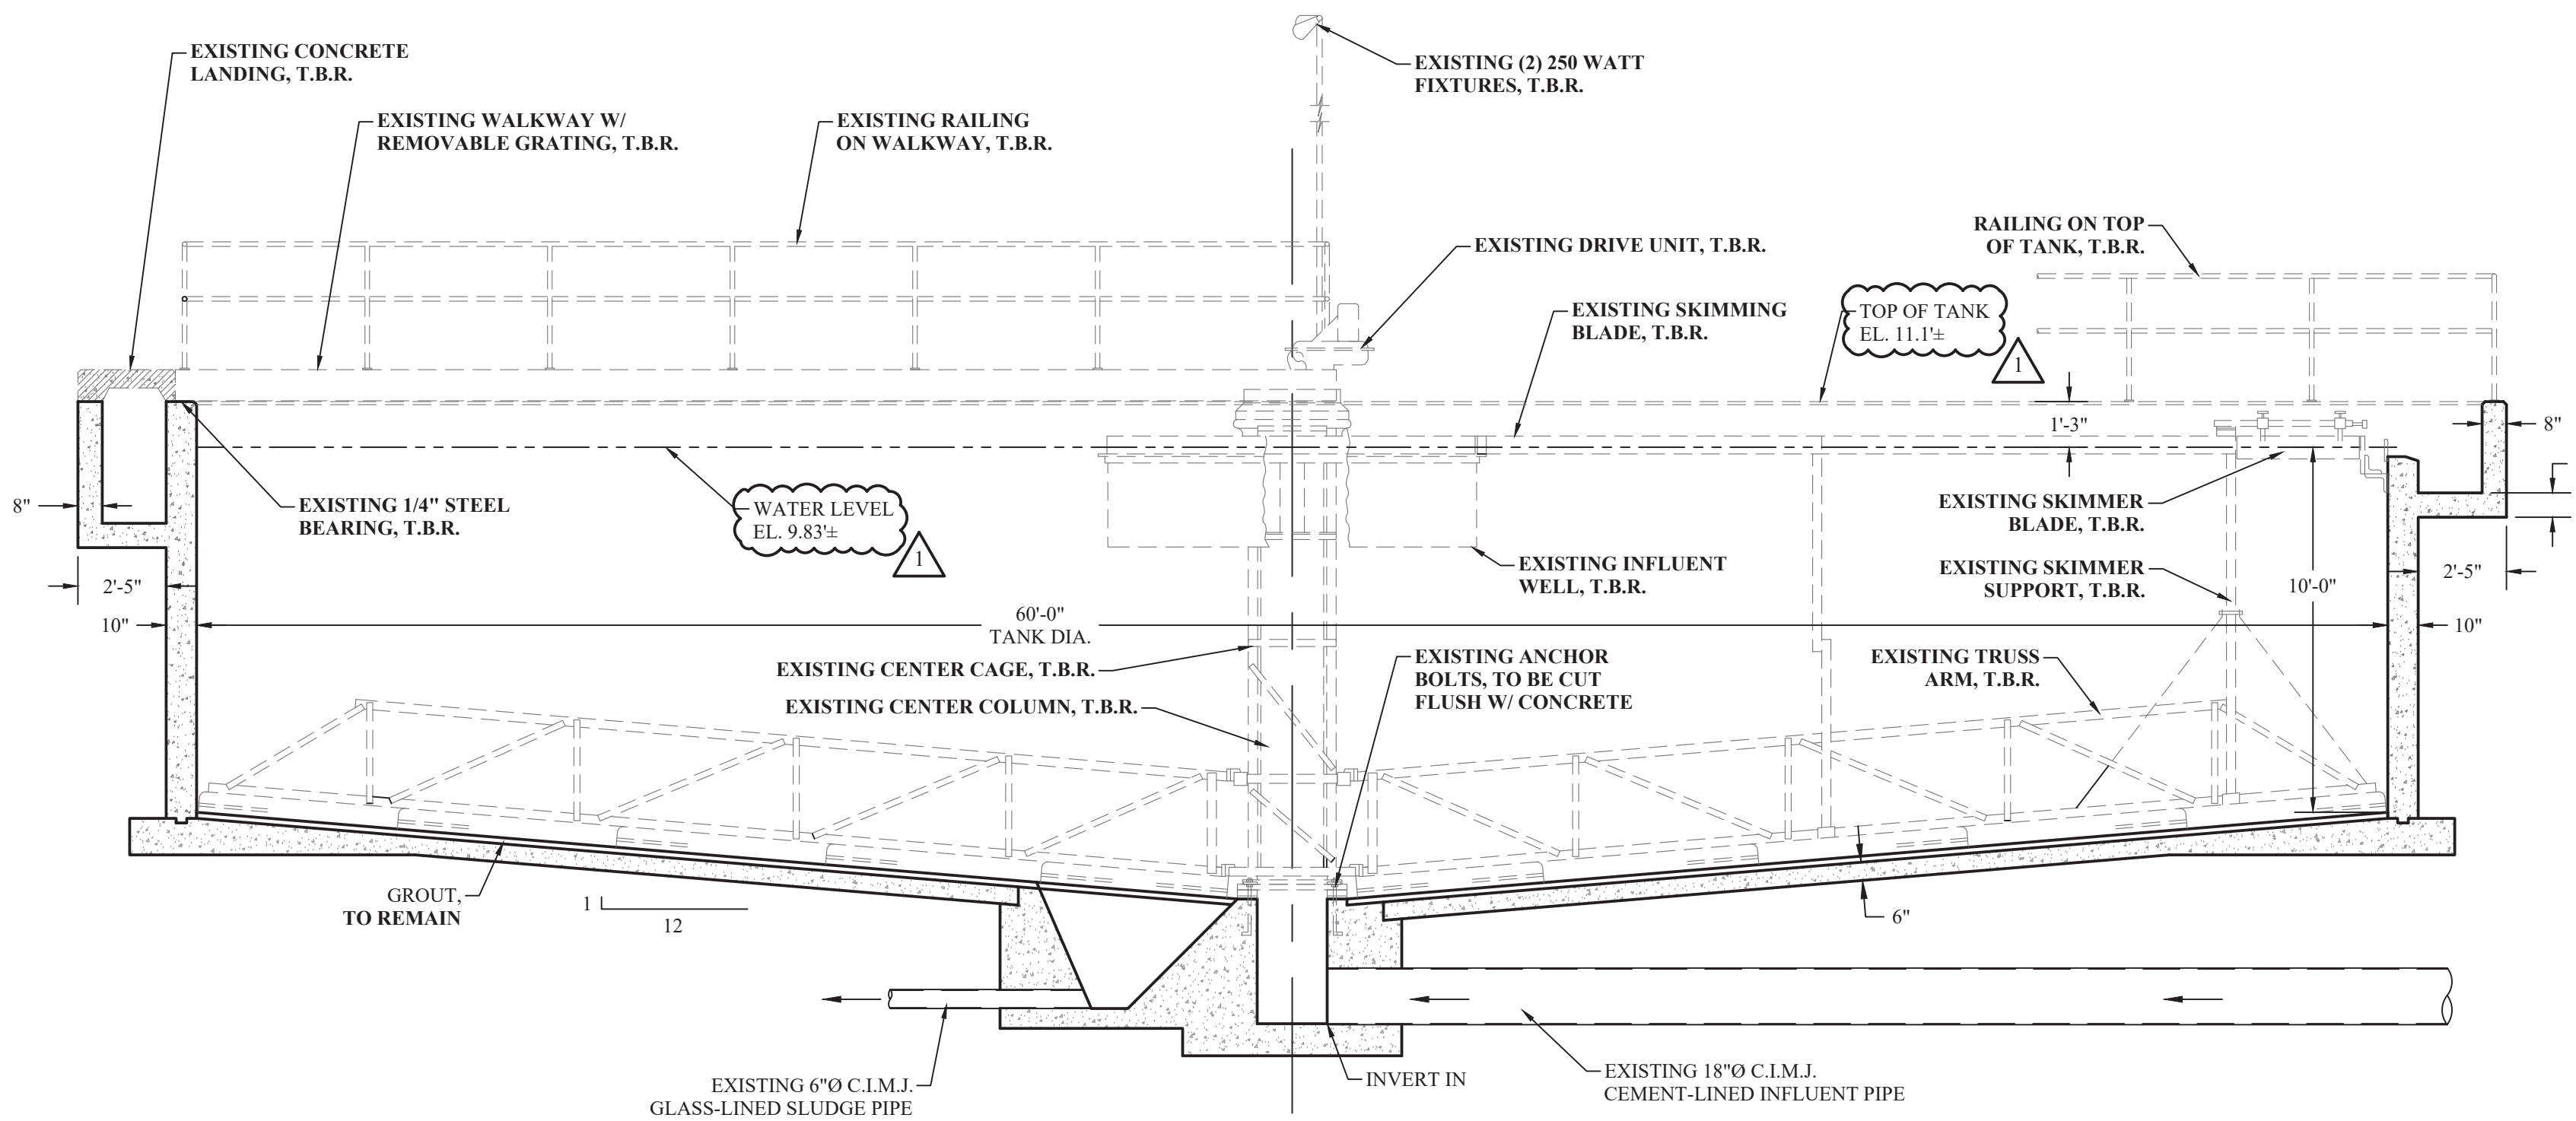

3
CD-801
TYPICAL SECONDARY SETTLING TANK DEMOLITION ELEVATION - SECTION
SCALE: 1/4\"/>

Addendum #2

SPECIFICATIONS TABLE OF CONTENTS

Division	Section Title
----------	---------------

SPECIFICATIONS GROUP

General Requirements Subgroup

DIVISION 01 - GENERAL REQUIREMENTS

011000	SUMMARY
013000	ADMINISTRATIVE REQUIREMENTS
013100	PROJECT MANAGEMENT AND COORDINATION
013233	PHOTOGRAPHIC DOCUMENTATION
013300	SUBMITTAL PROCEDURES
014000	QUALITY REQUIREMENTS
014535	CODE-REQUIRED SPECIAL INSPECTIONS AND PROCEDURES (NY)
015000	TEMPORARY FACILITIES AND CONTROLS
015500	MAINTENANCE AND PROTECTION OF TRAFFIC
015800	NEW YORK STATE ENVIRONMENTAL FACILITIES CORPORATION FINANCING SIGNAGE
016000	PRODUCT REQUIREMENTS
017300	EXECUTION
017419	CONSTRUCTION WASTE MANAGEMENT AND DISPOSAL
017700	CLOSEOUT PROCEDURES
017823	OPERATION AND MAINTENANCE DATA
017839	PROJECT RECORD DOCUMENTS
017900	DEMONSTRATION AND TRAINING

Facility Construction Subgroup

DIVISION 02 – EXISTING CONDITIONS

024116	STRUCTURE DEMOLITION
024119	SELECTIVE DEMOLITION

DIVISION 03 – CONCRETE

030130	MAINTENANCE OF CAST-IN-PLACE CONCRETE
031000	CONCRETE FORMING AND ACCESSORIES
032000	CONCRETE REINFORCING
033000	CAST-IN-PLACE CONCRETE
033110	CONTROLLED DENSITY FILL
034100	PRECAST STRUCTURAL CONCRETE
034110	PRESTRESSED HOLLOW-CORE PLANK
035300	CONCRETE TOPPING

Addendum #2

036200 GROUT

DIVISION 04 - MASONRY

040110 MASONRY CLEANING
040120.64 BRICK AND UNIT MASONRY REPOINTING
042000 UNIT MASONRY
042613 MASONRY VENEER

DIVISION 05 – METALS

051200 STRUCTURAL STEEL
052100 STEEL JOIST FRAMING
053100 STEEL DECKING
054000 COLD-FORMED METAL FRAMING
054400 COLD-FORMED METAL TRUSSES
055000 METAL FABRICATIONS
055119 METAL GRATING STAIRS
055210 ALUMINUM HANDRAILS
055213 PIPE AND TUBE RAILINGS
055901 STANDARD-DUTY ALUMINUM INTERLOCKING FLAT PANEL TANK COVER
055902 HEAVY DUTY ALUMINUM TANK COVERS

DIVISION 06 – WOOD, PLASTICS AND COMPOSITES

061000 ROUGH CARPENTRY
061600 SHEATHING
062023 INTERIOR FINISH CARPENTRY
064113 WOOD-VENEER-FACED ARCHITECTURAL CABINETS
066400 PLASTIC PANELING

DIVISION 07 - THERMAL AND MOISTURE PROTECTION

071616 CRYSTALLINE WATERPROOFING
072100 THERMAL INSULATION
072119 FOAMED-IN-PLACE INSULATION
072500 WEATHER BARRIERS
074113.16 STANDING-SEAM METAL ROOF PANELS
074213.13 FORMED METAL WALL PANELS
074293 SOFFIT PANELS
074646 FIBER-CEMENT SIDING
075323 ETHYLENE-PROPYLENE-DIENE-MONOMER
076200 SHEET METAL FLASHING AND TRIM
077100 ROOF SPECIALTIES
077200 ROOF ACCESSORIES
077253 SNOW GUARDS

Addendum #2

078413	PENETRATION FIRESTOPPING
079100	PERFORMED JOINT SEALS
079200	JOINT SEALANTS

DIVISION 08 - OPENINGS

081113	HOLLOW METAL DOORS AND FRAMES
081416	FLUSH WOOD DOORS
081613	FIBERGLASS DOORS AND FRAMES
083113	ACCESS DOORS AND FRAMES
083323	OVERHEAD COILING DOORS
083613	SECTIONAL DOORS
084113	ALUMINUM-FRAMED ENTRANCES AND STOREFRONTS
085113	ALUMINUM WINDOWS
087100	DOOR HARDWARE
088000	GLAZING
088113.1	DECORATIVE GLAZING FILM
089119	FIXED LOUVERS

DIVISION 09 - FINISHES

092900	GYPSUM BOARD
093013	CERAMIC TILING
095123	ACOUSTICAL TILE CEILINGS
096513	RESILIENT BASE AND ACCESSORIES
096519	RESILIENT TILE FLOORING
098116	ACOUSTIC BLANKET INSULATION
099113	EXTERIOR PAINTING
099123	INTERIOR PAINTING
099600	HIGH PERFORMANCE COATINGS

DIVISION 10 - SPECIALTIES

101423.16	ROOM-IDENTIFICATION PANEL SIGNAGE
102113.19	PLASTIC TOILET COMPARTMENTS
102123	CUBICLE CURTAINS AND TRACK
102800	TOILET, BATH, AND LAUNDRY ACCESSORIES
104413	FIRE PROTECTION CABINETS
104416	FIRE EXTINGUISHERS
105113	METAL LOCKERS
107316	CANOPIES

DIVISION 12 - FURNISHINGS

123553.13	METAL LABORATORY CASEWORK
123640	STONE COUNTERTOPS

Addendum #2

124813 ENTRANCE FLOOR MATS AND FRAMES

DIVISION 13 – SPECIAL CONSTRUCTION

133419 METAL BUILDING SYSTEMS

DIVISION 14 – CONVEYING EQUIPMENT

146001 CRANES & HOISTS

DIVISION 22 - PLUMBING

220510 BASIC PLUMBING REQUIREMENTS
220515 PLUMBING FIRESTOPPING
220516 EXPANSION FITTINGS AND LOOPS FOR PLUMBING PIPING
220553 PLUMBING IDENTIFICATION
220719 PLUMBING PIPING INSULATION
221005 PLUMBING PIPING
221006 PLUMBING PIPING SPECIALTIES
221319.13 SANITARY TRENCH DRAIN
223000 PLUMBING EQUIPMENT
224000 PLUMBING FIXTURES

Division 23 – HEATING, VENTILATING AND AIR CONDITIONING (HVAC)

230510 BASIC MECHANICAL REQUIREMENTS
230515 MECHANICAL FIRESTOPPING
230553 IDENTIFICATION FOR HVAC PIPING AND EQUIPMENT
230593 TESTING, ADJUSTING, AND BALANCING FOR HVAC
230713 DUCT INSULATION
230719 PIPING AND EQUIPMENT INSULATION
232113 HYDRONIC PIPING
232114 HYDRONIC SPECIALTIES
232123 HYDRONIC PUMPS
232300 REFRIGERANT PIPING
233100 HVAC DUCTS AND CASINGS
233300 AIR DUCT ACCESSORIES
233416 CENTRIFUGAL HVAC FANS
233700 AIR OUTLETS AND INLETS
235100 BREECHINGS, CHIMNEYS AND STACKS
235216 CONDENSING BOILERS
235400 FURNACES
235533 UNIT HEATERS
236313 AIR COOLED REFRIGERANT CONDENSERS

Addendum #2

238124	ROOM AIR CONDITIONERS
238200	CONVECTION HEATING AND COOLING UNITS

DIVISION 26 – ELECTRICAL

260501	MINOR ELECTRICAL DEMOLITION
260510	BASIC ELECTRICAL REQUIREMENTS
260513	MEDIUM-VOLTAGE CABLES
260515	ELECTRICAL FIRESTOPPING
260519	LOW-VOLTAGE ELECTRICAL POWER CONDUCTORS AND CABLES
260526	GROUNDING AND BONDING FOR ELECTRICAL SYSTEMS
260529	HANGERS AND SUPPORTS FOR ELECTRICAL SYSTEMS
260534	CONDUIT
260537	BOXES
260543	UNDERGROUND ELECTRICAL WORK
260553	IDENTIFICATION FOR ELECTRICAL SYSTEMS
260573	POWER SYSTEM ANALYSIS
260910	HVAC MONITORING PANELS
260911	GAS DETECTION
260912	CONTROL PANELS AND INTEGRATION
260913	FIRE DETECTION AND ALARM
260914	HEAT TRACING CABLES
260915	FIBER OPTIC CABLING
260922	LIGHTING CONTROL DEVICES
262100	LOW-VOLTAGE ELECTRICAL SERVICE ENTRANCE
262200	LOW-VOLTAGE TRANSFORMERS
262413	SWITCHBOARDS
262416	PANELBOARDS
262419	MOTOR CONTROL CENTERS
262717	EQUIPMENT WIRING
262726	WIRING DEVICES
262727	EQUIPMENT FOR HAZARDOUS LOCATIONS
262813	FUSES
262818	ENCLOSED SWITCHES
262913	ENCLOSED CONTROLLERS
262923	VARIABLE-FREQUENCY MOTOR CONTROLLER
263213	ENGINE GENERATORS
263600	TRANSFER SWITCHES
264113	LIGHTNING PROTECTION
264300	SURGE PROTECTIVE DEVICES

Addendum #2

265100	INTERIOR LIGHTING
265600	EXTERIOR LIGHTING

Site and Infrastructure Subgroup

DIVISION 31 - EARTHWORK

310000	EARTHWORK
311100	CLEARING AND GRUBBING
312213	ROUGH GRADING (NY)
312219	FINISH GRADING (NY)
312316	ROCK REMOVAL (ROCK EXCAVATION) (NY)
312319	DEWATERING
312323.13.01	BACKFILL (CRUSHED STONE FOUNDATION) (NY)
312323.13.02	BACKFILL (SELECTED BORROW BACKFILL)
312323.13.03	BACKFILL (SUBBASE MATERIAL) (NY)
312333	TRENCHING, BACKFILLING AND COMPACTION WORK (NY)
312334	STRUCTURAL EXCAVATION BACKFILL AND COMPACTION (NY)
312500	EROSION AND SEDIMENTATION CONTROL (NY)

DIVISION 32 - EXTERIOR IMPROVEMENTS

321000	ASPHALT CONCRETE ROADWAY CONSTRUCTION
323100	HEAVY DUTY CANTILEVER SLIDE GATE SYSTEM (CHAIN LINK)
323113	CHAIN LINK FENCES
323216	PRE-CAST MODULE BLOCK RETAINING WALL SYSTEM
329119.13	TOPSOIL PLACEMENT AND GRADING (TOPSOIL) (NY)
329219	SEEDING (NY)

DIVISION 33 – UTILITIES

330110.13	PRESSURE AND LEAKAGE TESTING OF PIPELINES
330505.41	LOW PRESSURE AIR TEST – SANITARY SEWER LINES
330531.11	POLYVINYL CHLORIDE (PVC) PIPE FOR NON-PRESSURE SEWER SERVICE
330598	TRACER WIRE
331050	POLYETHYLENE PRESSURE PIPE
331113.13	DUCTILE IRON (DI) WATER PIPE AND SPECIALS
331113.23	POLYVINYL CHLORIDE (PVC) PIPE FOR WATER SERVICE
331216.01	RESILIENT-DISC GATE VALVES
331216.02	BUTTERFLY VALVES, AIR SERVICE
331216.03	BUTTERFLY VALVES, WATER/SEWAGE SERVICE
331219	HYDRANT AND VALVE ASSEMBLY

Addendum #2

331301	DISINFECTION TESTING OF PIPELINES
333113	POLYVINYL CHLORIDE (PVC) PIPE FOR PRESSURE SEWER SERVICE
333113.14	DUCTILE IRON (DI) PRESSURE SEWER PIPE
333213	PLANT WATER PUMP STATION
333217	HORIZONTAL DRY INSTALLED WASTEWATER PUMP FOR SEWAGE LIFT STATION
333913.01	PRECAST CONCRETE MANHOLES (SANITARY SEWAGE)
334100	HIGH DENSITY POLYETHYLENE DRAINAGE PIPE
334413.13	PRECAST CONCRETE CATCH BASINS
334913	PRECAST CONCRETE MANHOLES (STORM DRAINAGE)
335133.10	PLUG VALVES

DIVISION 40 – PROCESS INTERCONNECTIONS

400507	HANGERS & SUPPORTS
400508	PROCESS PIPING IDENTIFICATION
400523	STAINLESS STEEL PIPE AND FITTINGS
400551	COMMON REQUIREMENTS FOR PROCESS VALVES
400552	PROCESS VALVES
400557	ACTUATORS FOR PROCESS VALVES AND GATES
400559.23	STAINLESS STEEL GATES
400561.43	KNIFE GATE VALVES
400565	BALL CHECK VALVES
402301	STAINLESS STEEL AND CARBON STEEL PROCESS AIR PIPING
402323	PVC PROCESS PIPING
402400	CHEMICAL FEED PIPING
404213	PROCESS PIPING INSULATION
404213.1	PROCESS HOT AIR PIPING INSULATION
409123.23	PARSHALL FLUME

DIVISION 41 – MATERIAL PROCESSING AND HANDLING EQUIPMENT

414010	REMOTE FILL STATION
--------	---------------------

DIVISION 43 – PROCESS GAS AND LIQUID HANDLING, PURIFICATION AND STORAGE EQUIPMENT

431133	POSITIVE DISPLACEMENT ROTARY LOBE BLOWER PACKAGE
432313.27	PRIMARY SLUDGE PUMPS
432613	CHOPPER PUMP
432618.10	SUBMERSIBLE SEWAGE PUMPS
432618.20	SUBMERSIBLE SEWAGE PUMPS (RDT FILTRATE)
432618.21	RDT FILTRATE DUPLEX PUMP CONTROL SYSTEM
434183	LIQUID CHEMICAL STORAGE TANKS

DIVISION 46 – WATER AND WASTEWATER EQUIPMENT

462100	FINE SCREENING EQUIPMENT
--------	--------------------------

Addendum #2

462113	MECHANICALLY CLEANED BAR SCREEN
462113.1	MECHANICAL BS WASHER COMPACTOR
462323	VORTEX GRIT REMOVAL SYSTEM EQUIPMENT
463366	LIQUID CHEMICAL TRANSFER PUMPS
464321	PRIMARY CLARIFIER CONSTRUCTION
465136.22	AERATION DIFFUSER SYSTEM
467133	ROTARY DRUM THICKENER
467321	ATAD SYSTEM SPECIFICATION
467621	BELT DEWATERING PRESS

END OF TABLE OF CONTENTS

SECTION 462100 – FINE SCREENING EQUIPMENT

PART 1 – GENERAL

1.1 WORK INCLUDED:

- A. Supply all labor, materials, equipment and incidentals required to install and place into operation the fine screening system as shown on the Drawings and as specified herein.

1.2 REFERENCE STANDARDS:

- A. The properties of all materials, design, fabrication and performance of the equipment to be furnished under this section shall be in accordance with the latest issue of applicable standard specifications. The governing authorities of these standards are listed below.
 - 1. AICS, American Institute of Steel Construction
 - 2. AISI American Iron and Steel Institute
 - 3. ANSI, American National Standards Institute
 - 4. ASCE, American Society of Civil Engineers
 - 5. ASME, American Society of Mechanical Engineers
 - 6. ASTM, American Society of Testing and Materials
 - 7. AWS, American Welding Society
 - 8. IBC, International Building Code
 - 9. IEC, International Electric Code
 - 10. IEEE, Institute of Electrical and Electronics Engineers
 - 11. NEC, National Electrical Code
 - 12. NEMA, National Electrical Manufacturers Association
 - 13. Underwriters Laboratory (UL and cUL)

1.3 SUBMITTALS:

- A. Submittals shall be provided to the engineer that includes all the following information:
 - 1. Certified shop drawings showing all important details of construction, dimensions and anchor bolt locations.
 - 2. Descriptive product literature.
 - 3. Schematic electrical wiring diagram and electrical controls information.
 - 4. Complete motor and drive data.
 - 5. The total weight of the equipment.
 - 6. A complete bill of materials of all equipment.
 - 7. A valid certificate of registration naming manufacturer, and supplier if equipment is relabeled, as ISO 9001:2015 certified.
 - 8. A certificate from an industry recognized, independent testing facility verifying compliance with Screening Capture Ratio requirement.

1.4 QUALIFICATIONS:

- A. All the equipment specified under this Section shall be supplied by a single manufacturer whose Quality Management System is ISO 9001:2015 certified and applicable to the manufacture of

water and wastewater treatment equipment.

- B. Qualified manufacturers shall have a minimum of ten (10) years experience with wastewater screening systems, specifically including Center Flow band screens and washing compactors for consideration.
- C. If equipment is not manufactured by supplier, including welding and machining, the name and contact information of manufacturing facility must be supplied. If more than one manufacturer is used all companies and facilities must be provided.
- D. If patents protecting equipment are not owned by supplier, then an affidavit must be supplied stating owner of design and expiration of licensing agreement.
- E. All equipment specified under this Section shall comply Bipartisan Infrastructure Law's (BIL Public Law 117-58) Build America, Buy America (BABA) requirements for manufactured products. As defined in the Law, this requires
 - 1. The manufactured product was manufactured in the United States, and
 - 2. The cost of the components of the manufactured product that are mined, produced, or manufactured in the United States is greater than 55 percent of the total cost of all components of the manufactured product.
- F. Certifications attesting to compliance will be required prior to approval and shall be included with submittals and upon completion of manufacture.

1.5 DESIGN REQUIREMENTS:

- A. System Description
 - 1. The fine screen will have a continuous stainless-steel belt that automatically rotates within the internal guide system of the static frame.
 - 2. The fine screen herein specified will be of the center flow type. The flow enters the inside of the continuous belt and exits through both sides and the bottom of the belt.
 - 3. The screen shall have undergone performance testing by an industry recognized, independent testing facility. The results of this testing shall verify a Screening Capture Ratio of at least 84% for solids equal to or larger than the screen grid opening listed in System Performance below.
 - 4. The screen will be installed into the channel as shown on the contract drawings to accommodate the flow pattern through the screen belt.
 - 5. The solids will collect as a mat on the inside of the continuous belt. The belt will intermittently rotate and elevate the solids to the discharge point. Larger objects will be picked up by a series of hooks and/or trays placed at regular intervals.
 - 6. The solids will be removed at the top of the screen by two spray bar headers positioned on the outside of the belt. The screenings will drop into an internal hopper and be fed to the screening handling system.

7. The continuous belt will be directly driven by drive sprockets that shall support and rotate the grid assembly.
8. The screen will be totally enclosed and have access covers that will be lightweight and easily removable for maintenance. Maintenance, inspection, access and lubrication points shall be no higher than 60 inches above grade level.
9. The Washing Compactor will sit under the discharge point of the fine screen.
10. The Washing Compactor will be adequately sized to handle all the screenings and wash water that will be generated by the screen at peak flow. The system will be required to wash the screenings to reduce the organic content and compact the remaining solids into a dry plug.
11. The Washing Compactor will generally comprise of a screw auger rotating within the washing and drainage trough, a wash water system, a compaction zone and an outlet chute arrangement.
12. All stainless steel (including frame, grid and drive components) mentioned below as stainless steel shall be T304 stainless steel. All hardware shall be T316 stainless steel.

B. System Performance – The fine screening system will be designed to meet the following design parameters:

Number of Screens	2
Peak Flow Per Screen	16.5 MGD
Screen Grid Opening	2 mm
Head Loss at Peak Flow	11.86 inches @ 30% blinding and 52 inches downstream water level
Structural Design Differential of Frame/Grid	48 inches minimum @ 100% blinding
Drive Design Differential (Operating)	48 inches minimum
Screen Grid Supporting Drive Sprockets	3 minimum – all stainless steel
Channel Width	48 inches
Channel Height	114 inches
Channel Width – Recess Around Screen	N/A
Number of Washing Compactors	2
Diameter of Screw	6 inches
Diameter of Shaft	2.26 inches
Compactor Discharge Height Above Grade	48 inches
Wash Water Requirements per Screen/WC	82 GPM @ 60 PSI when screen is on

PART 2 - MATERIALS

2.1 MANUFACTURER:

- A. The equipment shall be the Center Flow Screen and Washing Compactor as provided by Hydro-Dyne Engineering, Inc., Clearwater, FL. Other than the named supplier, all manufacturers proposing equipment described herein, will provide a detailed submittal package, which will

consist, at a minimum, of all information and details prescribed in Contract Documents.

- B. If submitted equipment requires arrangement differing from that specified, prepare, and submit for review complete structural, mechanical, and electrical drawings and equipment lists showing all necessary changes and embodying all special features of equipment proposed. Any changes are at no additional compensation and the Manufacturer will be responsible for all engineering costs of redesign by the Engineer, if necessary.

2.2 CENTER FLOW SCREEN:

A. Perforated Plate - The Continuous Screening Belt

1. The screenings belt will consist of panels manufactured from stainless steel plate that shall be punched with perforations of the specified opening. The stainless steel plate shall be reinforced with a stainless steel frame.
2. The perforated panels will be supported by 12 gauge stainless steel vertical mounted lifting hooks horizontally spaced a maximum of 3 inches apart preventing deflection. The lifting hooks shall support the screening grid and bear tension loads across the entire length and width of the screen belt.
3. The hooks on elements shall form horizontal lifting trays or shelves for removing large solids and rags every 8 inches around the entire screen grid.
4. The perforated panels will be connected by heavy duty stainless steel axles every 8 inches to form a continuous belt that will rotate within the frame's guide system. The axle design will allow the plates to pivot and create a seal between the perforated panels to prevent the passage of solids.
5. The axles will include Delrin spacers that will maintain the 3 inch space between the vertical support elements. Delrin spacers will also form a seal between each perforated panel with clearance not to exceed 0.5mm.
6. The axles will be extended to fix a stainless-steel guide link to the side of each perforated plate. These guides will interlock to create a continuous guide link system that will slide within the frame.
7. Guide links shall be precision machined from solid virgin stainless steel. Injection molded links are not acceptable.
8. The heavy duty guide links will be minimum 2 inches thick to protect against undue wear from grit and will be specially machined to form a closure seal between the rotating belt and the static frame.
9. The seal shall be continuous from grade level through the water flow forming an uninterrupted closure between the traveling screen grid and the stationary frame. The seal shall be heavy gauge stainless steel, fixed to the screen frame and be adjustable so it will remain in contact with the rotating screen belt at all times. There shall be no gap in the grid to frame seal larger than 0.5mm.
10. Guide systems that use rollers, stainless or hardened steel chains will not be acceptable.

11. Grid panel sealing systems that use neoprene seals or stainless steel hinges will not be acceptable.
12. Grid to frame sealing systems that use adjustable stainless steel strips attached to the frame will not be acceptable.

B. FRAME

1. The continuous belt will rotate within a heavy-duty stainless steel static support frame that shall be a rectangular box construction.
2. The guide link system will travel around a stainless-steel guide wear track that is integral to the support frame. Top and bottom wear tracks shall be bolt in and field replaceable.
3. There shall be a removable inspection panel located directly beneath the drive allowing easy access to the grid drive sprockets, drive shaft and screenings collection hopper.
4. The design will ensure that the support frame meshes with the closure seal on each guide link to prevent passage of screening material and grit particles.
5. All components of the lower wear tracks shall be bolt in, field replaceable and manufactured from stainless steel.
6. The frame shall accommodate stainless steel protective covers designed to prevent leakage and contain spray wash. All access covers for maintenance will be lightweight and easily removable. Screens with covers requiring neoprene, rubber or plastic seals are not acceptable.
7. The screen manufacturer will supply the stainless-steel angled filler plates to connect from the upstream corners of the support frame to the channel walls.
8. The back-plate of the screen shall be furnished with a bypass gate that will allow manual removal for complete flow bypass.

C. OFFLOADING OF SCREENINGS

1. Two stainless steel spray wash headers will be located in the head space of the screen to offload the screenings from the continuous belt.
2. The spray bar will incorporate brass nozzles at 2 inch spaces that can easily be replaced or removed for cleaning.
3. The spray bars will be positioned behind the rotating belt and will backwash the solids into an internal hopper manufactured from stainless steel. The wash water will be used to continuously flush the screenings from the internal hopper directly into the Washing Compactor.
4. The addition of a rotating or static brush system to aid offloading will not be acceptable.

D. SCREEN DRIVE MECHANISM

1. Each screen will have a minimum 1.0 hp, continuous duty electric motor suitable for a 460/3/60 supply. As a minimum, the motor will be TEFC with an IP55 enclosure rating and will conform to NEMA MG-1 requirements. The motor will be located outside of the screen covers and above the top of the channel.
2. The gear reducer shall be directly coupled to a heavy duty shaft machined from solid stainless steel round bar.
3. The drive shaft shall be supported on both ends by grease filled roller bearings. Separate grease-filled self-contained cartridge seals shall be mounted on drive shaft between bearings and frame to eliminate spray wash from entering bearings or gear reducer.
4. The continuous belt will be supported and rotated around heavy duty stainless steel sprockets located on the drive shaft in the head space of the screen.
5. These sprockets will have lugs that transmit torque directly from the gear reducer to notches on the underside of the UHMWPE guide links. Driving forces shall be transmitted to areas located behind the screen's grid to prevent solids from contacting drive surfaces.
6. Chain driven systems or screens with wheels submerged in the wastewater are not acceptable.
7. Drive systems that use an external track and pinion to drive or push the band against grid weight supporting wear tracks will not be acceptable. Drive shall lift, and be capable of bearing, the full weight of the grid.

2.3 WASHING COMPACTOR WITH ENHANCED WASHING AND DEWATERING:

- A. The main body will be the washing trough that will receive screenings and wash water directly from the discharge point of the screen.
- B. The washing trough will house the screw auger and provide a dedicated section to reduce organic content.
- C. The stainless-steel drainage section will be slots with 5mm openings and be adjustable to maintain auger alignment. This drainage section shall be removable and easily replaceable in the field with no special tools. The flights of the screw may be fitted with a stiff nylon brush that will maintain contact with the drainage section, preventing blockages. The replaceable brushes will be supplied in pre-coiled lengths with stainless steel removable clamps.
- D. The AR400 hardened steel screw auger will sit in the washing trough. Washing compactors with shaftless screws are not acceptable as a shaft is required to support the flight and provide necessary torque and compaction. Screw auger will be primer coated to inhibit corrosion.
- E. The auger will be a varied pitch screw aligned at the compaction end by AR400 hardened steel wear and anti-rotation bars designed to prevent the compacted screening from spinning within the compaction zone.
- F. The screw will rotate allowing wash water and free organic/fecal material finer than trough

openings to escape and return to the plant flow. The wash water will flush the separated organic material through the drainage section in solution or as small particles.

- G. Washing of screenings shall be achieved through an enhanced washing module consisting of the following minimum requirements manufactured out of stainless steel:
 - 1. Variable pitch flight for separate screening transport through the wash, dewatering and compaction zones.
 - 2. Washing Module Zone
 - a. Flanged connections and a stainless-steel orifice plate or nozzle
 - b. Hardened steel wear and anti-rotation bars
 - c. Separately controlled high pressure washing to sheer and break-up organic and fecal material for return to the channel.
 - d. Cleansing cycles moving the auger in forward and reverse direction are controlled through the main control panel and operator adjustable up to 9 cycles
 - 3. Dewatering and Compaction Zone
 - a. Stainless steel header feeding an external rinse shower
 - b. Hardened steel wear and anti-rotation bars
 - c. Full circumference perforations for dewatering and extrusion of organics and fecal material.
 - d. Attached drainage catch pan with a separate wash water supply to purge the area of accumulated solids
 - e. Removable covers for inspection access
- H. The compacted screenings will be pushed through the compaction zone and pass through an elbow into an outlet chute. The outlet chute will provide for screening expansion and will elevate the dewatered screenings to discharge by gravity into a waste receptacle (by others).
- I. Each Washing Compactor will have a minimum 1.5 hp, inverter duty reversing electric motor suitable for a 460/3/60 supply and rated for a Class 1 Div. 1 environment. As a minimum, the motor will be TEFC with an IP55 enclosure rating and will conform to NEMA MG-1 requirements.

2.4 PARABOLIC PROPORTIONAL WEIR:

- A. The manufacturer shall design and supply a stainless steel parabolic proportional weir that will be installed by the contractor downstream of the screen.
- B. The weir will be designed to maintain a grid velocity of no more than 3 ft/sec for the full flow range (minimum to maximum).
- C. The weir will be designed to maintain a downstream water depth that will increase screen performance during periods of high flow.
- D. The weir will be anchored to the sides of the channel with no horizontal supports across the channel to prevent the accumulation of solids.
- E. Weir will allow for 2 inch incremental height adjustment and shall have the capability to be safely removed during live flow conditions.

2.5 SPARE PARTS:

- A. The manufacturer will supply the following spare parts, per screen supplied, with the equipment:
 - 1. Ten (10) hook links and elements spacers
 - 2. Two (2) grid axles
 - 3. Two (2) guide links

2.6 ACCESSORIES:

- A. The manufacturer will supply the following accessories, per screen supplied, with the equipment:
 - 1. One (1) NEMA 7 brass body solenoid valve
 - 2. One (1) wash water strainer
 - 3. Two (2) wash water pressure gauges

2.7 ELECTRICAL CONTROLS AND ANCILLARY COMPONENTS:

- A. General Information - The manufacturer will supply one UL listed main control panel and two local control stations that shall automatically control the equipment offered in this section.
- B. The Main Control Panel – NEMA 4X stainless steel enclosure for indoor or outdoor installation - panel shall consist of the following components:
 - 1. Allen Bradely PLC for ethernet output for SCADA integration.
 - 2. Main lockout/fused disconnect switch
 - 3. Variable Frequency Drive for screen
 - 4. Compactor motor starter
 - 5. Control transformer, 500 VA minimum
 - 6. Programmable control relay with minimum of 5 cycle timers
 - 7. Fused disconnect
 - 8. Hour run meter
 - 9. Fuses and breakers
 - 10. Motor overload sensor
 - 11. Panel power light
 - 12. Screen run/fault lights
 - 13. Washing Compactor run/fault lights
 - 14. Reset pushbutton
 - 15. Current monitors
- C. Ancillary Control Components
 - 1. Float switch
 - 2. Upstream ultrasonic level system consisting of the following per screen:
 - a. NEMA 4X enclosure with viewing window
 - b. Milltronics Hydro-Ranger 200 controller with real-time 4-20 mA output
 - c. One (1) NEMA 4X transducer
 - 3. Local Control Station – NEMA 4X - Each local station panel shall consist of the following components:
 - a. 4-hole NEMA 4X cast aluminum enclosure
 - b. Hand/Off/Auto switch for each motor

- c. Forward/Off/Reverse for compactor
- d. Emergency stop

PART 3 - CONSTRUCTION DETAILS

3.1 GENERAL:

- A. Applicable stainless-steel materials, including hardware, flanges and piping shall be pickled by means of a four-tank system that is in accordance with ASTMs A380 and A967. This process is for quality control, removal of heat affected discoloration, surface treatment for corrosive environments and to provide a uniform finish to the stainless-steel surfaces. Stainless steel components must be fully submerged in the tanks for complete coverage. Electro-chemical wanding is acceptable on weld finishes that cannot be submerged due to size. Sandblasting, pickling pastes and abrasive cleaners will not be accepted as forms of metal finishing. The drive and grid components do not require pickling.
 - 1. Tank 1 – Detergent bath for the removal of soils, greases, oils and dirt
 - 2. Tank 2 – Rinsing process to remove detergent and residual soils
 - 3. Tank 3 – Two part acid solution for the removal of tightly adhere oxide films
 - 4. Tank 4 – Final rinse process to remove all residual acid
- B. All ferrous surfaces (except stainless steel) shall be coated with a pre-primer, primer, and an exterior top coating, or fusion bonded polyester coating suitable for humid/wet environments for superior corrosion protection.
- C. Motors and gearboxes shall be surface prepared to withstand humid/wet environments for superior corrosion protection.

3.2 DELIVERY AND STORAGE:

- A. The screening system shall be appropriately crated and delivered to protect against damage during shipment.
- B. An authorized representative of the Contractor shall inspect the screens on delivery to the jobsite and shall report any damage or missing components to the Manufacturer and the Engineer within 72 hours of receipt of the shipment.

3.3 INSTALLATION:

- A. The installation of the equipment shall be as indicated on the drawings and in strict accordance with the Manufacturer's instructions and recommendations.

3.4 WARRANTY:

- A. The Manufacturer of the equipment supplied under this specification shall provide a warranty for a period of twelve months commencing on acceptance and/or beneficial occupancy by the Owner. ~~but no later than 90 days from the date of shipment by the Manufacturer.~~ The Manufacturer shall guarantee that the equipment furnished is suitable for the purpose intended

and free from defects in design, materials and workmanship. In the event that the equipment fails to perform as specified the Manufacturer shall, at his option, promptly repair, modify or replace the defective equipment.

3.5 FACTORY TESTING:

- A. The screening system and all components shall be factory assembled and tested for a minimum of 24 hours prior to shipment. The equipment shall be shipped fully assembled and shall be capable of being set in place and field erected by the Contractor with minimal field assembly.
- B. During the factory test period the screening system shall be adjusted as required assuring proper operation on completion of the field installation. The Manufacturer shall supply a certification of the completion of the factory testing of the assembled screening system and appurtenances and shall certify as to the equipment being in satisfactory operating condition at time of shipment. The Engineer and/or Owner may, at their own option and expense, witness the factory test.

3.6 FIELD TESTS, ADJUSTMENTS, AND COMMISSIONING:

- A. The equipment shall be shipped completely factory assembled. Contractor shall verify all access dimensions, channel dimensions, and any interior building dimensions to ensure equipment may be installed as a factory assembled units.
- B. After completion of the installation, the equipment shall be inspected and certified by an authorized representative of the Manufacturer as being in compliance with the Manufacturer's recommendations and requirements. At such time as the Manufacturer has deemed the installation to be acceptable, the Manufacturer's authorized service representative shall make any required adjustments and shall start the equipment to assure proper operation.
- C. The Manufacturer's authorized representative shall provide instruction to the plant personnel as to the operation and maintenance of the equipment including commissioning, shut down, on-line operations, lubrication and preventative maintenance.
- D. Manufacturer shall state field service rates for a Service Engineer to Owner and Contractor. In the event that the field service time required by this section should not be sufficient to properly place the equipment into operation, and the requirement for additional time is beyond the manufacturer's responsibility, additional time shall be purchased by Contractor to correct deficiencies in installation, equipment, or material without additional cost to Owner.
- E. The Contractor shall include in his bid, the cost of the above referenced authorized service representative for one (1) trip totaling three (3) eight-hour days total for the fine screens onsite to complete the certifications and training described in this specification section.

END OF SECTION 462100

SECTION 083613 - SECTIONAL DOORS – R2

PART 1 - GENERAL

1.1 SUMMARY

- A. Section includes manually or electrically operated sectional doors.

1.2 ACTION SUBMITTALS

- A. Product Data: For each type and size of sectional door and accessory.
- B. Shop Drawings: For each installation and for special components not dimensioned or detailed in manufacturer's product data.
- C. Samples: For each exposed product and for each color and texture specified.

1.3 INFORMATIONAL SUBMITTALS

- A. Sample warranty.

1.4 CLOSEOUT SUBMITTALS

- A. Maintenance data.

1.5 QUALITY ASSURANCE

- A. Installer Qualifications: An entity that employs installers and supervisors who are trained and approved by manufacturer for both installation and maintenance of units required for this Project.

1.6 WARRANTY

- A. Special Warranty: Manufacturer agrees to repair or replace components of sectional doors that fail in materials or workmanship within specified warranty period.
 - 1. Warranty Period: Five years from date of Substantial Completion.
- B. Special Finish Warranty: Manufacturer agrees to repair or replace components that show evidence of deterioration of factory-applied finishes within specified warranty period.
 - 1. Warranty Period: 10 years from date of Substantial Completion.

PART 2 - PRODUCTS

2.1 PERFORMANCE REQUIREMENTS

- A. General Performance: Sectional doors shall comply with performance requirements specified without failure due to defective manufacture, fabrication, installation, or other defects in construction and without requiring temporary installation of reinforcing components.
- B. Structural Performance, Exterior Doors: Capable of withstanding the design wind loads.
 - 1. Design Wind Load: Uniform pressure (velocity pressure) of 20 lbf/sq. ft., acting inward and outward.
 - 2. Testing: According to ASTM E330 or DASMA 108 for garage doors and complying with the acceptance criteria of DASMA 108.
- C. Seismic Performance: Sectional doors shall withstand the effects of earthquake motions determined according to ASCE/SEI 7.

2.2 DOOR ASSEMBLY

- A. Sectional Insulated Steel Door: Sectional door formed with hinged sections and fabricated according to DASMA 102 unless otherwise indicated.
 - a. Basis of design : ThermaSeal TM320 as manufactured by Raynor Garage Doors.
 - 2. Manufacturers: Subject to compliance with requirements, available manufacturers offering products that may be incorporated into the Work include, but are not limited to the following:
 - a. Overhead Door Corporation.
 - b. Wayne-Dalton Corp.
- B. Operation Cycles: Door components and operators capable of operating for not less than 50,000.
- C. Air Infiltration: Maximum rate of 0.4 cfm/sq. ft. at 15 and 25 mph when tested according to ASTM E283.
- D. R-Value: 24.0 deg F x h x sq. ft./Btu.
- E. Steel Sections: Zinc-coated (galvanized) steel sheet with G60 zinc coating.
 - 1. Section Thickness: 3 inches.
 - 2. Exterior-Face Surface: Paneled 20 Gauge.
 - 3. Interior Facing Material: Zinc-coated (galvanized) 26 gauge steel sheet.
- F. Track Configuration: Standard-lift & Low-headroom track.
- G. Weather-seals: Fitted to bottom and top and around entire perimeter of door. Provide combination bottom weather-seal and sensor edge.

- H. Windows: Approximately 24 by 8 inches, with curved corners, and spaced apart the approximate distance as indicated on Drawings; in one row(s) at height indicated on Drawings; installed with insulated glazing of clear float glass.
- I. Locking Devices: Equip door with locking device assembly.
 - 1. Locking Device Assembly: Cremone type, both jamb sides, locking bars, operable from inside with thumb-turn, outside with cylinder.
- J. Electric Door Operator:
 - 1. Usage Classification: Standard duty, up to 25 cycles per hour and up to 90 cycles per day.
 - 2. Operator Type: Jackshaft, side mounted.
 - 3. Safety: Listed according to UL 325 by a qualified testing agency for commercial or industrial use; moving parts of operator enclosed or guarded if exposed and mounted at 8 feet or lower.
 - 4. Motor Exposure: Interior, clean, and dry.
 - 5. Emergency Manual Operation: Chain type.
 - 6. Obstruction-Detection Device: Automatic photoelectric sensor.
 - 7. Control Station: Interior-side mounted.
 - 8. Other Equipment: Portable, radio-control system.
- K. Door Finish:
 - 1. Baked-Enamel or Powder-Coat Finish: Color and gloss as selected by Engineer/Architect from manufacturer's full range.
 - 2. Factory Prime Finish: Manufacturer's standard color.
 - 3. Finish of Interior Facing Material: Finish as selected by Engineer/Architect from manufacturer's full range.

2.3 STEEL DOOR SECTIONS

- A. Exterior Section Faces and Frames: Zinc-coated (galvanized), cold-rolled, commercial steel (CS) sheet.
 - 1. Roll horizontal meeting edges to a continuous, interlocking, keyed, rabbeted, shiplap, or tongue-in-groove weather-resistant seal, with a reinforcing flange return.
 - 2. For insulated doors, provide sections with continuous thermal-break construction, separating the exterior and interior faces of door.
- B. Section Ends and Intermediate Stiles: Enclose open ends of sections with channel end stiles formed from galvanized-steel sheet welded to door section. Provide intermediate stiles formed from galvanized-steel sheet, cut to door section profile, and welded in place. Space stiles not more than 48 inches apart.
- C. Reinforce bottom section with a continuous channel or angle conforming to bottom-section profile and allowing installation of astragal.
- D. Reinforce sections with continuous horizontal and diagonal reinforcement, as required to stiffen door and for wind loading. Provide galvanized steel bars, struts, trusses, or strip steel, formed to depth and bolted or welded in place. Ensure that reinforcement does not obstruct vision lites.

- E. Provide reinforcement for hardware attachment.
- F. Thermal Insulation: Insulate interior of steel sections with door manufacturer's standard CFC-free insulation, with maximum flame-spread and smoke-developed indexes of 75 and 450, respectively, according to ASTM E84. Enclose insulation completely within steel sections and the interior facing material, with no exposed insulation.

2.4 TRACKS, SUPPORTS, AND ACCESSORIES

- A. Tracks: Manufacturer's standard, galvanized-steel track system of configuration indicated, sized for door size and weight, designed for lift type indicated and clearances indicated on Drawings. Provide complete system including brackets, bracing, and reinforcement to ensure rigid support of ball-bearing roller guides for required door type, size, weight, and loading.
 - 1. Track Reinforcement and Supports: Galvanized-steel members to support track without sag, sway, and vibration during opening and closing of doors. Slot vertical sections of track spaced 2 inches apart for door-drop safety device.
- B. Weather-seals: Replaceable, adjustable, continuous, compressible weather-stripping gaskets of flexible vinyl, rubber, or neoprene fitted to bottom and top of sectional door unless otherwise indicated.
- C. Windows: Manufacturer's standard window units of type, size, and in arrangement indicated. Provide removable stops of same material as door-section frames.

2.5 HARDWARE

- A. General: Heavy-duty, corrosion-resistant hardware, with hot-dip galvanized, stainless-steel, or other corrosion-resistant fasteners, to suit door type.
- B. Hinges: Heavy-duty, galvanized-steel hinges at each end stile and at each intermediate stile, according to manufacturer's written recommendations for door size. Attach hinges to door sections through stiles and rails.
- C. Rollers: Heavy-duty rollers with steel ball-bearings in case-hardened steel races, mounted with varying projections to suit slope of track. Provide 3-inch-diameter roller tires for 3-inch-wide track and 2-inch-diameter roller tires for 2-inch-wide track.
- D. Push/Pull Handles: Equip each push-up operated or emergency-operated door with galvanized-steel lifting handles on each side of door, finished to match door.

2.6 LOCKING DEVICES

- A. Slide Bolt: Fabricate with side-locking bolts to engage through slots in tracks for locking by padlock, located on single-jamb side, operable from inside only.
- B. Locking Device Assembly: Fabricate with cylinder lock, spring-loaded deadbolt, operating handle, cam plate, and adjustable locking bars to engage through slots in tracks.

1. Lock Cylinders: Cylinders specified in Section 087100 "Door Hardware" and keyed to building keying system.
 2. Keys: Three for each cylinder.
- C. Chain Lock Keeper: Suitable for padlock.
- D. Safety Interlock Switch: Equip power-operated doors with safety interlock switch to disengage power supply when door is locked.

2.7 COUNTERBALANCE MECHANISM

- A. Torsion Spring: Counterbalance mechanism consisting of adjustable-tension torsion springs fabricated from steel-spring wire complying with ASTM A229/A229M, mounted on torsion shaft made of steel tube or solid steel. Provide springs designed for number of operation cycles indicated.
- B. Cable Drums and Shaft for Doors: Cast-aluminum or gray-iron casting cable drums mounted on torsion shaft and grooved to receive door-lifting cables as door is raised. Mount counterbalance mechanism with manufacturer's standard ball-bearing brackets at each end of torsion shaft.
- C. Cables: Galvanized steel, multistrand, lifting cables.
- D. Cable Safety Device: Include a spring-loaded steel or spring-loaded bronze cam mounted to bottom door roller assembly on each side and designed to automatically stop door if either lifting cable breaks.
- E. Bracket: Provide anchor support bracket as required to connect stationary end of spring to the wall and to level the shaft and prevent sag.
- F. Bumper: Provide spring bumper at each horizontal track to cushion door at end of opening operation.

2.8 ELECTRIC DOOR OPERATORS

- A. General: Electric door operator assembly of size and capacity recommended and provided by door manufacturer for door and "operation cycles" requirement specified, with electric motor and factory-prewired motor controls, starter, gear-reduction unit, solenoid-operated brake, clutch, control stations, control devices, integral gearing for locking door, and accessories required for proper operation.
1. Manufacturers: Subject to compliance with requirements, provide products by the following:
 - a. Chamberlain Group, Inc. (The).
 2. Comply with NFPA 70.
 3. Control equipment complying with NEMA ICS 1, NEMA ICS 2, and NEMA ICS 6; with NFPA 70, Class 2 control circuit, maximum 24-V ac or dc.

- B. Usage Classification: Electric operator and components capable of operating for not less than number of cycles per hour indicated for each door.
- C. Door-Operator Type: Unit consisting of electric motor, gears, pulleys, belts, sprockets, chains, and controls needed to operate door and meet required usage classification.
- D. Motors: Reversible-type motor with controller (disconnect switch) for motor exposure indicated.
 - 1. Electrical Characteristics:
 - a. Phase: Single phase.
 - b. Volts: 115 V.
 - c. Hertz: 60.
 - 2. Motor Size: Minimum size as indicated. If not indicated, large enough to start, accelerate, and operate door in either direction from any position, at a speed not less than 8 in./sec. and not more than 12 in./sec., without exceeding nameplate ratings or service factor.
- E. Obstruction Detection Device: External entrapment protection consisting of indicated automatic safety sensor capable of protecting full width of door opening. Activation of device immediately stops and reverses downward door travel.
 - 1. Photoelectric Sensor: Manufacturer's standard system designed to detect an obstruction in door opening without contact between door and obstruction.
 - a. Self-Monitoring Type: Designed to interface with door operator control circuit to detect damage to or disconnection of sensing device. When self-monitoring feature is activated, door closes only with sustained pressure on close button.
 - 2. Electric Sensor Edge: Automatic safety sensor edge, located within astragal or weather stripping mounted to bottom section. Contact with sensor activates device. Connect to control circuit using manufacturer's standard take-up reel or self-coiling cable.
 - a. Self-Monitoring Type: Four-wire configured device designed to interface with door-operator control circuit to detect damage to or disconnection of sensor edge.
- F. Control Station: Three-button control station in fixed location with momentary-contact push-button controls labeled "Open" and "Stop" and sustained- or constant-pressure, push-button control labeled "Close."
 - 1. Interior-Mounted Units: Full-guarded, surface-mounted, heavy-duty type, with general-purpose NEMA ICS 6, Type 1 enclosure.
 - 2. Exterior-Mounted Units: Full-guarded, standard-duty, surface-mounted, weatherproof type, NEMA ICS 6, Type 4 enclosure, key operated.
- G. Emergency Manual Operation: Equip electrically powered door with capability for emergency manual operation. Design manual mechanism so required force for door operation does not exceed 25 lbf.

- H. Emergency Operation Disconnect Device: Equip operator with hand-operated disconnect mechanism for automatically engaging manual operator and releasing brake for emergency manual operation while disconnecting motor without affecting timing of limit switch. Mount mechanism so it is accessible from floor level. Include interlock device to automatically prevent motor from operating when emergency operator is engaged.
- I. Motor Removal: Design operator so motor may be removed without disturbing limit-switch adjustment and without affecting emergency manual operation.
- J. Audible and Visual Signals: Audible alarm and visual indicator lights in compliance with regulatory requirements for accessibility.
- K. Portable Radio-Control System: Consisting of two of the following:
 - 1. Three-channel universal coaxial receiver to open, close, and stop door.
 - 2. Portable control devices to open and stop door may be momentary-contact type; control to close door shall be sustained- or constant-pressure type.

PART 3 - EXECUTION

3.1 INSTALLATION

- A. Install sectional doors and operating equipment complete with necessary hardware, anchors, inserts, hangers, and equipment supports; according to manufacturer's written instructions and as specified.
- B. Tracks: Provide sway bracing, diagonal bracing, and reinforcement as required for rigid installation of track and door-operating equipment.
- C. Accessibility: Install sectional doors, switches, and controls along accessible routes in compliance with regulatory requirements for accessibility.
- D. Power-Operated Doors: Install automatic garage doors openers according to UL 325.
- E. Adjust hardware and moving parts to function smoothly so that doors operate easily, free of warp, twist, or distortion.
- F. Touch-up Painting: Immediately after welding galvanized materials, clean welds and abraded galvanized surfaces and repair galvanizing to comply with ASTM A780/A780M.

3.2 DEMONSTRATION

- A. Engage a factory-authorized service representative to train Owner's maintenance personnel to adjust, operate, and maintain sectional doors.

END OF SECTION 083613