

SUBMITTAL COVERSHEET Nanuet UFSD –Phase 3 Projects

Architect:

KSQ Architects
215 W 40th Street, 15th Floor
New York, NY 10018

Owner:

Nanuet Union Free School District
101 Church Street
Nanuet, NY 10954

Construction Manager:

Jacobs
One Penn Plaza, 54th floor
New York, NY 10019

Contractor: Joe Lombardo Plumbing & Heating of Rockland Inc

Contract: Ron Lombardo

Address: 321 Spook Rock Road Suite 109A

845-357-6537

Suffern, New York 10901

Telephone:

Fax: 845-357-8529

School Name: Nanuet Union Free School District Phase 3 Bond Projects @ Barr Middle School & Nanuet High School

Type of Submittal:

Re-submittal: ☐ No ☐ Yes

☐ Shop Drawings

☐ Product Data

☐ Schedule

☐ Sample

☐

☐ Test Report

☐ Certificate

☐ Color Sample

☐ Warranty

☐

Submittal Description:

LOMBARDO'S PROJECT MILESTONE SCHEDULE

Product Name:

Manufacturer:

LOMBARDO updated with current delivery dates

**Subcontractor/
Supplier:**

PEARLS CONSTRUCTION

References:

Spec. Section No.: 011100

Drawing No(s):

Paragraph:

Rm. or Detail No(s):

Architect's/ Engineer's Review Stamp

See comments on submittals. Several submittal have not been submitted per your schedule, please update.

Please update schedule to reflect starting work in January 2024.
The following may be completed second shift:

Barr MS:

1. Ceiling Removals & Refrigerant piping
2. Structural Steel
3. Condensate piping
4. Condensate pumps

5. Roof top fans

Nanuet HS:

1. Exhaust fans
2. Condensing units
3. Structural Steel
4. RTUs and curbs

The following may be completed during the school day:

Barr MS:

1. Condensing units, curbs, pitch pockets

Nanuet HS:

1. Boiler room pads
2. Boiler room hydronic piping
3. Setting of expansion tanks and pumps
4. Setting of heat exchanger
5. Crawl space hydronic piping

Remarks:

Contractor Review Statement:

These documents have been checked for accuracy and coordinated with job conditions and Contract requirements by this office and have been found to comply with the provisions of the Contract Documents.

Ronald J. Lombardo

10.31.23

Name:

Date:


Company Name:

Joe Lombardo Plumbing & Heating of Rockland Inc.

Jacobs Reviewed

Revise & Resubmit

11/01/2023 9:35:36 AM

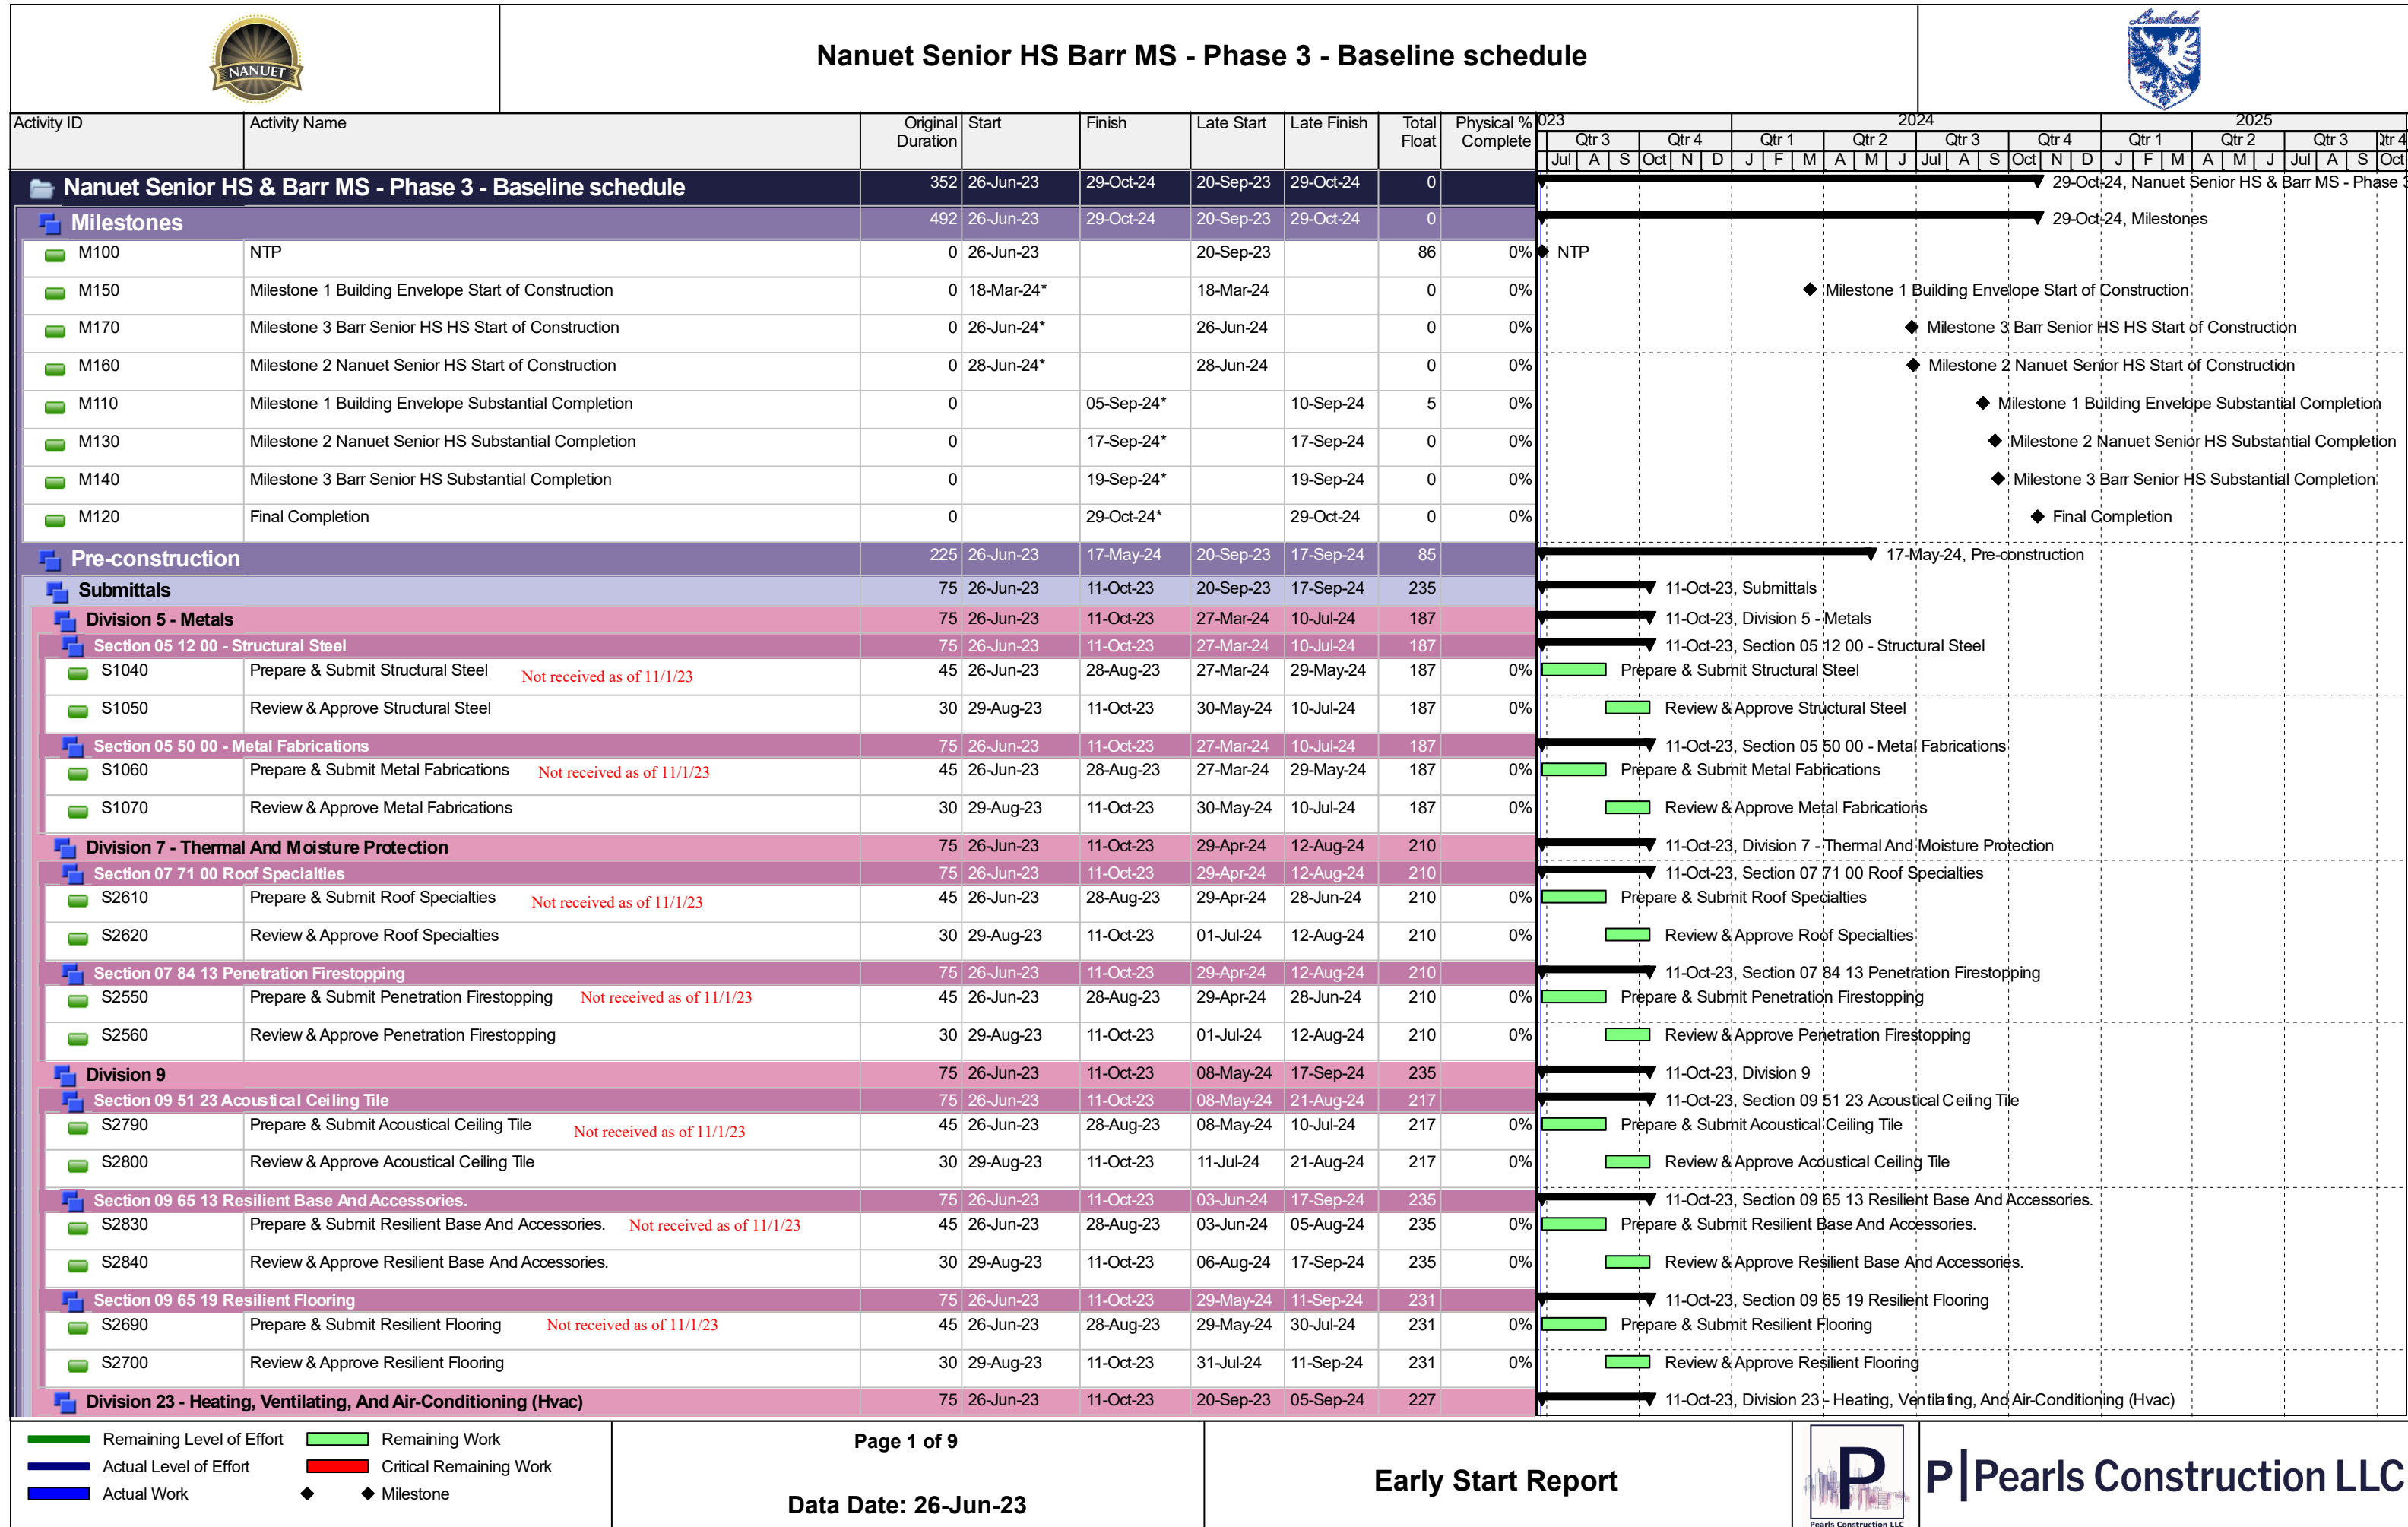

Nanuet Senior HS Barr MS - Phase 3 - Baseline schedule



Activity ID	Activity Name	Original Duration	Start	Finish	Late Start	Late Finish	Total Float	Physical % Complete	2023												2024												2025																
									Qtr 3			Qtr 4			Qtr 1			Qtr 2			Qtr 3			Qtr 4			Qtr 1			Qtr 2			Qtr 3			Qtr 4													
									Jul	A	S	Oct	N	D	J	F	M	A	M	J	Jul	A	S	Oct	N	D	J	F	M	A	M	J	Jul	A	S	Oct													
Section 23 05 01 Basic Hvac Materials And Methods									11-Oct-23, Section 23 05 01 Basic Hvac Materials And Methods																																								
S2530 Prepare & Submit Basic Hvac Materials And Methods									11-Oct-23, Section 23 05 01 Basic Hvac Materials And Methods																																								
S2540 Review & Approve Basic Hvac Materials And Methods									11-Oct-23, Section 23 05 01 Basic Hvac Materials And Methods																																								
Section 23 05 16 Expansion Fittings And Loops For Hvac Piping									11-Oct-23, Section 23 05 16 Expansion Fittings And Loops For Hvac Piping																																								
S2010 Prepare & Submit Expansion Fittings And Loops For Hvac Piping Reviewed as of 11/1/23									11-Oct-23, Section 23 05 16 Expansion Fittings And Loops For Hvac Piping																																								
S2020 Review & Approve Expansion Fittings And Loops For Hvac Piping									11-Oct-23, Section 23 05 16 Expansion Fittings And Loops For Hvac Piping																																								
Section 23 05 19 Meters And Gauges For Hvac Piping									11-Oct-23, Section 23 05 19 Meters And Gauges For Hvac Piping																																								
S1990 Prepare & Submit Meters And Gauges For Hvac Piping Furnish as corrected as of 11/1/23									11-Oct-23, Section 23 05 19 Meters And Gauges For Hvac Piping																																								
S2000 Review & Approve Meters And Gauges For Hvac Piping									11-Oct-23, Section 23 05 19 Meters And Gauges For Hvac Piping																																								
Section 23 05 48 Vibration Controls For Hvac Piping And Equipment									11-Oct-23, Section 23 05 48 Vibration Controls For Hvac Piping And Equipment																																								
S2110 Prepare & Submit Vibration Controls For Hvac Piping And Equipment Furnish as corrected as of 11/1/23									11-Oct-23, Section 23 05 48 Vibration Controls For Hvac Piping And Equipment																																								
S2120 Review & Approve Vibration Controls For Hvac Piping And Equipment									11-Oct-23, Section 23 05 48 Vibration Controls For Hvac Piping And Equipment																																								
Section 23 05 53 Identification For Hvac Piping And Equipment									11-Oct-23, Section 23 05 53 Identification For Hvac Piping And Equipment																																								
S2210 Prepare & Submit Identification For Hvac Piping And Equipment Reviewed as of 11/1/23									11-Oct-23, Section 23 05 53 Identification For Hvac Piping And Equipment																																								
S2220 Review & Approve Identification For Hvac Piping And Equipment									11-Oct-23, Section 23 05 53 Identification For Hvac Piping And Equipment																																								
Section 23 05 93 Testing, Adjusting, And Balancing For Hvac									11-Oct-23, Section 23 05 93 Testing, Adjusting, And Balancing For Hvac																																								
S2310 Prepare & Submit Testing, Adjusting, And Balancing For Hvac Reviewed as of 11/1/23									11-Oct-23, Section 23 05 93 Testing, Adjusting, And Balancing For Hvac																																								
S2320 Review & Approve Testing, Adjusting, And Balancing For Hvac									11-Oct-23, Section 23 05 93 Testing, Adjusting, And Balancing For Hvac																																								
Section 23 07 13 Duct Insulation									11-Oct-23, Section 23 07 13 Duct Insulation																																								
S2410 Prepare & Submit Duct Insulation Furnish as corrected as of 11/1/23									11-Oct-23, Section 23 07 13 Duct Insulation																																								
S2420 Review & Approve Duct Insulation									11-Oct-23, Section 23 07 13 Duct Insulation																																								
Section 23 07 16 Hvac Equipment Insulation									11-Oct-23, Section 23 07 16 Hvac Equipment Insulation																																								
S2510 Prepare & Submit HVAC Equipment Insulation Furnish as corrected as of 11/1/23 - need refrigerant piping									11-Oct-23, Section 23 07 16 Hvac Equipment Insulation																																								
S2520 Review & Approve HVAC Equipment Insulation									11-Oct-23, Section 23 07 16 Hvac Equipment Insulation																																								
Section 23 07 19 Hvac Piping Insulation									11-Oct-23, Section 23 07 19 Hvac Piping Insulation																																								
S1220 Prepare & Submit HVAC Piping Insulation Furnish as corrected as of 11/1/23 - need refrigerant piping									11-Oct-23, Section 23 07 19 Hvac Piping Insulation																																								
S1230 Review & Approve HVAC Piping Insulation									11-Oct-23, Section 23 07 19 Hvac Piping Insulation																																								
Section 23 08 00 Commissioning Of Hvac									11-Oct-23, Section 23 08 00 Commissioning Of Hvac																																								
S1970 Prepare & Submit Commissioning Of HVAC Not received as of 11/1/23									11-Oct-23, Section 23 08 00 Commissioning Of Hvac																																								
S1980 Review & Approve Commissioning Of HVAC									11-Oct-23, Section 23 08 00 Commissioning Of Hvac																																								
Section 23 09 23 Direct-Digital Control System For Hvac									11-Oct-23, Section 23 09 23 Direct-Digital Control System For Hvac																																								
S2090 Prepare & Submit Direct-Digital Control System For Hvac Not received as of 11/1/23									11-Oct-23, Section 23 09 23 Direct-Digital Control System For Hvac																																								
S2100 Review & Approve Direct-Digital Control System For Hvac									11-Oct-23, Section 23 09 23 Direct-Digital Control System For Hvac																																								
Section 23 21 13 Hydronic Piping									11-Oct-23, Section 23 21 13 Hydronic Piping																																								
S2190 Prepare & Submit Hydronic Piping Furnish as corrected as of 11/1/23									11-Oct-23, Section 23 21 13 Hydronic Piping																																								
S2200 Review & Approve Hydronic Piping									11-Oct-23, Section 23 21 13 Hydronic Piping																																								
Section 23 21 14 Hydronic Specialties									11-Oct-23, Section 23 21 14 Hydronic Specialties																																								

 Remaining Level of Effort
 Remaining Work

 Actual Level of Effort
 Critical Remaining Work


 Actual Work
 Milestone

Data Date: 26-Jun-23

Early Start Report



P | Pearls Construction LLC

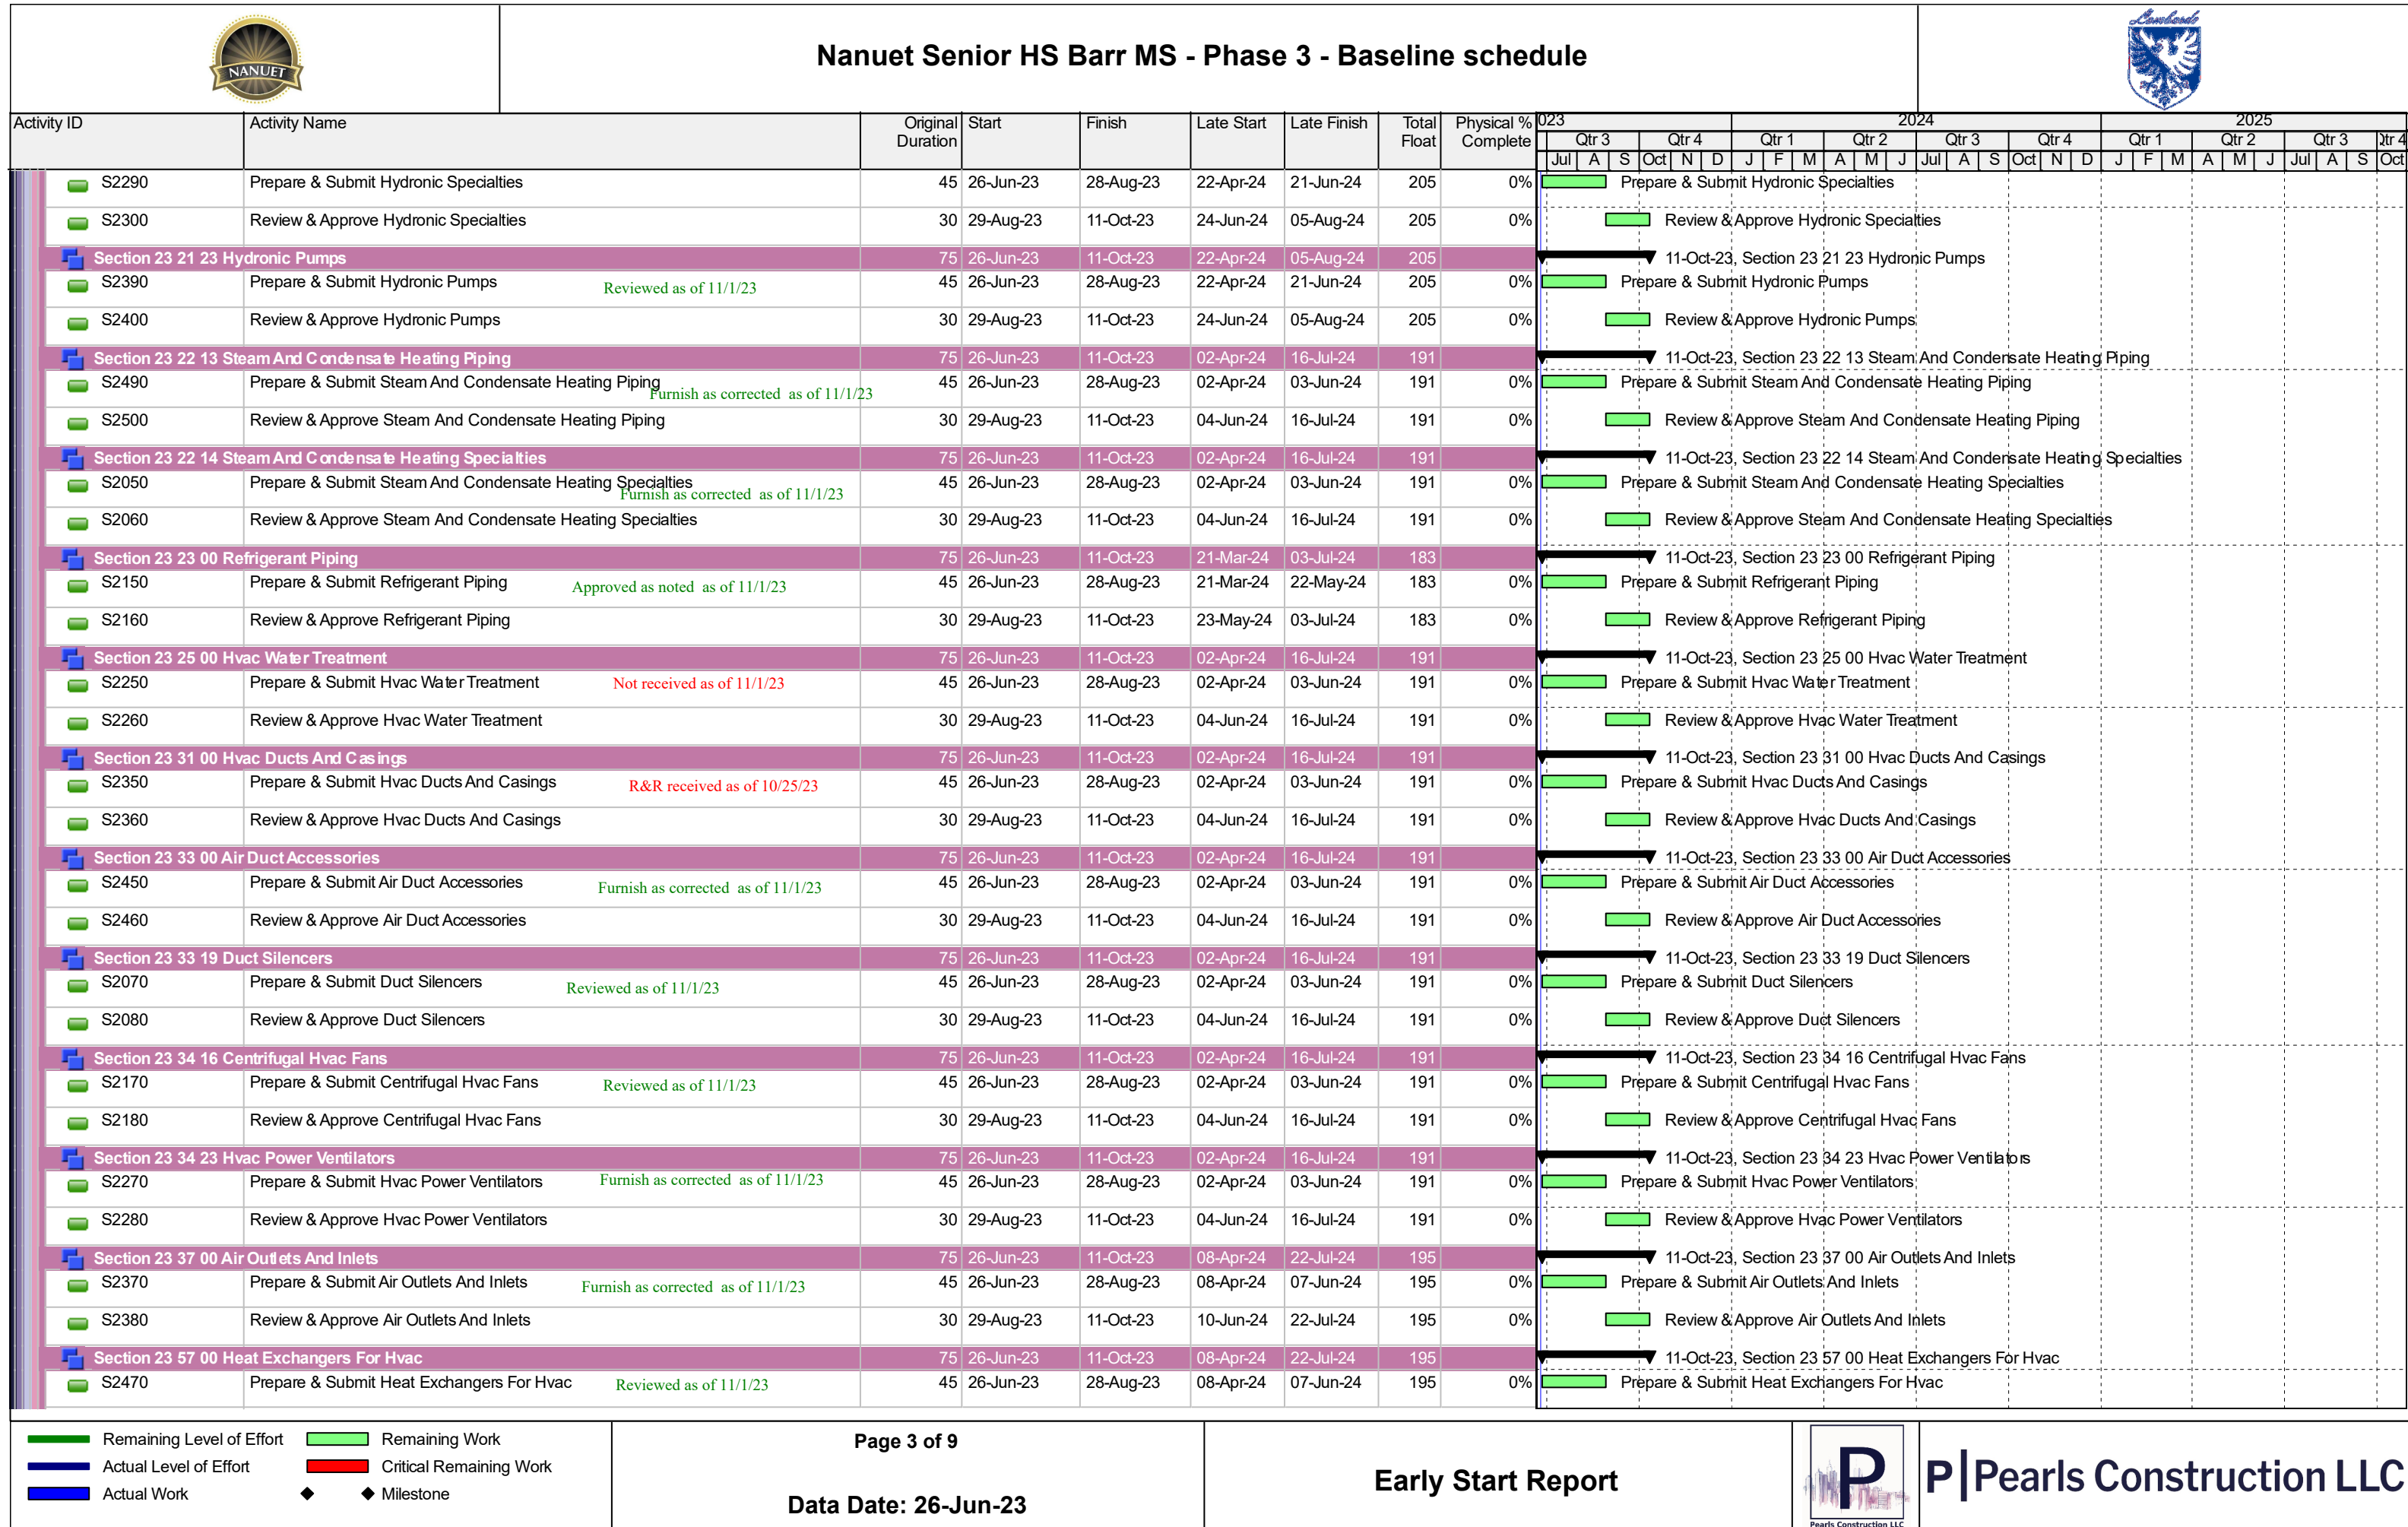



Nanuet Senior HS Barr MS - Phase 3 - Baseline schedule



Activity ID	Activity Name	Original Duration	Start	Finish	Late Start	Late Finish	Total Float	Physical % Complete	023		2024												2025																
									Qtr 3			Qtr 4			Qtr 1			Qtr 2			Qtr 3			Qtr 4			Qtr 1			Qtr 2			Qtr 3			Qtr 4			
									Jul	A	S	Oct	N	D	J	F	M	A	M	J	Jul	A	S	Oct	N	D	J	F	M	A	M	J	Jul	A	S	Oct			
	 S2480	Review & Approve Heat Exchangers For Hvac	30	29-Aug-23	11-Oct-23	10-Jun-24	22-Jul-24	195	0%			Review & Approve Heat Exchangers For Hvac																											
	 Section 23 62 13 Air Cooled Refrigerant Compressor And Condenser Unit		75	26-Jun-23	11-Oct-23	08-Apr-24	22-Jul-24	195			11-Oct-23, Section 23 62 13 Air Cooled Refrigerant Compressor And Condenser Unit																												
	 S2030	Prepare & Submit Air Cooled Refrigerant Compressor And Condenser Unit Not received as of 11/1/23	45	26-Jun-23	28-Aug-23	08-Apr-24	07-Jun-24	195	0%		Prepare & Submit Air Cooled Refrigerant Compressor And Condenser Unit																												
	 S2040	Review & Approve Air Cooled Refrigerant Compressor And Condenser Unit	30	29-Aug-23	11-Oct-23	10-Jun-24	22-Jul-24	195	0%			Review & Approve Air Cooled Refrigerant Compressor And Condenser Unit																											
	 Section 23 73 13 Indoor Air-Handling Units		75	26-Jun-23	11-Oct-23	13-Nov-23	04-Mar-24	96			11-Oct-23, Section 23 73 13 Indoor Air-Handling Units																												
	 S2130	Prepare & Submit Indoor Air-Handling Units Not received as of 11/1/23	45	26-Jun-23	28-Aug-23	13-Nov-23	19-Jan-24	96	0%		Prepare & Submit Indoor Air-Handling Units																												
	 S2140	Review & Approve Indoor Air-Handling Units	30	29-Aug-23	11-Oct-23	22-Jan-24	04-Mar-24	96	0%			Review & Approve Indoor Air-Handling Units																											
	 Section 23 74 13 Packaged Rooftop Units		75	26-Jun-23	11-Oct-23	08-Apr-24	22-Jul-24	195			11-Oct-23, Section 23 74 13 Packaged Rooftop Units																												
	 S2230	Prepare & Submit Packaged Rooftop Units Reviewed as of 11/1/23	45	26-Jun-23	28-Aug-23	08-Apr-24	07-Jun-24	195	0%		Prepare & Submit Packaged Rooftop Units																												
	 S2240	Review & Approve Packaged Rooftop Units	30	29-Aug-23	11-Oct-23	10-Jun-24	22-Jul-24	195	0%			Review & Approve Packaged Rooftop Units																											
	 Section 23 81 29 Variable Refrigerant Flow Hvac Systems		75	26-Jun-23	11-Oct-23	08-Apr-24	22-Jul-24	195			11-Oct-23, Section 23 81 29 Variable Refrigerant Flow Hvac Systems																												
	 S2330	Prepare & Submit Variable Refrigerant Flow Hvac Systems Not received as of 11/1/23	45	26-Jun-23	28-Aug-23	08-Apr-24	07-Jun-24	195	0%		Prepare & Submit Variable Refrigerant Flow Hvac Systems																												
	 S2340	Review & Approve Variable Refrigerant Flow Hvac Systems	30	29-Aug-23	11-Oct-23	10-Jun-24	22-Jul-24	195	0%			Review & Approve Variable Refrigerant Flow Hvac Systems																											
	 Section 23 82 00 Convection Heating And Cooling Units		75	26-Jun-23	11-Oct-23	08-Apr-24	22-Jul-24	195			11-Oct-23, Section 23 82 00 Convection Heating And Cooling Units																												
	 S2430	Prepare & Submit Convection Heating And Cooling Units Approved as noted as of 11/1/23	45	26-Jun-23	28-Aug-23	08-Apr-24	07-Jun-24	195	0%		Prepare & Submit Convection Heating And Cooling Units																												
	 S2440	Review & Approve Convection Heating And Cooling Units	30	29-Aug-23	11-Oct-23	10-Jun-24	22-Jul-24	195	0%			Review & Approve Convection Heating And Cooling Units																											
	 Division 26 - Electrical		75	26-Jun-23	11-Oct-23	10-May-24	23-Aug-24	219			11-Oct-23, Division 26 - Electrical																												
	 Section 26 29 23 Variable-Frequency Motor Controllers		75	26-Jun-23	11-Oct-23	10-May-24	23-Aug-24	219			11-Oct-23, Section 26 29 23 Variable-Frequency Motor Controllers																												
	 S1670	Prepare & Submit Variable-Frequency Motor Controllers Reviewed as of 11/1/23	45	26-Jun-23	28-Aug-23	10-May-24	12-Jul-24	219	0%		Prepare & Submit Variable-Frequency Motor Controllers																												
	 S1680	Review & Approve Variable-Frequency Motor Controllers	30	29-Aug-23	11-Oct-23	15-Jul-24	23-Aug-24	219	0%			Review & Approve Variable-Frequency Motor Controllers																											
	 Procurement		150	12-Oct-23	17-May-24	11-Jan-24	23-Aug-24	69			17-May-24, Procurement																												
	 S1300	Fabricate & Deliver R-MS-1 & 2	40	12-Oct-23	11-Dec-23	18-Jun-24	13-Aug-24	171	0%			Fabricate & Deliver R-MS-1 & 2																											
	 S1310	Fabricate & Deliver EF-8, 10, 21 & 23	150	12-Oct-23	17-May-24	11-Jan-24	12-Aug-24	60	0%			Fabricate & Deliver EF-8, 10, 21 & 23																											
	 S1320	Fabricate & Deliver Dampers	88	12-Oct-23	21-Feb-24	11-Apr-24	13-Aug-24	123	0%			Fabricate & Deliver Dampers																											
	 S1340	Fabricate & Deliver UV-MS- 1-41	63	12-Oct-23	16-Jan-24	28-May-24	22-Aug-24	155	0%			Fabricate & Deliver UV-MS- 1-41																											
	 S1350	Fabricate & Deliver HP-MS-3-9	60	12-Oct-23	10-Jan-24	20-May-24	12-Aug-24	150	0%			Fabricate & Deliver HP-MS-3-9																											
	 S1360	Fabricate & Deliver CV-HS-1-11	40	12-Oct-23	11-Dec-23	25-Jun-24	20-Aug-24	176	0%			Fabricate & Deliver CV-HS-1-11																											
	 S1370	Fabricate & Deliver UH-HS-1	20	12-Oct-23	08-Nov-23	29-Jul-24	23-Aug-24	199	0%			Fabricate & Deliver UH-HS-1																											
	 S1380	Fabricate & Deliver CUH- HS-1, 2, 3	40	12-Oct-23	11-Dec-23	25-Jun-24	20-Aug-24	176	0%			Fabricate & Deliver CUH- HS-1, 2, 3																											
	 S1390	Fabricate & Deliver R2-1, 2, 3, & 4	40	12-Oct-23	11-Dec-23	25-Jun-24	20-Aug-24	176	0%			Fabricate & Deliver R2-1, 2, 3, & 4																											
	 S1400	Fabricate & Deliver F-HS-2 & 3	150	12-Oct-23	17-May-24	11-Jan-24	12-Aug-24	60	0%			Fabricate & Deliver F-HS-2 & 3																											
	 S1410	Fabricate & Deliver L-1 Louver with bird screen	88	12-Oct-23	21-Feb-24	22-Apr-24	22-Aug-24	130	0%			Fabricate & Deliver L-1 Louver with bird screen																											
	 S1420	Fabricate & Deliver RTU-HS- 4 & 5	90	12-Oct-23	23-Feb-24	11-Apr-24	15-Aug-24	123	0%			Fabricate & Deliver RTU-HS- 4 & 5																											
	 S1430	Fabricate & Deliver BC-HS-1 & 2	28	12-Oct-23	21-Nov-23	03-May-24	11-Jun-24	139	0%			Fabricate & Deliver BC-HS-1 & 2																											
	 S1440	Fabricate & Deliver HC-HS-2 to 4	26	12-Oct-23	17-Nov-23	19-Jul-24	23-Aug-24	193	0%			Fabricate & Deliver HC-HS-2 to 4																											

Remaining Level of Effort

Actual Level of Effort

Actual Work

Remaining Work

Critical Remaining Work

Milestone



Nanuet Senior HS Barr MS - Phase 3 - Baseline schedule



Activity ID	Activity Name	Original Duration	Start	Finish	Late Start	Late Finish	Total Float	Physical % Complete	2023												2024												2025											
									Qtr 3			Qtr 4			Qtr 1			Qtr 2			Qtr 3			Qtr 4			Qtr 1			Qtr 2			Qtr 3			Qtr 4								
									Jul	A	S	Oct	N	D	J	F	M	A	M	J	Jul	A	S	Oct	N	D	J	F	M	A	M	J	Jul	A	S	Oct								
 S1450	Fabricate & Deliver AHU-HS-3	120	12-Oct-23	05-Apr-24	05-Mar-24	20-Aug-24	96	0%																																				
 S1460	Fabricate & Deliver ACCU-HS 2	34	12-Oct-23	01-Dec-23	28-Jun-24	15-Aug-24	179	0%																																				
 S1470	Fabricate & Deliver CP-HS-2	140	12-Oct-23	03-May-24	08-Feb-24	23-Aug-24	79	0%																																				
 S1480	Fabricate & Deliver HX-HS-2	40	12-Oct-23	11-Dec-23	28-Jun-24	23-Aug-24	179	0%																																				
 S1490	Fabricate & Deliver P-HS-3 & 4	120	12-Oct-23	05-Apr-24	05-Mar-24	20-Aug-24	96	0%																																				
 S1500	Fabricate & Deliver B&G Suction Diffuser	80	12-Oct-23	08-Feb-24	28-Mar-24	18-Jul-24	113	0%																																				
 S1510	Fabricate & Deliver B&G Triple Duty Valve	100	12-Oct-23	08-Mar-24	29-Feb-24	18-Jul-24	93	0%																																				
 S1520	Fabricate & Deliver Flex Hose 6"X 24"	30	12-Oct-23	27-Nov-23	15-Jul-24	23-Aug-24	189	0%																																				
 S1530	Fabricate & Deliver EXP-HS-2 & 3	80	12-Oct-23	08-Feb-24	03-May-24	23-Aug-24	139	0%																																				
 S1540	Fabricate & Deliver Flex Hose Exp Loops	30	12-Oct-23	27-Nov-23	15-Jul-24	23-Aug-24	189	0%																																				
 S3200	Fabricate & Deliver FT-MS-1	35	12-Oct-23	04-Dec-23	05-Jul-24	22-Aug-24	183	0%																																				
 Construction		209	22-Nov-23	19-Sep-24	07-Jun-24	19-Sep-24	0																																					
 Mobilization		10	22-Nov-23	07-Dec-23	12-Jun-24	25-Jun-24	139																																					
 C6920	Mobilization & Site Prep.	10	22-Nov-23	07-Dec-23	12-Jun-24	25-Jun-24	139	0%																																				
 Nanuet Senior HS		130	18-Mar-24	17-Sep-24	07-Jun-24	17-Sep-24	0																																					
 Demolition		14	28-Jun-24	18-Jul-24	28-Jun-24	18-Jul-24	0																																					
 C5910	Remove Spandrel Panels In Existing Storefront Window System - Basement - Nanuet Senior HS	1	28-Jun-24	28-Jun-24	28-Jun-24	28-Jun-24	0	0%																																				
 C7030	Remove HVAC Ducts & Piping - Nanuet Senior HS	14	28-Jun-24	18-Jul-24	28-Jun-24	18-Jul-24	0	0%																																				
 C5920	Remove Unit Ventilator - First Floor - Nanuet Senior HS	1	01-Jul-24	01-Jul-24	01-Jul-24	01-Jul-24	0	0%																																				
 C5950	Remove & Salvage Existing Wainscoting Pipe Enclosure - First Floor - Nanuet Senior HS	1	02-Jul-24	02-Jul-24	02-Jul-24	02-Jul-24	0	0%																																				
 C5930	Remove Spandrel Panels In Existing Storefront Window System - Second Floor - Nanuet Senior HS	1	03-Jul-24	03-Jul-24	03-Jul-24	03-Jul-24	0	0%																																				
 Asbestos Abatement Nanuet Senior HS		83	18-Mar-24	11-Jul-24	07-Jun-24	11-Jul-24	0																																					
 C5830	Perform Asbestos Abatement @ Roof - Nanuet Senior HS NOT MC SCOPE - THIS IS BY GC	15	18-Mar-24	05-Apr-24	07-Jun-24	27-Jun-24	59	0%																																				
 C5820	Perform Asbestos Abatement @ Second Floor - Nanuet Senior HS WHERE IS THIS SCOPE? CLASSROOM WING FLOORS IS BY GC. NO HVAC SCOPE	5	05-Jul-24	11-Jul-24	05-Jul-24	11-Jul-24	0	0%																																				
 Basement		47	12-Jul-24	17-Sep-24	12-Jul-24	17-Sep-24	0																																					
 Architectural		6	10-Sep-24	17-Sep-24	10-Sep-24	17-Sep-24	0																																					
 C6870	Patch Ceilings - Basement - Nanuet Senior HS NEEDS TO BE PERFORED SECOND SHIFT.	2	10-Sep-24	11-Sep-24	10-Sep-24	11-Sep-24	0	0%																																				
 C6910	Patch Walls - Basement - Nanuet Senior HS NEEDS TO BE PERFORED SECOND SHIFT.	3	12-Sep-24	16-Sep-24	12-Sep-24	16-Sep-24	0	0%																																				
 C6760	Patch Flooring - Basement - Nanuet Senior HS NEEDS TO BE PERFORED SECOND SHIFT.	1	17-Sep-24	17-Sep-24	17-Sep-24	17-Sep-24	0	0%																																				
 Mechanical		41	12-Jul-24	09-Sep-24	12-Jul-24	09-Sep-24	0																																					
 C6600	Install Mechanical Ducts & Pipes Hangers - Basement - Nanuet Senior HS	2	12-Jul-24	15-Jul-24	12-Jul-24	15-Jul-24	0	0%																																				
 C6630	Install Above ceiling Terminal Equipment - Basement - Nanuet Senior HS	6	16-Jul-24	23-Jul-24	25-Jul-24	01-Aug-24	7	0%																																				
 C6610	Install HVAC Ducts & Pipes - Basement - Nanuet Senior HS	10	19-Jul-24	01-Aug-24	19-Jul-24	01-Aug-24	0	0%																																				
 C6620	Insulate HVAC Ducts & Pipes - Basement - Nanuet Senior HS	8	02-Aug-24	13-Aug-24	02-Aug-24	13-Aug-24	0	0%																																				
 C6640	Mechanical Rough-Ins Inspection - Basement - Nanuet Senior HS	3	14-Aug-24	16-Aug-24	14-Aug-24	16-Aug-24	0	0%																																				

Remaining Level of Effort

Actual Level of Effort

Actual Work

Remaining Work

Critical Remaining Work

Milestone



[illegible]



Nanuet Senior HS Barr MS - Phase 3 - Baseline schedule



Activity ID	Activity Name	Original Duration	Start	Finish	Late Start	Late Finish	Total Float	Physical % Complete	2023												2024												2025																																																																																																																																																																																																																																																																																																																																																																																																																																																																																																																																																																																																																																																																																																																																																																																																																																																																																																																																																																																																																																																																																																																																																																																																																																																												
									Qtr 3			Qtr 4			Qtr 1			Qtr 2			Qtr 3			Qtr 4			Qtr 1			Qtr 2			Qtr 3			Qtr 4																																																																																																																																																																																																																																																																																																																																																																																																																																																																																																																																																																																																																																																																																																																																																																																																																																																																																																																																																																																																																																																																																																																																																																																																																																																									
									Jul	A	S	Oct	N	D	J	F	M	A	M	J	Jul	A	S	Oct	N	D	J	F	M	A	M	J	Jul	A	S	Oct																																																																																																																																																																																																																																																																																																																																																																																																																																																																																																																																																																																																																																																																																																																																																																																																																																																																																																																																																																																																																																																																																																																																																																																																																																																									
	C5870	Remove Roof Top Exhaust Fan & All Associated Controls & Wiring - Roof - Nanuet Senior HS	8	28-Jun-24	10-Jul-24	28-Jun-24	10-Jul-24	0	0%																																																																																																																																																																																																																																																																																																																																																																																																																																																																																																																																																																																																																																																																																																																																																																																																																																																																																																																																																																																																																																																																																																																																																																																																																																																																																				</

Remaining Level of Effort

Actual Level of Effort


Actual Work

Remaining Work

Critical Remaining Work

Milestone



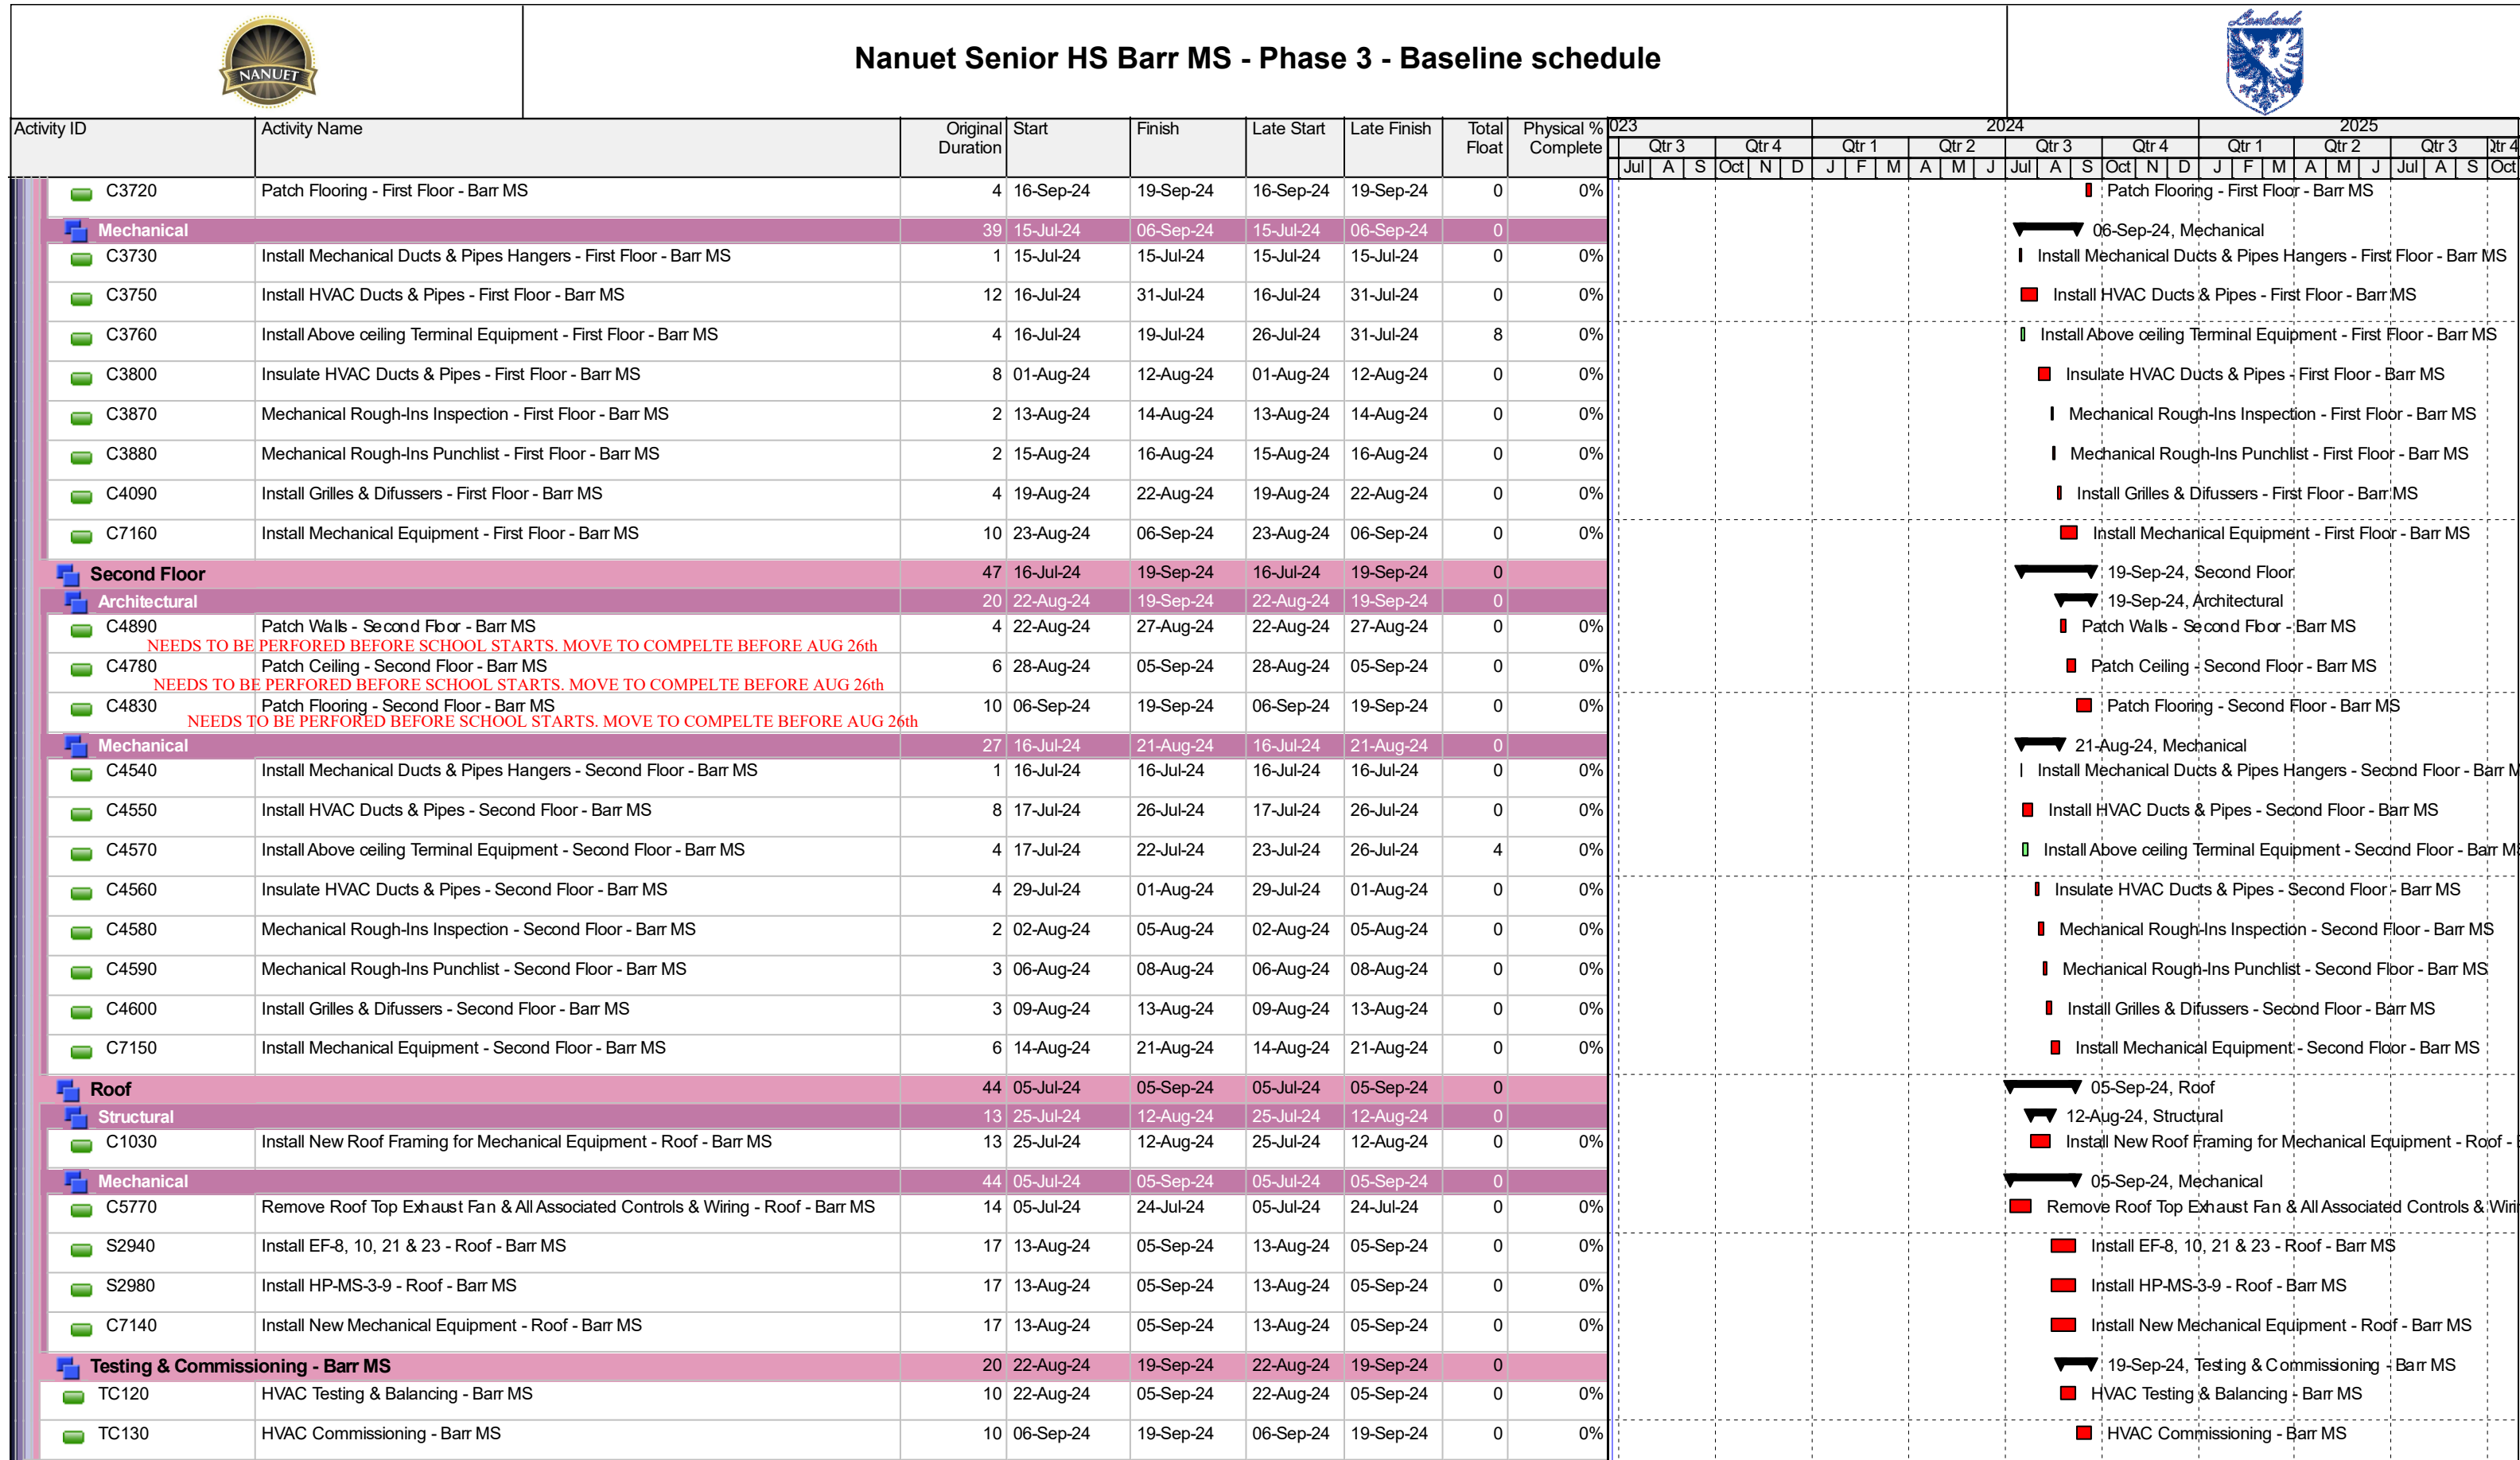



Nanuet Senior HS Barr MS - Phase 3 - Baseline schedule

