

SUBMITTAL COVERSHEET Nanuet UFSD –Phase 3 Projects

Architect:
KSQ Architects
215 W 40th Street, 15th Floor
New York, NY 10018

Owner:
Nanuet Union Free School District
101 Church Street
Nanuet, NY 10954

Construction Manager:
Jacobs
One Penn Plaza, 54th floor
New York, NY 10019

Contractor: Joe Lombardo Plumbing & Heating of Rockland Inc

Contract: Ron Lombardo

Address: 321 Spook Rock Road Suite 109A
Suffern, New York 10901

845-357-6537
Telephone:

845-357-8529
Fax:

School Name: Nanuet Union Free School District Phase 3 Bond Projects @ Barr Middle School & Nanuet High School

Type of Submittal:

Re-submittal: [] No [] Yes

- | | | | | |
|--|---------------------------------------|---------------------------------------|-----------------------------------|--------------------------------|
| <input type="checkbox"/> Shop Drawings | <input type="checkbox"/> Product Data | <input type="checkbox"/> Schedule | <input type="checkbox"/> Sample | <input type="checkbox"/> _____ |
| <input type="checkbox"/> Test Report | <input type="checkbox"/> Certificate | <input type="checkbox"/> Color Sample | <input type="checkbox"/> Warranty | <input type="checkbox"/> _____ |

Submittal Description:

shop dwg mechanical piping high school basment part plan area 1

Product Name: _____

Manufacturer: lombardo

Subcontractor/ Supplier: Elite drafting

References:

Spec. Section No.: 230000

Drawing No(s): _____

Paragraph: _____

Rm. or Detail No(s): _____

Architect's/ Engineer's Review Stamp

SAGE ENGINEERING ASSOCIATES, LLP

<input type="checkbox"/> Reviewed	<input checked="" type="checkbox"/> Furnish as Corrected
<input type="checkbox"/> Rejected	<input type="checkbox"/> Revise and Resubmit
<input type="checkbox"/> Submit Specified Item	

This review is only for general conformance with the design concept and the information given in the Construction Documents. Corrections or comments made on the shop drawings during this review do not relieve the contractor from compliance with the requirements of the plans and specifications. Review of a specific item shall not include review of an assembly of which the item is a component. The Contractor is responsible for dimensions to be confirmed and correlated at the jobsite; information that pertains solely to the fabrication processes or to the means, methods, techniques, sequences and procedures of construction; coordination of the Work with that of all other trades and performing all Work in a safe and satisfactory manner.

SAGE LOG NO. M-33

Date: 11/22/2023 By: J. Venditte

Contractor Review Statement:

These documents have been checked for accuracy and coordinated with job conditions and Contract requirements by this office and have been found to comply with the provisions of the Contract Documents.

Ronald J. Lombardo

11-21-23

Name:


Date:

Company Name:

Joe Lombardo Plumbing & Heating of Rockland Inc.

1. Refer to comments on attached shop drawing.

Remarks:

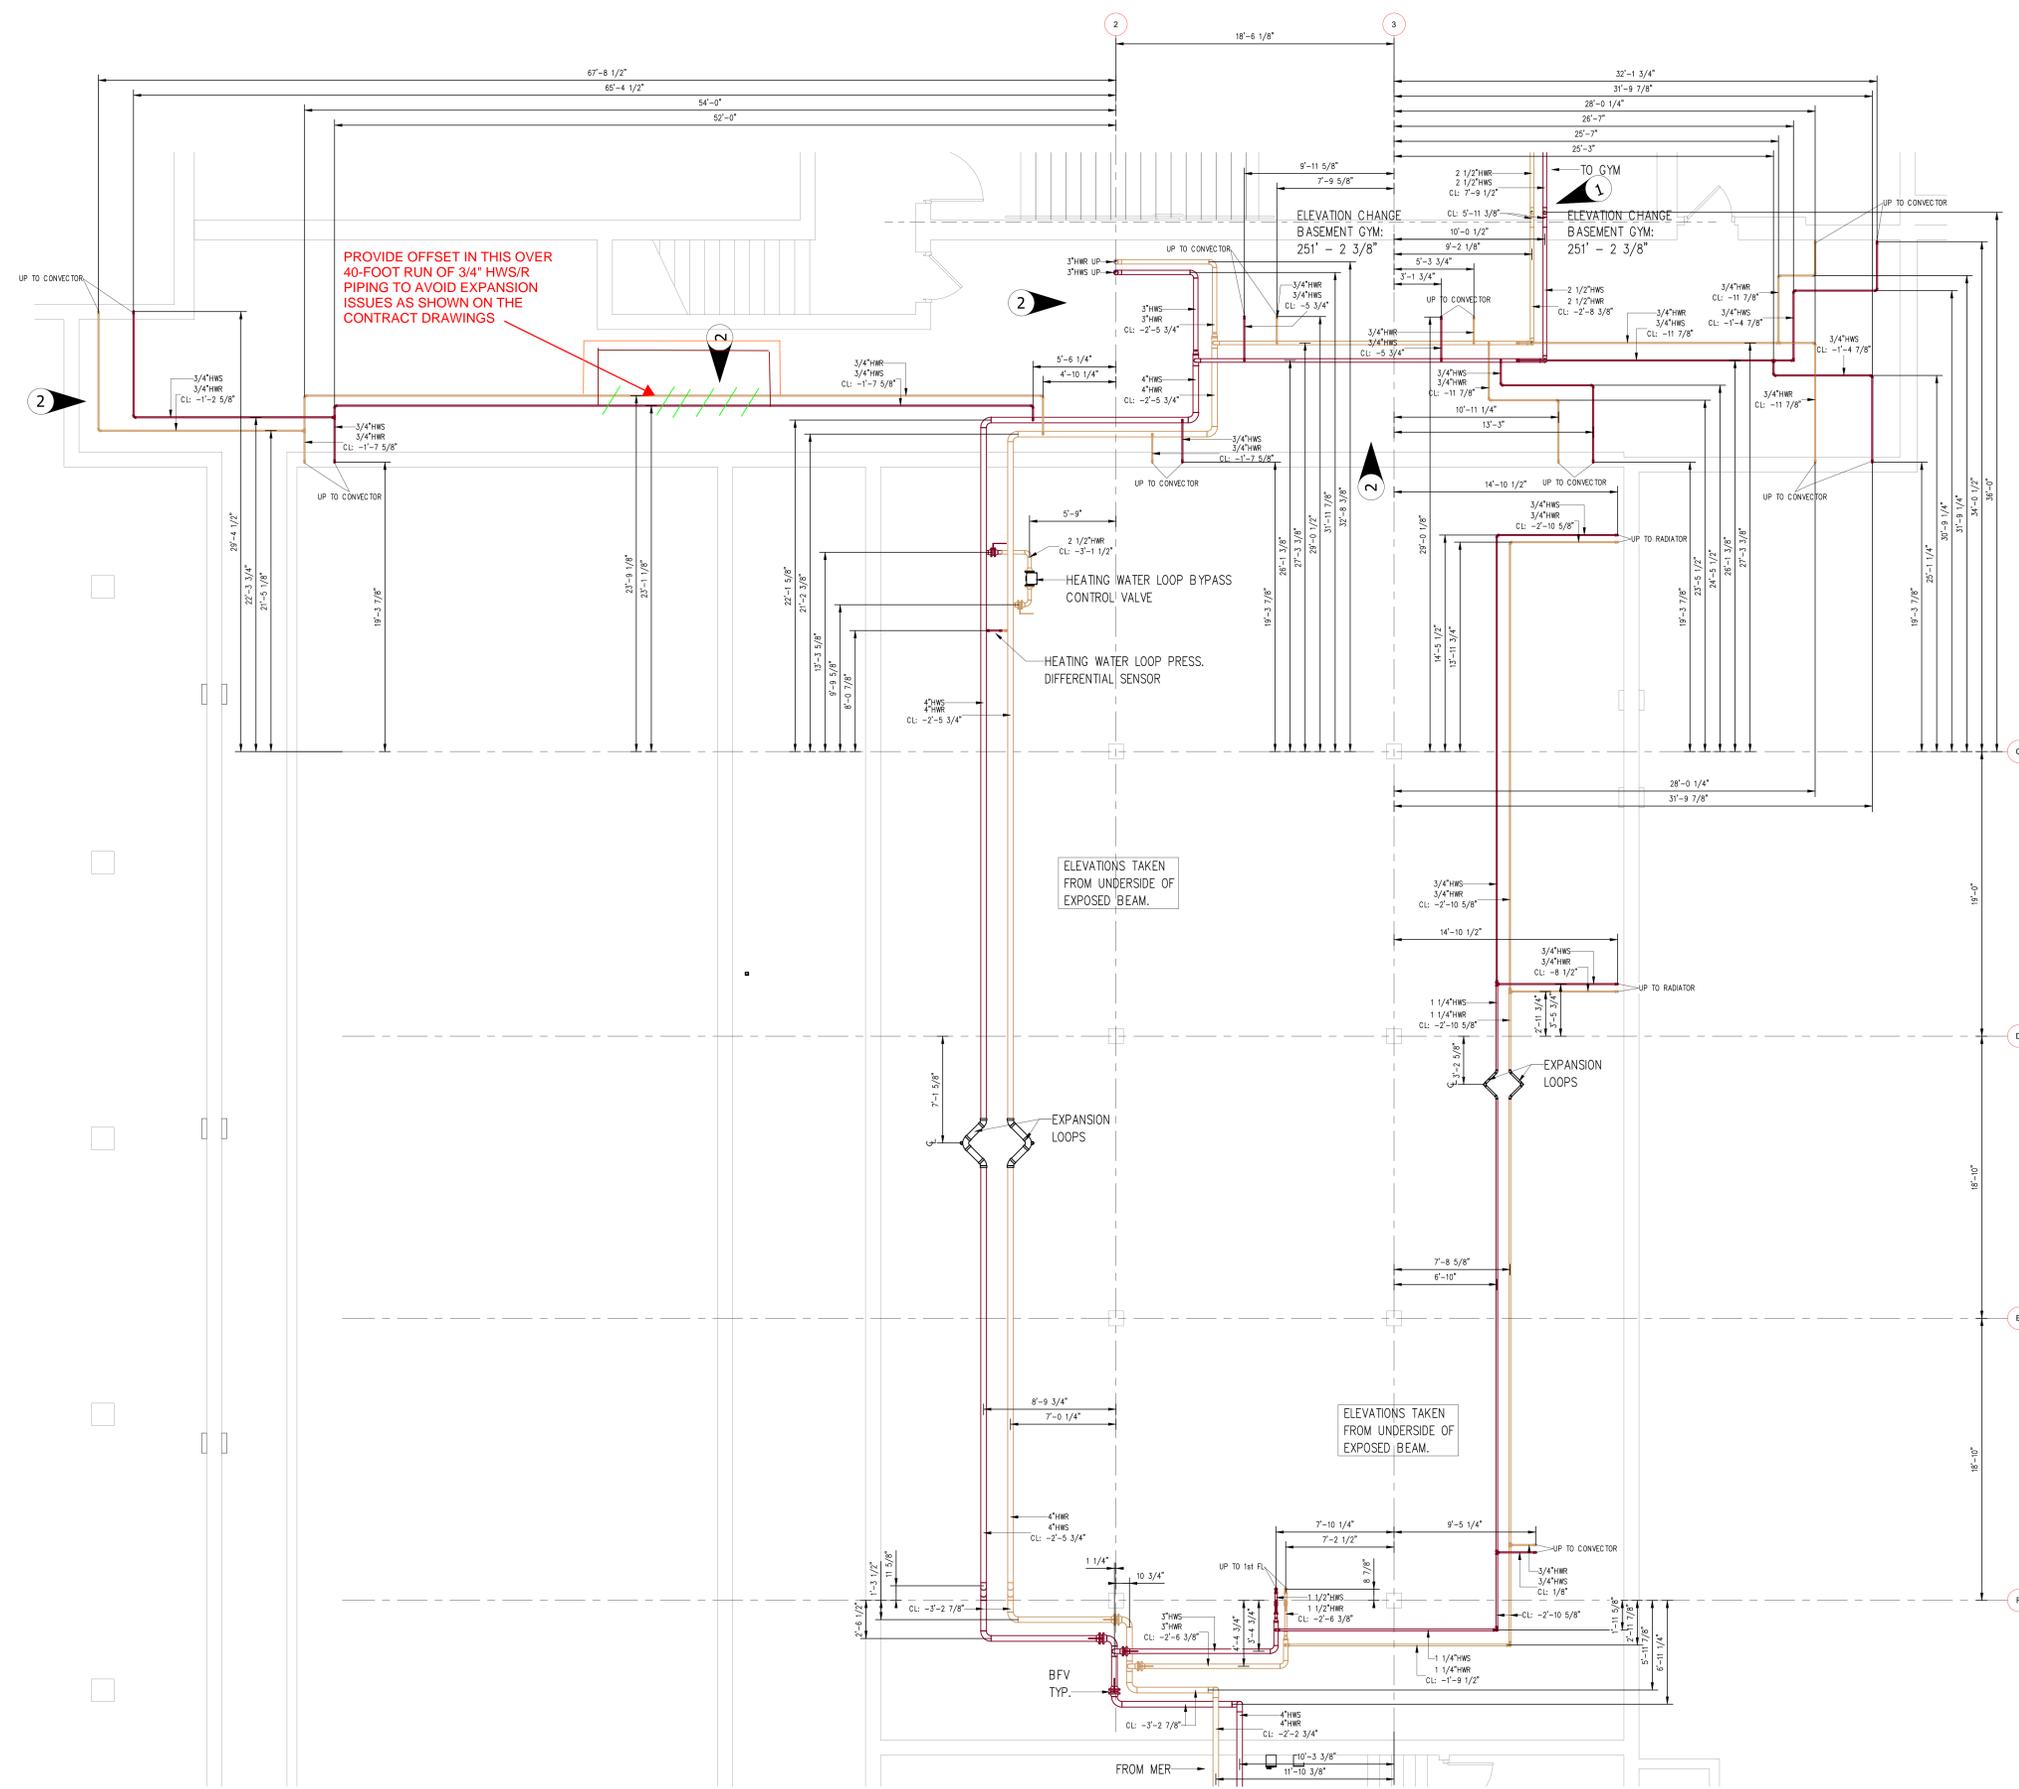

PROVIDE OFFSET IN THIS OVER 40-FOOT RUN OF 3/4\"/>

ELEVATIONS TAKEN FROM UNDERSIDE OF EXPOSED BEAM.

ELEVATIONS TAKEN FROM UNDERSIDE OF EXPOSED BEAM.

- DRAWING NOTES AND SYMBOLS**
- ELEVATIONS TAKEN FROM UNDERSIDE OF CRAWLSPACE BEAM: 25'-0 1/8" (UNLESS OTHERWISE INDICATED).
 - COLUMN LINES NOT PRESENT. COLUMN LINES CREATED FROM ARCHITECTURAL BACKGROUND. VERIFY IN FIELD.

REFERENCE DRAWINGS

TRADE	DESCRIPTION	DATE	REV
MECH	MECHANICAL PIPING		
PLUMB	PLUMBING		
ELECTR	ELECTRICAL		
STRUCT	STRUCTURAL		
MECH	MECHANICAL		

RECORD OF TRADE COORDINATION

TRADE	COMPANY	DATE	AUTHORIZED SIGNATURE
MECH			
PLUMB			
ELECTR			
MECH			

COORDINATION NOTE

ELITECAD DESIGNERS SHALL NOT BE RESPONSIBLE FOR ANY CONSTRUCTION ERRORS OR OMISSIONS THAT MAY RESULT FROM COORDINATION MADE BY THE CLIENT BASED ON THE INFORMATION PROVIDED OR FROM CHANGES REQUESTED BY THE CLIENT. THE CLIENT SHALL BE RESPONSIBLE FOR OBTAINING THE NECESSARY PERMITS AND APPROVALS FROM THE LOCAL JURISDICTION.

- ARCHITECT / ENGINEER NOTES:**
- CRAWL SPACE EXISTING CONDITIONS CONSTRAIN ENTRY INTO GYM. PIPING CURRENTLY IN CONFLICT WITH GYM MIRROR.
 - POOR VISIBILITY IN THIS SECTION OF CRAWLSPACE. VERIFY IN FIELD.

FOR APPROVAL

VERIFY THAT LINE ABOVE IS 1" LONG. PRINT MAY HAVE BEEN REDUCED.

REV	DATE	DESCRIPTION
0	11/17/2023	SUBMITTED FOR APPROVAL

