



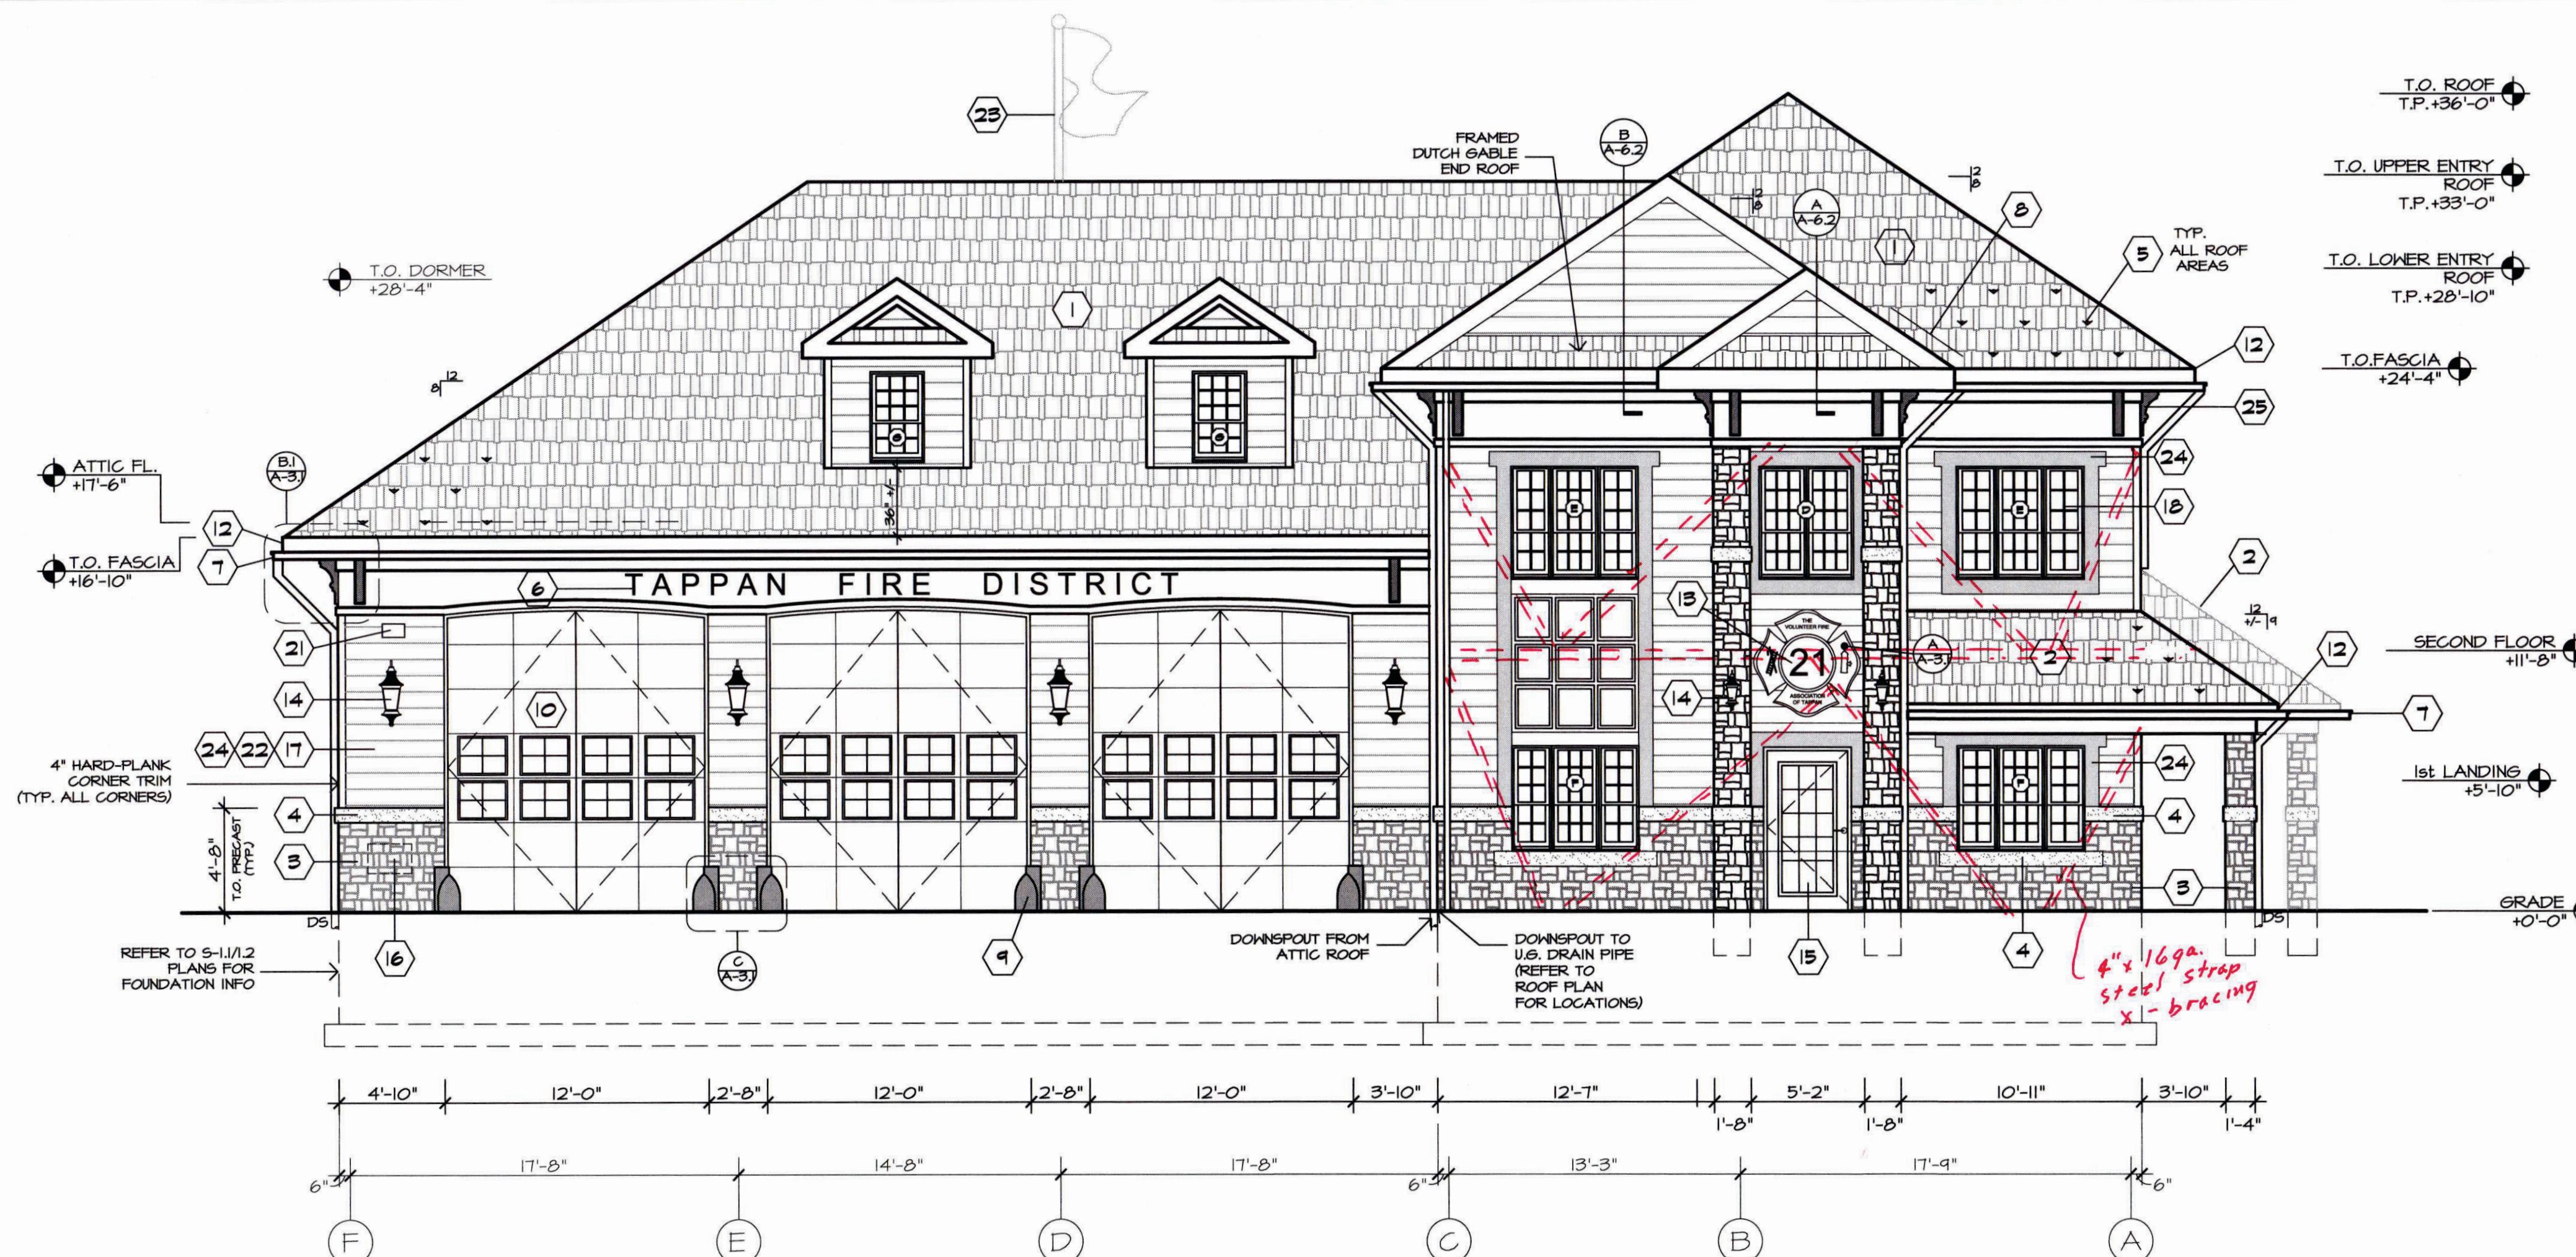

NORTH ELEVATION
SCALE: 3/16" = 1'-0"

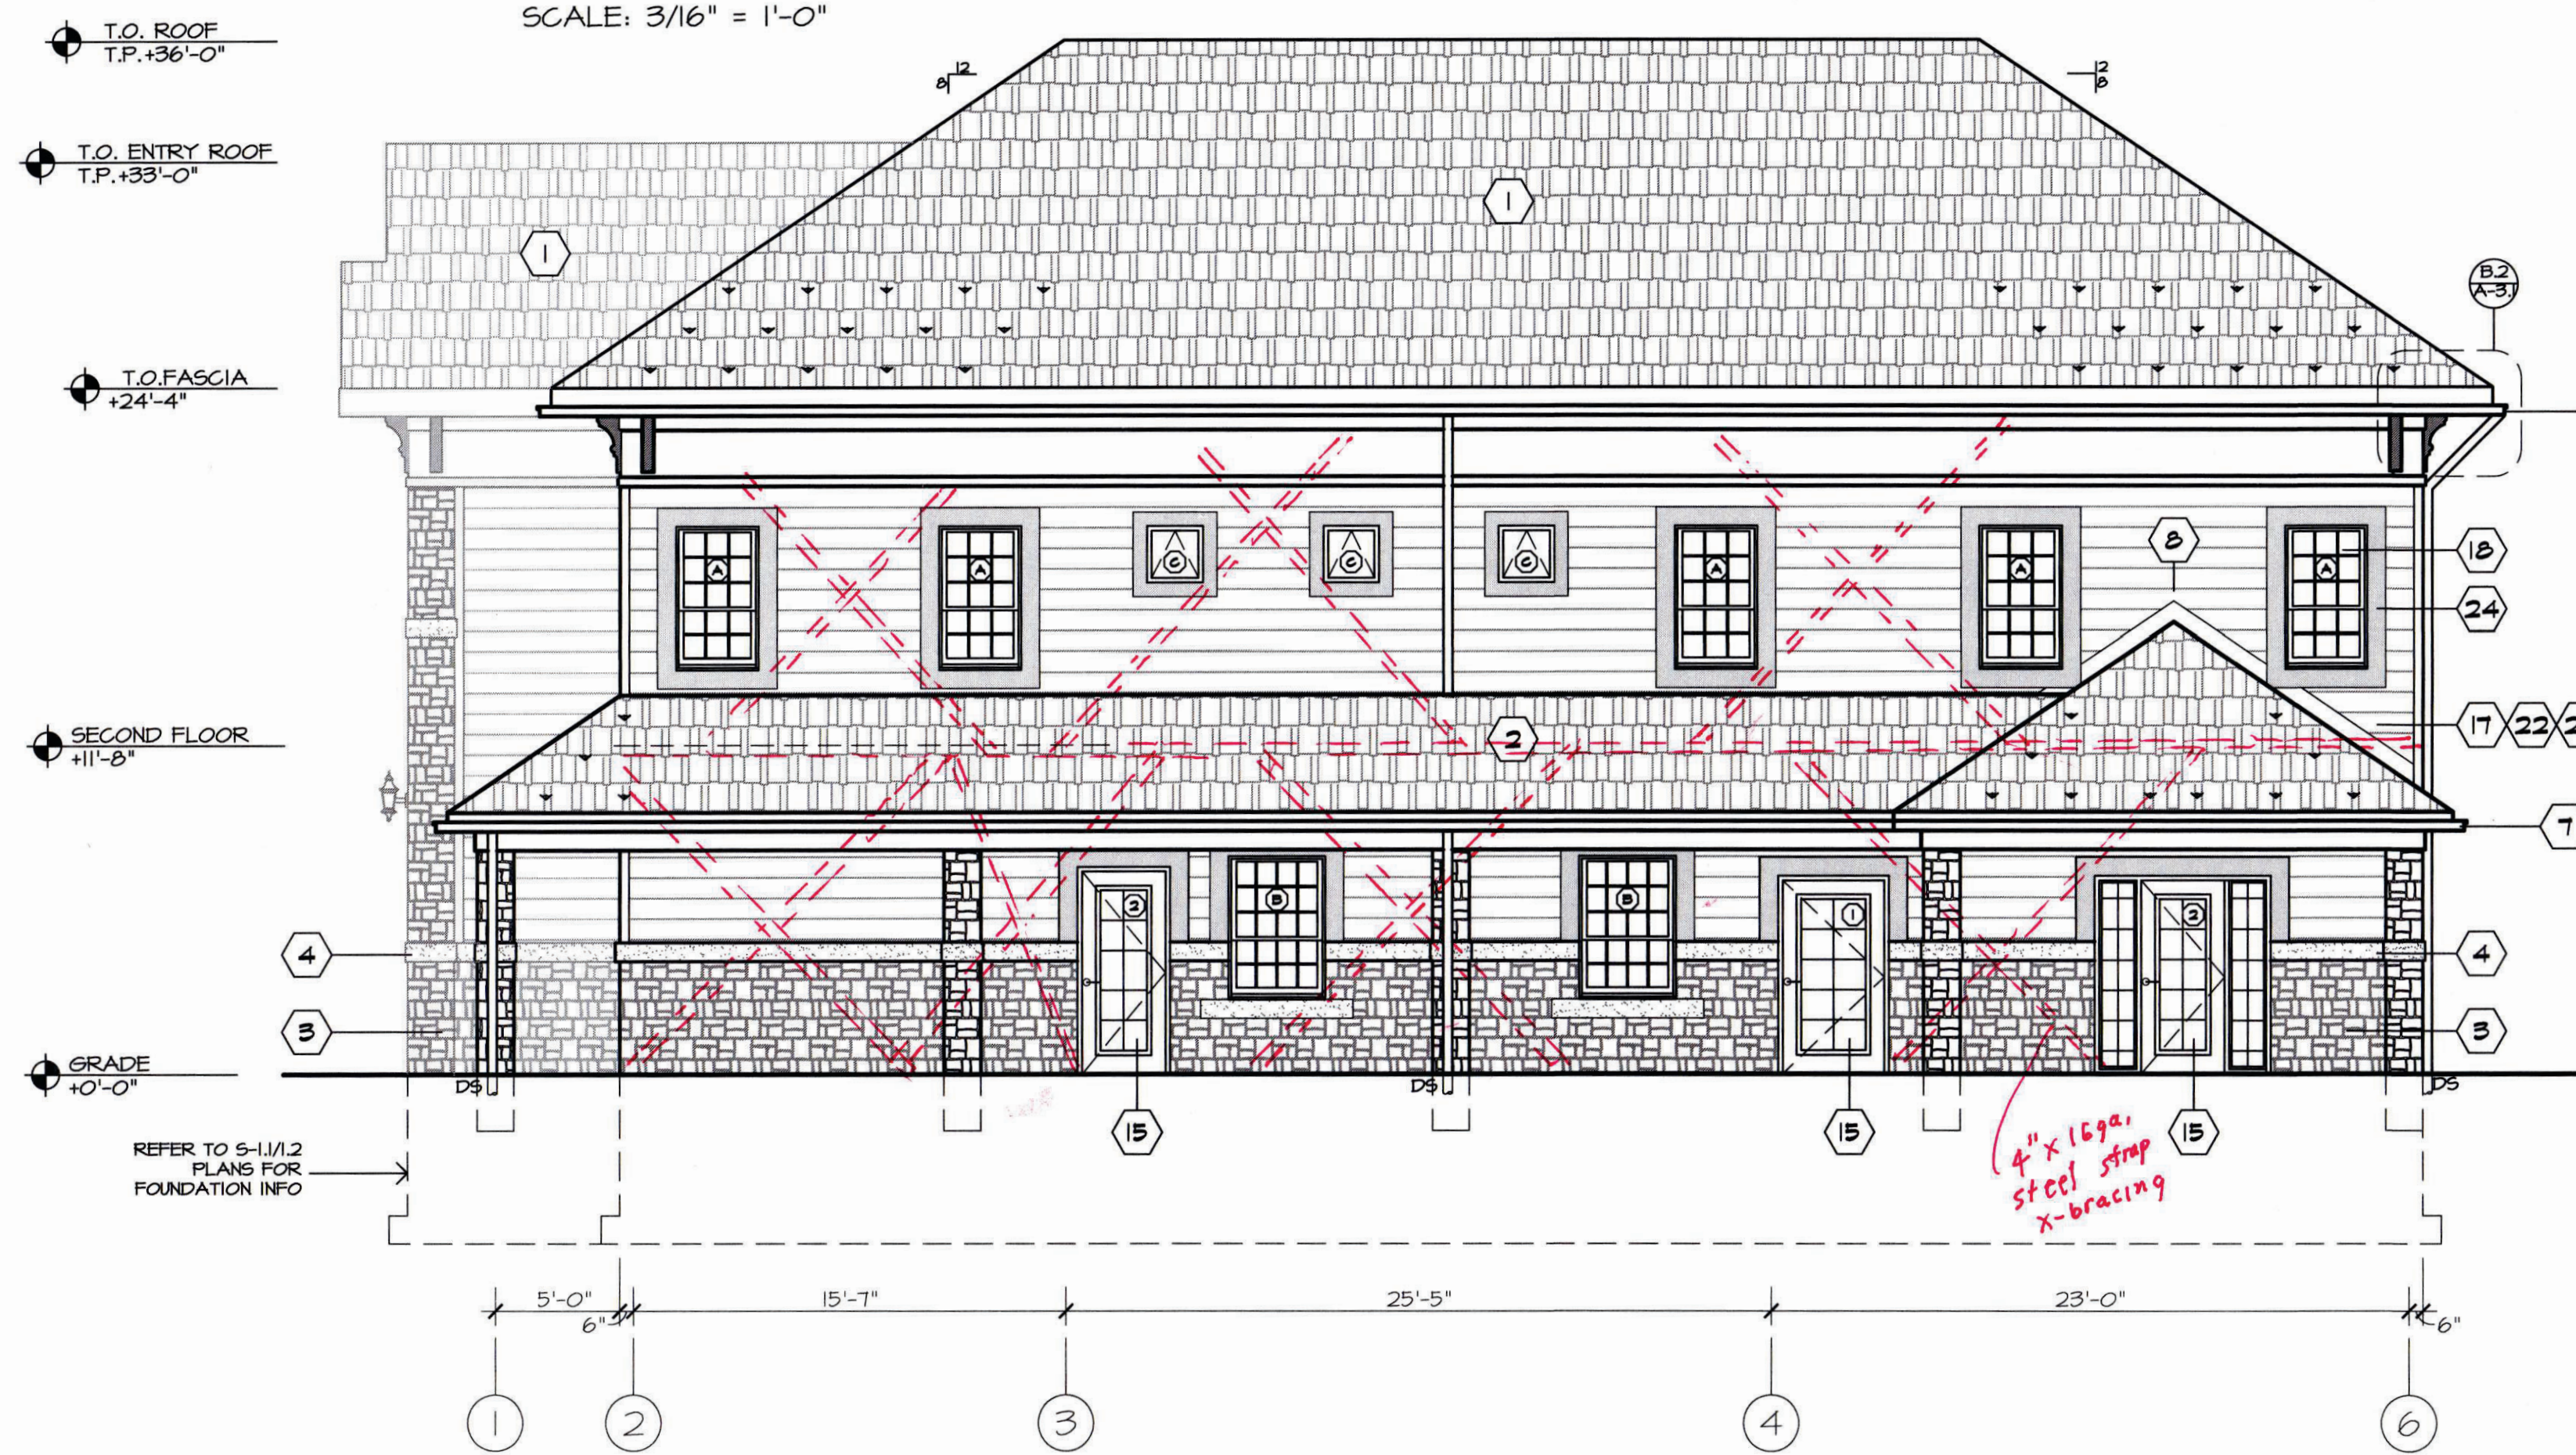


WEST ELEVATION
SCALE: 3/16" = 1'-0"


LEGEND

1. ALL SLOPED ROOF AREAS SHALL BE TRUSS/9"X12" SIZED W/ 1/2" HOMASOTE NFRG ROOF DECKING W/ TYVEK PROTECT UNDERLAYMENT FELT AND 6.4" TYPESCREEN ROOFING SHINGLES (OR EQUAL) TYPICAL. COLOR: SLATE. TO BE CONFIRMED BY OWNER.
2. LOW ROOF AREAS SHALL BE 8" MARINO C JOIST @ 16" O.C. W/ TYVEK PROTECT UNDERLAYMENT FELT AND SAME ROOF SHINGLES AS NOTE 1, W/ 1/2" HOMASOTE NFRG DECK.
3. EXTERIOR MASONRY VENEER SHALL BE 60/40 MIXTURE OF SHOULDICE ESTATE STONE 'NORTON' (60%) & SHOULDICE ESTATE STONE 'HAMPTON' (40%), BY KINGS MATERIALS.
4. HORIZONTAL ACCENT BANDS SHALL BE 8"x4" MAX LENGTH PRECAST ROCK-CAST SELECT STONE SPLIT-FACE FINISH, OR EQUAL. COLOR TO BE SELECTED BY OWNER.
5. COPPER SNOWGUARD BY 'ALPINE SNOW GUARDS' MODEL #40R SNOWGUARD.
6. NUMBERS/LETTERS SHALL BE METAL ARTS OR EQUAL (800) 231-8064, CAST METAL LETTERS 18" HIGH X 3/4" DEEP TIMES BD. 210 STYLE WITH #20 ACRYLIC BAKED ENAMEL FINISH. MOUNT WITH PWS-3 ALUMINUM TUBE SPACERS. VERIFY FINISH COLOR W/ OWNER.
7. GUTTER SHALL BE SAJF 6" CORNIAL GUTTER SYSTEM W/ 4"x4" DOWNSPOUTS.
8. STRAIGHT LINE FLASHING, TYPICAL ALL ROOF AREAS.
9. 24"x12" HEAVY DUTY CAST IRON WHEEL GUARD BY TRENCH DRAIN SUPPLY (MODEL: R-4486-D6) WITH PAINT FINISH, COLOR SELECTED BY OWNER.
10. NEW 12'-0"X14'-0" FOUR-FOLD APPARATUS BAY DOOR. DOORS SHALL BE BY DOOR ENGINEERING MODEL #FF300, INSULATED DOORS WITH RED FINISH.
11. NEW HOLLOW-METAL INSULATED DOOR & FRAME. PROVIDE 4" HEAD AT MASONRY LOCATIONS.
12. FASCIA & TRIM SHALL BE PRE-PRIMED 5/4X12 W/ D62 ALUM. WRAP (COLOR: WHITE).
13. 5'-0" DIA. CUSTOM MALTESE CROSS, REFER TO DETAIL 'A' ON A-3.1, GC TO PROVIDE & INSTALL W/ ASSOCIATED MOUNTS, HARNESS, TRANSFORMER, ETC... TO MAKE COMPLETE. ELECTRICIAN SHALL MAKE FINAL POWER WIRING CONNECTION.
14. DECORATIVE LIGHTS. REFER TO ELECTRICAL DRAWINGS FOR FIXTURE TYPE. MOUNT BOX 8'-0" TO BOTTOM.
15. STOREFRONT ALUM./GLASS DOOR UNITS SHALL BE KANNEER 350T SERIES. APPLIES TO DOORS 10'1A, 10'1B, 10'2A, 10'2B, 1-02, 1-03 & 1-14.
16. 16" X 24" BRONZE PLAQUE (SIMILAR TO DMS, 0-0 PLAQUE DETAIL) TO BE CAST W/ CUSTOM TEXT/DATE, TO BE CONFIRMED W/ OWNER.
17. COORDINATE ALL EXTERIOR OUTLETS IN MASONRY WITH ELECTRICAL CONTRACTOR.
18. WINDOWS SHALL BE ANDERSEN 400 SERIES 'STORM WATCH' TYPICAL. REFER TO DRAWING A-3.3 FOR ADDITIONAL WINDOW SPEC INFORMATION.
19. WALL PACK LIGHT FIXTURE. REFER TO ELECTRICAL DRAWINGS FOR FIXTURE TYPE.
20. FLOOD LIGHT FIXTURE. REFER TO ELECTRICAL DRAWINGS FOR FIXTURE TYPE.
21. BRASS THRU WALL OVERFLOW SCUPPER TO BE ZURN Z194, PIPED AND INSULATED THRU FROM WALL SCUPPER @ ROOF.
22. THRU WALL VENTS/LOWERS/PIPPES/ETC. COORDINATE M.O. W/ DEDICATED CONTRACTOR. REFER TO ME/P DRAWINGS AS NECESSARY. VENTS/LOWERS PROVIDED BY DEDICATED CONTRACTOR & INSTALLED BY GC.
23. 12" VERTICAL WALL-MOUNT FLAG POLE BY EDER FLAG (MODEL: EVNS-12), INSTALLED AT FLAT-ROOF NORTH PARAPET WALL PROVIDED & INSTALLED BY GC (INCLUDE ASSOCIATED BLOCKING AS REQ'D).
24. HARDIE-PLANK STATEMENT COLLECTION 'SMOOTH' LAP SIDING, SIZE: 8" EXPOSURE, (COLOR: PEARL GRAY) W/ MATCHING CORNER TRIM (WHITE) TYP. ALL BUILDING CORNERS, INCLUDE HARDIE 1/4"X1" SMOOTH 6" TRIM BOARDS (COLOR: ARTIC WHITE) AT ALL WINDOWS & DOORS TYPICAL.
25. 5'X14'X1" D 18'X22'4" STANDARD 'DIANE' ARCHITECTURAL GRADE PVC CORBEL BY EKENA MILLWORK (OR EQUAL), COLOR/FINISH: RED.


NOTE:
- ALL EXTERIOR FINISHES (MASONRY/VENEER/SIDING/TRIM/ETC.) SHALL BE FULLY CLEANED FREE OF STAINS/DEBRIS AS PART OF CLOSE-OUT AT PROJECTS END.
- COORDINATE ALL ROOF GUTTER LEADERS WITH ROOF PLAN & MANUFACTURER FOR LOCATIONS.
- C DENOTES DOOR/WINDOW TYPE (REFER TO DOOR/WINDOW ELEVATION DETAILS DMS.)

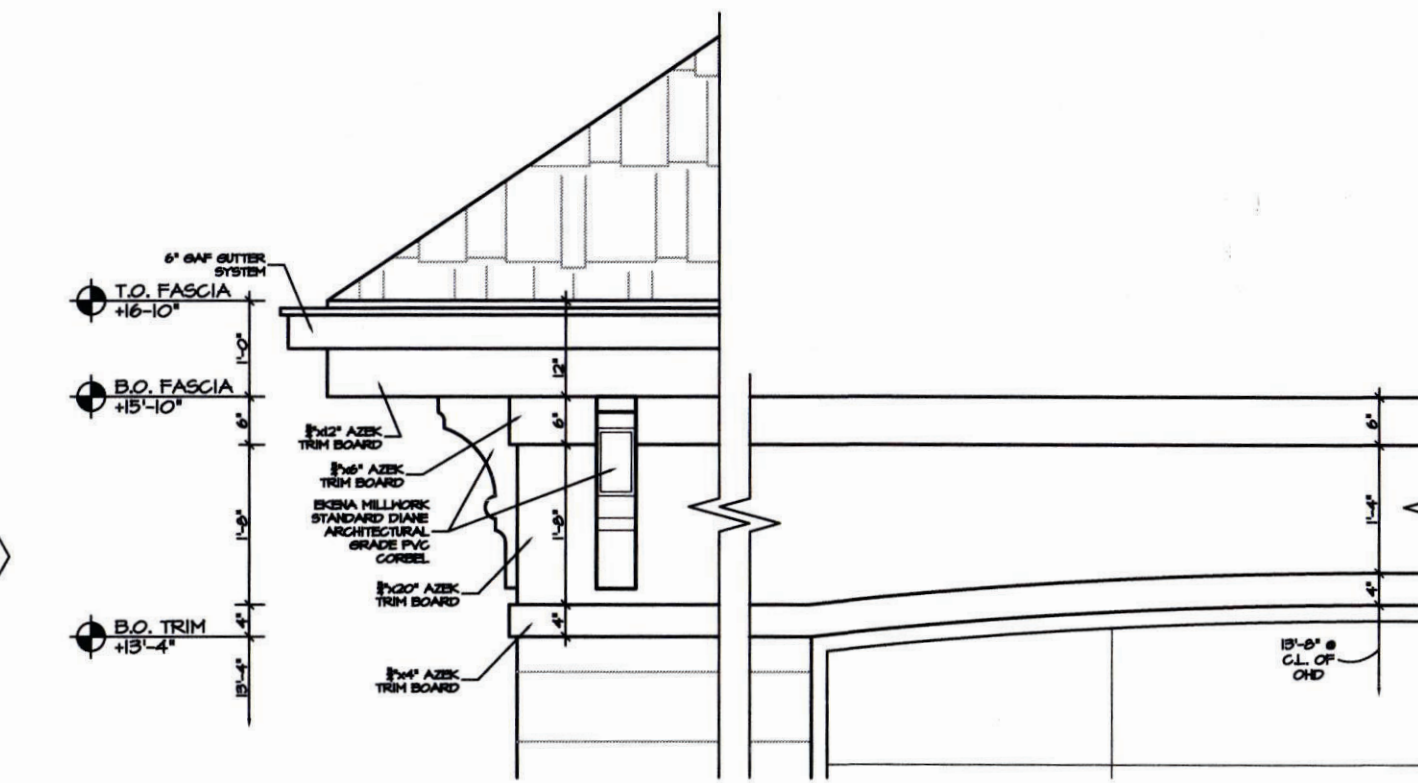


B.1 OVERHANG DETAIL
SCALE: 1/2" = 1'-0"

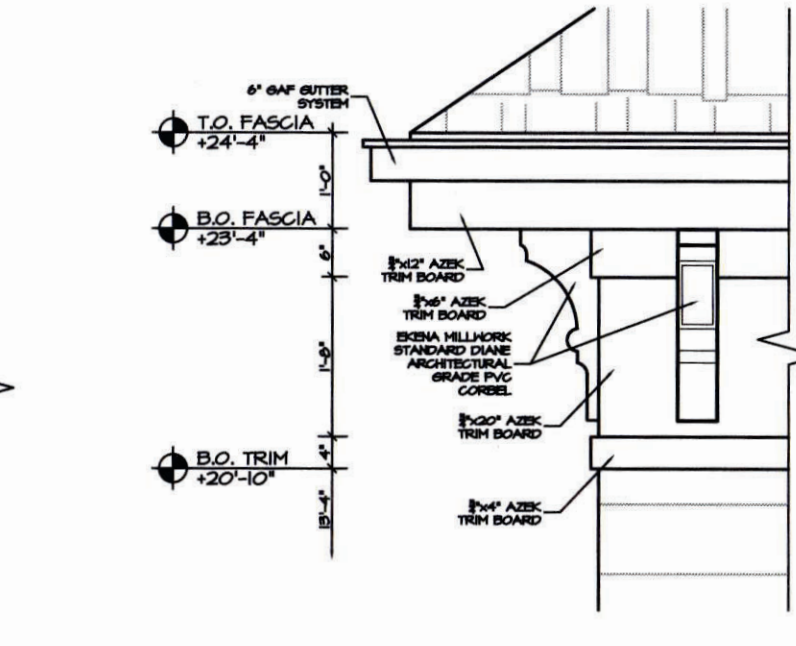

B.2 OVERHANG DETAIL
SCALE: 1/2" = 1'-0"

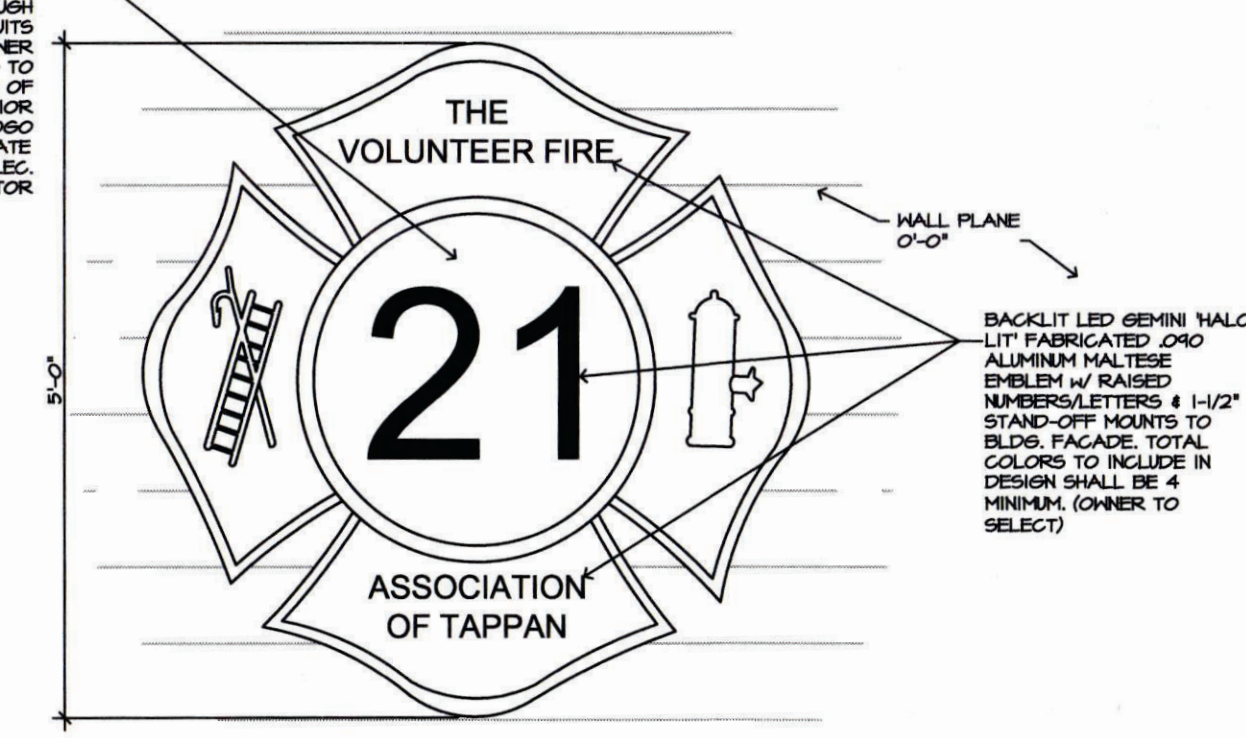

A MALTESE DETAIL
SCALE: 1/2" = 1'-0"

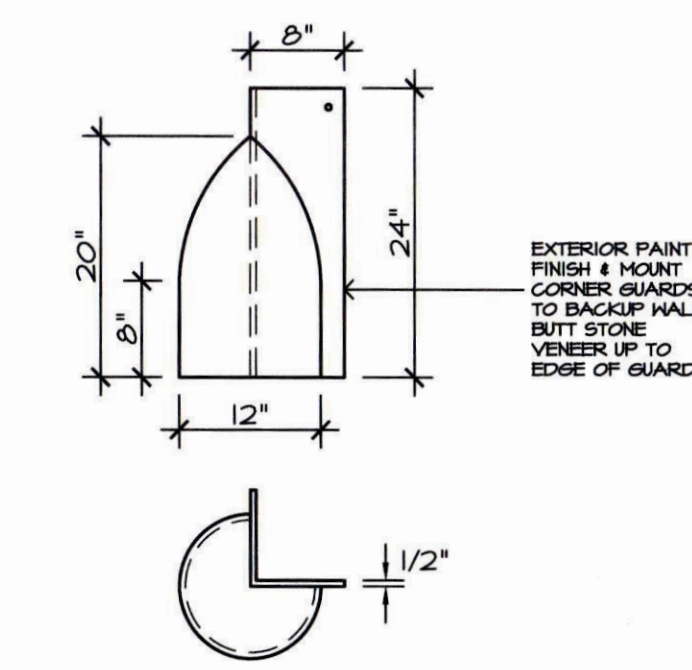

C WHEEL GUARD DETAIL
SCALE: 3/4" = 1'-0"

DATE: ISSUE
07-20-2022 ISSUED FOR BID & PERMIT

SEAL:

SENDEWSKI ARCHITECTS PC
ARCHITECTS - PLANNERS
215 ROANOKE AVENUE
RIVERHEAD, NY 11901
(631) 727-5552
9 SELENA COURT
WALDEN, NY 12586
(845) 275-8859

PROPOSED NEW FACILITY
TAPPAN FIRE DISTRICT
135 WASHINGTON STREET
TAPPAN, NY 10983
ELEVATIONS (WEST/NORTH)


PROJECT #: 2108.01A

DRAWN BY:

CAD FILE: 2108.01A/P/BID


DRAWING #:

A-3.1

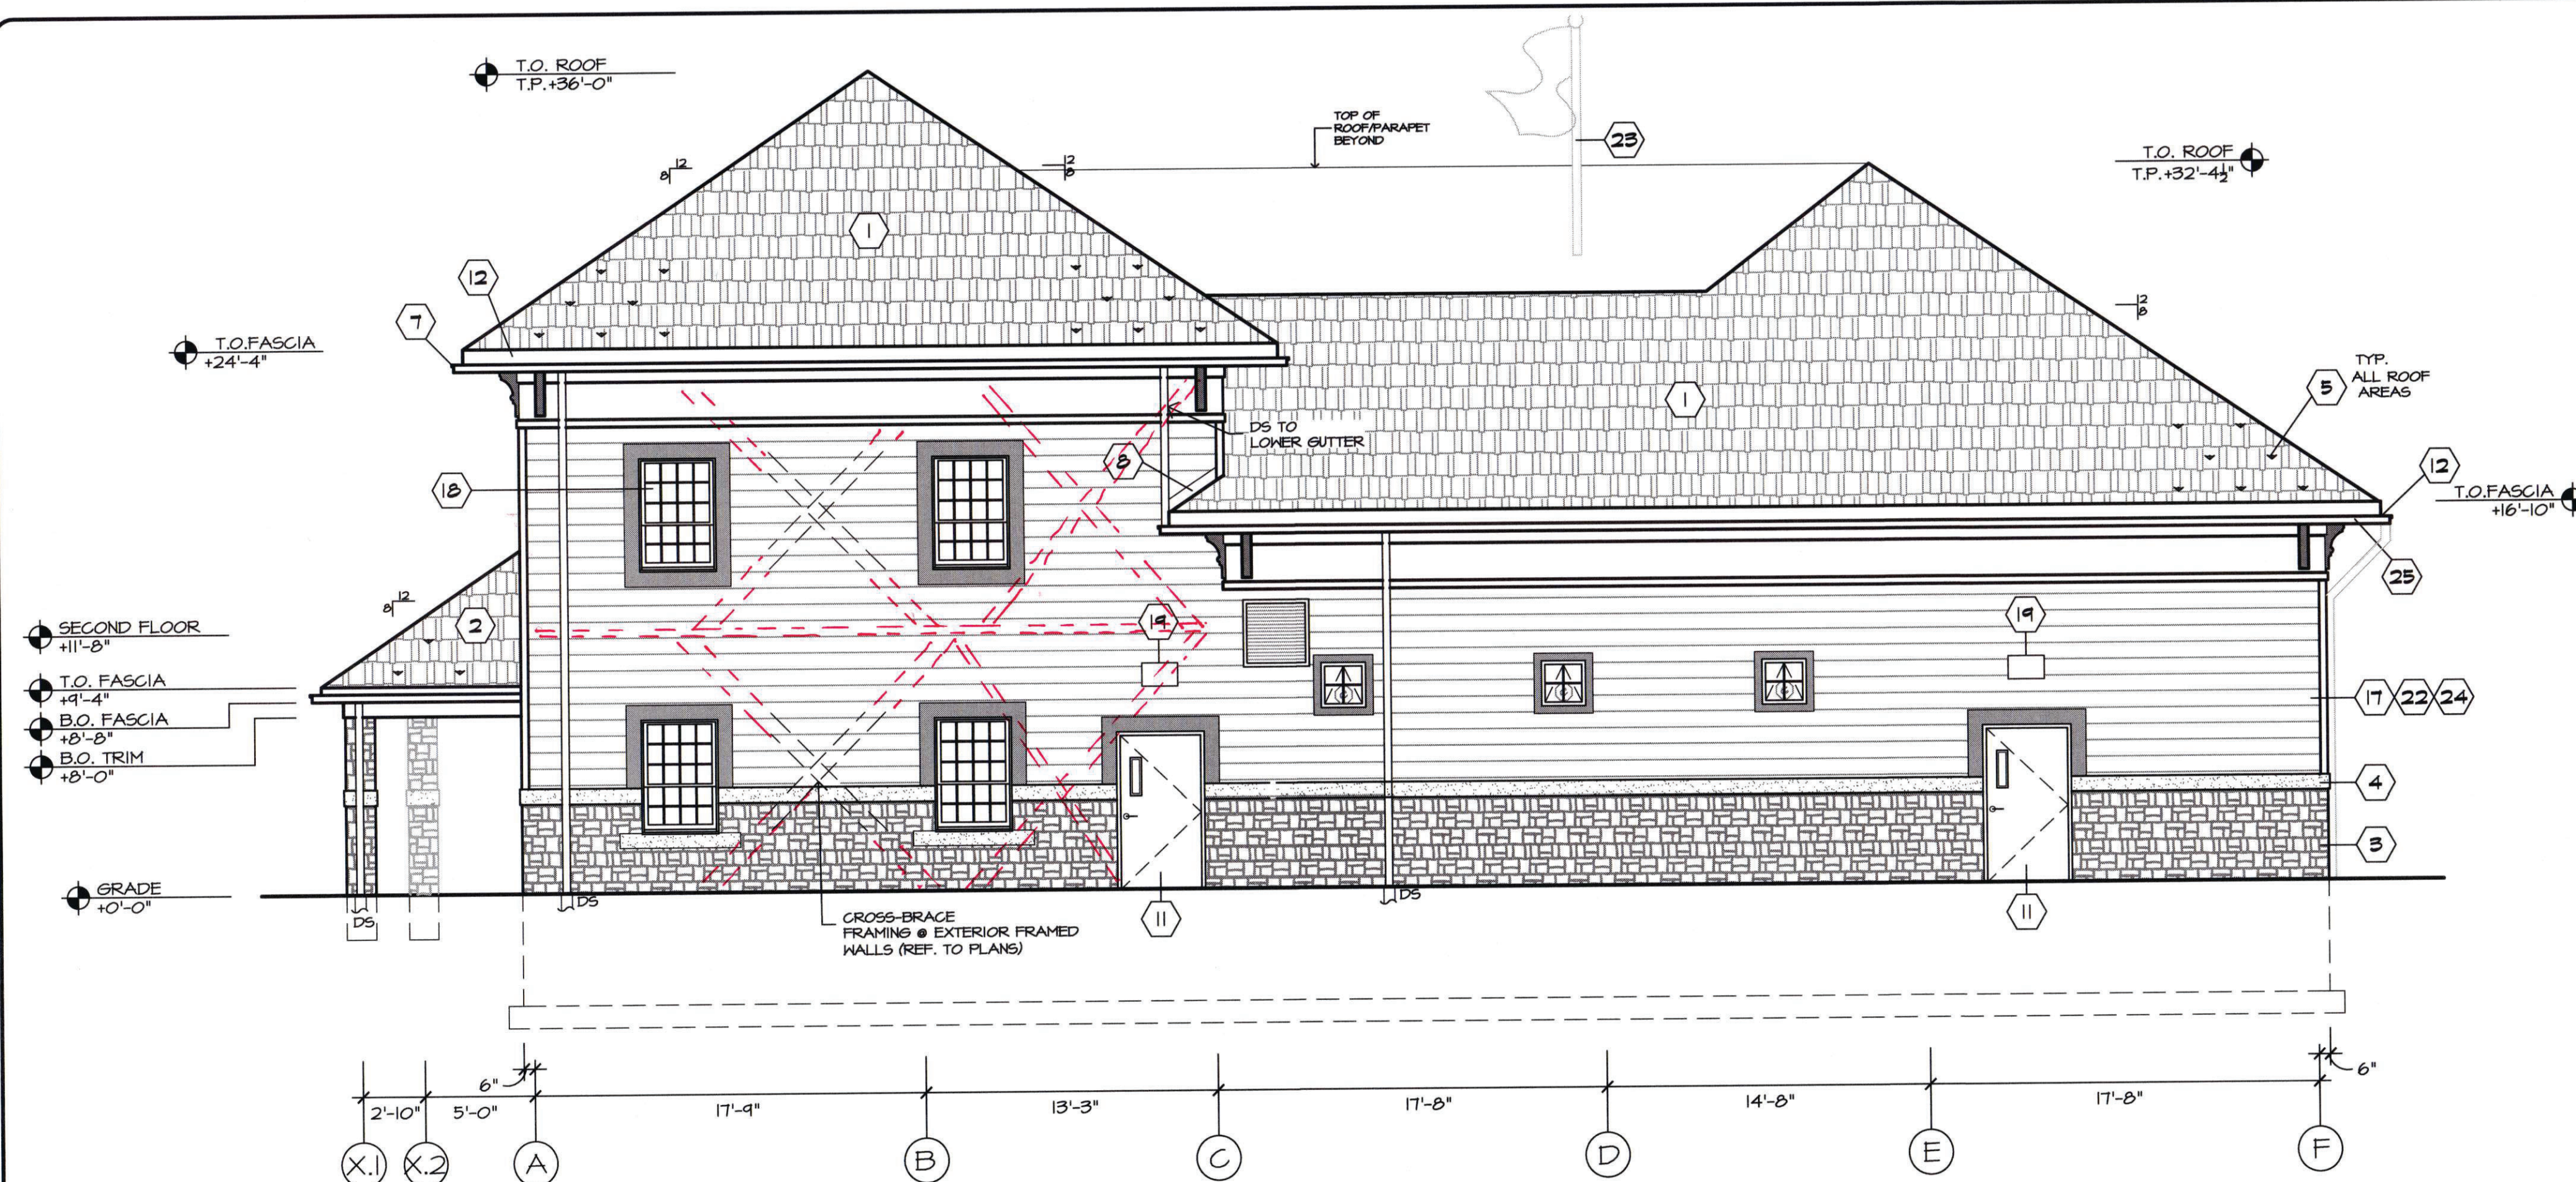

SOUTH ELEVATION

SCALE: 3/16" = 1'-0"

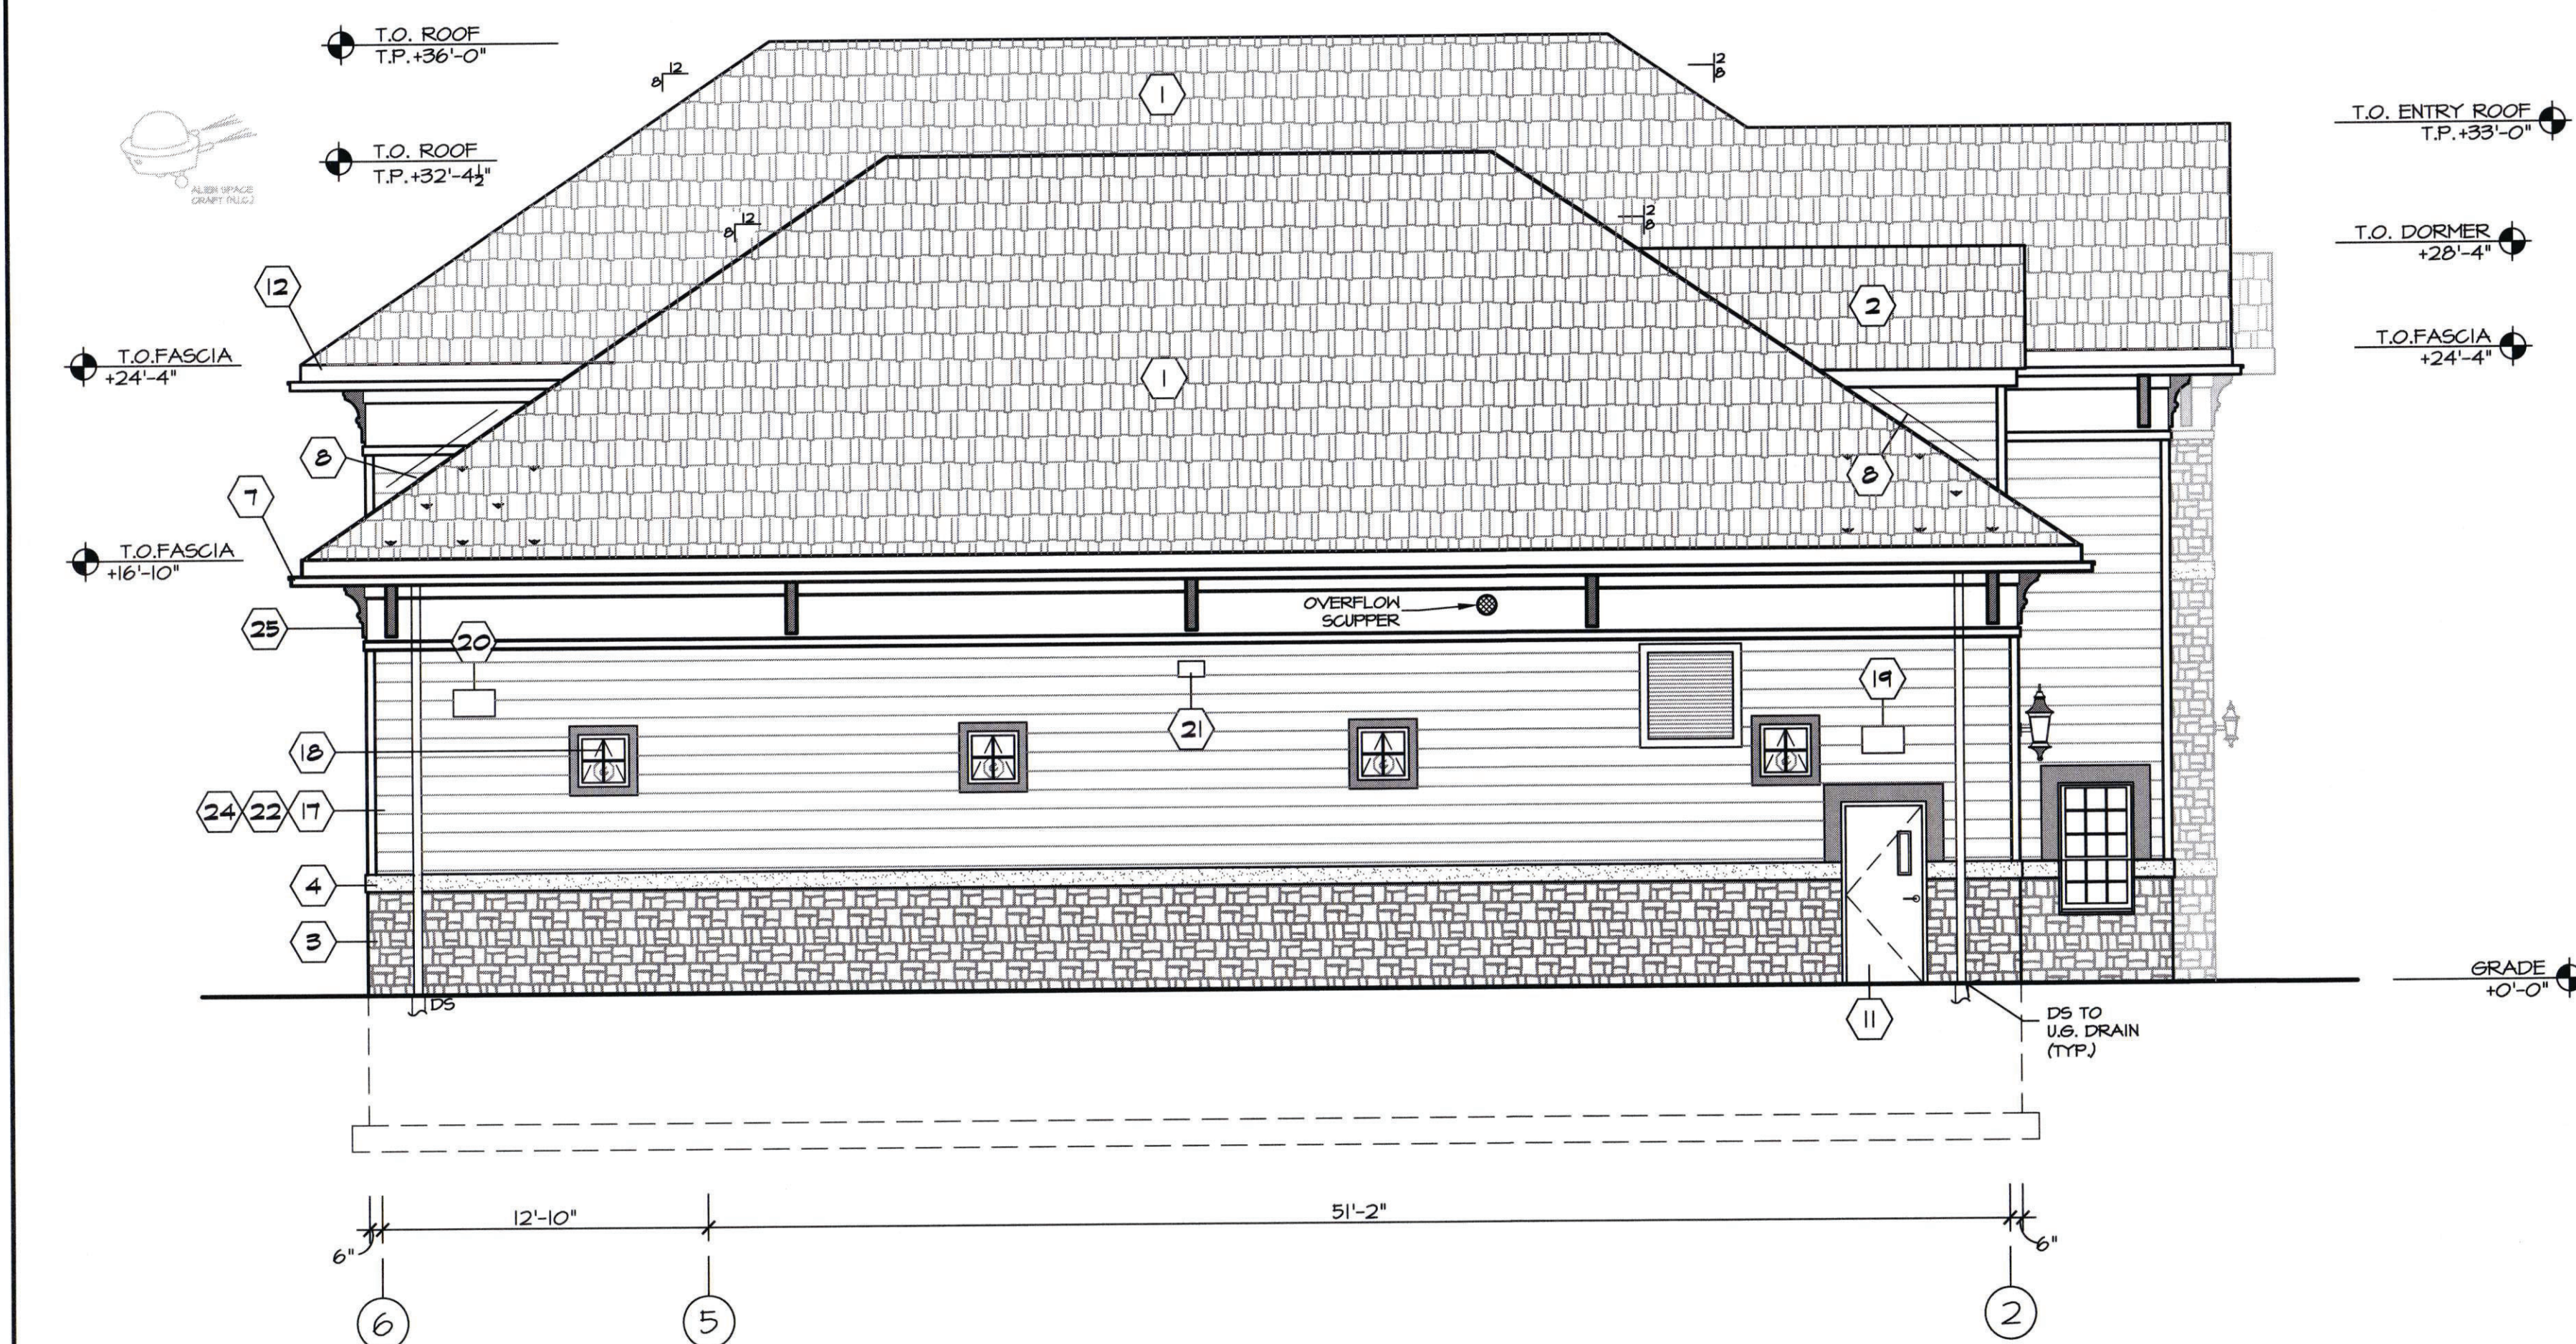

EAST ELEVATION

SCALE: 3/16" = 1'-0"

LEGEND

- 1 ALL SLOPED ROOF AREAS SHALL BE TRUSS/8"RR SIZED W/ 1/2" HOMASOTE NFOR ROOF DECKING W/ TYVEK PROTEC UNDERLAYMENT FELT AND G.A.F. "TIMBERLINE" ROOFING SHINGLES (OR EQUAL) TYPICAL. COLOR 'SLATE' BY DEFAULT & TO BE CONFIRMED BY OWNER.
- 2 LOW ROOF AREAS SHALL BE 8" MARINO C JOIST @ 16"O.C. W/ TYVEK PROTEC UNDERLAYMENT FELT AND SAME ROOF SHINGLES AS NOTE 1, W/ 1 1/2" HOMASOTE NFOR DECK.
- 3 EXTERIOR MASONRY VENEER SHALL BE 60/40 MIXTURE OF SHOULDICE ESTATE STONE 'NORTON' (60%) & SHOULDICE ESTATE STONE 'HAMPTON' (40%), BY KINGS MATERIALS.
- 4 HORIZONTAL ACCENT BANDS SHALL BE 8"x4" MAX LENGTH PRECAST 'ROCK-CAST' SELECT STONE SPLIT-FACE FINISH, OR EQUAL. COLOR TO BE SELECTED BY OWNER.
- 5 COPPER SNOWGUARD BY 'ALPINE SNOW GUARDS' MODEL #40R SNOWGUARD
- 6 NUMBERS/LETTERS SHALL BE METAL ARTS OR EQUAL (800) 231-8064, CAST METAL LETTERS 18" HIGH X 3/4" DEEP TIMES BD. 210 STYLE WITH # 20 ACRYLIC BAKED ENAMEL FINISH. MOUNT WITH PMS-3 ALUMINUM TUBE SPACERS. VERIFY FINISH COLOR W/ OWNER.
- 7 GUTTER SHALL BE S.A.F. 6" CORNIAL GUTTER SYSTEM W/ 4"x4" DOWNSPOUTS.
- 8 STRAIGHT LINE FLASHING. TYPICAL ALL ROOF AREAS.
- 9 24"x12" HEAVY DUTY CAST IRON WHEEL GUARD BY TRENCH DRAIN SUPPLY (MODEL: R-4486-D6) WITH PAINT FINISH, COLOR SELECTED BY OWNER.
- 10 NEW 12'-0"x14'-0" FOUR-FOLD APPARATUS BAY DOOR. DOORS SHALL BE BY 'DOOR ENGINEERING' MODEL #FF300, INSULATED DOORS WITH RED FINISH.
- 11 NEW HOLLOW-METAL INSULATED DOOR & FRAME. PROVIDE 4" HEAD AT MASONRY LOCATIONS.
- 12 FASCIA & TRIM SHALL BE PRE-PRIMED 5/4X12 W/ .062 ALUM. WRAP (COLOR WHITE)
- 13 5'-0" DIA. CUSTOM MALTESE CROSS. REFER TO DETAIL 'A' ON A-3.1. GC TO PROVIDE & INSTALL W/ ASSOCIATED MOUNTS, HARNESS, TRANSFORMER, ETC... TO MAKE COMPLETE. ELECTRICIAN SHALL MAKE FINAL POWER WIRING CONNECTION.
- 14 DECORATIVE LIGHTS. REFER TO ELECTRICAL DRAWINGS FOR FIXTURE TYPE. MOUNT BOX 8'-0" TO BOTTOM.
- 15 STOREFRONT ALUM/GLASS DOOR UNITS SHALL BE KAWNEER 350T SERIES. APPLIES TO DOORS 101.1A, 101.1B, 101.2A, 101.2B, 1-02, 1-03 & 1-14.
- 16 16" x 24" BRONZE PLAQUE (SIMILAR TO DWS. O-O PLAQUE DETAIL) TO BE CAST W/ CUSTOM TEXT/DATE, TO BE CONFIRMED W/ OWNER.
- 17 COORDINATE ALL EXTERIOR OUTLETS IN MASONRY WITH ELECTRICAL CONTRACTOR
- 18 WINDOWS SHALL BE ANDERSEN 400 SERIES 'STORM WATCH' TYPICAL. REFER TO DRAWING A-3.3 FOR ADDITIONAL WINDOW SPEC INFORMATION.
- 19 WALL PACK LIGHT FIXTURE. REFER TO ELECTRICAL DRAWINGS FOR FIXTURE TYPE.
- 20 FLOOD LIGHT FIXTURE. REFER TO ELECTRICAL DRAWINGS FOR FIXTURE TYPE.
- 21 BRASS THRU WALL OVERFLOW SCUPPER TO BE ZURN Z199, PIPED AND INSULATED THRU FROM WALL SCUPPER @ ROOF.
- 22 THROUGH WALL VENTS/LOUVERS/PIPES/ETC... COORDINATE M.O. W/ DEDICATED CONTRACTOR. REFER TO M/E/P DRAWINGS AS NECESSARY. VENTS/LOUVERS PROVIDED BY DEDICATED CONTRACTOR & INSTALLED BY GC.
- 23 12" VERTICAL WALL-MOUNT FLAG POLE BY EDER FLAG (MODEL: EVNS-12), INSTALLED AT FLAT-ROOF NORTH PARAPET WALL PROVIDED & INSTALLED BY GC (INCLUDE ASSOCIATED BLOCKING AS REQ'D.)
- 24 HARDIE-PLANK STATEMENT COLLECTION 'SMOOTH' LAP SIDING, SIZE: 8" EXPOSURE. (COLOR: PEARL GRAY) W/ MATCHING CORNER TRIM (WHITE) TYP. ALL BUILDING CORNERS, INCLUDE HARDIE '1/4 NT3 SMOOTH' 6" TRIM BOARDS (COLOR: ARTIC WHITE) AT ALL WINDOWS & DOORS TYPICAL.
- 25 5"X4 X 9"D X 18"/22"H STANDARD 'DIANE' ARCHITECTURAL GRADE PVC CORBEL BY EKENA MILLWORK (OR EQUAL). COLOR/FINISH: RED

- NOTE:
- ALL EXTERIOR FINISHES (MASONRY/VENEER/SIDING/TRIM/ETC...) SHALL BE FULLY CLEANED FREE OF STAINS/DEBRIS AS PART OF CLOSE-OUT AT PROJECTS END.
 - COORDINATE ALL ROOF GUTTER LEADERS WITH ROOF PLAN & MANUFACTURER FOR LOCATIONS.
 - DENOTES DOOR/WINDOW TYPE (REFER TO DOOR/WINDOW ELEVATION DETAILS DWS.)

DATE: ISSUE
01-20-2022 ISSUED FOR BID & PERMIT

SEAL:

SENDEWSKI ARCHITECTS PC
ARCHITECTS - PLANNERS
215 ROANOKE AVENUE
RIVERHEAD, NY 11901
(631) 727-5352
9 SELENA COURT
WALDEN, NY 12586
(845) 275-8859

PROPOSED NEW FACILITY
TAPPAN FIRE DISTRICT
135 WASHINGTON STREET
TAPPAN, NY 10983

ELEVATIONS (EAST/NORTH)
& DETAILS

PROJECT #: 2108.01A

DRAWN BY:

CAD FILE: 2108.01A/P:/BID

DRAWING#:

A-3.2

DATE: ISSUE
07-20-2022 ISSUED FOR BID
& PERMIT

SEAL:

SENDLEWSKI ARCHITECTS PC
ARCHITECTS - PLANNERS
215 ROANOKE AVENUE
RIVERHEAD, NY 11901
(631) 727-5352
9 SELENA COURT
WALDEN, NY 12586
(845) 275-8859

PROPOSED NEW FACILITY
TAPPAN FIRE DISTRICT
135 WASHINGTON STREET
TAPPAN, NY 10983

WALL SECTION & DETAIL



PROJECT #: 2108.01A


DRAWN BY:

CAD FILE: 2108.01A/P/BID


DRAWING#:

A-6.1

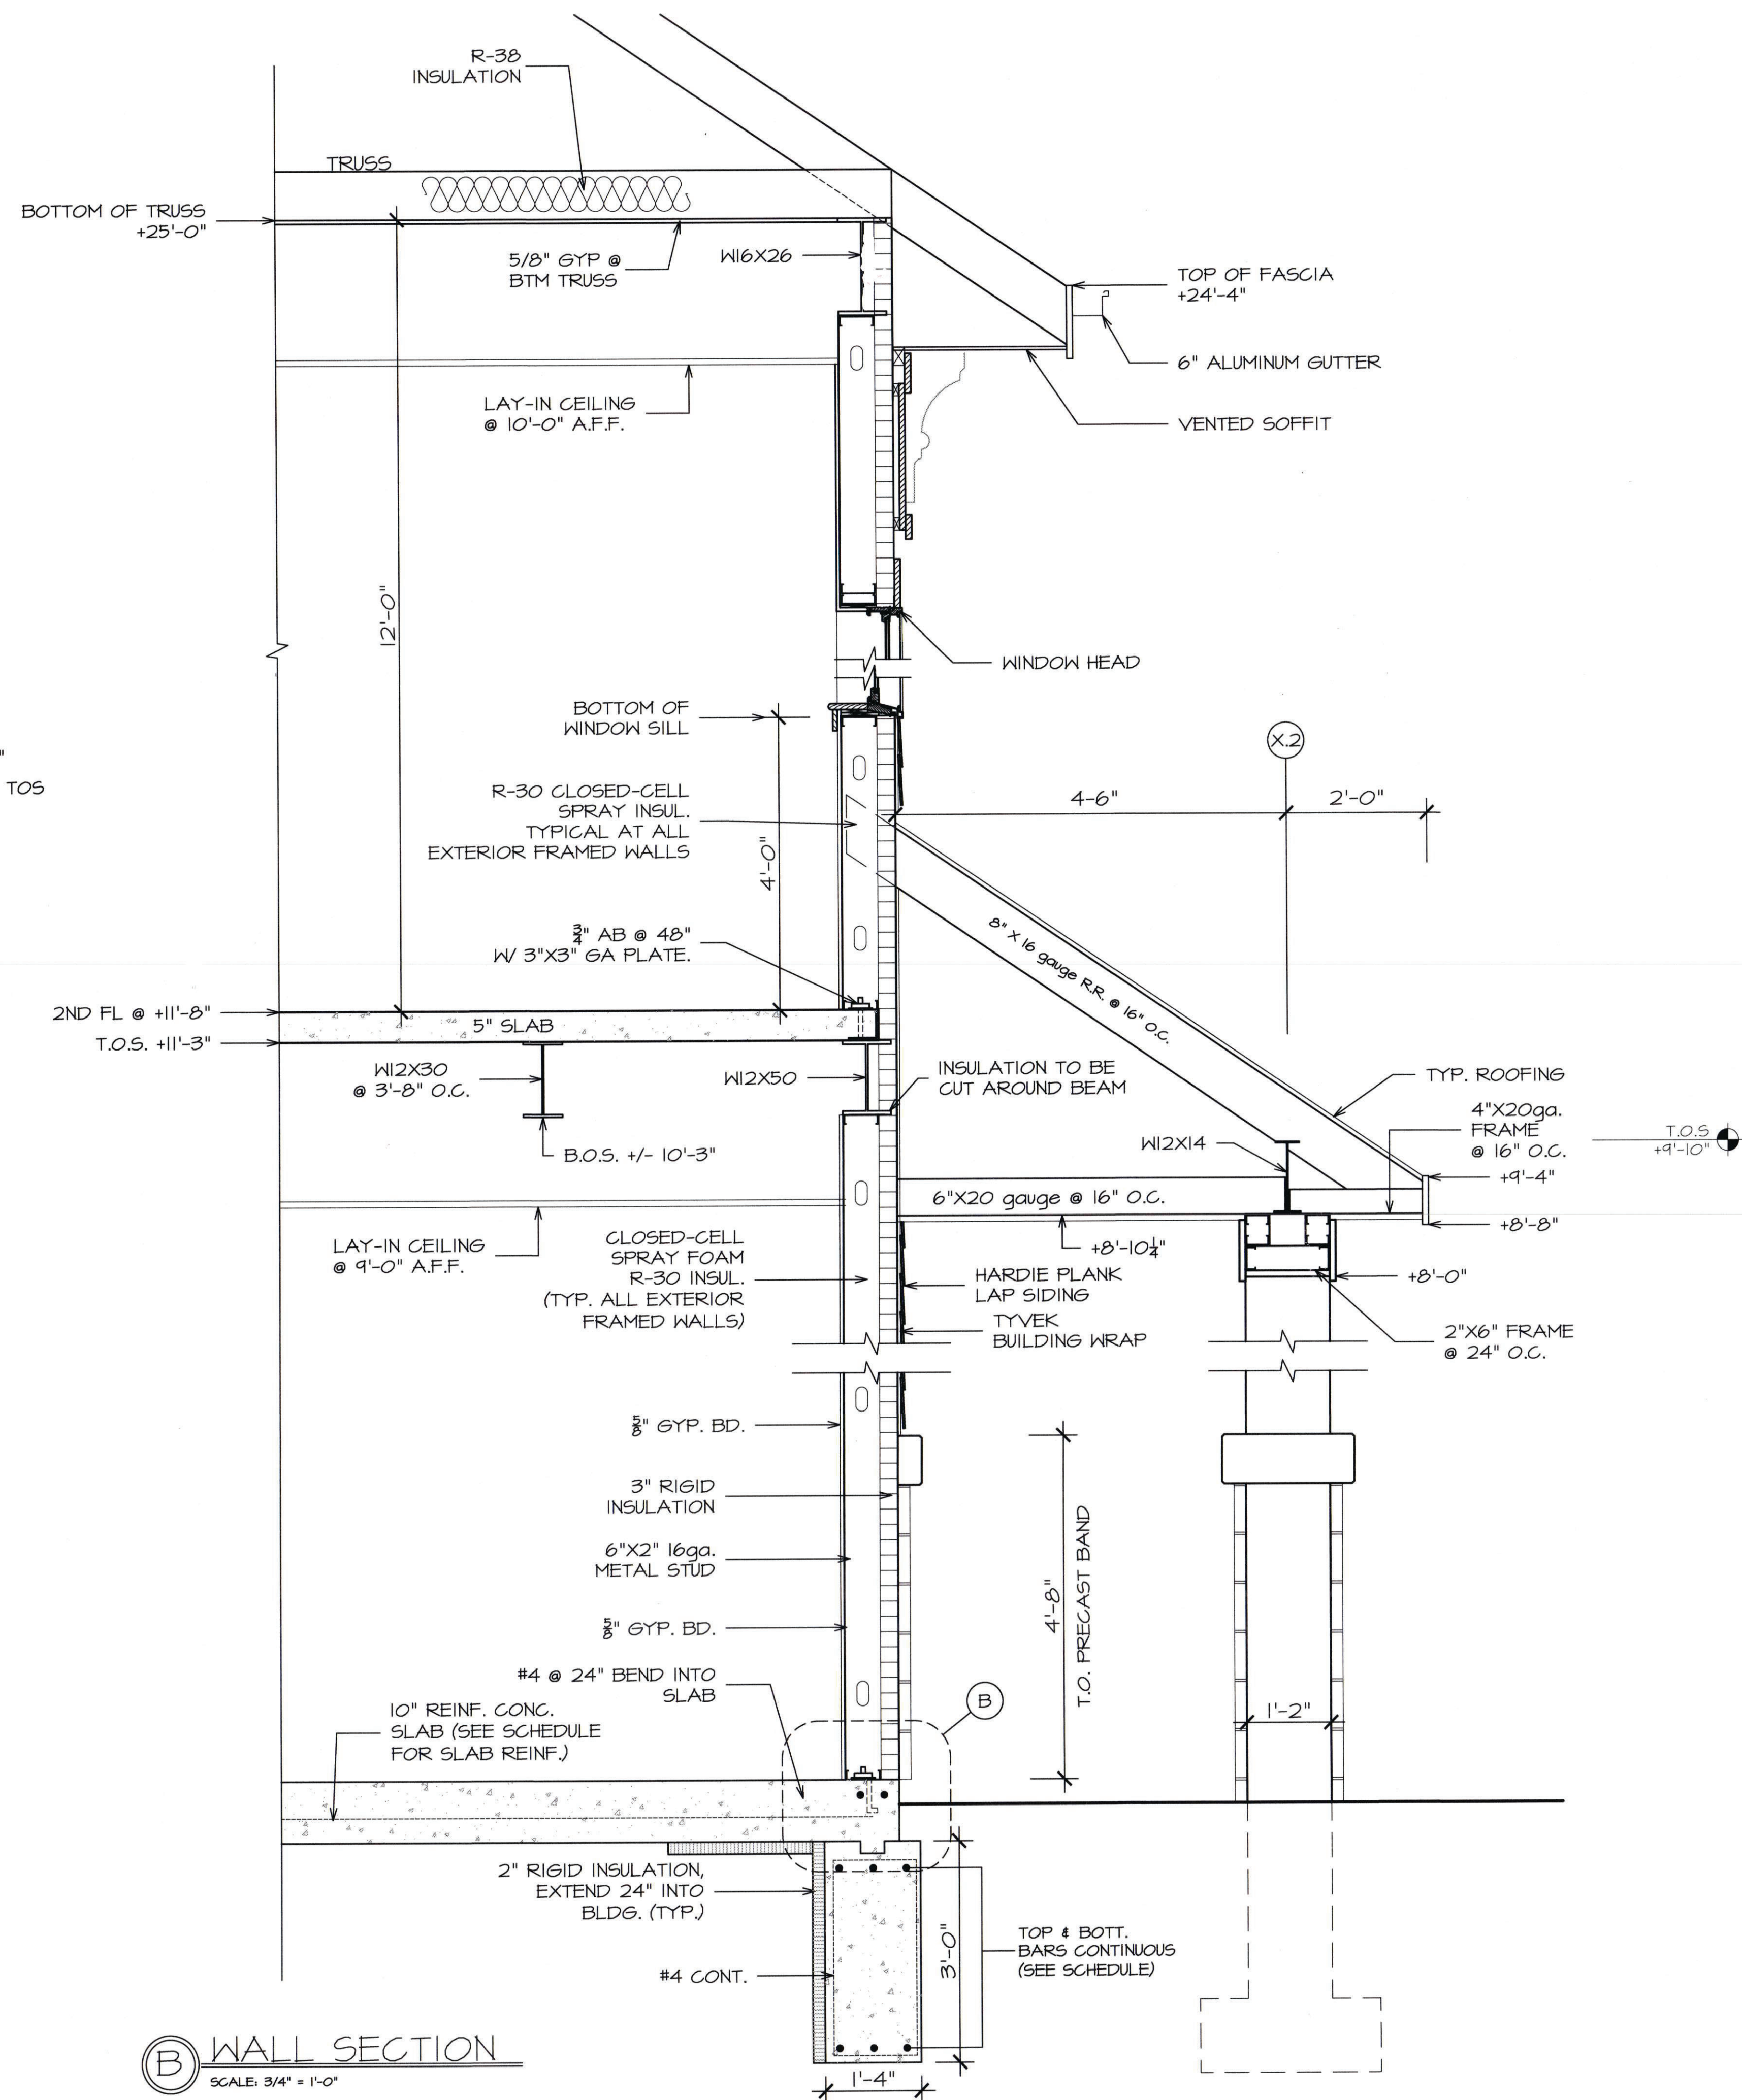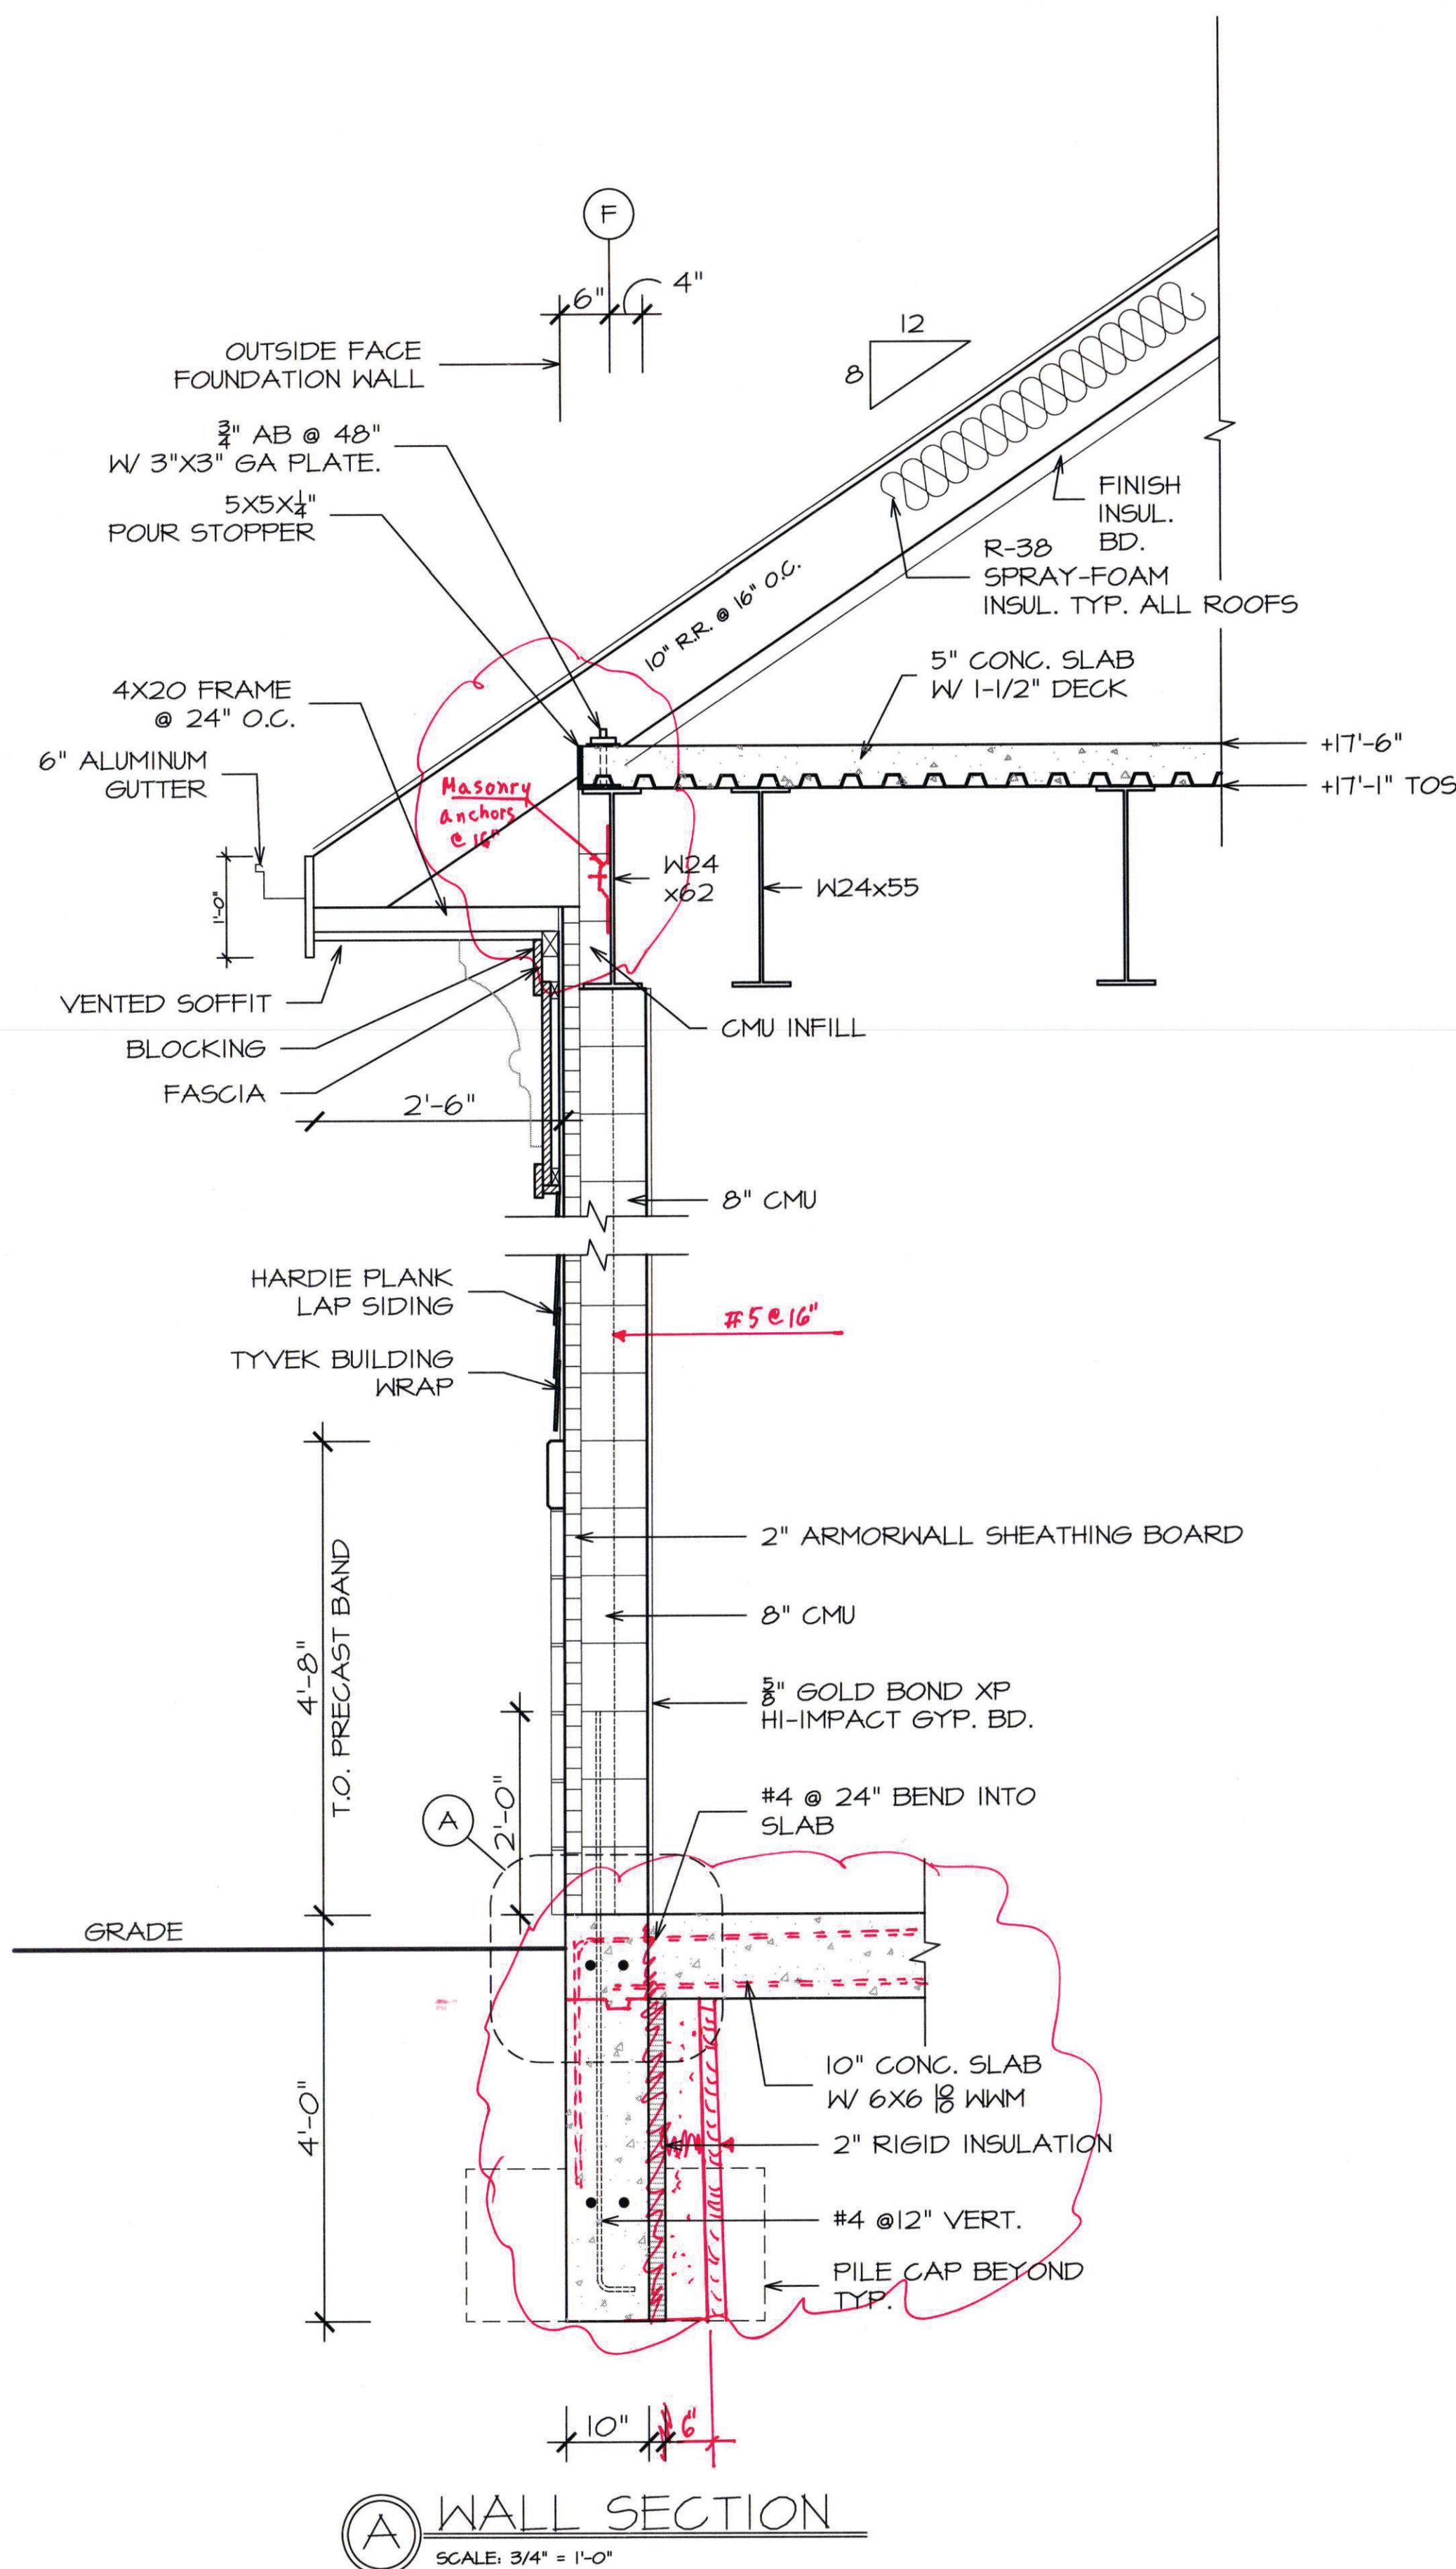


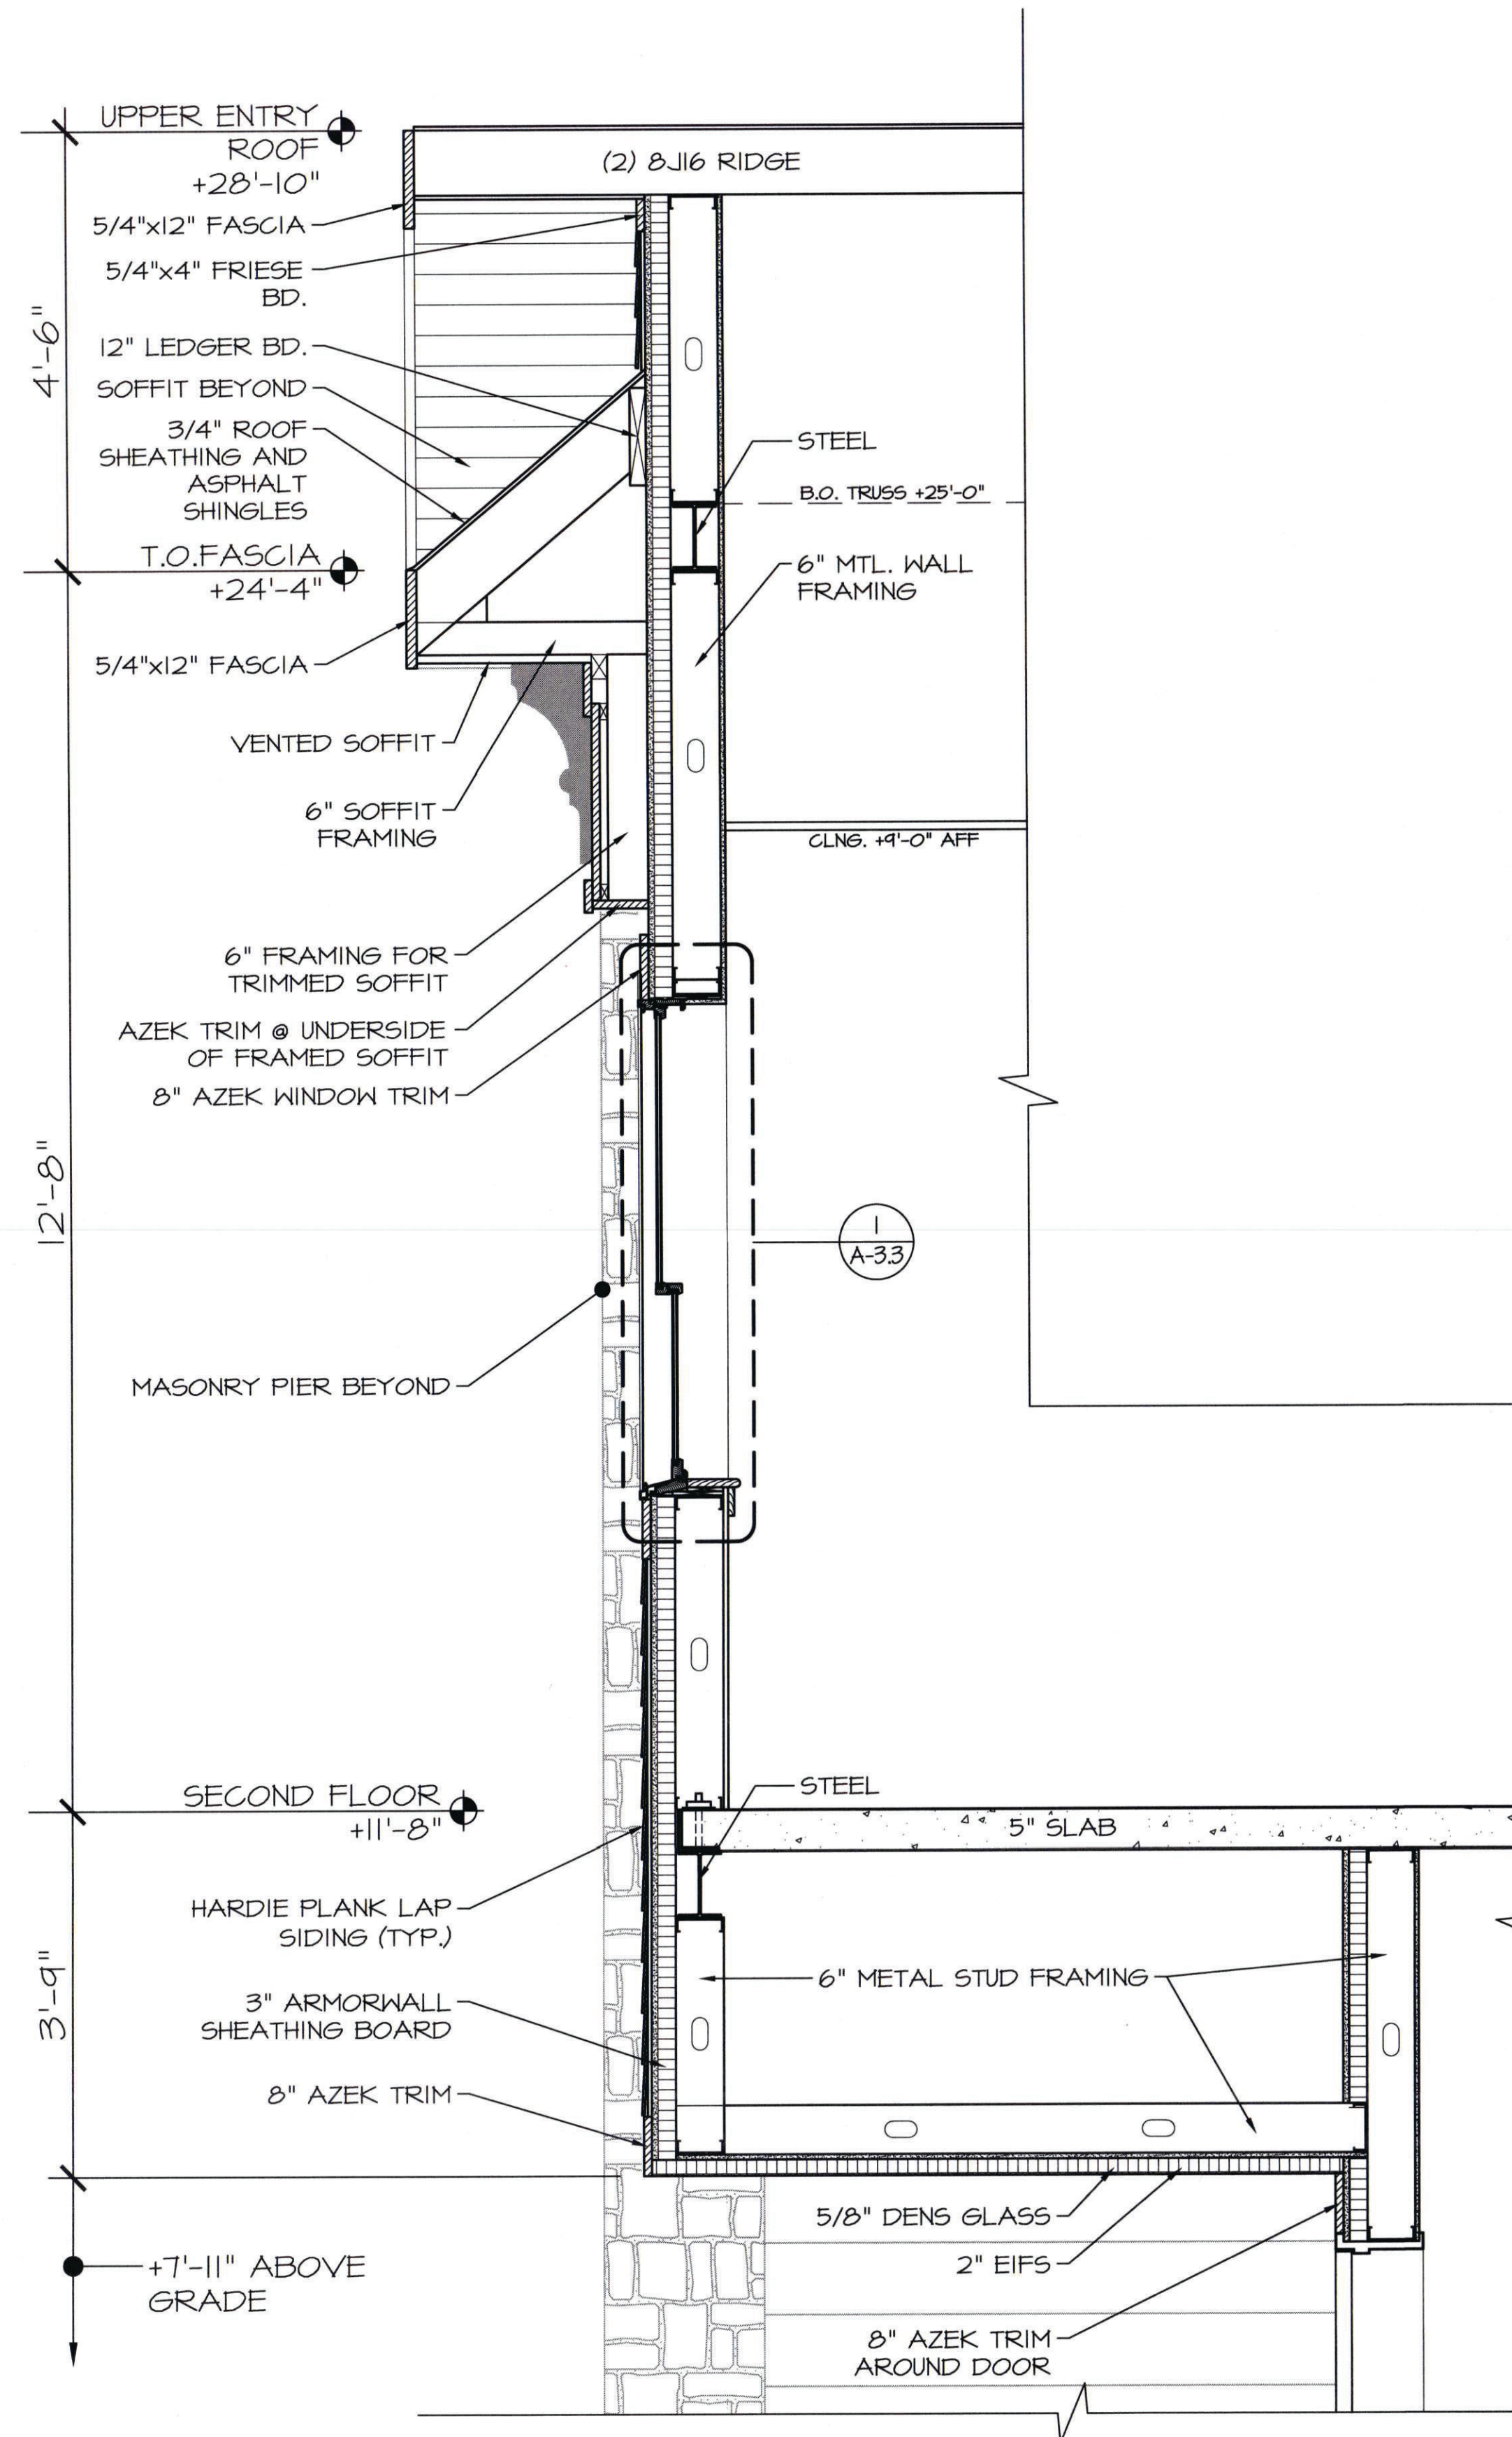

A WALL SECTION THRU DUTCH GABLE
SCALE: 3/4" = 1'-0"

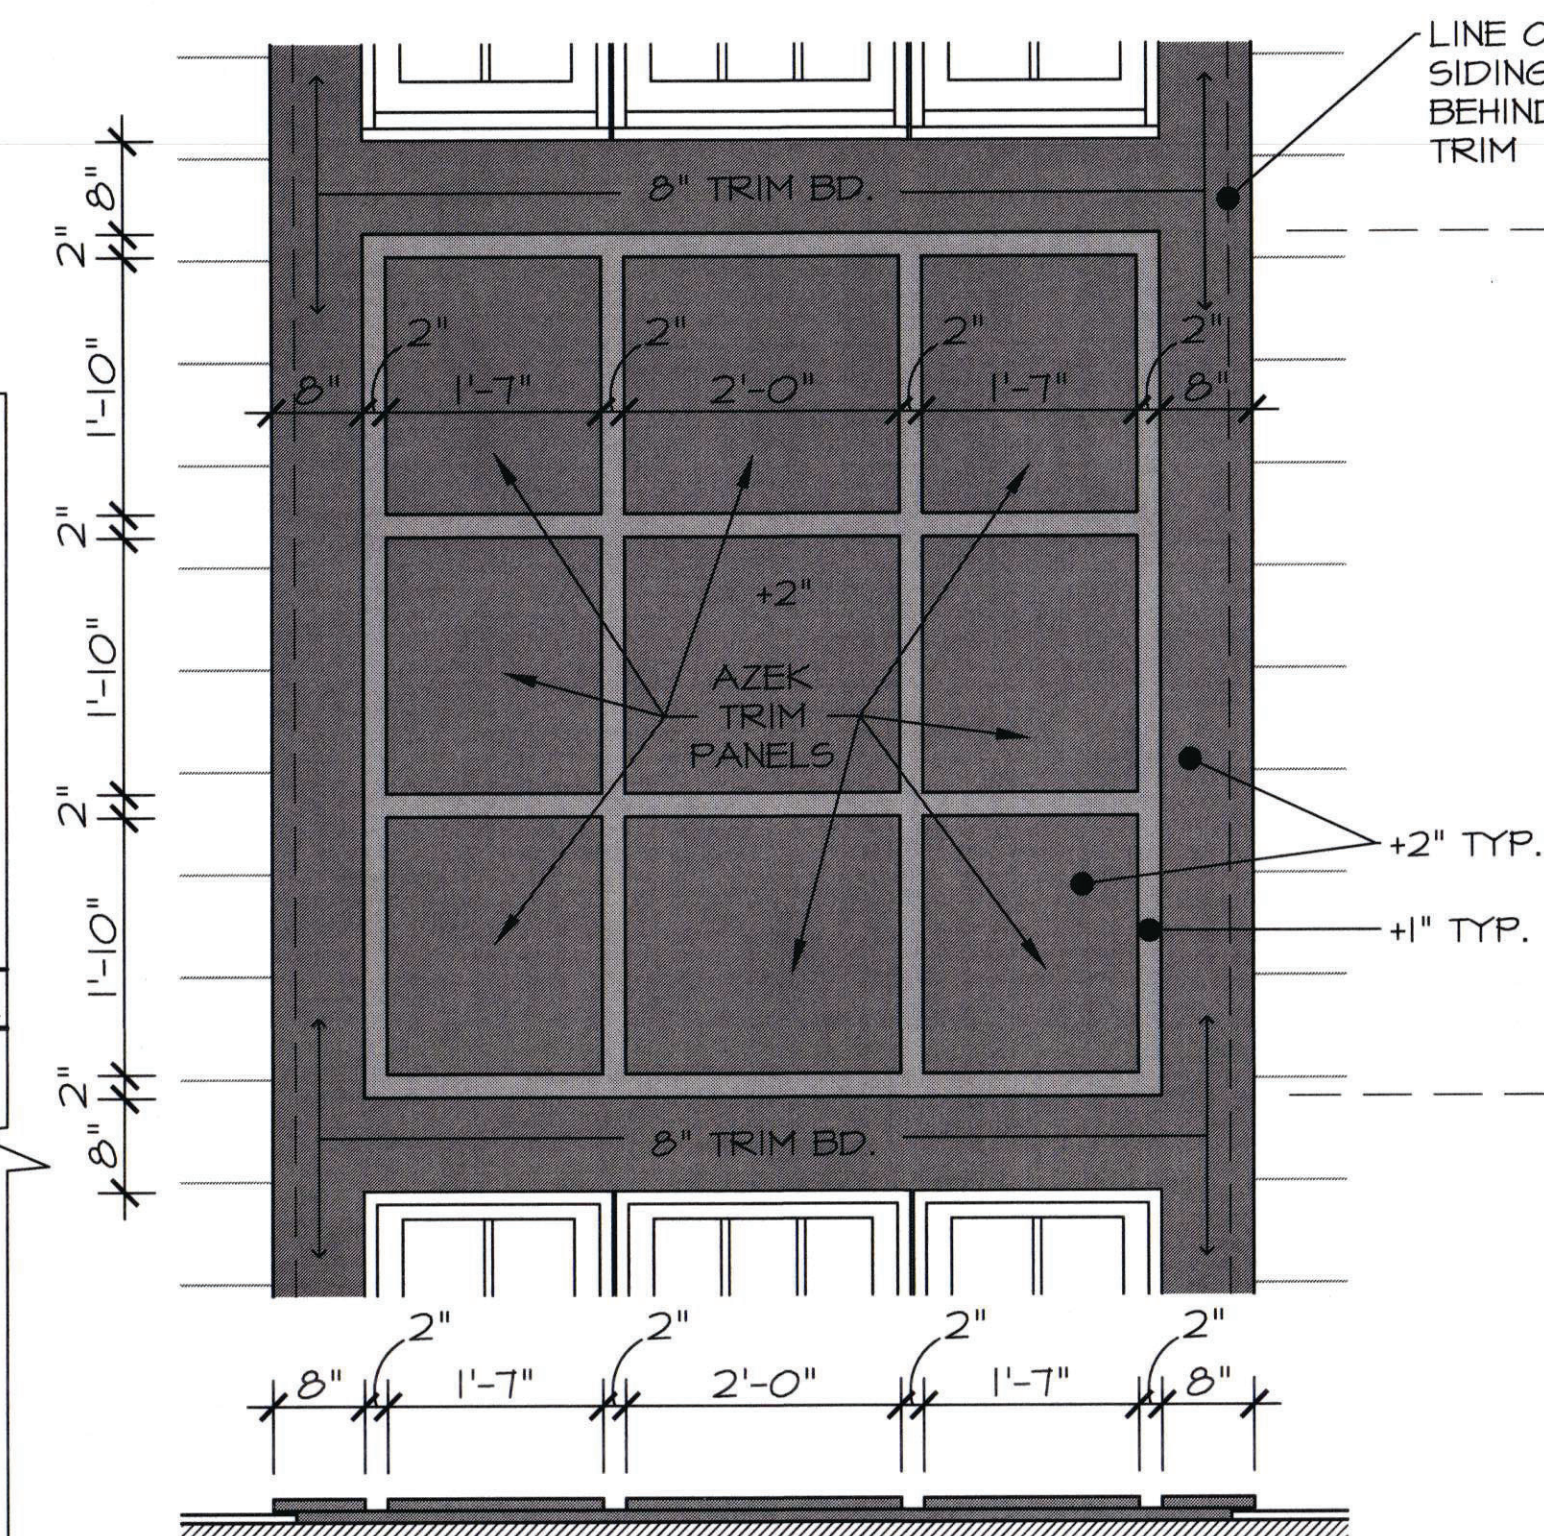

1 RAISED PANEL DETAIL
SCALE: 3/4" = 1'-0"
NOTE: DATUM OF RELIEF ELEVATIONS IS +0'-0" FROM WALL SHEATHING.

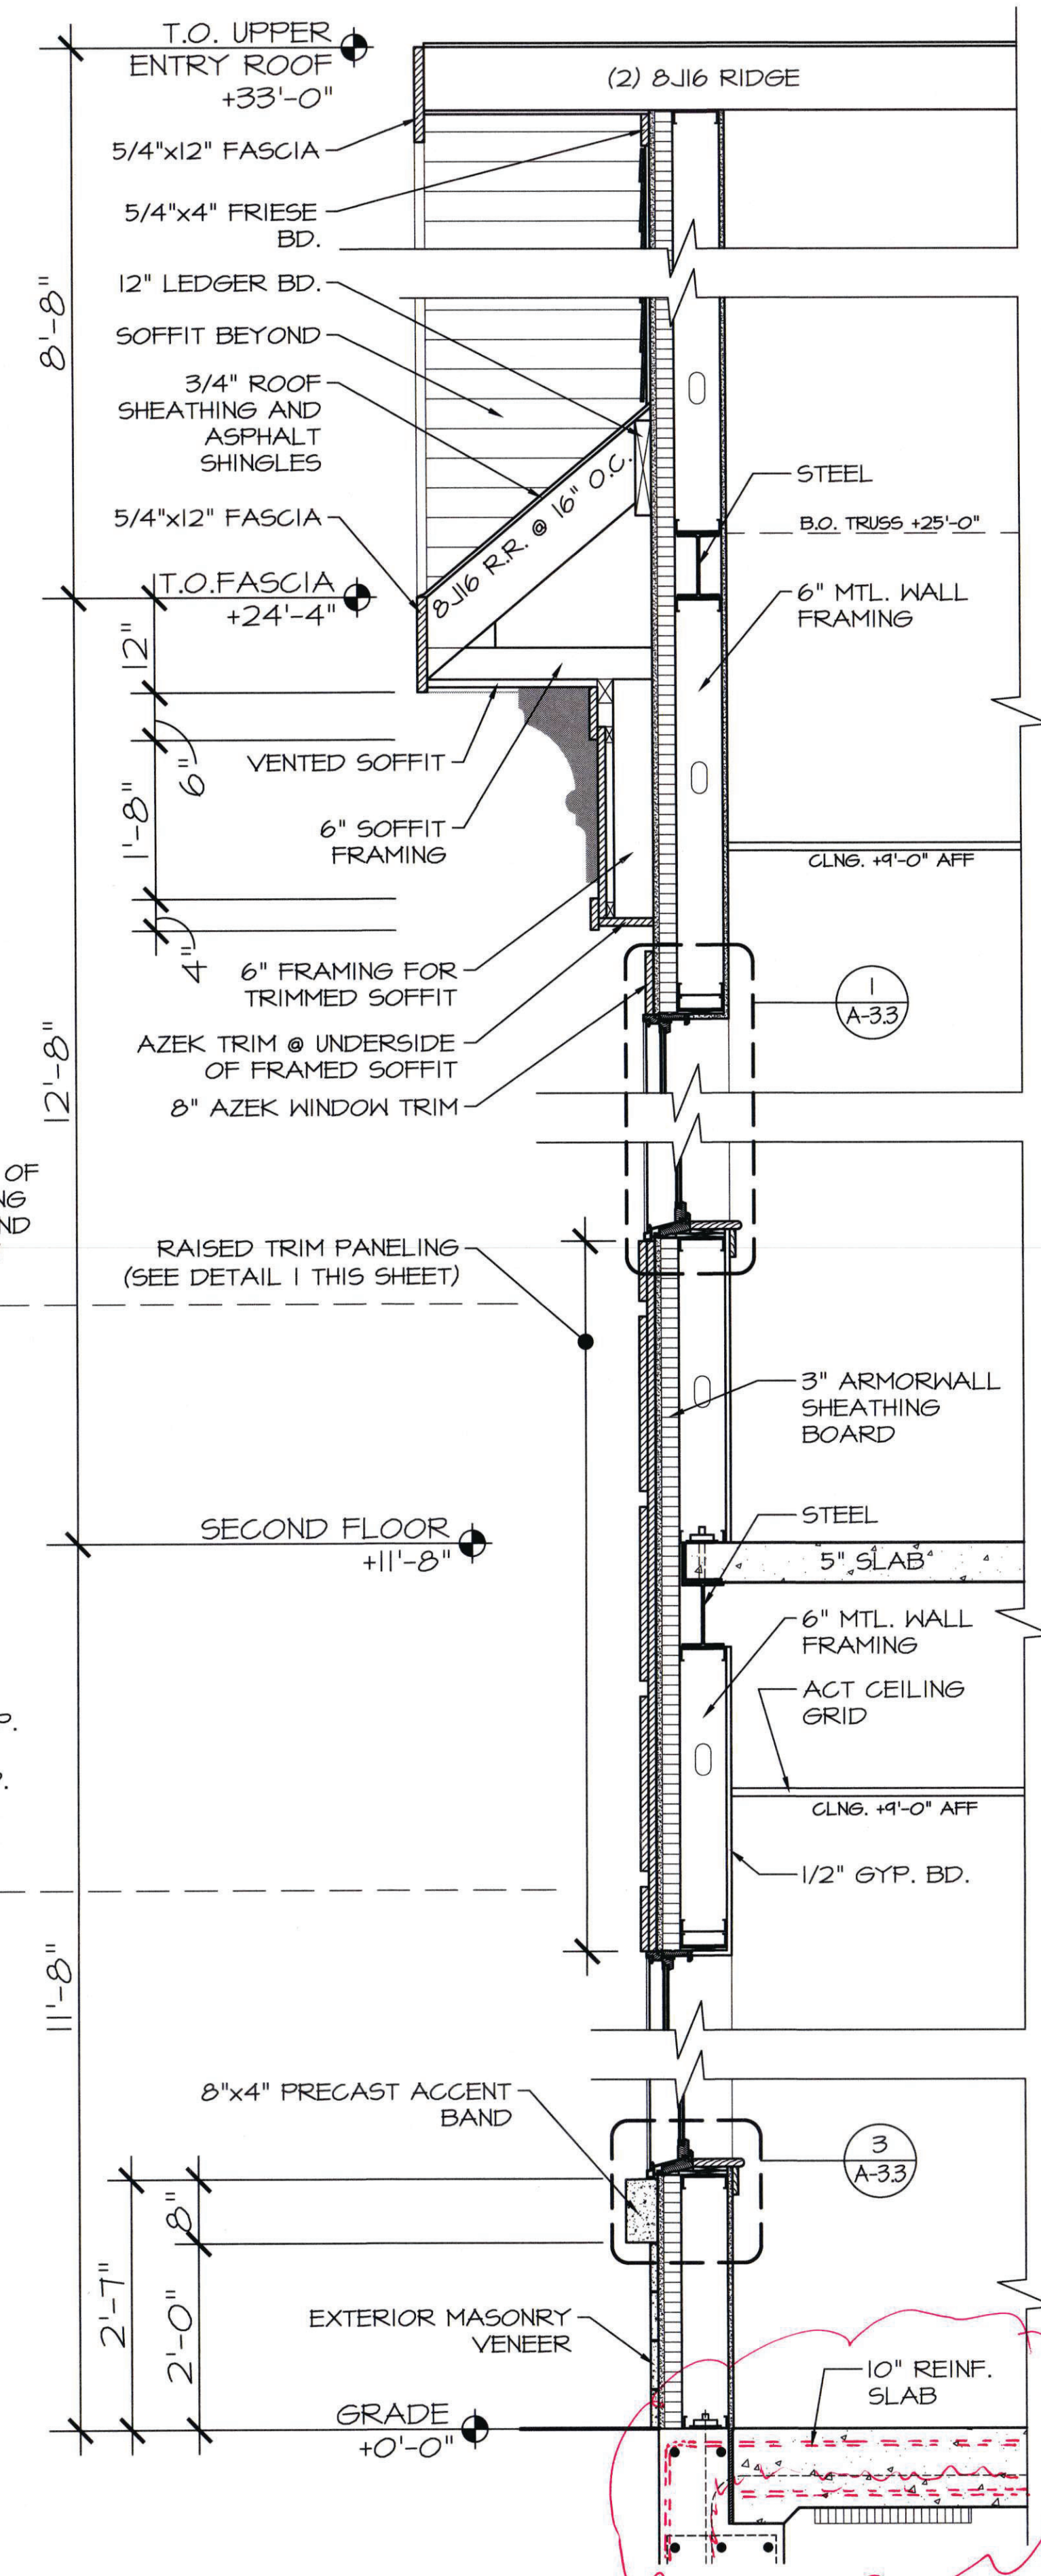

B WALL SECTION THRU DUTCH GABLE
SCALE: 3/4" = 1'-0"

DATE: ISSUE
07-20-2022 ISSUED FOR BID & PERMIT

SEAL:

SENDEWSKI ARCHITECTS PC
ARCHITECTS - PLANNERS
215 ROANOKE AVENUE
RIVERHEAD, NY 11901
(631) 727-5352
9 SELENA COURT
WALDEN, NY 12586
(845) 275-8859

PROPOSED NEW FACILITY
TAPPAN FIRE DISTRICT
135 WASHINGTON STREET
TAPPAN, NY 10983

WALL SECTION & DETAIL


PROJECT #: 2102.01A

DRAWN BY:

CAD FILE: 2102.01A/F./BID

DRAWING#:

A-6.2

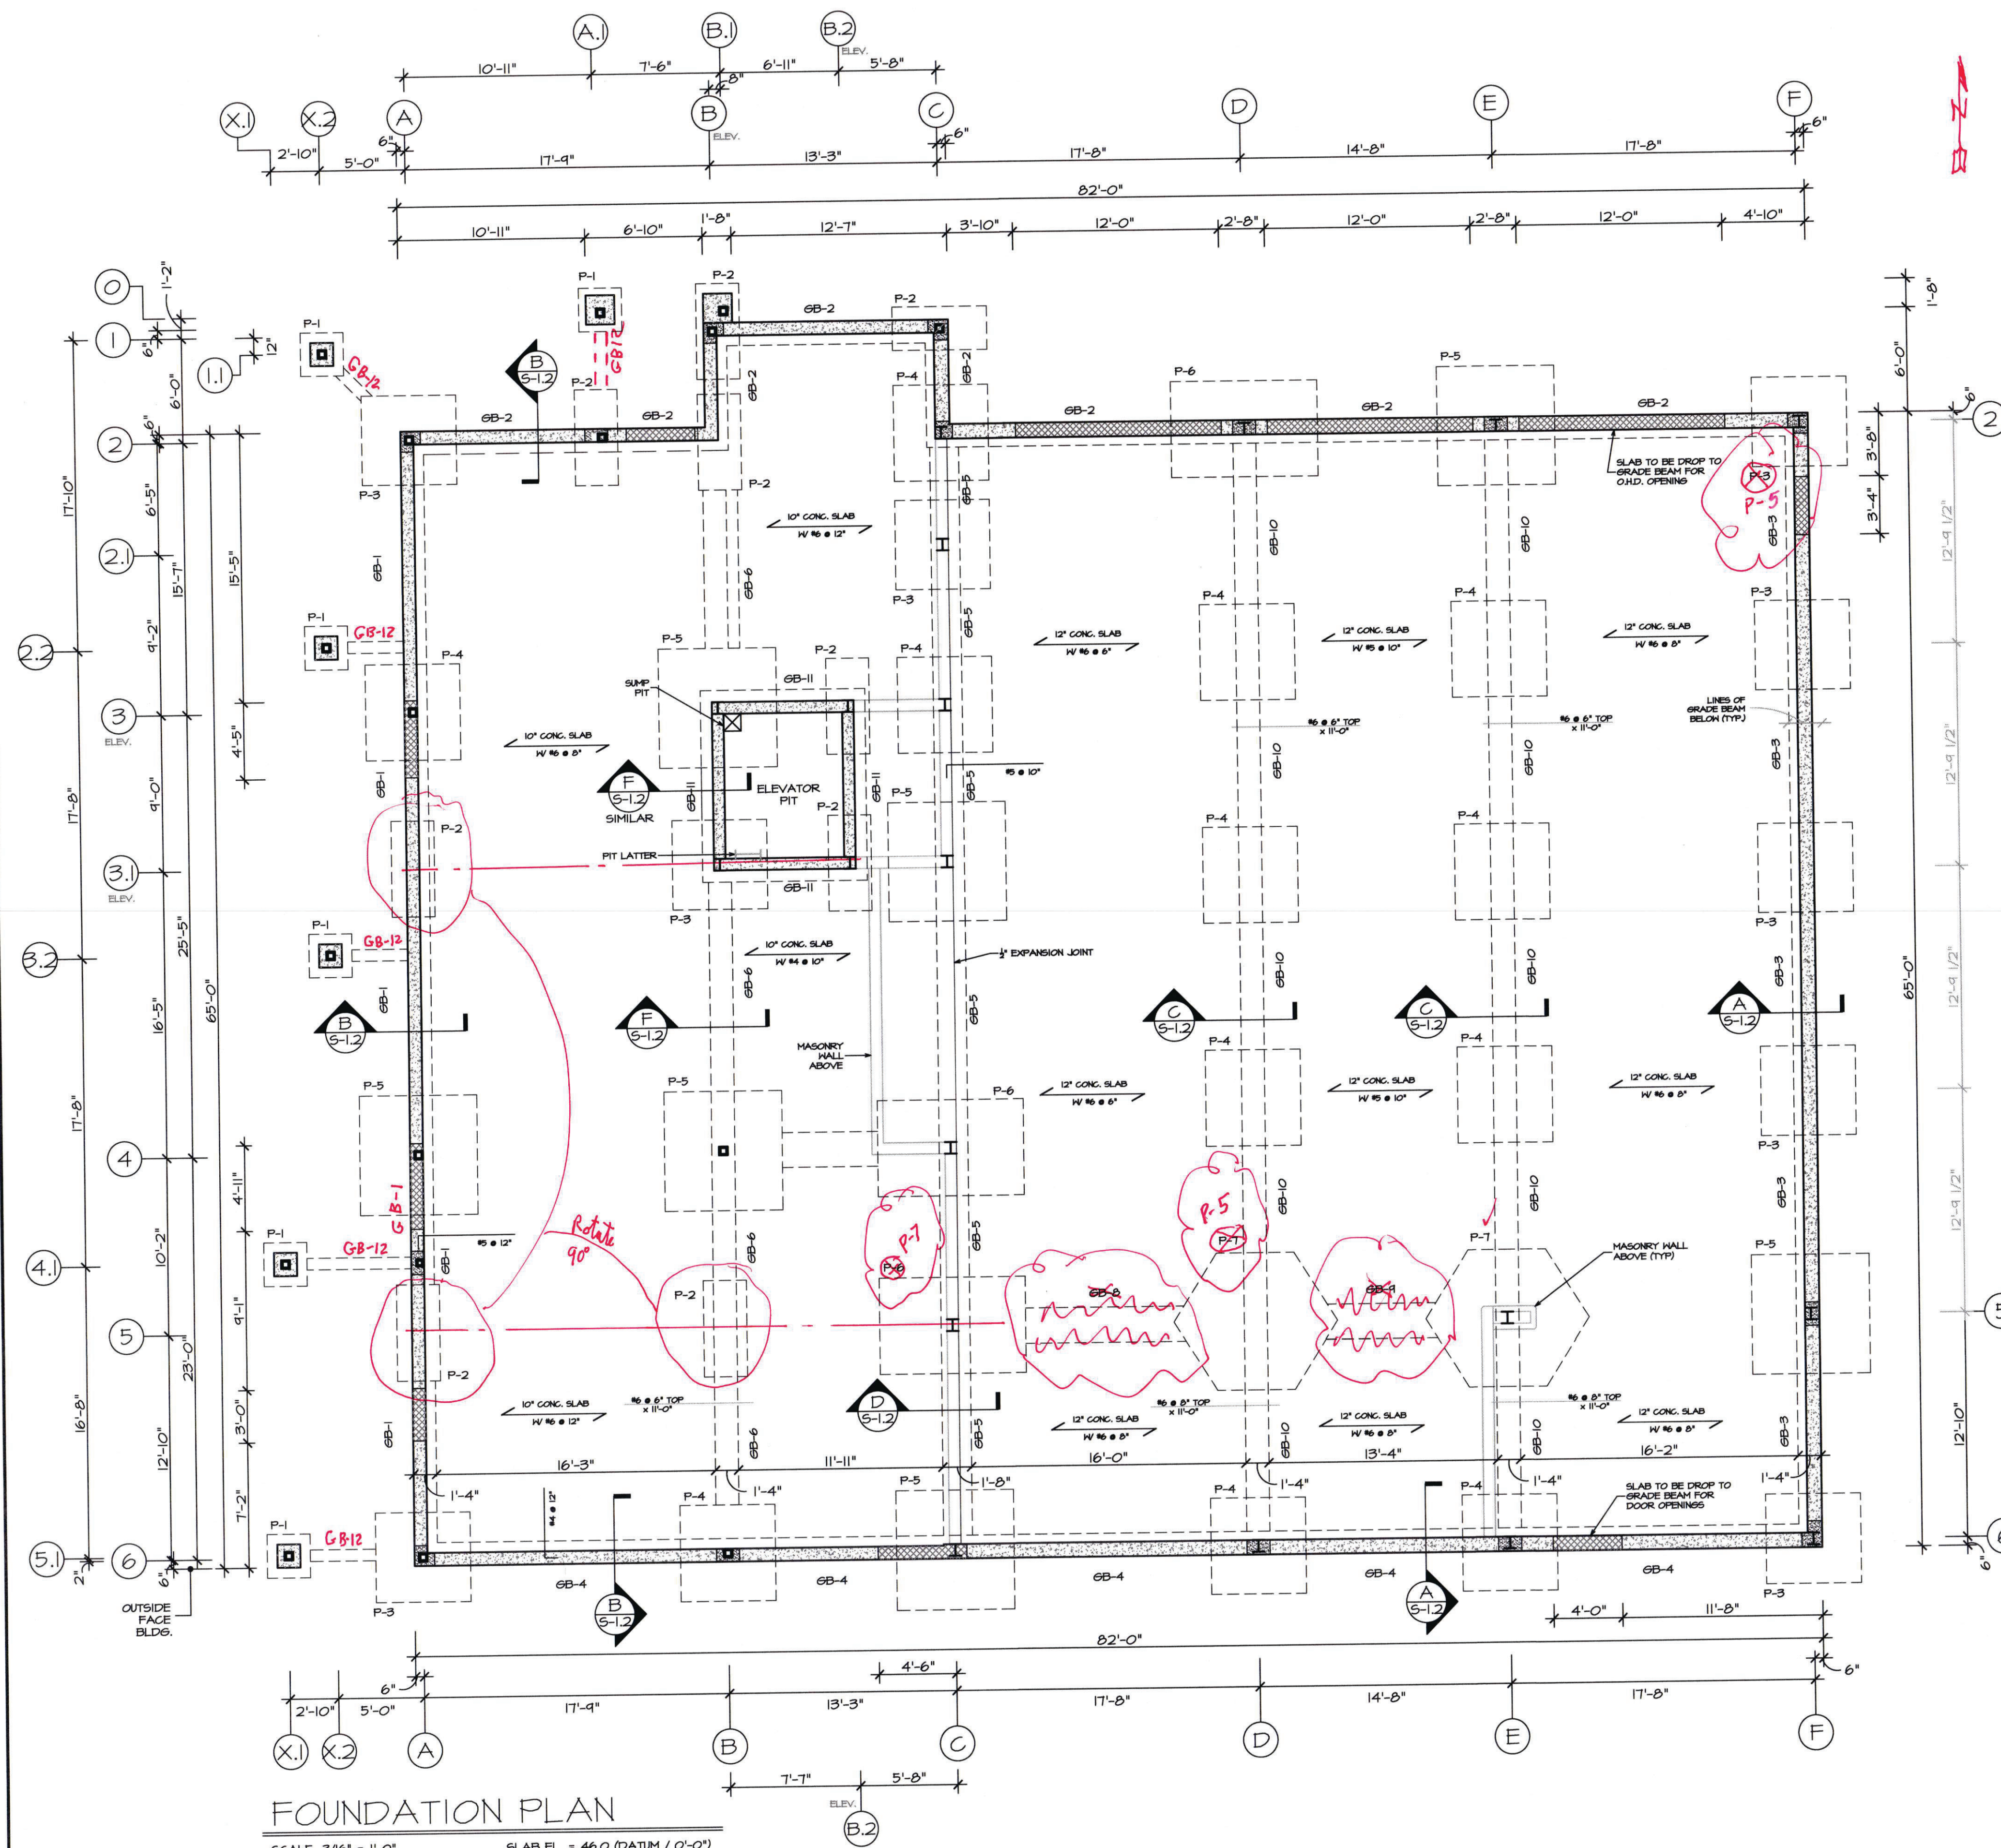


FOUNDATION PLAN

SCALE: 3/16" = 1'-0" SLAB EL. = 46.0 (DATUM / 0'-0")

NOTES:

1. HEAVY DUTY 20-MIL VAPOR BARRIER SHALL BE PROVIDED & INSTALLED UNDER ALL CONCRETE SLABS.
2. REFER TO TEST HOLES PROVIDED IN SITE DRAWINGS FOR SOIL CLASSIFICATIONS & ANTICIPATED DEPTHS. RESULTS WITHIN PROVIDED TEST HOLES SHALL BE CONSIDERED APPLICABLE TO ALL OTHER AREAS OF THE SITE.
3. BID DEPTH OF HELICAL PILES SHALL BE 20'-0" FROM DATUM ELEV. 44.0
4. UNIT PRICE IS TO BE PROVIDED IN BID FOR EXTRA/CREDIT FOR DIFFERENCE IN ACTUAL DEPTH COMPARED TO THE 25'-0"
5. COORDINATE UNDER SLAB PIPING HANGERS WITH PLUMBING CONTRACTOR.
6. GC SHALL VERIFY ELEVATOR PIT CLEAR DIMENSIONS W/ APPROVED MANUFACTURER PRIOR TO FORMING/POURING & STEEL WORK.
7. INCLUDE SLAB EXPANSION JOINTS FOR ALL MAIN COLUMN LINES. VERIFY REQUIRED LOCATIONS PRIOR TO PLACEMENT.

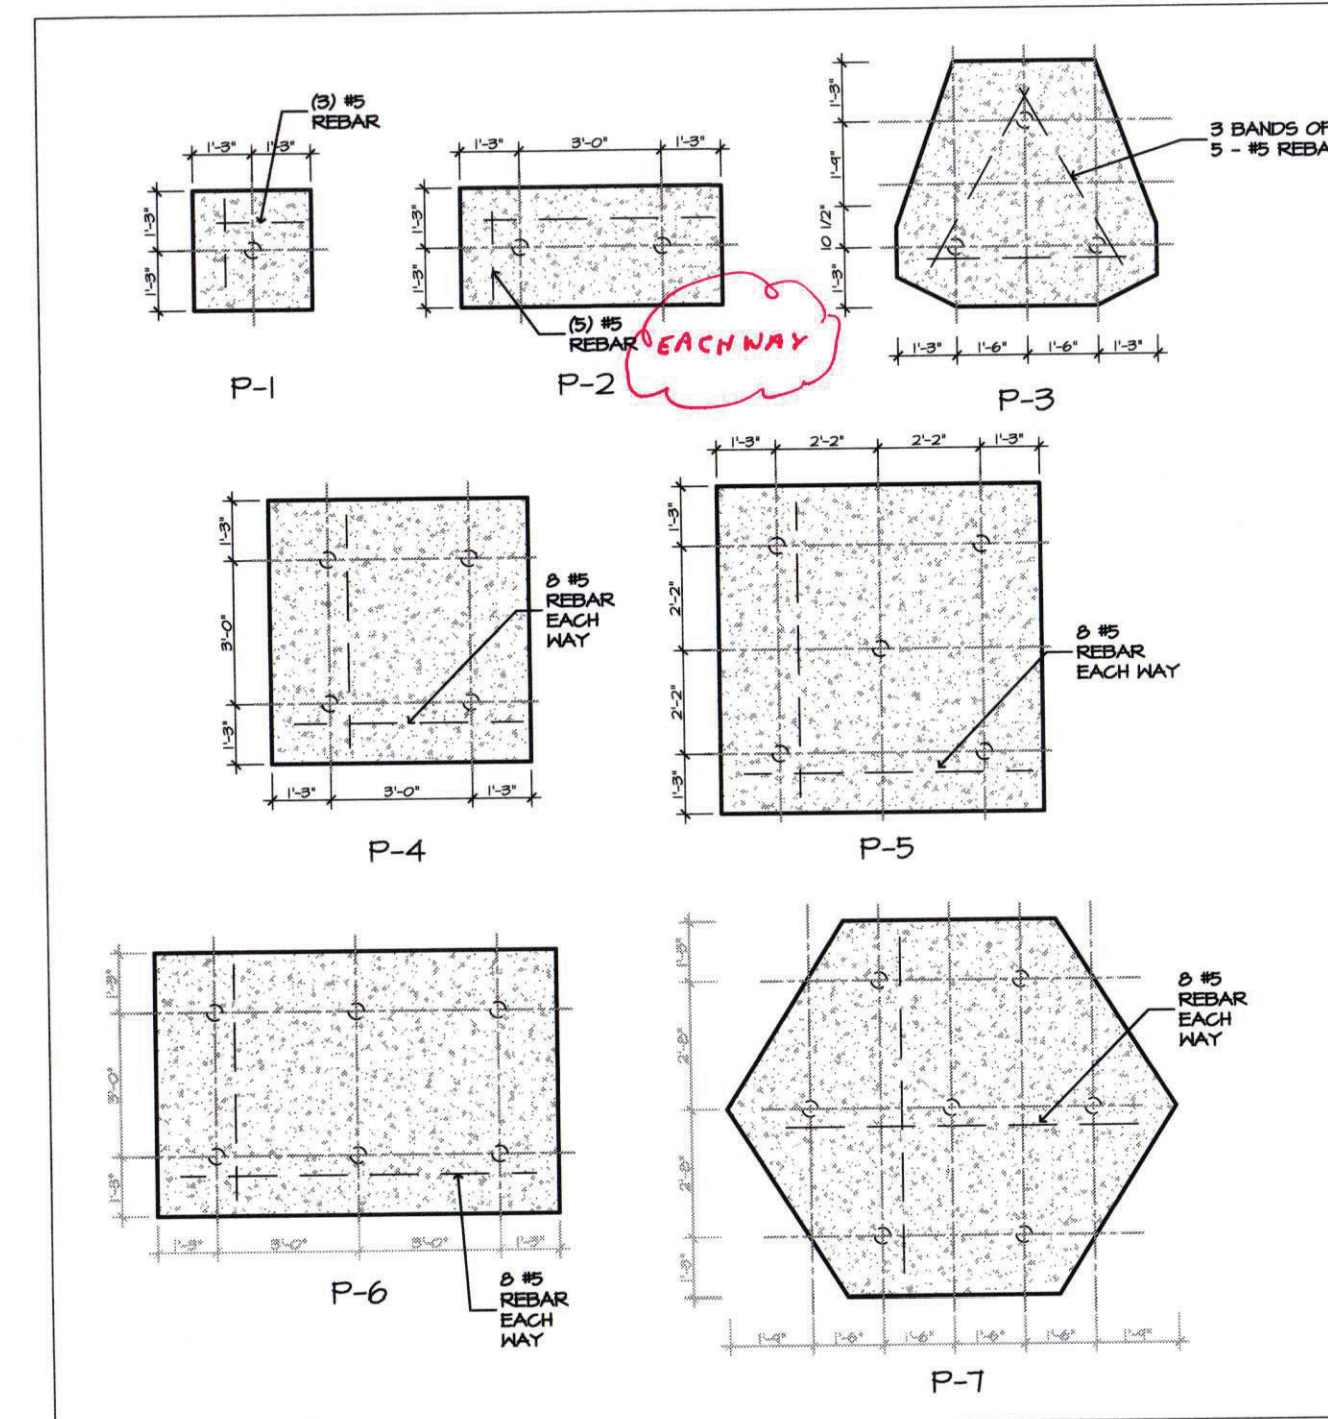

PILE CAP DETAILS

SCALE: 1/4" = 1'-0"

GRADE BEAM SCHEDULE				
DESIGNATION	SIZE	TOP STEEL	BOTTOM STEEL	#5 STIRRUPS @ 12"
GB-1	16"x36"	3 - #7	3 - #6	#5 STIRRUPS @ 12"
GB-2	16"x36"	3 - #5	3 - #5	#5 STIRRUPS @ 12"
GB-3	16"x36"	3 - #6	3 - #7	#5 STIRRUPS @ 12"
GB-4	16"x36"	3 - #7	3 - #7	#5 STIRRUPS @ 12"
GB-5	20"x36"	3 - #7	3 - #6	#5 STIRRUPS @ 12"
GB-6	16"x36"	3 - #6	3 - #6	#5 STIRRUPS @ 12"
GB-7	16"x36"	3 - #6	3 - #6	#5 STIRRUPS @ 12"
GB-8	16"x36"	4 - #4	4 - #4	#5 STIRRUPS @ 12"
GB-9	16"x36"	4 - #4	3 - #4	#5 STIRRUPS @ 12"
GB-10	16"x36"	4 - #5	3 - #4	#5 STIRRUPS @ 12"
GB-11	16"x66"	4 - #5	3 - #4	#5 STIRRUPS @ 12"
GB-12	12"x12"	2-#5	2-#5	#3 Stirrups @ 12"


HELICAL PILE NOTES:

1. ALL PILES SHALL BE PATENTED HELICAL PILES AND APPURTANCES AS FURNISHED BY PREMIUM TECHNICAL SERVICES OR EQUAL.
2. HELICAL PILE LEAD SECTIONS SHALL BE MODEL SS175 WITH A 1-3/4" DIAMETER ROUND SHAFT AND (1) 10", (1) 12" AND (1) 14" DIAMETER HELIX. LEAD SECTIONS SHALL BE 55' LONG. HELIX PILE EXTENSION MAY BE 5', 7', OR 10' LONG DEPENDING ON VERTICAL CLEARANCE.
3. HELICAL PILES, EXTENSIONS AND APPURTANCES SHALL BE HOT DIPPED GALVANIZED STEEL IN ACCORDANCE WITH ASTM A153.
4. ALL PILE INSTALLATION OPERATIONS SHALL BE SUPERVISED BY A N.Y.S. LICENSED ENGINEER COMMISSIONED BY THE PILE INSTALLER. THE INSPECTOR SHALL KEEP A COMPLETE RECORD OF THE PILE INSTALLATION OPERATION.
5. HELICAL PILES SHALL BE INSTALLED THROUGH ALL FILL, BOG, SILT, ETC. AND TO PENETRATE A MINIMUM DEPTH 10' INTO GOOD GRANULAR BEARING MATERIAL, AND TO A MINIMUM CAPACITY OF 15 TONS (WORKING LOAD).
6. HELICAL PILES SHALL BE INSTALLED AS SHOWN ON THE ENGINEERS PLAN. ALL CHANGES IN PILE LOCATION MUST BE APPROVED BY THE DESIGN ENGINEER.
7. IF UNDERGROUND OBSTRUCTIONS ARE ENCOUNTERED DURING INSTALLATION, THE CONTRACTOR SHALL HAVE THE OPTION OF REMOVING THE OBSTRUCTION, IF POSSIBLE, OR RELOCATING THE PILE WITH THE DESIGN ENGINEERS APPROVAL. THE LATTER OPTION MAY REQUIRE THE RELOCATION OF ADJACENT PILES.
8. THE HELICAL PILE SHALL BE CONNECTED TO THE STRUCTURE USING A PTS APPROVED STEEL BRACKET OR CAP PLATE AS THE CASE MAY BE SHOWN ON DESIGN ENGINEERS PLAN. THESE CONNECTION DEVICES SHALL BE CAPABLE OF SAFELY TRANSFERRING THE STRUCTURAL LOADS TO THE HELICAL PILE.
9. WRITTEN INSTALLATION RECORDS SHALL BE MAINTAINED FOR EACH HELICAL PILE. THESE RECORDS SHALL INCLUDE BUT ARE NOT LIMITED TO THE FOLLOWING:
 - A. PROJECT NAME AND/OR LOCATION.
 - B. NAME OF CONTRACTORS FOREMAN OR REPRESENTATIVE WHO WITNESSED THE INSTALLATION
 - C. DATE AND TIME OF INSTALLATION.
 - D. LOCATION AND REFERENCE NUMBER OF EACH PILE.
 - E. DESCRIPTION OF LEAD SECTION AND EXTENSIONS INSTALLED.
 - F. OVERALL DEPTH OF INSTALLATIONS REFERENCED FROM THE BOTTOM OF GRADE BEAM OR PILE CAP.
 - G. TORQUE READING FOR THE LAST THREE FEET OF INSTALLATION IF PRACTICAL. IN LIEU OF THIS REQUIREMENT, THE TERMINAL TORQUE SHALL BE RECORDED AS A MINIMUM.
 - H. ANY OTHER RELEVANT INFORMATION RELATING TO THE INSTALLATION.
10. THE INSTALLERS N.Y.S. LICENSED PROFESSIONAL ENGINEER MUST CERTIFY THE PILE INSTALLATION RECORD.

DATE: ISSUE
01-20-2022 ISSUED FOR BID & PERMIT

SEAL:

SENDEWSKI ARCHITECTS PC
ARCHITECTS - PLANNERS
215 ROANOKE AVENUE
RIVERHEAD, NY 11901
(631) 727-5352
9 SELENA COURT
WALDEN, NY 12586
(845) 275-8859

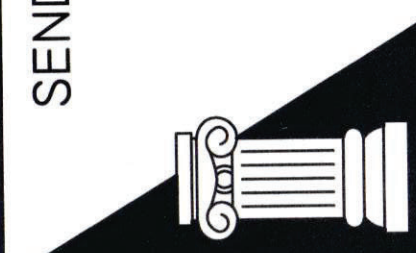

PROPOSED NEW FACILITY
TAPPAN FIRE DISTRICT
135 WASHINGTON STREET
TAPPAN, NY 10983

FOUNDATION PLAN
& DETAILS


PROJECT #: 2108.01A


DRAWN BY:

CAD FILE: 2108.01A/P/BID

DRAWING#:

S-1.1

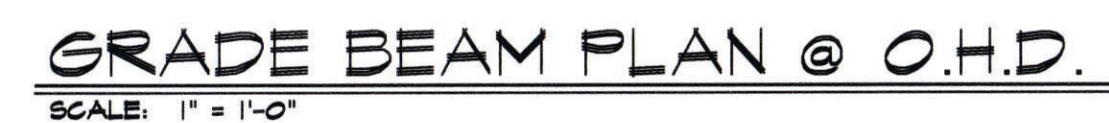

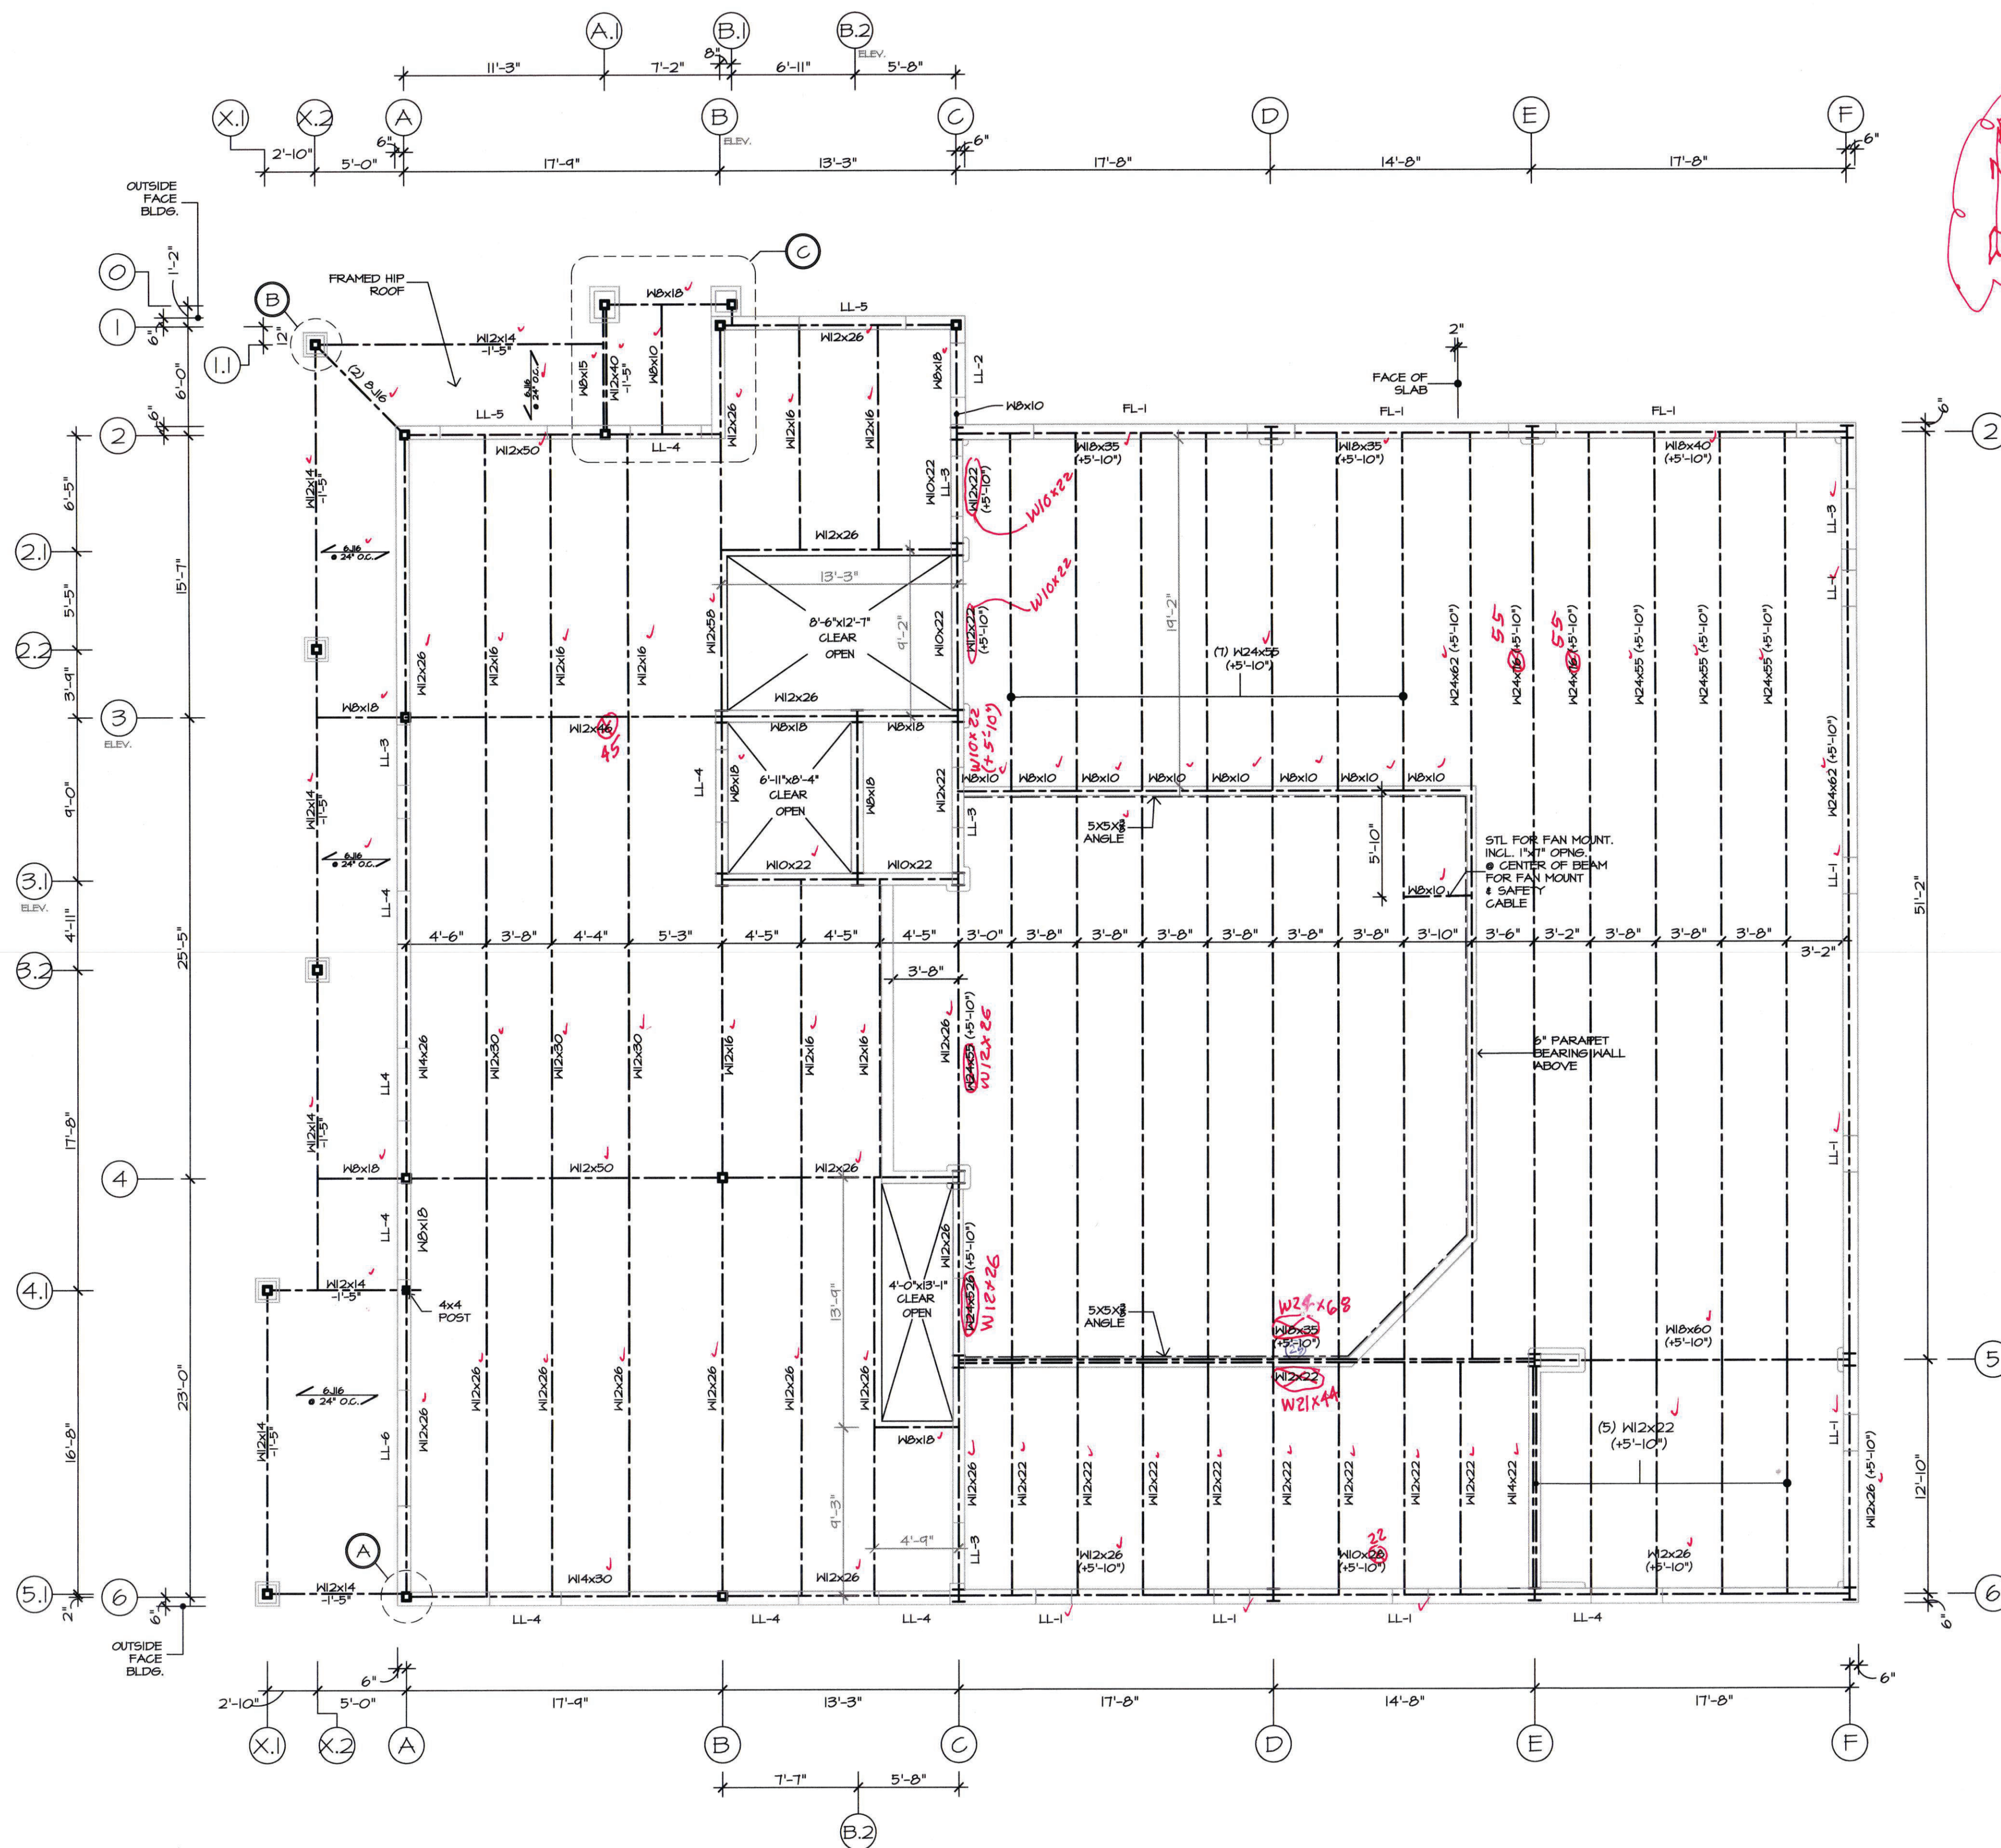

SECOND FLOOR FRAMING PLAN


SCALE: 3/16" = 1'-0"

NOTES:

1. TOP OF STEEL ELEVATION +11'-3" UNLESS NOTED OTHERWISE USING +11'-3" AS REFERENCE. ALL ELEVATIONS ARE FROM FIRST FLOOR DATUM ELEVATION 0'-0".
2. SECOND FLOOR DECK TO BE 5" CONC. SLAB ON 1 1/2" DEEP 22-GAUGE 'B-LOK' COMPOSITE FLOOR DECK W/ 6"x6"-W4.0/W4.0 WMM.
3. ATTIC FLOOR DECK TO BE 5" CONC. SLAB ON 1 1/2" DEEP 22-GAUGE 'B-LOK' COMPOSITE FLOOR DECK W/ 6"x6"-W4.0/W4.0 WMM.

LOAD NOTES:

1. LL 100#/SF + 75#/SF DL USED FOR ALL ATTIC AREAS OVER 5'-0" HIGH.
2. 50#/SF LL + 20#/SF DL PROVIDED FOR FLAT ROOF AREAS.

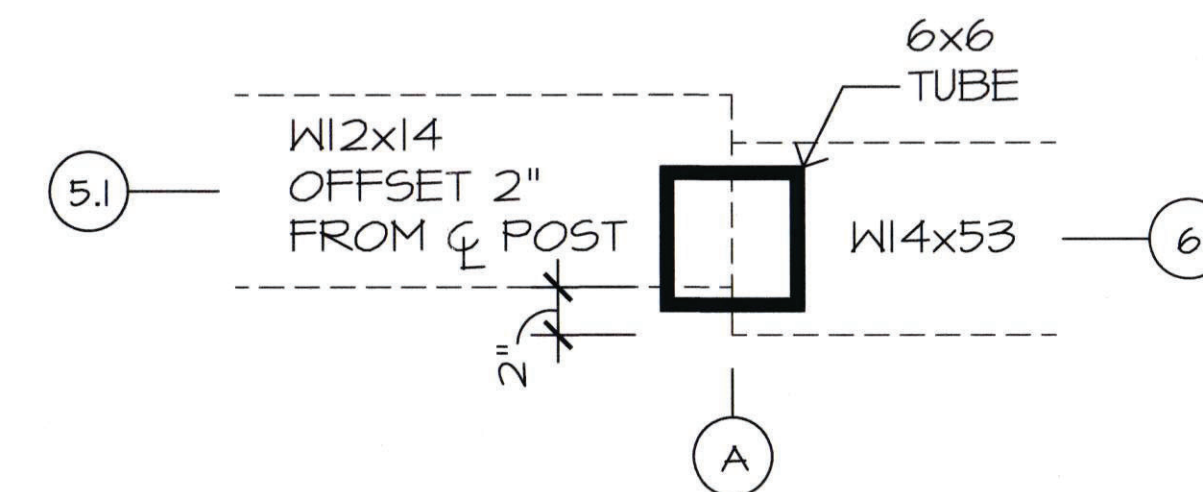


A POST DETAIL

SCALE: 1 1/2" = 1'-0"


LINTEL SCHEDULE

MARK	SIZE
LL-1	2 JLs 3 1/2 x 3 1/2 x 5/16"
LL-2	2 JLs 3 1/2 x 3 1/2 x 5/16"
LL-3	2 JLs 3 1/2 x 3 1/2 x 5/16"
LL-4	2 JLs 3 1/2 x 4 x 5/16"
LL-5	2 JLs 5 x 3 1/2 x 5/16"
FL-1	

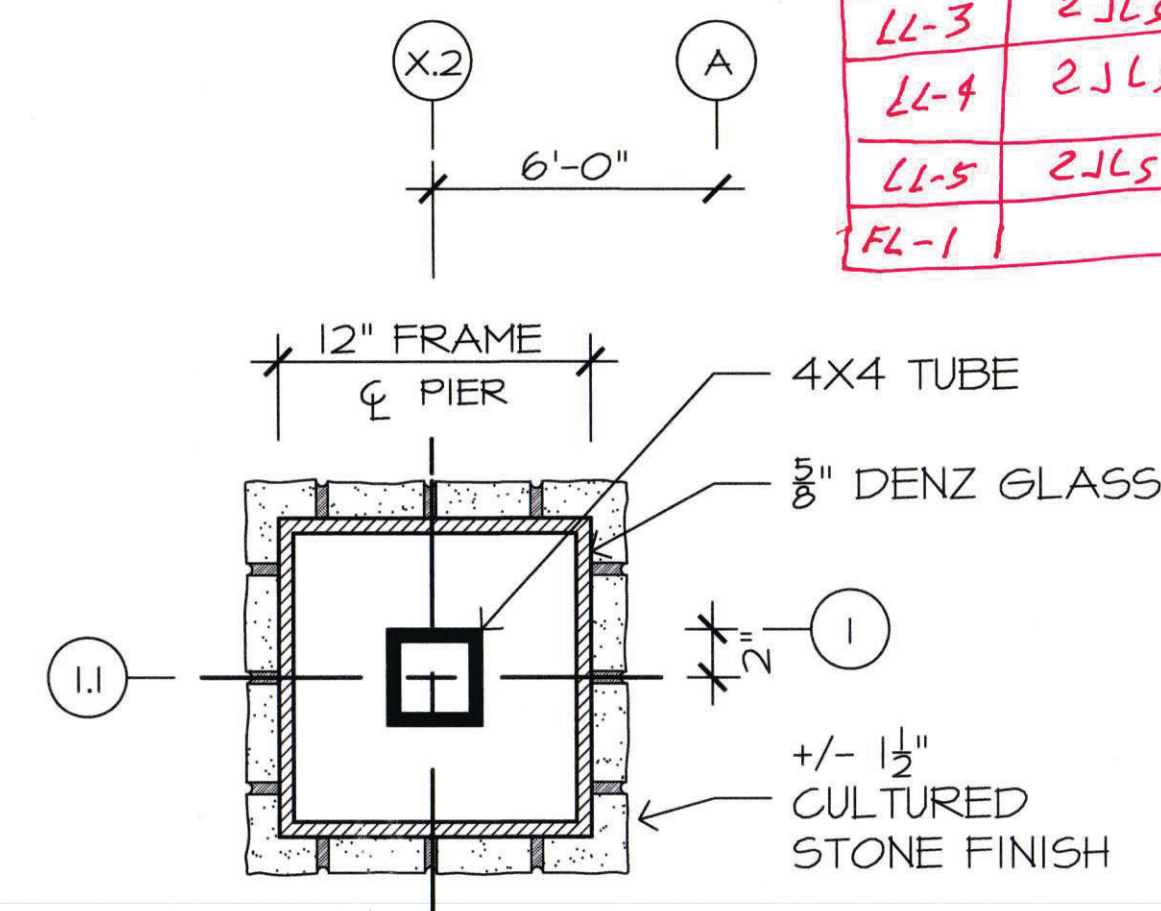

B PIER DETAIL

SCALE: 1 1/2" = 1'-0"

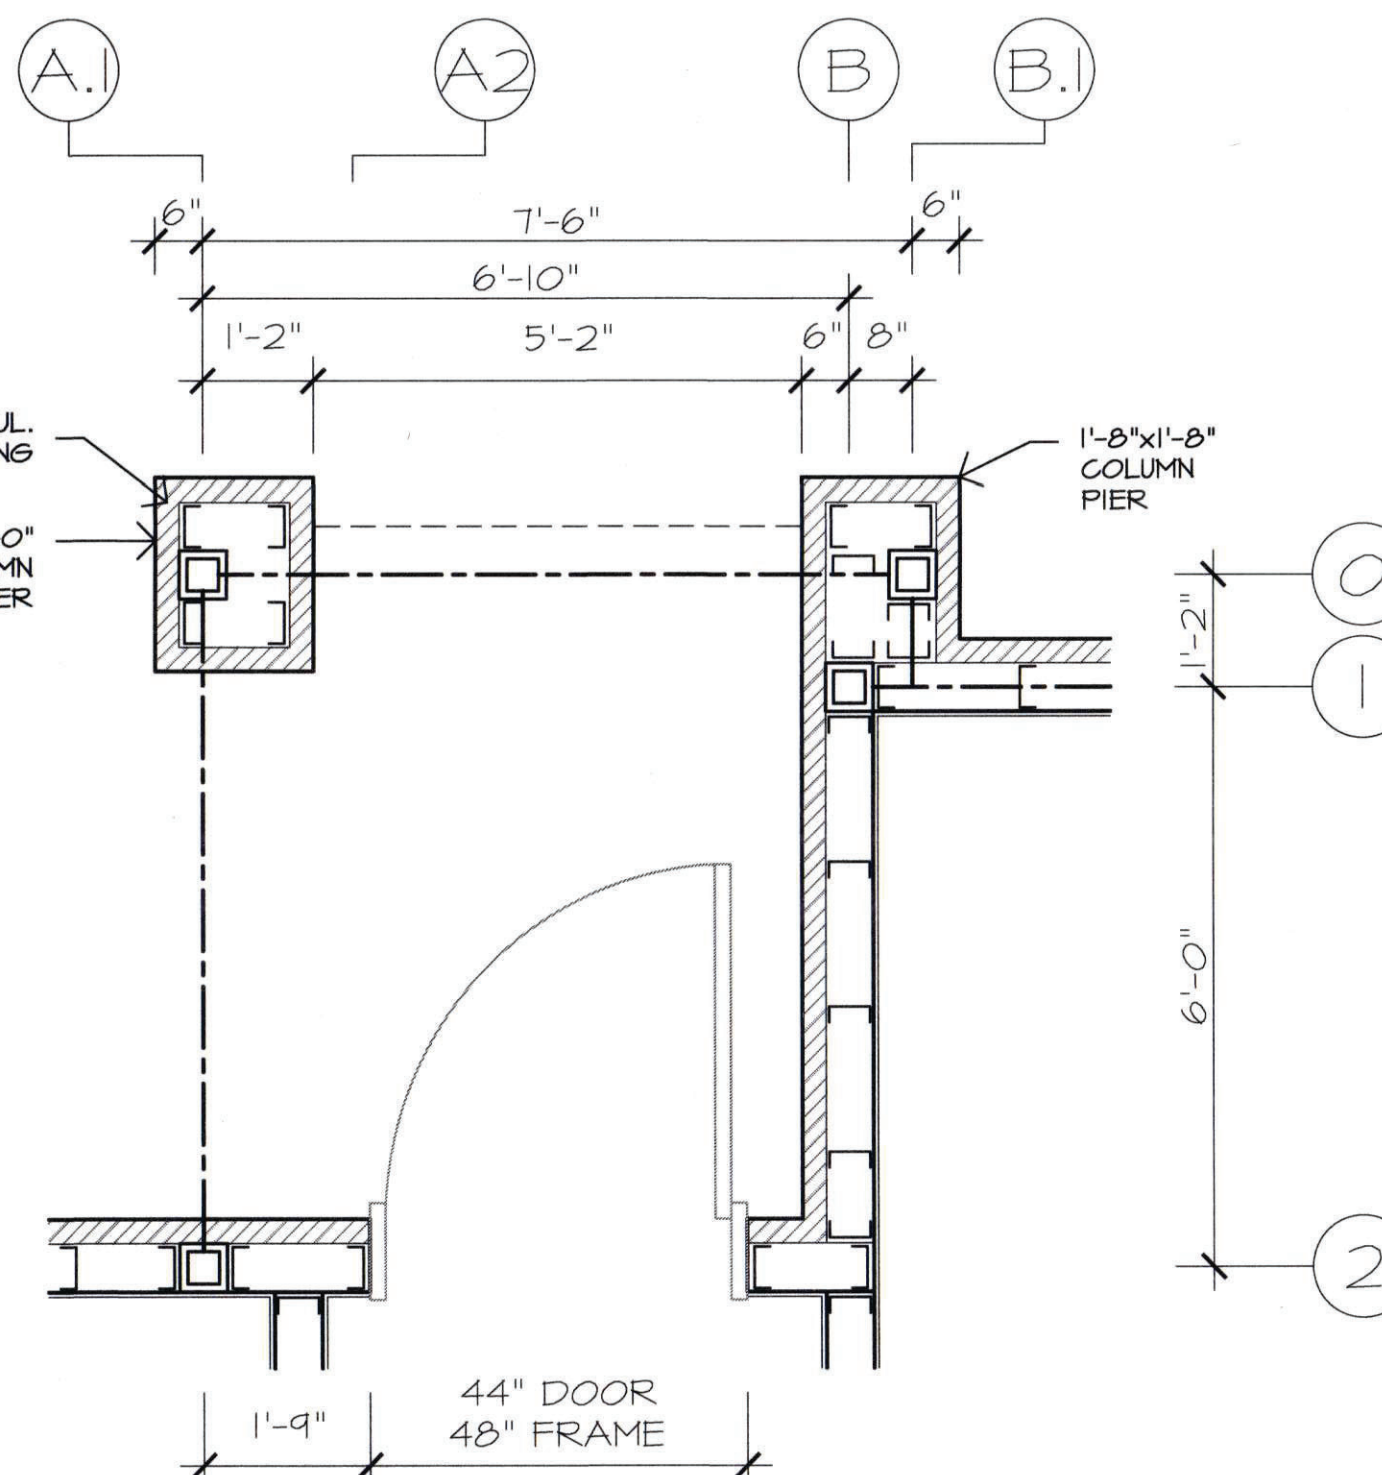

C PIER DETAIL

SCALE: 1 1/2" = 1'-0"

DATE: ISSUE

07-20-2022 ISSUED FOR BID & PERMIT

SEAL:

SENDEWSKI ARCHITECTS PC
ARCHITECTS - PLANNERS
215 ROANOKE AVENUE
RIVERHEAD, NY 11901
(631) 727-5352
9 SELENA COURT
WALDEN, NY 12586
(845) 275-8859

PROPOSED NEW FACILITY
TAPPAN FIRE DISTRICT
135 WASHINGTON STREET
TAPPAN, NY 10983

SECOND FLOOR/ATTIC FRAMING
PLAN & DETAILS

PROJECT #: 2108.01A

DRAWN BY:

CAD FILE: 2108.01A/P/BID

DRAWING#:

S-2

		COLUMN SCHEDULE																								COVERED PATIO											
COL. NO.		A-2	A-3	A-4	A-4.1	A-6	A-10	A-12	B-1	B-3 #B-3.1 (ELEV.)	B-4	B-6	B-6.1	B-2.3 (ELEV.)	B-2.3.1 (ELEV.)	C-1	C-2	C-2.1	C-3	C-3.1	C-4	C-5	C-6	D-2	D-6	E-2	E-5	E-6	F-2	F-5	F-6	X1-5.1	X1-4.1	X2-3.2	X2-2.2	X2-1.1	
TIER																																					
UPPER TRUSS ROOF +25'-0"																																					
UPPER ATTIC/ FLAT ROOF FLOOR +17'-6"																																					
2ND. FLR. +11'-8"																																					
1ST. FL. +0'-0" (DATUM)																																					
BASE PLATE SEE DETAILS		B	C	C	E	B	E	C	B	F	C	C	E	F	F	B	A	A	A	A	A	A	A	A	A	A	A	A	A	A	A	E	E	E	E	E	

NOTES:

- BOTTOM ELEV. OF ALL COLUMNS BELOW DATUM TO BE -7" ± 1" NON-SHRINK GROUT (UNLESS NOTED OTHERWISE)
- WELDED MASONRY ANCHORS ON ALL COLUMNS @ CMU SHALL BE FULL HEIGHT TYPICAL. COORDINATE W/ MASON FOR ANCHOR TIE INSTALLS.
- ALL TUBE COLUMNS TO BE $F_y = 46$ ksi
- ALL 'W' COLUMNS 50 ksi UNLESS NOTED OTHERWISE

TAPPAN PD - DESIGN CRITERIA:

DESIGN LOADS:

GROUND SNOW LOAD = 36 PSF
 SNOW LOAD IMPORTANCE FACTOR $I_s = 1.2$
 THERMAL FACTOR $C = 1.0$
 FLAT ROOF SNOW LOAD = 25.2 PSF
 ROOF DEAD LOAD = 25 PSF
 ROOF LIVE LOAD = 20 PSF
 FLOOR (LL) = 100 PSF
 FLOOR (DL) = 50/105 PSF
 (DRIFTING LOADS IN ACCORDANCE WITH ASCE 7)
 WIND (128 MPH) = 42 PSF
 WIND IMPORTANCE FACTOR $I_w = 1.15$
 EXPOSURE 'B'
 INTERNAL PRESSURE COEFFICIENT = ± 0.18
 DESIGN WIND PRESSURE FOR COMPONENTS & CLADDING = +34 PSF; -43 PSF
 OCCUPANCY CATEGORY IV


SEISMIC DESIGN PARAMETERS:

- $I_e = 1.50$; SEISMIC USE GROUP 'IV'
- $S_s = .299$
 $S_1 = .062$
- SITE CLASS 'D'
- $S_{DS} = .259$
 $S_{D1} = .062$
- SEISMIC DESIGN CATEGORY 'C'
- SEISMIC COEFFICIENTS FOR ORDINARY REINFORCED MASONRY SHEARWALLS
 - $R = 2$
 - $QV = 2.5$
 - $C_d = 2$
 - REDUNDANCY COEFFICIENT = 1.0
 - FUNDAMENTAL PERIOD = .41 SEC.
 - $C_e = .113$
- SEISMIC COEFFICIENTS FOR LIGHT-FRAME (COLD-FORMED STEEL) WALL SYSTEMS USING PLAT STRIP BRACING
 - $R = 4$
 - $QV = 2$
 - $C_d = 3.5$
 - REDUNDANCY COEFFICIENT = 1.0
 - FUNDAMENTAL PERIOD = .31 SEC.
 - $C_e = .046$
- DESIGN BASE SHEAR = 95.6 KIPS

SPECIAL INSPECTIONS REQUIRED:

- STEEL
 - MATERIAL VERIFICATION OF STRUCTURAL STEEL
 - HIGH STRENGTH BOLTS
 - WELDING
 - JOINT DETAILS AS CONSTRUCTED
- CONCRETE
 - REINFORCING STEEL
 - ANCHOR BOLTS
 - PLACEMENT & CURING
 - SAMPLING FRESH CONCRETE
- MASONRY
 - MORTAR & JOINTS
 - REINFORCING
 - HOT & COLD WEATHER PROTECTION
 - GROUTING
- PILE FOUNDATIONS
 - CONTINUOUS SPECIAL INSPECTIONS DURING INSTALLATION.
- SOIL BEARING CAPACITY (PER TEST BORINGS REPORT)

BASEPLATE DETAILS

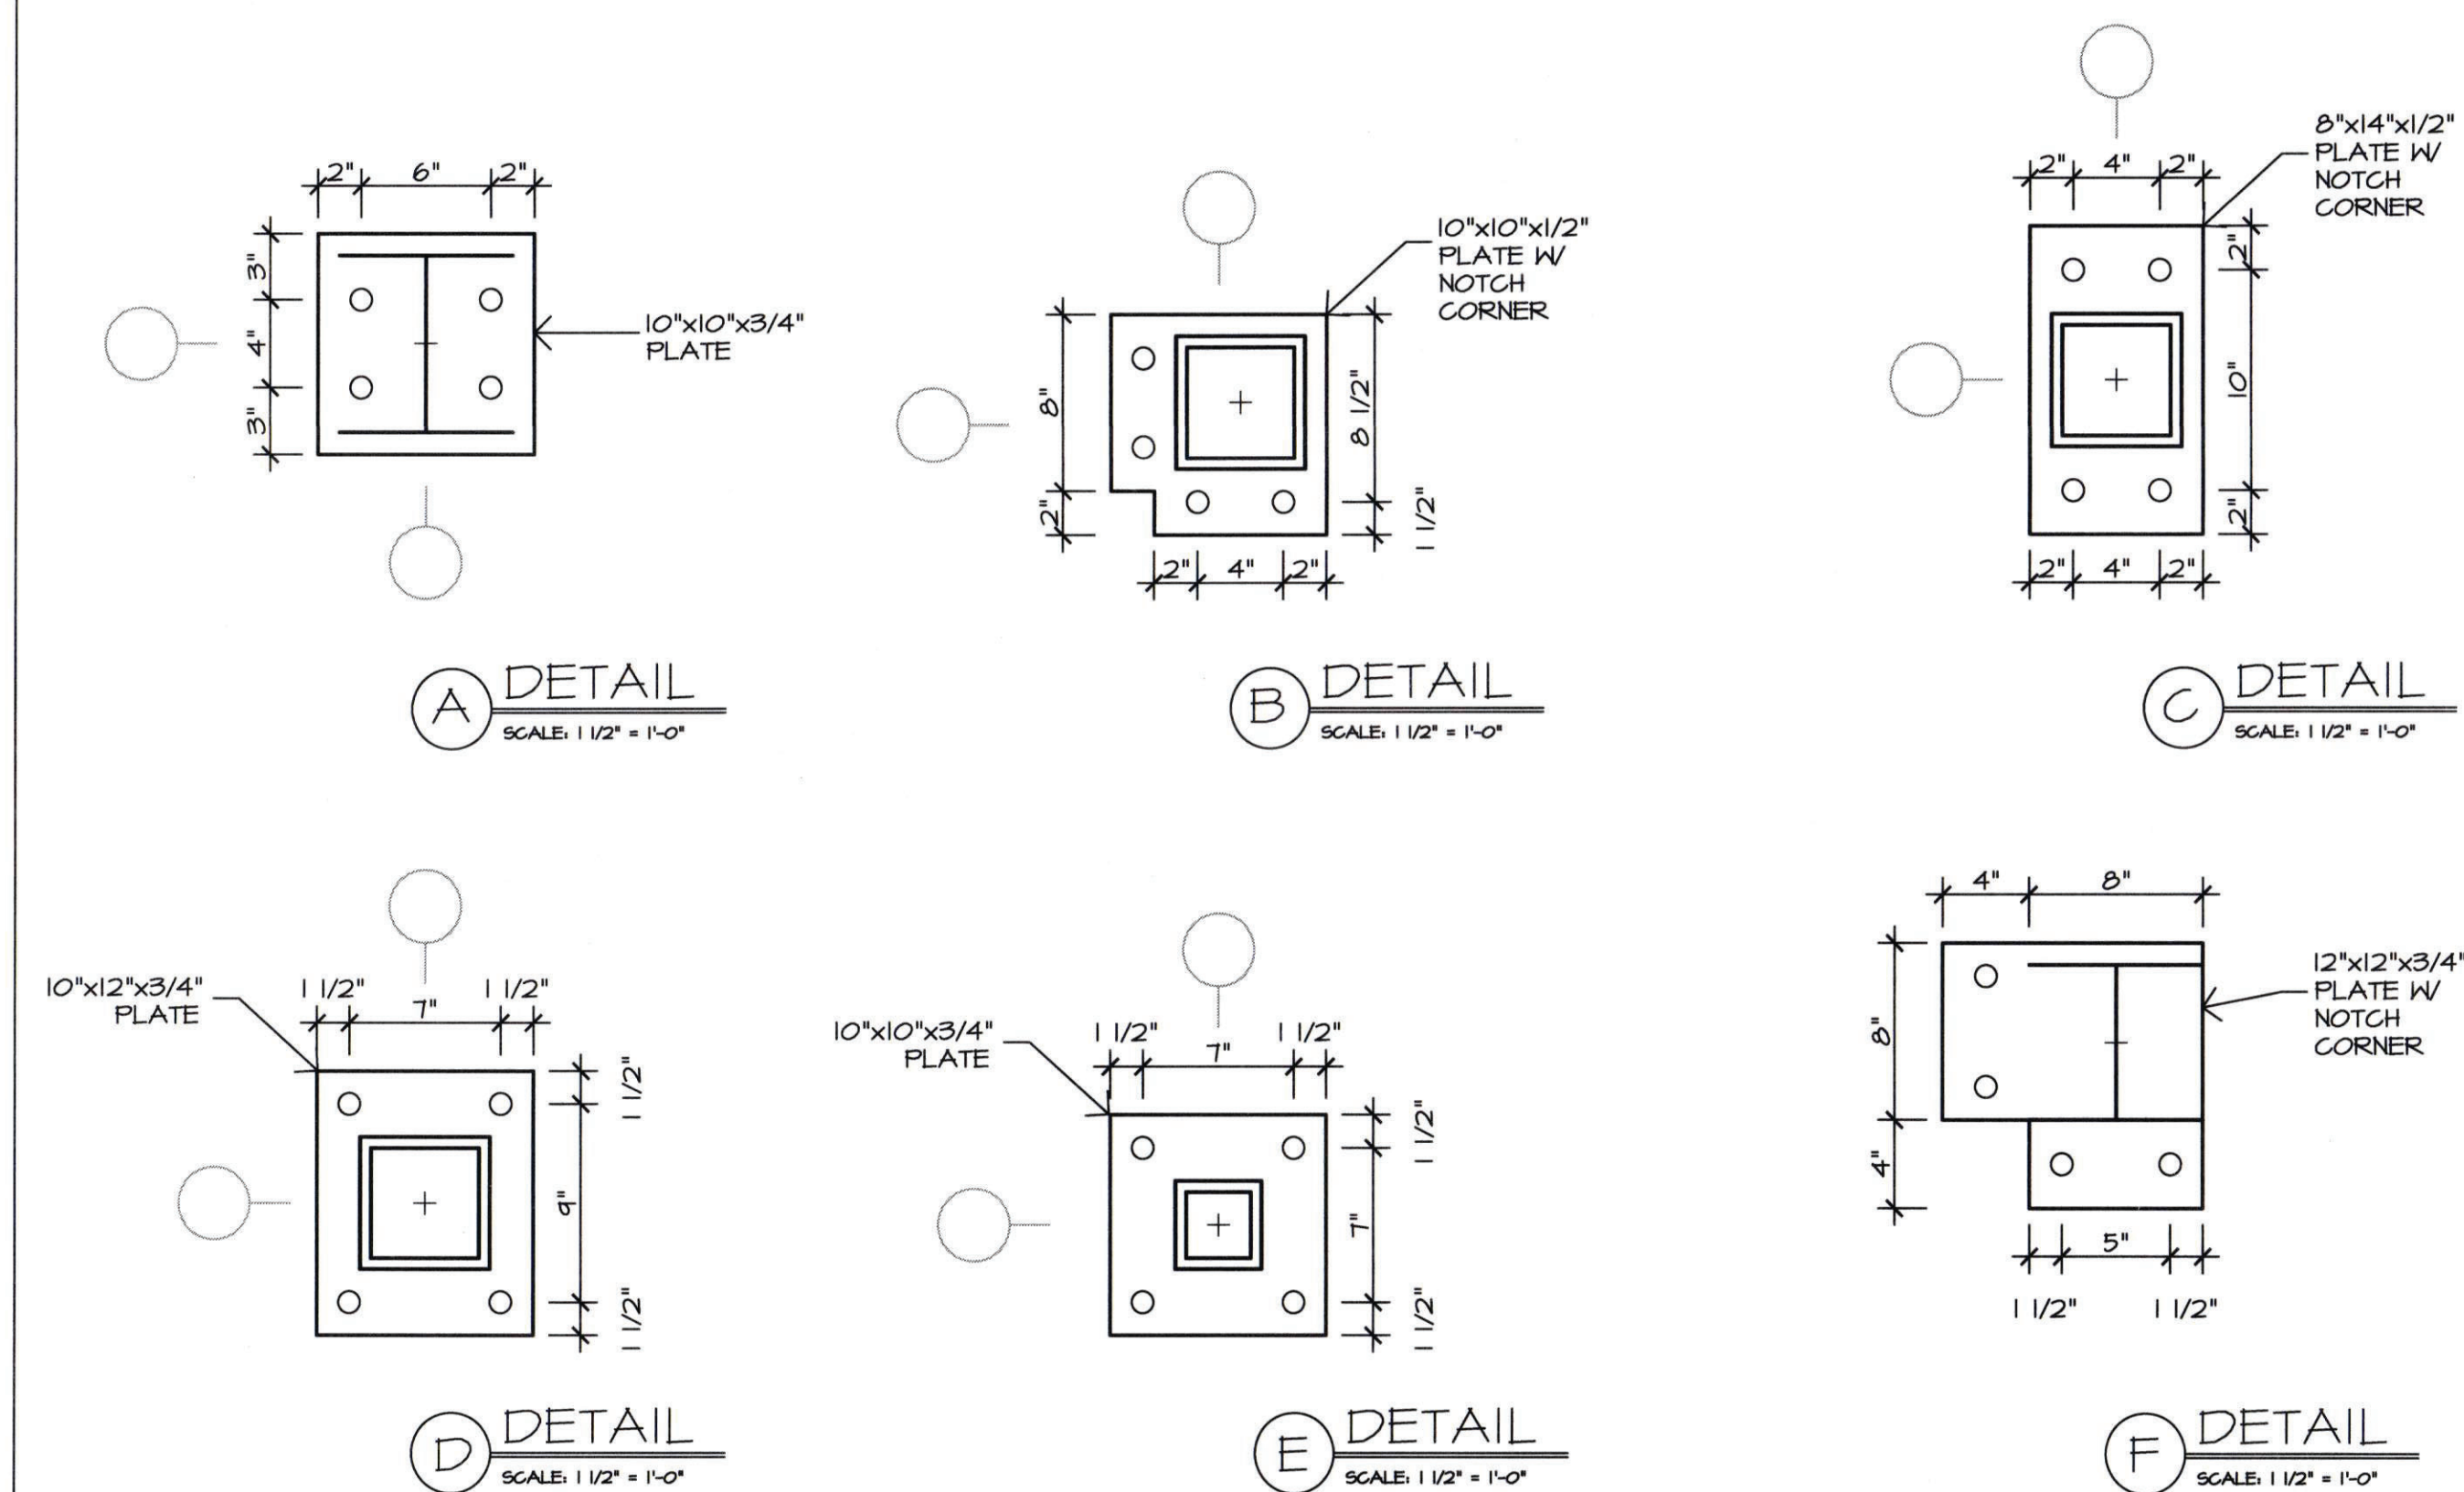

GENERAL STRUCTURAL NOTES

FOUNDATION:

- ALL PILE CAP FOOTINGS SHALL REST ON HELICAL PILES. SEE DETAILS DWG S-1
- KEEP FOOTING BOTTOMS WELL DRAINED UNTIL FOOTINGS ARE IN PLACE, PUMP AS REQUIRED.
- CONSTRUCTION JOINTS IN FOUNDATION WALLS SHALL BE NO MORE THAN 50 FEET APART AND NO LESS THAN 4'-0" FROM ANY PIER. REINFORCEMENT SHALL BE CONTINUOUS THROUGH CONSTRUCTION JOINTS. DO NOT USE HORIZONTAL CONSTRUCTION JOINTS.
- SLABS ON GRADE SHALL BE PLACED BY STRIP PLACING METHOD (MAX. WIDTH 50 FT. BY INFINITE LENGTH) WITH CONTROL JOINTS (SAW CUT) MAX. 50'-0" O.C. CONSTRUCTION JOINTS SHALL BE LOCATED ALONG LENGTH OF PLACEMENT AND AT ENDS OF PLACEMENT.

CONCRETE:

- ALL CONCRETE WORK SHALL CONFORM TO ACI 301-16; EXTERIOR CONCRETE WORK SHALL BE 4000 PSI AIR-ENTRAINED. SLABS ON GRADE SHALL BE NORMAL WEIGHT CONCRETE.
- ALL REINFORCEMENT SHALL BE DEFORMED TYPE INTERMEDIATE GRADE NEW BILLET STEEL CONFORMING TO ASTM A-615 GRADE 60.
- TEMPERATURE REINFORCEMENT, SPLICES, SUPPORTS FOR REINFORCEMENT SHALL CONFORM TO REQUIREMENTS OF ACI-318 14.
- CONTINUOUS REINFORCEMENTS SHALL BE LAPPED 48 DIAMETERS AT SPLICES AND CORNERS AND HOOKED AT NON-CONTINUOUS ENDS OR EXTENDED 24 BAR DIAMETERS UNLESS OTHERWISE NOTED. DETAILING OF ALL REINFORCEMENT SHALL BE IN ACCORDANCE WITH ACI SP-66. (BB)
- PROVIDE TWO #6 ALL SIDES FOR OPENINGS IN CONCRETE WALLS UNLESS OTHERWISE NOTED. EXTEND BARS 2'-0" BEYOND OPENING. HOOK ENDS.
- PROVIDE SLEEVES AND BOX OUT FOR OPENINGS FOR MECHANICAL TRADES. OPENINGS SHALL BE PLACED SO AS NOT TO AFFECT THE STRENGTH OF STRUCTURAL MEMBERS.
- BEFORE PLACING CONCRETE, CONTRACTOR SHALL SUBMIT FOR REVIEW A COMPLETE SEQUENCE OF PLACING SCHEDULE INDICATING ALL CONSTRUCTION JOINTS, TIME SCHEDULE, AND GUARANTEE OF CONTINUITY OF CONCRETE SUPPLY.

MASONRY:

- ALL CONCRETE BLOCK SHALL BE LOAD BEARING AND SHALL CONFORM TO A.S.T.M. STANDARD C-90 FOR GRADE 'N' UNITS. MORTAR SHALL BE TYPE 'M'.
- PROVIDE VERTICAL CONTROL JOINTS IN BLOCK WALL 30'-0" O.C. MAXIMUM USING A PRE MOLDED FILLER AND JAMB BLOCKS UNLESS DETAILED OTHERWISE.
- ALL BLOCK WALLS SHALL BE CONSTRUCTED WITH SALV. WALL REINFORCING. REINFORCING TO BE TRUSS-TYPE # GAUGE AND PLACED A MAXIMUM OF 1'-4" O.C. VERTICALLY AND TO BE THE WIDTH RECOMMENDED BY THE MANUFACTURER. PROVIDE #5 BARS @ 32" O.C. VERT. IN ALL MASONRY WALLS
- FILL BLOCKS SOLID UNDER CONCENTRATED LOADS IN ALL BLOCK WALLS ABOVE AND BELOW GRADE.
- ALL ANCHORAGE PLACED IN MASONRY SHALL BE ANCHORED SECURELY WITH CONCRETE.
- ALL JAMBS AT MASONRY OPENINGS SHALL BE FILLED SOLID WITH CONCRETE.

STRUCTURAL STEEL:

- STRUCTURAL STEEL SHALL BE FABRICATED AND ERECTED IN ACCORDANCE WITH AISC SPECIFICATIONS FOR DESIGN, FABRICATION AND ERECTION OF STRUCTURAL STEEL FOR BUILDINGS.
- ROLLED SHAPES AND PLATES SHALL CONFORM TO ASTM DESIGNATION A-572 UNLESS NOTED OTHERWISE; STEEL PIPE SHALL CONFORM TO ASTM A501; STRUCTURAL TUBING SHALL CONFORM TO ASTM A500 GRADE B.
- SHOP CONNECTIONS SHALL BE WELDED. FIELD CONNECTIONS SHALL BE 3/4" DIAMETER A-325 TYPE N CONNECTION, EXCEPT WHERE FIELD WELDING IS CALLED FOR ON THE DRAWINGS.
- WELDING SHALL COMPLY WITH AWS SPECIFICATIONS. USE ETOXX ELECTRODES.
- ALL STEEL SHALL RECEIVE ONE SHOP COAT OF RUST-INHIBITIVE PAINT.
- PROVIDE ANGLE ANCHORS AT ENDS OF ALL BEAMS RESTING ON MASONRY OR CONCRETE.
- CONNECTIONS TO BE DOUBLE ANGLE CONNECTIONS UNLESS NOTED OTHERWISE.
- ALL BASE PLATES SHALL BE ANCHORED WITH (4) 3/4" DIAMETER BY 18" LONG ANCHOR RODS UNLESS NOTED OTHERWISE.
- ALL LOOSE LINTELS SHALL HAVE A MINIMUM OF 8" BEARING AT EACH END OF M.O.; PROVIDE FLASHING AT ALL EXTERIOR OPENINGS. ALL WIDE FLANGE LINTELS SHALL HAVE A MINIMUM OF 10" BEARING EACH END OVER 16" BRICK MASONRY.
- PROVIDE ALL BOLTS, HOLES ANCHORS, ANGLES, ETC. AS REQUIRED FOR A COMPLETE INSTALLATION AND AS REQUIRED BY THE WORK OF OTHER TRADES.
- PROVIDE MASONRY ANCHORS AT 32" O.C. ON ALL SPANDREL BEAMS AND 16" O.C. ON ALL COLUMNS. HOHMANN & BARNARD 1/4" #VMT SALV. WALL TIE WITH #334 SALV. WELD-ON TIES OR APP. EQUAL.
- STEEL DECK:
 - STEEL ROOF DECK SHALL BE 22 GAUGE, 1 1/2" DEEP, GALVANIZED, TYPE 'B' AS MANUFACTURED BY UNITED STEEL DECK INC. OR APPROVED EQUAL; FLOOR DECK SHALL BE 1 1/2" DEEP SALV. 22 GAUGE B-LOK COMPOSITE FLOOR DECK
 - WELD SIDE LAPS AT MID-POINT OF SPAN.

DATE: ISSUE
 07-20-2022 ISSUED FOR BID
 & PERMIT

SEAL:

SENLEWSKI ARCHITECTS PC
 ARCHITECTS - PLANNERS
 215 ROANOKE AVENUE
 RIVERHEAD, NY 11901
 (631) 727-5352
 9 SELENA COURT
 WALDEN, NY 12586
 (845) 275-8859

PROPOSED NEW FACILITY
 TAPPAN FIRE DISTRICT
 135 WASHINGTON STREET
 TAPPAN, NY 10983
 COLUMN SCHEDULE & DETAILS







PROJECT #: 2108.01A

DRAWN BY:

CAD FILE: 2108.01A/P:/BID

DRAWING#:

S=4

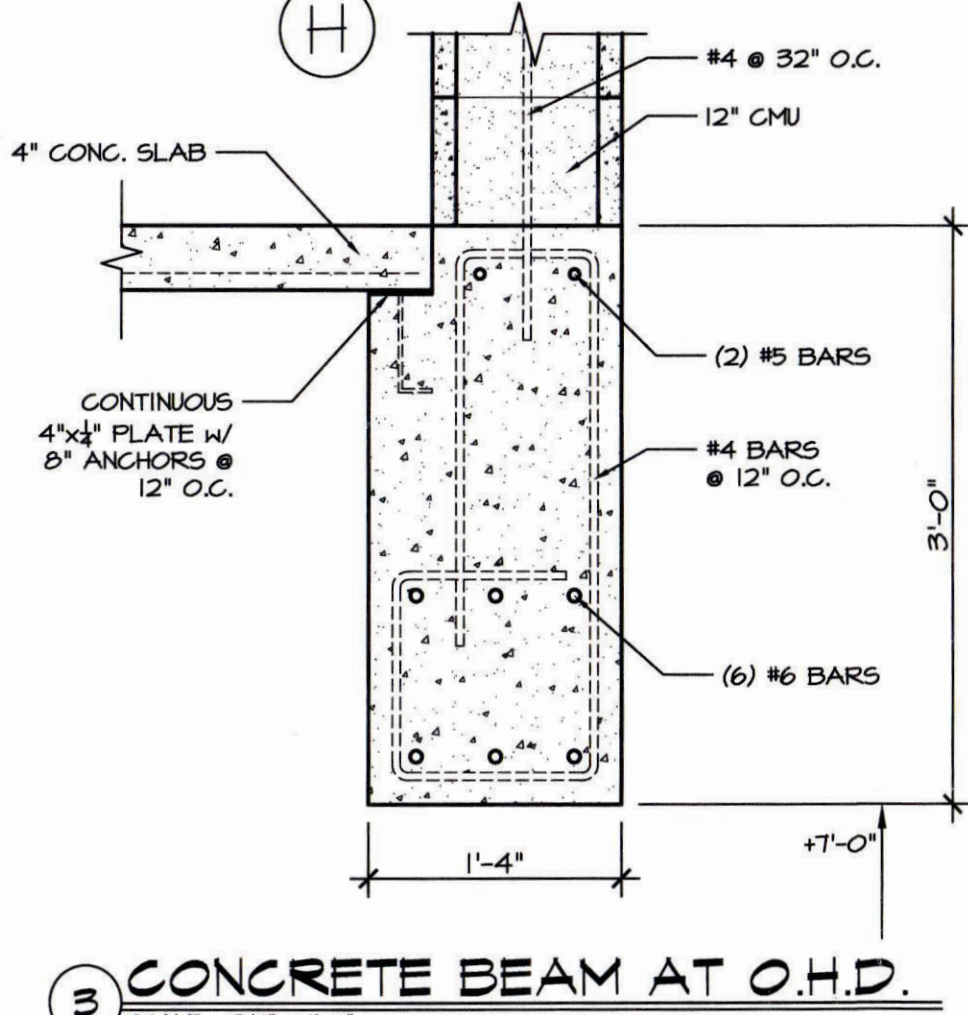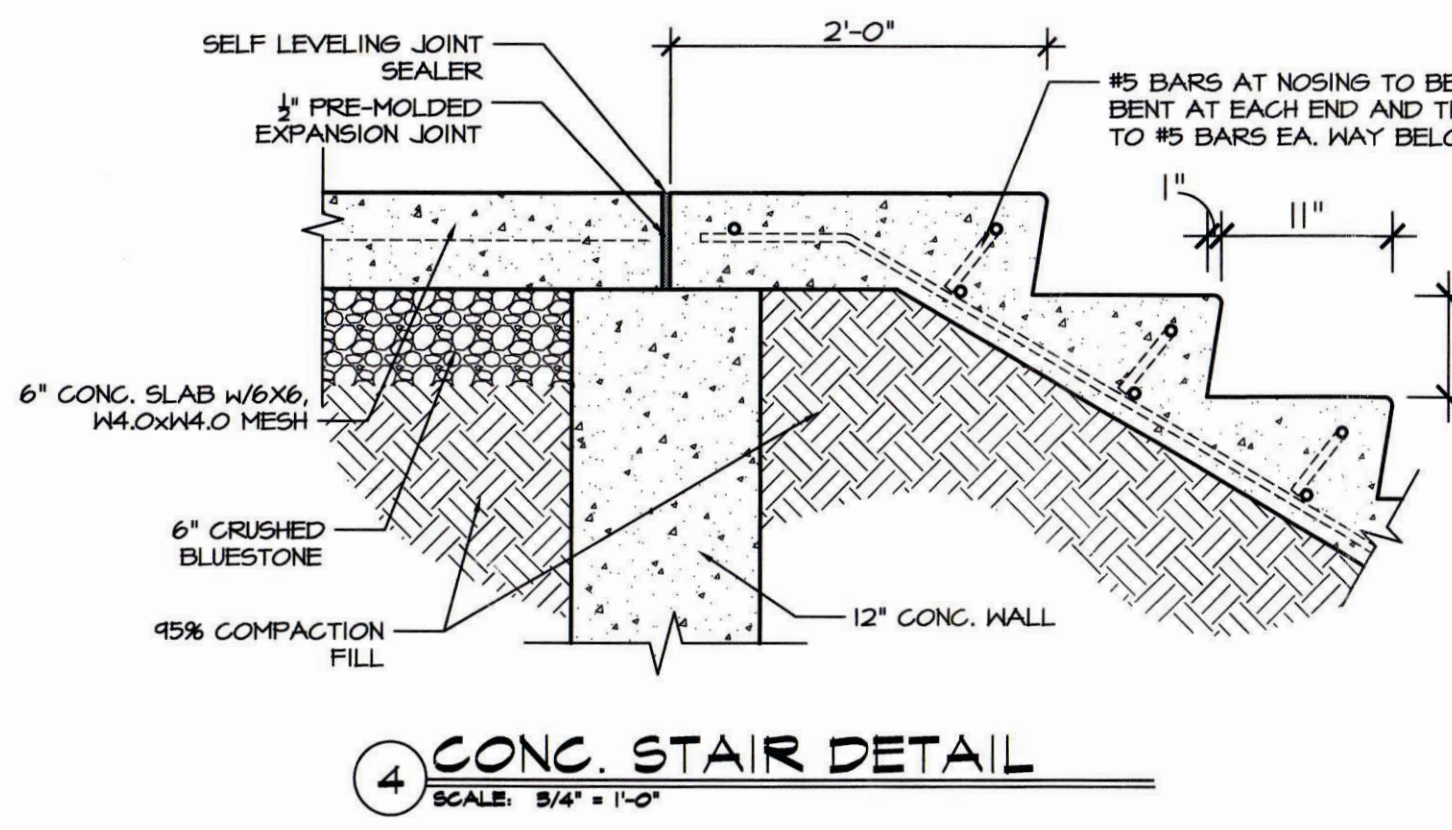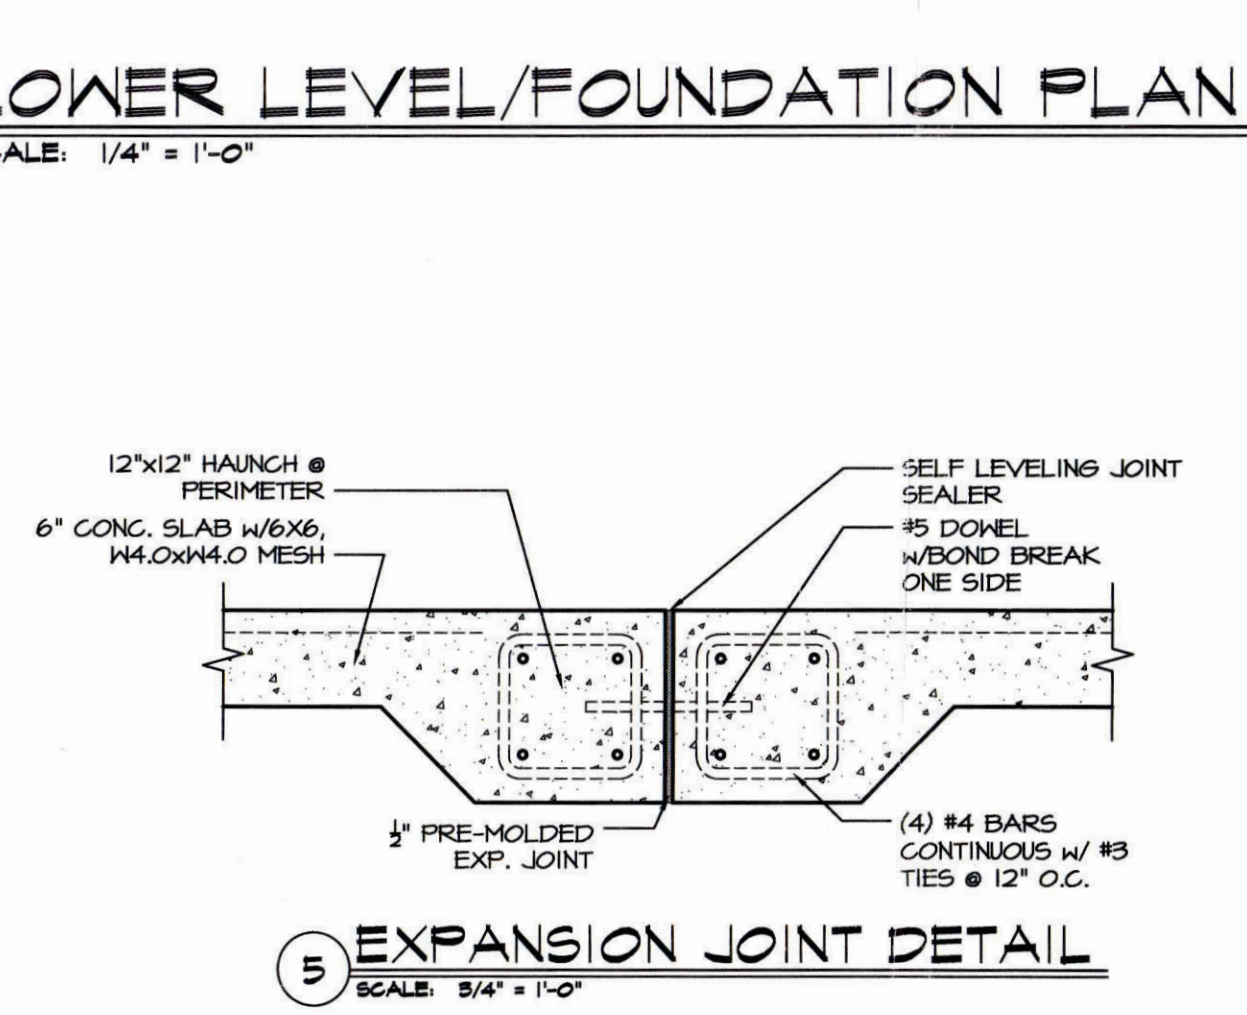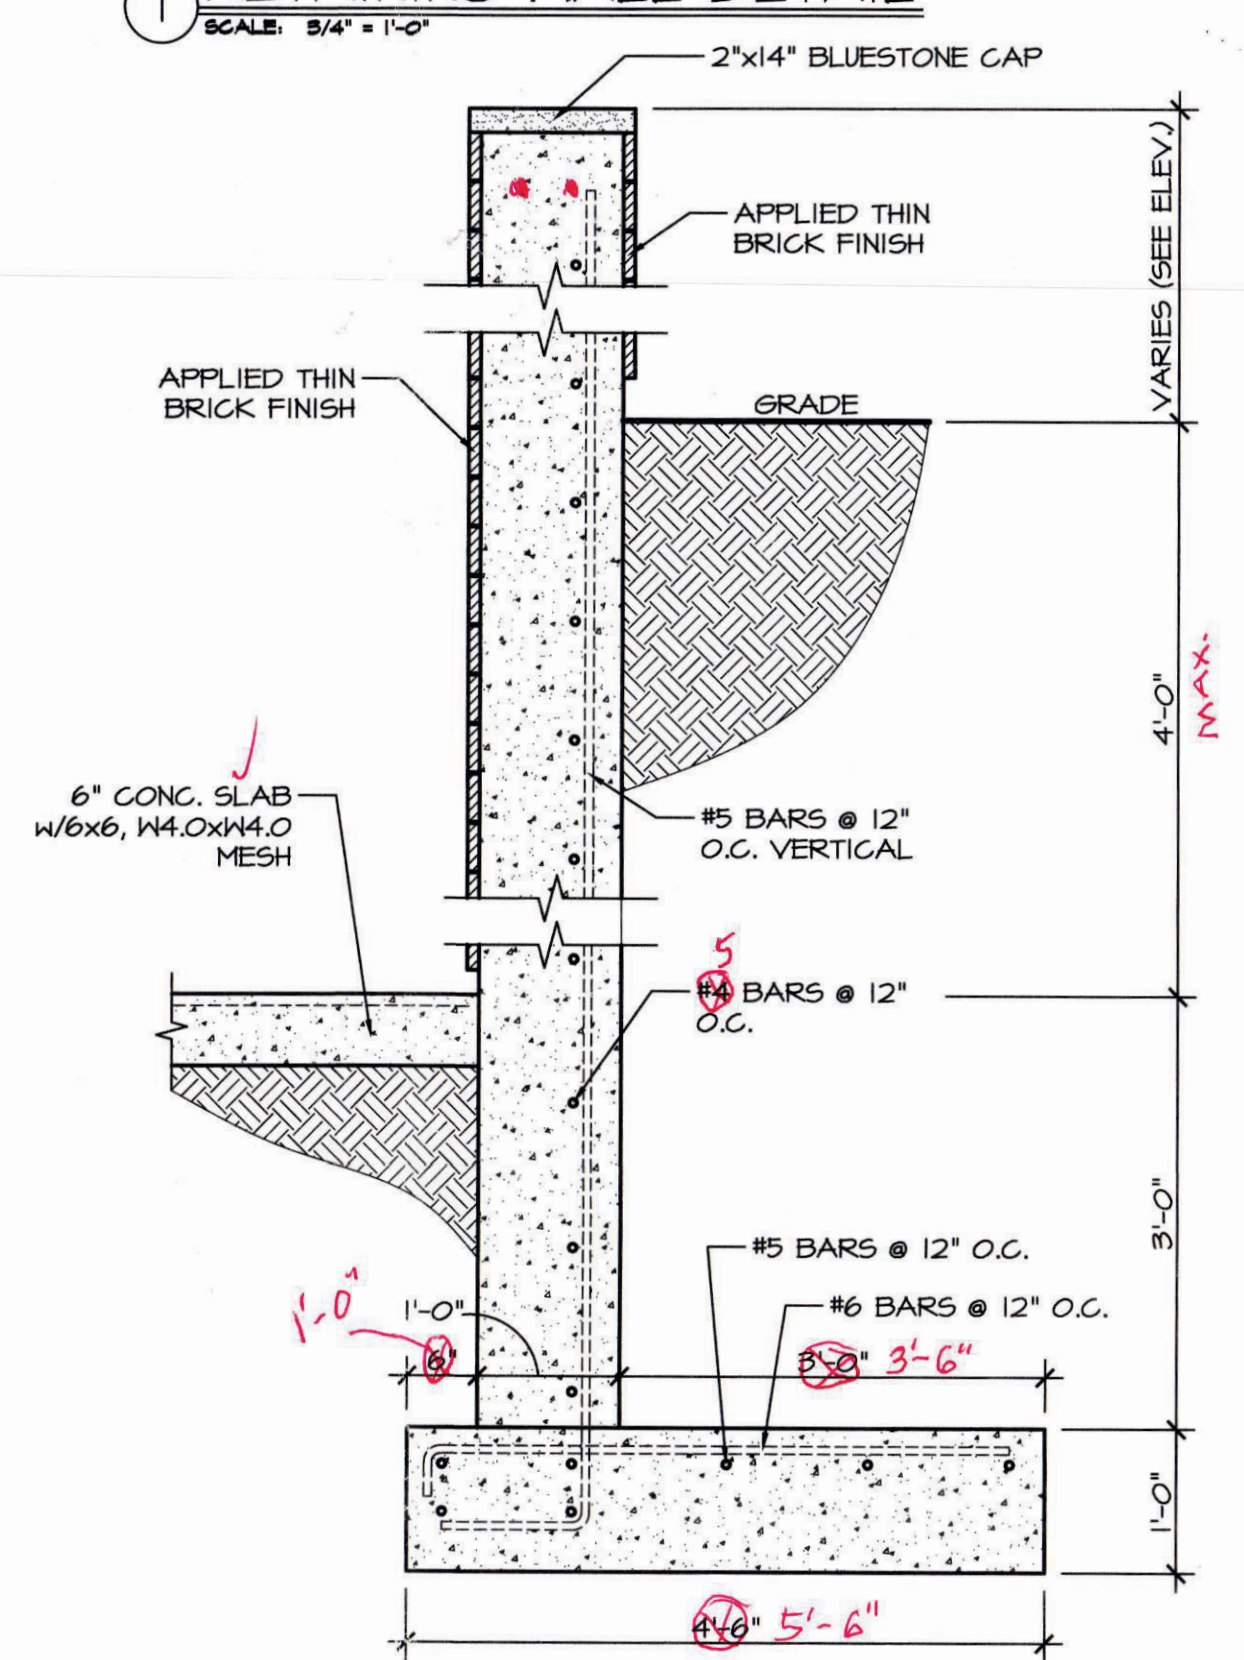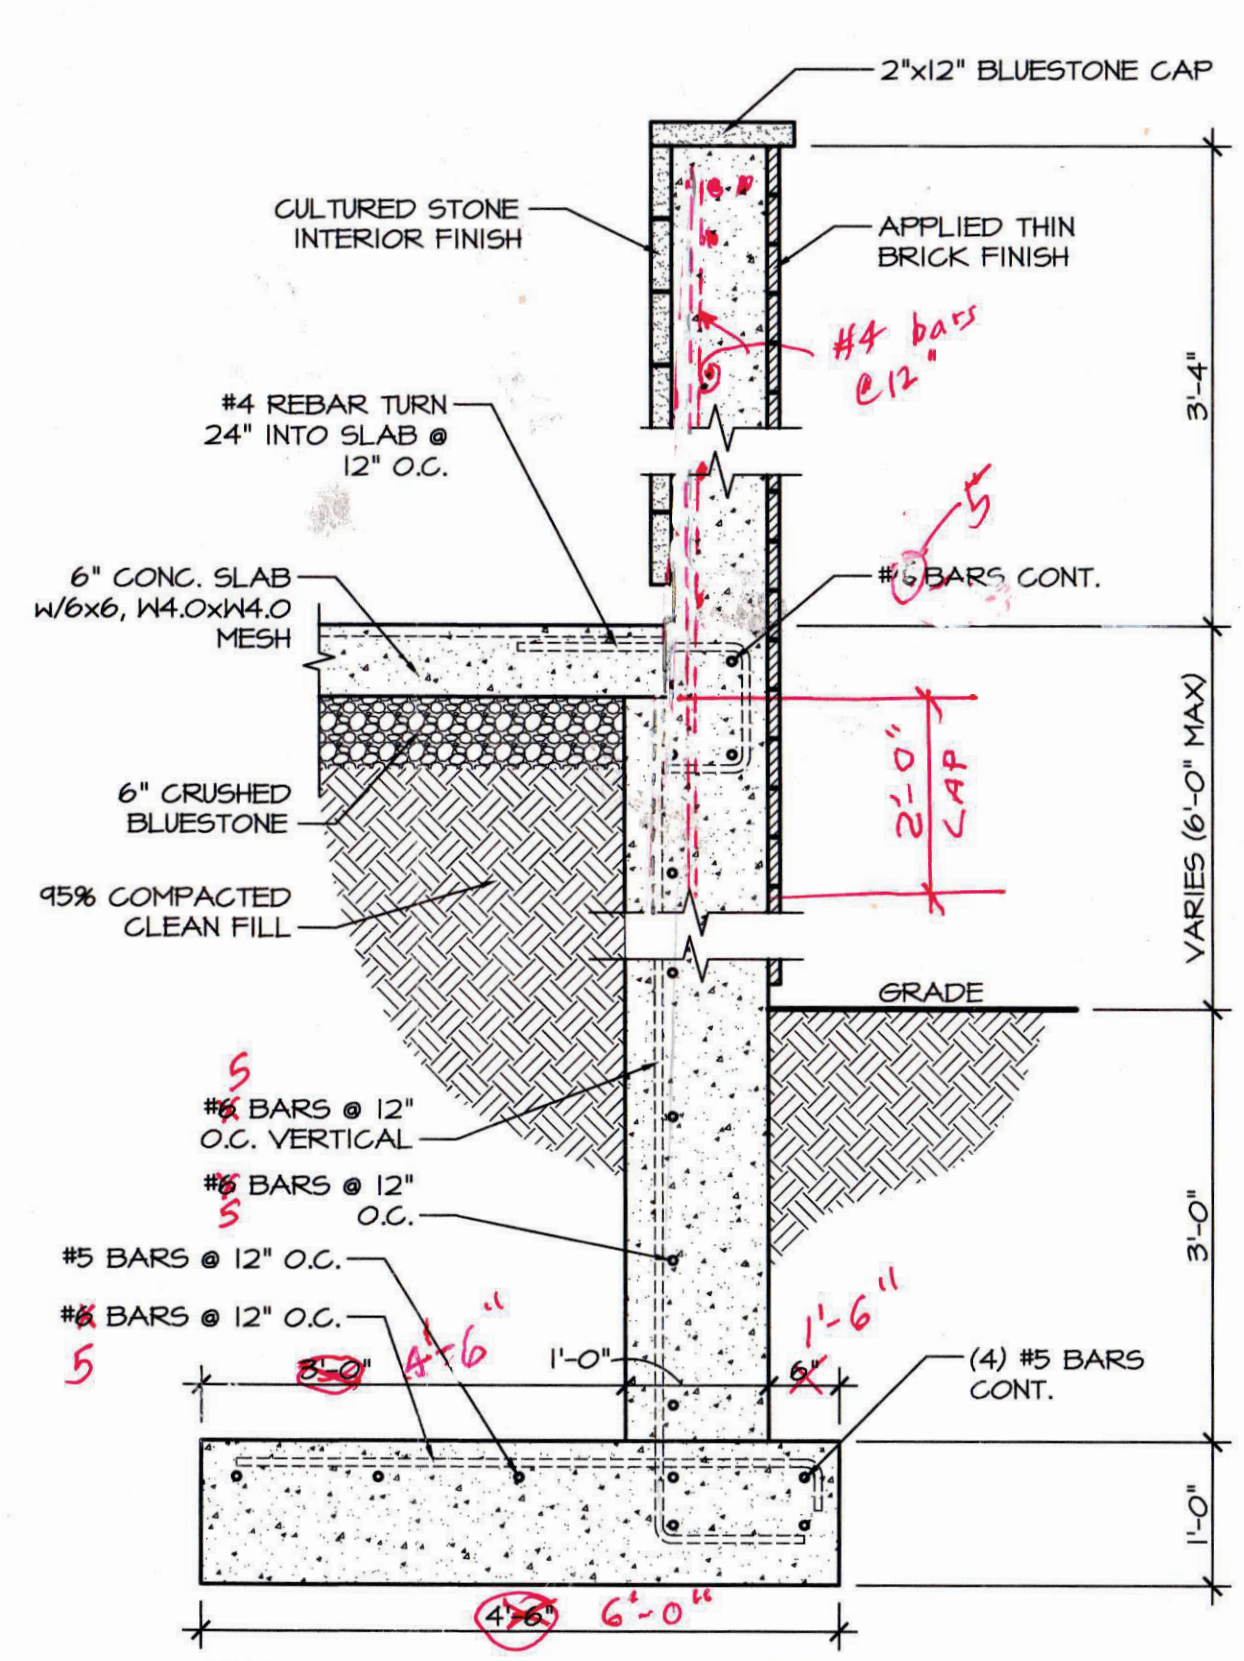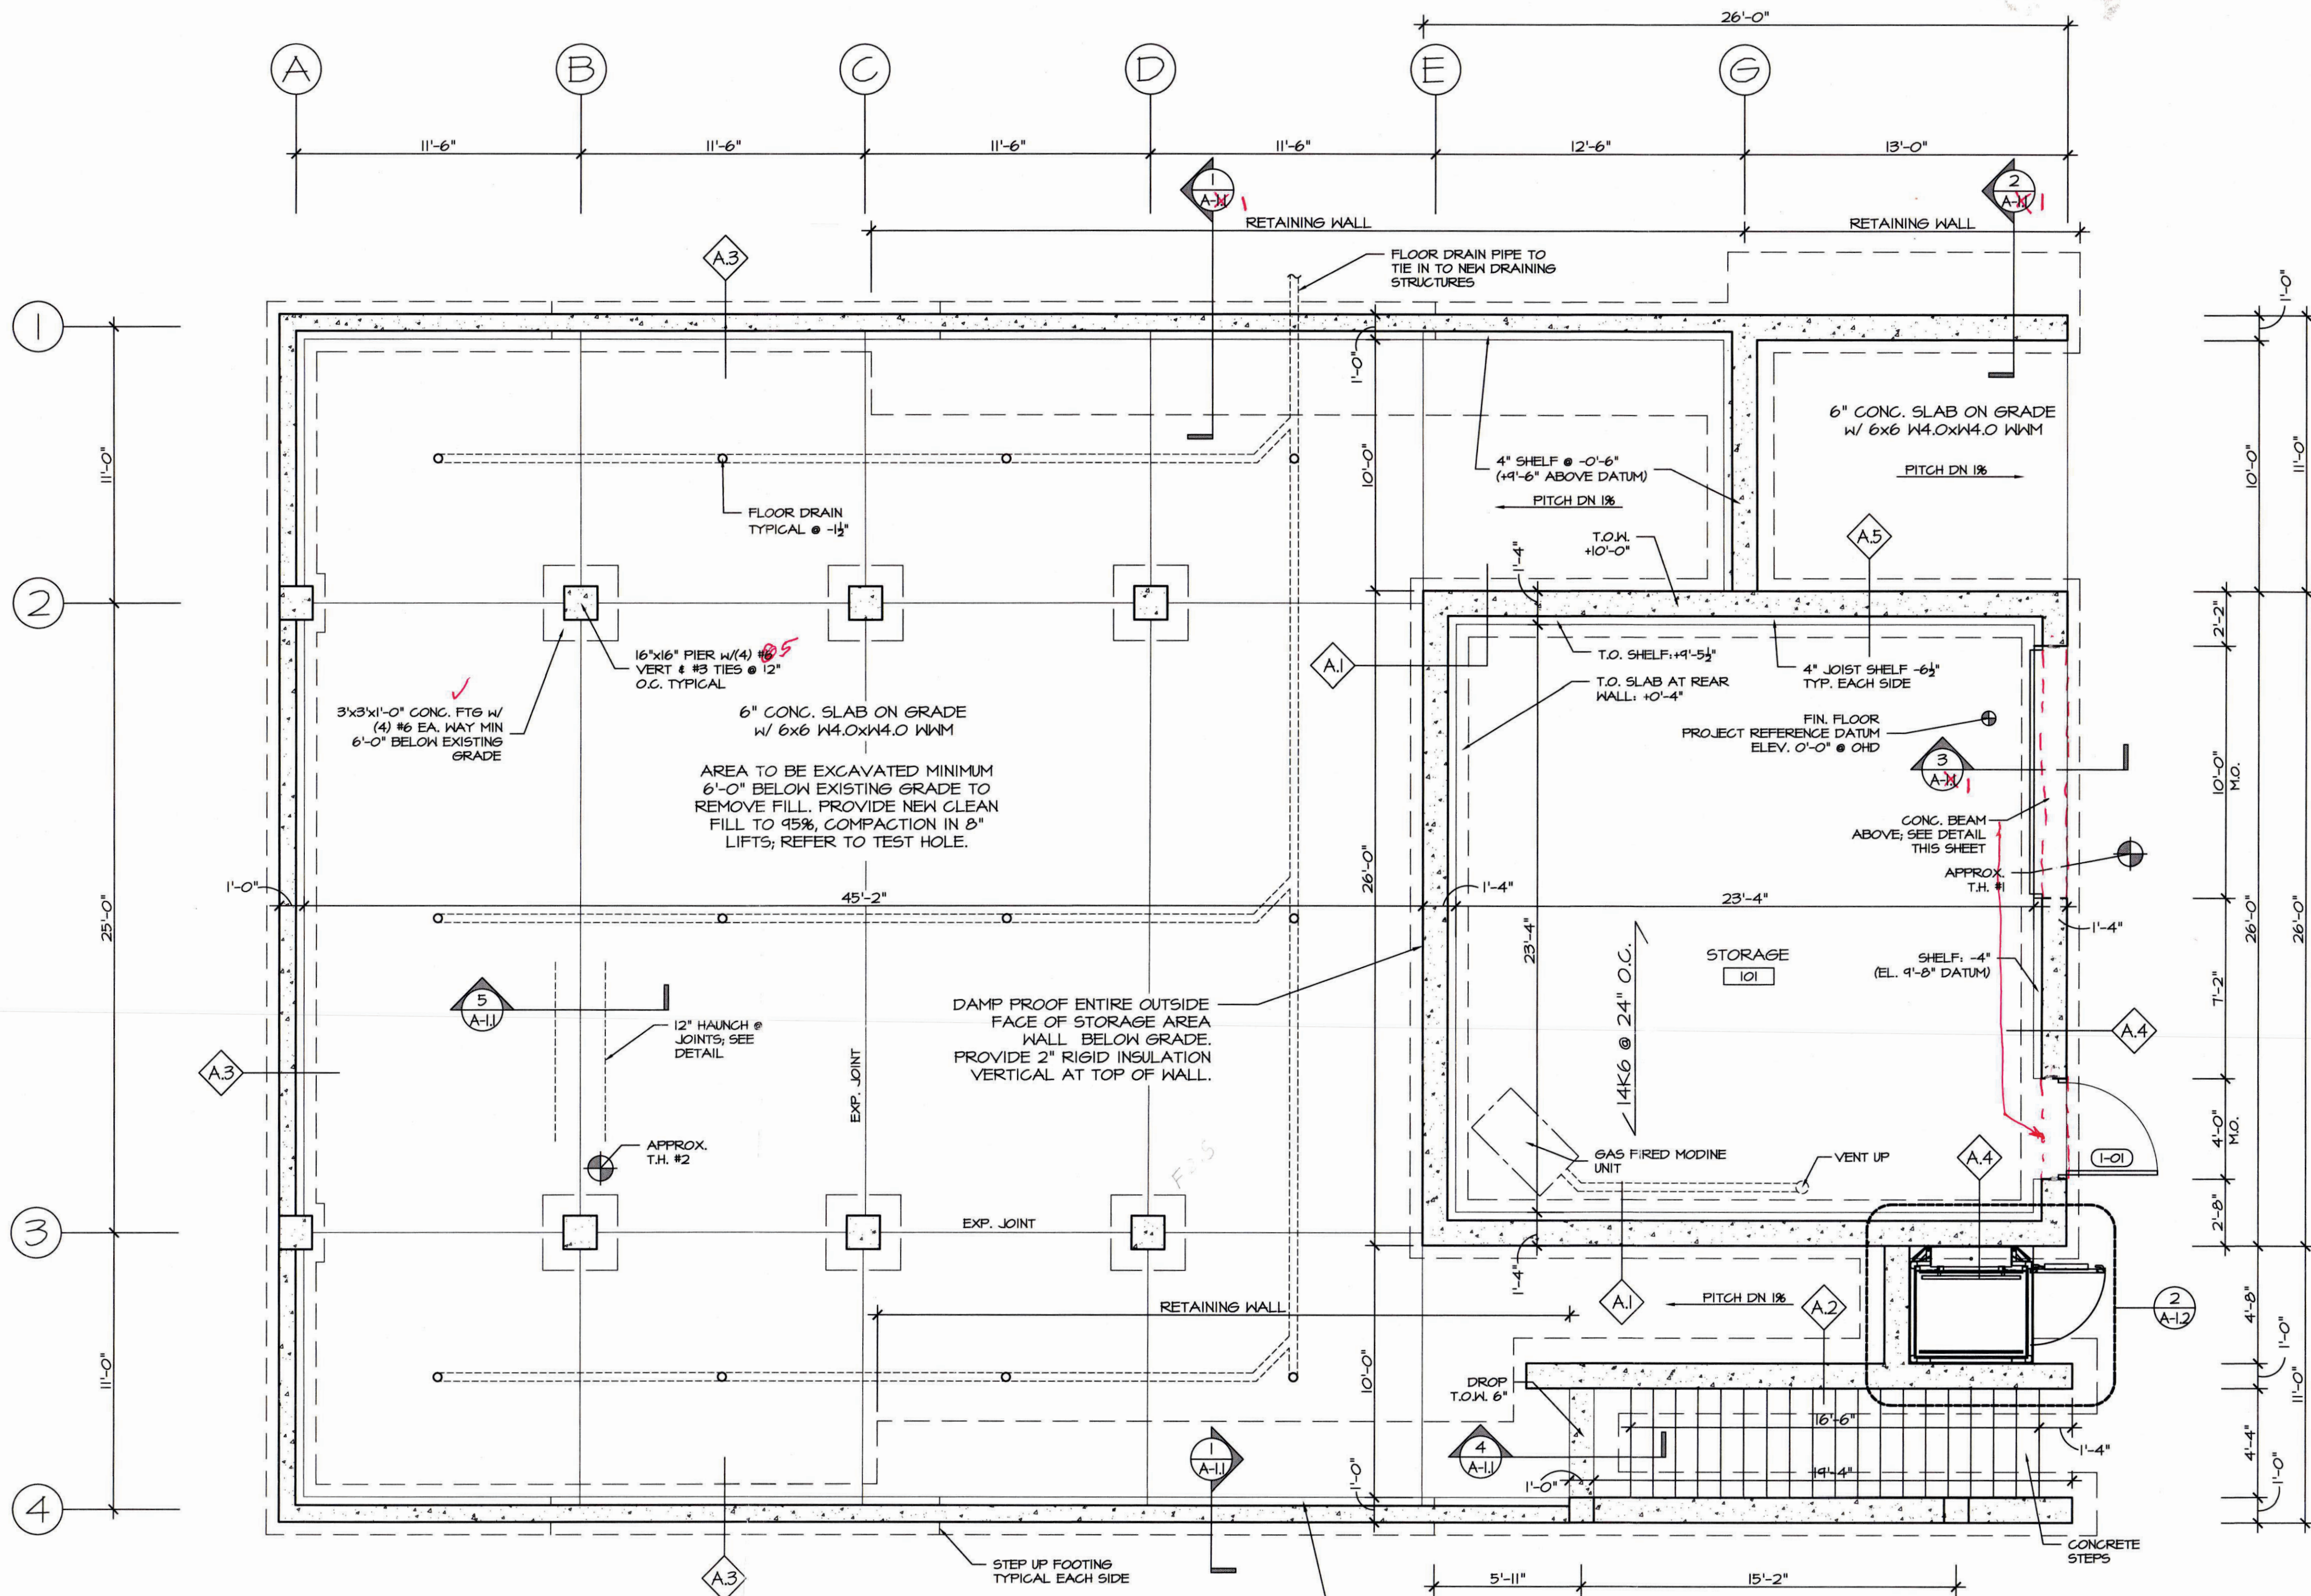

DATE: ISSUE

ISSUED FOR BIDDING & PERMIT

SEAL:

SENDEWSKI ARCHITECTS PC
ARCHITECTS - PLANNERS
215 ROANOKE AVENUE
RIVERHEAD, NY 11901
(631) 727-5352

9 SELINA COURT
WALDEN, NY 12586
(845) 275-8859

PROPOSED PAVILION
TAPPAN FIRE DISTRICT
300 WESTERN HIGHWAY SOUTH
TAPPAN, NY 10983

LOWER LEVEL/FOUNDATION PLAN

PROJECT #: 2108.02

DRAWN BY: AR/JC

CAD FILE: 2108.02/F./BID

DRAWING#:

A=1

PAVILLION

07-12-22 UPDATE

MAIN LEVEL PLAN


SCALE: 1/4" = 1'-0"

OCCUPANCY

KITCHEN: 800 sf / 200 = 4.1


ASSEMBLY AREAS: 2,162 sf / 15 = 144.13

TOTAL OCCUPANT LOAD: = 148.23

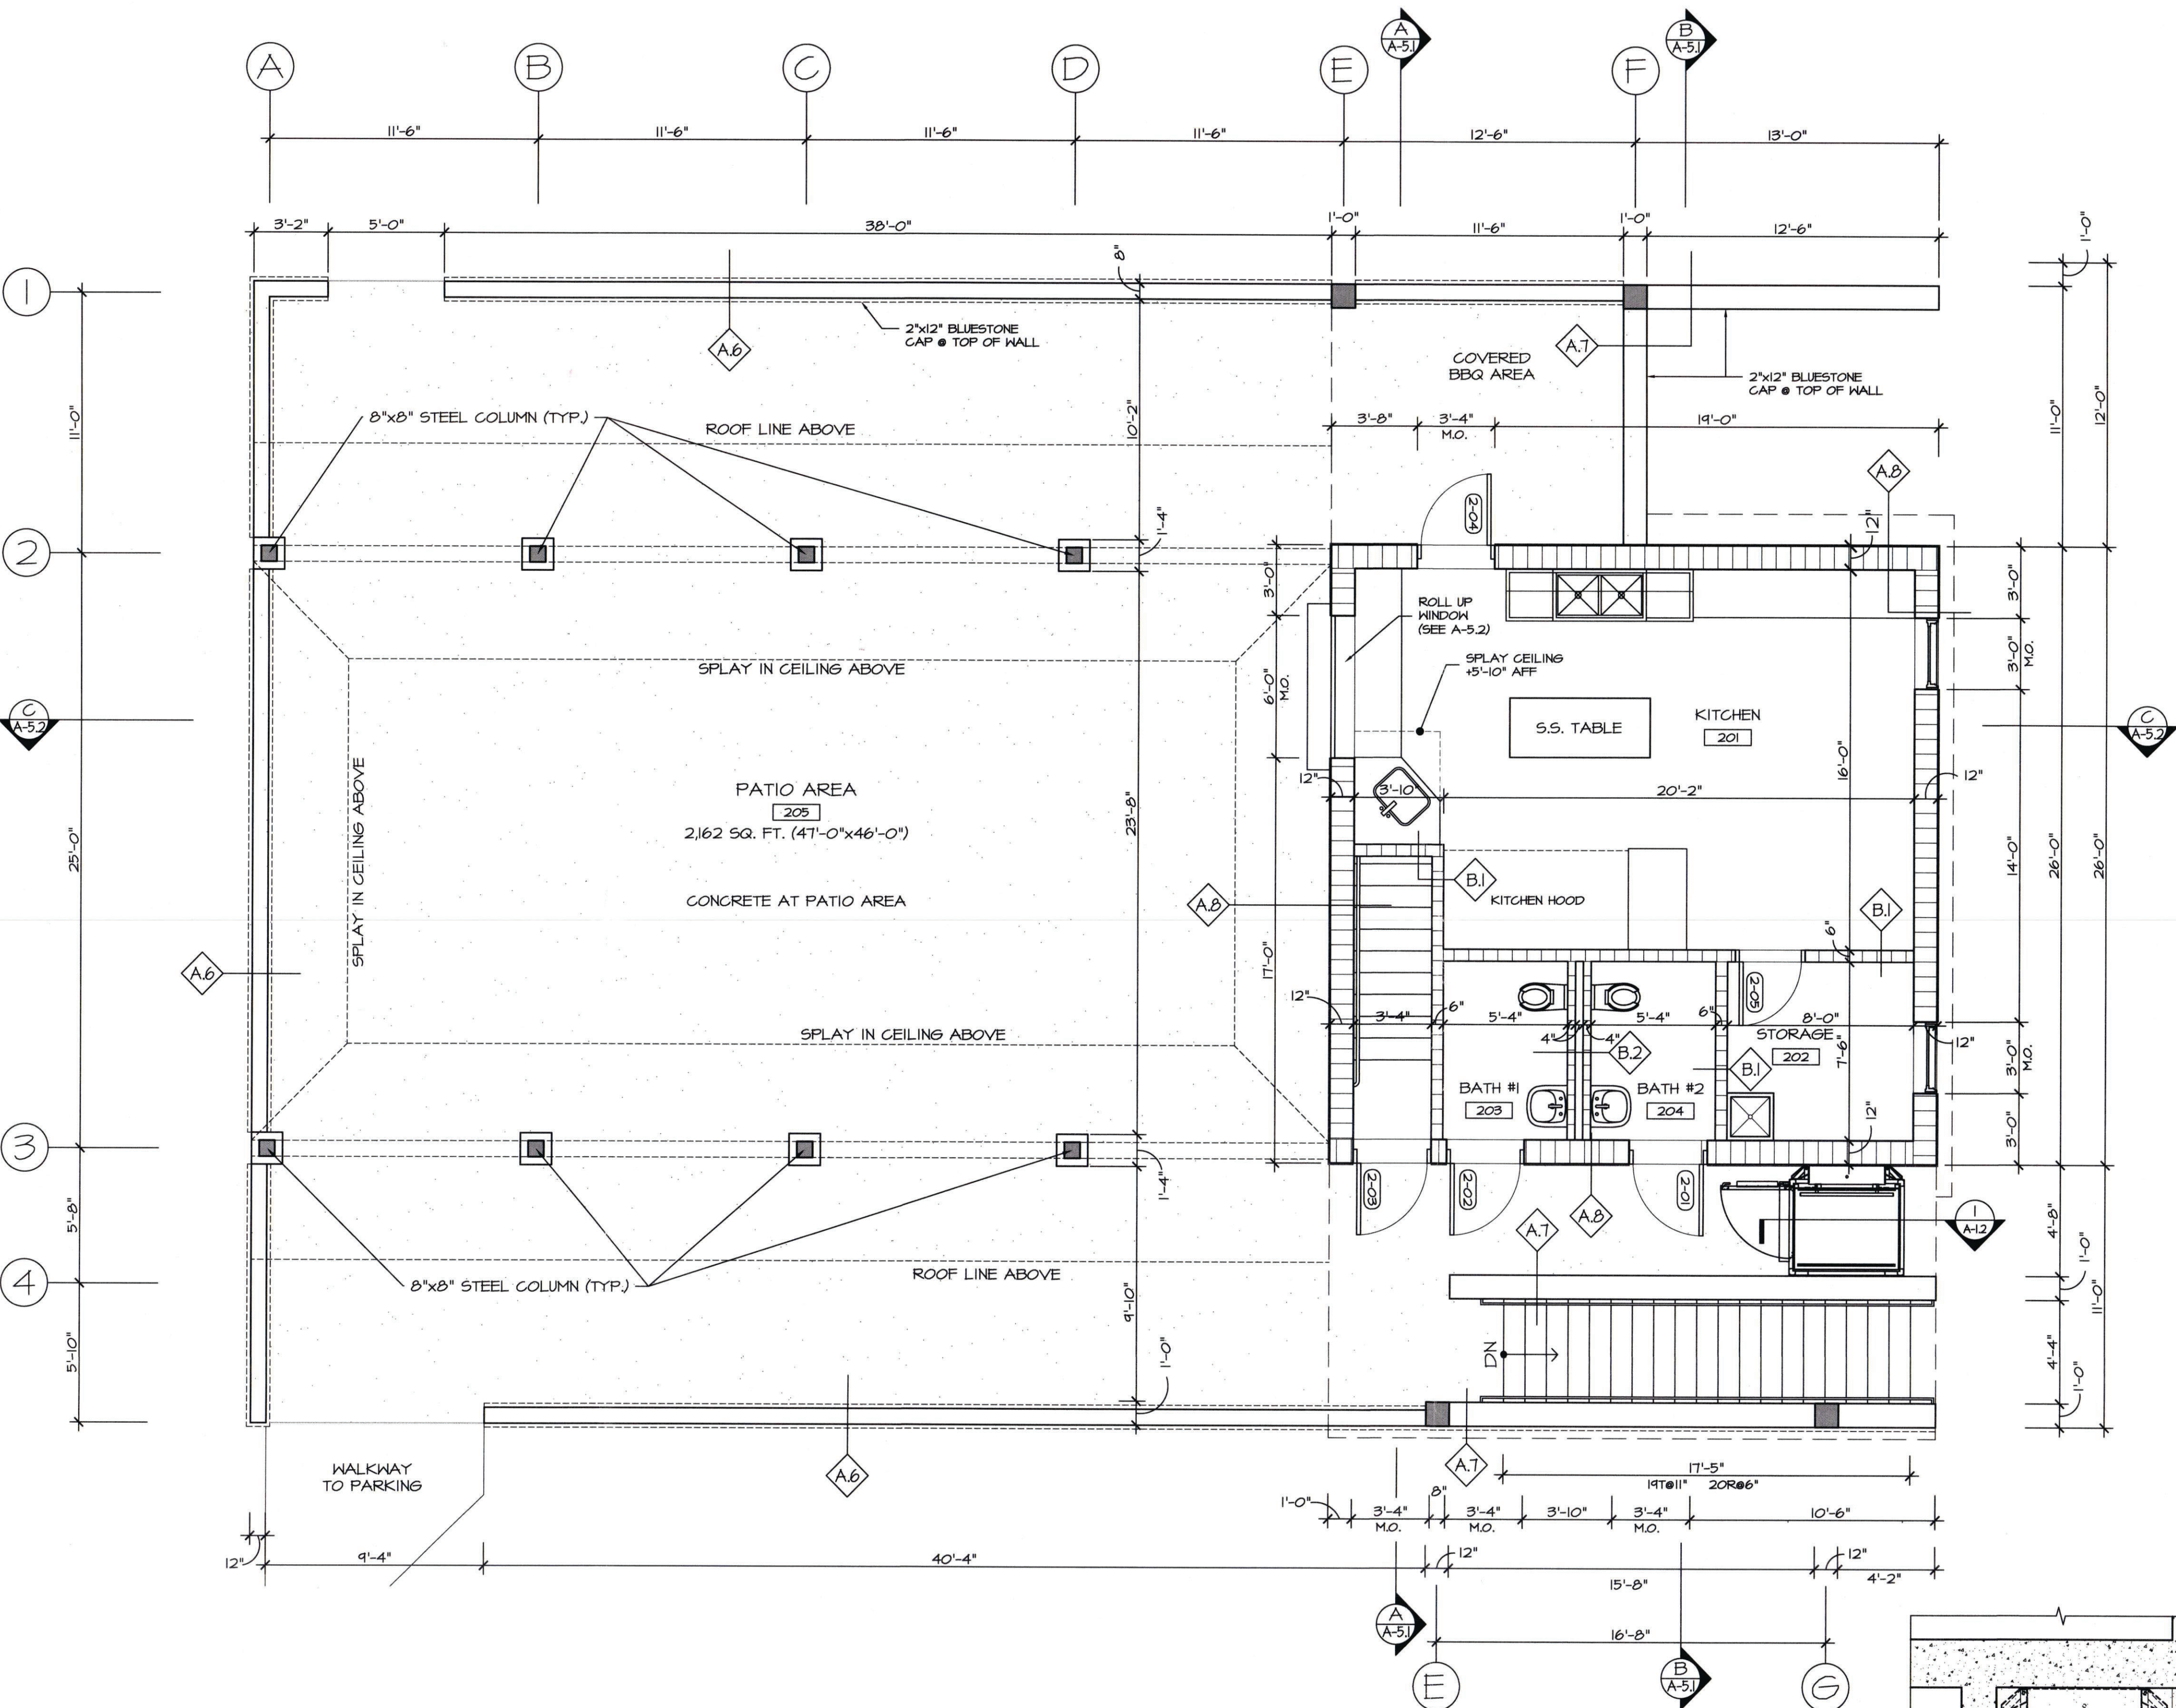

WALL TYPES LEGEND

A.1	EXTERIOR WALL	16" 4000 PSI CONC. WALL
A.2	EXTERIOR WALL	12" 4000 PSI CONC. WALL
A.3	EXTERIOR WALL	12" 4000 PSI CONC. WALL W/ EXTERIOR APPLIED THIN BRICK FINISH BOTH SIDES
A.4	EXTERIOR WALL	16" CONC. WALL W/ 36" HIGH CULTURED STONE WATER TABLE AND APPLIED THIN BRICK FINISH ABOVE
A.5	EXTERIOR WALL	16" CONC. WALL W/ APPLIED THIN BRICK FINISH ABOVE
A.6	EXTERIOR WALL	8" CONC. WALL W/ CULTURED STONE INTERIOR FINISH, APPLIED THIN BRICK EXTERIOR FINISH 2'X12" BLUESTONE CAP @ TOP OF WALL
A.7	EXTERIOR WALL	12" CONC. WALL W/ APPLIED THIN BRICK FINISH BOTH SIDE 2'X12" BLUESTONE CAP @ TOP OF WALL
A.8	EXTERIOR WALL	12" CMU BLOCK WALL W/ FULLY INSULATED CAVITY, 36" HIGH THIN BRICK @ BASE AND HARDIE PLANK LAP SIDING ABOVE
A.9	EXTERIOR WALL	12" CMU BLOCK WALL TO 20" SILL HEIGHT, CONTINUE WITH 8" BLOCK TO UNDERSIDE OF ROOF W/ FULLY INSULATED CAVITY, HARDIE PLANK LAP SIDING
A.10	EXTERIOR WALL	8" CMU BLOCK WALL W/ FULLY INSULATED CAVITY AND HARDIE PLANK LAP SIDING
B.1	INTERIOR WALL	6" CMU BLOCK WALL W/ FULLY INSULATED CAVITY
B.2	INTERIOR MET WALL	(3) 4" CMU BLOCK WALLS WITH 4" AIR GAPS IN-BETWEEN FOR PLUMBING
B.3	INTERIOR WALL	4" 18GA. MTL STUDS @ 24" O.C. FULL HEIGHT TO DECK, 5/8" GYP. BOARD EA. SIDE, TAPE SPACKLE AND PAINT

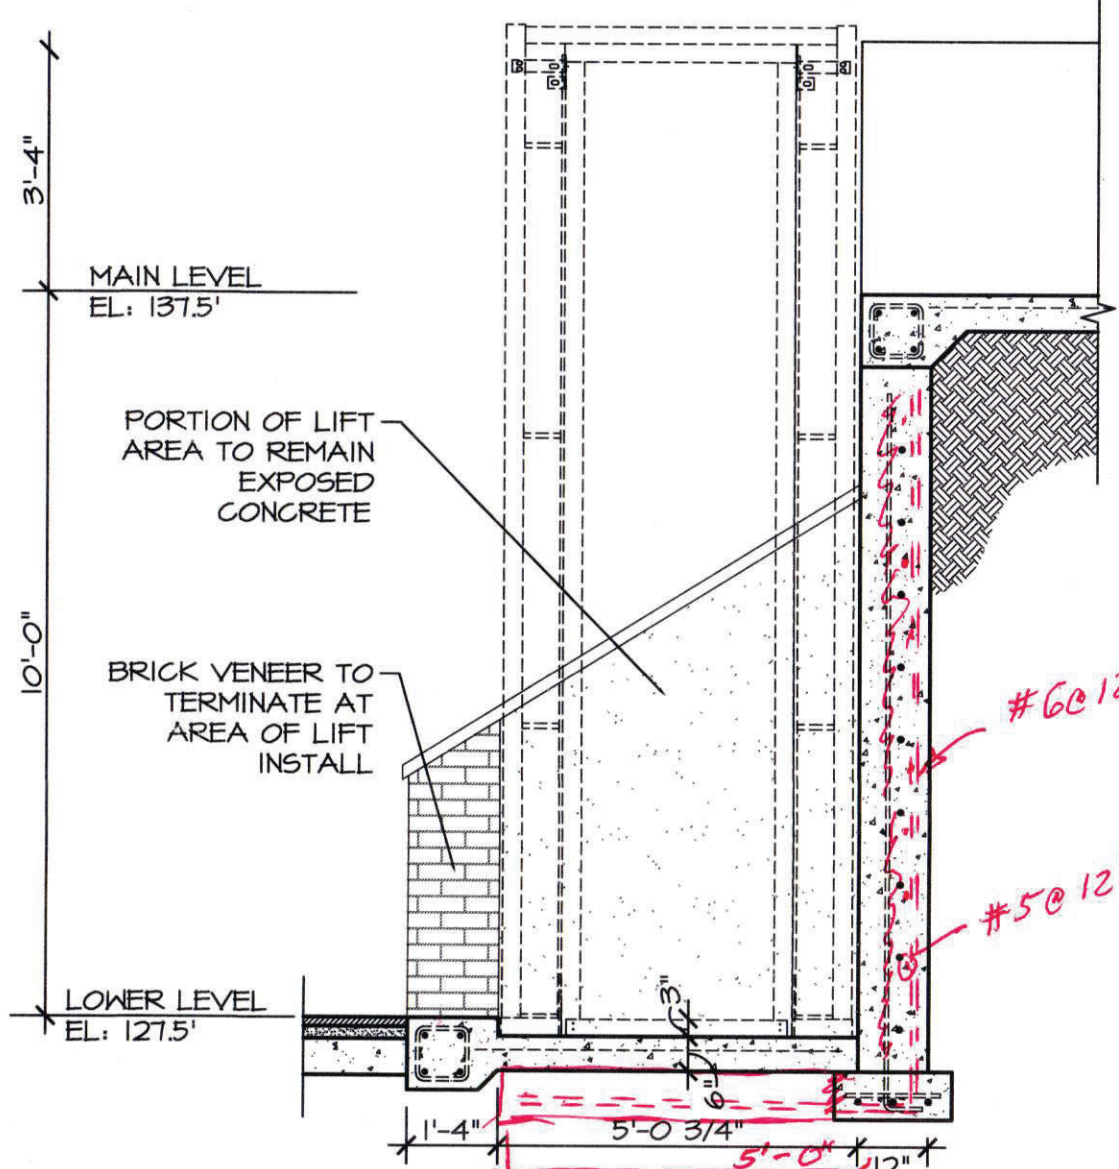

1 LIFT PIT SECTION

GENERAL:	ASME A18.1 SAFETY STANDARD FOR PLATFORM LIFTS AND STAIRWAY CHAIRLIFTS
DRIVE HOIST:	MODEL: 2VL-BH-444 CAN INTEGRAL DRIVE SYSTEM CAN CONTINUOUS HAND POWER WITH AUXILIARY BATTERY POWER SYSTEM SYSTEM PLATFORM EMERGENCY LOWERING (SHIPPED LOCKED) SHOWN PIN 4 PRESSURE GAUGE MOTOR: 3.3 HP (300 W) 24 VDC TRAVEL SPEED: 20.0 LB # 17 FT/MIN. POWER SUPPLY: 120 VAC, SINGLE PHASE, 60 HZ, ON A DEDICATED 15 AMP CIRCUIT. EQUIPPED WITH ELECTRICAL DISCONNECT (SHIPPED LOCKED) (4) OIL RECOVERY SYSTEM (SHIPPED KIT)
CONTROLS:	PLATFORM CONTROLS: PUSH-BUTTON (TACTILE) TYPE CAN ILLUMINATED DIRECTIONAL, BUTTONS, COURTESY LIGHTING, ILLUMINATED ROUND PUSHBUTTON EMERGENCY STOP SWITCH & AUDIBLE ALARM LOWER LANDING CALL STATION PUSH BUTTON (TACTILE) WALL MOUNT UPPER LANDING CALL STATION PUSH BUTTON (TACTILE) WALL MOUNT EQUIPPED WITH THE DELAY DOOR LOCK
PLATFORM:	SIZE: STANDARD CAN GRAB RAIL, ANTI-SKID DECK AND 45 1/4" HIGH COMPARTMENT STRUTTING THROUGH (SHIPPED) BUTTERFLY CAPACITY: MAXIMUM 750 LB OPERATING LOAD EQUIPPED WITH AUTO-DIALER PHONE
DOORWAYS:	LOWER: 36" WIDE 1/4" LAMINATED GLASS DOOR CAN POWERLOCK 2000 INTERLOCK & CHAMA DOOR STOP & ANAVENTA POWER DOOR UPPER: 36" WIDE 1/4" LAMINATED GLASS GATE CAN POWERLOCK 2000 INTERLOCK & CHAMA DOOR STOP & ANAVENTA POWER DOOR OPERATOR
ENCLOSURE:	PANELS: 1/2" TOTAL NET HEIGHT: APPROXIMATELY 105 LB LIFTING HT. (N/A) 120" LOWER TO UPPER FLOOR PLUS 3" DEEP PIT

2 LIFT PLAN

SCALE: 5/8" = 1'-0"

DATE: ISSUE

ISSUED FOR BIDDING & PERMIT

SEAL:

SENDEWSKI ARCHITECTS PC
ARCHITECTS - PLANNERS

215 ROANOKE AVENUE
RIVERHEAD, NY 11901
(631) 727-5352

9 SELENA COURT
WALDEN, NY 12586
(845) 275-8859

PROPOSED PAVILION
TAPPAN FIRE DISTRICT
300 WESTERN HIGHWAY SOUTH
TAPPAN, NY 10983

MAIN LEVEL PLAN


PROJECT #: 2108.02

DRAWN BY: AR/JC


CAD FILE: 2108.02/P./BID

DRAWING#: A-2




PAVILLION

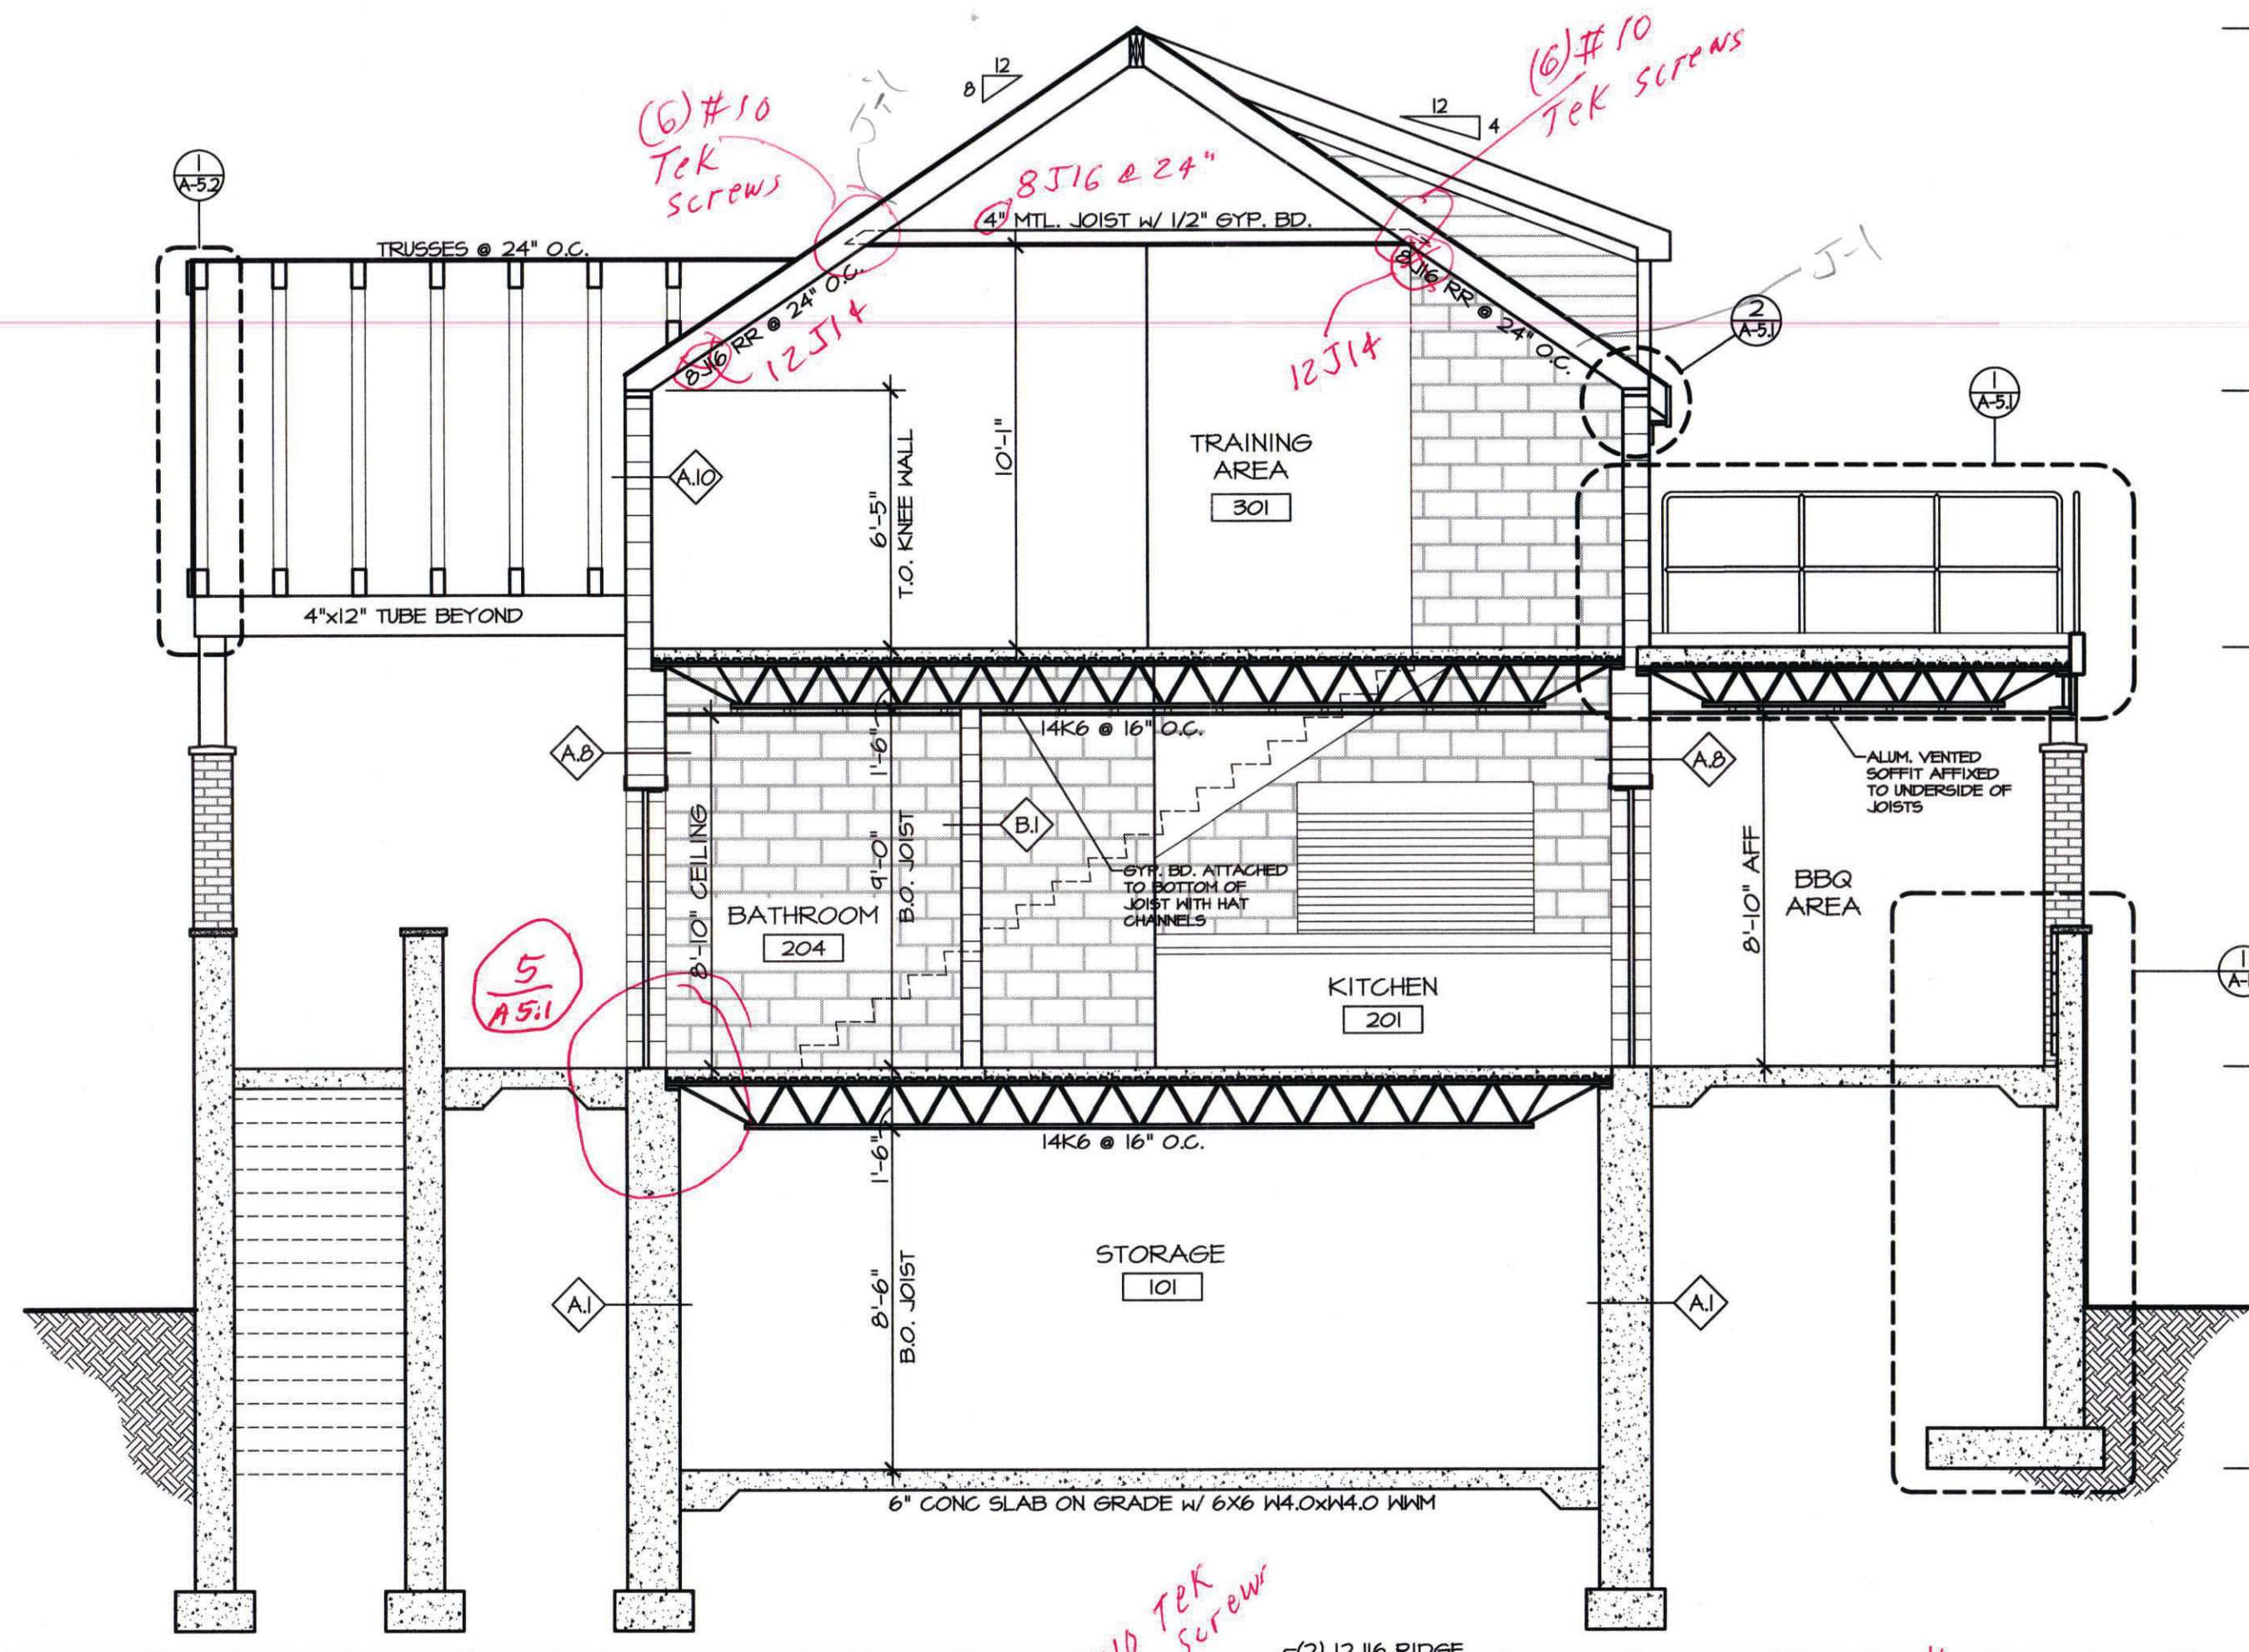


SECTION A-A
SCALE: 1/4" = 1'-0"

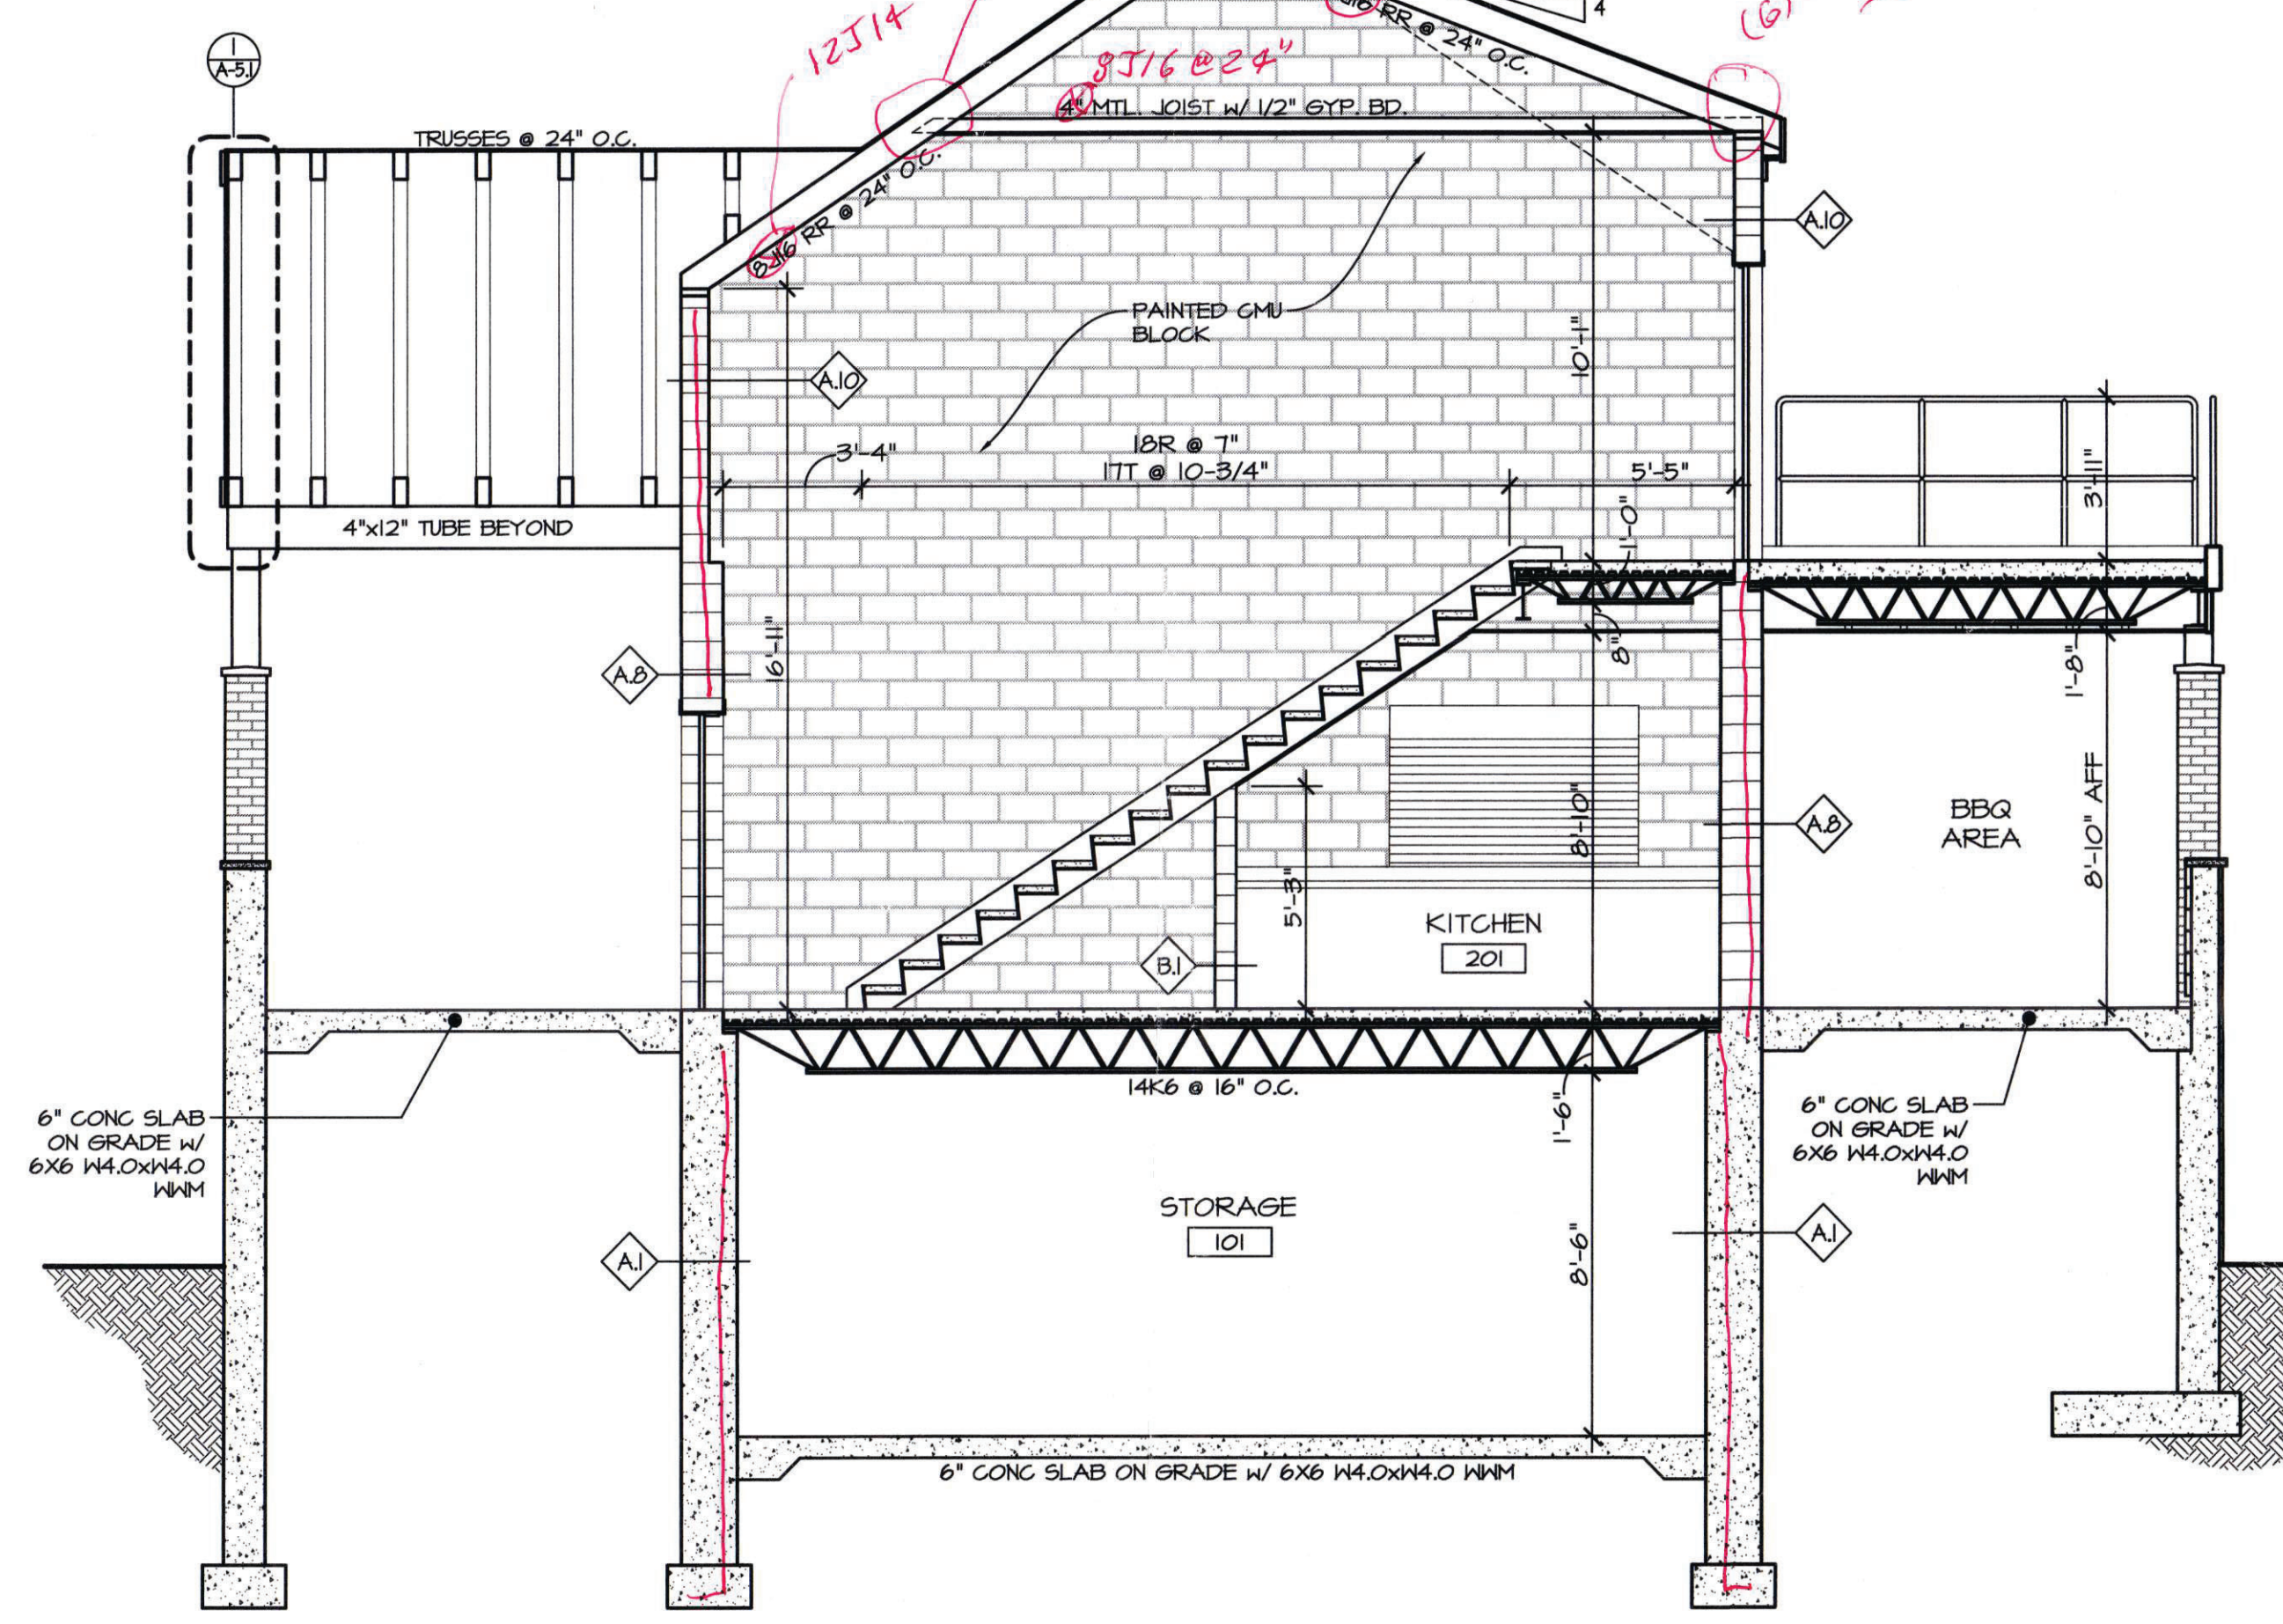


SECTION B-B
SCALE: 1/4" = 1'-0"

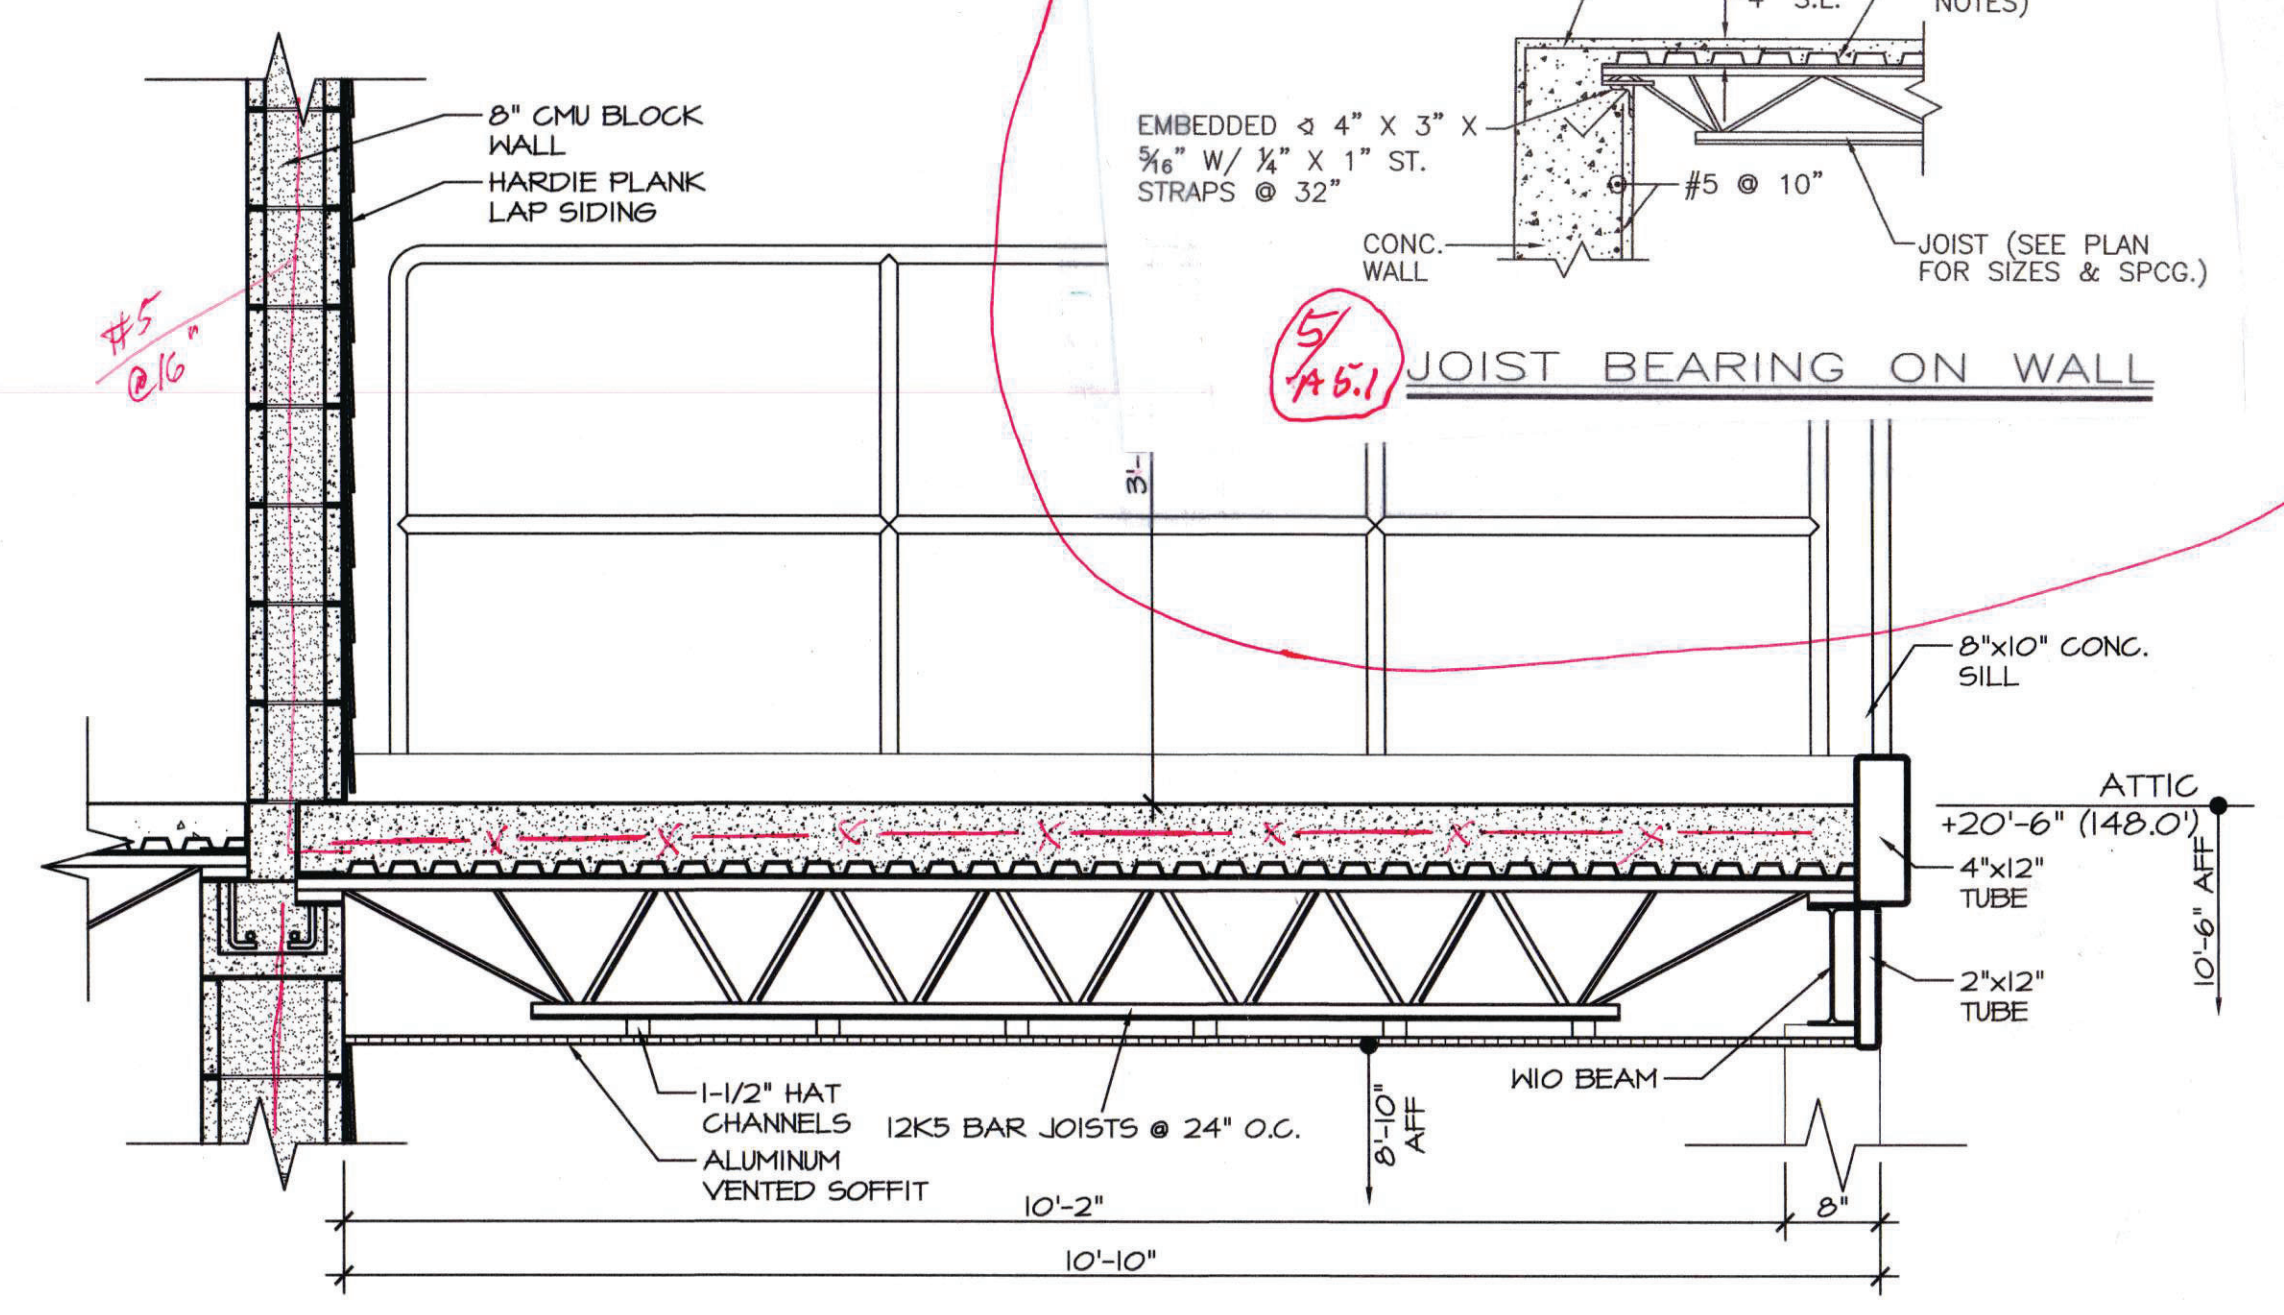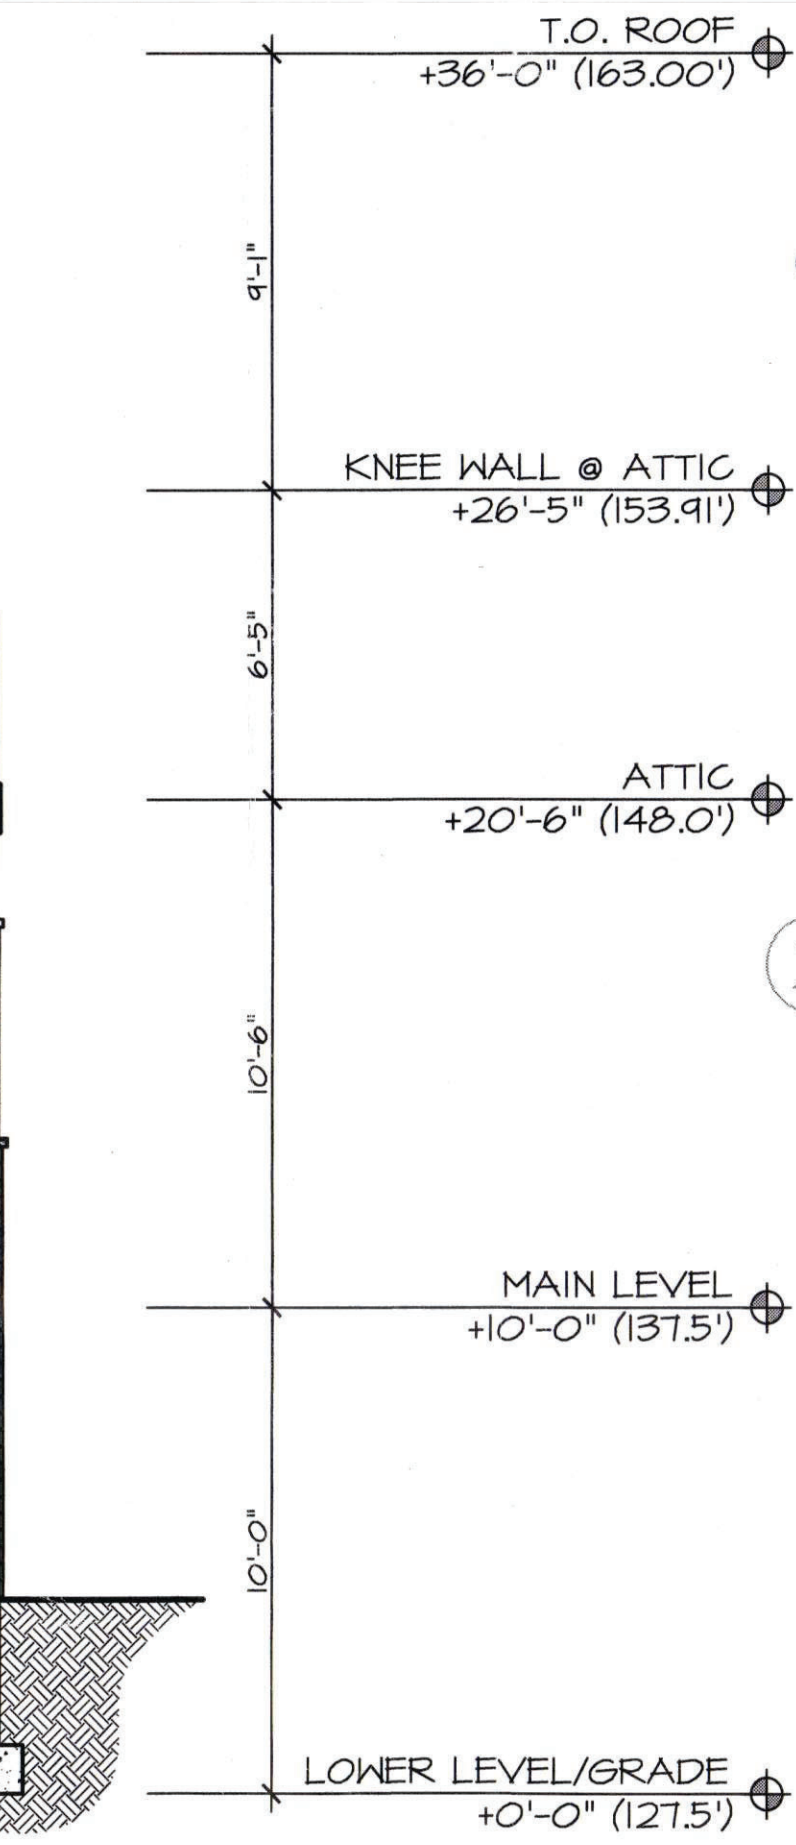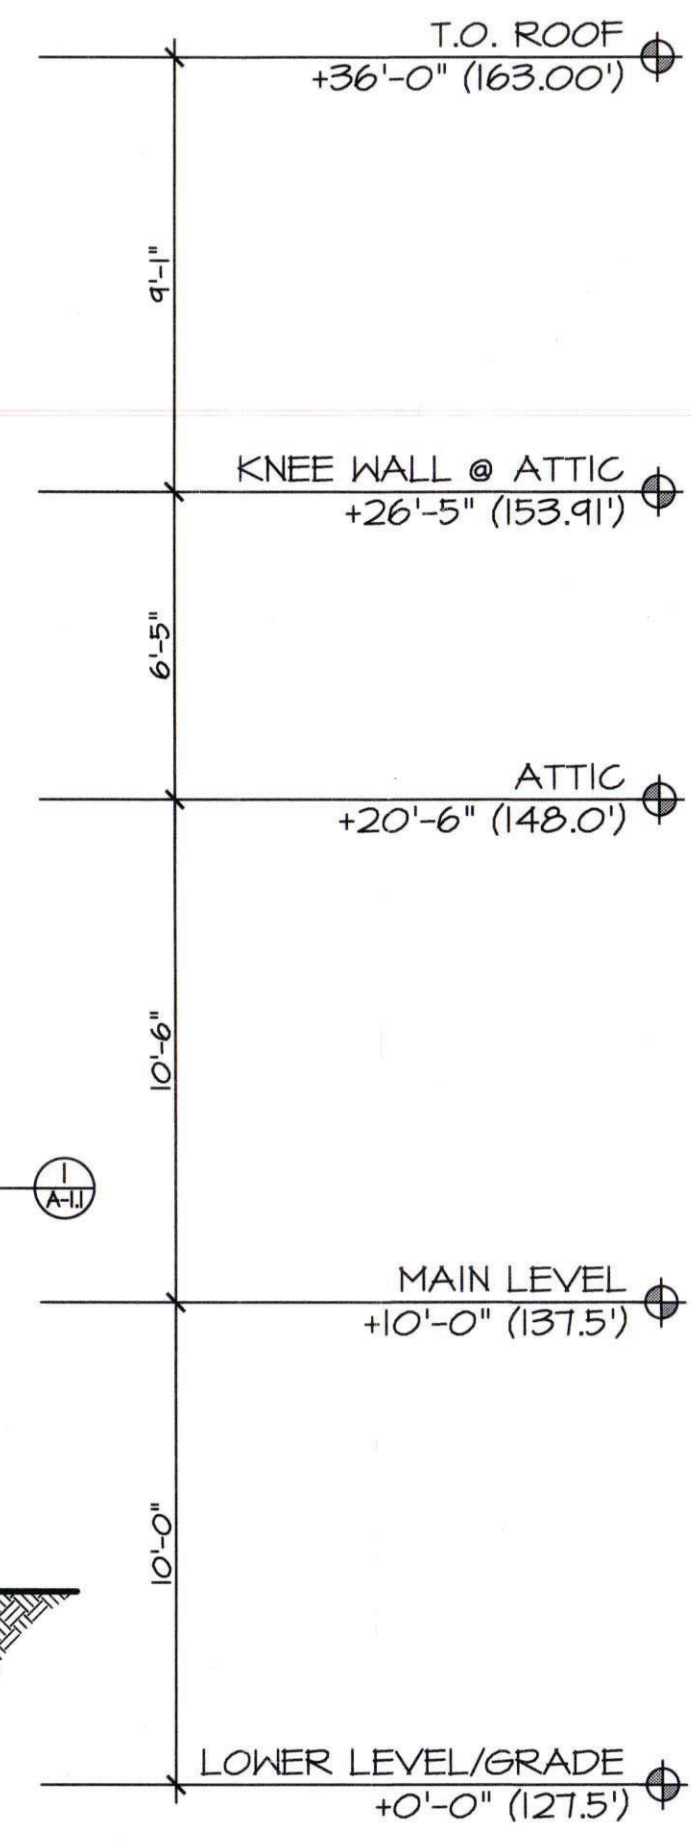


SECTION 1
SCALE: 3/4" = 1'-0"

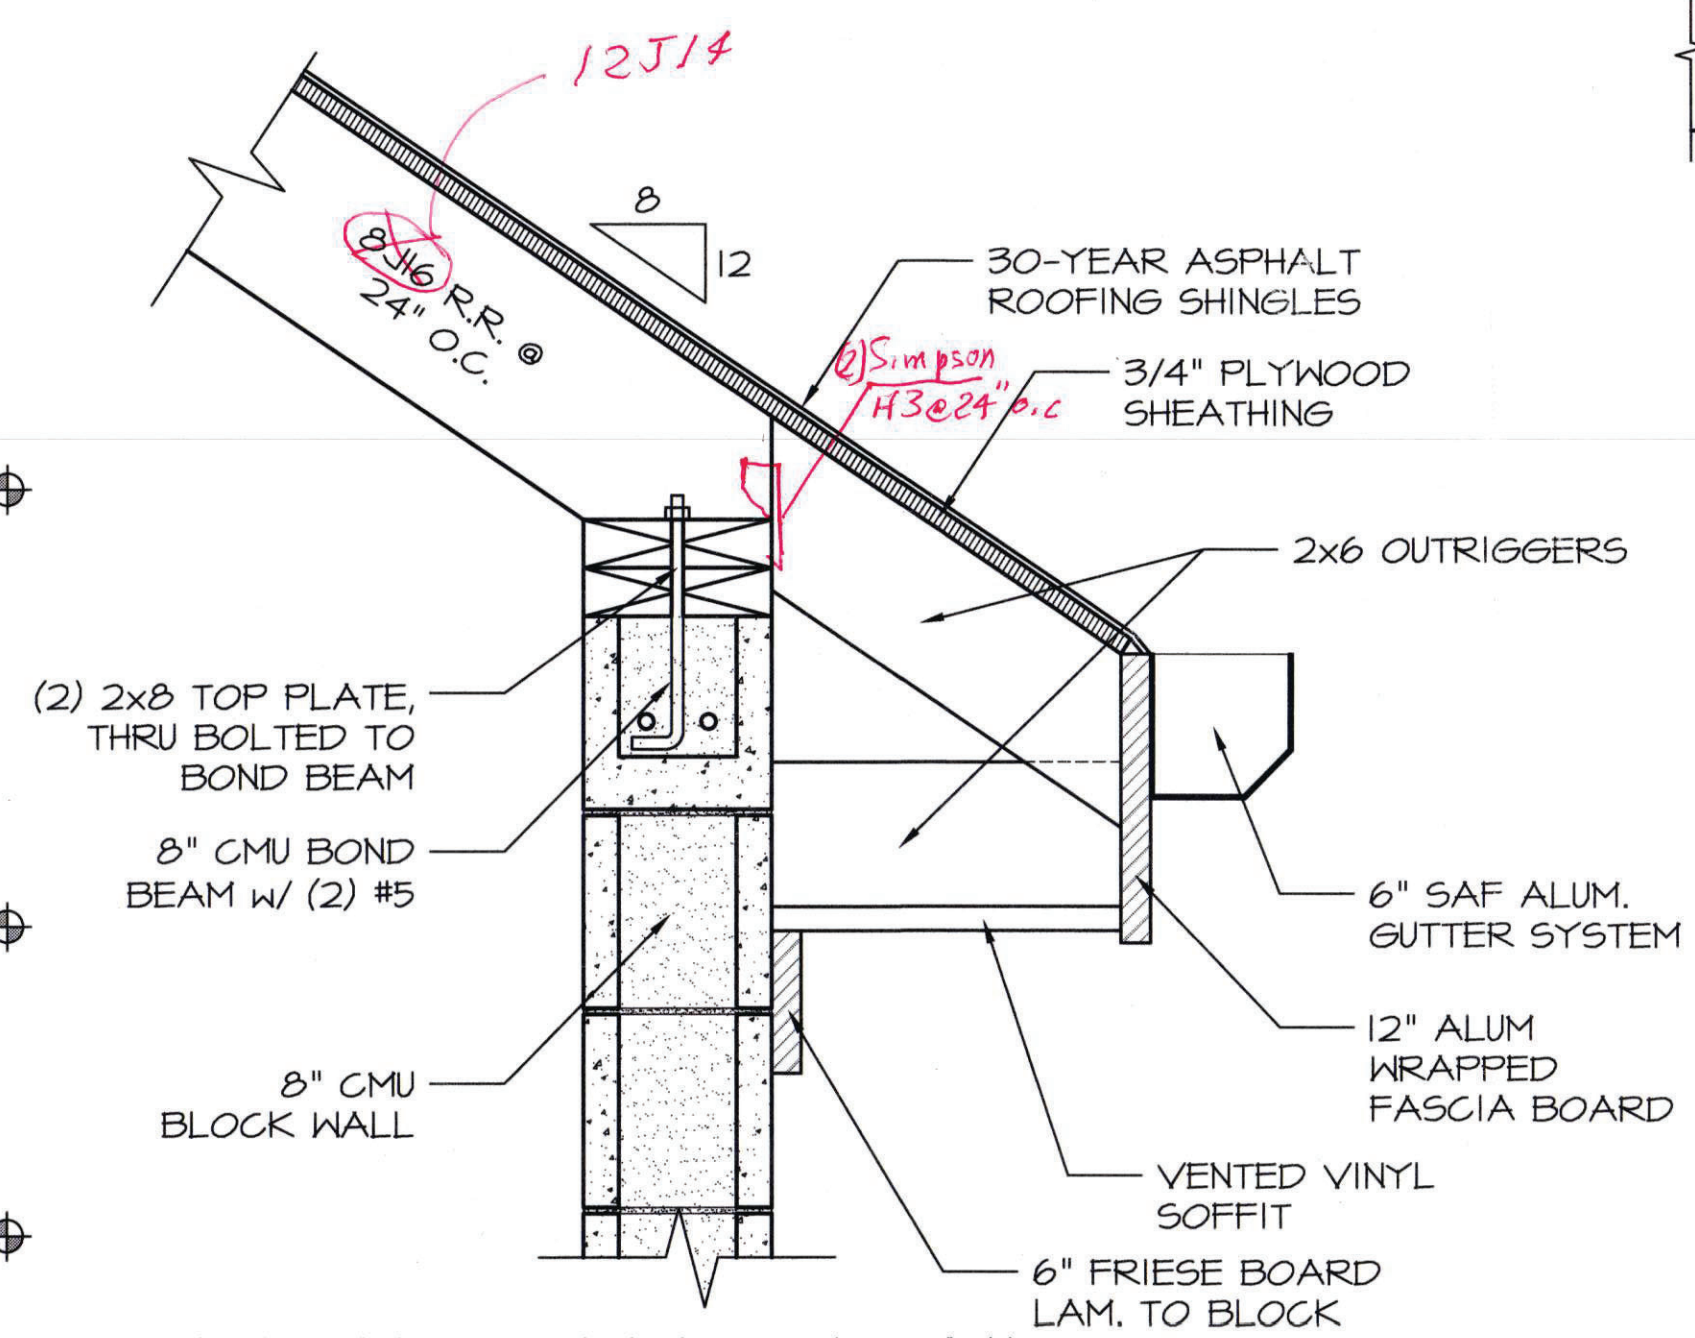


SECTION 2
SCALE: 1-1/2" = 1'-0"

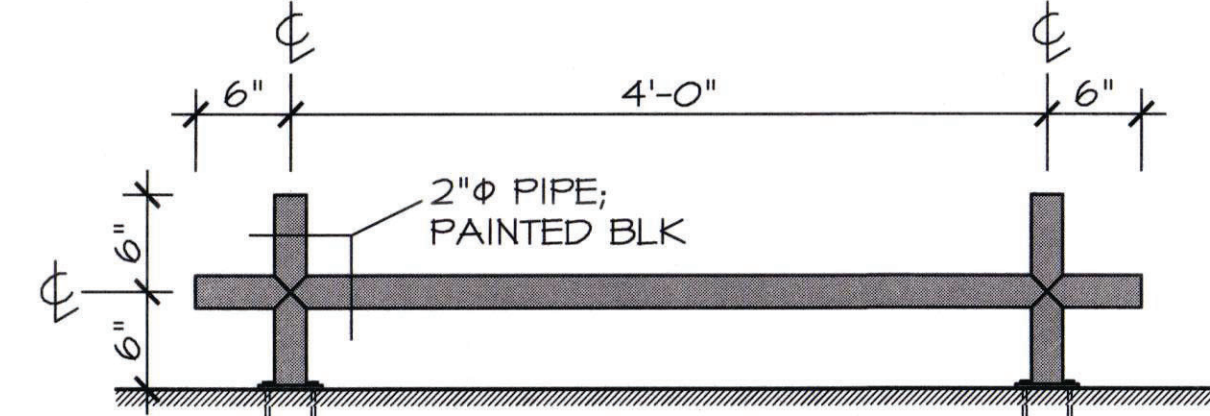

SECTION 3
SCALE: 1-1/2" = 1'-0"

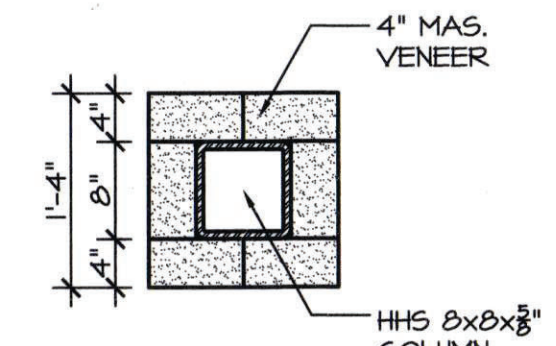

SECTION 4
SCALE: 3/4" = 1'-0"

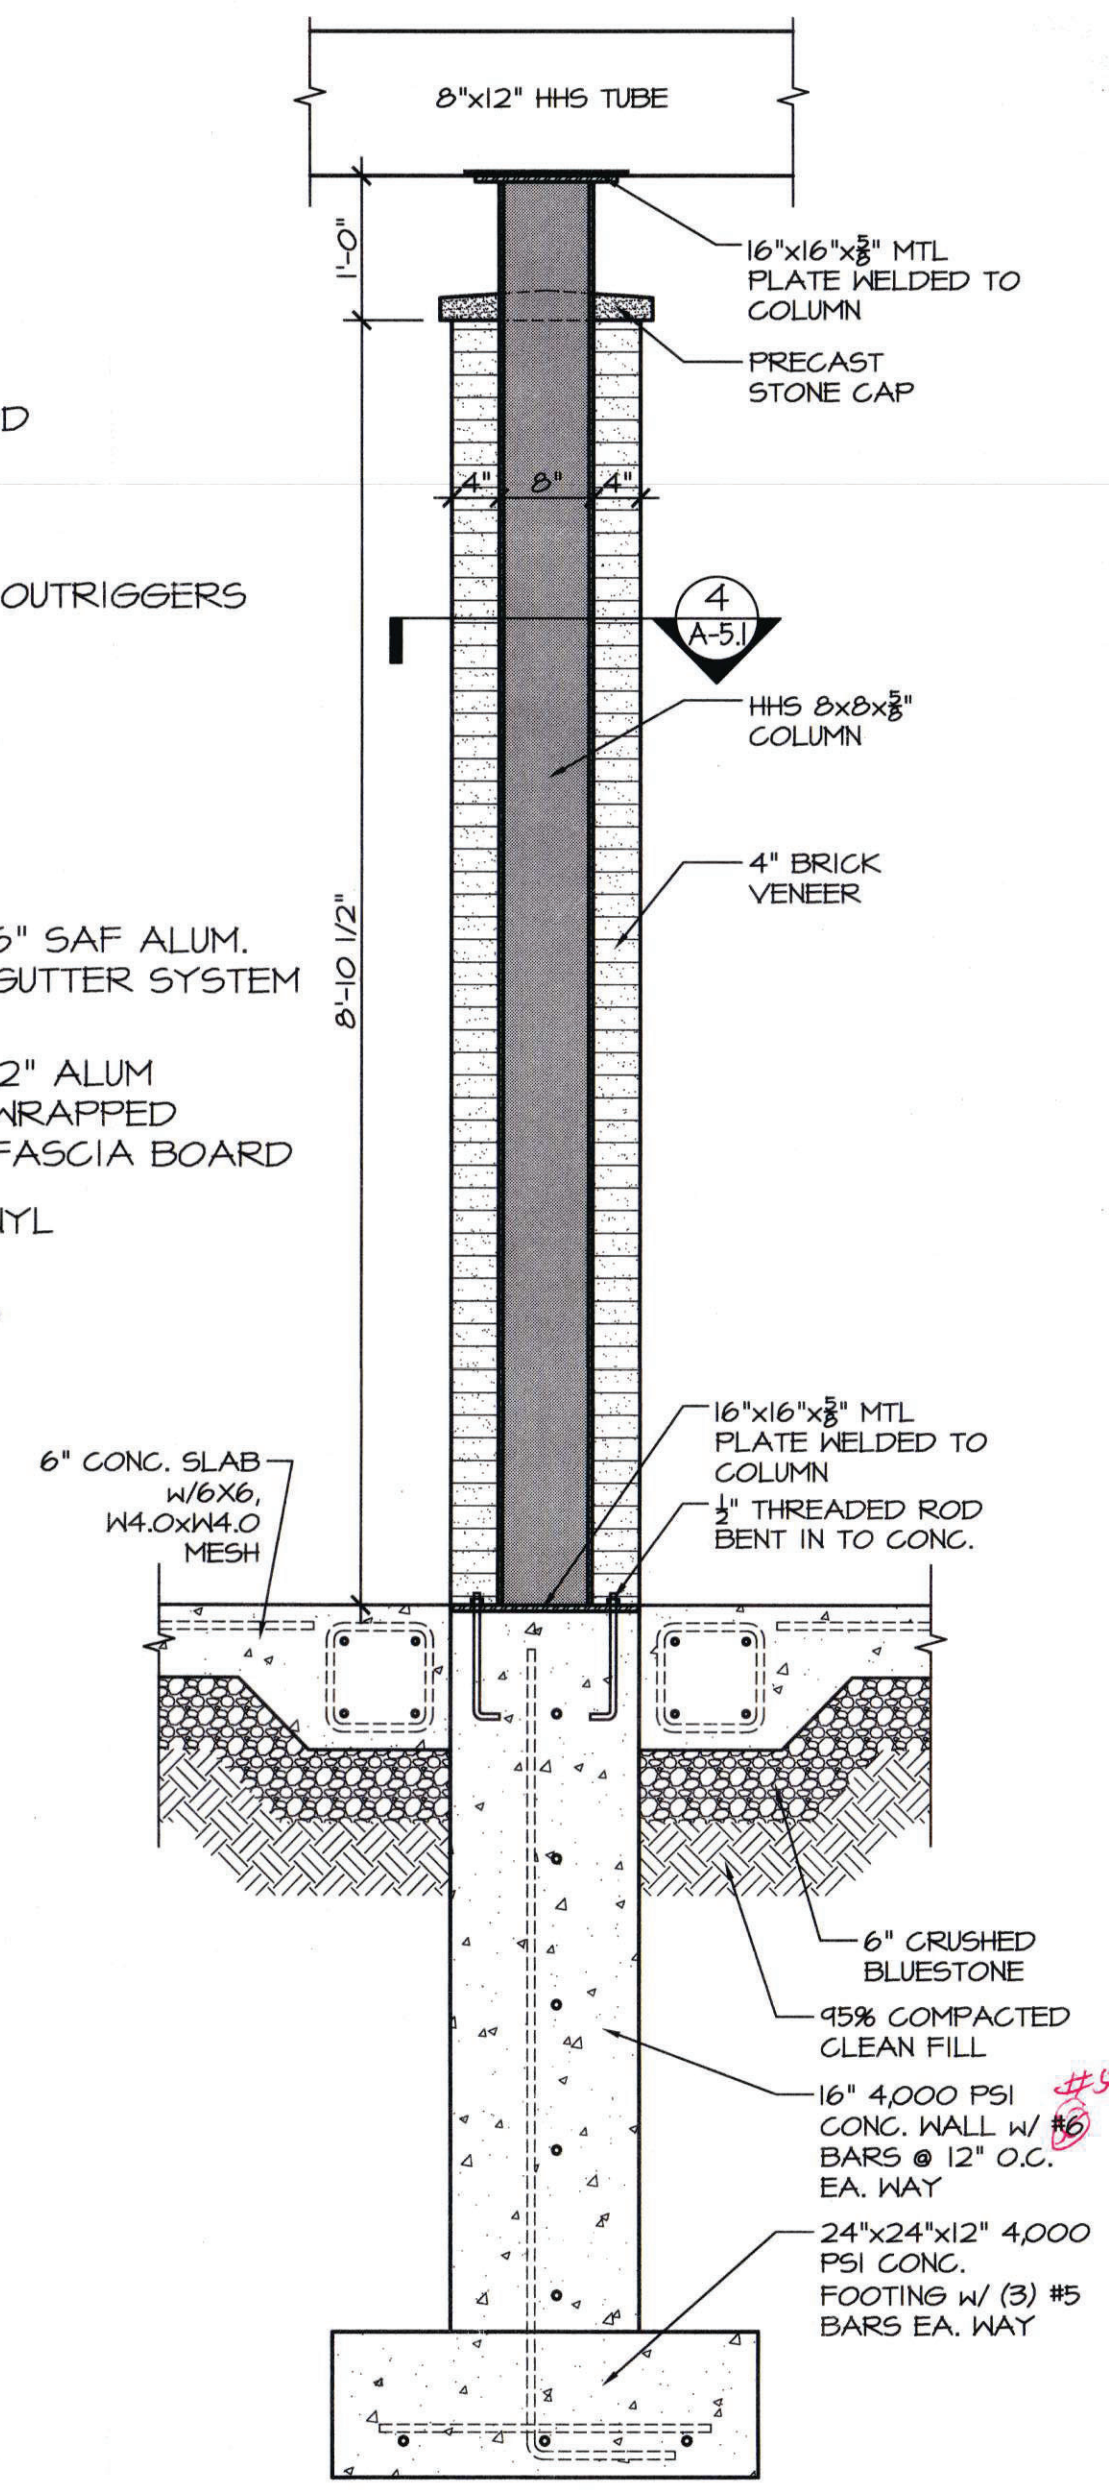

SECTION 5
SCALE: 3/4" = 1'-0"

DATE: ISSUE
FOR BIDDING & PERMIT

SEAL:

SENDLEWSKI ARCHITECTS PC
ARCHITECTS - PLANNERS
215 ROANOKE AVENUE
RIVERHEAD, NY 11901
(631) 727-5352
9 SELENA COURT
WALDEN, NY 12586
(845) 275-8859

PROPOSED PAVILION
TAPPAN FIRE DISTRICT
300 WESTERN HIGHWAY SOUTH
TAPPAN, NY 10983

PROJECT #: 2108/C

DRAWN BY:


CAD FILE: 2108/P/BID

DRAWING#:



A-5.1

PAVILION


07-11-22 UPDATE

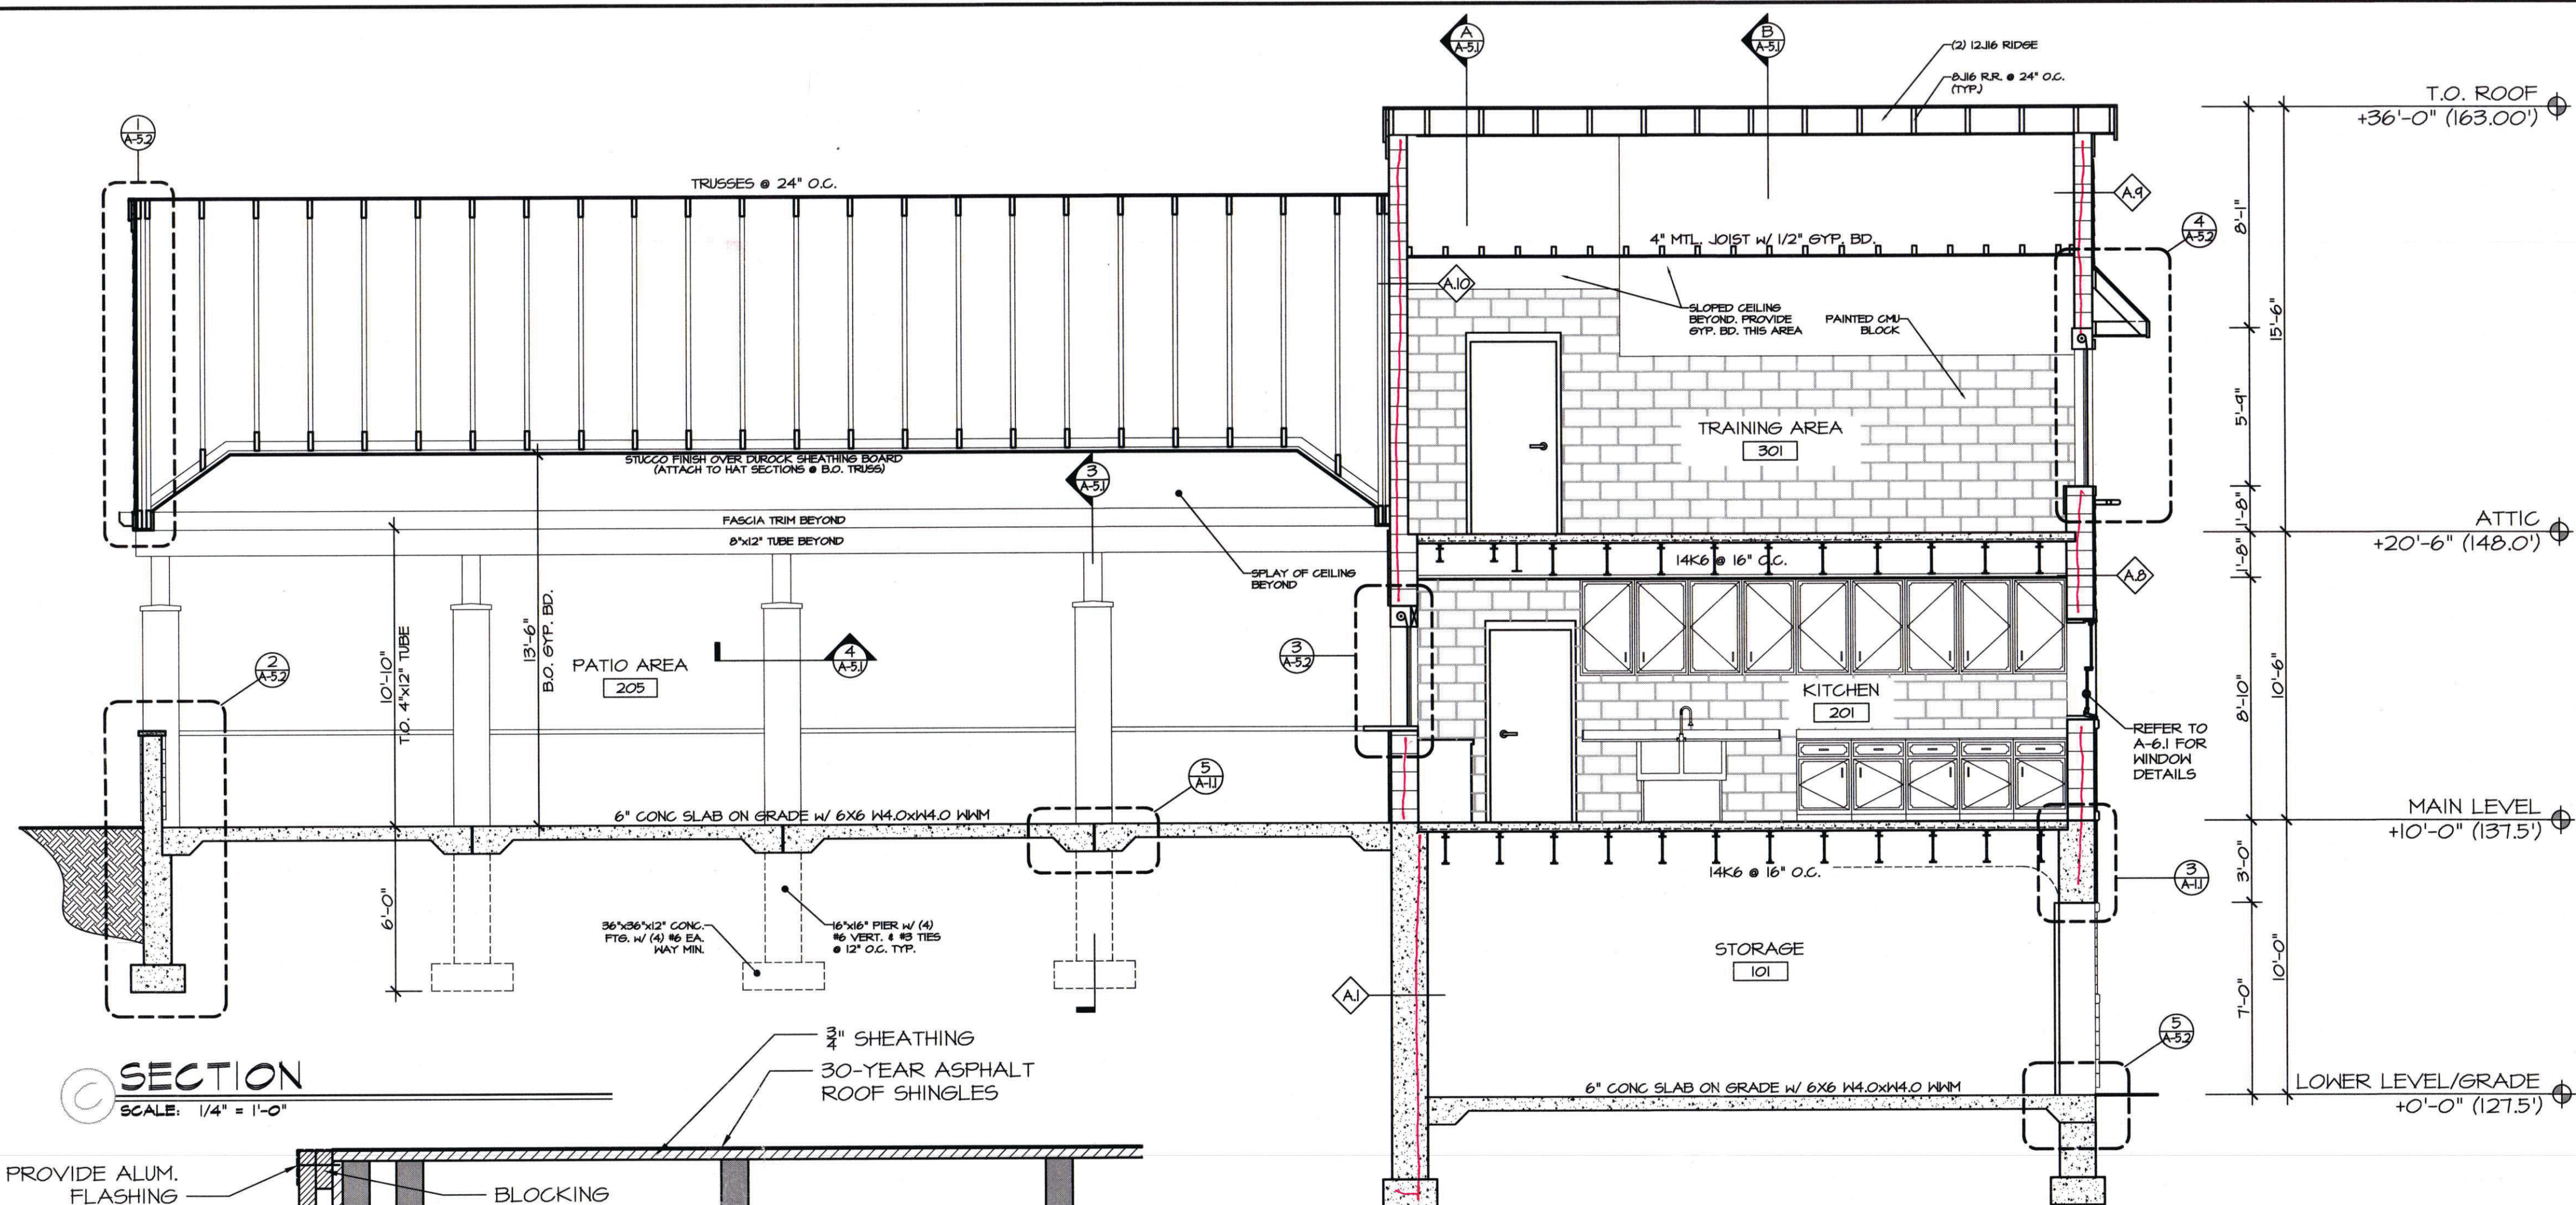


SECTION
SCALE: 1/4" = 1'-0"

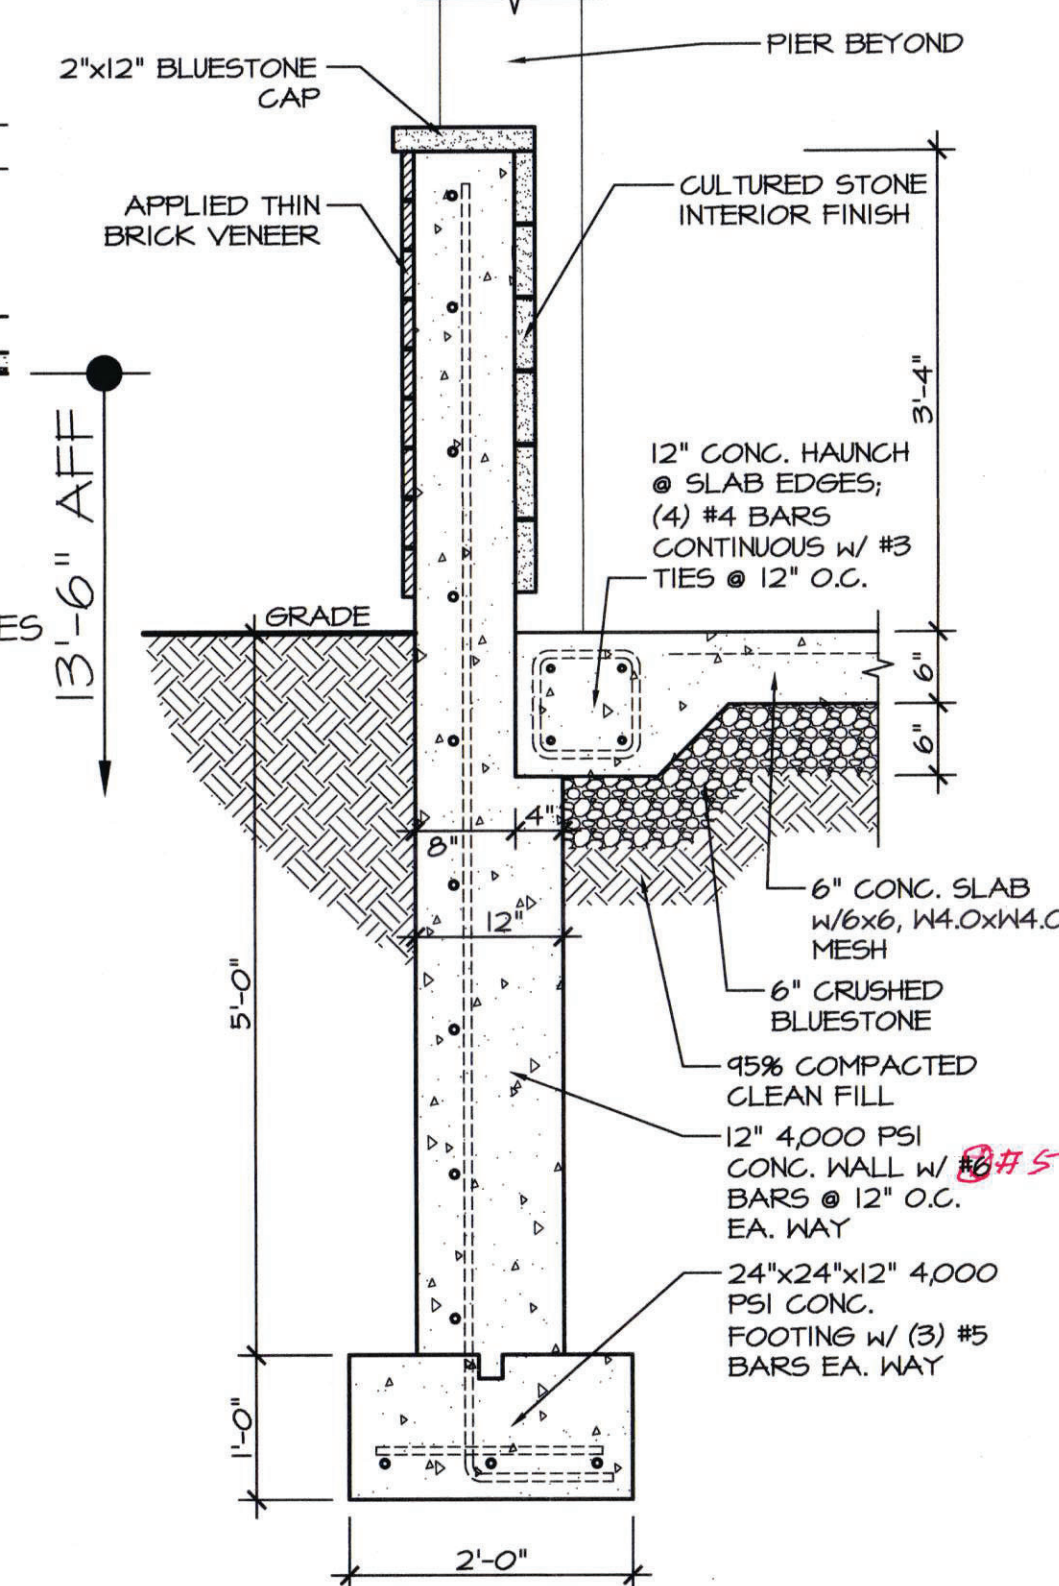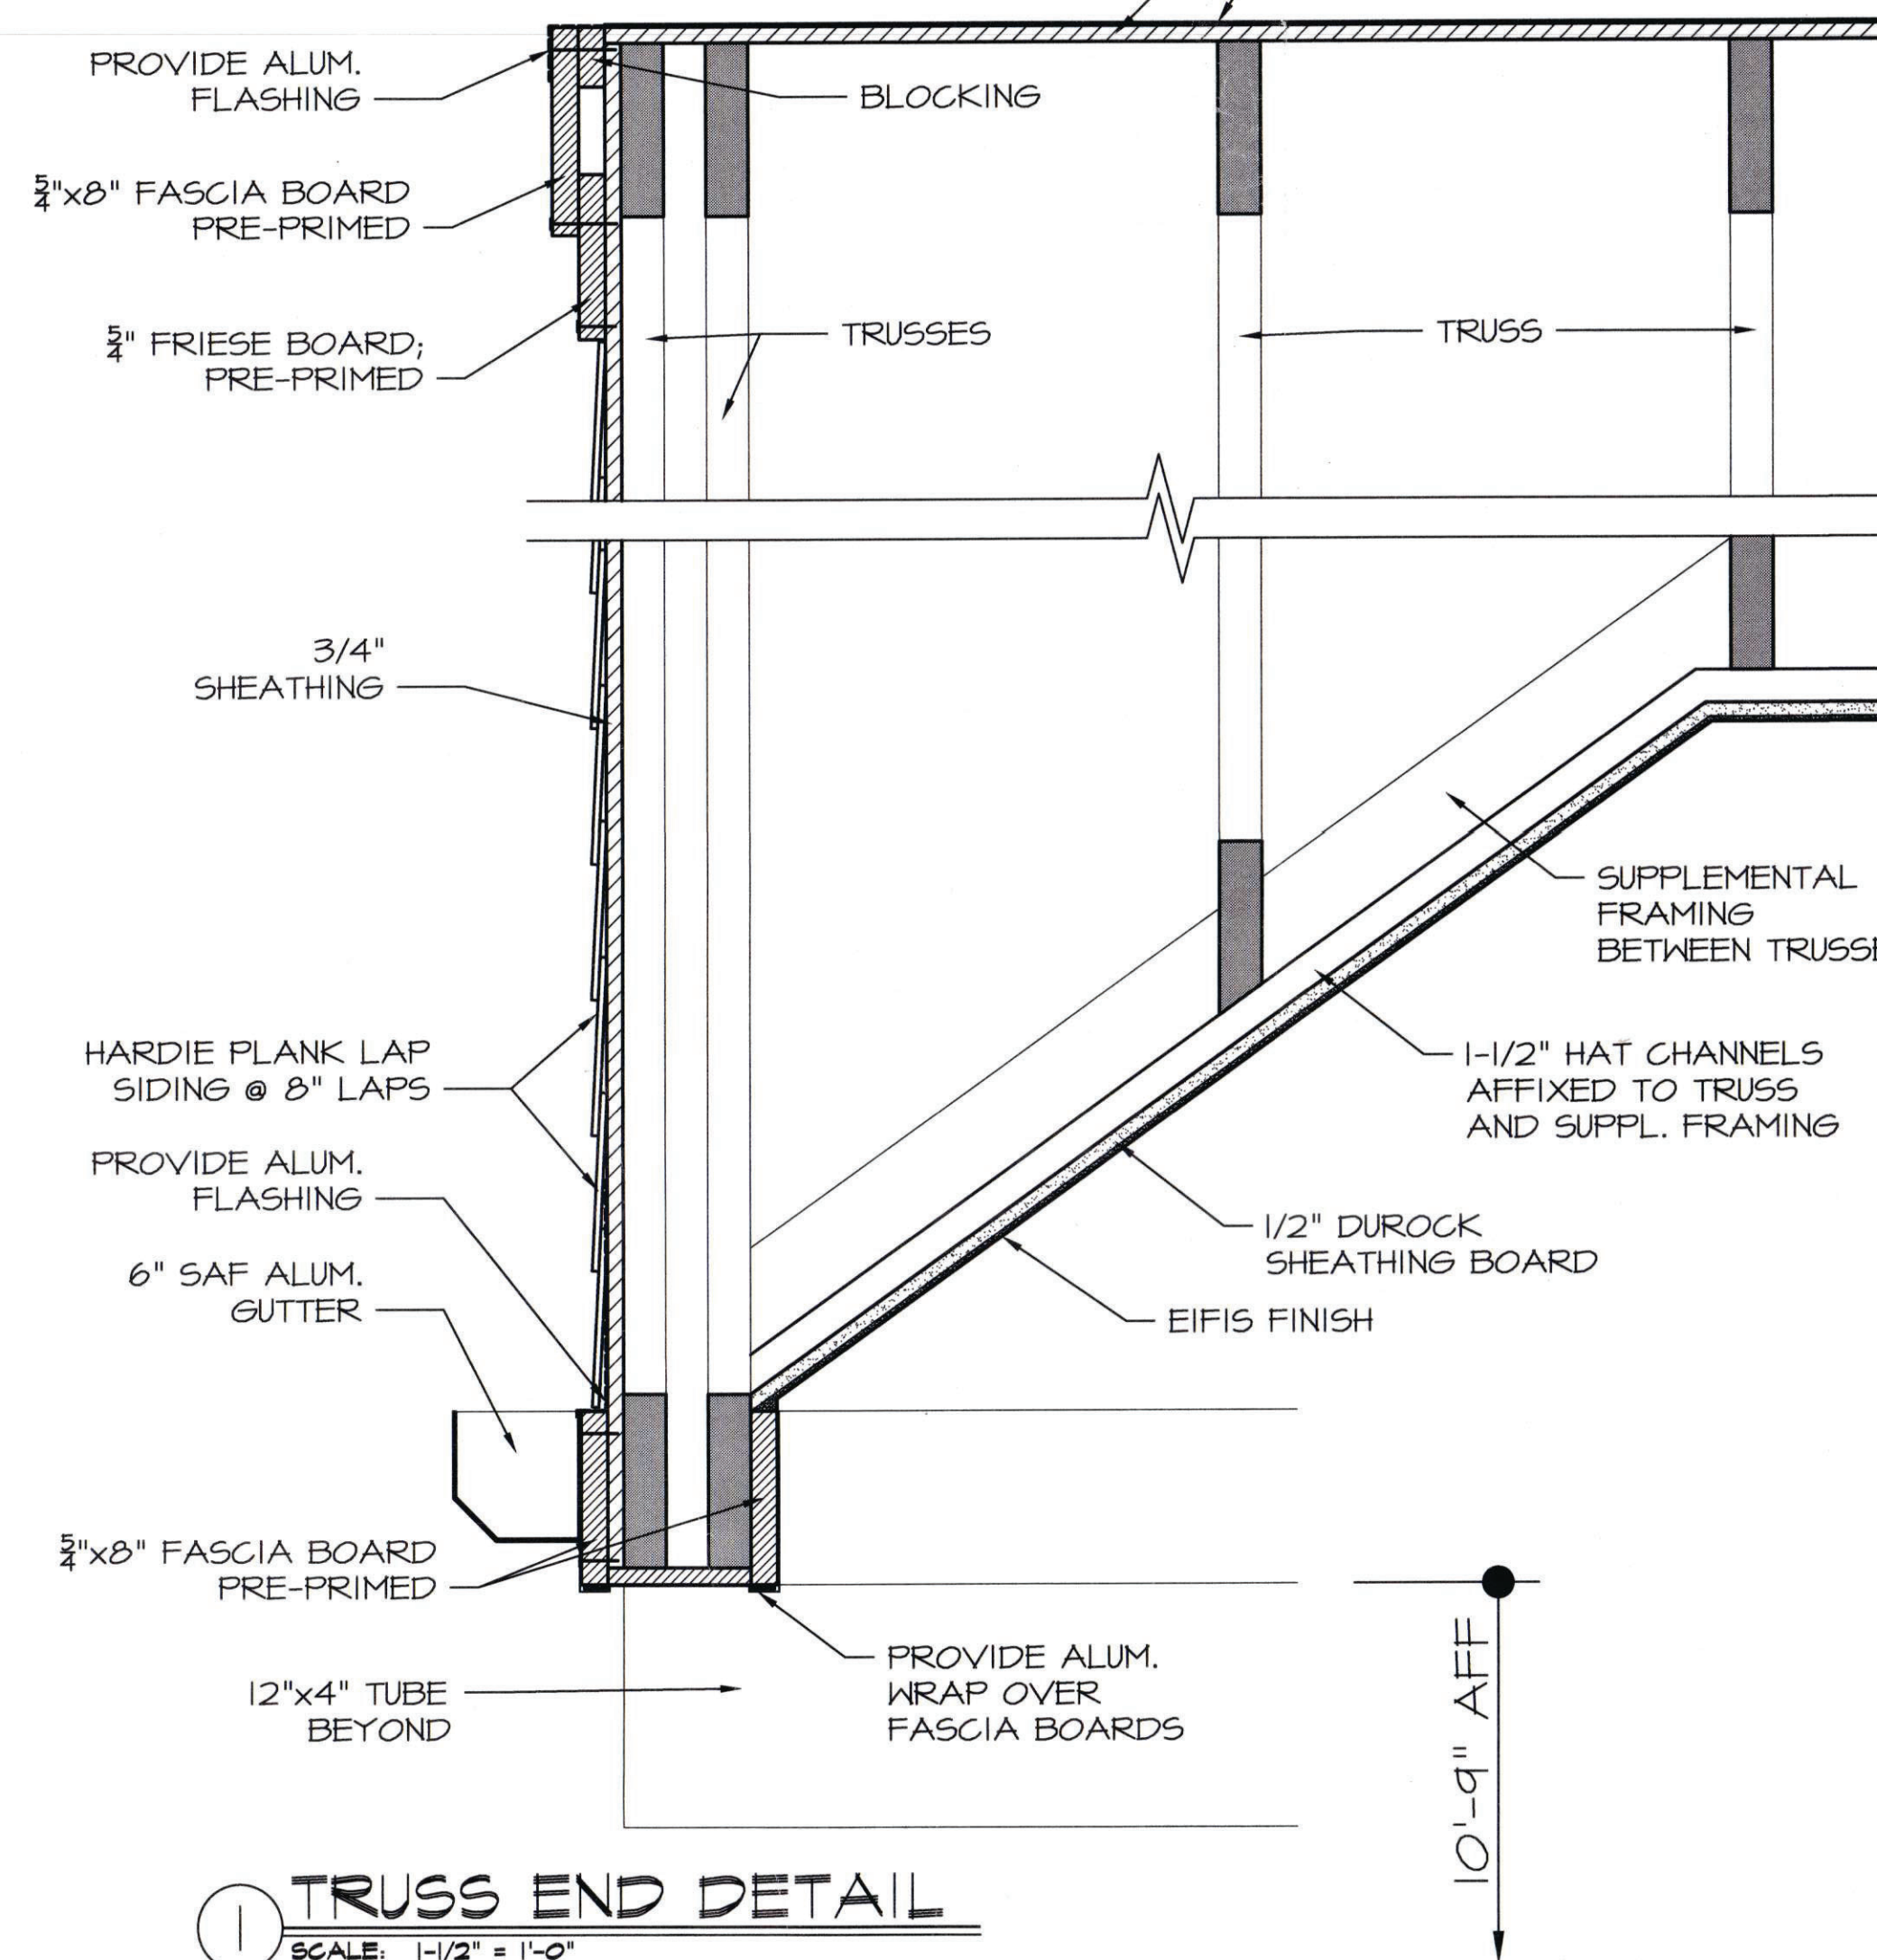


2 WALL DETAIL
SCALE: 3/4" = 1'-0"

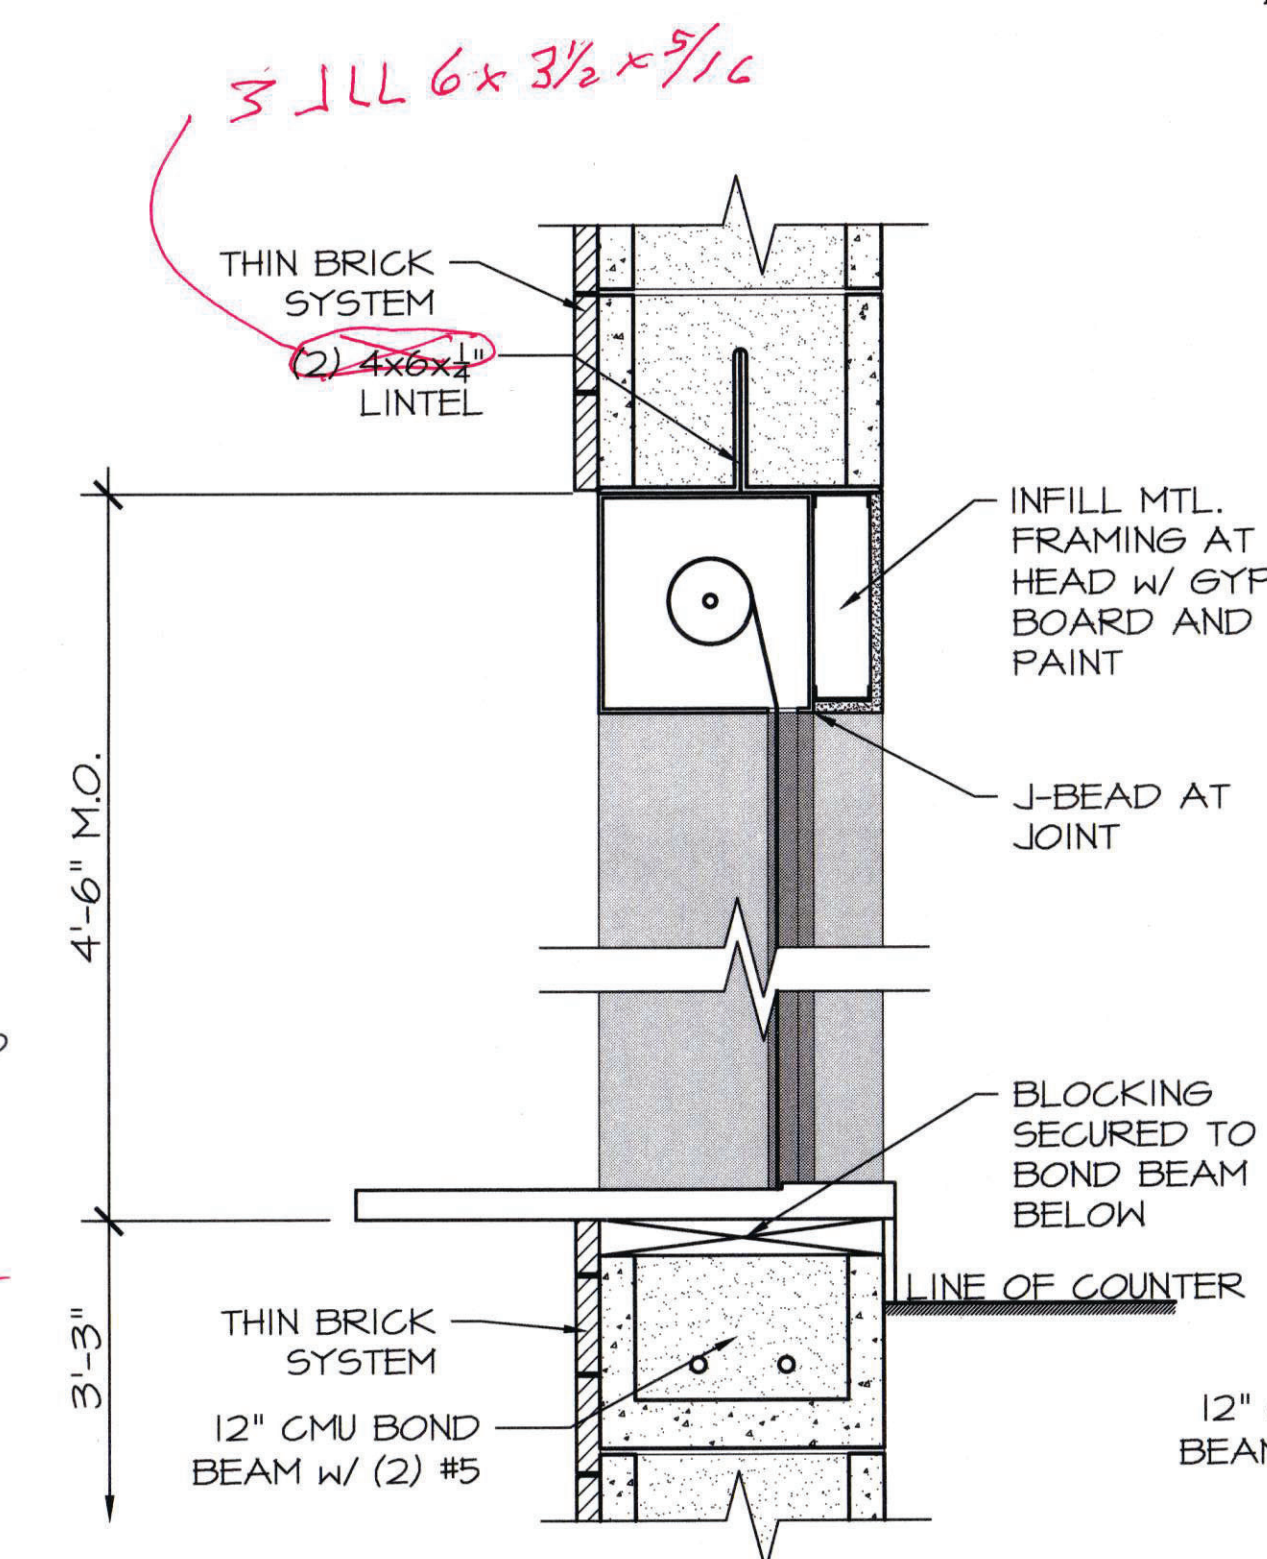

3 KITCHEN ROLL UP WINDOW
SCALE: 1-1/2" = 1'-0"

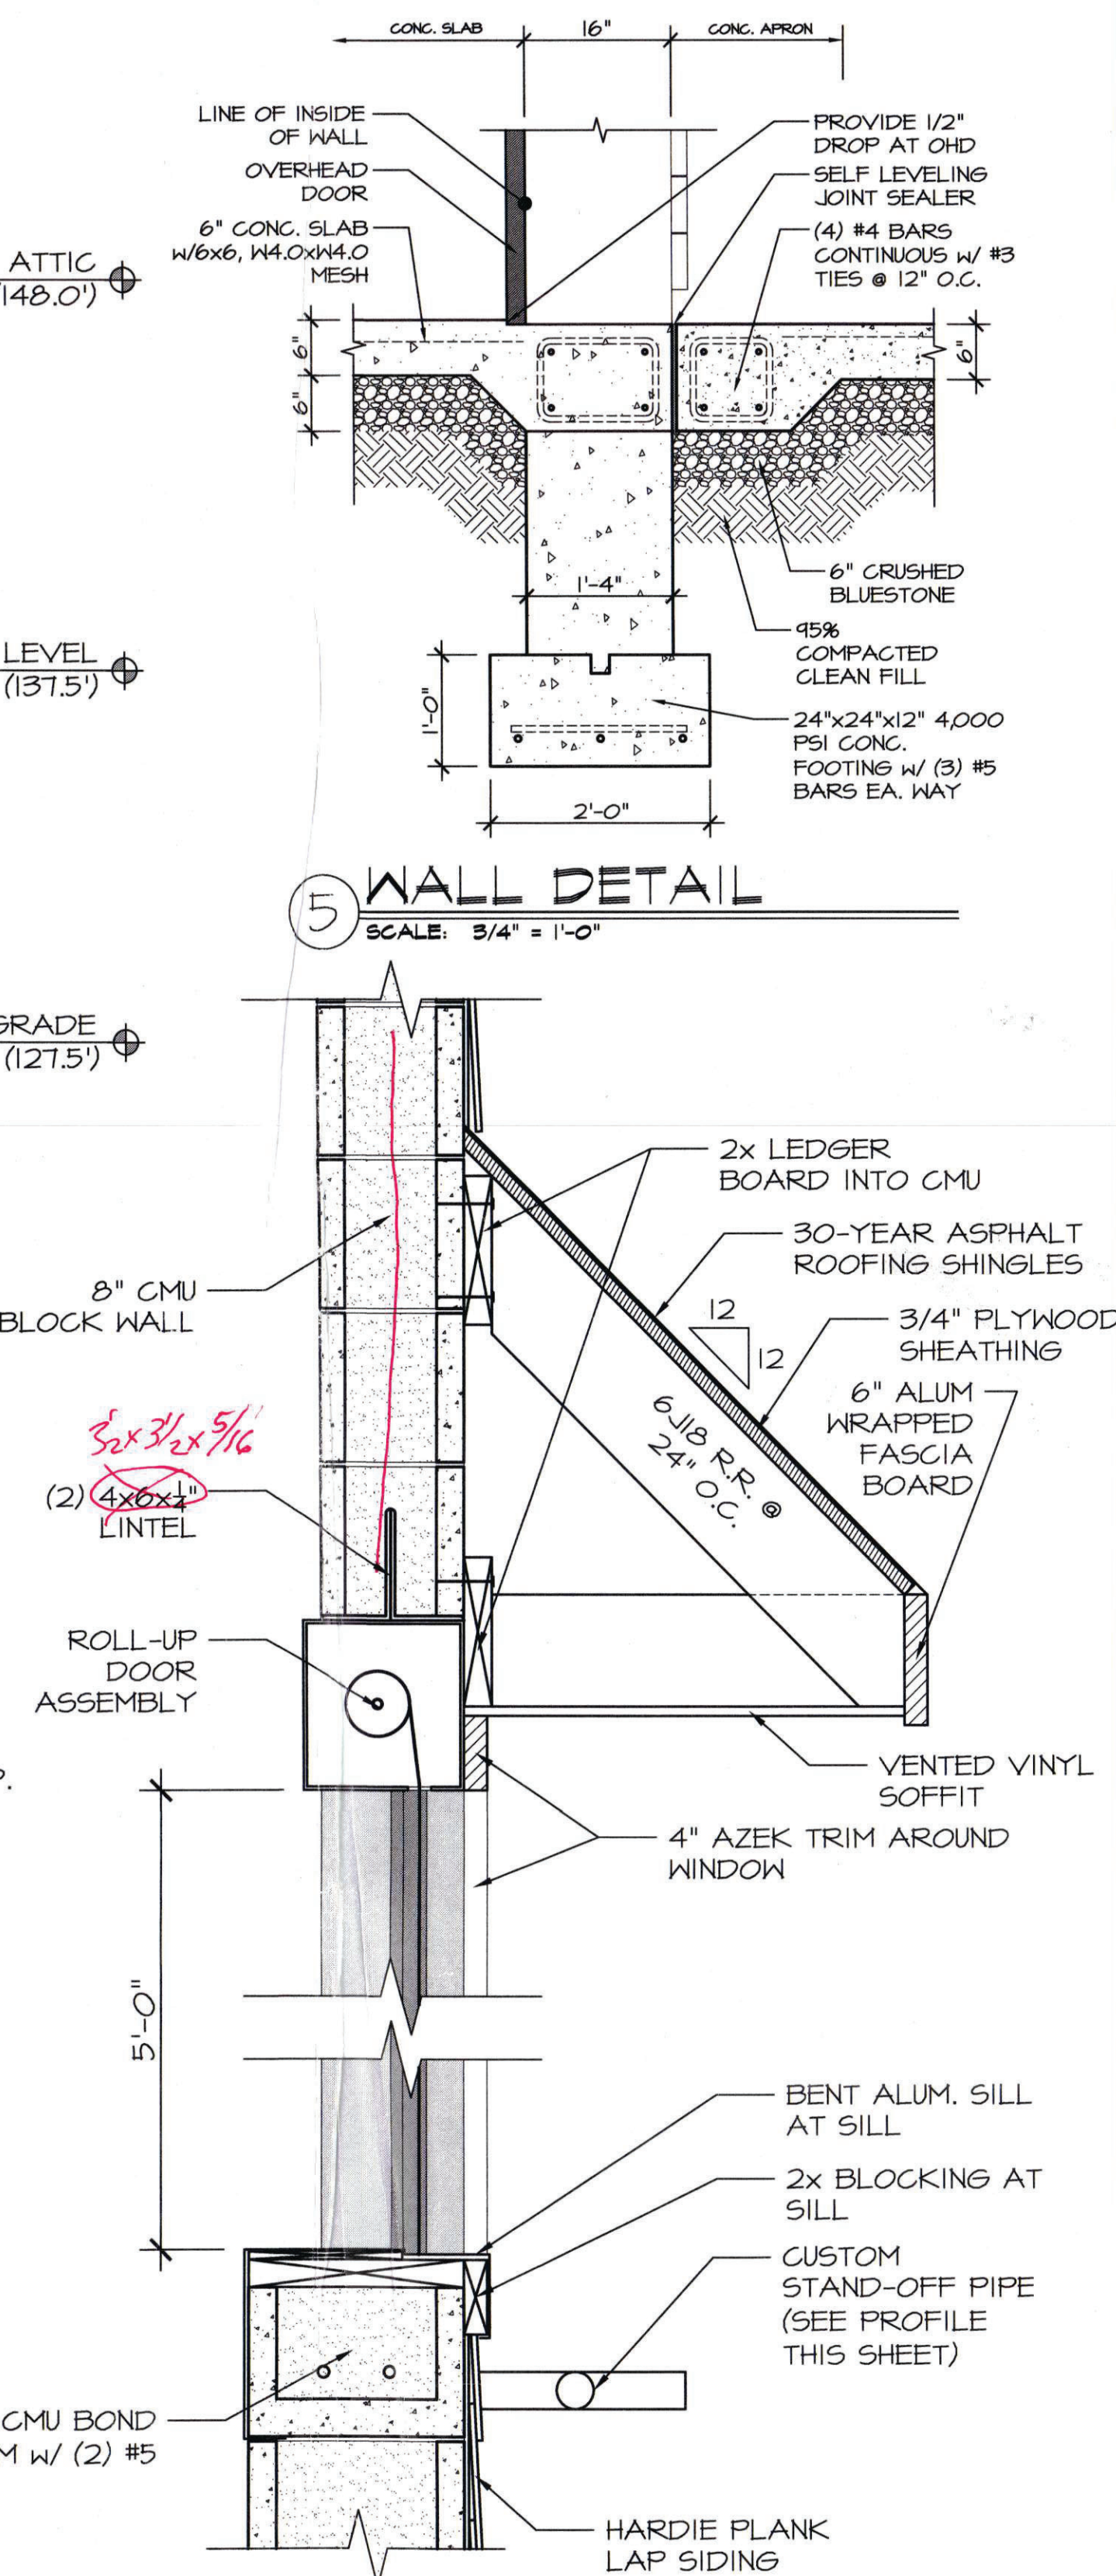

4 TRAINING ROLL UP WINDOW
SCALE: 1-1/2" = 1'-0"

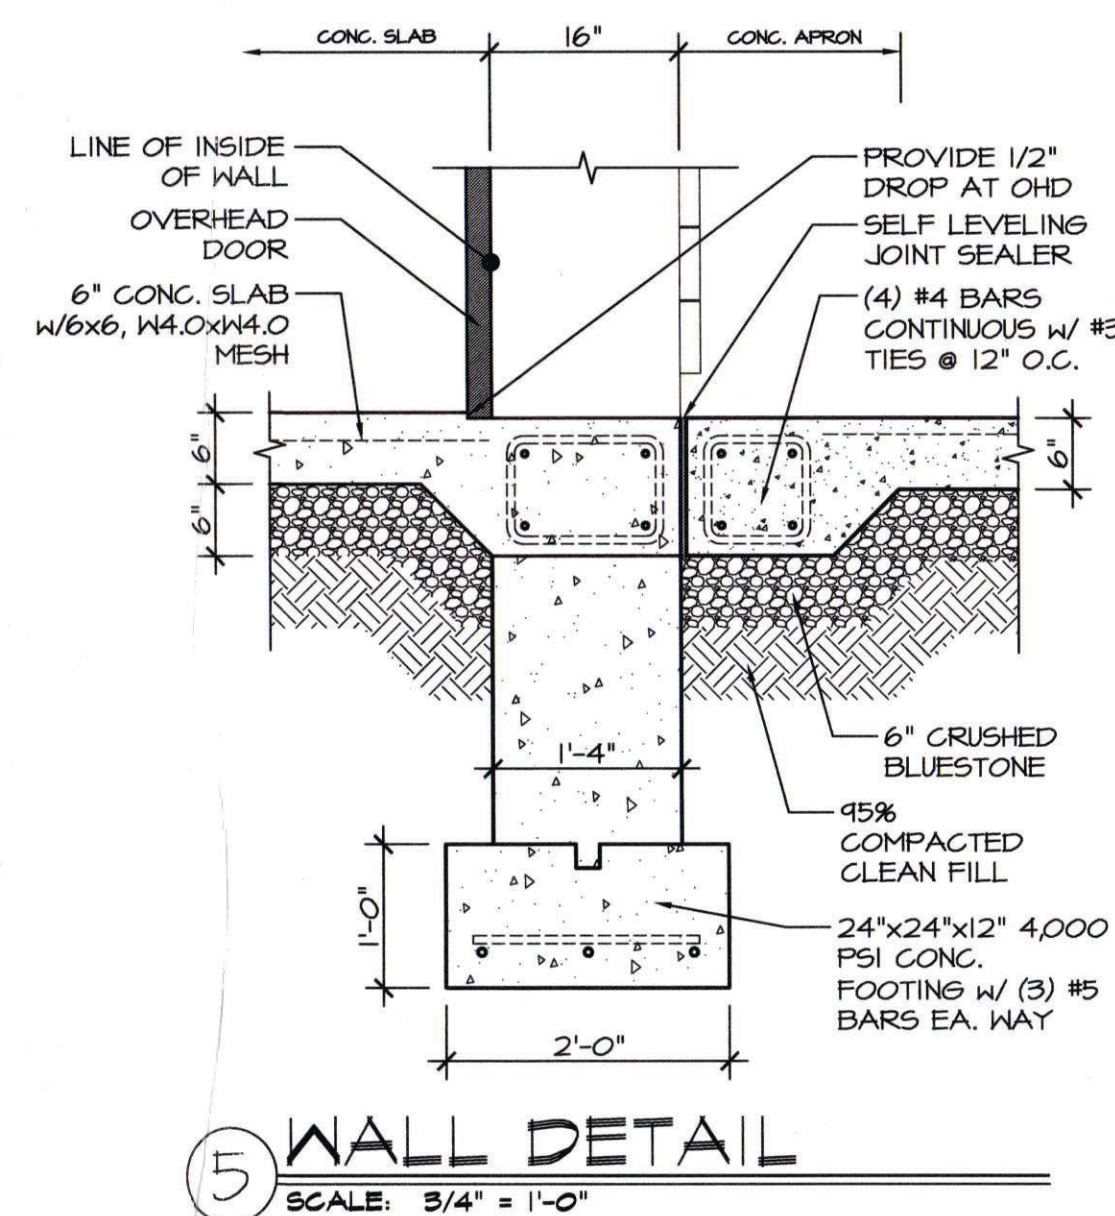

5 WALL DETAIL
SCALE: 3/4" = 1'-0"

DATE: ISSUE
-20- ISSUED FOR BIDDING & PERMIT

SEAL:

SENDELSKI ARCHITECTS PC
ARCHITECTS - PLANNERS
215 ROANOKE AVENUE
RIVERHEAD, NY 11901
(631) 727-5352
9 SELENA COURT
WALDEN, NY 12586
(845) 275-8859

PROPOSED PAVILION
TAPPAN FIRE DISTRICT
300 WESTERN HIGHWAY SOUTH
TAPPAN, NY 10983

SECTIONS & DETAILS

PROJECT #: 2108/C

DRAWN BY:


CAD FILE: 2108/P/BID

DRAWING#:

A-5.2

PAVILLION

07-11-22 UPDATE

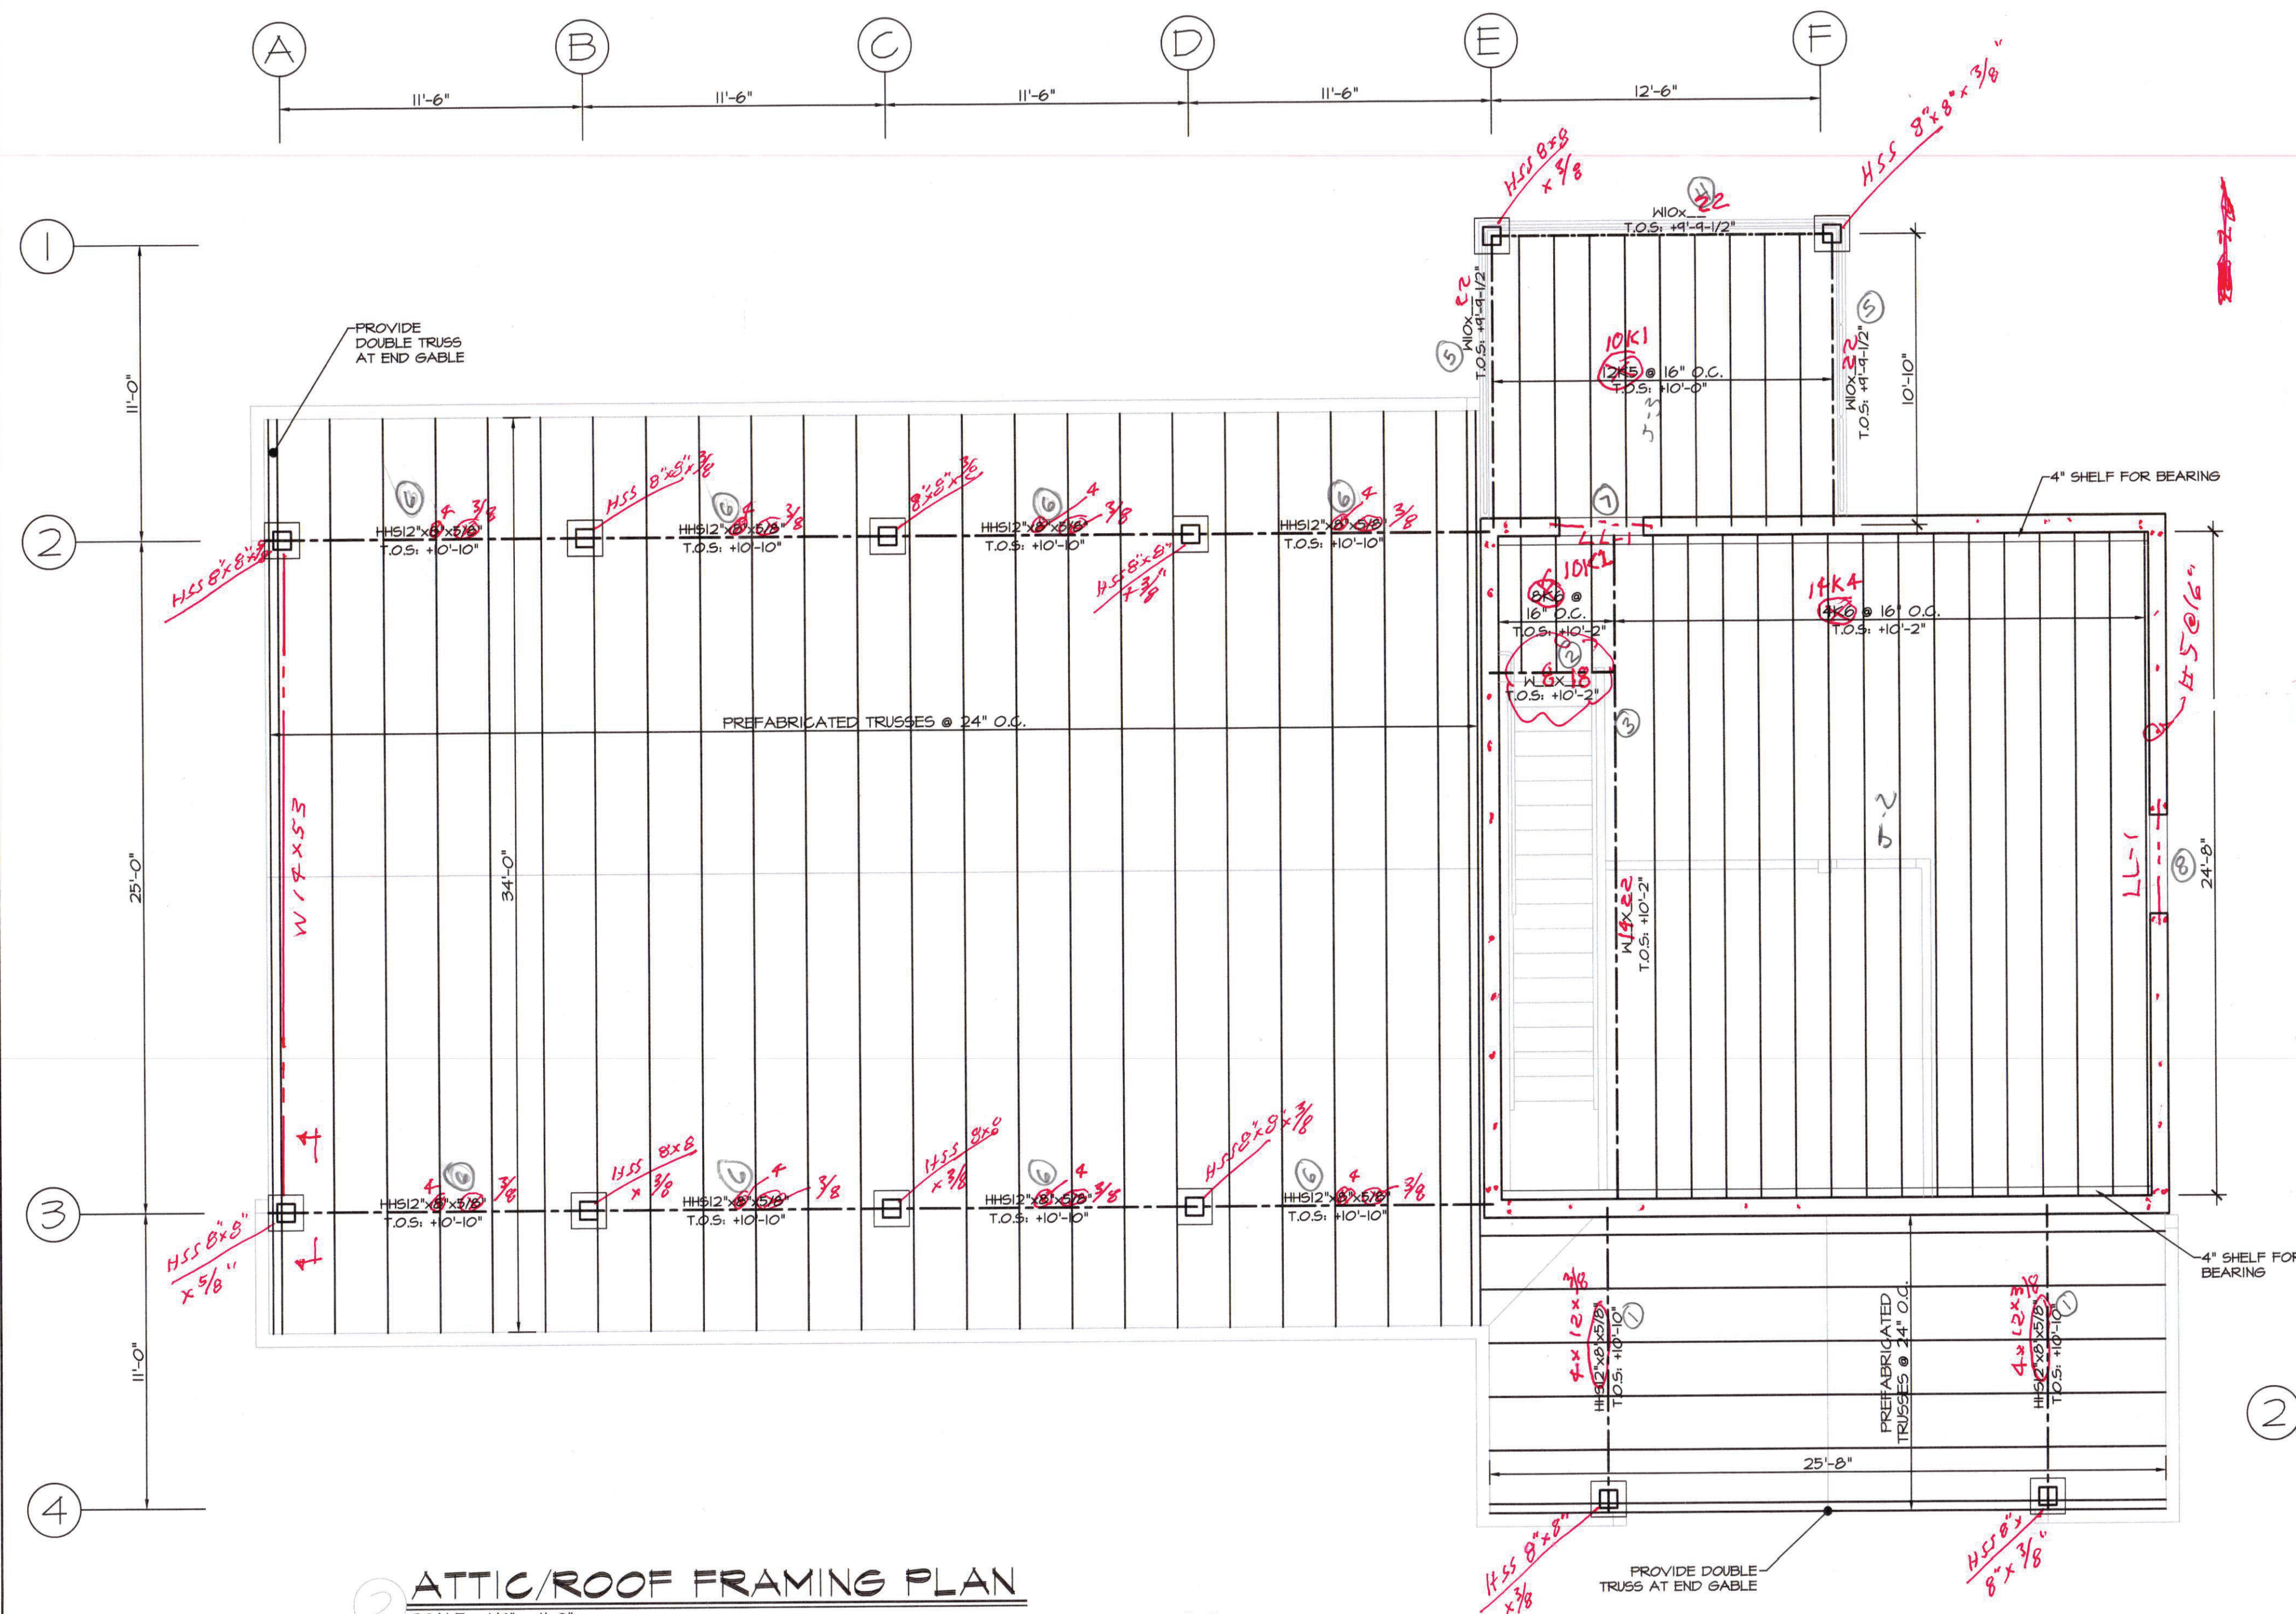

ATTIC/ROOF FRAMING PLAN


SCALE: 1/4" = 1'-0"

- Notes: 1. Floor Deck @ Attic Floor to be 4" concrete slab on 22 gauge 1 1/2" deep "B-lak" composite floor deck with 6"x6"-W4.0/W4.0 w/w m
2. Floor Deck @ Terrace to be 6" concrete slab on 22 gauge 1 1/2" deep "B-lak" composite floor deck with 4"x4"-W4.0/W4.0 w/w m

PREFABRICATED ROOF TRUSS NOTES



PreFabricated Steel roof trusses shall be designed in accordance with the following criteria:

- Loading: Top chord live load 36 psf
Top chord dead load 10 psf
Bottom chord live load 10 psf
Bottom chord dead load 9 psf
Total 65 psf
- Trusses to be designed for wind load of 42psf.
- Provide all temporary and permanent lateral bracing as required to maintain structural integrity.
- Shop drawings prepared and sealed by a N.Y.S. licensed professional engineer shall be submitted to the Architect of record for review prior to fabrication. Shop drawings shall show member forces, steel grades, and all details of connections.

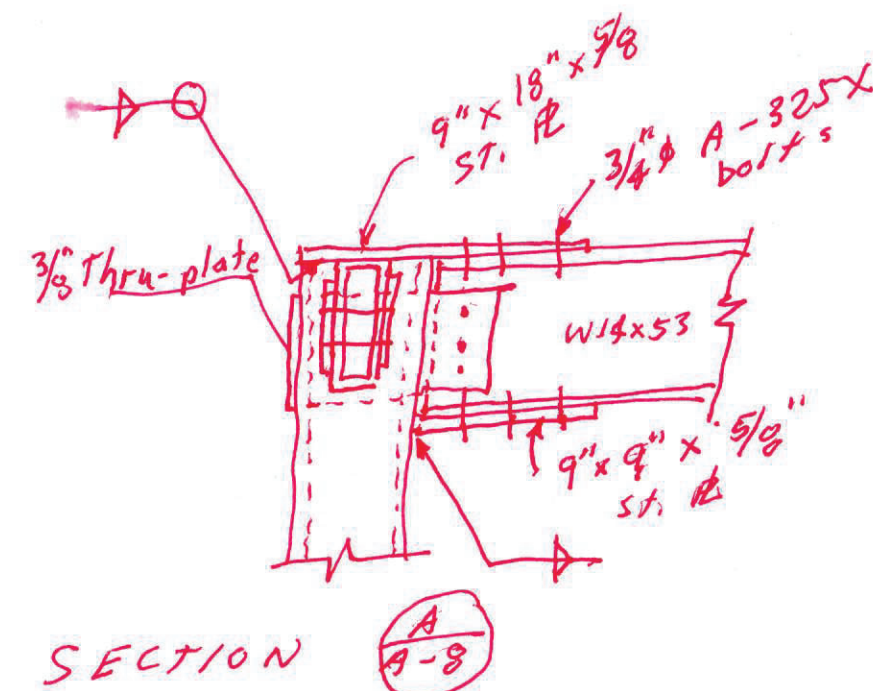

MARK	SIZE
LL-1	2 JLS 3 1/2 x 3 1/2 x 5/16
LL-2	3 JLS 3 1/2 x 3 1/2 x 5/16
LL-3	3 JLS 6 x 3 1/2 x 5/16

DESIGN LOADS	TAPPAN PD - DESIGN CRITERIA
GROUND SNOW LOAD = 50 PSF	SNOW LOAD IMPORTANCE FACTOR $I_s = 1.2$
FLAT ROOF SNOW LOAD = 25.2 PSF	ROOF DEAD LOAD = 25 PSF
ROOF LIVE LOAD = 20 PSF	FLOOR (LL) = 100 PSF
FLOOR (DL) = 80/100 PSF	WIND (30 MPH) = 42 PSF
WIND IMPORTANCE FACTOR $I_w = 1.15$	EXPOSURE B
INTERNAL PRESSURE COEFFICIENT $C_{pi} = 0.18$	CLADDING = 154 PSF, 48 PSF
OCCUPANCY CATEGORY IV	
DESIGNING DESIGN PARAMETERS	
1. $I_s = 1.2$	2. $I_w = 1.15$
3. $C_{pi} = 0.18$	4. $C_{pe} = 0.8$
5. $C_{pe} = 0.8$	6. $C_{pe} = 0.8$
7. $C_{pe} = 0.8$	8. $C_{pe} = 0.8$
9. $C_{pe} = 0.8$	10. $C_{pe} = 0.8$
99. $C_{pe} = 0.8$	100. $C_{pe} = 0.8$

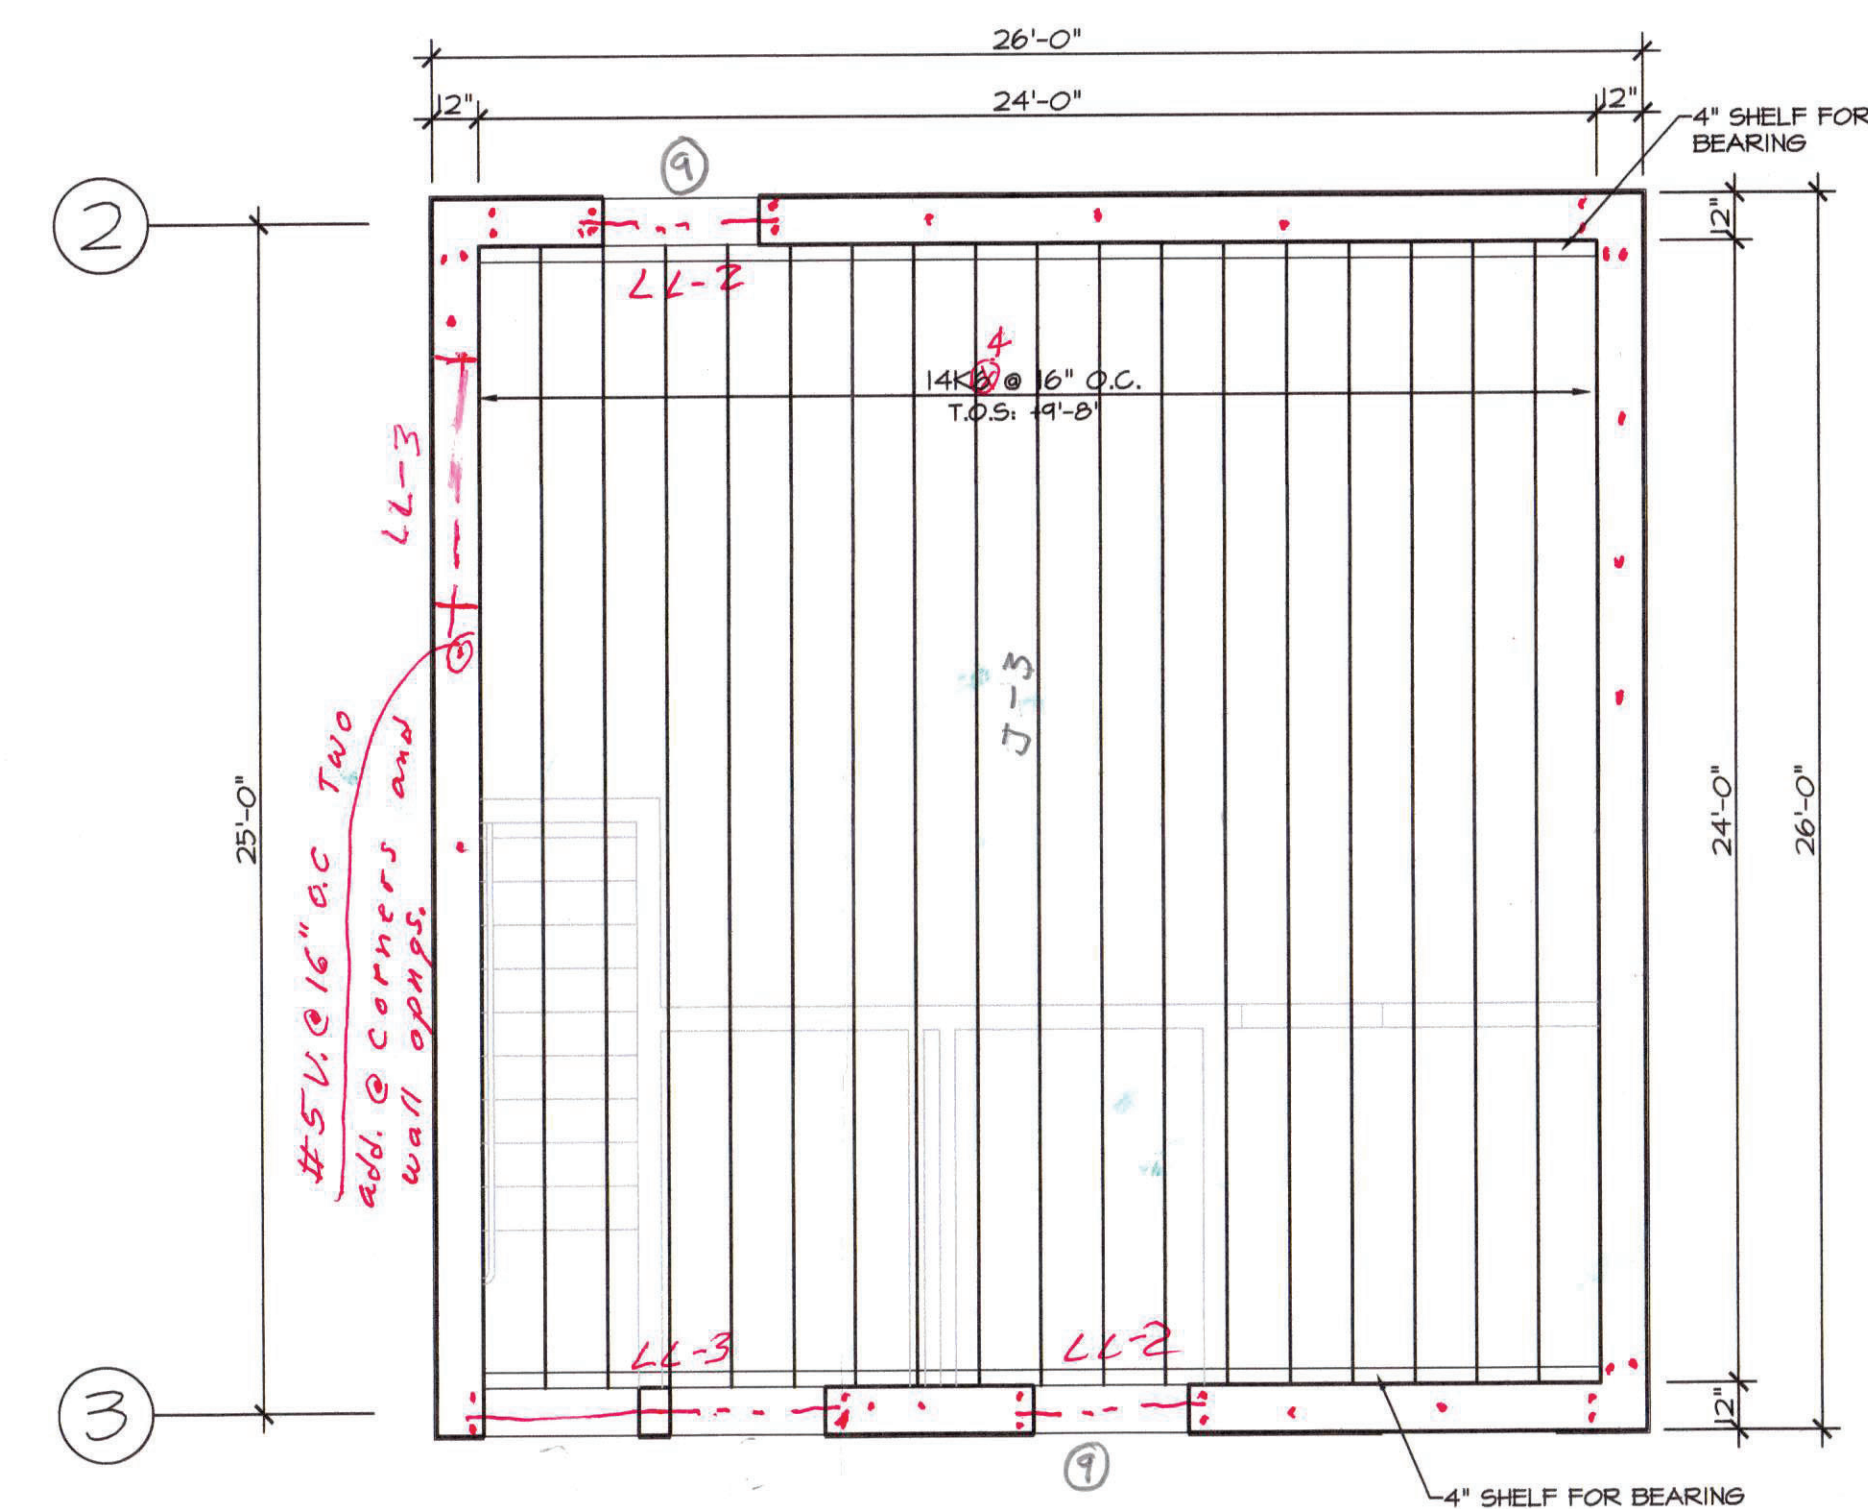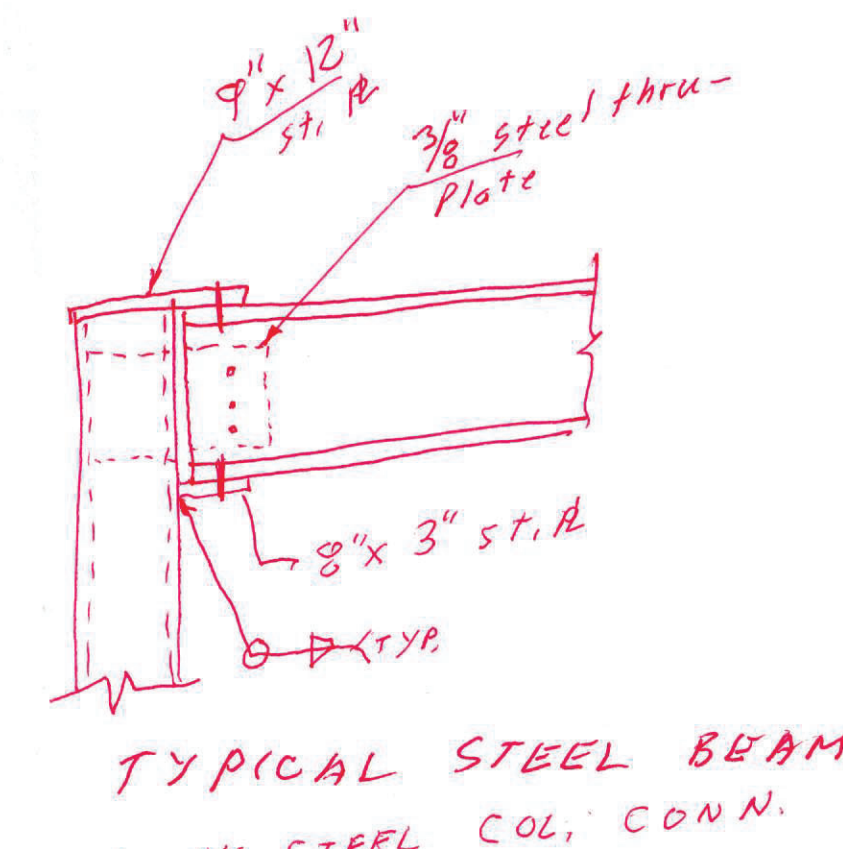

MAIN LEVEL FRAMING PLAN

SCALE: 1/4" = 1'-0"

- Notes: Floor Deck to be 4" concrete slab on 22 gauge 1 1/2" deep "B-lak" composite floor deck with 6"x6"-W4.0/W4.0 w/w m

DATE: ISSUE
07-20-2022 ISSUED FOR BIDDING & PERMIT

SEAL:

SENDLEWSKI ARCHITECTS PC
ARCHITECTS - PLANNERS
215 ROANOKE AVENUE
RIVERHEAD, NY 11901
(631) 727-5352
9 SELENA COURT
WALDEN, NY 12586
(845) 275-8859

PROPOSED PAVILION
TAPPAN FIRE DISTRICT
300 WESTERN HIGHWAY SOUTH
TAPPAN, NY 10983

STRUCTURAL FRAMING PLANS

PROJECT #: 2108.02


DRAWN BY: AR/JC

CAD FILE: 2108.02/P-BID

DRAWING#:

A-8

PAVILLION

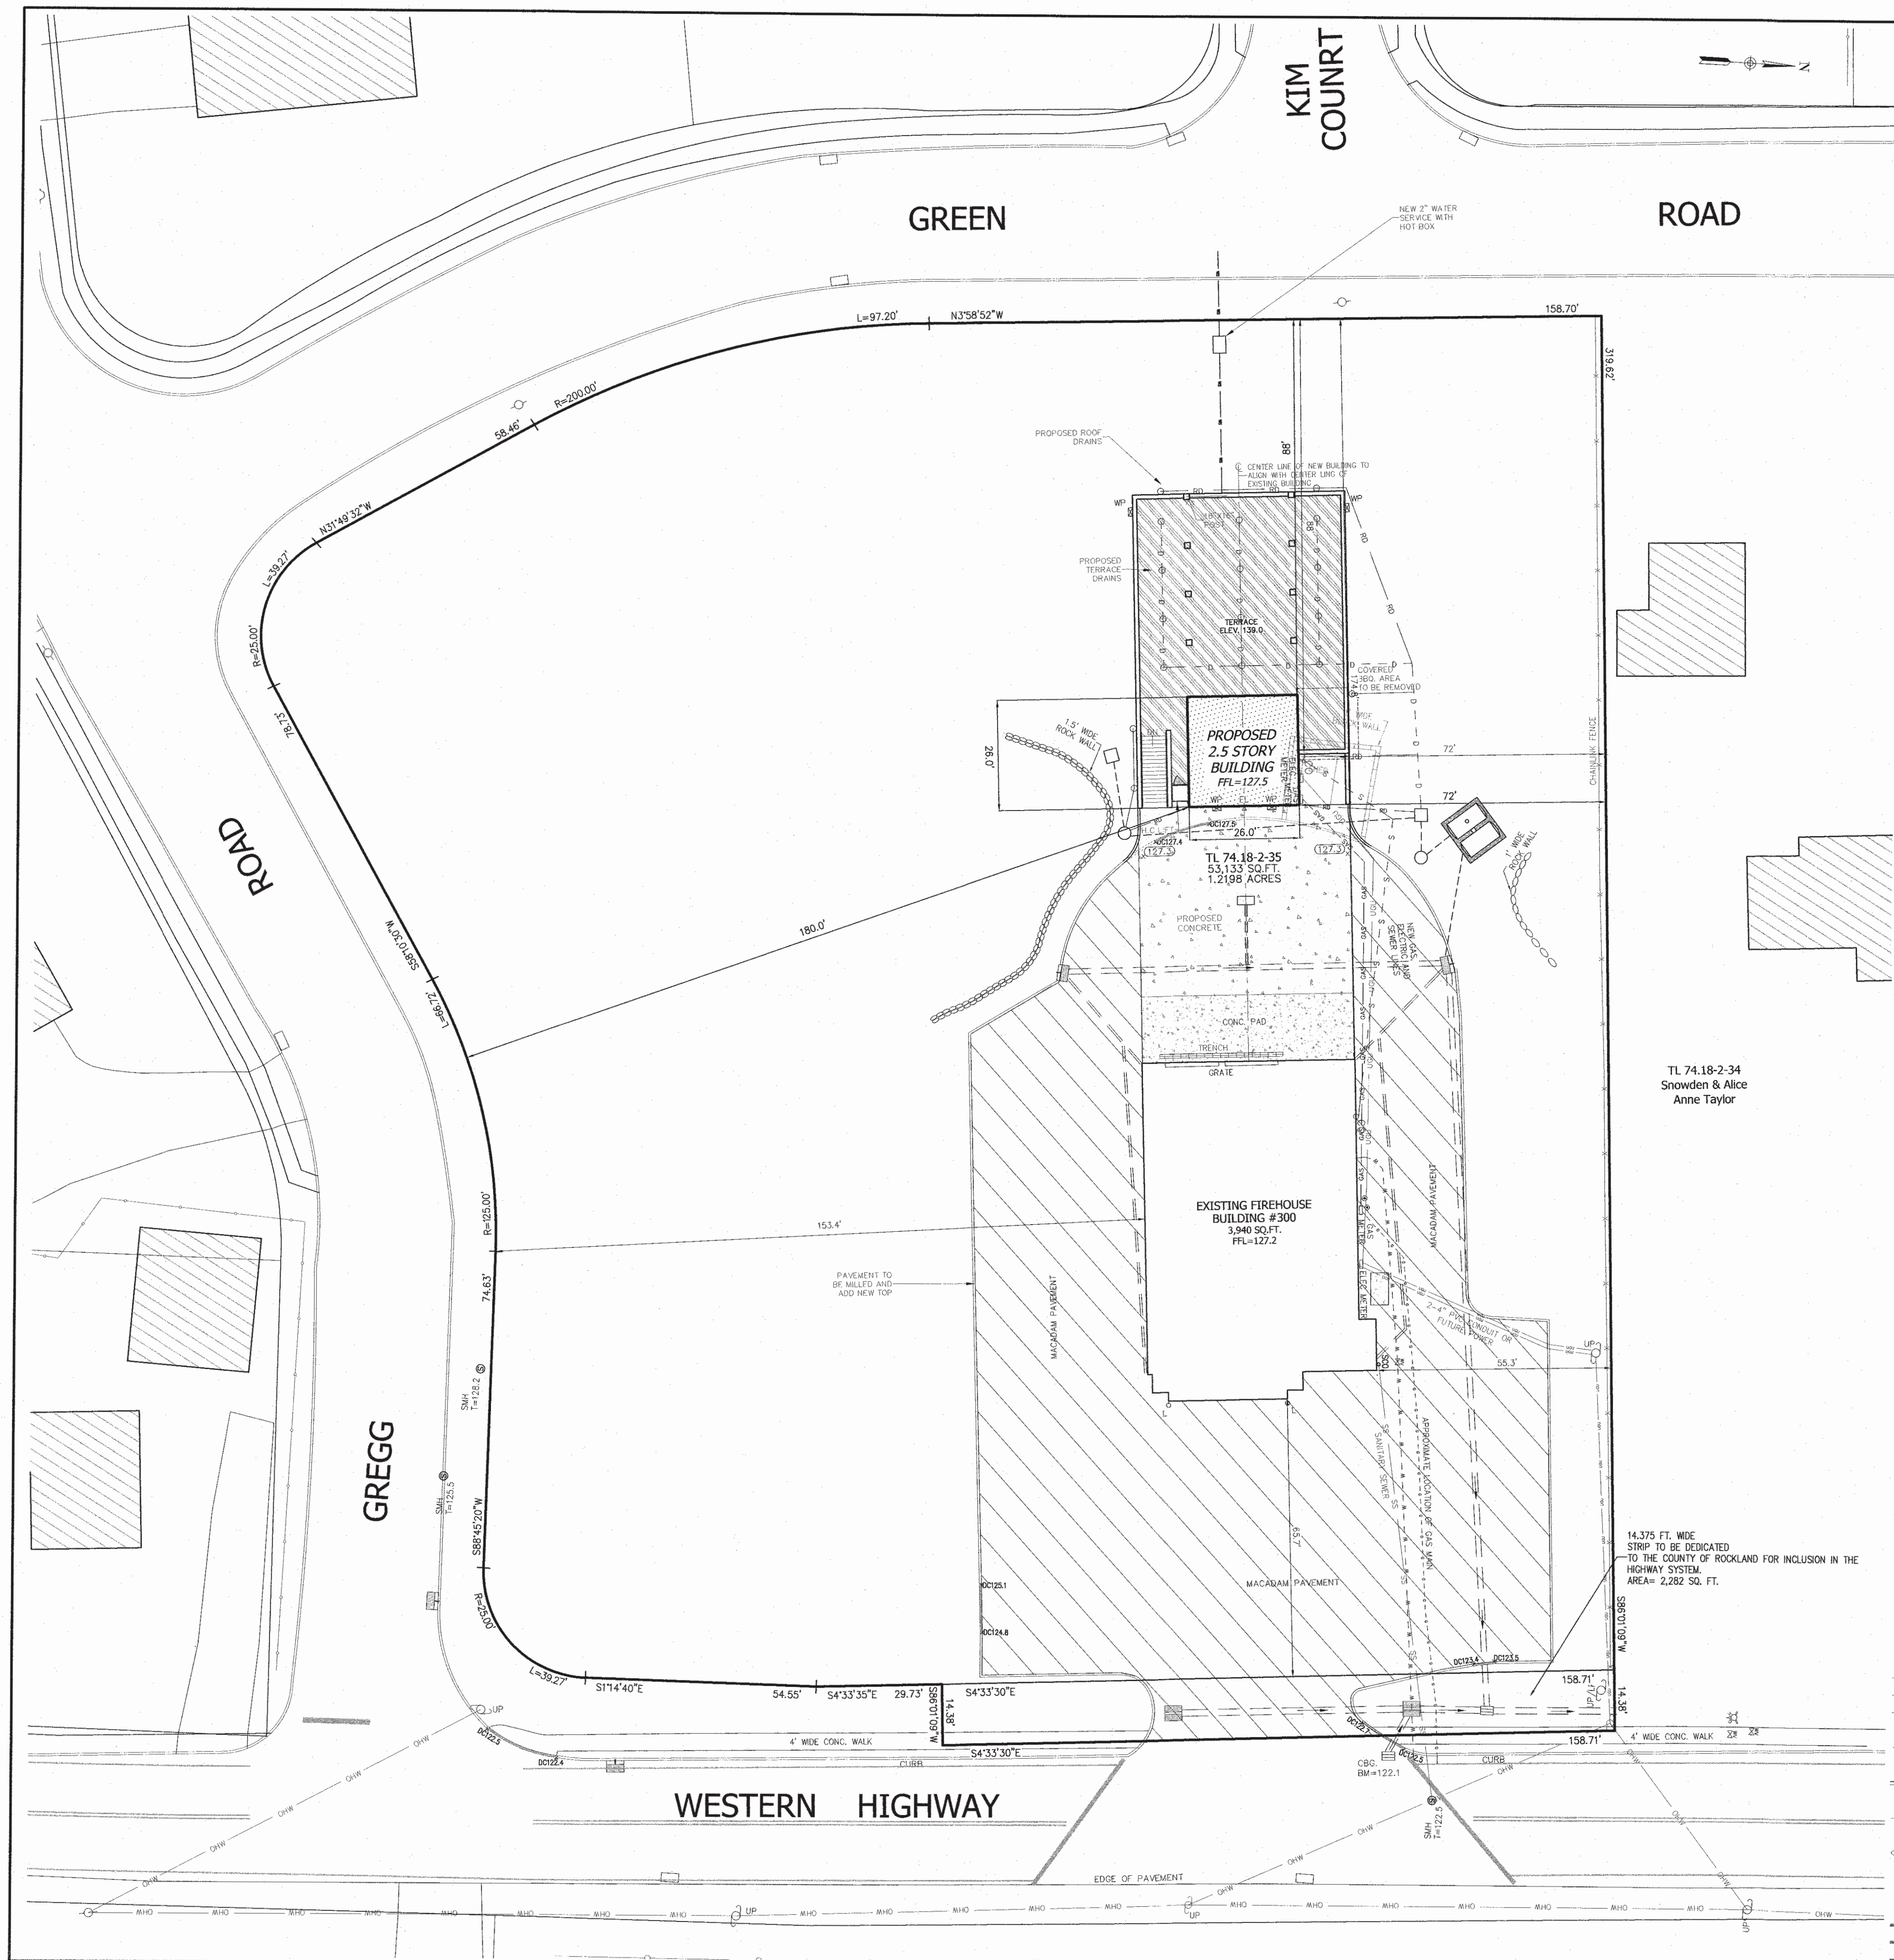

- # NOTES:
1. ALL UTILITIES, INCLUDING ELECTRIC AND TELEPHONE SERVICE SHALL BE INSTALLED UNDERGROUND.
 2. NO BUILDING PERMIT WILL BE ISSUED UNTIL SEWAGE DISPOSAL ARRANGEMENTS HAVE BEEN APPROVED BY THE ROCKLAND COUNTY HEALTH DEPARTMENT AND/OR THE TOWN OF ORANGETOWN.
 3. LOT DRAINAGE ON THIS PLAN SHALL CONSTITUTE EASEMENTS RUNNING WITH THE LAND AND SHALL NOT BE DISTURBED.
 4. ANY EXISTING UTILITIES (POLES, HYDRANTS, ETC.) AFFECTED BY CONSTRUCTION OF THIS SITE PLAN SHALL BE RELOCATED AT THE DEVELOPERS EXPENSE PRIOR TO THE ISSUANCE OF ANY CERTIFICATE OF OCCUPANCY.
 5. NO OPEN BURNING DURING CONSTRUCTION WITHOUT SPECIFIC PERMISSION FROM NEW YORK STATE DEPARTMENT OF HEALTH.
 6. DATUM: NAVD 1988-CATCHBASIN GREENBUSH ROAD.
 7. NO BUILDING PERMIT SHALL BE ISSUED UNTIL RESULTS OF TEST PITS HAVE BEEN SUBMITTED TO THE BUILDING DEPARTMENT.
 8. DURING THE COURSE OF CONSTRUCTION, ALL STORM DRAIN INLETS SHALL BE PROTECTED WITH A HALF BALE FILTER (SEE DETAIL).
 9. ALL AREAS DISTURBED BY ONSITE GRADING SHOULD BE LIMED AND FERTILIZED PRIOR TO SEEDING.
 10. THE NEW CORNERS OF ALL LOTS SHALL BE MARKED WITH METAL RODS 3/4" IN DIAMETER, AND AT LEAST 30" IN LENGTH (TO BE INSTALLED AFTER FINAL GRADING). SAID PINS SHOWN THIS: ●
 11. THIS SITE PLAN IS SUBJECT TO DETAILS OF GRADING, ROADS AND UTILITIES AS SHOWN ON CONSTRUCTION DRAWINGS APPROVED BY THE PLANNING BOARD AND IN ACCORDANCE WITH THE TOWN CLERK.
 12. SIDEWALKS AND CURBS SHALL BE INSTALLED IN ACCORDANCE WITH HIGHWAY DEPARTMENT SPECIFICATIONS.
 13. TEMPORARY SEDIMENT ENTRAPMENT AREAS SHALL BE PROVIDED AS SHOWN TO INTERCEPT AND CLARIFY SILT LADEN RUNOFF FROM THE SITE. THESE MAY BE EXCAVATED OR MAY BE CREATED UTILIZING UNBURNED BERMUS, LOGS, CRUSHED COTONWOOD DAMS, BALE BERMUS, OR OTHER SUITABLE MATERIALS. DIVERSION SWALES, BERMUS OR CHANNELIZATION SHALL BE CONSTRUCTED TO INSURE THAT ALL SILT AND SOIL WATERS ARE DIRECTED INTO THE ENTRAPMENT AREAS. WHICH SHALL NOT BE PERMITTED TO FILL IN, BUT SHALL BE CLEANED PERIODICALLY DURING THE COURSE OF CONSTRUCTION. THE COLLECTED SILT SHALL BE DEPOSITED IN AREAS SAFE FROM FURTHER EROSION.
 14. ALL DISTURBED AREAS, EXCEPT ROADWAYS, WHICH WILL REMAIN UNBURNED FOR PASTURE, SHALL BE RESEEDED WITH TEMPORARILY SEEDING WITH 1 LB. OF RYE GRASS OR MILUM WITH 100 LBS. OF STRAW OR HAY PER 1000 SQUARE FEET. ROADWAYS SHALL BE STABILIZED AS RAPIDLY AS PRACTICABLE BY THE INSTALLATION OF THE BASE COURSE.
 15. SILT THAT LEAVES THE SITE IN SPITE OF THE REQUIRED PRECAUTIONS SHALL BE COLLECTED AND REMOVED AS DIRECTED BY APPROPRIATE AGENCY OR AUTHORITY.
 16. AT THE COMPLETION OF THE PROJECT ALL TEMPORARY SILTATION DEVICES SHALL BE REMOVED AND THE AFFECTED AREAS REGRADED, PLANTED, OR TREATED IN ACCORDANCE WITH THE APPROVED SITE PLANS.
 17. PERMANENT VEGETATION COVER SPECIFICATIONS:
LAWN AREA - PER 1,000 S.F.
15 LBS. 10-6-4 SOX 50% SLOW RELEASE FERTILIZER
70 LBS. GRANULATE LIMESTONE
4 LBS. SEED MIXTURE
40% KENTUCKY BLUE
40% RED FESCUE
20% PERENNIAL RYEGRASS
 18. THIS PLAN DOES NOT CONFLICT WITH THE COUNTY OFFICIAL MAP AND HAS BEEN APPROVED IN THE MANNER SPECIFIED BY SECTION 239 L&M OF THE GENERAL MUNICIPAL LAW.
 19. CERTIFICATE OF OCCUPANCY SHALL NOT BE REQUESTED FROM THE TOWN OF ORANGETOWN BUILDING DEPARTMENT UNTIL RESULTS OF INFILTRATION AND EXFILTRATION TESTS FOR SANITARY SEWERS ARE CERTIFIED BY A NEW YORK STATE LICENSED PROFESSIONAL ENGINEER AND APPROVED BY THE DIRECTOR, DIVISION OF SEWERS.
 20. AT LEAST ONE WEEK PRIOR TO THE COMMENCEMENT OF ANY WORK, INCL. INSTALLATION OF EROSION CONTROL DEVICES OR THE REMOVAL OF TREES, A PRECONSTRUCTION MEETING MUST BE HELD WITH THE DEMONSTRATION STATE DEPARTMENT OF ENVIRONMENTAL CONSERVATION SUPERINTENDENT AND THE OFFICE OF BUILDING, ZONING AND PLANNING ADMINISTRATION AND ENFORCEMENT. IT IS THE RESPONSIBILITY PROJECT OWNER TO ARRANGE SUCH A MEETING.
 21. TREE PROTECTION:
A) TREE PROTECTION PROGRAM WILL BE IMPLEMENTED IN ORDER TO PROTECT AND PRESERVE BOTH INDIVIDUAL SPECIMEN TREES AND BUFFER AREAS WITH MATTER. WHICH WILL BE TAKEN TO PRESERVE AND PROTECT EXISTING TREES FOLLOWS:
A) NO CONSTRUCTION EQUIPMENT SHALL BE PARKED UNDER THE TREE CANOPY
B) THERE WILL BE NO EXCAVATION OR STOCKPILING OF EARTH UNDERNEATH
C) TREES TO BE PRESERVED SHALL BE MARKED CONSPICUOUSLY ON ALL DEEDS
D) TREES TO BE SAVED WILL BE FENCED AT THE OUTER DRIP LINE
E) NO EARTH FILL OR WATER 2' OR 6" IN DEPTH WILL BE MADE BENEATH ANY TREE
F) IN FILL AREAS, TREES TO BE PRESERVED SHALL BE FENCED OFF THROUGHOUT
G) IN CUT AREAS, TREES WILL BE PRESERVED WITH RETAINING WALLS
 22. ADDITIONAL CERTIFICATION, BY AN APPROPRIATE LICENSED OR CERTIFIED DRAINAGE ENGINEER, SHALL BE REQUIRED FOR ALL MATTERS BEFORE THE PLANNING BOARD AND DRAWINGS AND PROJECT ARE IN COMPLIANCE WITH THE STORMWATER MAN REGULATION.
 23. A DRAINAGE PERMIT IS REQUIRED FROM THE ROCKLAND COUNTY DRAINAGE DEPARTMENT IN ORDER TO OBTAIN A PERMIT TO DISCHARGE INTO THE TOWN OF ORANGETOWN BUILDING PERMIT.
 24. PRIOR TO ISSUANCE OF A CERTIFICATE OF OCCUPANCY, A FLOOD ELEVATION CERTIFICATE IS TO BE SUBMITTED TO THE TOWN OF ORANGETOWN BUILDING DEPARTMENT.

ZONE R-15, GROUP P	REQUIRED/ PERMITTED	EXISTING	PROPOSED
MAXIMUM FLOOR AREA RATIO	NONE	0.08	0.10
MINIMUM LOT AREA (SQ.FT.)	NONE	90,393 SQ.FT. (NET)	90,393 SQ.FT. (NET)
MINIMUM LOT WIDTH	NONE	N/A	N/A COR LOT
MINIMUM STREET FRONTAGE	50 FT.	158.7 FT.	266.7 FT.
FRONT YARD	100 FT.	65.7 FT.	88 FT. *
SIDE YARD	100 FT.	55.3 FT.	72 FT. *
TOTAL SIDE YARD	200 FT.	N/A COR LOT	N/A COR LOT
REAR YARD	100 FT.	N/A	N/A
MAXIMUM BUILDING HEIGHT	NONE	25 FT.	32 FT.

*—DENOTES VARIANCE REQUIRED

PARKING REQUIREMENTS: LOT AREA CALCULATIONS

NOT LISTED IN CODE
13 SPACES PROVIDED

GROSS LOT AREA = 90,393 SQ. FT.

LEGEND

LEGEND

- | | |
|--|---------------------------|
| | EXISTING 2" CONTOUR |
| | EXISTING 10" CONTOUR |
| | EXISTING WATERLINE |
| | EXISTING FIRE HYDRANT |
| | EXISTING GAS LINE |
| | EXISTING CATCH BASIN |
| | EXISTING STORM DRAIN |
| | EXISTING SEWER MANHOLE |
| | EXISTING SEWER LINE |
| | EXISTING SPOT ELEVATION |
| | EXISTING STONEWALL |
| | EXISTING SIGN |
| | EXISTING LIGHT POLE |
| | EXISTING UTILITY LOCATION |
| | LIMIT OF 100 YEAR FLOOD |
| | LIMIT OF 500 YEAR FLOOD |
| | PROPOSED GAS LINE |

THE EDUCATION LAW OF THE STATE OF NEW YORK PROHIBITS ANY PERSON ALTERING ANYTHING ON THESE EXAMINATIONS AND THE ACCOMPANYING SPECIFICATIONS, UNLESS IT IS UNDER THE DIRECTION OF A LICENSED PROFESSIONAL ENGINEER, WHERE SUCH ALTERATIONS ARE MADE, THE PROFESSIONAL ENGINEER MUST SIGN, SEAL, DATE AND FURNISH THE FULL EXTENT OF THE ALTERATION ON THE EXAMINATIONS AND/OR IN THE SPECIFICATIONS. (NYS EDUCATION LAW SECTION 7609-2)

STATE OF NEW YORK
RYAN A. NASHNER
Professional Engineer
No. 18066
Ryan A. Nashner

RYAN A. NASHNER, P.E.
N.Y.S.P.E.#IC NO. 89066


"UNAUTHORIZED ALTERATIONS OR ADDITIONS TO A SURVEY MAP BEARING THE
LOCATED LAND SURVEYORS' EMBOSSED SEAL IS A VIOLATION OF SECTIONS
7509, SUBSECTION 6, OF THE NEW YORK STATE EDUCATION LAW,
AND SECTION 8-100 OF THE GENERAL VEHICLE AND TRAFFIC LAW.
THE LAND SURVEYOR'S EMBOSSED SEAL ON THIS SURVEY MAP MARKED
WITH THE LAND SURVEYORS' EMBOSSED SEAL SHALL BE CONSIDERED TO
VOID THESE COPIES."

"CERTIFICATION INDICATED HEREON SHOWS THAT THIS SURVEY WAS
PREPARED IN ACCORDANCE WITH THE EXISTING CODE OF PRACTICE FOR
LAND SURVEYS ADOPTED BY THE DELAWARE - HUDSON LAND SURVEYORS'
ASSOCIATION, 201 CERTIFICATIONS SHALL FURNISH THE SAME TO THE
ASSOCIATION, 201 CERTIFICATIONS FOR KNOW THE SURVEY WAS PREPAR
CIFIC REASONS ARE NOT TRANSFERABLE TO ADDITIONAL INDIVIDUALS.
INSTITUTION, THEIR SUCCESSORS AND/OR ASSIONS OR SUBSEQUENT

STATE OF NEW YORK
JOHN R. ATZL

[Signature]

JOHN R. ATZL
N.Y.S. P.S. HC. NO. 50228

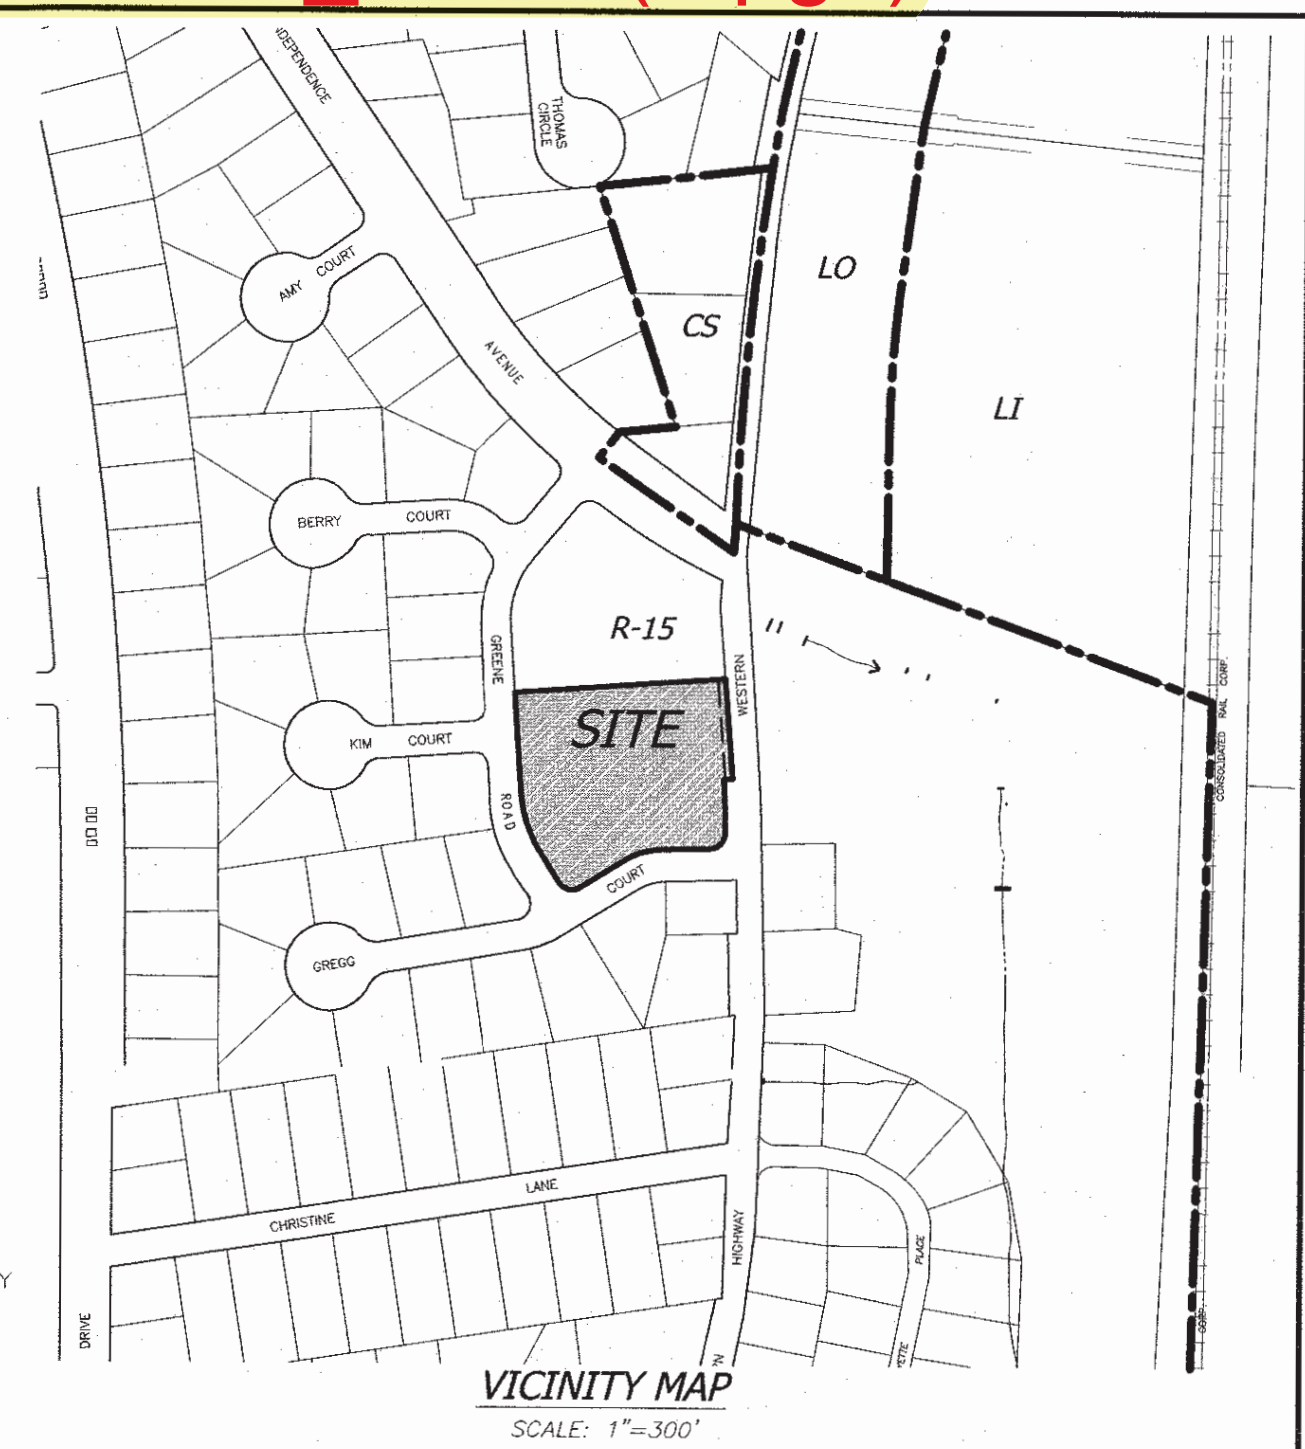

OWNER & APPLICANT:

TAPPAN FIRE DISTRICT
PO BOX 525
TAPPAN, NY 10983

TAX MAP REFERENCE:

TOWN OF ORANGETOWN
SECTION 74.18, BLOCK 2, LOTS 35

SITE ADDRESS:

TAPPAN FIRE DISTRICT
300 WESTERN HIGHWAY
TAPPAN, NY 10983

AREAS:

90,393 SQ.FT. OR 2.07 ACS

DISTRICTS:

SCHOOL DISTRICT - SOUTH ORANGETOWN
CENTRAL SCHOOL DISTRICT NO. 1
FIRE DISTRICT - TAPPAN
WATER DISTRICT - TAPPAN
SEWER DISTRICT - ORANGETOWN SEWER DISTRICT
LIGHTING DISTRICT - TOWN OF ORANGETOWN

DRAWING LIST

DRAWING No.	TITLE	ORIGIN DATE	LAST REVISION
DRAWING 1	SITE DEVELOPMENT PLAN	10-28-2021	07-15-2022
DRAWING 2	EXISTING CONDITION	10-28-2021	07-15-2022
DRAWING 3	GRADING PLAN	10-28-2021	07-15-2022
DRAWING 4	DETAIL	10-28-2021	07-15-2022
DRAWING 5	EROSION & SEDIMENT CONTROL PLAN	10-28-2021	07-15-2022
DRAWING 6	LANDSCAPING PLAN	10-28-2021	07-15-2022
DRAWING 7	LIGHTING PLAN	10-28-2021	07-15-2022

1	07-15-22	PER COMMENTS BY ARCHITECT
REVISION	DATE	DESCRIPTION



ATZL, NASHER & ZIGLER P.C.
ENGINEERS-SURVEYORS-PLANNERS

232 North Main Street
New City, New York 10956
Tel: (845) 634-4694
Fax: (845) 634-5543
E-mail: info@anzny.com
Web: www.ANZNY.com

PROJECT:

TAPPAN FIRE DISTRICT




TOWN OF ORANGETOWN
ROCKLAND COUNTY, NEW YORK

SITE DEVELOPMENT PLAN



DRAWN BY: LF	CHECKED BY: JRA
DATE: JUNE 24, 2022	SCALE: 1 IN. = 20 FT.
PROJECT NO:	DRAWING NO:

4924

1

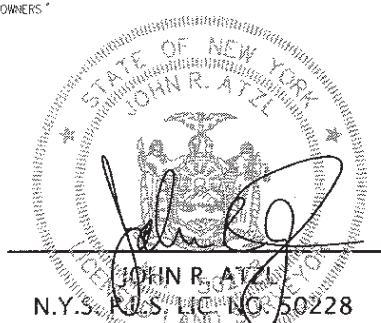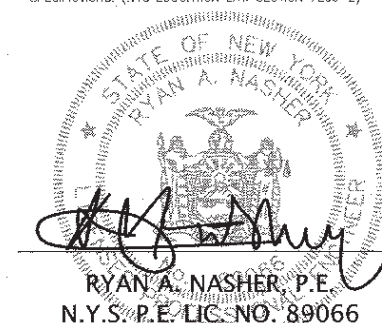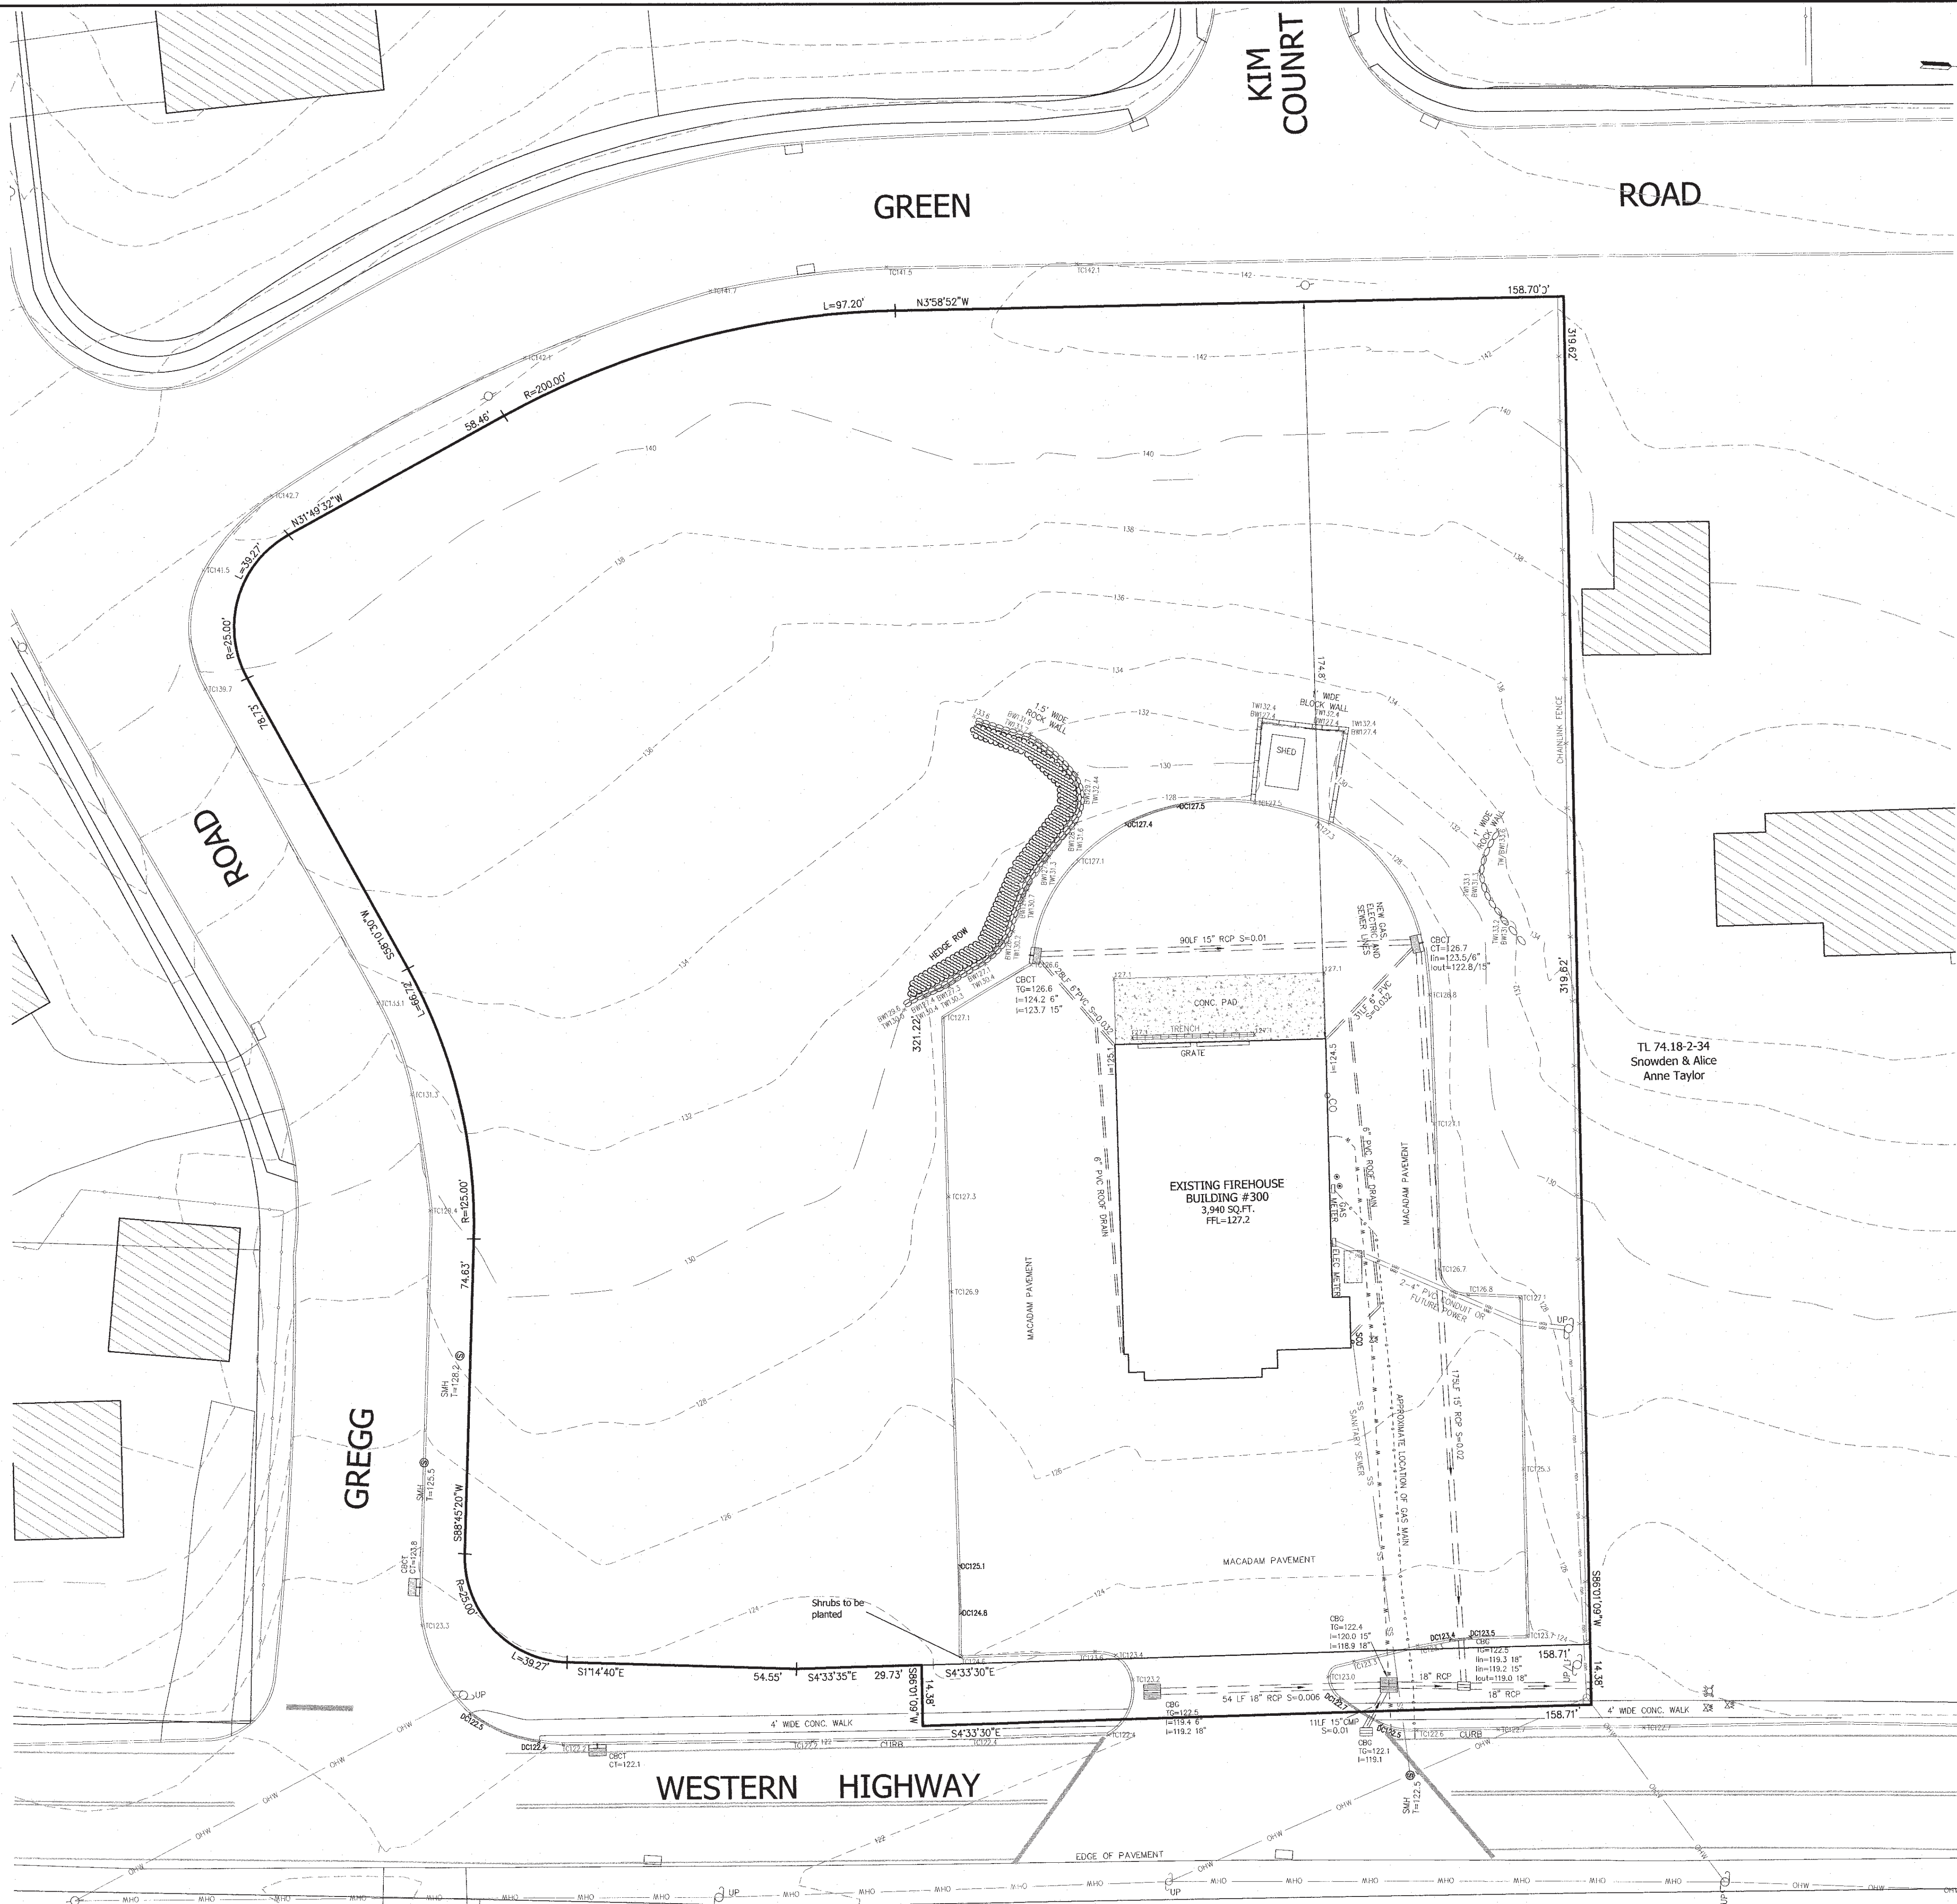

1	07-15-22	PER COMMENTS BY ARCHITECT
REVISION	DATE	DESCRIPTION
 ATZL, NASHER & ZIGLER P.C. ENGINEERS-SURVEYORS-PLANNERS 232 North Main Street New City, New York 10956 Tel: (845) 634-4694 Fax: (845) 634-5543 E-mail: info@anzny.com Web: www.ANZNY.com		
PROJECT: TAPPAN FIRE DISTRICT		
TOWN OF ORANGETOWN ROCKLAND COUNTY, NEW YORK		
TITLE: EXISTING CONDITION		
DRAWN BY: LF	CHECKED BY: JRA	
DATE: OCTOBER 28, 2021	SCALE: 1 IN. = 20 FT.	
PROJECT NO:	DRAWING NO:	
4924	2	

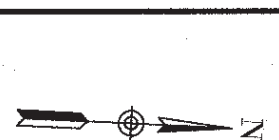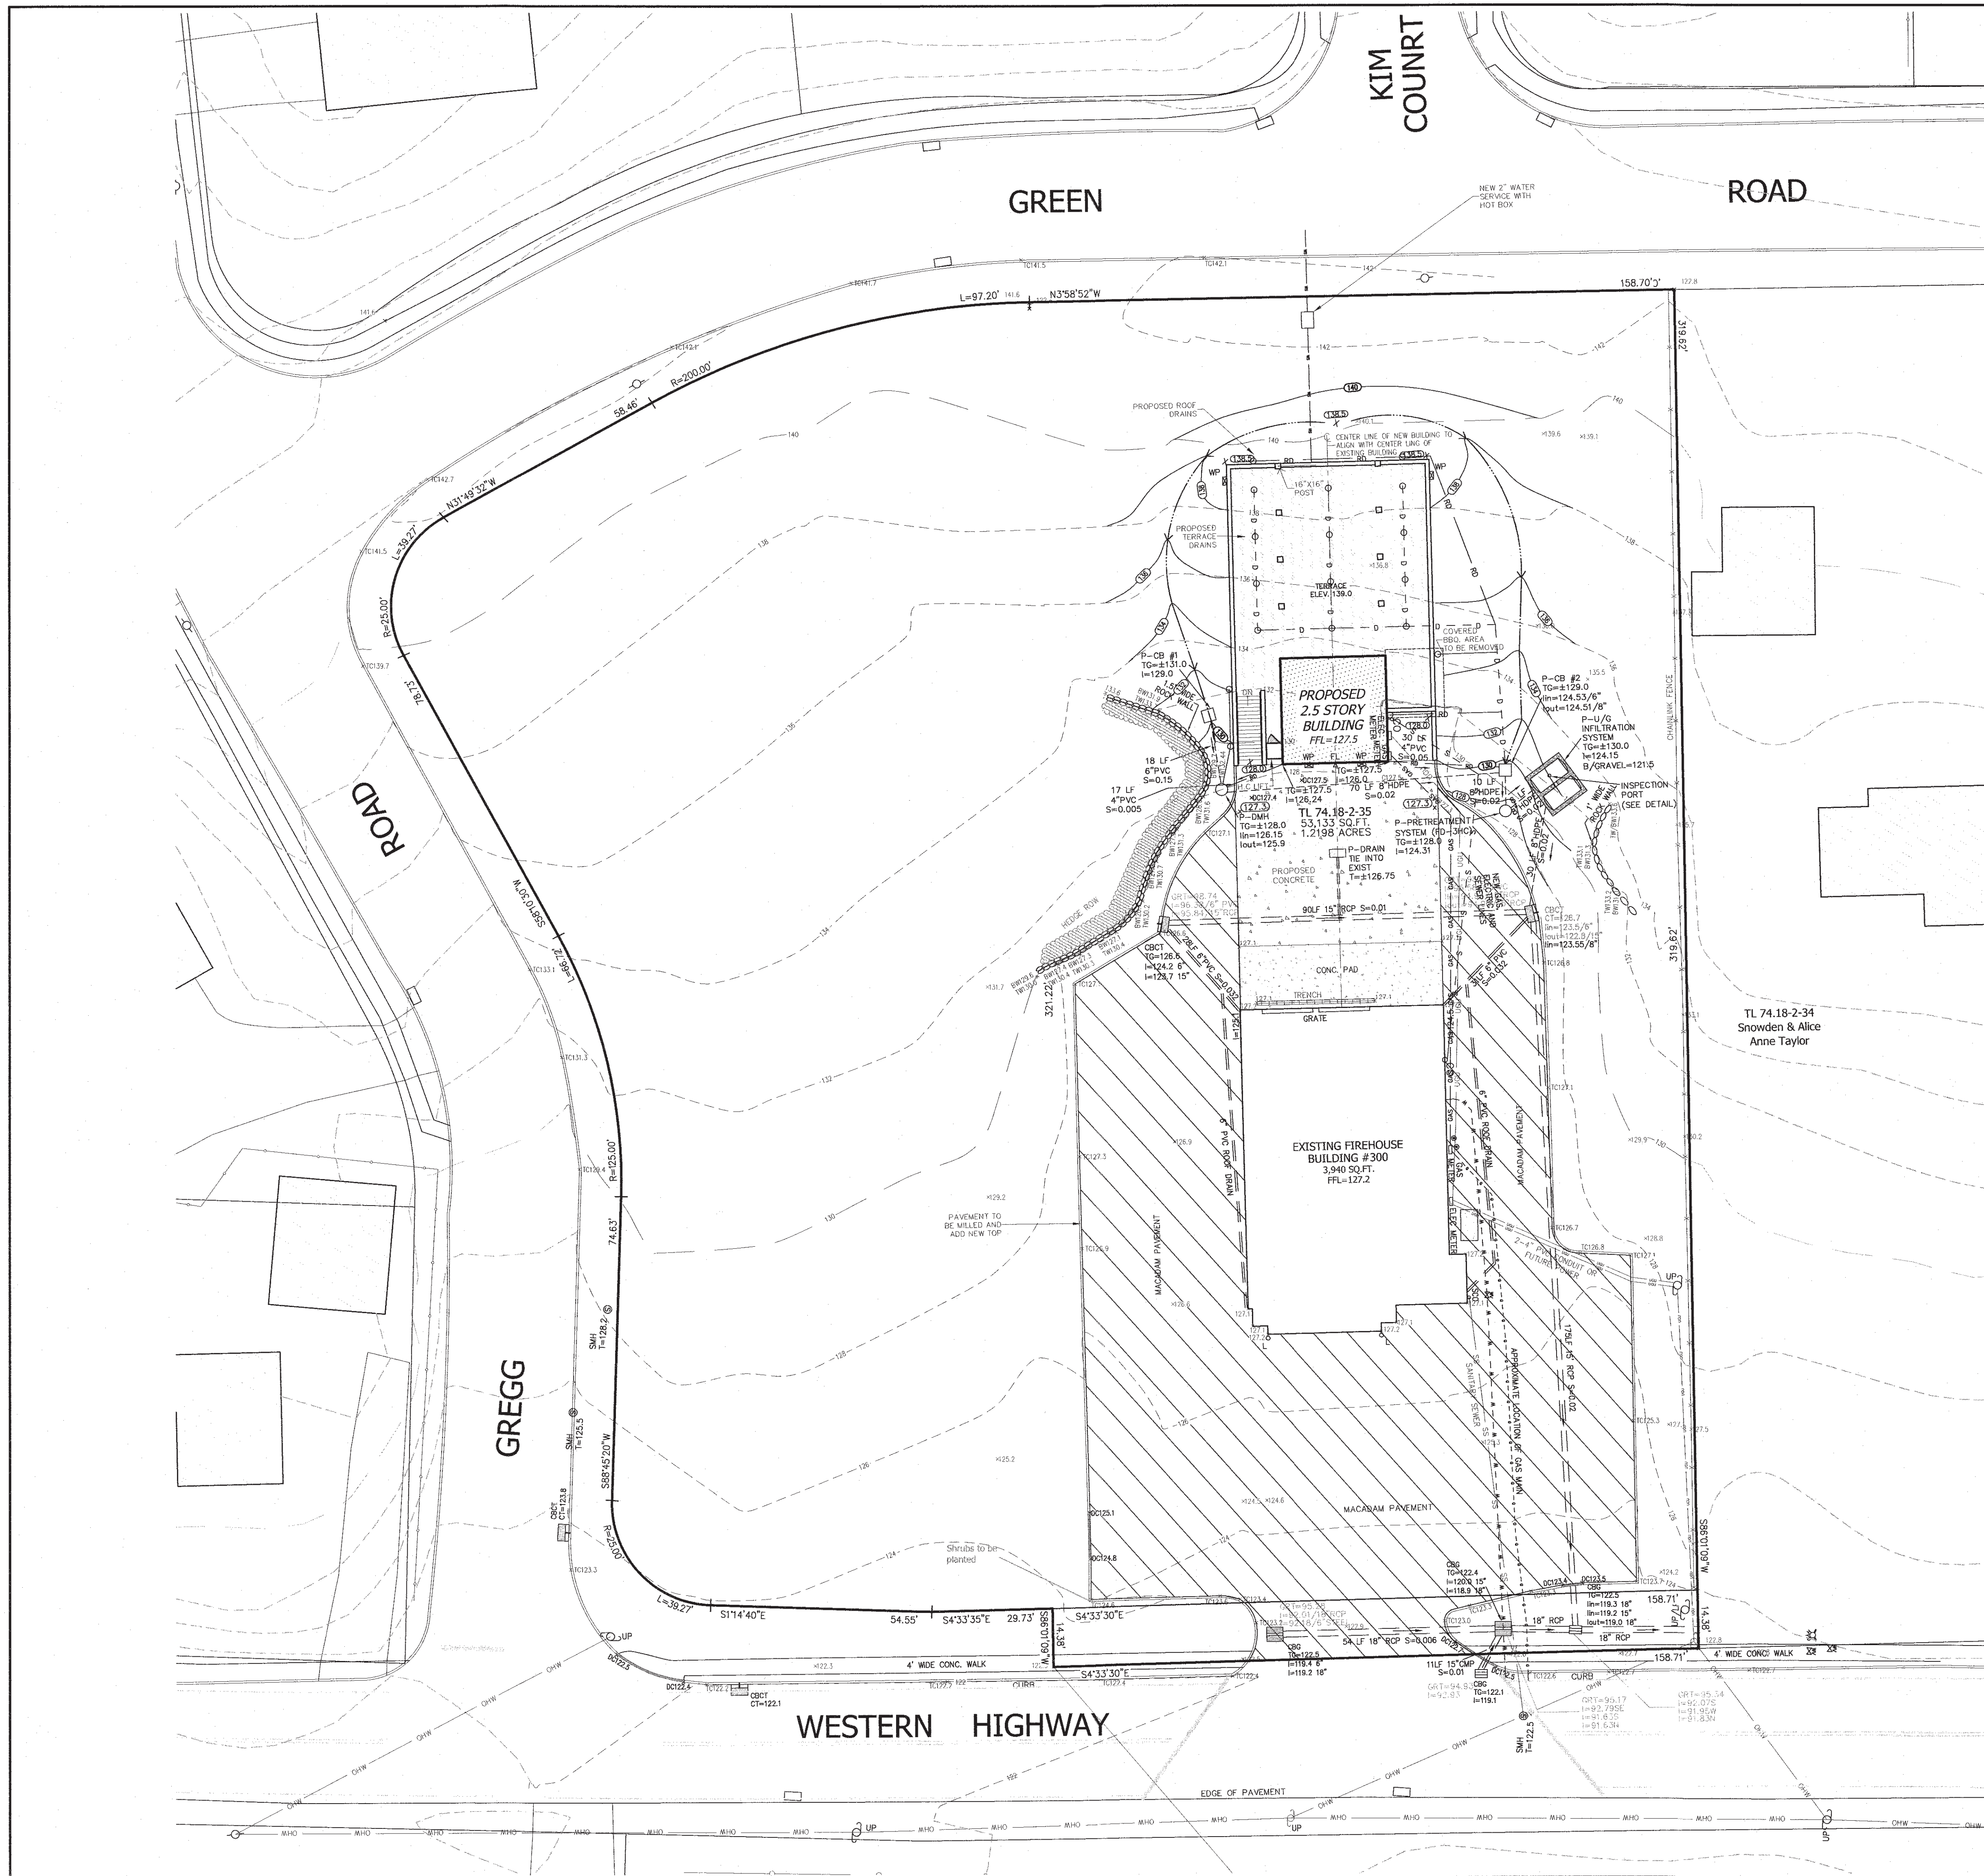




- LEGEND**
- 2' --- EXISTING 2' CONTOUR
 - 10' --- EXISTING 10' CONTOUR
 - W --- EXISTING WATERLINE
 - --- EXISTING FIRE HYDRANT
 - G --- EXISTING GAS LINE
 - CB --- EXISTING CATCH BASIN
 - --- EXISTING STORM DRAIN LINE
 - SMH --- EXISTING SEWER MANHOLE
 - --- EXISTING SEWER LINE
 - + 36.0 --- EXISTING SPOT ELEVATION
 - --- EXISTING STONEWALL
 - --- EXISTING SIGN
 - LP --- EXISTING LIGHT POLE
 - UP --- EXISTING UTILITY POLE
 - --- LIMIT OF 100 YEAR FLOODPLAIN
 - --- LIMIT OF 500 YEAR FLOODPLAIN
 - --- PROPOSED GAS LINE

THE EDUCATION LAW OF THE STATE OF NEW YORK PROVIDES THAT ANY PERSON ASSUMING ANYTHING ON THESE DRAWINGS AND/OR SPECIFICATIONS WITHOUT BEING A LICENSED PROFESSIONAL ENGINEER, ARCHITECT, SURVEYOR, OR PLANNER, SHALL BE CONSIDERED TO BE IN VIOLATION OF THE EDUCATION LAW OF THE STATE OF NEW YORK. THE EDUCATION LAW OF THE STATE OF NEW YORK PROVIDES THAT ANY PERSON ASSUMING ANYTHING ON THESE DRAWINGS AND/OR SPECIFICATIONS WITHOUT BEING A LICENSED PROFESSIONAL ENGINEER, ARCHITECT, SURVEYOR, OR PLANNER, SHALL BE CONSIDERED TO BE IN VIOLATION OF THE EDUCATION LAW OF THE STATE OF NEW YORK.

RYAN A. NASHER, P.E.
N.Y.S. P.E. LIC. NO. 89066

JOHN R. ATZL, P.E.
N.Y.S. P.E. LIC. NO. 30228

1	07-15-22	PER COMMENTS BY ARCHITECT
REVISION	DATE	DESCRIPTION
 ATZL, NASHER & ZIGLER P.C. ENGINEERS-SURVEYORS-PLANNERS 232 North Main Street New City, New York 10956 Tel: (845) 634-4694 Fax: (845) 634-5543 E-mail: info@anzny.com Web: www.ANZNY.com		
PROJECT: TAPPAN FIRE DISTRICT		
TOWN OF ORANGETOWN ROCKLAND COUNTY, NEW YORK		
TITLE: GRADING PLAN		
DRAWN BY: LF	CHECKED BY: JRA	
DATE: OCTOBER 28, 2021	SCALE: 1 IN. = 20 FT.	
PROJECT NO: 4924	DRAWING NO: 3	

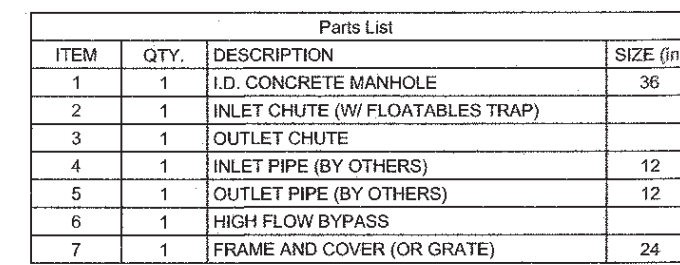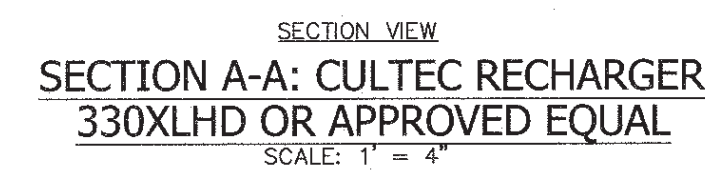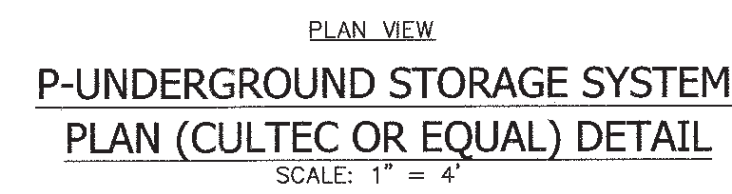

- CAPACITIES:**
1. PEAK HYDRAULIC FLOW: 15.0 cfs (424 l/s)
 2. TYPICAL TREATMENT FLOW: 0.84 cfs (23.78 l/s)
 3. SEDIMENT STORAGE CAPACITY: 0.4 cu. yd. (0.3 cu. m.)
 4. OIL STORAGE CAPACITY: 125 gal. (473 liters)
 5. MAXIMUM INLET/OUTLET PIPE DIAMETERS: 18 in. (450 mm)

SCALE: N.T.S.



"UNAUTHORIZED ALTERATIONS OR ADDITIONS TO A SURVEY MAP BEARING A LICENSED LAND SURVEYOR'S EMBOSSED SEAL IS A VIOLATION OF SECTION 2, ARTICLE 2, SUBSECTION 2, OF THE NEW YORK STATE CONSTITUTION. ANY CHANGES FROM THE ORIGINAL TRACING OF THIS SURVEY MAP MARKED WITH THE LAND SURVEYOR'S EMBOSSED SEAL SHALL BE CONSIDERED TO BE FALSE TRUE COPIES."

"CERTIFICATION INDICATED HERE ON SURVEY THAT THIS SURVEY WAS PREPARED IN ACCORDANCE WITH THE ENGINEERING CODE OF PRACTICE FOR LAND SURVEYING ADOPTED BY THE DELAWARE - HUSKON LAND SURVEYORS ASSOCIATION. SAID CERTIFICATIONS SHALL RUN ONLY TO THOSE NAMED INDIVIDUALS AND/OR INSTITUTIONS FOR WHOM THE SURVEY WAS PREPARED. CERTIFICATIONS ARE NOT TRANSFERABLE TO ANY OTHER INDIVIDUALS, INSTITUTIONS, THEIR SUCCESSORS AND/OR ASSOCIATES OR SUBSEQUENT OWNERS."

THE EDUCATION LAW OF THE STATE OF NEW YORK PROHIBITS ANY PERSON ALTERING ANYTHING ON THESE DRAWINGS AS THE ACCOMPANYING SPECIFICATIONS, UNLESS IT IS UNDER THE DIRECTION OF A LICENSED PROFESSIONAL ENGINEER. WHEN SUCH ALTERATIONS ARE MADE, THE PROFESSIONAL ENGINEER MUST SIGN, SEAL, DATE AND DESCRIBE THE FULL EXTENT OF THE ALTERATION ON THE DRAWINGS AND/OR IN THE SPECIFICATIONS. (NYS EDUCATION LAW SECTION 7200-3)

OFFICE OF THE
COMPTROLLER OF THE STATE OF NEW YORK
DIVISION OF PROFESSIONAL SERVICES
100 NASSAU ST., 10TH FLOOR, NEW YORK, N.Y. 10038
TEL: (212) 463-3333 FAX: (212) 463-3334

[Signature]



RYAN A. NASHER, P.E.
N.Y.S. P.E. LIC. NO. 89066



 JOHN R. ATZL

 N.Y.S. P.L.S. LIC. NO: 50228

1	07-15-22	PER COMMENTS BY ARCHITECT
REVISION	DATE	DESCRIPTION
		
ATZL, NASHER & ZIGLER P.C. ENGINEERS - SURVEYORS - PLANNERS		
232 North Main Street New City, New York 10956 Tel: (845) 634-4694 Fax: (845) 634-5543 E-mail: info@anzny.com Web: www.ANZNY.com		
PROJECT:		
TAPPAN FIRE DISTRICT		
TOWN OF ORANGETOWN ROCKLAND COUNTY, NEW YORK		
TITLE:		
DETAILS		
DRAWN BY: LF	CHECKED BY: JRA	
DATE: OCTOBER 28, 2021	SCALE: 1 IN. = 20 FT.	
PROJECT NO:	DRAWING NO:	
4924	4	

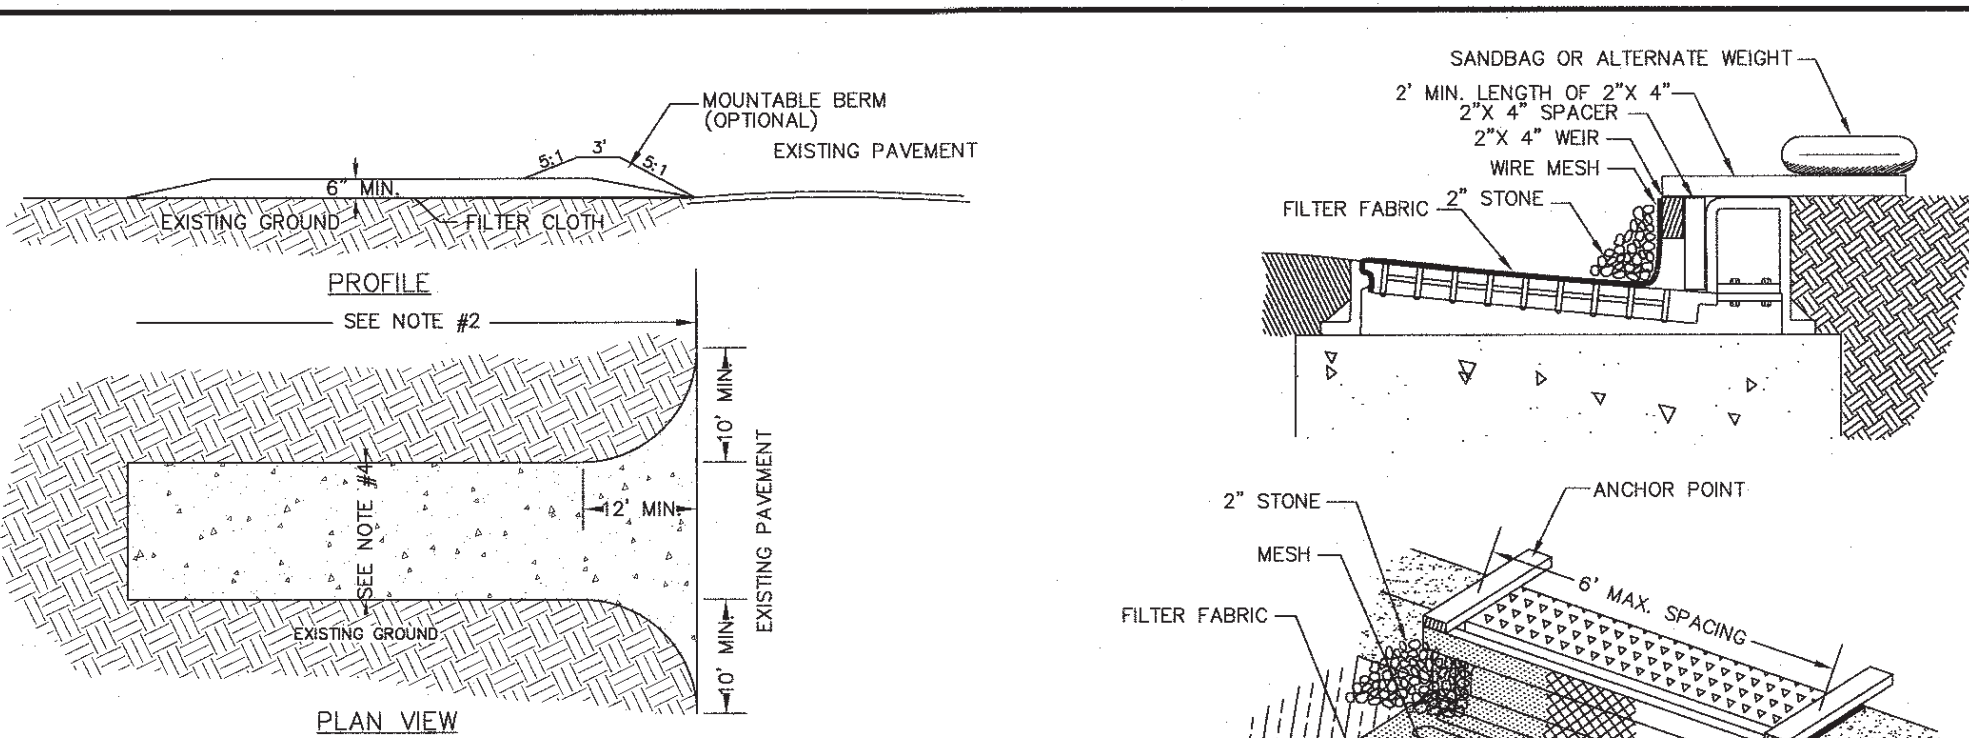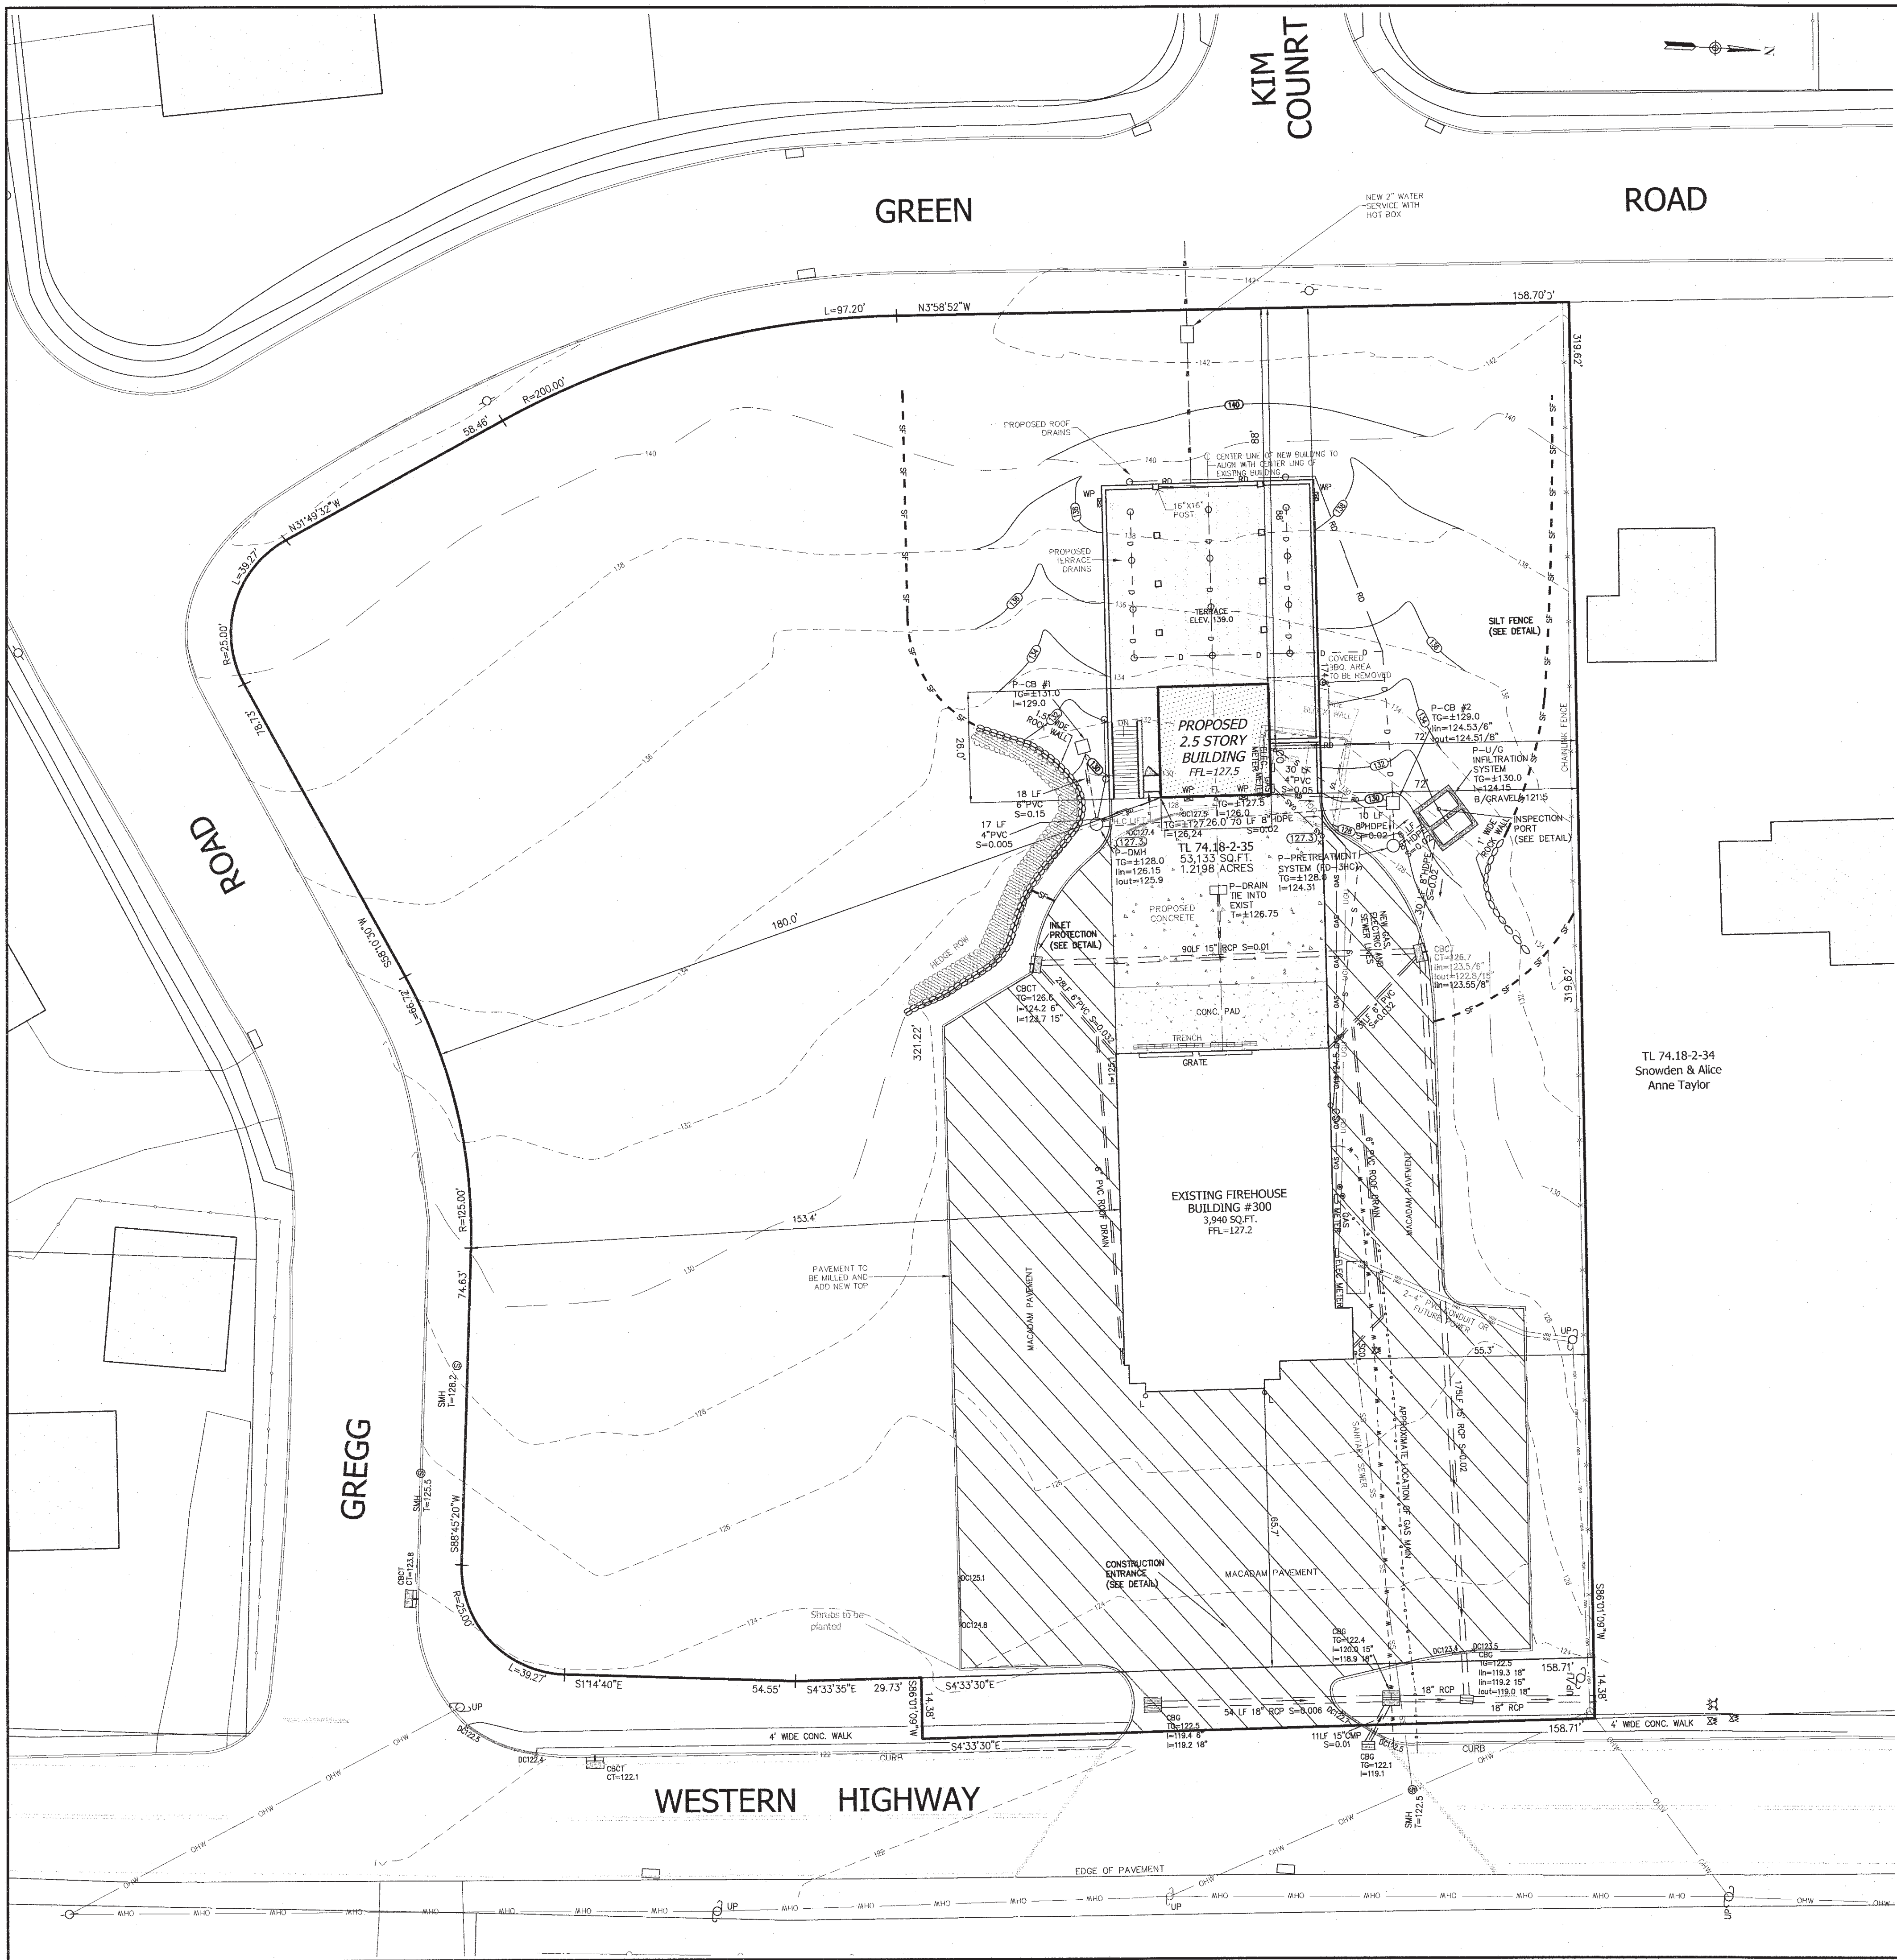

SPECIFICATIONS FOR CONSTRUCTION ENTRANCE


- STONE SIZE - USE 2" STONE, OR RECLAIMED OR RECYCLED CONCRETE EQUIVALENT.
- LENGTH - NOT LESS THAN 50 FT. (EXCEPT ON A SINGLE RESIDENCE LOT WHERE A 30 FT. MINIMUM LENGTH WOULD APPLY).
- THICKNESS - NOT LESS THAN 6 IN.
- WIDTH - 12 FT. MINIMUM, BUT NOT LESS THAN THE FULL WIDTH AT POINTS WHERE INGRESS AND EGRESS OCCUR. 24" IF SINGLE ENTRANCE TO SITE.
- FILTER CLOTH - WILL BE PLACED OVER THE ENTIRE AREA PRIOR TO THE PLACEMENT OF STONE.
- SURFACE WATER - ALL SURFACE WATER FLOWING OR DIVERTED TOWARD CONSTRUCTION ENTRANCES SHALL BE PIPED ACROSS THE ENTRANCE. PIPING IS IMPRACTICAL, A MOUNTABLE BERM WITH 5:1 SLOPES WILL BE PERMITTED.
- MAINTENANCE - THE ENTRANCE SHALL BE MAINTAINED IN A CONDITION WHICH WILL PREVENT TRACKING OR FLOWING OF SEDIMENT INTO ADJACENT RIGHT-OF-WAY. ALL SEDIMENT SPILLED, DROPPED, WASHED, OR TRACKED ONTO PUBLIC RIGHT-OF-WAYS MUST BE REMOVED IMMEDIATELY.
- WHEN WASHING IS REQUIRED, IT SHALL BE DONE ON AN AREA STABILIZED WITH STONE AND WHICH DRAINS TO AN APPROVED SEDIMENT TRAPPING DEVICE.
- PERIODIC INSPECTION AND NEEDED MAINTENANCE SHALL BE PROVIDED AFTER EACH RAIN.

CONSTRUCTION ENTRANCE DETAIL

N.T.S.

PREFABRICATED UNIT: GEOFAB, ENVIROFENCE, OR APPROVED EQUAL.

- WHEN TWO SECTIONS OF FILTER CLOTH ADJOIN EACH OTHER THEY SHALL BE OVERLAPPED BY SIX INCHES AND FOLDED.
- MAINTENANCE SHALL BE PERFORMED AS NEEDED AND MATERIAL REMOVED WHEN "BULGES" DEVELOP IN THE SILT FENCE.

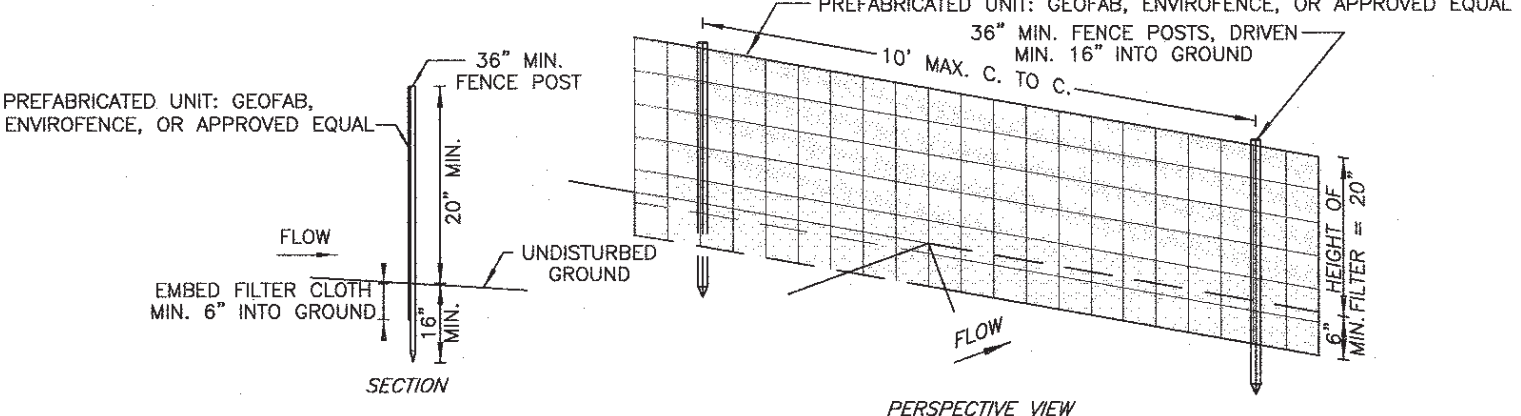

SILT FENCE DETAIL

N.T.S.

GENERAL SOIL RESTORATION NOTES AND REQUIREMENTS:

- Soil restoration is not required to the area where no soil disturbance is proposed.
- Soil restoration is not required to the area where minimal soil disturbance is proposed such as clearing and grubbing.
- Aerate and apply 6 inch of top soil to areas where topsoil is stripped only and no change in grade. Aeration includes the use of machines such as tractor-drawn implements with coulters making a narrow slit in the soil, a roller with many spikes making indentations in the soil, or prongs which function like a mini-subsoiler.
- Soil Restoration (de-compaction and compost enhancement) is required to areas where cut and fill are proposed.
- Soil Restoration (de-compaction and compost enhancement) is required to areas where heavy traffic areas on site, especially in a zone 5-25 feet around buildings but not within a 5 feet perimeter around foundation wall.
- Soil Restoration (de-compaction and compost enhancement) is required on redevelopment projects in areas where existing impervious area will be converted to pervious area. During periods of relatively low to moderate subsoil moisture, the disturbed subsoils are returned to rough grade and the following Soil Restoration steps applied:
 - Apply 3 inches of compost over subsoil
 - Till compost into subsoil to a depth of at least 12 inches using a cat-mounted ripper, tractor-mounted disc, or tiller, mixing, and circulating air and compost into subsoils
 - Rock-pick until uplifted stone/rock materials of four inches and larger size are cleaned off the site
 - Apply topsoil to a depth of 6 inches
 - Vegetate as required by approved plan.

LEGEND


- 362 --- EXISTING 2' CONTOUR
- 360 --- EXISTING 10' CONTOUR
- W --- EXISTING WATERLINE
- G --- EXISTING GAS LINE
- CB --- EXISTING CATCH BASIN
- SMH --- EXISTING SEWER MANHOLE
- S --- EXISTING SEWER LINE
- SPT --- EXISTING SPOT ELEVATION
- STW --- EXISTING STONEWALL
- SIG --- EXISTING SIGN
- LPO --- EXISTING LIGHT POLE
- UPO --- EXISTING UTILITY POLE
- 100 --- LIMIT OF 100 YEAR FLOODPLAIN
- 500 --- LIMIT OF 500 YEAR FLOODPLAIN
- GAS --- PROPOSED GAS LINE

THE EDUCATION LAW OF THE STATE OF NEW YORK PROHIBITS ANY PERSON, INCLUDING ANY ENGINEER OR SURVEYOR, FROM SEALING OR SIGNING ANY DRAWING OR SPECIFICATION, UNLESS IT IS UNDER THE DIRECTION OF A LICENSED PROFESSIONAL ENGINEER. THESE RULES SHALL APPLY TO ALL DRAWINGS AND SPECIFICATIONS, INCLUDING ANY DRAWING OR SPECIFICATION THAT IS PREPARED BY AN ENGINEER OR SURVEYOR AND IS USED IN CONNECTION WITH ANY PROJECT. ANY VIOLATION OF THESE RULES IS A VIOLATION OF THE EDUCATION LAW OF THE STATE OF NEW YORK AND IS A CRIMINAL OFFENSE.

RYAN A. NASHER, P.E.
N.Y.S. P.E. LIC. NO. 89066

JOHN R. ATZL
N.Y.S. P.E. LIC. NO. 50228

1	07-15-22	PER COMMENTS BY ARCHITECT
REVISION	DATE	DESCRIPTION
 ATZL, NASHER & ZIGLER P.C. ENGINEERS-SURVEYORS-PLANNERS 232 North Main Street New City, New York 10956 Tel: (845) 634-4694 Fax: (845) 634-5543 E-mail: info@anzny.com Web: www.ANZNY.com		
PROJECT: TAPPAN FIRE DISTRICT		
TOWN OF ORANGETOWN ROCKLAND COUNTY, NEW YORK		
TITLE: EROSION & SEDIMENT CONTROL PLAN		
DRAWN BY: MM	CHECKED BY: JRA	
DATE: OCTOBER 28, 2021	SCALE: 1 IN. = 20 FT.	
PROJECT NO:	DRAWING NO:	
4924	5	

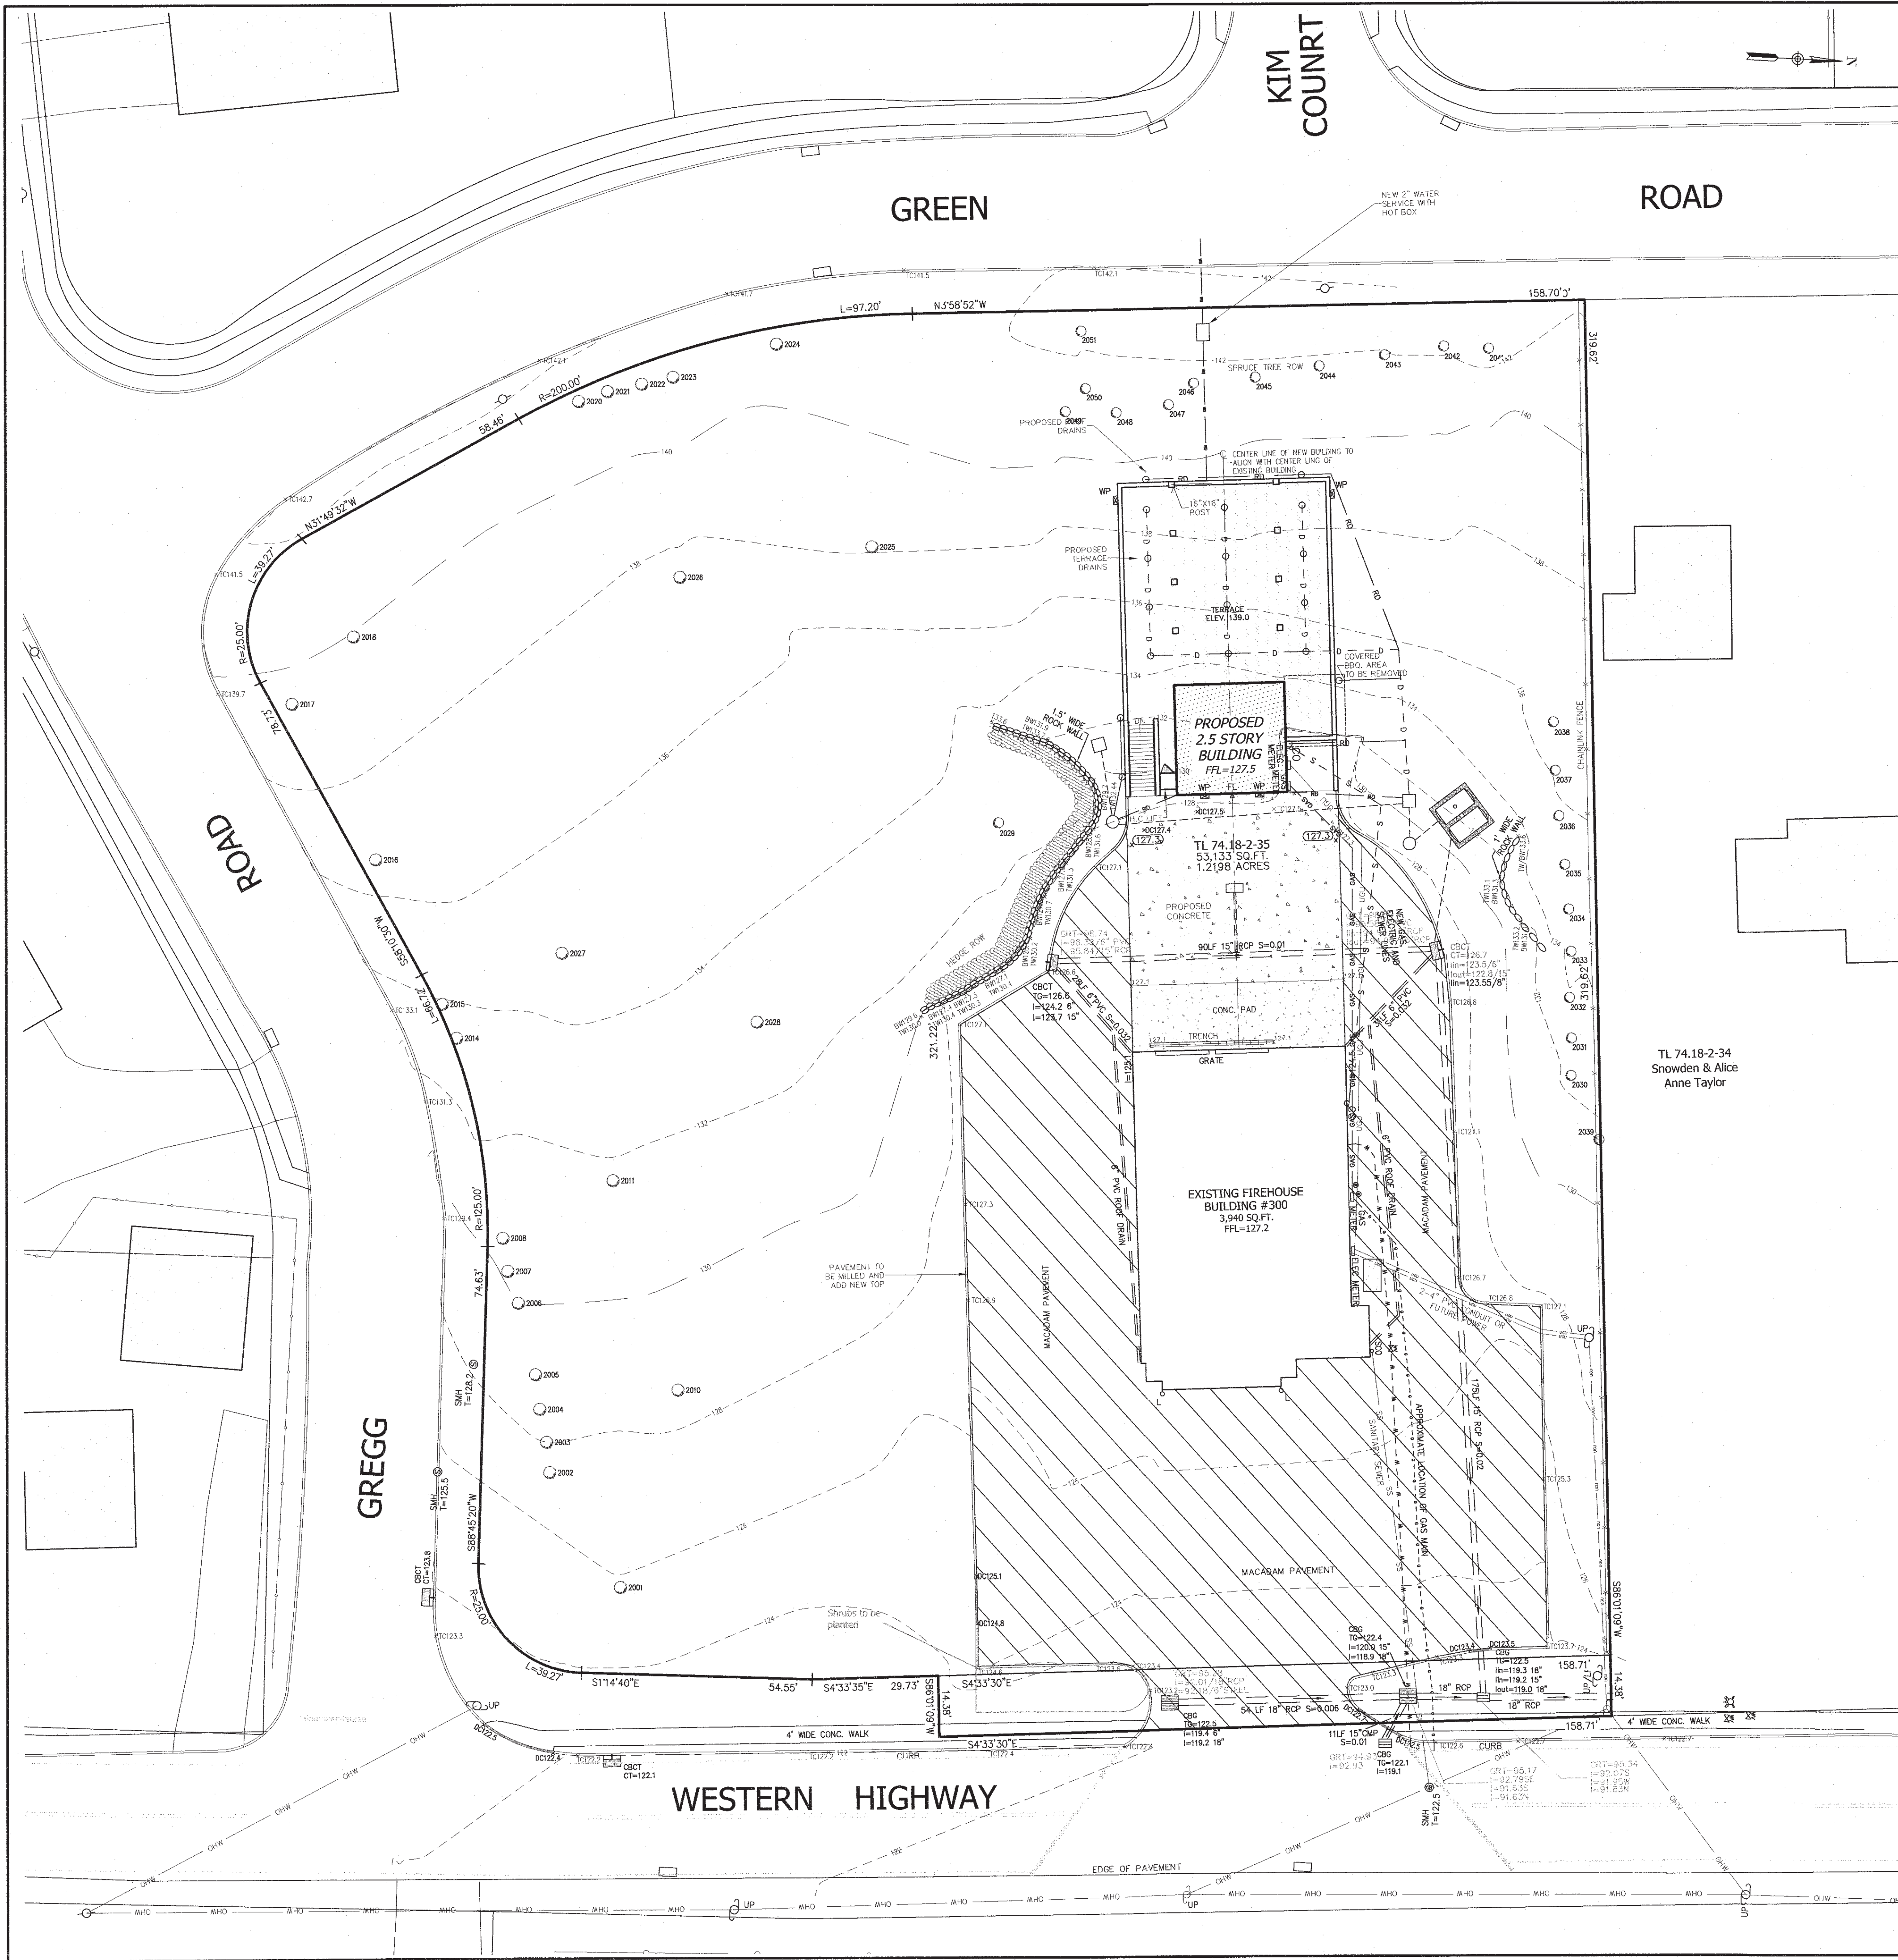

LEGEND

- EXISTING 2" CONTOUR
- EXISTING 10' CONTOUR
- EXISTING WATERLINE
- EXISTING FIRE HYDRANT
- EXISTING GAS LINE
- EXISTING CATCH BASIN
- EXISTING STORM DRAIN LINE
- EXISTING SEWER MANHOLE
- EXISTING SEWER LINE
- EXISTING SPOT ELEVATION
- EXISTING STONEWALL
- EXISTING SIGN
- EXISTING LIGHT POLE
- EXISTING UTILITY POLE
- LIMIT OF 100 YEAR FLOODPLAIN
- LIMIT OF 500 YEAR FLOODPLAIN
- GAS
- PROPOSED GAS LINE

PLANTING NOTES


- ALL PLANTS SHALL BE NURSERY GROWN AND PLANTS AND WORKMANSHIP SHALL CONFORM TO THE AMERICAN ASSOCIATION OF NURSERYMEN STANDARDS AND SHALL BE SUBJECT TO THE APPROVAL OF THE LANDSCAPE ARCHITECT BEFORE AND AFTER PLANTING.
- ALL PLANTING SHALL BE PLACED UNDER THE DIRECTION OF THE LANDSCAPE ARCHITECT. GIVE 48 HOURS NOTICE BEFORE PLANTING.
- GUARANTEE ALL PLANTS AND WORKMANSHIP FOR A PERIOD OF TWO PLANTING SEASONS (ONE FULL YEAR).
- PLACE 4" OF TOPSOIL ON ALL LAWN AREAS AND 12" TOP SOIL IN ALL PLANTING BEDS.
- PLANT PITS SHALL BE 36" WIDER FOR TREES (MINIMUM OF TWO TIMES ROOT BALL DIAMETER) AND 24" WIDER FOR SHRUBS AND 6" DEEPER THAN THE ROOT BALL. SET PLANTS AT SAME LEVEL AS ORIGINALLY GROWN ON BASE OF UNDISTURBED SOIL. REMOVE ALL EXISTING SOIL FROM PLANT PIT AND BACKFILL WITH A MIXTURE OF ONE PART PEAT HUMUS, ONE PART DEHYDRATED COW MANURE, AND FOUR PARTS TOPSOIL. FERTILIZE ALL PLANTS WITH 2 TO 3 OZ. PER FOOT OF SHRUB HEIGHT AND 2 TO 3 LBS. PER INCH OF TREE TRUNK OF 5-10-5 FERTILIZER. FOR EVERGREEN PLANTING, ADD 1 LB. PER 100 SQUARE FEET OF PLANT BED EACH OF AMMONIUM SULFATE AND SUPERPHOSPHATE.
- STAKE ALL TREES WITH TWO CEDAR STAKES. COVER TWISTED 10 GAGE GALVANIZED WIRE WITH RUBBER HOSE AND FASTEN AROUND TREE AT 5 FOOT HEIGHT MINIMUM. WRAP TRUNK WITH KRAFT PAPER TO FIRST BRANCH. REMOVE WIRES AND STAKES AFTER THE ONE YEAR.
- MULCH ALL PLANTS AND PLANTED AREAS WITH A 4" DEPTH OF SHREDDED PINE, OAK BARK.
- FERTILIZE AREAS BEFORE SEEDING OR SODDING WITH 15 LBS. PER 1000 SQUARE FEET OF 10-20-10 FERTILIZER OR APPROVED EQUIVALENT. REPEAT AFTER 8 WEEKS.
- LAWN AREAS SHALL BE SEED AT 5 LBS. PER 1000 SQUARE FEET WITH THE FOLLOWING SEED MIX: 40% JAMES TOWN CHEWINGS FESCUE, 40% BARON KENTUCKY BLUEGRASS, AND 20% YORKTOWN PERENNIAL RYE. MULCH NEWLY SEED LAWN AT 90 LBS. PER 1000 SQUARE FEET WITH HAY OR STRAW MULCH.
- THE CONTRACTOR IS RESPONSIBLE TO PLANT THE TOTAL QUANTITIES OF ALL PLANTS SHOWN ON THE PLANTING PLAN. THE QUANTITIES OF PLANTING SHOWN GRAPHICALLY ON THE PLAN SHALL GOVERN.
- EXISTING TREES SHOWN ON THIS PLAN ARE TO REMAIN UNDISTURBED. ALL EXISTING TREES SHOWN TO REMAIN ARE TO BE PROTECTED WITH A 4 FOOT HIGH SNOW FENCE PLACED AT THE DRIP LINE OF THE BRANCHES OR AT 6 FEET MINIMUM FROM THE TREE TRUNK.

TREE LIST

NO.	SIZE	TYPE	CONDITION
2001	18"	MAPLE	GOOD
2002	11"	TRIPLEMAPLE	GOOD
2003	19"	TWIN MAPLE	GOOD
2004	21"	QUAD MAPLE	GOOD
2005	24"	MAPLE	GOOD
2006	12"	TRIPLE MAPLE	GOOD
2007	12"	TRIPLE MAPLE	GOOD
2008	14"	QUADMAPLE	GOOD
2010	26"	MAPLE	GOOD
2011	20"	MAPLE	GOOD
2014	16"	TRIPLE MAPLE	GOOD
2015	12"	QUAD MAPLE	GOOD
2016	30"	MAPLE	GOOD
2017	12"	TRIPLE MAPLE	GOOD
2018	16"	MAPLE	GOOD
2020	10"	MAPLE	POOR
2021	12"	MAPLE	GOOD
2022	6"	CLUMP MAPLE	GOOD
2023	22"	TWIN MAPLE	GOOD
2024	21"	TRIPLE MAPLE	GOOD
2025	27"	MAPLE	GOOD
2026	23"	MAPLE	GOOD
2027	24"	SYCAMORE	GOOD
2028	15"	MAPLE	GOOD
2029	48"	OAK	GOOD
2030	7"	FIR	GOOD
2031	10"	FIR	GOOD
2032	12"	FIR	GOOD
2033	8"	FIR	GOOD
2034	10"	FIR	GOOD
2035	9"	FIR	GOOD
2036	9"	FIR	GOOD
2037	7"	FIR	GOOD
2038	10"	FIR	GOOD
2039	15"	BIRCH	GOOD
2041	8"	FIR	GOOD
2042	11"	FIR	GOOD
2043	11"	FIR	GOOD
2044	12"	FIR	GOOD
2045	12"	FIR	GOOD
2046	11"	FIR	GOOD
2047	8"	FIR	GOOD
2048	8"	FIR	GOOD
2049	12"	FIR	GOOD
2050	8"	FIR	GOOD
2051	19"	ASH	GOOD

TREE LEGEND

- EXISTING TREE
- TREE TO BE PRESERVED
- TREE TO BE REMOVED

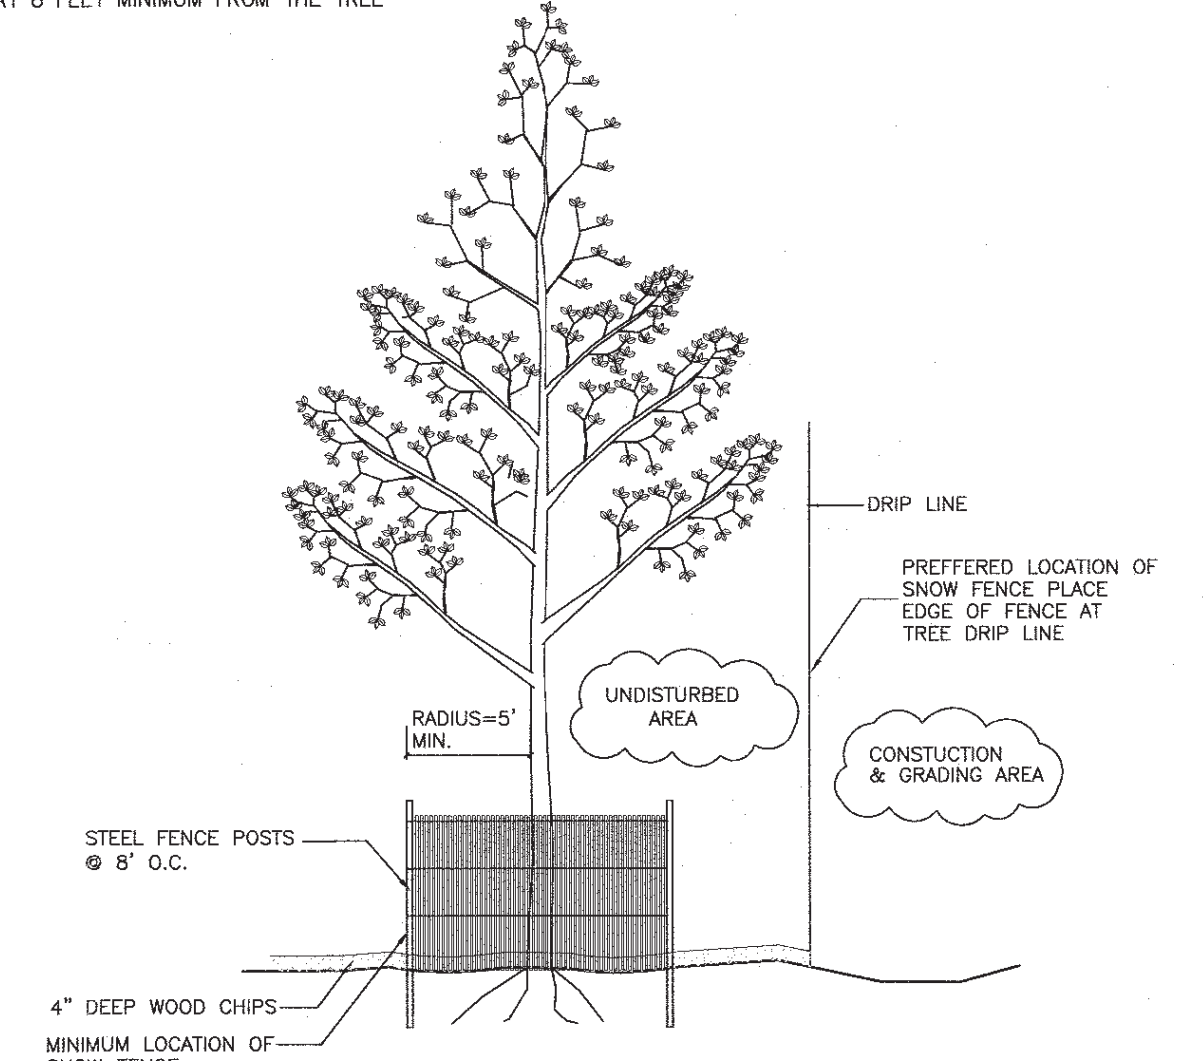

NOTES:

- INSTALL SNOW FENCE TREE PROTECTION PRIOR TO ANY CLEARING OR EXCAVATION.
- MAINTAIN SNOW FENCE FOR THE DURATION OF THE CONSTRUCTION PERIOD.

TREE PROTECTION DETAIL

N.T.S.

107-15-22PER COMMENTS BY ARCHITECT

REVISIONDATEDESCRIPTION

ATZL, NASHER & ZIGLER P.C.
ENGINEERS-SURVEYORS-PLANNERS
232 North Main Street
New City, New York 10956
Tel: (845) 634-4894
Fax: (845) 634-5543
E-mail: info@anzny.com
Web: www.ANZNY.com

PROJECT:
TAPPAN FIRE DISTRICT


**TOWN OF ORANGETOWN
ROCKLAND COUNTY, NEW YORK**

TITLE:
TREE PLAN

DRAWN BY: LF
DATE: OCTOBER 28, 2021
PROJECT NO:
4924

CHECKED BY: JRA
SCALE: 1 IN. = 20 FT.
DRAWING NO:
6

THE EDUCATION LAW OF THE STATE OF NEW YORK PRESCRIBES THAT NO PERSON SHALL SIGN ANY ARCHITECTURAL OR ENGINEERING DRAWING OR SPECIFICATION UNLESS HE OR SHE IS A LICENSED PROFESSIONAL ENGINEER OR ARCHITECT AND HIS OR HER NAME IS PLACED THEREON IN THE MANNER AND FORM PRESCRIBED BY THE EDUCATION LAW OF THE STATE OF NEW YORK AND THE REGULATIONS OF THE BOARD OF REGENTS OF THE STATE OF NEW YORK.

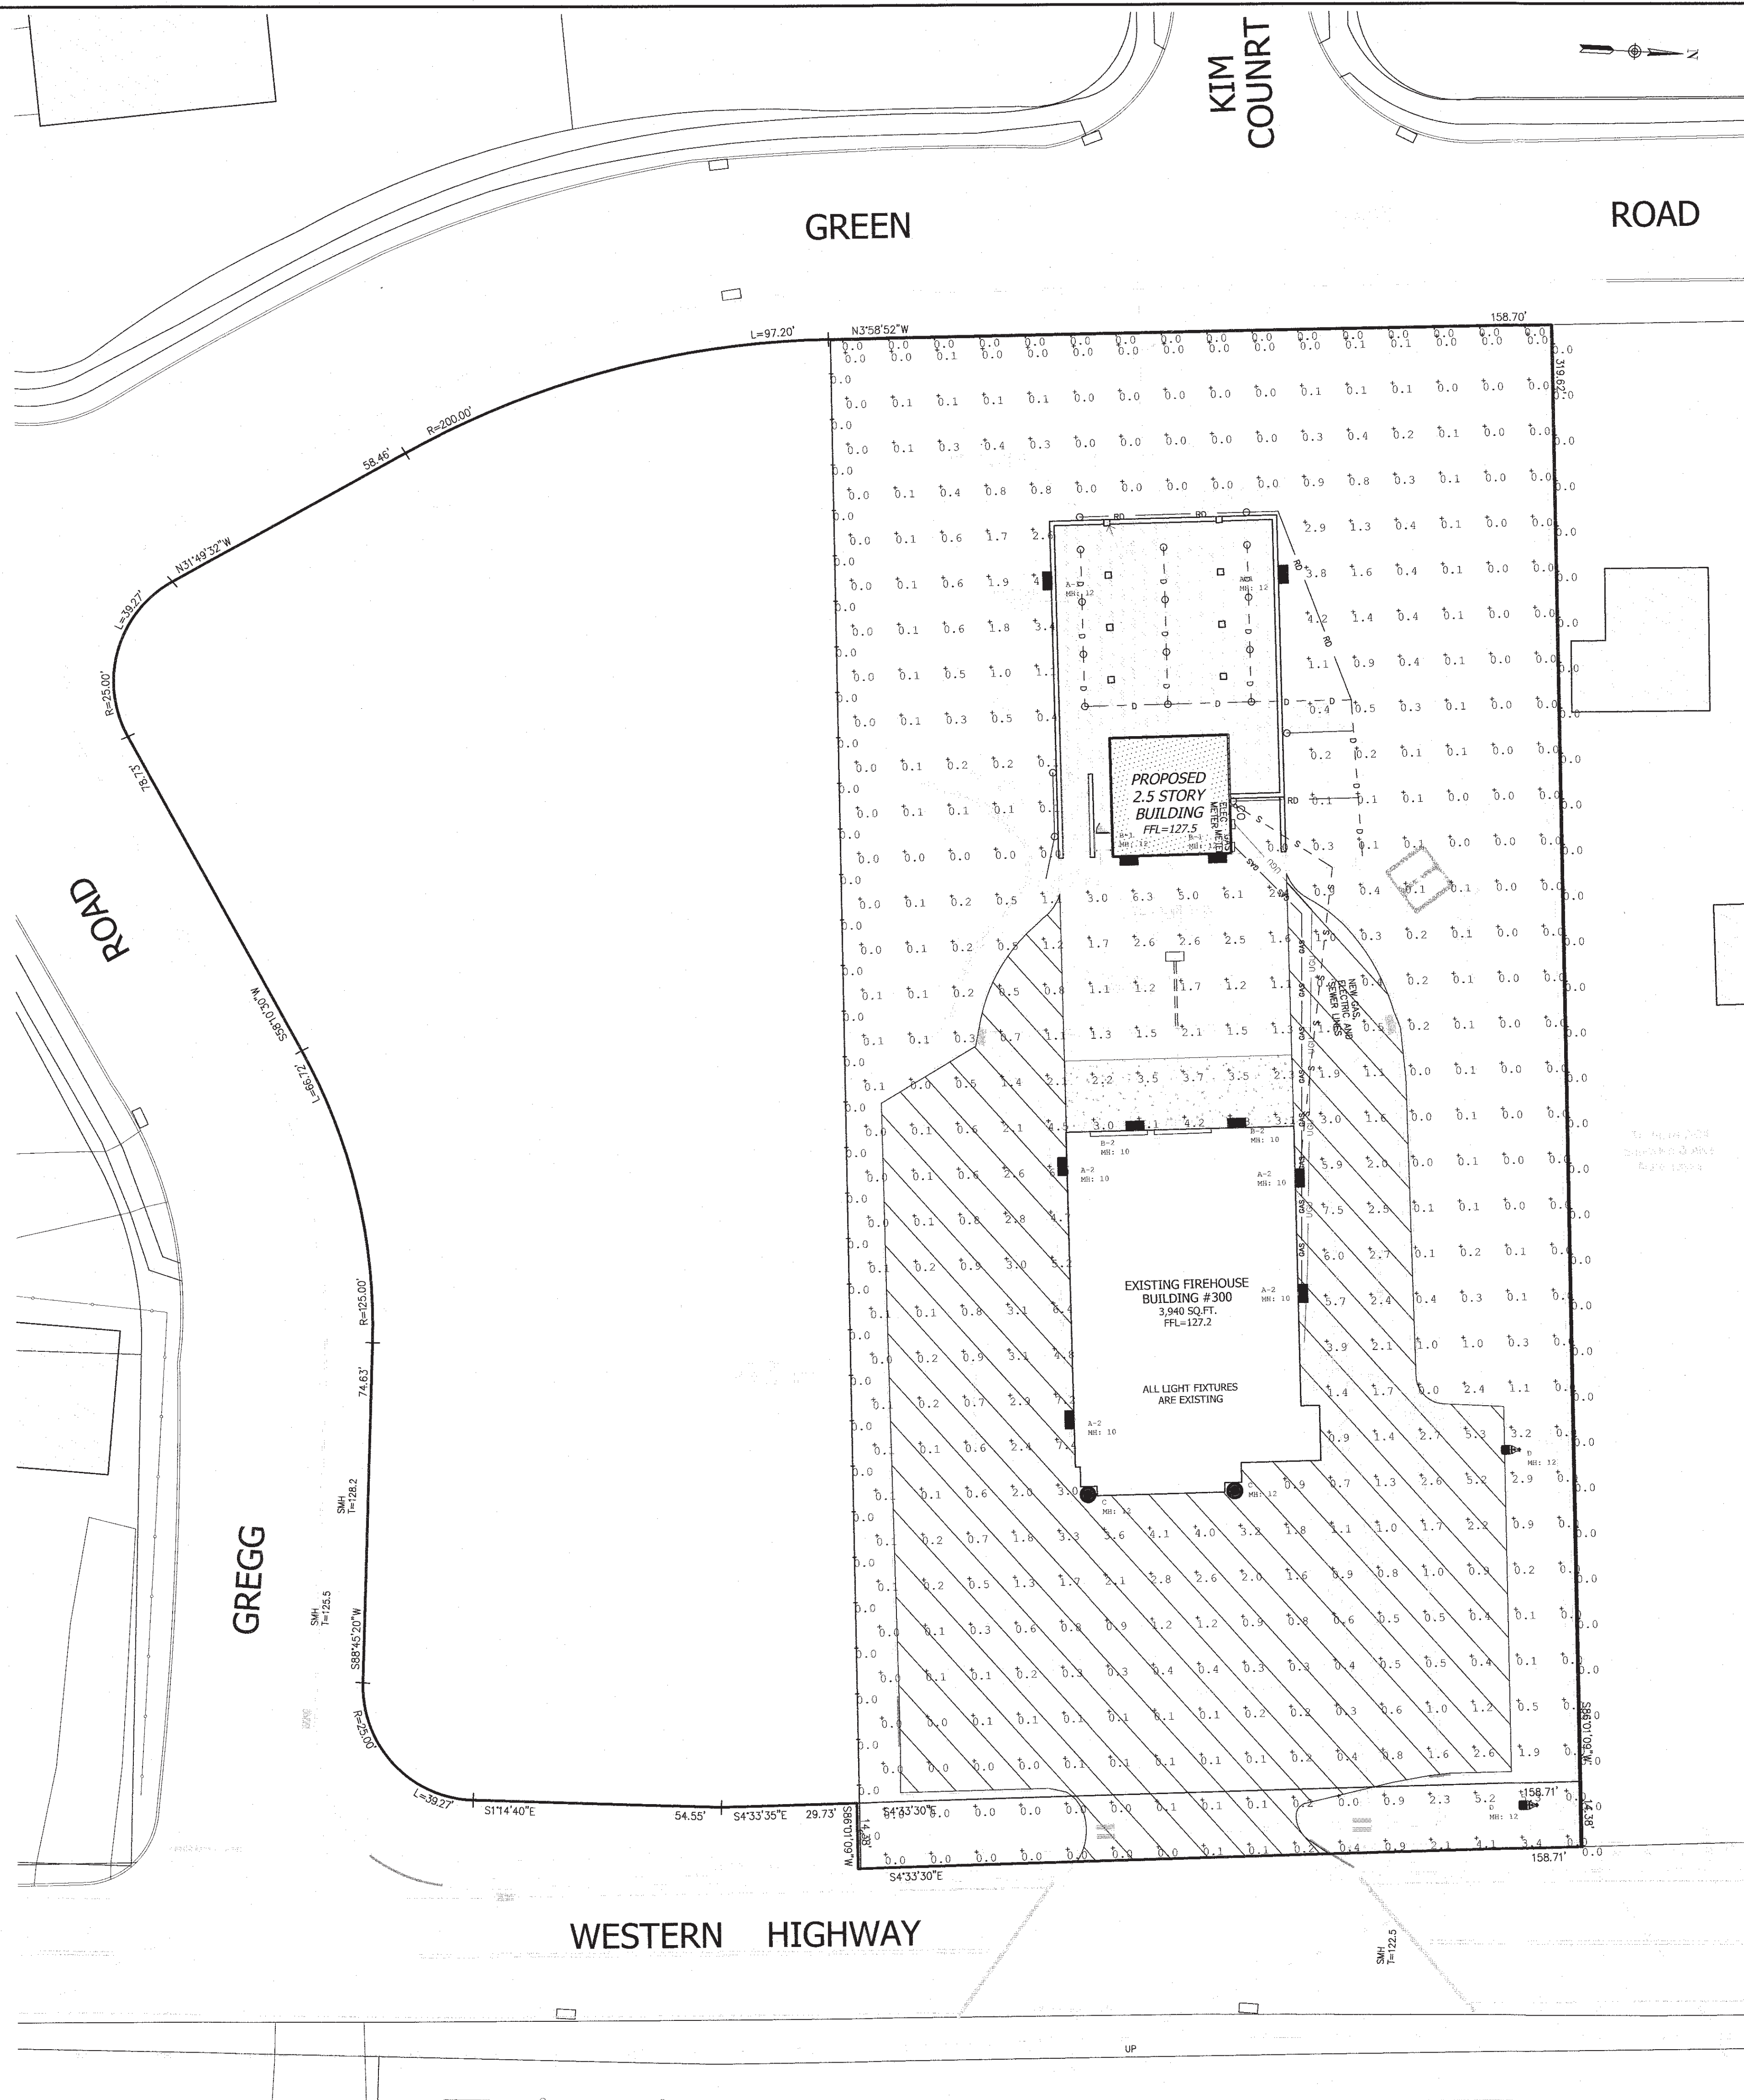

CALCULATION SUMMARY						
LABEL	CALC TYPE	UNITS	AVG	MAX	MIN	AVG/MIN MAX/MIN
CALCULATION GRID @ GRADE	ILLUMINANCE	FC	0.91	7.5	0.0	N.A. N.A.
PROPERTY LINE	ILLUMINANCE	FC	0.00	0.0	0.0	N.A. N.A.
SITE	ILLUMINANCE	FC	1.78	7.5	0.0	N.A. N.A.

LUMINAIRE SCHEDULE										TOTAL WATTS	BUG RATING	LUM. WATTS
SYMBOL	QTY	LABEL	ARRANGEMENT	TOTAL LAMP LUM.	LLF	DESCRIPTION						
	2	A-1	SINGLE	N.A.	0.950	VISIONAIRE MLB-1-T3-24LC-5-4K-VOLT @ 12' MTG. HT.				77.71428	B1-U0-G1	38.85714
	5	A-2	SINGLE	N.A.	0.950	VISIONAIRE MLB-1-T3-24LC-5-4K-VOLT @ 10' MTG. HT.				194.2857	B1-U0-G1	38.85714
	2	B-1	SINGLE	N.A.	0.950	VISIONAIRE MLB-1-T4-24LC-5-4K-COLT @ 12' MTG. HT.				77.71428	B1-U0-G1	38.85714
	2	B-2	SINGLE	N.A.	0.950	VISIONAIRE MLB-1-T4-24LC-5-4K-COLT @ 12' MTG. HT.				77.71428	B1-U0-G1	38.85714
	2	C	SINGLE	N.A.	0.950	VISIONAIRE SRL-1-T4-32LC-3-4K-UNV_CL @ 12' MTG. HT.				70	B1-U3-G2	35
	2	D	SINGLE	N.A.	0.950	VISIONAIRE VSX-I-T4L-20LC-4K_HS-VOLT-SINGLE @ 12' MTG. HT.				268	B0-U3-G3	134

LEGEND

- 2' --- EXISTING 2' CONTOUR
- 10' --- EXISTING 10' CONTOUR
- W --- EXISTING WATERLINE
- H --- EXISTING FIRE HYDRANT
- G --- EXISTING GAS LINE
- CB --- EXISTING CATCH BASIN
- S --- EXISTING STORM DRAIN LINE
- S --- EXISTING SEWER MANHOLE
- S --- EXISTING SEWER LINE
- S --- EXISTING SPOT ELEVATION
- S --- EXISTING STONEWALL
- S --- EXISTING SIGN
- S --- EXISTING LIGHT POLE
- S --- EXISTING UTILITY POLE
- S --- LIMIT OF 100 YEAR FLOODPLAIN
- S --- LIMIT OF 500 YEAR FLOODPLAIN
- GAS --- PROPOSED GAS LINE

THE ENGINEERING LAW OF THE STATE OF NEW YORK PROVIDES THAT ANY PERSON ATTEMPTING TO PRACTICE AS AN ENGINEER WITHOUT BEING A LICENSED PROFESSIONAL ENGINEER, OR WITHOUT BEING A LICENSED PROFESSIONAL SURVEYOR, OR WITHOUT BEING A LICENSED PROFESSIONAL ARCHITECT, OR WITHOUT BEING A LICENSED PROFESSIONAL LANDSCAPE ARCHITECT, OR WITHOUT BEING A LICENSED PROFESSIONAL INTERIOR DESIGNER, OR WITHOUT BEING A LICENSED PROFESSIONAL PLANNING, SHALL BE CONSIDERED TO BE VIOLATING THE ENGINEERING LAW OF THE STATE OF NEW YORK.

RYAN A. NASHER, P.E.
N.Y.S. P.E. LIC. NO. 89066

JOHN R. ATZL
N.Y.S. P.E. LIC. NO. 50228

1	07-15-22	PER COMMENTS BY ARCHITECT
REVISION	DATE	DESCRIPTION
ATZL, NASHER & ZIGLER P.C. ENGINEERS-SURVEYORS-PLANNERS 232 North Main Street New City, New York 10956 Tel: (845) 634-4694 Fax: (845) 634-5543 E-mail: info@anzny.com Web: www.ANZNY.com		
PROJECT: TAPPAN FIRE DISTRICT		
TOWN OF ORANGETOWN ROCKLAND COUNTY, NEW YORK		
TITLE: LIGHTING PLAN		
DRAWN BY: LF	CHECKED BY: JRA	
DATE: OCTOBER 28, 2021	SCALE: 1 IN. = 20 FT.	
PROJECT NO:	DRAWING NO:	
4924	7	