

December 15, 2021

IRVINGTON UNION FREE SCHOOL DISTRICT
FACILITIES STORAGE BUILDING AT IRVINGTON CAMPUS:
SED Control Number: 66-04-02-02-2-022-001

CONTRACT G – GENERAL CONSTRUCTION, CIVIL & SITE WORK
HVAC WORK, PLUMBING WORK
ELECTRICAL WORK

WESTCHESTER COUNTY, NEW YORK

NOTE: *This clarification forms a part of the contract documents for the above project and must be acknowledged in the plans and specifications. Attach it to the inside front cover of each of the specifications.*

CLARIFICATION TO PROJECT:

1. Drawing C501.00 has been omitted from the project.

CLARIFICATION TO SPECIFICATIONS:

2. Remove *TABLE OF CONTENTS* and replace with revised *TABLE OF CONTENTS*, attached herewith. Specification section 074216 Metal Soffit Panels has been added.
3. Add SPECIFICATION SECTION NEW FACILITIES STORAGE BUILDING – SPECIAL PROVISIONS, attached herewith.
4. Remove *SPECIFICATION 004116.11 PROPOSAL (PB-G)* and replace with revised *SPECIFICATION 004116.11 PROPOSAL (PB-G)*, attached herewith. DIVISION 33 – UTILITIES has been added.
5. Add *SPECIFICATION 074216 METAL SOFFIT PANELS*, attached herewith.

CLARIFICATION TO DRAWINGS:

1. Remove *DRAWING G0.0 GENERAL NOTES, ABBREVIATIONS, DRAWING LIST, STAGING PLAN, LOCATION MAP AND LEGEND* and replace with revised *DRAWING G0.0 GENERAL NOTES, ABBREVIATIONS, DRAWING LIST, STAGING PLAN, LOCATION MAP AND LEGEND*, attached herewith. There is an update to the civil drawing list.
2. Remove *DRAWING CD100.00 EXISTING CONDITIONS AND DEMOLITION SITE PLAN* and replace with revised *DRAWING CD100.00 EXISTING CONDITIONS AND DEMOLITION SITE PLAN*, attached herewith. Added asphalt replacement ADD/ATLERNATE.
3. Remove *DRAWING C101.00 ADD ALTERNATE PAVEMENT RESTORATION PLAN* and replace with revised *DRAWING C101.00 ADD ALTERNATE PAVEMENT RESTORATION PLAN*, attached herewith. Added asphalt replacement ADD/ATLERNATE. Removed new force main, new sanitary manhole and new lift station.
4. Remove *DRAWING C500.00 SITE DETAILS* and replace with revised *DRAWING C500.00 SITE DETAILS*, attached herewith. Added asphalt replacement ADD/ATLERNATE. Removed Pipe Trench Detail #10.
5. Remove *DRAWING A6.0 DOOR SCHEDULE AND DETAILS* and replace with revised *DRAWING A6.0 DOOR SCHEDULE AND DETAILS*, attached herewith. The West wall is to receive epoxy instead of PT.

December 15, 2021

REQUEST FOR INFORMATION FROM NEW STYLE CONTRACTORS, INC.:

1. Please clarify any and all items that the owner will be providing for contractor installation.

RFI Response: Please review the drawings and specifications for clarification as it states who is responsible for the work.

2. Please specify whether there will be any required off-hour, after hours, and/or night work throughout the duration of this job.

RFI Response: Permitted working hours are Monday thru Friday between 7am and 7pm, and if necessary, Saturdays from 9am to 5pm as per local noise ordinances. No work on Sundays. No off hours are anticipated unless the Contractor is making up for schedule delays.

3. Will all noisy work be required to be performed after-hours?

RFI Response: Noisy work will be done during regular hours

4. Is there any specific phasing on this project?

RFI Response: The Construction Schedule is June 27, 2022 thru August 31, 2022. All work is planned to start and finish over the summer when there are no students.

5. Is this an occupied facility?

RFI Response: The project scope includes a new building. Adjacent, existing buildings will have minimal occupants during the summer Construction Schedule. Access must be maintained at all times for School deliveries and emergency access.

6. Please confirm that in the event of conflicting provisions within the bid documents, the more expensive option should be included with the bid price.

RFI Response: Confirmed

7. Is there any parking near the building?

RFI Response: Parking locations for contractors will be designated by the Construction Manager.

8. Please advise on labor affiliation for this project.

RFI Response: This is a public bid governed by the NYS labor laws.

9. Are there any MWBE goals set for this project?

RFI Response: MWBE is encouraged but not a requirement of the contract.

10. Where can the GC place its trailer / temporary office?

RFI Response: Trailer locations will be designated by the Construction Manager. Any utilities to the trailers are at each Prime Contractors own expense.

11. What areas can be used for storage?

RFI Response: See contract documents. Storage locations will be approved by the Construction

December 15, 2021

Manager.

12. Are there any allowances on this project?

RFI Response: Yes. Refer to Specification 004116.11 – Proposal (PB-G)

13. Are there any alternates on this project?

RFI Response: Yes. Refer to Specification 004116.11 – Proposal (PB-G)

REQUEST FOR INFORMATION FROM PIEROTTI CORP.:

1. Drawing C101 shows new lift station referencing P Sheets, this is not shown on the plumbing drawings. Please provide details.

RFI response: Please refer to revised Drawing C101.00, attached herein. The new force main, new sanitary manhole and new lift station are removed from the scope of work (see 'CLARIFICATIONS TO DRAWINGS')

2. Borings B-11, B-12 and B-13 look to be where the new force main is going, boring logs note termination at 1-foot below grade with no note if rock was encountered. Please advise if rock removal is required for the new force main and depth of rock to assume.

RFI response: Please refer to revised Drawing C101.00, attached herein. The new force main, new sanitary manhole and new lift station are removed from the scope of work (see 'CLARIFICATIONS TO DRAWINGS')

3. Drawing A6.0 under finish schedule shows North, East & South walls as epoxy and West wall as PT. Are these meant to be epoxy paint and regular paint? There are no specifications for painting. Please advise.

RFI response: Please refer to revised Drawing A6.0 DOOR SCHEDULE AND DETAILS, attached herein. The West wall is to receive epoxy. (see 'CLARIFICATIONS TO DRAWINGS')

4. Revised bid form in Addendum #2 does not have a line item for DIV 33 – Utilities which should be all the underground outside the building limits. Please advise where this should be allocated.

RFI response: Please refer to revised Specification 004116.11 PROPOSAL (PB-G). See 'Clarifications to Specifications'.

5. Please provide specifications for metal soffit as shown on A3.0 wall section 3.

RFI response: Please refer to added Specification 074216 METAL SOFFIT PANELS. See 'Clarifications to Specifications'.

IRVINGTON UNION FREE SCHOOL DISTRICT

FACILITIES STORAGE BUILDING AT IRVINGTON CAMPUS

SED Control No. 66-04-02-02-2-022-001

CONTRACT G – GENERAL CONSTRUCTION WORK, HVAC WORK, PLUMBING WORK, ELECTRICAL WORK, CIVIL & SITE WORK

DIVISION 00 - PROCUREMENT AND CONTRACTING REQUIREMENTS

000110	TABLE OF CONTENTS
001113	NOTICE TO BIDDERS
002113	INSTRUCTIONS FOR BIDDERS
002515	QUALIFICATIONS OF BIDDERS
004116	PROPOSAL (PA)
004116.11	PROPOSAL (PB-G)
004116.19	PROPOSAL (PC)
004357	INSURANCE CERTIFICATION
004519	NON-COLLUSIVE FORM
004521	HOLD HARMLESS AGREEMENT
004547	IRAN DIVESTMENT ACT CERTIFICATION
004550	SUB CONTRACTORS LIST
005209	SAMPLE AGREEMENT
007200	GENERAL CONDITIONS
007201	NYSED 155.5 REGULATIONS
007244	WEEKLY PAYROLL FORM – WH347
007343	PREVAILING WAGE RATES

SAMPLE AIA DOCUMENTS

AIA A310	(BID BOND)
AIA A312	(PERFORMANCE BOND)
AIA A312	(PAYMENT BOND)
AIA G702	(APPLICATION AND CERTIFICATE FOR PAYMENT)
AIA G703	(CONTINUATION SHEET)
AIA G704	(CERTIFICATE OF SUBSTANTIAL COMPLETION)
AIA G706	(CONTRACTOR'S AFFIDAVIT OF PAYMENT OF DEBTS AND CLAIMS)
AIA G706A	(CONTRACTOR'S AFFIDAVIT OF RELEASE OF LIENS)
AIA G707	(CONSENT OF SURETY TO FINAL PAYMENT)
00999.1	APPENDIX

DIVISION 01 - GENERAL REQUIREMENTS

011100	SUMMARY OF WORK
011400	WORK RESTRICTIONS
011419	SITE UTILIZATION PLAN
012100	ALLOWANCES
012200	UNIT PRICES
012500	PRODUCT SUBSTITUTION PROCEDURES
012900	PAYMENT PROCEDURES
012973	SCHEDULE OF VALUES
013100	PROJECT MANAGEMENT AND COORDINATION
013119	PROGRESS MEETINGS
013216	CONSTRUCTION SCHEDULE

013223	SURVEYING
013300	SUBMITTALS
014100	REGULATORY REQUIREMENTS
014223	SPECIFICATION FORMAT
014320	PRE-INSTALLATION MEETINGS
014500	QUALITY CONTROL
014500.01	STATEMENT OF SPECIAL INSPECTION AND TESTS
014536	ENVIRONMENTAL QUALITY CONTROL
015000	TEMPORARY FACILITIES AND CONTROLS
015213	FIELD OFFICES
016100	BASIC PRODUCT REQUIREMENTS
016500	PRODUCT DELIVERY, STORAGE AND HANDLING
017329	CUTTING AND PATCHING
017419	CONSTRUCTION WASTE MANAGEMENT AND DISPOSAL
017423	CLEANING
017500	STARTING AND ADJUSTING
017800	CLOSEOUT SUBMITTALS
017823	OPERATING AND MAINTENANCE DATA
017839	PROJECT RECORD DOCUMENTS
017843	SPARE PARTS
017900	DEMONSTRATION AND TRAINING

DIVISION 03 - CONCRETE

030000	CONCRETE
031000	CONCRETE FORMING AND ACCESSORIES
033000	CAST-IN PLACE CONCRETE
036000	GROUT

DIVISION 04 - MASONRY

040513	MORTAR
--------	--------

DIVISION 05 - METAL


053100	STEEL DECKING
054000	COLD FORMED METAL FRAMING
055000	METAL FABRICATIONS

DIVISION 06 – WOOD, PLASTICS AND COMPOSITES

051200	STRUCTURAL FRAMING
053100	ROUGH CARPENTRY

DIVISION 07 - THERMAL AND MOISTURE PROTECTION

072100	THERMAL INSULATION
072419	WATER-DRAINAGE EXTERIOR INSULATION AND FINISH SYSTEM_EFIS_
073113	ASPHALT SHINGLES
074216	METAL SOFFIT PANELS
074400	CONCRETE FACED PANELS
076200	SHEET METAL FLASHING AND TRIM
077123	GUTTERS AND DOWNSPOUTS
077253	SNOW GUARDS9,
078413	PENETRATION FIRESTOPPING
078413	FIRESTOPPING

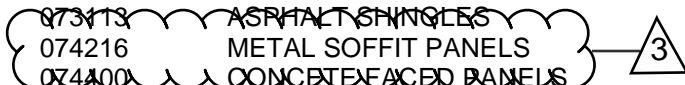

079200	JOINT SEALANTS
079500	EXPANSION CONTROL

DIVISION 08 - OPENINGS

081613	FIBERGLASS / ALUMINUM COMPOSITE DOORS
083323	OVERHEAD COILING DOORS
087100	DOOR HARDWARE
087113	AUTOMATIC DOOR OPERATORS
088000	GLAZING
089119	FIXED LOUVERS

DIVISION 09 - FINISHES

096716	EPOXY FLUID – APPLIED FLOORING
--------	--------------------------------

DIVISION 22 – PLUMBING

220517	SLEEVES AND SLEEVE SEALS FOR PLUMBING PIPING
220523	GENERAL-DUTY VALVES FOR PLUMBING PIPING
220529	HANGERS AND SUPPORTS FOR PLUMBING PIPING AND EQUIPMENT
220553	IDENTIFICATION FOR PLUMBING PIPING AND EQUIPMENT
220719	PLUMBING PIPING INSULATION
221005	PLUMBING PIPING
221006	PLUMBING PIPING SPECIALTIES
223000	PLUMBING EQUIPMENT
224000	PLUMBING FIXTURES

DIVISION 23 – HVAC

230010	GENERAL MECHANICAL REQUIREMENTS
230555	MECHANICAL SYSTEM IDENTIFICATION
230594	BALANCING OF AIR SYSTEMS
230991	INSTRUMENTATION AND CONTROL INTEGRATION
230993	SEQUENCE OF OPERATIONS
233416	EXHAUST FANS
238239	ELECTRIC HEATERS

DIVISION 26 – ELECTRICAL

260000	ELECTRICAL
260519	LOW-VOLTAGE ELECTRICAL POWER CONDUCTORS AND CABLES
260529	HANGERS AND SUPPORTS FOR ELECTRICAL SYSTEMS
260533	RACEWAYS AND BOXES FOR ELECTRICAL SYSTEMS
260553	IDENTIFICATION FOR ELECTRICAL SYSTEMS
263400	PANELBOARDS
262726	WIRING DEVICES
265000	LIGHTING
281000	CARD LOCK HARDWARE SYSTEM _SALTO_
283100	FIRE DETECTION AND ALARM

DIVISION 31 – SITE WORK

311000	SITE CLEARING
312200	GRADING

312316	EXCAVATION
312316_13	TRENCHING
312316_26	ROCK REMOVAL
312323	FILL

DIVISION 32 – EXTERIOR IMPROVEMENTS

321123	AGGREGATE BASE COURSES
321125	TURF SURFACED ROADWAYS
321216	ASPHALT PAVING
321623	SIDEWALKS
323113	CHAIN LINK FENCES AND GATES
323300	SITE FURNISHINGS

DIVISION 33 – UTILITIES

330561	CONCRETE MANHOLES
333123	SANITARY SEWERAGE FORCE MAIN PIPING
334211	STORMWATER GRAVITY PIPING

SPECIAL PROVISIONS

These Special Provisions are in addition to the Plans, Specifications and the other Contract Documents and shall be part of this Agreement between the Owner and the Contractor. All references to "This Prime Contractor", "This Contractor" or "Contractor" refer to the General Contractor, Mechanical Contractor and Electrical Contractor, Plumbing Contractor, and Site Work Contractor. In cases of contradictions, the most stringent Provision shall govern.

General Requirements for a Single Prime Contractor

I. General

1. All dates, durations, etc. defined herein shall be in business days.
2. Except for the basic building permit, the Prime Contractor's price shall include all fees and other costs for securing and maintaining (by the Prime Contractors or their subcontractors) for the life of the job; all permits, PE licenses, connection fees, inspections, etc., applicable to, or customarily secured for the Work. This provision includes any applications and/or permits to be issued by utility companies in the name of the Prime Contractor, or the Owner, as required for the Work. Originals of all permits are to be issued in the name of the Prime Contractor as required for the Work. The Prime Contractor shall furnish the Construction Manager with original copies of all permits prior to the commencement of the Work, and, shall prominently display a copy of all permits at a location agreed to with the Construction Manager.
3. One week after Notice to Proceed (NTP), the Prime Contractor shall provide two copies of a videotaped recording of all existing conditions to the Construction Manager. This taping shall provide a record of all-existing buildings, grounds, exterior conditions and interior conditions. The Contractor shall schedule a representative of both the Owner and the Construction Manager to be present at this taping. In the absence of this record, the Prime Contractor shall be responsible for paying the costs associated with any and all repairs or replacements of existing materials and/ or conditions that were damaged in an area where the Prime Contractor is working or has worked, as may be deemed necessary by the Owner or the Construction Manager.
4. The Prime Contractor is responsible for providing the required mock-ups defined by the Contract Documents out of sequence as needed by the Architect.
5. The Prime Contractor is responsible for providing all required Engineered material calculations as defined by the contract documents.
6. The Prime Contractor shall provide drinking water for his own employees.
7. On Site Communications. The Prime Contractor shall provide, or otherwise see that, the project manager, or site managers, and/or responsible workers of the Prime Contractor and major subcontractor are equipped with cellular phones for the purpose of staying in contact with for the Construction Manager.
8. The Prime Contractor shall include in his base price the cost of all rigging and equipment required for the performance and installation of the Work.

II. Schedule

1. The Prime Contractor is to recognize that the Project Schedule is of critical importance to the Owner. All aspects of construction must reflect a 'time is of the essence' construction strategy. The attached 'Bid Schedules' serves as a guide of critical milestone dates to the Project. Failure to meet intermediate milestone dates will jeopardize the overall Project Schedule. This failure will mandate Contractor(s) to, increase staff, work overtime, or use other means to recover time, at the costs of those Contractor(s) responsible for such delays. In addition, all costs due to delays in completion of the Work, which require additional Custodial Overtime, Construction Management services, Architectural services, and Engineering services beyond the Work duration in the Bid Schedule, shall be borne by Contractor(s) responsible for delays.
2. The Prime Contractor shall review the completed "Final" detailed construction schedule and acknowledge their acceptance of this schedule by signing a copy to be kept on record by the Construction Manager. This agreed upon schedule must incorporate all milestone dates and shall be established within five (5) weeks of Notice to Proceed.
3. The Prime Contractor shall update the detailed construction schedule with the Construction Manager and issue copies to the Owner, Construction Manager, and the Architect monthly.
4. The Prime Contractor is to submit a schedule of projected fabrication on long lead items (items requiring four weeks and over to fabricate) three weeks after Notice to Proceed. Progress/Status reports on fabrication to be submitted to the Construction Manager every two weeks. 'Rate of Change' chart and marked up shop drawings to be included in these reports.
5. The Prime Contractors shall be responsible for coordinating and expediting their fabrication and delivery schedules and keeping the Construction Manager informed as to their progress and their anticipated ability to stay on schedule. Should it become necessary (in the opinion of the Construction Manager) to supplement the Prime Contractor's expediting efforts in order to maintain job progress, the Construction Manager may elect to charge all costs incurred to said Prime Contractor.
6. In the event that Owner makes special arrangements to open a building at the request of a Contractor and the Contractor does not show, the Prime Contractor shall pay the Owner all costs incurred. All parties agree that any action taken to enforce this requirement shall not be construed by the Prime Contractor or its subcontractors/suppliers, as a reason for a claim (for either time or money) for delay to, or cost of, the Work or to the Prime Contractor, its subcontractors, or suppliers.
7. The Owner shall take occupancy of the new building spaces in accordance with the dates established by the Bid Schedule and the Special Provisions. The Contractors shall perform all Work necessary to maintain the Owner's move-in and occupancy schedule.
8. The Prime Contractor shall include in their base price, all out of sequence Work and any Work required to be performed during overtime hours or non-working hours necessary to maintain the Master Schedule, the Prime Contractors' project schedule, or, the Owner's move-in schedule.

Milestone Requirements

Submittal Priorities

The following submittal dates are critical to allow for proper fabrication timeframes to ensure timely completion of the project to meet the attached bid schedule. A complete listing of all submittal requirements is located in "Section 01 33 00 Submittal Requirements"

Major Submittals

Concrete Footings and Foundations	15 days from Notice to Proceed
EFIS System	15 days from Notice to Proceed
Cold Formed Metal Frame and Decking	20 days from Notice to Proceed
Asphalt Roofing Systems	15 days from Notice to Proceed
Exterior Doors/ Frames/Hardware	15 days from Notice to Proceed
Garage Doors	20 days from Notice to Proceed
Exterior and Interior Signage	20 days from Notice to Proceed
Site Fencing	20 days from Notice to Proceed
Interior Finishes	20 days from Notice to Proceed
Oil/ water Separator	20 days from Notice to Proceed
HWH	20 days from Notice to Proceed
Plumbing Fixtures, piping, and Accessories	20 days from Notice to Proceed
Mechanical Unit Heaters and Fans	15 days from Notice to Proceed
Underground service conduit and cable	15 days from Notice to Proceed
Raceways, panels, and boxes for Electrical	15 days from Notice to Proceed
Hangers and supports for Electrical Systems	15 days from Notice to Proceed
Interior and Exterior Power wiring and Conduit	15 days from Notice to Proceed
Wiring Devices	15 days from Notice to Proceed
Interior and Exterior Lighting	15 days from Notice to Proceed
Fire Detection and Alarm System	15 days from Notice to Proceed
Card Lock Hardware System	15 days from Notice to Proceed
Grading and Final Topsoil	15 days after Notice to Proceed
Excavation, Backfill, and Compaction	15 days after Notice to Proceed
Site/ Sediment Protection, Temp. Site Fencing	15 days after Notice to Proceed
Trenching and Associated Piping	15 days after Notice to Proceed
Rock Removal	15 days after Notice to Proceed
Aggregate Base Courses	15 days after Notice to Proceed
Asphalt Paving	15 days after Notice to Proceed
All remaining Submittals with-in	25 days from Notice to Proceed

Construction Milestones

Special consideration should be made to the requirements of the project bid schedule attached in the Specifications. The Prime Contractor will be required to man each contract to meet the milestone dates indicated below and/or in the contract bid schedule. All costs should be included in the bid for working multiple shifts, nights, weekends, and holidays to complete each phase of the project.

Time frames indicated, show milestone dates required to be met by The Prime Contractor. These areas, once completed, will be punch-listed and given partial occupancy for the Owner to occupy. Occupying these areas is critical to the Owner. If said dates are not met Liquidated damages may be assessed and back-charged to the responsible Contractor.

Key Milestone Dates

New Facilities Storage Building

- o Construction Start June 27, 2022, Substantial Completion August 30, 2022, Final Completion September 30, 2022.

Summary of Work

This contract work is intended take place over the summer when school is not in session. Any work required after September 1, 2022 will be completed after regular school hours at no additional cost to the District. The appropriate construction site fencing will enclose the entire work area. Unabated construction area access for this Prime Contractor will be maintained by the High School Construction Project at all times. This Prime Contractor will allow roadway access around the construction site for the District deliveries and other Prime Contractor work in the exiting courtyard.

Faculty, Staff, and Students will be occupying the existing building, track and fields throughout the summer.

Be advised that the main roadway leading into campus (Heritage Hill Road) is a public roadway and cannot be closed or burdened by materials or equipment at any time.

It is anticipated that rock removal will be necessary. No blasting will be allowed.

SCHOOL OPERATIONS & CONTRACTOR WORK HOURS

This project will affect areas, which in some cases will remain in operation during construction. During the school session all contract work not effecting the District's Operation may be performed weekdays during the hours of 7:00 a.m. and 7:00 p.m. All contract work effecting the Operation of the School must be performed on an after-hours schedule, weekends or school holidays.

The Prime Contractor may work Saturdays to make up for lost time (Saturday work will be required if necessary, to meet deadline) with prior approval from the Owner and after Contractor has verified allowable working hours by town ordinance. Work will not be permitted on Sundays and Jewish Holidays.

III. SAFETY / LOGISTICS/STORAGE

1. Two weeks after the receipt of the Notice to Proceed, the Prime Contractor shall provide a Site Safety/Logistics Plan to the Construction Manager. The site logistics plan should minimally include locations of the eight-foot high temporary fence, traffic plans for deliveries and removals, refuse container locations, crane locations, pick locations, boom radius, and lift locations. This plan shall also show the location of all staging and storage areas, non-rated and fire-rated partitions used to separate construction and school areas, made with plywood

and/or gypsum wallboard, etc. The logistical information represented by the construction documents shall serve as a minimal guide.

2. The Prime Contractor is to submit their corporate safety policy (5) days after notice to proceed. Plan to minimally meet OSHA standards and current COVID-19 protocols. The Prime Contractor shall make the participation of their subcontractors in this program mandatory. These Safety Programs should be a detailed Company Policy defining the specifics as to how a safe work environment shall be maintained.
3. The Prime Contractor and Sub Contractors shall schedule weekly safety meetings (Job Site Safety Talks) and submit meeting minutes indicating attendees and topics to the Construction Manager.
4. The Prime Contractor is to identify in writing to the Construction Manager their "OSHA Competent Person Regarding Safety" Definition. "Competent person" means one who is capable of identifying existing and predictable hazards in the surroundings or working conditions which are unsanitary, hazardous, or dangerous to employees, and who has authorization to take prompt corrective measures to eliminate them.
5. All flagmen required for deliveries to the site are to be furnished by the Prime Contractor responsible for the delivery. Any and all deliveries crossing the site or student traffic areas shall be escorted by flagmen. All flagmen shall wear orange vests. All deliveries shall be scheduled and coordinated with the Construction Manager and the Owner. Delivery blackout periods for bus traffic interference shall be established with the Construction Manager.
6. Smoking, firearms, alcoholic beverages, indecent photography, and radios are expressly prohibited on all school properties. All persons representing Contractors, subcontractors or suppliers shall wear shirts, long pants and other proper attire while on school property. All persons representing Contractors, subcontractors or suppliers shall conduct themselves in a professional manner consistent with the rules and policies of The School District, and the New York State Education Department while on school property or otherwise representing this project.
7. The Prime Contractor will ensure that all their employees, while on school property, will wear hard hats, high visibility vests, and ID badges at all times. Anyone on site without this safety gear will be escorted off school property.
8. The Prime Contractor will ensure that every employee working on this project has completed a 10-hour OSHA training course. Any worker that cannot present a 10-hour OASHA safety-training card will be escorted off the property.
9. Food truck vendors for Construction Workers will only be allowed on school property with prior authorization from the School District. The District may allow or discontinue food vendor truck service at any time for any reason.
10. **Identification Badges.** The Prime Contractor will provide an ID badge for each of their field personnel prior to coming on school property. All workmen shall display the badge on their person while on site, and at all times. Failure to wear identification badge at all times will result in the immediate removal from the jobsite.
11. The Prime Contractor is responsible for their own storage and personnel trailers at each site. The Contractor will be required to supply man trailers and storage box trailers as required. All costs related to its delivery, construction, protection, power, etc. is borne by the individual Contractors utilizing space. The Owner WILL NOT PROVIDE STORAGE SPACE. The placement of these trailers will be strictly limited to predetermined locations. Approval of the placement of any trailer or storage box must be received from the Construction Manager.

12. The parking for construction personnel shall be limited to designated parking areas only. Failure to abide by this rule will result in towing of cars at the expense of the Contractor whom employs the individual.
13. All delivery vehicles/trucks/machinery/etc. permitted on site, must be equipped with back-up alarms and enter through the designated access points. Failure to demonstrate this ability will result in cancellation of delivery or stoppage of work. All delays associated with this cancellation will be the responsibility of the Contractor responsible for the Work involved.
14. All temporary construction site fences installed by the any Contractor shall be installed with a tightly woven, blind screen mesh. This mesh is to be installed on the "construction" side of the fence. This Contractor will maintain all fencing daily and lock gates at the end of the day. All fencing must also include signage at least every 25 feet the reads "Construction area keep out" and "No trespassing"
15. All crane picks, material delivery, etc. must be coordinated with the Construction Manager and must not lift over any occupied area of the building. If absolutely necessary, this work shall be done on off hours to ensure the safety of the building occupants. Crane location must be carefully chosen to ensure the safety of building occupants.
16. The Owner or Construction Manager reserves the right to have all hoisting equipment periodically inspected by an independent inspector whose findings will be binding. The Prime Contractor at its own expense must make corrections before continuing work. The Owner or Construction Manager will not assume any responsibility for the safe operation of any hoisting equipment by exercising this right. The Prime Contractor or Sub Contractor shall cooperate with the inspector by allowing time for the inspection. The Prime Contractor shall be notified 24 hours prior to the time of the inspection. These inspections do not release the Prime Contractor of their responsibility to provide all engineering, permits, and inspections as required by OSHA or the SED prior to use of any hoisting equipment.
17. All vehicular traffic (personal vehicles, trucks, equipment, deliveries, etc.) are to use the designated entrances as outlined on the Contractor Logistics Drawings. Access by other routes is to be on exception basis only.

IV. SUBMITTALS

1. Each copy of each submittal shall have attached as the cover page the "Submittal Cover Sheet". All information requested in "Section 01 33 00 Submittal Requirements" shall be provided by the respective Contractor. Submittals will be returned without review if the cover sheet is not accurately completed.
2. The Prime Contractor shall generate a complete "Submittal Log" within one calendar week of the Notice to Proceed. This log is to list all required submittals specific to your trade as detailed in the Project Manual/Specs. See enclosed form for your use. "ROJ" stands for Required on Job to assist your judgment of the time gap between submission, Architect review, fabrication/procurement and on-site need for putting the work item into place.
3. The Prime Contractor shall review all submissions for completeness. The Prime Contractor is responsible to stamp all shop drawings prior to submission to the Architect. The Architect will not review any shop drawings unless first reviewed by said Contractor. Bundle similar material submissions for proper review. Use the Architects Submittal cover sheet located in the Specifications

4. **All submissions shall be sent electronically to the Architect. Submittals will be processed and stored electronically, with access available to all Prime Contractors for coordination.**
5. The Prime Contractor shall provide one transmittal for each submission package identifying each unique submission individually. For each submittal with the submission package, the Prime Contractor shall identify the length of the delivery time and the necessary "last date" an item may be received on site. Each Prime Contractor shall keep a log of all submissions in a manner prescribed by the Construction Manager and the attached form. Minimally, the Contractor shall update this submittal log biweekly and provide a copy to the Construction Manager for review and information.
6. The Prime Contractor shall copy the Construction Manager's Project Manager on all transmittals, correspondence, RFI's and any other documents sent to the Architect, his consultants or the Owner
7. At the direction of the Construction Manager, the Prime Contractor shall provide copies of either document and/or data files for any requested document on one of the following programs: Microsoft Word, Microsoft Excel, or Primavera's SureTrack – Project Manager 2.0 scheduling program.

VI. MANAGEMENT OF WORK

1. **The Prime Contractor shall employ (from one week after Notice to Proceed until punch-list and closeout are complete) at a minimum a part time Project Manager and full-time on-Site Super. The Project Manager and Site Super shall represent the Prime Contractor. All communications given to the Project Manager or Site Super either verbal or written shall be as binding as if given to the Prime Contractor. Important communications shall be so confirmed in writing.**
2. The Prime Contractor shall provide copies of their daily construction reports to the Construction Manager's Project Manager. These reports shall be submitted no later than 10:00am the following workday. The daily reports shall provide detailed information concerning the Prime Contractors' activities and operation only. Daily Construction Reports to the owners' representative detailing manpower and work activities on site. A "Daily Construction" form is attached and shall be used for reporting these said activities. In addition, the Contractors are to submit Two Week Look Ahead schedules at every construction meeting which describes coming work in detail. A "Two Week Look Ahead" form is also attached and shall be used to report said activities
3. The Prime Contractor shall have responsible representation at the **MANDATORY** weekly job meetings held at the Construction Manager's job office from notice to proceed thru close out. These meetings will be held to arrange for a satisfactory coordination of all building trades so as not to impede job progress. **Prime Contractors or subcontractors who fail to attend the meetings will be back-charged \$500.00 per each occurrence.**
4. The Prime Contractor shall submit two-week look ahead schedules identifying the anticipated activity, and material needs for all of the work scheduled to be formed by the Prime Contractor and his subcontractors for the identified time period. The Prime Contractor shall keep this schedule current and provide a biweekly report to the Construction Manager concerning the actual performance and activity compared to the two-week look ahead.
5. The MEP Coordination shall follow the guidelines stated below:
 - a. It is the responsibility of the Prime Contractor to coordinate with the architectural details and elements, such as soffits, variations in ceiling height and materials,

fire/smoke partitions or barriers, folding partition, doors, lockers, and any other general construction items that impact the space above the ceiling or otherwise requiring light framing and/or miscellaneous support or bracing.

6. If the Prime Contractor fails to keep the site safe and clean within four hours of being notified by the Construction Manager either verbally or in writing, the Construction Manager will have this work performed and back charged to the appropriate Prime Contractor at prevailing overtime rates plus 15%. Notice to field personnel is deemed notice to this Prime Contractor.
7. Dust and fume control are essential to the reduction of health risks to the surrounding personnel. Methods of dust control shall include but not be limited to the following:
 - a. Adequate ventilation.
 - b. Wetting down.
 - c. Keeping bags of insulating materials, cement, etc. closed.
 - d. Controlled mixing of materials under field conditions.
 - e. Special attention should be utilized in sawing of insulation and certain acoustical materials and storage of materials.
 - f. Job housekeeping must be maintained.
 - g. Advising all personnel of hazardous conditions, including supervisors and workmen.
 - h. The Prime Contractor shall be responsible for instituting the above policies to ensure minimal impact to surrounding occupied areas.
8. The Prime Contractor shall confine operations on the premises to areas designated by the Construction Manager and permitted by law, ordinances, permits and the Contract Documents, and shall not unreasonably encumber the Premises with any materials or equipment. The Prime Contractor shall coordinate all of his operations with, and secure approval from, the Construction Manager, before using any portion of the Premises. Field personnel are to be confined to the work area assigned.
9. Where material is specified to be furnished by others or furnished and delivered only, the Prime Contractor installing the material shall be responsible for scheduling the delivery and receiving, unloading, storing, handling, relocating, hoisting, distribution, laying out and installing this material. Upon receipt by the Prime Contractor installing the material, risk of loss and damage shall be borne by that Contractor.
10. The Contractors and their subcontractors shall allow sufficient time to inspect and accept the work. Should any discrepancies be discovered, The Construction Manager shall be notified sufficiently in advance so that corrective action can be agreed to and taken (by all necessary parties) without affecting the progress of any Contractor or the work.
11. The Prime Contractor is advised to exert utmost care and diligence when working in or near any existing buildings or site work which is to remain. The absence of protection around such items shall not excuse the Prime Contractor from his liability to provide protection. Any damages to the existing buildings, sitework or facilities shall be repaired and expensed to the responsible Prime Contractor.
12. The Prime Contractor shall be solely responsible to remove and replace the existing ceiling tiles and grid in areas of the existing building where their work is required but new ceilings are not scheduled. In the event that the existing ceilings are damaged and cannot be replaced to the satisfaction of the Owner, the responsible Prime Contractor shall be solely responsible for replacing, in kind, the existing ceilings with new tile and grid. A qualified Contractor, acceptable to the Owner, shall perform all ceiling replacements.
13. All disconnect and/or tie-in work involving any utilities that would interfere with the ongoing operations of the Owner shall be completed on an after-hours basis. The performance of this work shall be projected on the required schedules and the Owners Representative is to be

notified at least forty-eight hours in advance of commencing with this work. All overtime and standby personnel necessary to complete these tie-ins shall be the responsibility of the Prime Contractor performing the work.

14. At the same time the Prime Contractor submits their Insurance Certificate they shall also submit to the Construction Manager the prevailing wage labor rates of each category of labor for which he or his subcontractors shall employ (either directly or indirectly). This information shall be itemized in the format shown below.

Contractor's Name					
Contractor's Address					
Contractor's Office Phone					
Contractor's Fax Number					
Contractor's Email Address					
Labor Rate Breakdown					
Worker's Title		Journey man	1.5 Rate	Fore man	1.5 Rate
Base Hourly Rate					
Payroll Tax & Insurance:	% Per Hr.				
FICA					
Federal Unemployment					
State					
Workers Compensation					
Disability					
Other (Explanation Required)					
Subtotal					
Benefits:	\$ Per Hr.				
Vacation					
Health & Welfare					
Pension					
Annuity					
401K Fund					
Other (Explanation Required)					
Other (Explanation Required)					
Subtotal					
Hourly Labor Rate					

VII. REQUEST FOR INFORMATION (RFIs)

1. Please refer to the specifications for Construction Phase Clarifications-Request for Information from Architect's Office" for a complete explanation of the process and copy of RFI form.

VIII. TESTING/INSPECTIONS

1. If the Architect or Owner determines that any work requires special inspection, testing or approval the Owner's Representative will instruct the Prime Contractor of such special inspection, or testing. If such special inspection or testing reveals a failure of the work to comply with the requirements of the Contract Documents, the Prime Contractor shall bear all costs thereof, including compensation for the Architect's, Owner's Representative's, and Testing Lab costs.
2. Contractor shall furnish incidental labor to:
 - a. Provide access to the work to be tested, sampled, and inspected.
 - b. Obtain and handle samples at the project site or at the source of the product to be tested.
 - c. Facilitate inspections, samplings and tests.
 - d. Coordinate with the Owners Rep and testing lab and submit schedule of required tests one week in advance.
 - e. Coordinate inspections
3. As they relate to the timely prosecution of the work, the Prime Contractors shall coordinate when independent testing and inspections are needed with the Construction Manager. If the Prime fails to coordinate such inspections and additional costs are incurred to the Owner, the Prime Contractor will be responsible for that inspection cost.
4. **The following is a list of intended inspections:**
 - a. Soil bearing, sub-grade inspection and/or compaction
 - b. Concrete field and plant testing & rebar placement
 - c. Asphalt and sub-base inspection
 - d. Soil compaction, density and sieve analysis testing, soil bearing
 - e. Roofing, flashing, waterproofing
 - f. Under slab plumbing work
5. Architect and Owner's Representative shall be notified forty-eight hours prior to the need of testing, in the event the Contractor does not give proper notification and the work is done with no test, that Contractor will bear all costs for such tests.
6. ***All testing costs will be paid for by the Owner except as noted above.***
7. As part of the two-week look ahead, the Prime Contractor shall provide the Construction Manager with a schedule of all anticipated on-site Owner supplied inspections (if any are required). The Prime Contractor shall submit all requests for Owner-supplied inspection for all items of controlled inspection by 1:30 p.m. of the day previous.

IX. CHANGES TO THE WORK

1. Refer to the General Conditions for additional information pertaining to this subject.
2. All change proposals for extra work by the Prime Contractors shall be submitted to the Construction Manager, with a complete labor and material breakdown and on the basis of net difference in quantities. The Owner reserves the right to request adequate back up such as invoices, subcontractor quotes, etc., to substantiate the change order cost. Current labor rates for all trades are to be submitted to the Construction Manager by the respective Prime Contractors at the first scheduled job meeting. When both additions and deductions are involved in any one change, the allowance for overhead and profit shall be figured on the basis of net increase or decrease. All change requests shall include the following breakdown:
 - a. Materials (itemized breakdown)
 - b. Rental of equipment (itemized breakdown)
 - c. Labor (itemized breakdown)
 - d. Insurance
 - e. **Subtotal**
 - f. Overhead 10%
 - g. **Subtotal**
 - h. Subcontractor work (same as above, subcontractor O & P 10%)
 - i. **Subtotal**
 - j. Profit 5%
 - k. **Subtotal**
 - l. Bond charges 2%
 - m. **Total change order**

X. SCHEDULE OF VALUES/PAYMENTS

1. Within one week after Notice to Proceed, the Prime Contractor shall submit a detailed billing breakdown on the AIA G702/ G703 form for approval by Construction Manager. No payments will be made until such billing breakdown is approved.
2. The schedule of values will be reviewed and adjusted if necessary. Once approved, the schedule of values is to be used for the AIA pay application. The schedule of value will take into account and include at minimum the following items:
 - a. Bond/insurance based on actual invoice amount
 - b. Labor and material on line items as applicable
 - c. Submittals - 1% of contract sum
 - d. Punch list - 1% of contract sum
 - e. Close-out documents/warranties - 3% of the contract sum
 - f. Meeting Attendance & Meeting Documentation - 2% of the contract sum
 - g. Allowances
 - h. Approved Alternates
 - i. Labor and Material breakdown for each line item

Note: ALL PAYMENT APPLICATIONS SHALL INCLUDE A 5% RETAINAGE FACTOR.

3. The Owner has elected to require the Prime Contractor to submit releases of liens with respect to all Work previously performed and for which payments were made under a preceding application. Beginning with the second payment requisition and with each

subsequent payment requisition, each Prime Contractor shall furnish to Owner the following documents:

- a. Labor and/or Materials Affidavit
 - b. Daily and Weekly Wage Affidavit
 - c. Prime Contractor's-Partial Release and Wavier of Lien
4. Monthly Payment Applications for Payments shall be made as per Article 9 of the General Conditions of the Contract

XI. PUNCH LIST:

1. Upon substantial completion of each phase of work, the Prime Contractor is to submit to the Owner/Construction Manager a letter declaring the work is substantial complete. Included with said letter is to be the Contractor's punch list. Upon the receipt of above, the Construction Manager will schedule with the Owner, Architect, and Contractor a walk through to develop a single final punch list. This single final punch list agreed by all parties shall serve as the only punch list. Upon failure to complete the final punch list within two weeks from receipt, the Owner reserves the right to complete same and back-charge the costs of material, labor, supervision and other incidental costs.

XII. INSURANCE/INDEMNIFICATION

1. The Prime Contractors must issue a Certificate of Insurance with liability limits as defined in the Construction Documents naming Triton Construction Company, The Architect, and the School District as an 'Additional Insured' in addition to all other parties as stipulated in the General Conditions of the Contract in the project manual.
2. All Prime Contractors agree to indemnify and hold harmless Triton Construction Company, The Architect, the School District, its agents and employees in addition to all other parties as stipulated in the General Conditions of the Contract in the project manual.
3. All Prime Contractors and Sub-Contractors/sub-subcontractor's/vendors/etc. insurance/indemnification shall comply with Article 10 "Insurance" and Article 12 "Indemnification" as specified in the General Conditions of the Contract in the project manual.

Specific Scope Requirements for the Prime Contractor

1. This Prime Contractor shall provide, for all new building construction, and existing building renovation work, all necessary site refuse containers and disposal services to maintain the site in a clean and safe condition. This Prime Contractor shall be responsible for emptying and/or replacing all containers on a regular basis or when full. All containers and disposal services shall be provided by a single entity.
2. This Prime Contractor will employ the necessary laborer for the purpose of maintaining general housekeeping and safety of the work area, including but not limited to all site fencing, erosion and sediment control, and broom cleaning daily. Failure to do so may result in back-charges by the District

3. This Prime Contractor will provide a flag person, when required, at the entrance gates and Public roadways to coordinate deliveries for their work from the street and protect the public.
4. This Prime Contractor shall coordinate all the Electrical, Mechanical, Plumbing, and Civil/ Site Contractors work under this contract. This Prime Contractor to allow other Prime Contractors unabated access to the building and surrounding work areas to complete their work.
5. This Prime Contractor shall provide and maintain temporary chemical toilets for the duration of the project at the new addition, building renovations, and Site work for all Contractors. The quantity of these toilets should be as required to properly maintain sanitary facilities and easy access for the personnel on the job. This quantity shall be one toilet for every ten workers, and a minimum of two toilets per major work area. This requirement shall include all necessary paper products, supplies and services, as well as the maintenance of these toilets until all work is complete and the Owner assumes partial occupancy of the building additions and renovations. As a minimum, this Contractor shall include the pumping and servicing of these toilets twice per week.
6. This Prime Contractor or General Construction will provide, maintain, and remove all temporary construction fencing enclosing construction work areas, or storage and trailer park areas.
7. This Prime Contractor shall include in his bid price, all costs to provide an 8' ht. rental type chain link temporary construction fencing and gates around the entire construction work area. All fencing shall have a tightly woven, blind screen mesh installed on the "construction" side of the fence. Mesh to be dark green or black. When directed by the Construction Manager, this Prime Contractor shall remove and dispose of this fencing and all related materials. Gates for man access shall be passive to the exterior of the jobsite during the event of an emergency but remain closed for un-authorized entry during construction. All gates shall be chain locked when the site is not active, with a double-keyed system, granting the District access to the site after-hours
8. This Prime Contractor shall provide and maintain all temporary protection of existing building floors, walls, doorways, etc. in order to access the construction areas.
9. Construction Signage. The Prime Contractor shall include in his base price all construction signage required by OSHA. At the site fence, "Construction Area keep out", "Hard Hats Required" and "Authorized personal only" signage shall be posted every 25' on site fencing. This Prime Contractor shall reference the logistics plans for each project to include any other signage designated for entry gates. Signs shall be made of either metal or durable PVC to endure the project duration.
10. Professional Cleaning: The Prime Contractor shall provide a professional commercial cleaning service to prepare all areas of interior construction for use and to provide a final cleaning after substantial completion is achieved and after direction to provide such service is received from the Construction Manager. This work shall be completed in cooperation with the building maintenance staff and their respective procedures. As part of this service, this Prime shall wax all new or repaired floors, and wash or clean all walls, doors, windows,

- frames, casework, blinds, unit ventilators, shelves, counters, toilet fixture, sinks, equipment, etc. All work shall be performed in place or on site and does not include sending items out for service or special cleaning operations. Building Services shall provide this Contractor with the necessary paper products, hand soaps, trash liners and other products to fill (one time) any dispensers or accessories in order for these items to be prepared for use.
11. This Prime Contractor is responsible for protection of finished work. Including but not limited to, floors, walls, and doors. This Prime Contractor will provide, maintain, and remove the appropriate protection materials necessary to adequately protect his finished product.
 12. This Prime Contractor should note there are areas where the existing ceilings are remaining. Unless otherwise indicated, This Contractor will be required to remove and reinstall any ceilings displaced by installation of this Contractor's Work. If open ceilings are not replaced within a twenty-four-hour period after a request by the Construction Manager, either verbal or written, the Construction Manager will have said ceilings reinstalled and all related costs will be back charged to said Contractor.
 13. Unless otherwise noted in the construction documents, this Prime Contractor will repair and patch all existing building walls, floors, and ceilings to match adjacent finishes after the removal of interior partitions, ceilings, floors. Each Prime Contractor will cut and cap and patch their own work inside finished walls, floors and ceilings.
 14. Stormwater: This Prime Contractor will be responsible to install sewer and stormwater structures and piping associated with the new building. Stormwater and ponding during the period where final connections have yet to be made will be managed by this Prime Contractor. Ponding of water within or directly outside the site due to construction activities will be mitigated by this Prime contractor, by removing the water by pumping or with re-grading the disturbed area.
 15. Soil Erosion: This Prime Contractor will be responsible to establish and maintain a soil erosion fence around the disturbed site during the entirety of construction until authorized by the Civil Engineer to remove such provisions. This Prime contractor will also provide erosion control at each existing and new nearby storm basin or inlet structure.
 16. Exterior Site underground Trenching: This Prime Contractor will provide coordination for any excavation, bedding, backfill, or support of excavation for any underground utility work required outside the building footprint.
 17. Trenching inside new building footprint: This Prime Contractor will provide coordination for any saw cutting, removal, or patching of existing building slabs, including excavation, bedding, backfill, or support of excavation for any underground utility work required inside the new building or existing building footprint.
 18. This Prime Contractor will remove and dispose of topsoil inside the building footprint, and install stone subbase, water barrier, and concrete slabs. This contractor will provide excavation, compaction, and backfill for new building foundations and footings.
 19. This Prime Contractor will provide all plumbing work associated with the contract documents, including but not limited to Plumbing fixtures, equipment, piping, insulation, signage and tie-ins for a complete assembly of the work.

20. This Prime Contractor will provide all Mechanical work associated with the contract documents, including but not limited to Mechanical fixtures, equipment, piping, insulation, signage and tie-ins for a complete assembly of the work.
21. This Prime Contractor will provide all Electrical work associated with the contract documents, including but not limited to Electrical fixtures, equipment, piping, insulation, signage and tie-ins for a complete assembly of the work.
22. This Prime Contractor shall provide and maintain temporary light and power operational throughout the entire building (normal working hours 7:00 am to 4:00 pm). This applies to all scheduled workdays, Monday through Saturday inclusive, which are established as regular workdays for any trade engaged in the work, including such days that are holidays for Electricians but are regular workdays for other trades. These services are to be kept operational until the CM determines that they are no longer required for the execution of the work.
23. This Prime Contractor is to develop a separate site-specific electrical service shutdown/upgrade schedule within four weeks after Notice to Proceed. This schedule will be developed in conjunction with the Construction Manager and the Owner. No service shutdown/transfer will be permitted at any time without prior written notification.
24. This Prime Contractor shall remove and replace all Asphalt pavements with-in the area of work defined on the construction documents.

Note: The bidder is asked to use either black ink or typewriter (black ribbon) in completing this proposal form. Each line item amount must be completed. Failure to do so will be grounds for disqualification of the bidder.

BASE BID: Contract G – General Construction Work

ITEM 1 – BONDS and INSURANCES

(written in words) _____ (\$)

ITEM 2 – DIVISION 1 – GENERAL REQUIREMENTS

(written in words) _____ (\$)

ITEM 3 – DIVISION 1 – PROJECT SUPERVISION

(written in words) _____ (\$)

ITEM 4 – DIVISION 2 – EXISTING CONDITIONS & DEMOLITION WORK

(written in words) _____ (\$)

ITEM 6 – DIVISION 3 – CONCRETE

(written in words) _____ (\$)

ITEM 7 – DIVISION 4 – MASONRY

(written in words) _____ (\$)

ITEM 8 – DIVISION 5 – METALS

(written in words) _____ (\$)

ITEM 9 – DIVISION 6 – WOOD, PLASTICS AND COMPOSITES

(written in words) _____ (\$)

ITEM 10 – DIVISION 7 – THERMAL AND MOISTURE PROTECTION

(written in words) _____ (\$)

ITEM 11 – DIVISION 7 – PENETRATION FIRESTOPPING

(written in words) _____ (\$)

ITEM 12 – DIVISION 8 - OPENINGS

(written in words) _____ (\$)

ITEM 13 – DIVISION 9 - FINISHES

(written in words) _____ (\$)

ITEM 14 – DIVISION 32 – WATER SUPPLY SYSTEM

(written in words) _____ (\$)

ITEM 15 – DIVISION 22 – PLUMBING EQUIPMENT

(written in words) _____ (\$)

ITEM 16 – DIVISION 22 – ALL OTHER PLUMBING CONTRACT ITEMS

(written in words) _____ (\$)

ITEM 17 – DIVISION 23 – SHEET METAL WORK

(written in words) _____ (\$)

ITEM 18 – DIVISION 23 – DIFFUSERS, REGISTERS & GRILLES

(written in words) _____ (\$)

ITEM 19 – DIVISION 23 – HVAC CONTROLS

(written in words) _____ (\$)

ITEM 20 – DIVISION 23 – ALL OTHER MECHANICAL CONTRACT ITEMS

(written in words) _____ (\$)

ITEM 21 – DIVISION 26 – CONDUIT, CONDUCTORS, BOXES & WIRE TROUGHS

(written in words) _____ (\$)

ITEM 22 – DIVISION 26 – WIRING DEVICES

(written in words) _____ (\$)

ITEM 23 – DIVISION 26 – ELECTRIC SERVICE AND PANEL BOARDS

(written in words) _____ (\$)

ITEM 24 – DIVISION 26 – LIGHTING

(written in words) _____ (\$)

ITEM 25 – DIVISION 28 – ALARM, SIGNAL & DETECTION

(written in words) _____ (\$)

ITEM 26 – DIVISION 26– ALL OTHER ELECTRICAL CONTRACT ITEMS

(written in words) _____ (\$)

ITEM 27 – DIVISION 31 – EARTHWORK

(written in words) _____ (\$)

ITEM 28 – DIVISION 32 – EXTERIOR IMPROVEMENTS

3 (written in words) _____ (\$ _____)
ITEM 29 – DIVISION 33 – UTILITIES
(written in words) _____ (\$ _____)
ITEM 30 – PROJECT CLOSEOUT

(written in words) _____ (\$ _____)

ALLOWANCE G1 – ALLOWANCE FOR GENERAL CONTINGENCY

(written in words) Thirty Thousand Dollars and 00 Cents (\$30,000.00)

TOTAL BASE BID (ITEMS 1 – 29 INCLUSIVE, PLUS ALLOWANCE G1)

(written in words) _____ (\$ _____)

Note: The IRVINGTON UNION FREE SCHOOL DISTRICT is exempt from Federal, New York State and local taxes. TOTAL AMOUNT BID shall be exclusive of all taxes.

EACH BIDDER SHALL SUBMIT WITH IT'S BID A SEPARATE SEALED LIST THAT NAMES THE SUBCONTRACTORS THAT THE BIDDER WILL USE TO PERFORM WORK AND THE AGREED UPON AMOUNT TO BE PAID FOR A.) HEATING, VENTILATION AND AIR-CONDITIONING WORK, B.) PLUMBING WORK AND C.) ELECTRICAL WORK. AFTER THE LOW BID IS ANNOUNCED, THE SEALED LIST OF SUBCONTRACTORS SUBMITTED BY THE APPARENT LOW BIDDER SHALL BE OPENED AND THE NAMES OF THE SUBCONTRACTORS ANNOUNCED. ANY CHANGE OF SUBCONTRACTOR OR AGREED UPON AMOUNT TO BE PAID SHALL REQUIRE THE APPROVAL OF THE PUBLIC OWNER, UPON A SHOWING OF "LEGITIMATE CONSTRUCTION NEED" FOR SUCH CHANGE.

"LEGITIMATE CONSTRUCTION NEED" SHALL INCLUDE, BUT NOT BE LIMITED TO:

A CHANGE IN PROJECT SPECIFICATIONS,
A CHANGE IN CONSTRUCTION MATERIAL COSTS,
A CHANGE IN SUBCONTRACTOR STATUS, OR
THE SUBCONTRACTOR HAS BECOME UNWILLING, UNABLE OR UNAVAILABLE TO PERFORM THE SUBCONTRACT.

THE SEALED LISTS OF SUBCONTRACTORS SUBMITTED BY ALL OTHER BIDDERS SHALL BE RETURNED TO THEM UNOPENED AFTER THE CONTRACT AWARD.

PAYMENTS TO SUBCONTRACTORS AND MATERIAL MEN MUST BE MADE WITHIN 7 CALENDAR DAYS AS OPPOSED TO 15 CALENDAR DAYS OF THE RECEIPT OF PAYMENT FROM THE PUBLIC OWNER. FAILURE TO PAY WITHIN 7 CALENDAR DAYS WILL RESULT IN INTEREST DUE FOR ALL CALENDAR DAYS SUBSEQUENT TO THE SEVENTH DAY THROUGH THE DATE THAT PAYMENT IS MADE.

THE BIDDER UNDERSTANDS THAT THE OWNER RESERVES THE RIGHT TO REJECT ANY OR ALL BIDS AND TO WAIVE ANY INFORMALITIES IN THE BIDDING.

THE BIDDER AGREES THAT THE BID SHALL BE GOOD AND MAY NOT BE WITHDRAWN FOR A PERIOD OF **FORTY-FIVE (45)** CALENDAR DAYS AFTER THE SCHEDULED CLOSING TIME FOR RECEIVING BIDS.

THE BIDDER HAS SUBMITTED ALL REQUESTS FOR OTHER BRAND NAMES OR PRODUCTS NOT LISTED IN THE SPECIFICATIONS IN ACCORDANCE WITH ARTICLE 6(W) OF THE GENERAL CONDITIONS OF THE CONTRACT FOR CONSTRUCTION.

ALTERNATE WORK

THE CONTRACTOR SHALL CLEARLY STATE WHETHER COST INDICATED IS TO BE ADDED TO OR DEDUCTED FROM THE BASE BID COST. FAILURE TO CLEARLY STATE SAME WILL BE GROUNDS FOR DISQUALIFICATION OF THE BIDDER.

ALL WORK INCLUDED UNDER THIS HEADING SHALL BE SUBJECT TO THE GENERAL CONDITIONS OF THE PROJECT. ALL CONSTRUCTION, WORKMANSHIP AND FINISHES REQUIRED BY THE ALTERNATES SHALL BE AS SPECIFIED IN THE APPLICABLE SECTIONS OF THE SPECIFICATIONS MANUAL.

THE BIDDER PROPOSES AND AGREES THAT SHOULD THE FOLLOWING ALTERNATES BE ACCEPTED AND INCLUDED IN THE CONTRACT, THE AMOUNT OF THE TOTAL BASE BID WILL BE REVISED AS FOLLOWS. THE UNDERSIGNED FURTHER AGREES THAT SHOULD THE FOLLOWING ALTERNATES BE ACCEPTED, THE ALTERNATE BID PRICES INDICATED SHALL BE HELD AND HONORED FOR A PERIOD OF ONE YEAR FROM THE DATE OF CONTRACT SIGNING.

NUMBER	DESCRIPTION	COST
C-1	PAVEMENT RESTORATION Provide all labor, material and equipment required and as specified for work related to restoring pavement including but not limited to removal of materials as required, new asphaltic concrete courses and pavement striping, for areas of existing pavement as shown on the contract documents	\$ _____ Is

TOTAL BID (ITEMS 1 – 29 INCLUSIVE, PLUS ALLOWANCE G1 AND ALTERNATE C-1)

(written in words) _____ **(\$)**

UNIT PRICES

THE CONTRACT SHALL INCLUDE UNIT PRICES AS HEREIN STATED. SHOULD THE AMOUNT OF WORK REQUIRED BY THE CONTRACT DOCUMENTS BE INCREASED OR DECREASED, THE FOLLOWING UNIT PRICES SHALL BE USED AS A BASIS FOR COMPUTING THE COST TO THE DISTRICT, OR THE CREDIT DUE THE DISTRICT AS THE CASE MAY BE, FOR SUCH INCREASES OR DECREASES IN THE WORK. THE LISTED UNIT PRICES WILL ALSO BE USED FOR DETERMINING THE VALUE OF QUANTITIES INCLUDED IN THE SPECIFICATIONS. PRICES SHALL REFLECT THE BASIS FOR FURNISHING ALL LABOR, MATERIAL, EQUIPMENT AND OTHER RELATED ITEMS NECESSARY FOR COMPLETION OF WORK (IN PLACE). THE QUOTED FIGURE SHALL INCLUDE CONTRACTOR'S OVERHEAD AND PROFIT.

THE OWNER/ARCHITECT HEREBY RESERVES THE RIGHT TO ORDER ANY ADDITION OR DEDUCTION OF MATERIALS ON BASIS OF UNIT COST FIGURES QUOTED.

NUMBER	DESCRIPTION	COST
CU-1	Trench Rock Provide all labor, material and equipment trench rock and replace with compacted structural fill, to be used as an add or deduct from bid quantities and/or allocation of bid allowance. Unit of Measurement: per cubic yard of trench rock measured in place.	\$ _____cy
CU-2	Rock Excavation / Removal Provide all labor, material and equipment for rock excavation / removal using non-blasting methods and replace with compacted structural fill, to be used from allocation of bid allowance. Unit of Measurement: per cubic yard of rock measured in place.	\$ _____cy

SITE SUPERVISION

THE SUCCESSFUL CONTRACTOR IS TO PROVIDE FULL TIME SITE SUPERVISION FOR HIS OR HER STAFF, SUBCONTRACTORS AND SUPPLIERS FOR THE DURATION OF THIS PROJECT. A COMPETENT SUPERINTENDENT SHALL BE IN ATTENDANCE AT THE JOB SITE AT ALL TIMES WHEN WORK IS BEING PERFORMED UNDER THEIR CONTRACT. THE SUPERINTENDENT IS RESPONSIBLE TO VISIT THE JOB SITE DAILY WHEN WORK IS NOT BEING PERFORMED UNDER THEIR CONTRACT AND TO MONITOR THE OVERALL CONSTRUCTION PROGRESS. A QUALIFIED SITE SUPERINTENDENT MUST HAVE THE AUTHORITY TO REPRESENT AND MAKE DECISIONS FOR HIS OR HER COMPANY WITH REGARDS TO THE SUBJECT JOB, MUST BE ABLE TO GIVE GUIDANCE AND DIRECTION TO EMPLOYEES, SUBCONTRACTORS AND SUPPLIERS, AND MUST BE KNOWLEDGEABLE ABOUT THE WORK TO BE PROVIDED. FAILURE TO PROVIDE A QUALIFIED SITE SUPERINTENDENT AT THE JOB SITE SHALL SUBJECT SAID PRIME CONTRACTOR TO A PENALTY OF \$1,000 PER DAY FOR EVERY OCCURRENCE.

TIME OF COMPLETION

ALL WORK UNDER THIS CONTRACT SHALL BE COMPLETED BETWEEN THE FOLLOWING HOURS, IN ACCORDANCE WITH THE FOLLOWING DATES:

WORK DAYS:	MONDAY – FRIDAY
WORK HOURS:	7:00 AM – 5:00 PM
WEEKEND WORK DAYS:	SATURDAY
WEEKEND WORK HOURS:	9:00 AM – 5:00 PM
CONSTRUCTION START DATE:	MONDAY, JUNE 27, 2022
SUBSTANTIAL COMPLETION:	TUESDAY, AUGUST 30, 2022

FINAL COMPLETION:

FRIDAY, SEPTEMBER 30, 2022

IF NECESSARY, WEEKEND, HOLIDAY AND EVENING WORK SHALL BE PROVIDED TO ENSURE THE COMPLETION DATES LISTED ABOVE, AT THE SOLE COST AND EXPENSE OF THE BIDDER.

FAILURE OF THE CONTRACTOR TO COMPLETE WORK BY THE SPECIFIED TIME SHALL SUBJECT HIM/HER TO LIQUIDATED DAMAGES AS SET FORTH IN ARTICLE 13 OF THE GENERAL CONDITIONS.

THE ARCHITECT/ENGINEER SHALL ACT AS THE RECORD KEEPER OF CONTRACT DAYS; HE WILL BE THE SOLE JUDGE OF DELAYS CAUSED BY WEATHER. ONLY WEATHER DELAYS, AS ADJUDGED BY THE ARCHITECT/ENGINEER, WILL BE CONSIDERED FOR EXTENSIONS OF THE CONSTRUCTION PERIOD. THE CONTRACTOR SHALL SUBMIT A BI-WEEKLY REQUEST FOR DELAYS DUE TO WEATHER TO THE ARCHITECT/ENGINEER FOR APPROVAL. NO OTHER DELAY CLAIMS WILL BE ACCEPTED, FOR CREDIT TOWARDS THE PROJECT COMPLETION SCHEDULE, REGARDLESS OF THE SOURCE OF THE DELAY.

FAILURE OF THE CONTRACTOR TO COMPLETE ALL WORK SHOWN AND SPECIFIED IN THE CONTRACT DOCUMENTS, BY ALL OF THE SPECIFIED TIME FRAMES, SHALL SUBJECT THE CONTRACTOR TO LIQUIDATED DAMAGES, AS SET FORTH IN ARTICLE 13 OF THE GENERAL CONDITIONS OF THE CONTRACT FOR CONSTRUCTION, IN THE SUM OF ONE THOUSAND DOLLARS (\$1,000.00) PER CALENDAR DAY. SUCH DAMAGES WILL COMMENCE ON THE DAY AFTER THE COMPLETION DATE OR THE DAY AFTER ANY LISTED MILESTONE DATE IN THE NOTICE TO PROCEED.

WITHIN TEN (10) CONSECUTIVE CALENDAR DAYS AFTER THE DATE OF THE NOTICE OF AWARD, THE BIDDER SHALL EXECUTE THE CONTRACT AND FURNISH THE REQUIRED PERFORMANCE BOND, PAYMENT BOND AND INSURANCES.

THE BOARD OF EDUCATION OF THE DISTRICT RESERVES THE RIGHT TO AWARD THIS CONTRACT TO OTHER THAN THE LOW BIDDER IF THE LAW SO PERMITS.

THE UNDERSIGNED HEREBY ACKNOWLEDGES RECEIPT OF THE FOLLOWING ADDENDA (IF ANY):

ADDENDUM NO.

DATED

SPECIFIC DAMAGES WILL BE ASSESSED AND DEDUCTED FROM AMOUNTS OTHERWISE DUE THE CONTRACTOR FOR ADDITIONAL INSPECTION (FIELD) AND CONTRACT ADMINISTRATION (OFFICE) TIME EXPENDED BY THE ARCHITECT/ENGINEER AND/OR OTHER CONSTRUCTION EMPLOYEE(S) HIRED TO ADMINISTER OR OBSERVE THE CONTRACT, SHOULD THE CONTRACTOR COMPLETE THE CONTRACT BEYOND THE CONTRACT COMPLETION PERIOD SPECIFIED ABOVE.

SUCH DEDUCTION SHALL BE IN ACCORDANCE WITH THE ARCHITECT, ENGINEER'S, AND/OR OTHER CONSTRUCTION EMPLOYEE(S) STANDARD HOURLY BILLING RATES IN EFFECT AT THE TIME FOR THE SCHOOL DISTRICT.

THE REQUIREMENTS OF THE PROPOSAL HAVE BEEN COMPLETELY READ, UNDERSTOOD AND ACKNOWLEDGED BY THE BIDDER.

BIDDER: _____

NOTICE TO BIDDERS
IRVINGTON UNION FREE SCHOOL DISTRICT



BIDDER'S ADDRESS: _____

SIGNED BY: _____ TITLE: _____

DATE: _____

Telephone number where the contractor or a competent representative can accept a telephone message and provide a reasonable reply as soon as possible, but not later than twenty-four (24) hours:

DAY: () _____ NIGHT: () _____

FAX: () _____

FEDERAL I.D. NO. OR SOCIAL SECURITY NO.: _____

PART 1 GENERAL

1.01 SECTION INCLUDES

- A. Manufactured metal panels for soffits, with related flashings and accessory components.

1.02 REFERENCE STANDARDS

- A. AAMA 609 & 610 - Cleaning and Maintenance Guide for Architecturally Finished Aluminum (Combined Document); 2015.
- B. ASTM A653/A653M - Standard Specification for Steel Sheet, Zinc-Coated (Galvanized) or Zinc-Iron Alloy-Coated (Galvannealed) by the Hot-Dip Process; 2015.
- C. ASTM B209 - Standard Specification for Aluminum and Aluminum-Alloy Sheet and Plate; 2014.

1.03 SUBMITTALS

- A. See Section 013300 - SUBMITTALS, for submittal procedures.
- B. Shop Drawings: Indicate dimensions, layout, joints, construction details, methods of anchorage, and elevations indicating material type, finish and direction of rib installation..
- C. Samples: Submit two samples of wall panel and soffit panel, by 18 inch (____ mm) in size or one complete 12 inch long section of panel illustrating finish color, sheen, and texture.

1.04 QUALITY ASSURANCE

- A. Manufacturer Qualifications: Company specializing in manufacturing the products specified in this section with minimum ten years of documented experience.
- B. Installer Qualifications: Company specializing in installing the products specified in this section with minimum five years of documented experience.
- C. Source Limitations: Obtain all components from a single manufacturer. Secondary products that are required shall be recommended and approved in writing by the Manufacturer.
 - 1. Upon request of the Architect or Owner, submit Manufacturer's written approval of secondary components in list form, signed by an authorized agent of the Manufacturer.
 - 2. Manufacturer shall have direct authority and control over all fabrication of steel components as well as the raw materials used in their fabrication.

1.05 MOCK-UP

- A. Construct mock-up, 12 feet (____ m) long by 8 feet (____ m) wide or as directed by the Architect; include panel system, attachments to building frame, associated vapor retarder and air seal materials, weep drainage system, sealants and seals, related insulation, and connections to adjoining materials in mock-up.
- B. Locate where directed.
- C. Mock-up may remain as part of the Work.

1.06 DELIVERY, STORAGE, AND HANDLING

- A. Manufacturer's responsibilities:
 - 1. All panels shall be shipped from the manufacturer with polystyrene or similar cushioned packaging material separating the individual panels to minimize flexing, stressing, scratching or otherwise damaging the material during transit to the job.
 - 2. Fully cover materials with tarpaulins or similar protective cover during transit to prevent dirt and debris from coming in contact with the finished goods.
- B. Inspect materials upon delivery. Reject and remove physically damaged or marred material from project site.
- C. Protect panels from accelerated weathering by removing or venting sheet plastic shipping wrap.
- D. Store prefinished material off ground and protected from weather. Prevent twisting, bending, or abrasion, and provide ventilation to stored materials. Slope metal sheets to ensure drainage.
- E. Prevent contact with materials that may cause discoloration or staining of products.

1.07 WARRANTY

- A. See Section 017800 - CLOSEOUT SUBMITTALS, for additional warranty requirements.
- B. Correct defective Work within a five year period after the Date of Substantial Completion, including defects in water tightness and integrity of seals.
- C. Additional Special Warranties:
 - 1. Manufacturer's standard twenty (20) year finish warranty covering checking, crazing, peeling, chalking, fading, or adhesion.
 - 2. Installer's two (2) year warranty covering panel system installation.
- D. Warranties shall commence on date of Substantial Completion.

PART 2 PRODUCTS

2.01 MANUFACTURERS

- A. Metal Soffit Panels:
 - 1. ATAS International, Inc; Wind-Lok Soffit MPS120 and MPV120 panels:
www.atas.com/sle.
 - a. Finish: KYNAR 500 PVDF. Finish thickness shall provide a 1.0 mil dry film thickness consisting of a primer and finish color coat.
 - b. Color shall be as selected by the Architect from the manufacturers full color offering.
 - 2. The Garland Company: R-MER Soffit System.
The Garland Company
3800 East 91st Street
Cleveland, Ohio 44105
Telephone: (800) 762-8225
Website: www.garlandco.com
 - 3. Or approved equal
 - 4. Substitutions: See 012500 - PRODUCT SUBSTITUTION PROCEDURES.

2.02 MATERIALS

- A. Precoated Steel Sheet: Hot-dipped galvanized steel sheet, ASTM A653/A653M Structural Steel (SS) or Forming Steel (FS), with G90/Z275 coating; continuous coil-coated on exposed surfaces with specified finish coating and on panel back with specified panel back coating.
- B. Precoated Aluminum Sheet: ASTM B209 (ASTM B209M), 3105 alloy, H14 smooth surface texture; continuous-coil-coated on exposed surfaces with specified finish coating and on panel back with specified panel back coating.

2.03 ACCESSORIES

- A. Sealants:
 - 1. Exposed Sealant: Elastomeric; silicone, polyurethane, or silyl-terminated polyether/polyurethane.
 - 2. Concealed Sealant: Non-curing butyl sealant or tape sealant.
 - 3. Color: Color of sealants shall match the approved panel color unless directed otherwise by the Architect.
- B. Fasteners: Manufacturer's standard type to suit application; with soft neoprene washers, steel, hot dip galvanized. Exposed fasteners same finish as panel system.
 - 1. Metal-to-Metal Fasteners: Self-drilling, self-tapping screws.
 - 2. Products:
 - a. ITW Commercial Construction North America; Teks Select Series: www.ITWBuildex.com.
- C. Field Touch-up Paint: As recommended by panel manufacturer.
- D. Bituminous Paint: Asphalt base.

PART 3 EXECUTION

3.01 EXAMINATION

- A. Verify that building framing members are ready to receive panels.
- B. Verify that weather barrier has been installed over substrate completely and correctly.

3.02 PREPARATION

- A. Install subgirts perpendicular to panel length, securely fastened to substrates and shimmed and leveled to uniform plane. Space at intervals indicated.

3.03 INSTALLATION

- A. Install panels on soffits in accordance with manufacturer's instructions.
- B. Manufacturer shall provide all details on their shop drawings provided to the contractor; the manufacturer approved installation contractor shall install soffit and flashings in accordance with approved shop drawings and manufacturer's product data, within specified erection tolerances.

- C. Protect surfaces in contact with cementitious materials and dissimilar metals with bituminous paint. Allow to dry prior to installation.
- D. Install metal soffit panels over the completed soffit substrate fastened into the structural substrate with compatible / non-corrosive screw type fasteners at twelve (12) inches o.c. maximum spacing along each panel seam, unless a closer spacing is required by the manufacturer to meet local wind loading conditions.
- E. Fasten panels to structural supports; aligned, level, and plumb.
- F. Locate joints over supports. Lap panel ends minimum 2 inches (51 mm).
- G. Provide expansion joints where indicated.
- H. Coordinate flashing and sheet metal work to provide weathertight conditions at soffit terminations. Fabricate and install in accordance with standard of SMACNA Manual.
- I. Use concealed fasteners unless otherwise approved by Architect.
- J. Seal and place gaskets to prevent weather penetration. Maintain neat appearance.

3.04 TOLERANCES

- A. Maximum Offset From True Alignment Between Adjacent Members Butting or In Line: 1/16 inch (1.6 mm).
- B. Maximum Variation from Plane or Location Indicated on Drawings: 1/8 inch (3.2 mm).

3.05 CLEANING

- A. Remove site cuttings from finish surfaces.
- B. Clean and wash prefinished surfaces with mild soap and water; rinse with clean water in accordance with the manufacturer's directions.
- C. Replace damaged work that cannot be restored by normal cleaning methods.
- D. Upon completion of installation, thoroughly clean prefinished aluminum surfaces in accordance with AAMA 609 & 610.


END OF SECTION

IRVINGTON UNION FREE SCHOOL DISTRICT
FACILITIES STORAGE BUILDING

40 N. BROADWAY, IRVINGTON, NY 10533

SED PROJECT CONTROL NUMBER 66-04-02-02-2-022-001


CONTRACT G - GENERAL CONSTRUCTION, HVAC CONSTRUCTION, ELECTRICAL CONSTRUCTION,
PLUMBING CONSTRUCTION, CIVIL & SITE WORK

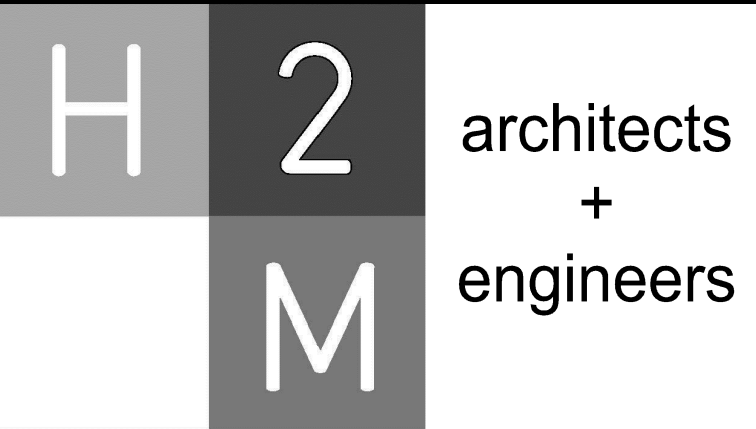

2700 Westchester Avenue, Suite 415
Purchase, NY 10577
914.358.5623 www.h2m.com

CONSULTANTS:

MARK	DATE	DESCRIPTION
3	12/14/2021	ADDENDUM #3
2	12/10/2021	ADDENDUM #2
1	12/01/2021	ADDENDUM #1
	11/18/2021	FINAL BID DOCUMENT

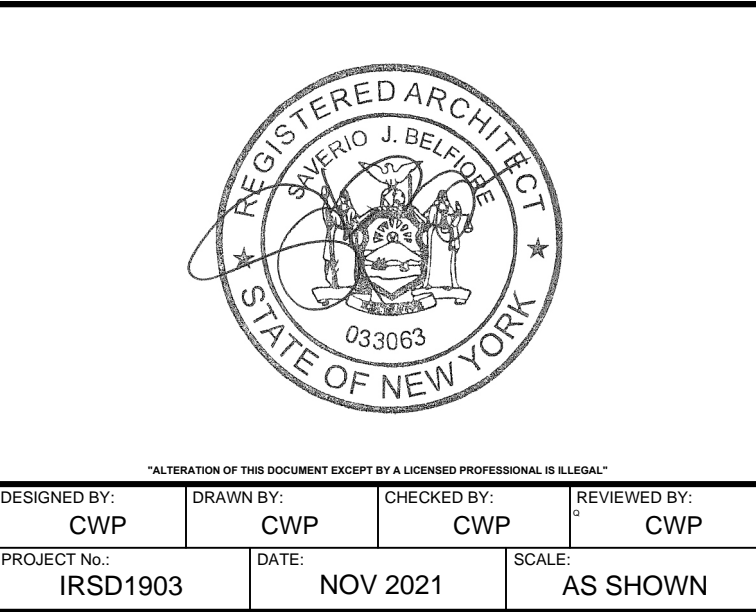

CLIENT
Irvington Union Free School District

Facilities Storage Building at Irvington Campus



Irvington Campus
40 N. Broadway
Irvington, NY 10533

SED Number:66-04-02-02-2-022-001

CONTRACT
**CONTRACT G
GENERAL CONSTRUCTION**

STATUS
FINAL BID DOCUMENT

SHEET TITLE
**GENERAL NOTES, ABBREVIATIONS
DRAWING LIST, STAGING PLAN,
LOCATION MAP AND LEGEND**


DRAWING NO.
G0.0

ABBREVIATIONS				GENERAL NOTES	DRAWING LIST		STAGING PLAN
AB	ANCHOR BOLT	FAI	FRESH AIR INTAKE	<div>1. ALL WORK SHALL COMPLY WITH THE 2020 BUILDING CODE OF NEW YORK STATE, 2020 FIRE CODE OF NEW YORK STATE AND THE NEW YORK STATE EDUCATION DEPARTMENT MANUAL OF PLANNING STANDARDS.</div> <div>2. ALL NOTES APPEARING HEREIN, WITH THOSE ON VARIOUS DRAWINGS SHALL APPLY TO ALL DRAWINGS AND FORM PART OF THE CONTRACT DOCUMENTS.</div> <div>3. IT IS THE CONTRACTORS RESPONSIBILITY TO FIELD VERIFY ALL DIMENSIONS, SQUARE FOOTAGES, LOCATIONS AND QUANTITIES OF ALL ITEMS AND/OR SPACES WHETHER INDICATED IN THE DRAWINGS OR NOT.</div> <div>4. DO NOT SCALE MEASURE ANY DRAWING. VERIFY THE FIGURES, DIMENSIONS AND DESIGN INTENTION SHOWN ON THE DRAWINGS BEFORE BEGINNING LAYOUT OF THE WORK AND REPORT ANY ERRORS, INACCURACIES, OR CONFLICTS TO THE ARCHITECT/ENGINEER IN WRITING BEFORE BEGINNING ANY WORK.</div> <div>5. ALL WORK SHALL COMPLY WITH ALL APPLICABLE CODES, LAWS AND STATUTES AS REQUIRED. STRICTLY ADHERE TO MANUFACTURER'S PRINTED INSTRUCTIONS.</div> <div>6. VERIFY EXACT LAYOUT COMPATIBILITY WITH ALL EXISTING CONDITIONS BEFORE BEGINNING WORK.</div> <div>7. DISTURB ONLY THOSE AREAS OF THE SITE AFFECTED BY RENOVATION, UNLESS NOTED OTHERWISE. PROTECT ALL OTHER AREAS. CONTRACTORS SHALL BE RESPONSIBLE FOR ALL PATCH AND REPAIR OF EXISTING FINISHES WHICH ARE DAMAGED DURING CONSTRUCTION.</div> <div>8. EACH CONTRACTOR SHALL COMPLY WITH THE REQUIREMENTS OF ANSI AND PROVIDE WHERE APPLICABLE ADA COMPLIANT BUILDING COMPONENTS.</div> <div>9. THE OWNER RESERVES THE RIGHT AT ALL TIMES TO DELIVER, PLACE AND INSTALL EQUIPMENT AND FURNISHINGS AS THE WORK PROGRESSES SO LONG AS THERE IS NOT A CONFLICT WITH THE CONTRACTORS.</div> <div>10. THE CONTRACTOR SHALL MAINTAIN AT THE SITE ONE RECORD COPY OF ALL DRAWINGS, SPECIFICATIONS AND APPROVED SHOP DRAWINGS AND APPROVED SAMPLES MARKED CURRENTLY TO RECORD ALL CHANGES DURING CONSTRUCTION.</div> <div>11. ANY CHANGES TO THE SCOPE OF WORK OR IN THE CONSTRUCTION DETAILS, WHETHER DUE TO FIELD CONDITIONS OR OMISSION SHALL BE DOCUMENTED BY THE ARCHITECT PRIOR TO EXECUTION. ANY INCREASE OR DECREASE IN THE CONTRACT PRICE MUST BE APPROVED IN WRITING PRIOR TO EXECUTION.</div> <div>12. THE CONTRACTOR BY PRESENTING THEIR BID FOR THE WORK, REPRESENTS THAT HE/SHE HAS INSPECTED THE SITE AND IS COMPLETELY FAMILIAR WITH THE SCOPE OF WORK AND ALL FIELD CONDITIONS RELATED TO, AND AFFECTING THE WORK AND ITS PERFORMANCE. EXCEPTIONS AFFECTING THE WORK AND ITS PERFORMANCE, OR CONFLICTS BETWEEN FIELD CONDITIONS, SHALL BE BROUGHT TO THE ATTENTION OF THE ARCHITECT PRIOR TO THE SUBMISSION OF BIDS. FAILURE TO DO SO WILL NOT RESULT IN A CHANGE TO THE CONTRACT PRICE IT SHALL BE THE CONTRACTOR'S SOLE RESPONSIBILITY TO PROVIDE ALL NECESSARY ACCOMMODATIONS TO COMPLETE THE SCOPE OF WORK.</div>	<div>INFORMATIONAL DRAWINGS</div> <div>G.0.0 GENERAL NOTES, MAPS, DRAWING LIST, STAGING PLAN, EXIT PLAN & LEGENDS</div> <div>G.1.0 CODE ANALYSIS</div> <div>G.1.1 COM CHECK</div> <div>CIVIL DRAWINGS</div> <div>CD100.00 EXISTING CONDITIONS AND DEMOLITION SITE PLAN</div> <div>C100.00 SITE IMPROVEMENT PLAN</div> <div>C101.00 SANITARY ALIGNMENT PLAN</div> <div>C500.00 SITE DETAILS</div> <div>STRUCTURAL DRAWINGS</div> <div>S001.00 GENERAL NOTES</div> <div>S100.00 FOUNDATION PLAN</div> <div>S101.00 SLAB PLAN</div> <div>S102.00 ROOF FRAMING PLAN</div> <div>S300.00 STRUCTURAL SECTIONS</div> <div>S500.00 STRUCTURAL DETAILS</div> <div>ARCHITECTURAL DRAWINGS</div> <div>A1.0 FLOOR PLAN & REFLECTED CEILING PLAN</div> <div>A1.1 ROOF PLAN</div> <div>A2.0 ELEVATIONS</div> <div>A3.0 BUILDING SECTION AND WALL SECTION</div> <div>A6.0 DOOR SCHEDULE AND DETAILS</div> <div>PLUMBING DRAWINGS</div> <div>P0.0 PLUMBING NOTES, LEGEND ABBREVIATIONS, AND SCHEDULES</div> <div>P1.0 SITE PLAN AND EXISTING BASEMENT PLAN</div> <div>P2.0 GROUND FLOOR PLANS</div> <div>P3.0 PLUMBING DETAILS</div> <div>P4.0 PLUMBING RISER DIAGRAMS</div> <div>HVAC DRAWINGS</div> <div>H0.0 HVAC LEGENDS, SYMBOLS, ABBREVIATIONS, AND GENERAL NOTES</div> <div>H1.0 HIGH SCHOOL FACILITIES STORAGE BUILDING HVAC CONSTRUCTION</div> <div>ELEVATION DRAWINGS</div> <div>E0.0 ELECTRICAL LEGENDS</div> <div>E1.0 ELECTRICAL SITE PLAN</div> <div>E2.0 ELECTRICAL PARTIAL LOWER LEVEL CAFE - SCIENCE - MUSIC BUILDING POWER PLAN</div> <div>E2.1 ELECTRICAL FACILITIES STORAGE BUILDING PLAN</div> <div>E3.0 ELECTRICAL SINGLE LINE DIAGRAM, DETAILS AND SCHEDULES</div>		<div>STAGING NOTES</div> <div>1. POST SIGNS INDICATING CONSTRUCTION AREA AND CONSTRUCTION EMPLOYEE ENTRANCE.</div> <div>2. CONSTRUCTION FENCE TO BE 8'-0" HIGH CHAIN LINK FENCE LOCATED A MINIMUM OF 15'-0" FROM ALL WINDOW OPENINGS. ALL GATES ARE TO BE LOCKED AT ALL TIMES, EXCEPT FOR WHEN A WORKER IS IN ATTENDANCE TO PREVENT UNAUTHORIZED ENTRY.</div> <div>3. CONTRACTOR IS TO STAGE ON THE SITE IN SUCH A MANNER AS TO NOT BLOCK OR ENCR OACH UPON EXISTING EXITS/ENTRANCES TO BUILDING, AND VEHICLE ACCESS.</div> <div>RENOVATION OF INTERIOR FINISHES WORK IS SCHEDULED TO BE COMPLETED DURING THE SUMMER RECESS WHEN SCHOOL IS NOT IN SESSION AND THEREFORE WILL NOT HAVE AN IMPACT ON STUDENT ENTRANCE/EXIT EGRESS.</div>
AC	AIR CONDITIONING	F.C.	FIRE CODE				
ACI	AMERICAN CONCRETE INSTITUTE	FD	FLOOR DRAIN				
ACST	ACOUSTIC	FIN	FINISH				
ACT	ACOUSTICAL CEILING TILE	FR	FIRE RETARDANT				
ACU	AIR CONDITIONING UNIT	FTG	FOOTING				
AD	ACCESS DOOR ADJUSTABLE	GA	GAUGE				
ADJ	A/E ARCHITECT/ENGINEER	GWB	GYPSUM WALL BOARD				
AFF	ABOVE FINISH FLOOR	GYP	GYPSUM				
ALUM	ALUMINUM	GYP. BD.	GYPSUM BOARD				
ANCH	ANCHOR ANSI AMERICAN NATIONAL STANDARDS INSTITUTE	HC	HANDICAPPED				
		HM	HOLLOW METAL				
		HOR	HORIZONTAL				
		HW	HOT WATER				
APA	ACCESS PANEL	INSUL	INSULATION/INSULATING				
APPROX	APPROXIMATELY	INT	INTERIOR				
ASPH	ASPHALT	LAV	LAVATORY				
ASTM	AMERICAN SOCIETY FOR TESTING & MATERIALS	LDR	LEADER				
		LT	LIGHT				
AWS	AMERICAN WELDING SOCIETY	MAX	MAXIMUM				
B	FIRE BLANKET	MECH	MECHANICAL				
BAL	BALANCE	MISC	MISCELLANEOUS				
BB	BULLETIN BOARD	MO	MASONRY OPENING				
BD	BOARD	MR	MOISTURE RESISTANT				
BLDG	BUILDING	NIC	NOT IN CONTRACT				
BLK	BLOCK	NTS	NOT TO SCALE				
BLKG	BLOCKING	OC	ON CENTER				
BM	BEAM	OD	OUTSIDE DIAMETER				
B.O.	BOTTOM OF	PLYWD	PLYWOOD				
BOL	BOTTOM OF LINTEL	PSF	POUNDS PER SQUARE FOOT				
BOT	BOTTOM	PSI	POUNDS PER SQUARE INCH				
CEL	CEILING	PTD	PAINTED				
CEM	CEMENT	PVC	POLYVINYL CHLORIDE				
CER	CERAMIC	R	RADIUS OR RISER				
CLO	CLOSET	RCP	REFLECTED CEILING PLAN				
CMU	CONCRETE MASONRY UNIT	RD	ROOF DRAIN				
COL	COLUMN	REINF	REINFORCED				
CONC	CONCRETE	RM	ROOM				
CONST	CONSTRUCTION	RO	ROUGH OPENING				
CONT	CONTINUOUS	SIM	SIMILAR				
CORR	CORRIDOR	SPEC	SPECIFICATIONS				
CPT	CARPET	SQ	SQUARE				
DS	DOWNSPOUT	SS	STAINLESS STEEL				
DW	DISHWASHER	STL	STEEL				
DWG	DRAWING	TEMP	TEMPERATURE				
EA	EACH	TER	TERRAZZO				
EL	ELEVATION	THK	THICK				
ELEC	ELECTRIC/ELECTRICAL	TYP	TYPICAL				
ELEV	ELEVATOR	UTIL	UTILITY				
EP	ELECTRICAL PANEL	VB	VAPOR BARRIER				
EPY	EPOXY COATING	VCT	VINYL COMPOSITION TILE				
EQ	EQUAL	VERT	VERTICAL				
EQUIP	EQUIPMENT	VTR	VENT THRU ROOF				
EXIST	EXISTING	WC	WATER CLOSET				
EXST	EXHAUST	WH	WATER HEATER				
		WWF	WELDED WIRE FABRIC				

LOCATION MAP	SYMBOLS LEGEND		UNIFORM SAFETY STANDARDS - FOR SCHOOL CONSTRUCTION AND MAINTENANCE PROJECTS (NYSED 155.5 REGULATION)																																											
	<table><thead><tr><th>DESCRIPTION</th><th>SYMBOL</th><th>DESCRIPTION</th><th>SYMBOL</th></tr></thead><tbody><tr><td>ROOM DESIGNATION</td><td></td><td>GYPSUM</td><td></td></tr><tr><td></td><td></td><td>CONCRETE</td><td></td></tr><tr><td>SECTION MARK</td><td></td><td>AGGREGATE SUB-BASE</td><td></td></tr><tr><td></td><td></td><td>EARTH</td><td></td></tr><tr><td>DETAIL SYMBOL</td><td></td><td>BATT INSULATION</td><td></td></tr><tr><td>ELEVATION KEY</td><td></td><td>PLYWOOD</td><td></td></tr><tr><td>INTERIOR ELEVATION REFERENCE</td><td></td><td>RIGID INSULATION</td><td></td></tr><tr><td>ELEVATION LINE</td><td></td><td>STEEL</td><td></td></tr><tr><td>REVISION</td><td></td><td>WOOD</td><td></td></tr><tr><td>PARTITION TYPE</td><td></td><td>WOOD BLOCKING</td><td></td></tr></tbody></table>	DESCRIPTION	SYMBOL	DESCRIPTION	SYMBOL	ROOM DESIGNATION		GYPSUM				CONCRETE		SECTION MARK		AGGREGATE SUB-BASE				EARTH		DETAIL SYMBOL		BATT INSULATION		ELEVATION KEY		PLYWOOD		INTERIOR ELEVATION REFERENCE		RIGID INSULATION		ELEVATION LINE		STEEL		REVISION		WOOD		PARTITION TYPE		WOOD BLOCKING		<p>1. "THE OCCUPIED PORTION OF ANY SCHOOL BUILDING SHALL ALWAYS COMPLY WITH THE MINIMUM REQUIREMENTS NECESSARY TO MAINTAIN A CERTIFICATE OF OCCUPANCY."</p> <p>THE OCCUPIED PORTION OF ANY SCHOOL BUILDING SHALL COMPLY WITH THE COMMISSIONER OF EDUCATION 155.5 - UNIFORM SAFETY STANDARDS.</p> <p>2. PORTIONS OF WORK TO BE DISTURBED DURING THIS PROJECT ARE KNOWN TO CONTAIN ASBESTOS AND SHALL BE ABATED AS SHOWN.</p> <p>3. "GENERAL SAFETY AND SECURITY STANDARDS FOR CONSTRUCTION PROJECTS:</p> <p>(1) ALL CONSTRUCTION MATERIALS SHALL BE STORED IN A SAFE AND SECURE MANNER.</p> <p>(2) FENCES AROUND CONSTRUCTION SUPPLIES OR DEBRIS SHALL BE MAINTAINED.</p> <p>(3) GATES SHALL ALWAYS BE LOCKED UNLESS A WORKER IS IN ATTENDANCE TO PREVENT UNAUTHORIZED ENTRY.</p> <p>(4) DURING EXTERIOR RENOVATION WORK, OVERHEAD PROTECTION SHALL BE PROVIDED FOR ANY SIDEWALKS OR AREAS IMMEDIATELY BENEATH THE WORK SITE OR SUCH AREAS SHALL BE FENCED OFF AND PROVIDED WITH WARNING SIGNS TO PREVENT ENTRY.</p> <p>(5) WORKERS SHALL BE REQUIRED TO WEAR PHOTO-IDENTIFICATION BADGES AT ALL TIMES FOR IDENTIFICATION AND SECURITY PURPOSES WHILE WORKING AT OCCUPIED SITES."</p> <p>4. "SEPARATION OF CONSTRUCTION AREAS FROM OCCUPIED SPACES: CONSTRUCTION AREAS WHICH ARE UNDER THE CONTROL OF A CONTRACTOR AND THEREFORE NOT OCCUPIED BY DISTRICT STAFF OR STUDENTS SHALL BE SEPARATED FROM OCCUPIED AREAS. PROVISIONS SHALL BE MADE TO PREVENT THE PASSAGE OF DUST AND CONTAMINANTS INTO OCCUPIED PARTS OF THE BUILDING. PERIODIC INSPECTION AND REPAIRS OF THE CONTAINMENT BARRIERS MUST BE MADE TO PREVENT EXPOSURE TO DUST OR CONTAMINANTS. GYPSUM</p> <p>BOARD MUST BE USED IN EXIT WAYS OR OTHER AREAS THAT REQUIRE FIRE RATED SEPARATION. HEAVY DUTY PLASTIC SHEETING MAY BE USED ONLY FOR A VAPOR, FINE DUST OR AIR INFILTRATION BARRIER, AND SHALL NOT BE USED TO SEPARATE OCCUPIED SPACES FROM CONSTRUCTION AREAS.</p> <p>(1) A SPECIFIC STAIRWELL AND/OR ELEVATOR SHALL BE ASSIGNED OR CONSTRUCTION WORKER USE DURING WORK HOURS. IN GENERAL, WORKERS MAY NOT USE CORRIDORS, STAIRS OR ELEVATORS DESIGNATED FOR STUDENTS OR SCHOOL STAFF. WHERE NO STAIRWELL AND/OR ELEVATOR IS ASSIGNED, WORKERS MUST ENTER THE CONSTRUCTION SPACES DIRECTLY FROM THE BUILDING EXTERIOR.</p> <p>(2) LARGE AMOUNTS OF DEBRIS MUST BE REMOVED BY USING ENCLOSED CHUTES OR A SIMILAR SEALED SYSTEM. THERE SHALL BE NO MOVEMENT OF DEBRIS THROUGH HALLS OF OCCUPIED SPACES OF THE BUILDING. NO MATERIAL SHALL BE DROPPED OR THROWN OUTSIDE THE WALLS OF THE BUILDING.</p> <p>(3) ALL OCCUPIED PARTS OF THE BUILDING AFFECTED BY RENOVATION ACTIVITY SHALL BE CLEANED AT THE CLOSE OF EACH WORKDAY. SCHOOL BUILDINGS OCCUPIED DURING A CONSTRUCTION PROJECT SHALL MAINTAIN REQUIRED HEALTH, SAFETY AND EDUCATIONAL CAPABILITIES AT ALL TIMES THAT CLASSES ARE IN SESSION."</p> <p>5. A PLAN DETAILING HOW EXITING REQUIRED BY THE APPLICABLE BUILDING CODE WILL BE MAINTAINED.</p> <p>6. WORK UNDER THIS CONTRACT WILL BE CONDUCTED DURING THE SUMMER RECESS OR DURING AFTER SCHOOL HOURS WHEN THE BUILDING IS UNOCCUPIED. IF THE BUILDING BECOMES OCCUPIED THE CONTRACTOR SHALL BE RESPONSIBLE TO MAINTAIN ALL EXISTING MEANS OF EGRESS IN A CLEAR AND FREE MANNER, INCLUDING THE STORAGE OF MATERIALS AND STAGING OF EQUIPMENT ON THE SITE. IF ANY PORTION OF THE BUILDING DOES BECOME OCCUPIED THE ARCHITECT WILL PROVIDE A DETAILED PLAN FOR EXITING, OVERHEAD PROTECTION AND EGRESS IN ACCORDANCE WITH APPLICABLE BUILDING CODES.</p> <p>7. A PLAN DETAILING HOW ADEQUATE VENTILATION WILL BE MAINTAINED DURING CONSTRUCTION.</p> <p>8. WORK UNDER THIS PROJECT WILL BE COMPLETED DURING OFF HOURS WHEN THE BUILDING WILL NOT BE OCCUPIED BY FACULTY, STAFF OR STUDENTS. IF A PORTION OF THE BUILDING IS TO BECOME OCCUPIED DURING THE CONSTRUCTION PROCESS THE CONTRACTOR SHALL CLOSE OFF ALL INTAKES, OPENINGS, AND MECHANICAL VENTILATION SYSTEMS ADJACENT TO THE WORK AREA. THE ARCHITECT SHALL ASSIST THE CONTRACTOR IN DEVELOPING A PLAN TO PROVIDE ALTERNATE MEANS OF FRESH AIR TO ALL OCCUPIED SPACES.</p> <p>9. "CONSTRUCTION AND MAINTENANCE OPERATIONS SHALL NOT PRODUCE NOISE IN EXCESS OF 80 DBA IN OCCUPIED SPACES OR SHALL BE SCHEDULED FOR TIMES WHEN THE BUILDING OR AFFECTED BUILDING SPACES ARE NOT OCCUPIED OR ACOUSTICAL ABATEMENT MEASURES SHALL BE TAKEN."</p> <p>10. "THE CONTRACTOR SHALL BE RESPONSIBLE FOR THE CONTROL OF CHEMICAL FUMES, GASES, AND OTHER CONTAMINANTS PRODUCED BY WELDING, GASOLINE OR DIESEL ENGINES, ROOFING, PAVING, PAINTING, ETC. TO ENSURE THEY DO NOT ENTER OCCUPIED PORTIONS OF THE BUILDING OR AIR INTAKES." ALL VENTS SHALL BE SEALED TO PREVENT CONTAMINANTS FROM THE CONSTRUCTION AREA FROM ENTERING THE OCCUPIED AREAS OF THE BUILDING.</p> <p>11. "THE CONTRACTOR SHALL BE RESPONSIBLE TO ENSURE THAT ACTIVITIES AND MATERIALS WHICH RESULT IN "OFF-GASSING" OF VOLATILE ORGANIC COMPOUNDS SUCH AS GLUES, PAINTS, FURNITURE, CARPETING, WALL COVERING, DRAPERY, ETC. ARE SCHEDULED, CURED OR VENTILATED IN ACCORDANCE WITH MANUFACTURERS RECOMMENDATIONS BEFORE A SPACE CAN BE OCCUPIED."</p> <p>12. "LARGE AND SMALL ASBESTOS ABATEMENT PROJECTS AS DEFINED BY 12NYCRR56 SHALL NOT BE PERFORMED WHILE THE BUILDING IS OCCUPIED." IT IS OUR INTERPRETATION THAT THE TERM "BUILDING", AS REFERENCED IN THIS SECTION, MEANS A WING OR MAJOR SECTION OF A BUILDING THAT CAN BE COMPLETELY ISOLATED FROM THE REST OF THE BUILDING WITH SEALED NON COMBUSTIBLE CONSTRUCTION. THE</p> <p>13. EXTERIOR WORK SUCH AS ROOFING, FLASHING, SIDING, OR SOFFIT WORK MAY BE PERFORMED ON OCCUPIED BUILDINGS PROVIDED PROPER VARIANCES ARE IN PLACE AS REQUIRED, AND COMPLETE ISOLATION OF VENTILATION SYSTEMS AND AT WINDOWS IS PROVIDED. CARE MUST BE TAKEN TO SCHEDULE WORK SO THAT CLASSES ARE NOT DISRUPTED BY NOISE OR VISUAL DISTRACTION.</p> <p>14. MINOR ASBESTOS PROJECTS DEFINED BY 12NYCRR56 AS AN ASBESTOS PROJECT INVOLVING THE REMOVAL, DISTURBANCE, REPAIR, ENCAPSULATION, ENCLOSURE OR HANDLING OF 10 SQUARE FEET OF ASBESTOS OR ASBESTOS MATERIAL MAY BE PERFORMED IN UNOCCUPIED AREAS OF AN OCCUPIED BUILDING IN ACCORDANCE WITH 12NYCRR56.</p> <p>15. NONE OF THE SURFACES AND/OR MATERIALS TO BE REMOVED OR DISTURBED BY THIS RENOVATION ARE SUSPECT OF CONTAINING LEAD.</p> <p>16. UNDER NEW YORK STATE LAW SMOKING IS PROHIBITED ON SCHOOL GROUNDS. EMPLOYEES FOUND TO BE SMOKING ON SCHOOL GROUNDS SHALL BE ORDERED OFF SITE AND A SECOND OFFENSE WILL BE GROUNDS FOR PERMANENT REMOVAL FROM PROJECT. LEGAL PENALTIES MAY ALSO BE APPLIED.</p> <p>17. ALL CONTRACTORS SHALL TAKE EVERY PRECAUTION AND SHALL PROVIDE SUCH EQUIPMENT AND FACILITIES AS ARE NECESSARY OR REQUIRED FOR THE SAFETY OF ITS EMPLOYEES. IN CASE OF AN ACCIDENT, FIRST AID SHALL BE ADMINISTERED TO ANY WHO MAY BE INJURED IN THE PROGRESS OF THE WORK. IN ADDITION, THE CONTRACTOR SHALL BE PREPARED FOR THE REMOVAL TO THE HOSPITAL FOR TREATMENT OF ANY EMPLOYEE EITHER SERIOUSLY INJURED OR ILL.</p> <p>18. THE CONTRACTOR SHALL PROVIDE TEMPORARY WEATHER-TIGHT AND INSULATED ENCLOSURES AS MAY BE REQUIRED BY THE SCOPE OF WORK FOR ALL EXTERIOR OPENINGS SO AS TO PROTECT ALL WORK FROM THE WEATHER, AND TO PROVIDE SECURITY AGAINST UNAUTHORIZED ENTRY. ENCLOSURES SHALL NOT CREATE DEAD END CONDITIONS, REQUIRED EXITS SHALL BE MAINTAINED FREE AND CLEAR.</p>
DESCRIPTION	SYMBOL	DESCRIPTION	SYMBOL																																											
ROOM DESIGNATION		GYPSUM																																												
		CONCRETE																																												
SECTION MARK		AGGREGATE SUB-BASE																																												
		EARTH																																												
DETAIL SYMBOL		BATT INSULATION																																												
ELEVATION KEY		PLYWOOD																																												
INTERIOR ELEVATION REFERENCE		RIGID INSULATION																																												
ELEVATION LINE		STEEL																																												
REVISION		WOOD																																												
PARTITION TYPE		WOOD BLOCKING																																												

--

Facilities Storage Building at Irvington Campus

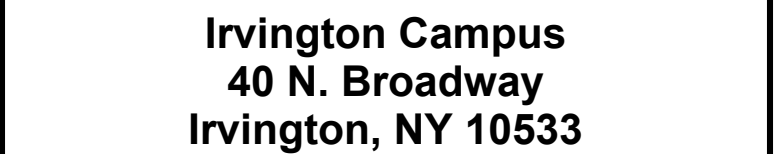


CONTRACT

CONTRACT G

GENERAL CONSTRUCTION

EXISTING CONDITIONS AND DEMOLITION SITE PLAN


DRAWING No. **CD100.00**


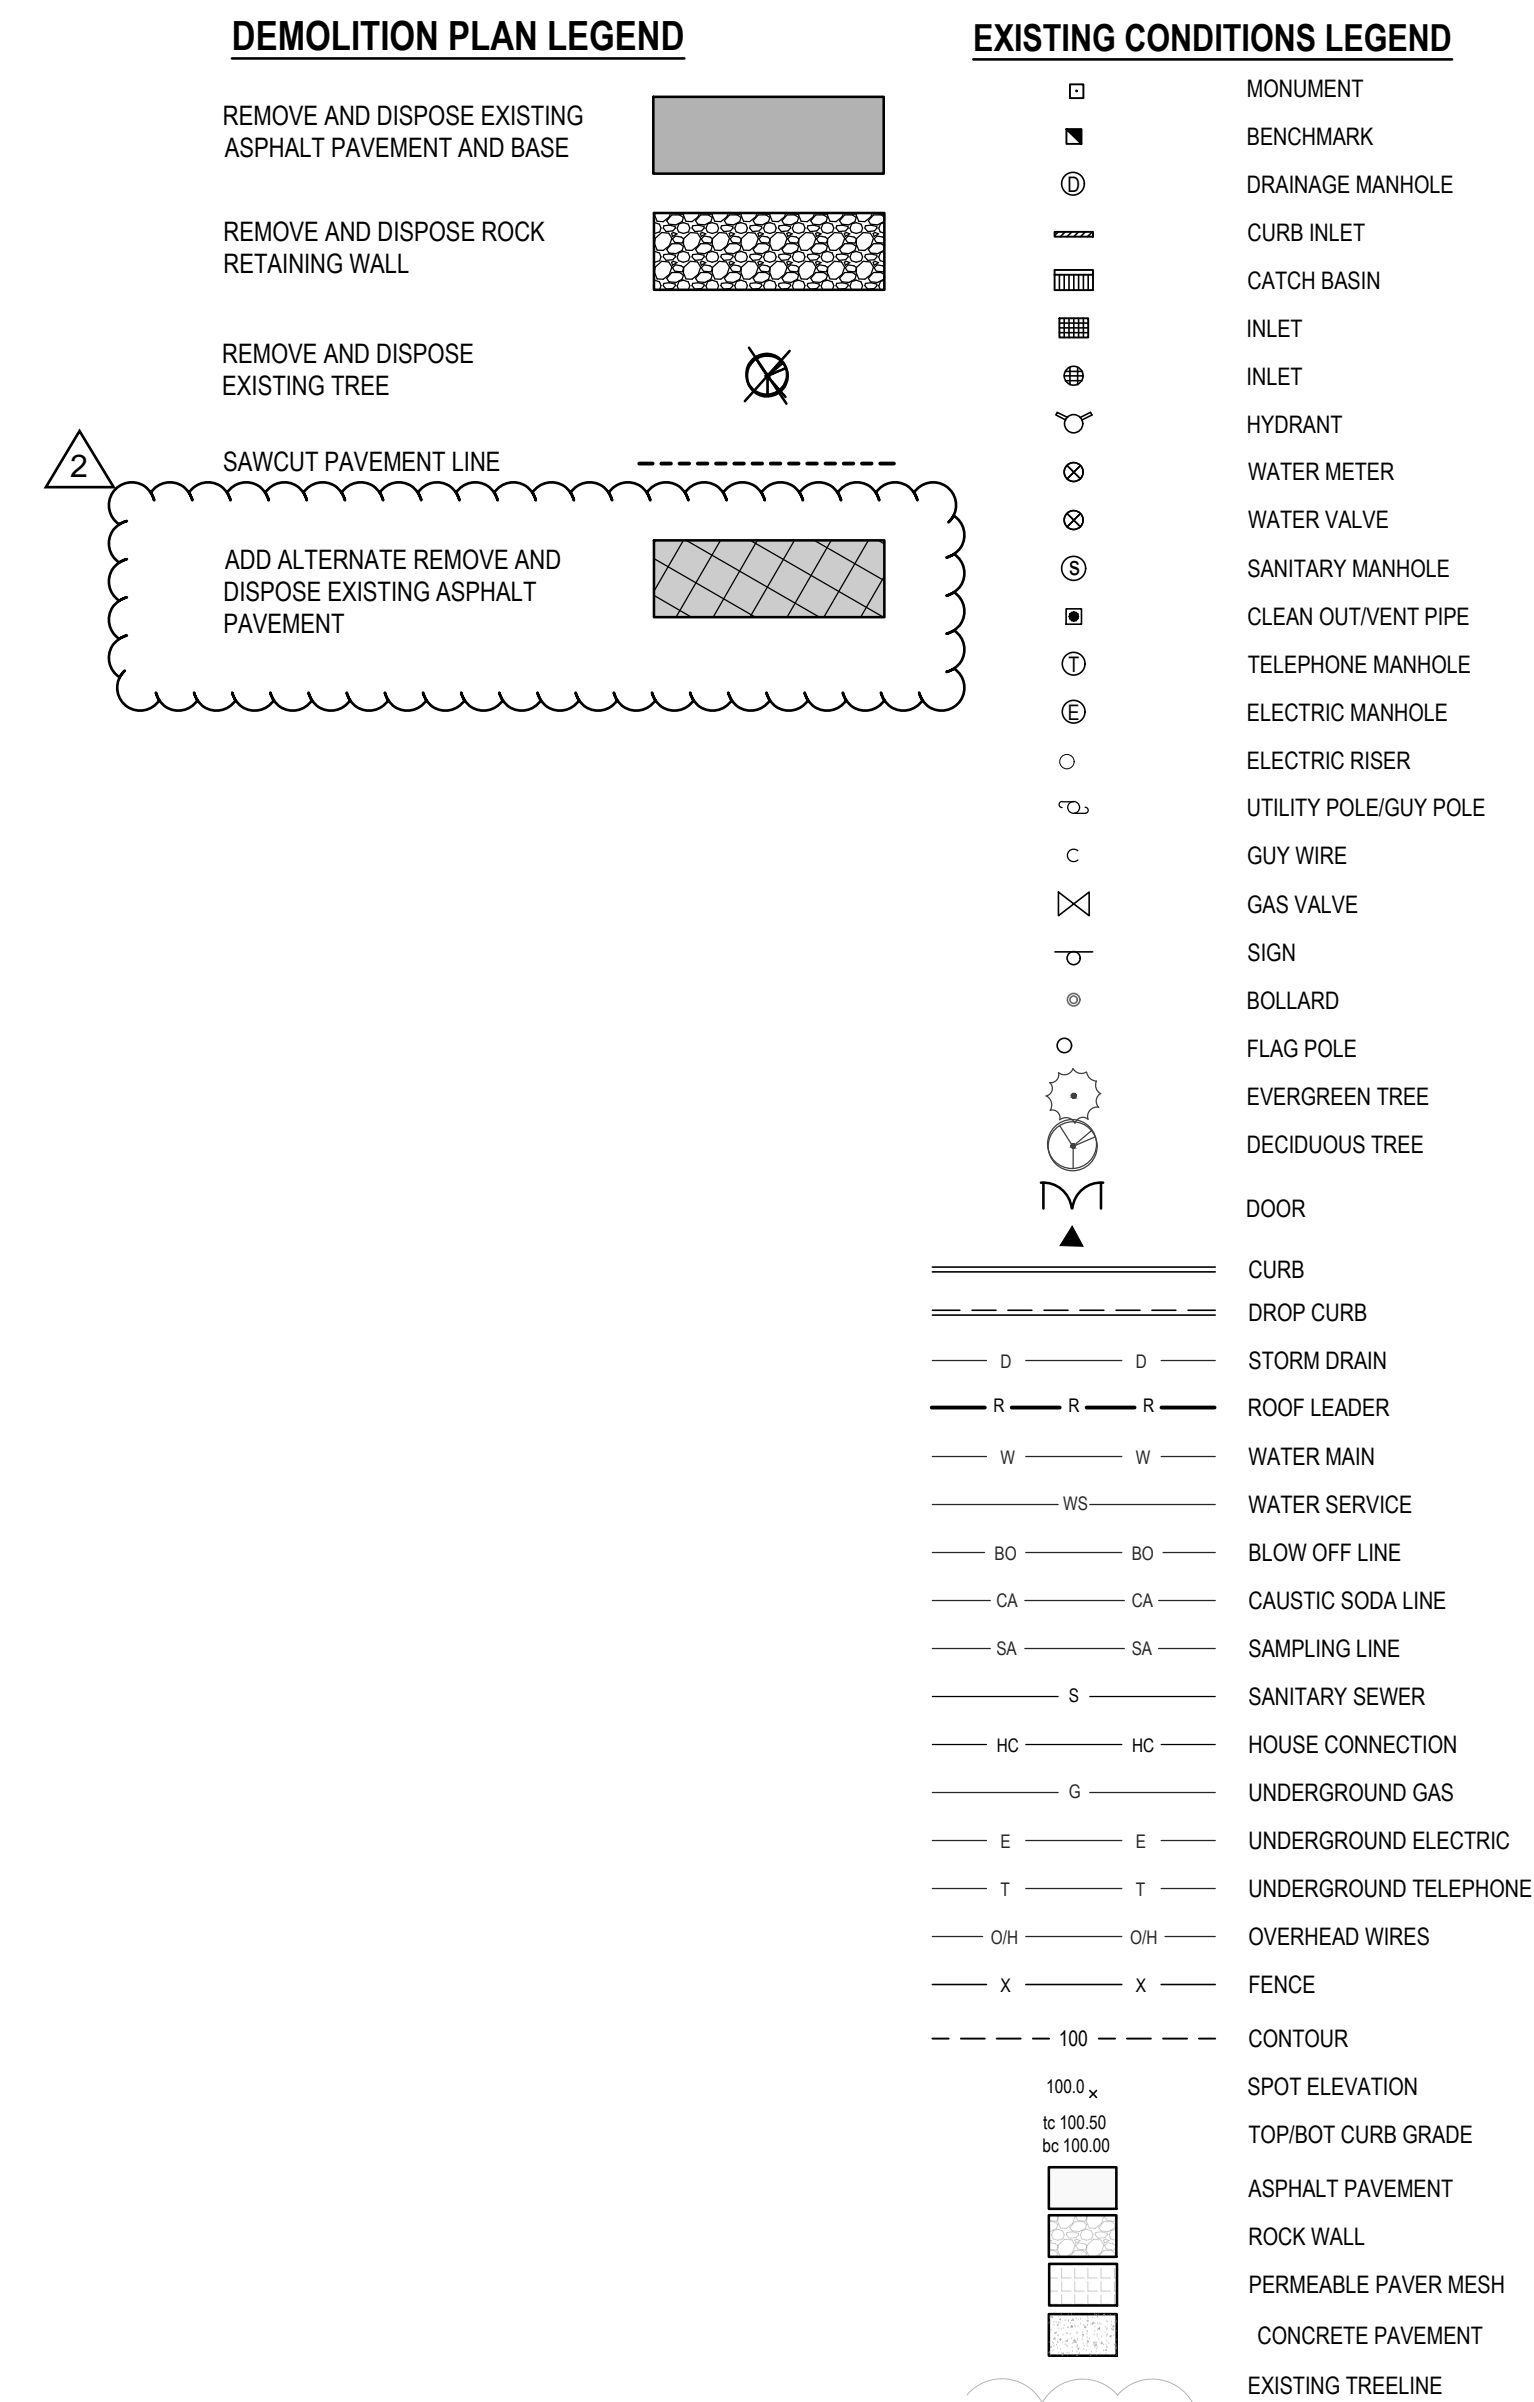


1. REPORT ANY DISCREPANCIES BETWEEN ACTUAL FIELD CONDITIONS AND THE PLANS TO THE ENGINEER IN WRITING IMMEDIATELY.
2. UNDERGROUND UTILITY INFORMATION SHOWN ON THESE PLANS WAS OBTAINED FOR DESIGN PURPOSES ONLY. PROVIDE FOR CONSTRUCTION MARKOUT AND LOCATE EXISTING UNDERGROUND UTILITIES. NO EXCAVATION CAN COMMENCE UNTIL UTILITY DOCUMENTATION HAS BEEN COMPLETED.
3. AFTER MARKOUT AND PRIOR TO DISTURBING THE SITE, UNCOVER ALL SUBSURFACE UTILITIES AND STRUCTURES WITHIN LIMITS OF DISTURBANCE TO CONFIRM THEIR LOCATION AND DEPTH.
4. NO COMPENSATION WILL BE MADE FOR ANY INCONVENIENCE CAUSED BY ENCOUNTERING UTILITIES AND STRUCTURES WHICH ARE NOT SHOWN, OR ARE INACCURATELY SHOWN ON THE PLANS.
5. REPAIR ANY DAMAGE TO EXISTING UTILITIES RESULTING FROM CONTRACTOR OPERATIONS IMMEDIATELY AT NO COST TO OWNER.
6. REPAIR ANY DAMAGE TO EXISTING SITE FEATURES SCHEDULED TO REMAIN RESULTING FROM CONTRACTOR OPERATIONS AT NO COST TO OWNER.
7. LOCATE ALL COMPONENTS OF ANY EXISTING IRRIGATION SYSTEMS PRIOR TO CONSTRUCTION AND PROTECT THROUGHOUT THE DURATION OF THE CONTRACT. REPAIR ALL DAMAGED COMPONENTS AT NO ADDITIONAL COST TO THE OWNER.
8. PROVIDE TEMPORARY FENCING TO PROTECT WORK AREAS.
9. INSTALL EROSION CONTROL MEASURES AS SHOWN ON THE DIMENSIONAL SITE PLAN PRIOR TO ANY GROUND DISTURBANCE.
10. DELINEATE THE LIMITS OF CLEARING AND REVIEW WITH THE OWNER PRIOR TO COMMENCING WORK.
11. NOTIFY OWNER AND ENGINEER IMMEDIATELY IN WRITING WHEN UNKNOWN STRUCTURES OR SUSPECTED HAZARDOUS OR CONTAMINATED MATERIALS ARE ENCOUNTERED PRIOR TO REMOVAL OR DISTURBANCE.
12. TAKE APPROPRIATE MEASURES TO PROTECT PEDESTRIANS AND VEHICULAR TRAFFIC DURING REMOVAL ACTIVITIES, AND PROVIDE TEMPORARY MEASURES FOR THE PROTECTION AND SAFETY OF THE PUBLIC UNTIL FINAL ACCEPTANCE BY THE OWNER.
13. BACKFILL ALL VOIDS RESULTING FROM THE REMOVAL OF EXISTING SITE FEATURES. BACKFILL TO BE SOIL, FREE OF ORGANIC MATERIAL, DEBRIS, TRASH, CLAY AND STONES LARGER THAN 4 INCHES.

END OF INFORMATION PERTAINS TO THE LOSS OF SIGNAL THAT HAS BEEN APPLIED TO AN UNDERGROUND UTILITY AND THEN DETECTED TO ELECTRONICALLY LOCATE THE UTILITY. COMMONLY FOUND WHERE UTILITIES CHANGE TO NON-CONDUCTIVE MATERIALS, ARE CUT OR AT END OF UTILITY.

1. EXISTING SURVEY PREPARED BY H2M architects + engineers. DATED 10/22/2019 AND MOST RECENTLY REVISED 07/09/2020.
2. ELEVATIONS REFER TO N.A.V.D. 1988.
3. THIS SURVEY WAS COMPLETED WITHOUT THE BENEFIT OF A COMPLETE TITLE REPORT.
4. THE OFFSETS AND DIMENSIONS SHOWN FROM STRUCTURES TO THE PROPERTY LINE ARE FOR A SPECIFIC PURPOSE AND ARE NOT INTENDED TO GUIDE THE ERECTION OF FENCES WALLS POOLS PATIOS ADDITIONS TO BUILDINGS AND ANY OTHER CONSTRUCTION.
5. THE LOCATIONS OF UNDERGROUND STRUCTURES AND UTILITIES SHOWN HEREON ARE BASED ON ABOVEGROUND FEATURES AND/OR RECORD DRAWINGS AND MARKOUT PROVIDED BY SINGER UTILITY ENGINEERING, P.C. ON SEPTEMBER, 2019. LOCATIONS OF UNDERGROUND STRUCTURES AND UTILITIES MAY VARY FROM LOCATIONS SHOWN HEREON. ADDITIONAL BURIED STRUCTURES AND UTILITIES MAY BE ENCOUNTERED. THE CONTRACTOR IS RESPONSIBLE FOR DETERMINING THE LOCATION OF ALL UNDERGROUND UTILITIES PRIOR TO ANY EXCAVATION.

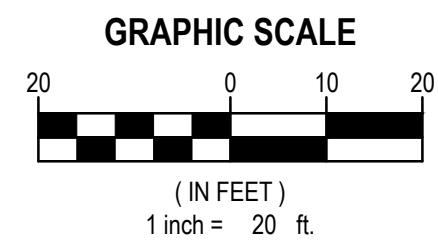

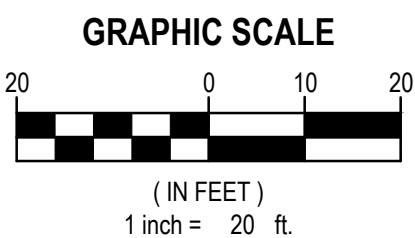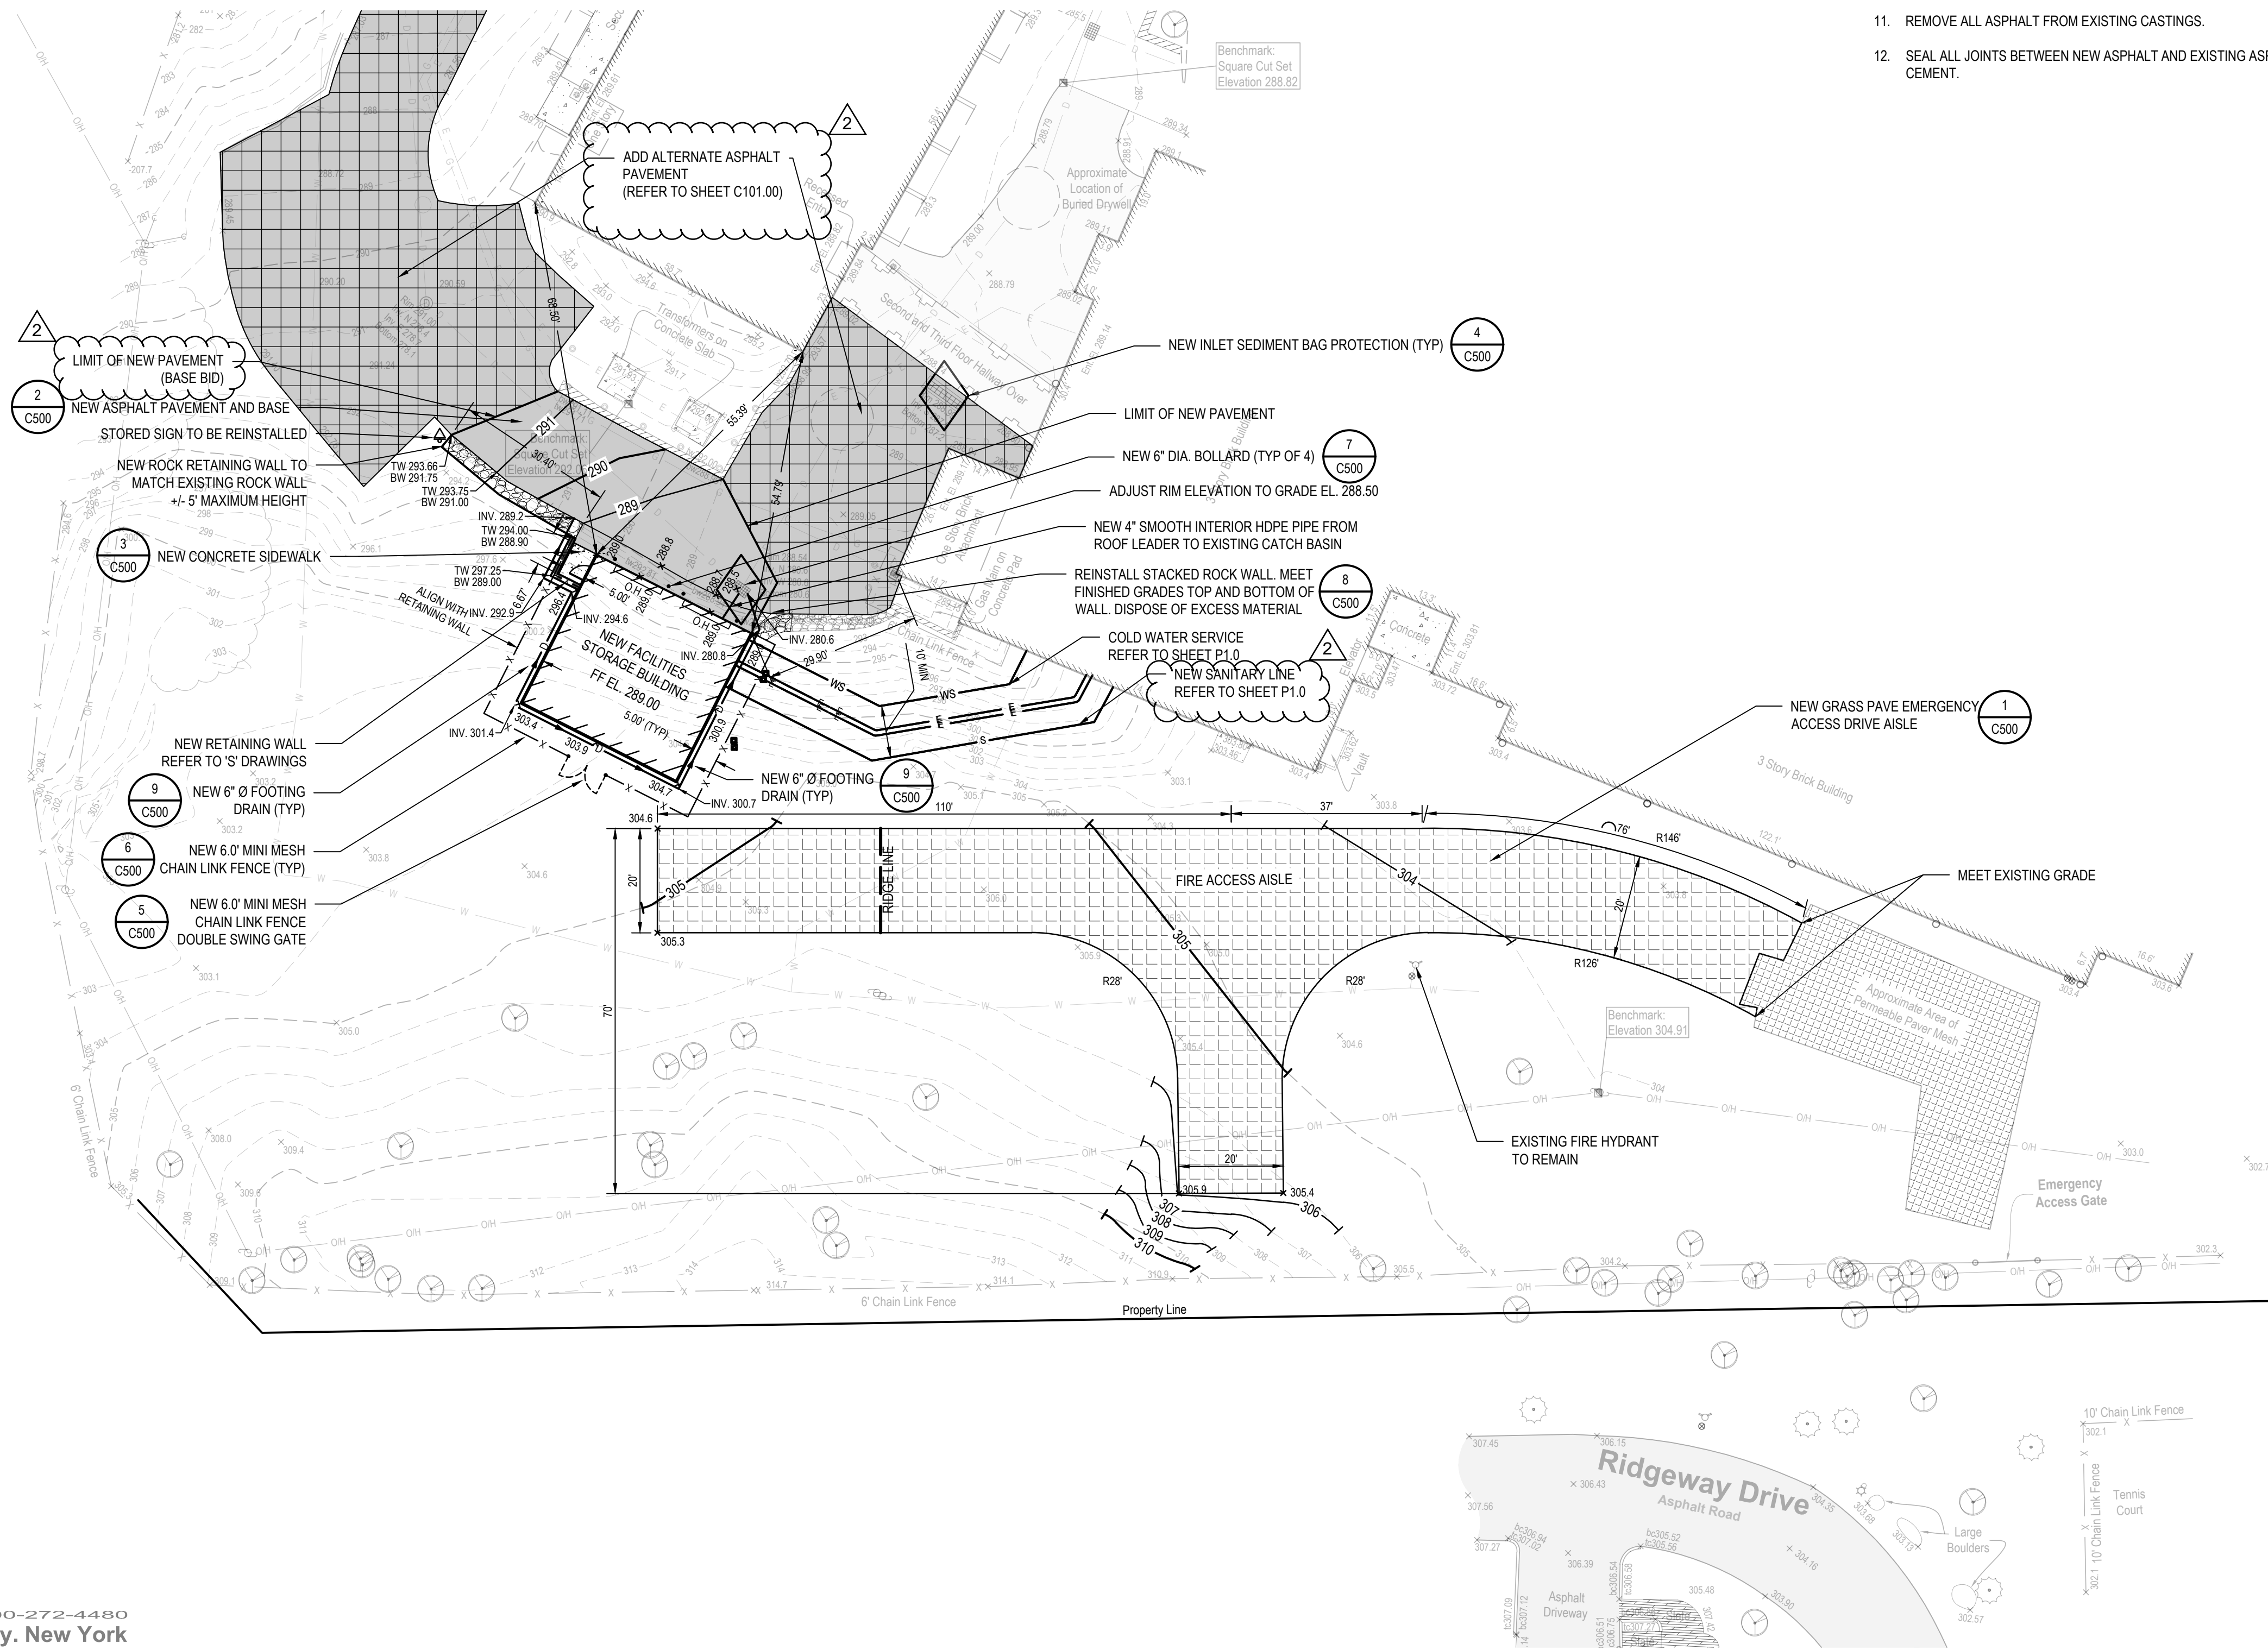

GRADING AND DRAINAGE NOTES:

1. FOR NEW CONSTRUCTION THAT MEETS EXISTING CONDITIONS, ABUTTING SURFACES SHALL BE FLUSH AND ALIGNED.
2. ADJUST ALL EXISTING CASTINGS AND VALVE COVERS TO MEET PROPOSED GRADE.
3. CONSTRUCTION DEBRIS AND EXCESS SOIL SHALL BE REMOVED AND LEGALLY DISPOSED OFF SITE.
4. UNSUITABLE SOILS ENCOUNTERED DURING CONSTRUCTION SHALL BE BROUGHT TO THE ATTENTION OF THE OWNER AND ENGINEER IMMEDIATELY IN WRITING BEFORE REMOVAL OR DISTURBANCE.

SITE PLAN NOTES:

1. INSPECT THE SITE PRIOR TO SUBMISSION OF BIDS AND MAKE NO ADDITIONAL CLAIMS REGARDING SITE CONDITIONS THEREAFTER.
2. NOTIFY THE OWNER AND H2M (TELEPHONE 631-756-8000) AT LEAST 48 HOURS PRIOR TO THE COMMENCEMENT OF THE WORK. THE SAME NOTICE SHALL BE REQUIRED WHEN RESUMING WORK AFTER ANY STOPPAGE OR DELAY.
3. COMPLETE ALL SURVEY AND STAKEOUT AS REQUIRED TO PROPERLY COMPLETE THE WORK.
4. PERFORM DAILY CLEANUP OPERATIONS INCLUDING REMOVAL OF DEBRIS AND EXCESS CONSTRUCTION MATERIAL, AND DRIVEWAY/STREET CLEANING TO THE SATISFACTION OF THE OWNER.
5. DURING ALL NON-WORKING HOURS, STORE ALL EQUIPMENT AND MATERIALS WITHIN AN AREA DESIGNATED BY THE OWNER AT THE PROJECT SITE.
6. ALL CURB DIMENSIONS SHOWN REFER TO THE FACE OF CURB.
7. ALL CONSTRUCTION TO CONFORM WITH ALL APPLICABLE FEDERAL, STATE AND LOCAL CODE REQUIREMENTS.
8. COORDINATE CONSTRUCTION ACTIVITIES WITH OWNER TO MINIMIZE INTERRUPTION TO THE OWNER'S OPERATIONS.
9. RESTORE SURROUNDING AREAS DAMAGED OR DISTURBED DURING CONSTRUCTION. RESTORE TO NEW CONDITIONS AT NO ADDITIONAL COST TO THE OWNER.
10. RESTORE ALL DISTURBED GRASS AREAS AND ALL AREAS NOT SPECIFICALLY IDENTIFIED FOR OTHER IMPROVEMENTS WITH 4 INCHES OF TOPSOIL AND SEED.
11. REMOVE ALL ASPHALT FROM EXISTING CASTINGS.
12. SEAL ALL JOINTS BETWEEN NEW ASPHALT AND EXISTING ASPHALT WITH HOT ASPHALT CEMENT.

LEGEND

DESCRIPTION	SYMBOL
BASE CONTRACT ASPHALT PAVEMENT	
CONCRETE PAVEMENT SIDEWALK	
ADD ALTERNATE ASPHALT PAVEMENT	
ROCK RETAINING WALL	
DOOR	
OVERHEAD DOOR	
SPOT ELEVATION	
TOP AND BOTTOM CURB ELEVATION	
MAJOR CONTOUR	
MINOR CONTOUR	
RIDGE LINE	
RETAINING WALL	
SANITARY LINE	
DRAINAGE LINE	
ELECTRIC LINE	
WATER SERVICE LINE	


EROSION CONTROL NOTES:

1. DURING THE COURSE OF CONSTRUCTION, EROSION AND SEDIMENT CONTROL MEASURES ARE NECESSARY TO PREVENT THE TRANSPORT OF SEDIMENT TO UNDISTURBED AREAS, PONDS, WATER COURSES, DRAINAGE SYSTEMS, RECHARGE BASINS, AND ROADS. THE MINIMUM EROSION CONTROL MEASURES REQUIRED ARE INDICATED ON THIS PLAN. IN ADDITION, THE FOLLOWING GENERAL CONDITIONS SHALL BE OBSERVED:
 - a. EXISTING VEGETATION SCHEDULED TO REMAIN SHALL BE PROTECTED AND REMAIN UNDISTURBED.
 - b. INSTALL ADDITIONAL EROSION AND SEDIMENT CONTROL MEASURES AS REQUIRED TO PREVENT THE INCIDENTAL DISCHARGE OF SEDIMENT FROM THE SITE.
2. SPECIFIC METHODS AND MATERIALS EMPLOYED IN THE INSTALLATION AND MAINTENANCE OF EROSION CONTROL MEASURES MUST CONFORM TO THE LATEST EDITION OF THE "NEW YORK STATE STANDARDS AND SPECIFICATIONS FOR EROSION AND SEDIMENT CONTROL".
3. INSTALL PROPRIETARY EROSION AND SEDIMENT CONTROL PRODUCTS IN ACCORDANCE WITH MANUFACTURERS INSTRUCTIONS.
4. ADJUST EROSION AND SEDIMENT CONTROL MEASURES TO ACCOMMODATE CONSTRUCTION PHASING TO MAINTAIN EFFECTIVENESS OF EROSION AND SEDIMENT CONTROL MEASURES.
5. PROTECT EXISTING DRAINAGE INLETS WITHIN THE PROJECT LIMITS AND NEW DRAINAGE INLETS INSTALLED AS PART OF THIS PROJECT FROM SEDIMENT INTRUSION.
6. PERFORM INSPECTION AND MAINTENANCE OF EROSION AND SEDIMENT CONTROL MEASURES ON A WEEKLY BASIS, AND AFTER HEAVY OR PROLONGED STORMS. MAINTENANCE MEASURES INCLUDE, BUT ARE NOT LIMITED TO, CLEANING AND REPAIR OF ALL EROSION AND SEDIMENT CONTROL MEASURES.
7. UTILIZE APPROPRIATE MEANS TO CONTROL DUST DURING CONSTRUCTION, INCLUDING BUT NOT LIMITED TO APPLYING WATER TO BARE SOIL SURFACES.
8. MAINTAIN THE STABILIZED CONSTRUCTION ENTRANCE TO PREVENT SOIL AND LOOSE DEBRIS FROM BEING TRACKED ONTO LOCAL ROADS. MAINTAIN THE CONSTRUCTION ENTRANCE WEEKLY UNTIL THE SITE IS PERMANENTLY STABILIZED.
9. ALL EROSION AND SEDIMENT CONTROL MEASURES SHALL REMAIN IN PLACE UNTIL DISTURBED AREAS ARE PERMANENTLY STABILIZED. AFTER PERMANENT STABILIZATION, REMOVE ALL TEMPORARY EROSION AND SEDIMENT CONTROL MEASURES AND ALL ACCUMULATED SEDIMENT AND DEBRIS FROM THE SITE AND DRAINAGE STRUCTURES.

2700 Westchester Avenue, Suite 415
Purchase, NY 10577
914.358.5623 • www.h2m.com

CONSULTANTS:

MARK	DATE	DESCRIPTION
3	12/14/2021	ADDENDUM #3
2	12/10/2021	ADDENDUM #2
1	12/01/2021	ADDENDUM #1
	11/18/2021	FINAL BID DOCUMENT

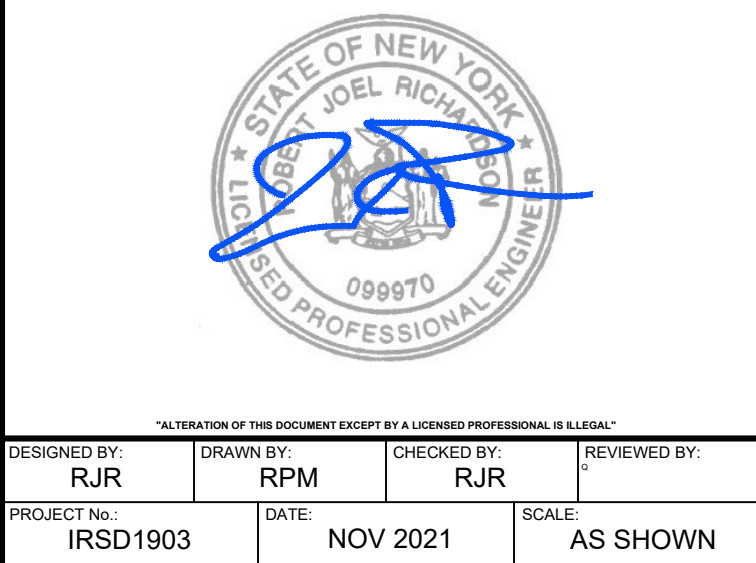

Irvington Union Free School District

**Facilities Storage Building
at Irvington Campus**



**Irvington Campus
40 N. Broadway
Irvington, NY 10533**

SED Number:66-04-02-02-2-022-001

**CONTRACT G
GENERAL CONSTRUCTION**

FINAL BID DOCUMENT

SITE IMPROVEMENT PLAN

C100.00

CONSULTANTS:		

MARK	DATE	DESCRIPTION
3	12/14/2021	ADDENDUM #3
2	12/10/2021	ADDENDUM #2
1	12/01/2021	ADDENDUM #1
	11/18/2021	FINAL BID DOCUMENT



DESIGNED BY: RJR			
DRAWN BY: RPM		CHECKED BY: RJR	
PROJECT NO: IRSD1903		DATE: NOV 2021	
		SCALE: AS SHOWN	

Irvington Union Free
School District

Facilities Storage Building
at Irvington Campus



Irvington Campus
40 N. Broadway
Irvington, NY 10533



SED Number:66-04-02-02-2-022-001











CONTRACT
CONTRACT G GENERAL CONSTRUCTION

STATUS
FINAL BID DOCUMENT

SHEET TITLE
ADD ALTERNATE PAVEMENT RESTORATION PLAN

DRAWING No.
C101.00

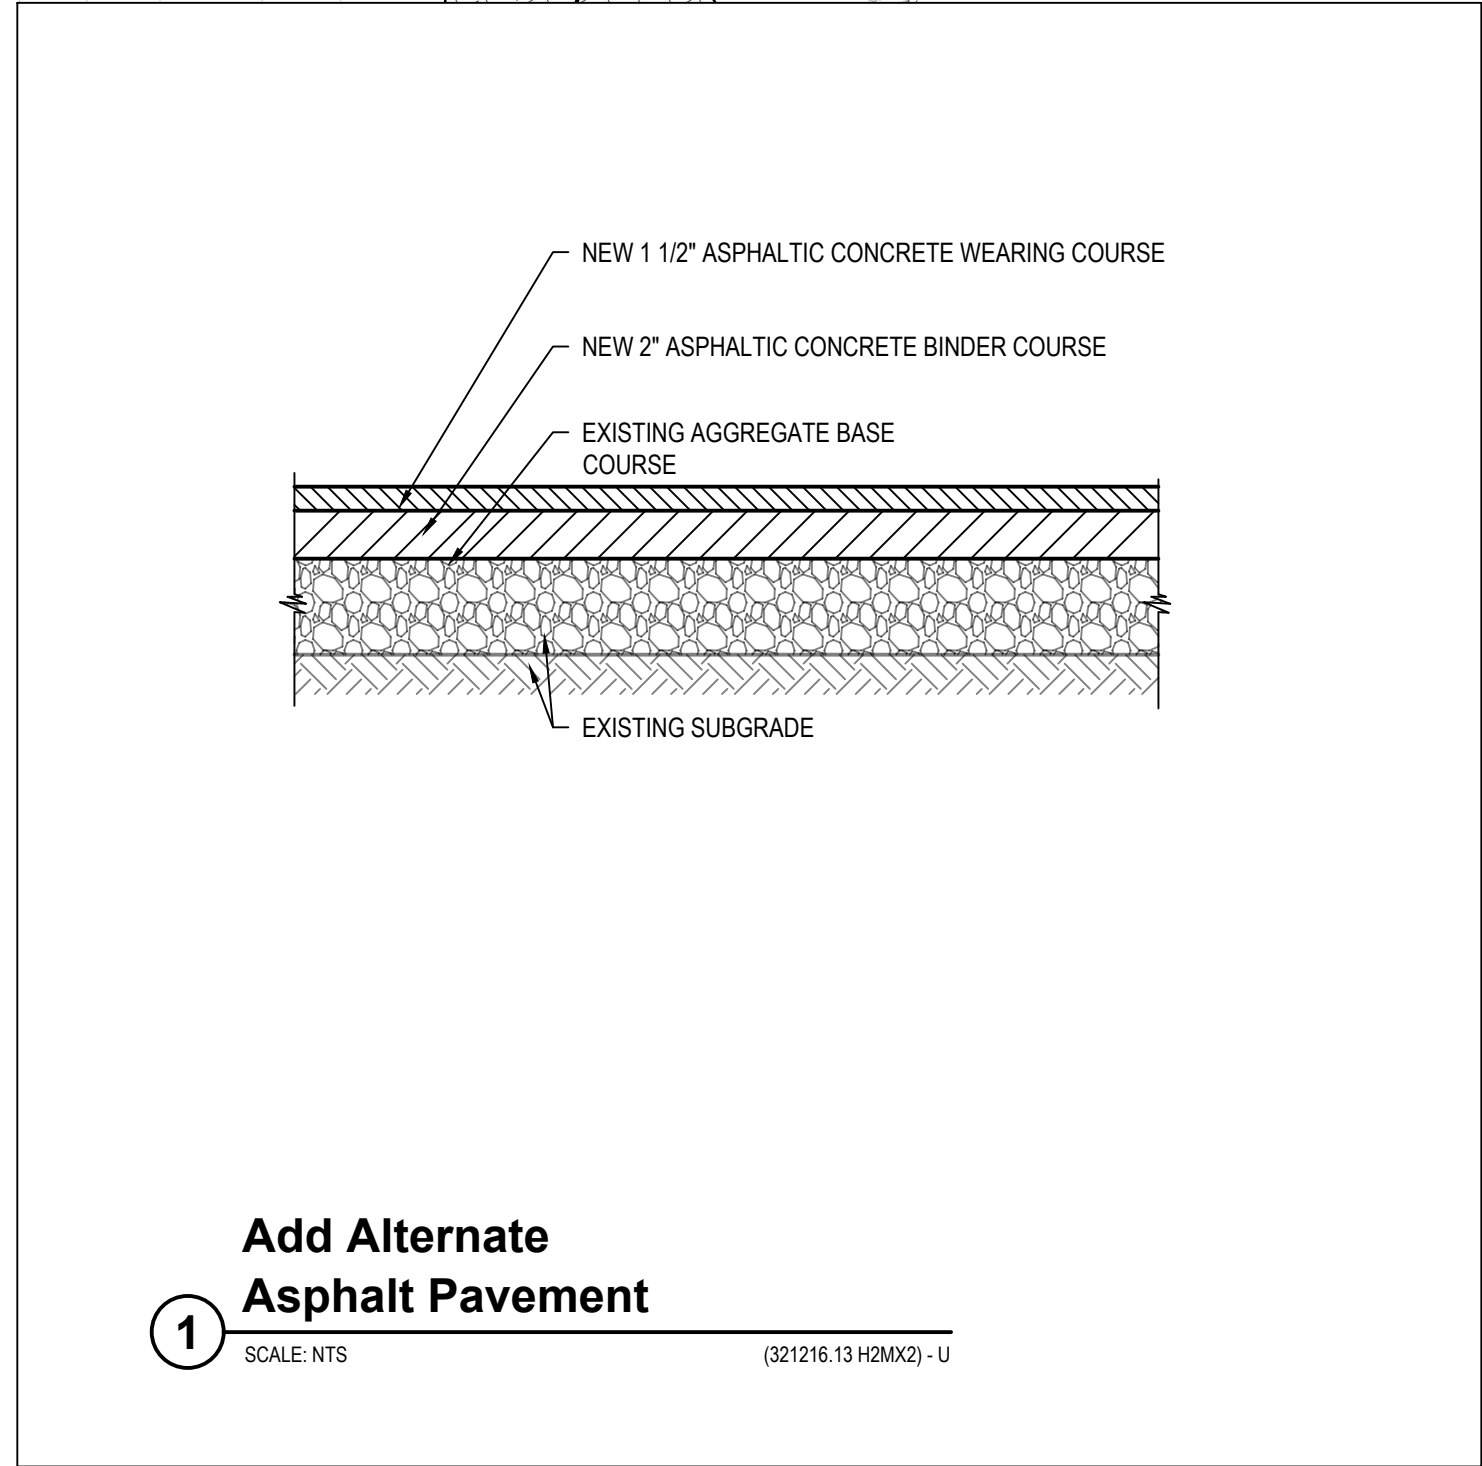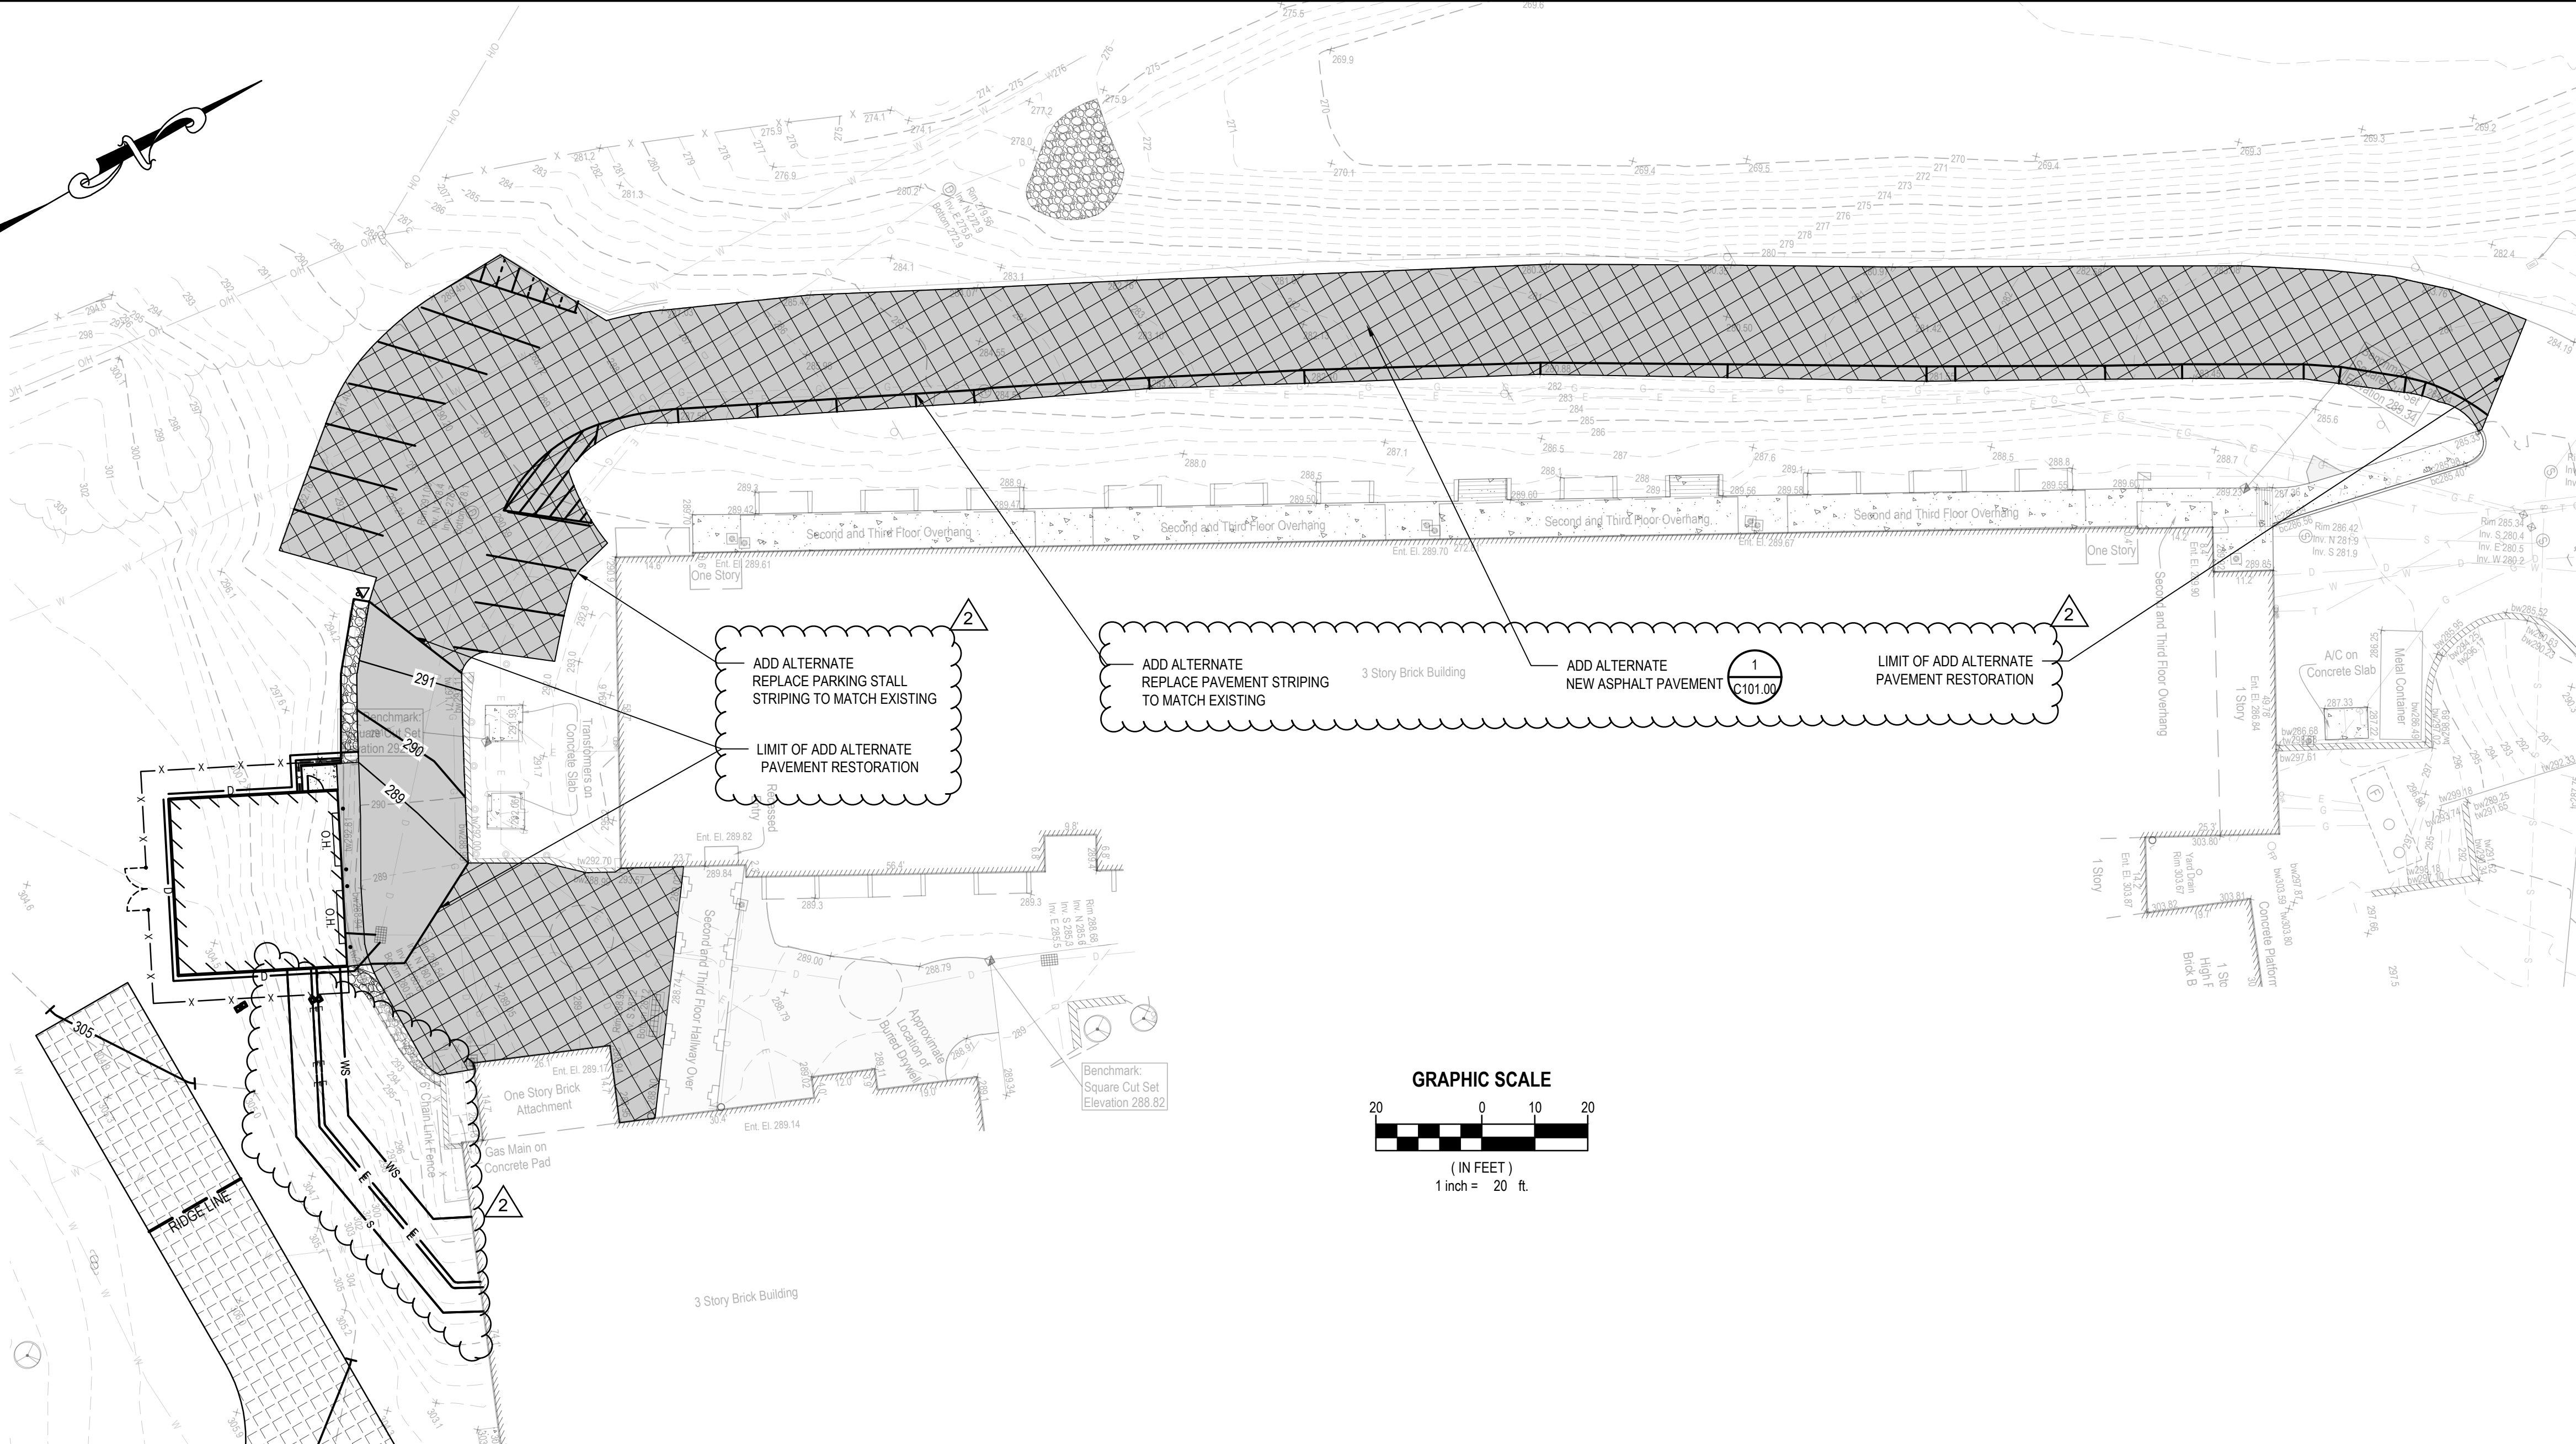

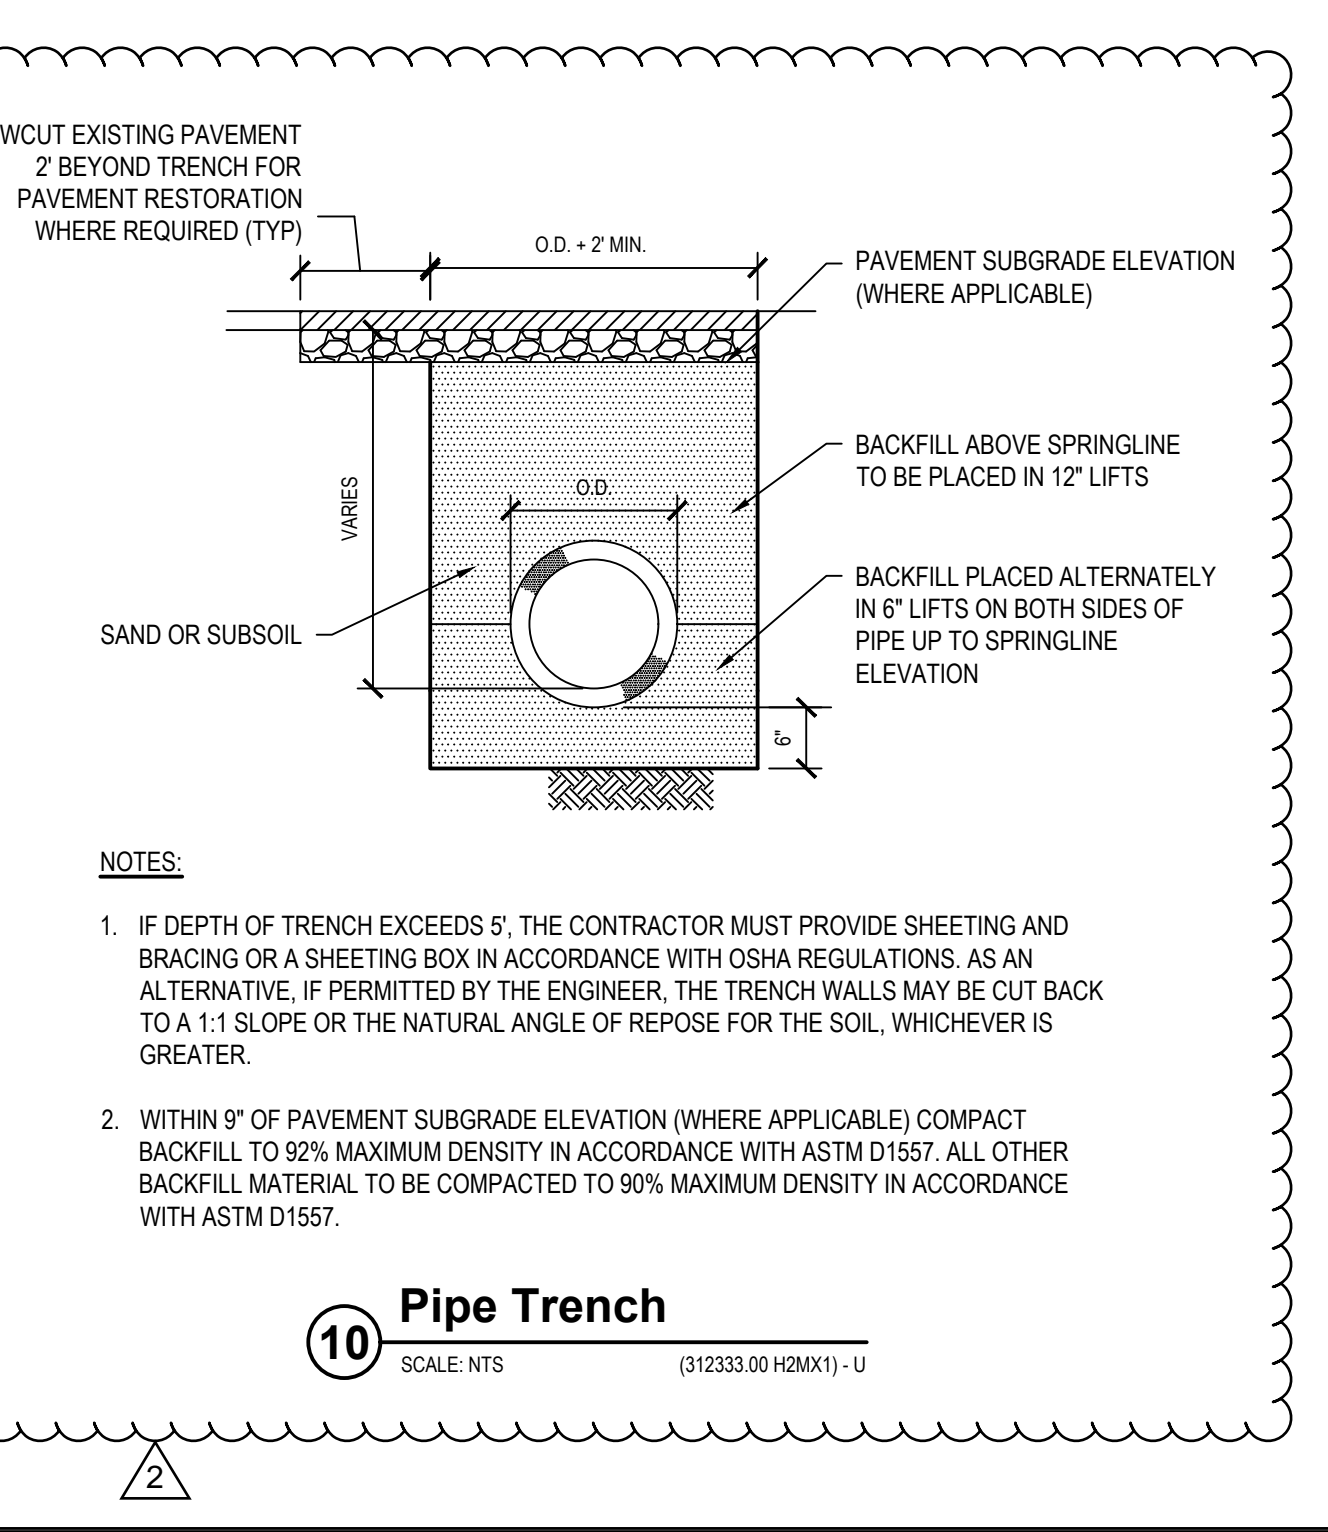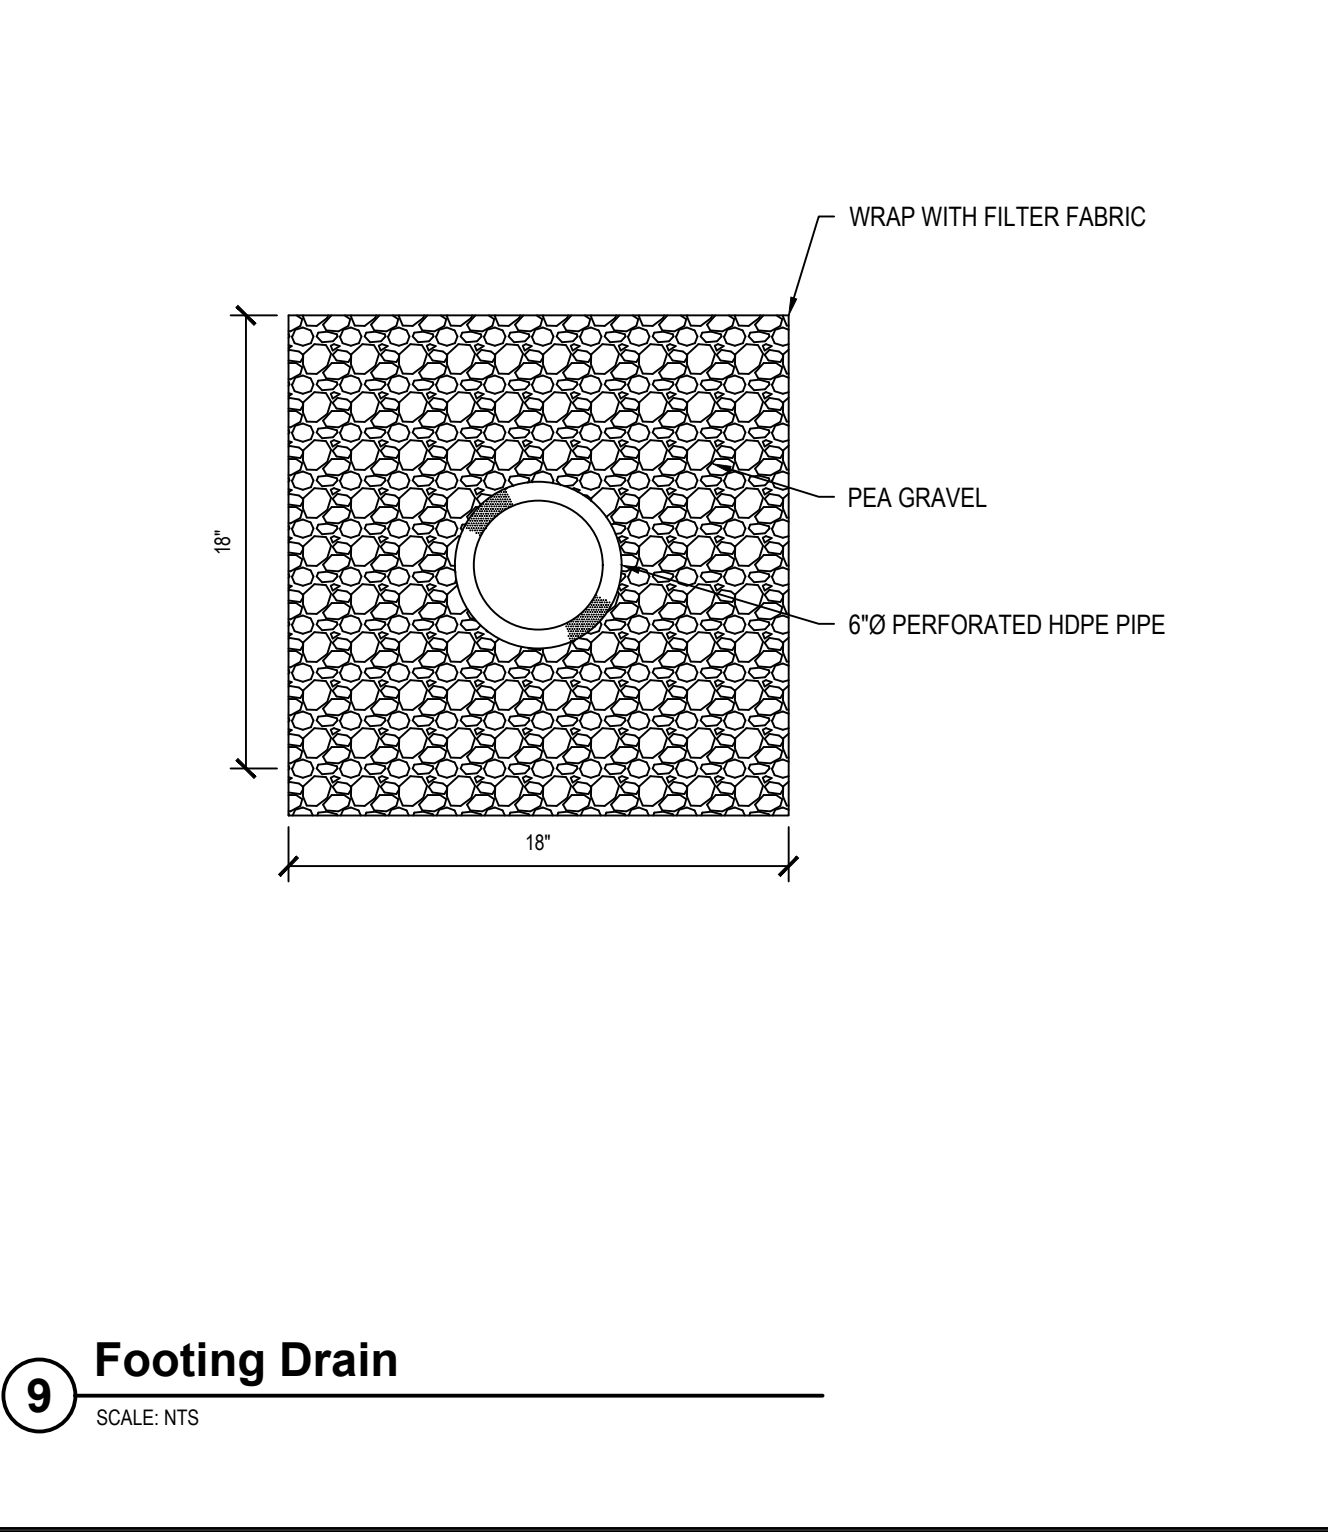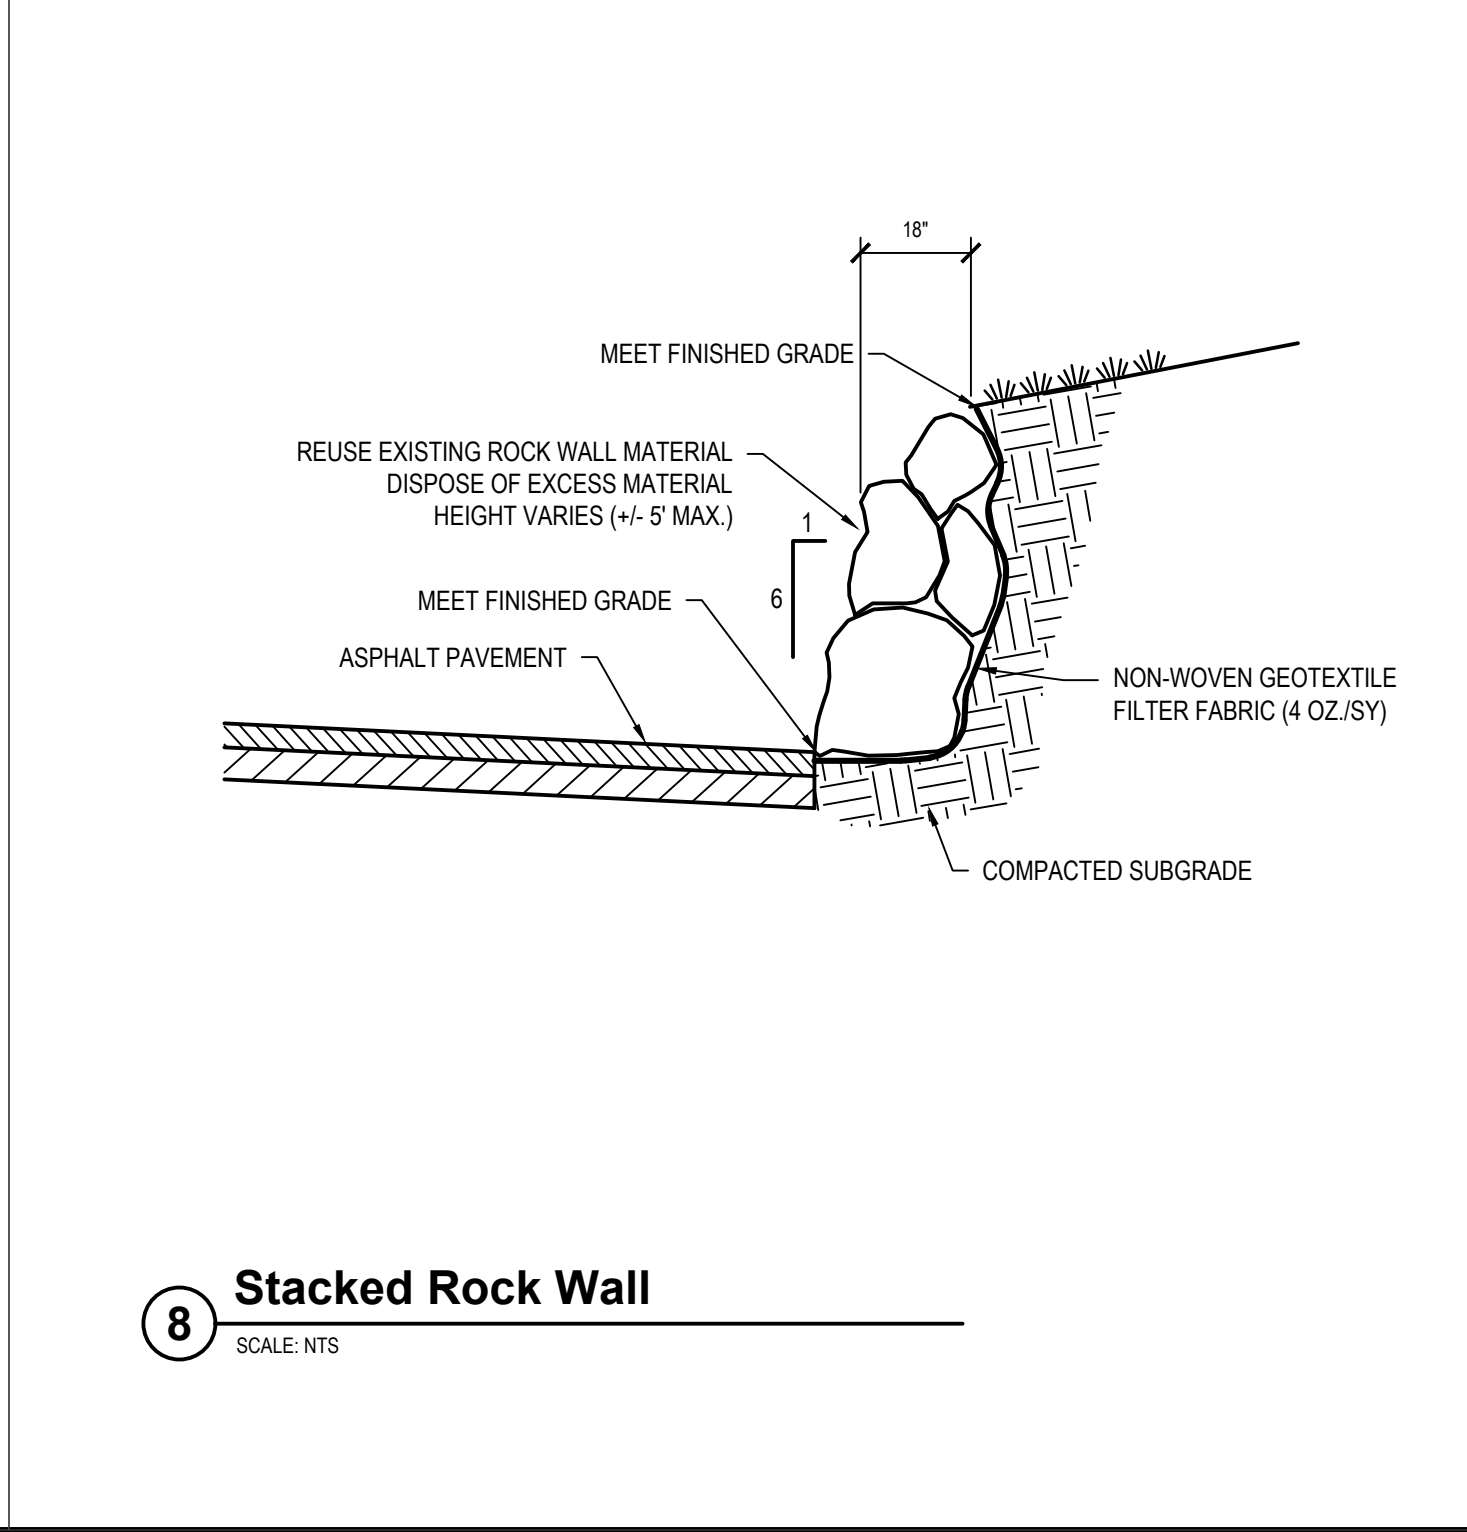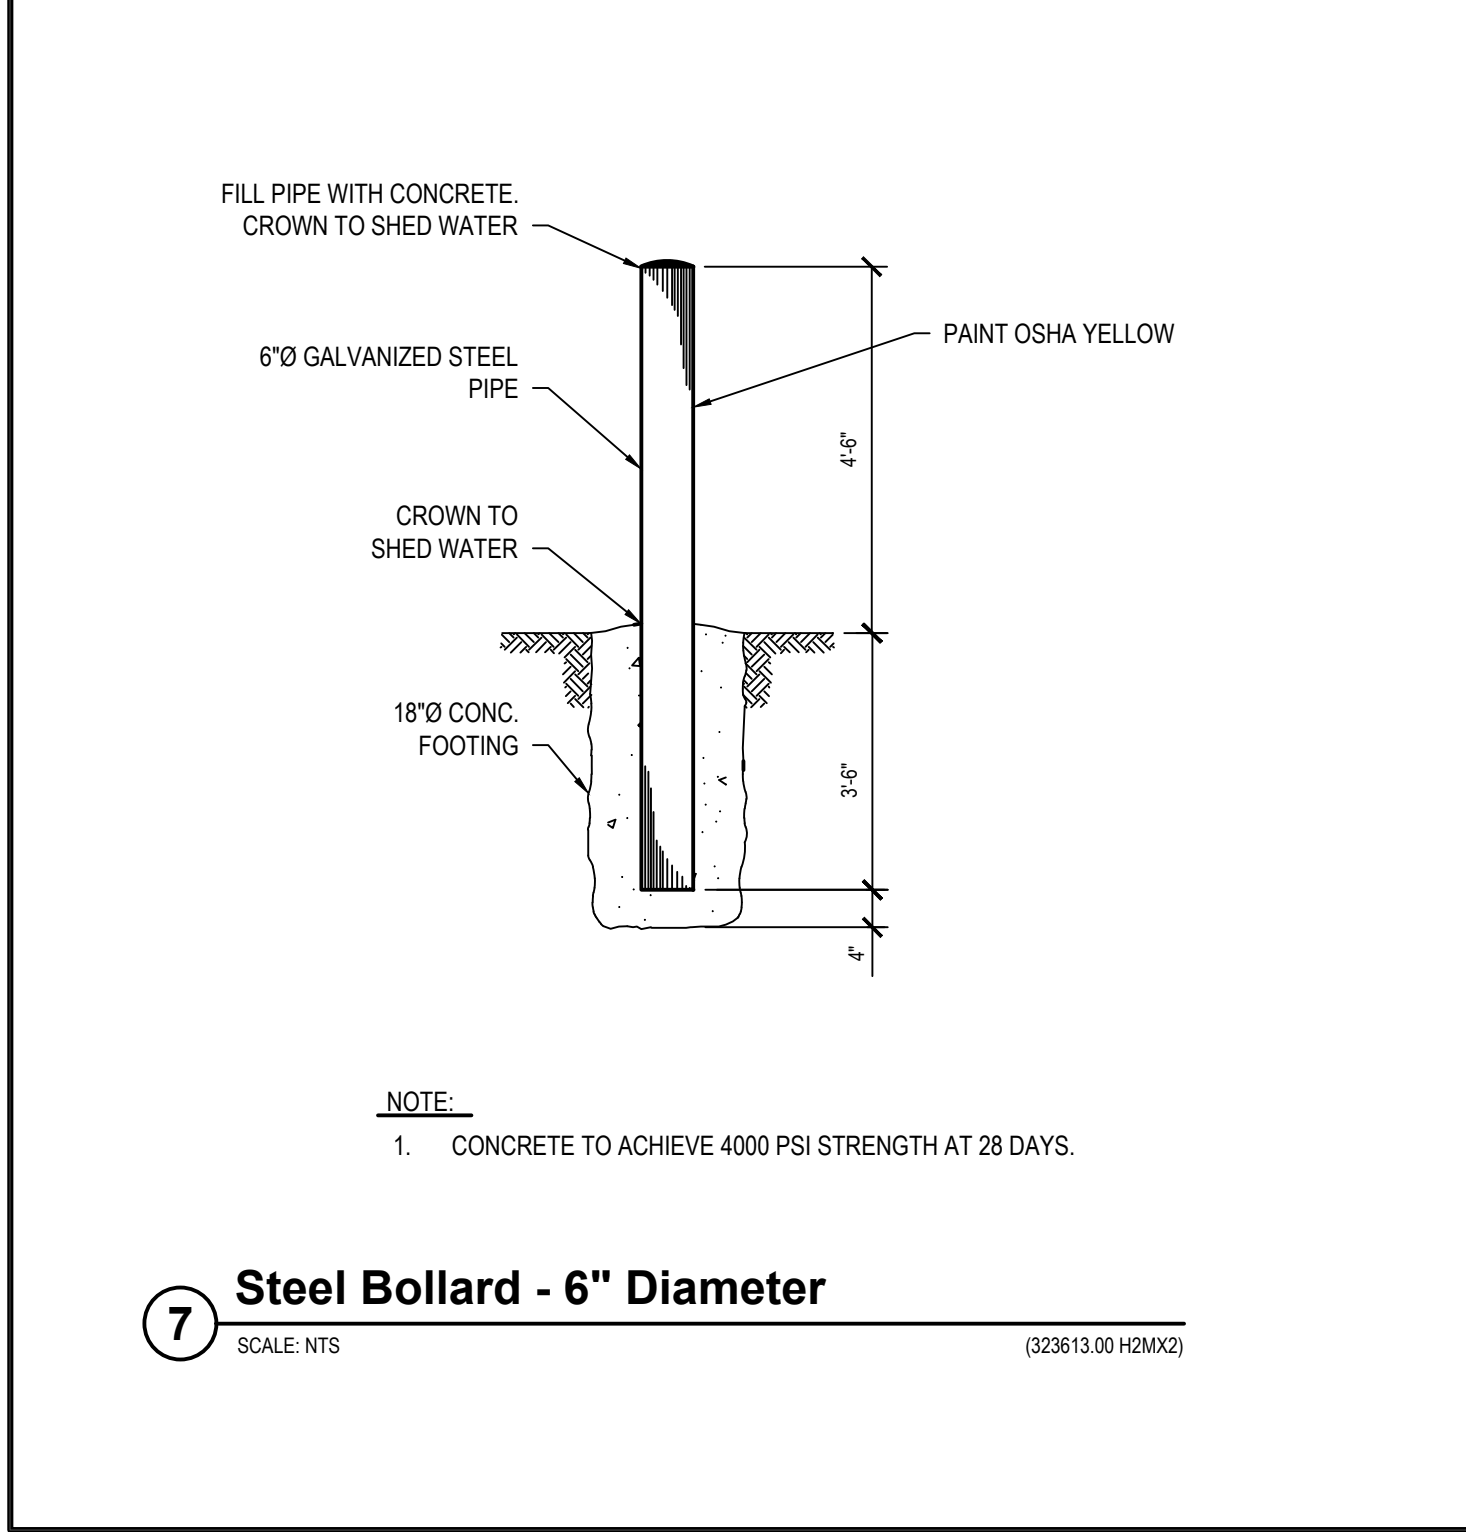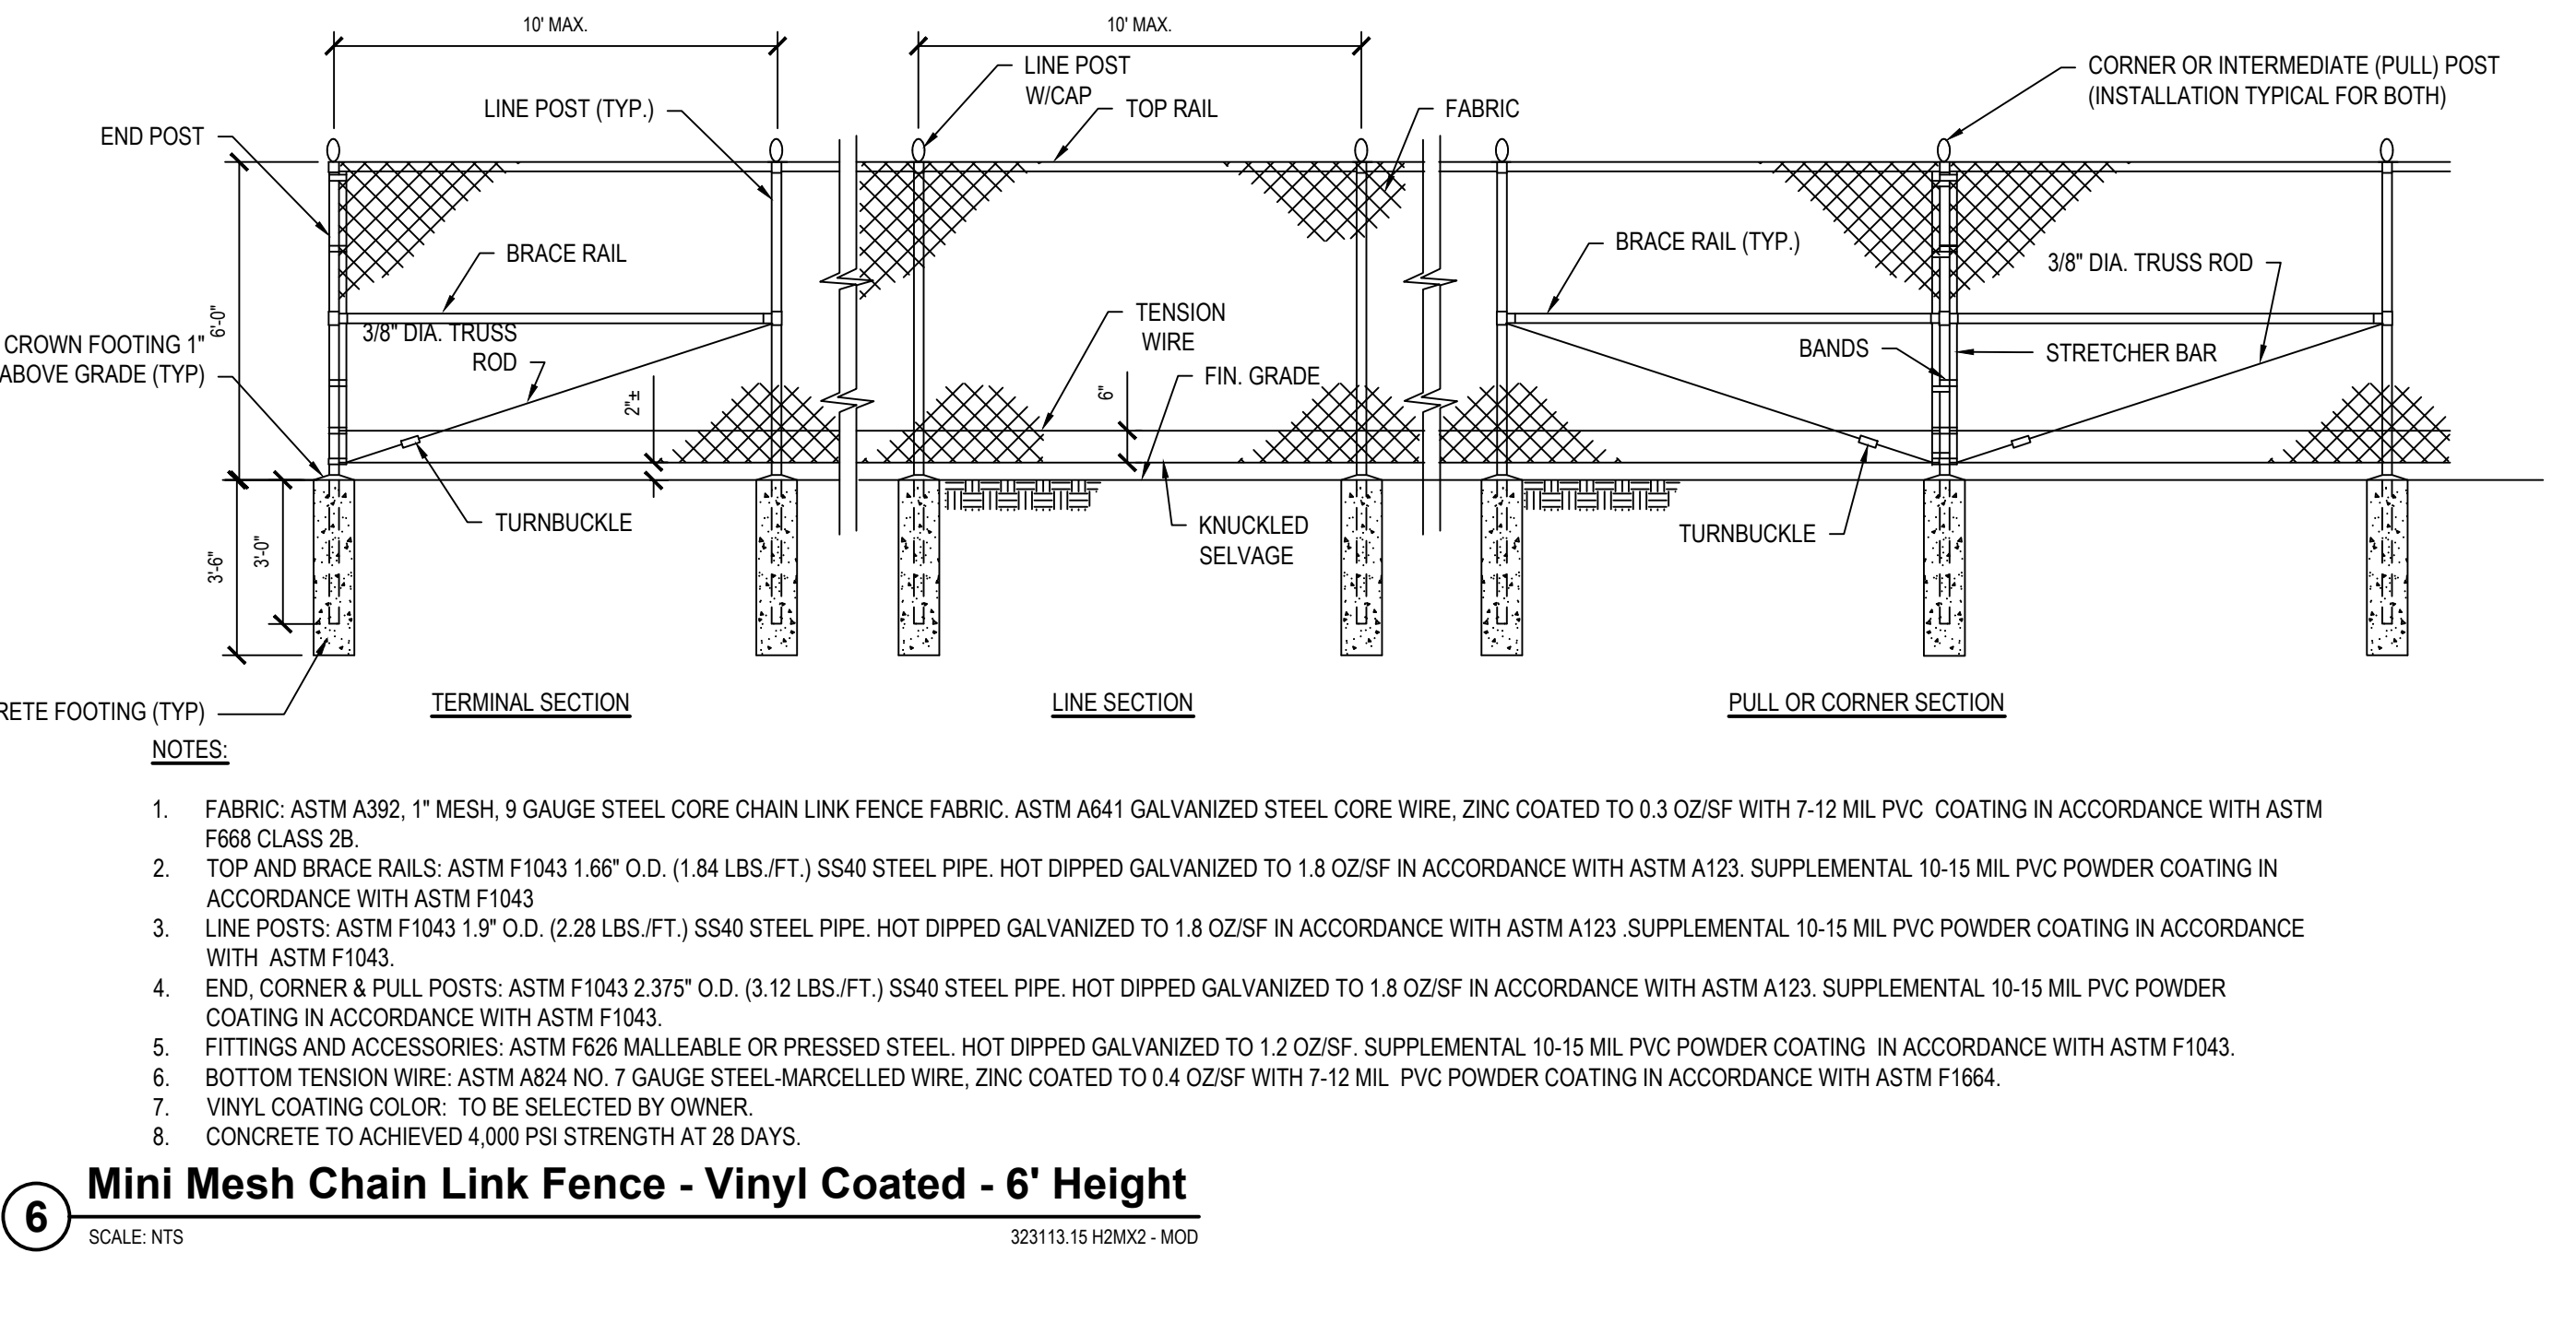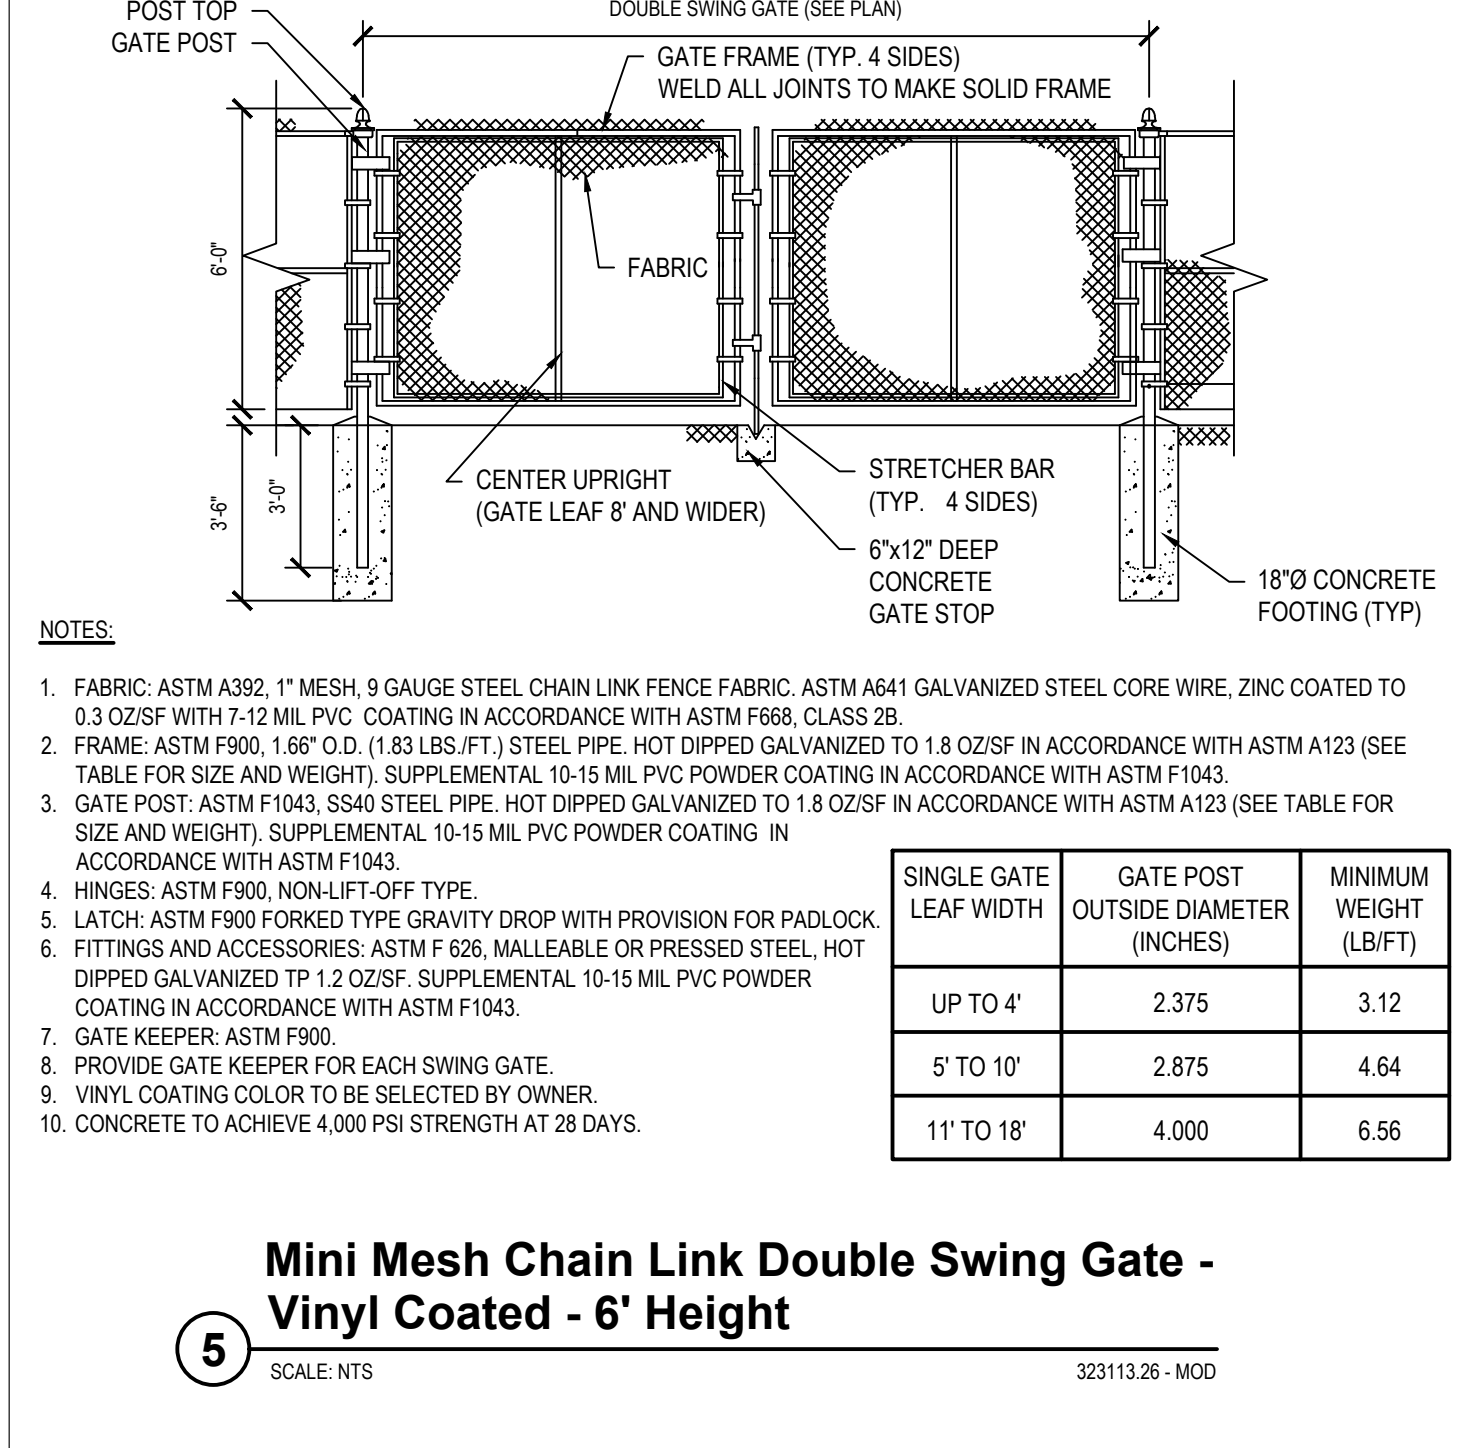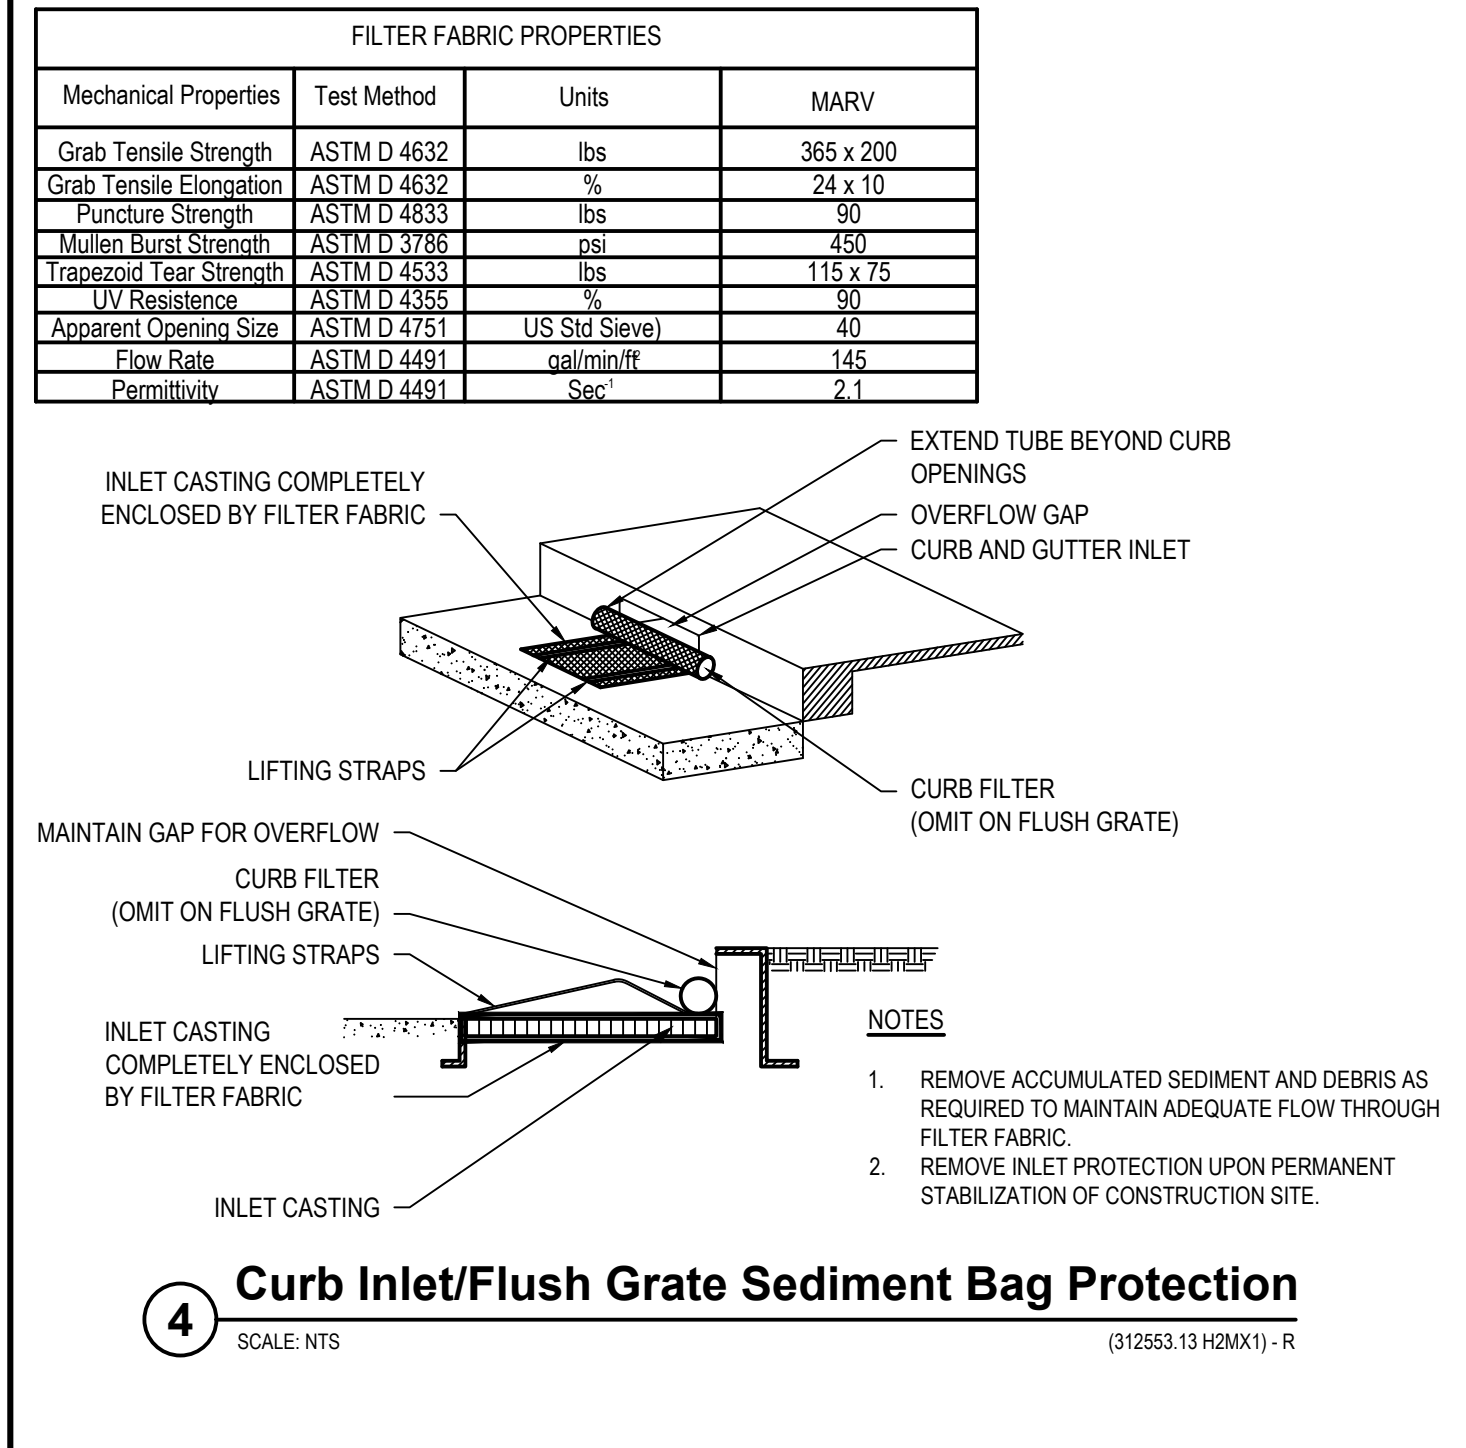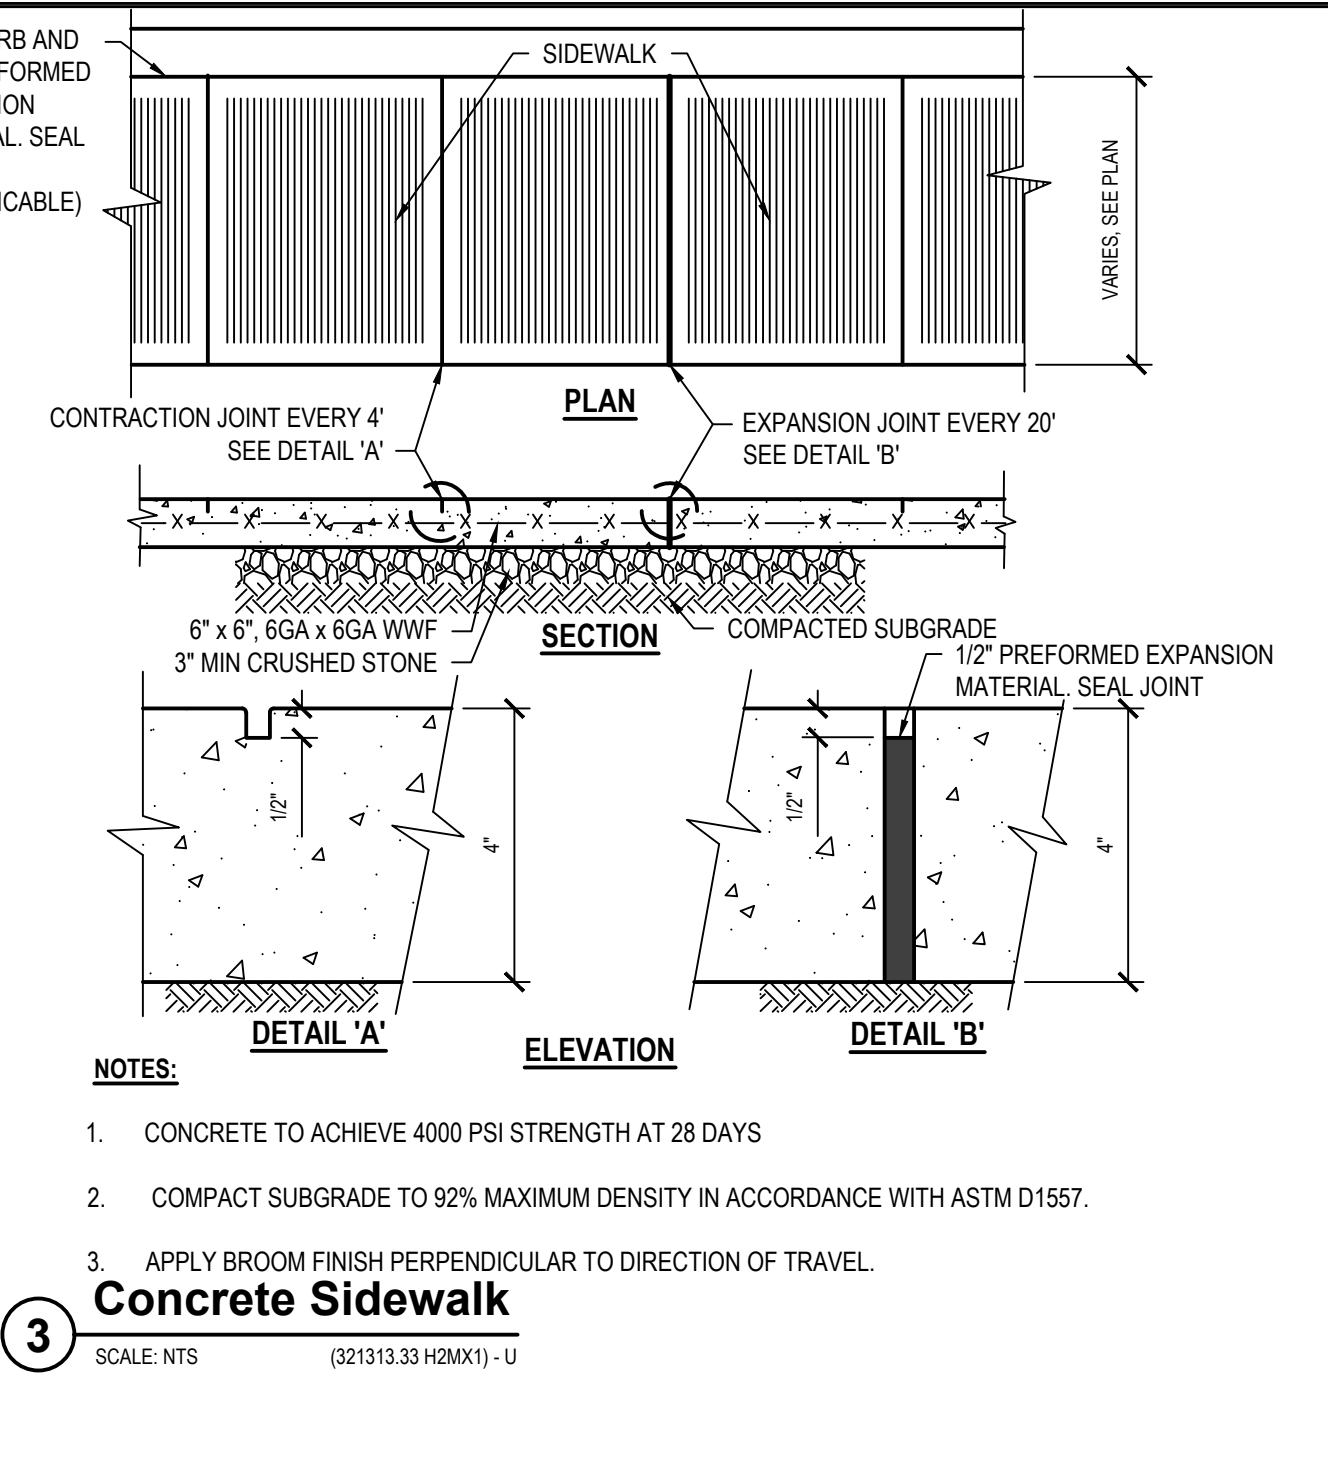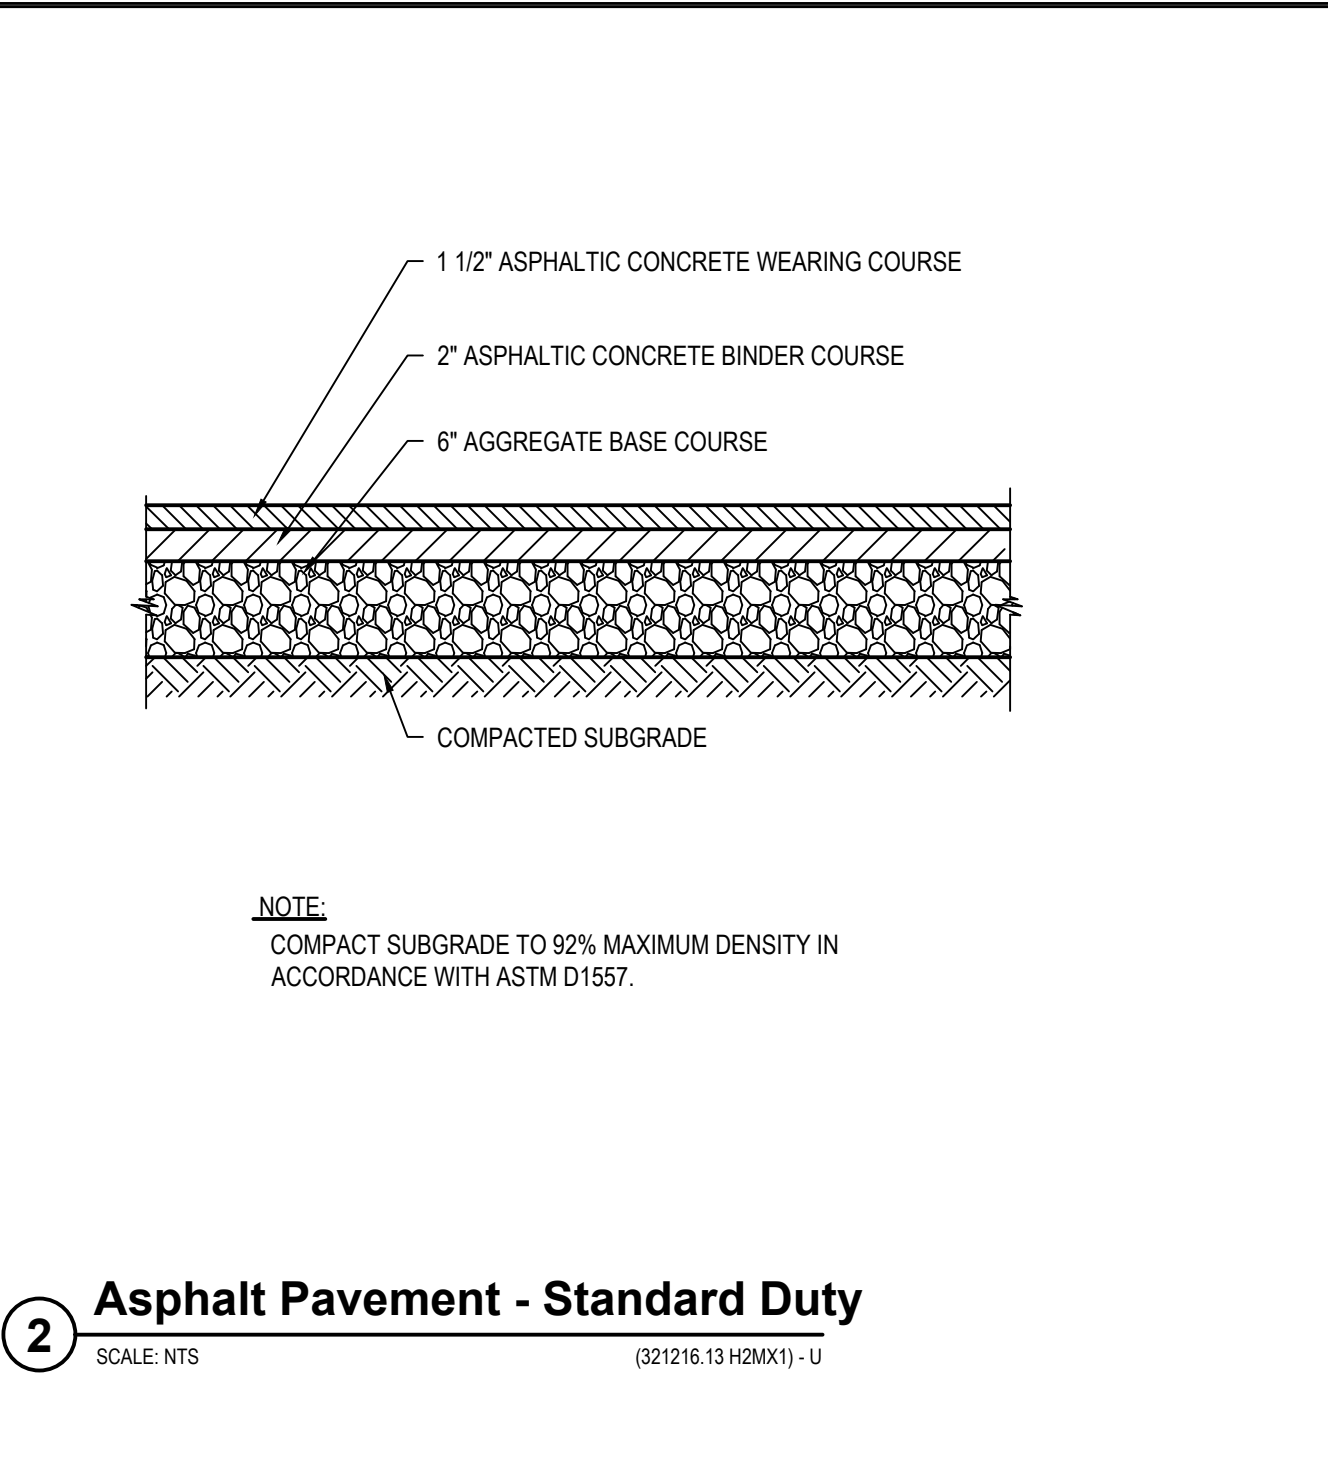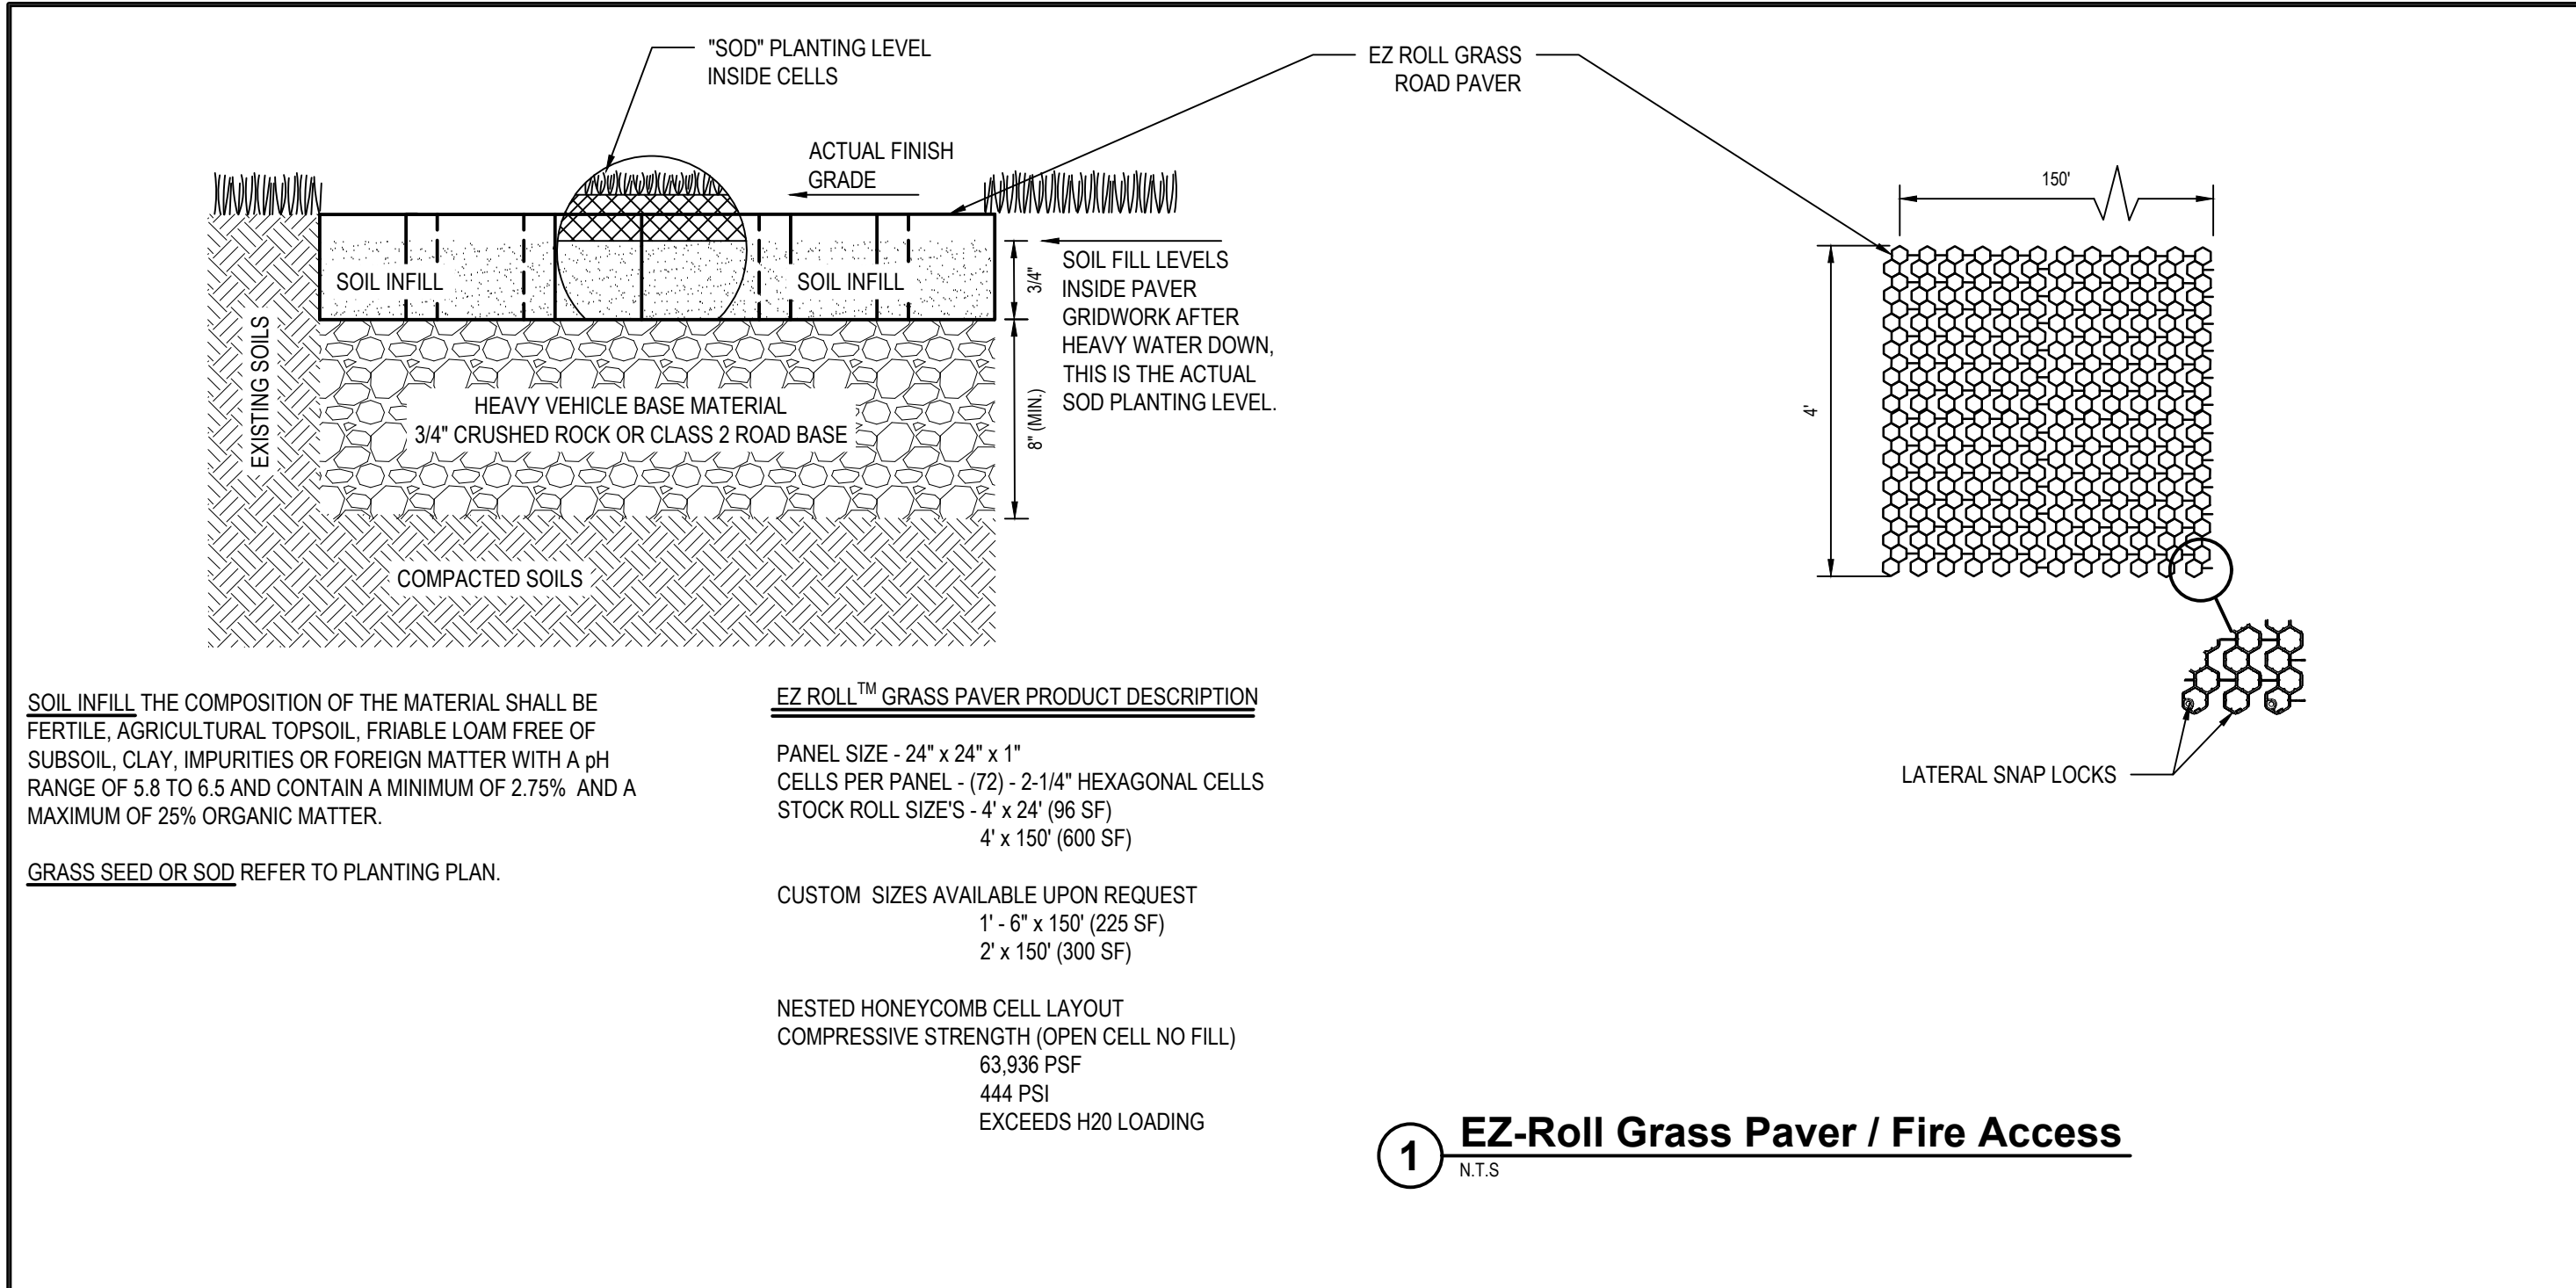

H2M

architects
+
engineers

2700 Westchester Avenue, Suite 415
Purchase, NY 10577
914.358.5623 • www.h2m.com

CONSULTANTS:

MARK	DATE	DESCRIPTION
3	12/14/2021	ADDENDUM #3
2	12/10/2021	ADDENDUM #2
1	12/01/2021	ADDENDUM #1
	11/18/2021	FINAL BID DOCUMENT

STATE OF NEW YORK
JOEL RICHARDS
099970
REGISTERED PROFESSIONAL ENGINEER

ALTERNATION OF THIS DOCUMENT EXCEPT BY A LICENSED PROFESSIONAL IS ILLEGAL.

DESIGNED BY:	DRAWN BY:	CHECKED BY:	REVIEWED BY:
EPI	EPI	RJR	

PROJECT No.:	DATE:	SCALE:
IRSD1903	NOV 2021	AS SHOWN

CLIENT

Irvington Union Free School District

Facilities Storage Building at Irvington Campus

IRVINGTON
NEW YORK
UNION FREE SCHOOL DISTRICT

Irvington Campus
40 N. Broadway
Irvington, NY 10533








SED Number:66-04-02-02-2-022-001

CONTRACT	CONTRACT G GENERAL CONSTRUCTION
STATUS	FINAL BID DOCUMENT
SHEET TITLE	SITE DETAILS
DRAWING No.	C500.00


DOOR SCHEDULE																						
DOOR NO.	FROM ROOM		TO ROOM		DOOR SIZE		DOOR			FRAME			DETAIL			FIRE RATING	HARDWARE SET	SECURITY ACCESS	DOOR SIGNAGE	WEATHER STRIPPING	PANIC HARDWARE	COMMENTS
	NAME	NO.	NAME	NO.	WIDTH X HEIGHT	THICKNESS	DOOR TYPE	DOOR MATERIAL	DOOR FINISH	FRAME TYPE	FRAME MATERIAL	FRAME FINISH	HEAD	JAMB	SADDLE							
100	EXTERIOR	-	GARAGE	100	OPENING 10'-0" X 10'-0" DIMS	-	A	FRP	PT	-	-	PT	H2	J2	-	0	X	•	•	YES	•	
101	EXTERIOR	-	GARAGE	100	OPENING 10'-0" X 10'-0" DIMS	-	A	FRP	PT	-	-	PT	H2	J2	-	0	X	•	•	YES	•	
102	EXTERIOR	-	GARAGE	100	3'-0" X 7'-0"	1 3/4"	B	FRP	PT	F01	HM	PT	H1	J1	S1	0	01	YES	YES	YES	YES	S.S KICKPLATE ON EACH SIDE




FINISH SCHEDULE																
ROOM		FLOOR			WALLS								CEILING			COMMENTS
NUMBER	NAME	MATL.	FIN.	BASE	NORTH		EAST		SOUTH		WEST		MATL.	FIN.	HGT.	
					MATL.	FIN.	MATL.	FIN.	MATL.	FIN.	MATL.	FIN.				
100	GARAGE	CONC.	EPOXY	-	CONC.	EPOXY	CONC.	EPOXY	CONC.	EPOXY	CONC.	EPOXY	EXPOSED	-	-	

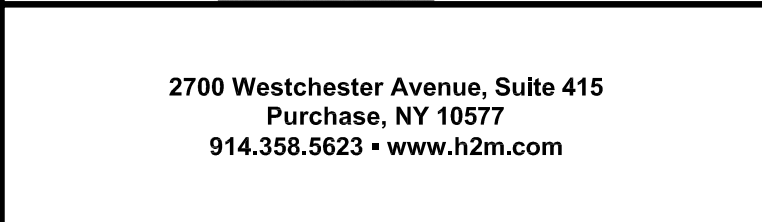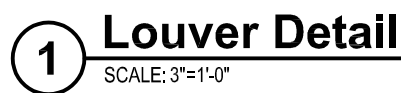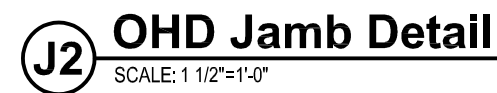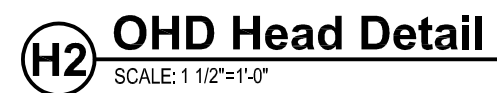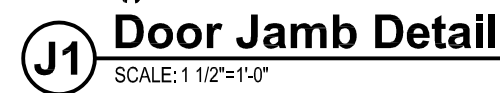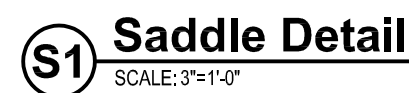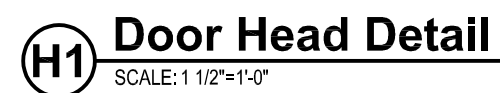

MARK	DATE	DESCRIPTION
3	12/14/2021	ADDENDUM #3
2	12/10/2021	ADDENDUM #2
1	12/01/2021	ADDENDUM #1
	11/18/2021	FINAL BID DOCUMENT

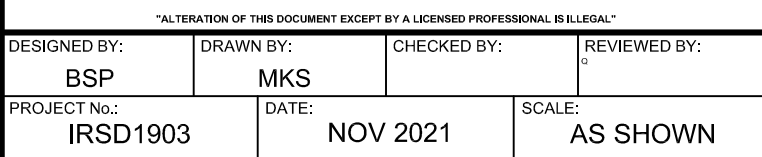

Facilities Storage Building at Irvington Campus

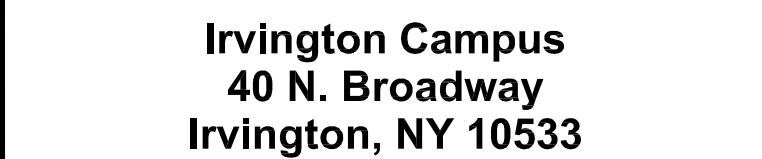

CONTRACT

CONTRACT G

GENERAL CONSTRUCTION

SHEET TITLE

DOOR SCHEDULE AND DETAILS

DRAWING No. **A6.0**