

# BRIARCLIFF MANOR U.F.S.D.

## DISTRICT ADMINISTRATION OFFICES

444 PLEASANTVILLE RD, BRIARCLIFF MANOR, NY 10510

## PHASE 2 BOND IMPROVEMENTS

## AT

### BRIARCLIFF MANOR MIDDLE/ HIGH SCHOOL

444 PLEASANTVILLE RD  
SED No.: 66-14-02-02-0-004-023  
BBS No.: 21-274C

### TODD ELEMENTARY SCHOOL

45 INGHAM RD  
SED No.: 66-14-02-02-0-002-021  
BBS No.: 21-274D



#### BRIARCLIFF MANOR MIDDLE/HIGH SCHOOL

GENERAL INFORMATION  
T0.01 TITLE SHEET  
  
CONSTRUCTION IMPLEMENTATION PLANS  
CIP-1 CONSTRUCTION IMPLEMENTATION NOTES  
CIP-2 FIRST FLOOR CONSTRUCTION IMPLEMENTATION PLAN  
CIP-3 SECOND FLOOR CONSTRUCTION IMPLEMENTATION PLAN  
CIP-4 FIRST FLOOR CONSTRUCTION IMPLEMENTATION PLAN - TODD ELEMENTARY

ARCHITECTURAL  
A0.01 CODE COMPLIANCE FIRST FLOOR HIGH SCHOOL  
A0.02 CODE COMPLIANCE SECOND FLOOR HIGH SCHOOL  
A0.03 CODE COMPLIANCE MIDDLE SCHOOL  
A0.06 PARTITION TYPES  
A1.00 FIRST FLOOR HIGH SCHOOL ABATEMENT PLAN  
A1.01 DEMOLITION FIRST FLOOR PLAN - AREA A & C  
A1.02 DEMOLITION FIRST FLOOR PLAN - AREA D  
A1.03 DEMOLITION SECOND FLOOR PLAN - AREA D  
A2.01 PROPOSED FIRST FLOOR PLAN - AREA A & C  
A2.02 PROPOSED FIRST FLOOR PLAN - AREA D  
A2.03 PROPOSED SECOND FLOOR PLAN - AREA D  
A2.04 ENLARGED PLANS  
A2.05 PLAN DETAILS  
A3.01 ROOF DEMOLITION PLANS  
A3.02 PROPOSED ROOF PLANS  
A4.01 MASONRY RECONSTRUCTION  
A5.01 BUILDING SECTIONS  
A5.02 BUILDING SECTIONS  
A6.01 WALL SECTIONS - LIGHT WELL  
A6.02 WALL SECTIONS  
A6.10 SECTIONS DETAILS  
A7.01 STAIR PLANS AND ELEVATIONS  
A7.02 STAIR PLANS AND ELEVATIONS  
A8.01 DOOR SCHEDULE AND DETAILS  
A8.02 STOREFRONT PLANS AND DETAILS  
A8.03 STOREFRONT PLANS AND ELEVATIONS  
A8.04 STOREFRONT PLANS AND ELEVATIONS  
A8.05 STOREFRONT PLANS AND ELEVATIONS  
A9.01 FINISH SCHEDULE  
A9.02 FINISH FLOOR PLAN  
A10.01 REFLECTED CEILING PLANS - AREA A & C  
A10.02 REFLECTED CEILING FIRST FLOOR PLAN - AREA D  
A10.03 REFLECTED CEILING SECOND FLOOR PLAN - AREA D  
A10.10 REFLECTED CEILING DETAILS  
A11.01 ENLARGED RESTROOM PLANS & ELEVATIONS  
A11.02 ENLARGED RESTROOM ELEVATIONS  
A11.03 ENLARGED RESTROOM ELEVATIONS  
A11.04 ENLARGED EQUIPMENT PLANS & DETAILS  
A11.05 ENLARGED EQUIPMENT PLANS & DETAILS  
A11.06 ENLARGED EQUIPMENT PLANS & DETAILS  
A11.07 NOT USED  
A11.08 ENLARGED FURNITURE PLANS - AREA A & C  
A11.09 ENLARGED FURNITURE PLANS - AREA D

STRUCTURAL  
S0.01 DESIGN DATA AND GENERAL NOTES  
S0.02 SPECIAL INSPECTION NOTES AND SCHEDULE  
S1.00 FOUNDATION PLAN  
S1.01 ROOF FRAMING PLAN  
S3.00 CONCRETE SECTIONS AND DETAILS  
S5.00 STEEL SECTIONS AND DETAILS

MECHANICAL  
M0.01 GENERAL NOTES, LEGENDS AND SYMBOLS (1 OF 2)  
M0.02 GENERAL NOTES, LEGENDS AND SYMBOLS (2 OF 2)  
M1.01 DEMOLITION HVAC PART PLANS - AREA A & C  
M1.02 DEMOLITION HVAC PART PLANS - AREA D  
M1.03 DEMOLITION ROOF HVAC PART PLAN - AREA D & E  
M1.04 DEMOLITION PIPING PART PLANS - AREA A & C  
M1.05 DEMOLITION PIPING PART PLANS - AREA D & E  
M1.06 SECOND FLOOR AND ROOF DEMOLITION PIPING PART PLAN - AREA D & E  
M1.07 SECOND FLOOR ROOF DEMOLITION PIPING PART PLAN - AREA D & E  
M2.01 PROPOSED HVAC PLAN - AREA A & C  
M2.02 PROPOSED HVAC PLAN - AREA D  
M2.03 PROPOSED HVAC SECOND FLOOR AND ROOF PART PLAN - AREA D & E  
M2.04 PROPOSED HVAC PLAN - AREA H  
M3.01 PROPOSED PIPING PLAN - AREA A & C  
M3.02 PROPOSED PIPING PLAN - AREA D  
M3.03 PROPOSED PIPING ROOF PLAN - AREA D & E  
M3.04 PROPOSED SECOND FLOOR AND ROOF HVAC PART PLAN - AREA C & D  
M5.01 NOT USED  
M6.01 SCHEDULES, EQUIPMENT NOTES AND DETAILS  
M6.02 SCHEDULES, EQUIPMENT NOTES AND DETAILS  
M6.03 SCHEDULES, EQUIPMENT NOTES AND DETAILS  
M6.04 SCHEDULES, EQUIPMENT NOTES AND DETAILS  
M6.05 SCHEDULES, EQUIPMENT NOTES AND DETAILS  
M6.06 SCHEDULES, EQUIPMENT NOTES AND DETAILS  
M6.07 SCHEDULES, EQUIPMENT NOTES AND DETAILS  
M6.08 SCHEDULES, EQUIPMENT NOTES AND DETAILS  
M6.09 SCHEDULES, EQUIPMENT NOTES AND DETAILS  
M6.10 SCHEDULES, EQUIPMENT NOTES AND DETAILS

#### TODD ELEMENTARY SCHOOL

ARCHITECTURAL  
A0.01 CODE COMPLIANCE NOTES & PARTITION TYPES  
A0.02 OVERALL KEY PLAN  
A1.00 ABATEMENT PLAN  
A1.01 DEMO PLAN RESTROOM AND VESTIBULE  
A1.02 PROPOSED RESTROOM AND VESTIBULE  
A2.01 RAILINGS AND DETAILS  
A2.02 RAILING PLANS & ELEVATIONS  
A4.01 MASONRY RECONSTRUCTION  
A8.01 DOOR SCHEDULE, FINISH SCHEDULE AND DETAILS  
A10.01 REFLECTED CEILING PLANS

MECHANICAL  
M0.01 MECHANICAL GENERAL NOTES, LEDGENDS AND SCHEDULES  
M1.01 HVAC DEMOLITION & PROPOSED PART PLANS  
M6.01 MECHANICAL SCHEDULES & DETAILS


PLUMBING  
P0.01 GENERAL NOTES, LEGENDS & SCHEDULES  
P1.01 DEMOLITION PLANS  
P2.01 PROPOSED PLANS

ELECTRICAL  
E0.01 GENERAL NTOES, LEDGENDS AND DETAILS  
E4.01 PROPOSED PANEL REPLACEMENT  
E6.01 ENLARGED TOILET ROOM PLANS

## LOCATION MAP

TODD ELEMENTARY  
SCHOOL

BRIARCLIFF MANOR  
MIDDLE/ HIGH SCHOOL

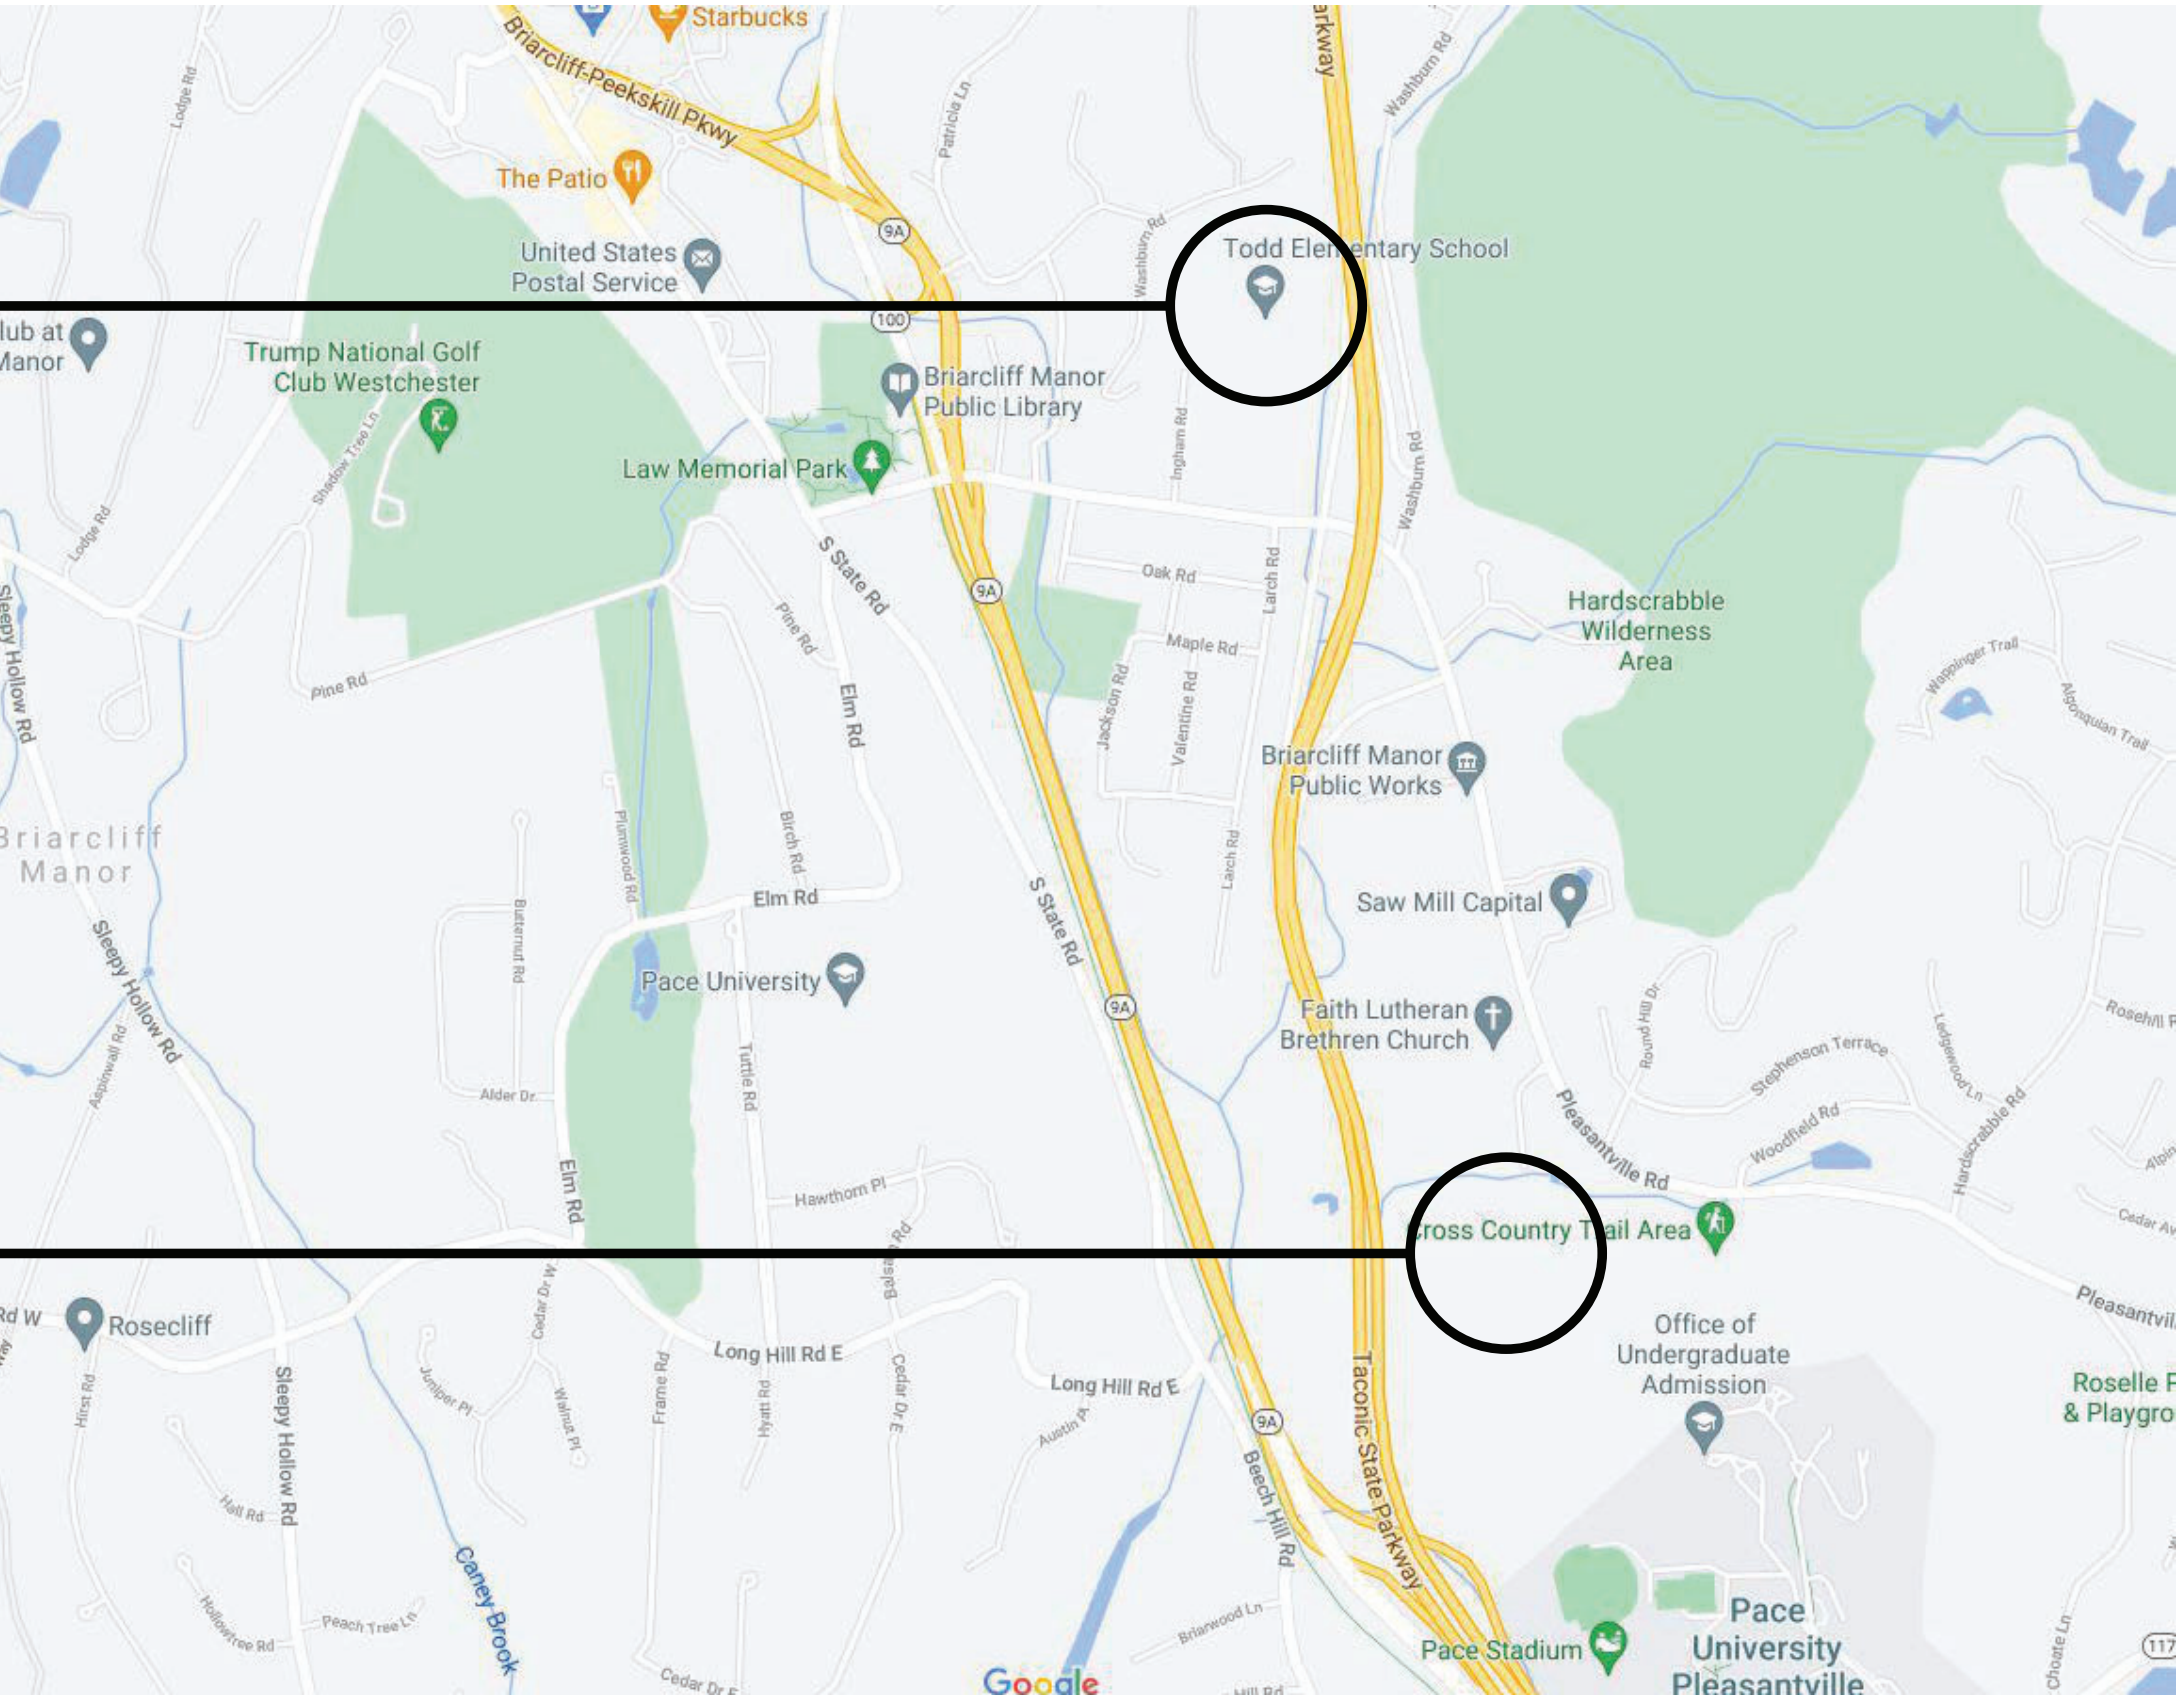

**BBS** ARCHITECTS  
LANDSCAPE ARCHITECTS  
ENGINEERS

BRANCH PROJECT CONTACT: 187 WOLF ROAD, SUITE 205 | ALBANY | NEW YORK 12205 | T. 518.621.7650  
244 EAST MAIN STREET | PATCHOGUE | NEW YORK 11772 | T. 631.475.0349 | F. 631.475.0361


WWW.BBSARCHITECTURE.COM

ARCHITECTS CERTIFICATION  
THE UNDERSIGNED CERTIFIES THAT TO THE BEST OF HIS KNOWLEDGE, INFORMATION, AND BELIEF, THE PLANS AND SPECIFICATIONS ARE IN ACCORDANCE WITH APPLICABLE REQUIREMENTS OF THE NEW YORK STATE UNIFORM FIRE PREVENTION AND BUILDING CODE, THE NEW YORK STATE ENERGY CONSERVATION CONSTRUCTION CODE, AND THE CONSTRUCTION STANDARDS OF THE EDUCATION DEPARTMENT.

LAWRENCE SALVESEN, A.I.A. LIC. No. 020623

T0.01  
BBS FILE No. 21-274C HS/MS  
21-274D TODD ES  
ISSUE FOR BID: NOVEMBER 16, 2022



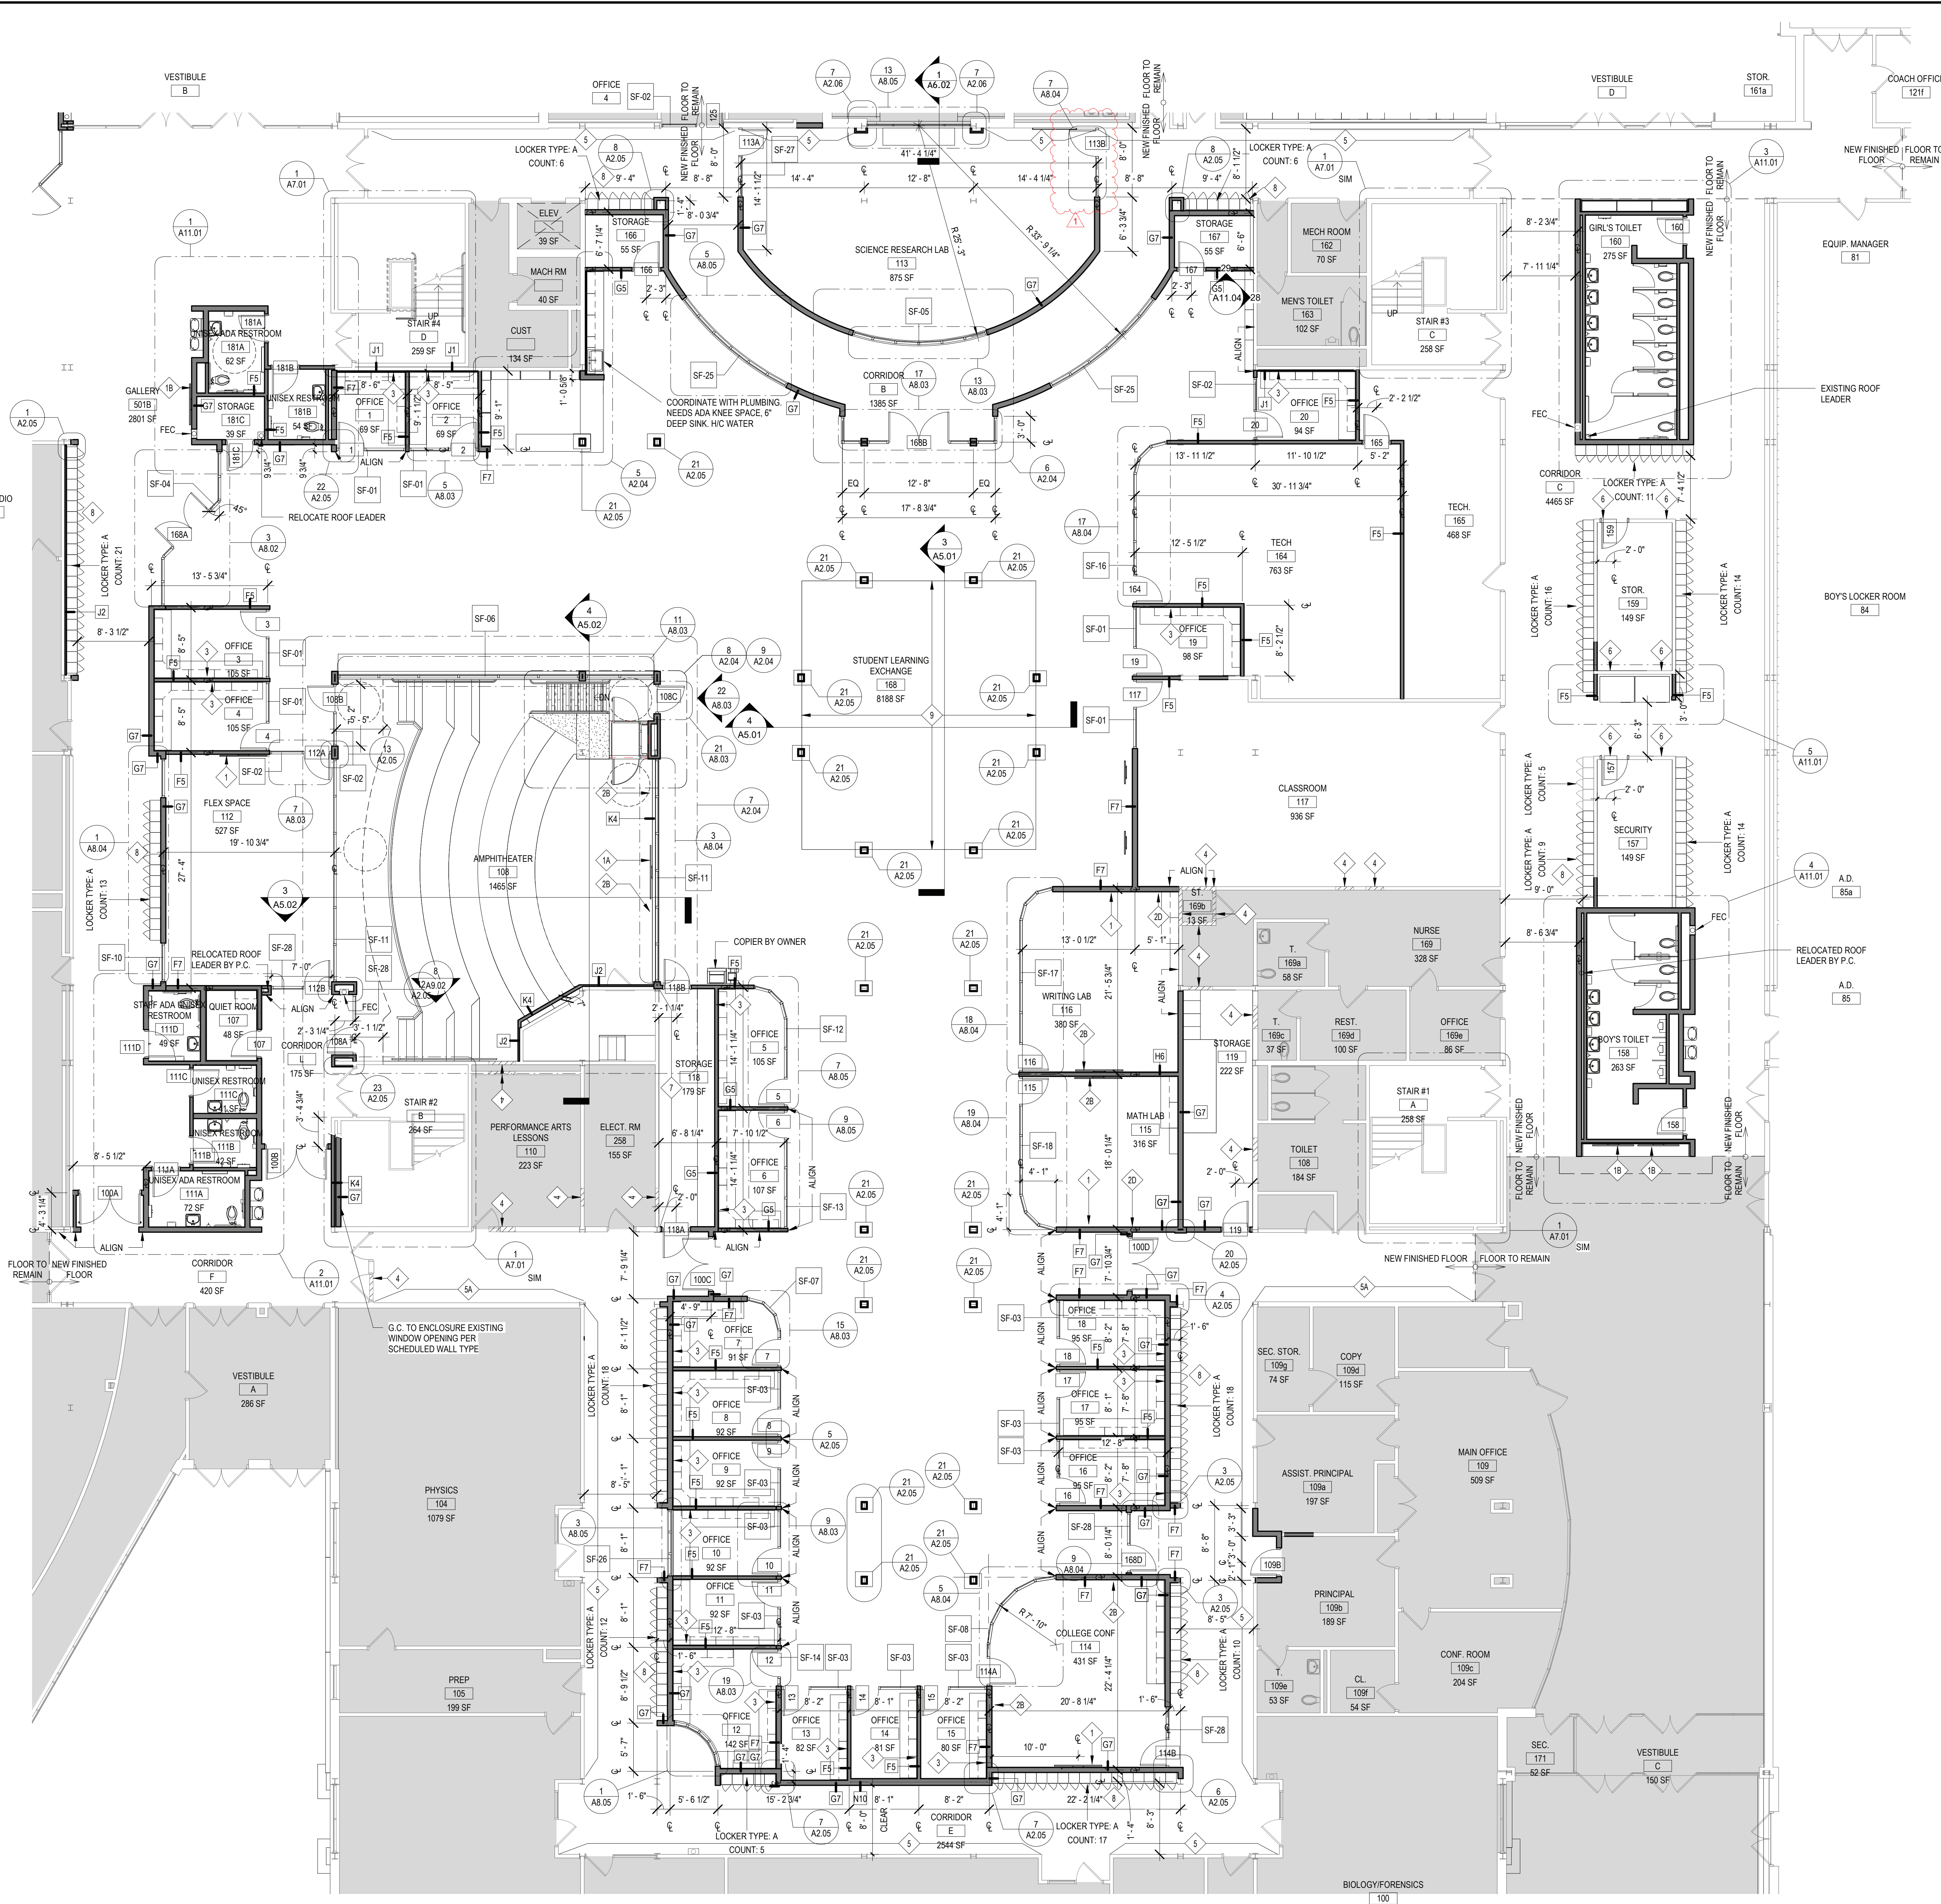

1 FIRST FLOOR PROPOSED PLAN - AREA D  
SCALE: 1/8" = 1'-0"

REV.	DATE	ITEM
1	11/28/2022	BID ADDENDUM #1

NOTICE  
THESE DRAWINGS ARE BASED ON CONSTRUCTION DRAWINGS NOT PREPARED BY BBS ARCHITECTS, LANDSCAPE ARCHITECTS AND ENGINEERS, P.C. AND THEREFORE, THEY MAY NOT REPRESENT THE CONDITIONS AS CONSTRUCTED AT THE TIME. ALL EXISTING CONDITIONS SHALL BE REPRESENTED AS SUGGESTED INFORMATION AS THEY MAY NOT HAVE BEEN FIELD AND SHOULD BE THE ORIGINAL DOCUMENTS OF THE OWNER'S INFORMATION.

KEY PLAN  
NO SCALE

BRIARCLIFF MANOR U.F.S.D.  
PHASE 2 BOND IMPROVEMENTS  
BRIARCLIFF MANOR MIDDLE / HIGH SCHOOL  
444 PLEASANTVILLE RD. BRIARCLIFF MANOR, NY 10510

PROPOSED FIRST FLOOR PLAN - AREA D

PROJECT  
DWG. BY: C.M.  
CHK. BY: G.E.O.

THIS DRAWING, PREPARED FOR THE SPECIFIC PROJECT INDICATED IN AN INSTRUMENT OF SERVICE AND THE PROPERTY OF BBS ARCHITECTS, LANDSCAPE ARCHITECTS AND ENGINEERS, P.C., IS NOT TO BE REPRODUCED OR USED IN ANY MANNER FOR ANY OTHER PROJECT WITHOUT THE WRITTEN CONSENT OF BBS ARCHITECTS, LANDSCAPE ARCHITECTS AND ENGINEERS, P.C.

**BBS**  
ARCHITECTS  
LANDSCAPE ARCHITECTS  
ENGINEERS  
BRANCH PROJECT CONTACT: 187 WOLF ROAD, STE. 205 ALBANY, NEW YORK 12205 T: 518.621.7650  
244 EAST MAIN STREET PATROCKVILLE, NEW YORK 11772 T: 631.475.0349 F: 631.475.0361  
WWW.BBSARCHITECTURE.COM

SED NO. 66-14-02-02-0-004-003  
DISTRICT BRIARCLIFF MANOR U.F.S.D.  
PROJECT PHASE 2 BOND IMPROVEMENTS  
DWG TITLE PROPOSED FIRST FLOOR PLAN - AREA D  
SCALE: AS NOTED  
DATE: -  
BID PAU DATE: 11/14/2022  
FILE NO. 21-274C

A2.02 HSMS

ARCHITECTURAL SYMBOL LEGEND	
SYMBOL	DESCRIPTION
X	KEY NOTE
DOOR	DOOR NUMBER
W	WINDOW DESIGNATION
ROOM TAG	ROOM NAME
ROOM NUMBER	ROOM NUMBER
ROOM AREA	ROOM AREA
ELEVATION DATUM	ELEVATION DATUM
DETAIL TAG	DETAIL NUMBER
DETAIL NUMBER	DRAWING NUMBER
SECTION ELEVATION TAG	SECTION ELEVATION TAG
DETAIL NUMBER	DRAWING NUMBER
DOOR	DENOTES INTERIOR PARTITION TYPE - REFER TO PARTITION TYPES FOR ADDITIONAL INFORMATION
DOOR	DENOTES LOCATION OF RECESSED FIRE EXTINGUISHER WITH FIRE RATED CABINET
DOOR	DENOTES LOCATION OF DRINKING FOUNTAIN
DOOR	DENOTES LOCATION OF FULL BUILDING EXPANSION JOINT - PROVIDE APPROPRIATE INTERIOR FLOOR, WALL AND CEILING EXPANSION JOINT COVERS, WHERE APPLICABLE. PROVIDE VERTICAL JOINT BY EXTERIOR OR EQUAL AT EXTERIOR, WHERE APPLICABLE
DOOR	DENOTES LOCATION OF 12" MASONRY CONTROL JOINT WITH CONTINUOUS BACKER ROD AND SEALANT
DOOR	DENOTES LOCATION OF NEW CAST STONE DATE STONE
DOOR	DENOTES LOCATION OF NEW DESIGNATION PLaque
DOOR	DENOTES LOCATION OF SMOKE DOOR
DOOR	DENOTES FINISH FLOOR ELEVATION REFERENCED FROM 0'-0" WHERE ENGINEERING ELEVATIONS ARE REFERENCED FROM 0'-0" REFER TO CIVIL SERIES DRAWINGS FOR ADDITIONAL DATUM INFORMATION
DOOR	DENOTES LOCATION AND DESIGNATION OF NEW LEVEL
DOOR	DENOTES LOCATION OF NEW EXISTING WINDOW
DOOR	DENOTES LOCATION OF TRUSS / JOIST IDENTIFICATION SIGN
DOOR	DENOTES LOCATION OF AUTOMATED EXTERNAL DEFIBRILLATOR
DOOR	DENOTES LOCATION OF ASSEMBLY SPACE MAXIMUM OCCUPANCY SIGN
DOOR	DENOTES LOCATION OF AREA OF REFUGE WITH TWO-WAY COMMUNICATION DEVICE. REFER TO E-SERIES DRAWINGS FOR ADDITIONAL INFORMATION
DOOR	DENOTES MAXIMUM DOOR / STAIR EXITING CAPACITY
DOOR	DENOTES R.E.U. FOR ASSEMBLY SPACES
DOOR	DENOTES DOOR ON MAGNETIC AUTOMATIC HOLD OPEN DEVICE, CONNECTED TO FIRE ALARM SYSTEM
DOOR	MAX. OCCUPANCY (LOAD PER N.Y.S. CODE)
DOOR	PURL. STATION COUNT
DOOR	DENOTES ACCESSIBLE ENTRANCEWAY: FURNITURE, ACCESSORY DEVICE, OR PARTITION/SCREEN
DOOR	REVISION CLOUD AND KEYED DESIGNATION. REFER TO DRAWING TITLEBLOCK FOR ADDITIONAL INFORMATION


ARCHITECTURAL KEY NOTES	
1	75" DIAG SMART BOARD BY OWNER. MOUNTING BLOCKING BY G.C. POWER BY E.C. REFER TO MOUNTING DETAIL 1/A2.06 FOR INFO.
1A	85" DIAG SMART BOARD BY OWNER. MOUNTING BLOCKING BY G.C. POWER BY E.C. REFER TO MOUNTING DETAIL 1/A2.06 FOR INFO.
1B	85" DIAG SMART BOARD BY OWNER. MOUNTING BLOCKING BY G.C. POWER BY E.C. REFER TO MOUNTING DETAIL 1/A2.06 FOR INFO.
2A	16" MARKER BOARD BY G.C.
2B	8" MARKER BOARD BY G.C.
2C	6" MARKER BOARD BY G.C.
2D	4" MARKER BOARD BY G.C.
3	HOMASOTE TACK BOARD WRAPPED W/ FABRIC, CUT TO ALIGN WITH ALL WALL CABINETS ABOVE AND COUNTERTOP BELOW REFER TO FINISH SCHEDULE.
4	G.C. SHALL INFILL EXISTING GYP. BOARD WALL OPENING ABOVE CEILING AND OR INFILL TO NEW SIZED OPENING AFTER DUCT REMOVAL/INSTALL BY M.C. MATCH EXISTING ADJACENT CONDITIONS. TAPE/SPACKLE AND FIRE STOP OPENINGS. (TYP.)
5	G.C. SHALL PATCH/REPAIR EXISTING GYP. BOARD WALL AFTER REMOVAL OF EXISTING WALL MOUNTED LIGHTING BY E.C. PAINT. (TYPICAL ENTIRE LENGTH OF CORRIDOR)
5A	G.C. SHALL PATCH/REPAIR EXISTING MASONRY WALL AFTER REMOVAL OF EXISTING WALL MOUNTED LIGHTING BY E.C. PAINT. PATCH EXISTING FASTENER HOLES. (TYPICAL ENTIRE LENGTH OF CORRIDOR)
6	G.C. SHALL PATCH/REPAIR EXISTING GYP. BOARD WALL AFTER REMOVAL OF EXISTING LIGHTING FIXTURE BY E.C. PAINT. (TYP.)
7	G.C. SHALL PATCH/REPAIR EXISTING GYP. BOARD WALL AFTER REMOVAL/INSTALL OF ELECTRICAL PANELS BY E.C. PAINT. (TYP.)
8	G.C. SHALL REINSTALL EXISTING LOCKERS AND BASES. PROVIDE NEW CONTINUOUS SLOPE TOP TO MATCH EXISTING COLOR. PROVIDE NEW RUBBER BASE AT LOCKER. (TYP.)
9	G.C. SHALL PROVIDE AND INSTALL NEW SLAB ON GRADE. REFER TO STRUCTURAL DRAWINGS AND ELECTRICAL DRAWINGS FOR UNDERSLAB ELECTRICAL.
10	G.C. SHALL INSTALL NEW PHENOLIC RESIN SILL
11	G.C. SHALL PROVIDE AND INSTALL NEW 9793X4" THICK CONCRETE PAD CENTERED ON NEW LOCKER. PROVIDE 6X6 4.0X4.0W/W REIN. WITH 8" THICK HAUNCH AT PERIMETER. PROVIDE BROOM FINISH.

MATERIAL LEGEND	
HATCH	MATERIAL
CMU WALL CONSTRUCTION	EARTH
24 HOUR FIREWALL CONSTRUCTION	GRAVEL
BRICK VENEER CONSTRUCTION	RIGID INSULATION
GYP/PLUM AND METAL STUD WALL CONSTRUCTION	BATT INSULATION
GYP/PLUM BOARD PLASTER, MORTAR, SAND	PLYWOOD
CONCRETE	INTERMEDIATE BLOCKING CONTINUOUS BLOCKING
STEEL	FINISH WOOD


FLOOR PLAN LEGEND	
AREA NOT IN CONTRACT U.O.N.	
AREA NOT IN CONTRACT U.O.N.	

GENERAL CONSTRUCTION NOTES  
1. GENERAL CONTRACTOR SHALL VERIFY ALL EXISTING CONDITIONS PRIOR TO BIDDING AND PROCEEDING WITH WORK. NOTIFY ARCHITECT OF ANY DISCREPANCIES IN WRITING PRIOR TO START OF WORK.  
2. IN ACCORDANCE WITH STATE AND LOCAL CODES, THE REQUIRED EXITS IN THE EXISTING BUILDING MUST BE KEPT CLEAR, MAINTAINED AND PROTECTED DURING THE CONSTRUCTION PERIOD.  
3. CONTRACTOR SHALL BE RESPONSIBLE FOR VERIFICATION OF ALL DIMENSIONS REQUIRED FOR ESTIMATING.  
4. ALL WORK AND MATERIAL OF THIS PROJECT AND ADJACENT SURFACES SHALL BE PROTECTED FROM DAMAGE. IN THE EVENT OF DAMAGE, THE CONTRACTOR SHALL IMMEDIATELY MAKE ALL REPAIRS AND REPLACEMENT NECESSARY TO THE APPROVAL OF THE ARCHITECT AND OWNER AND AT NO ADDITIONAL COST TO OWNER.  
5. CONTRACTOR SHALL PROTECT ALL AREAS OF WORK FROM INCLEMENT WEATHER DURING AND AT THE END OF EACH WORK OPERATION.  
6. ALL PROJECT WASTE MATERIAL AND RUBBISH SHALL BE DISPOSED IN CONTAINERS PROVIDED BY THE CONTRACTOR FOR SUBSEQUENT LEGAL OFF-SITE DISPOSAL. CONTAINER LOCATION TO BE COORDINATED WITH THE OWNER & CONSTRUCTION MANAGER. OFF-SITE DISPOSAL TO BE ON A REGULAR BASIS.  
7. ALL INTERIOR SURFACES DISTURBED DURING CONSTRUCTION SHALL BE REPAIRED AND/OR REPLACED TO MATCH EXISTING CONDITIONS TO THE APPROVAL OF THE ARCHITECT AND OWNER.  
8. ALL DEBRIS, DUST AND DIRT CAUSED BY WORK OF THIS CONTRACT SHALL BE REMOVED FROM SITE BY APPROPRIATE MEANS. RESTORE ALL CONDITIONS TO THE STATE OF CLEANLINESS THAT EXISTED PRIOR TO COMMENCEMENT OF WORK.  
9. ALL DEMOLITION AND CONSTRUCTION WORK TO BE PERFORMED MUST NOT PROCEED UNTIL WRITTEN APPROVAL HAS BEEN OBTAINED FROM OWNER.  
10. ALL CONTRACTORS ARE TO COORDINATE INSTALLATION OF THEIR WORK WITH EACH OTHER AND WITH THE WORK BEING PERFORMED UNDER SEPARATE CONTRACTS BY OTHERS AND WORK PERFORMED BY THE OWNER'S VENDOR(S).  
11. REFER TO CONSTRUCTION IMPLEMENTATION PLANS AND CONSTRUCTION SPECIAL PROVISIONS (PREPARED BY OTHERS, IF APPLICABLE) FOR ALL REQUIREMENTS FOR TEMPORARY CONSTRUCTION.




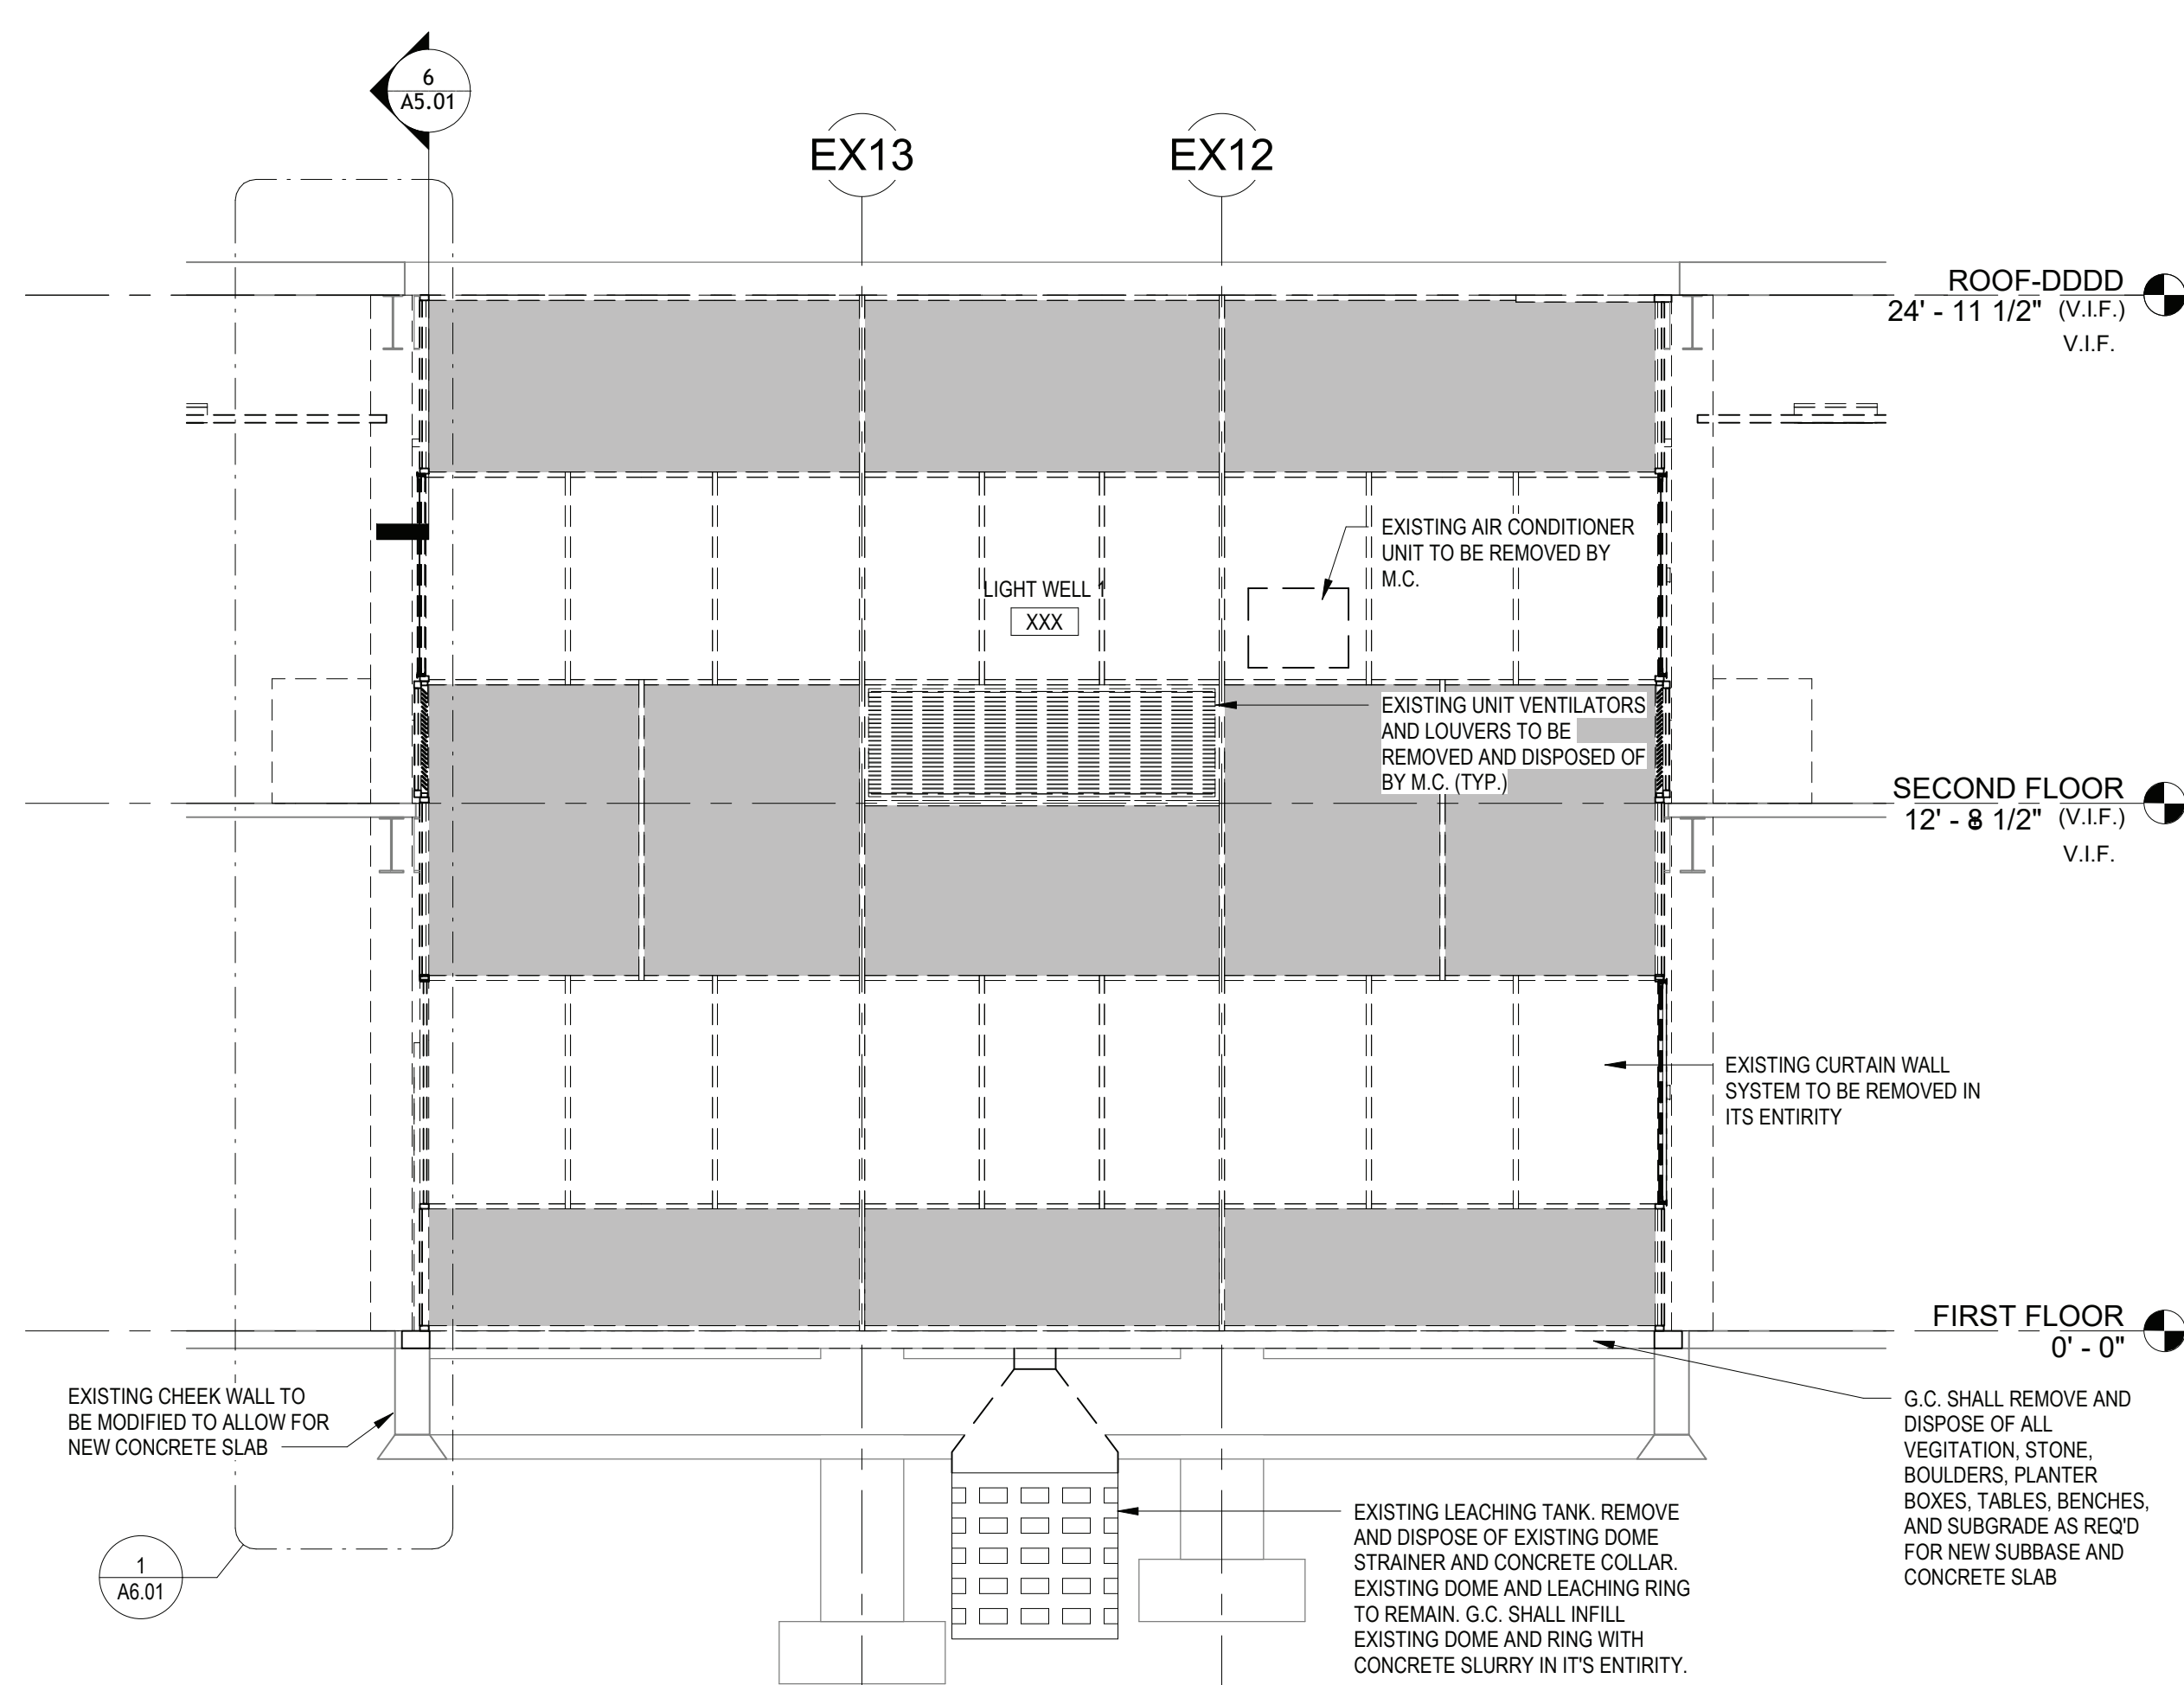


1 LIGHT WELL DEMOLITION SECTION  
SCALE: 1/4" = 1'-0"

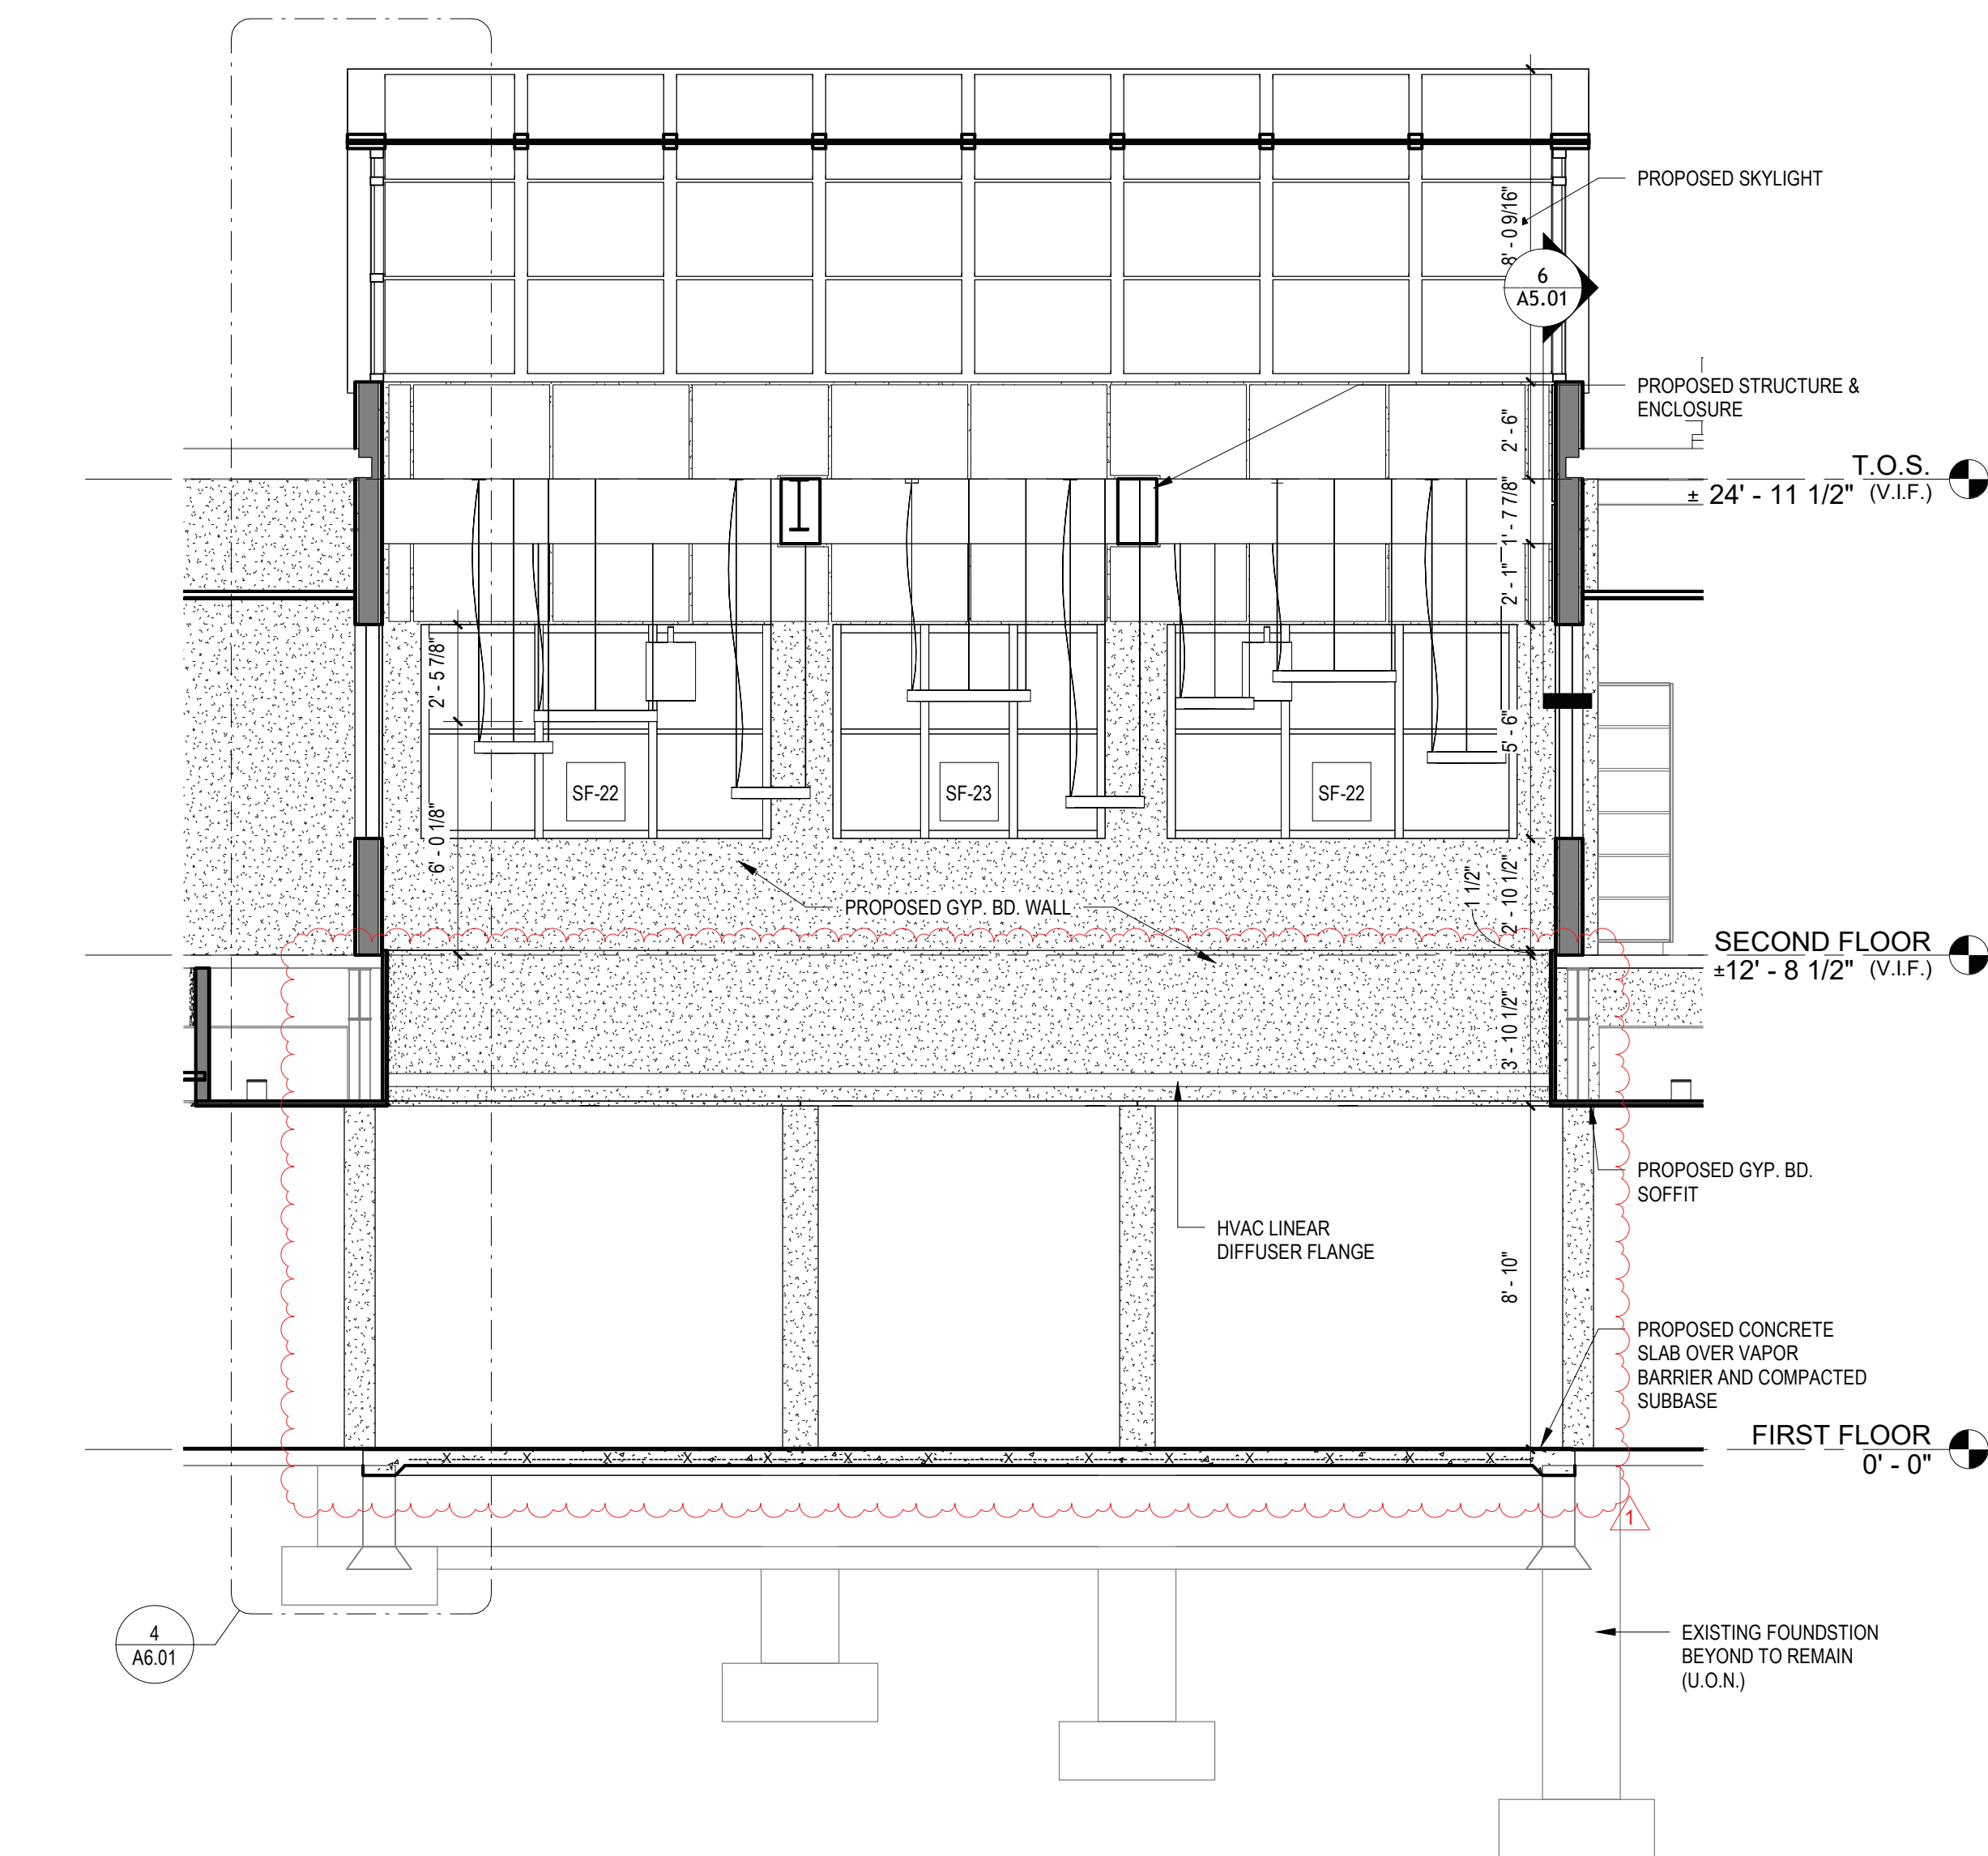


3 PROPOSED LIGHT WELL SECTION  
SCALE: 1/4" = 1'-0"

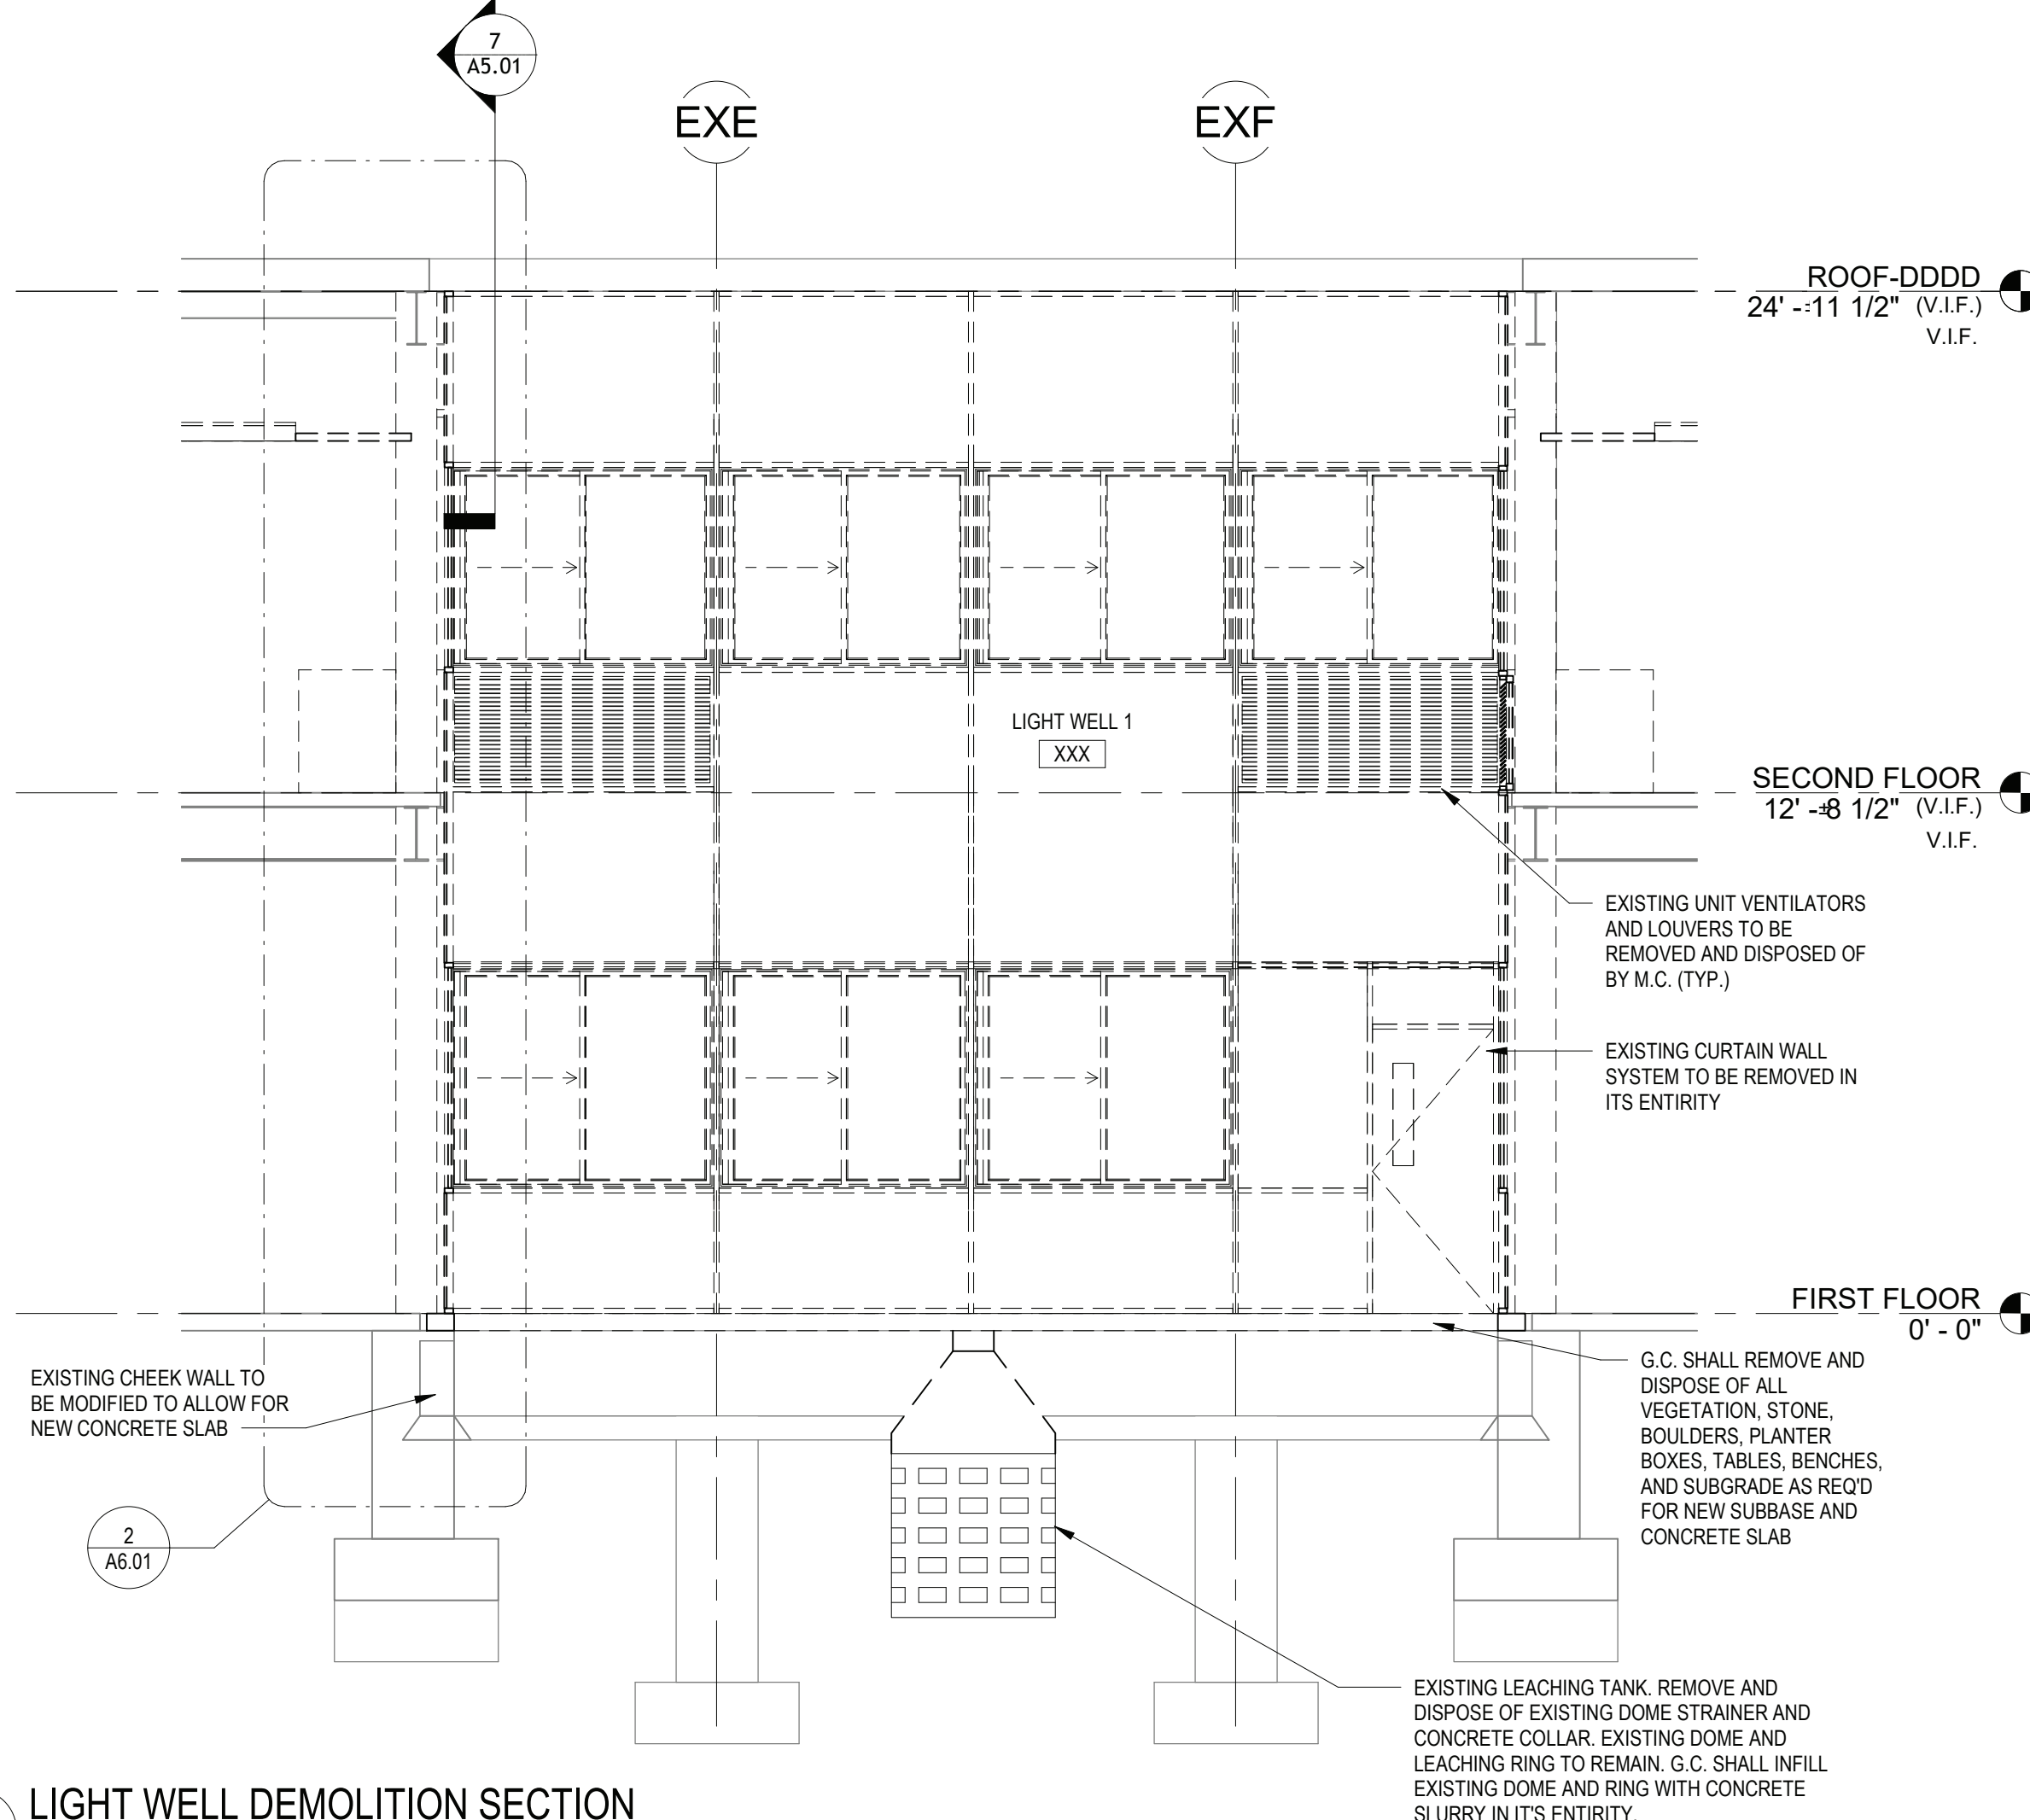


2 LIGHT WELL DEMOLITION SECTION  
SCALE: 1/4" = 1'-0"

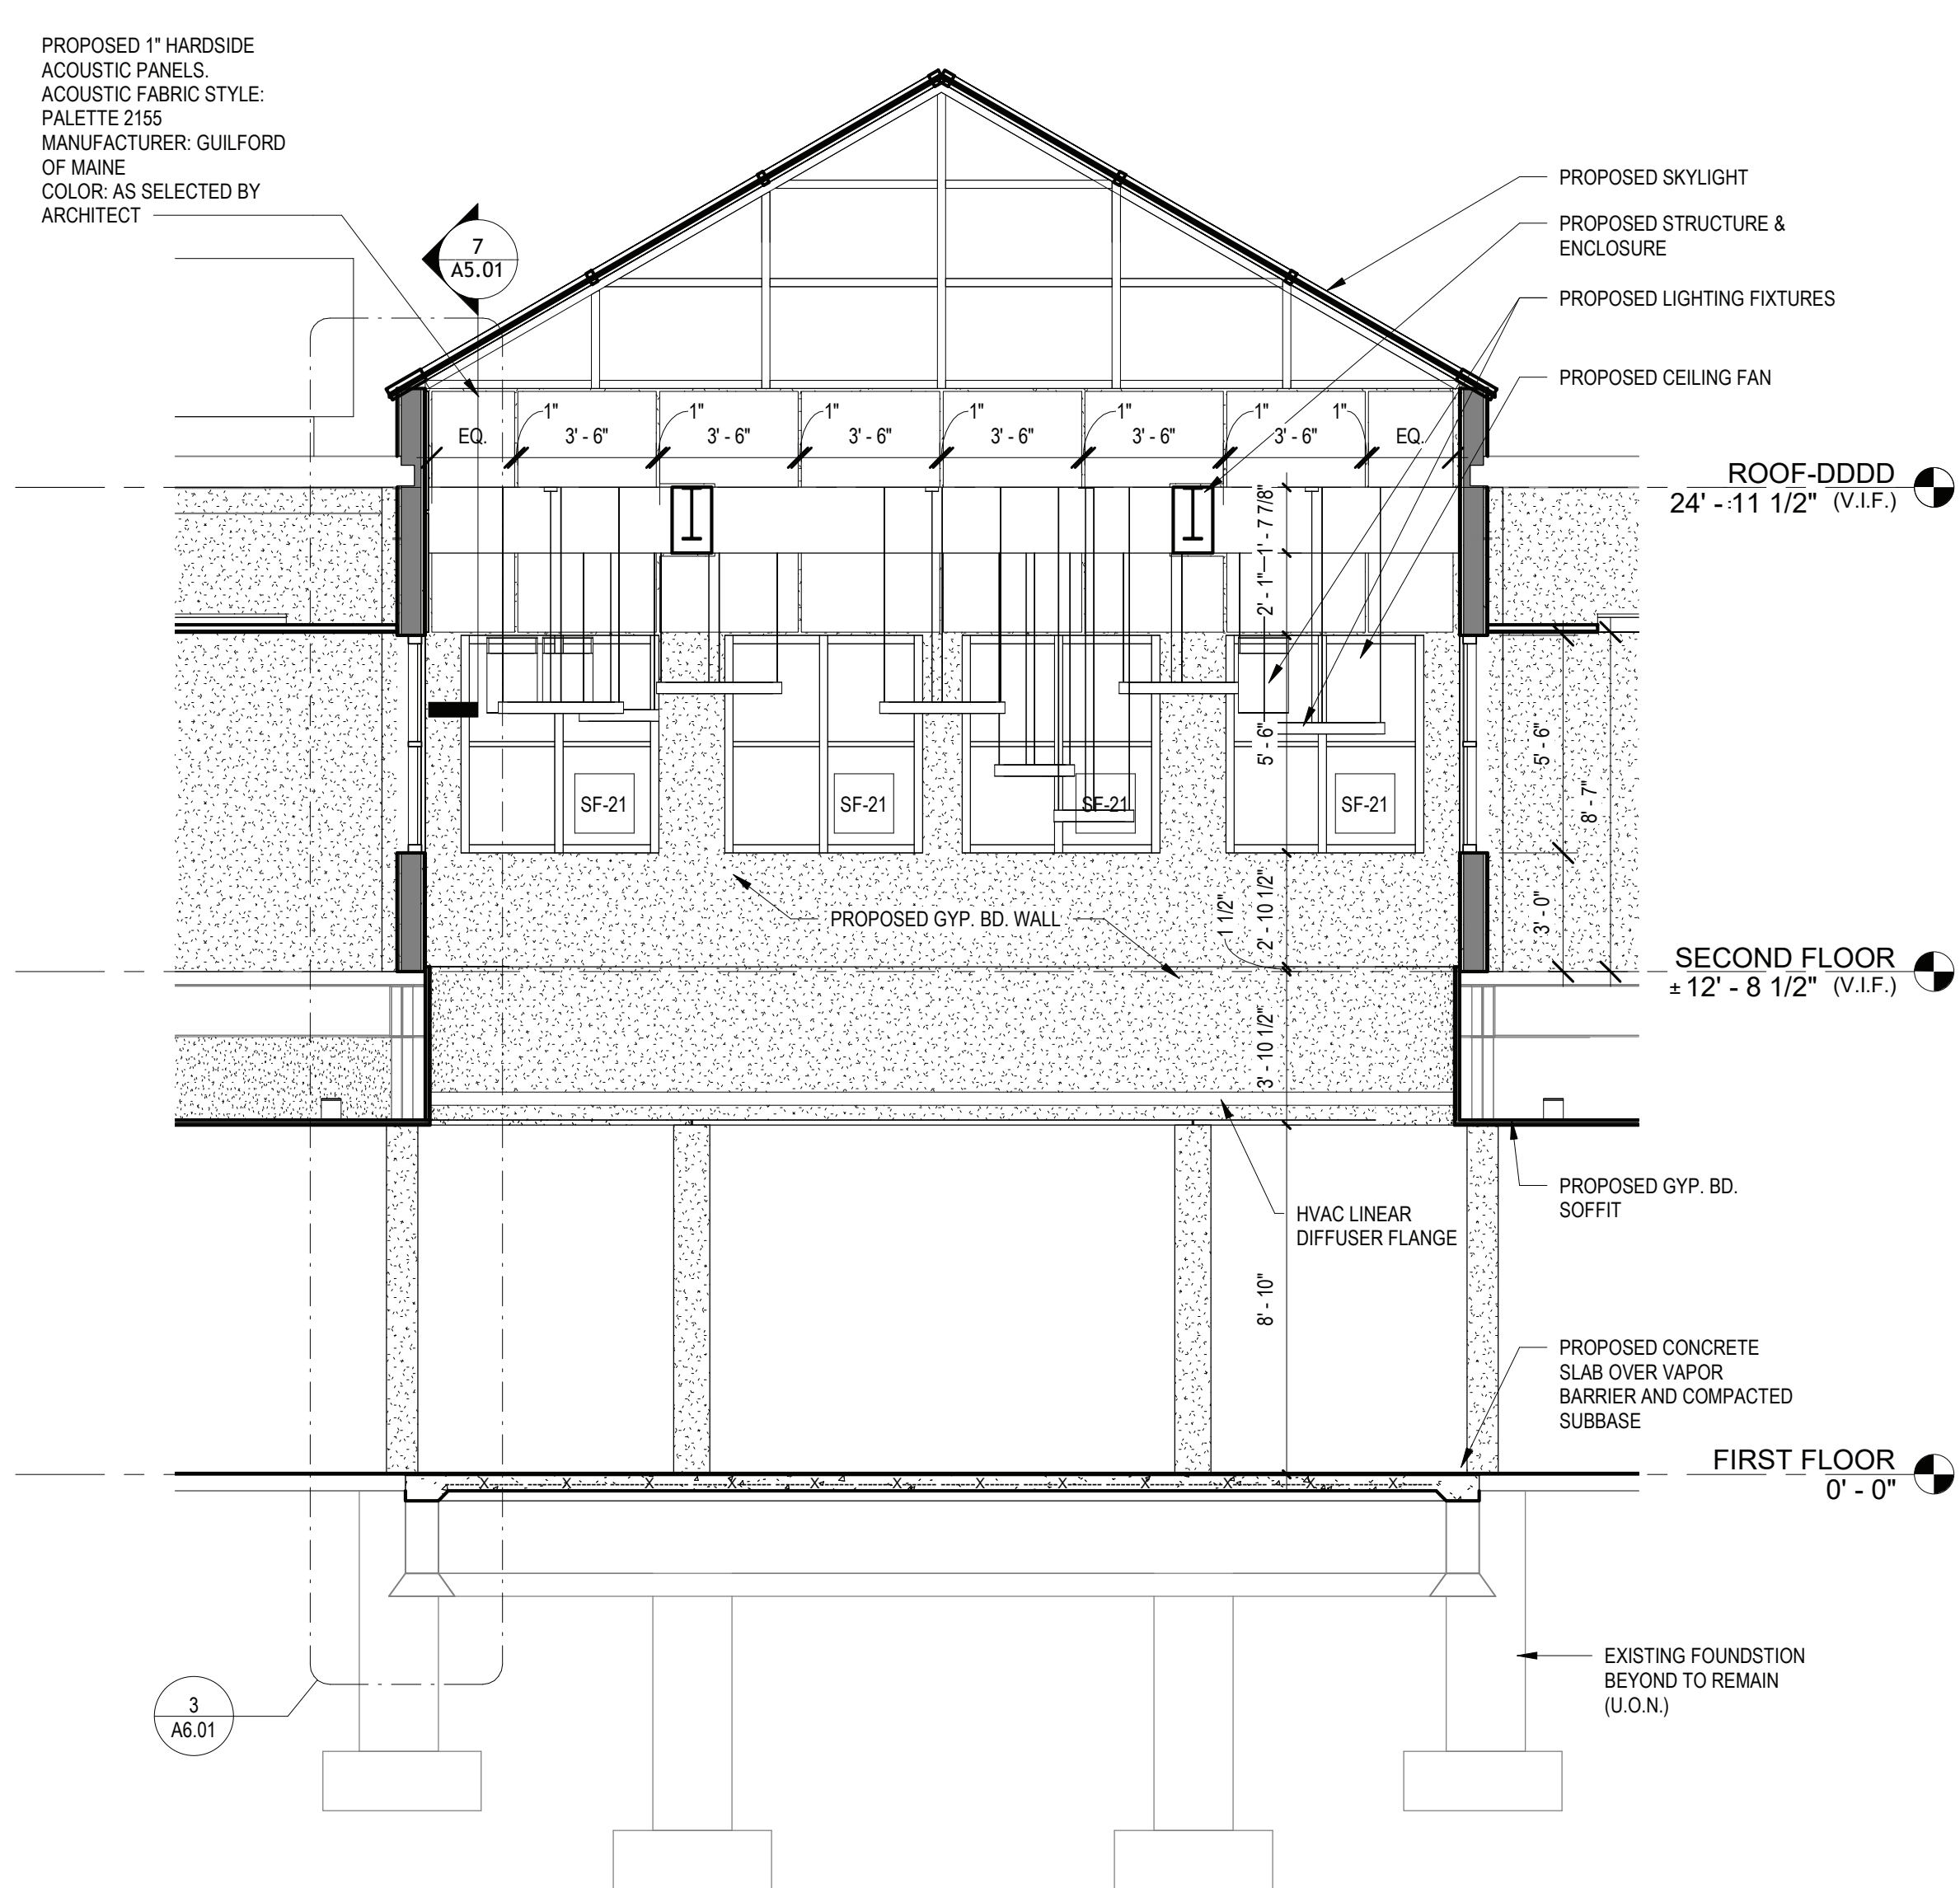


4 PROPOSED LIGHT WELL SECTION  
SCALE: 1/4" = 1'-0"

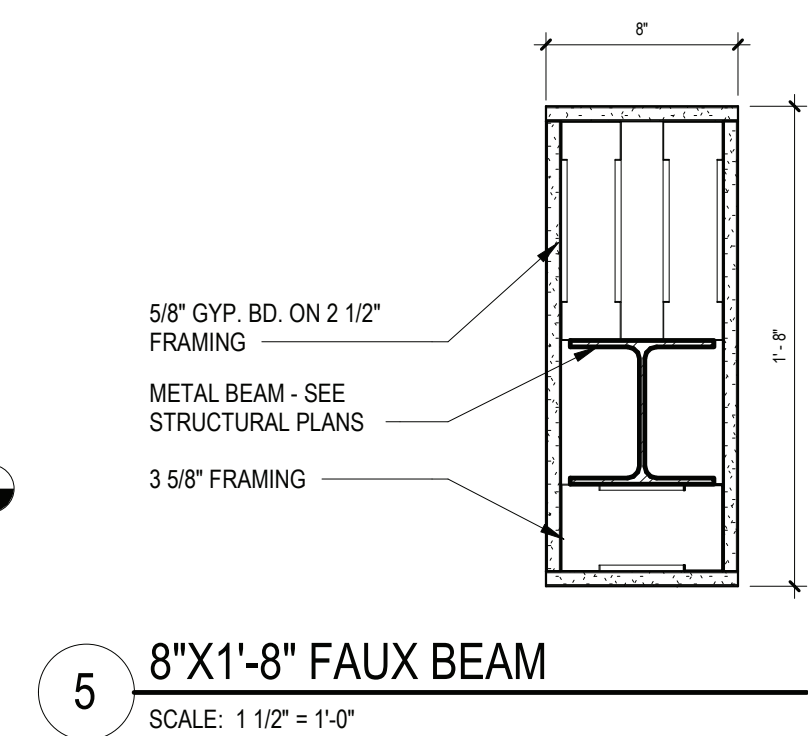

5 8\"/>

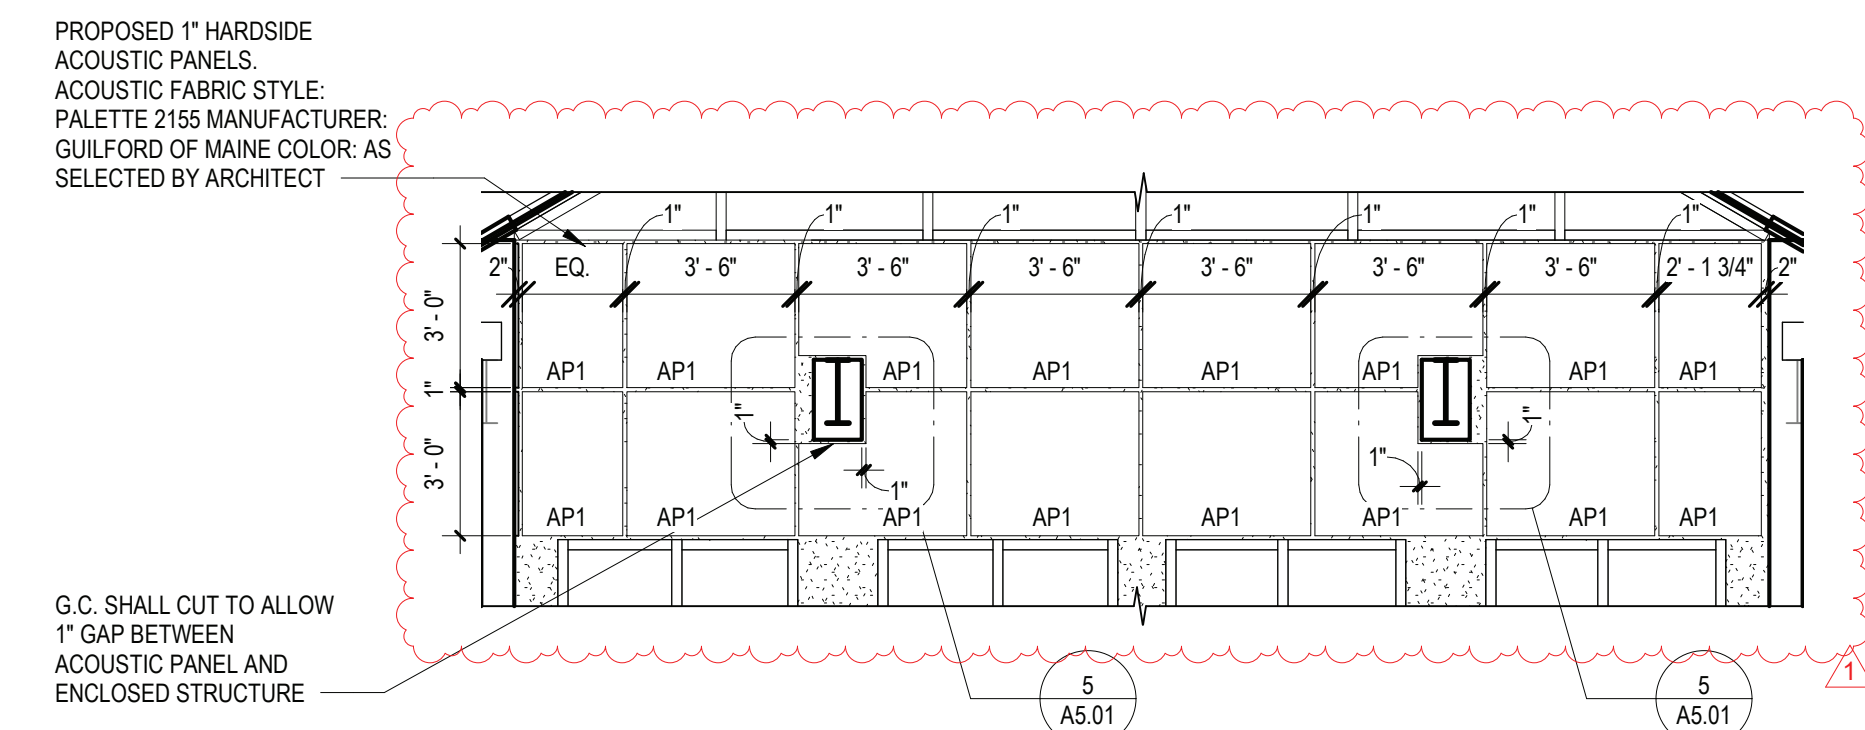

6 ACOUSTIC PANEL INTERIOR ELEVATION A - (TYPICAL 2 ELEVATIONS)  
SCALE: 1/4" = 1'-0"

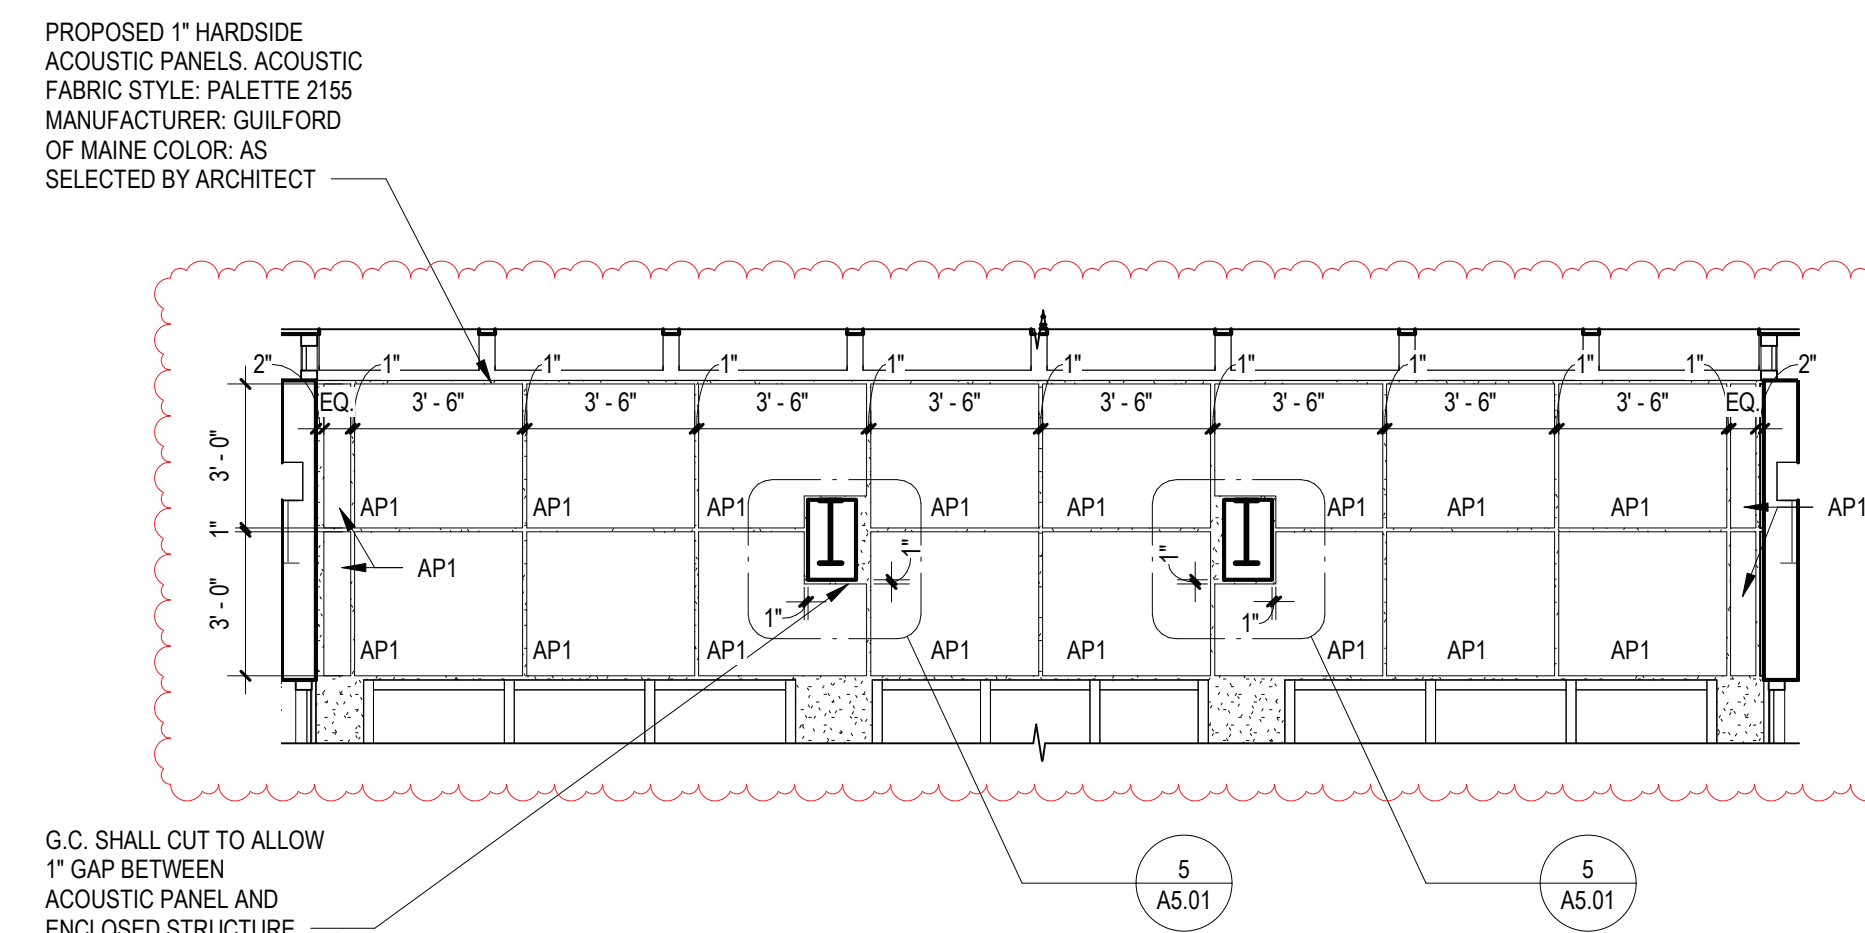

7 ACOUSTIC PANEL INTERIOR ELEVATION B - (TYPICAL 2 ELEVATIONS)  
SCALE: 1/4" = 1'-0"

REV.	DATE	ITEM
1	11/28/2022	BID ADDENDUM #1

NOTICE

THESE DRAWINGS ARE BASED ON CONSTRUCTION DRAWINGS NOT PREPARED BY BBS ARCHITECTS, LANDSCAPE ARCHITECTS AND ENGINEERS, P.C. AND THEREFORE, MAY NOT REPRESENT THE CONDITIONS AS CONSTRUCTED AT THE TIME. ALL EXISTING CONDITIONS SHOWN ARE REPRESENTED AS SUGGESTIVE INFORMATION AS THEY MAY NOT HAVE BEEN BUILT AND DETAIL FOR THE ORIGINAL DOCUMENTS OF THE OWNER'S INFORMATION.

BRIARCLIFF MANOR U.F.S.D.  
PHASE 2 BOND IMPROVEMENTS  
BRIARCLIFF MANOR MIDDLE / HIGH SCHOOL  
444 PLEASANTVILLE RD. BRIARCLIFF MANOR, NY 10510

BUILDING SECTIONS

PROJECT

DWG/TITLE

DRWG. BY: J.N.  
CHK. BY: G.E.O.

THIS DRAWING, PREPARED FOR THE SPECIFIC PROJECT INDICATED IS AN INSTRUMENT OF SERVICE AND THE PROPERTY OF BBS ARCHITECTS, LANDSCAPE ARCHITECTS AND ENGINEERS, P.C. REPRODUCTION OR ANY USE OF THIS DRAWING FOR ANY OTHER PROJECT IS PROHIBITED. ANY ALTERATION OR REPRODUCTION OF THIS DOCUMENT IS ALSO PROHIBITED WITHOUT THE WRITTEN CONSENT OF THE ARCHITECT OR ENGINEER.

**BBS**  
ARCHITECTS  
LANDSCAPE ARCHITECTS  
ENGINEERS

BRANCH PROJECT CONTACT: 244 EAST MAIN STREET  
187 WOLF ROAD, STE. 205 PATCHOGUE, NEW YORK 11772  
NEW YORK 12205 T. 631.475.0349  
T. 516.621.7650 F. 631.475.0361  
WWW.BBSARCHITECTURE.COM

SER. NO. 66-14-02-02-0-004-023

DISTRICT BRIARCLIFF MANOR U.F.S.D.

PROJECT PHASE 2 BOND IMPROVEMENTS

DWG. TITLE BUILDING SECTIONS

SCALE: AS NOTED  
DATE: -  
BID PAU DATE: 11/14/2022  
FILE NO. 21-274C

A5.01 HSMS











DOOR SCHEDULE - BRIARCLIFF MANOR HIGH SCHOOL																			
LOCATION		SIGNAGE	DOOR				FRAME		DETAILS		REMARKS	DOOR NO.							
FROM ROOM	TO ROOM		LEAF	WIDTH	HEIGHT	THICKNESS	TYPE	MATERIAL	GLAZING	TYPE			MATERIAL	GLAZING	HARDWARE	HEAD	JAMB	SILL	THOLD
1	STUDENT LEARNING EXCHANGE (168)	OFFICE (1)	B	1	3'-0"	8'-0"	1 3/4"	D4	ALUM	GL-1	SF-01	ALUM	GL-1	01	E/ A8.02	1 & J/ A8.02	-	---	---
2	OFFICE (2)	STUDENT LEARNING EXCHANGE (168)	B	1	3'-0"	8'-0"	1 3/4"	D4	ALUM	GL-1	SF-01	ALUM	GL-1	01	E/ A8.02	1 & J/ A8.02	-	---	---
3	OFFICE (3)	STUDENT LEARNING EXCHANGE (168)	B	1	3'-0"	8'-0"	1 3/4"	D4	ALUM	GL-1	SF-01	ALUM	GL-1	01	E/ A8.02	1 & J/ A8.02	-	---	---
4	STUDENT LEARNING EXCHANGE (168)	OFFICE (4)	B	1	3'-0"	8'-0"	1 3/4"	D4	ALUM	GL-1	SF-01	ALUM	GL-1	01	E/ A8.02	1 & J/ A8.02	-	---	---
5	STUDENT LEARNING EXCHANGE (168)	OFFICE (5)	B	1	3'-0"	8'-0"	1 3/4"	D4	ALUM	GL-1	SF-12	ALUM	GL-1	01	E/ A8.02	1 & J/ A8.02	-	---	---
6	OFFICE (6)	STUDENT LEARNING EXCHANGE (168)	B	1	3'-0"	8'-0"	1 3/4"	D4	ALUM	GL-1	SF-13	ALUM	GL-1	01	E/ A8.02	1 & J/ A8.02	-	---	---
7	STUDENT LEARNING EXCHANGE (168)	OFFICE (7)	B	1	3'-0"	8'-0"	1 3/4"	D4	ALUM	GL-1	SF-07	ALUM	GL-1	01	E/ A8.02	1 & J/ A8.02	-	---	---
8	STUDENT LEARNING EXCHANGE (168)	OFFICE (8)	B	1	3'-0"	8'-0"	1 3/4"	D4	ALUM	GL-1	SF-03	ALUM	GL-1	01	E/ A8.02	1 & J/ A8.02	-	---	---
9	OFFICE (9)	STUDENT LEARNING EXCHANGE (168)	B	1	3'-0"	8'-0"	1 3/4"	D4	ALUM	GL-1	SF-03	ALUM	GL-1	01	E/ A8.02	1 & J/ A8.02	-	---	---
10	STUDENT LEARNING EXCHANGE (168)	OFFICE (10)	B	1	3'-0"	8'-0"	1 3/4"	D4	ALUM	GL-1	SF-03	ALUM	GL-1	01	E/ A8.02	1 & J/ A8.02	-	---	---
11	OFFICE (11)	STUDENT LEARNING EXCHANGE (168)	B	1	3'-0"	8'-0"	1 3/4"	D4	ALUM	GL-1	SF-03	ALUM	GL-1	01	E/ A8.02	1 & J/ A8.02	-	---	---
18	OFFICE (18)	STUDENT LEARNING EXCHANGE (168)	B	1	3'-0"	8'-0"	1 3/4"	D4	ALUM	GL-1	SF-03	ALUM	GL-1	01	E/ A8.02	1 & J/ A8.02	-	---	---
19	OFFICE (19)	STUDENT LEARNING EXCHANGE (168)	B	1	3'-0"	8'-0"	1 3/4"	D4	ALUM	GL-1	SF-01	ALUM	GL-1	01	E/ A8.02	1 & J/ A8.02	-	---	---
20	OFFICE (20)	STUDENT LEARNING EXCHANGE (168)	B	1	3'-0"	8'-0"	1 3/4"	D4	ALUM	GL-1	SF-01	ALUM	GL-1	01	E/ A8.02	1 & J/ A8.02	-	---	---
100A	CORRIDOR (F)	CORRIDOR (F)	B	2	3'-6"	7'-0"	1 3/4"	D4	M.C.O.V.	F.L.P.	F2	HM	---	10A	H6	J6	-	T4	45 MIN.
100B	CORRIDOR (L)	CORRIDOR (F)	B	2	3'-6"	7'-0"	1 3/4"	D4	M.C.O.V.	F.L.P.	F2	HM	---	10	H4	J4	-	T4	45 MIN.
100C	STUDENT LEARNING EXCHANGE (168)	CORRIDOR (E)	B	2	3'-0"	7'-0"	1 3/4"	D4	M.C.O.V.	F.L.P.	F2	HM	---	10	H4	J4	-	T1	45 MIN.
100D	CORRIDOR (E)	STUDENT LEARNING EXCHANGE (168)	B	2	3'-0"	7'-0"	1 3/4"	D4	M.C.O.V.	F.L.P.	F2	HM	---	10	H4	J4	-	T1	45 MIN.
107	QUIET ROOM (107)	CORRIDOR (L)	B	1	3'-0"	7'-0"	1 3/4"	D1	HM	---	F1	HM	---	06	H4	J4	-	T2	20 MIN.
108A	CORRIDOR (L)	AMPHITHEATER (108)	B	1	3'-0"	8'-0"	1 3/4"	D4	ALUM	TEMP	SF-28	F.R.A.F.	GL-2	08A	E/ A8.02	1 & J/ A8.02	-	---	60 MIN.
108B	STUDENT LEARNING EXCHANGE (168)	AMPHITHEATER (108)	B	1	3'-0"	8'-0"	1 3/4"	D4	ALUM	GL-1	SF-02	F.R.A.F.	GL-1	01B	E/ A8.02	1 & J/ A8.02	-	---	---
108C	AMPHITHEATER (108)	STUDENT LEARNING EXCHANGE (168)	B	1	3'-0"	8'-0"	1 3/4"	D4	ALUM	GL-1	F1	F.R.A.F.	GL-1	05	H4	J4	-	---	---
109B	PRINCIPAL (109B)	CORRIDOR (E)	B	1	3'-0"	7'-0"	1 3/4"	D2	M.C.O.V.	F.L.P.	F1	HM	---	03	H4	J4	-	T4	60 MIN.
111A	GALLERY (501B)	UNISEX ADA RESTROOM (111A)	D1	1	3'-0"	7'-0"	1 3/4"	D1	HM	---	F1	HM	---	02	H4	J4	-	T2	20 MIN.
111B	GALLERY (501B)	UNISEX RESTROOM (111B)	D2	1	3'-0"	7'-0"	1 3/4"	D1	HM	---	F1	HM	---	02	H4	J4	-	T2	20 MIN.
111C	GALLERY (501B)	UNISEX RESTROOM (111C)	D2	1	3'-0"	7'-0"	1 3/4"	D1	HM	---	F1	HM	---	02	H4	J4	-	T2	20 MIN.
111D	GALLERY (501B)	STAFF ADA UNISEX RESTROOM (111D)	D1	1	3'-0"	7'-0"	1 3/4"	D1	HM	---	F1	HM	---	02	H4	J4	-	T2	20 MIN.
112A	STUDENT LEARNING EXCHANGE (168)	FLEX SPACE (112)	B	1	3'-0"	8'-0"	1 3/4"	D4	ALUM	GL-1	SF-02	ALUM	GL-1	08	E/ A8.02	1 & J/ A8.02	-	T1	---
112B	FLEX SPACE (112)	CORRIDOR (L)	B	1	3'-0"	8'-0"	1 3/4"	D4	ALUM	GL-1	SF-28	F.R.A.F.	GL-2	08	E/ A8.02	1 & J/ A8.02	-	---	60 MIN.
113A	CORRIDOR (B)	SCIENCE RESEARCH LAB (113)	B	1	3'-0"	8'-0"	1 3/4"	D4	ALUM	GL-2	SF-27	F.R.A.F.	GL-2	08	E/ A8.02	1 & J/ A8.02	-	---	60 MIN.
113B	SCIENCE RESEARCH LAB (113)	CORRIDOR (B)	B	1	3'-0"	8'-0"	1 3/4"	D4	ALUM	GL-2	SF-27	F.R.A.F.	GL-2	08	E/ A8.02	1 & J/ A8.02	-	---	60 MIN.
114A	COLLEGE CONF (114)	STUDENT LEARNING EXCHANGE (168)	B	1	3'-0"	8'-0"	1 3/4"	D4	ALUM	GL-1	SF-08	ALUM	GL-1	01A	E/ A8.02	1 & J/ A8.02	-	---	---
114B	CORRIDOR (E)	COLLEGE CONF (114)	B	1	3'-0"	7'-0"	1 3/4"	D4	ALUM	GL-2	SF-28	F.R.A.F.	GL-2	08	E/ A8.02	1 & J/ A8.02	-	T1	60 MIN.
115	STUDENT LEARNING EXCHANGE (168)	MATH LAB (115)	B	1	3'-0"	8'-0"	1 3/4"	D4	ALUM	F.L.P.	SF-18	ALUM	GL-1	01A	E/ A8.02	1 & J/ A8.02	-	T1	---
116	WRITING LAB (116)	STUDENT LEARNING EXCHANGE (168)	B	1	3'-0"	8'-0"	1 3/4"	D4	ALUM	GL-1	SF-17	ALUM	GL-1	01A	E/ A8.02	1 & J/ A8.02	-	T1	---
117	STUDENT LEARNING EXCHANGE (168)	CLASSROOM (117)	B	1	3'-0"	8'-0"	1 3/4"	D4	ALUM	GL-1	SF-01	ALUM	GL-1	01A	E/ A8.02	1 & J/ A8.02	-	---	---
118A	CORRIDOR (E)	STORAGE (118)	B	1	3'-0"	7'-0"	1 3/4"	D1	HM	---	F1	HM	---	07C	H4	J4	-	T4	60 MIN.
118B	STUDENT LEARNING EXCHANGE (168)	STORAGE (118)	B	1	3'-0"	7'-0"	1 3/4"	D1	HM	---	F1	HM	---	07C	H4	J4	-	T4	60 MIN.
119	STORAGE (119)	CORRIDOR (E)	B	1	3'-0"	7'-0"	1 3/4"	D1	HM	---	F1	HM	---	07B	H4	J4	-	T4	60 MIN.
120	ROBOTICS/ENGINEERING (121)	FAB LAB PHOTOGRAPHY (120)	B	1	3'-0"	7'-0"	1 3/4"	D6	M.C.O.V.	F.L.P.	F1	HM	---	03	H4	J4	-	T4	90 MIN.
120A	FAB LAB PHOTOGRAPHY (120)	STORAGE (120A)	B	1	3'-0"	7'-0"	1 3/4"	D1	M.C.O.V.	---	F1	HM	---	07B	H4	J4	-	T4	45 MIN.
121	ROBOTICS/ENGINEERING (121)	CORRIDOR (D)	B	1	3'-0"	7'-0"	1 3/4"	D6	M.C.O.V.	F.L.P.	EXIST	EXIST	---	03	H2	J2	-	T4	90 MIN.
121A	ROBOTICS/ENGINEERING (121)	STORAGE (121A)	B	1	3'-0"	7'-0"	1 3/4"	D1	M.C.O.V.	---	F1	HM	---	07B	H4	J4	-	T4	90 MIN.
125	GUIDANCE (125)	CORRIDOR (B)	B	1	3'-0"	7'-0"	1 3/4"	D4	ALUM	GL-2	SF-27	F.R.A.F.	GL-2	08	E/ A8.02	1 & J/ A8.02	-	---	60 MIN.
157	CORRIDOR (C)	SECURITY (157)	B	1	3'-0"	7'-0"	1 3/4"	D4	HM	F.L.P.	F1	HM	---	03A	H2	J2	-	T4	20 MIN.
158	BOYS TOILET (158)	CORRIDOR (C)	C2	1	3'-0"	7'-0"	1 3/4"	D5	HM	---	F1	HM	---	03B	H4	J4	-	T2	20 MIN.
159	CORRIDOR (C)	STOR. (159)	B	1	3'-0"	7'-0"	1 3/4"	D1	HM	F.L.P.	F1	HM	---	07B	H2	J2	-	T4	20 MIN.
160	CORRIDOR (C)	GIRLS TOILET (160)	C2	1	3'-0"	7'-0"	1 3/4"	D5	HM	---	F1	HM	---	03B	H4	J4	-	T2	20 MIN.
164	TECH (164)	STUDENT LEARNING EXCHANGE (168)	B	1	3'-0"	8'-0"	1 3/4"	D4	ALUM	GL-1	SF-16	ALUM	GL-1	01A	E/ A8.02	1 & J/ A8.02	-	T1	---
165	TECH (165)	TECH. (165)	B	1	3'-0"	7'-0"	1 3/4"	D1	HM	---	F1	HM	---	04	H4	J4	-	T4	---
166	STUDENT LEARNING EXCHANGE (168)	STORAGE (166)	B	1	3'-0"	7'-0"	1 3/4"	D1	S.C.L.C.O.V.	---	F1	HM	---	07A	H4	J4	-	T1	---
167	STUDENT LEARNING EXCHANGE (168)	STORAGE (167)	B	1	3'-0"	7'-0"	1 3/4"	D1	S.C.L.C.O.V.	---	F1	HM	---	07A	H4	J4	-	T1	---
168A	STUDENT LEARNING EXCHANGE (168)	GALLERY (501B)	B	2	3'-0"	8'-0"	1 3/4"	D4	ALUM	GL-2	SF-04	F.R.A.F.	GL-2	09A	E/ A8.02	1 & J/ A8.02	-	T1	60 MIN.
168B	STUDENT LEARNING EXCHANGE (168)	CORRIDOR (B)	B	2	3'-6"	8'-0"	1 3/4"	D4	ALUM	GL-2	SF-09	F.R.A.F.	GL-2	09A	E/ A8.02	1 & J/ A8.02	-	T1	60 MIN.
168D	CORRIDOR (E)	STUDENT LEARNING EXCHANGE (168)	B	1	3'-0"	8'-0"	1 3/4"	D4	ALUM	GL-2	SF-28	F.R.A.F.	GL-2	09A	E/ A8.02	1 & J/ A8.02	-	T1	60 MIN.
181A	GALLERY (501B)	UNISEX ADA RESTROOM (181A)	D2	1	3'-0"	7'-0"	1 3/4"	D1	HM	---	F1	HM	---	02	H4	J4	-	T2	20 MIN.
181B	UNISEX RESTROOM (181B)	GALLERY (501B)	D2	1	3'-0"	7'-0"	1 3/4"	D1	HM	---	F1	HM	---	02	H4	J4	-	T2	20 MIN.
181C	STORAGE (181C)	STUDENT LEARNING EXCHANGE (168)	B	1	3'-0"	7'-0"	1 3/4"	D1	HM	---	F1	HM	---	07	H4	J4	-	T1	---
500	CAFETERIA (505)	BREAKOUT (500)	B	1	3'-0"	7'-0"	1 3/4"	D4	HM	TEMP	F1	HM	---	08	H4	J4	-	---	---
501	CAFETERIA (505)	BREAKOUT (501)	B	1	3'-0"	7'-0"	1 3/4"	D4	HM	TEMP	F1	HM	---	08	H4	J4	-	---	---
505A	GALLERY (501B)	CAFETERIA (505)	B	2	3'-6"	7'-0"	1 3/4"	D4	ALUM	GL-2	SF-15	F.R.A.F.	GL-2	09	E/ A8.02	J/ A8.02	-	---	60 MIN.
505B	GALLERY (501B)	CAFETERIA (505)	-	2	3'-6"	7'-0"	1 3/4"	D4	ALUM	GL-2	SF-15	F.R.A.F.	GL-2	09	E/ A8.02	J/ A8.02	-	---	60 MIN.





ABBREVIATIONS		
ALUM	ALUMINUM	M.C.M.V. . . . . MINERAL CORE MAPLE VENEER
F.R.A.F.	FIRE RATED ALUMINUM FRAME	M.C.O.V. . . . . MINERAL CORE OAK VENEER
F.G.	1/4" FIREGLASS 20	S.C.L.C.M.V. . . . . SOLID COMPOSITE LUMBER CORE MAPLE VENEER
F.L.P.	5/8" FIRE-LITE PLUS	S.C.L.C.O.V. . . . . SOLID COMPOSITE LUMBER CORE OAK VENEER
F.R.P.	FIBERGLASS REINFORCED POLYESTER	GL-1 . . . . . 1/2" TEMPERED LAMINATED SAFETY GLASS
H.M.	HOLLOW METAL	GL-2 . . . . . 7/8" PYROSTOP 60 MIN. GLAZING
INS.	1" INSULATED GLASS	OBSC. . . . . OBSCURE GLASS

- NOTES:**
- ALL DOORS, FRAMES AND HARDWARE SHALL BE PROVIDED AND INSTALLED BY GENERAL CONTRACTOR UNLESS OTHERWISE NOTED.
  - GENERAL CONTRACTOR SHALL COORDINATE ALL KEYING WITH OWNER.
  - ALL FIRE RATED WOOD DOORS SHALL HAVE SOLID MINERAL CORE, ALL OTHER WOOD DOORS SHALL HAVE SOLID COMPOSITE LUMBER CORE.
  - FLUSH WOOD DOORS SHALL BE 5 PLY LAMINATED FACE SHEETS WITH 2 PLY FINISH VENEER OVER SPECIFIED CORE. AT FIRE RATED DOORS, TOP AND BOTTOM RAILS AND STILES SHALL BE FIRE RESISTANT COMPOSITION MATERIAL BONDED TO CORE. REFER TO SPECIFICATION SECTION 05211 FOR ADDITIONAL INFORMATION.
  - ALL GLAZING IN DOORS SHALL BE INSTALLED IN METAL VISION KIT TO MATCH FIRE LABEL. VISION KIT COLOR SHALL BE AS SELECTED BY ARCHITECT.
  - ALL NEW H.M. FRAMES SHALL BE WRAP AROUND TYPE (UNLESS OTHERWISE NOTED OR DETAILED). THROATS SHALL BE SIZED ACCORDING TO WALL THICKNESS AND FINISH, REFER TO FLOOR PLAN AND ENLARGED DETAILS FOR ADDITIONAL INFORMATION.
  - GENERAL CONTRACTOR SHALL MODIFY AND PATCH EXISTING WOOD OR H.M. DOOR FRAMES (DESIGNATED TO REMAIN) TO ACCOMMODATE NEW DOOR OPERATOR, LOCKSET LATCH, HINGES, DOOR SWING AND/OR CLOSER, ETC. AS REQUIRED FOR COMPLETE AND FUNCTIONAL OPERATION.
  - GENERAL CONTRACTOR IS RESPONSIBLE FOR VERIFYING HEIGHT AND WIDTH OF PROPOSED DOORS TO BE INSTALLED IN EXISTING FRAMES (PRIOR TO SHOP DRAWING SUBMITTAL) TO ENSURE PROPER FIT AND DOOR FUNCTION.
  - ALL NEW HOLLOW METAL FRAMES AND HOLLOW METAL DOORS SHALL BE FINISH PAINTED. COLOR AS SELECTED BY ARCHITECT.
  - GENERAL CONTRACTOR SHALL



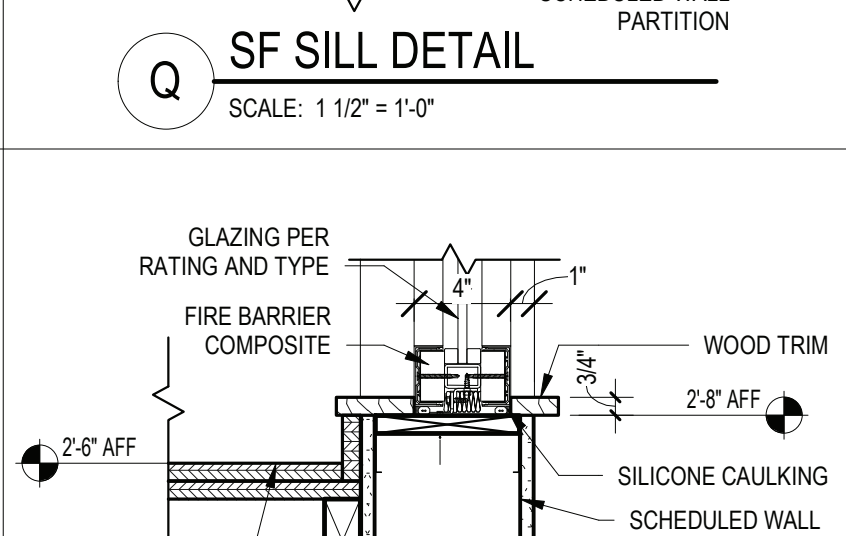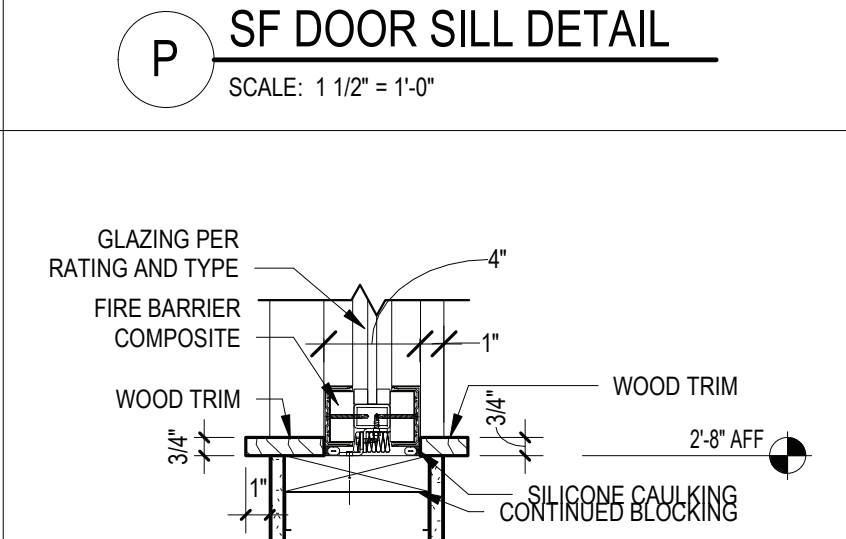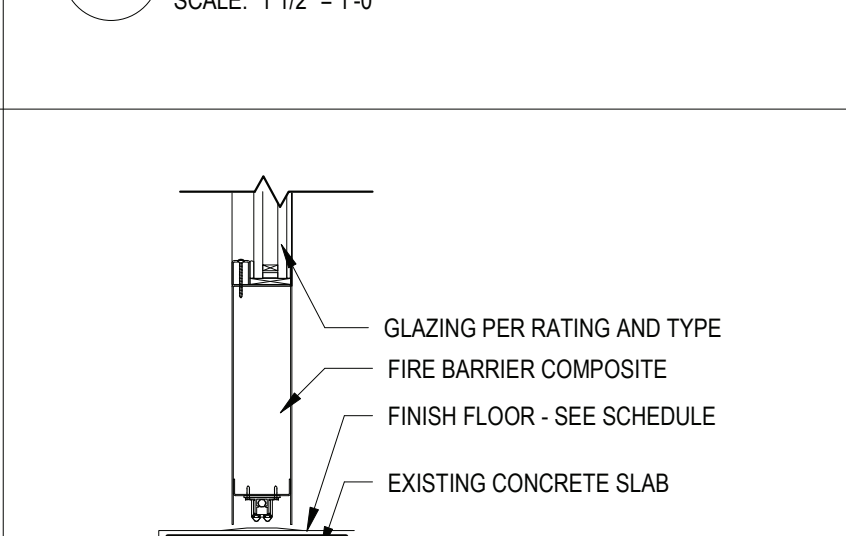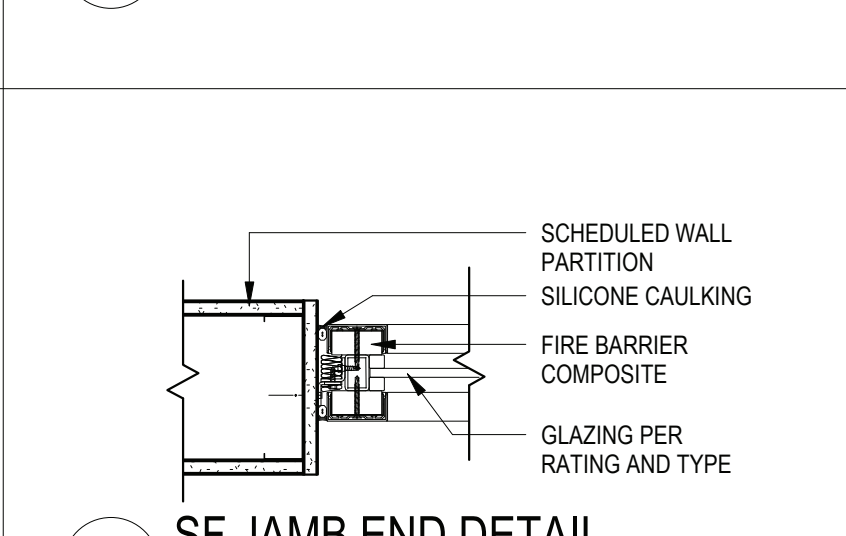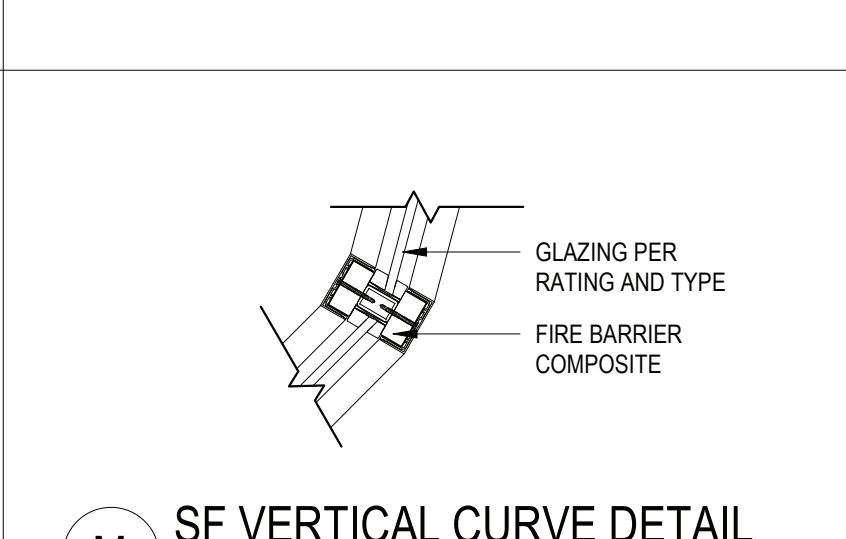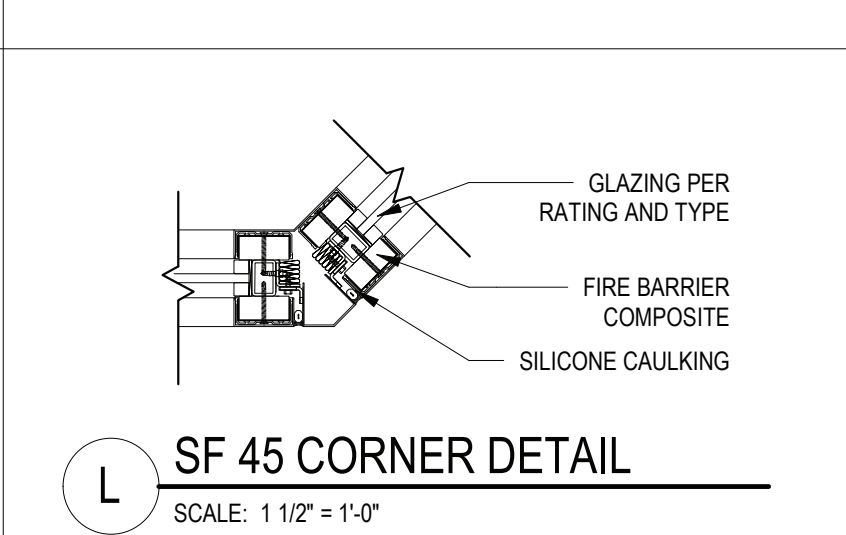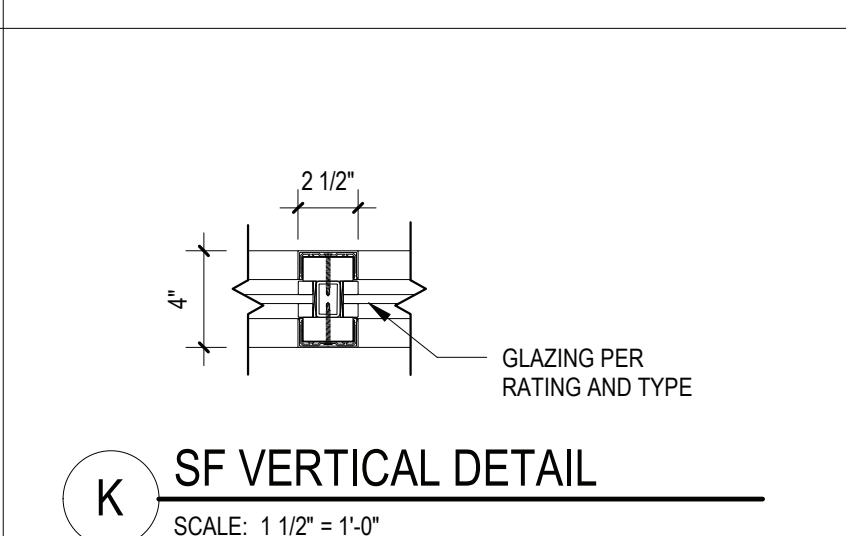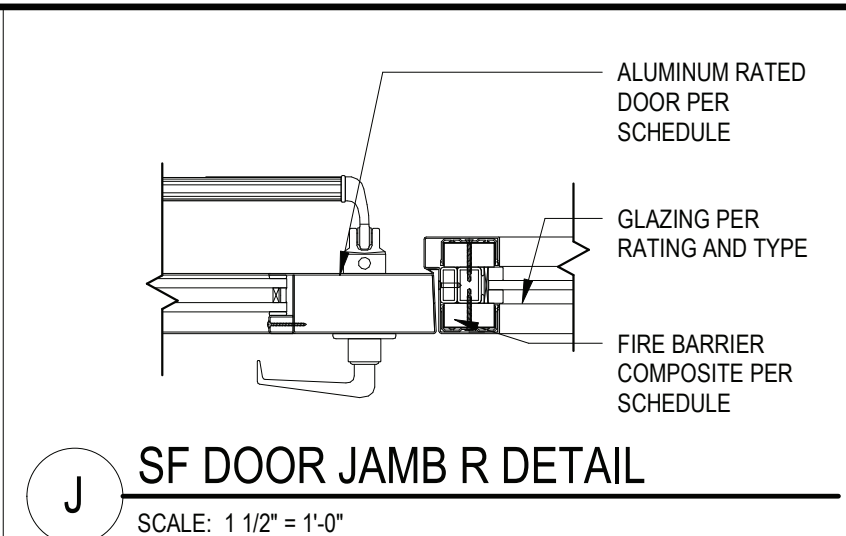

<u>STOREFRONT &amp; WINDOW GLAZING LEGEND</u>	
GL-1	SINGLE PANEL TEMPERED GLAZING - PER PROJECT MANUAL NO RATED ALUMINUM MULLIONS
GL-2	RATED SINGLE PANEL GLAZING - PER PROJECT MANUAL & DOOR SCHEDULE 1HR RATED ALUMINUM MULLIONS WITH FIRE BARRIER COMPOSITE
GL-3	HIGH PERFORMANCE INSULATING DOUBLE GLAZING - PER PROJECT MANUAL INSULATED ALUMINUM MULLIONS
GL-4	HIGH PERFORMANCE SPANDREL DOUBLE GLAZING - PER PROJECT MANUAL INSULATED ALUMINUM MULLIONS
PNL-1	COMPOSITE PANEL - PER PROJECT MANUAL NO RATED ALUMINUM MULLIONS
PNL-2	RATED COMPOSITE PANEL - PER PROJECT MANUAL & DOOR SCHEDULE 1HR RATED ALUMINUM MULLIONS WITH FIRE BARRIER COMPOSITE

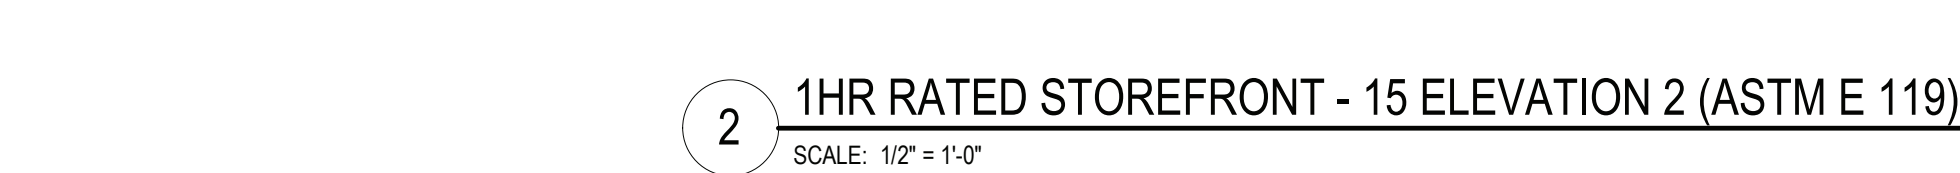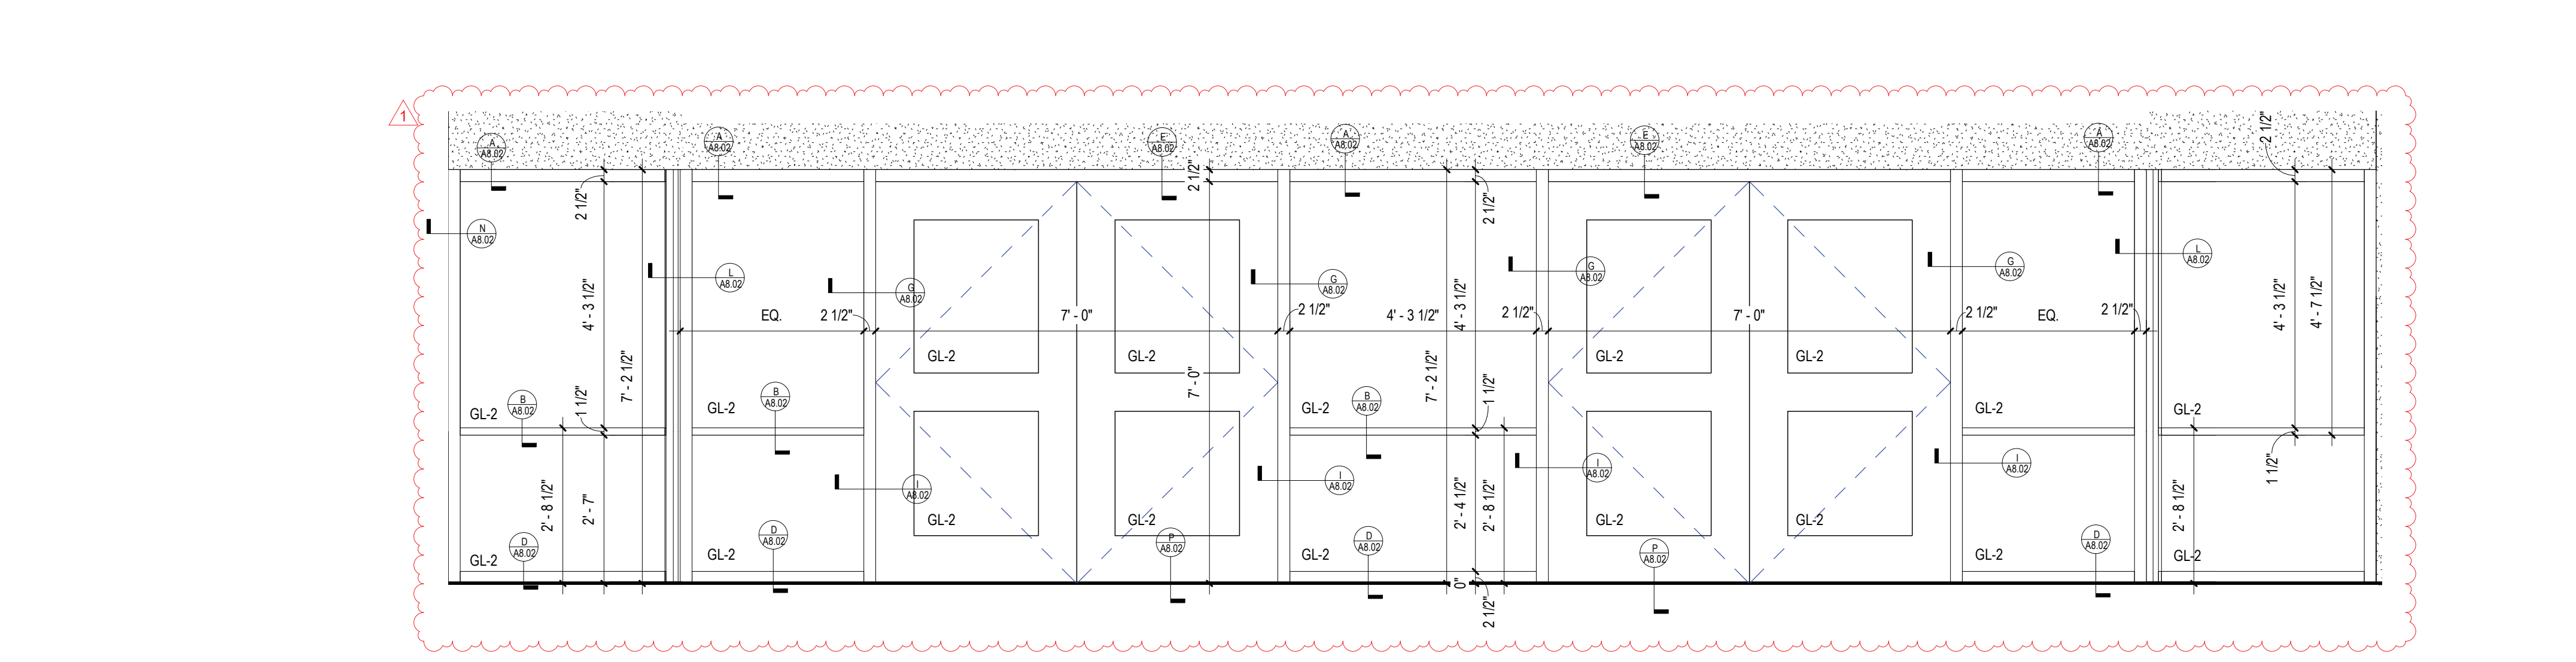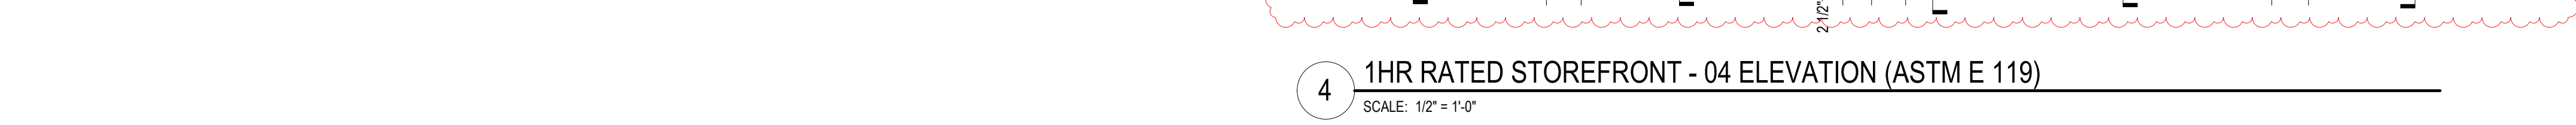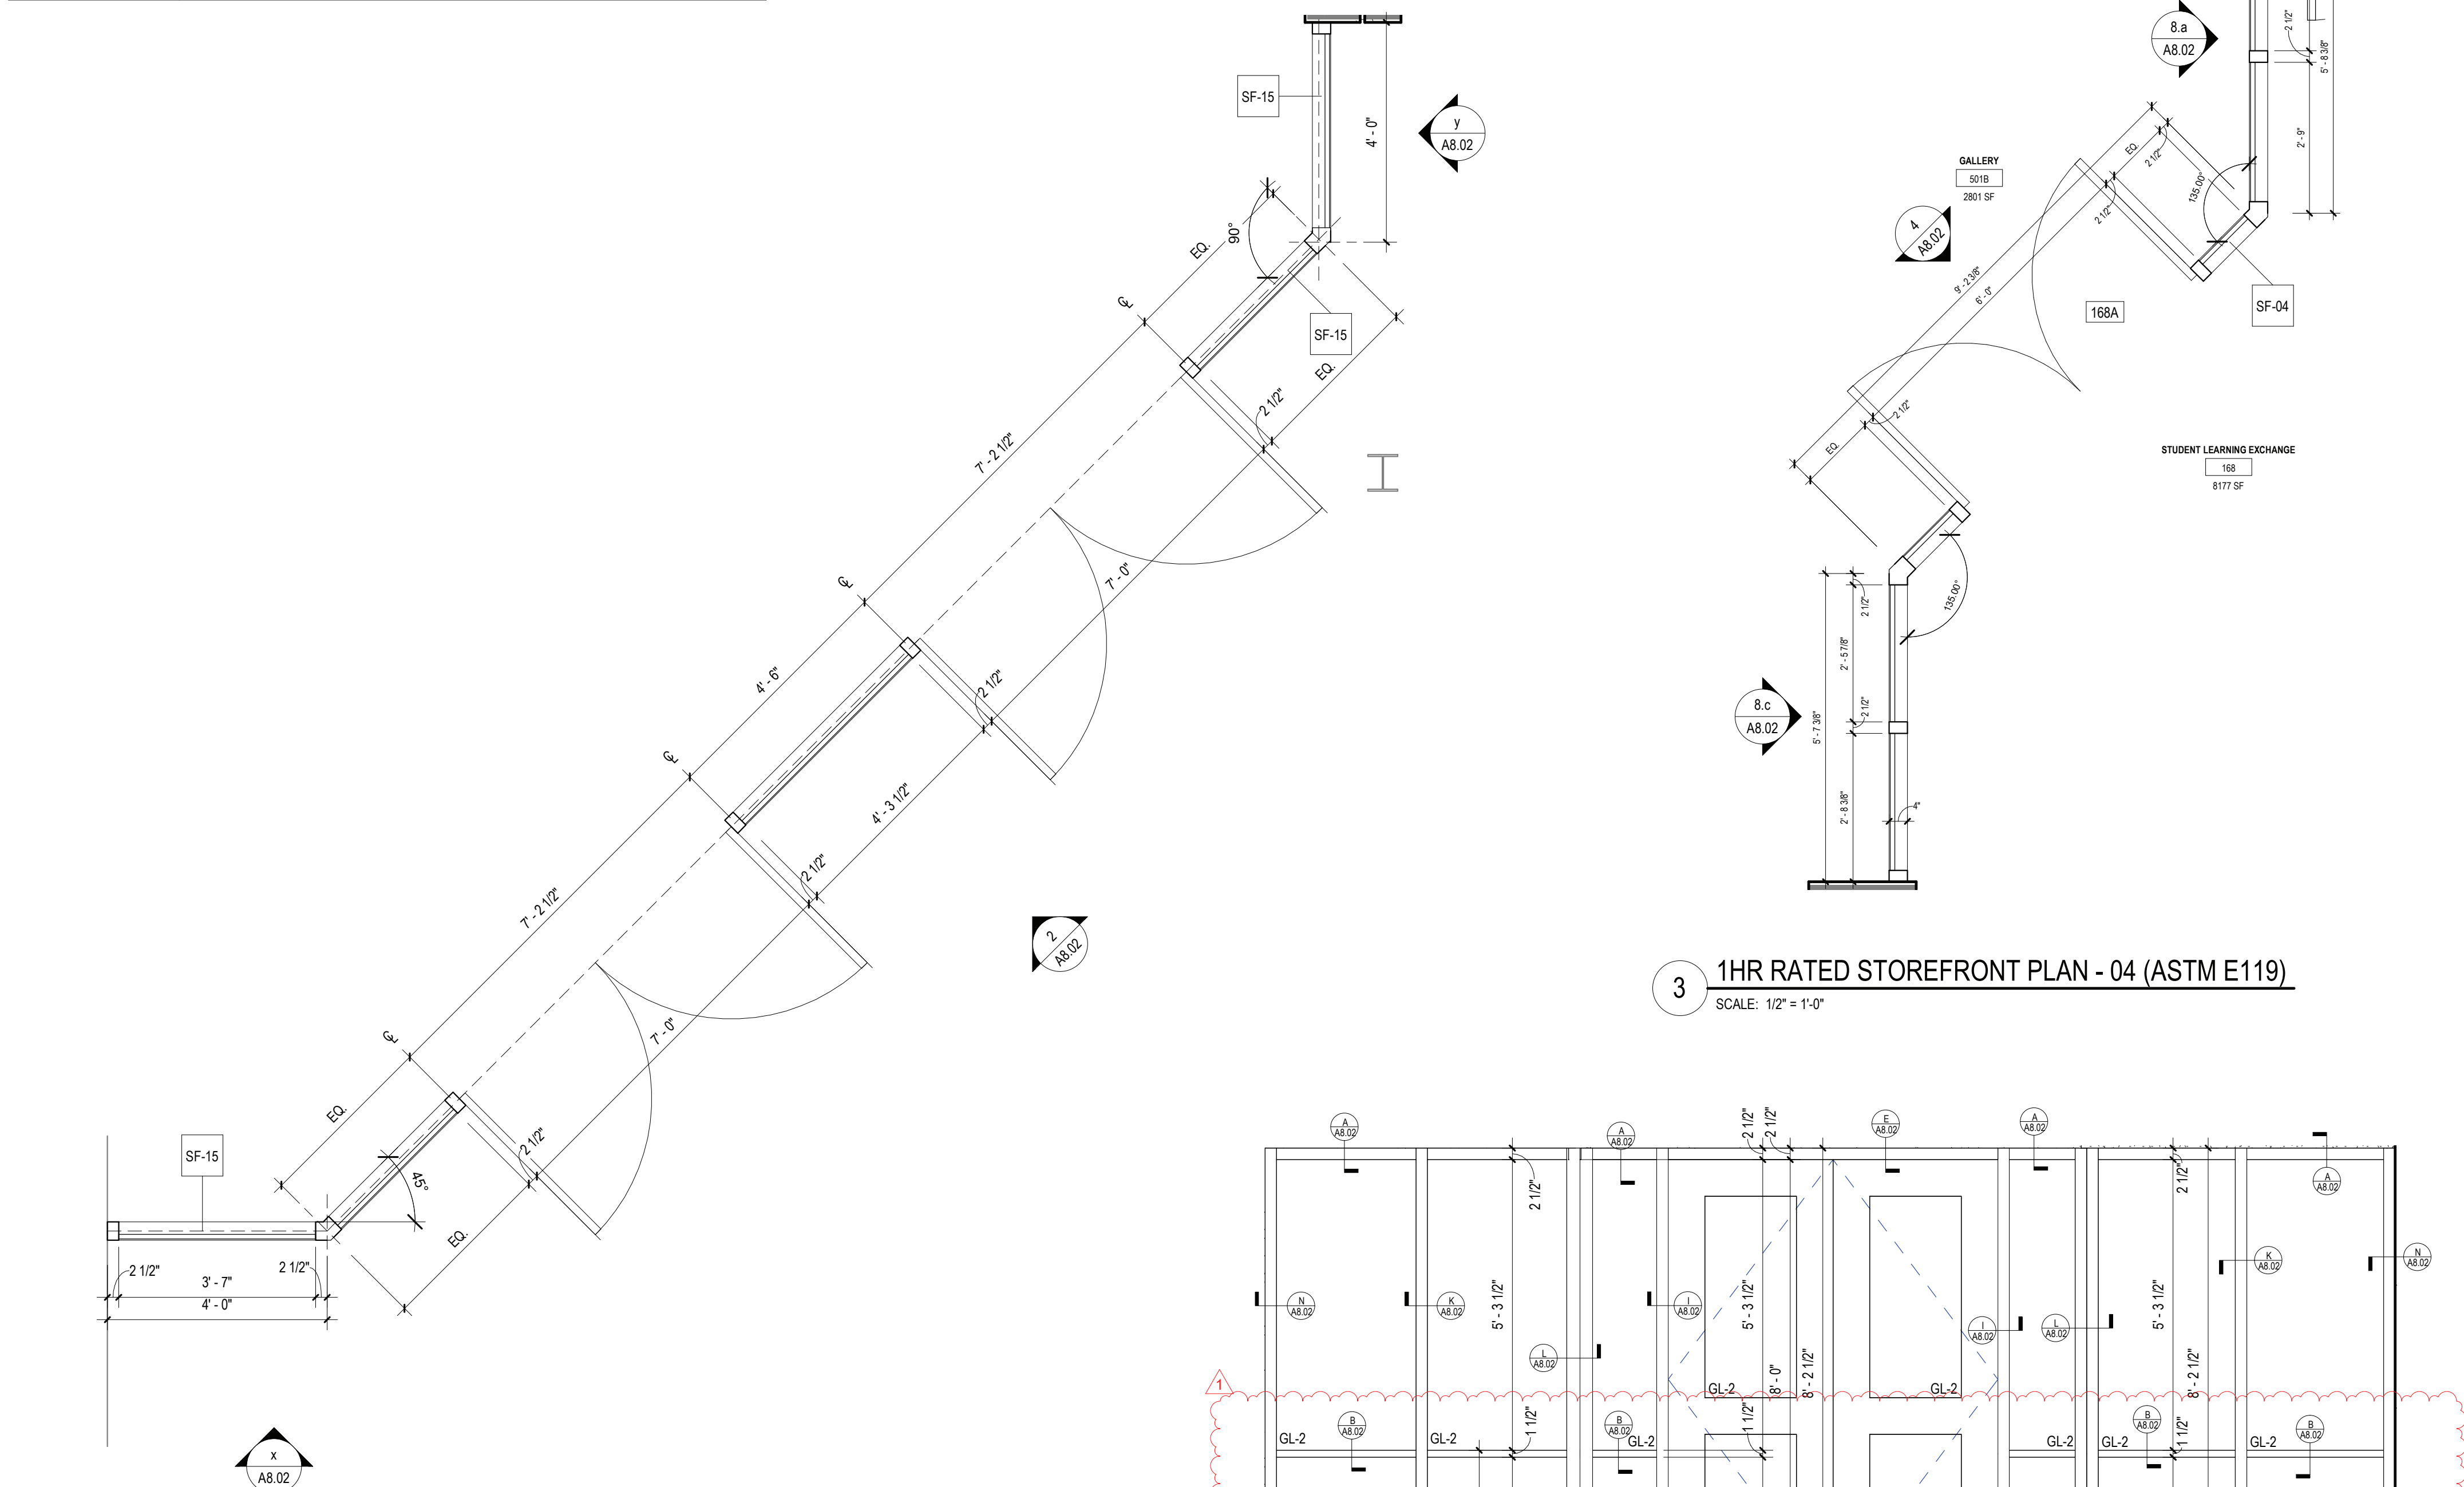

REV.	DATE	ITEM
1	11/29/2022	BID ADDENDUM #1

**NOTICE**

THESE DRAWINGS ARE BASED ON CONSTRUCTION DRAWINGS NOT PREPARED BY BBS ARCHITECTS, LANDSCAPE ARCHITECTS AND ENGINEERS, P.C. AND, THEREFORE, MAY NOT REPRESENT THE CONDITIONS AS CONSTRUCTED AT THE TIME. ALL EXISTING CONDITIONS SHOWN ARE REPRESENTED AS SUGGESTIVE INFORMATION AS THEY MAY NOT HAVE BEEN BUILT AND DETAILED PER THE ORIGINAL DOCUMENTS OR PER THE OWNERS INFORMATION.

BRIARCLIFF MANOR U.F.S.D.  
PHASE 2 BOND IMPROVEMENTS  
BRIARCLIFF MANOR MIDDLE / HIGH SCHOOL  
444 PLEASANTVILLE RD, BRIARCLIFF MANOR, NY 10510

---

STOREFRONT PLANS AND DETAILS

CT

DRWG. BY:	J.N.
CHK. BY:	G.E.O.

 
THIS DRAWING, PREPARED FOR THE SPECIFIC PROJECT INDICATED IS AN INSTRUMENT OF SERVICE AND THE PROPERTY OF BBS ARCHITECTS, LANDSCAPE ARCHITECTS AND ENGINEERS, P.C. INFRAINGEMENT OR ANY USE OF THIS DRAWING FOR ANY OTHER PROJECT IS PROHIBITED. ANY ALTERATION OR REPRODUCTION OF THIS DOCUMENT IS ALSO PROHIBITED WITHOUT THE WRITTEN CONSENT OF THE ARCHITECT OR ENGINEER.

**BBS**  
ARCHITECTS  
LANDSCAPE ARCHITECTS  
ENGINEERS

BRANCH PROJECT CONTACT:  
187 WOLF ROAD, STE 205  
ALBANY  
NEW YORK 12205  
T. 518.621.7650

244 EAST MAIN STREET  
PATCHOGUE  
NEW YORK 11772  
T. 631.475.0349  
F. 631.475.0361

www.BBSARCHITECTURE.COM



SED No. 66-14-02-02-0-004-023

DISTRICT BRIARCLIFF MANOR U.F.S.D.

## PROJECT

DWG TITLE	STOREFRONT PLANS AND DETAILS
-----------	---------------------------------

SCALE: \_\_\_\_\_ AS NOTED  
DATE: \_\_\_\_\_


BID P/U DATE:	11/14/2022
FILE NO.	21-274C

A8.02	HSMS
-------	------









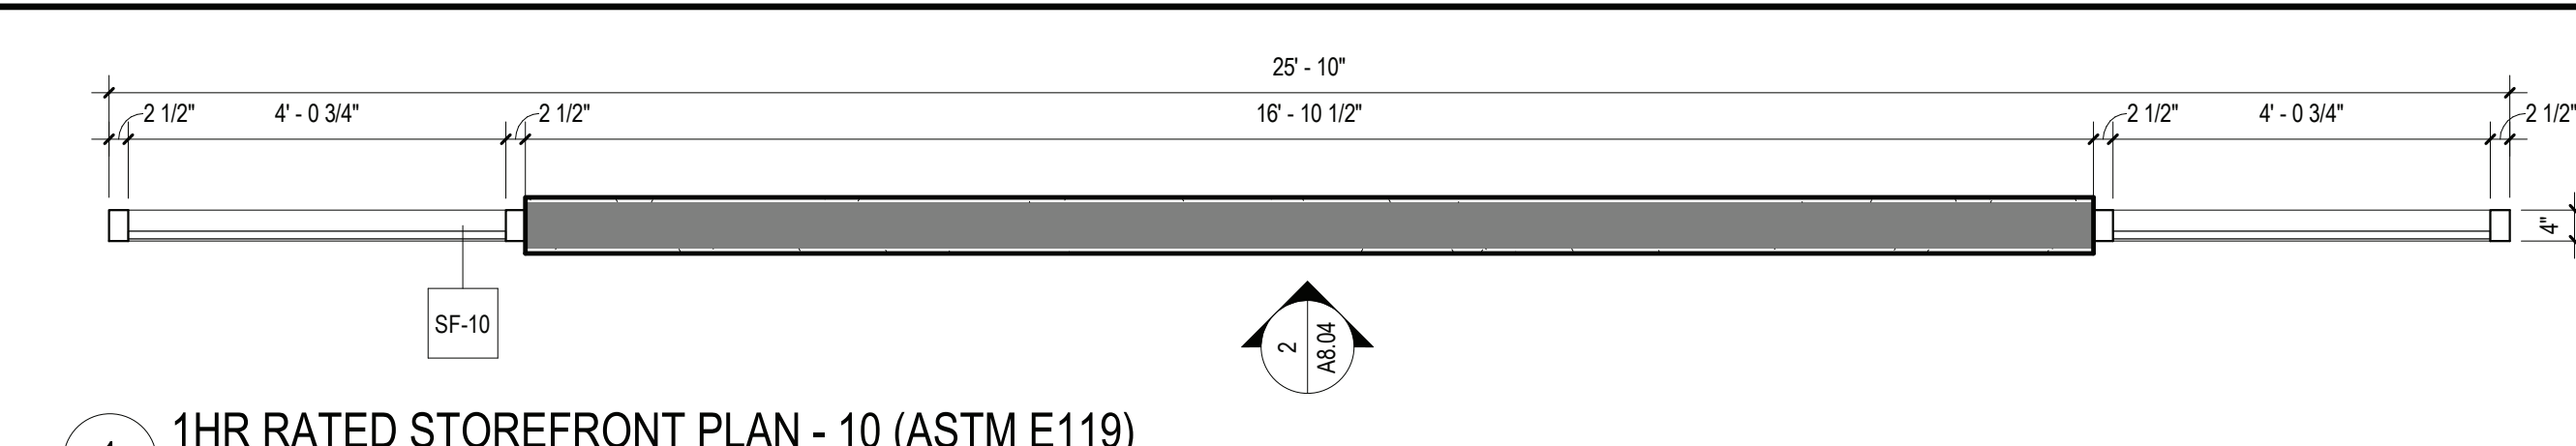


1 1HR RATED STOREFRONT PLAN - 10 (ASTM E119)  
SCALE: 1/2" = 1'-0"

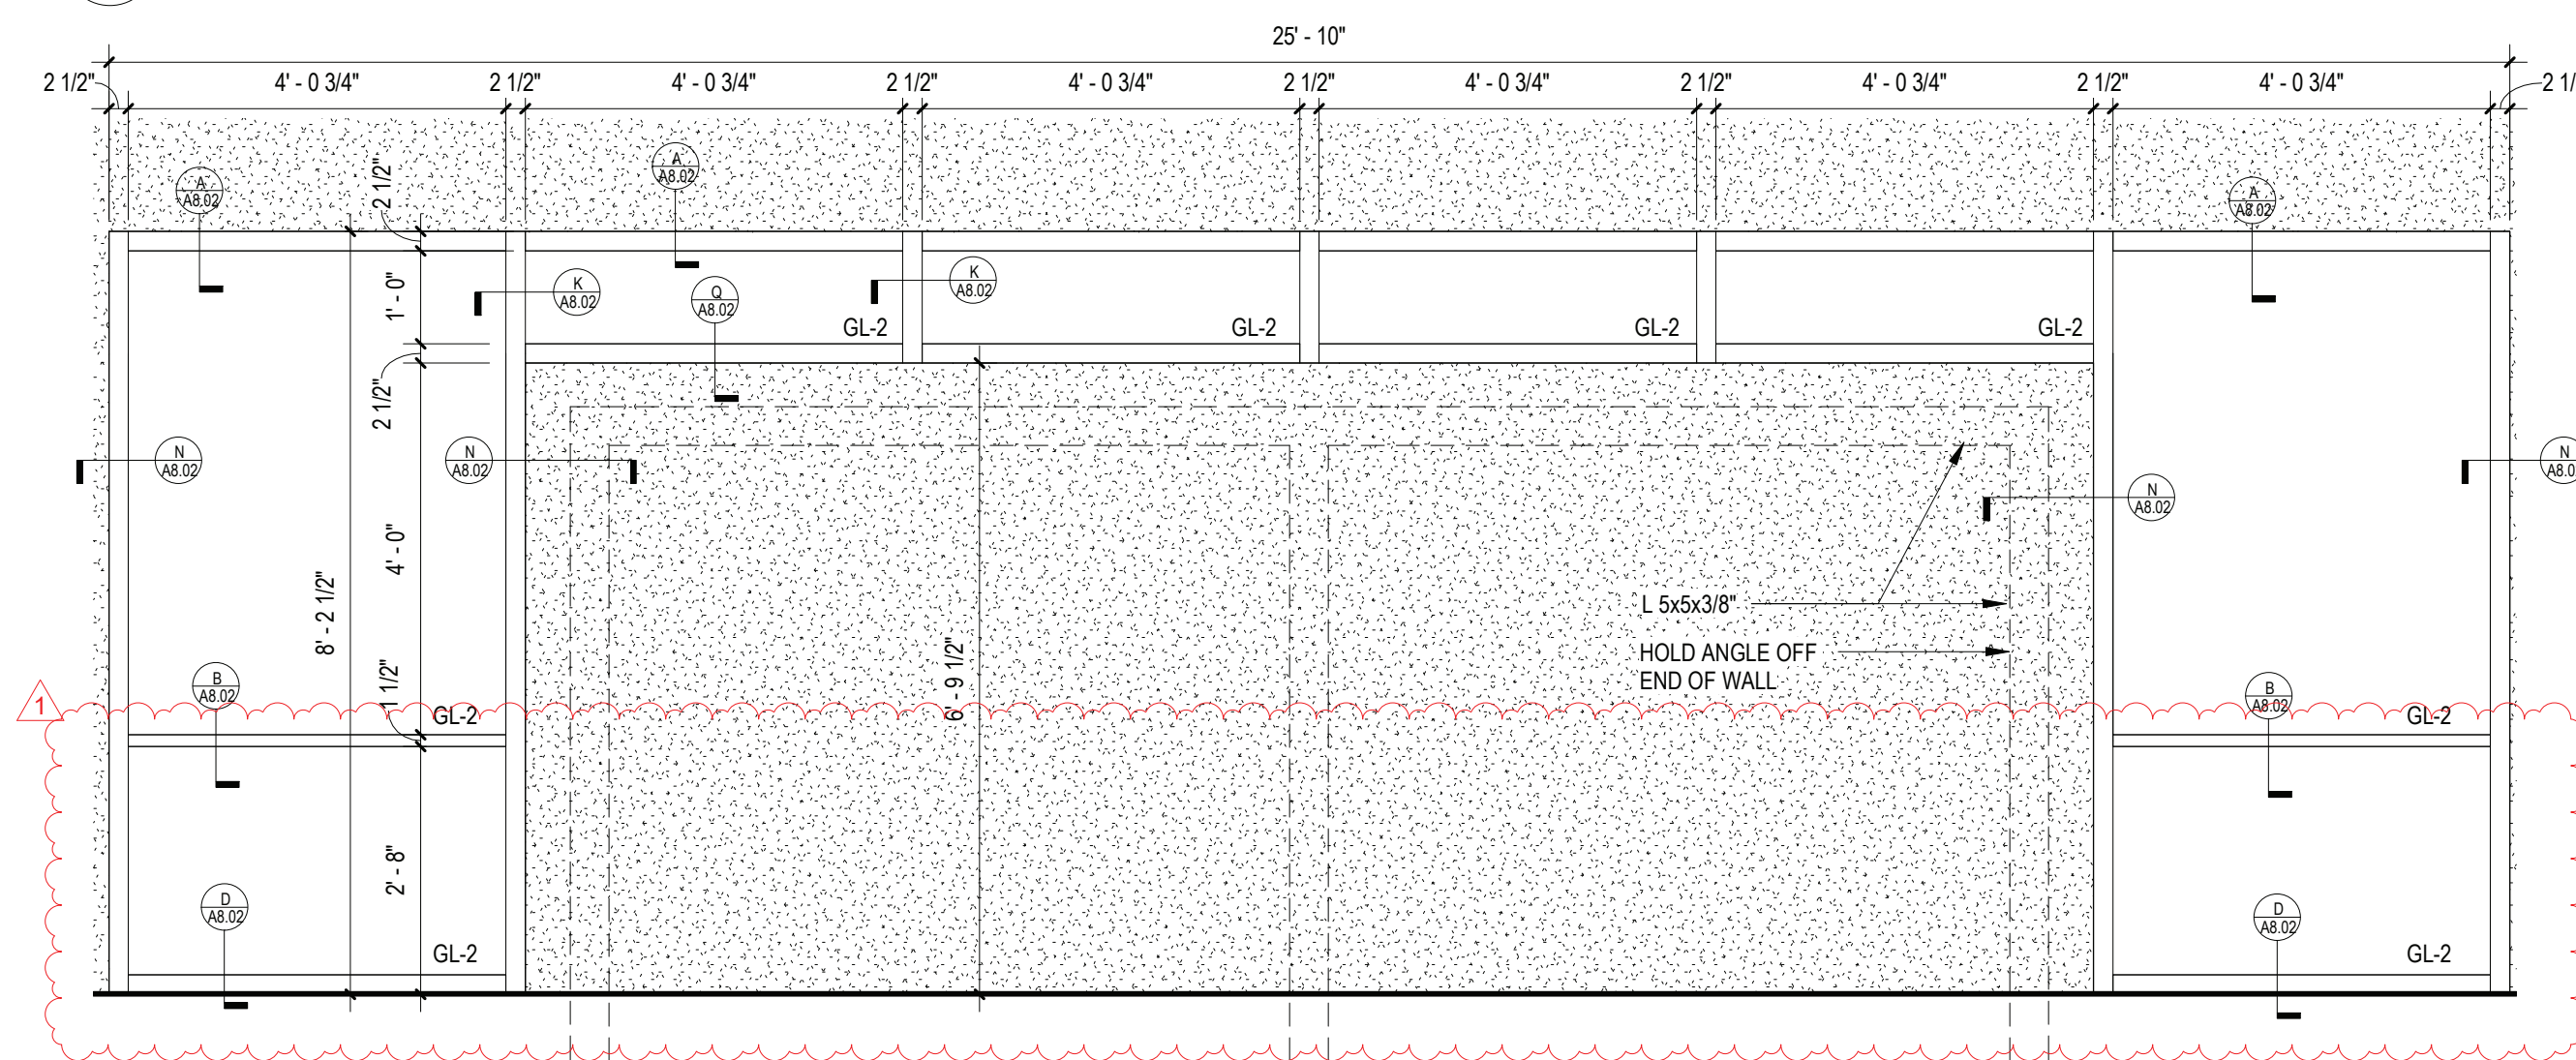


2 1HR RATED STOREFRONT - 10 ELEVATION (ASTM E 119)  
SCALE: 1/2" = 1'-0"

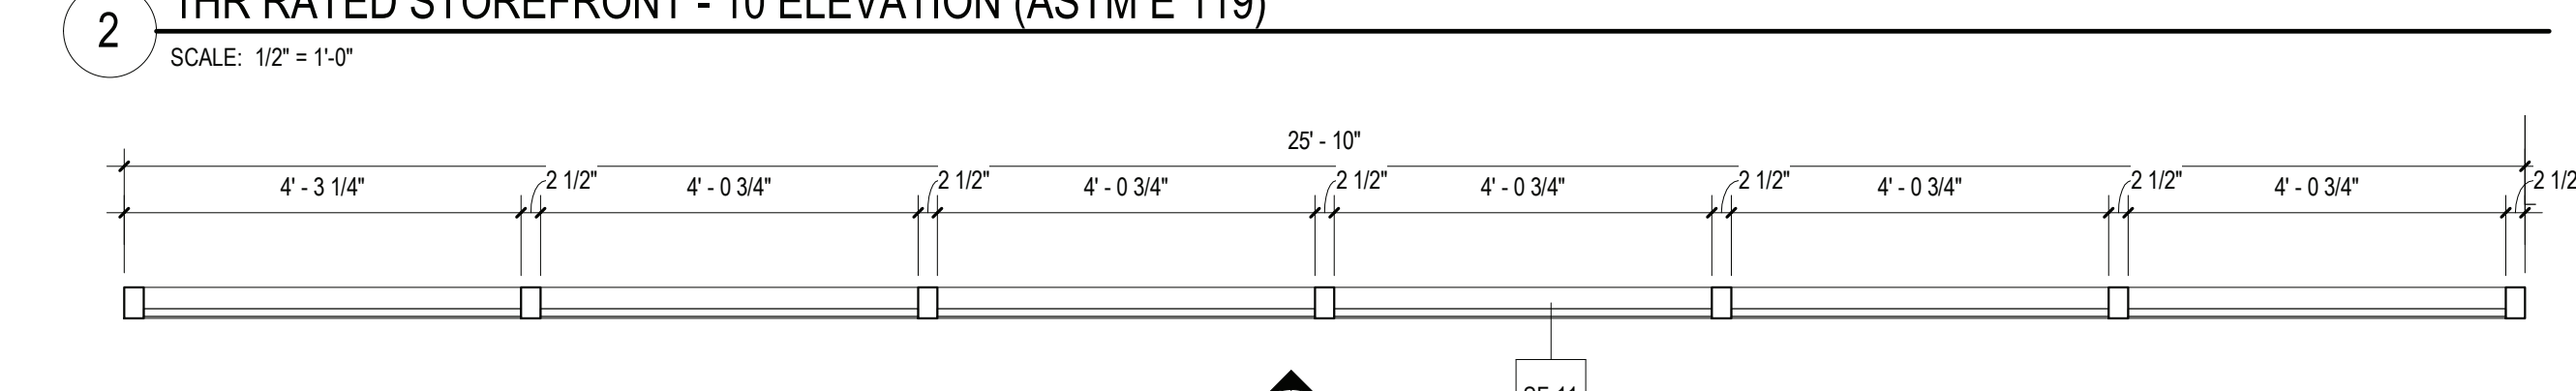


3 STOREFRONT PLAN - 11  
"GENIUS ARCHITECTURAL WALL"  
SCALE: 1/2" = 1'-0"

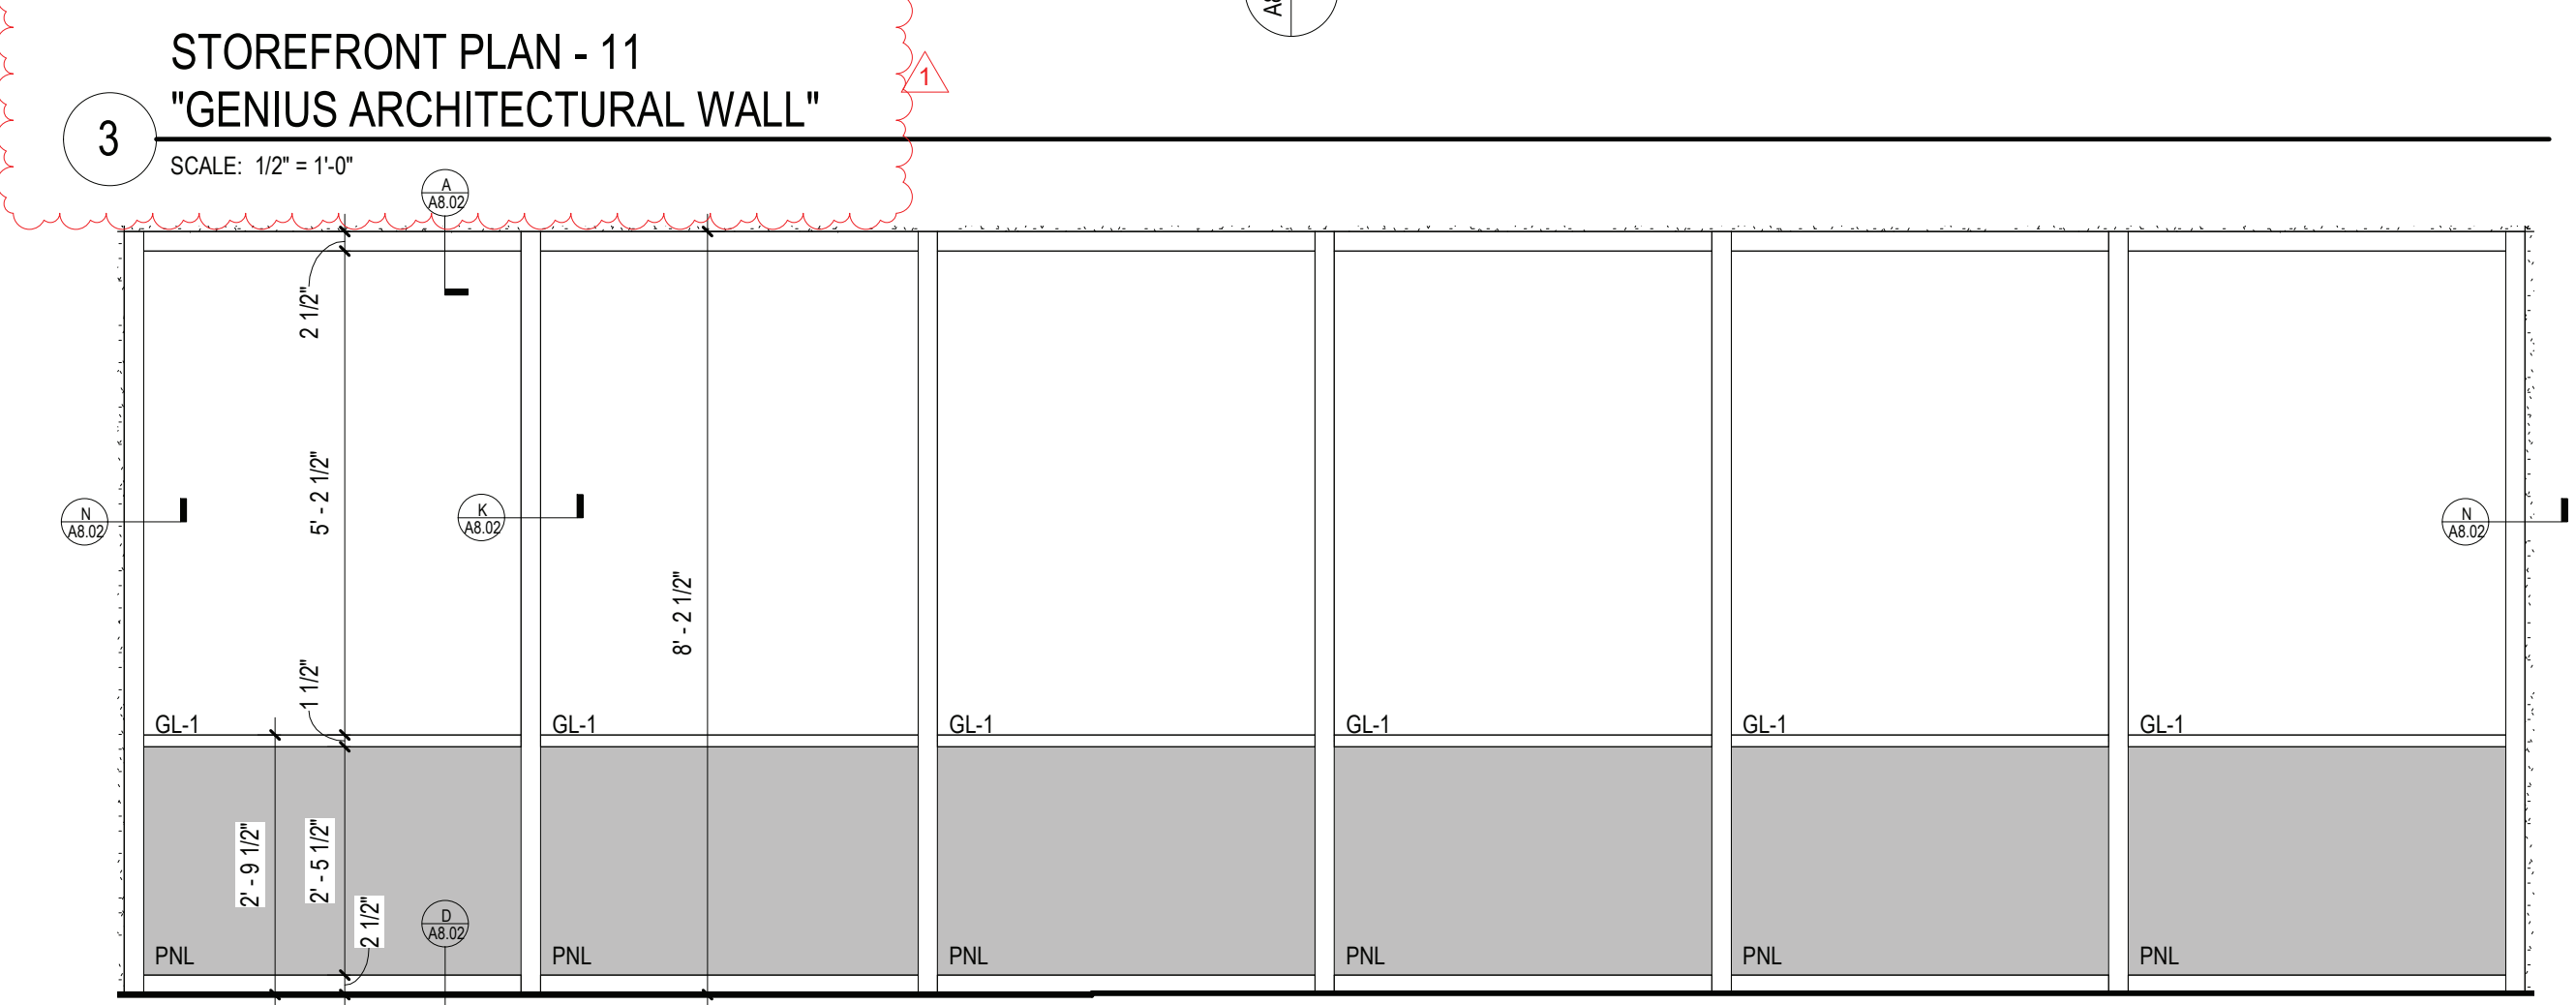

4 STOREFRONT - 11 ELEVATION  
"GENIUS ARCHITECTURAL WALL"  
SCALE: 1/2" = 1'-0"

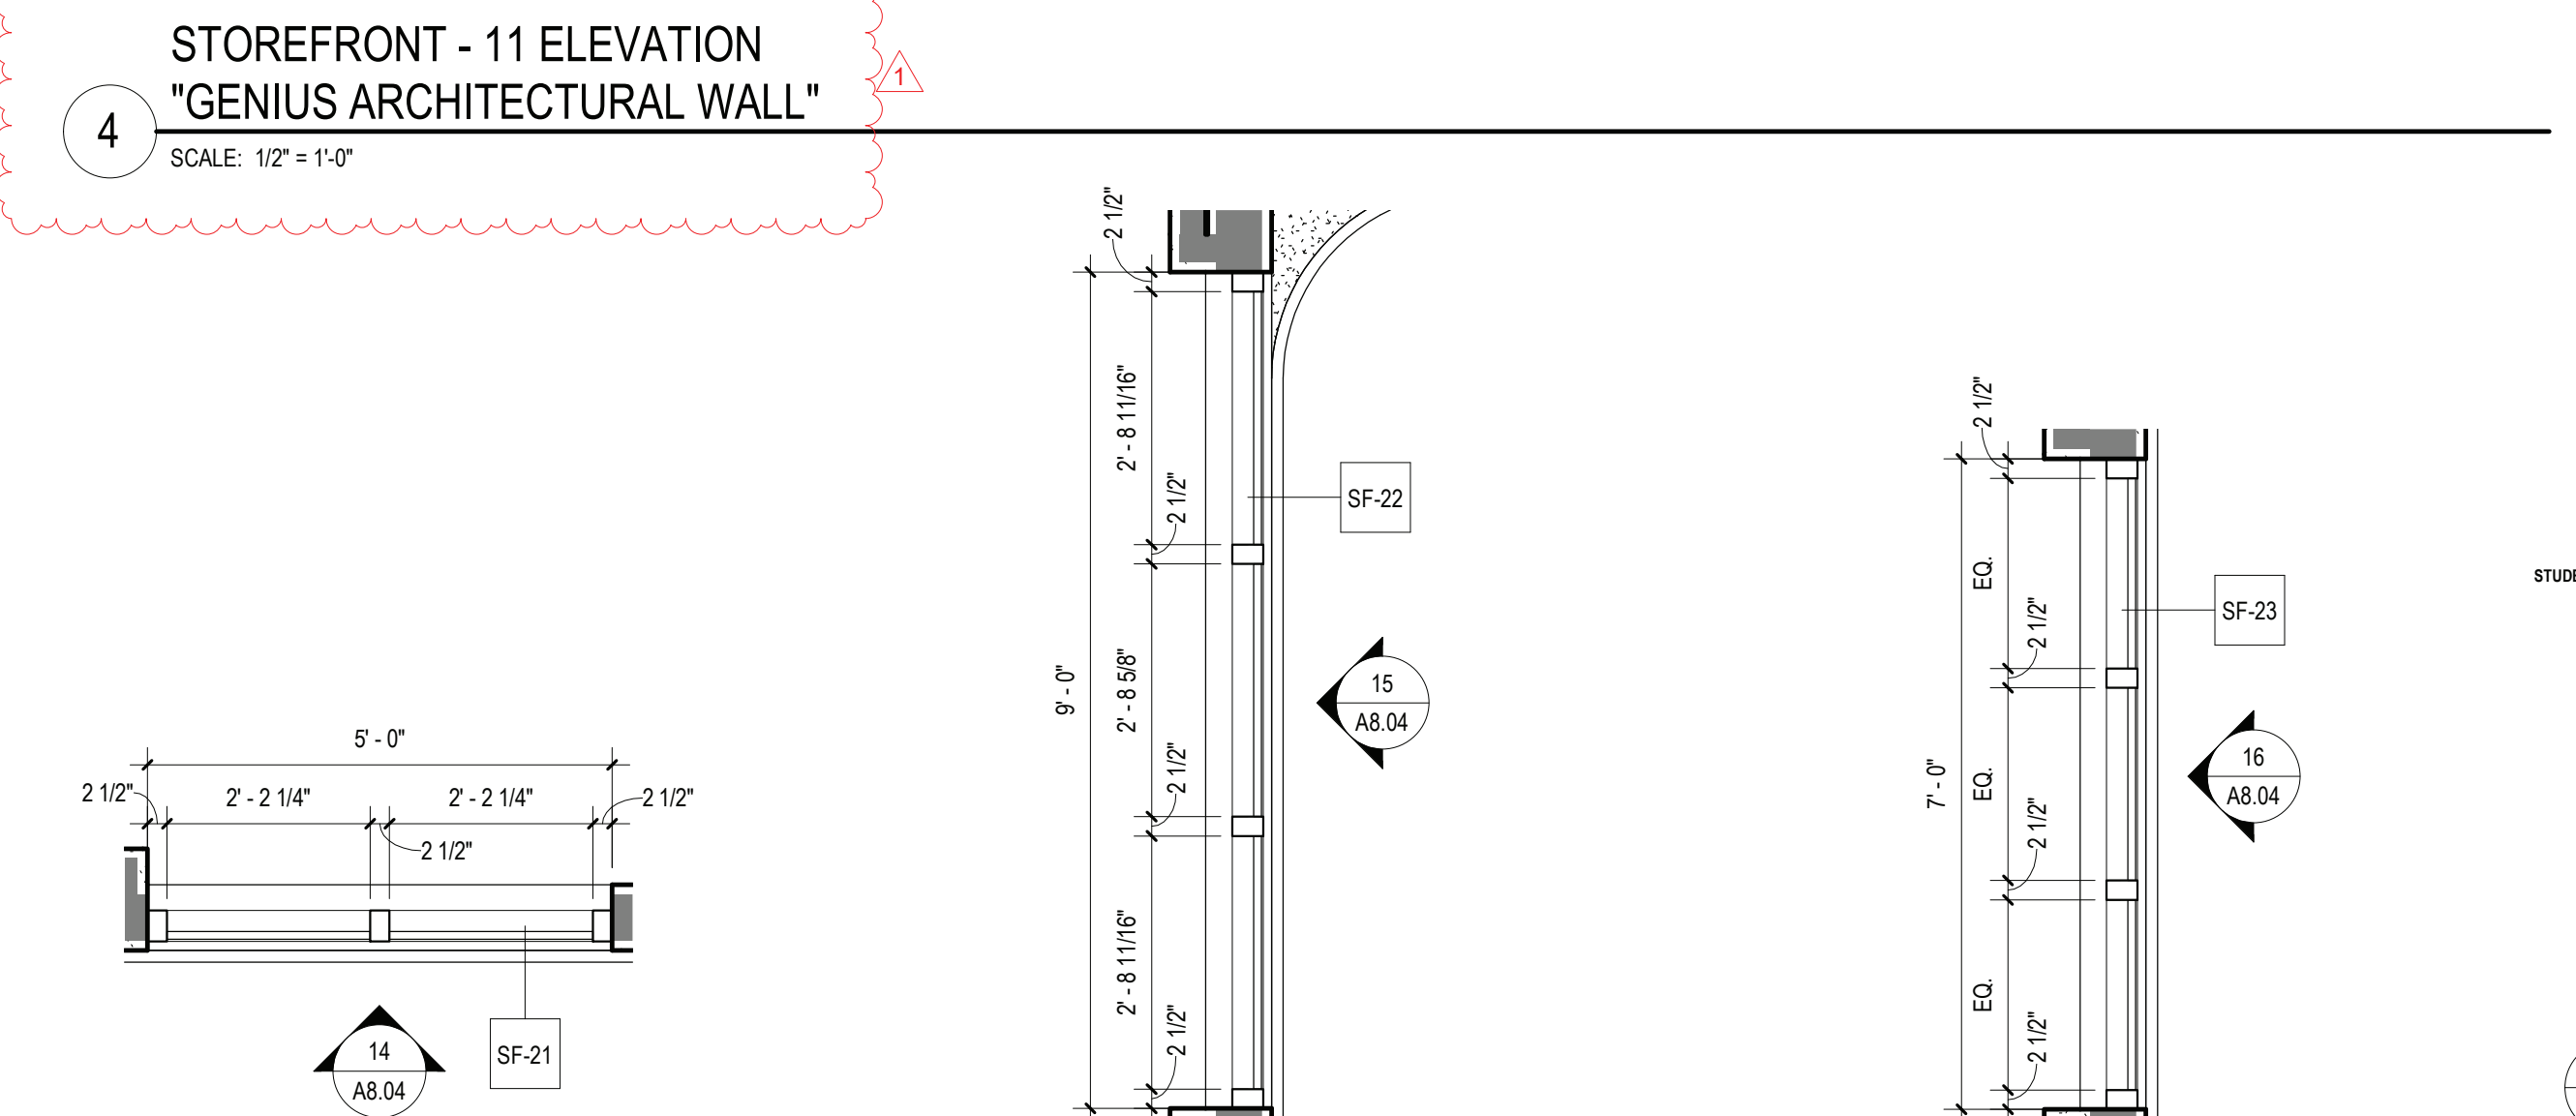

11 STOREFRONT PLAN - 21  
SCALE: 1/2" = 1'-0"

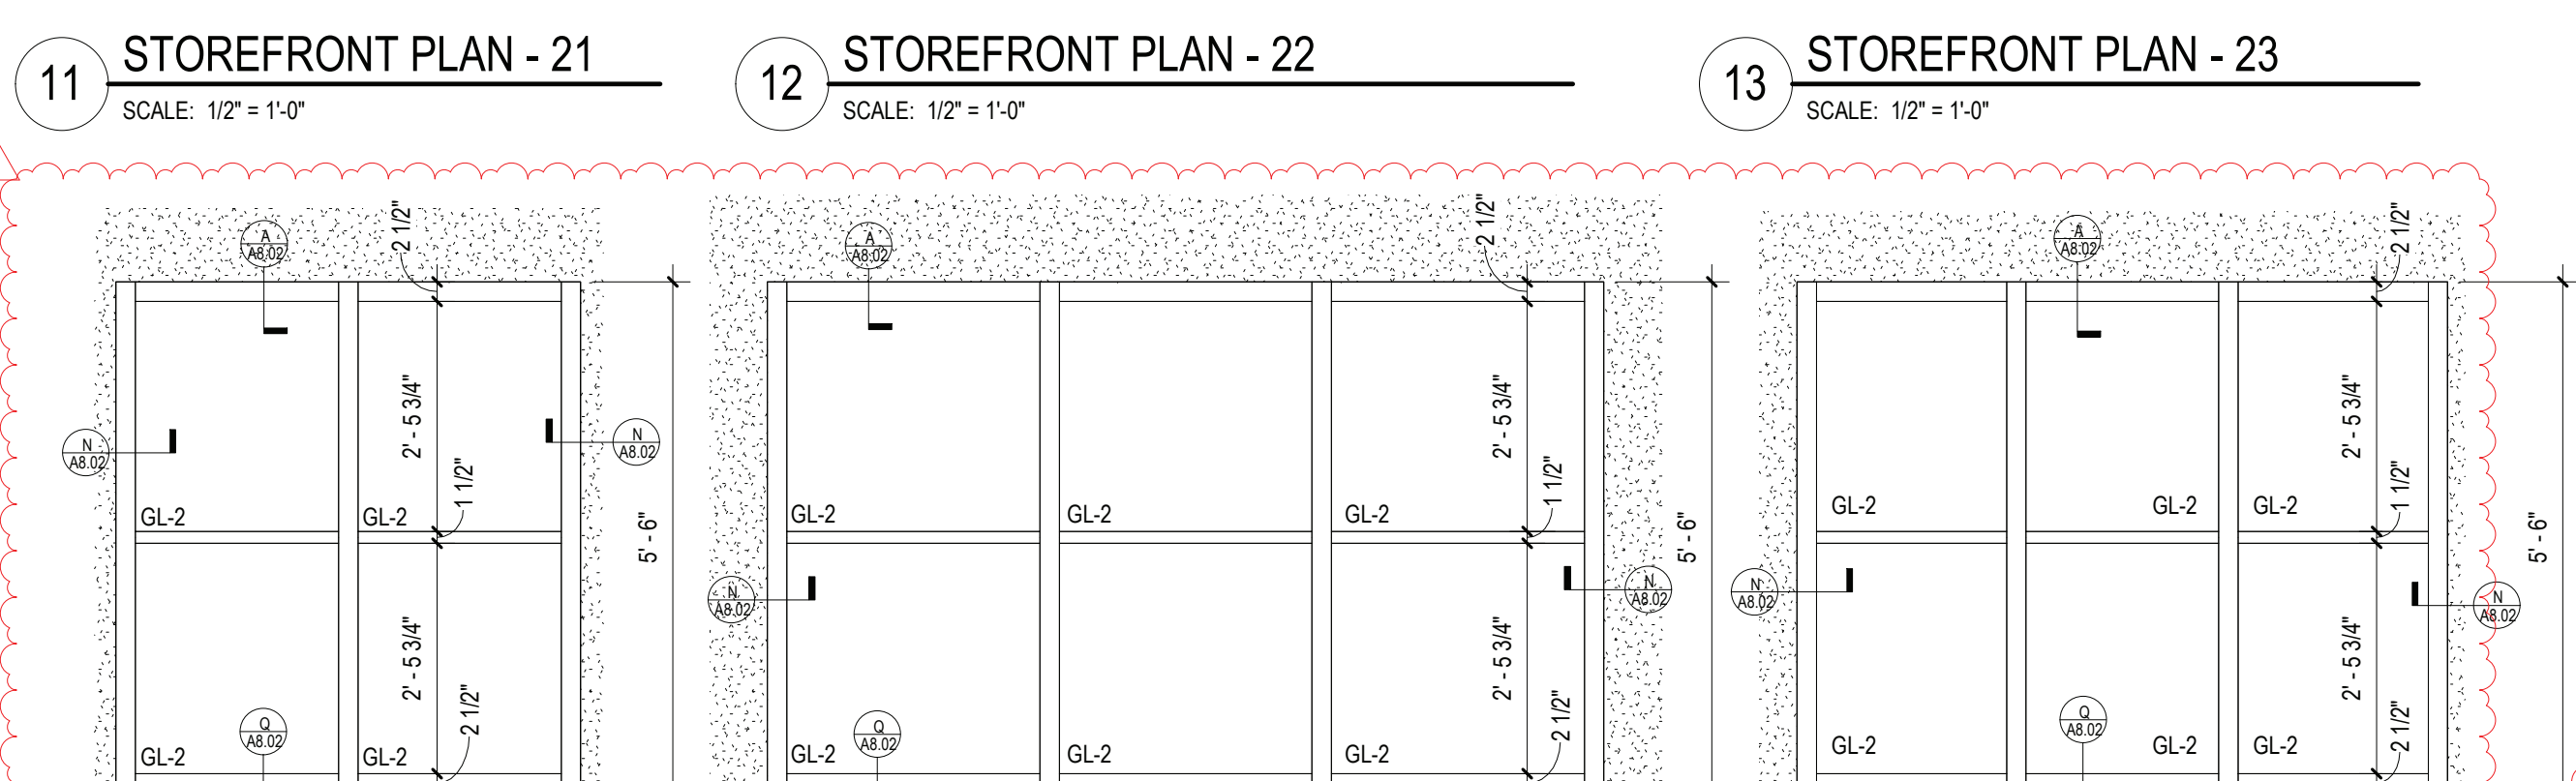


12 STOREFRONT PLAN - 22  
SCALE: 1/2" = 1'-0"




13 STOREFRONT PLAN - 23  
SCALE: 1/2" = 1'-0"




14 1HR RATED STOREFRONT 21 ELEVATION (ASTM E 119)  
SCALE: 1/2" = 1'-0"

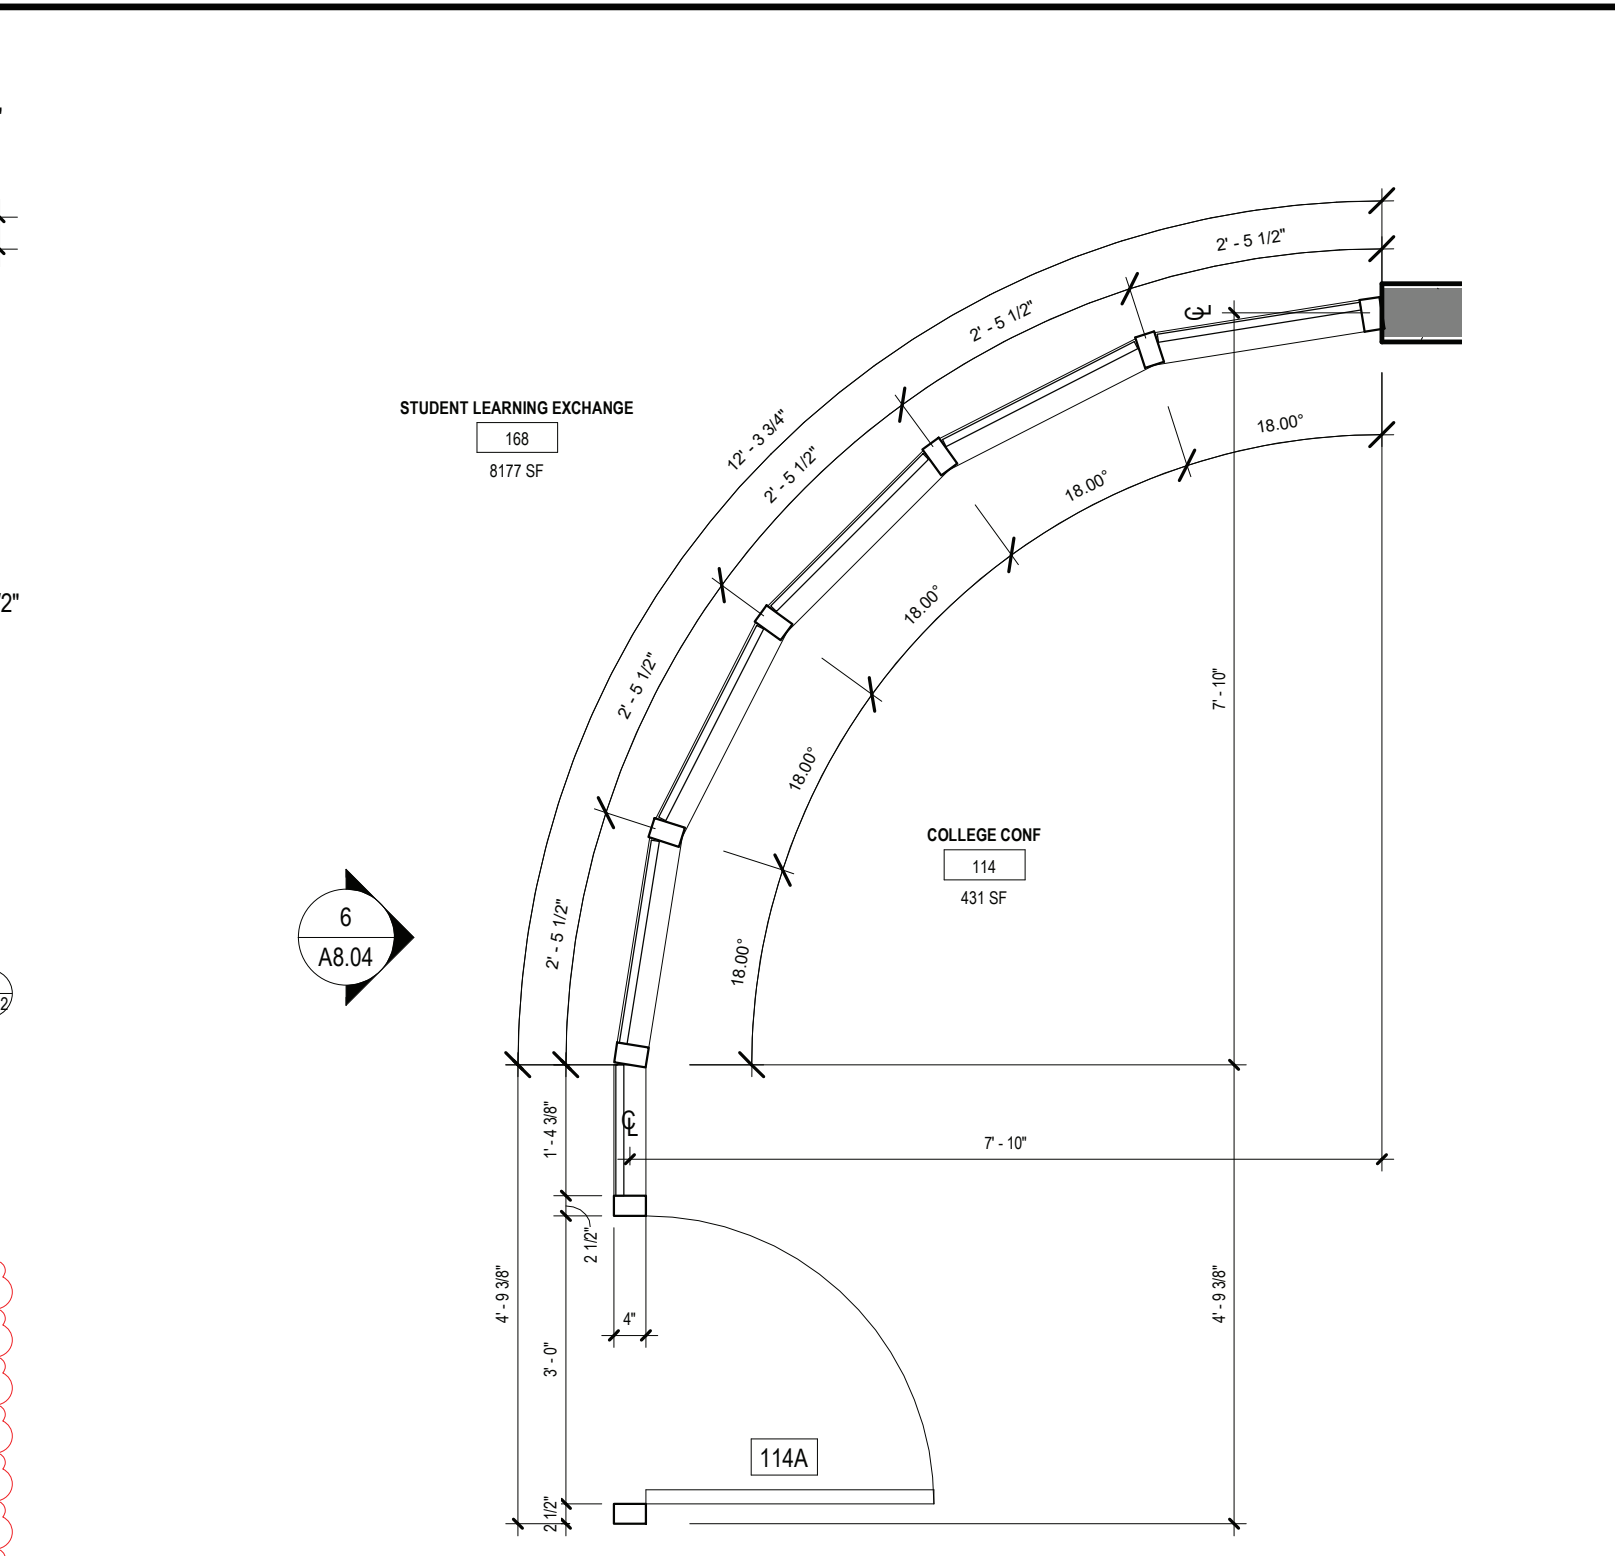


5 STOREFRONT PLAN - 08  
"GENIUS ARCHITECTURAL WALL"  
SCALE: 1/2" = 1'-0"

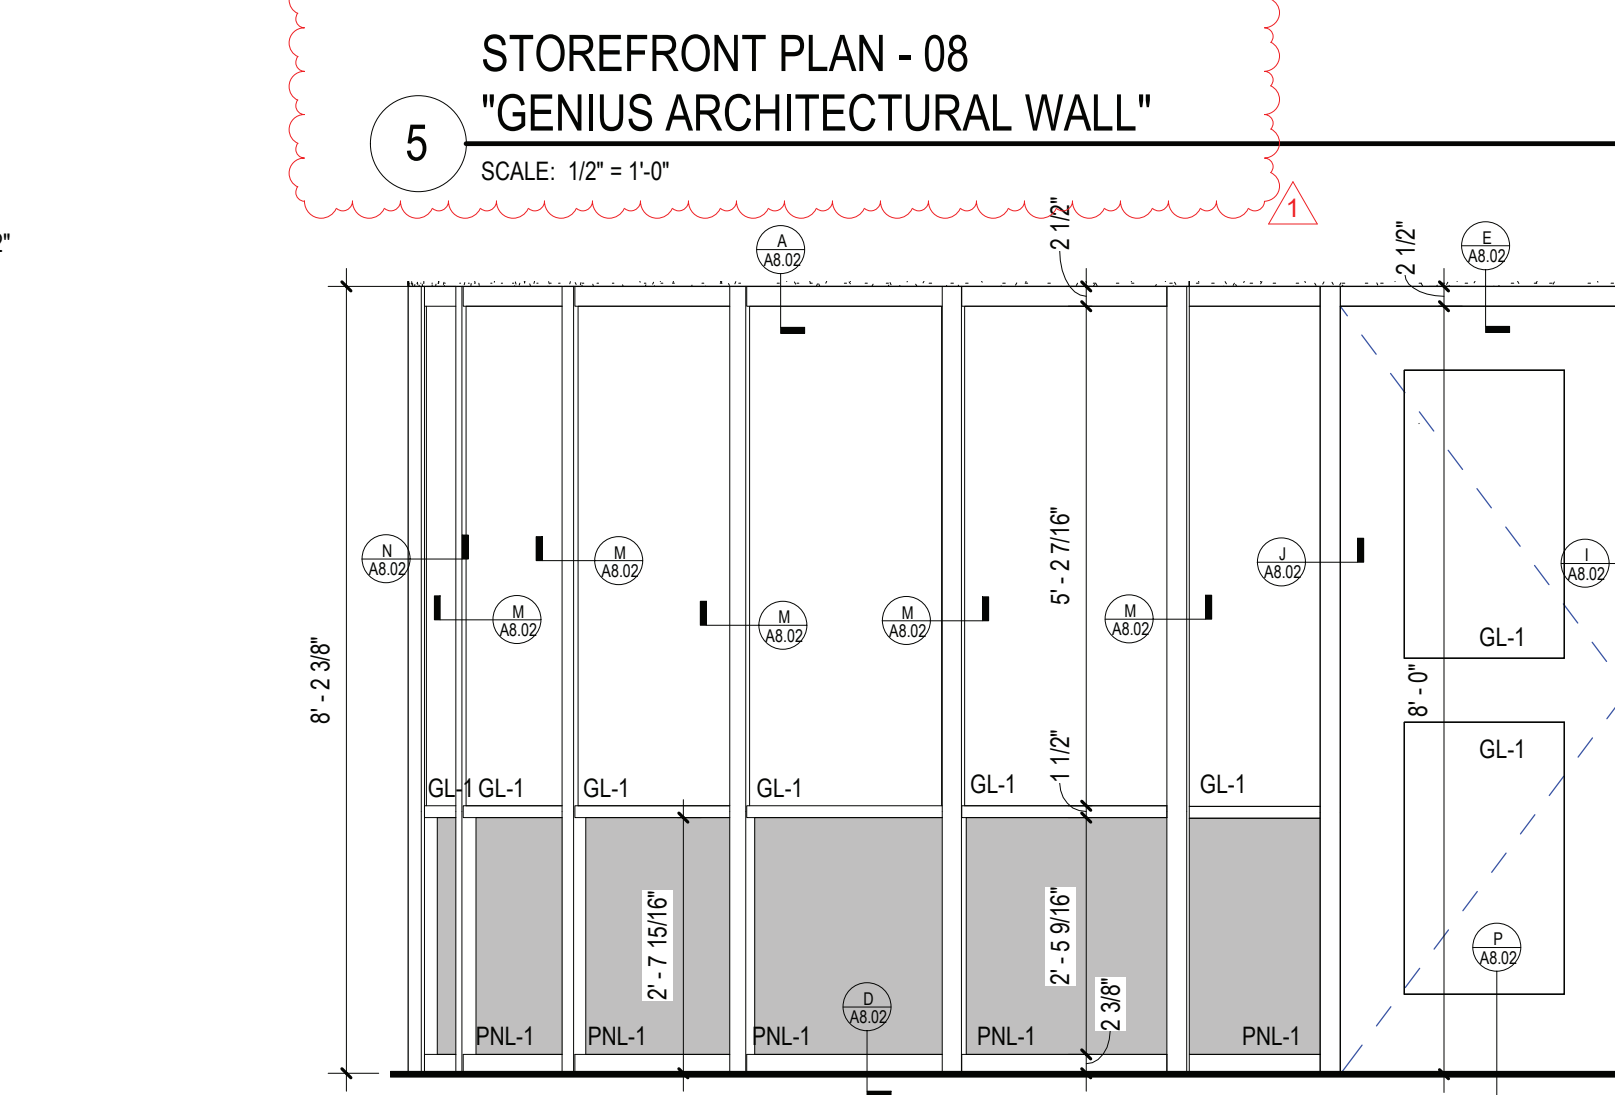

6 STOREFRONT - 08 ELEVATION  
"GENIUS ARCHITECTURAL WALL"  
SCALE: 1/2" = 1'-0"

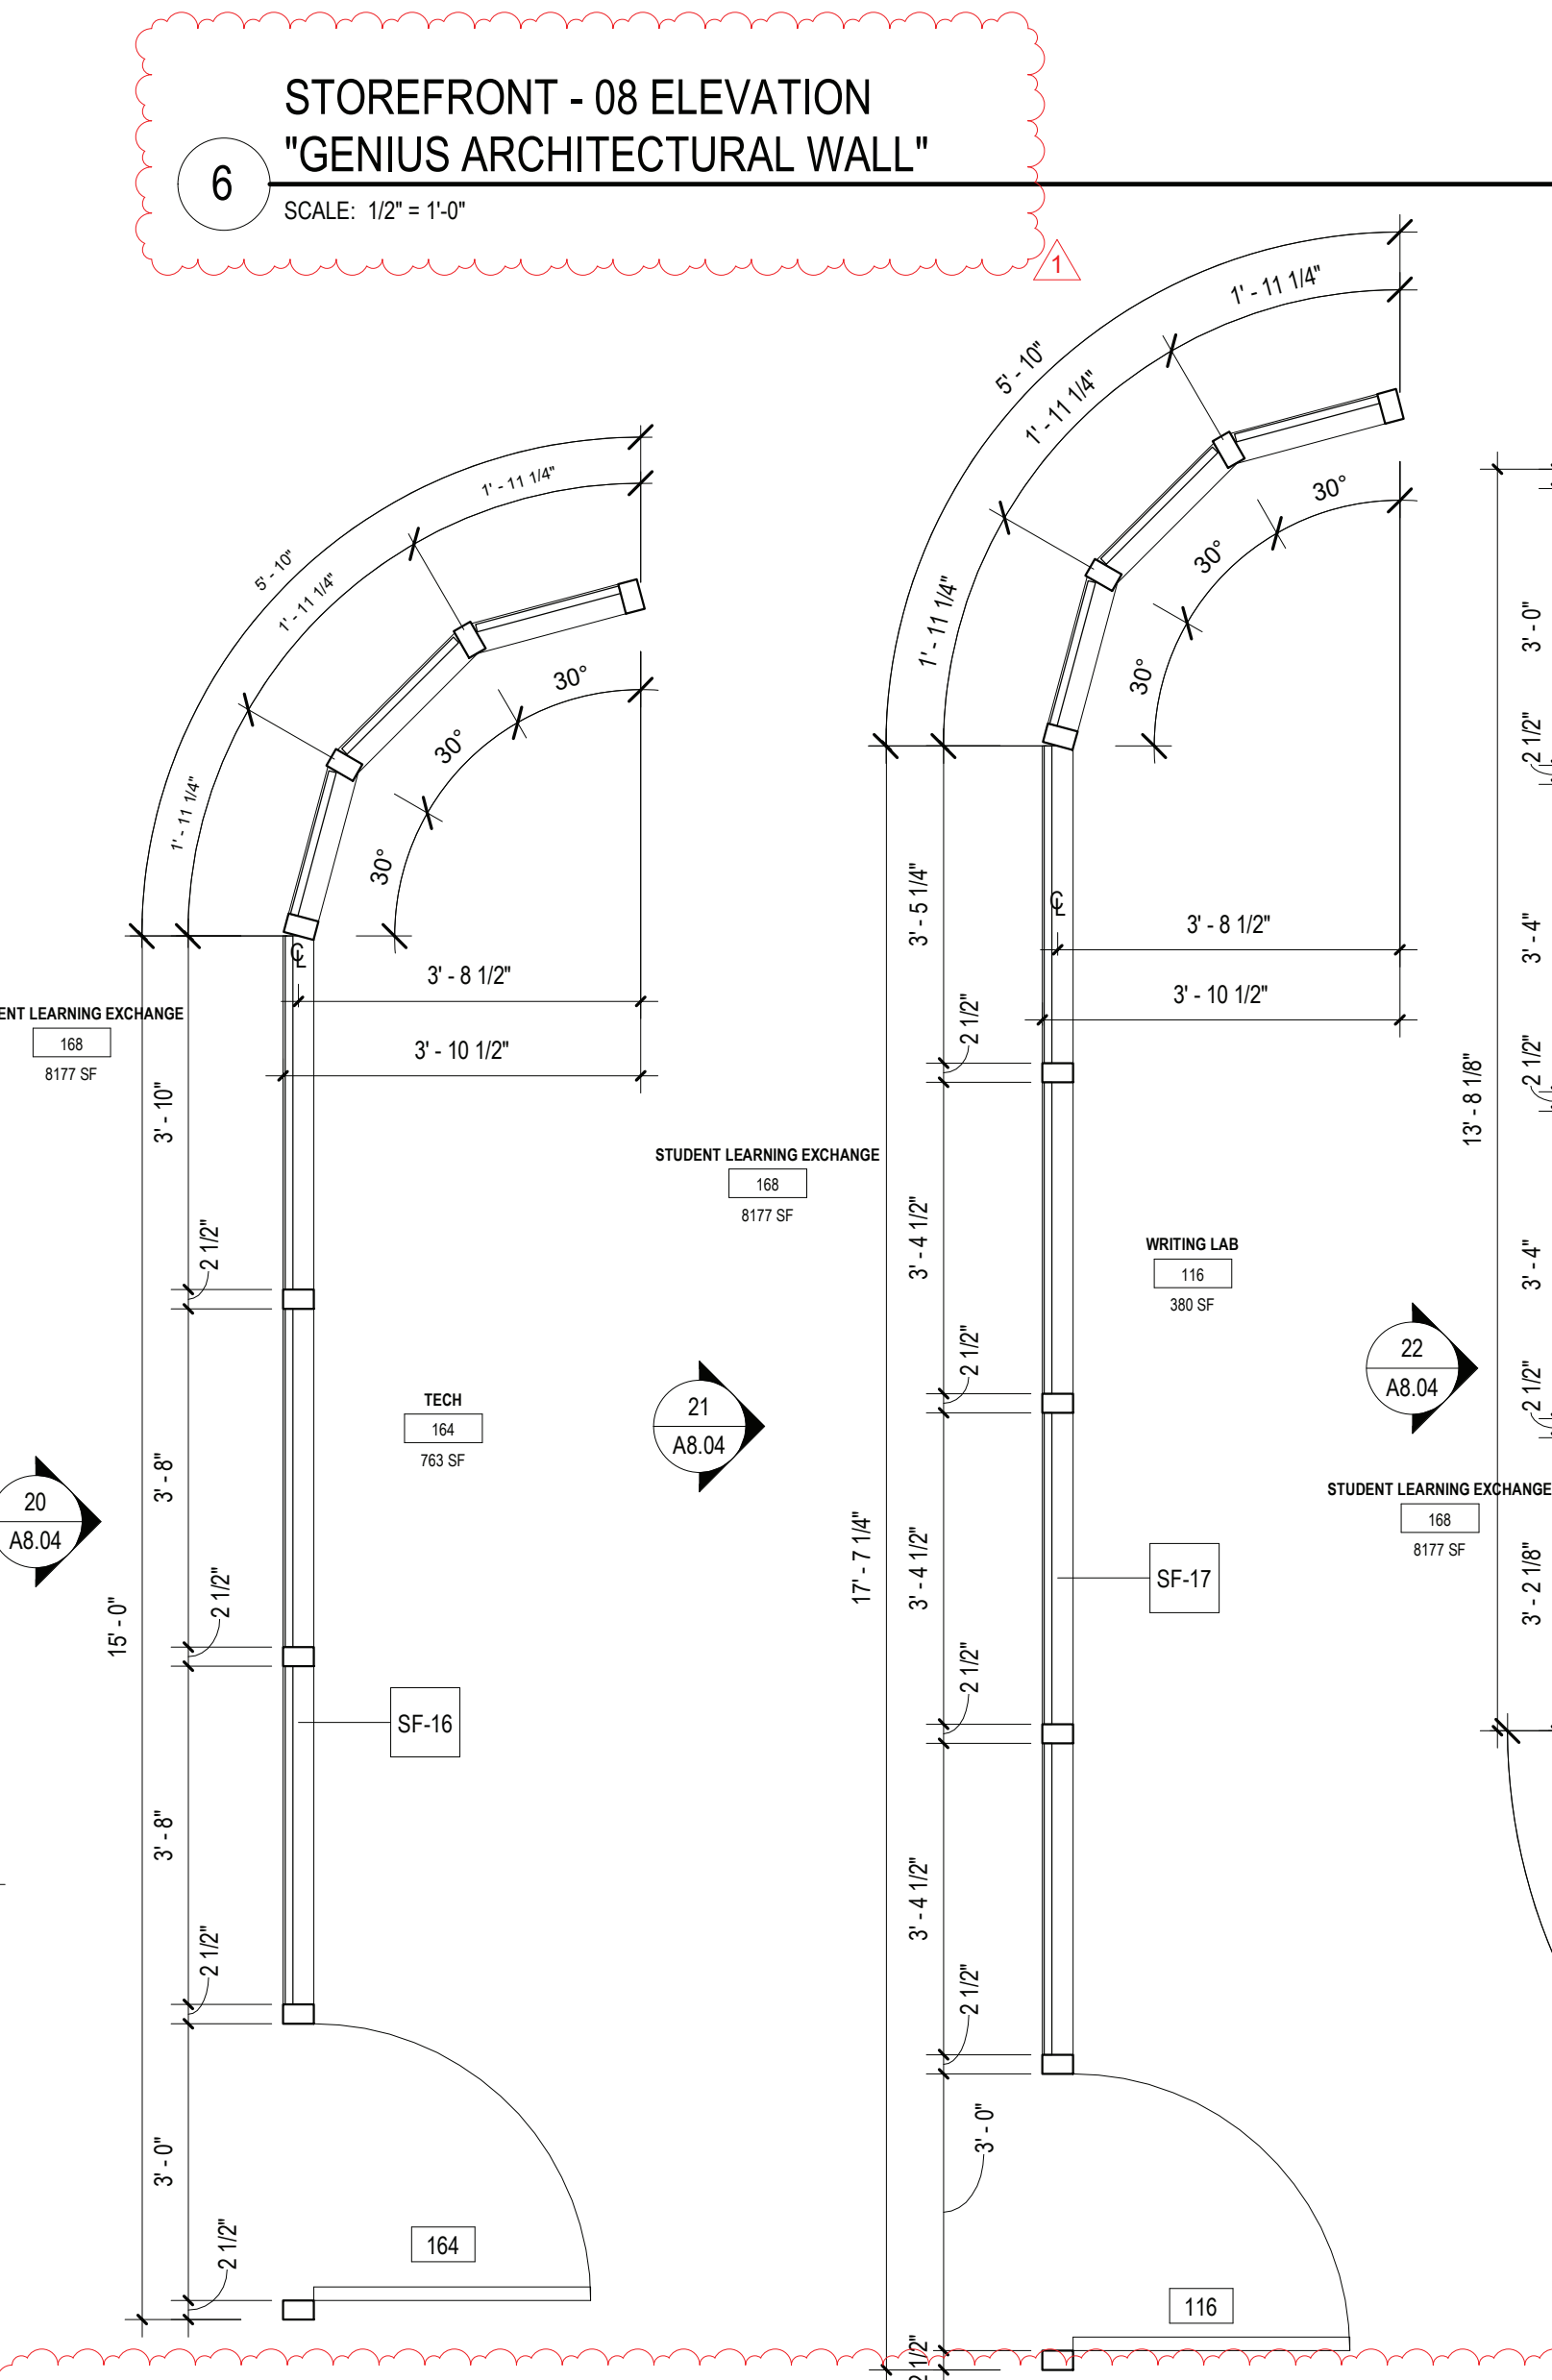


17 STOREFRONT PLAN - 16  
"GINIUS ARCHITECTURAL WALL"  
SCALE: 1/2" = 1'-0"

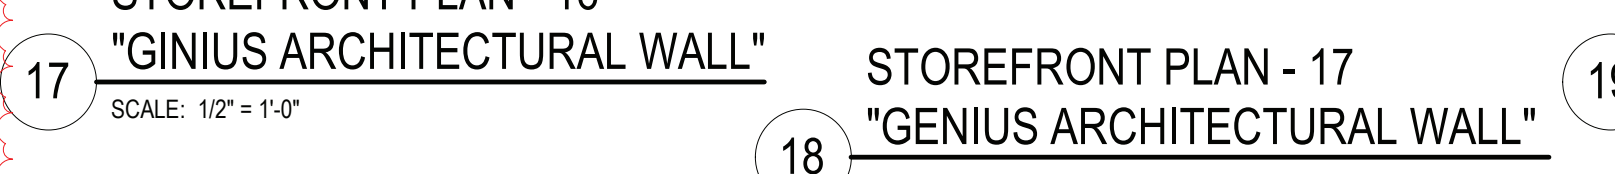


18 STOREFRONT PLAN - 17  
"GENIUS ARCHITECTURAL WALL"  
SCALE: 1/2" = 1'-0"




19 STOREFRONT PLAN - 18  
"GENIUS ARCHITECTURAL WALL"  
SCALE: 1/2" = 1'-0"

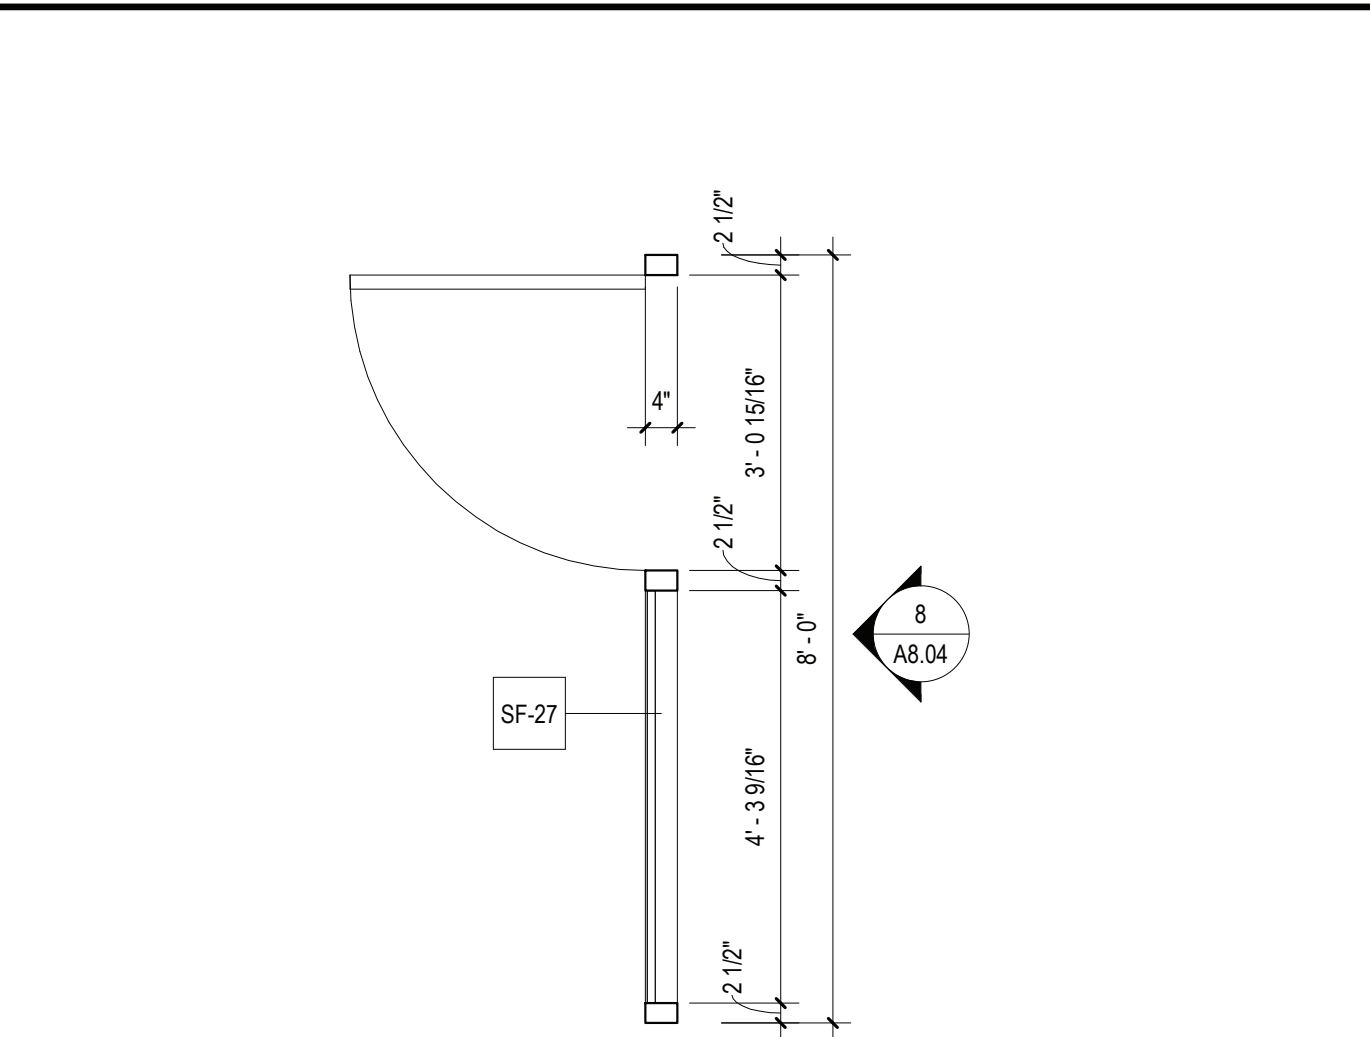


7 1HR RATED STOREFRONT PLAN - 27 (ASTM E 119)  
SCALE: 1/2" = 1'-0"

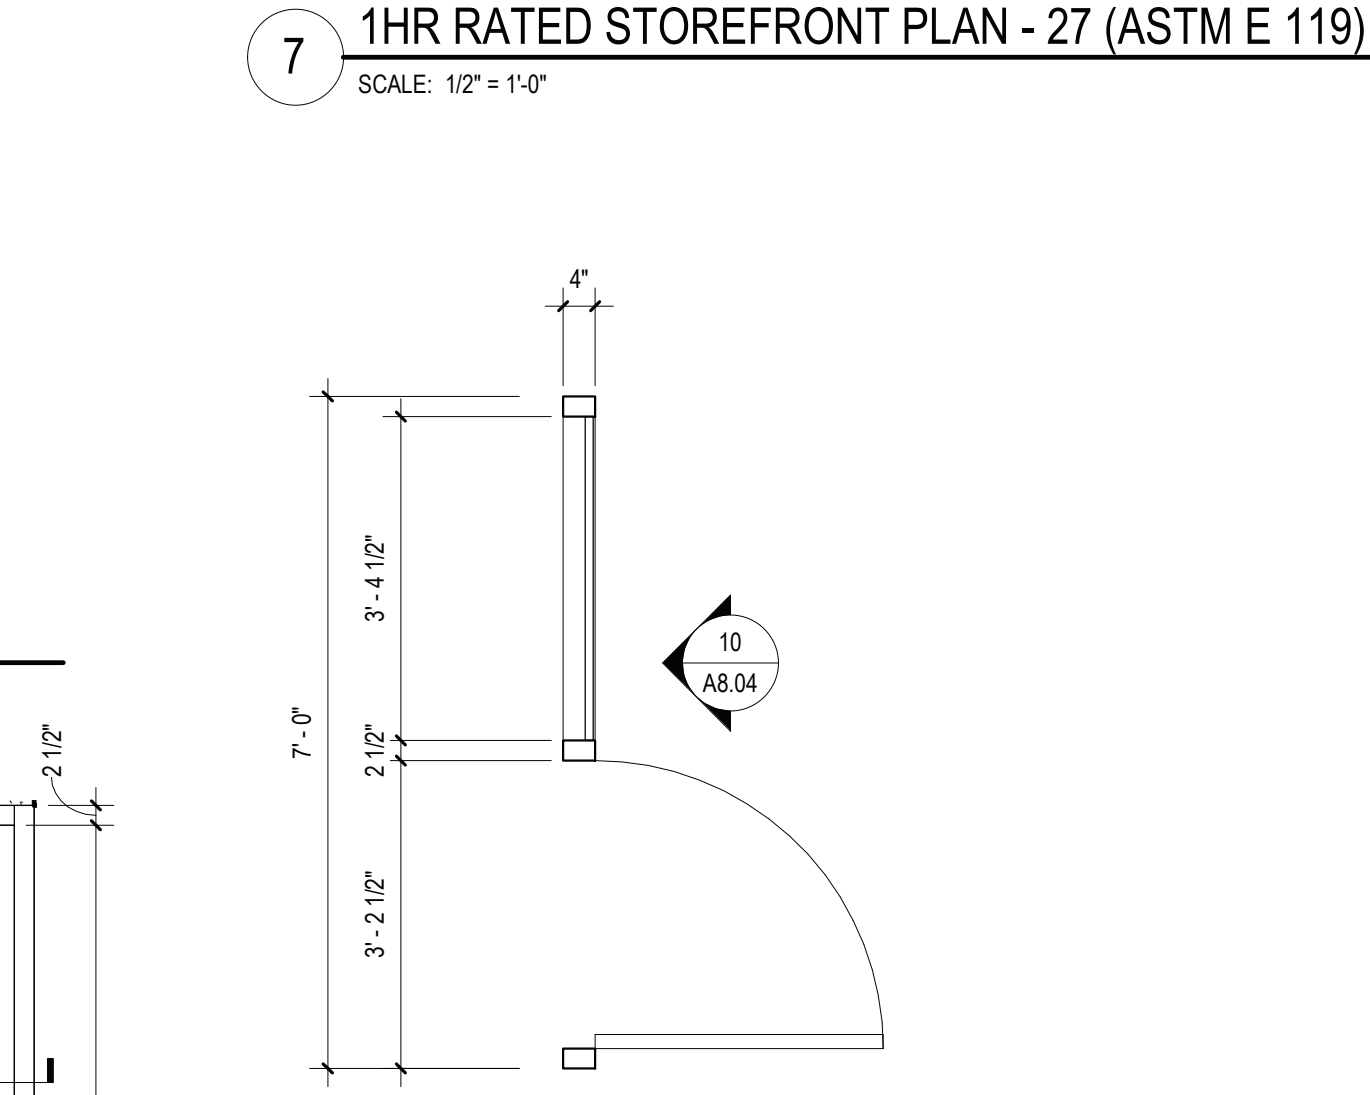


9 1HR RATED STOREFRONT PLAN - 28 (ASTM E 119)  
SCALE: 1/2" = 1'-0"

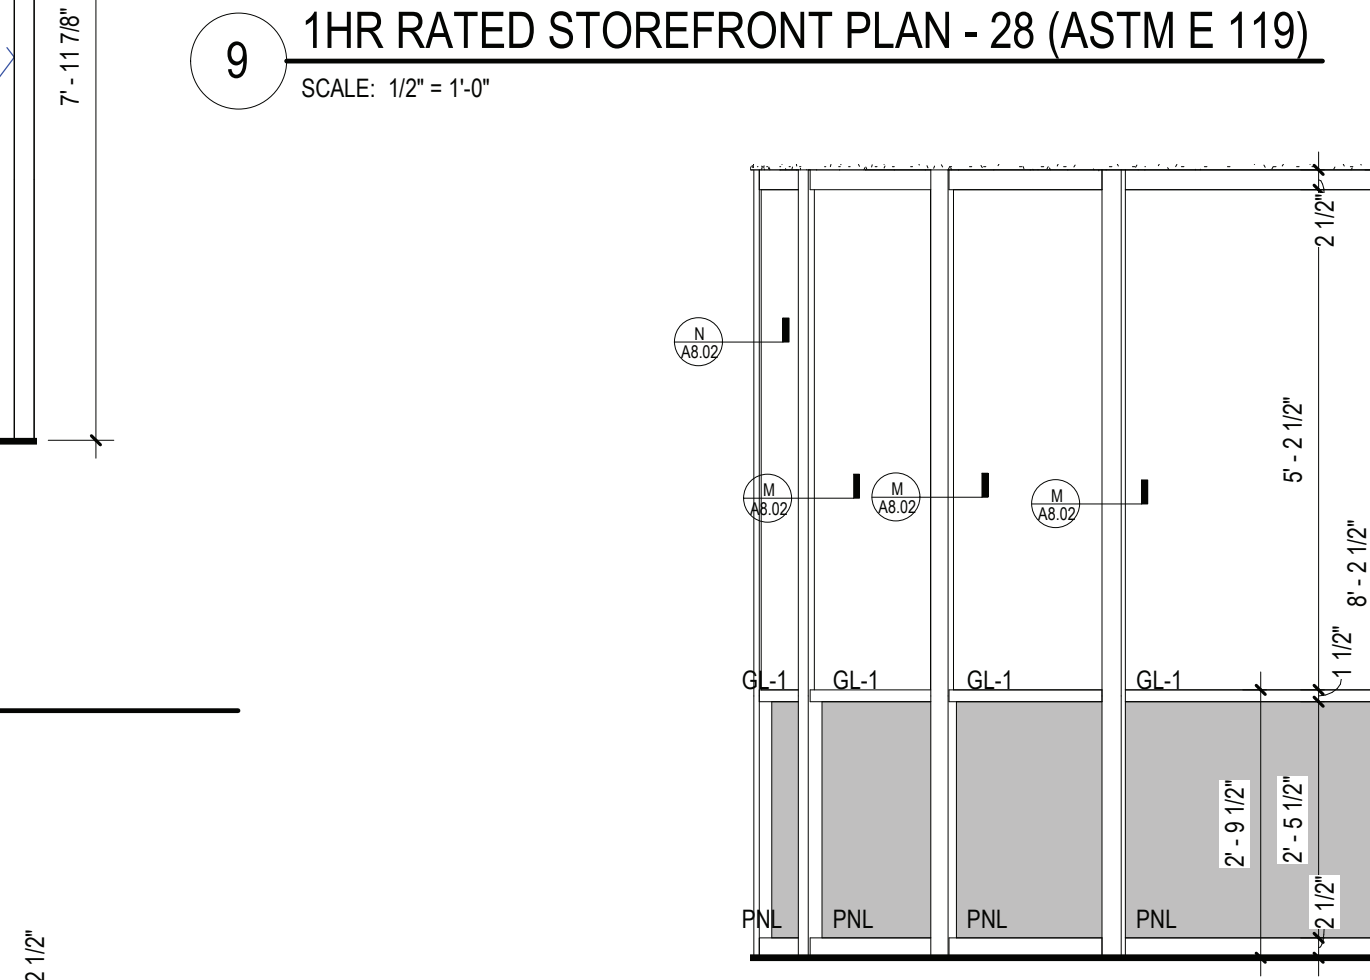


20 STOREFRONT - 16 ELEVATION - "GENIUS ARCHITECTURAL WALL"  
SCALE: 1/2" = 1'-0"

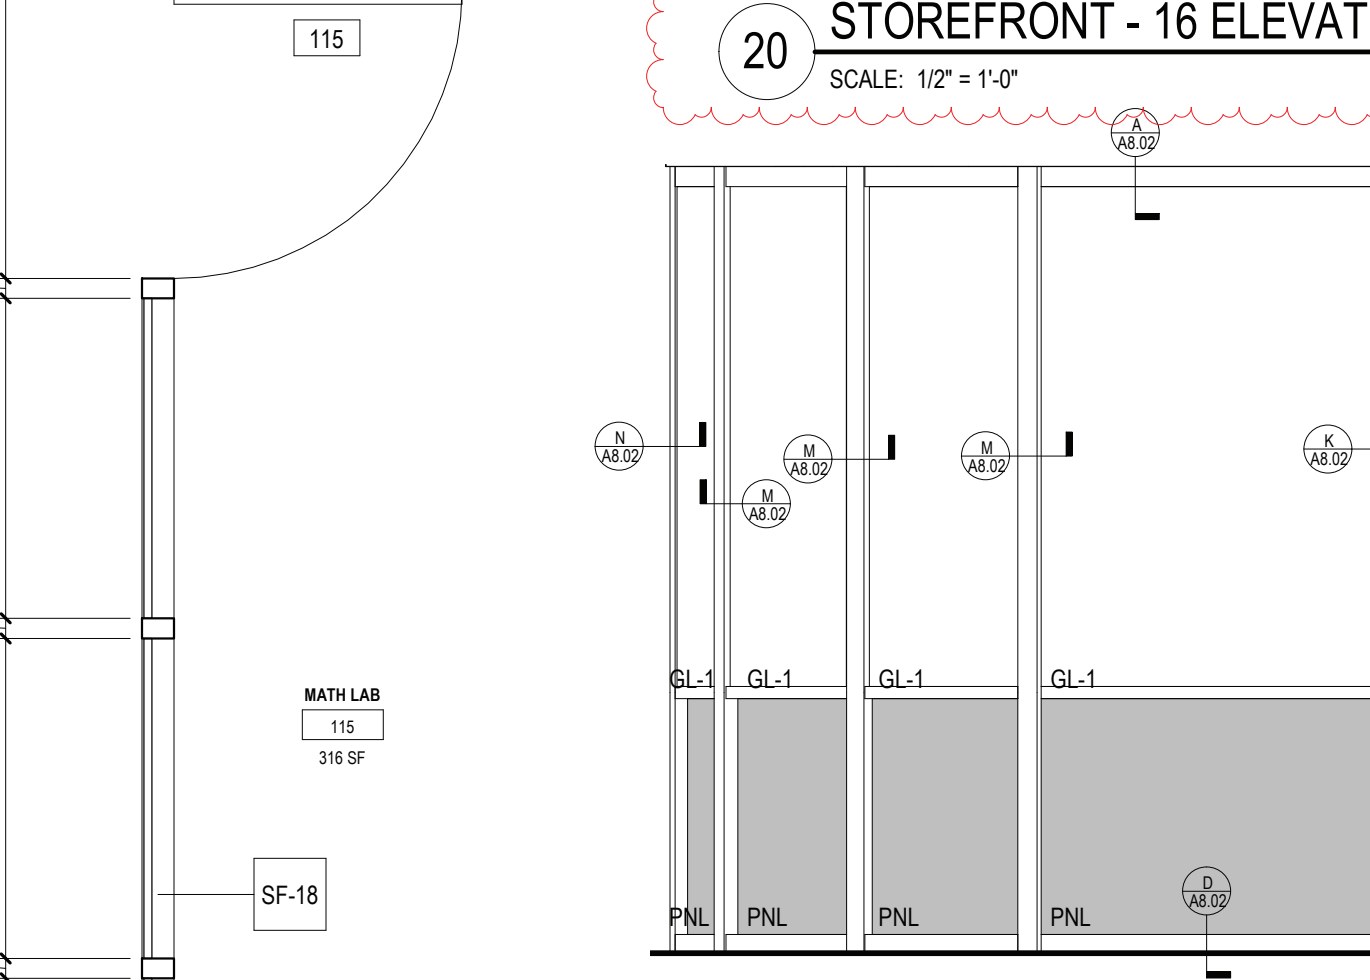


21 STOREFRONT - 17 ELEVATION - "GENIUS ARCHITECTURAL WALL"  
SCALE: 1/2" = 1'-0"

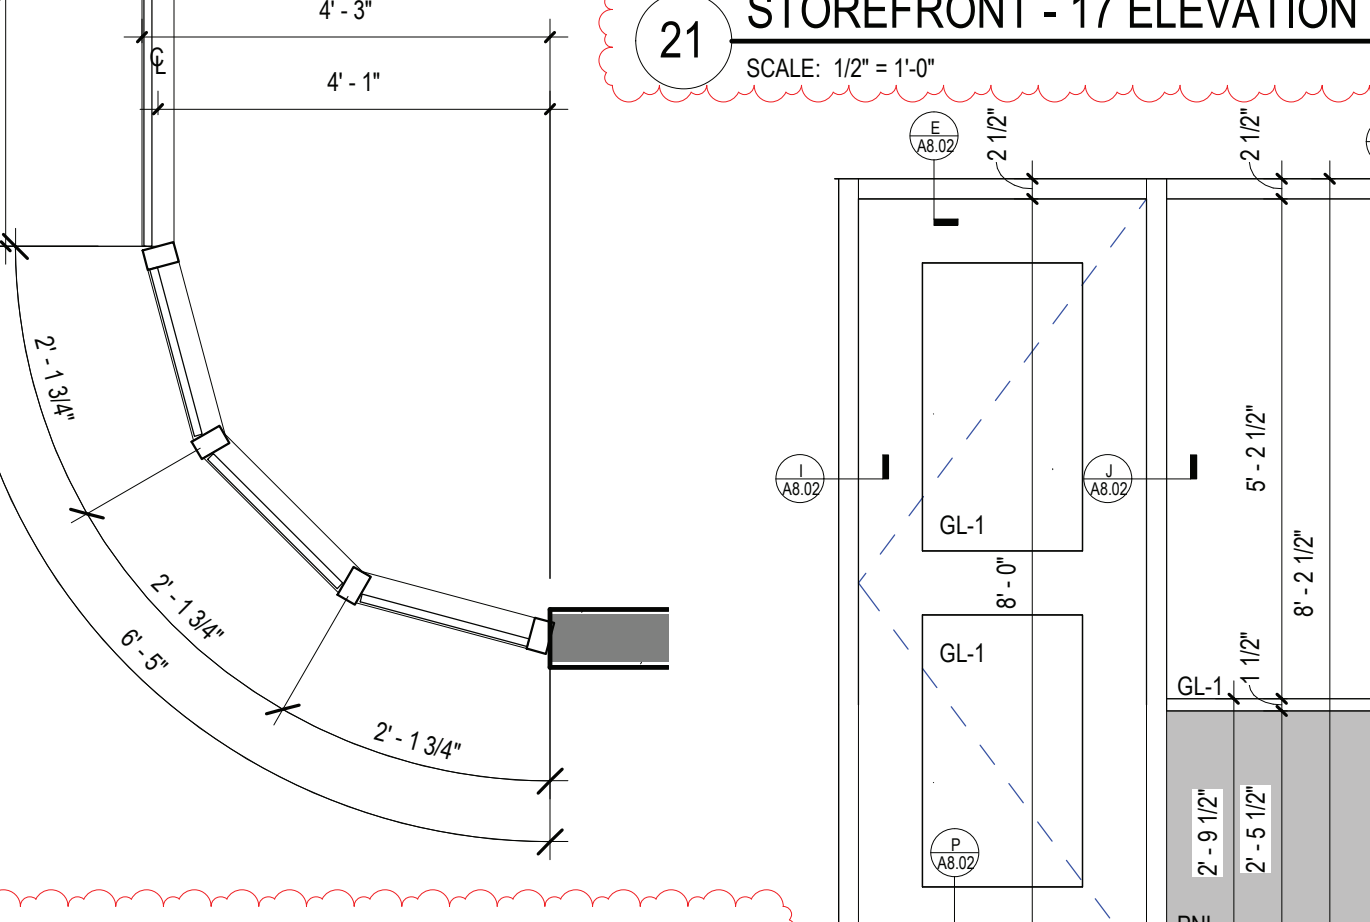


22 STOREFRONT - 18 ELEVATION - "GENIUS ARCHITECTURAL WALL"  
SCALE: 1/2" = 1'-0"

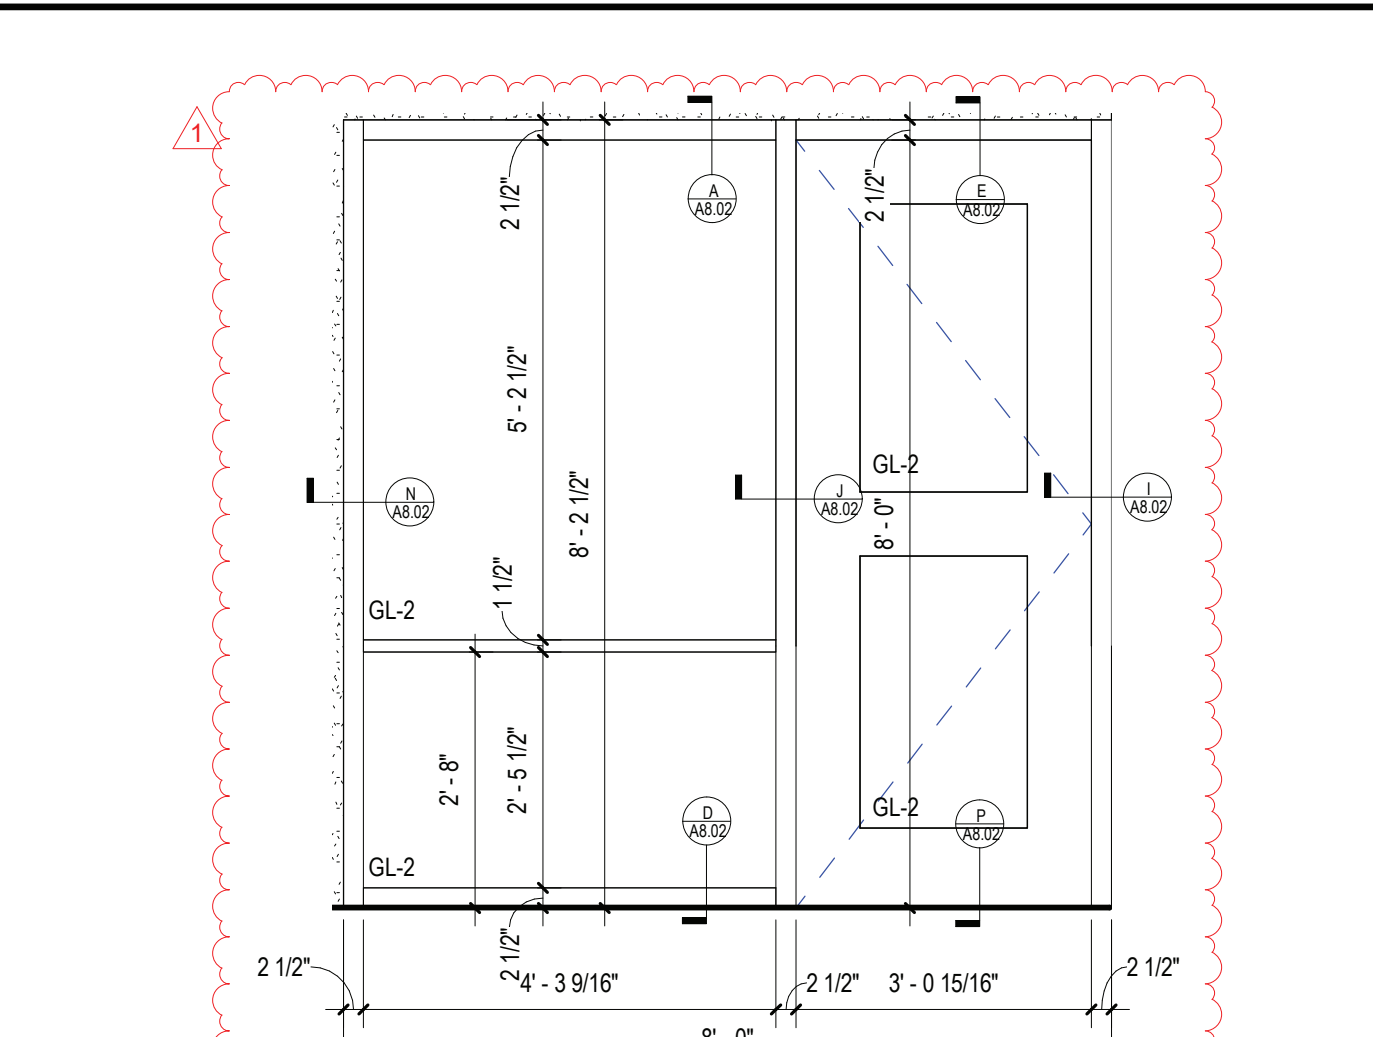


8 1HR RATED STOREFRONT - 27 ELEVATION (ASTM E 119)  
SCALE: 1/2" = 1'-0"

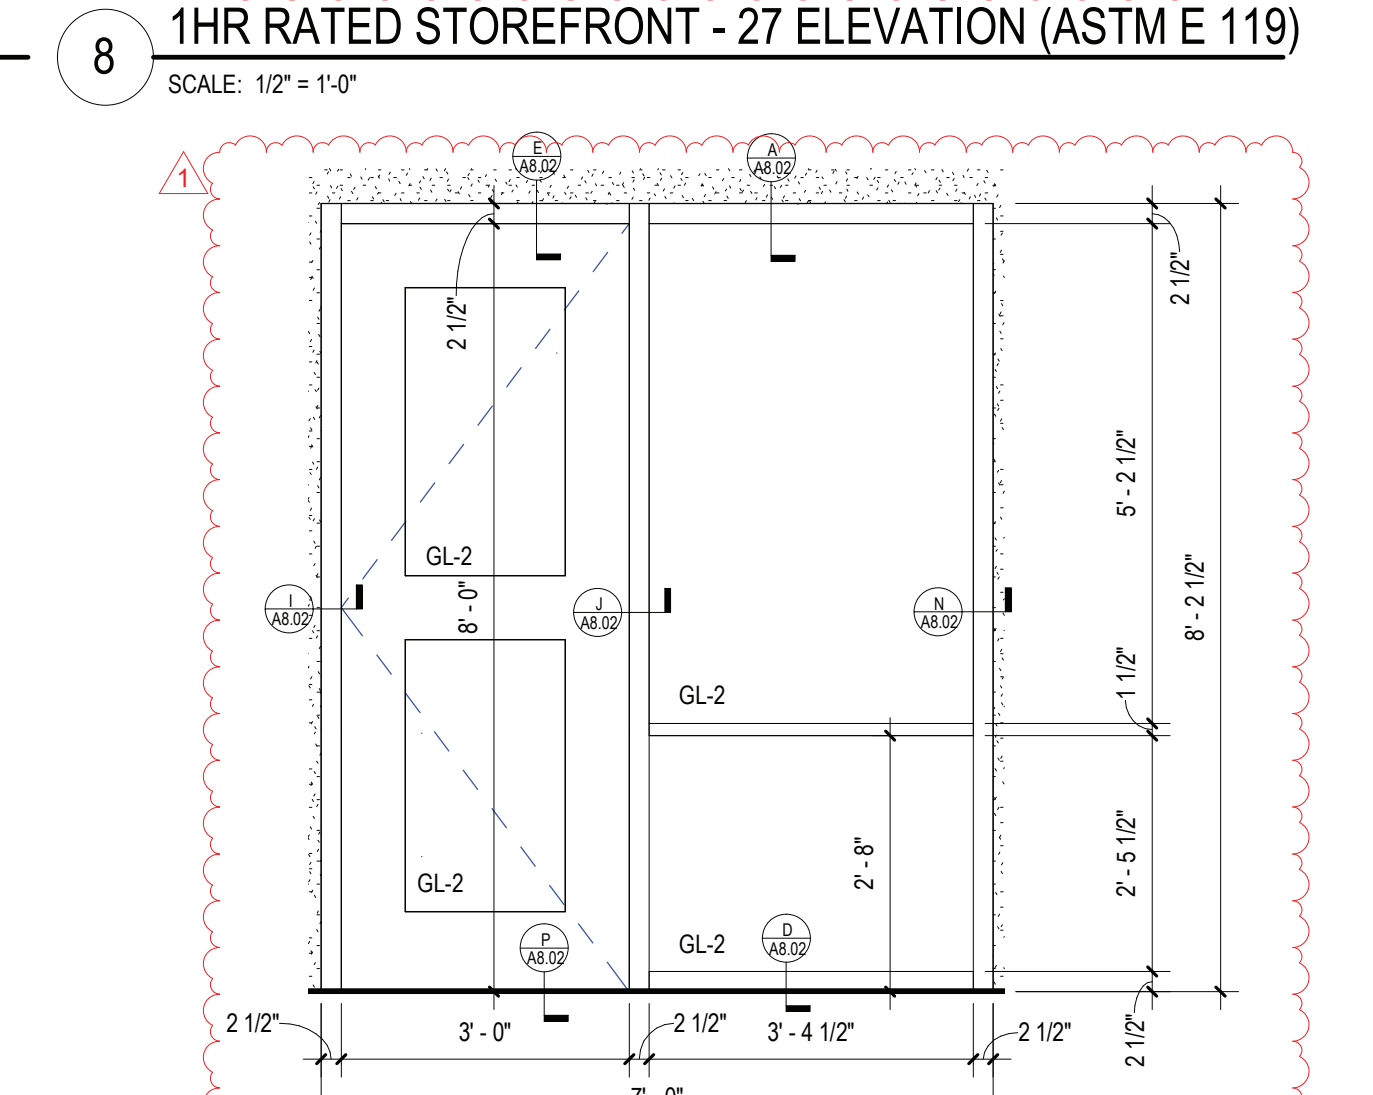


10 1HR RATED STOREFRONT - 28 ELEVATION (ASTM E 119)  
SCALE: 1/2" = 1'-0"

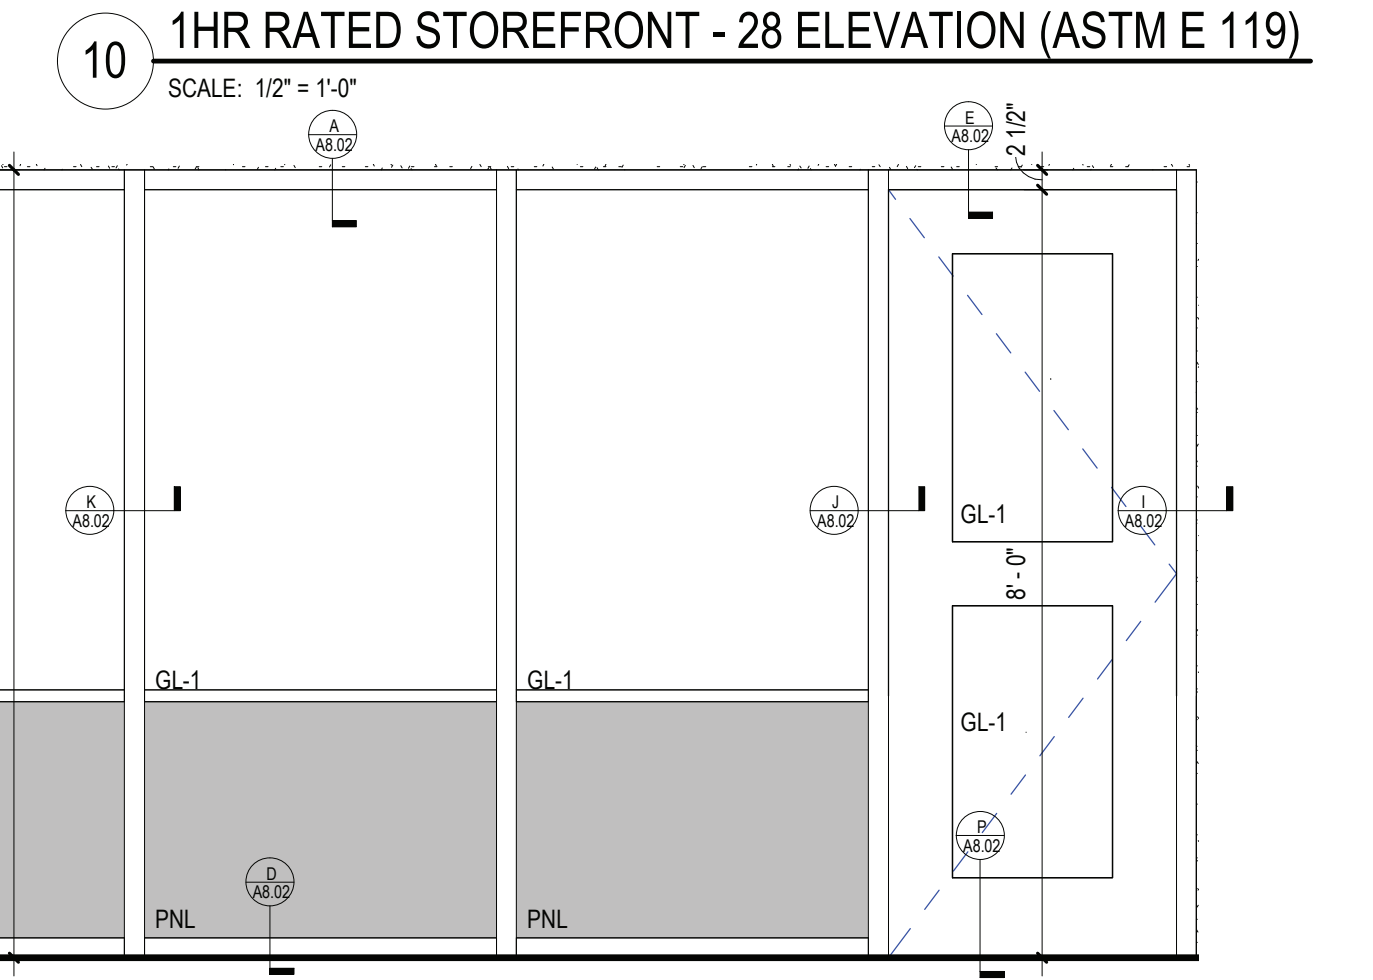

11 1HR RATED STOREFRONT - 27 ELEVATION (ASTM E 119)  
SCALE: 1/2" = 1'-0"

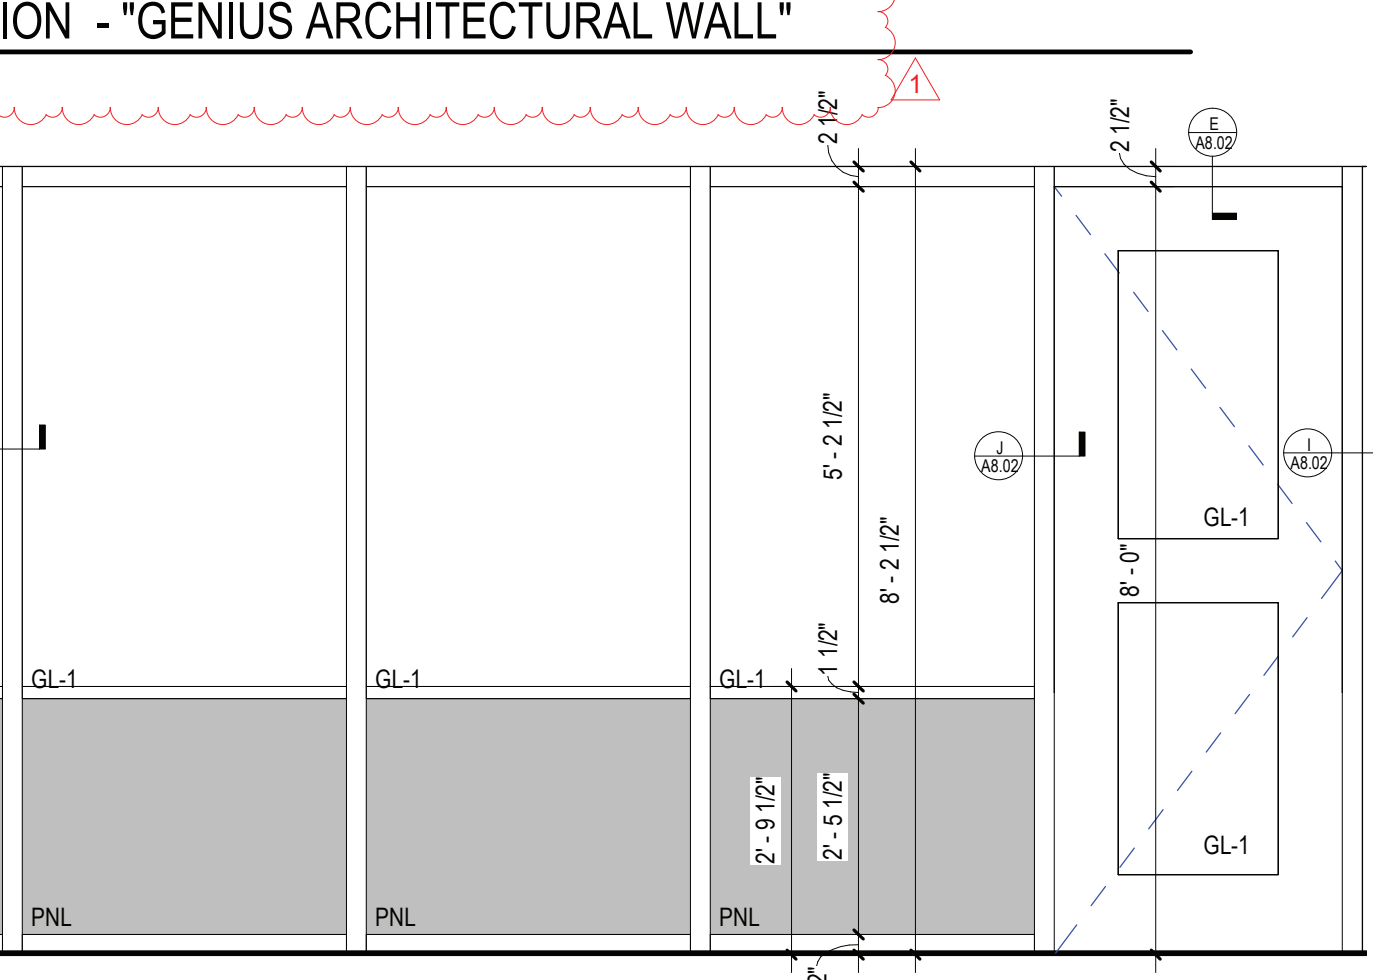

12 1HR RATED STOREFRONT - 28 ELEVATION (ASTM E 119)  
SCALE: 1/2" = 1'-0"

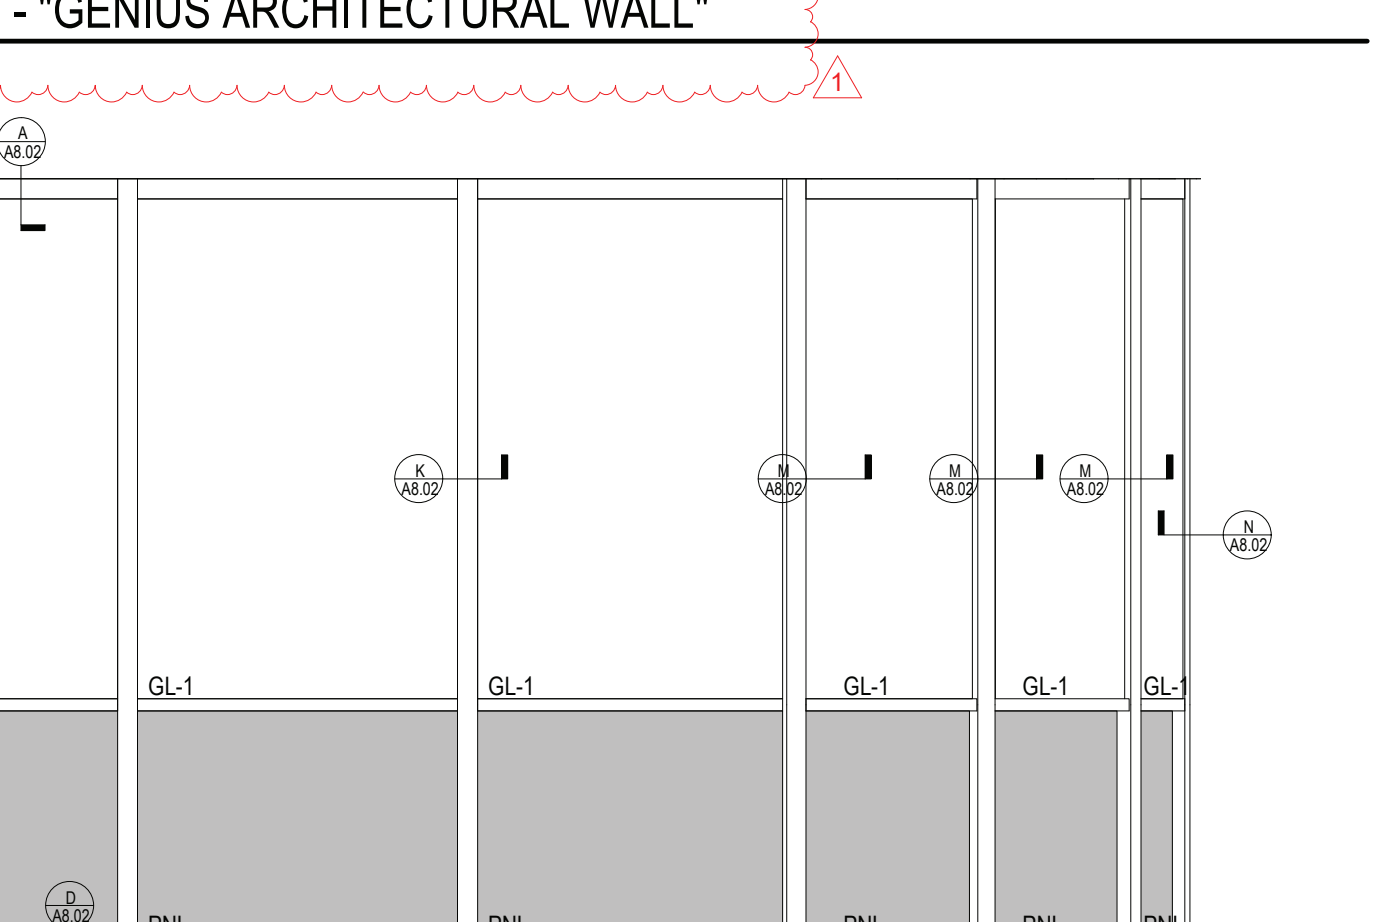

13 1HR RATED STOREFRONT - 27 ELEVATION (ASTM E 119)  
SCALE: 1/2" = 1'-0"



14 1HR RATED STOREFRONT - 28 ELEVATION (ASTM E 119)  
SCALE: 1/2" = 1'-0"



15 1HR RATED STOREFRONT - 27 ELEVATION (ASTM E 119)  
SCALE: 1/2" = 1'-0"

REV.	DATE	ITEM
1	11/28/2022	BID ADDENDUM #1

NOTICE  
THESE DRAWINGS ARE BASED ON CONSTRUCTION DRAWINGS NOT PREPARED BY BBS ARCHITECTS, LANDSCAPE ARCHITECTS AND ENGINEERS, P.C. AND THEREFORE, MAY NOT REPRESENT THE CONDITIONS AS CONSTRUCTED AT THE TIME. ALL EXISTING CONDITIONS SHOWN ARE REPRESENTED AS SUGGESTIVE INFORMATION AS THEY MAY NOT HAVE BEEN BUILT AND SHOULD BE THE ORIGINAL DOCUMENTS OF THE OWNER'S INFORMATION.

BRIARCLIFF MANOR U.F.S.D.  
PHASE 2 BOND IMPROVEMENTS  
BRIARCLIFF MANOR MIDDLE / HIGH SCHOOL  
444 PLEASANTVILLE RD. BRIARCLIFF MANOR, NY 10510

PROJECT  
DWG TITLE  
STOREFRONT PLANS AND ELEVATIONS

DRWG. BY: J.N.  
CHK. BY: G.E.O.

THIS DRAWING, PREPARED FOR THE SPECIFIC PROJECT INDICATED IS AN INSTRUMENT OF SERVICE AND THE PROPERTY OF BBS ARCHITECTS, LANDSCAPE ARCHITECTS AND ENGINEERS, P.C. REPRODUCTION OR ANY USE OF THIS DRAWING FOR ANY OTHER PROJECT IS PROHIBITED. ANY ALTERATION OR REPRODUCTION OF THIS DOCUMENT IS ALSO PROHIBITED WITHOUT THE WRITTEN CONSENT OF THE ARCHITECT OR ENGINEER.


BBS  
ARCHITECTS  
LANDSCAPE ARCHITECTS  
ENGINEERS  
BRANCH PROJECT CONTACT  
187 WOLF ROAD, STE. 205  
ALBANY, NEW YORK 12205  
T. 518.621.7650  
244 EAST MAIN STREET  
PATSCOQUE  
NEW YORK 11772  
T. 631.475.0349  
F. 631.475.0361  
www.bbsarchitecture.com

SED NO.  
66-14-02-02-0-004-023  
DISTRICT  
BRIARCLIFF MANOR U.F.S.D.  
PROJECT  
PHASE 2 BOND IMPROVEMENTS  
DWG TITLE  
STOREFRONT PLANS AND ELEVATIONS


SCALE: AS NOTED  
DATE: 11/14/2022  
BID PAI DATE: 11/14/2022  
FILE NO.: 21-274C

A8.04 HSMS




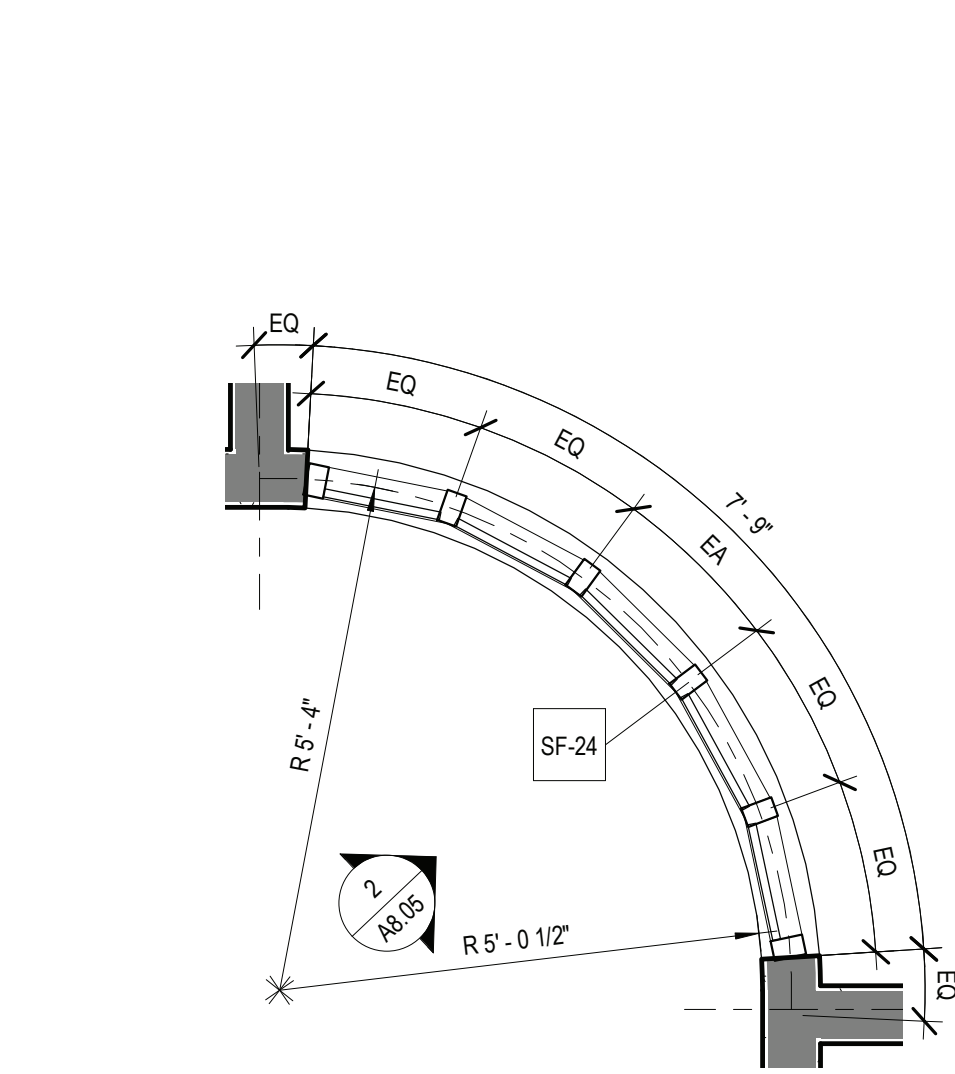


1 1HR RATED STOREFRONT PLAN - 24 (ASTM E 119)  
SCALE: 1/2" = 1'-0"

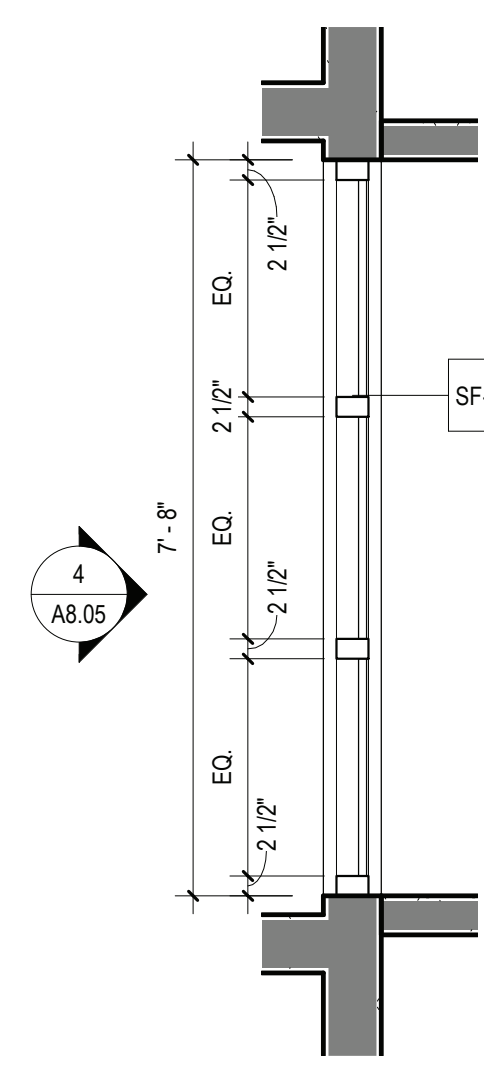


3 1HR RATED STOREFRONT PLAN - 26 (ASTM E 119)  
SCALE: 1/2" = 1'-0"

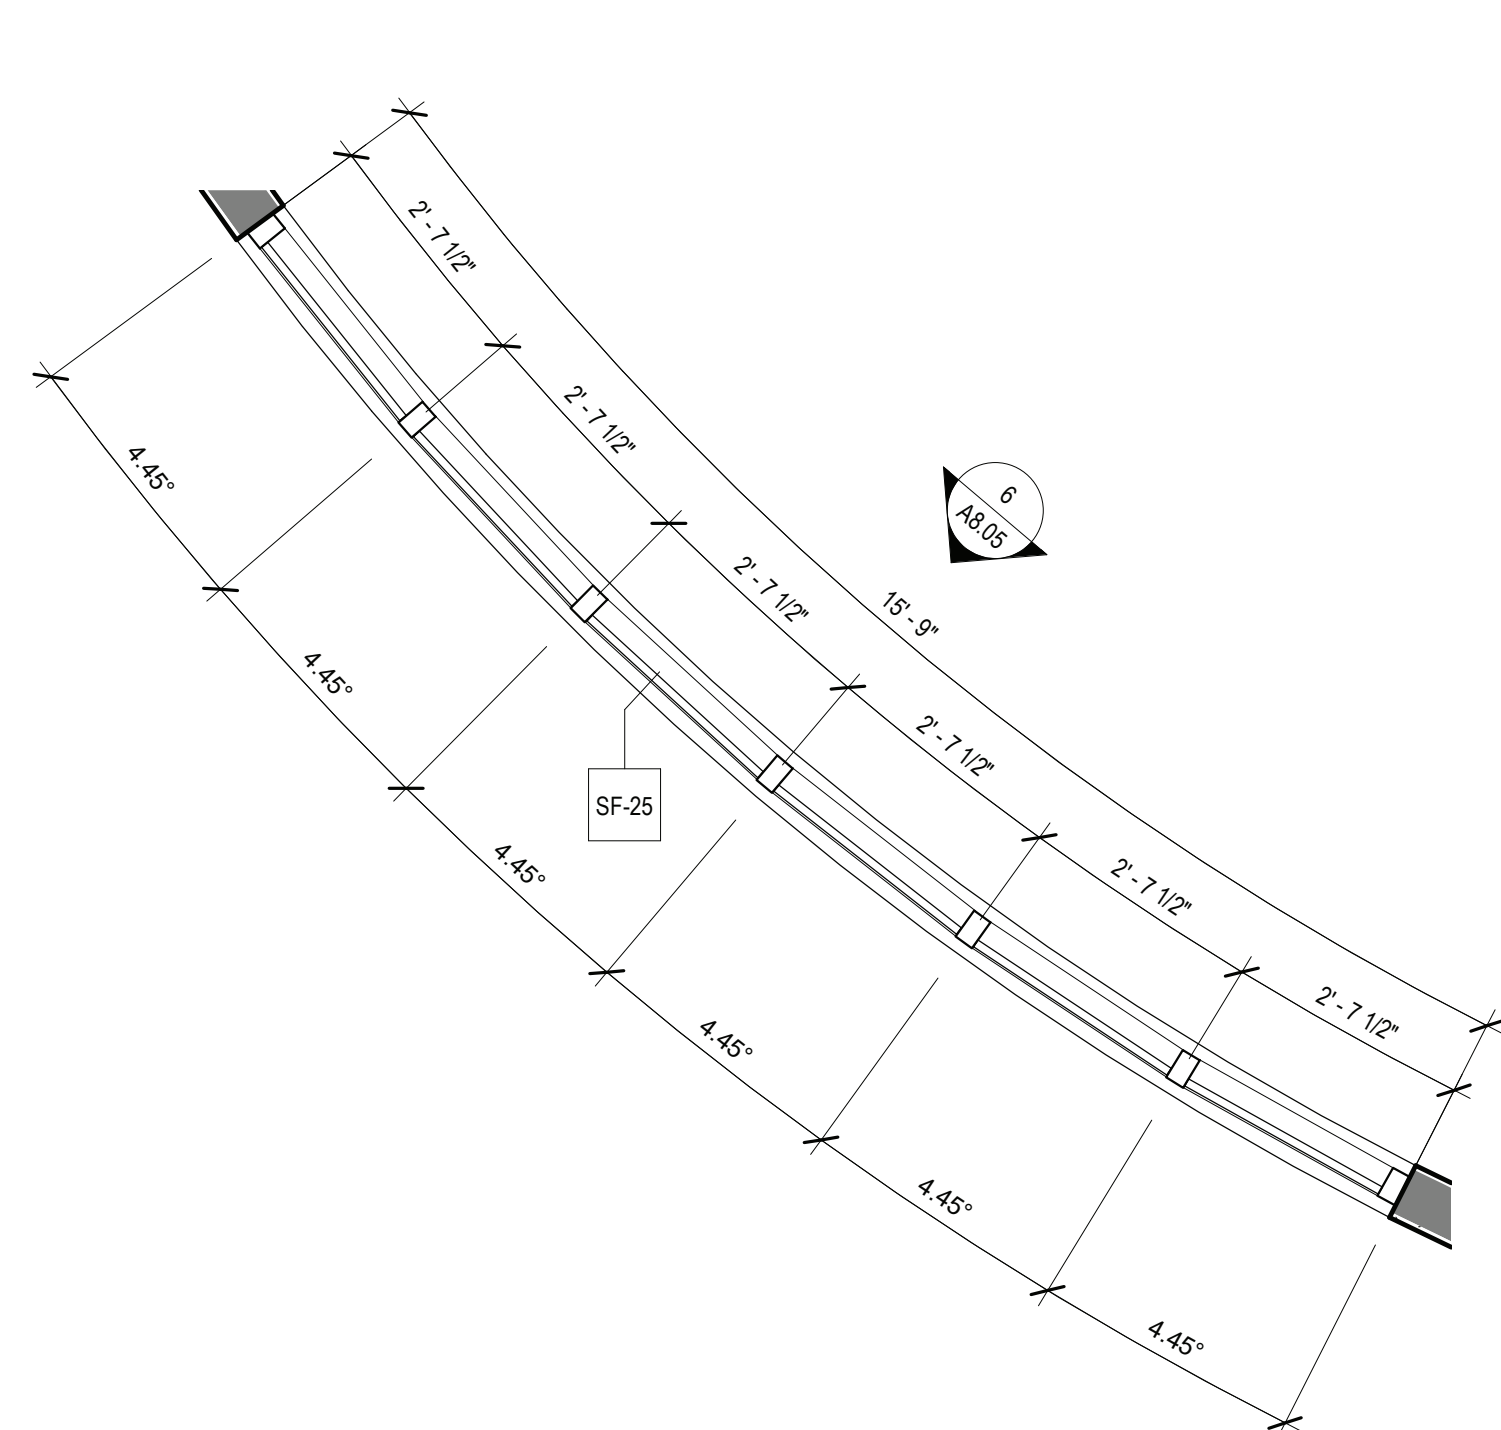


5 1HR RATED STOREFRONT PLAN - 25 (ASTM E 119)  
SCALE: 1/2" = 1'-0"

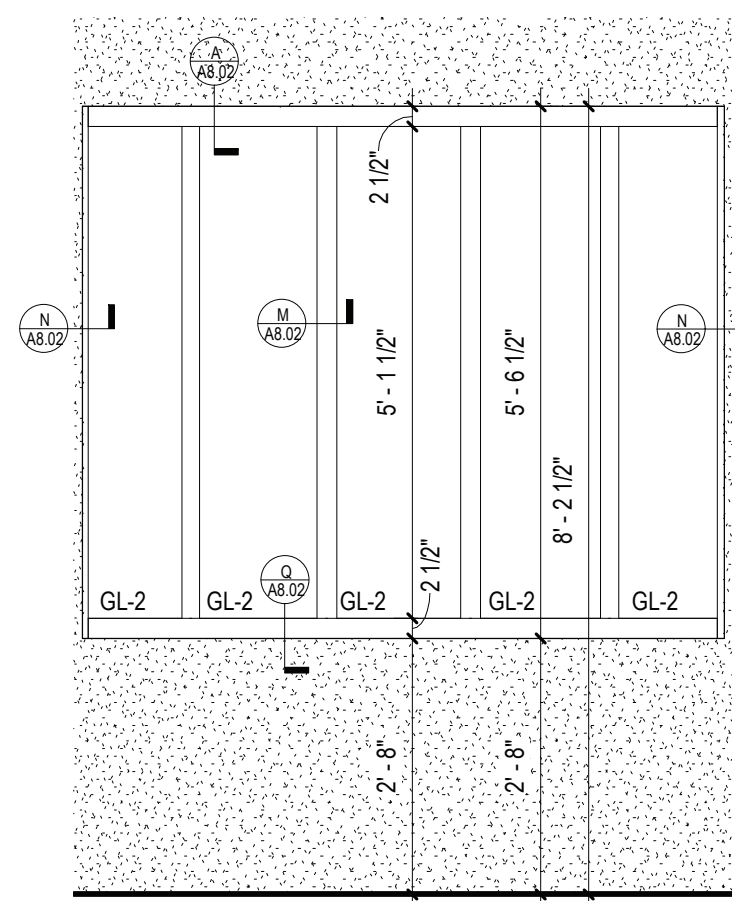


2 1HR RATED STOREFRONT - 24 ELEVATION (ASTM E 119)  
SCALE: 1/2" = 1'-0"

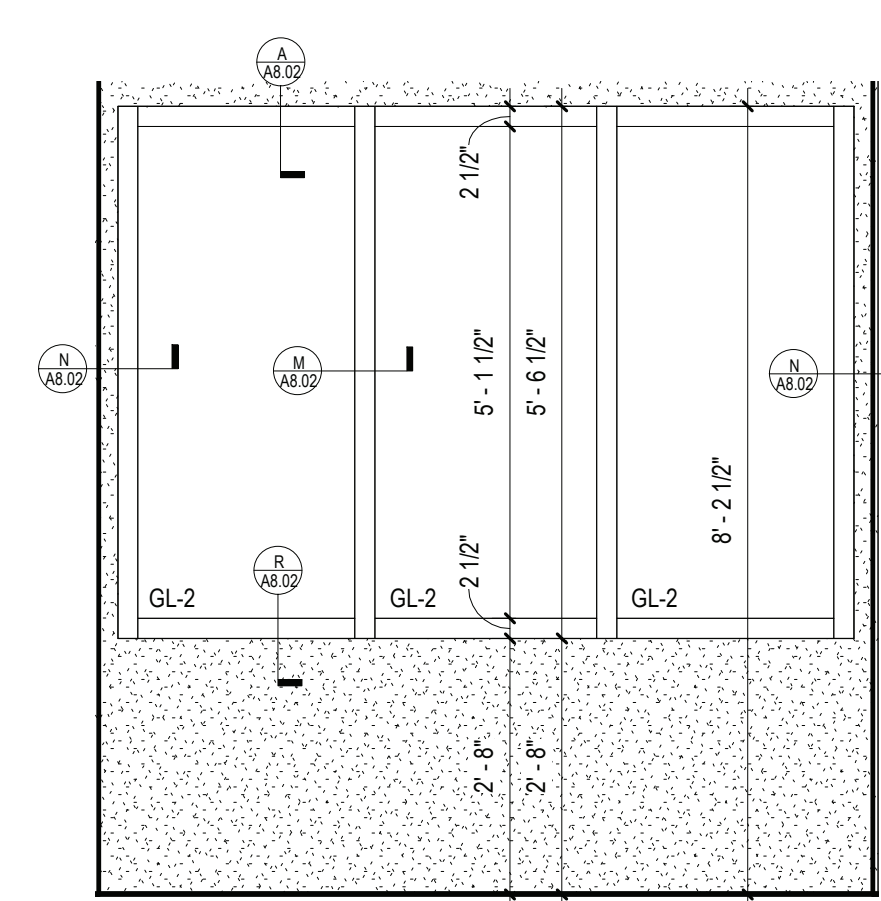


4 1HR RATED STOREFRONT - 26 ELEVATION (ASTM E 119)  
SCALE: 1/2" = 1'-0"

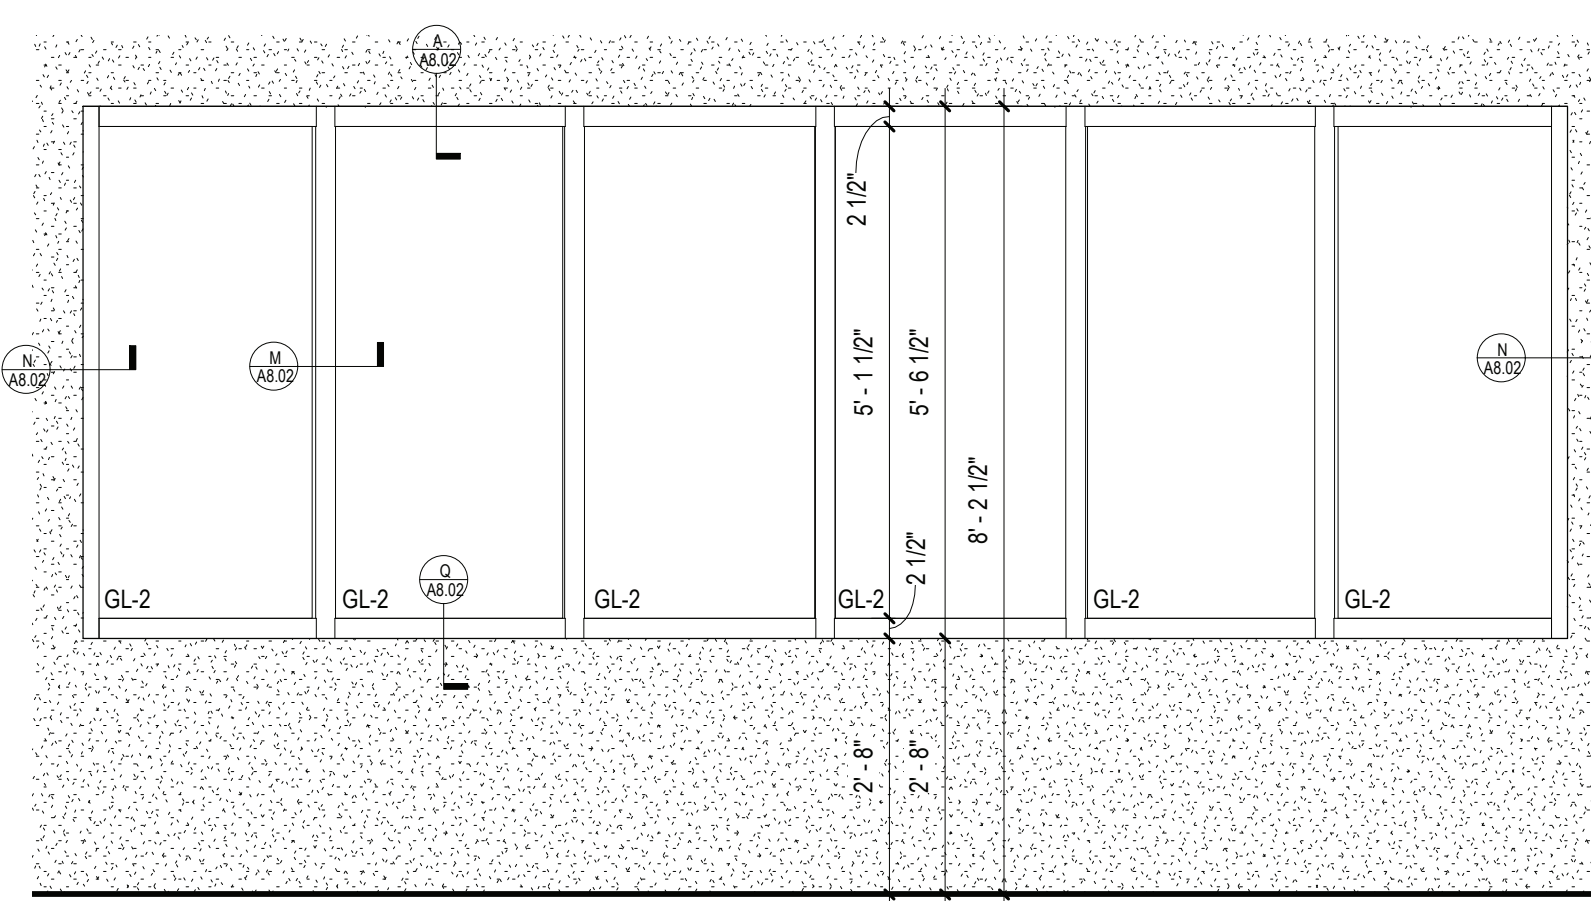


6 1HR RATED STOREFRONT - 25 ELEVATION (ASTM E 119)  
SCALE: 1/2" = 1'-0"

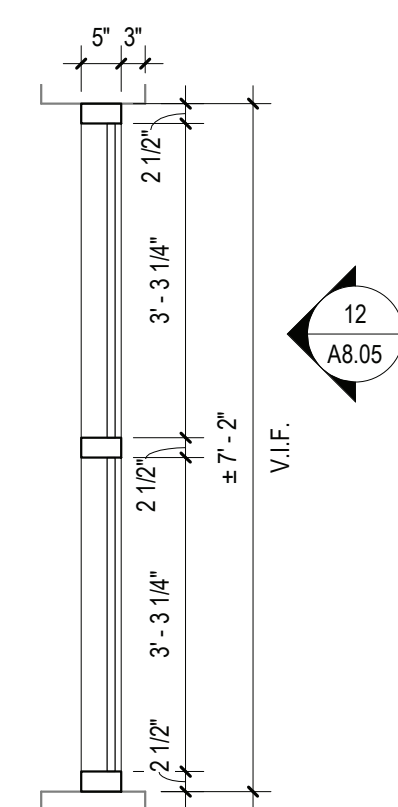


11 STOREFRONT PLAN - 29  
SCALE: 1/2" = 1'-0"

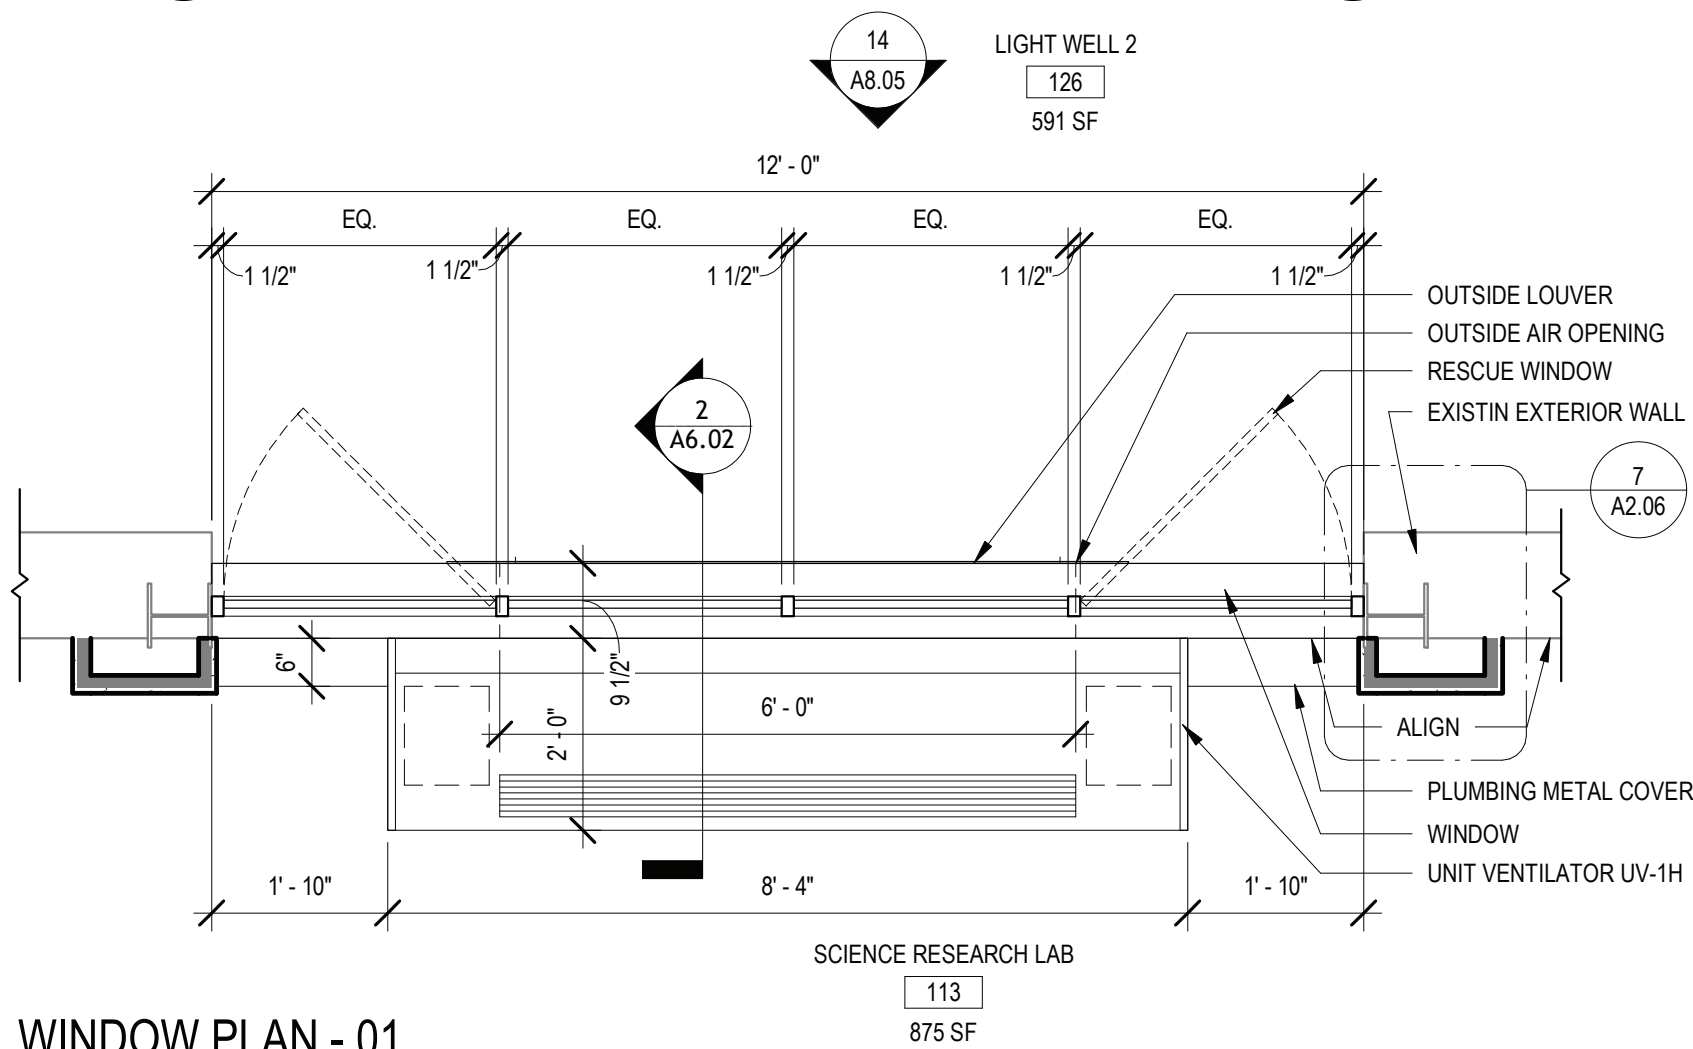


13 WINDOW PLAN - 01  
SCALE: 1/2" = 1'-0"

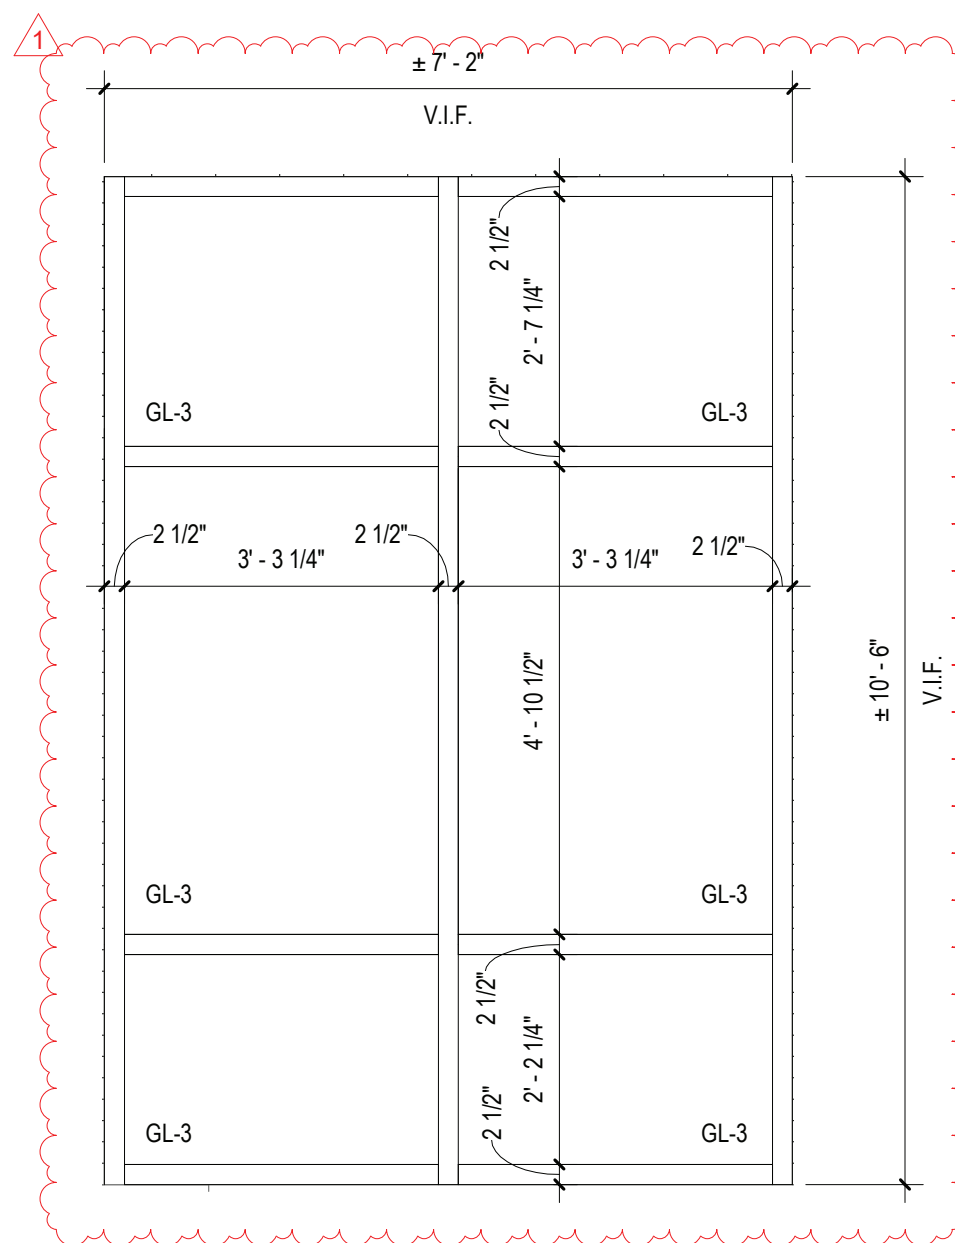


12 STOREFRONT - 29 ELEVATION  
SCALE: 1/2" = 1'-0"

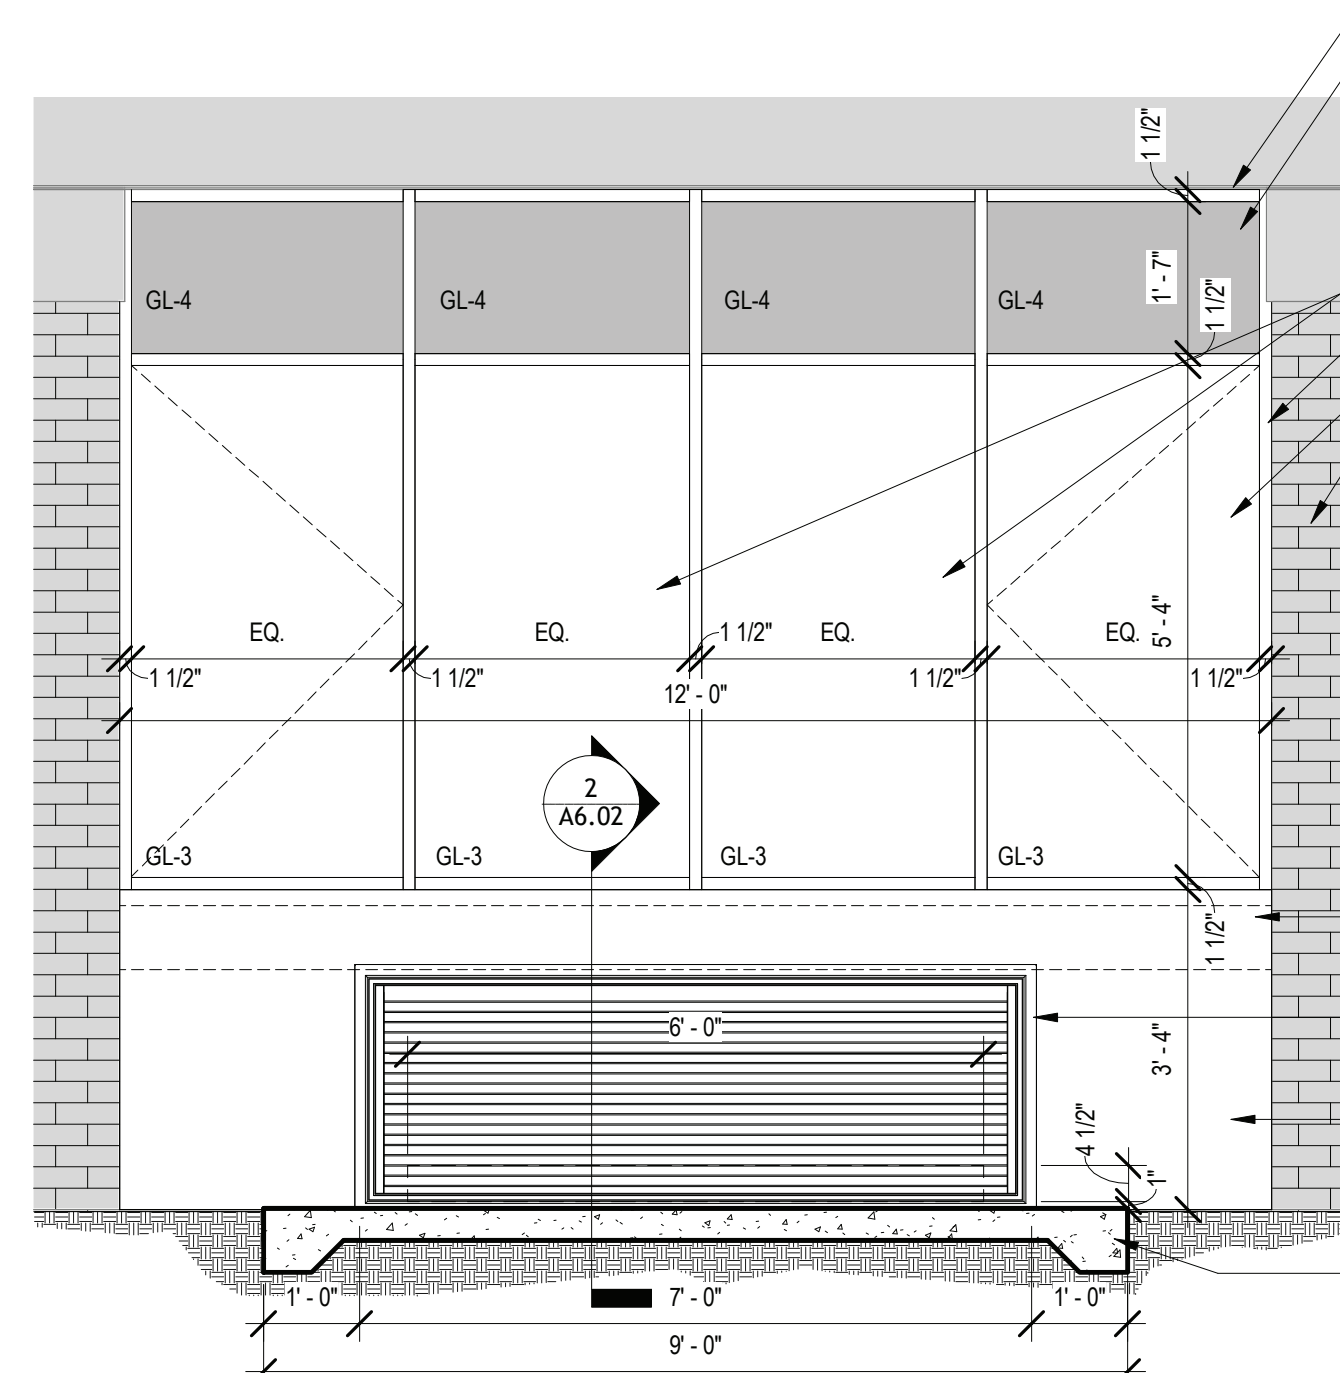


14 WINDOW - 01 ELEVATION  
SCALE: 1/2" = 1'-0"

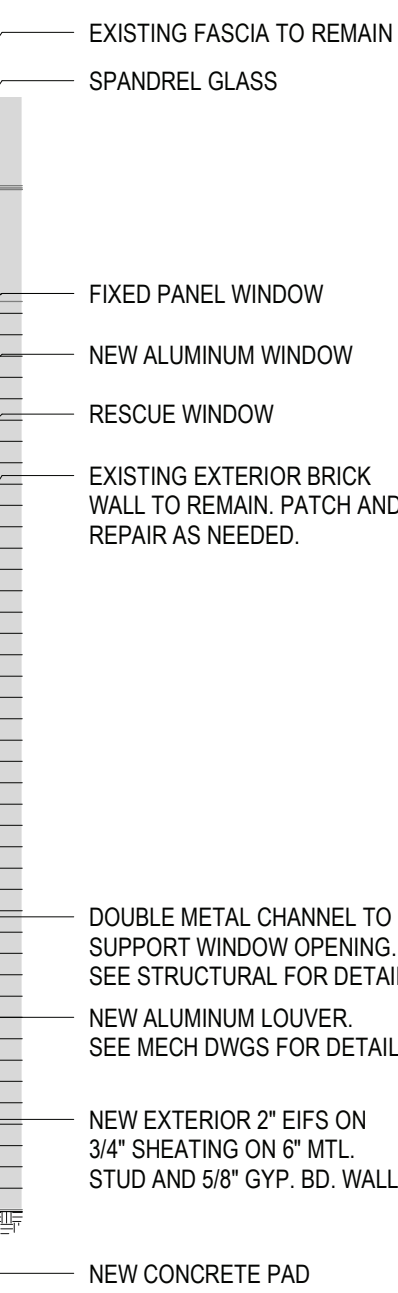


15 CORRIDOR B - DETAIL SECTION  
SCALE: 1 1/2" = 1'-0"

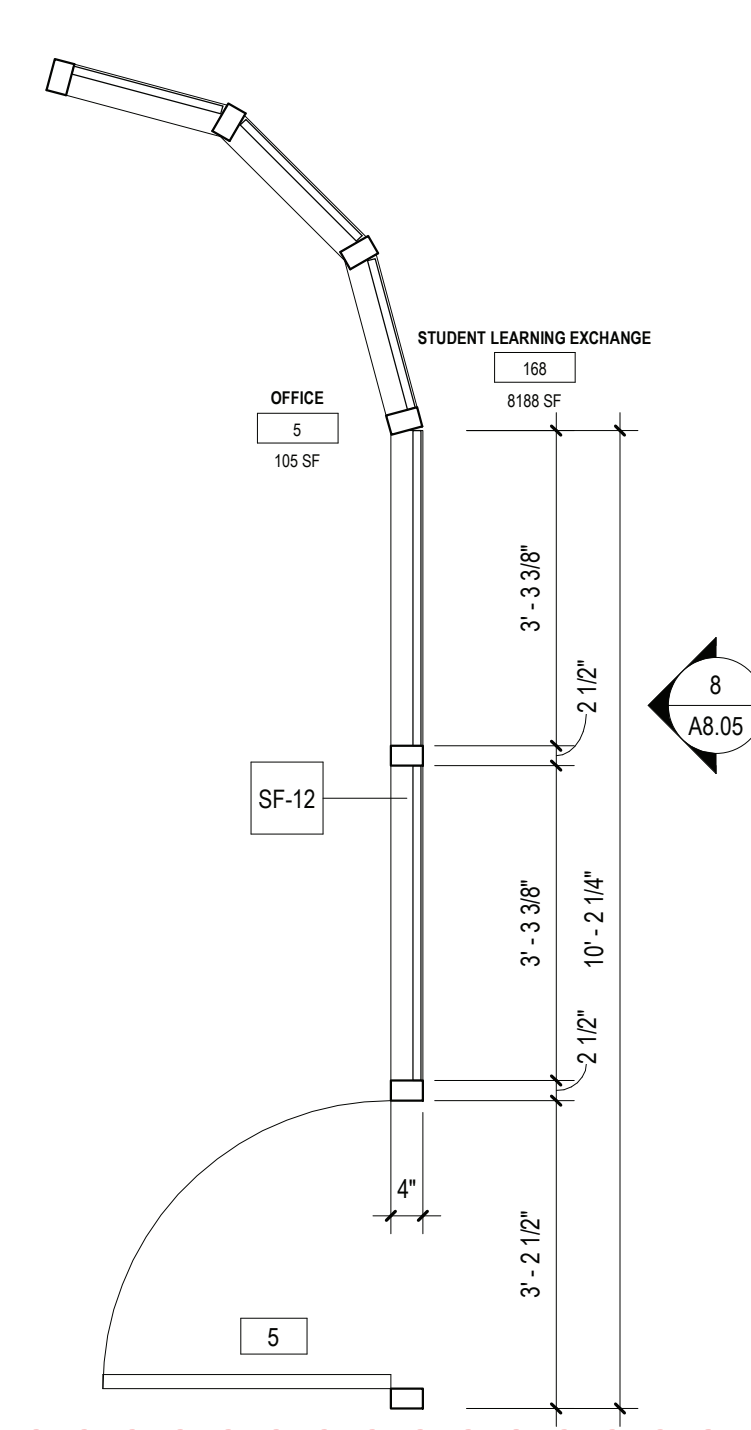


7 STOREFRONT PLAN - 12 "GENIUS ARCHITECTURAL WALL"  
SCALE: 1/2" = 1'-0"

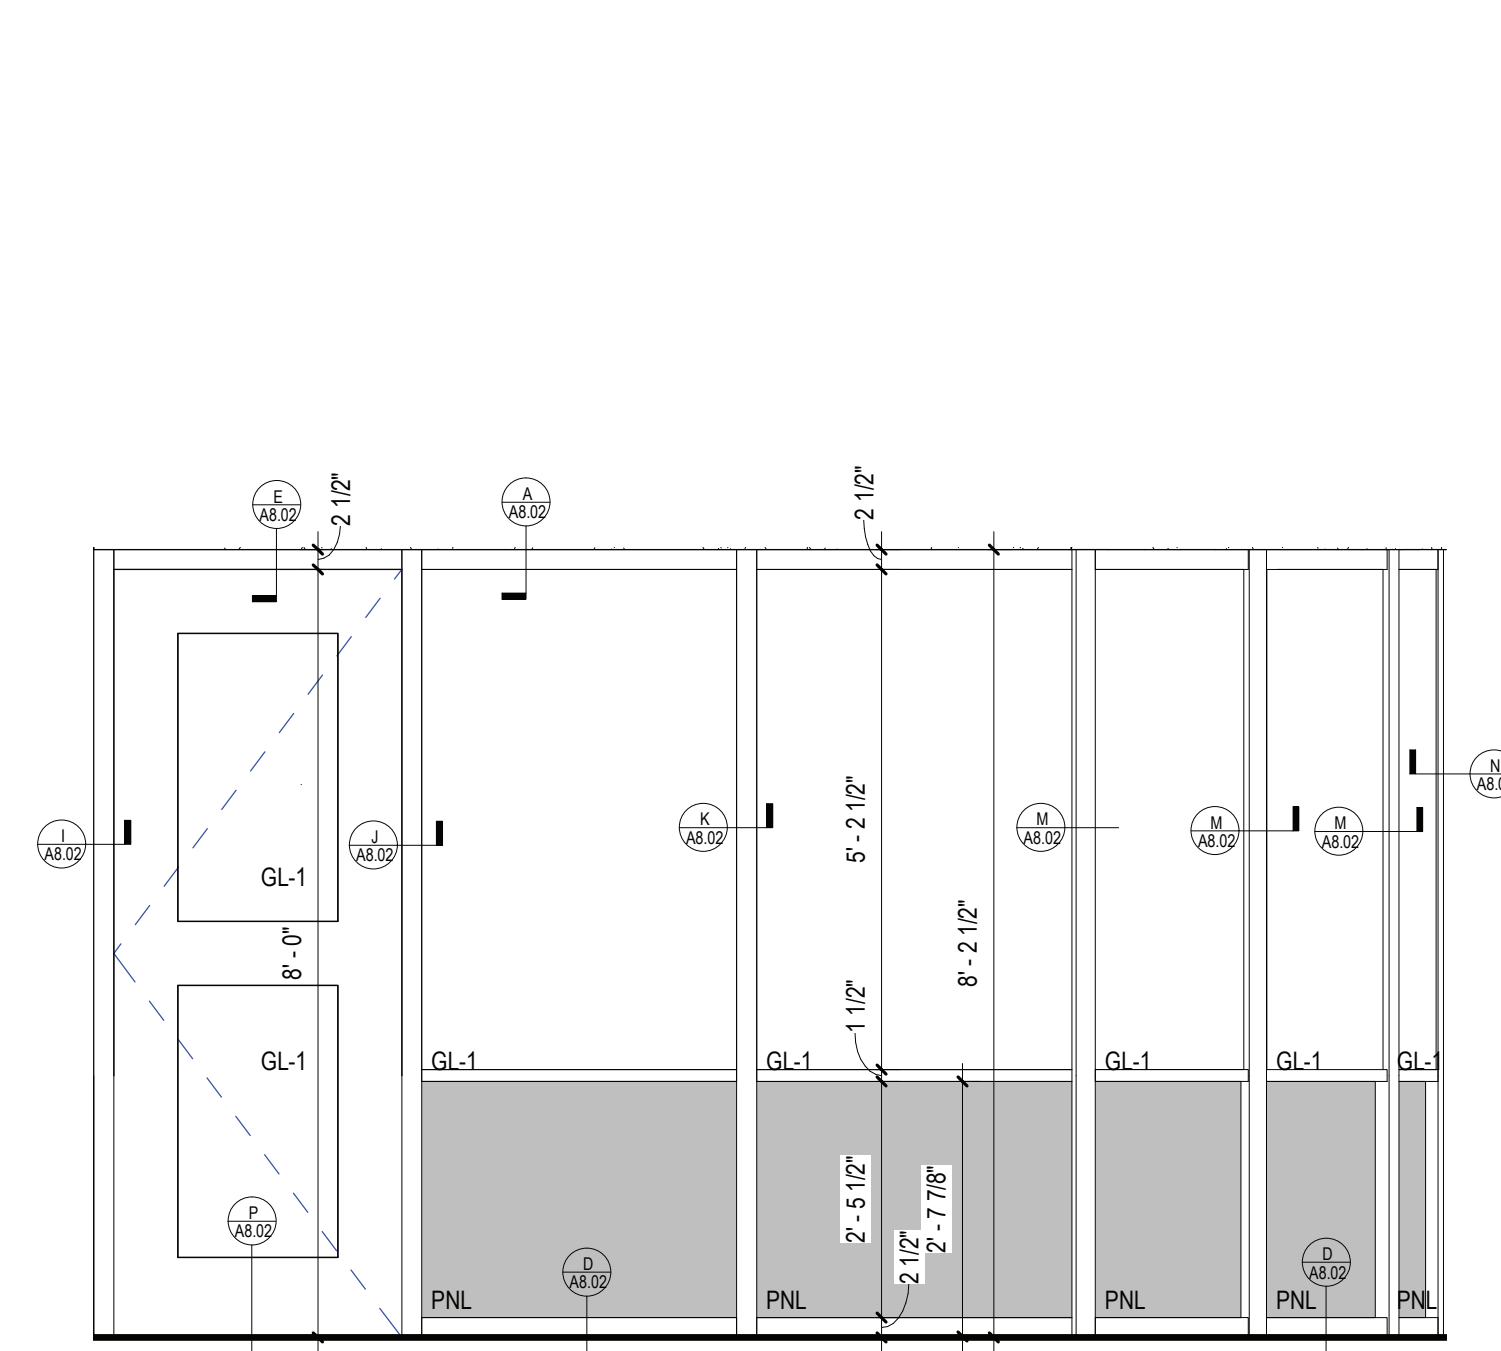



8 STOREFRONT - 12 ELEVATION "GENIUS ARCHITECTURAL WALL"  
SCALE: 1/2" = 1'-0"

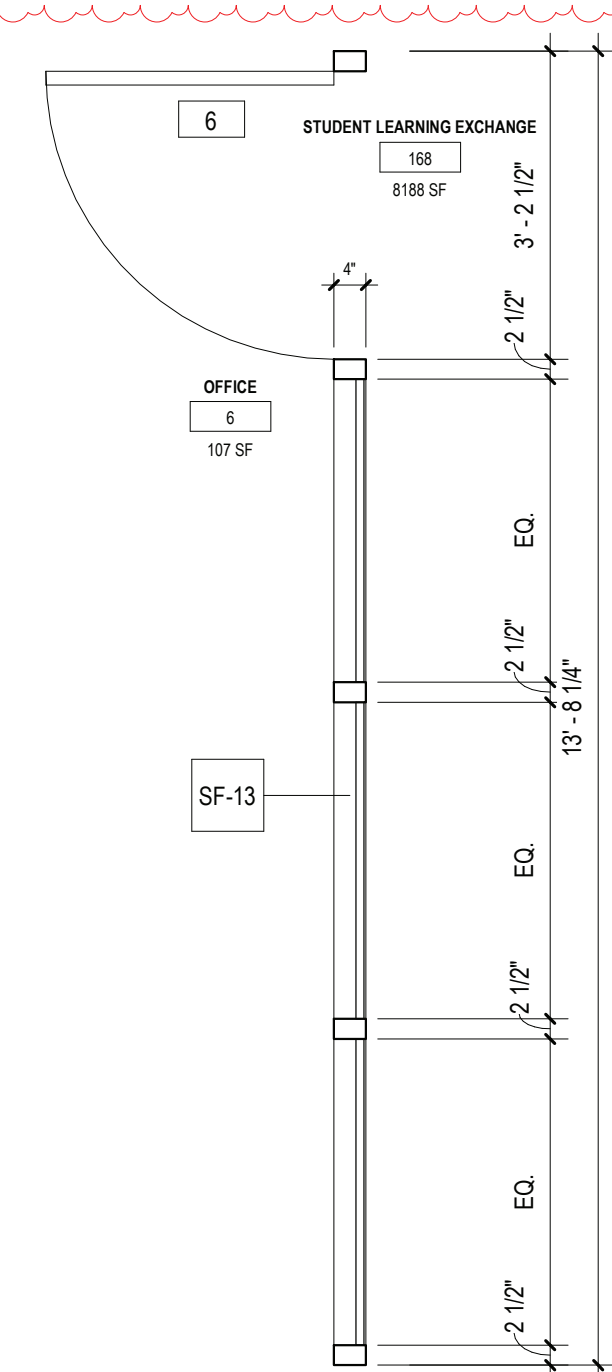

9 STOREFRONT PLAN - 13 "GENIUS ARCHITECTURAL WALL"  
SCALE: 1/2" = 1'-0"

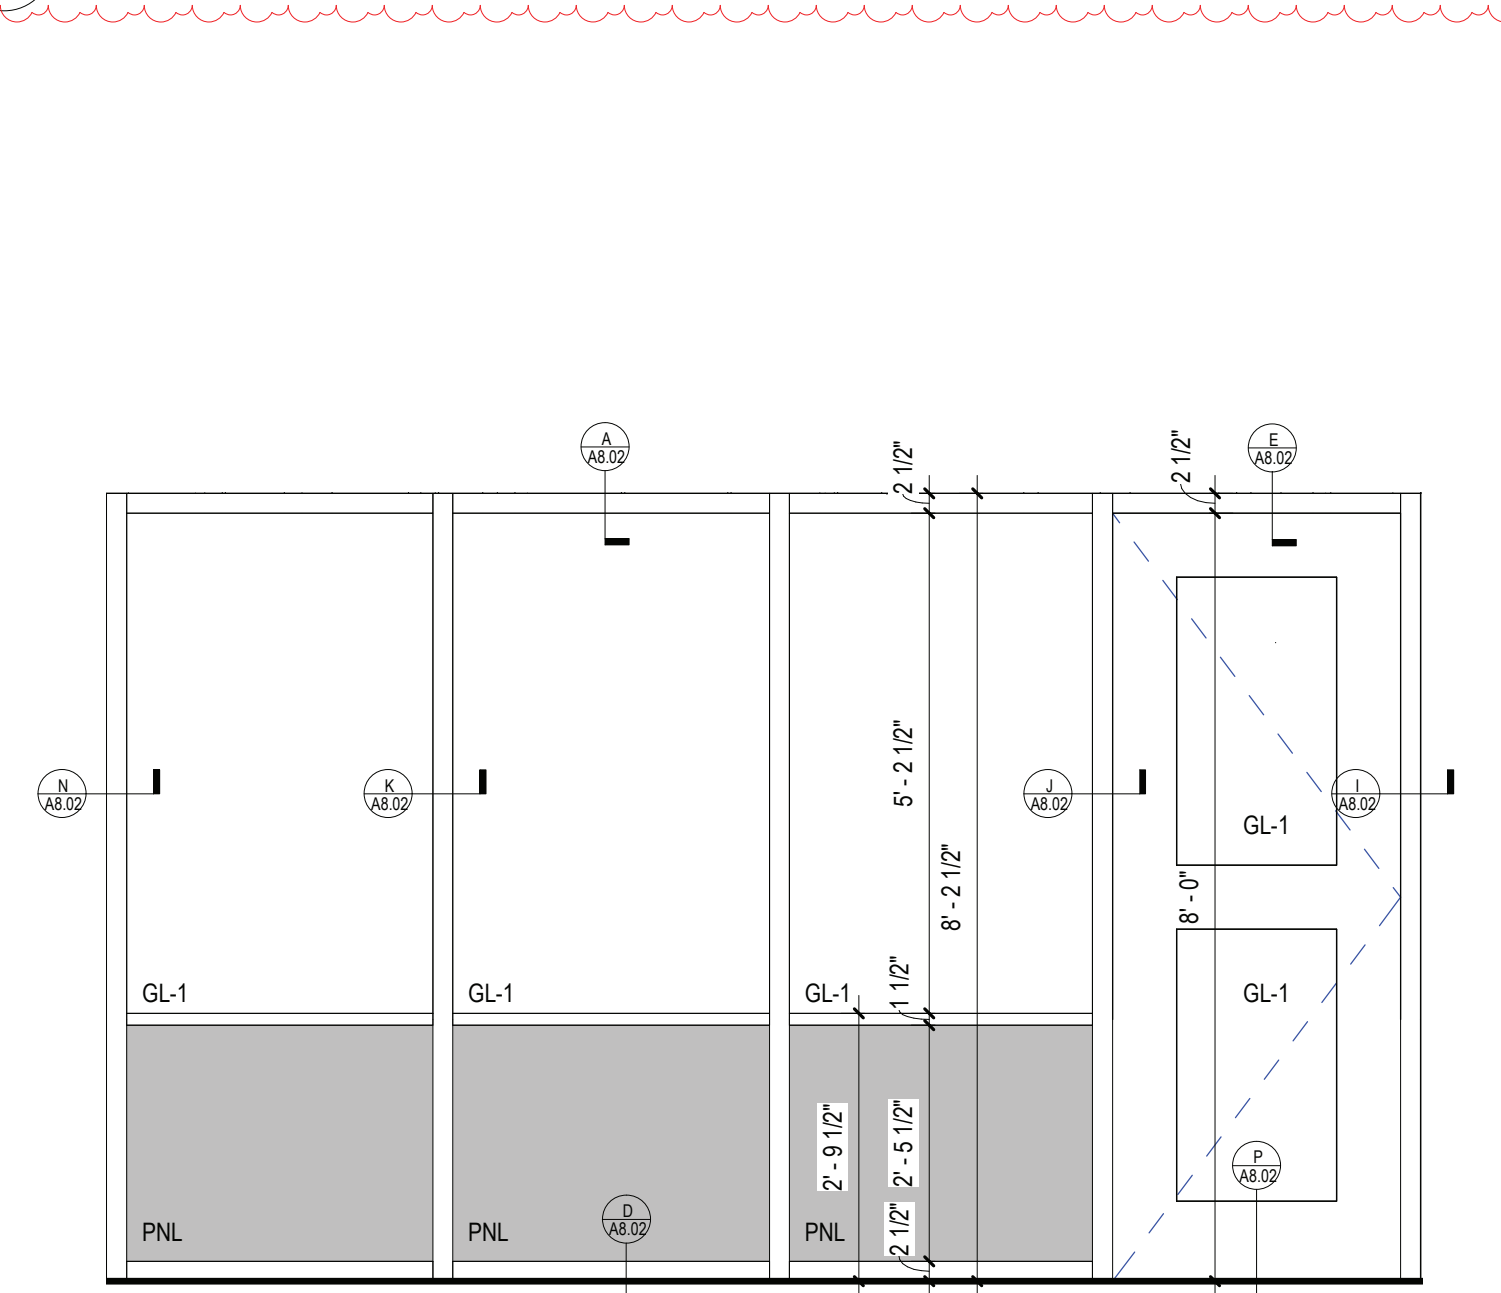

10 STOREFRONT - 13 ELEVATION "GENIUS ARCHITECTURAL WALL"  
SCALE: 1/2" = 1'-0"

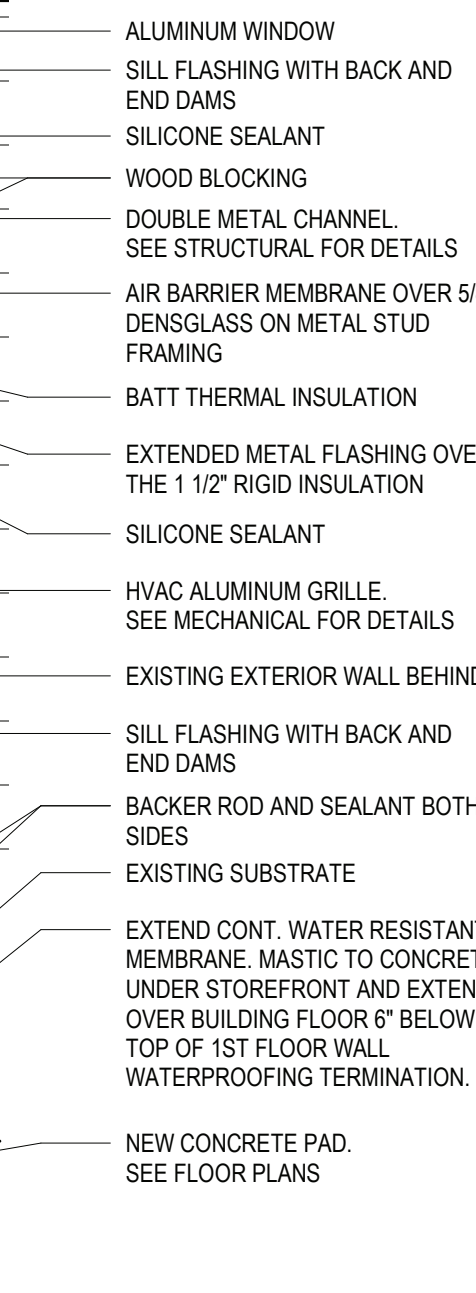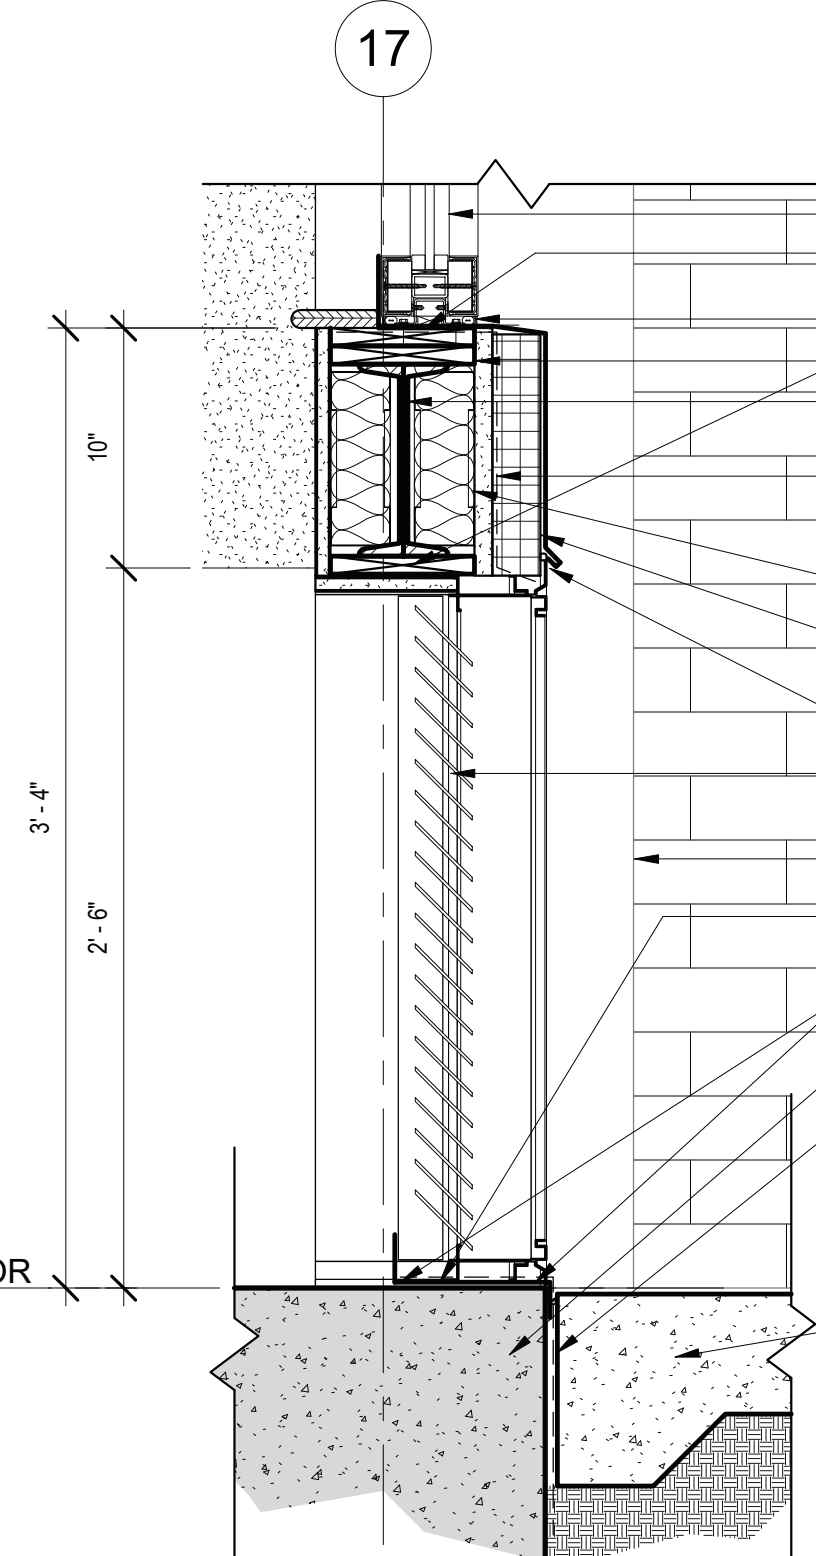

REV.	DATE	ITEM
1	11/28/2022	ADDENDUM #1

#### NOTICE

THESE DRAWINGS ARE BASED ON CONSTRUCTION DRAWINGS NOT PREPARED BY BBS ARCHITECTS, LANDSCAPE ARCHITECTS AND ENGINEERS, P.C. AND THEREFORE, MAY NOT REPRESENT THE CONDITIONS AS CONSTRUCTED AT THE TIME. ALL EXISTING CONDITIONS SHOWN ARE REPRESENTED AS SUGGESTIVE INFORMATION AS THEY MAY NOT HAVE BEEN BUILT AND DETAIL FOR THE ORIGINAL DOCUMENTS OR FOR THE OWNER'S INFORMATION.

BRIARCLIFF MANOR U.F.S.D.  
PHASE 2 BOND IMPROVEMENTS  
BRIARCLIFF MANOR MIDDLE / HIGH SCHOOL  
444 PLEASANTVILLE RD. BRIARCLIFF MANOR, NY 10510

STOREFRONT PLANS AND ELEVATIONS

PROJECT

DWG TITLE

DRWG. BY: Author  
CHK. BY: Checker

THIS DRAWING, PREPARED FOR THE SPECIFIC PROJECT INDICATED IS AN INSTRUMENT OF SERVICE AND THE PROPERTY OF BBS ARCHITECTS, LANDSCAPE ARCHITECTS AND ENGINEERS, P.C. REPRODUCTION OR ANY USE OF THIS DRAWING FOR ANY OTHER PROJECT IS PROHIBITED. ANY ALTERATION OR REPRODUCTION OF THIS DOCUMENT IS ALSO PROHIBITED WITHOUT THE WRITTEN CONSENT OF THE ARCHITECT OR ENGINEER.

**BBS**  
ARCHITECTS  
LANDSCAPE ARCHITECTS  
ENGINEERS

BRANCH PROJECT CONTACT  
187 WOLF ROAD, STE. 205  
ALBANY  
NEW YORK 12205  
T: 518.621.7650

244 EAST MAIN STREET  
PATSCOQUE  
NEW YORK 11772  
T: 631.475.0349  
F: 631.475.0361

www.bbsarchitecture.com

SED NO. 66-14-02-02-0-004-023

DISTRICT BRIARCLIFF MANOR U.F.S.D.

PROJECT PHASE 2 BOND IMPROVEMENTS

DWG TITLE STOREFRONT PLANS AND ELEVATIONS

SCALE: AS NOTED

DATE: -

BID PAU DATE: 11/14/2022

FILE NO. 21-274C

A8.05 HSMS



WALL TYPES:

TYPE P1:	PAINT BY SHERWIN WILLIAMS LATEX EGGSHELL ENAMEL COLOR: EXTRA WHITE SW7006 (CEILING)	TYPE P2:	PAINT BY SHERWIN WILLIAMS LATEX FLAT ENAMEL COLOR: DENIM SW6523 (CEILING ACCENT - BLUE)
TYPE P3:	PAINT BY SHERWIN WILLIAMS LATEX EGGSHELL ENAMEL COLOR: BIG CHILL SW7648 (GENERAL WALLS)	TYPE P4:	PAINT BY SHERWIN WILLIAMS LATEX EGGSHELL ENAMEL COLOR: DENIM SW6523 (ACCENT A - BLUE)
TYPE P5:	PAINT BY SHERWIN WILLIAMS LATEX EGGSHELL ENAMEL COLOR: ROBUST ORANGE SW6628 (ACCENT B - ORANGE)	TYPE P6:	PAINT BY SHERWIN WILLIAMS LATEX EGGSHELL ENAMEL COLOR: DAPHNE SW9161 (ACCENT C- LIGHT BLUE)
TYPE P7:	PAINT BY SHERWIN WILLIAMS LATEX EGGSHELL ENAMEL COLOR AS SELECTED BY ARCHITECT (CORRIDOR)	TYPE P8:	PAINT BY SHERWIN WILLIAMS LATEX EGGSHELL ENAMEL COLOR AS SELECTED BY ARCHITECT (CORRIDOR)
TYPE P9:	PAINT BY SHERWIN WILLIAMS LATEX SEMI-GLOSS ENAMEL COLOR: AS SELECTED BY ARCHITECT (TOILET)	TYPE WC1:	WALLTALKERS MAG-RITE (M248) - MAGNETIC, WRITABLE WALL SURFACE AS MANUFACTURED BY KOROSEAL OR EQUAL, PROVIDE FLOOR TO CEILING- LEVEL 5 GYP. BOARD FINISH REQUIRED FOR INSTALLATION.
TYPE CT-1:	4" X 12" CERAMIC WALL TILE MANUFACTURER: AMERICAN OLEAN COLLECTION: COLORSTORY WALL COLOR: MATTE DESIGNER WHITE 0061  NOTE: GROUT FOR CT1 TO BE CUSTOM - #381 BRIGHT WHITE, SPACED AT 1/8" UNLESS OTHERWISE NOTED.	TYPE CT-2:	4" X 12" CERAMIC WALL TILE MANUFACTURER: AMERICAN OLEAN COLLECTION: COLORSTORY WALL COLOR: SAPPHIRE SKY 0070  NOTE: GROUT FOR CT2 TO BE CUSTOM - #381 BRIGHT WHITE, SPACED AT 1/8" UNLESS OTHERWISE NOTED.
TYPE CT-3:	4" X 12" CERAMIC WALL TILE MANUFACTURER: AMERICAN OLEAN COLLECTION: COLORSTORY WALL COLOR: BLAZE 0029  NOTE: GROUT FOR CT3 TO BE CUSTOM - #381 BRIGHT WHITE, SPACED AT 1/8" UNLESS OTHERWISE NOTED.		

FLOOR MATERIAL TYPES

TYPE VCT1:	12" X 12" VINYL COMPOSITION TILE MANUFACTURER: ARMSTRONG EXCELCOR IMPERIAL FIELD COLOR: SOFT WARM GRAY S1861 ACCENT VCT1A: GO BLUE S7531 ACCENT VCT1B: SCREAMIN' PUMPKIN S7516	TYPE LVT1:	7"x8" LUXURY VINYL TILE MANUFACTURER: PATCRAFT STYLE: RESTON 20 MIL COLOR: 00730 ANISE-V2
TYPE CPT1:	24" X 24" CARPET TILE MANUFACTURER: TARKETT STYLE: COLORKIT COLOR: 30230 REGAL BLUE	TYPE CT-4:	8" X 8" CERAMIC FLOOR TILE MANUFACTURER: CREATIVE MATERIAL CO. COLLECTION: FRAMMENTO COLOR: BEIGE MACRO - NATURAL - RECTIFIED (BEIGE TERRAZZO)  NOTE: GROUT FOR CT4 TO BE CUSTOM - #380 HAYSTACK, SPACED AT 1/16" UNLESS OTHERWISE NOTED.

BASE TYPES:

TYPE RCB1:	4" RUBBER COVE BASE BY TARKETT COLOR: BLUE INTENSITY TH2	TYPE RCB2:	4" RUBBER COVE BASE BY TARKETT COLOR: SHORELINE 280
TYPE RCB3:	RUBBER COVE BASE BY "JOHNSONITE" LATEX EGGSHELL ENAMEL COLOR AS SELECTED BY ARCHITECT (CORRIDORS)	TYPE RCB4:	RUBBER COVE BASE BY "JOHNSONITE" LATEX EGGSHELL ENAMEL COLOR AS SELECTED BY ARCHITECT (OFFICES)
TYPE CT-5:	8" X 8" CERAMIC FLOOR TILE MANUFACTURER: CREATIVE MATERIAL CO. COLLECTION: FRAMMENTO COLOR: BEIGE MACRO - NATURAL - RECTIFIED (BEIGE TERRAZZO)  NOTE: GROUT FOR CT5 TO BE CUSTOM - #380 HAYSTACK, SPACED AT 1/16" UNLESS OTHERWISE NOTED.		

CEILING TILE TYPES:

TYPE ACT1:	ACOUSTIC CEILING TILE BY "ARMSTRONG" SIZE: 24" X 24" X 3/4" STYLE: #1911 ULTIMA BEVELED REGULAR (CORRIDORS/CLASSROOMS)	TYPE ACT2:	ACOUSTIC CEILING TILE BY "ARMSTRONG" SIZE: 24" X 24" X 5/8" STYLE: #170 CORTESA SQUARE LAY-IN (STORAGE ROOMS/CUSTODIAL)
TYPE ACT3:	ACOUSTIC CEILING TILE BY "ARMSTRONG" SIZE: 24" X 24" X 1" RNC RATING 95 STYLE: # 3250 OPTIMA SQUARE REGULAR (STUDENT LEARNING EXCHANGE/OFFICES)	TYPE ACT4:	ACOUSTIC CEILING BY "CERTAINTEE" SIZE: 8" DEEP X 2" THICK STYLE: TYPE 10 DECOUSTICS RONDOLLO BAFFLES COLOR(S) AS SELECTED BY ARCH. (STUDENT LEARNING EXCHANGE)
TYPE ACT5:	ACOUSTIC CEILING TILE BY "ARMSTRONG" SIZE: 24" X 24" X 3/4" STYLE: # 1535 ULTIMA HEALTH ZONE SQUARE LAY-IN (TOILET ROOMS)	CEILING GRID:	CEILING GRID BY "ARMSTRONG", 1516" PRELUDE, WHITE, U.O.N.  NOTE: ALL CEILING TILE & GRID TO BE WHITE UNLESS OTHERWISE NOTED.

GROUT TYPES:

TYPE GRT1:	GRT1: 1/8" GROUT MANUFACTURER: CUSTOM BUILDING PRODUCTS COLOR: #11 SNOW WHITE	TYPE GRT2:	GRT2: 1/16" GROUT MANUFACTURER: CUSTOM BUILDING PRODUCTS COLOR: #380 HAYSTACK
------------	-------------------------------------------------------------------------------------	------------	-------------------------------------------------------------------------------------

TACKBOARDS:

TB1: TACK BOARDS.  
COLOR: AS PER ARCHITECT

WINDOW TREATMENTS:

TYPE WS1: DRAPER CLUTCH OPERATED FLEXSHADE,  
PHIFER SHEARWEAVE PW 2800, 1% OPEN  
COLOR AS SELECTED BY ARCHITECT  
(ALL EXTERIOR WINDOWS, U.O.N.)

TYPE WS2: DRAPER CLUTCH OPERATED FLEXSHADE,  
PHIFER SHEARWEAVE PW 2800, SOLID  
COLOR AS SELECTED BY ARCHITECT  
(ALL INTERIOR WINDOWS @ MEDIA CENTER)

NOTES:  
1. PROVIDE (1) PER WINDOW UNIT  
2. GC SHALL SUBMIT SHOP DRAWINGS AND SAMPLES FOR  
APPROVAL BY ARCHITECT.

ACOUSTICAL WALL PANEL:

AP: 1" HARDSIDE FABRIC WRAPPED  
ACOUSTICAL WALL PANEL AS MANUFACTURED  
BY KINETICS NOISE CONTROL OR EQUAL  
FABRIC: PALETTE 2155 BY GUILFORD OF MAINE  
COLOR: AS PER ARCHITECT

WRITABLE WALL COVERING

- WALLTALKERS WALLCOVERINGS: AS MANUFACTURED BY  
KOROSEAL INTERIOR PRODUCTS, LLC, 3875 EMBASSY PARKWAY,  
SUITE 110, FAIRLAWN, OHIO 44333, TELEPHONE: (855)753-5474,  
EMAIL: INFO@KOROSEAL.COM, OR APPROVED EQUAL.
- WALLTALKERS TO BE WRITE-ABLE WITH MAGNETIC  
CAPABILITIES AND WILL EXTEND ENTIRE LENGTH OF WALL,  
FLOOR TO CEILING. WALLTALKERS TO BE WHITE WITH  
ALUMINUM J-CAP TRIM, SEMI-GLOSS (PRODUCT CODE M248).
- ACCESSORIES - 1 SET REQUIRED FOR EACH ROOM.  
INCLUDE THE FOLLOWING:  
a. ONE SILVER ANODIZED ALUMINUM MARKER CADDY  
(MODEL NO. AMCM)  
b. STARTER KIT (8 MARKERS, ONE FELT ERASER, 8 OZ.  
SPRAY BOTTLE OF LIQUID CLEANER, ONE EMPTY 8 OZ.  
SPRAY BOTTLE FOR WATER, TWO DRY ERASE CLEANING  
CLOTHS)  
c. HEAVY DUTY MAGNETS (MAG1), MINIMUM OF 12  
MAGNETS.
- WARRANTY: INCLUDE MANUFACTURER'S STANDARD 5 YEAR  
WARRANTY.
- INSTALL AS PER MANUFACTURER'S RECOMMENDATIONS  
HORIZONTALLY WITH SEAM AT 2' A.F.F. AND 8' A.F.F. REFER TO  
INSTALLATION INSTRUCTIONS, DOUBLE CUTTING ALL SEAMS.
- G.C. SHALL CLEAN / PREP MATERIAL FOR FIRST USE AS  
RECOMMENDED BY MANUFACTURER AN AMMONIA OR ALCOHOL  
BASED CLEANER OR MILD SOAP AND RINSED THOROUGHLY WITH  
WATER.

BALANCE ALLOW TOP  
SEAM ---  
SOLID WALLTALKERS' PIECE  
SEAM ---  
32" FROM FLOOR

GRAPHIC VINYL DECAL

GV1: GC RESPONSIBLE FOR USING GRAPHICS ALLOWANCE TO  
PROVIDE HEAT FORMED VINYL WALL DECAL DESIGN AND  
INSTALLATION BY 71 VISUALS (631.532.6142) ON PAINTED GYP.  
BD. WALL.  
PRODUCT: ARLON VINYL WITH MATTE LAMINATE, MULTIPLE  
COLORS

RUBBER TRANSITIONS/NOSINGS

GC RESPONSIBLE FOR USING GRAPHICS ALLOWANCE TO  
PROVIDE HEAT FORMED VINYL WALL DECAL DESIGN AND  
INSTALLATION BY 71 VISUALS (631.532.6142) ON PAINTED GYP.  
BD. WALL.  
PRODUCT: ARLON VINYL WITH MATTE LAMINATE, MULTIPLE  
COLORS

CASEWORK FINISHES

QT-1: SOLID SURFACE AS MANUFACTURED BY WILSONART OR  
EQUAL. COLOR: FROSTY WHITE MIRAGE 1573MG

PL-1: PLASTIC LAMINATE AS MANUFACTURED BY WILSONART OR  
EQUAL W/ MATCHING 3MM PVC EDGE WHERE REQUIRED  
COLOR: LOFT QAK 798-12

PL-2: PLASTIC LAMINATE AS MANUFACTURED BY WILSONART OR  
EQUAL W/ MATCHING 3MM PVC EDGE WHERE REQUIRED  
COLOR: HIGH RISE 4986-38

PL-3: PLASTIC LAMINATE AS MANUFACTURED BY WILSONART OR  
EQUAL W/ MATCHING 3MM PVC EDGE WHERE REQUIRED  
COLOR: INDIGO D379-80

"G.C. RESPONSIBLE FOR PROVIDING AND INSTALLING  
CASEWORK SHOWN IN ELEVATION 2311.04, 2711.04 AND  
RECEPTION DESK DETAILED ON 1116 ONLY. ALL OTHER  
CASEWORK TO BE PROVIDED AND INSTALLED BY OWNER'S CC  
ON SEPARATE CONTRACT.

FABRIC WRAPPED TACK BOARD:

FWTB: 1/2" HOMASOTE WALL BOARD BETWEEN  
COUNTERTOP AND UPPER CABINETS, WRAPPED  
WITH FABRIC. CUT TO MATCH LENGTH OF UPPER  
CABINETS  
FABRIC: PALETTE 2155 BY GUILFORD OF MAINE  
COLOR: AS PER ARCHITECT  
TYPICAL OF ALL OFFICES (ROOM #1 THROUGH #20)

ABBREVIATIONS:

ACT.....ACOUSTIC CEILING TILE  
CPT.....CARPET  
C.M.U.....CONCRETE MASONRY UNIT  
CONC.....CONCRETE

CWT.....CERAMIC WALL TILE  
EPOXY.....EPOXY TERRAZZO  
GTW.....GLAZED TILE WAINSCOT  
GYP.....GYPSUM BOARD

MS.....MARBLE SADDLE (ADA)  
NA.....NOT APPLICABLE  
NIC.....NOT IN CONTRACT  
PCB.....PORCELAIN TILE COVE BASE

PFT.....PORCELAIN FLOOR TILE  
PLAST.....PLASTER  
RB.....RUBBER COVE BASE  
RF.....RUBBER FLOORING

RT.....RUBBER TILE  
TERR.....TERRAZZO  
VCT.....VINYL COMPOSITION TILE  
VET.....VINYL ENHANCED TILE

VINYL.....SLIP-RESISTANT FLOORING  
WD.....WOOD  
WM.....WALK OFF MAT

FINISH SCHEDULE

RM. NO.	LOCATION	FLOOR	MATERIAL	FINISH	MATERIAL	FINISH	MATERIAL	FINISH	CEILING	REMARKS
1	OFFICE		CARPET	CP11	RUBBER BASE	R81	GYP. BD	P6	ACT3	FWTB
2	OFFICE		CARPET	CP11	RUBBER BASE	R81	GYP. BD	P6	ACT3	FWTB
3	OFFICE		CARPET	CP11	RUBBER BASE	R81	GYP. BD	P6	ACT3	FWTB
107	QUIET ROOM		LVT	LVT1	RUBBER BASE	R82	GYP. BD	AP	ACT3	WALLS TO BE WRAPPED IN ACOUSTICAL PANEL
108	AMPHITHEATER		LVT	LVT1	RUBBER BASE	R82	GYP. BD	P3	ACT3&GYP	
111A	UNISEX ADA RESTROOM		CERAMIC TILE	CT1	CERAMIC TILE	CT2	CERAMIC TILE	CT2	ACT5	
111B	UNISEX RESTROOM		CERAMIC TILE	CT1	CERAMIC TILE	CT2	CERAMIC TILE	CT2	ACT5	
111C	UNISEX RESTROOM		CERAMIC TILE	CT1	CERAMIC TILE	CT2	CERAMIC TILE	CT2	ACT5	
111D	STAFF ADA UNISEX RESTROOM		CERAMIC TILE	CT1	CERAMIC TILE	CT2	CERAMIC TILE	CT2	ACT5	
112	FLEX SPACE		LVT	LVT1	RUBBER BASE	R82	GYP. BD	P3	ACT11GYP	
113	SCIENCE RESEARCH LAB		LVT	LVT1	RUBBER BASE	R82	GYP. BD	P3&P5WC1	ACT11&GYP	
114	COLLEGE CONF		CARPET	CP11	RUBBER BASE	R81	GYP. BD	P3P4	ACT1	
115	MATH LAB		LVT	LVT1	RUBBER BASE	R81	GYP. BD	P5WC1	ACT1	
116	WRITING LAB		LVT	LVT1	RUBBER BASE	R81	GYP. BD	P5WC1	ACT1	
117	CLASSROOM		VCT	VCT1	RUBBER BASE	R81	GYP. BD	P3P5	ACT1	
118	STORAGE		VCT	VCT1	RUBBER BASE	R81	GYP. BD	P3	ACT2	
119	STORAGE		VCT	VCT1	RUBBER BASE	R81	GYP. BD	P3	ACT2	
120	FAB LAB/ PHOTOGRAPHY		VCT	VCT1	RUBBER BASE	R81	GYP. BD	P4	ACT1	
120A	STORAGE		VCT	VCT1	RUBBER BASE	R81	GYP. BD	P4	ACT1	
121	ROBOTICS ENGINEERING		VCT	VCT1	RUBBER BASE	R81	GYP. BD	P4	ACT1	
157	SECURITY		VCT	VCT1	RUBBER BASE	R81	EXIST	P4	ACT2	
158	BOYS' TOILET		CERAMIC TILE	CT1	CERAMIC TILE	CT2	CERAMIC TILE	CT2	ACT5	
159	STOR.		VCT	VCT1	RUBBER BASE	R81	EXIST	P3	ACT2	
160	GIRLS' TOILET		CERAMIC TILE	CT1	CERAMIC TILE	CT2	CERAMIC TILE	CT2	ACT5	
164	TECH		VCT	VCT1	RUBBER BASE	R81	GYP. BD	P3P5	ACT1	
165	TECH		VCT	VCT1	RUBBER BASE	R81	GYP. BD	P3P5	ACT1	
166	STORAGE		VCT	VCT1	RUBBER BASE	R81	GYP. BD	P3	ACT2	
167	STORAGE		VCT	VCT1	RUBBER BASE	R81	GYP. BD	P3	ACT2	
168	STUDENT LEARNING EXCHANGE		CARPET/LVT	CP11/LVT1	RUBBER BASE	R81	GYP. BD	P3P4P5	ACT3&GYP	
181A	UNISEX ADA RESTROOM		CERAMIC TILE	CT1	CERAMIC TILE	CT2	CERAMIC TILE	CT2	ACT5	
181B	UNISEX RESTROOM		CERAMIC TILE	CT1	CERAMIC TILE	CT2	CERAMIC TILE	CT2	ACT5	
501B	GALLERY		VCT	VCT1	RUBBER BASE	R82	GYP. BD	P	NO CLGP1&11	
505	CAFETERIA		VCT	MATCH EXIST	RUBBER BASE	MATCH EXIST	GYP. BD	MATCH EXIST	MATCH EXIST	
B	CORRIDOR		VCT	VCT1	RUBBER BASE	R82	GYP. BD	P	ACT11GYP	
C	CORRIDOR		EXIST VCT	PATCH AS REQ'D	RUBBER BASE	R82	GYP. BD	P	NO CLGP1	
E	CORRIDOR		VCT	VCT1	RUBBER BASE	R82	GYP. BD	P	ACT1	
F	CORRIDOR		VCT	VCT1	RUBBER BASE	R82	GYP. BD	P	NO CLGP1	
L	CORRIDOR		CERAMIC TILE	CT1	CERAMIC TILE	CT2	CERAMIC TILE	CT2	ACT1	

FINISH NOTES

- ALL FINISH TYPES (STYLE/COLOR/PATTERN) SHALL CONFORM  
TO THE STANDARD OF QUALITY INDICATED BY THE PROJECT  
MANUAL. FINAL STYLE/COLOR/PATTERN TO BE SELECTED BY  
ARCHITECT.
- ALL CMU SURFACES SHALL BE PRIMED WITH INTERIOR &  
EXTERIOR BLOCK FILLER M88 INDUSTRIAL MAINTENANCE BY  
BENJAMIN MOORE. PRIOR TO FINISH PAINT APPLICATION.
- ALL WINDOWS IN AREA OF WORK ARE TO HAVE NEW SHADES  
OR BLINDS SUPPLIED AND INSTALLED BY GC, (1) PER WINDOW  
UNIT. G.C. SHALL SUBMIT SHOP DRAWINGS FOR APPROVAL.
- NEW AND EXISTING DOOR FRAMES ASSOCIATED IN SCOPE OF  
WORK SHALL BE PREPPED AND PAINTED WITH BENJAMIN  
MOORE LATEX SEMI-GLOSS PAINT BY GC. COLOR AS  
SELECTED BY ARCHITECT.
- REFER TO FLOOR PLANS FOR TILE PATTERNS.
- G.C. SHALL PREPRIME AND PAINT ALL SHEET METAL PIPE  
ENCLOSURES (INSTALLED BY MC). COLOR AS SELECTED BY  
ARCHITECT.
- BEFORE PAINTING, CONCRETE SURFACES MUST CURE 30  
DAYS. BLOCK AND PLASTER SURFACES MUST CURE FOR 30  
DAYS.
- ALL NEW WOOD WINDOW SILLS, MOLDING AND TRIM SHALL  
RECEIVE A "STAINED" FINISH AND RECEIVE (3) COATS OF  
"BENWOOD POLYURETHANE FINISH LOW LUSTER NO. 438 BY  
"BENJAMIN MOORE" OR APPROVED EQUAL. STAIN COLOR AS  
SELECTED BY ARCHITECT. GC SHALL SUBMIT PHYSICAL  
COLOR SAMPLE FOR REVIEW AND APPROVAL.
- ALL FINISHES SHALL BE PROVIDED AND INSTALLED BY GC  
UNLESS OTHERWISE NOTED. REFER TO SPEC SECTION 09000  
FOR ADDITIONAL INFORMATION.
- ALL INTERIOR FINISHES IN CORRIDOR SHALL BE CLASS 'A'  
RATED.
- PATCH, REPAIR AND FINISH CEILING, WALLS, AND FLOOR @  
POINTS OF DEMOLITION TO MATCH EXISTING ADJACENT.  
EXISTING FINISHES TO REMAIN.
- SHOULD ANY FINISH MATERIALS BE DISCONTINUED BY  
MANUFACTURER, GC MUST REPLACE WITH CLOSEST MATCH  
AT NO ADDITIONAL COST, AND SUBMIT TO ARCHITECT FOR  
APPROVAL PRIOR TO INSTALLATION.
- REFER TO REFLECTED CEILING PLANS AND FINISH FLOOR  
PLANS FOR ADDITIONAL INFORMATION.
- DOOR FRAMES TO BE PREPPED & PAINTED AS PER SPEC.  
COLOR AS SELECTED BY ARCHITECT.
- G.C. SHALL PREP, PRIME & PAINT SHEETROCK CEILINGS  
UNLESS OTHERWISE NOTED. FINISH AS PER SPEC. COLOR:  
WHITE, FLAT FINISH.
- REFER TO FINISH FLOOR PLANS FOR TILE PATTERNS - THE  
TILE PATTERNS MAY NOT REPRESENT THE FINAL PATTERNS  
TO BE DESIGNED, INSTALLED & TURNED OVER TO OWNER. THE  
BID SHALL BE BASED ON THE TILE MIX & PERCENTAGES, AS  
INDICATED IN THE PROJECT MANUAL.
- REFER TO REFLECTED CEILING PLANS, TOILET ROOM TILE  
PLANS, AND FINISHED FLOOR PLANS FOR ADDITIONAL FINISH  
INFORMATION.
- GENERAL CONTRACTOR SHALL PERFORM A BOND TEST IN  
ACCORDANCE WITH MANUFACTURERS SPECIFICATIONS PRIOR  
TO INSTALLATION OF NEW V.C.T. FLOORINGS.
- CONTRACTOR SHALL INSTALL PLANIPATCH PLUS BY MAPET  
OR APPROVED EQUAL. OVER SUBSTRATE AND/OR CONCRETE  
SLAB TO PROVIDE A FLOOR SURFACE IN ACCORDANCE WITH  
MANUFACTURERS WRITTEN INSTRUCTIONS AND AS SPECIFIED  
FOR INSTALLATION OF NEW FINISH FLOOR MATERIALS.

PRIME CONTRACTOR TO PROVIDE ALL REQUIRED SADDLES,  
THRESHOLDS, REDUCER STRIPS, TRANSITION STRIPS AND OR FLAT  
PLATES AS REQUIRED TO PROVIDE A FINISHED, ADA COMPLAINT  
TRANSITION AT NUMEROUS FLOORING TRANSITIONS AND  
TERMINATIONS.

TYPICAL MOLDING NOTES

- COORDINATE DEMOLITION AND PROPOSED DRAWINGS FOR  
EXTENT OF MOLDING REPLACEMENT IN THE EXISTING  
BUILDING. ALL MOLDING COMPONENTS AND PROFILES ARE  
INDICATED FOR REFERENCE ONLY.
- EXISTING TRIM SHALL BE MAINTAINED WHERE INDICATED.  
WHERE NEW TRIM SHALL MATCH THE EXISTING TO REMAIN, THE  
SIZE AND PROFILE SHALL MATCH THE EXISTING - SPECIES MAY  
VARY.
- CONTRACTOR SHALL PROVIDE SOLID BLOCKING AS REQUIRED  
TO SUPPORT ALL MOLDINGS AND TRIM WHETHER EXPLICITLY  
NOTED/SHOWN OR NOT.
- ALL MOLDINGS TO BE EITHER MAPLE OR POPLAR AS SPECIFIED.  
ALL MOLDINGS SHALL BE PAINTED - COLOR BY ARCHITECT.
- REFER TO SPECIFICATION REGARDING PAINT FOR NEW/EXISTING  
MOLDINGS, PAINT FOR NEW/EXISTING PLASTER, CAULKING,  
REQUIRED PREPARATION WORK, AND APPLICATION  
PROCEDURES.

GYPSUM BOARD FINISHING

GENERAL CONTRACTOR SHALL CONFORM TO THE REQUIREMENTS  
OF GYPSUM ASSOCIATION TRADE PUBLICATION GA-214-96  
RECOMMENDED LEVELS OF GYPSUM BOARD FINISH & 3.06 OF  
SPECIFICATION SECTION 09250.

LEVEL 0 - FOR USE IN TEMPORARY CONSTRUCTION, OR WHERE  
FINAL FINISH/DECORATION HAS NOT BEEN DETERMINED.

LEVEL 1 - FOR USE AT PLENUM AREAS, ABOVE CEILING, IN ATTICS &  
IN AREAS WHERE THE ASSEMBLY WOULD GENERALLY BE  
CONCEALED OR IN BUILDING CORRIDORS & OTHER AREAS NOT  
NORMALLY OPEN TO THE PUBLIC VIEW.

LEVEL 2 - FOR USE AT LOCATIONS WHERE WATER-RESISTANT  
GYPSUM BACKING BOARD IS INSTALLED AS A TILE SUBSTRATE AND  
FOR USE IN GARAGES, WAREHOUSE STORAGE OR OTHER SIMILAR  
AREAS WHERE SURFACE APPEARANCES ARE NOT OF PRIMARY  
CONCERN.

LEVEL 3 - FOR USE IN APPEARANCE AREAS THAT ARE TO RECEIVE  
HEAVY OR MEDIUM TEXTURE FINISHES BEFORE FINAL PAINTING, OR  
WHERE HEAVY - GRADE WALL COVERINGS ARE TO BE APPLIED AS  
THE FINAL DECORATION.

LEVEL 4 - FOR USE WHERE LIGHT TEXTURE OR WALL COVERINGS  
ARE TO BE APPLIED, OR WHERE ECONOMY IS OF THE ARCHITECT'S  
CONCERN.

LEVEL 5 - FOR USE WHERE GLOSS, SEMI-GLOSS, ENAMEL OR NON-  
TEXTURED FLAT PAINTS ARE SPECIFIED, OR WHERE SEVERE  
LIGHTING CONDITIONS OCCUR (IN THE OPTION OF THE ARCHITECT.)

REV.	DATE	ITEM
	11/28/2022	BID ADDENDUM #1

NOTICE

THESE DRAWINGS ARE BASED ON CONSTRUCTION  
DRAWINGS NOT PREPARED BY BBS ARCHITECTS, LANDSCAPE  
ARCHITECTS AND ENGINEERS, PC, AND THEREFORE, MAY  
NOT REPRESENT THE CONDITIONS AS CONSTRUCTED AT THE  
TIME. ALL EXISTING CONDITIONS AS SHOWN ARE REPRESENTED  
AS SUGGESTIVE INFORMATION AS THEY MAY NOT HAVE BEEN  
BUILT AND STAINED PER THE ORIGINAL DOCUMENTS OF THE  
THE OWNER'S INFORMATION.

BRIARCLIFF MANOR U.F.S.D.  
PHASE 2 BOND IMPROVEMENTS  
BRIARCLIFF MANOR MIDDLE / HIGH SCHOOL  
444 PLEASANTVILLE RD. BRIARCLIFF MANOR, NY 10510

FINISH SCHEDULE

PROJECT	DWG TITLE
DRWG. BY:	C.M.
CHK. BY:	G.E.O.

THIS DRAWING, PREPARED FOR THE SPECIFIC PROJECT  
INDICATED IS AN INSTRUMENT OF SERVICE AND THE  
PROPERTY OF BBS ARCHITECTS, LANDSCAPE ARCHITECTS  
AND ENGINEERS, P.C. REPRODUCTION OR ANY USE OF THIS  
DRAWING FOR ANY OTHER PROJECT IS PROHIBITED. ANY  
ALTERATION OR REPRODUCTION OF THIS DOCUMENT IS  
ALSO PROHIBITED WITHOUT THE WRITTEN CONSENT OF  
THE ARCHITECT OR ENGINEER.

BBS  
ARCHITECTS  
LANDSCAPE ARCHITECTS  
ENGINEERS  
BRANCH PROJECT CONTACT  
187 WOLF ROAD, STE. 205  
ALBANY  
NEW YORK 12205  
T: 518.621.7650  
244 EAST MAIN STREET  
PATROCKVILLE  
NEW YORK 11772  
T: 631.475.0349  
F: 631.475.0361  
www.bbsarchitecture.com

SER. NO.	66-14-02-02-0-004-023
DISTRICT	BRIARCLIFF MANOR U.F.S.D.
PROJECT	PHASE 2 BOND IMPROVEMENTS
DWG. TITLE	FINISH SCHEDULE
SCALE:	AS NOTED
DATE:	-
BID P/U DATE:	11/14/2022
FILE NO.	21-274C

A9.01	HSMS
-------	------







PROPOSED FINISH FLOOR PLAN  
SCALE: 3/32" = 1'-0"

FLOOR TYPES		
REFER TO FINISH SCHED FOR MORE INFO		
VCT	CPT	LVT
CT		


FINISH LEGEND	
PA	ACCENT PAINT LOCATION - REFER TO FINISH SCHED
TA	THRESHOLD DETAIL - REFER TO DOOR SCHED

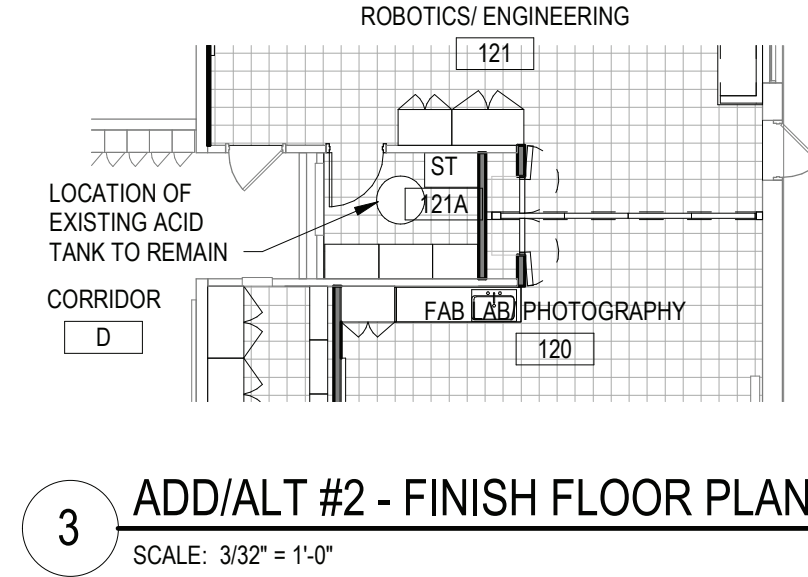


3 ADD/ALT #2 - FINISH FLOOR PLAN  
SCALE: 3/32" = 1'-0"

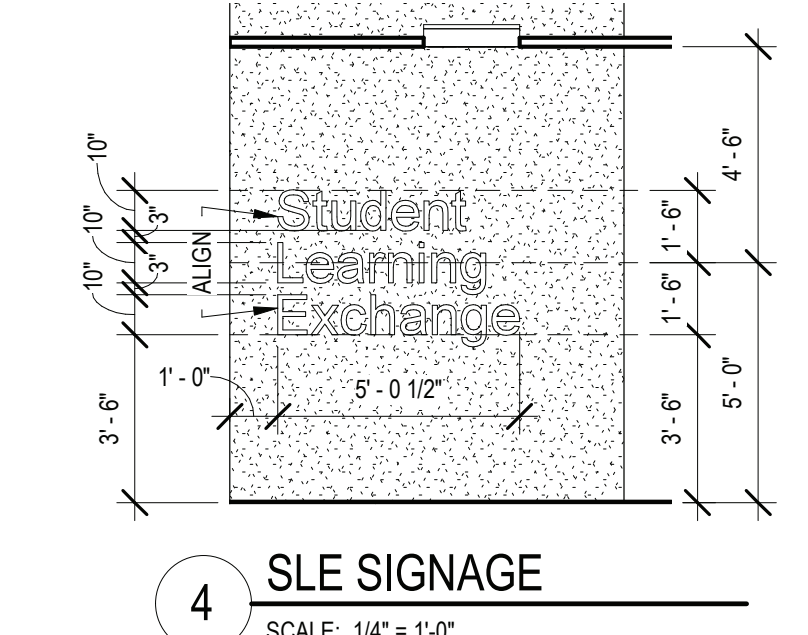


4 SLE SIGNAGE  
SCALE: 1/4" = 1'-0"

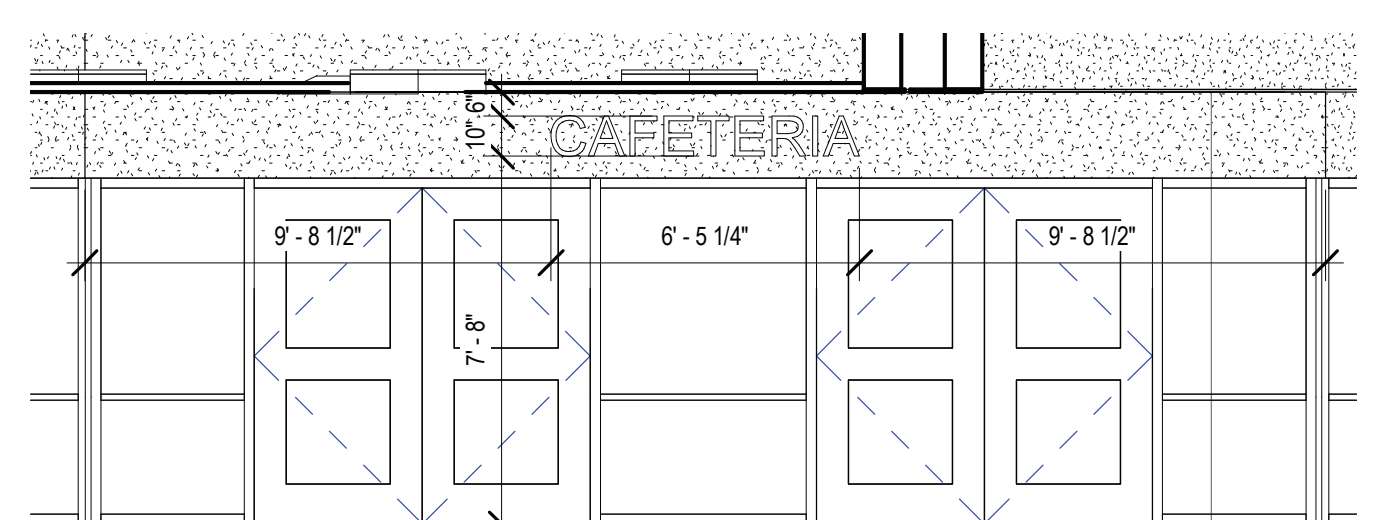


5 CAFETERIA SIGNAGE  
SCALE: 1/4" = 1'-0"

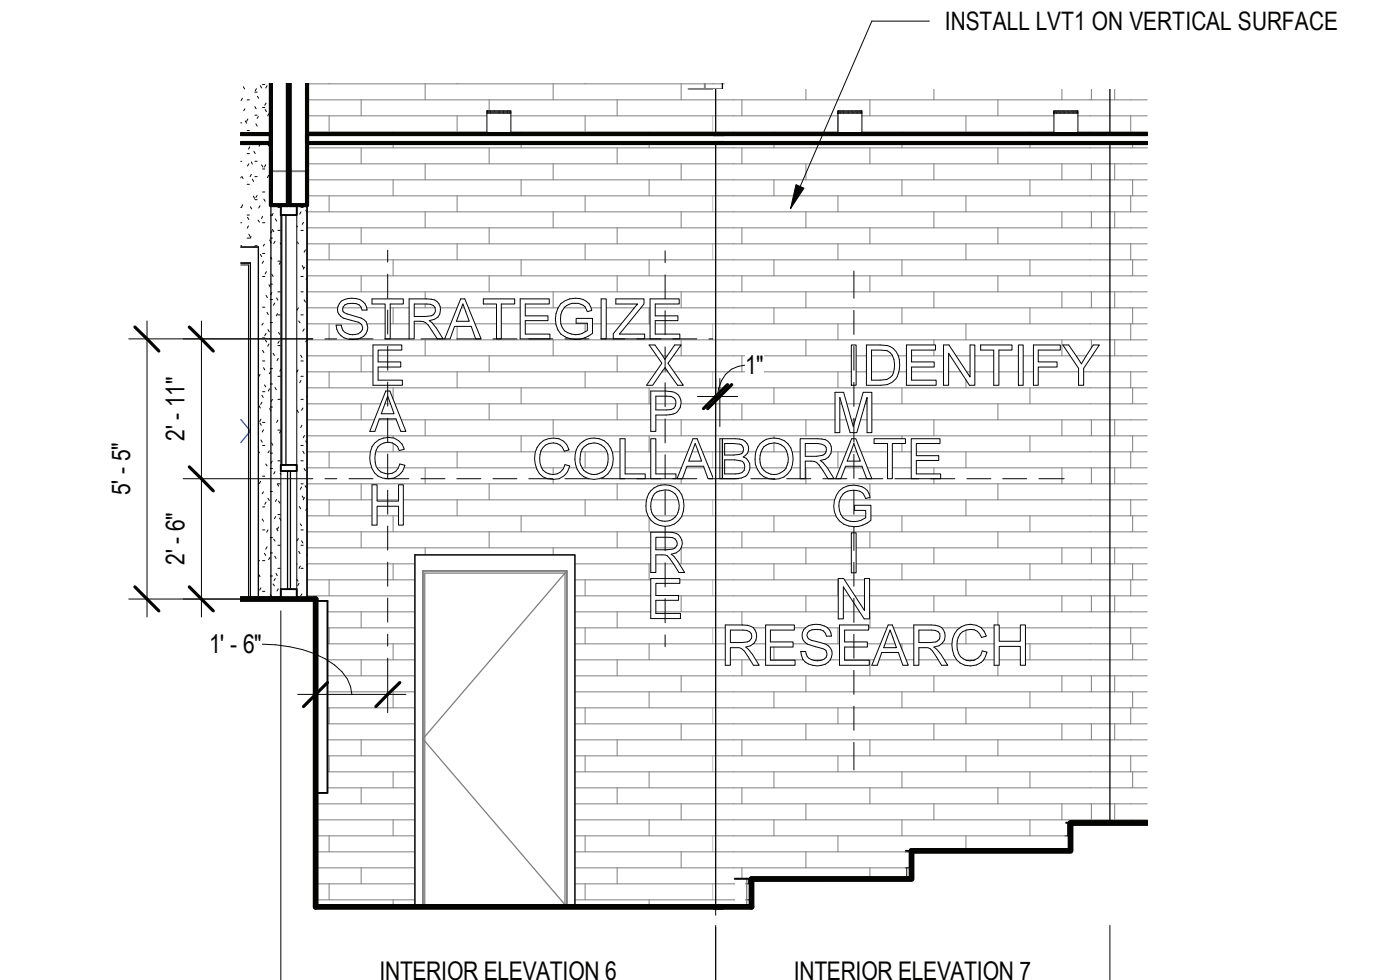

6A AMPHITHEATER SIGNAGE  
SCALE: 1/4" = 1'-0"

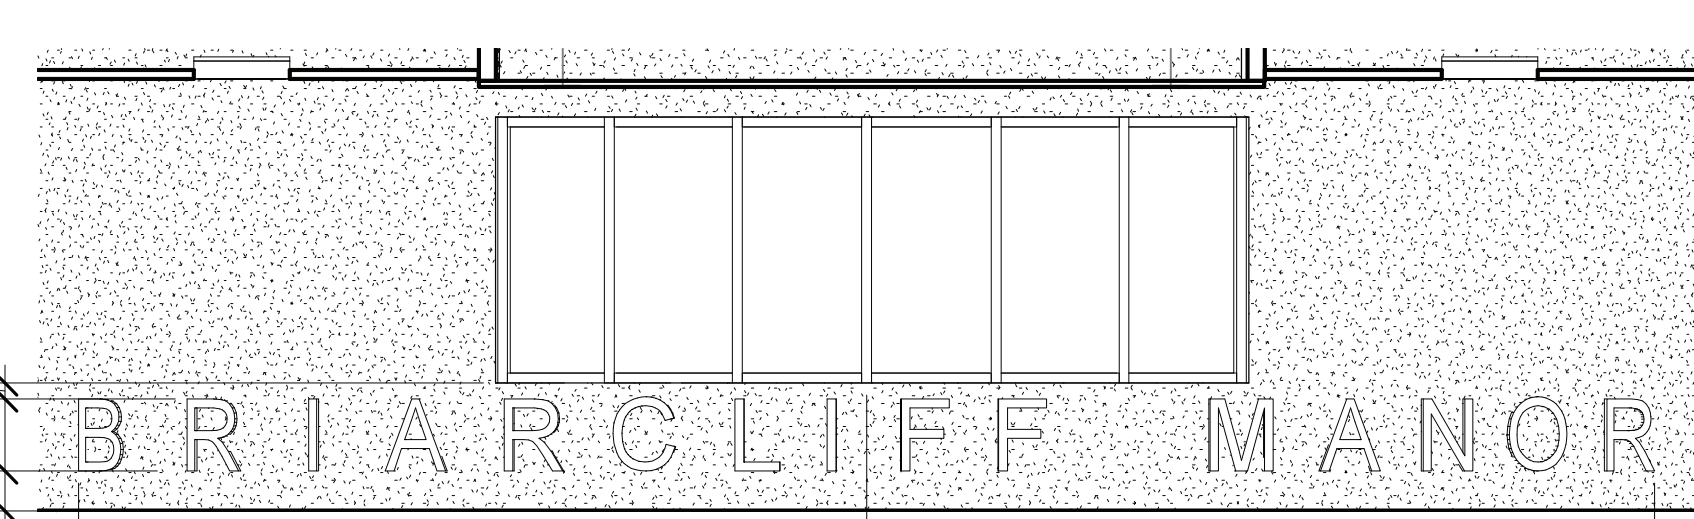

7 BRIARCLIFF MANOR SIGNAGE  
SCALE: 1/4" = 1'-0"

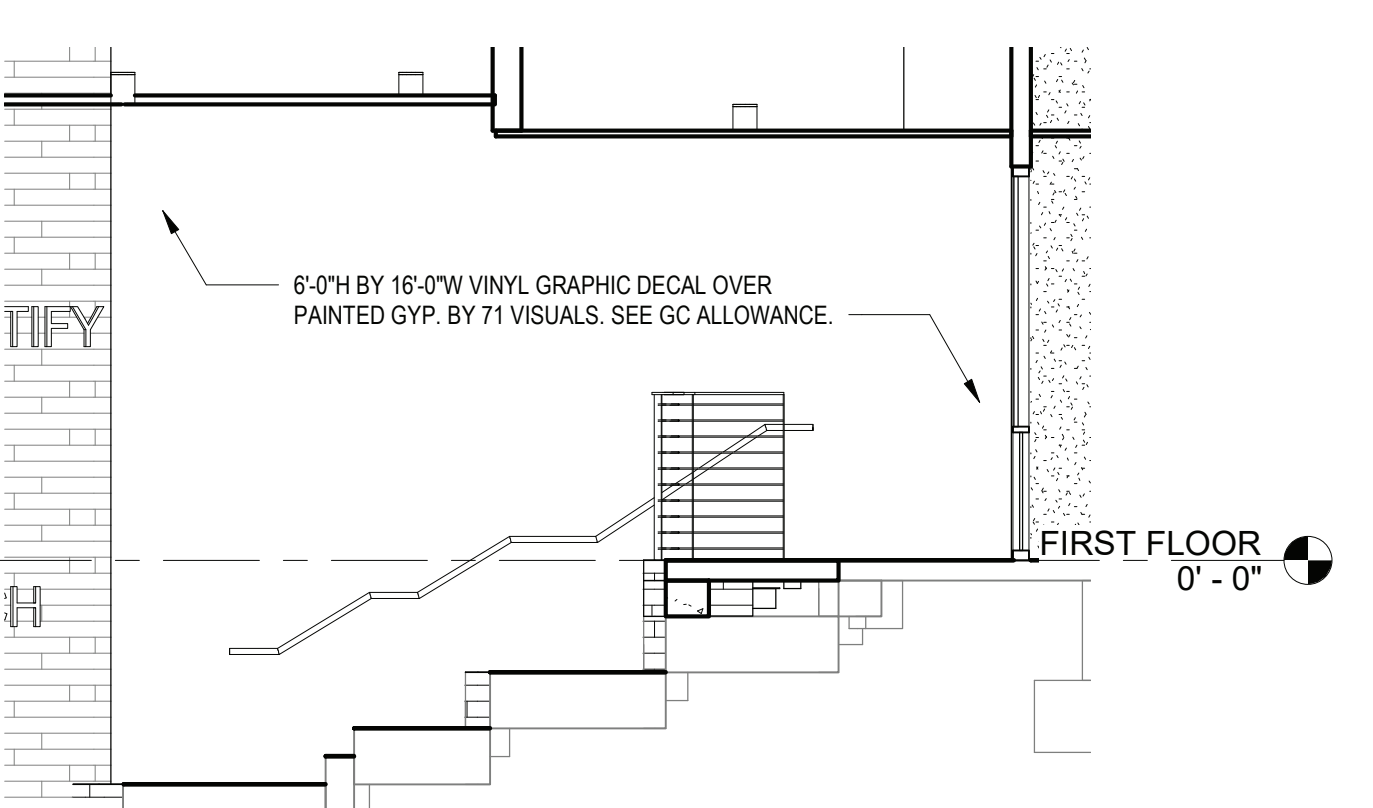

8 AMPHITHEATER GRAPHIC  
SCALE: 1/4" = 1'-0"

REV.	DATE	ITEM
1	11/28/2022	BID ADDENDUM #1
NOTICE		
THESE DRAWINGS ARE BASED ON CONSTRUCTION DRAWINGS NOT PREPARED BY BBS ARCHITECTS, LANDSCAPE ARCHITECTS AND ENGINEERS, P.C. AND THEREFORE, MAY NOT REPRESENT THE CONDITIONS AS CONSTRUCTED AT THE TIME. ALL EXISTING CONDITIONS SHOWN ARE REPRESENTED AS SUGGESTIVE INFORMATION AS THEY MAY NOT HAVE BEEN BUILT AND OBTAINED FROM THE ORIGINAL DOCUMENTS OF THE OWNER'S INFORMATION.		
KEY PLAN		
NO SCALE		
PROJECT		
BRIARCLIFF MANOR U.F.S.D. PHASE 2 BOND IMPROVEMENTS BRIARCLIFF MANOR MIDDLE / HIGH SCHOOL 444 PLEASANTVILLE RD. BRIARCLIFF MANOR, NY 10510		
DWG TITLE		
FINISH FLOOR PLAN		
DRWG. BY: C.M.		
CHK. BY: G.E.O.		
THIS DRAWING, PREPARED FOR THE SPECIFIC PROJECT INDICATED IN AN INSTRUMENT OF SERVICE AND THE PROPERTY OF BBS ARCHITECTS, LANDSCAPE ARCHITECTS AND ENGINEERS, P.C., IS NOT TO BE REPRODUCED OR USED IN ANY MANNER FOR ANY OTHER PROJECT WITHOUT THE WRITTEN CONSENT OF BBS ARCHITECTS, LANDSCAPE ARCHITECTS AND ENGINEERS, P.C.		
BBS		
ARCHITECTS LANDSCAPE ARCHITECTS ENGINEERS		
BRANCH PROJECT CONTACT: 244 EAST MAIN STREET 187 WOLF ROAD, STE. 205 ALBANY, NEW YORK 12205 T: 518.621.7650		
PARCHOQUE NEW YORK 11772 T: 631.475.0349 F: 631.475.0341		
www.bbsarchitecture.com		
SED NO. 66-14-02-02-0-004-023		
DISTRICT BRIARCLIFF MANOR U.F.S.D.		
PROJECT PHASE 2 BOND IMPROVEMENTS		
DWG TITLE FINISH FLOOR PLAN		
SCALE: AS NOTED		
DATE: 11/14/2022		
BID PAU DATE: 21-274C		
FILE NO. 21-274C		
A9.02 HSMS		







AREA NOT IN CONTRACT U.O.N.

A10.02	HSMS
--------	------




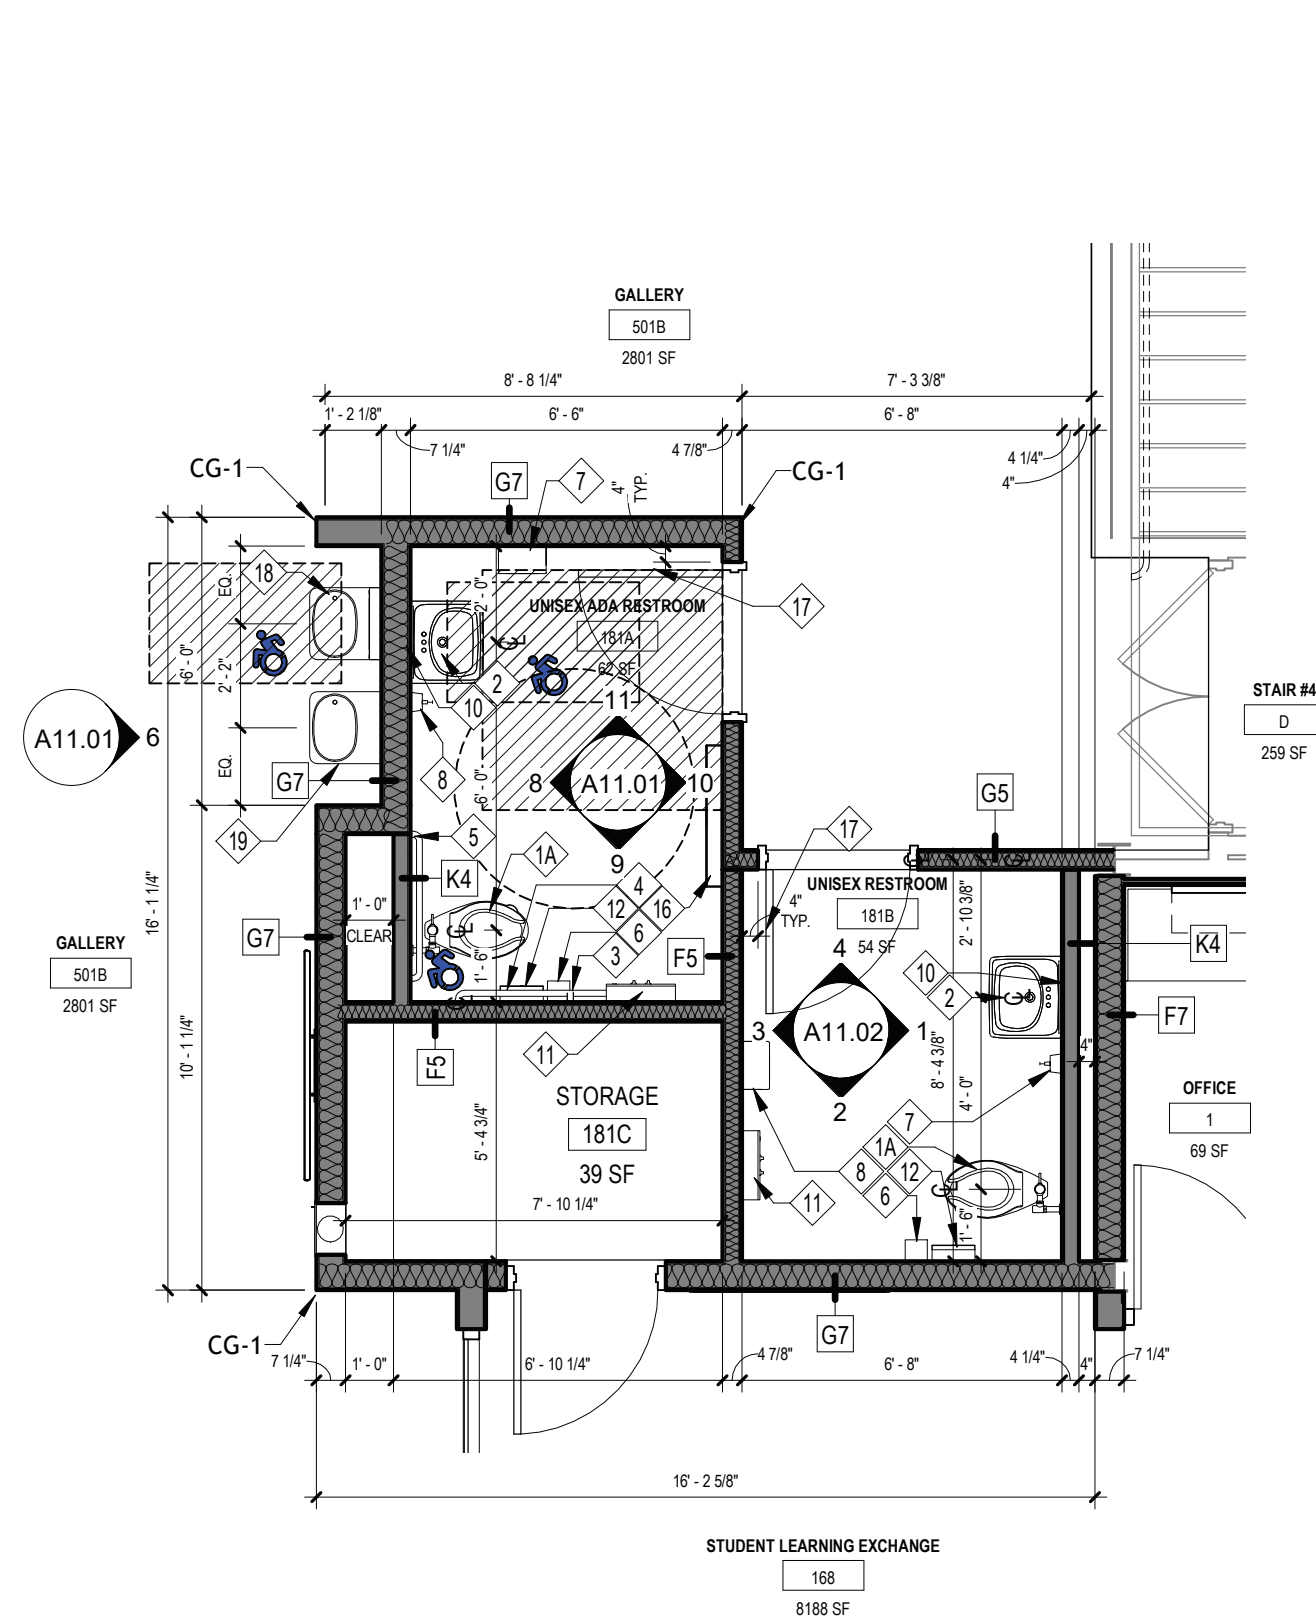


1 ENLARGED PLAN - AREA D - UNISEX RESTROOM  
SCALE: 1/4" = 1'-0"

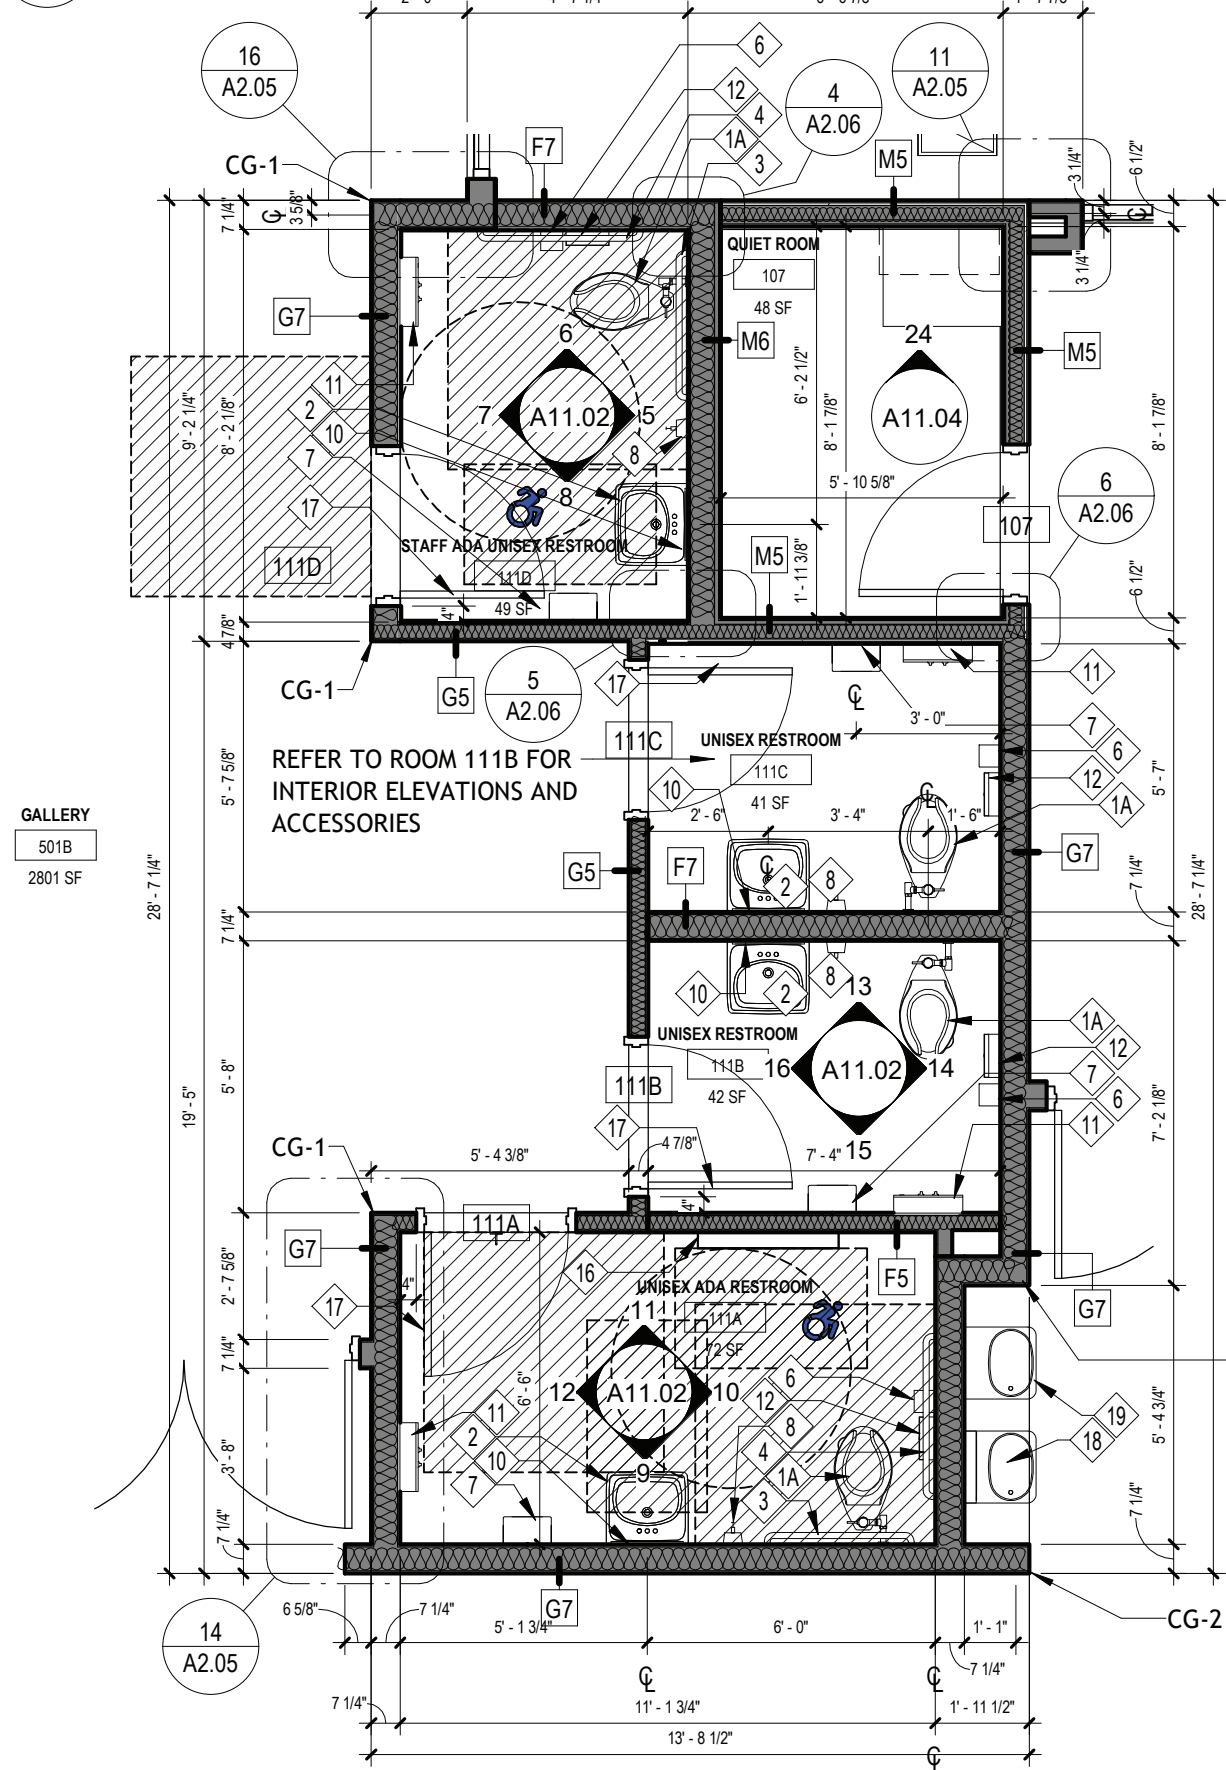


2 ENLARGED PLAN AREA D - RESTROOMS & QUIET ROOM AREA  
SCALE: 1/4" = 1'-0"

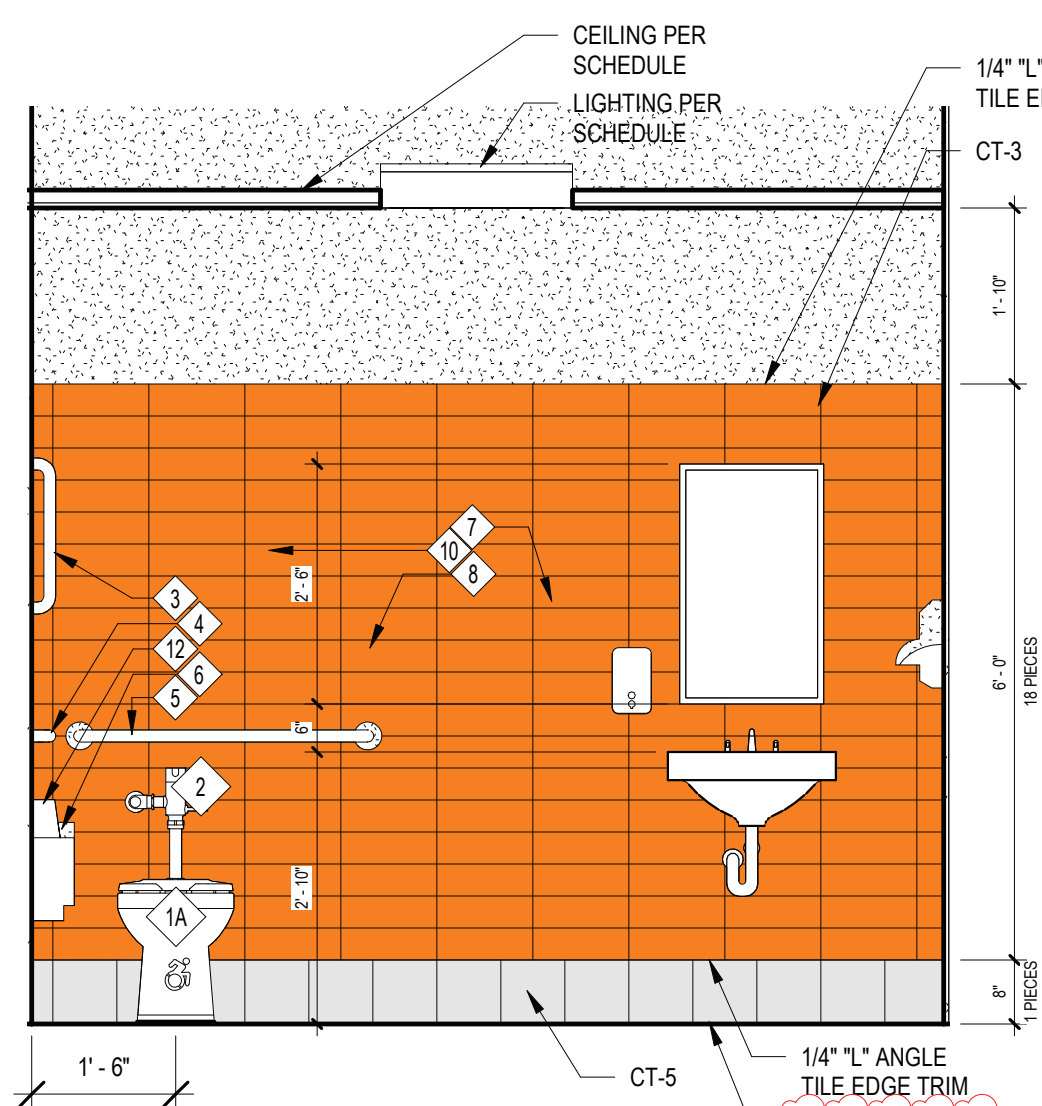


8 UNISEX ADA RESTROOM 181A - INTERIOR ELEVATION 1  
SCALE: 1/2" = 1'-0"

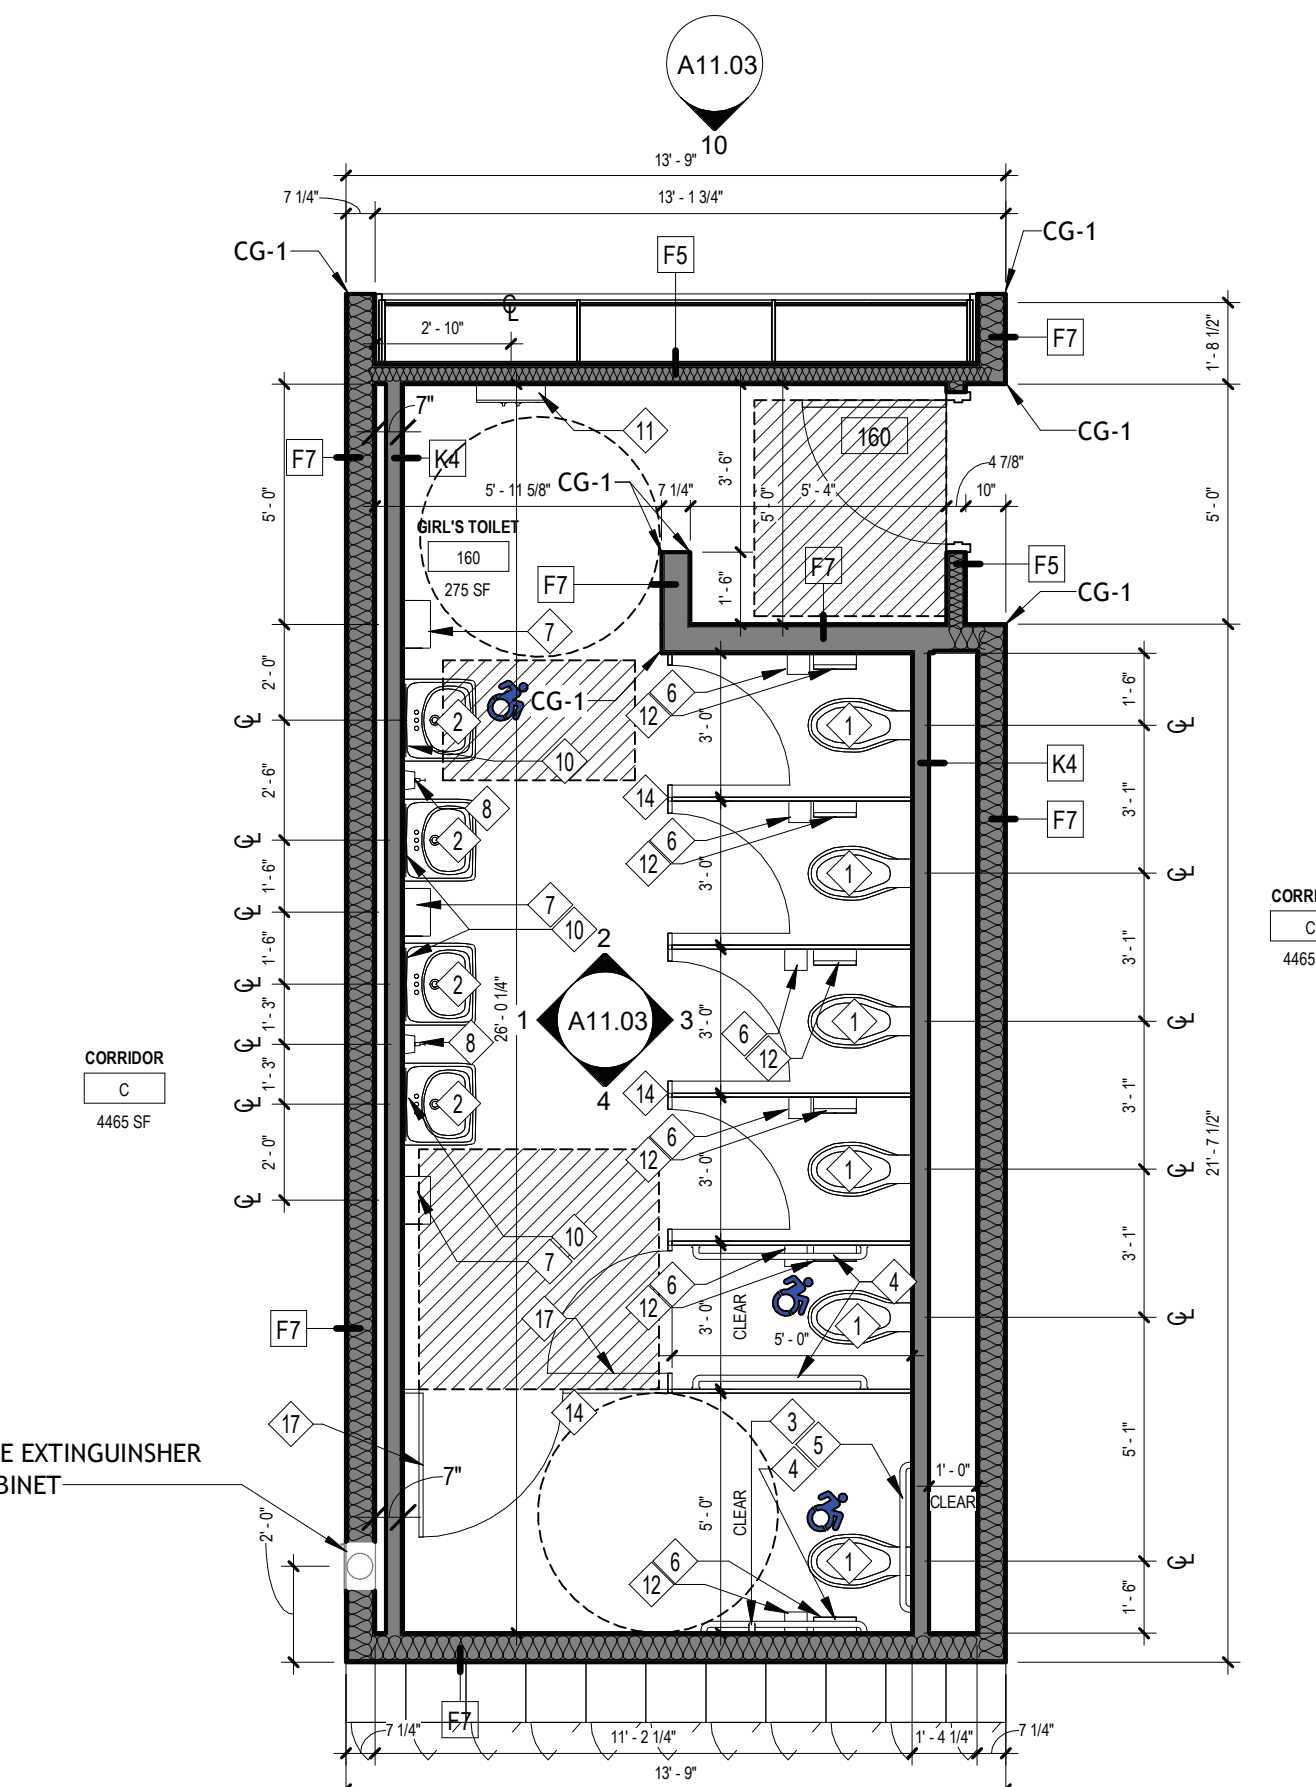


3 ENLARGED PLAN - AREA D - GILR'S RESTROOM  
SCALE: 1/4" = 1'-0"

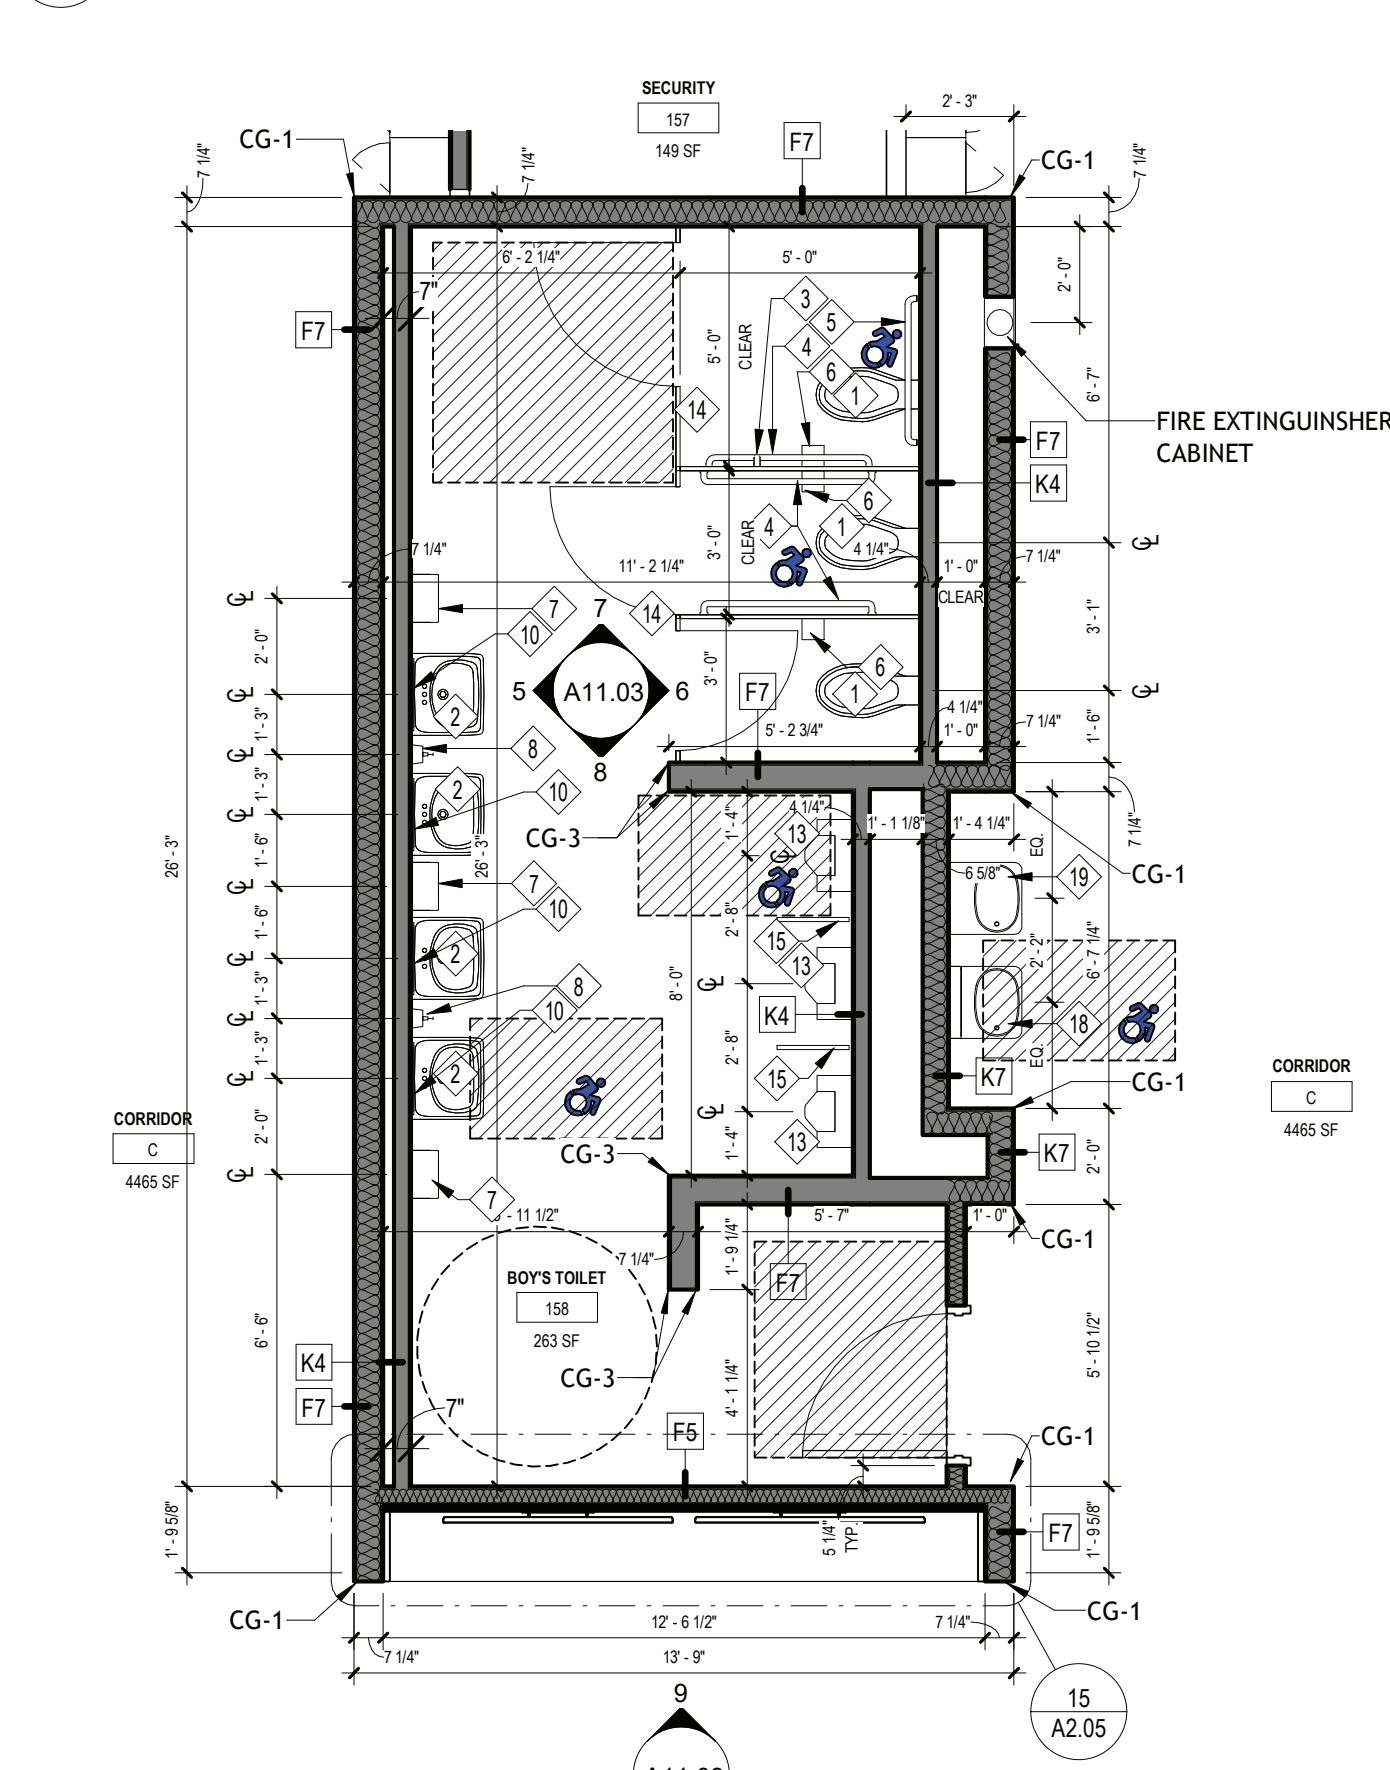


4 ENLARGED PLAN - AREA D - BOY'S RESTROOM  
SCALE: 1/4" = 1'-0"

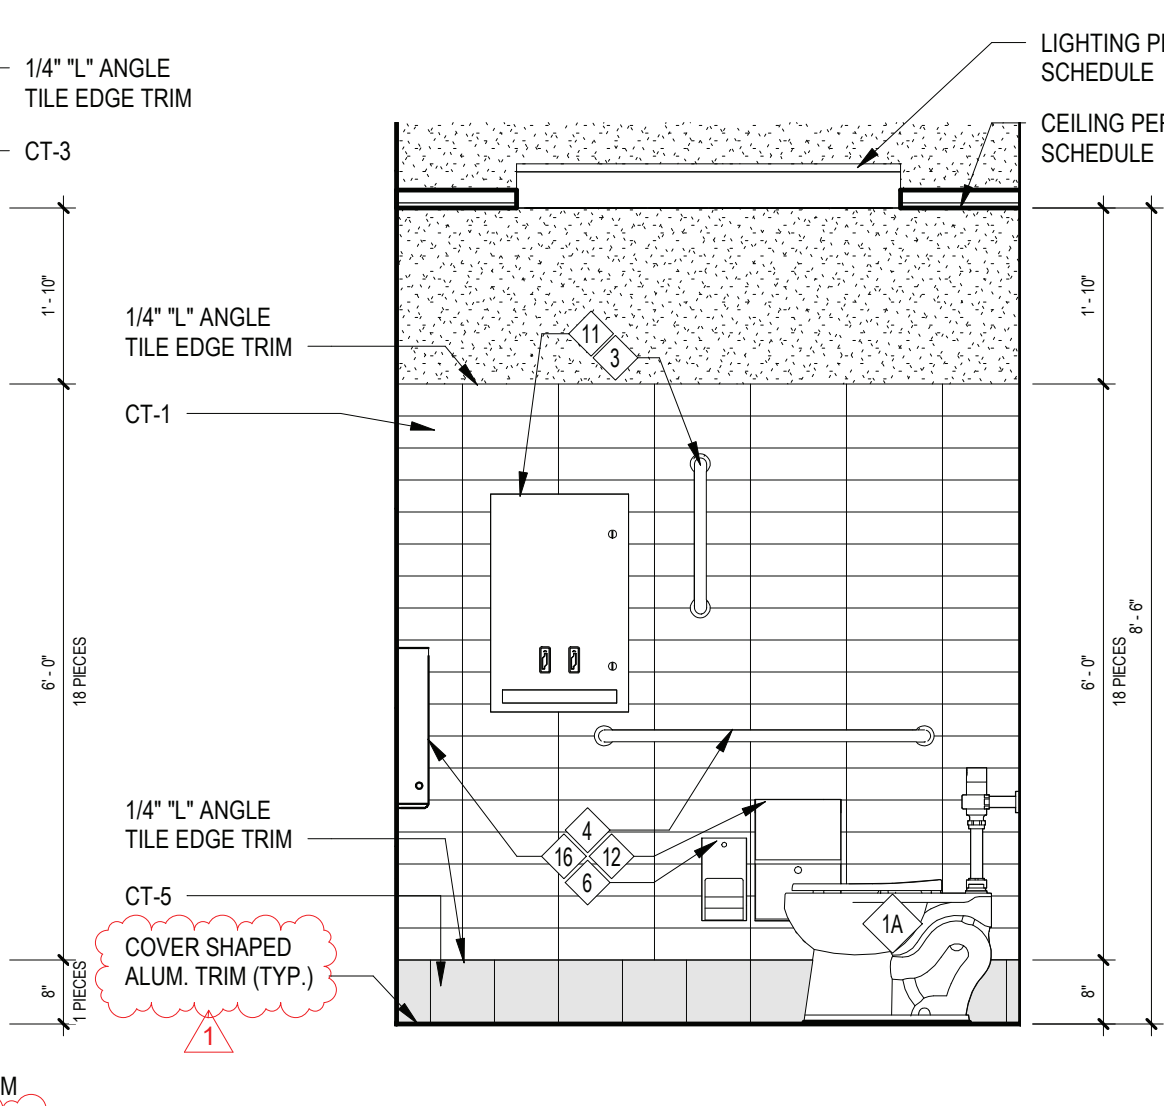


9 UNISEX ADA RESTROOM 181A - INTERIOR ELEVATION 2  
SCALE: 1/2" = 1'-0"

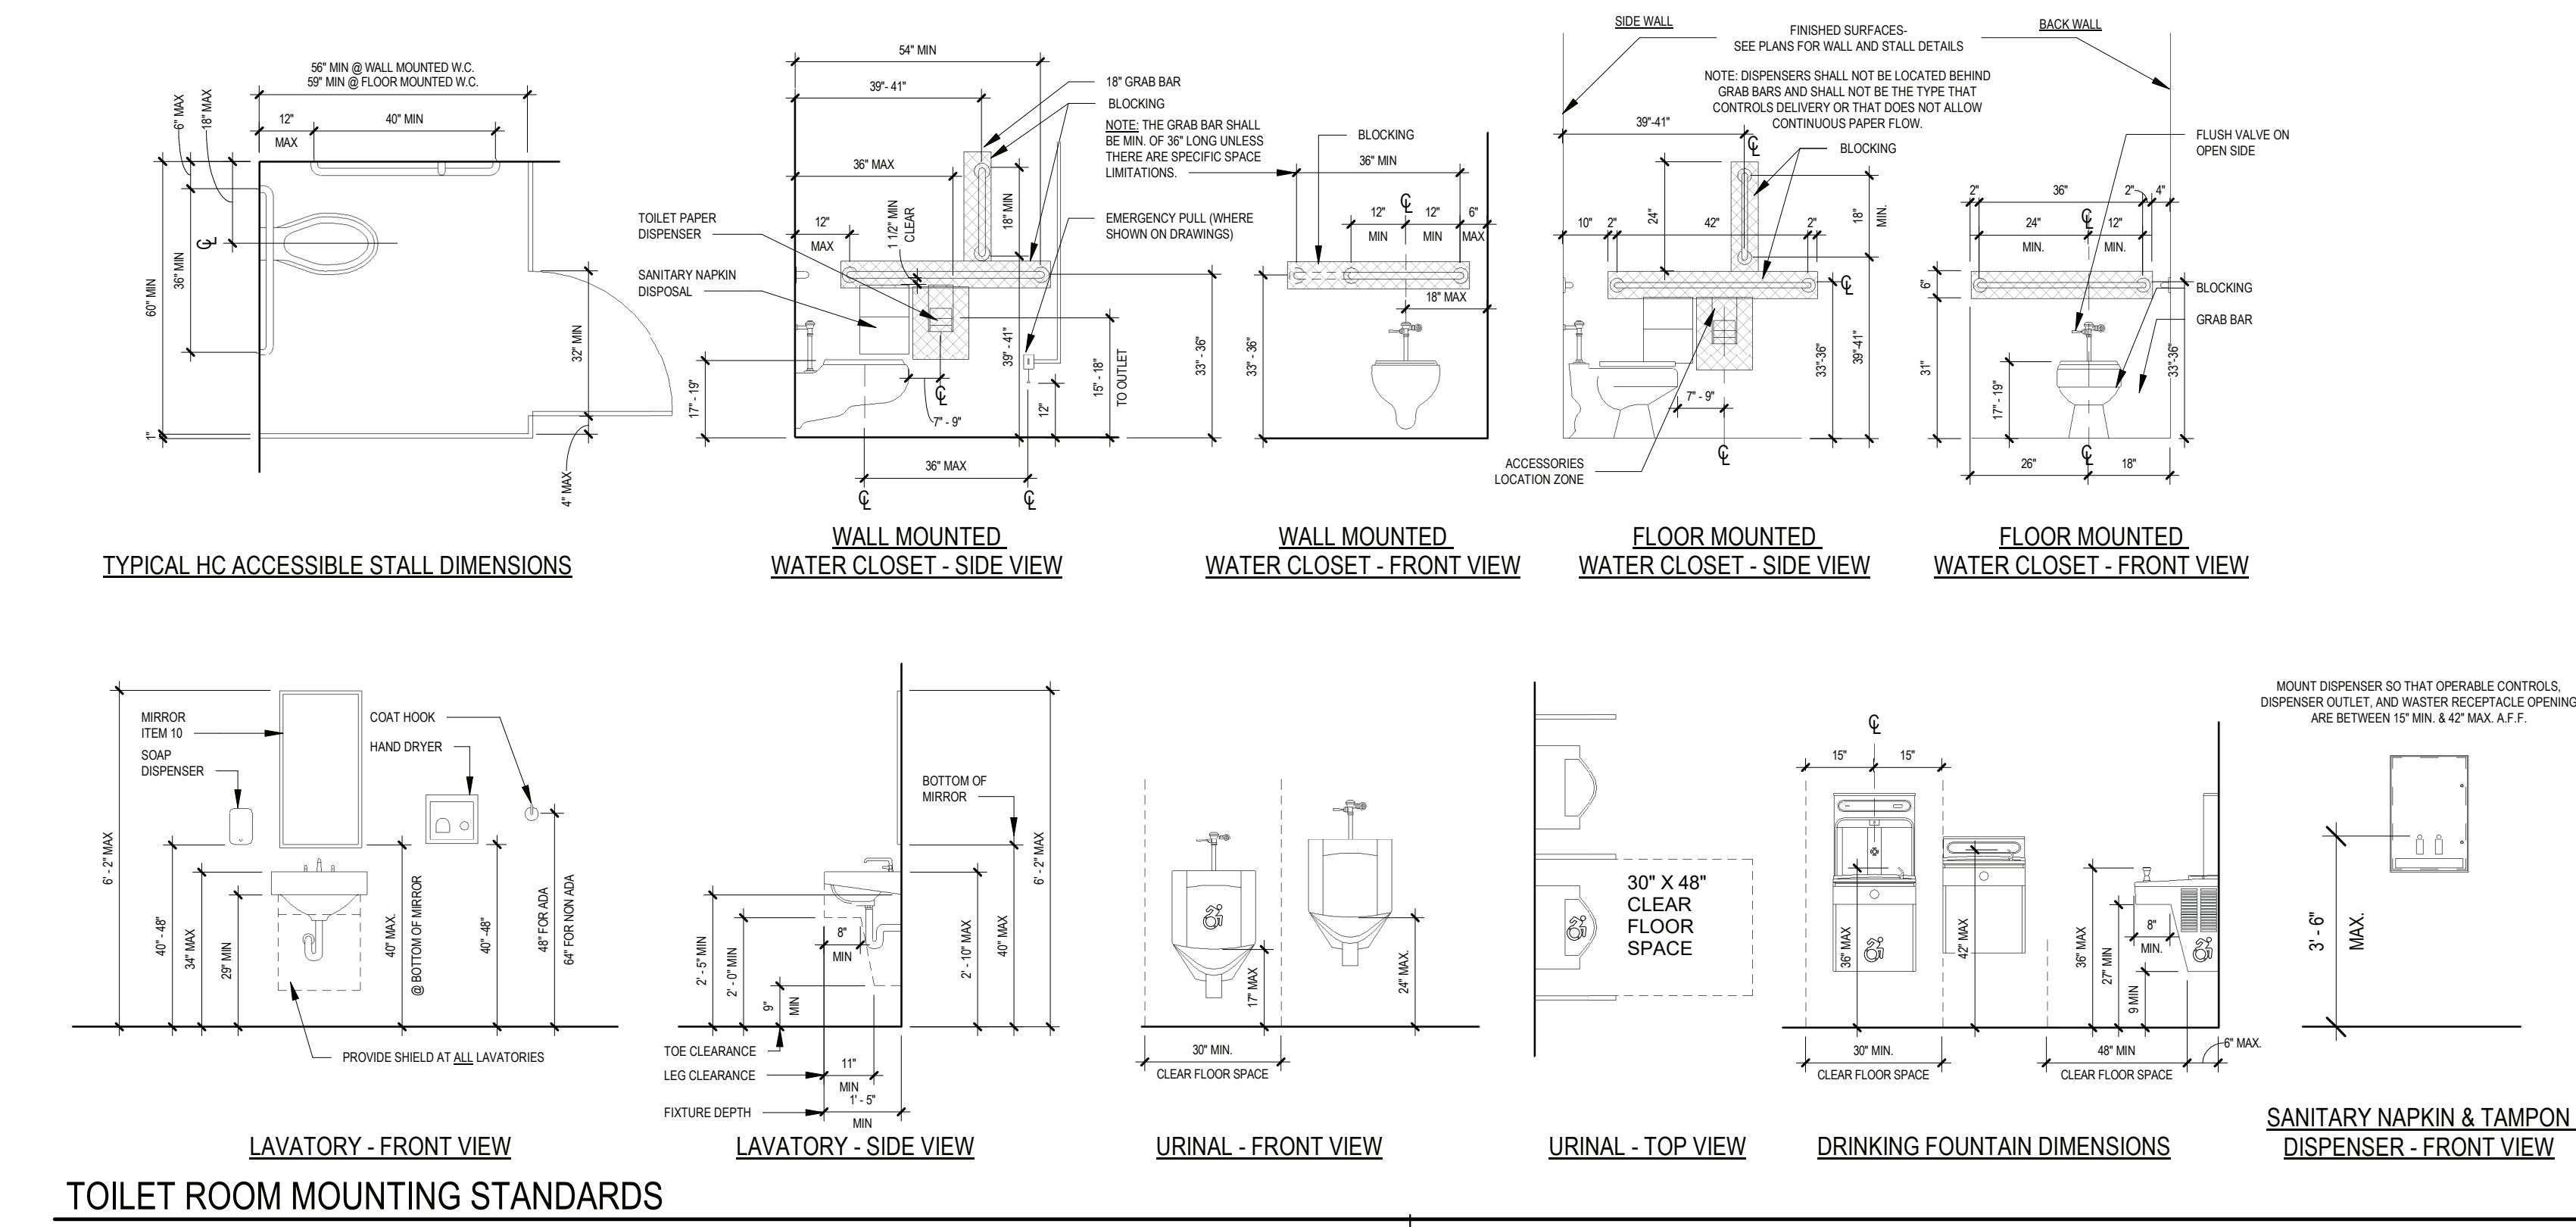


TOILET ROOM MOUNTING STANDARDS  
SCALE: 3/8" = 1'-0"

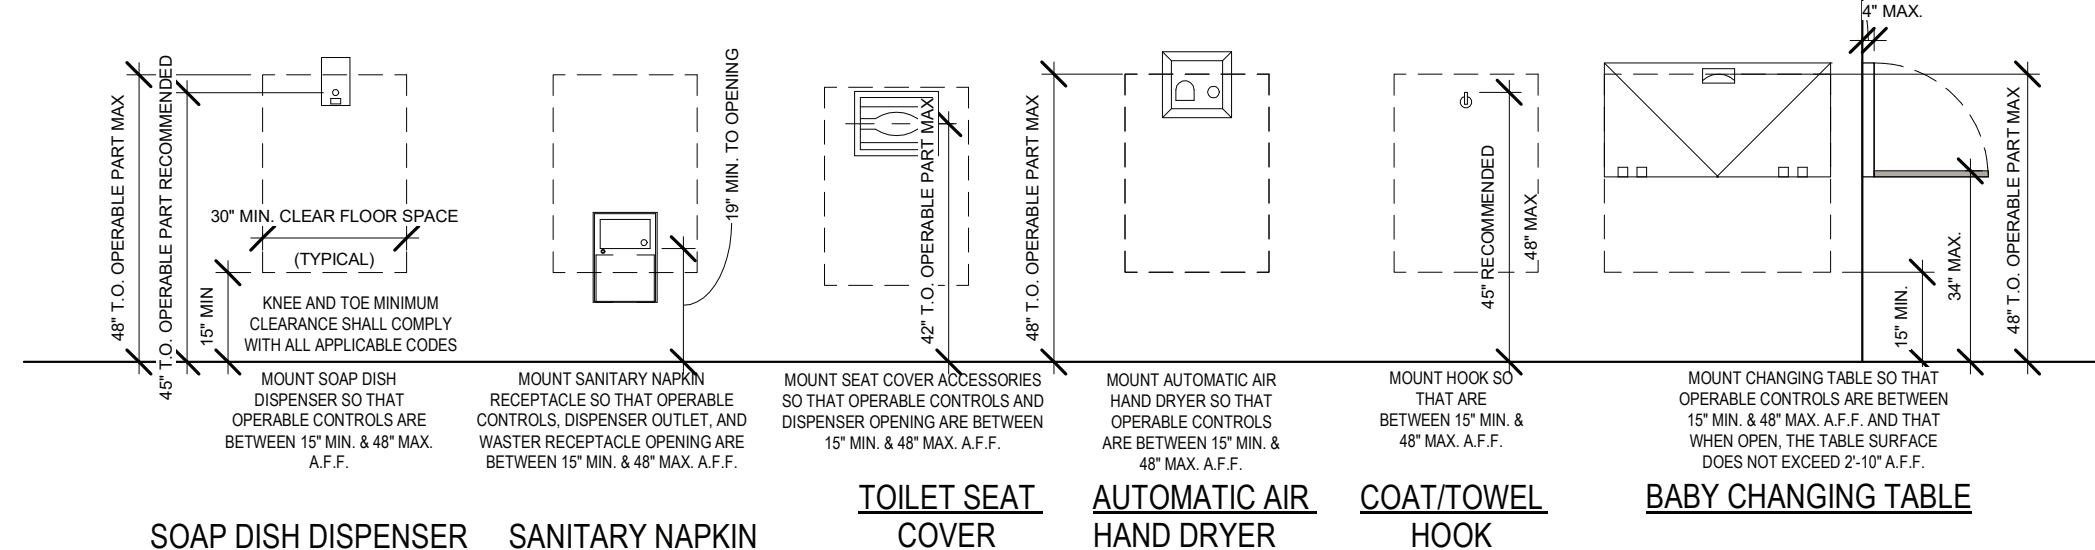


ADA - ADA MOUNTING HEIGHTS FOR RESTROOM ACCESSORIES  
SCALE: 3/8" = 1'-0"

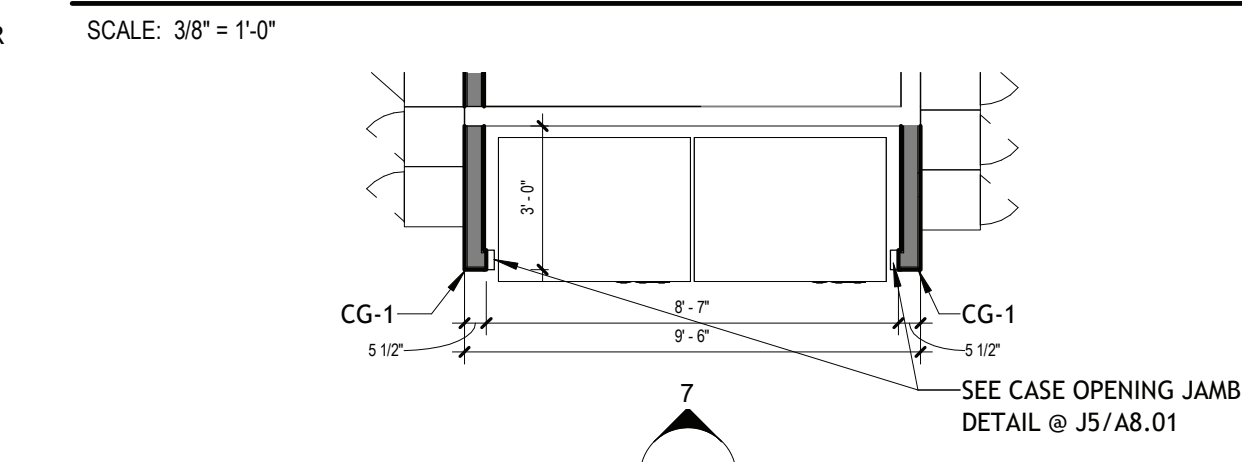


5 ENLARGED PLAN AREA D - VENDING POD  
SCALE: 1/4" = 1'-0"

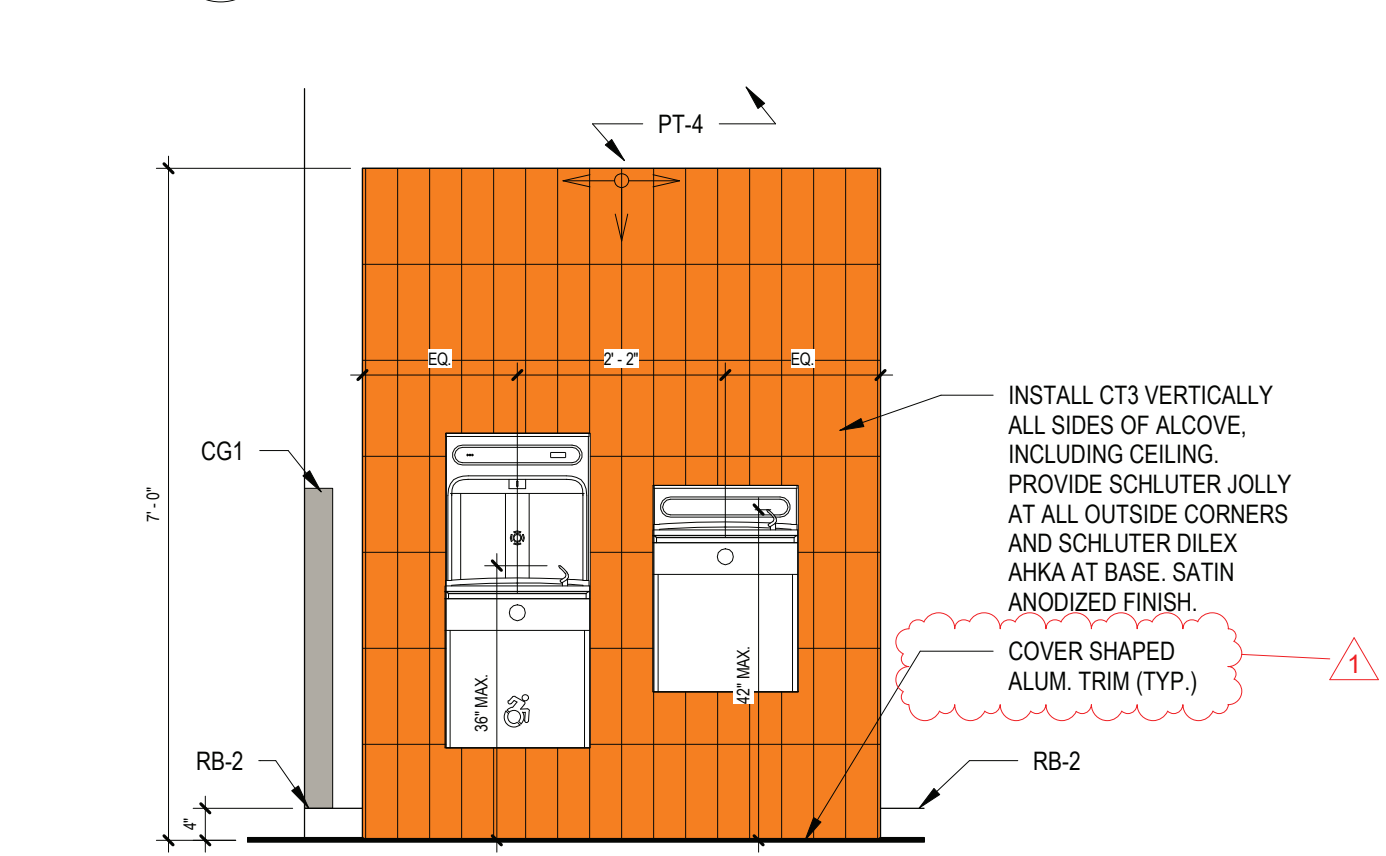


6 DRINKING FOUNTAIN INTERIOR ELEVATION - TYPICAL  
SCALE: 1/2" = 1'-0"

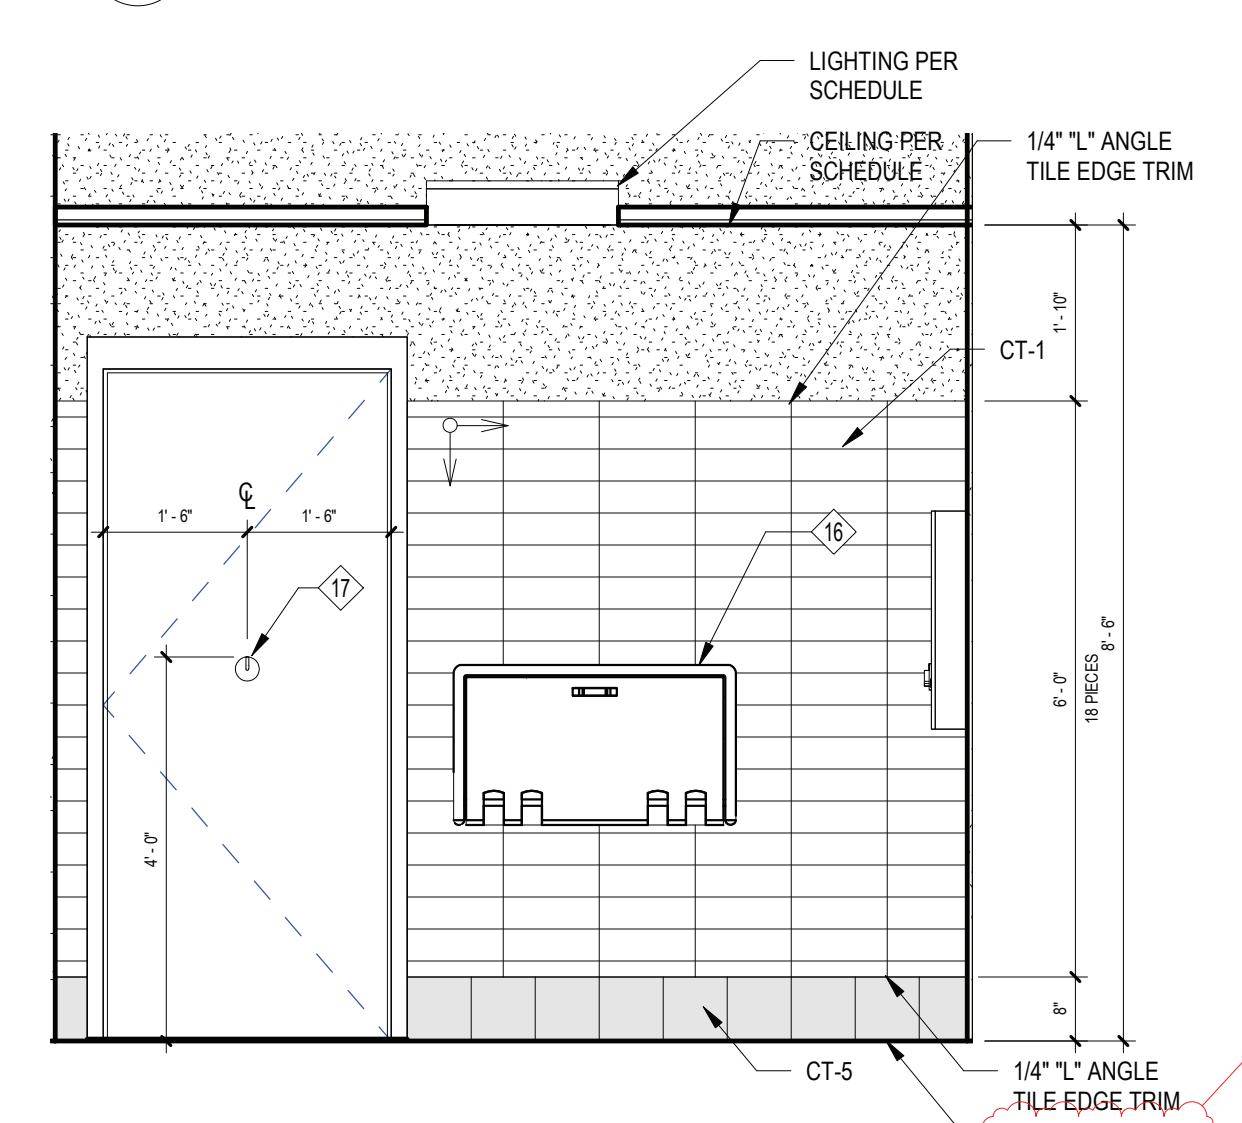

10 UNISEX ADA RESTROOM 181A - INTERIOR ELEVATION 3  
SCALE: 1/2" = 1'-0"

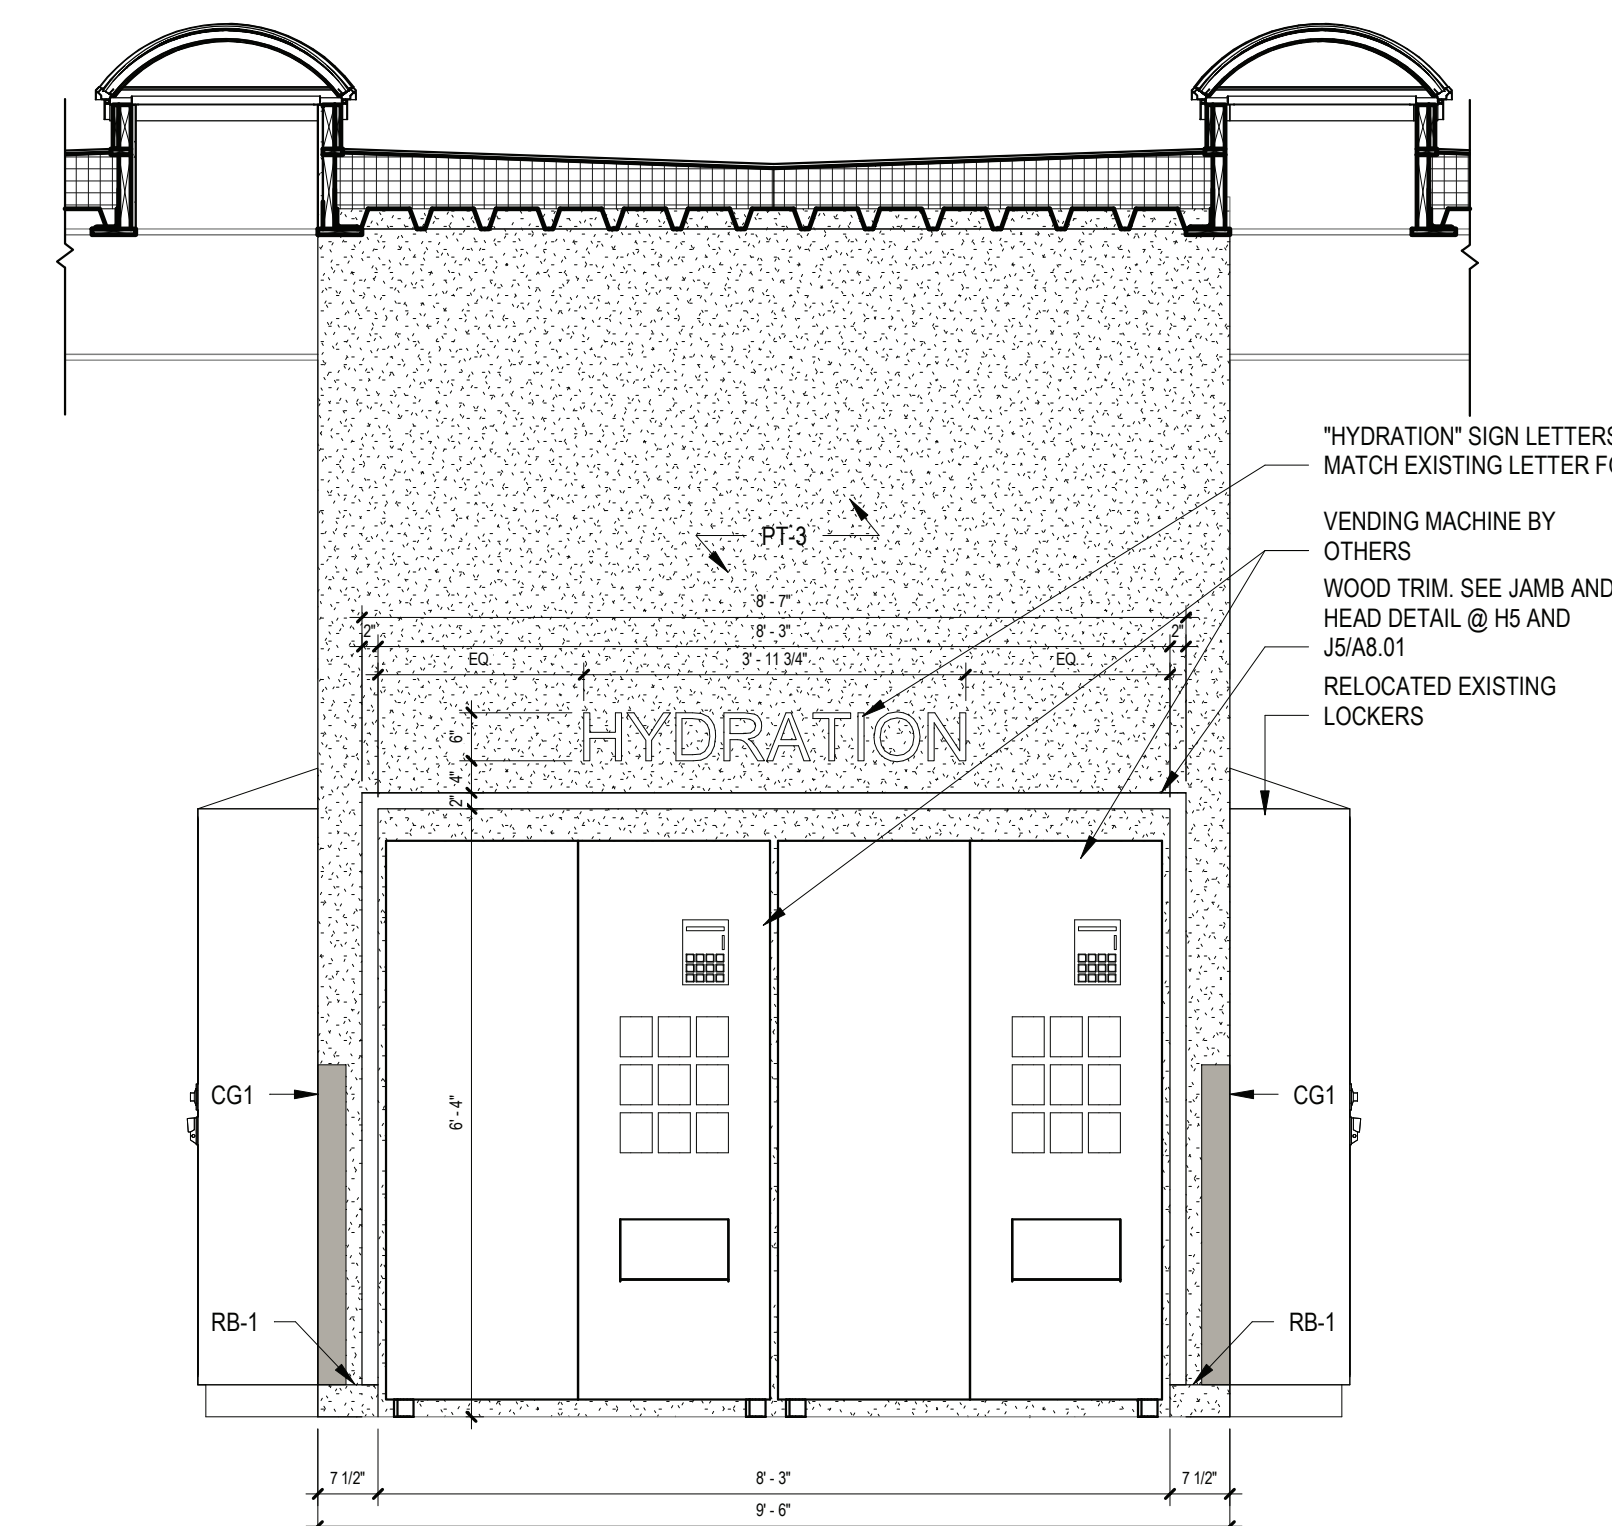

7 VENDING POD - INTERIOR ELEVATION  
SCALE: 1/2" = 1'-0"

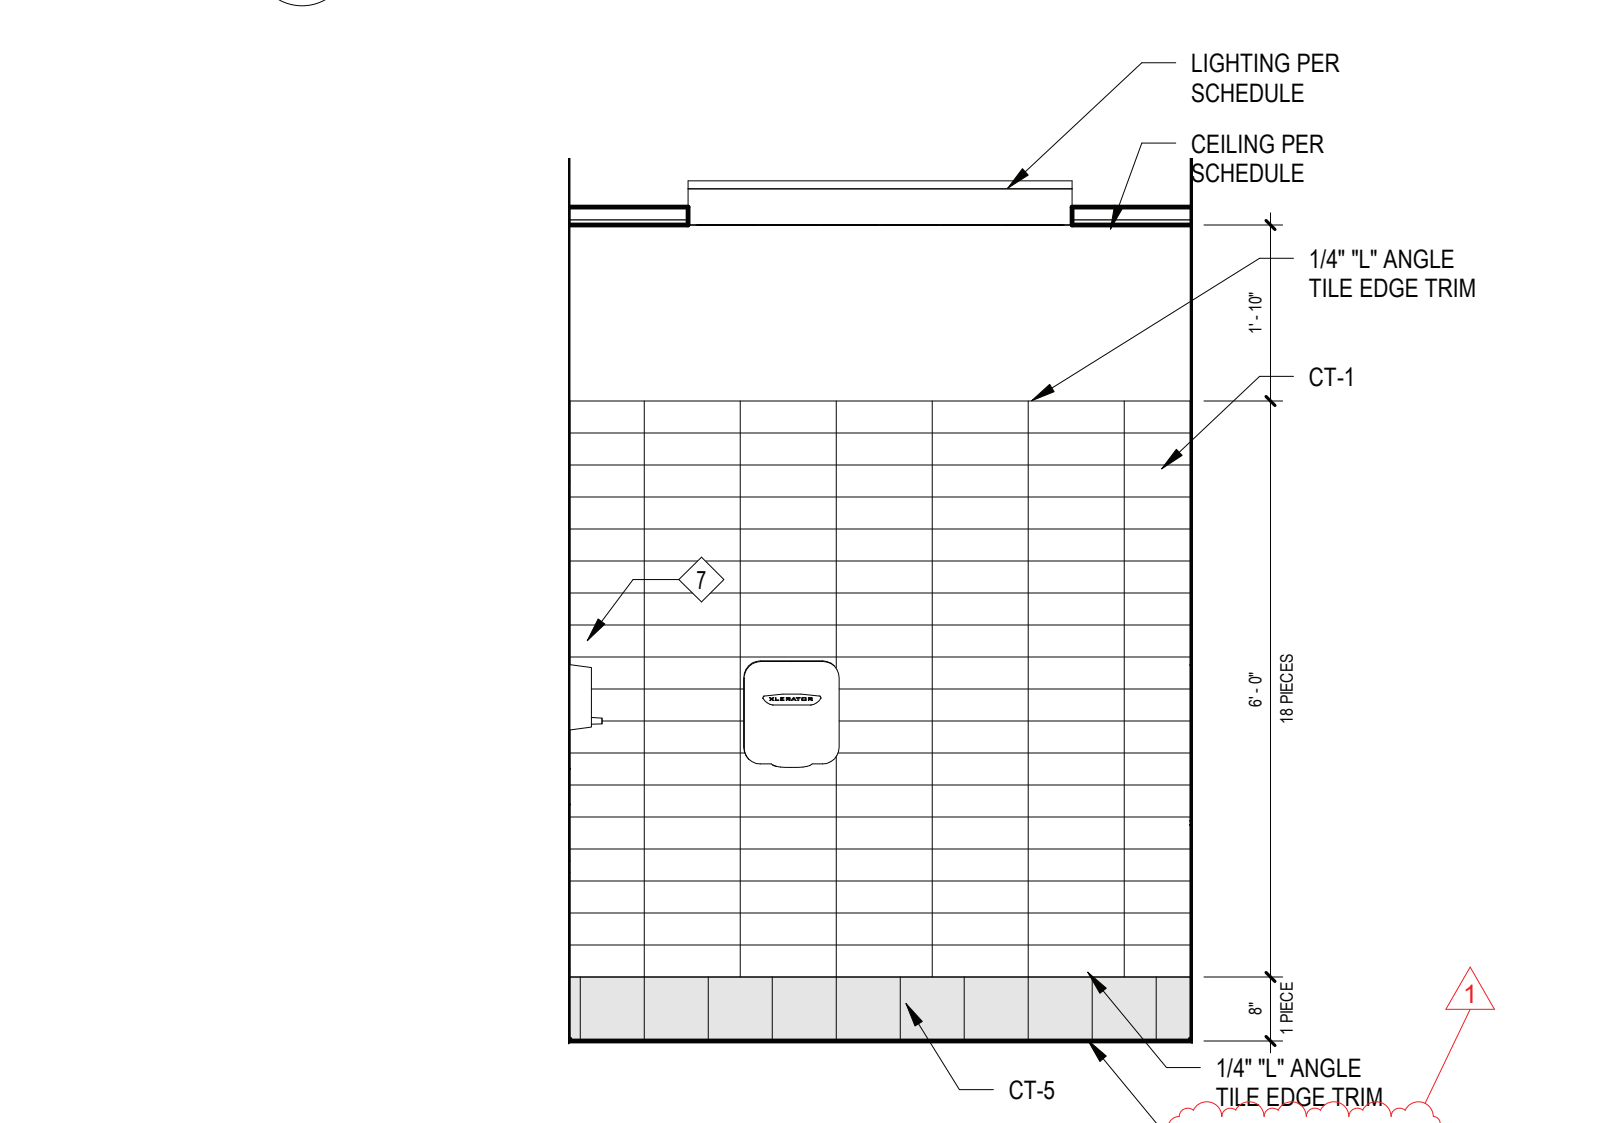

11 UNISEX ADA RESTROOM 181A - INTERIOR ELEVATION 4  
SCALE: 1/2" = 1'-0"

## BIDDER NOTE

NOTE: ADD ALTERNATE #2 TO BASE BID GC-1 PROVIDE ADDITIONAL WALL TILE TO CEILING ABOVE THE BASE BID WAINSCOT HEIGHT TYPICAL FOR ALL TOILETS ROOMS.

## TOILET KEY NOTES

NOTE: G.C. & P.C. COORDINATE ADA ACCESSIBLE FIXTURES LOCATION WITH PLANS. SEE A11.01 FOR TOILET ROOM MOUNTING STANDARDS. SYMBOL DENOTES ADA COMPLIANCE PLUMBING FIXTURE

- P.C. TO FURNISH AND INSTALL ALL NEW WALL MOUNTED WATER CLOSET AND FLUSHOMETER.
- P.C. TO FURNISH AND INSTALL ALL NEW FLOOR MOUNTED WATER CLOSET AND FLUSHOMETER.
- P.C. TO FURNISH AND INSTALL NEW LAVATORY AND FAUCET.
- G.C. TO FURNISH AND INSTALL NEW 18" GRAB BAR.
- G.C. TO FURNISH AND INSTALL NEW 42" GRAB BAR.
- G.C. TO FURNISH AND INSTALL NEW 36" GRAB BAR.
- OWNER TO FURNISH AND G.C. TO INSTALL NEW TOILET PAPER DISPENSER.
- G.C. TO FURNISH AND INSTALL NEW HAND DRYER. G.C. TO COORDINATE LOCATION WITH E.C.
- OWNER TO FURNISH AND G.C. TO INSTALL NEW SOAP DISPENSER.
- P.C. TO FURNISH AND INSTALL NEW FLOOR DRAINS. REFER TO PLUMBING DRAWINGS FOR ADDITIONAL INFORMATION.
- G.C. TO FURNISH AND INSTALL NEW FLAT MIRROR.
- G.C. TO FURNISH AND INSTALL NEW SANITARY NAPKIN & TAMPON DISPENSER. REFER TO SPECIFICATIONS FOR ADDITIONAL INFORMATION.
- G.C. TO FURNISH AND INSTALL NEW SANITARY NAPKIN DISPOSAL. REFER TO SPECIFICATIONS FOR ADDITIONAL INFORMATION.
- P.C. TO FURNISH AND INSTALL NEW URINAL AND FLUSHOMETER.
- G.C. TO FURNISH AND INSTALL ALL TOILET PARTITION WALLS, DOORS AND HARDWARE.
- G.C. TO FURNISH AND INSTALL ALL URINAL PARTITION WALLS.
- HORIZONTAL WALL MOUNTED CHANGING STATION/ TABLE
- G.C. TO FURNISH AND INSTALL COAT/ROBE HOOK. BRADLEY CONCEALED MOUNTING CHROME-PLATED ROBE HOOK, ON BACK OF DOOR.
- ADA DRINKING WATER FOUNTAIN WITH BOTTLE REFILLING STATION
- DRINKING WATER FOUNTAIN STATION

REV.	DATE	ITEM
1	11/28/2022	ADDENDUM #1

**NOTICE**  
THESE DRAWINGS ARE BASED ON CONSTRUCTION DRAWINGS NOT PREPARED BY BBS ARCHITECTS, LANDSCAPE ARCHITECTS AND ENGINEERS, P.C. AND THEREFORE, MAY NOT REPRESENT THE CONDITIONS AS CONSTRUCTED AT THE TIME. ALL EXISTING CONDITIONS SHALL BE REPRESENTED AS SUGGESTIVE INFORMATION AS THEY MAY NOT HAVE BEEN BUILT AND SHOULD BE THE ORIGINAL DOCUMENTS OF THE OWNER'S INFORMATION.

BRIARCLIFF MANOR U.F.S.D.  
PHASE 2 BOND IMPROVEMENTS  
BRIARCLIFF MANOR MIDDLE / HIGH SCHOOL  
444 PLEASANTVILLE RD. BRIARCLIFF MANOR, NY 10510

PROJECT

DRWG. BY: J.N.  
CHK. BY: G.E.O.

THIS DRAWING, PREPARED FOR THE SPECIFIC PROJECT INDICATED IS AN INSTRUMENT OF SERVICE AND THE PROPERTY OF BBS ARCHITECTS, LANDSCAPE ARCHITECTS AND ENGINEERS, P.C. REPRODUCTION OR ANY USE OF THIS DRAWING FOR ANY OTHER PROJECT IS PROHIBITED. ANY ALTERATION OR REPRODUCTION OF THIS DOCUMENT IS ALSO PROHIBITED WITHOUT THE WRITTEN CONSENT OF BBS ARCHITECTS OR ENGINEERS.

**BBS**  
ARCHITECTS  
LANDSCAPE ARCHITECTS  
ENGINEERS

BRANCH PROJECT CONTACT  
187 WOLF ROAD, STE. 205  
ALBANY  
NEW YORK 12205  
T: 518.621.7650

244 EAST MAIN STREET  
PATCHOGUE  
NEW YORK 11772  
T: 631.475.0349  
F: 631.475.0361

www.bbsarchitect.com

SED NO. 66-14-02-02-0-004-023

DISTRICT BRIARCLIFF MANOR U.F.S.D.

PROJECT PHASE 2 BOND IMPROVEMENTS

DWG TITLE ENLARGED RESTROOM PLANS & ELEVATIONS

SCALE: AS NOTED  
DATE: -  
BID PAU DATE: 11/14/2022  
FILE NO.: 21-274C

A11.01 HSMS



REV.	DATE	ITEM
1	11/28/2022	ADDENDUM #1

#### NOTICE

THESE DRAWINGS ARE BASED ON CONSTRUCTION DOCUMENTS PREPARED BY BBS ARCHITECTS, LANDSCAPE ARCHITECTS AND ENGINEERS, P.C. AND THEREFORE, THEY MAY NOT REPRESENT THE CONDITIONS AS CONSTRUCTED AT THE TIME. ALL EXISTING CONDITIONS SHOWN ARE REPRESENTED AS SUGGESTIVE INFORMATION AS THEY MAY NOT HAVE BEEN BUILT AND DESIGNED PER THE ORIGINAL DOCUMENTS OR PER THE OWNER'S INFORMATION.

BRIARCLIFF MANOR U.F.S.D.  
PHASE 2 BOND IMPROVEMENTS  
BRIARCLIFF MANOR MIDDLE / HIGH SCHOOL  
444 PLEASANTVILLE RD. BRIARCLIFF MANOR, NY 10510

ENLARGED RESTROOM ELEVATIONS

PROJECT

CHK. BY: Author

CHK. BY: Checker

THIS DRAWING, PREPARED FOR THE SPECIFIC PROJECT INDICATED BY AN INSTRUMENT OF SERVICE AND THE PROPERTY OF BBS ARCHITECTS, LANDSCAPE ARCHITECTS AND ENGINEERS, P.C., IS NOT TO BE REPRODUCED OR ANY USE OF THIS DRAWING FOR ANY OTHER PROJECT IS PROHIBITED. ANY REPRODUCTION OR REUSE OF THIS DOCUMENT IS ALSO PROHIBITED WITHOUT THE WRITTEN CONSENT OF BBS ARCHITECTS, P.C.

**BBS**  
ARCHITECTS  
LANDSCAPE ARCHITECTS  
ENGINEERS

BRANCH PROJECT CONTACT: 187 WOLF ROAD, STE. 205 ALBANY, NEW YORK 12205 T: 518.621.7650  
244 EAST MAIN STREET PATCHOGUE, NEW YORK 11772 T: 631.475.0349 T: 631.475.0361  
www.bbsarchitecture.com

SED NO. 66-14-02-02-0-004-023

DISTRICT BRIARCLIFF MANOR U.F.S.D.

PROJECT PHASE 2 BOND IMPROVEMENTS

DWG TITLE ENLARGED RESTROOM ELEVATIONS


SCALE: AS NOTED

DATE: -

BID PAU DATE: 11/14/2022


FILE NO. 21-274C

A11.02 HSMS

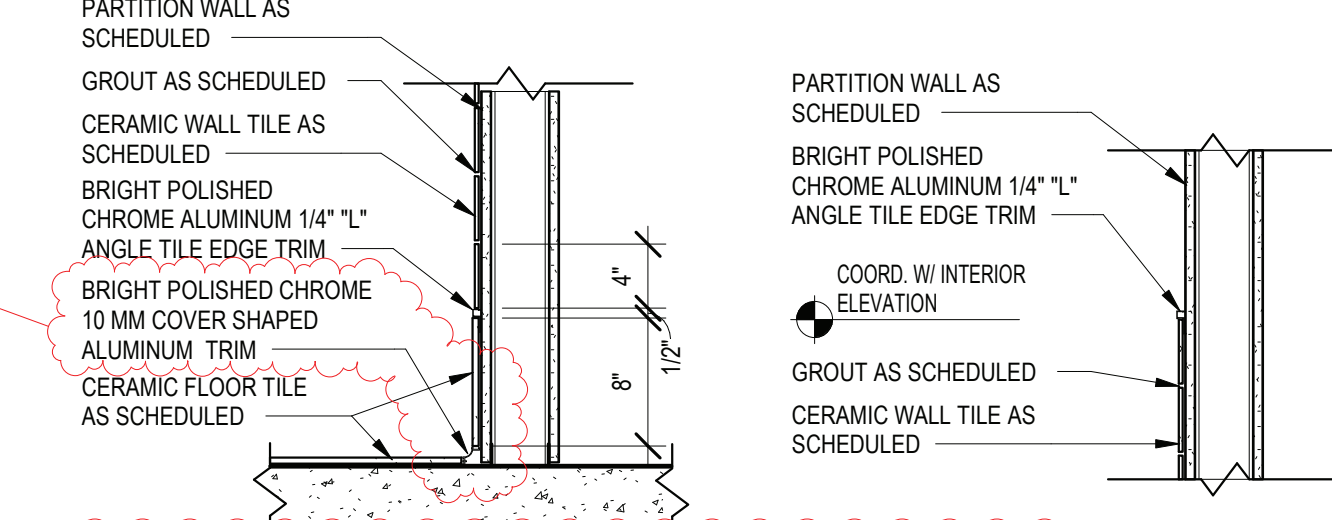

#### 17 TILE TRIM DETAILS

SCALE: 1" = 1'-0"

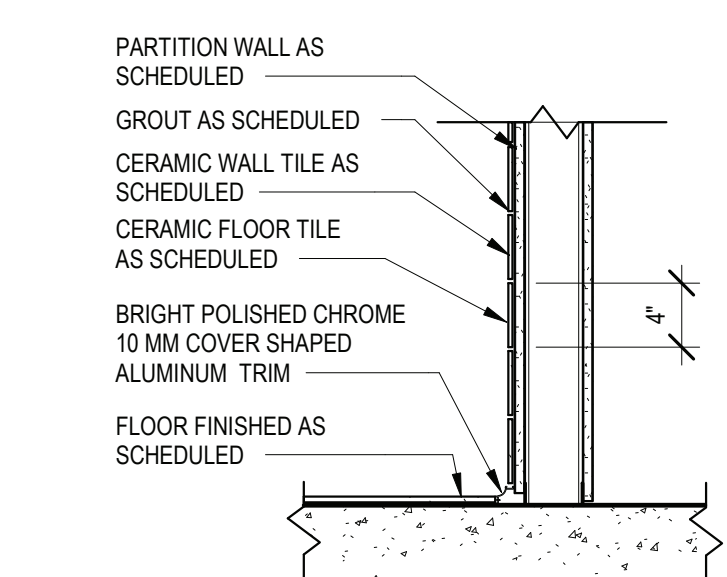

#### 18 BOY'S 158, GIRL'S 160 & DRINKING FOUNTAIN TRIM DETAILS

SCALE: 1" = 1'-0"

#### 1 UNISEX RESTROOM 181B - INTERIOR ELEVATION 1

SCALE: 1/2" = 1'-0"

#### 2 UNISEX RESTROOM 181B - INTERIOR ELEVATION 2

SCALE: 1/2" = 1'-0"

#### 3 UNISEX RESTROOM 181B - INTERIOR ELEVATION 3

SCALE: 1/2" = 1'-0"

#### 4 UNISEX RESTROOM 181B - INTERIOR ELEVATION 4

SCALE: 1/2" = 1'-0"

#### 5 STAFF ADA RESTROOM 111D - INTERIOR ELEVATION 1

SCALE: 1/2" = 1'-0"

#### 6 STAFF ADA RESTROOM 111D - INTERIOR ELEVATION 2

SCALE: 1/2" = 1'-0"

#### 7 STAFF ADA RESTROOM 111D - INTERIOR ELEVATION 3

SCALE: 1/2" = 1'-0"

#### 8 STAFF ADA RESTROOM 111D - INTERIOR ELEVATION 4

SCALE: 1/2" = 1'-0"

#### 9 UNISEX ADA RESTROOM 111A - INTERIOR ELEVATION 1

SCALE: 1/2" = 1'-0"

#### 10 UNISEX ADA RESTROOM 111A - INTERIOR ELEVATION 2

SCALE: 1/2" = 1'-0"

#### 11 UNISEX ADA RESTROOM 111A - INTERIOR ELEVATION 3

SCALE: 1/2" = 1'-0"

#### 12 UNISEX ADA RESTROOM 111A - INTERIOR ELEVATION 4

SCALE: 1/2" = 1'-0"

#### 13 UNISEX RESTROOM 111B - INTERIOR ELEVATION 1

SCALE: 1/2" = 1'-0"

#### 14 UNISEX RESTROOM 111B - INTERIOR ELEVATION 2

SCALE: 1/2" = 1'-0"

#### 15 UNISEX RESTROOM 111B - INTERIOR ELEVATION 3

SCALE: 1/2" = 1'-0"

#### 16 UNISEX RESTROOM 111B - INTERIOR ELEVATION 4

SCALE: 1/2" = 1'-0"

#### BIDDER NOTE


NOTE: ADD ALTERNATE # 2 TO BASE BID GC-1 PROVIDE ADDITIONAL WALL TILE TO CEILING ABOVE THE BASE BID WAINSCOT HEIGHT TYPICAL FOR ALL TOILET ROOMS.

#### TOILET KEY NOTES


NOTE: G.C. & P.C. COORDINATE ADA ACCESSIBLE FIXTURES LOCATION WITH PLANS. SEE A11.01 FOR TOILET ROOM MOUNTING STANDARDS. SYMBOL DENOTES ADA COMPLIANCE PUMBLING FIXTURE

- P.C. TO FURNISH AND INSTALL ALL NEW WALL MOUNTED WATER CLOSET AND FLUSHOMETER.
- P.C. TO FURNISH AND INSTALL ALL NEW FLOOR MOUNTED WATER CLOSET AND FLUSHOMETER.
- P.C. TO FURNISH AND INSTALL NEW LAVATORY AND FAUCET.
- G.C. TO FURNISH AND INSTALL NEW 16" GRAB BAR.
- G.C. TO FURNISH AND INSTALL NEW 42" GRAB BAR.
- G.C. TO FURNISH AND INSTALL NEW 36" GRAB BAR.
- OWNER TO FURNISH AND G.C. TO INSTALL NEW TOILET PAPER DISPENSER.
- G.C. TO FURNISH AND INSTALL NEW HAND DRYER. G.C. TO COORDINATE LOCATION WITH E.C.
- OWNER TO FURNISH AND G.C. TO INSTALL NEW SOAP DISPENSER.
- P.C. TO FURNISH AND INSTALL NEW FLOOR DRAINS. REFER TO PLUMBING DRAWINGS FOR ADDITIONAL INFORMATION.
- G.C. TO FURNISH AND INSTALL NEW FLAT MIRROR.
- G.C. TO FURNISH AND INSTALL NEW SANITARY NAPKIN & TAMPON DISPENSER. REFER TO SPECIFICATIONS FOR ADDITIONAL INFORMATION.
- G.C. TO FURNISH AND INSTALL NEW SANITARY NAPKIN DISPOSAL. REFER TO SPECIFICATIONS FOR ADDITIONAL INFORMATION.
- P.C. TO FURNISH AND INSTALL NEW URINAL AND FLUSHOMETER.
- G.C. TO FURNISH AND INSTALL ALL TOILET PARTITION WALLS, DOORS AND HARDWARE.
- G.C. TO FURNISH AND INSTALL ALL URINAL PARTITION WALLS.
- HORIZONTAL WALL MOUNTED CHANGING STATION/ TABLE
- G.C. TO FURNISH AND INSTALL COATROBE HOOK. BRADLEY CONCEALED MOUNTING CHROME-PLATED ROBE HOOK, ON BACK OF DOOR.
- ADA DRINKING WATER FOUNTAIN WITH BOTTLE REFILLING STATION
- DRINKING WATER FOUNTAIN STATION




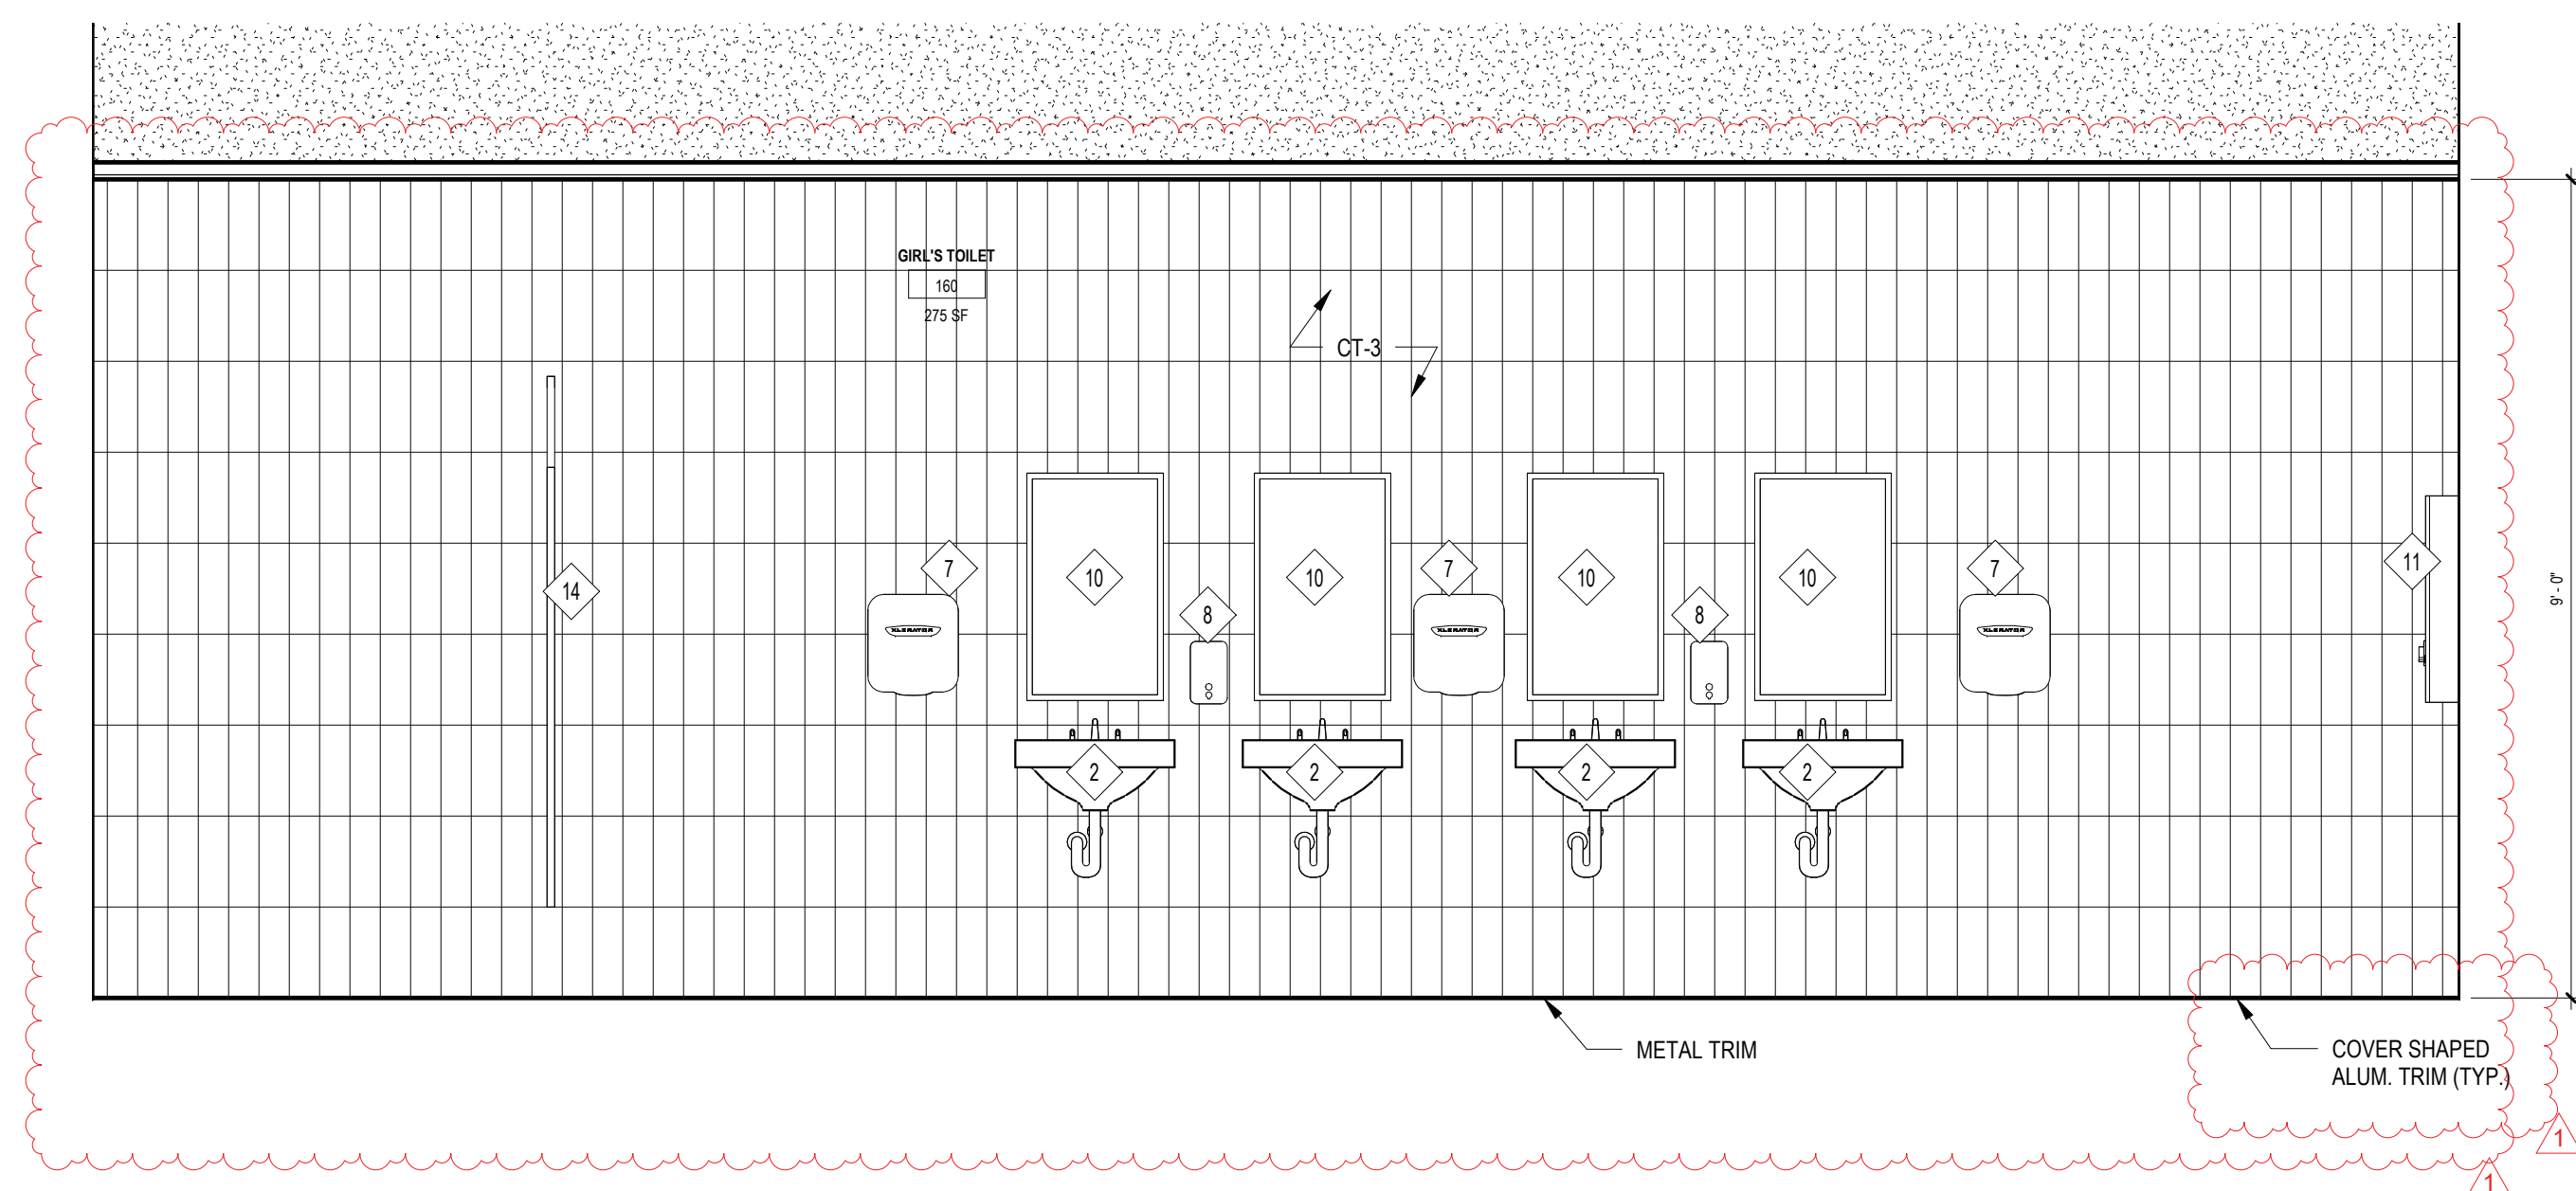


1 GIRL'S RESTROOM - INTERIOR ELEVATION 1  
SCALE: 1/2" = 1'-0"

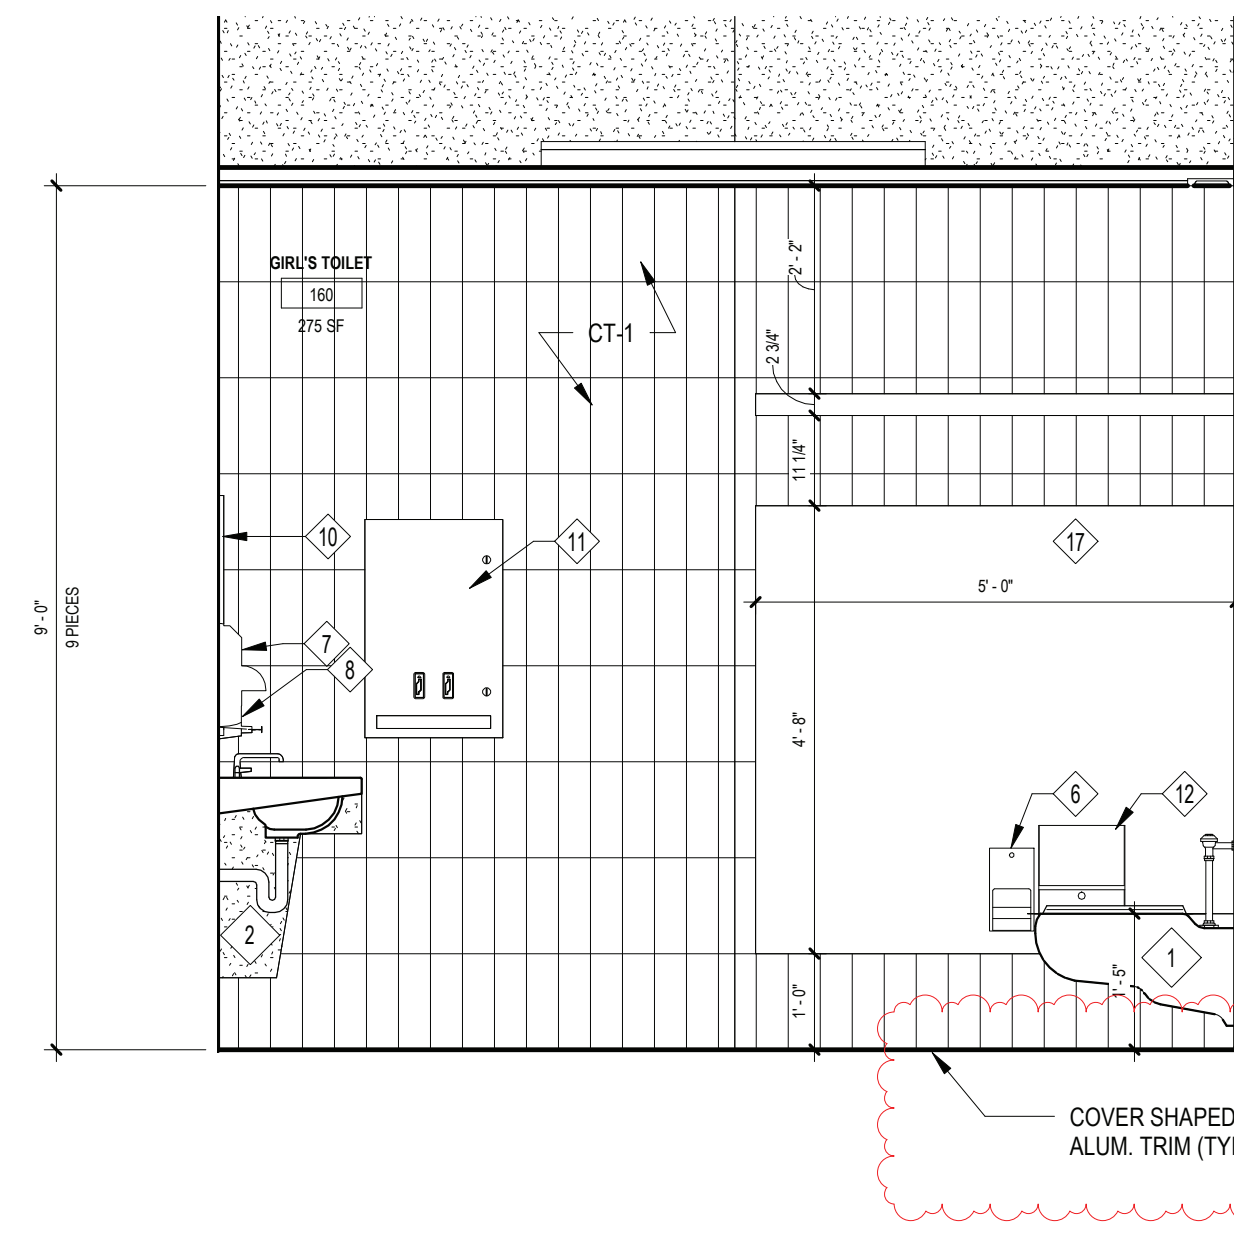


2 GIRL'S RESTROOM - INTERIOR ELEVATION 2  
SCALE: 1/2" = 1'-0"

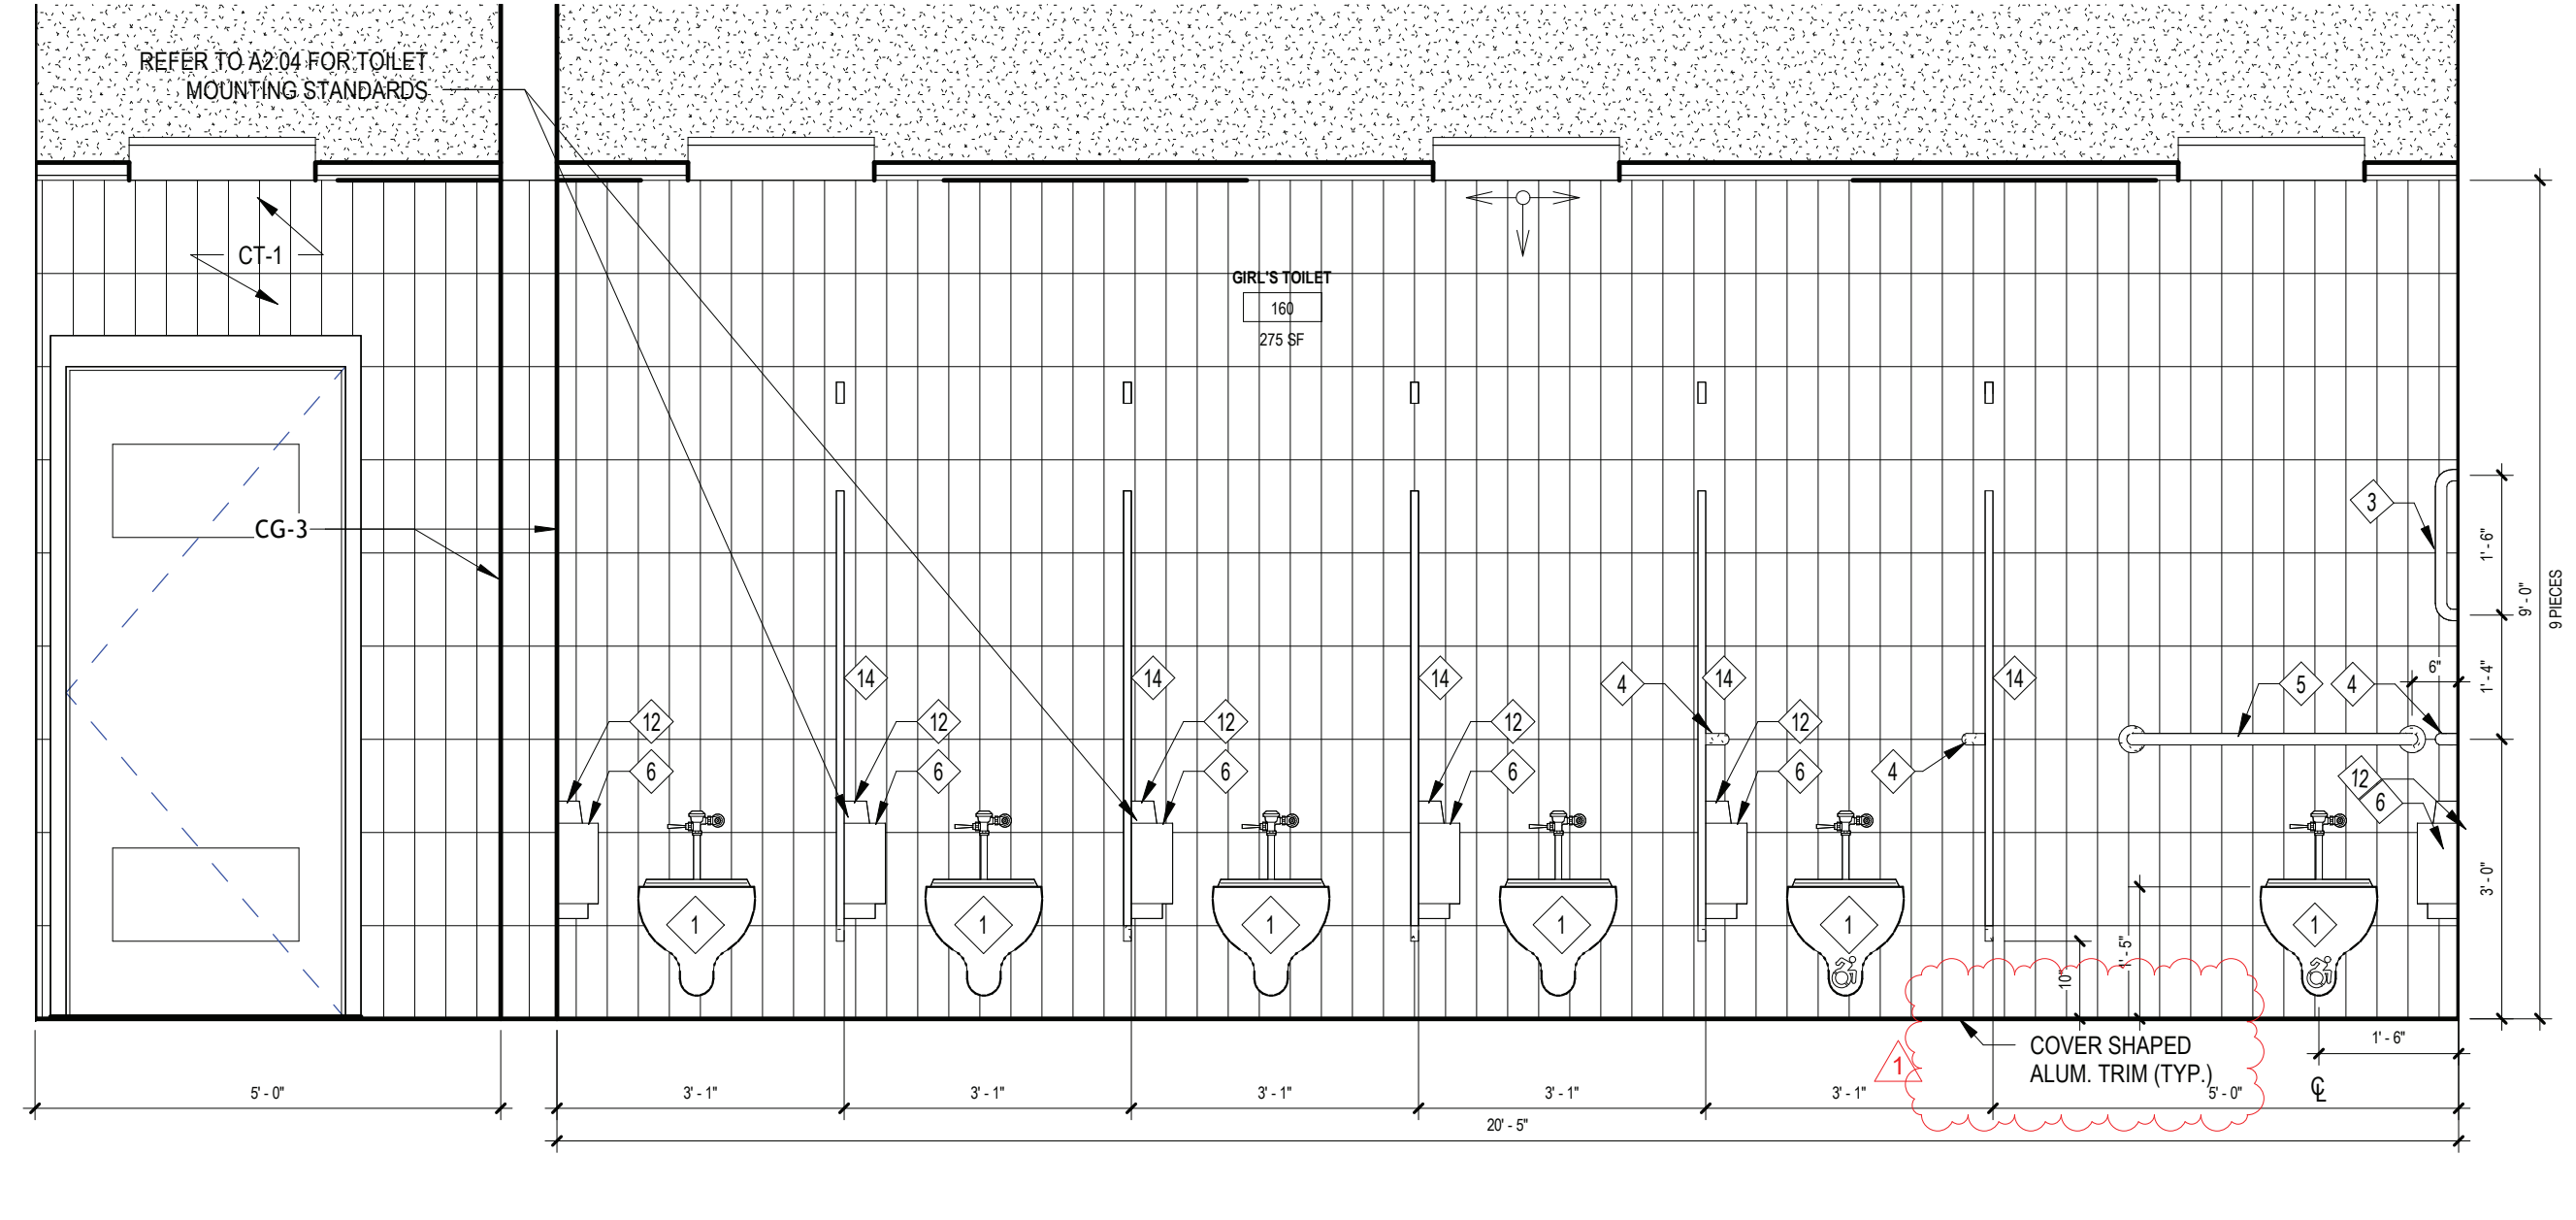


3 GIRL'S RESTROOM - INTERIOR ELEVATION 3  
SCALE: 1/2" = 1'-0"

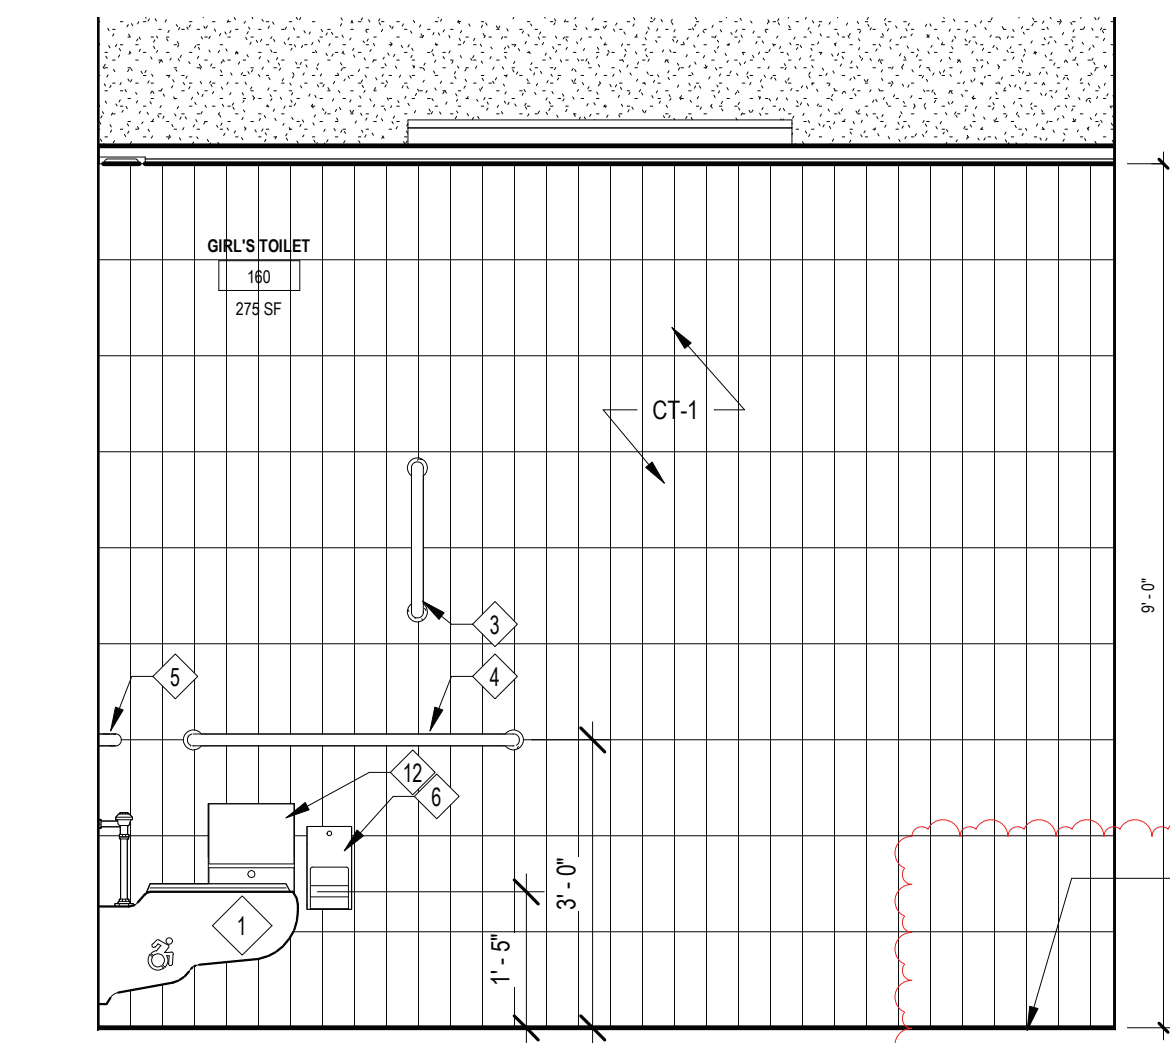


4 GIRL'S RESTROOM - INTERIOR ELEVATION 4  
SCALE: 1/2" = 1'-0"

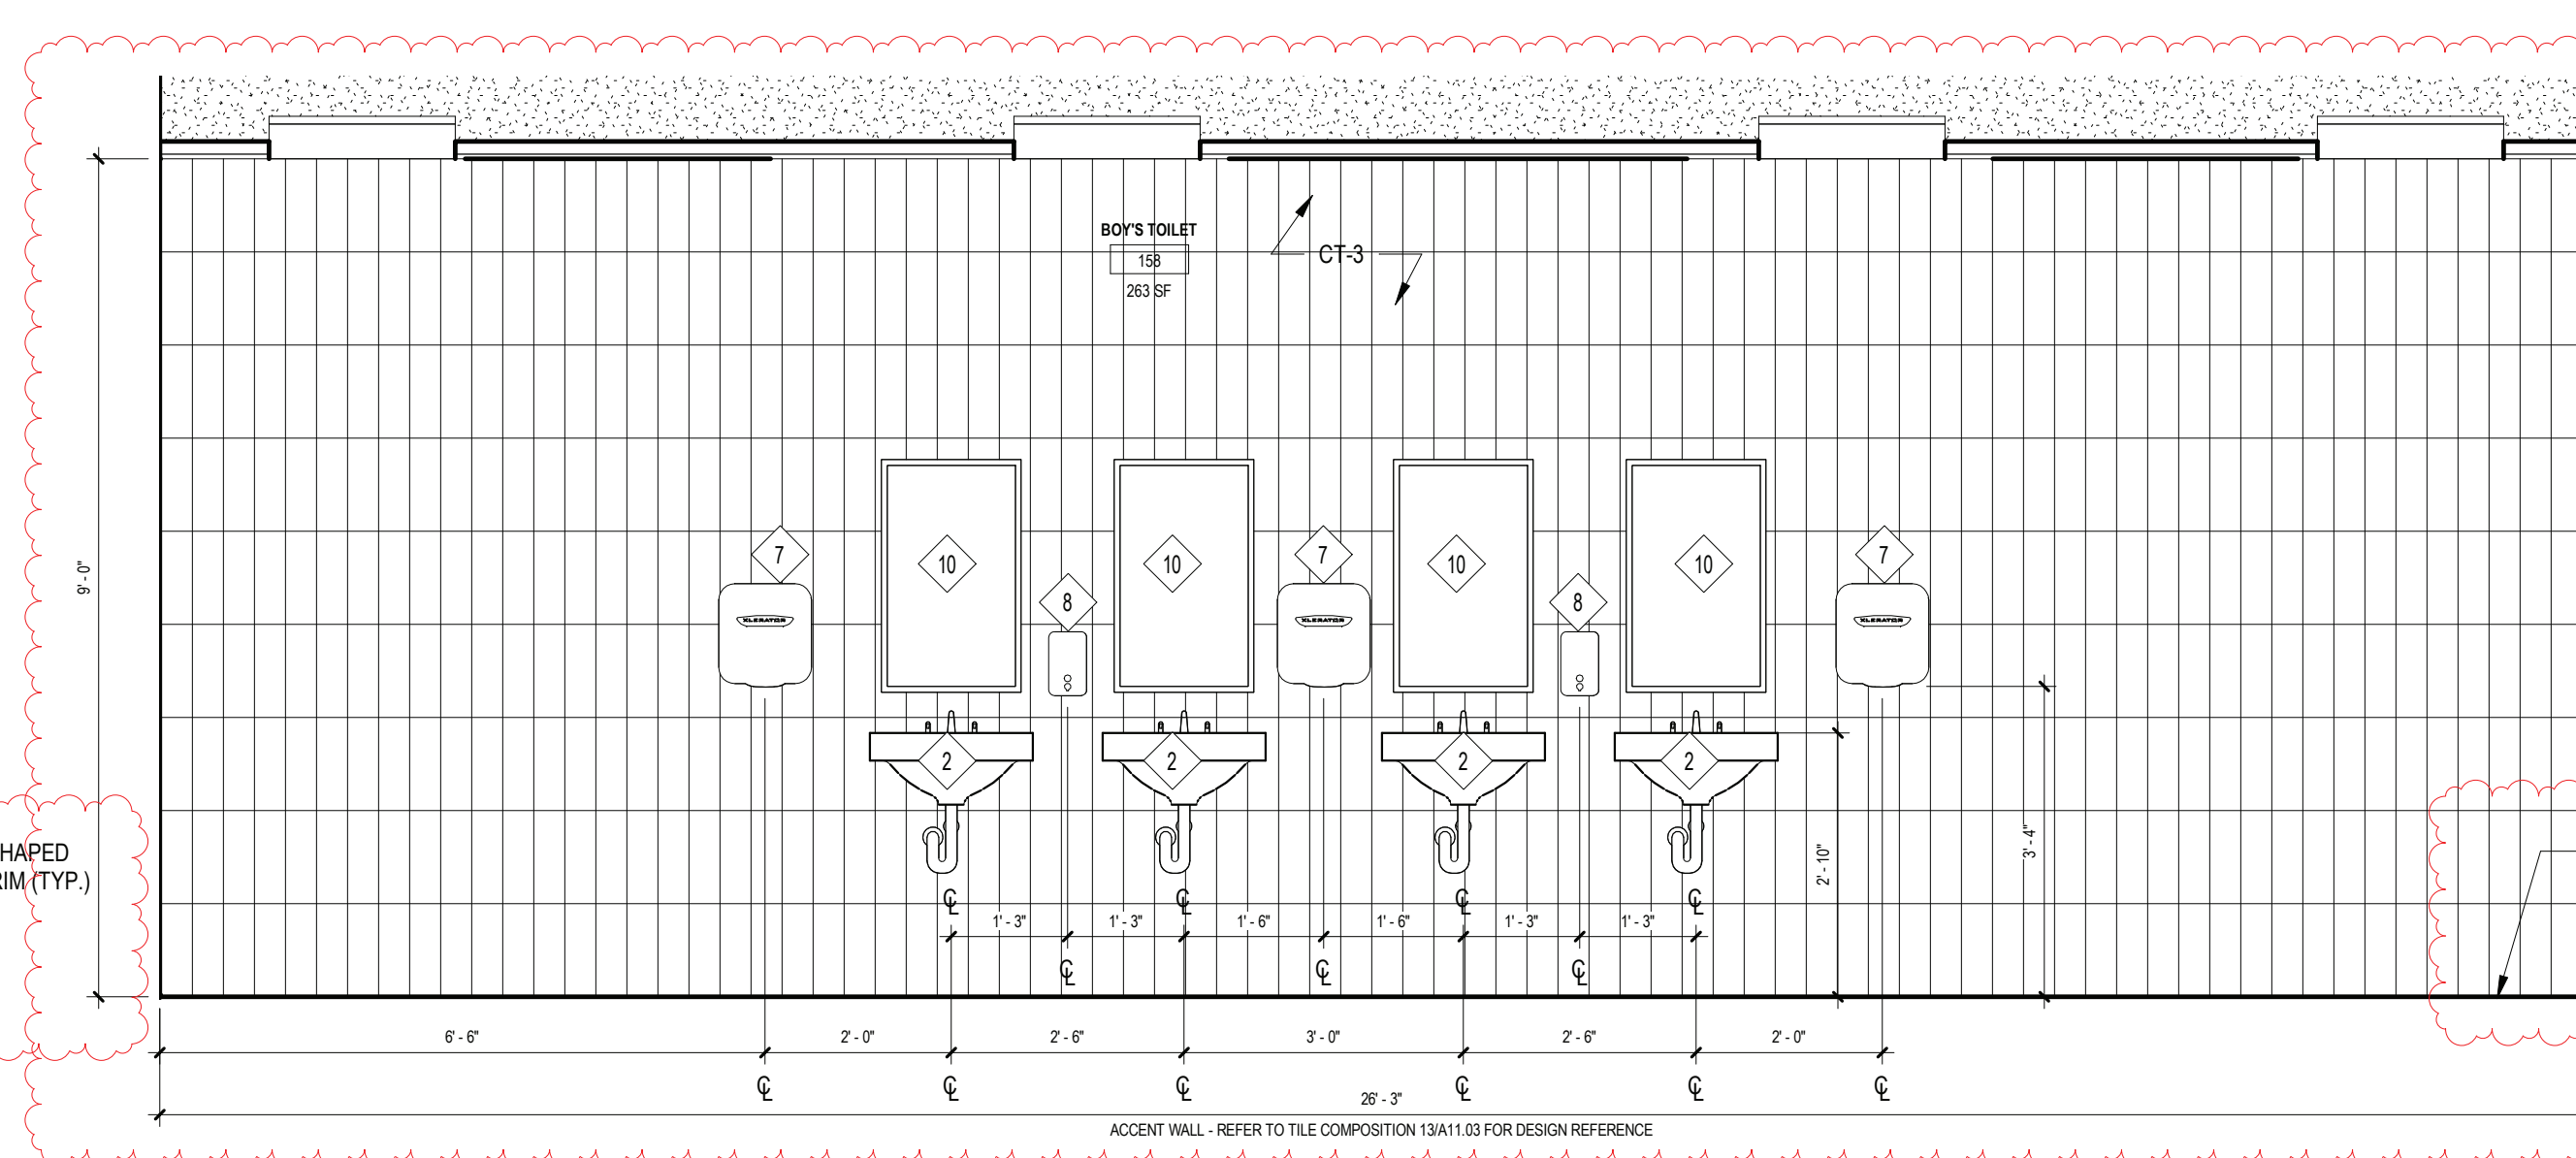


5 BOY'S RESTROOM - INTERIOR ELEVATION 4  
SCALE: 1/2" = 1'-0"

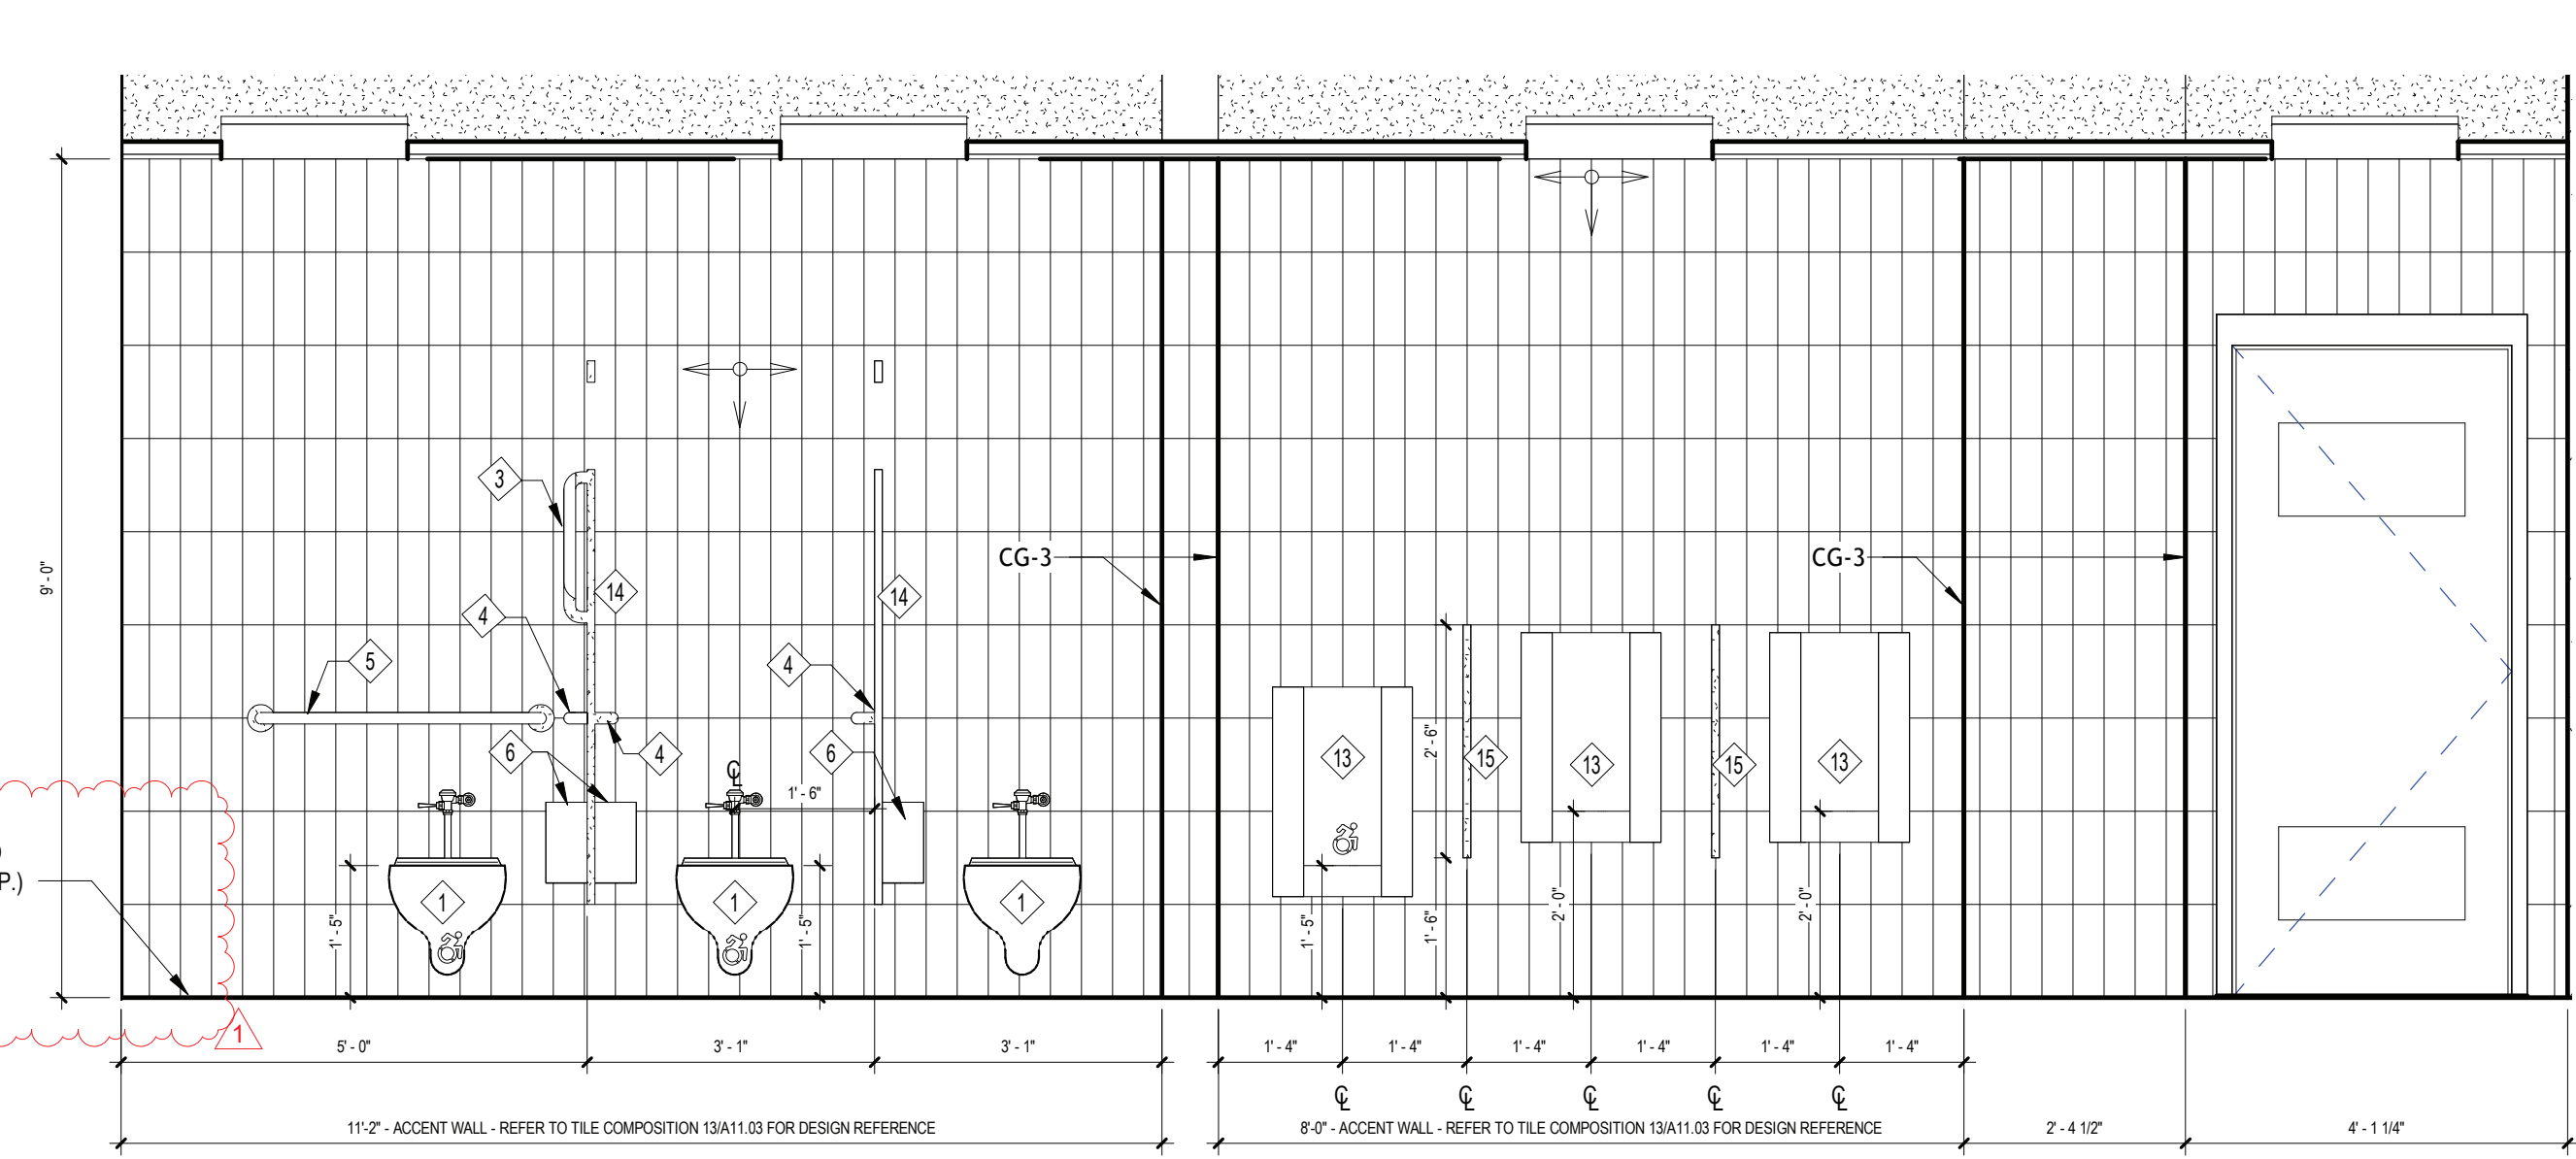


6 BOY'S RESTROOM - INTERIOR ELEVATION 2  
SCALE: 1/2" = 1'-0"

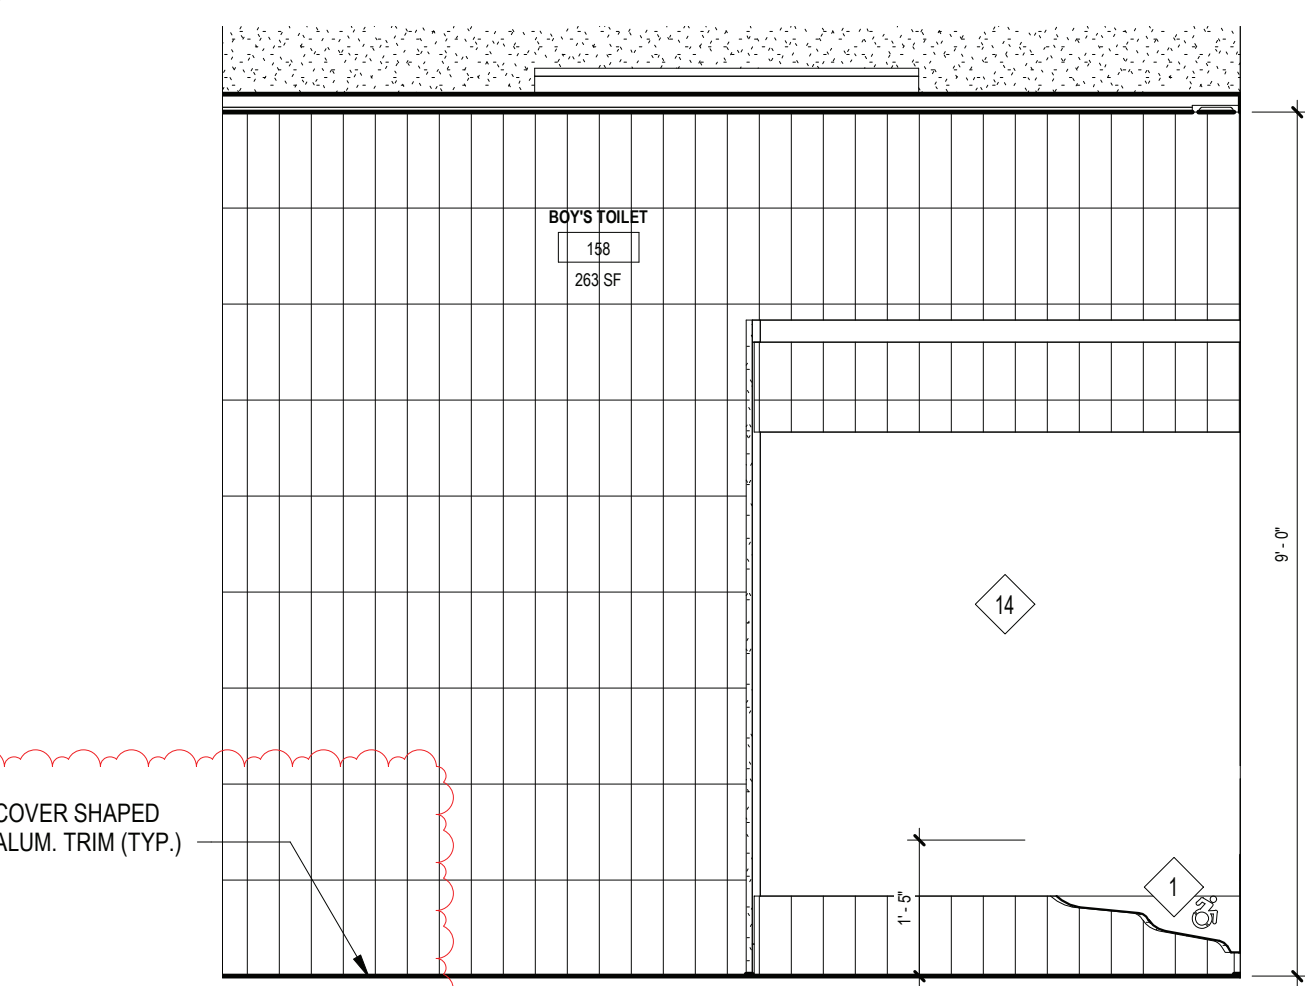


7 BOY'S RESTROOM - INTERIOR ELEVATION 1  
SCALE: 1/2" = 1'-0"

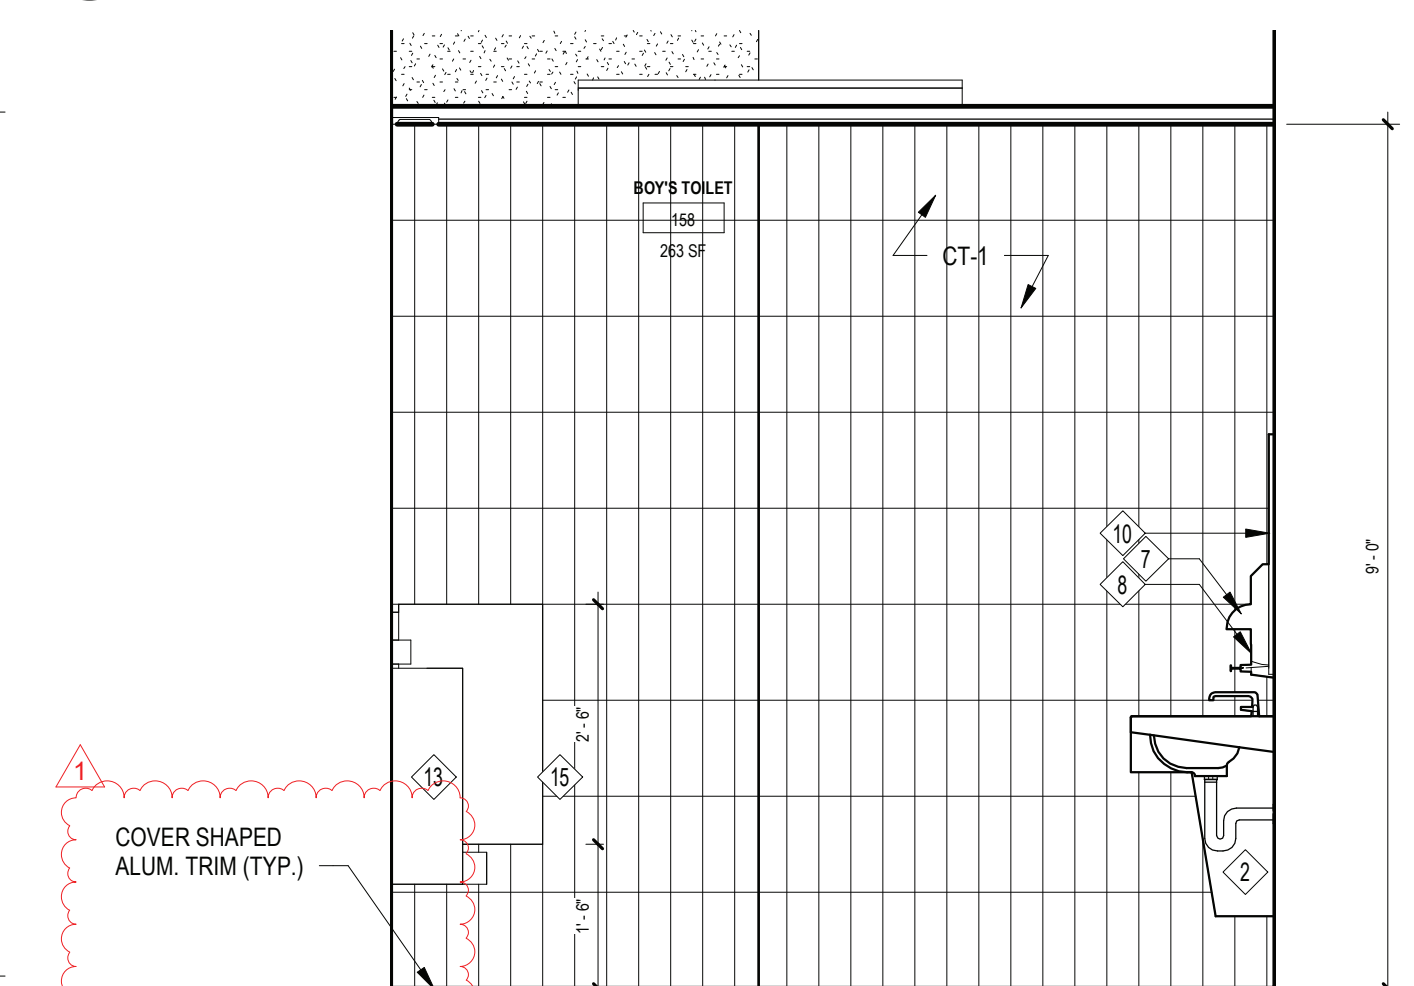


8 BOY'S RESTROOM - INTERIOR ELEVATION 3  
SCALE: 1/2" = 1'-0"

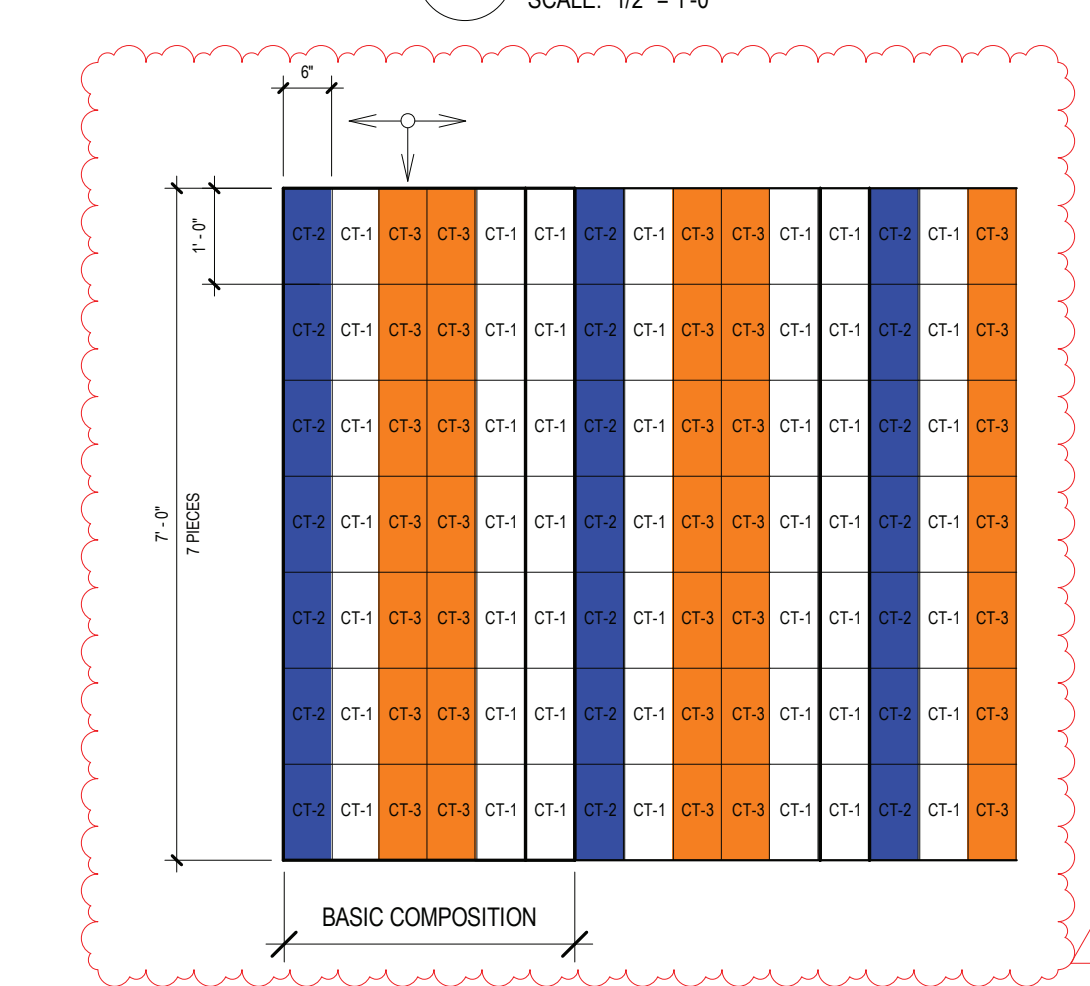


13 TILE COMPOSITION - REFERENCE ELEVATION  
SCALE: 1/2" = 1'-0"

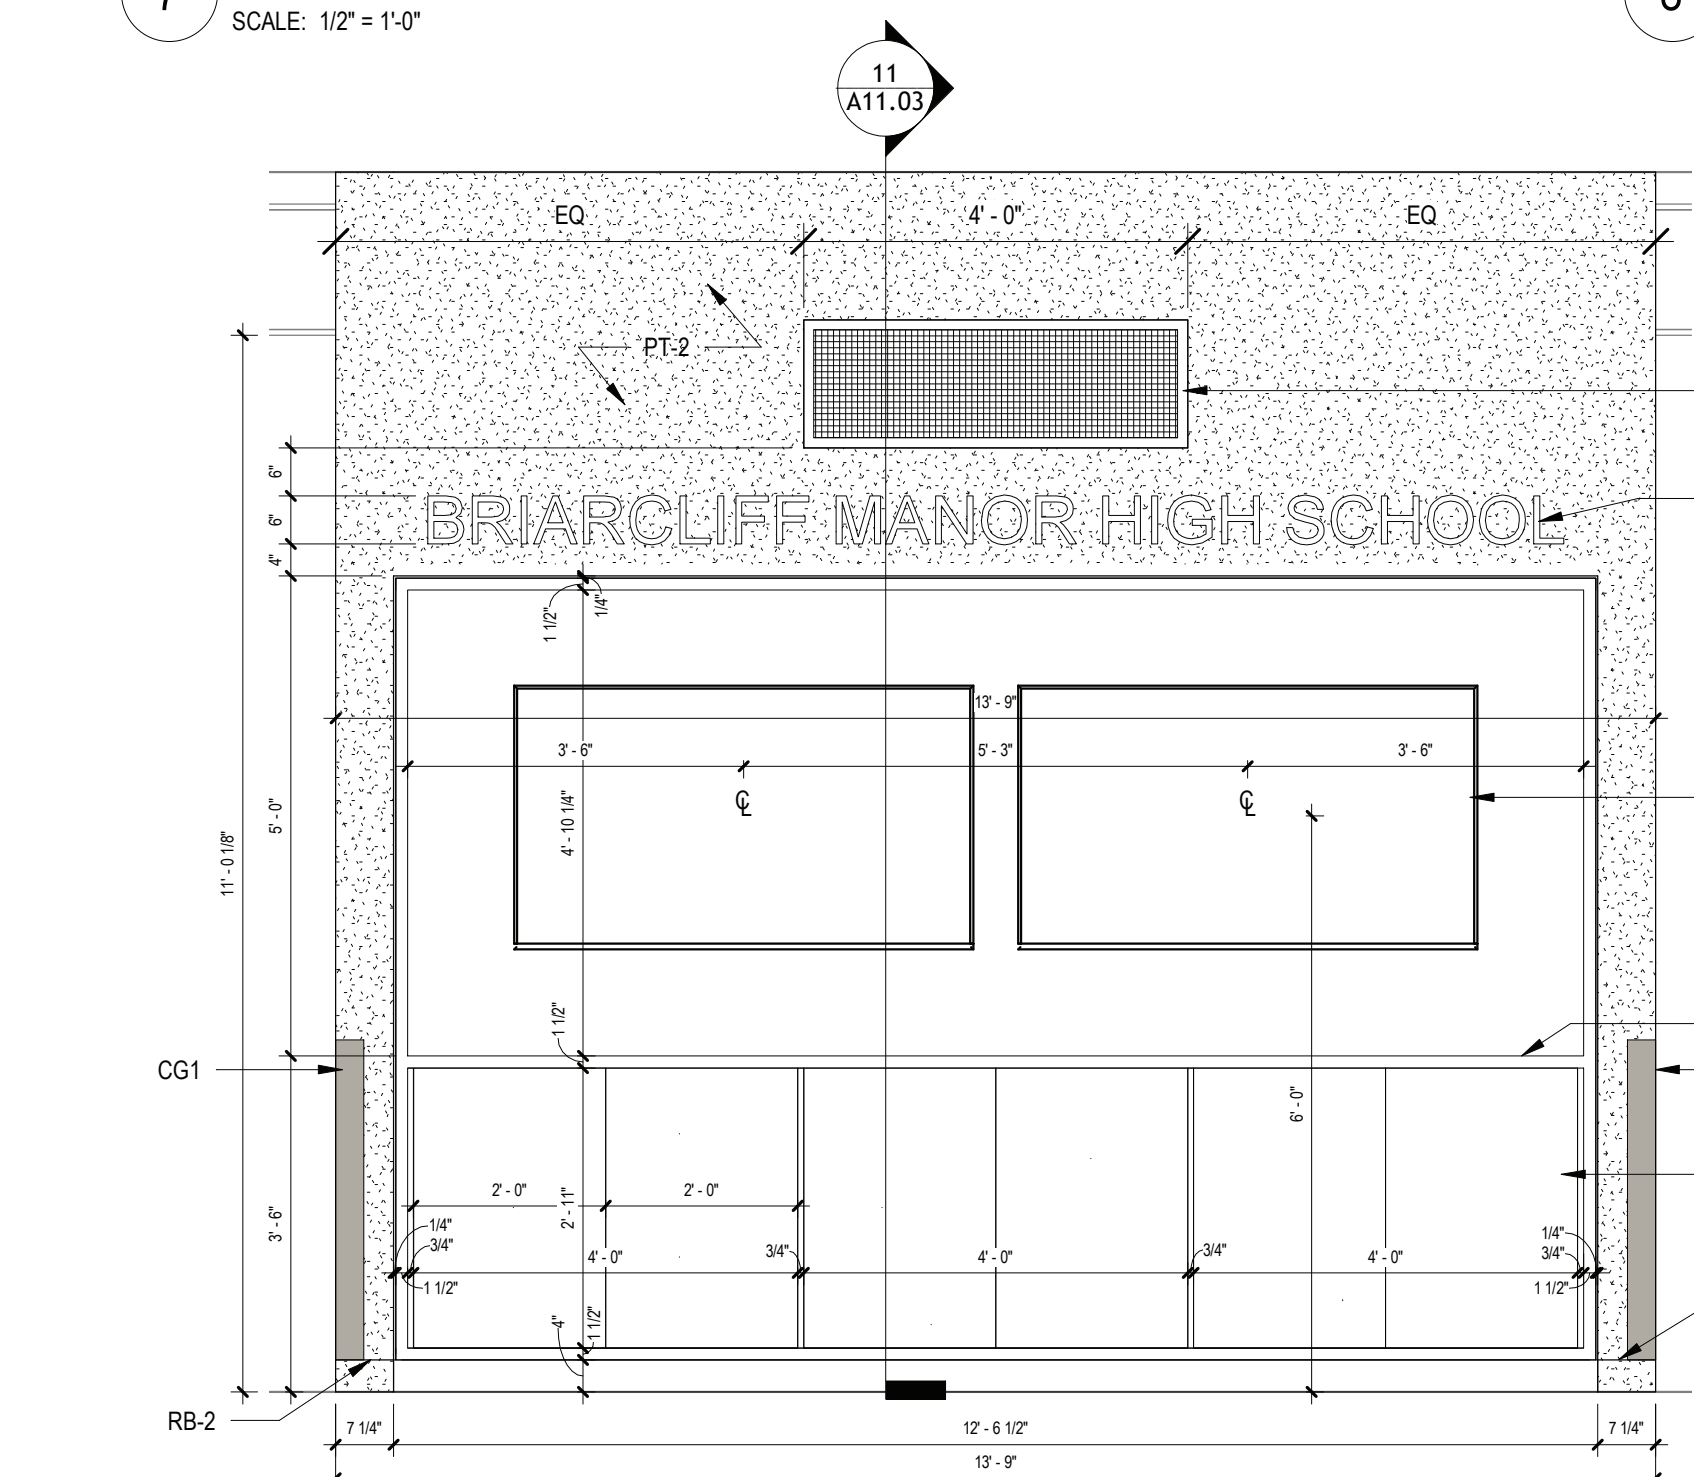


9 ENTRANCE DISPLAY - INTERIOR ELEVATION  
SCALE: 1/2" = 1'-0"

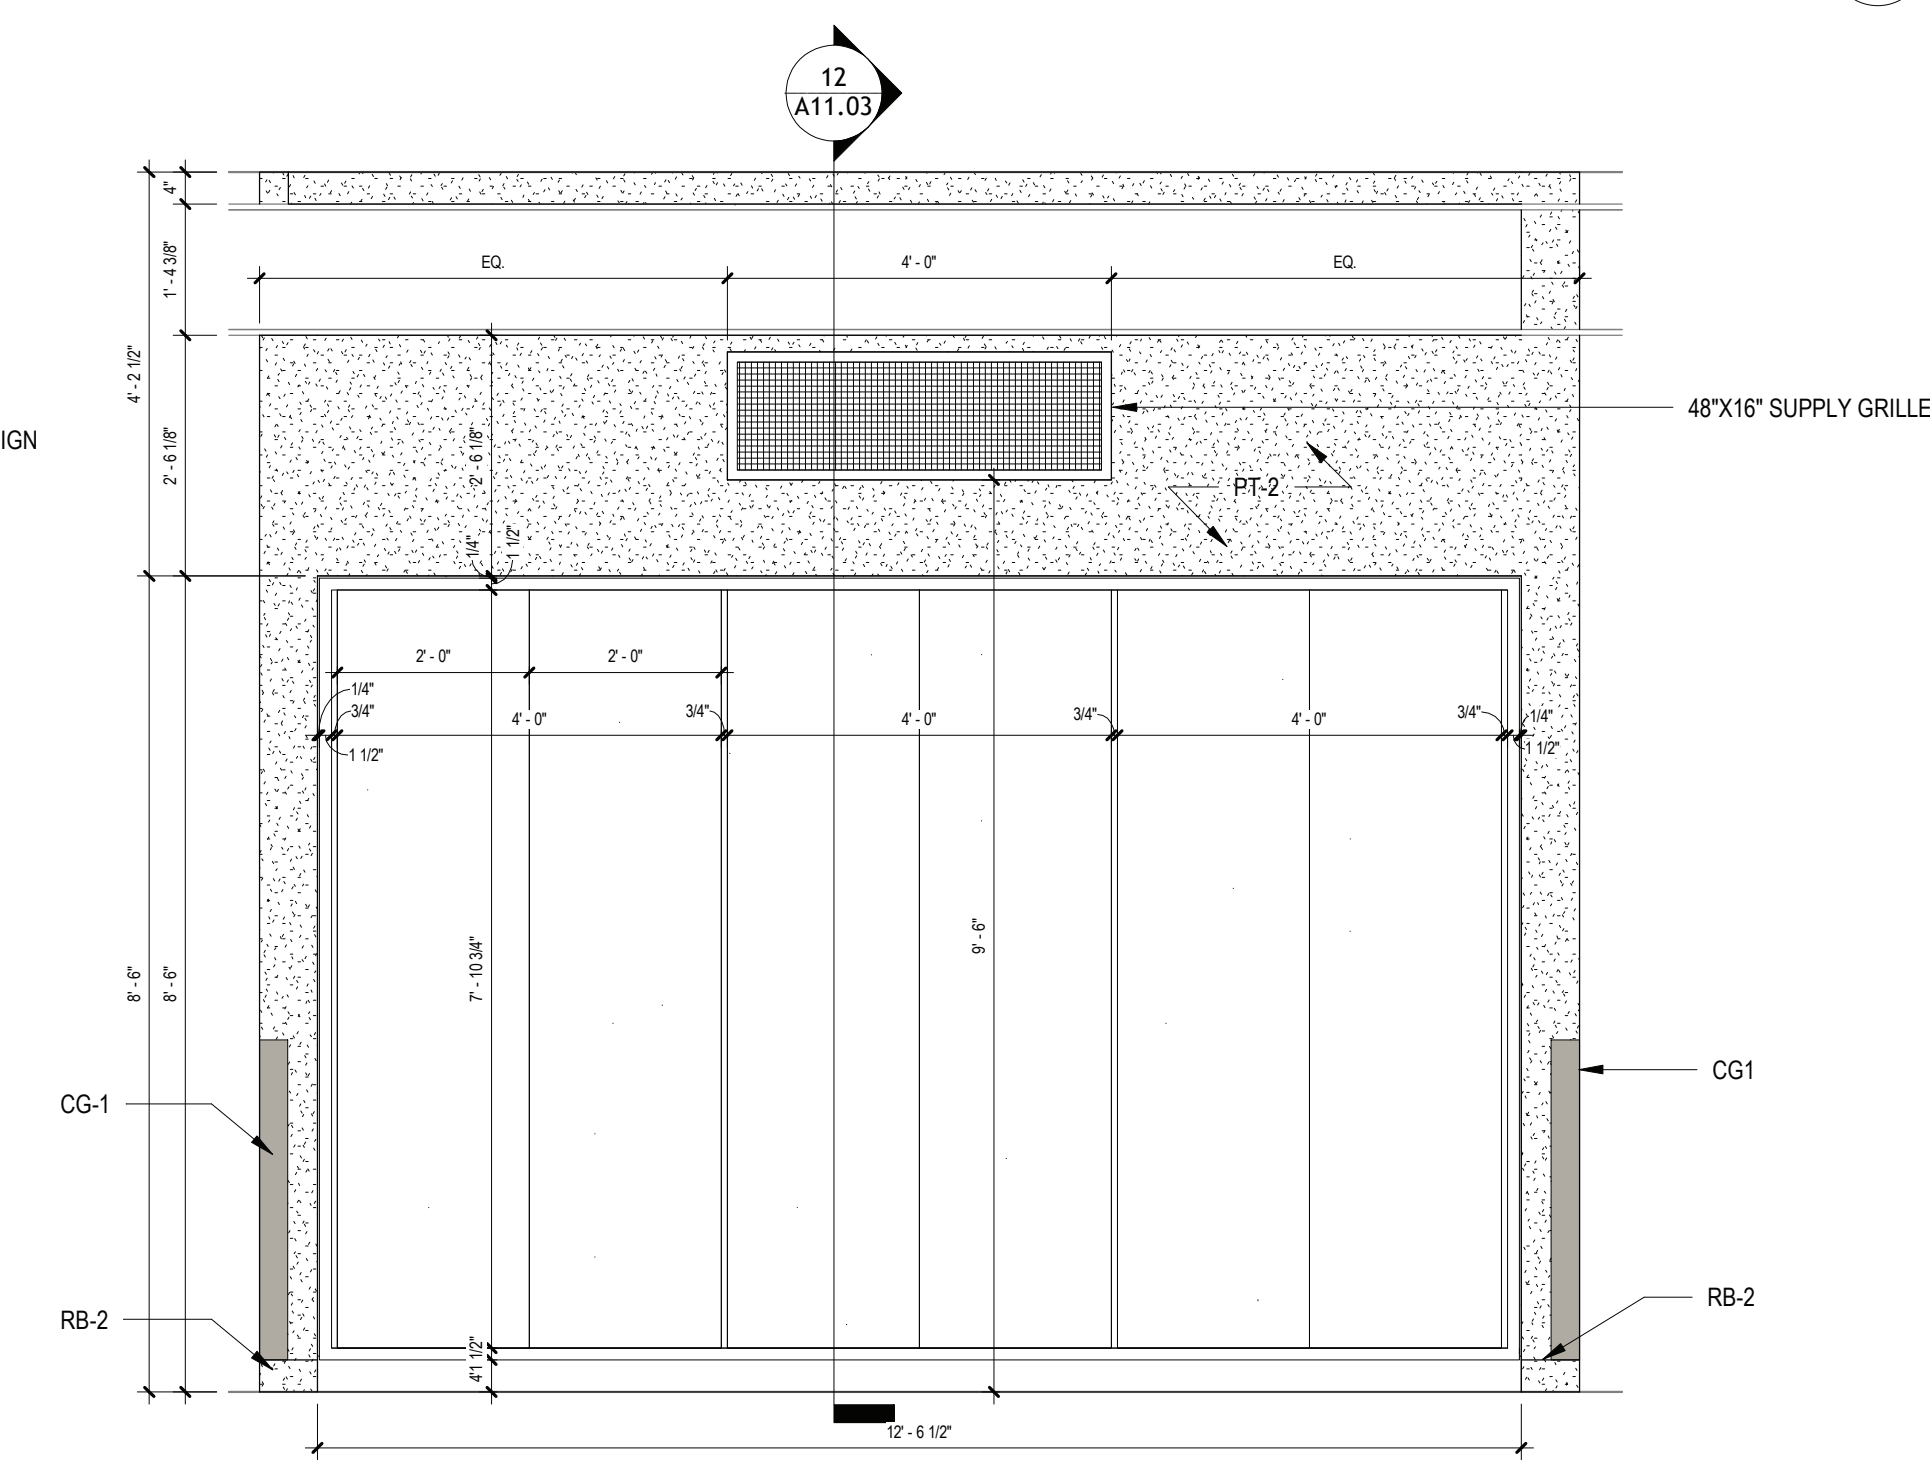

10 CORRIDOR C DISPLAY - INTERIOR ELEVATION  
SCALE: 1/2" = 1'-0"

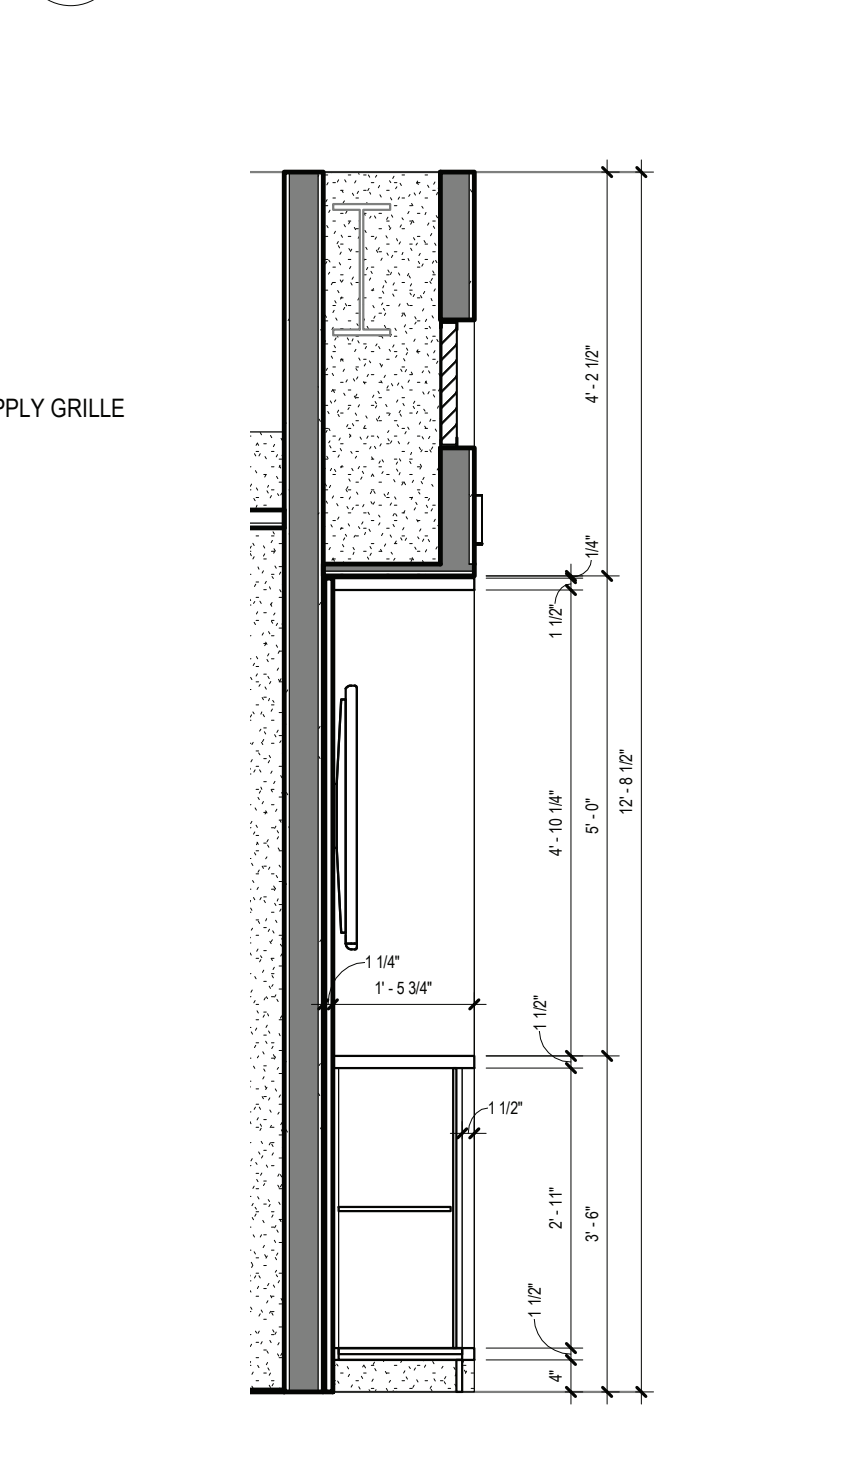

11 ENTRANCE DISPLAY WALL SECTION  
SCALE: 1/2" = 1'-0"

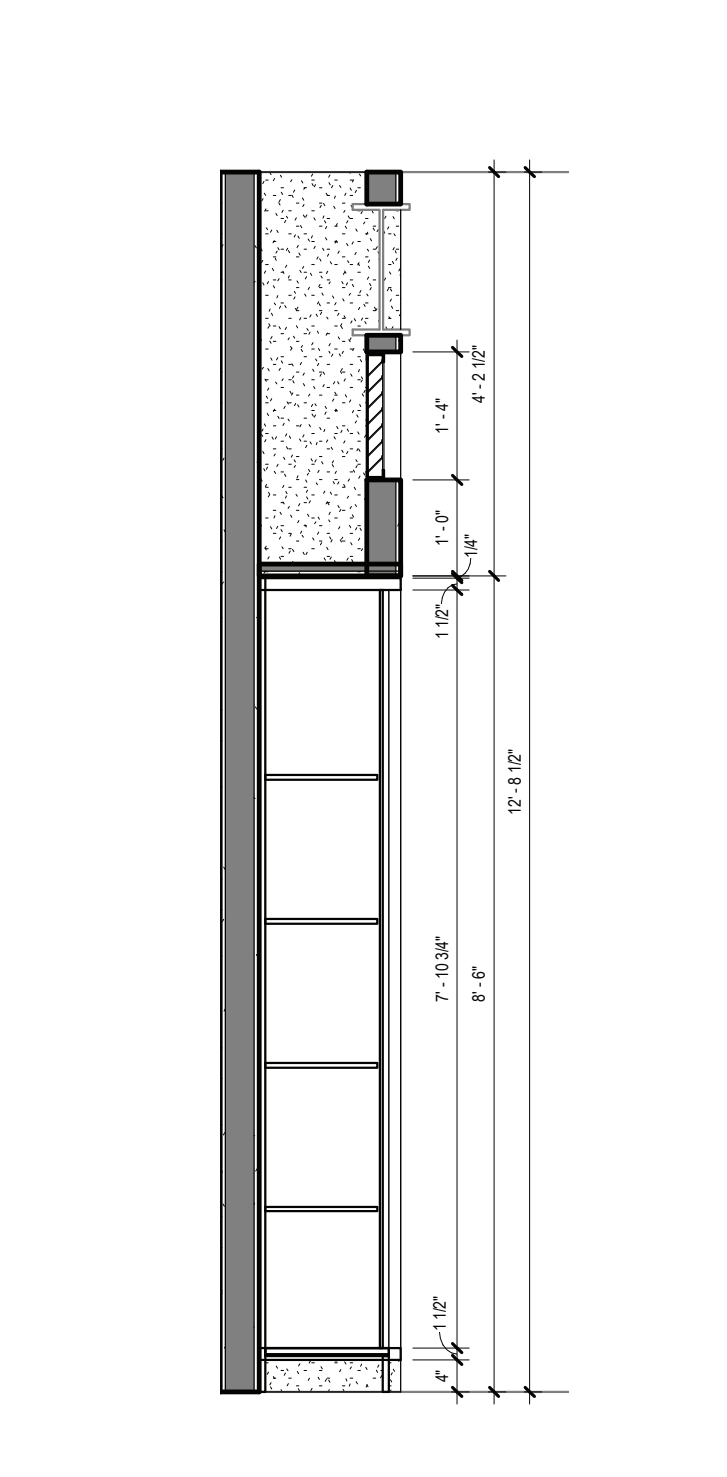

12 CORRIDOR C WALL SECTION  
SCALE: 1/2" = 1'-0"

## BIDDER NOTE

**NOTE:** ADD ALTERNATE # 2 TO BASE BID GC-1 PROVIDE ADDITIONAL WALL TILE TO CEILING ABOVE THE BASE BID WAINSCOT HEIGHT TYPICAL FOR ALL TOILETS ROOMS.

## TOILET KEY NOTES

**NOTE:** G.C. & P.C. COORDINATE ADA ACCESSIBLE FIXTURES LOCATION WITH PLANS SEE A11.01 FOR TOILET ROOM MOUNTING STANDARDS. SYMBOL DENOTES ADA COMPLIANCE PUMPELING FIXTURE

- 1 P.C. TO FURNISH AND INSTALL ALL NEW WALL MOUNTED WATER CLOSET AND FLUSHOMETER.
- 2 P.C. TO FURNISH AND INSTALL ALL NEW FLOOR MOUNTED WATER CLOSET AND FLUSHOMETER.
- 3 P.C. TO FURNISH AND INSTALL NEW LAVATORY AND FAUCET.
- 4 G.C. TO FURNISH AND INSTALL NEW 18" GRAB BAR.
- 5 G.C. TO FURNISH AND INSTALL NEW 36" GRAB BAR.
- 6 OWNER TO FURNISH AND G.C. TO INSTALL NEW TOILET PAPER DISPENSER.
- 7 G.C. TO FURNISH AND INSTALL NEW HAND DRYER. G.C. TO COORDINATE LOCATION WITH E.C.
- 8 OWNER TO FURNISH AND G.C. TO INSTALL NEW SOAP DISPENSER.
- 9 P.C. TO FURNISH AND INSTALL NEW FLOOR DRAINS. REFER TO PLUMBING DRAWINGS FOR ADDITIONAL INFORMATION.
- 10 G.C. TO FURNISH AND INSTALL NEW FLAT MIRROR.
- 11 G.C. TO FURNISH AND INSTALL NEW SANITARY NAPKIN & TAMPON DISPENSER. REFER TO SPECIFICATIONS FOR ADDITIONAL INFORMATION.
- 12 G.C. TO FURNISH AND INSTALL NEW SANITARY NAPKIN DISPOSAL. REFER TO SPECIFICATIONS FOR ADDITIONAL INFORMATION.
- 13 P.C. TO FURNISH AND INSTALL NEW URINAL AND FLUSHOMETER.
- 14 G.C. TO FURNISH AND INSTALL ALL TOILET PARTITION WALLS, DOORS AND HARDWARE.
- 15 G.C. TO FURNISH AND INSTALL ALL URINAL PARTITION WALLS.
- 16 HORIZONTAL WALL MOUNTED CHANGING STATION/ TABLE
- 17 G.C. TO FURNISH AND INSTALL COATROBE HOOK. BRADLEY CONCEALED MOUNTING CHROME-PLATED ROBE HOOK, ON BACK OF DOOR.
- 18 ADA DRINKING WATER FOUNTAIN WITH BOTTLE REFILLING STATION
- 19 DRINKING WATER FOUNTAIN STATION

REV.	DATE	ITEM
1	11/28/2022	BID ADDENDUM #1

## NOTICE

THESE DRAWINGS ARE BASED ON CONSTRUCTION DRAWINGS NOT PREPARED BY BBS ARCHITECTS, LANDSCAPE ARCHITECTS AND ENGINEERS, P.C. AND THEREFORE, MAY NOT REPRESENT THE CONDITIONS AS CONSTRUCTED AT THE TIME. ALL EXISTING CONDITIONS SHALL BE REPRESENTED AS SUGGESTIVE INFORMATION AS THEY MAY NOT HAVE BEEN BUILT AND DELETED FOR THE ORIGINAL DOCUMENTS OF THE OWNER'S INFORMATION.

BRIARCLIFF MANOR U.F.S.D.  
PHASE 2 BOND IMPROVEMENTS  
BRIARCLIFF MANOR MIDDLE / HIGH SCHOOL  
444 PLEASANTVILLE RD. BRIARCLIFF MANOR, NY 10510

ENLARGED RESTROOM ELEVATIONS

PROJECT

 
DWG TITLE

DRWG. BY: Author

CHK. BY: Checker

THIS DRAWING, PREPARED FOR THE SPECIFIC PROJECT INDICATED IS AN INSTRUMENT OF SERVICE AND THE PROPERTY OF BBS ARCHITECTS, LANDSCAPE ARCHITECTS AND ENGINEERS, P.C. REPRODUCTION OR ANY USE OF THIS DRAWING FOR ANY OTHER PROJECT IS PROHIBITED. ANY ALTERATION OR REPRODUCTION OF THIS DOCUMENT IS ALSO PROHIBITED WITHOUT THE WRITTEN CONSENT OF THE ARCHITECT OR ENGINEER.

**BBS**  
ARCHITECTS  
LANDSCAPE ARCHITECTS  
ENGINEERS  
BRANCH PROJECT CONTACT: 187 WOLF ROAD, STE. 205 ALBANY, NEW YORK 12205 T. 518.621.7650  
244 EAST MAIN STREET PATCHOGUE, NEW YORK 11772 T. 631.475.0349 F. 631.475.0361  
www.bbsarchitecture.com



SED NO. 66-14-02-02-0-004-023  
DISTRICT BRIARCLIFF MANOR U.F.S.D.  
PROJECT PHASE 2 BOND IMPROVEMENTS  
DWG TITLE ENLARGED RESTROOM ELEVATIONS  
SCALE: AS NOTED  
DATE: 11/14/2022  
BID PAU DATE: 11/14/2022  
FILE NO. 21-274C

A11.03 HSMS







ELECTRICAL CONSTRUCTION NOTES:

1. ALL WORK SHALL BE DONE IN ACCORDANCE WITH THE LATEST EDITIONS OF THE NEC, APPLICABLE LOCAL CODES, STATE CODES, SCHOOL WORKING RULES AND SCHEDULE DIRECTIVES, AND THE ENGINEER'S SPECIFICATIONS.
2. THE DRAWINGS SHOW SCHEMATICALLY THE APPROXIMATE LOCATION OF ALL EQUIPMENT, CONDUITS, DEVICES, ETC. THE EXACT LOCATION OF WHICH SHALL BE SUBJECT TO APPROVAL BY THE ARCHITECT/OWNER WHO RESERVES THE RIGHT TO MAKE PRIOR TO INSTALLATION, ANY REASONABLE CHANGES IN LOCATION INDICATED WITHOUT EXTRA COST TO THE OWNER. CONTRACTOR SHALL VERIFY ALL INDICATED OR APPROXIMATE DIMENSIONS (DRAWN OR NOTED).
3. DIVISION 16 CONTRACTOR SHALL EXAMINE THE SITE TO VERIFY WORK TO BE PERFORMED AS SHOWN ON DRAWINGS AND SPECIFICATIONS BEFORE SUBMITTING HIS BID. ANY DISCREPANCY BETWEEN DRAWINGS/SPECIFICATIONS AND ACTUAL FIELD CONDITIONS SHALL BE BROUGHT TO ARCHITECT/ENGINEER'S ATTENTION BEFORE BID SUBMITTAL.
4. DIVISION 16 CONTRACTOR SHALL PROVIDE ALL LABOR SERVICE MATERIALS, EQUIPMENT, AND RELATED ITEMS TO COMPLETE THE WORK OF THIS DIVISION, AS REQUIRED BY THE NATIONAL ELECTRIC CODE, AND ALL STATE AND LOCAL AUTHORITIES HAVING JURISDICTION.
5. DIVISION 16 CONTRACTOR SHALL PROVIDE ALL ELECTRICAL HARDWARE SHOWN ON THESE DRAWINGS AND RELATED DETAIL MATERIALS NOT SPECIFICALLY SHOWN OR SPECIFIED.
6. DIVISION 16 CONTRACTOR SHALL PAY ANY FEES APPLICABLE TO ELECTRICAL WORK, SUCH AS, BUT NOT LIMITED TO, THE POWER COMPANY, TELEPHONE COMPANY, CATV, CERTIFIED ELECTRICAL INSPECTORS, ALARM AND FIRE PROTECTION COMPANIES.
7. THE DIVISION 16 CONTRACTOR SHALL REFER TO ALL OTHER DRAWINGS IN BID PACKAGE AND PERFORM THE WORK (INCLUDE IN HIS BID) INDICATED AS ELECTRICAL CONTRACTOR E.G. WORK.
8. ALL WORK SHALL BE IN ACCORDANCE WITH MANUFACTURER'S RECOMMENDATIONS AND DIRECTIVES OF THE SCHOOL DISTRICT BUILDINGS AND GROUNDS DEPARTMENT.
9. ALL WORK SHALL BE PERFORMED BY A LICENSED ELECTRICAL CONTRACTOR WHO SHALL OBTAIN AN INSPECTION CERTIFICATE AND PAY ASSOCIATED FEE. SUBMIT A PHOTOCOPY OF THIS CERTIFICATE TO THE ENGINEER WITH FINAL PAYMENT APPLICATION.
10. DIVISION 16 CONTRACTOR SHALL GUARANTEE ALL MATERIALS AND THEIR INSTALLATION TO BE FREE OF DEFECTS FOR A PERIOD AS DEFINED IN SECTION 170.0 OF THE PROJECT MANUAL.
11. A COMPLETE SYSTEM OF WIRING, WITH ALL FEEDERS, MAINS, AND BRANCHES AS SHOWN ON THE DRAWINGS, SHALL BE FURNISHED AND INSTALLED FROM THE MAIN DISTRIBUTION BOARD TO THE BUILDING'S OUTLETS, MOTORS, AND APPURTENANCES.
12. PROVIDE IDENTIFICATION FOR ALL PANEL, AND MOTOR FEEDER CABLES IN FULL BOXES AND AT TERMINATIONS, ANY CONDUCTOR VOLTAGES HIGHER THAN 240 VOLTS SHALL BE MARKED ON DEVICES AND JUNCTION BOXES.
13. FURNISH AND INSTALL ALL WIRING OF ANY VOLTAGE OR PURPOSE AS SHOWN ON THE DRAWINGS.
14. ALL BRANCH CIRCUITS SHALL HAVE INDIVIDUAL NEUTRALS, SHARING COMMON NEUTRALS AMONG BUNDLED CIRCUITS IS SPECIFICALLY DISALLOWED UNLESS OTHERWISE NOTED.
15. ALL JUNCTION BOXES SHALL BE PROVIDED WHERE INDICATED OR AS OTHERWISE REQUIRED TO FACILITATE THE PROPER INSTALLATION OF WIRES AND CABLES. CONDUITS MAY BE INCREASED IN SIZE FOR CONSTRUCTION CONVENIENCE.
16. FURNISH AND INSTALL ALL DISCONNECT DEVICES AND SAFETY SWITCHES AS SHOWN ON THE DRAWINGS AND/OR AS REQUIRED TO CONFORM WITH REQUIREMENTS.
17. FURNISH AND INSTALL ALL INDICATED LIGHTING FIXTURES AND MOUNTING HARDWARE AS REQUIRED FOR A COMPLETE INSTALLATION.
18. DIVISION 16 CONTRACTOR SHALL PROVIDE TO SCHOOL 5 PERCENT SPARE LAMPS (MINIMUM QUANTITY 1) OF EACH TYPE SPECIFIED WITH NEW FIXTURES.
19. PROVIDE ALL WIRING, PANEL BOARDS, SWITCHES, FUSES, EQUIPMENT, AND ALL INCIDENTAL MATERIALS REQUIRED TO SUPPLY TEMPORARY AND PERMANENT ELECTRICAL NEEDS FOR THE WORK INVOLVED, ALL IN ACCORDANCE WITH OSHA, LOCAL, STATE AND UNDERWRITERS REQUIREMENTS.
20. ALL WIRING TO BE 1/4" (12"X12") #12 (2) 34/0, OR STEEL JACKETED MC CABLE (WHERE CODE PERMITTED), UNLESS OTHERWISE SPECIFIED ON DRAWINGS. RUN BRANCH CIRCUITS IN DROPPED CEILINGS, VOIDS & CHASES. CONDUITS MAY BE SURFACE MOUNTED IN MECHANICAL SPACES UNLESS OTHERWISE NOTED. CONDUITS IN PUBLIC AREAS SHALL BE CONCEALED IN HUNG CEILINGS, EMBEDDED IN SLAB OR MASONRY WALLS, EXCEPT WHERE SURFACE MOUNTED RACEWAY IS SPECIFIED. ALUMINUM JACKETED MC CABLE IS NOT ACCEPTABLE.
21. ALL CONNECTIONS AND/OR SPLICES SHALL BE MADE ONLY IN ACCESSIBLE JUNCTION BOXES.
22. ALL COUPLINGS AND CONNECTORS FOR USE WITH EMT SHALL BE COMPRESSION TYPE, SET SCREW TYPE OR RIDGENT TYPE FITTINGS WILL NOT BE ACCEPTED.
23. ALL CONNECTIONS TO CONDUIT RUN UNDERGROUND SHALL BE MADE WATERTIGHT, ALL METALLIC CONDUIT INSTALLED IN EARTH FILL, AS WELL AS UNDERGROUND, SHALL BE PAINTED WITH (2) COATS OF ASPHALTUM PAINT OR EQUAL.
24. WIRING INSTALLED IN CEILINGS SHALL BE HUNG INDEPENDENT OF CEILING SYSTEM COMPONENTS UP TO BUILDING STEEL.
25. ALL LOW VOLTAGE FIRE ALARM, PA INTERCOM, PHONE, DATA, ETC. WIRING INSTALLED IN OPEN AREAS SHALL BE IN METALLIC RACEWAY IN MECHANICAL AREAS, GYMNASIUMS, ART ROOMS, STOREROOMS, ETC., AND IN SURFACE MOUNTED RACEWAY IN PUBLIC AREAS. LOW VOLTAGE WIRE INSTALLED IN DROPPED CEILINGS SHALL BE BUNDLED TOGETHER AND SUPPORTED BY BUILDING STEEL.
26. LOW VOLTAGE WIRE SHALL NOT BE SUPPORTED WITH BRANCH CIRCUITS OR FEEDER CIRCUITS AND SHALL NOT BE SUPPORTED BY CONDUIT, PIPES, ETC. LOW VOLTAGE WIRING NOT INSTALLED IN CONDUITS, SHALL BE PLENUM RATED.
27. CONDUITS SHALL BE SECURED IN PLACE AND PROTECTED WHERE NECESSARY TO PREVENT DAMAGE DURING CONSTRUCTION. FURNISH AND INSTALL ALL HARDWARE TO INSTALLED SUPPORT ALL CONDUITS NOT INSTALLED IN CONCRETE SLABS OR UNDERGROUND.
28. ALL CONDUITS OR MC CABLE SHALL BE EQUIPPED WITH AN INSULATING/CHARGE GUARD GROMMET AT WIRE EXIT/ENTRANCE. MC CABLE SHALL USE MC STYLE BUSHINGS BX OR OTHER BUSHINGS ARE SPECIFICALLY DISALLOWED.
29. WHERE AN EXISTING CONDUIT OR CABLE IS REQUIRED TO BE REMOVED BUT SERVES AN EXISTING PIECE OF EQUIPMENT WHICH IS TO REMAIN OPERABLE, THE DIVISION 16 CONTRACTOR SHALL REROUTE SAID CONDUIT OR CABLE OR PROVIDE A NEW SOURCE OF POWER (APPROVED BY ENGINEERING) TO THIS EQUIPMENT AS A PART OF THIS CONTRACT.
30. ALL PANELS, SWITCHES, DISCONNECT STARTERS, OR OTHER ELECTRIC SYSTEM CONTROLS SHALL BE STENOILED WITH THEIR APPROPRIATE DESIGNATION/FUNCTION. ALL CIRCUIT BREAKERS SHALL BE IDENTIFIED BY A PANEL, SCHEDULE OR STENCIL ADJACENT TO THE CIRCUIT BREAKER.
31. ALL CIRCUIT BREAKERS POSITIONS IN ALL PANELS ARE SHOWN FOR ESTIMATE PURPOSES ONLY. EC IS RESPONSIBLE FOR LOAD BALANCING.
32. ALL DEVICES SHALL BE FASTENED IN PLACE SECURELY. GRID MOUNTING LIGHTING FIXTURES SHALL BE SECURED TO GRID WITH CLIPS LISTED FOR THE PURPOSE OR SUSPENDED FROM STRUCTURE PER NEC.
33. WORK WHICH MUST BE DONE IN OCCUPIED AREAS SHALL BE DONE AT SUCH TIMES AS INDICATED IN THE PHASING OF CONSTRUCTION AND AS APPROVED BY THE SCHOOL.
34. WHERE THE DIVISION 16 CONTRACTOR IS INSTRUCTED TO PROVIDE, INSTALL AND WIRE CIRCUIT BREAKERS) TO AN EXISTING PANEL AND THAT THAT PANEL DOES NOT HAVE THE ROOM TO INSTALL REQUIRED CIRCUIT BREAKERS, THE DIVISION 16 CONTRACTOR SHALL REMOVE (3) ADJACENT 1P CIRCUIT BREAKERS AND PROVIDE A 3P, 60A BREAKER IN THEIR PLACE FOR SUB FEED TO A SURFACE MOUNTED 100A, 3-4W 24 POLE SUB PANEL AND ESTABLISH OVER/LOW CIRCUITS IN NEW SUB PANEL. EACH WITH REQUIRED CIRCUIT BREAKERS. PROVIDE (3) 1P, AMPERAGE AS BEFORE CIRCUIT BREAKERS FOR DISCONNECTED CIRCUITS IN MAIN PANEL AND RECONNECT THEM IN SUB PANEL. SUB PANEL FEED TO BE 3/4" (H=H)N-110(0)-1" C.
35. SELECTED RECEPTACLES AS SHOWN ON DRAWINGS MAY BE GFI PROTECTED BY CONNECTING TO GFCI RECEPTACLE FIRST IN CIRCUIT. ALL RECEPTACLES THAT ARE PROTECTED FROM AN UPSTREAM GFCI UNIT SHALL BE VISUALLY LABELED AS SUCH: GFCI RECEPTACLE SHALL BE SPEC GRADE AND RATED 20A, WITH OPERATING NOTIFICATION INDICATING LIGHT.
36. ALL DEVICES ADDRESSED BY ADA REGULATIONS SHALL BE INSTALLED AT ADA COMPLIANT HEIGHT AND LOCATIONS.
37. ALL NEW LIGHTING OR EXISTING LIGHTING HAVING SWITCHING REARRANGEMENT SHALL BE EQUIPPED WITH CODE COMPLIANT ENERGY CONSERVATION CONTROLS. SUCH CONTROL SHALL BE SUBMITTED TO THE ENGINEER FOR APPROVAL PRIOR TO INSTALLATION.
38. REMOVAL OF ELECTRICAL ITEMS INCLUDES THEIR DISPOSAL. THE EXCEPTION WILL BE TO TURN OVER TO THE OWNER ITEMS, IF ANY, THEY SPECIFY TO BE RETAINED IN THEIR INVENTORY. PCB OR ASBESTOS BEARING MATERIAL SHALL BE DISPOSED OF IN ACCORDANCE WITH LAWS AND REGULATIONS.
39. EC SHALL PROVIDE A WIRE WATERPROOF GFCI RECEPTACLES ON ALL APPLICABLE ROOFTOP UNITS AS PART OF HIS BID. SEE MECHANICAL EQUIPMENT SCHEDULES FOR UNITS WITH SERVICE RECEPTACLES FACTORY INSTALLED.
40. UNLESS OTHERWISE NOTED, STARTERS AND DISCONNECTS FOR MECHANICAL EQUIPMENT SHALL BE FURNISHED BY THE MECHANICAL CONTRACTOR. COORDINATE WITH THE MECHANICAL CONTRACTOR FOR ALL POWERED MECHANICAL EQUIPMENT. THE DIVISION 16 CONTRACTOR IS RESPONSIBLE TO INSTALL ALL MOTOR STARTERS AND ASSOCIATED POWER WIRING FROM SOURCE TO UNIT VIA STARTERS AND DISCONNECTS. THE LOCATIONS OF MOTOR STARTERS SHALL BE DETERMINED BY THE MECHANICAL CONTRACTOR IN THE FIELD AND SUBMITTED TO THE ENGINEER FOR APPROVAL UNLESS IT IS SPECIFIED ON THE DRAWINGS. THE DIVISION 16 CONTRACTOR SHALL REFER TO THE MECHANICAL DRAWINGS, EQUIPMENT SCHEDULES & NOTES AND INCLUDE IN HIS BID PRICE ALL ELECTRICAL WORK ASSOCIATED WITH THEIR INSTALLATION, AND THE REMOVAL OF ANY STARTERS/DISCONNECTS NO LONGER REQUIRED.
41. DUCT SMOKE DETECTORS SHALL BE FURNISHED BY THE DIVISION 16 CONTRACTOR AND INSTALLED BY MECHANICAL CONTRACTOR.

DEMOLITION NOTES:

1. THE ITEMS SPECIFICALLY SHOWN ON DEMOLITION DRAWINGS ARE TO BE ADDRESSED BY THE ELECTRICAL CONTRACTOR. THE ITEMS ARE TO BE TREATED AS NOTED AND RANGE FROM DIRECT REMOVAL AND DISPOSAL, OR REMOVAL, STORAGE AND REINSTALLATION/RELOCATION, OR TEMPORARY REMOVAL/STORAGE, AND REINSTALLATION IN SAME LOCATION.
2. MANY OTHER ELECTRIC ITEMS EXIST THAT ARE NOT SHOWN INCLUDE, BUT ARE NOT LIMITED TO, SWITCHES, RECEPTACLE, FLOOR OUTLETS, LOW VOLTAGE JACKS, LOW VOLTAGE DEVICES AND WIRING, TELEPHONE PUNCH DOWN BLOCKS, AND OUT OF SERVICE ITEMS. ALL SUCH ITEMS SHALL BE PERMANENTLY DE-ENERGIZED, DISCONNECTED, AND OTHERWISE MADE SAFE FOR DEMOLITION BY NON-ELECTRIC DEMOLITION WORKERS. THE ELECTRICAL CONTRACTOR IS RESPONSIBLE FOR ASSURING THAT ALL ELECTRIC DEVICES, OF ANY VOLTAGE OR FUNCTION, THAT ARE TO BE DEMOLISHED ARE SAFE AND ADVISE THE DEMOLITION CONTRACTOR WHEN THIS IS SO.
3. AFTER THE ELECTRICAL CONTRACTOR HAS DISCONNECTED ELECTRIC SUPPLIES TO ITEMS TO BE DEMOLISHED, HE SHALL ADVISE THE GENERAL CONTRACTOR OF ANY ELECTRIC ITEMS TO BE RETAINED FOR FUTURE USE AND THEREAFTER NOT TO BE DEMOLISHED. THE GENERAL CONTRACTOR SHALL THEN PERFORM ALL WORK ZONE DEMOLITION. THIS MATTER APPLIES TO ALL ELECTRIC ITEMS, OF ANY VOLTAGE OR PURPOSE.
4. THE SPECIAL SPECIFIC ITEMS SHOWN ON THE DRAWING FOR ELECTRICAL CONTRACTOR TO ACT ON WERE FOUND BY SURVEY. NUMEROUS LOCATIONS WERE BLOCKED BY FURNITURE, ETC. AND ADDITIONAL, EQUAL, TYPE ITEMS MAY BE PRESENT. THE ELECTRICAL CONTRACTOR SHALL ALLOW FOR THIS IN HIS BID PRICE AND ATTEND TO THOSE EQUAL OR SIMILAR DEVICES AS MAY BE DISCOVERED.
5. REMOVAL ITEMS THAT ARE LISTED AS TO BE TURNED OVER TO OWNER'S INVENTORY SHALL BE DISCUSSED WITH THE DISTRICT BUILDINGS AND GROUNDS MANAGER. THOSE ITEMS THAT THE OWNER DECLINES SHALL THEN BE DISPOSED OF BY THE CONTRACTOR OR THE MANOR OF OTHER PERMANENT REMOVALS. ANY PCB BEARING FLUORESCENT FIXTURES SHALL BE DISPOSED OF PER REGULATIONS.
6. RETAIN EXISTING RECEPTACLES IN WALLS THAT WILL NOT BE IN CONFLICT WITH NEW CONSTRUCTION. RETAIN LIGHT SWITCH LOCATIONS THAT WILL NOT BE IN CONFLICT WITH NEW CONSTRUCTION. INSTALL BLANKING PLATE COVERS OVER THE UNUSED PORTION OF GANG BOXES HAVING MORE GANG POSITIONS THAN NEEDED FOR NEW SWITCHES.
7. LIGHT FIXTURES ARE TO BE REMOVED AS GENERAL, NON-ELECTRIC, CONTRACTOR DEMOLITION. DIVISION 16 CONTRACTOR RESPONSIBLE TO SAVE OFF LIGHTING CIRCUITS FOR REMOVAL BY OTHERS. NO SPECIFIC QUANTITIES OR LOCATIONS ARE SHOWN. RETURN WHATEVER QUANTITY, IF ANY, OF THESE TO OWNER'S INVENTORY IF HE SO SPECIFIES OR THEY ARE OTHERWISE TO BE DISPOSED OF. ELECTRICAL CONTRACTOR SHALL EXAMINE FIXTURES FOR PRESENCE OF PCB'S AND SPECIAL DISPOSAL.
8. THE ELECTRICAL CONTRACTOR SHALL COVER ALL BACK BOXES IN THE WALL THAT BECOME EXPOSED DUE TO DEVICE REMOVALS. THIS INSTRUCTION ALSO APPLIES TO EXPOSED ELECTRICAL BACK BOXES AS MAY EXIST AT THE SITE PRIOR TO THIS PROJECT. THE COVER SHALL BE BRUSHED ALUMINUM WITH CHAMFERED EDGES AND COVER THE HOLE COMPLETELY WITH AT LEAST 3/4" EXTRA MARGIN ON ALL SIDES. MOUNT THE COVER WITH SCREWS TO MATCH THE ORIGINAL PATTERN.
9. IT IS EXPECTED THAT STRUCTURAL DEMOLITION BY THE GENERAL CONTRACTOR WILL CAUSE VARIOUS ELECTRIC SUPPLIES, OF VARIOUS VOLTAGES AND PURPOSES, TO BE CUT AND RENDER SOME DEVICES TEMPORARILY INACTIVE. IT IS THE ELECTRICAL CONTRACTOR'S RESPONSIBILITY TO RECONSTRUCT AND RECONNECT SUCH ELECTRIC SOURCES WHEN THE NEW STRUCTURE IS BUILT. NOTE THAT MOST REINSTALLED ITEMS WILL BE IN DIFFERENT LOCATIONS FROM THE REMOVAL LOCATION. THE ELECTRICAL CONTRACTOR SHALL MAKE ALL REQUIRED CIRCUIT EXTENSIONS OR MODIFICATIONS TO PROVIDE SERVICE TO A REINSTALLED ITEM AS RELOCATED. PROVIDE ALL REQUIRED CIRCUIT EXTENSIONS AS REQUIRED TO RESTORE SERVICE TO DEVICES. NOTE THAT THIS REQUIREMENT ALSO APPLIES TO THE ROOMS AND ELECTRICAL ITEMS WITHIN THAT ARE NORMALLY NOT IN CONTRACT. SUCH RESTORATION OF SERVICE, IF NEEDED, IS SPECIFICALLY IN THE ELECTRICAL CONTRACTOR'S CONTRACT.
10. IT SHALL BE THE ELECTRICAL CONTRACTOR'S RESPONSIBILITY TO PROTECT ALL ELECTRICAL DEVICES, FROM DAMAGES DURING CONSTRUCTION, WHICH ARE EITHER INDICATED TO REMAIN, AND/OR TO BE REMOVED AND REINSTALLED THROUGHOUT ALL CONSTRUCTION AREAS. DEVICES SHALL INCLUDE BUT WILL NOT BE LIMITED TO: SMOKE DETECTORS, EMERGENCY LIGHTS, EXIT SIGNS, OCCUPANCY SENSORS, SPEAKERS, LIGHT FIXTURES, SWITCHES, RECEPTACLE, ETC. IN THE EVENT OF DAMAGES INCURRED DUE TO CONSTRUCTION ACTIVITIES, THE ELECTRICAL CONTRACTOR SHALL BE RESPONSIBLE TO REPLACE ANY DAMAGED DEVICES AT NO ADDITIONAL COST TO OWNER.
11. ALL SYSTEM ASSOCIATED WITH THE DEVICES SCHEDULED TO BE REMOVED, STORED AND PROTECTED SHALL BE TESTED BY THE MANUFACTURER'S CERTIFIED TESTING VENDOR PRIOR TO ANY DEMOLITION ACTIVITY. ANY DEVICE WHICH FAILS THE TEST SHALL BE REPLACED WITH A FORM, FIT AND FUNCTION COMPONENT PER UNIT PRICES, AND SUCH DEVICES ARE NOT INCLUDED IN THIS RESPONSIBILITY STATEMENT, BUT ALSO SUCH INSTALLATION SHALL BE IN THE ELECTRICAL CONTRACTOR'S BASE BID. THE ELECTRICAL CONTRACTOR SHALL RE-TEST ALL SUCH SYSTEM COMPONENTS BY A MANUFACTURER CERTIFIED TESTING VENDOR OF SUCH SYSTEM OF ALL PREVIOUSLY TESTED SYSTEM COMPONENTS AFTER ALL WORK BY ALL TRADES HAS BEEN COMPLETED, AND ALL SYSTEM COMPONENTS HAVE BEEN INSTALLED. ANY COMPONENT WHICH FAILS SHALL BE REPLACED, AND PROGRAMMED IF NECESSARY BY THE ELECTRICAL CONTRACTOR. ALL SUCH REPLACEMENT AND PROGRAMMING COSTS SHALL BE ELECTRICAL CONTRACTOR'S RESPONSIBILITY. ALL COSTS ASSOCIATED WITH THE TESTING OF AFFECTED SYSTEM SUCH AS BUT NOT LIMITED TO FIRE ALARM, PUBLIC ADDRESS, INTERCOM, TELEPHONE, AND SECURITY SYSTEMS SHALL BE THE RESPONSIBILITY OF THE ELECTRICAL CONTRACTOR. ALL EQUIPMENT, MATERIALS, WIRING AND THEIR ASSOCIATED MATERIAL SPECIFIED TO REMAIN, WHICH IS NOT STORED AND PROTECTED, SHALL BE PROTECTED DURING THE DEMOLITION ACTIVITIES, AND ALL TRADES SHALL BE INFORMED OF SUCH COMPONENTS. ANY OF SUCH COMPONENTS WHICH BECAME DAMAGED DURING DEMOLITION SHALL BE REPLACED FORM, FIT AND FUNCTION BY THE ELECTRICAL CONTRACTOR AT HIS EXPENSE.

ABBREVIATIONS

E	EX	EXISTING
ETR		EXISTING TO REMAIN
PSEGL		PSE&G LONG ISLAND (UTILITY CO.)
SM, S.M.		SURFACE MOUNTED
U.O.N.		UNLESS OTHERWISE NOTED
EC, E.C.		ELECTRICAL CONTRACTOR
GC, G.C.		GENERAL CONTRACTOR
MC, M.C.		MECHANICAL CONTRACTOR
PC, P.C.		PLUMBING CONTRACTOR
TYP.		TYPICAL
REQD.		REQUIRED
O.C.		ON CENTER
OKT		CIRCUIT
AF		AWAY FROM FLOOR
CBB		CIRCUIT BREAKER
REC.		RECEPTACLE
ACT		ABOVE COUNTERTOP

TEMPORARY POWER CONSTRUCTION NOTES:

1. THE DIVISION 16 CONTRACTOR SHALL PROVIDE TEMPORARY POWER AND LIGHT IN THE NEW AREAS 'D', AND 'E' AND THE RECONSTRUCTED AREAS OF THE EXISTING BUILDING.
2. ALL TEMPORARY POWER PANELS AND FUSED SWITCHES OUTSIDE SHALL BE NEMA 3R CONSTRUCTION AND LOCKABLE. ALL OUTSIDE RECEPTACLES SHALL BE WATERPROOF AND HAVE A COVER THAT ENCLOSES THE PLUGGED IN CORDS WHILE IN SERVICE AS INTERMATIC WP12AC, NON-WATERPROOF GEAR IN A HOUSING 6 INCHES OR NOT ACCEPTABLE.
3. ALL RECEPTACLES SHALL BE GFCI PROTECTED AND MOUNTED 3' 0" ABOVE FINISHED FLOOR. PROVIDE WORK BLOCKING AS REQUIRED. ALL RECEPTACLES OUTLETS SHALL BE 2 GANG DOUBLE DUPLEX.
4. TEMPORARY LIGHTING SHALL BE CONSTRUCTED OF SINGLE AND DOUBLE 100 WATT CLEAR INCANDESCENT LAMPS, OR EQUIVALENT, AND WATERPROOF RUBBER SOCKETS, SPLICED WITH WATERPROOF CONNECTORS ON FESTOONED/ROMEX TYPE WIRE. ADEQUACY OF ALL TEMPORARY LIGHTING CONFIGURATIONS SHALL BE AS DETERMINED BY THE CONSTRUCTION MANAGER. PRE ASSEMBLED TEMPORARY LIGHTING IS DISALLOWED. TAPS AND SPLICES SHALL BE MADE WITH SCOTCH LOCK CONNECTORS, RUBBER TAPE, AND THEN PVC COATED. THE CONNECTORS SHALL BE FILLED WITH FENETROL. A PLASTIC SHAPE ON CAGE/GUARD SHALL PROTECT EACH SOCKET AND LAMP. NOMINAL SPACING BETWEEN LAMP CLUSTER IS 16 FEET. MOUNT LIGHTS EIGHT FEET ABOVE FINISHED FLOOR IN TYPICAL LOCATIONS AND 10 FEET ABOVE FINISHED FLOOR IN CORRIDOR.
5. PROVIDE NIGHT LIGHTING CIRCUIT, WHICH SHALL OPERATE CONTINUOUSLY. ALL LAMPS SHALL BE 10 VOLT, ROUGH SERVICE RATED, TEMPORARY LIGHTS SHALL BE TO OSHA STANDARDS. ALTERNATE FIXTURES SHALL BE 400W CONSTRUCTION SITE STYLE. PROVIDE HOOK UPS TO JOB TRAILER FOR ALL TRADES. USE SITE POWER AS SOURCE. OWNER PAYS FOR POWER CONSUMPTION.
6. WIRING SHALL BE #10-#14 (200V-#14)GND (200V) STYLE. CIRCUITS SHALL BE OPERATED A MAXIMUM OF 15 AMPS OR 1800 WATTS (1800 WATT LAMPS). SWITCHING SHALL BE DONE VIA THE SWITCH RATED 20A, 10 CIRCUIT BREAKERS. SEGREGATE THE NIGHT LIGHTS AND RECEPTACLES IN THE LOWER PART OF THE POWER PANELS AND LABEL THESE "NIGHT LIGHTS".
7. TURN OFF, CIRCUIT HOME RUNS CONDUCTORS SHALL INCREASE ONE WIRE SIZE EVERY 10 FEET (E-#10) CONDUCTORS. WIRING WITHIN THE ROOM AREA SHALL BE MADE WITH #12 CONDUCTORS.
8. THE DIVISION 16 CONTRACTOR SHALL PREPARE EACH PANEL, SCHEDULE.
9. A LENGTH OF GREENFIELD FLEX CONDUIT AT PUNCH POINTS SHALL PROTECT ALL WIRE, SUCH AS WHERE WIRING PASSED THROUGH A DOORWAY. WIRING SHALL BE SUPPORTED FROM ANCHORS INSTALLED BY THE DIVISION 16 CONTRACTOR FOR THE PURPOSE OF ATTACHMENT TO PROJECT. ALL ELECTRICAL HARDWARE SHALL BE NEW FOR THIS PROJECT.
10. ALL WIRING SHALL BE INSTALLED SO AS NOT TO CAUSE TRIPPING HAZARD OR SIMILAR OBSTRUCTION. POWER PANELS SHALL BE EQUIPPED WITH 42 1P, 20A CIRCUIT BREAKERS AND ALL CIRCUIT BREAKERS NOT IN SERVICE SHALL BE LABELED SPARE. AT THE OWNERS OPTION PANEL AND CIRCUIT BREAKERS SHALL BE TURNED OVER TO OWNERS INVENTORY AT COMPLETION OF THE PROJECT. ALL ELECTRICAL HARDWARE SHALL BE NEW FOR THIS PROJECT.
12. THE DIVISION 16 CONTRACTOR SHALL BE RESPONSIBLE FOR ALL MAINTENANCE OF TEMPORARY LIGHTING AND POWER SYSTEMS DURING, AND AFTER INSTALLATION, UP TO THE TIME OF BENEFICIAL OCCUPANCY, AND TIME OF REMOVAL. REPAIRS SHALL BE MADE WITHIN 24 HOURS OF THE REPORTED OUTAGE, OR AS DIRECTED BY THE CONSTRUCTION MANAGER. DIVISION 16 CONTRACTOR SHALL COMMENCE WORK ON THIS PROJECT WITH A GROSS OF SPARE CONSTRUCTION BULBS AT HIS IMMEDIATE DISPOSAL.
13. REMOVAL OF THE TEMPORARY POWER AND LIGHTING SHALL BE THE RESPONSIBILITY OF THE DIVISION 16 CONTRACTOR WHEN THE PROJECT IS COMPLETE. ALL EQUIPMENT, WIRING SUPPORTS, CONNECTORS, ETC. SHALL BE REMOVED FROM OWNERS PROPERTY AFTER PROJECT IS COMPLETE. INCLUDE STATEMENTS OF REMOVAL WITHIN CLOSURE DOCUMENTS, REQUIRED FOR FINAL PAYMENT.
14. PROVIDE THE TEMPORARY ELECTRICAL SERVICE TO THE CONSTRUCTION TRAILERS SHALL BE AS PER USERS REQUIREMENTS OF THE TRAILERS. TEMPORARY SERVICES ARE REQUIRED PER SPECIAL CONDITIONS OF THE PROJECT.
15. ALL TEMPORARY POWER WORK SHALL BE COORDINATED WITH THE CONSTRUCTION MANAGER SPECIAL EMPHASIS SHALL BE EXERCISED FOR TERRAZZO MACHINES AND ITS ELECTRICAL REQUIREMENT.

FIRE STOP NOTES:

1. ALL CONDUIT AND CABLE PENETRATIONS THROUGH FIRE RATED WALLS, FLOORS OR OTHER STRUCTURES SHALL BE FIRE STOPPED.
2. THE FIRE STOP MATERIALS SHALL BE HLTI TYPE FS-657 FIRE-616 SEALANT, CP-472 JONT SPRAY, CP-615 ELASTOMERIC SEALANT, CP-406 FLEXIBLE SEALANT, CP-443 OR CP-442 COLLAR, CP-418 PUTTY STICK, OR FS-635 TROWEL ABLE COMPOUND, AS SUITABLE.
3. CONTRACTOR SHALL SUBMIT SHOP DRAWINGS OF PRODUCTS SPECIFIED OR EQUAL.
4. FIRE STOP MATERIALS OTHER THAN HLTI SHALL INCLUDE FULL TECHNICAL DATA WITH SHOP DRAWINGS TO DEMONSTRATE EQUALITY WITH THE SPECIFIED FIRE STOPS AND STATEMENT FROM MANUFACTURER THAT THEY MEET OR EXCEED THE PRODUCTS SPECIFIED HERE.
5. ALL SYSTEMS SHALL HAVE THEIR OWN SLEEVE THROUGH FIRE RATED WALLS. IF FIRE ALARM, PUBLIC ADDRESS, TELEPHONE, DATA, POWER AND LIGHTING.

FIRE ALARM SYSTEM LEGEND

SYMBOL	DEVICE DESCRIPTION
	FIRE ALARM CONTROL PANEL
	REMOTE ANNUNCIATOR PANEL OR EQUAL, E.G. TO PROVIDE FRAMED BLDG GRAPHIC MAP WITHIN SIGHT
	FIRE ALARM SHUT DOWN
	SMOKE DETECTOR W/ BASE. "E" DESIGNATES ELEVATOR RECALL
	CARBON MONOXIDE DETECTOR WITH SOUNDER BASE, CONNECT TO ASSOCIATED UNIT WITH SOUNDER BASE FOR SIMULTANEOUS LOCAL ALARM. (SUPERVISORY SIGNAL)
	CARBON MONOXIDE SYSTEM AMBER COLOR VISUAL NOTIFICATION DEVICE (SUPERVISORY SIGNAL)
	MANUAL PULL STATION. PROVIDE WITH NON-ALARMED ST1 STOPPER II LIFT COVER (OR SIMILAR)
	DUCT TYPE SMOKE DETECTOR W/ HOUSING AND REMOTE LED INDICATOR. (SUPERVISORY SIGNAL)
	SPEAKER NOTIFICATION DEVICE - WALL MOUNT.
	SPEAKER/STROBE NOTIFICATION DEVICE - WALL MOUNT.
	SPEAKER/STROBE NOTIFICATION DEVICE - CEILING MOUNT.
	SPEAKER NOTIFICATION DEVICE - CEILING MOUNT.
	SPEAKER/STROBE NOTIFICATION DEVICE - CEILING MOUNT.
	STROBE NOTIFICATION DEVICE. WALL MOUNTED.
	STROBE NOTIFICATION DEVICE. CEILING MOUNTED.
	HORN/STROBE NOTIFICATION DEVICE
	24V ELECTROMAGNETIC DOOR HOLDER - GC FURNISH & MOUNT. EC TO WIRE. REFER TO FIRE ALARM DEVICE NOTES ON ES.01 FOR ADDITIONAL INFORMATION.
	EXISTING FIRE ALARM BELL. TO BE REMOVED. INSTALL BLANK COVER PLATE.
	EXISTING BATTERY OPERATED CO DETECTOR TO REMAIN UNLESS OTHERWISE NOTED.
	AIR HANDLING UNIT. REFER TO MECHANICAL DWG. FOR ADDITIONAL INFORMATION.
	ANNOTATION "R" - UNIT TO HAVE RELAY SHUTDOWN, REQUIRED ON ALL FANS OVER 1000 CFM.
	WATERFLOW SWITCH FOR NEW SPRINKLER SYSTEM (BY FIRE SPRINKLER CONTRACTOR)
	TAMPER SWITCH FOR NEW SPRINKLER SYSTEM (BY FIRE SPRINKLER CONTRACTOR)
	ANSUL SYSTEM
	FIRE ALARM - BEAM DETECTOR RECEIVER
	FIRE ALARM - BEAM DETECTOR TRANSMITTER
	STEEL WIRE GUARD.
	WEATHER PROOF.
	WALL MOUNT.
	EXISTING TO REMAIN
	AREA OF RESCUE
	AREA OF RESCUE POWER SUPPLY
	AREA OF RESCUE MAIN CONTROL PANEL
	FIRE ALARM RELAY

ELECTRICAL SYMBOL LEGEND	
	SINGLE POLE CIRCUIT 2-#12, #12G, TC UNLESS OTHERWISE NOTED
	TWO POLE CIRCUIT 3-#12, #12G, TC UNLESS OTHERWISE NOTED
	THREE POLE CIRCUIT 4-#12, #12G, TC UNLESS OTHERWISE NOTED
	SINGLE RECEPTACLE, NEMA 5-20R W/ STAINLESS STEEL FACEPLATE
	GROUND FAULT CIRCUIT INTERRUPTER 20A, 120V SINGLE RECEPTACLE, WITH STAINLESS STEEL FACEPLATE FOR KITCHEN EQUIPMENT.
	DUPLEX RECEPTACLE, 120V, 20A W/ STAINLESS STEEL FACEPLATE.
	M DESIGNATES TEACHING MONITOR RECEPTACLE. COORDINATE EXACT MOUNTING HEIGHT WITH ARCHITECTURAL PLANS
	QUADRUPLEX RECEPTACLE - (2) GANG DUPLEX RECEPTACLES PER ABOVE W/ STAINLESS STEEL FACEPLATE
	GROUND FAULT CIRCUIT INTERRUPTER 20A, 120V DUPLEX RECEPTACLE, WITH STAINLESS STEEL 302/304 FACEPLATE FOR MECHANICAL SPACES, BOILER ROOM, CORRIDORS, OUTDOORS, ETC.
	W.P. ANNOTATION - IN RAINPROOF & IN-USE COVER
	SPECIAL TYPE TWIST LOCK RECEPTACLE, NEMA INDICATES NEMA TYPE
	MOTOR, NO. INDICATES HORSEPOWER. "D" INDICATES MOTORIZED DAMPER.
	UNFUSED DISCONNECT SWITCH, SIZE PER PLAN
	FUSED DISCONNECT SWITCH, SIZE AND FUSE PER PLAN
	TRANSFORMER, VOLTAGE, PHASE, KVA PER PLAN
	PANEL BOARD, MOUNTING PER SCHEDULE
	JUNCTION BOX C/G MOUNT, WALL MOUNT
	PANEL "RPC" - POLE POSITION "I"
	CONTRACTOR "SC211" - CONTACT "I"
	POWER ONLY DUPLEX FLOOR BOX CAST IRON WHEN INSTALLED IN CONC. SLAB. COVER COLOR AND TYPE AS APPROVED BY ARCHITECT
	POWER ONLY DUPLEX FLOOR BOX CAST IRON WHEN INSTALLED IN CONC. SLAB. COVER COLOR AND TYPE AS APPROVED BY ARCHITECT
	LIGHTING FIXTURES
	FOR LIGHTING FIXTURES - INDICATES PANEL BOARD LP-A; POLE POSITION "I"; FIXTURE TYPE "G" CONTROLLED BY SWITCH "I" EX CIRCUIT DESIGNATION INDICATES CONNECTION TO EXISTING ROOM LIGHTING CIRCUIT. INCLUDES ANY NECESSARY WIRING EXTENSIONS. "N" LIGHT LOGIC DESIGNATION INDICATED FIXTURES TO BE UNSWITCHED AND CIRCUITED AHEAD OF ALL SWITCHING DEVICES.
	WALL SWITCH W/ STAINLESS STEEL FACEPLATE FACEPLATE LOWER CASE ALPHA SUPERSCRIPIT - CONTROLS CORRESPONDINGLY LABELLED FIXTURES IN ROOM SUBSCRIPTS (NONE) = SINGLE POLE 20A, HEAVY DUTY SPEC GRADE SWITCH, MCS= MASTER CONTROL SWITCH, ASCO 216889, BY PLUMBING CONTRACTOR
	K = KEY SWITCH
	3 = 20A THREE WAY SWITCH
	4 = 20A FOUR WAY SWITCH
	D = WALLBOX SLIDE DIMMER COMPATIBLE W/ FIXTURE DIMMING BALLAST
	DIG# = DIGITAL SWITCH, # - INDICATES NUMBER OF BUTTONS
	VSOS = DUAL TECH WALL SWITCH VACANCY OR OCCUPANCY SENSOR -
	M= MOMENTARY CONTACT SWITCH - MODEL # GNDOS-W OR EQUAL
	WS = PRESET WALLSTATION
	CEILING MOUNTED OCCUPANCY (OS)/VACANCY(VS) SENSOR, LOW VOLTAGE, DUAL TECHNOLOGY, COMPLETE W/ POWER PACK(S) AS REQUIRED. EATON GREENGATE OAC-DT-2000-R OR EQUAL
	VS - PROGRAM FOR MANUAL ON MODE
	OS - PROGRAM FOR AUTOMATIC ON MODE
	U - ULTRASONIC TECHNOLOGY ONLY
	WALL MOUNTED OCCUPANCY SENSOR
	DAYLIGHT SENSOR PHOTOCELL - COMPATIBLE W/ ROOM CONTROLS
	EMERGENCY EXIT LIGHTING FIXTURE
	RETRACTABLE WHITE INDUSTRIAL CORD REEL, 25' CORD LENGTH. SEE ALSO MOUNTING DETAIL ON DWG. E10.02
	DATA RECEPTACLE. PROVIDE TWO (2) CAT6 DATA CABLES UNLESS NOTED OTHERWISE WITH A 1" CONDUIT WITH PULL STRING TO ABOVE ACCESSIBLE CEILING SPACE. # DENOTES NUMBER OF CABLES TO BE PROVIDED. "I" DESIGNATES TELEPHONE DATA BOX.
	DATA & POWER SURFACE RACEWAY DROP - NUMBER OF TRIANGLES INDICATES NUMBER OF DATA DROPS - PROVIDE (2) DUPLEX RECEPTACLES PER DATA DROP. SEE ALSO TECH. PLANS.
	FIRE/SMOKE DAMPER - FURNISHED AND INSTALLED BY MC, EC TO WIRE. SEE MECH DRAWINGS FOR EXACT LOCATIONS.

SIMILAR SYMBOLS USED ON DEMO PLANS. ALL ITEMS SHOWN ON DEMO PLAN TO BE REMOVED ENTIRELY UNLESS OTHERWISE NOTED.

LINE DESIGNATIONS

EXISTING TO REMAIN DEVICES

DEVICES TO BE REMOVED. PULL BACK ALL ASSOCIATED CONDUIT AND WIRING AND REMOVE UNLESS OTHERWISE NOTED ON THE PLANS.

NEW DEVICES

- CONDUIT DOWN
- CONDUIT UP

MISCELLANEOUS

SYMBOL	DESCRIPTION
	CEILING MOUNTED PUBLIC ADDRESS SPEAKER.
	WALL MOUNTED PUBLIC ADDRESS SPEAKER.
	HORN LOUDSPEAKER SUBSCRIPT "WP" INDICATES OUTDOOR WEATHERPROOF HORN SPEAKER
	WALL MOUNTED VOLUME CONTROL FOR LOCAL PUBLIC ADDRESS SPEAKER
	WIRELESS CLOCK
	LIGHTING CONTROLS WALL STATION. SUBSCRIPT DENOTES LIGHTING SEQUENCE OF OPERATION ON PLANS.

ITEMS IN ABOVE LEGENDS MARKED WITH SUBSCRIPTS ON THE PLANS ARE DENOTED AS FOLLOWS:

- (E) - EXISTING ITEM TO REMAIN
- (R) - EXISTING ITEM TO BE RE-INSTALLED AND RELOCATED
- (RR) - REMOVE AND RE-INSTALL TO ACCOMMODATE NEW CONSTRUCTION
- NO SUBSCRIPT - NEW ITEM TO BE FURNISHED AND INSTALLED

REV.	DATE	ITEM
1	11/23/22	BID ADDENDUM #1

NOTICE

THESE DRAWINGS ARE BASED ON CONSTRUCTION DRAWINGS NOT PREPARED BY BBS ARCHITECTS, LANDSCAPE ARCHITECTS, OR ENGINEERS, ETC. THESE DRAWINGS SHALL BE THE PROPERTY OF BBS ARCHITECTS, LANDSCAPE ARCHITECTS, AND ENGINEERS, ETC. NO REPRESENTATION OF THE CONDITIONS AS CONSTRUCTED AT THE TIME OF BID SUBMITTAL. NO SUGGESTIVE INFORMATION AS THEY MAY NOT HAVE BEEN READ AND CHECKED FOR THE ORIGINAL DOCUMENTS OF THE OWNER'S INFORMATION.

GENERAL DOCUMENTS

KEY PLAN

NO SCALE

BRIARCLIFF MANOR U.F.S.D.  
PHASE 2 BOND IMPROVEMENTS  
BRIARCLIFF MANOR MIDDLE / HIGH SCHOOL  
444 PLEASANTVILLE RD. BRIARCLIFF MANOR, NY 10510  
GENERAL NOTES, SYMBOLS AND ABBREVIATIONS

PROJECT

DWG/TITLE

DWG. BY:	EEA
CHK. BY:	AG

THIS DRAWING, PREPARED FOR THE SPECIFIC PROJECT INDICATED IS AN INSTRUMENT OF SERVICE AND THE PROPERTY OF BBS ARCHITECTS, LANDSCAPE ARCHITECTS AND ENGINEERS, ETC. REPRODUCTION OR ANY USE OF THIS DRAWING FOR ANY OTHER PROJECT IS PROHIBITED. ANY ALTERATION OR REPRODUCTION OF THIS DOCUMENT IS ALSO PROHIBITED WITHOUT THE WRITTEN CONSENT OF THE ARCHITECT OR ENGINEER.

BBS  
ARCHITECTS  
LANDSCAPE ARCHITECTS  
ENGINEERS  
244 EAST MAIN STREET  
PATCHOGUE  
NEW YORK 11772  
T 516.475.0349  
F 516.475.0361  
187 WOLF ROAD, STE. 205  
ALBANY  
NEW YORK 12205  
T 518.621.7650  
F 518.621.7655  
www.bbsarchitect.com

SER. NO.	66-14-02-02-0-004-023
DISTRICT	BRIARCLIFF MANOR U.F.S.D.
PROJECT	PHASE 2 CAPITAL BOND IMPROVEMENTS
DWG. TITLE	GENERAL NOTES, SYMBOLS AND ABBREVIATIONS
SCALE:	NTS
DATE:	07/07/22
BID PAU DATE:	07/05/22
FILE NO.	21-274C


E0.01

HMS






1 DEMO PLAN - AREA A  
SCALE: 1/8" = 1'-0"

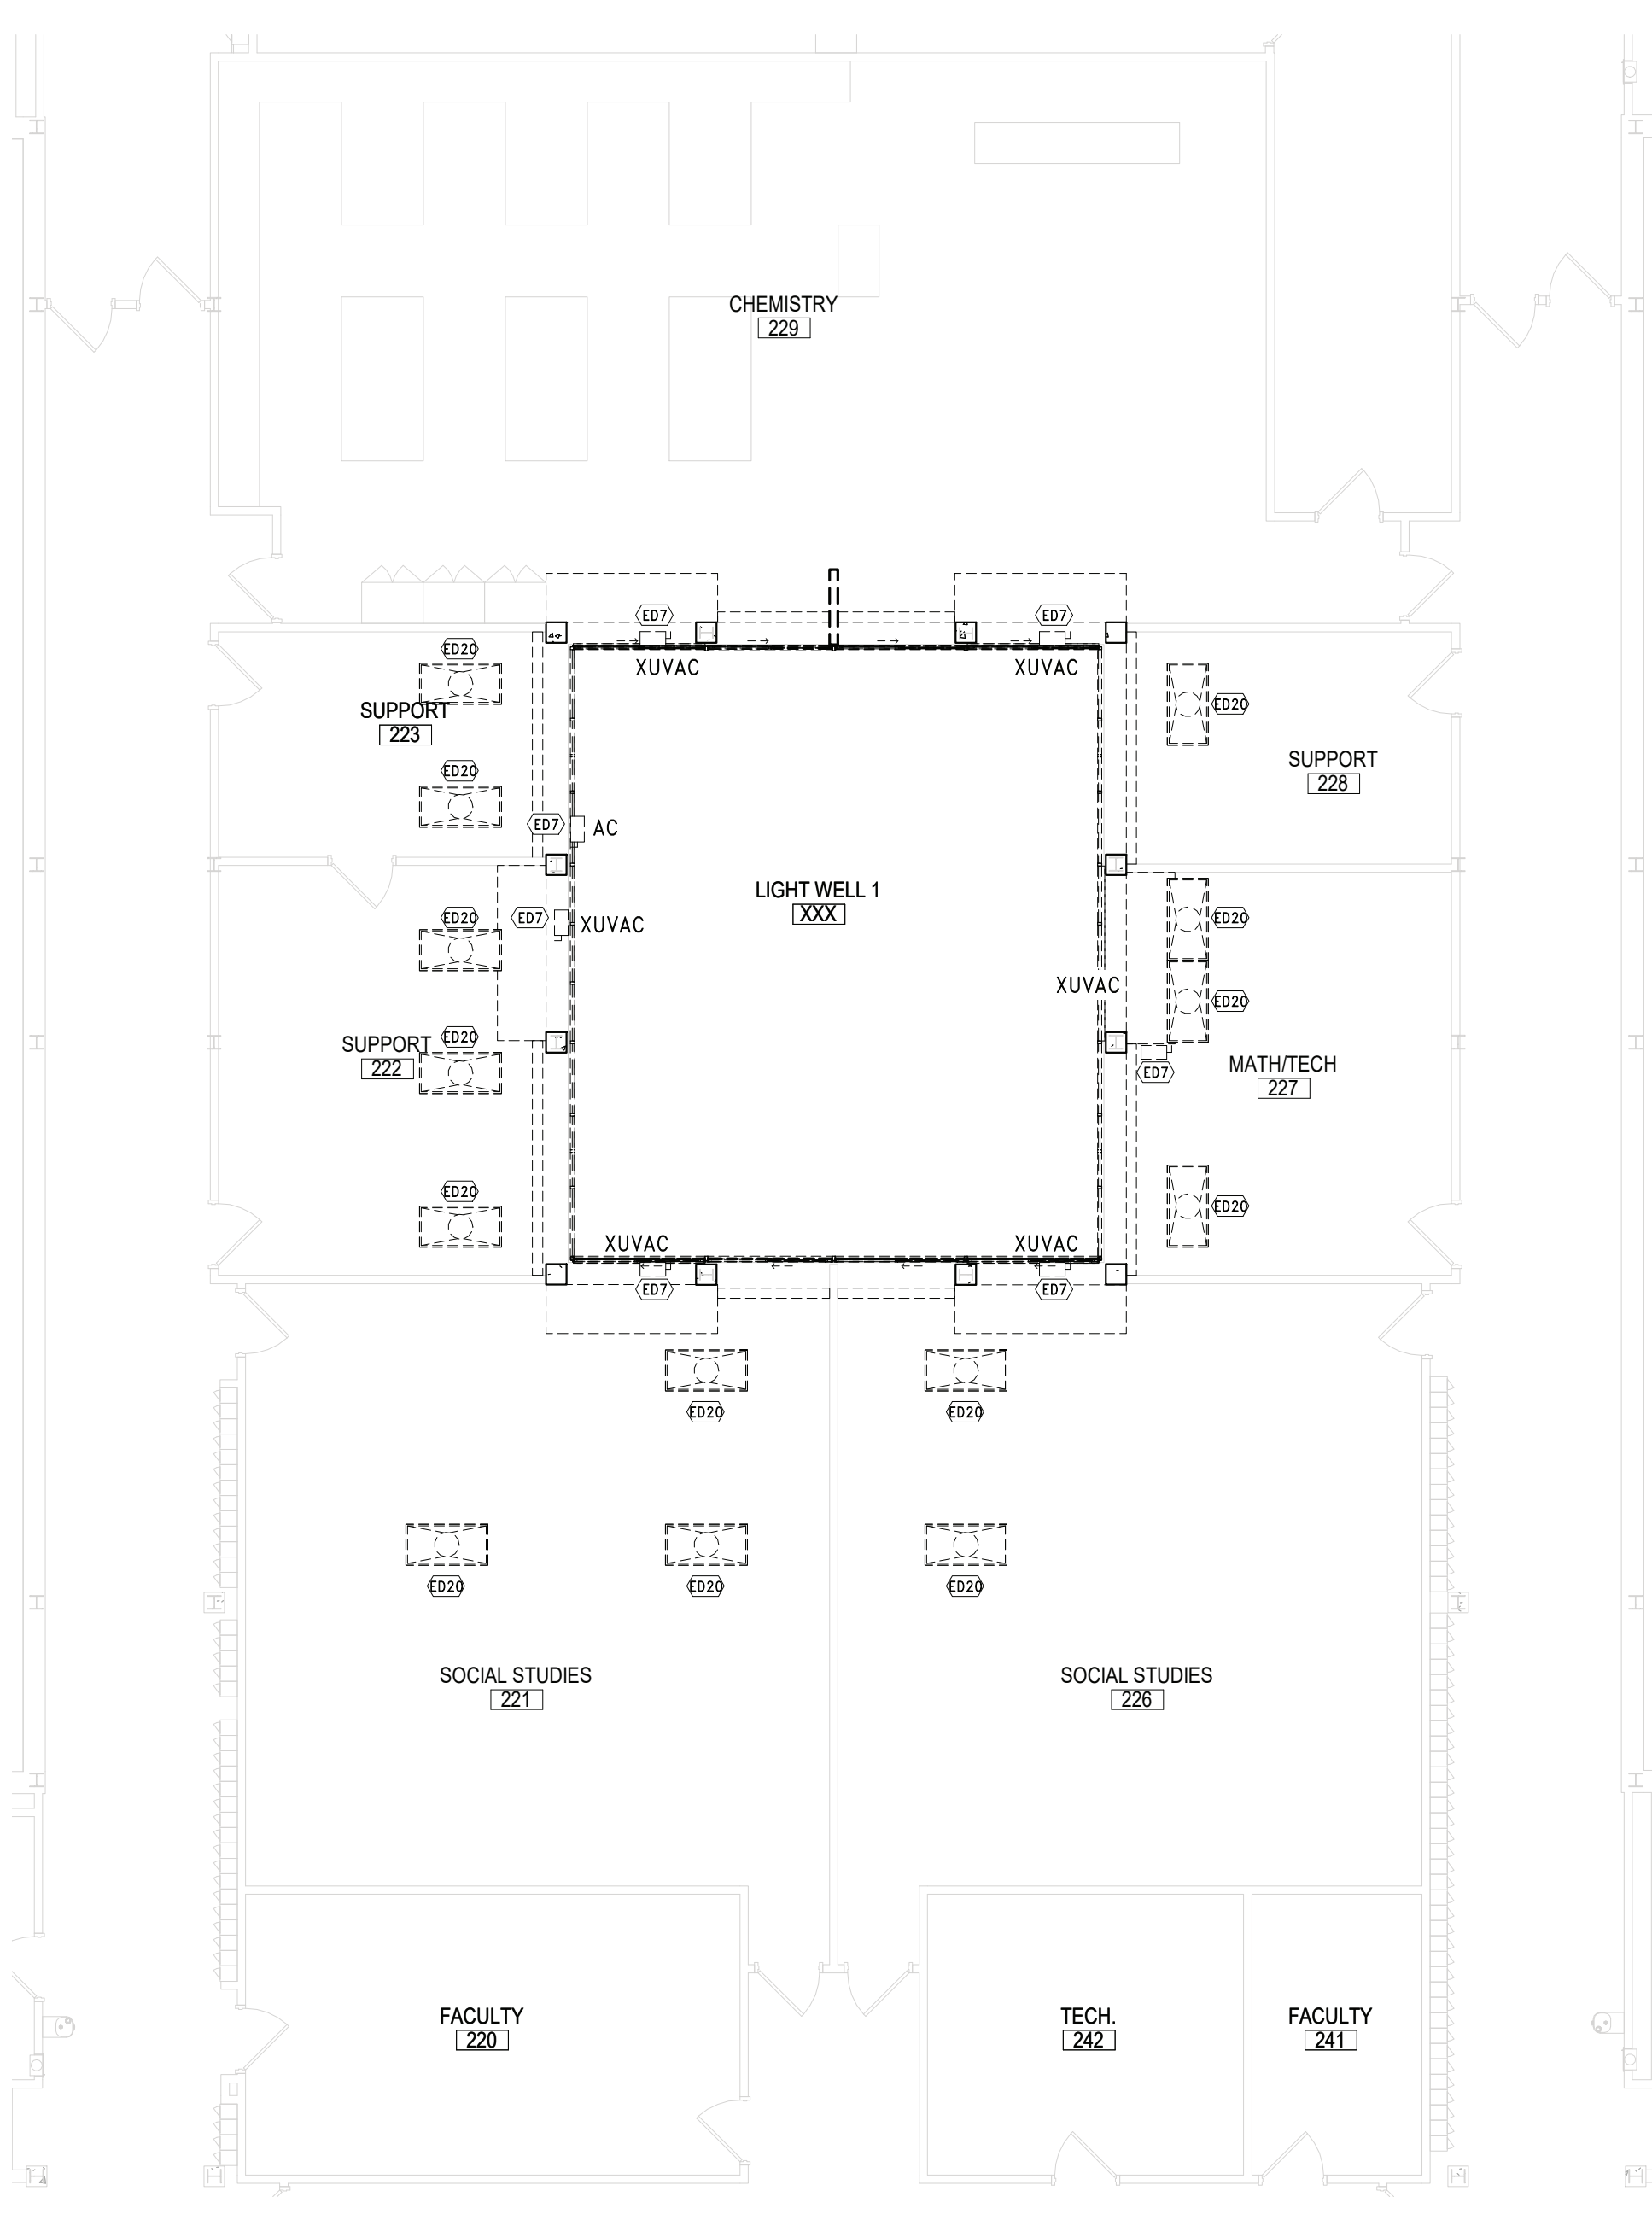

3 DEMO PLAN - SECOND FLOOR AREA D  
SCALE: 1/8" = 1'-0"

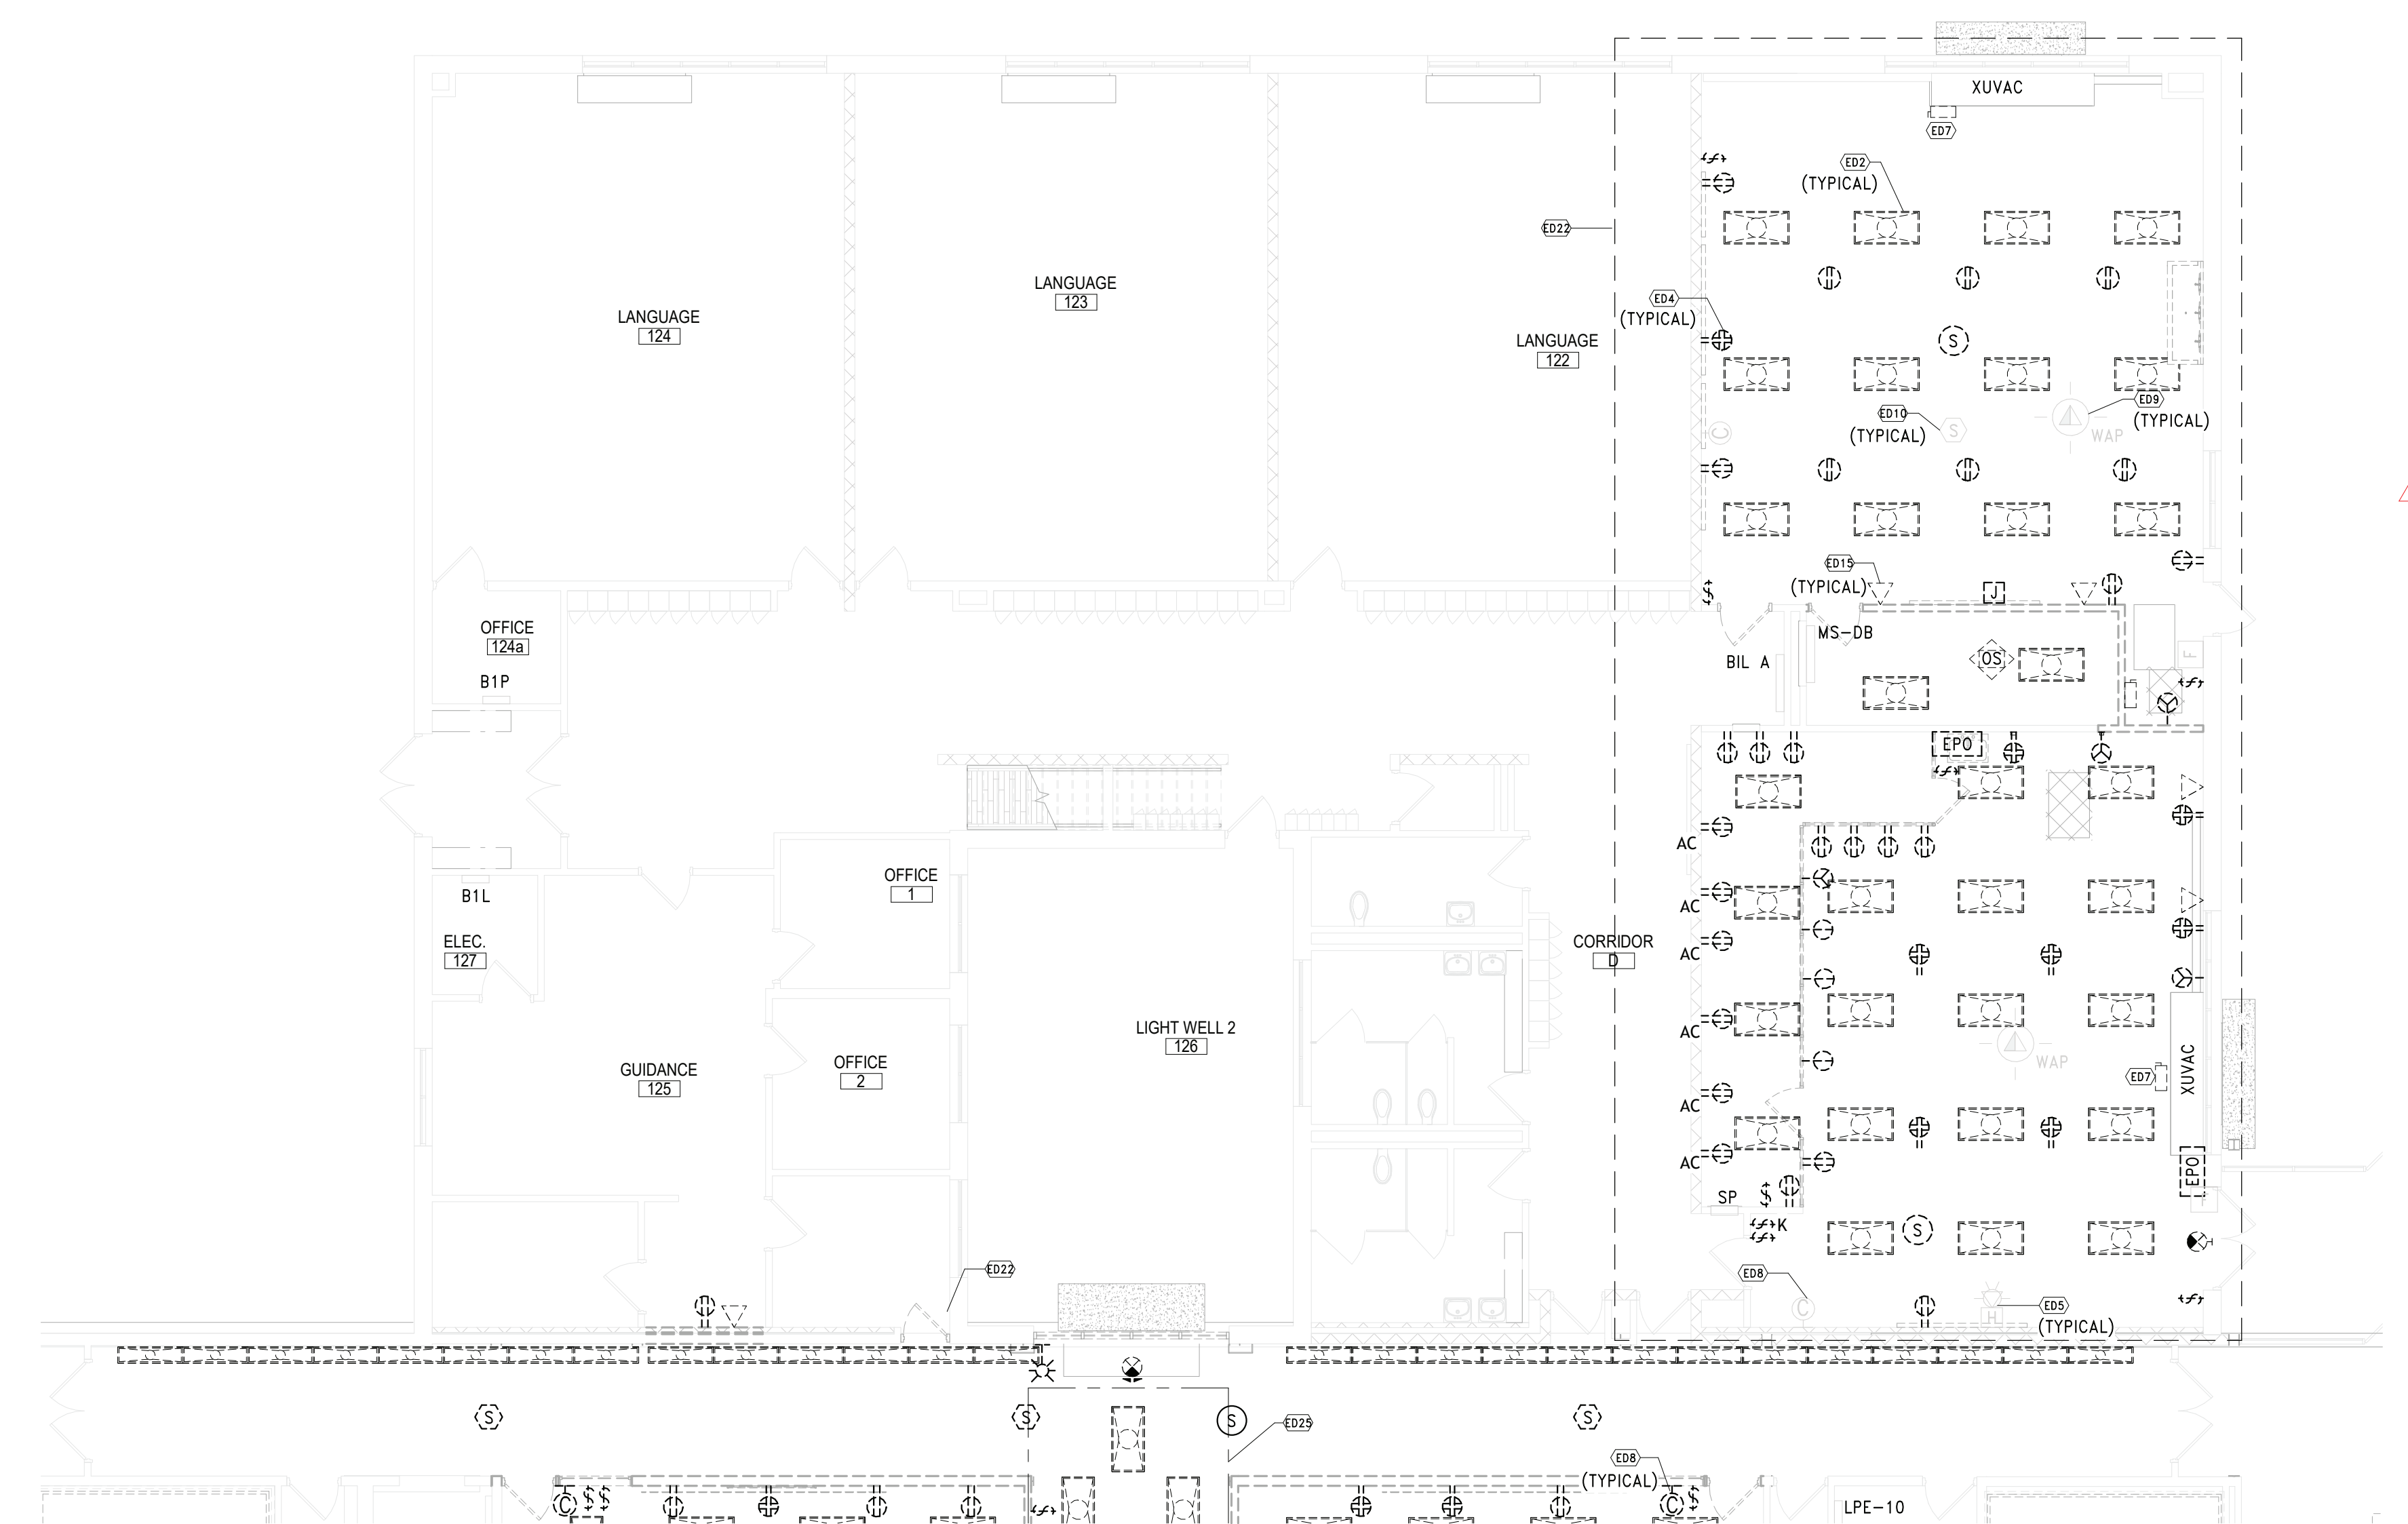

2 DEMO PLAN - AREA C  
SCALE: 1/8" = 1'-0"

SHEET NOTES

- A. CONTRACTOR SHALL FIELD VERIFY TYPE, QUANTITY AND LOCATION OF ALL EXISTING DEVICES TO BE REMOVED PRIOR TO SUBMITTING BID. EXISTING CONDITIONS SHOWN ARE BASED ON EXISTING PLANS AND FIELD OBSERVATIONS. EC IS RESPONSIBLE FOR THE REMOVAL OF ALL ELECTRICAL DEVICES ON WALLS SCHEDULED TO BE REMOVED. PULL BACK AND REMOVE ALL ASSOCIATED CIRCUITS.
- B. ELECTRICAL CONTRACTOR SHALL SECTION OFF FIRE ALARM FROM REST OF BUILDING DURING CONSTRUCTION.
- C. REFER TO GENERAL DEMOLITION NOTES ON SHEET ED.01 FOR ADDITIONAL DEMOLITION NOTES.
- D. ALL DEVICES SHOWN AS DASHED LINES ARE TO BE DEMOLISHED. REMOVE ASSOCIATED BRANCH CIRCUIT CONDUIT AND WIRING BACK TO NEAREST ACTIVE SOURCE.
- E. ALL DEVICES SHOWN AS GREY/HALFTONED LINES ARE TO REMAIN UNDISTURBED. COORDINATE ALL DEMOLITION WORK AROUND THESE DEVICES. IF NECESSARY TO REMOVE OR RE-CIRCUIT DEVICES, TO ALLOW FOR ARCHITECTURAL OR MECHANICAL WORK, DEVICES SHALL BE REINSTALLED AND RECONNECTED.
- F. FIELD COORDINATE ALL REMOVALS WITH GC PRIOR TO INITIATION OF WORK. VERIFY THE ABSENCE OF ASBESTOS IN CEILINGS WHERE LIGHTING/ELECTRICAL DEVICES SHALL BE REMOVED.
- G. ALL DEVICES WITH 'ER' DESIGNATION SHALL BE EXISTING TO BE RELOCATED OR RE-INSTALLED. UNINSTALL AND MAINTAIN DEVICES TO ALLOW FOR CEILING WORK. REFER TO NEW WOK PLAN FOR RE-INSTALLATION.


KEY NOTES

- ED2 DISCONNECT AND REMOVE LIGHTING FIXTURES AND ALL ASSOCIATED BRANCH CIRCUIT POWER AND CONTROLS AS INDICATED.
- ED4 DISCONNECT AND REMOVE ELECTRICAL DEVICES, WIREMOLD AND SURFACE RACEWAY TO ALLOW FOR ARCHITECTURAL WORK. PULL BACK AND REMOVE ALL ASSOCIATED BRANCH CIRCUIT CONDUIT AND WIRING TO NEAREST ACTIVE SOURCE. CIRCUIT CONTINUITY SHALL BE MAINTAINED FOR EXISTING TO REMAIN DEVICES IN SAME CIRCUIT.
- ED5 DISCONNECT AND REMOVE FIRE ALARM DEVICE AND ALL ASSOCIATED CABLEING BACK TO FACP.
- ED7 DE-ENERGIZE AND DISCONNECT MECHANICAL EQUIPMENT TO BE REMOVED (BY OTHERS). REMOVE DISCONNECTING MEANS AND ALL ASSOCIATED FIRE ALARM DUCT SMOKE AND FA SHUTDOWN CONNECTIONS. PULL BACK ALL ASSOCIATED BRANCH CIRCUIT CONDUIT AND WIRING TO SOURCE PANEL AND REMOVE.
- ED8 REMOVE AND MAINTAIN WIRELESS CLOCKS. CLOCKS TO BE RE-USED IN PROPOSED LOCATION. REFER TO NEW WORK PLAN. FINAL CLOCKS LOCATION TO BE FIELD COORDINATED WITH OWNER.
- ED9 DISCONNECT, REMOVE AND MAINTAIN WIRELESS ACCESS POINT. MAINTAIN ASSOCIATED DATA CABLEING FOR RECONNECTION. DEVICE SHALL BE REINSTALLED AFTER RENOVATION WORK HAS BEEN COMPLETED.
- ED10 DISCONNECT AND REMOVE CEILING DEVICES (PA SPEAKER, SMOKE DETECTOR, RECEPTACLE). PULL BACK ALL ASSOCIATED BRANCH CIRCUIT CONDUIT AND WIRING TO NEAREST ACTIVE SOURCE.
- ED14 DISCONNECT AND REMOVE DOOR HOLDERS. PULL BACK ALL ASSOCIATED WIRING TO NEAREST ACTIVE SOURCE AND REMOVE.
- ED15 REMOVE DATA BOX AND ALL ASSOCIATED CABLES. PULL CABLES BACK TO SOURCE PANEL LOCATION.
- ED16 DISCONNECT, REMOVE AND MAINTAIN DEVICE INSTALLED IN PREVIOUS PHASE. TURN HARDWARE OVER TO OWNER AT COMPLETION OF DEMOLITION WORK.
- ED20 DISCONNECT AND TEMPORARILY REMOVE LIGHTING FIXTURES TO ALLOW FOR ARCHITECTURAL AND MECHANICAL RENOVATION WORK. MAINTAIN ALL ASSOCIATED POWER AND CONTROL CABLES FOR RE-INSTALLATION. REFER TO NEW WORK PLAN.
- ED22 PULL BACK AND REMOVE ALL INACTIVE/ABANDONED CABLEING IN RENOVATION AREA. FIELD COORDINATE WITH DISTRICT IT TEAM PRIOR TO CUTTING AND REMOVING OF CABLEING.
- ED23 DISCONNECT POWER TO ABANDONED CONTROL PANEL TO BE REMOVED BY OTHERS.
- ED25 PROVIDE SUPPORTS AND CABLE MANAGEMENT SYSTEM FOR ALL CABLES AND CONDUIT WITHIN INDICATED AREA WHERE CEILING TYPE IS CHANGING FROM DROP TO EXPOSED. COORDINATE WITH ENGINEER AND ARCHITECT FOR THE CLEANING OF ABOVE CEILING SPACES.
- ED26 DISCONNECT AND REMOVE LIGHTING FIXTURES AND ALL ASSOCIATED CONTROLS AS INDICATED. MAINTAIN ASSOCIATED BRANCH CIRCUIT FOR RE-USE WITH NEW LIGHTING FIXTURES IN THIS SPACE. REFER TO NEW WORK PLAN.
- ED27 ADD ALTERNATE: DISCONNECT AND REMOVE LIGHTING FIXTURES TO ALLOW FOR ARCHITECTURAL WORK IN THIS AREA. PULL ALL BRANCH CIRCUIT CONDUIT AND WIRING TO THE NEAREST ACTIVE SOURCE TO MAINTAIN CIRCUIT CONTINUITY.

REV.	DATE	ITEM
1	11/23/22	BID ADDENDUM #1

NOTICE

THESE DRAWINGS ARE BASED ON CONSTRUCTION DRAWINGS NOT PREPARED BY BBS ARCHITECTS, LANDSCAPE ARCHITECTS AND ENGINEERS, P.C. AND THEREFORE MAY NOT REPRESENT THE CONDITIONS AS CONSTRUCTED AT THE TIME. ALL EXISTING CONDITIONS SHOWN ARE REPRESENTED AS SUGGESTIVE INFORMATION AS THEY MAY NOT HAVE BEEN BUILT AND SHOULD BE THE ORIGINAL DOCUMENTS OF THE OWNER'S INFORMATION.

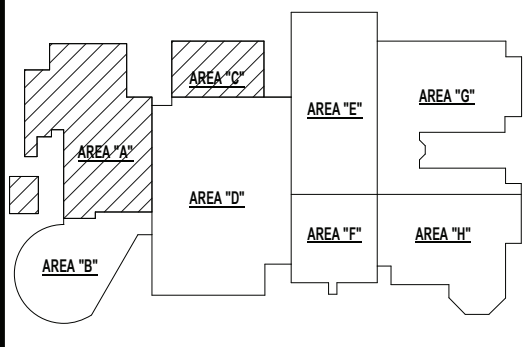

KEY PLAN  
NO SCALE

BRIARCLIFF MANOR U.F.S.D.  
PHASE 2 BOND IMPROVEMENTS  
BRIARCLIFF MANOR MIDDLE / HIGH SCHOOL  
444 PLEASANTVILLE RD. BRIARCLIFF MANOR, NY 10510  
PROJECT  
DWG TITLE  
PARTIAL DEMOLITION FIRST AND SECOND FL PLAN - AREA A & C

DRWG. BY: EEA  
CHK. BY: AG

THIS DRAWING, PREPARED FOR THE SPECIFIC PROJECT INDICATED IS AN INSTRUMENT OF SERVICE AND THE PROPERTY OF BBS ARCHITECTS, LANDSCAPE ARCHITECTS AND ENGINEERS, P.C. REPRODUCTION OR ANY USE OF THIS DRAWING FOR ANY OTHER PROJECT IS PROHIBITED. ANY ALTERATION OR REPRODUCTION OF THIS DOCUMENT IS ALSO PROHIBITED WITHOUT THE WRITTEN CONSENT OF THE ARCHITECT OR ENGINEER.

**BBS**  
ARCHITECTS  
LANDSCAPE ARCHITECTS  
ENGINEERS  
BRANCH PROJECT CONTACT  
187 WOLF ROAD, STE. 205  
ALBANY  
NEW YORK 12205  
T: 518.621.7650  
244 EAST MAIN STREET  
PATROCKQUE  
NEW YORK 11772  
T: 631.475.0349  
T: 631.475.0361  
www.bbsarchitecture.com

SER. NO. 66-14-02-02-0-004-023  
DISTRICT BRIARCLIFF MANOR U.F.S.D.  
PROJECT PHASE 2 BOND IMPROVEMENTS  
DWG TITLE PARTIAL DEMOLITION FIRST AND SECOND FL PLAN - AREA A & C  
SCALE: AS NOTED  
DATE: 07/07/22  
BID PAU DATE:  
FILE NO. 21-274C

E1.01 HSMS








LIGHTING SEQUENCE OF OPERATION	
<b>SEQUENCE A</b>	
1.	OCCUPANCY OR VACANCY SENSOR(S) FOR AUTO-OFF OF ALL FIXTURES AFTER 20 MIN. TIME DELAY
2.	NO DAYLIGHT SENSOR(S) IN SPACE
3.	NO FIXTURES LABELED AS 'EM'.
4.	3 BUTTON WALL STATION: BUTTON 1: ON/OFF CONTROL OF GENERAL ILLUMINATION FIXTURES BUTTON 2: DIM UP OF GENERAL ILLUMINATION FIXTURES** BUTTON 3: DIM DOWN OF GENERAL ILLUMINATION FIXTURES**
<b>SEQUENCE B</b>	
1.	OCCUPANCY OR VACANCY SENSOR(S) FOR AUTO-OFF OF ALL FIXTURES AFTER 20 MIN. TIME DELAY
2.	NO DAYLIGHT SENSOR(S) IN SPACE
3.	WHERE APPLICABLE, U.O.N. UNSWITCHED CONTROL FOR ALL FIXTURES LABELED AS 'EM'. FIXTURES SHALL REMAIN ON AT ALL TIMES.
4.	3 BUTTON WALL STATION: BUTTON 1: ON/OFF CONTROL OF GENERAL ILLUMINATION FIXTURES BUTTON 2: DIM UP OF GENERAL ILLUMINATION FIXTURES** BUTTON 3: DIM DOWN OF GENERAL ILLUMINATION FIXTURES**
<b>SEQUENCE C</b>	
1.	OCCUPANCY OR VACANCY SENSOR(S) FOR AUTO-OFF OF ALL FIXTURES AFTER 20 MIN. TIME DELAY
2.	NO DAYLIGHT SENSOR(S) IN SPACE
3.	WHERE APPLICABLE, U.O.N. UNSWITCHED CONTROL FOR ALL FIXTURES LABELED AS 'EM'. FIXTURES SHALL REMAIN ON AT ALL TIMES.
4.	9 BUTTON WALL STATION: BUTTON 1: ON/OFF CONTROL OF TYPE 'A' FIXTURES BUTTON 2: DIM UP OF TYPE "a" SWITCH LEG BUTTON 3: DIM DOWN OF TYPE "a" SWITCH LEG BUTTON 4: DIM UP OF TYPE "b" SWITCH LEG BUTTON 5: DIM DOWN OF TYPE "b" SWITCH LEG BUTTON 6: DIM UP OF TYPE "c" SWITCH LEG BUTTON 7: DIM DOWN OF TYPE "c" SWITCH LEG BUTTON 8: DIM UP OF TYPE "d" SWITCH LEG BUTTON 9: DIM DOWN OF TYPE "d" SWITCH LEG
<b>SEQUENCE D</b>	
1.	OCCUPANCY OR VACANCY SENSOR(S) FOR AUTO-OFF OF ALL FIXTURES AFTER 20 MIN. TIME DELAY
2.	WHERE APPLICABLE, U.O.N. UNSWITCHED CONTROL FOR ALL FIXTURES LABELED AS 'EM'. FIXTURES SHALL REMAIN ON AT ALL TIMES.
3.	7 BUTTON WALL STATION: BUTTON 1: ON/OFF CONTROL OF TYPE 'A' FIXTURES BUTTON 2: DIM UP OF TYPE "a" SWITCH LEG BUTTON 3: DIM DOWN OF TYPE "a" SWITCH LEG BUTTON 4: DIM UP OF TYPE "b" SWITCH LEG BUTTON 5: DIM DOWN OF TYPE "b" SWITCH LEG BUTTON 6: DIM UP OF TYPE "c" SWITCH LEG BUTTON 7: DIM DOWN OF TYPE "c" SWITCH LEG
<b>SEQUENCE E</b>	
1.	OCCUPANCY OR VACANCY SENSOR(S) FOR AUTO-OFF OF ALL FIXTURES AFTER 20 MIN. TIME DELAY
2.	NO DAYLIGHT SENSOR(S) IN SPACE
3.	WHERE APPLICABLE, U.O.N. UNSWITCHED CONTROL FOR ALL FIXTURES LABELED AS 'EM'. FIXTURES SHALL REMAIN ON AT ALL TIMES.
4.	SINGLE SWITCH FOR ON/OFF CONTROL OF ALL FIXTURES
5.	BUTTON WALL STATION: BUTTON 1: ON/OFF CONTROL OF GENERAL ILLUMINATION FIXTURES BUTTON 2: DIM UP OF GENERAL ILLUMINATION FIXTURES** BUTTON 3: DIM DOWN OF GENERAL ILLUMINATION FIXTURES**
<b>SEQUENCE F</b>	
1.	OCCUPANCY OR VACANCY SENSOR(S) FOR AUTO-OFF OF ALL FIXTURES AFTER 20 MIN. TIME DELAY
2.	NO DAYLIGHT SENSOR(S) IN SPACE
3.	WHERE APPLICABLE, U.O.N. UNSWITCHED CONTROL FOR ALL FIXTURES LABELED AS 'EM'. FIXTURES SHALL REMAIN ON AT ALL TIMES.
4.	SINGLE SWITCH FOR ON/OFF CONTROL OF ALL FIXTURES
5.	BUTTON WALL STATION: BUTTON 1: ON/OFF CONTROL OF TYPE 'A' FIXTURES BUTTON 2: DIM UP OF TYPE "a" SWITCH LEG** BUTTON 3: DIM DOWN OF TYPE "a" SWITCH LEG** BUTTON 4: DIM UP OF TYPE "b" SWITCH LEG** BUTTON 5: DIM DOWN OF TYPE "b" SWITCH LEG**
<b>NOTES:</b>	
** = DIMMING UP AND DOWN BUTTONS MAY BE SUBSTITUTED WITH DIMMING SLIDE TYPE SWITCH.	

2 FIRST FLOOR REFLECTED CEILING PLAN - AREA A BASE BID  
SCALE: 1/8" = 1'-0"

1 FIRST FLOOR REFLECTED CEILING PLAN - AREA C  
SCALE: 1/8" = 1'-0"



IMAGE 1: EXISTING CAFETERIA PENDANT FIXTURE

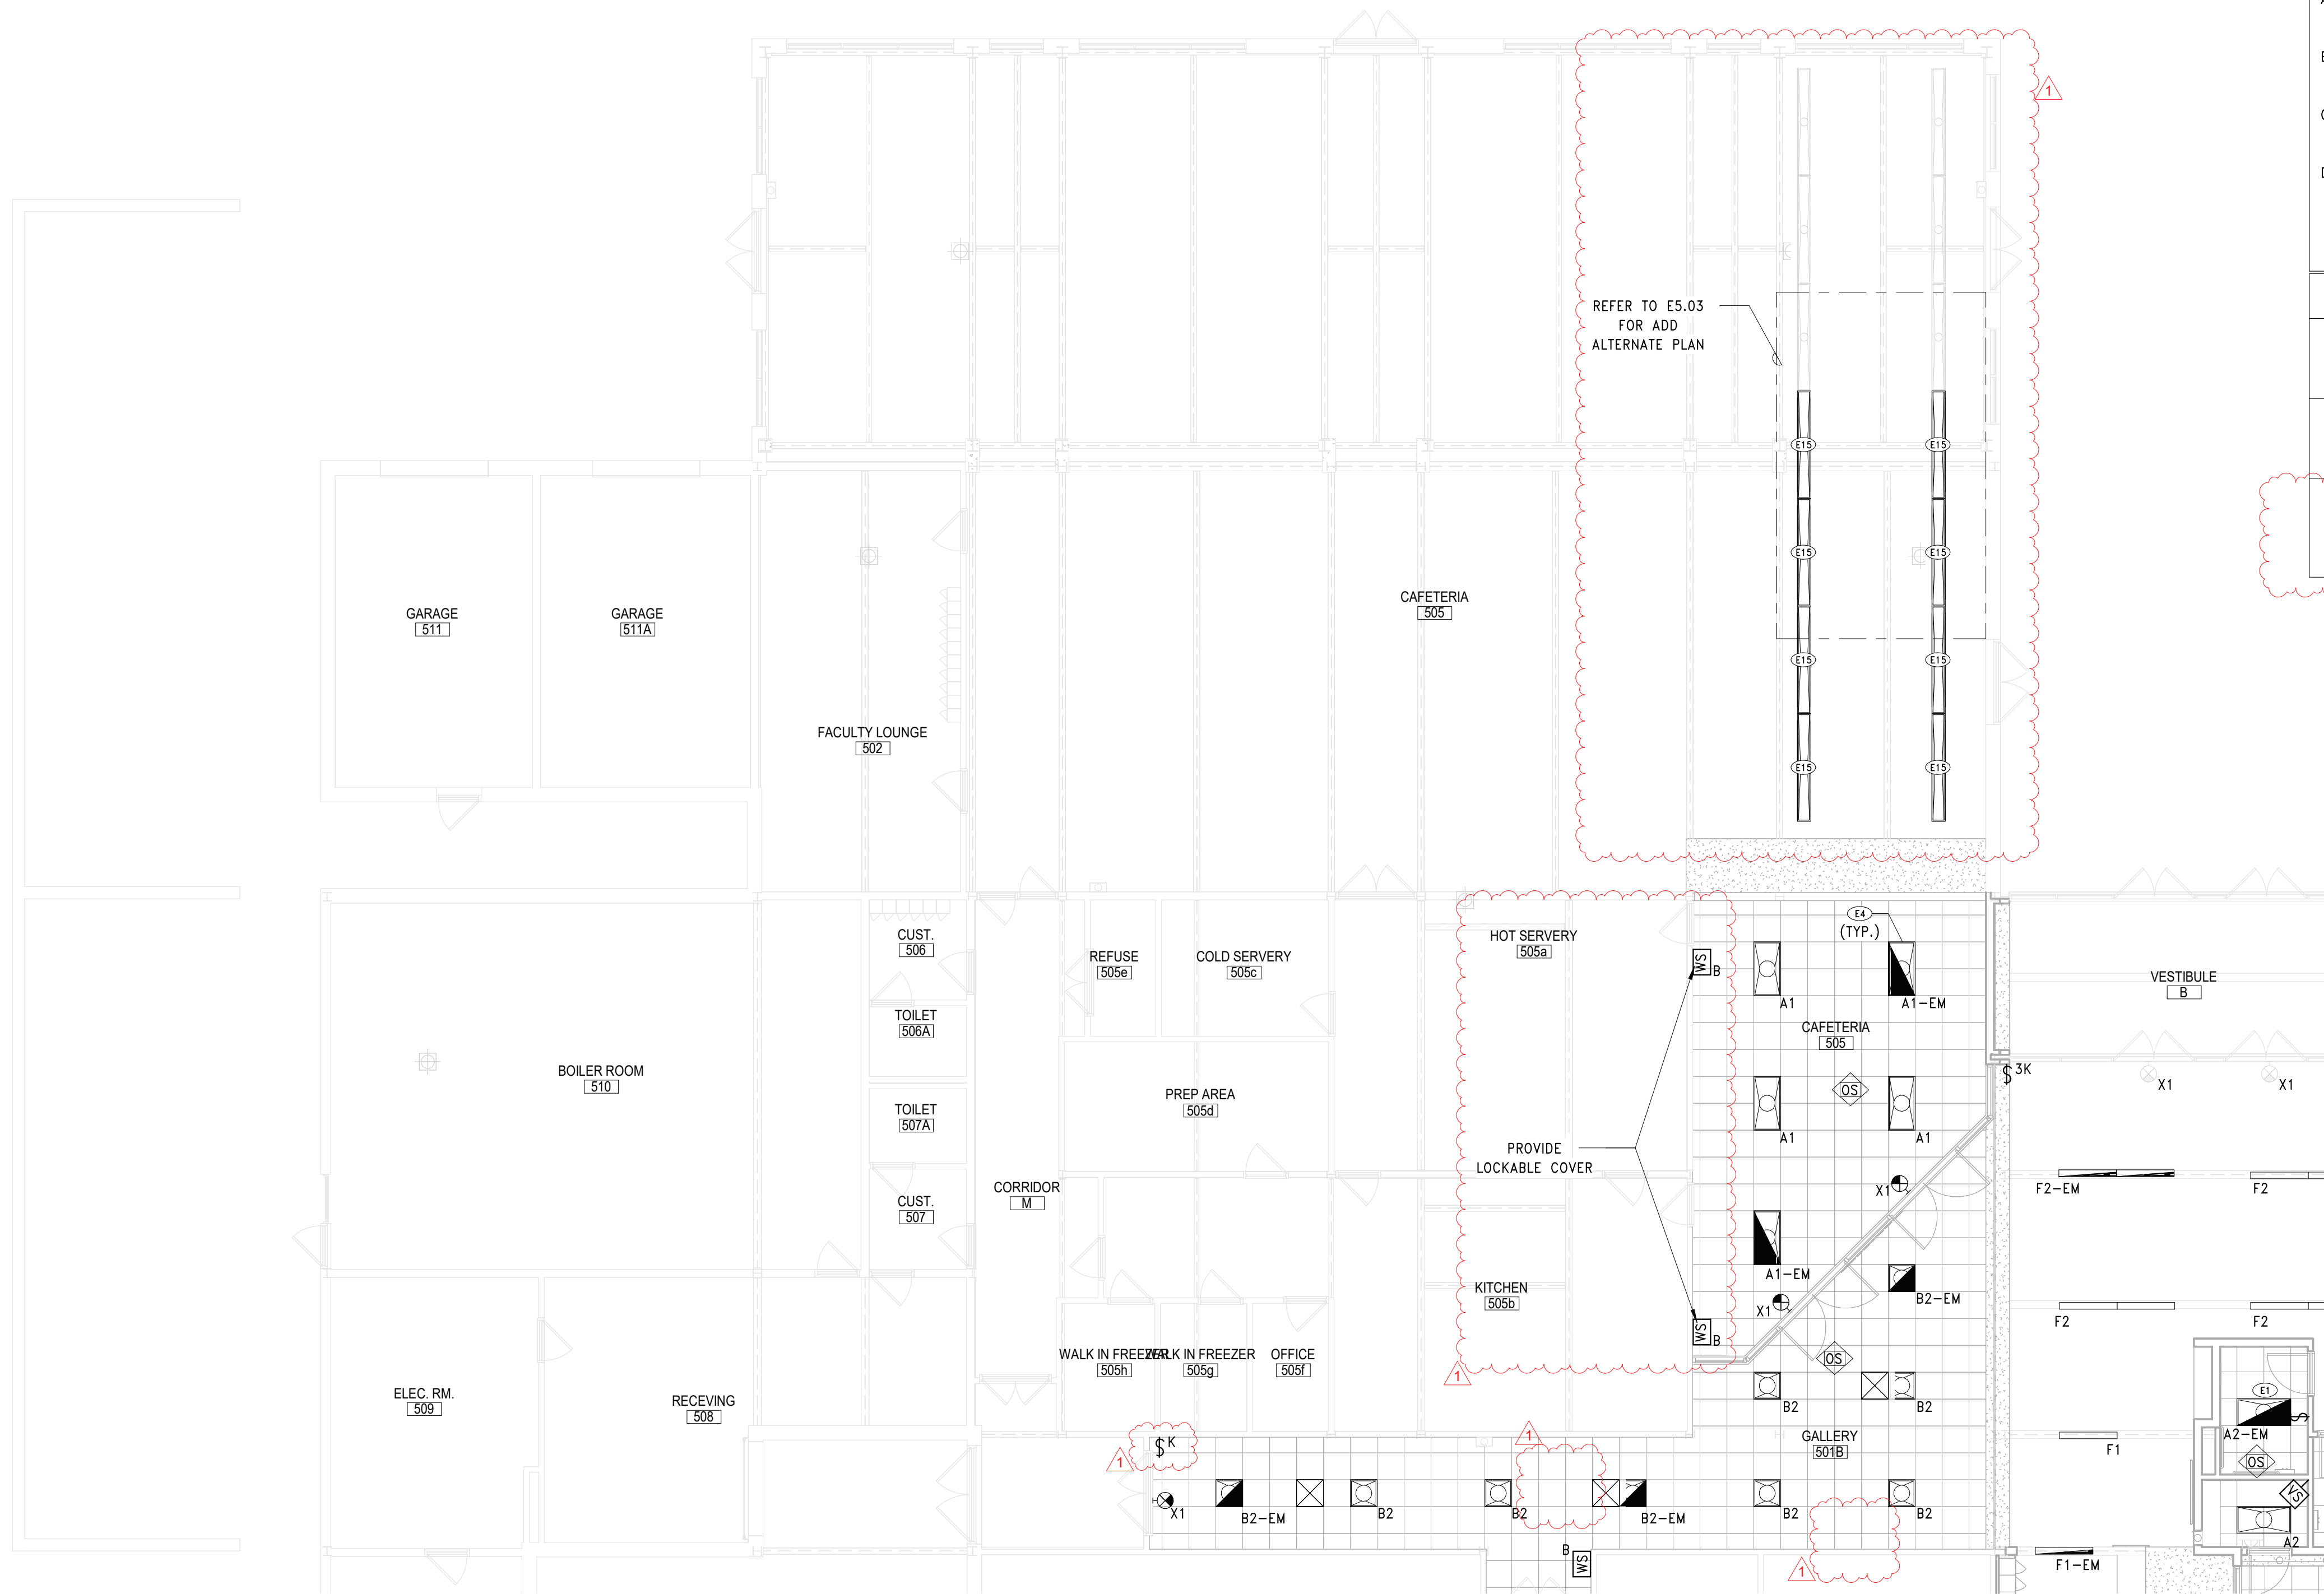

LIGHTING SHEET NOTES	
A.	FIELD COORDINATE ROUTING OF ALL FEEDERS AND BRANCH CIRCUITS.
B.	ALL PENETRATIONS THROUGH FIRE RATED WALLS AND FLOORS SHALL BE PROPERLY FIRE-STOPPED.
C.	REFER TO LIGHTING FIXTURE SCHEDULE ON DWG E601.
D.	ALL PROPOSED EMERGENCY EXIT LIGHTING SHALL BE CONNECT TO LOCAL LIGHTING CIRCUIT AHEAD OF ALL SWITCHING DEVICES. UTILIZE (2)#12, #12G. IN 3/4" EMT CONDUIT. EMERGENCY LIGHTING SHALL REMAIN ON AS NIGHT LIGHTS.
KEY NOTES	
E1	LIGHT FIXTURE SHALL BE SWITCHED. PROVIDE FIXTURE WITH UL 924 COMPLIANT EMERGENCY DRIVER AND RELAY TO ALLOW FOR AUTOMATIC ACTIVATION OF LIGHTING IN THE EVENT OF POWER LOSS.
E4	UTILIZE EXISTING CIRCUIT PREVIOUSLY CONNECTED TO REMOVED LIGHTING FIXTURES, AND CONNECT PROPOSED FIXTURES. EXTEND CIRCUIT AS NECESSARY MATCHING EXISTING SIZE(S) AND TYPE(S).
E15	PROVIDE PENDANT FIXTURE TO MATCH EXISTING FIXTURES. EXTEND EXISTING CIRCUIT AND CONNECT PROPOSED FIXTURES. VERIFY CIRCUIT LOAD CAPACITY PRIOR TO CONNECTION. REFER TO IMAGE 1 FOR SAMPLE OF EXISTING FIXTURE.

REV.	DATE	ITEM
1	11/23/22	BID ADDENDUM #1

**NOTICE**

THESE DRAWINGS ARE BASED ON CONSTRUCTION DRAWINGS NOT PREPARED BY BBS ARCHITECTS, LANDSCAPE ARCHITECTS AND ENGINEERS, P.C. AND THEREFORE, MAY NOT REPRESENT THE CONDITIONS AS CONSTRUCTED AT THE TIME. ALL EXISTING CONDITIONS SHOWN ARE REPRESENTED AS SUGGESTIVE INFORMATION AS THEY MAY NOT HAVE BEEN BUILT AND DETAIL FOR THE ORIGINAL DOCUMENTS OF THE OWNER'S INFORMATION.

KEY PLAN	
NO SCALE	

BRIARCLIFF MANOR U.F.S.D.  
PHASE 2 BOND IMPROVEMENTS  
BRIARCLIFF MANOR MIDDLE / HIGH SCHOOL  
444 PLEASANTVILLE RD. BRIARCLIFF MANOR, NY 10510  
PARTIAL FIRST FL LIGHTING PLAN - AREA A & C

PROJECT

DWG TITLE

DRWG. BY: EEA  
CHK. BY: AG

THIS DRAWING, PREPARED FOR THE SPECIFIC PROJECT INDICATED IN AN INSTRUMENT OF SERVICE AND THE PROPERTY OF BBS ARCHITECTS, LANDSCAPE ARCHITECTS AND ENGINEERS, P.C., IS NOT TO BE REPRODUCED OR USED IN ANY MANNER FOR ANY OTHER PROJECT WITHOUT THE WRITTEN CONSENT OF BBS ARCHITECTS, LANDSCAPE ARCHITECTS AND ENGINEERS, P.C.

**BBS**  
ARCHITECTS  
LANDSCAPE ARCHITECTS  
ENGINEERS  
BRANCH PROJECT CONTACT: 244 EAST MAIN STREET  
187 WOLF ROAD, STE. 205 PATSCOQUE  
ALBANY, NEW YORK 12205  
T: 518.621.7650 F: 518.475.0349 F: 518.475.0361  
WWW.BBSARCHITECTURE.COM

SER. NO. 66-14-02-02-0-004-023  
DISTRICT BRIARCLIFF MANOR U.F.S.D.  
PROJECT PHASE 2 BOND IMPROVEMENTS  
DWG TITLE PARTIAL FIRST FL LIGHTING PLAN - AREA A & C  
SCALE: AS NOTED  
DATE: 07/07/22  
BID P/L DATE:  
FILE NO. 21-274C

E3.01 HSMS



SEQUENCE A

1. OCCUPANCY OR VACANCY SENSOR(S) FOR AUTO-OFF OF ALL FIXTURES AFTER 20 MIN. TIME DELAY

2. NO DAYLIGHT SENSOR(S) IN SPACE

3. NO FIXTURES LABELED AS "EM"

4. 3 BUTTON WALL STATION:  
BUTTON 1: ON/OFF CONTROL OF GENERAL ILLUMINATION FIXTURES  
BUTTON 2: DIM UP OF GENERAL ILLUMINATION FIXTURES\*\*  
BUTTON 3: DIM DOWN OF GENERAL ILLUMINATION FIXTURES\*\*

SEQUENCE B

1. OCCUPANCY OR VACANCY SENSOR(S) FOR AUTO-OFF OF ALL FIXTURES AFTER 20 MIN. TIME DELAY

2. NO DAYLIGHT SENSOR(S) IN SPACE

3. WHERE APPLICABLE, U.O.N. UNSWITCHED CONTROL FOR ALL FIXTURES LABELED AS "EM". FIXTURES SHALL REMAIN ON AT ALL TIMES.

4. 3 BUTTON WALL STATION:  
BUTTON 1: ON/OFF CONTROL OF GENERAL ILLUMINATION FIXTURES  
BUTTON 2: DIM UP OF GENERAL ILLUMINATION FIXTURES\*\*  
BUTTON 3: DIM DOWN OF GENERAL ILLUMINATION FIXTURES\*\*

SEQUENCE C

1. OCCUPANCY OR VACANCY SENSOR(S) FOR AUTO-OFF OF ALL FIXTURES AFTER 20 MIN. TIME DELAY

2. NO DAYLIGHT SENSOR(S) IN SPACE

3. WHERE APPLICABLE, U.O.N. UNSWITCHED CONTROL FOR ALL FIXTURES LABELED AS "EM". FIXTURES SHALL REMAIN ON AT ALL TIMES.

4. 9 BUTTON WALL STATION:  
BUTTON 1: ON/OFF CONTROL OF TYPE "a" FIXTURES  
BUTTON 2: DIM UP OF TYPE "a" SWITCH LEG  
BUTTON 3: DIM DOWN OF TYPE "a" SWITCH LEG  
BUTTON 4: DIM UP OF TYPE "b" SWITCH LEG  
BUTTON 5: DIM DOWN OF TYPE "b" SWITCH LEG  
BUTTON 6: DIM UP OF TYPE "c" SWITCH LEG  
BUTTON 7: DIM DOWN OF TYPE "c" SWITCH LEG  
BUTTON 8: DIM UP OF TYPE "d" SWITCH LEG  
BUTTON 9: DIM DOWN OF TYPE "d" SWITCH LEG

SEQUENCE D

1. OCCUPANCY OR VACANCY SENSOR(S) FOR AUTO-OFF OF ALL FIXTURES AFTER 20 MIN. TIME DELAY

2. WHERE APPLICABLE, U.O.N. UNSWITCHED CONTROL FOR ALL FIXTURES LABELED AS "EM". FIXTURES SHALL REMAIN ON AT ALL TIMES.

3. 7 BUTTON WALL STATION:  
BUTTON 1: ON/OFF CONTROL OF TYPE ALL FIXTURES  
BUTTON 2: DIM UP OF TYPE "a" SWITCH LEG  
BUTTON 3: DIM DOWN OF TYPE "a" SWITCH LEG  
BUTTON 4: DIM UP OF TYPE "b" SWITCH LEG  
BUTTON 5: DIM DOWN OF TYPE "b" SWITCH LEG  
BUTTON 6: DIM UP OF TYPE "c" SWITCH LEG  
BUTTON 7: DIM DOWN OF TYPE "c" SWITCH LEG

SEQUENCE E

1. OCCUPANCY OR VACANCY SENSOR(S) FOR AUTO-OFF OF ALL FIXTURES AFTER 20 MIN. TIME DELAY

2. NO DAYLIGHT SENSOR(S) IN SPACE

3. WHERE APPLICABLE, U.O.N. UNSWITCHED CONTROL FOR ALL FIXTURES LABELED AS "EM". FIXTURES SHALL REMAIN ON AT ALL TIMES.

4. SINGLE SWITCH FOR ON/OFF CONTROL OF ALL FIXTURES

5. BUTTON WALL STATION:  
BUTTON 1: ON/OFF CONTROL OF GENERAL ILLUMINATION FIXTURES  
BUTTON 2: DIM UP OF GENERAL ILLUMINATION FIXTURES\*\*  
BUTTON 3: DIM DOWN OF GENERAL ILLUMINATION FIXTURES\*\*

SEQUENCE F

1. OCCUPANCY OR VACANCY SENSOR(S) FOR AUTO-OFF OF ALL FIXTURES AFTER 20 MIN. TIME DELAY

2. NO DAYLIGHT SENSOR(S) IN SPACE


3. WHERE APPLICABLE, U.O.N. UNSWITCHED CONTROL FOR ALL FIXTURES LABELED AS "EM". FIXTURES SHALL REMAIN ON AT ALL TIMES.

4. SINGLE SWITCH FOR ON/OFF CONTROL OF ALL FIXTURES

5. BUTTON WALL STATION:  
BUTTON 1: ON/OFF CONTROL OF TYPE ALL FIXTURES  
BUTTON 2: DIM UP OF TYPE "a" SWITCH LEG\*\*  
BUTTON 3: DIM DOWN OF TYPE "a" SWITCH LEG\*\*  
BUTTON 4: DIM UP OF TYPE "b" SWITCH LEG\*\*  
BUTTON 5: DIM DOWN OF TYPE "b" SWITCH LEG\*\*

NOTES:

\*\* = DIMMING UP AND DOWN BUTTONS MAY BE SUBSTITUTED WITH DIMMING SLIDE TYPE SWITCH.

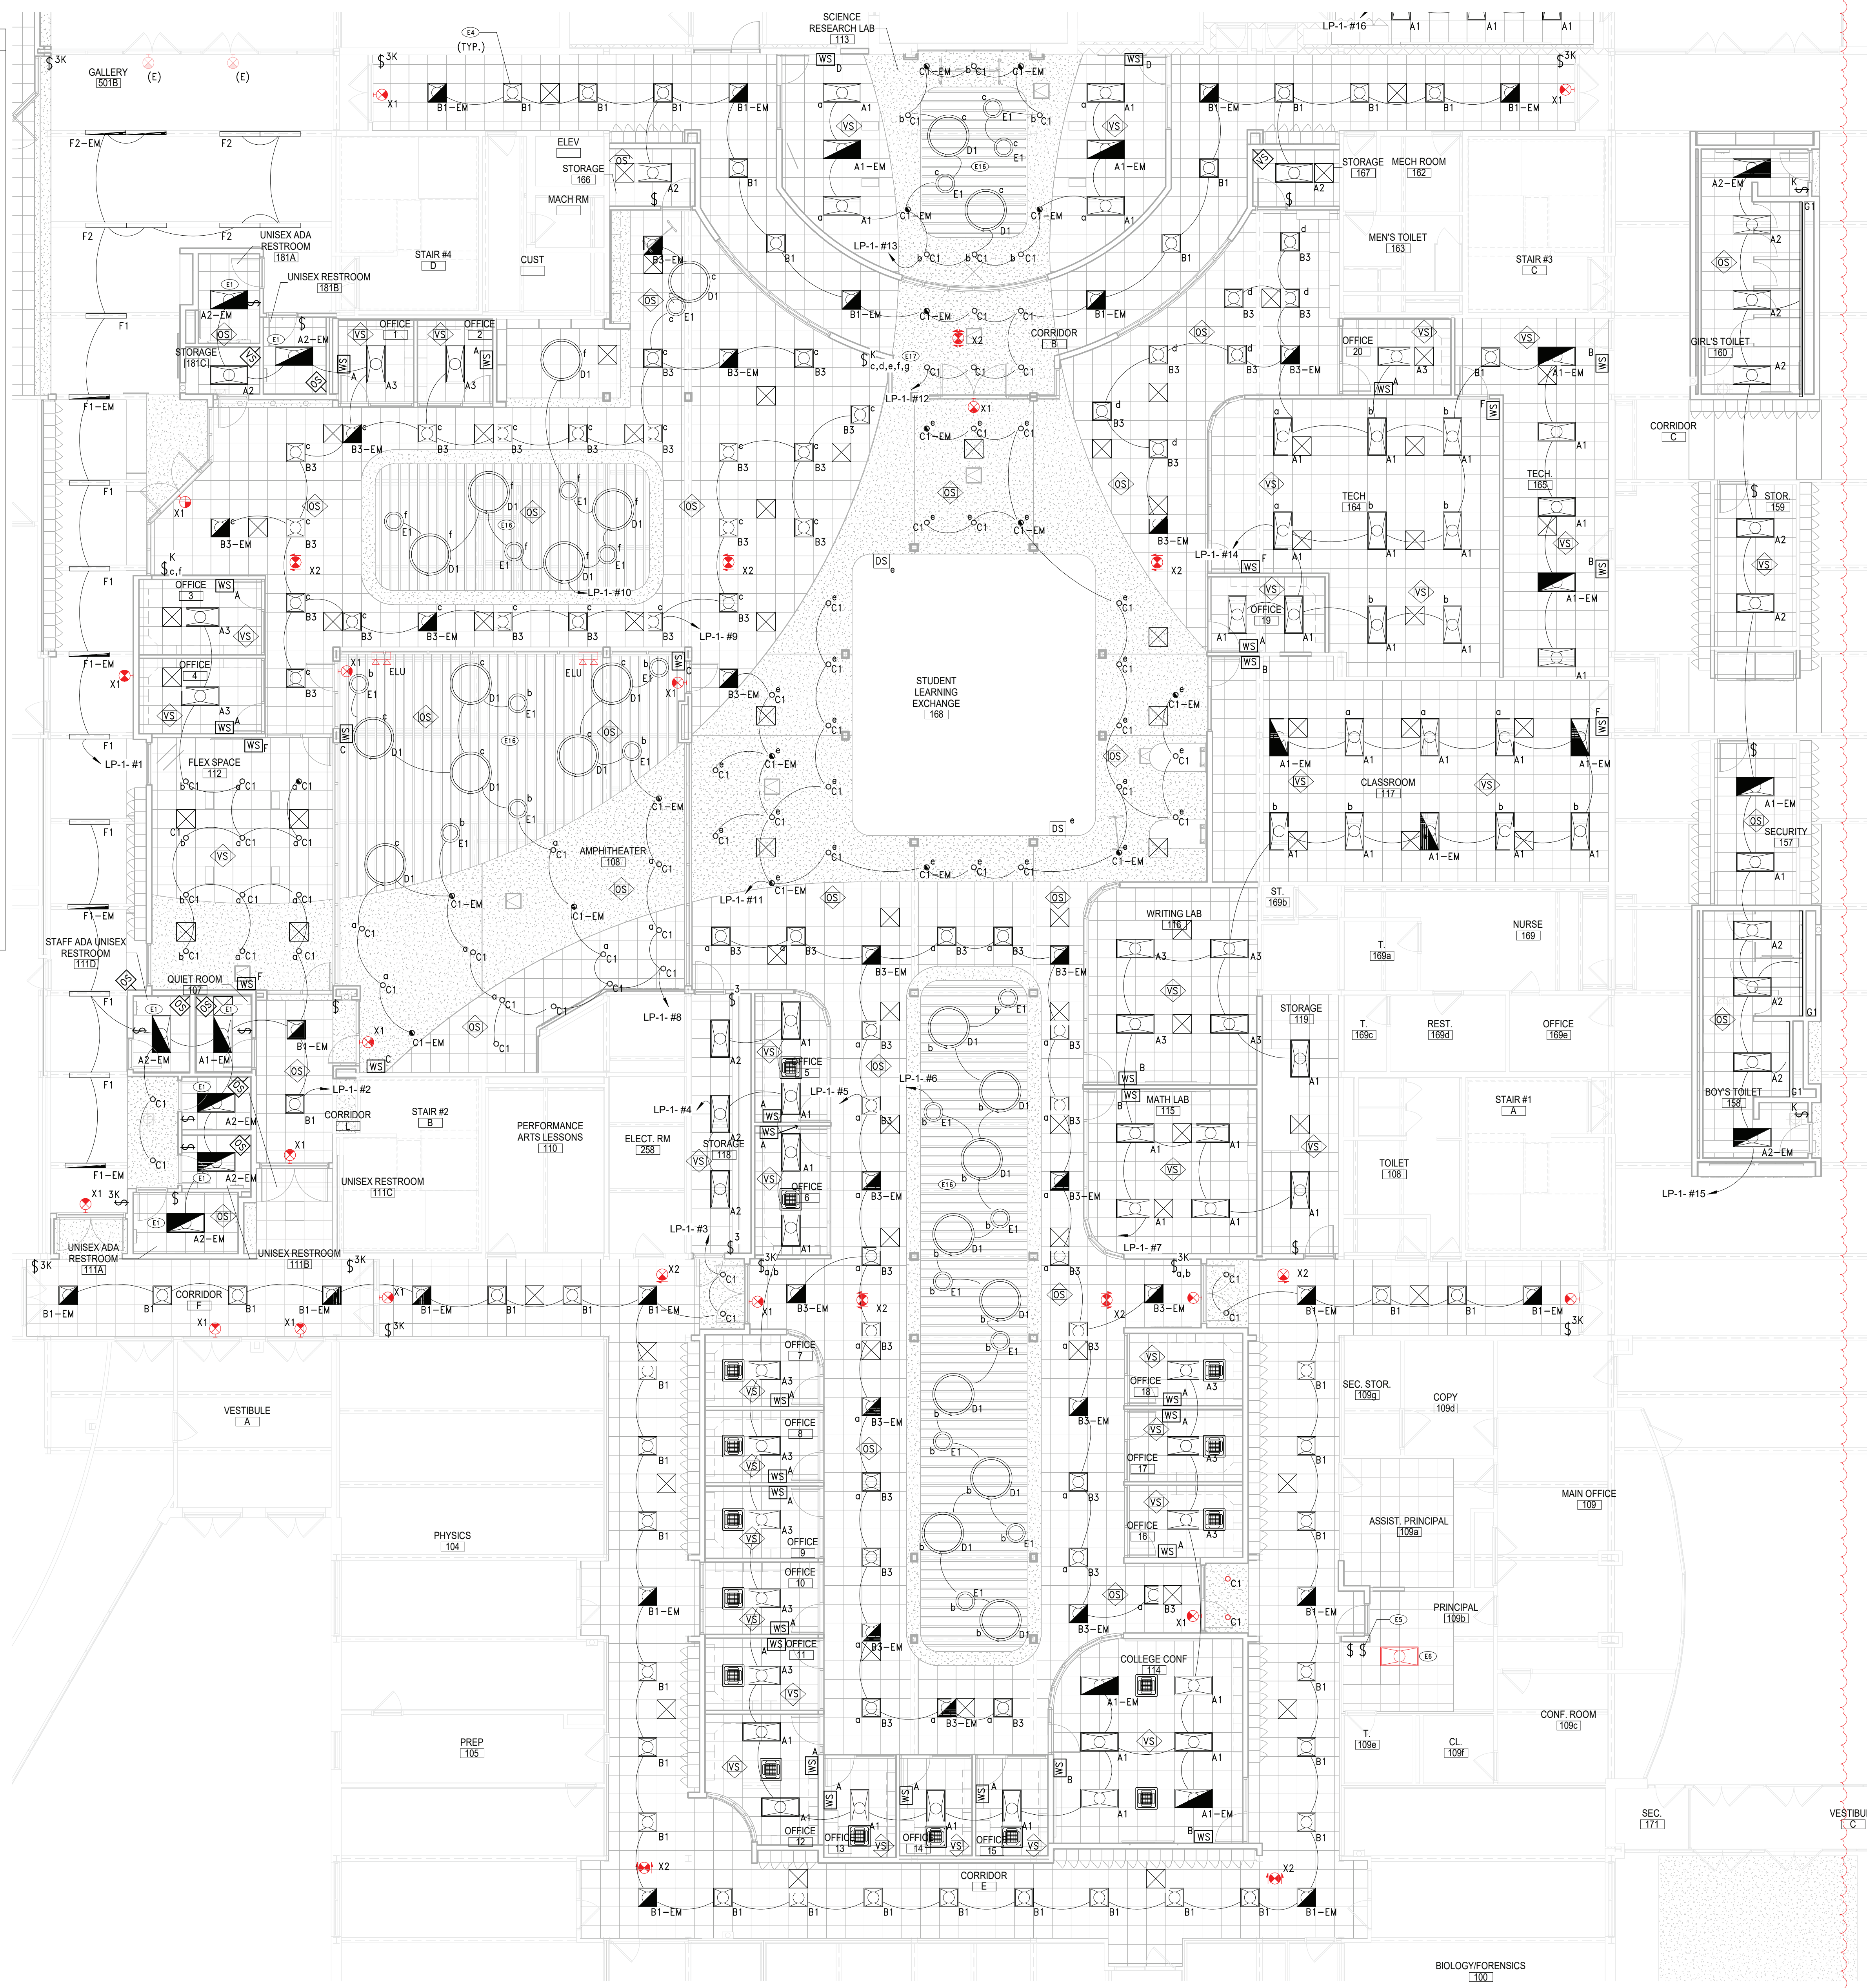

1 FIRST FLOOR REFLECTED CEILING PLAN - AREA D  
SCALE: 1/8" = 1'-0"

LIGHTING SHEET NOTES

A. FIELD COORDINATE ROUTING OF ALL FEEDERS AND BRANCH CIRCUITS.

B. ALL PENETRATIONS THROUGH FIRE RATED WALLS AND FLOORS SHALL BE PROPERLY FIRE-STOPPED.

C. REFER TO LIGHTING FIXTURE SCHEDULE ON DWG E601.

D. ALL PROPOSED EMERGENCY EXIT LIGHTING SHALL BE CONNECT TO LOCAL LIGHTING CIRCUIT AHEAD OF ALL SWITCHING DEVICES. UTILIZE (2)#12, #12G. IN 3/4" EMT CONDUIT. EMERGENCY LIGHTING SHALL REMAIN ON AS NIGHT LIGHTS.

KEY NOTES

E1 LIGHT FIXTURE SHALL BE SWITCHED. PROVIDE FIXTURE WITH UL 924 COMPLAINT EMERGENCY DRIVER AND RELAY TO ALLOW FOR AUTOMATIC ACTIVATION OF LIGHTING IN THE EVENT OF POWER LOSS.

E4 UTILIZE EXISTING CIRCUIT PREVIOUSLY CONNECTED TO REMOVED LIGHTING FIXTURES, AND CONNECT PROPOSED FIXTURES. EXTEND CIRCUIT AS NECESSARY MATCHING EXISTING SIZE(S) AND TYPE(S).

E5 RE-INSTALL PREVIOUSLY REMOVED LIGHTING SWITCH IN LOCATION AS INDICATED. FIELD COORDINATE WITH GC FOR EXACT LOCATION.

E6 RE-INSTALL PREVIOUSLY REMOVED LIGHTING FIXTURE IN LOCATION AS INDICATED. FIELD COORDINATE WITH GC FOR EXACT LOCATION.

E16 PROVIDE EVENLY SPACED UNITSTRUT FOR ADDITIONAL SUPPORTS AS NECESSARY FOR THE PROPER MOUNTING OF PENDANT MOUNTED FIXTURES.

E17 REFER TO DRAWING E3.03 FOR FIXTURES CONTROLLED WITH SWITCH LEG TYPE "g".

KEY PLAN

NO SCALE

PROJECT

DWG. BY: EEA

CHK. BY: AG

THIS DRAWING, PREPARED FOR THE SPECIFIC PROJECT INDICATED IN AN INSTRUMENT OF SERVICE AND THE PROPERTY OF BBS ARCHITECTS, LANDSCAPE ARCHITECTS AND ENGINEERS, P.C., IS NOT TO BE REPRODUCED OR USED IN ANY MANNER FOR ANY OTHER PROJECT WITHOUT THE WRITTEN CONSENT OF BBS ARCHITECTS, LANDSCAPE ARCHITECTS AND ENGINEERS, P.C.

BBS

ARCHITECTS

LANDSCAPE ARCHITECTS

ENGINEERS

BRANCH PROJECT CONTACT: 187 WOLF ROAD, STE. 205 ALBANY, NEW YORK 12205 T. 518.621.7650

244 EAST MAIN STREET PATCHOGUE, NEW YORK 11772 T. 631.475.0349 F. 631.475.0361

www.bbsarchitecture.com

SED NO. 66-14-02-02-0-004-023

DISTRICT BRIARCLIFF MANOR U.F.S.D.

PROJECT PHASE 2 BOND IMPROVEMENTS

DWG TITLE PARTIAL FIRST FL LIGHTING PLAN - AREA D

SCALE: AS NOTED

DATE: 07/07/22

BID PAU DATE:

FILE NO. 21-274C


E3.02

HSMS




2 FIRST FLOOR PROPOSED PLAN - AREA A BASE BID

SCALE: 1/8" = 1'-0"

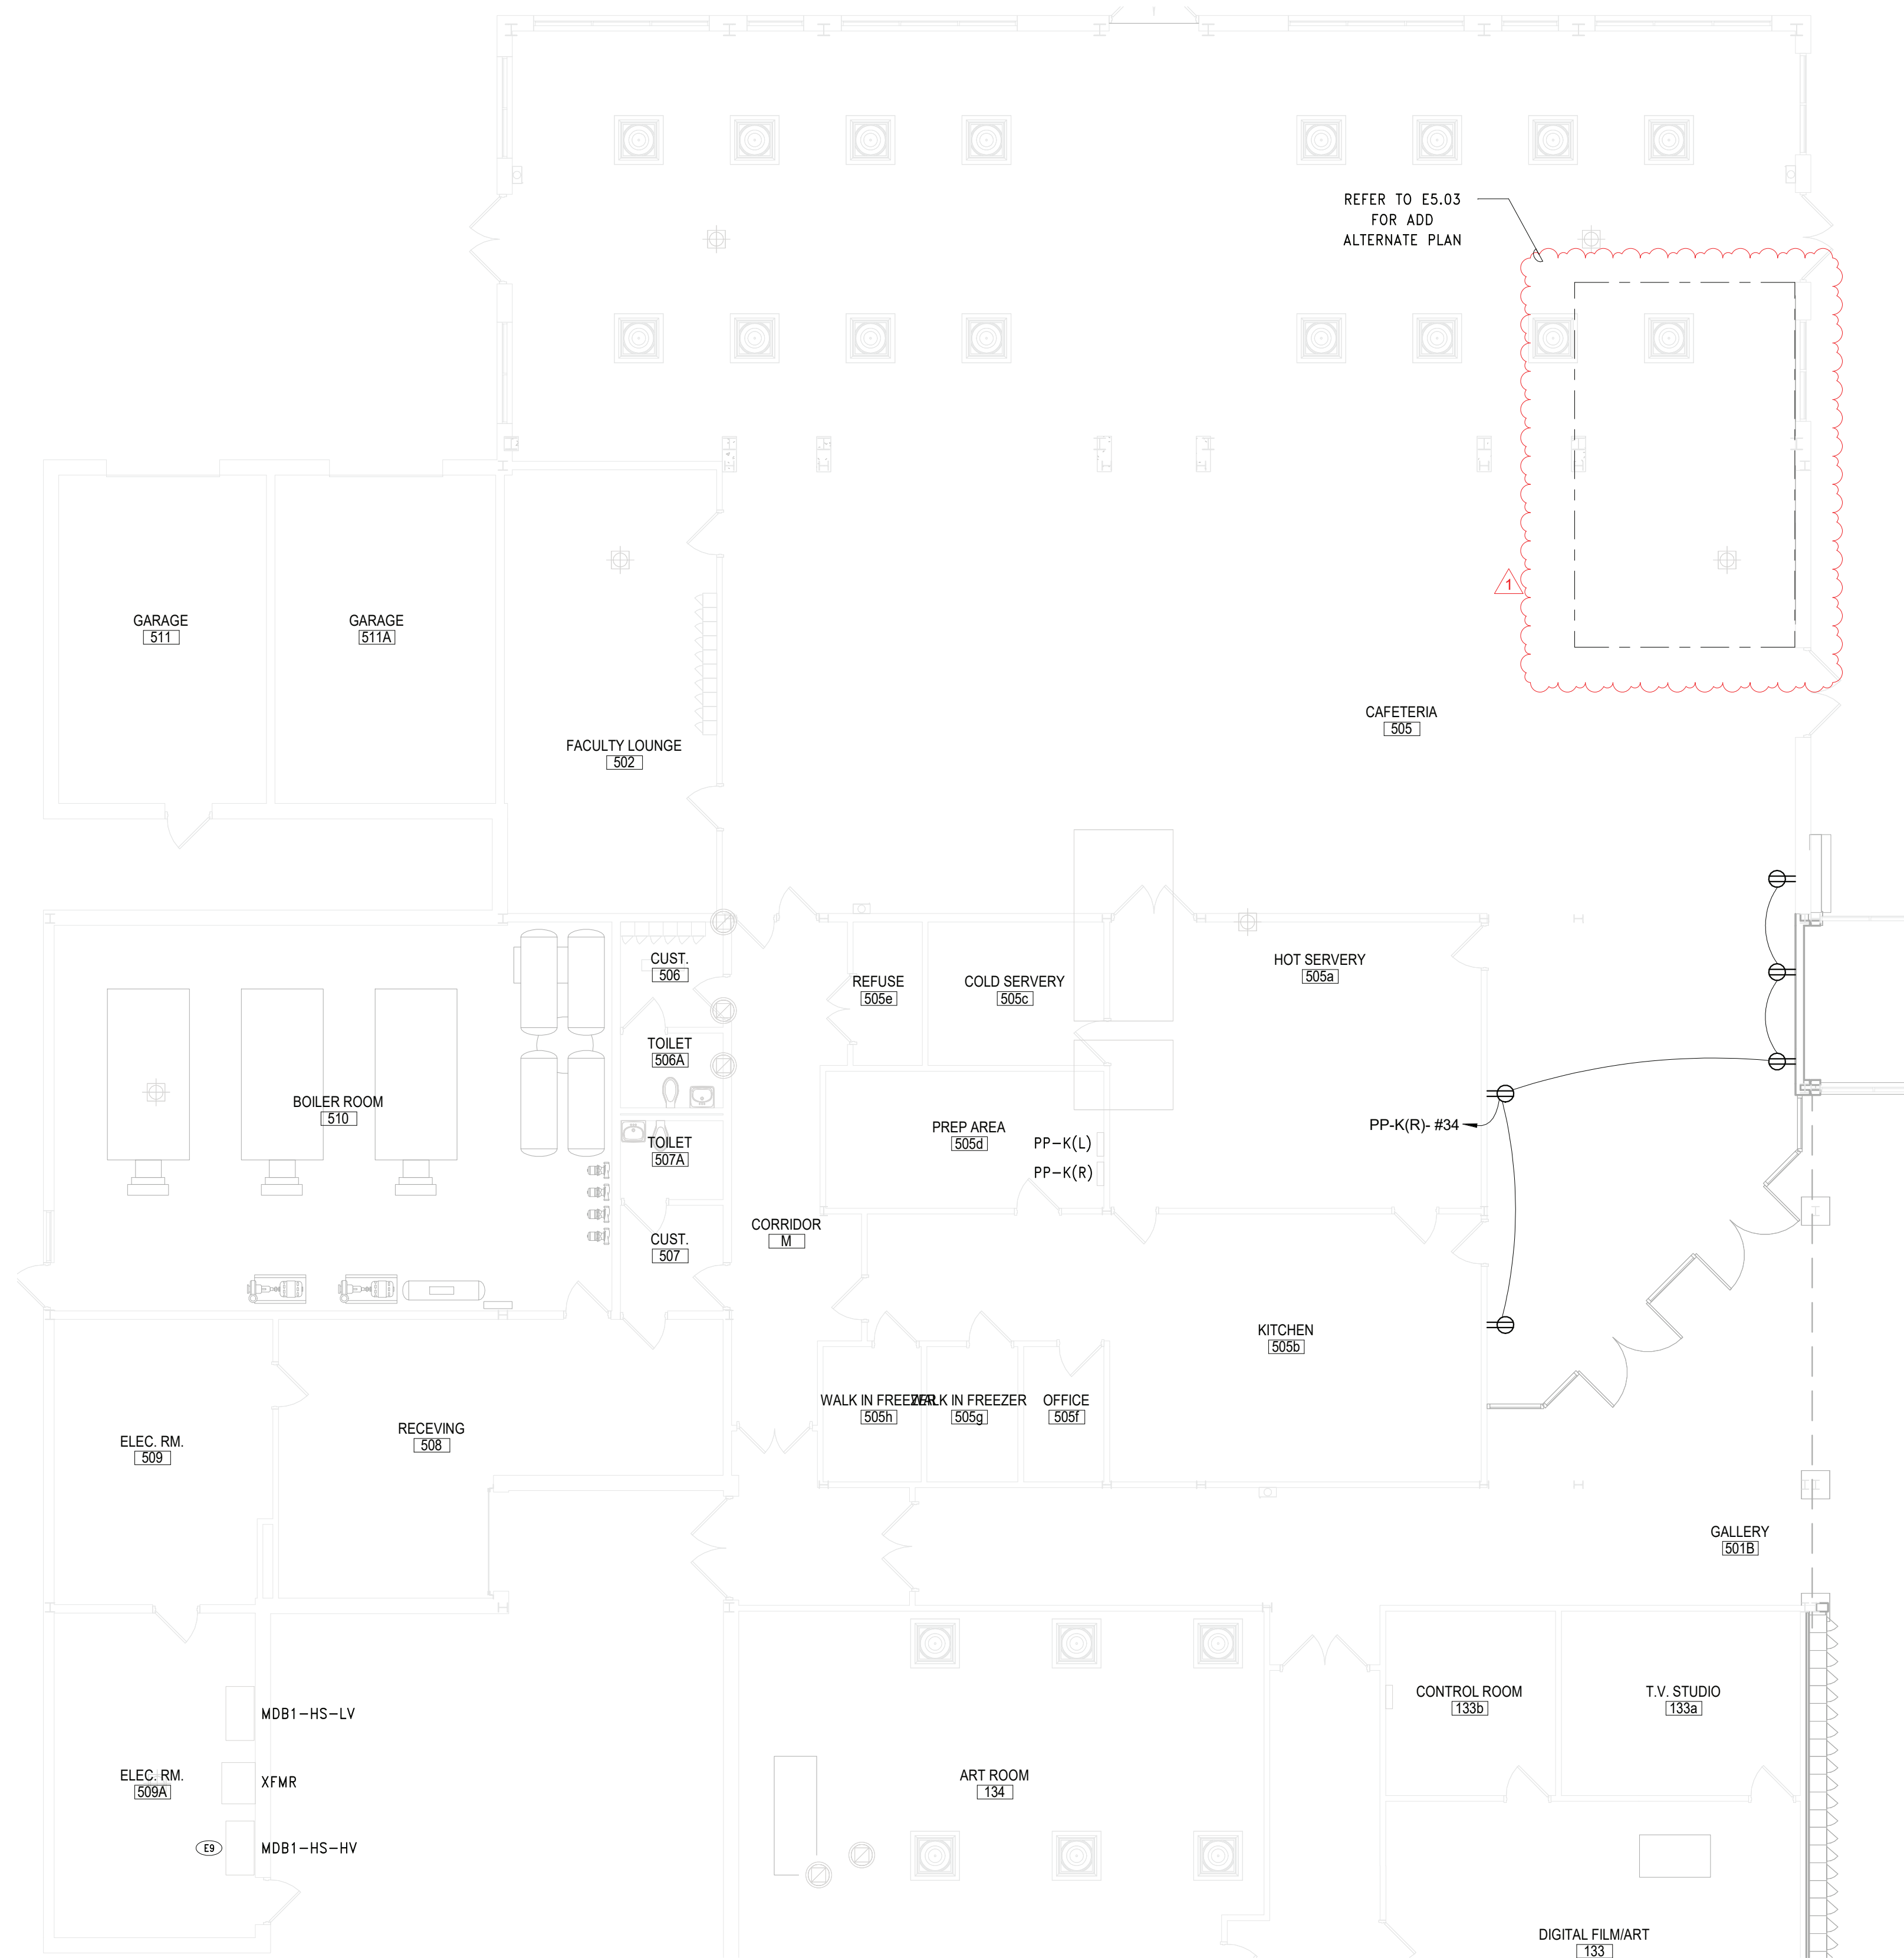


1 FIRST FLOOR PROPOSED PLAN - AREA C BASE BID

SCALE: 1/8" = 1'-0"

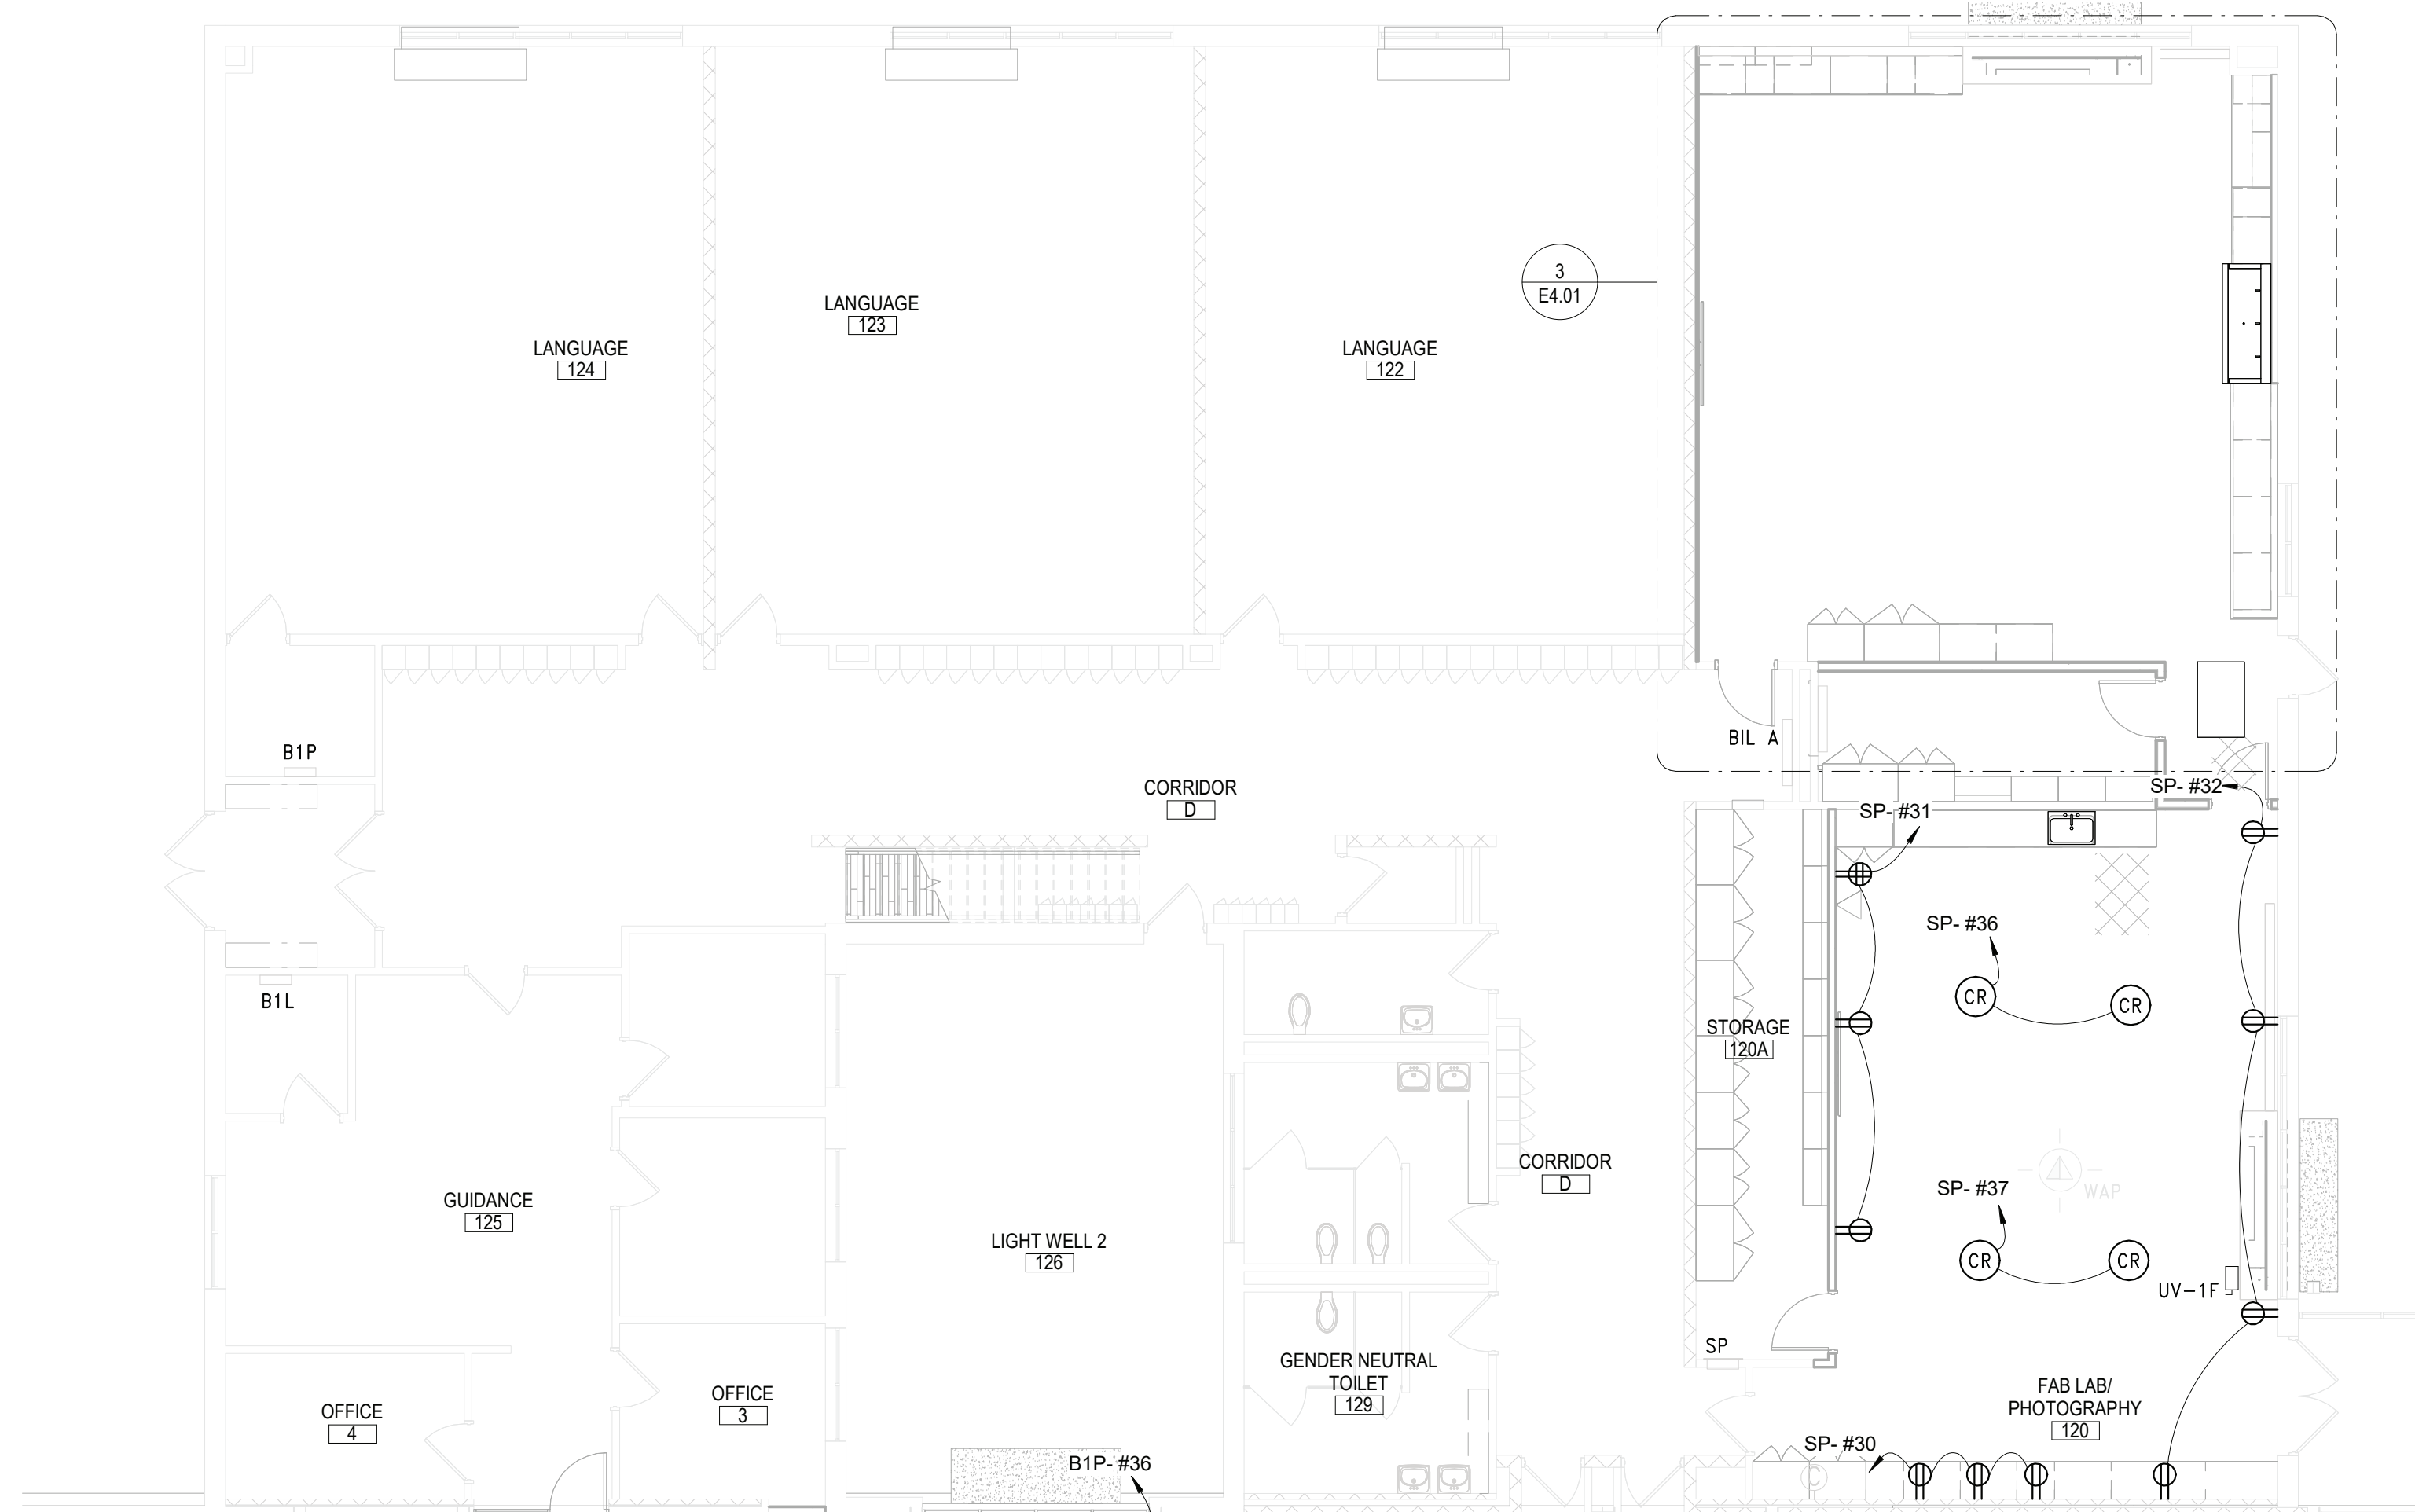


4 FIRST FLOOR PROPOSED PLAN - AREA H

SCALE: 1/8" = 1'-0"

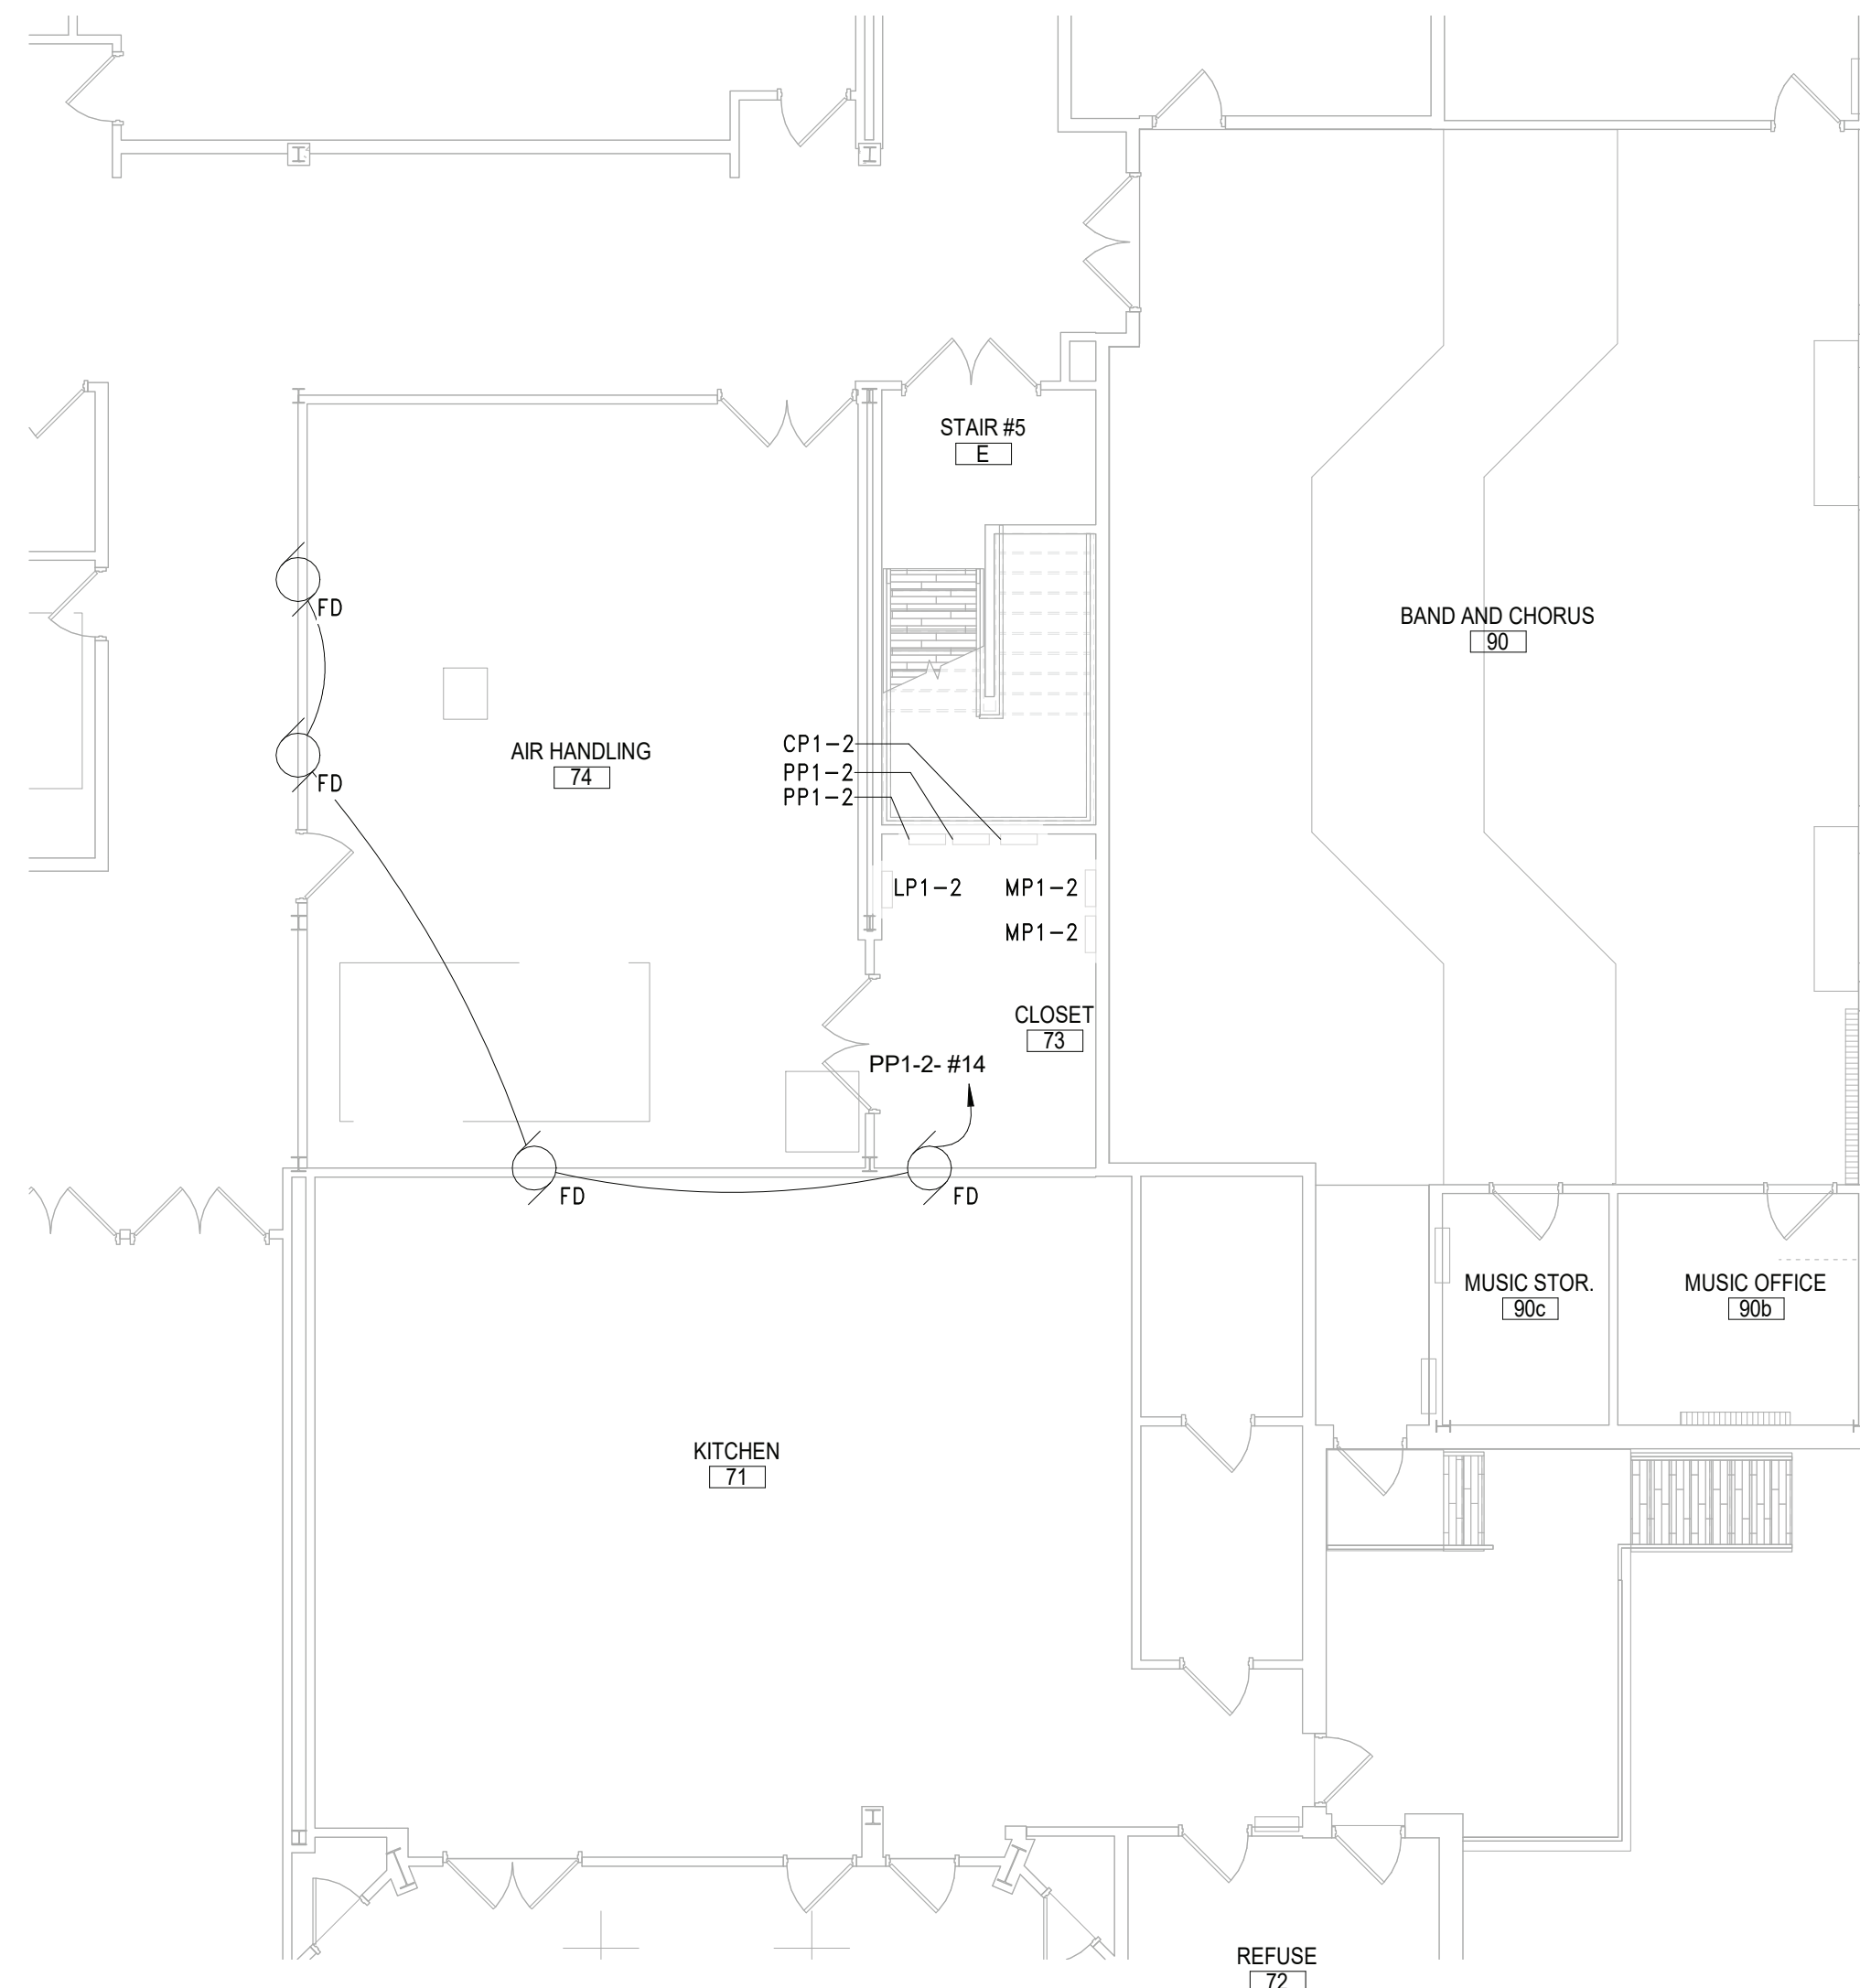

3 FIRST FLOOR PROPOSED PLAN - AREA C ENLARGED PLAN

SCALE: 1/4" = 1'-0"

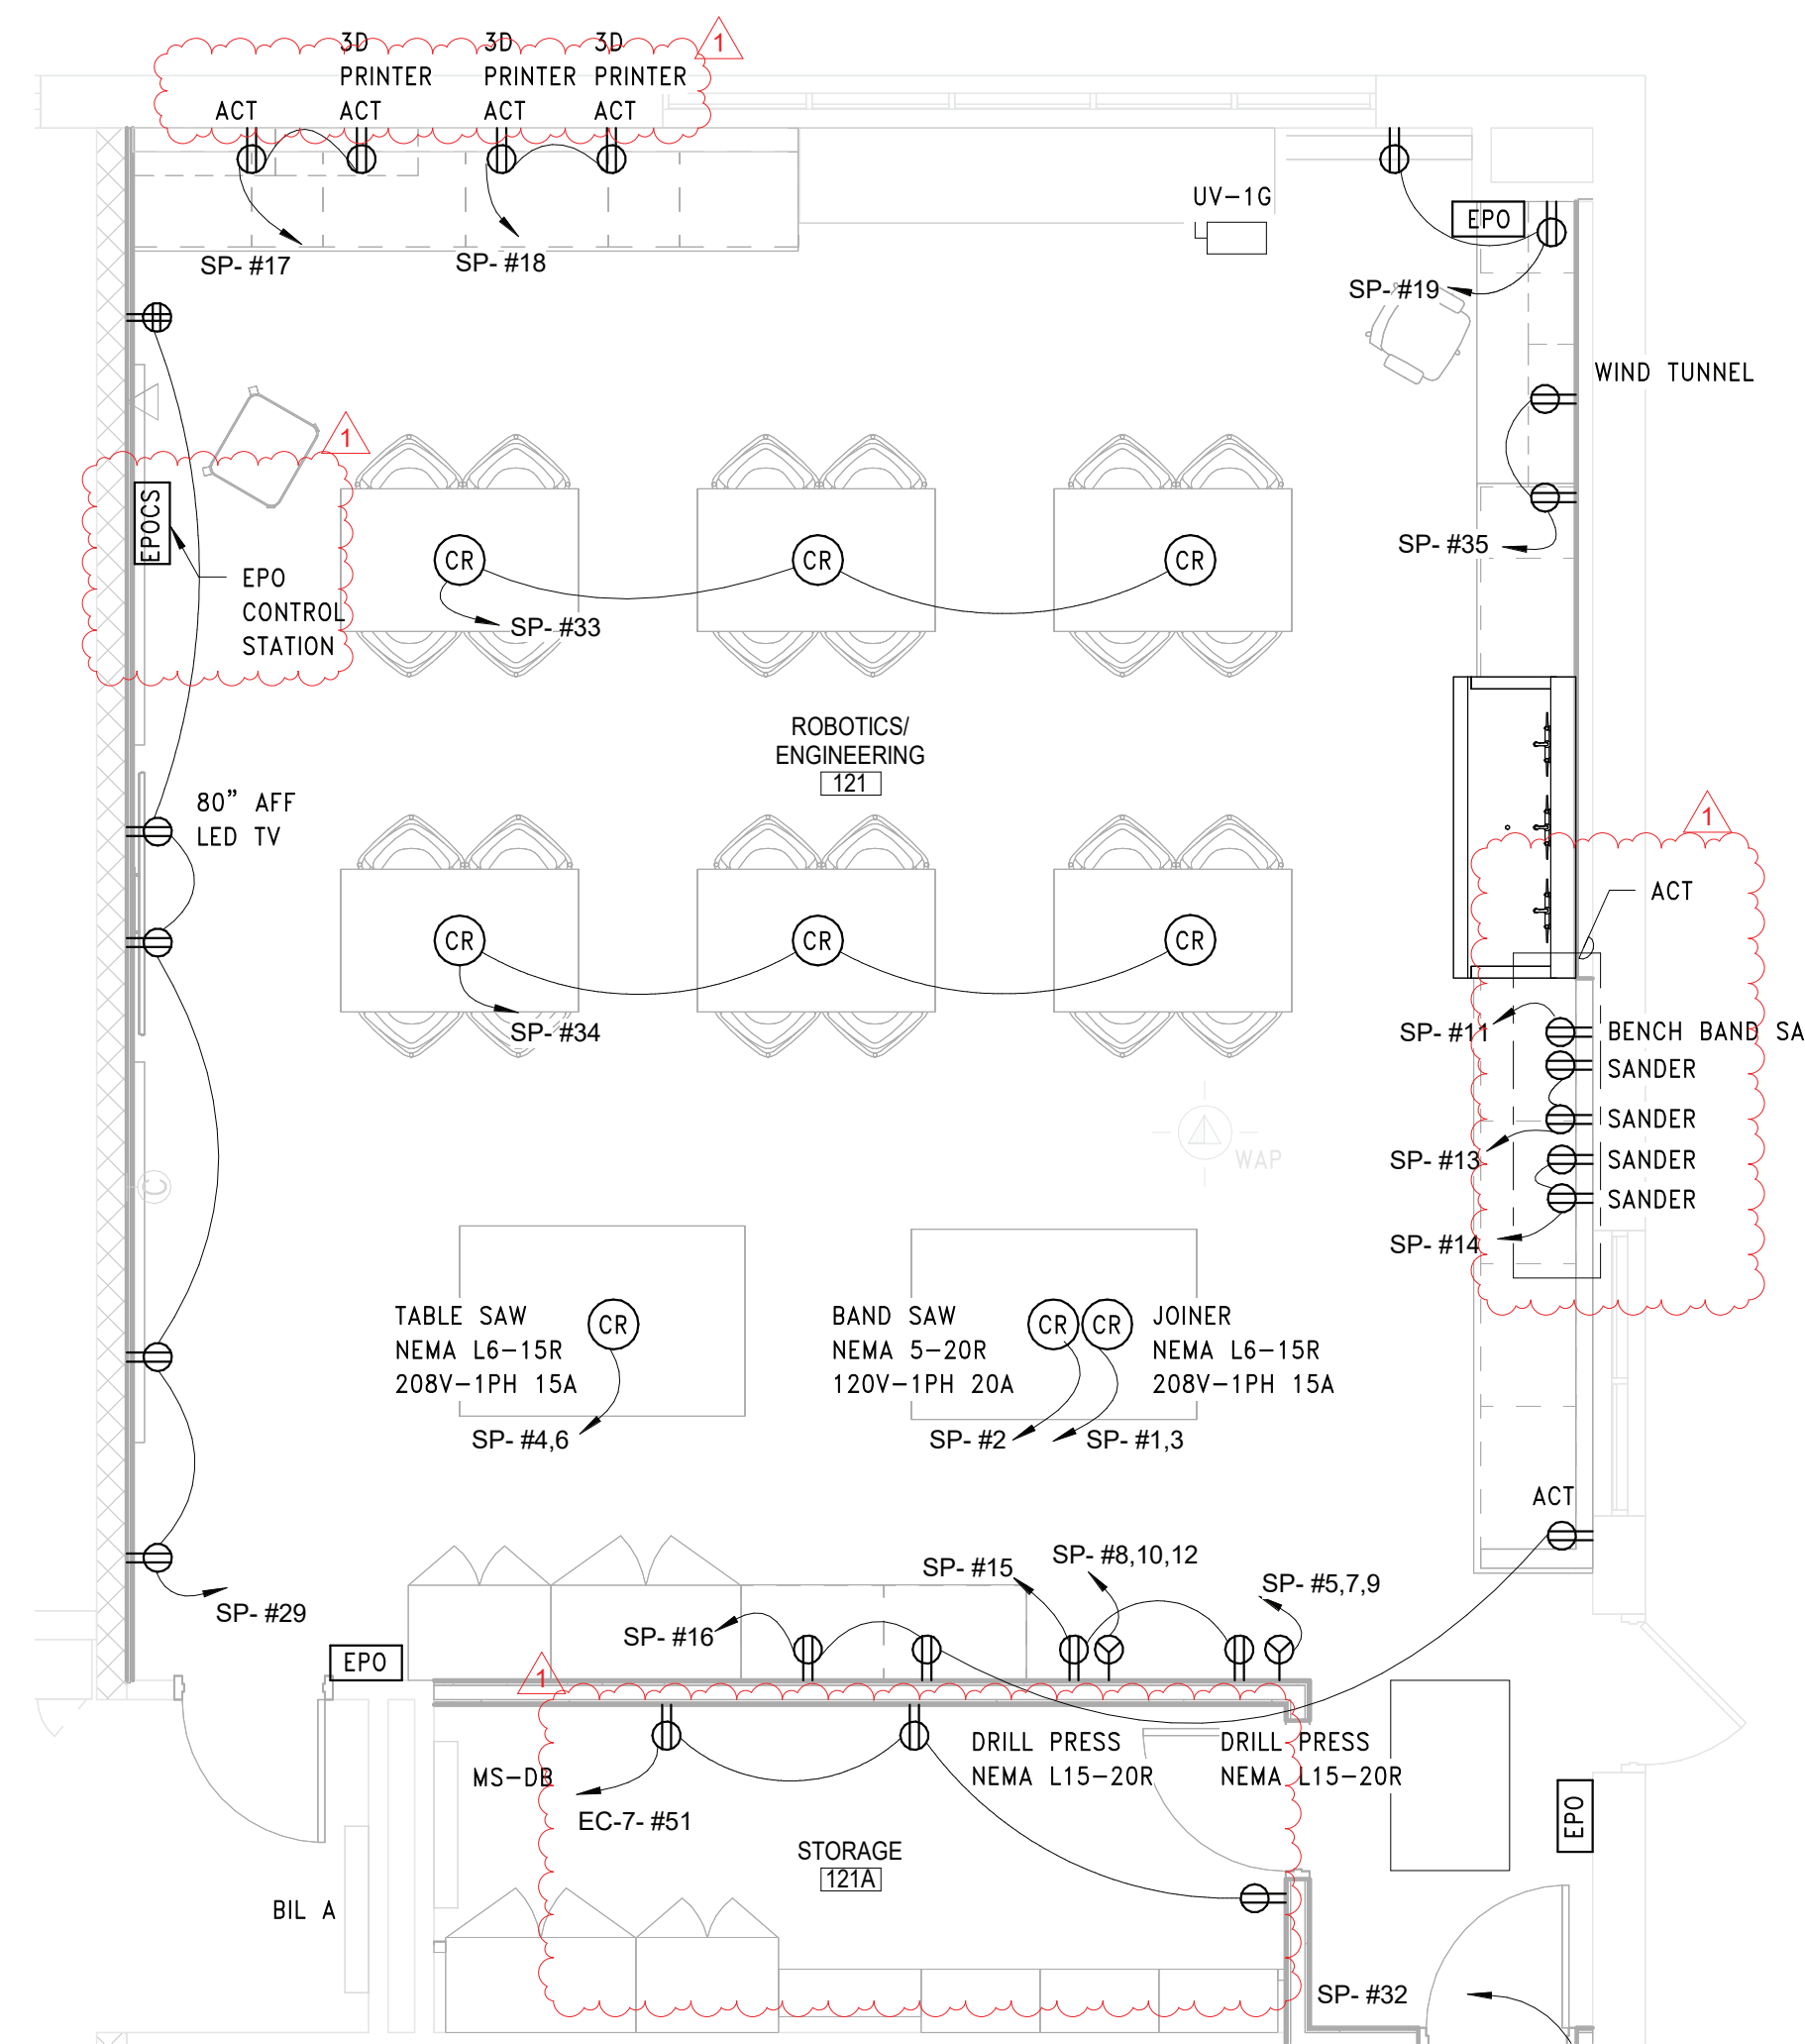

POWER SHEET NOTES

- COORDINATE LOCATION OF CORD REELS WITH GC PRIOR TO CEILING INSTALLATION.
- FIELD COORDINATE ROUTING OF ALL FEEDERS AND BRANCH CIRCUITS.
- ALL PENETRATIONS THROUGH FIRE RATED WALLS AND FLOORS SHALL BE PROPERLY FIRE-STOPPED.
- REFER TO EQUIPMENT SCHEDULE ON DRAWING E10.01 FOR MECHANICAL EQUIPMENT ELECTRICAL REQUIREMENTS.
- ALL DEVICES SHALL BE RECESSED IN WALL. CONTACT ENGINEER AND ARCHITECT TO COORDINATE ANY AREAS WHERE EXISTING WALLS ARE SHOWN WITH NEW DEVICES.


KEY NOTES

- E9 UTILIZE SPARE BREAKER SPACES PREVIOUSLY FEEDING REMOVED UNIT FOR PROPOSED UNITS TO BE PROVIDED IN THIS PHASE. REFER TO PANEL BOARD DIRECTORY AND ELECTRICAL EQUIPMENT SCHEDULE FOR BREAKER AND CIRCUIT INFORMATION.

REV.	DATE	ITEM
1	11/23/22	BID ADDENDUM #1

NOTICE

THESE DRAWINGS ARE BASED ON CONSTRUCTION DRAWINGS NOT PREPARED BY BBS ARCHITECTS, LANDSCAPE ARCHITECTS AND ENGINEERS, P.C. AND THEREFORE, MAY NOT REPRESENT THE CONDITIONS AS CONSTRUCTED AT THE TIME. ALL EXISTING CONDITIONS SHOWN ARE REPRESENTED AS SUGGESTIVE INFORMATION AS THEY MAY NOT HAVE BEEN BUILT AND OBTAINED FROM THE ORIGINAL DOCUMENTS OR FROM THE OWNER'S INFORMATION.

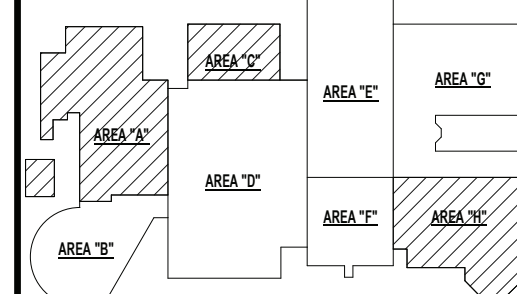

KEY PLAN

NO SCALE

BRIARCLIFF MANOR U.F.S.D.  
PHASE 2 BOND IMPROVEMENTS  
BRIARCLIFF MANOR MIDDLE / HIGH SCHOOL  
444 PLEASANTVILLE RD. BRIARCLIFF MANOR, NY 10510

PARTIAL FIRST FL POWER PLAN - AREA A & C

PROJECT

DRWG. BY: EEA  
CHK. BY: AG

THIS DRAWING, PREPARED FOR THE SPECIFIC PROJECT INDICATED IS AN INSTRUMENT OF SERVICE AND THE PROPERTY OF BBS ARCHITECTS, LANDSCAPE ARCHITECTS AND ENGINEERS, P.C. REPRODUCTION OR ANY USE OF THIS DRAWING FOR ANY OTHER PROJECT IS PROHIBITED. ANY ALTERATION OR REPRODUCTION OF THIS DOCUMENT IS ALSO PROHIBITED WITHOUT THE WRITTEN CONSENT OF THE ARCHITECT OR ENGINEER.

**BBS**  
ARCHITECTS  
LANDSCAPE ARCHITECTS  
ENGINEERS

BRANCH PROJECT CONTACT  
187 WOLF ROAD, STE. 205  
ALBANY  
NEW YORK 12205  
T: 518.621.7650

244 EAST MAIN STREET  
PATCHOGUE  
NEW YORK 11772  
T: 631.475.0349  
F: 631.475.0361

www.bbsarchitecture.com

SER. NO. 66-14-02-02-0-004-023

DISTRICT BRIARCLIFF MANOR U.F.S.D.

PROJECT PHASE 2 BOND IMPROVEMENTS

DWG. TITLE PARTIAL FIRST FL POWER PLAN - AREA A & C

SCALE: AS NOTED


DATE: 07/07/22

BID PAU DATE:

FILE NO. 21-274C

E4.01 HSMS



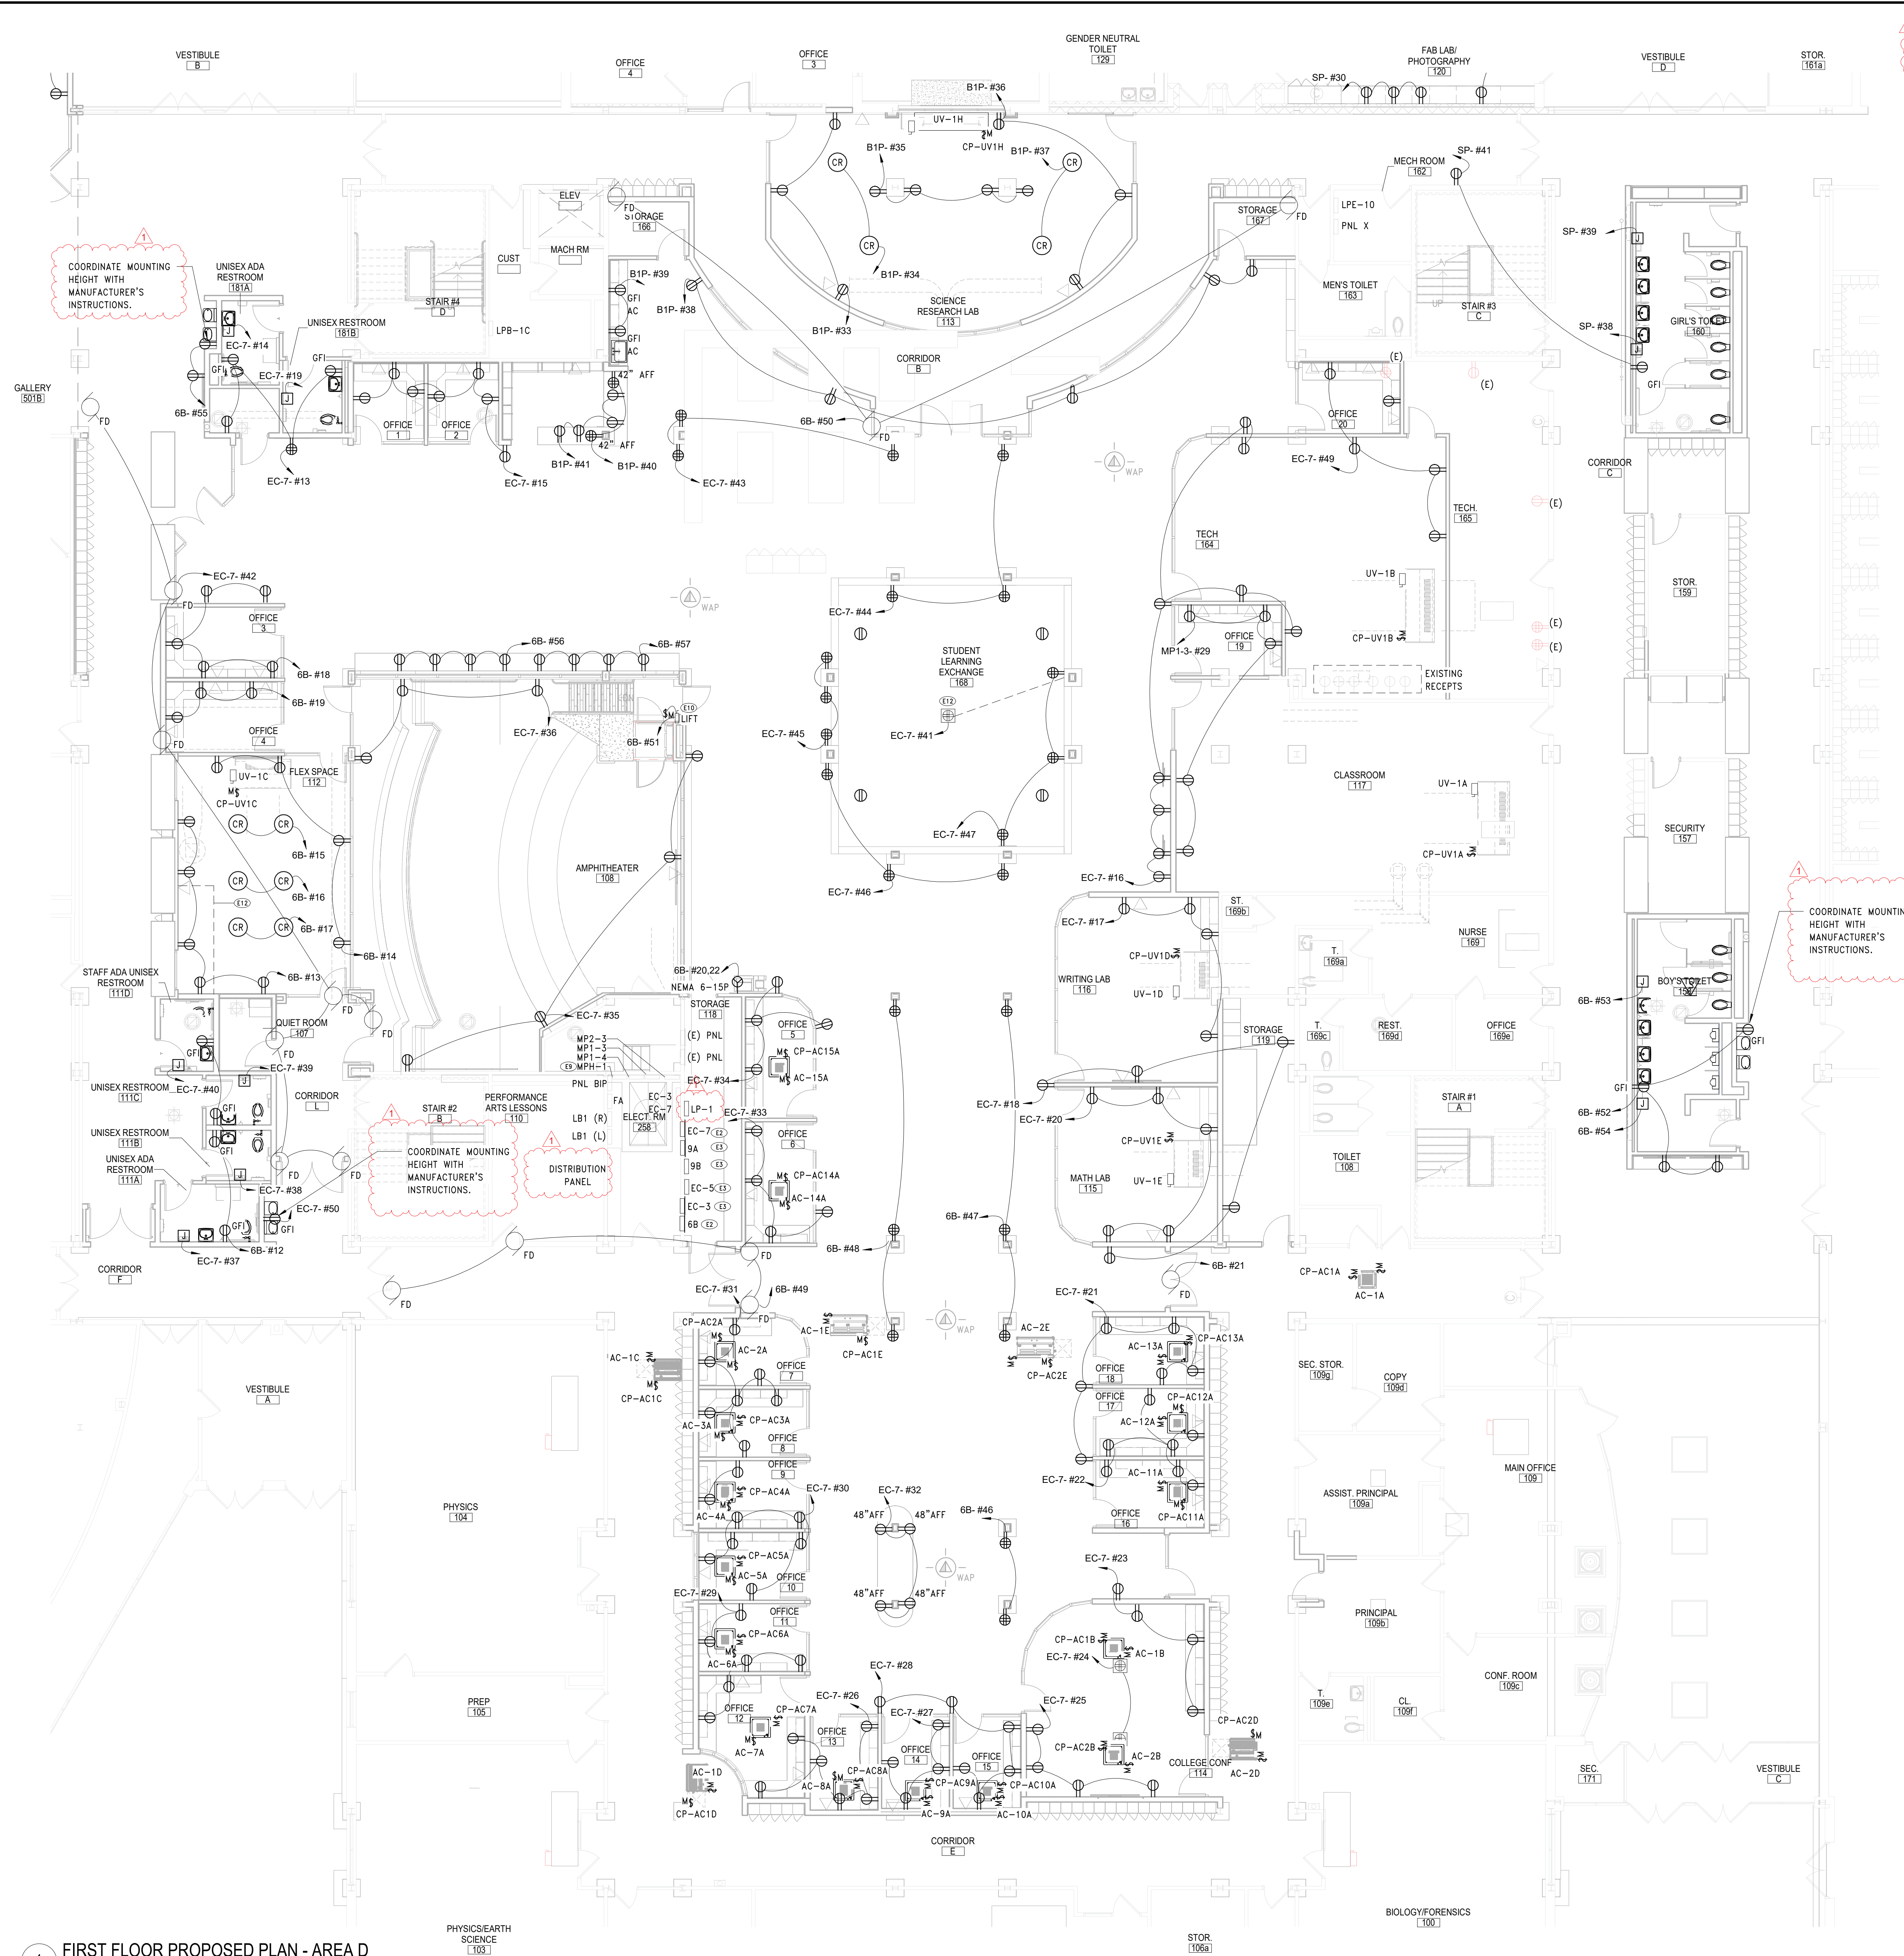

**POWER SHEET NOTES**

- A. COORDINATE LOCATION OF CORD REELS WITH GC PRIOR TO CEILING INSTALLATION.
- B. FIELD COORDINATE ROUTING OF ALL FEEDERS AND BRANCH CIRCUITS.
- C. ALL PENETRATIONS THROUGH FIRE RATED WALLS AND FLOORS SHALL BE PROPERLY FIRE-STOPPED.
- D. REFER TO EQUIPMENT SCHEDULE ON DRAWING E10.01 FOR MECHANICAL EQUIPMENT ELECTRICAL REQUIREMENTS.
- E. ALL DEVICES SHALL BE RECESSED IN WALL. CONTACT ENGINEER AND ARCHITECT TO COORDINATE ANY AREAS WHERE EXISTING WALLS ARE SHOWN WITH NEW DEVICES.

**KEY NOTES**

- E2 PROVIDE REPLACEMENT PANEL IN SAME LOCATION AS REMOVED PANEL. CONNECT EXISTING MAIN POWER FEEDERS AND BRANCH CIRCUITS TO PROPOSED PANEL. REFER TO PANELBOARD DIRECTORY FOR PANEL'S CHARACTERISTICS.
- E3 ADD ALTERNATE: PROVIDE REPLACEMENT PANEL IN SAME LOCATION AS REMOVED PANEL. CONNECT EXISTING MAIN POWER FEEDERS AND BRANCH CIRCUITS TO PROPOSED PANEL. FIELD VERIFY EXACT CIRCUIT BREAKER AMP RATING OF EACH BREAKER IN PANEL PRIOR TO PURCHASE. BREAKERS POLE SIZES WERE VERIFIED WITH FIELD OBSERVATION HOWEVER BREAKERS AMP RATING WAS NOT LEGIBLE IN ALL.
- E9 UTILIZE SPARE BREAKER SPACES PREVIOUSLY FEEDING REMOVED UNIT FOR PROPOSED UNITS TO BE PROVIDED IN THIS PHASE. REFER TO PANEL BOARD DIRECTORY AND ELECTRICAL EQUIPMENT SCHEDULE FOR BREAKER AND CIRCUIT INFORMATION.
- E10 PROVIDE 20A, 120V-1PH CIRCUIT THROUGH FUSED DISCONNECT WITH AN AUXILIARY CONTACT ON THE MAIN POWER SUPPLY OF THE LIFT. FIELD COORDINATE EXACT DISCONNECT MOUNTING LOCATION PRIOR TO INSTALLATION.
- E12 COORDINATE WITH GC FOR ROUTING OF POWER BELOW SLAB FOR FLOOR RECEPTACLE.

REV.	DATE	ITEM
1	11/23/22	BID ADDENDUM #1

**NOTICE**

THESE DRAWINGS ARE BASED ON CONSTRUCTION DRAWINGS NOT PREPARED BY BBS ARCHITECTS, LANDSCAPE ARCHITECTS AND ENGINEERS, P.C. AND THEREFORE, MAY NOT REPRESENT THE CONDITIONS AS CONSTRUCTED AT THE TIME. ALL EXISTING CONDITIONS SHOWN ARE REPRESENTED AS SUGGESTIVE INFORMATION AS THEY MAY NOT HAVE BEEN BUILT AND SHOULD BE THE ORIGINAL DOCUMENTS OF THE OWNER'S INFORMATION.

**KEY PLAN**

NO SCALE

**PROJECT**

BRIARCLIFF MANOR U.F.S.D.  
PHASE 2 BOND IMPROVEMENTS  
BRIARCLIFF MANOR MIDDLE / HIGH SCHOOL  
444 PLEASANTVILLE RD. BRIARCLIFF MANOR, NY 10510

**DWG TITLE**

PARTIAL FIRST FL POWER PLAN - AREA D

**DRWG. BY:** EEA  
**CHK. BY:** AG

THIS DRAWING, PREPARED FOR THE SPECIFIC PROJECT INDICATED IS AN INSTRUMENT OF SERVICE AND THE PROPERTY OF BBS ARCHITECTS, LANDSCAPE ARCHITECTS AND ENGINEERS, P.C. REPRISAL OR ANY USE OF THIS DRAWING FOR ANY OTHER PROJECT IS PROHIBITED. ANY ALTERATION OR REPRODUCTION OF THIS DOCUMENT IS ALSO PROHIBITED WITHOUT THE WRITTEN CONSENT OF THE ARCHITECT OR ENGINEER.

**BBS**  
ARCHITECTS  
LANDSCAPE ARCHITECTS  
ENGINEERS


BRANCH PROJECT CONTACT: 187 WOLF ROAD, STE. 205 ALBANY, NEW YORK 12205 T. 518.621.7650  
244 EAST MAIN STREET PATCHOGUE, NEW YORK 11772 T. 631.475.0349 T. 631.475.0361  
www.bbsarchitecture.com

**SED. NO.** 66-14-02-02-0-004-023  
**DISTRICT** BRIARCLIFF MANOR U.F.S.D.  
**PROJECT** PHASE 2 BOND IMPROVEMENTS  
**DWG TITLE** PARTIAL FIRST FL POWER PLAN - AREA D  
**SCALE:** AS NOTED  
**DATE:** 07/07/22  
**BID PAU DATE:**  
**FILE NO.** 21-274C


**E4.02** **HSMS**

1 FIRST FLOOR PROPOSED PLAN - AREA D  
SCALE: 1/8" = 1'-0"







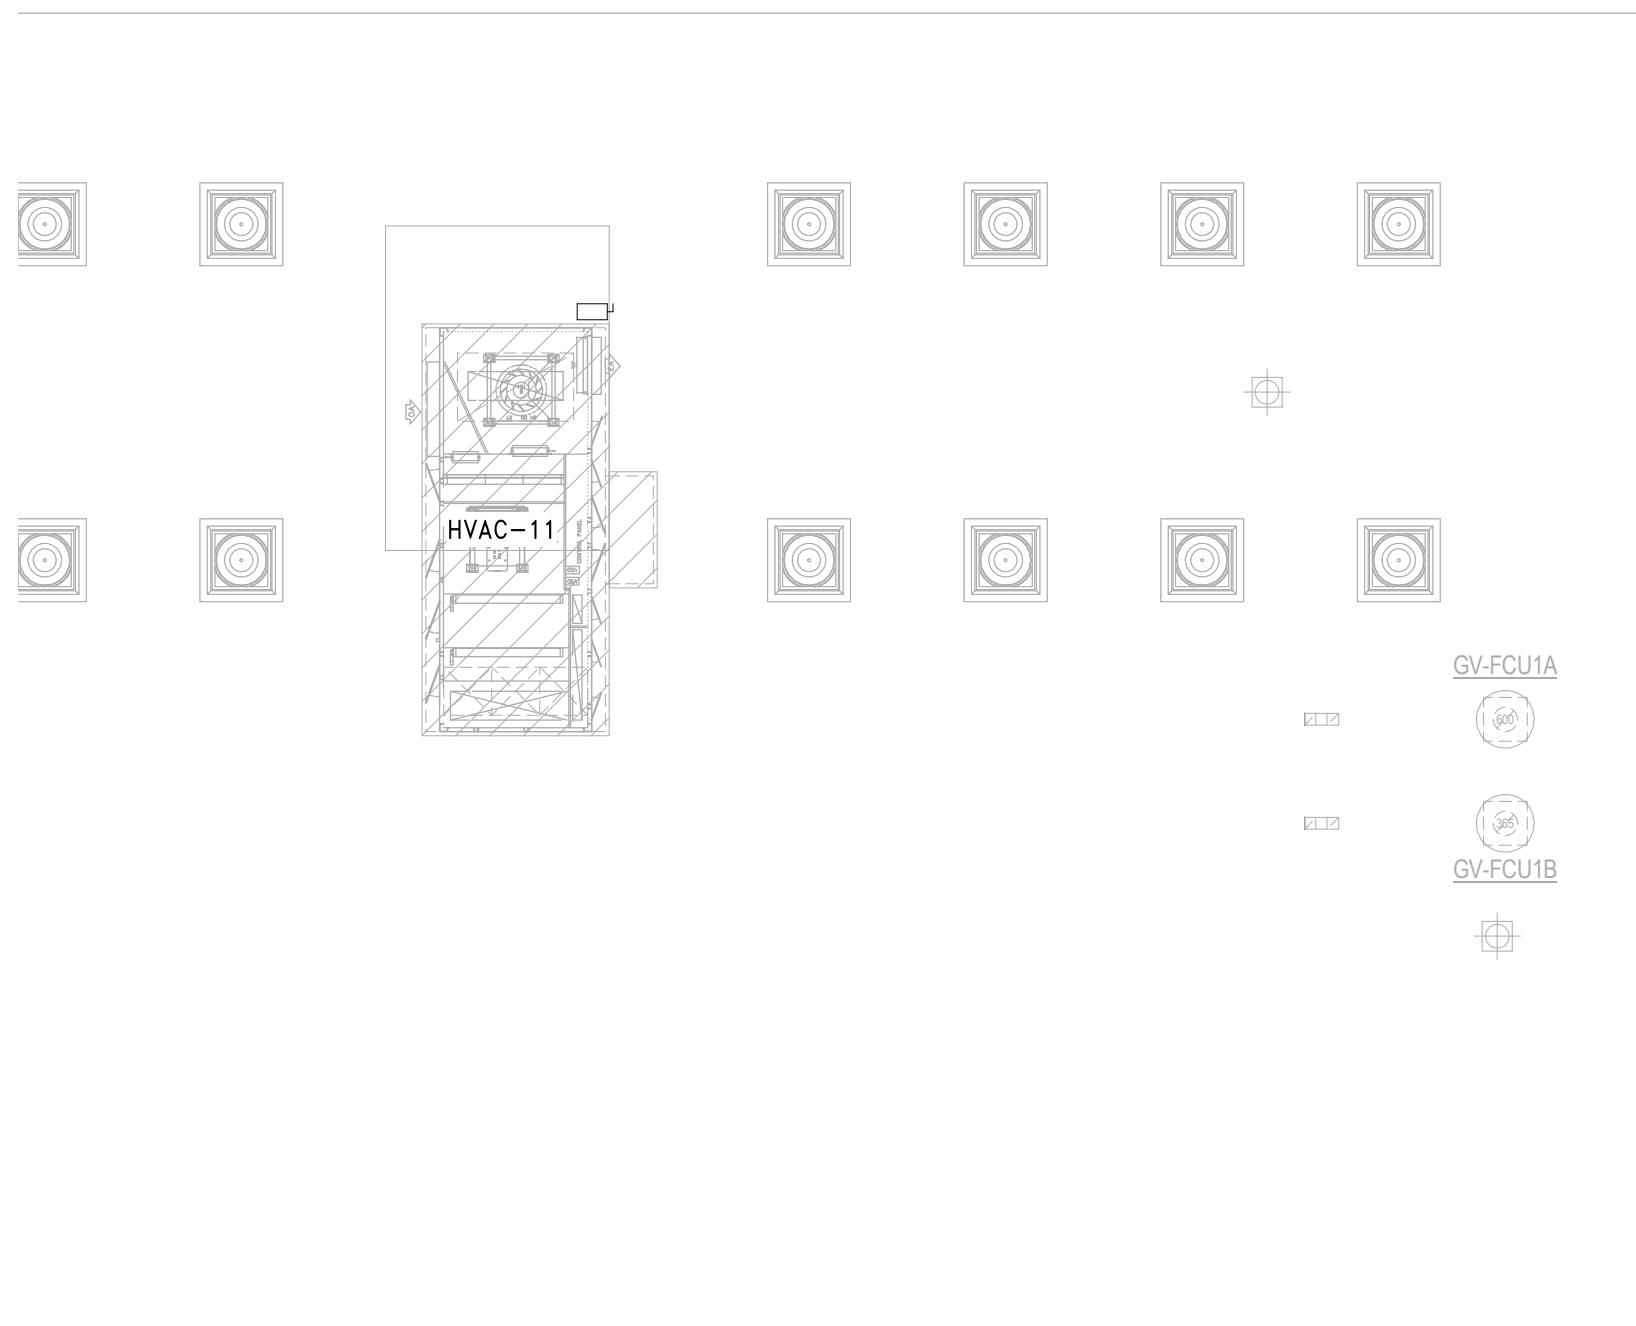

2 PARTIAL ROOF PLAN - AREA A & C  
SCALE: 1/8" = 1'-0"

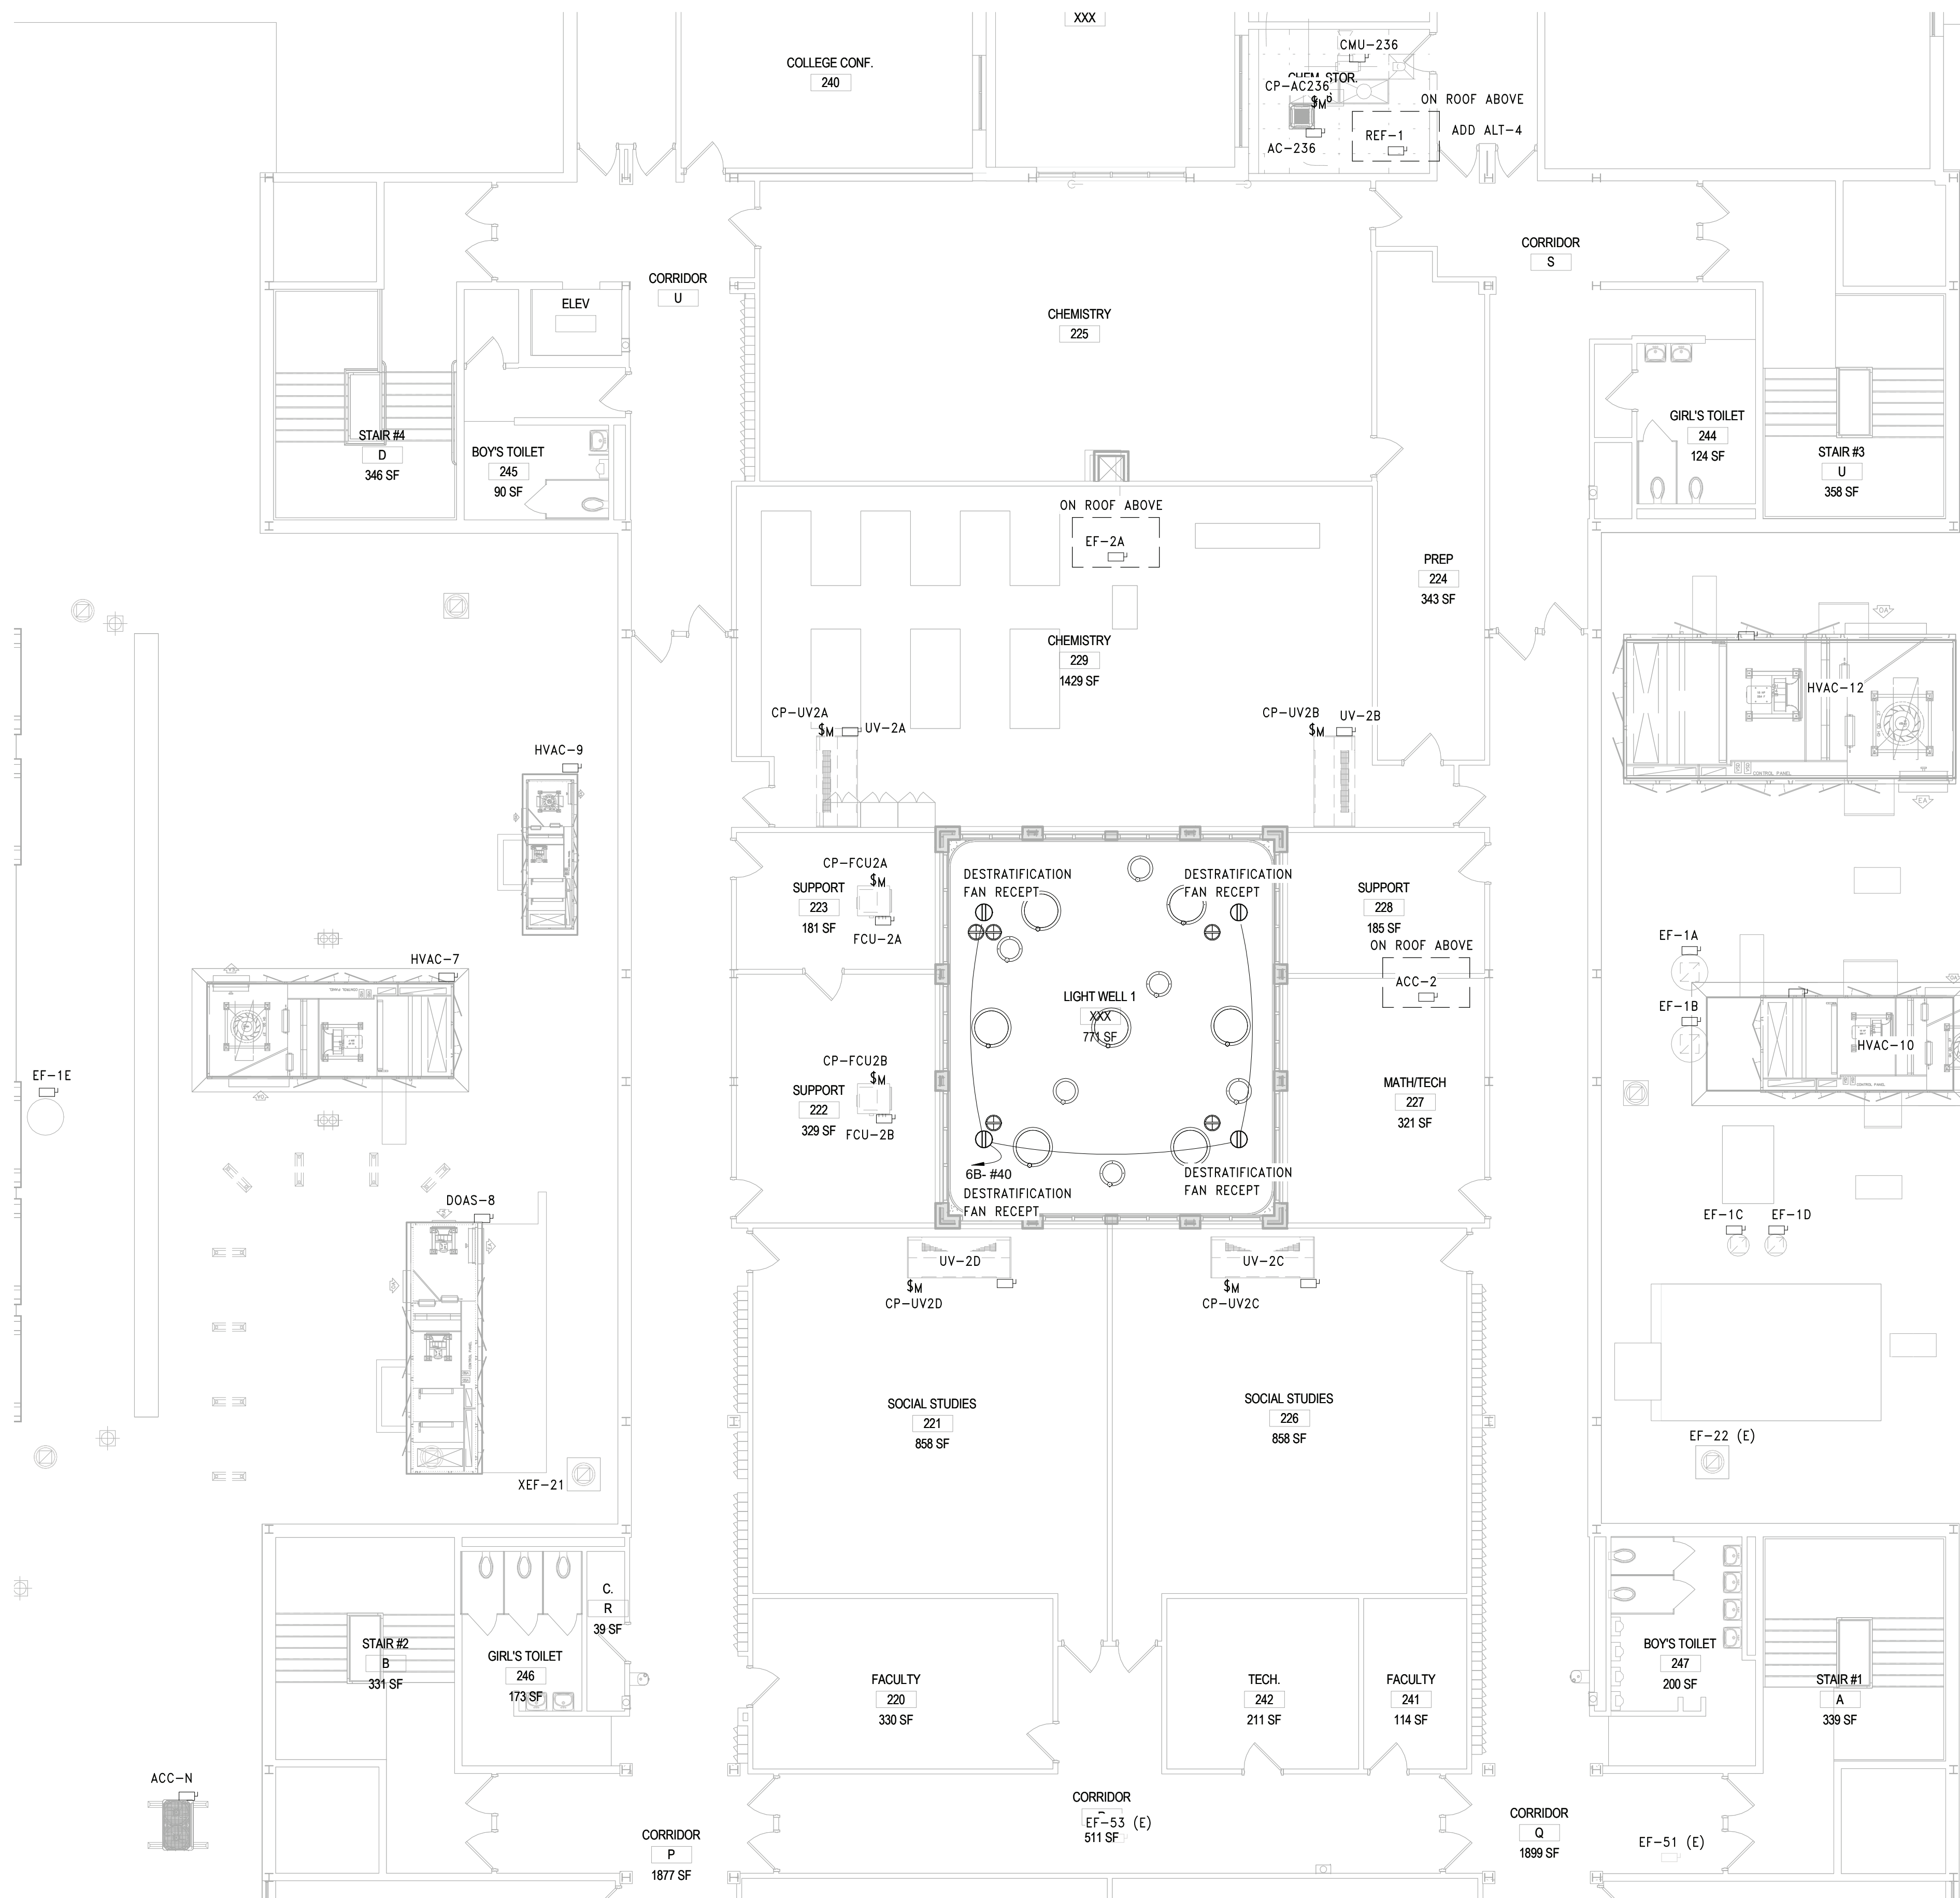

  1 NEW WORK PLAN - SECOND FLOOR AREA D  
SCALE: 1/8" = 1'-0"

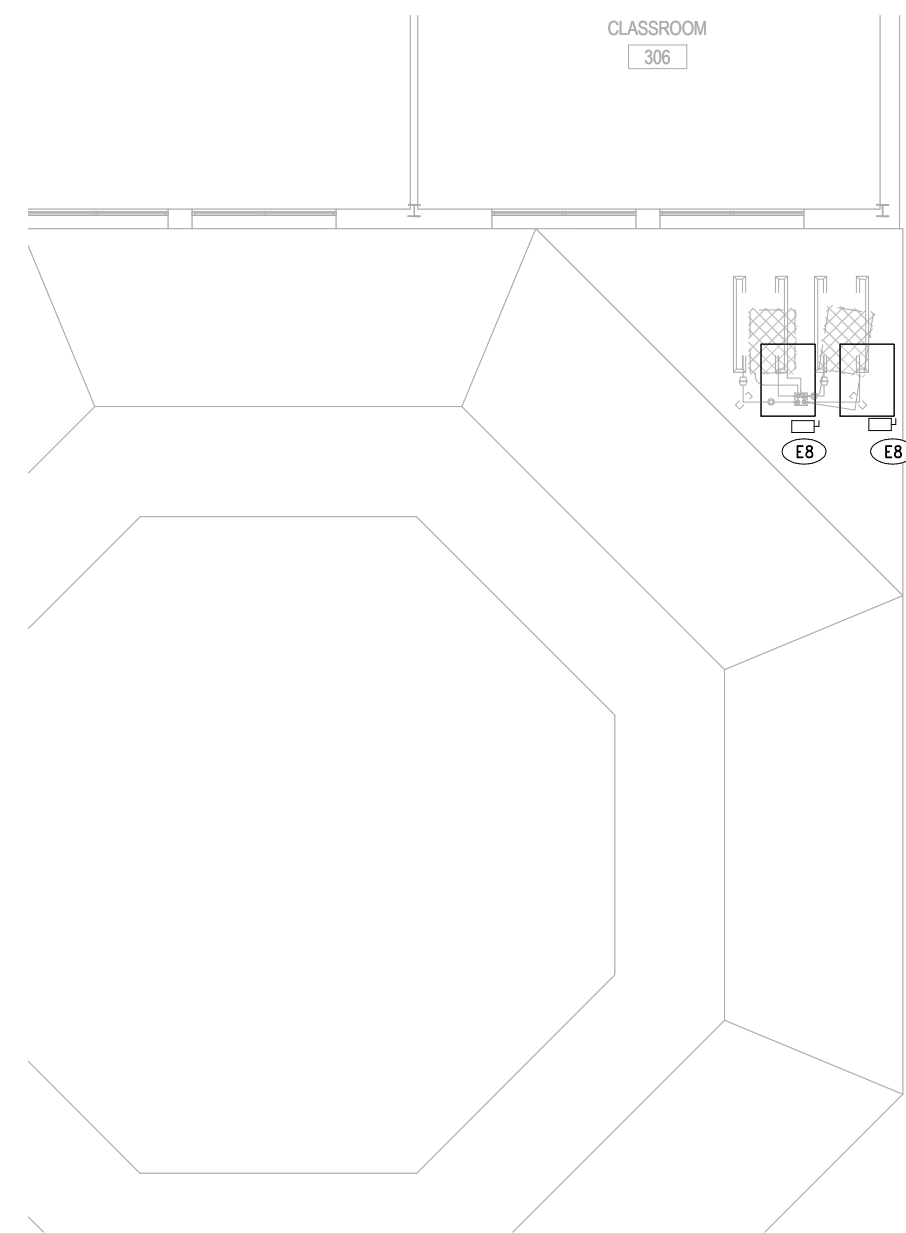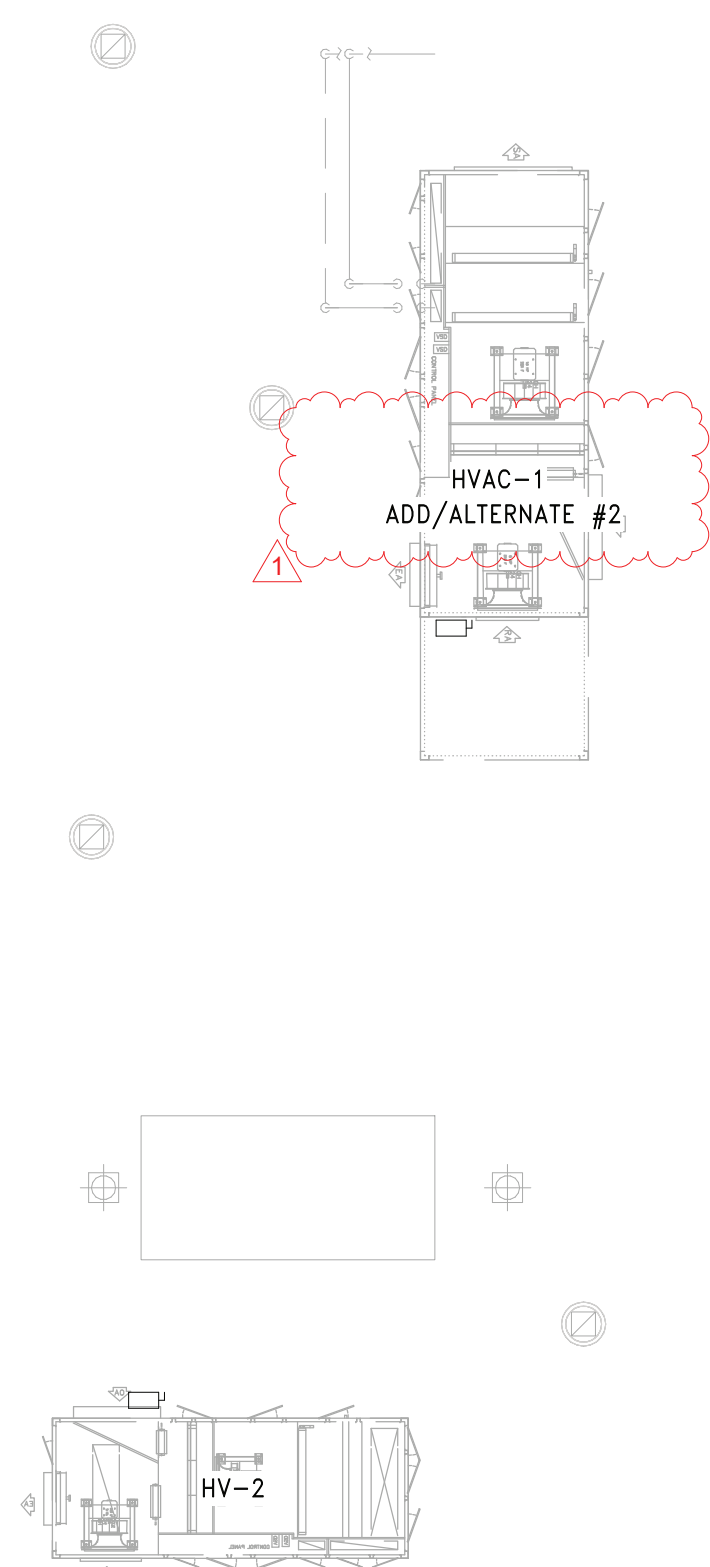

3 NEW WORK PLAN - SECOND FLOOR AREA H  
SCALE: 3/32" = 1'-0"

POWER SHEET NOTES	
A.	COORDINATE LOCATION OF CORD REELS WITH GC PRIOR TO CEILING INSTALLATION.
B.	FIELD COORDINATE ROUTING OF ALL FEEDERS AND BRANCH CIRCUITS.
C.	ALL PENETRATIONS THROUGH FIRE RATED WALLS AND FLOORS SHALL BE PROPERLY FIRE-STOPPED.
D.	REFER TO EQUIPMENT SCHEDULE ON DRAWING E10.01 FOR MECHANICAL EQUIPMENT ELECTRICAL REQUIREMENTS.
E.	ALL DEVICES SHALL BE RECESSED IN WALL. CONTACT ENGINEER AND ARCHITECT TO COORDINATE ANY AREAS WHERE EXISTING WALLS ARE SHOWN WITH NEW DEVICES.
KEY NOTES	
E8	RECONNECT EXISTING DISCONNECT FOR RELOCATED OUTDOOR CONDENSING UNITS. EXTEND CABLES AS NECESSARY MATCHING EXISTING SIZE AND TYPE. COORDINATE WITH MC FOR EXACT UNIT LOCATION.

REV.	DATE	ITEM
1	11/23/22	BID ADDENDUM #1

**NOTICE**  
THESE DRAWINGS ARE BASED ON CONSTRUCTION DRAWINGS NOT PREPARED BY BBS ARCHITECTS, LANDSCAPE ARCHITECTS AND ENGINEERS, P.C. AND THEREFORE, MAY NOT REPRESENT THE CONDITIONS AS CONSTRUCTED AT THE TIME. ALL EXISTING CONDITIONS SHOWN ARE REPRESENTED AS SUGGESTIVE INFORMATION AS THEY MAY NOT HAVE BEEN BUILT AND SHOULD BE THE ORIGINAL DOCUMENTS OR FOR THE OWNER'S INFORMATION.

**ORIGINAL DOCUMENTS**

**KEY PLAN**  
NO SCALE

**PROJECT**  
BRIARCLIFF MANOR U.F.S.D.  
PHASE 2 BOND IMPROVEMENTS  
BRIARCLIFF MANOR MIDDLE / HIGH SCHOOL  
444 PLEASANTVILLE RD. BRIARCLIFF MANOR, NY 10510

**DWG TITLE**  
PARTIAL SECOND FLOOR & ROOF PLAN - AREA D & E

**DRWG. BY:** EEA  
**CHK. BY:** AG

THIS DRAWING, PREPARED FOR THE SPECIFIC PROJECT INDICATED IS AN INSTRUMENT OF SERVICE AND THE PROPERTY OF BBS ARCHITECTS, LANDSCAPE ARCHITECTS AND ENGINEERS, P.C. REPRODUCTION OR ANY USE OF THIS DRAWING FOR ANY OTHER PROJECT IS PROHIBITED. ANY ALTERATION OR REPRODUCTION OF THIS DOCUMENT IS ALSO PROHIBITED WITHOUT THE WRITTEN CONSENT OF THE ARCHITECT OR ENGINEER.

**BBS**  
ARCHITECTS  
LANDSCAPE ARCHITECTS  
ENGINEERS  
244 EAST MAIN STREET  
PATCHOGUE  
NEW YORK 11772  
T: 631.475.0349  
F: 631.475.0361  
www.BBSARCHITECTURE.COM

187 WOLF ROAD, STE. 205  
ALBANY  
NEW YORK 12205  
T: 518.621.7650  
F: 518.621.7655

<b>SER. NO.</b> 66-14-02-02-0-004-023
<b>DISTRICT</b> BRIARCLIFF MANOR U.F.S.D.
<b>PROJECT</b> PHASE 2 CAPITAL BOND IMPROVEMENTS
<b>DWG. TITLE</b> PARTIAL SECOND FLOOR & ROOF PLAN - AREA D & E
<b>SCALE:</b> As indicated
<b>DATE:</b> 07/07/22
<b>BID PAU DATE:</b>
<b>FILE NO.</b> 21-274C

**E4.03** **HSMS**





2 PARTIAL FIRST FLOOR PROPOSED SYSTEMS PLANS - AREA A  
SCALE: 1/8" = 1'-0"



1 PARTIAL FIRST FLOOR PROPOSED SYSTEMS PLANS - AREA C  
SCALE: 1/8" = 1'-0"

SYSTEMS SHEET NOTES	
A.	CONNECT ALL PROPOSED FIRE ALARM DEVICES TO EXISTING FIRE ALARM CONTROL PANEL. PANEL IS AN EDWARDS IO ADDRESSABLE PANEL LOCATED OUTSIDE OF BOILER ROOM 510.
B.	REFER TO DRAWING E10.03 FOR TECHNOLOGY DETAILS.
C.	PROVIDE FIRE ALARM RELAY AND CONNECTION FROM FIRE DAMPERS TO FIRE ALARM CONTROL PANEL.
D.	ALL DEVICES WITH 'ER' DESIGNATION SHALL BE EXISTING TO BE RELOCATED OR RE-INSTALLED AFTER CEILING INSTALLATION HAS BEEN COMPLETED. RE-INSTALL DEVICES IN PROPOSED LOCATION AND RECONNECT TO ASSOCIATED WIRING.
E.	ALL DEVICES SHALL BE RECESSED IN WALL. CONTACT ENGINEER AND ARCHITECT TO COORDINATE ANY AREAS WHERE EXISTING WALLS ARE SHOWN WITH NEW DEVICES.
F.	MDF ROOM LOCATED IN SECOND FLOOR TECH ROOM 242 (AREA D).
G.	ALL IT AND SECURITY CABLES SHALL BE COLOR CODED AS FOLLOWS: A. DATA - BLUE B. WIRELESS ACCESS POINTS - GREEN C. CAMERAS - PURPLE D. DOORS - YELLOW E. SECURITY - RED
KEY NOTES	
E7	PROVIDE FIRE ALARM CONNECTION TO FIRE SMOKE DAMPERS.
E11	PROVIDE EDWARDS FIRE ALARM AUDIO NOTIFICATION SYSTEM PANEL AND CONNECT TO EXISTING FACP. NOTIFICATION PANEL SHALL PROVIDE EXISTING SYSTEM WITH SPEAKER/SPEAKER-STROBE CONNECTIONS FOR DEVICES IN RENOVATED AREA D.

REV.	DATE	ITEM
1	11/23/22	BID ADDENDUM #1

**NOTICE**

THESE DRAWINGS ARE BASED ON CONSTRUCTION DOCUMENTS PREPARED BY BBS ARCHITECTS, LANDSCAPE ARCHITECTS AND ENGINEERS, P.C. AND THEREFORE, MAY NOT REPRESENT THE CONDITIONS AS CONSTRUCTED AT THE TIME. ALL EXISTING CONDITIONS SHOWN ARE REPRESENTED AS SUGGESTIVE INFORMATION AS THEY MAY NOT HAVE BEEN BUILT AND SHOULD BE THE ORIGINAL DOCUMENTS OF THE OWNER'S INFORMATION.

**KEY PLAN**

NO SCALE

**PROJECT**

BRIARCLIFF MANOR U.F.S.D.  
PHASE 2 BOND IMPROVEMENTS  
BRIARCLIFF MANOR MIDDLE / HIGH SCHOOL  
444 PLEASANTVILLE RD. BRIARCLIFF MANOR, NY 10510

**DWG TITLE**

PARTIAL FIRST FL SYSTEMS PLAN - AREA A & C

**DRWG. BY:** EEA  
**CHK. BY:** AG

THIS DRAWING, PREPARED FOR THE SPECIFIC PROJECT INDICATED IS AN INSTRUMENT OF SERVICE AND THE PROPERTY OF BBS ARCHITECTS, LANDSCAPE ARCHITECTS AND ENGINEERS, P.C. REPRODUCTION OR ANY USE OF THIS DRAWING FOR ANY OTHER PROJECT IS PROHIBITED. ANY ALTERATION OR REPRODUCTION OF THIS DOCUMENT IS ALSO PROHIBITED WITHOUT THE WRITTEN CONSENT OF THE ARCHITECT OR ENGINEER.

**BBS**  
ARCHITECTS  
LANDSCAPE ARCHITECTS  
ENGINEERS

BRANCH PROJECT CONTACT  
187 WOLF ROAD, STE. 205  
ALBANY  
NEW YORK 12205  
T: 518.621.7650

244 EAST MAIN STREET  
PATCHOGUE  
NEW YORK 11772  
T: 631.475.0349  
T: 631.475.0361

www.bbsarchitecture.com

**SER. NO.** 66-14-02-02-0-004-023

**DISTRICT** BRIARCLIFF MANOR U.F.S.D.

**PROJECT** PHASE 2 BOND IMPROVEMENTS

**DWG TITLE** PARTIAL FIRST FL SYSTEMS PLAN - AREA A & C

**SCALE:** AS NOTED  
**DATE:** 07/07/22  
**BID PAU DATE:**  
**FILE NO.** 21-274C

**E5.01** **HSMS**





1 PARTIAL FIRST FLOOR PROPOSED SYSTEMS PLANS - AREA D  
SCALE: 1/8" = 1'-0"

SYSTEMS SHEET NOTES

A. CONNECT ALL PROPOSED FIRE ALARM DEVICES TO EXISTING FIRE ALARM CONTROL PANEL. PANEL IS AN EDWARDS IO ADDRESSABLE PANEL LOCATED OUTSIDE OF BOILER ROOM 510.

B. REFER TO DRAWING E10.03 FOR TECHNOLOGY DETAILS.

C. PROVIDE FIRE ALARM RELAY AND CONNECTION FROM FIRE DAMPERS TO FIRE ALARM CONTROL PANEL.

D. ALL DEVICES WITH 'ER' DESIGNATION SHALL BE EXISTING TO BE RELOCATED OR RE-INSTALLED AFTER CEILING INSTALLATION HAS BEEN COMPLETED. RE-INSTALL DEVICES IN PROPOSED LOCATION AND RECONNECT TO ASSOCIATED WIRING.

E. ALL DEVICES SHALL BE RECESSED IN WALL. CONTACT ENGINEER AND ARCHITECT TO COORDINATE ANY AREAS WHERE EXISTING WALLS ARE SHOWN WITH NEW DEVICES.

F. MDF ROOM LOCATED IN SECOND FLOOR TECH ROOM 242 (AREA D).

G. ALL IT AND SECURITY CABLES SHALL BE COLOR CODED AS FOLLOWS:  
A. DATA - BLUE  
B. WIRELESS ACCESS POINTS - GREEN  
C. CAMERAS - PURPLE  
D. DOORS - YELLOW  
E. SECURITY - RED

KEY NOTES

E7 PROVIDE FIRE ALARM CONNECTION TO FIRE SMOKE DAMPERS.

REV.	DATE	ITEM
1	11/23/22	BID ADDENDUM #1

NOTICE

THESE DRAWINGS ARE BASED ON CONSTRUCTION DOCUMENTS PREPARED BY BBS ARCHITECTS, LANDSCAPE ARCHITECTS AND ENGINEERS, P.C. AND THEREFORE, THEY MAY NOT REPRESENT THE CONDITIONS AS CONSTRUCTED AT THE TIME. ALL EXISTING CONDITIONS SHOWN ARE REPRESENTED AS SUGGESTIVE INFORMATION AS THEY MAY NOT HAVE BEEN BUILT AND SHOULD BE THE ORIGINAL DOCUMENTS OF THE OWNER'S INFORMATION.

KEY PLAN

NO SCALE

PROJECT

BRIARCLIFF MANOR U.F.S.D.  
PHASE 2 BOND IMPROVEMENTS  
BRIARCLIFF MANOR MIDDLE / HIGH SCHOOL  
444 PLEASANTVILLE RD. BRIARCLIFF MANOR, NY 10510

DWG TITLE

PARTIAL FIRST FL SYSTEMS PLAN - AREA D

DRWG. BY:

EEA

CHK. BY:

AG

THIS DRAWING, PREPARED FOR THE SPECIFIC PROJECT INDICATED IS AN INSTRUMENT OF SERVICE AND THE PROPERTY OF BBS ARCHITECTS, LANDSCAPE ARCHITECTS AND ENGINEERS, P.C. REPRODUCTION OR ANY USE OF THIS DRAWING FOR ANY OTHER PROJECT IS PROHIBITED. ANY ALTERATION OR REPRODUCTION OF THIS DOCUMENT IS ALSO PROHIBITED WITHOUT THE WRITTEN CONSENT OF THE ARCHITECT OR ENGINEER.

BBS

ARCHITECTS  
LANDSCAPE ARCHITECTS  
ENGINEERS

BRANCH PROJECT CONTACT  
187 WOLF ROAD, STE. 205  
ALBANY  
NEW YORK 12205  
T: 518.621.7650

244 EAST MAIN STREET  
PATCHOQUE  
NEW YORK 11772  
T: 631.475.0349  
T: 631.475.0361

www.bbsarchitecture.com

SED. NO.

66-14-02-02-0-004-023

DISTRICT

BRIARCLIFF MANOR U.F.S.D.

PROJECT

PHASE 2 BOND IMPROVEMENTS

DWG TITLE

PARTIAL FIRST FL SYSTEMS PLAN - AREA D

SCALE:

AS NOTED

DATE:

07/07/22

BID PAU DATE:

FILE NO.

21-274C

E5.02

HSMS



POWER SHEET NOTES

A. COORDINATE LOCATION OF CORD REELS WITH GC PRIOR TO CEILING INSTALLATION.

B. FIELD COORDINATE ROUTING OF ALL FEEDERS AND BRANCH CIRCUITS.

C. ALL PENETRATIONS THROUGH FIRE RATED WALLS AND FLOORS SHALL BE PROPERLY FIRE-STOPPED.

D. REFER TO EQUIPMENT SCHEDULE ON DRAWING E10.01 FOR MECHANICAL EQUIPMENT ELECTRICAL REQUIREMENTS.

E. ALL DEVICES SHALL BE RECESSED IN WALL. CONTACT ENGINEER AND ARCHITECT TO COORDINATE ANY AREAS WHERE EXISTING WALLS ARE SHOWN WITH NEW DEVICES.

LIGHTING SHEET NOTES

A. FIELD COORDINATE ROUTING OF ALL FEEDERS AND BRANCH CIRCUITS.

B. ALL PENETRATIONS THROUGH FIRE RATED WALLS AND FLOORS SHALL BE PROPERLY FIRE-STOPPED.

C. REFER TO LIGHTING FIXTURE SCHEDULE ON DWG E601.

D. ALL PROPOSED EMERGENCY EXIT LIGHTING SHALL BE CONNECT TO LOCAL LIGHTING CIRCUIT AHEAD OF ALL SWITCHING DEVICES. UTILIZE (2) #12, #12G, IN 3/4" EMT CONDUIT. EMERGENCY LIGHTING SHALL REMAIN ON AS NIGHT LIGHTS.

SYSTEMS SHEET NOTES

A. CONNECT ALL PROPOSED FIRE ALARM DEVICES TO EXISTING FIRE ALARM CONTROL PANEL. PANEL IS AN EDWARDS IO ADDRESSABLE PANEL LOCATED OUTSIDE OF BOILER ROOM 510.

B. REFER TO DRAWING E10.03 FOR TECHNOLOGY DETAILS.

C. PROVIDE FIRE ALARM RELAY AND CONNECTION FROM FIRE DAMPERS TO FIRE ALARM CONTROL PANEL.

D. ALL DEVICES WITH 'ER' DESIGNATION SHALL BE EXISTING TO BE RELOCATED OR RE-INSTALLED AFTER CEILING INSTALLATION HAS BEEN COMPLETED. RE-INSTALL DEVICES IN PROPOSED LOCATION AND RECONNECT TO ASSOCIATED WIRING.

E. ALL DEVICES SHALL BE RECESSED IN WALL. CONTACT ENGINEER AND ARCHITECT TO COORDINATE ANY AREAS WHERE EXISTING WALLS ARE SHOWN WITH NEW DEVICES.

F. MDF ROOM LOCATED IN SECOND FLOOR TECH ROOM 242 (AREA D).

G. ALL IT AND SECURITY CABLES SHALL BE COLOR CODED AS FOLLOWS:

A. DATA – BLUE

B. WIRELESS ACCESS POINTS – GREEN

C. CAMERAS – PURPLE

D. DOORS – YELLOW

E. SECURITY – RED

REV. DATE ITEM

11/23/22BID ADDENDUM #1

NOTICE

THESE DRAWINGS ARE BASED ON CONSTRUCTION DRAWINGS NOT PREPARED BY BBS ARCHITECTS, LANDSCAPE ARCHITECTS AND ENGINEERS, P.C. AND THEREFORE, MAY NOT REPRESENT THE CONDITIONS AS CONSTRUCTED AT THE TIME. ALL EXISTING CONDITIONS SHOWN ARE REPRESENTED AS SUGGESTIVE INFORMATION AS THEY MAY NOT HAVE BEEN BUILT AND DETAIL FOR THE ORIGINAL DOCUMENTS OR FOR THE OWNER'S INFORMATION.

EXISTING DOCUMENTS

KEY PLAN

NO SCALE

PROJECT

DWG TITLE

DRWG. BY: EEA

CHK. BY: AG

THIS DRAWING, PREPARED FOR THE SPECIFIC PROJECT INDICATED IS AN INSTRUMENT OF SERVICE AND THE PROPERTY OF BBS ARCHITECTS, LANDSCAPE ARCHITECTS AND ENGINEERS, P.C. REPRISAL OR REUSE OF ANY PART OF THIS DRAWING FOR ANY OTHER PROJECT IS PROHIBITED. ANY ALTERATION OR REPRODUCTION OF THIS DOCUMENT IS ALSO PROHIBITED WITHOUT THE WRITTEN CONSENT OF THE ARCHITECT OR ENGINEER.

BBS

ARCHITECTS

LANDSCAPE ARCHITECTS

ENGINEERS

244 EAST MAIN STREET  
PATCHOGUE  
NEW YORK 11772  
T: 631-475-0349  
F: 631-475-0361

187 WOLF ROAD, STE. 305  
ALBANY  
NEW YORK 12205  
T: 518-621-7650  
F: 518-621-7655

www.bbsarchitecture.com

SED. NO.

66-14-02-02-0-004-023

DISTRICT

BRIARCLIFF MANOR  
U.F.S.D.

PROJECT

PHASE 2 CAPITAL BOND  
IMPROVEMENTS

DWG TITLE

ELECTRICAL ADD-ALTERNATE  
PLANS

SCALE:

As indicated

DATE:

07/07/22

BID PAU DATE:

06/16/22

FILE NO.

21-274C

E5.03

HSMS

LIGHTING SEQUENCE OF OPERATION

SEQUENCE A

1. OCCUPANCY OR VACANCY SENSOR(S) FOR AUTO-OFF OF ALL FIXTURES AFTER 20 MIN. TIME DELAY

2. NO DAYLIGHT SENSOR(S) IN SPACE

3. NO FIXTURES LABELED AS 'EM'.

4. 3 BUTTON WALL STATION:

BUTTON 1: ON/OFF CONTROL OF GENERAL ILLUMINATION FIXTURES

BUTTON 2: DIM UP OF GENERAL ILLUMINATION FIXTURES\*\*

BUTTON 3: DIM DOWN OF GENERAL ILLUMINATION FIXTURES\*\*

SEQUENCE B

1. OCCUPANCY OR VACANCY SENSOR(S) FOR AUTO-OFF OF ALL FIXTURES AFTER 20 MIN. TIME DELAY

2. NO DAYLIGHT SENSOR(S) IN SPACE

3. WHERE APPLICABLE, U.O.N, UNSWITCHED CONTROL FOR ALL FIXTURES LABELED AS 'EM'. FIXTURES SHALL REMAIN ON AT ALL TIMES.

4. 3 BUTTON WALL STATION:

BUTTON 1: ON/OFF CONTROL OF GENERAL ILLUMINATION FIXTURES

BUTTON 2: DIM UP OF GENERAL ILLUMINATION FIXTURES\*\*

BUTTON 3: DIM DOWN OF GENERAL ILLUMINATION FIXTURES\*\*

SEQUENCE C

1. OCCUPANCY OR VACANCY SENSOR(S) FOR AUTO-OFF OF ALL FIXTURES AFTER 20 MIN. TIME DELAY

2. NO DAYLIGHT SENSOR(S) IN SPACE

3. WHERE APPLICABLE, U.O.N, UNSWITCHED CONTROL FOR ALL FIXTURES LABELED AS 'EM'. FIXTURES SHALL REMAIN ON AT ALL TIMES.

4. 9 BUTTON WALL STATION:

BUTTON 1: ON/OFF CONTROL OF TYPE 'A' ALL FIXTURES

BUTTON 2: DIM UP OF TYPE 'A' SWITCH LEG

BUTTON 3: DIM DOWN OF TYPE 'A' SWITCH LEG

BUTTON 4: DIM UP OF TYPE 'B' SWITCH LEG

BUTTON 5: DIM DOWN OF TYPE 'B' SWITCH LEG

BUTTON 6: DIM UP OF TYPE 'C' SWITCH LEG

BUTTON 7: DIM DOWN OF TYPE 'C' SWITCH LEG

BUTTON 8: DIM UP OF TYPE 'D' SWITCH LEG

BUTTON 9: DIM DOWN OF TYPE 'D' SWITCH LEG

SEQUENCE D

1. OCCUPANCY OR VACANCY SENSOR(S) FOR AUTO-OFF OF ALL FIXTURES AFTER 20 MIN. TIME DELAY

2. WHERE APPLICABLE, U.O.N, UNSWITCHED CONTROL FOR ALL FIXTURES LABELED AS 'EM'. FIXTURES SHALL REMAIN ON AT ALL TIMES.

3. 7 BUTTON WALL STATION:

BUTTON 1: ON/OFF CONTROL OF TYPE 'A' ALL FIXTURES

BUTTON 2: DIM UP OF TYPE 'A' SWITCH LEG

BUTTON 3: DIM DOWN OF TYPE 'A' SWITCH LEG

BUTTON 4: DIM UP OF TYPE 'B' SWITCH LEG

BUTTON 5: DIM DOWN OF TYPE 'B' SWITCH LEG

BUTTON 6: DIM UP OF TYPE 'C' SWITCH LEG

BUTTON 7: DIM DOWN OF TYPE 'C' SWITCH LEG

SEQUENCE E

1. OCCUPANCY OR VACANCY SENSOR(S) FOR AUTO-OFF OF ALL FIXTURES AFTER 20 MIN. TIME DELAY

2. NO DAYLIGHT SENSOR(S) IN SPACE

3. WHERE APPLICABLE, U.O.N, UNSWITCHED CONTROL FOR ALL FIXTURES LABELED AS 'EM'. FIXTURES SHALL REMAIN ON AT ALL TIMES.

4. SINGLE SWITCH FOR ON/OFF CONTROL OF ALL FIXTURES

5. BUTTON WALL STATION:

BUTTON 1: ON/OFF CONTROL OF GENERAL ILLUMINATION FIXTURES

BUTTON 2: DIM UP OF GENERAL ILLUMINATION FIXTURES\*\*

BUTTON 3: DIM DOWN OF GENERAL ILLUMINATION FIXTURES\*\*

SEQUENCE F

1. OCCUPANCY OR VACANCY SENSOR(S) FOR AUTO-OFF OF ALL FIXTURES AFTER 20 MIN. TIME DELAY

2. NO DAYLIGHT SENSOR(S) IN SPACE

3. WHERE APPLICABLE, U.O.N, UNSWITCHED CONTROL FOR ALL FIXTURES LABELED AS 'EM'. FIXTURES SHALL REMAIN ON AT ALL TIMES.

4. SINGLE SWITCH FOR ON/OFF CONTROL OF ALL FIXTURES

5. BUTTON WALL STATION:

BUTTON 1: ON/OFF CONTROL OF TYPE 'A' ALL FIXTURES

BUTTON 2: DIM UP OF TYPE 'A' SWITCH LEG\*\*


BUTTON 3: DIM DOWN OF TYPE 'A' SWITCH LEG\*\*

BUTTON 4: DIM UP OF TYPE 'B' SWITCH LEG\*\*


BUTTON 5: DIM DOWN OF TYPE 'B' SWITCH LEG\*\*

NOTES:


\*\* = DIMMING UP AND DOWN BUTTONS MAY BE SUBSTITUTED WITH DIMMING SLIDE TYPE SWITCH.

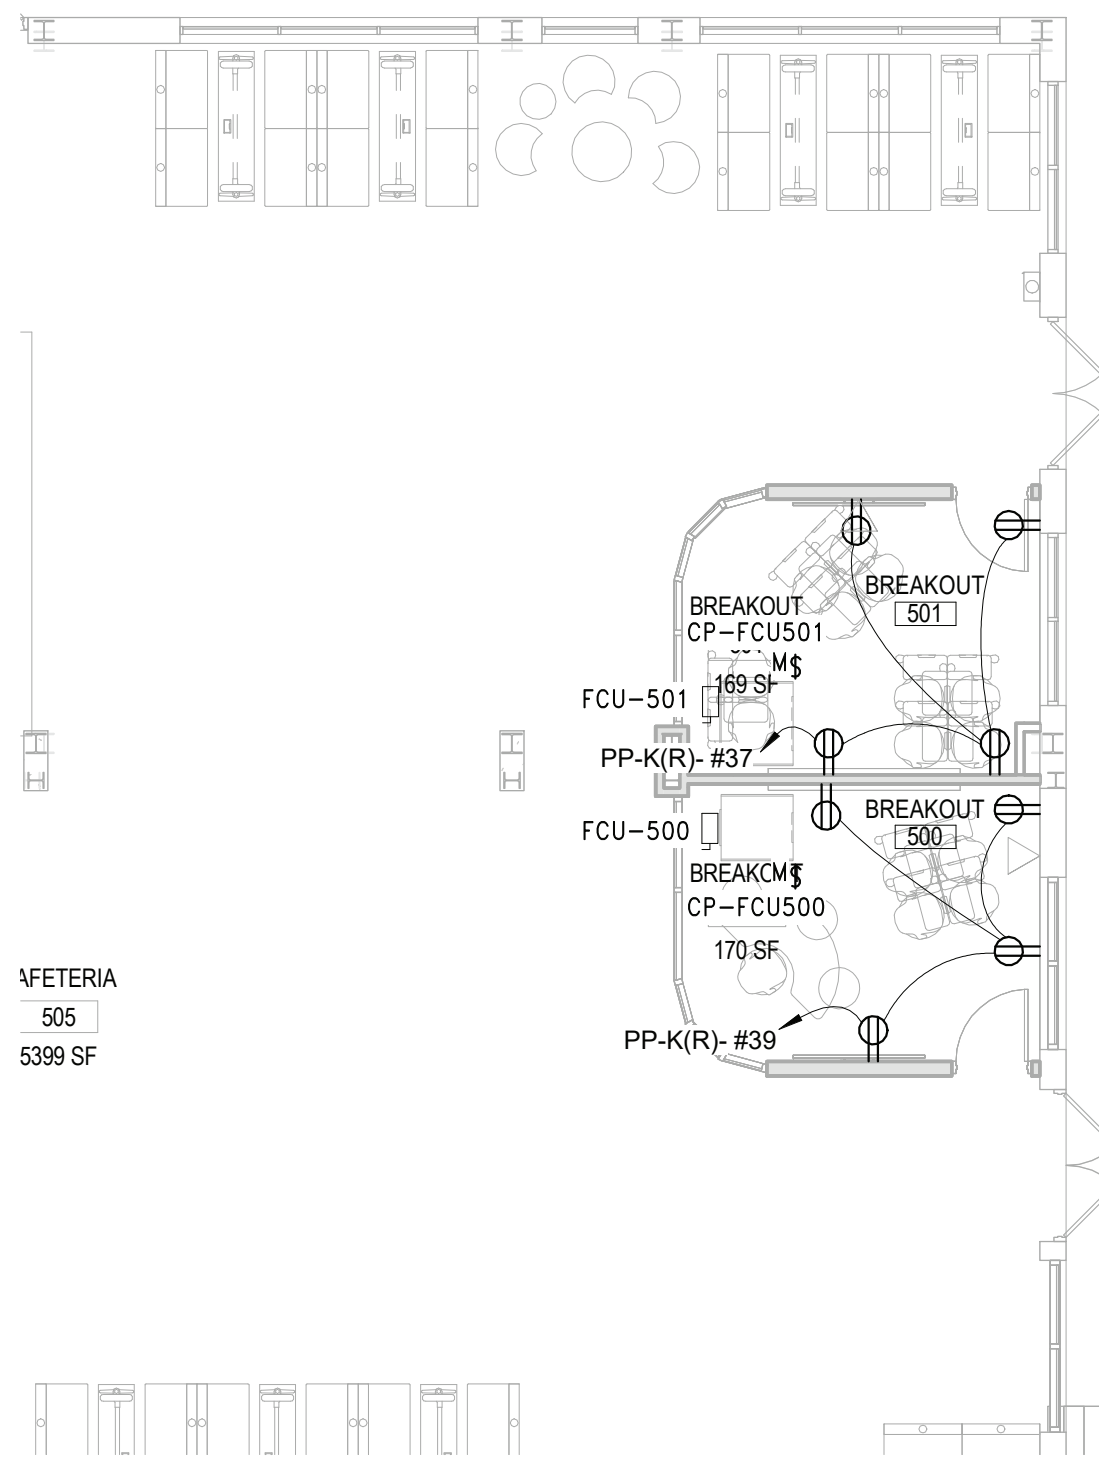

3 FIRST FLOOR PROPOSED PLAN - AREA A ADD ALT  
SCALE: 1/8" = 1'-0"

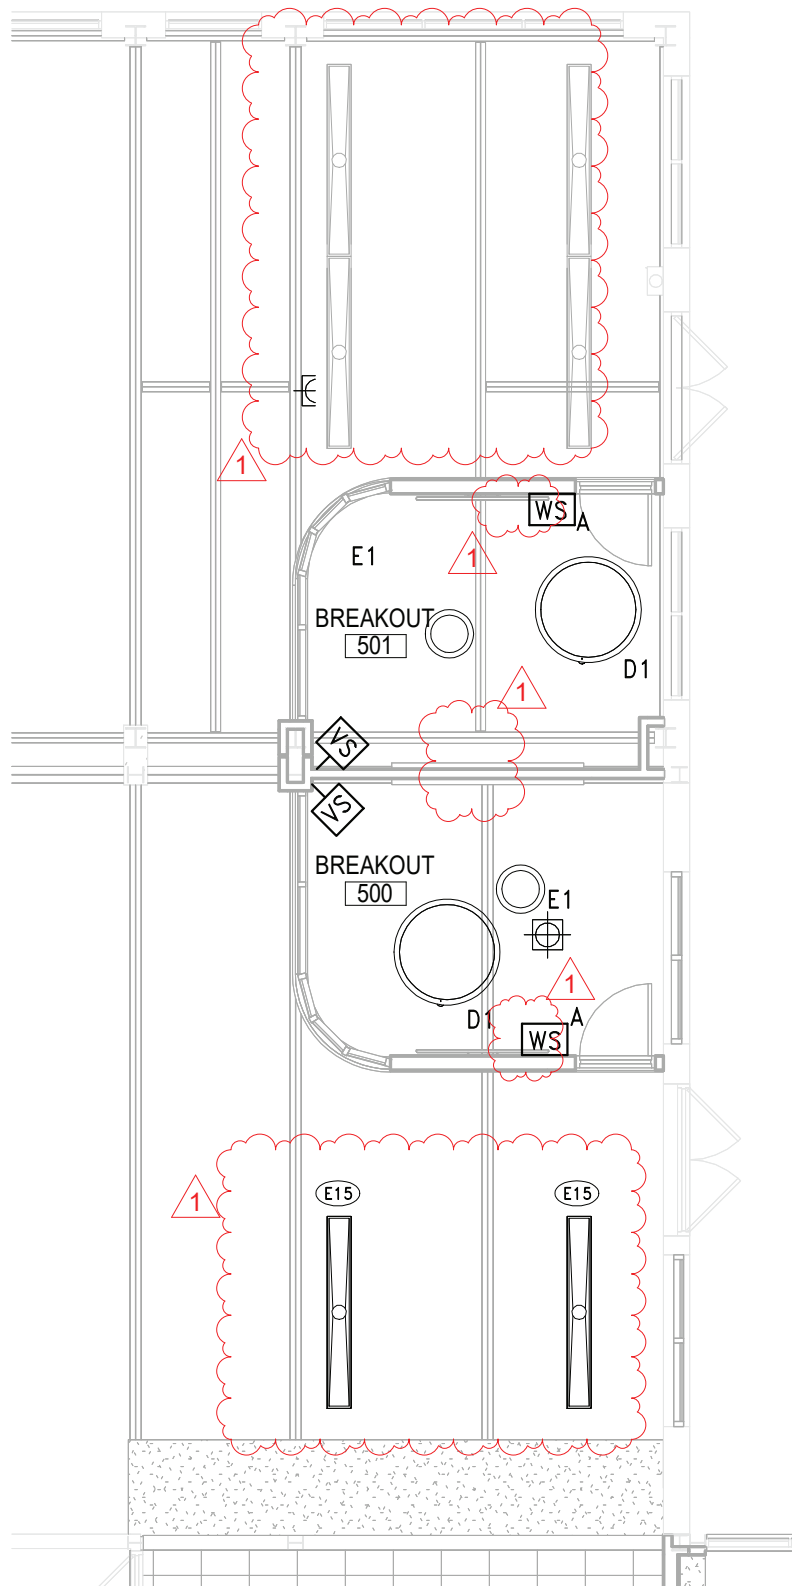

2 FIRST FLOOR REFLECTED CEILING PLAN AREA A ADD ALT  
SCALE: 1/8" = 1'-0"

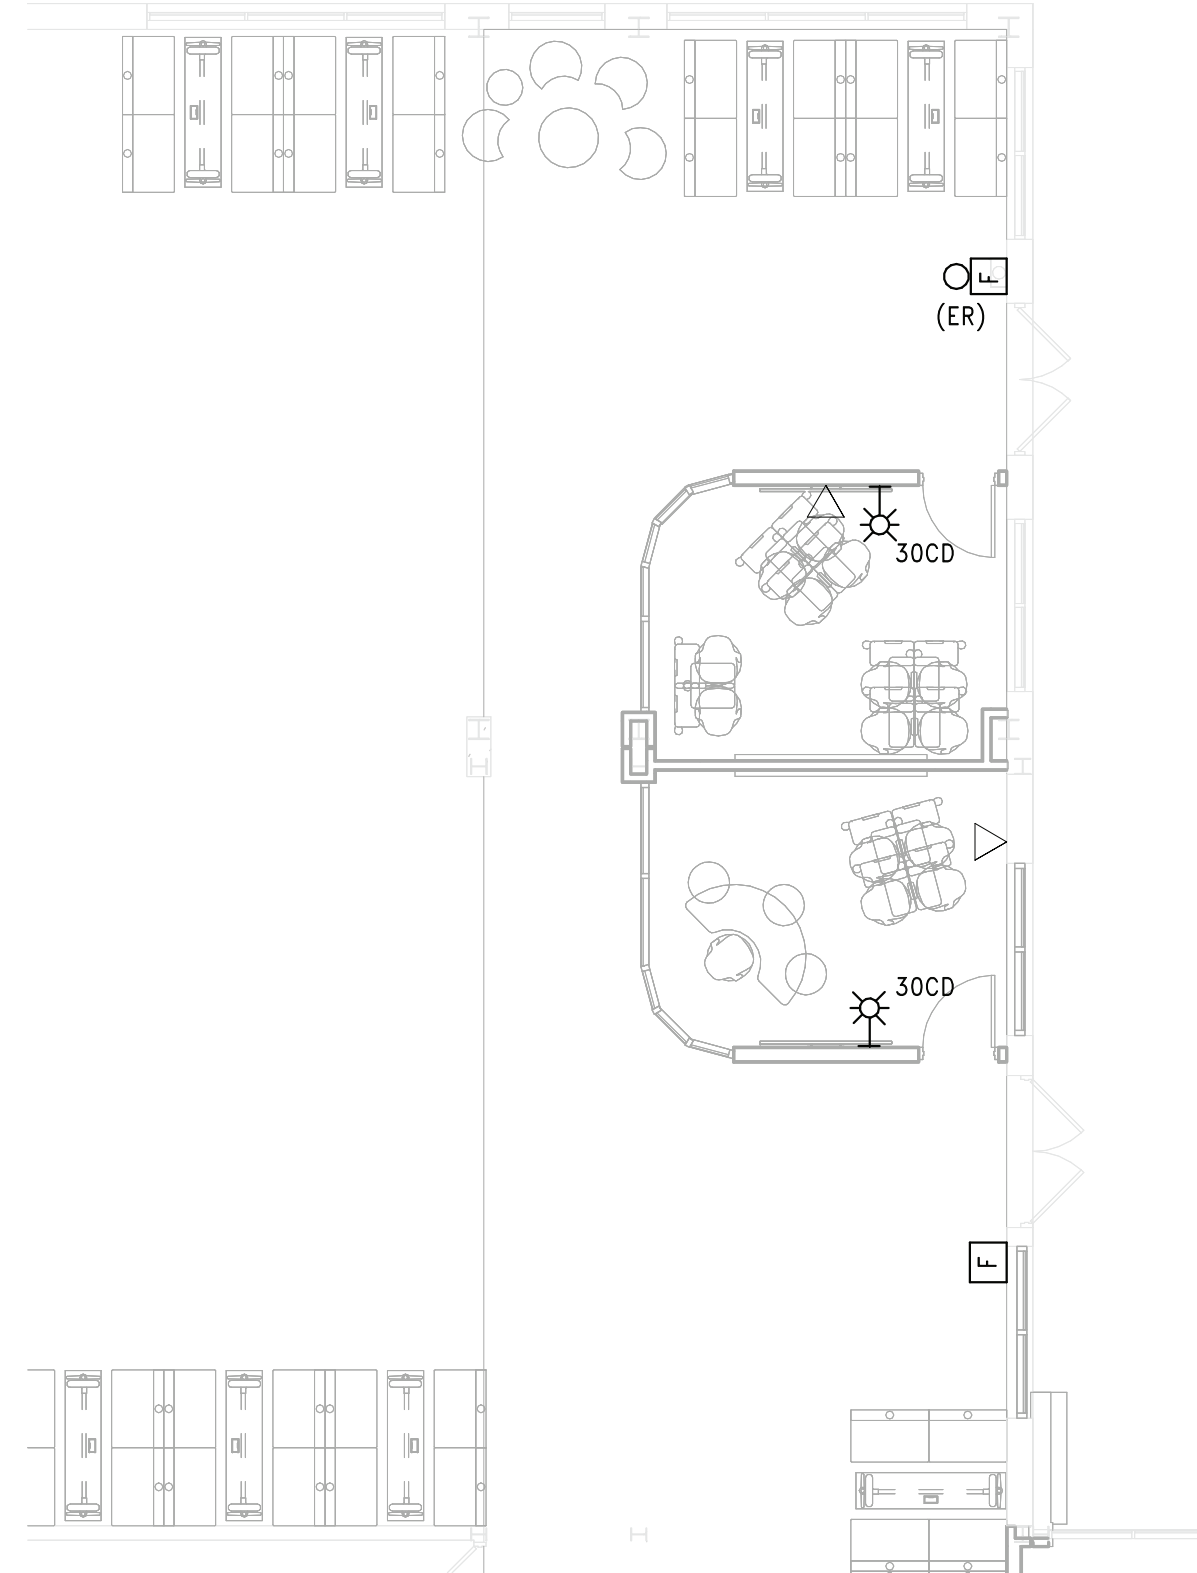

1 PARTIAL FIRST FLOOR PROPOSED SYSTEMS PLANS - AREA A ADD ALT  
SCALE: 1/8" = 1'-0"



Branch Panel: MP1-3																							
Location: ELECT. RM 258						Volts: 120/208 Wye			A.I.C. Rating: 22000														
Supply From:						Phases: 3			Mains Type: MCB														
Mounting: RECESSED						Wires: 4			Mains Rating: 200 A														
CKT	Circuit Description					Trip	Poles	A		B		C		Poles	Trip	Circuit Description					CKT		
1	EXISTING CKT.					20 A	2	0 VA	0 VA						3	20 A	EXISTING CKT.					2	
3	--					--	--			0 VA		0 VA				--	--	--					4
5	EXISTING CKT.					20 A	1					0 VA		0 VA		--	--	--					6
7	EXISTING CKT.					20 A	3	0 VA	0 VA						3	20 A	EXISTING CKT.					8	
9	--					--	--			0 VA		0 VA				--	--	--					10
11	--					--	--					0 VA		0 VA		--	--	--					12
13	EXISTING CKT.					20 A	3	0 VA	0 VA						3	20 A	EXISTING CKT.					14	
15	--					--	--			0 VA		0 VA				--	--	--					16
17	--					--	--					0 VA		0 VA		--	--	--					18
19	EXISTING CKT.					20 A	3	0 VA	0 VA						1	20 A	EXISTING CKT.					20	
21	--					--	--			0 VA		0 VA				1	20 A	EXISTING CKT.					22
23	--					--	--					0 VA		0 VA		1	20 A	EXISTING CKT.					24
25	EXISTING CKT.					20 A	1	0 VA							2	20 A	EXISTING CKT.					26	
27	--					--	--					0 VA				--	--	--					28
29	OFFICE 19 & 20					20 A	1	0 VA				900 VA		0 VA		2	20 A	EXISTING CKT.					30
31	EXISTING CKT.					20 A	1			0 VA		0 VA				--	--	--					32
33	--					--	--									--	--	--					34
35	--					--	--									--	--	--					36
37	EXISTING CKT.					20 A	1	0 VA	0 VA						1	20 A	EXISTING CKT.					38	
39	EXISTING CKT.					20 A	2			0 VA		0 VA				2	20 A	EXISTING CKT.					40
41	--					--	--					0 VA		0 VA		--	--	--					42
Total Load:						0 VA		0 VA		900 VA													
Total Amps:						0 A		0 A		8 A													

Notes:  
(EXISTING PANEL): ALL NEW BREAKERS SHALL MATCH PANEL'S TYPE AND AIC RATING.

Branch Panel: B1L																
Location: ELEC. 127						Volts: 120/208 Wye			A.I.C. Rating:							
Supply From:						Phases: 3			Mains Type: MCB							
Mounting: RECESSED						Wires: 4			Mains Rating: 250 A							
CKT	Circuit Description			Trip	Poles	A		B		C		Poles	Trip	Circuit Description		CKT
1	EF-2B			20 A	1	1176 VA	0 VA					1	20 A	EXISTING CKT.		2
3	EXISTING CKT.			15 A	2			0 VA	0 VA			1	20 A	EXISTING CKT.		4
5	--			--	--					0 VA	0 VA	1	20 A	EXISTING CKT.		6
7	EXISTING CKT.			20 A	1	0 VA	0 VA					1	20 A	EXISTING CKT.		8
9	EXISTING CKT.			20 A	1			0 VA	0 VA			1	20 A	EXISTING CKT.		10
11	EXISTING CKT.			20 A	1					0 VA	0 VA	1	20 A	EXISTING CKT.		12
13	EXISTING CKT.			20 A	1	0 VA	0 VA					1	20 A	EXISTING CKT.		14
15	EXISTING CKT.			20 A	1			0 VA	0 VA			1	20 A	EXISTING CKT.		16
17	EXISTING CKT.			20 A	1					0 VA	0 VA	1	20 A	EXISTING CKT.		18
19	EXISTING CKT.			20 A	1	0 VA	0 VA					1	20 A	EXISTING CKT.		20
21	EXISTING CKT.			20 A	1			0 VA	0 VA			1	20 A	EXISTING CKT.		22
23	EXISTING CKT.			20 A	1					0 VA	0 VA	1	20 A	EXISTING CKT.		24
25	EXISTING CKT.			20 A	1	0 VA	0 VA					1	20 A	EXISTING CKT.		26
27	EXISTING CKT.			20 A	1			0 VA	686.4 VA			2	20 A	UV-1F, UV-1G		28
29	EXISTING CKT.			20 A	1					0 VA	686.4 VA	1	20 A	EF-2C		30
31	EXISTING CKT.			20 A	1	0 VA	1176 VA					1	20 A			32
33																34
35																36
37																38
39																40
41																42
Total Load:						2352 VA		686 VA		686 VA						
Total Amps:						20 A		6 A		6 A						

Load Classification	Connected Load	Demand Factor	Estimated Demand	Panel Totals	
Equipment	3725 VA	100.00%	3725 VA		
				Total Conn. Load:	3725 VA
				Total Est. Demand:	3725 VA
				Total Conn. Current:	10 A
				Total Est. Demand Current:	10 A
Notes:					

Branch Panel: PP1-2												
Location: CLOSET 73					Volts: 120/208 Wye							
Supply From:					Phases: 3							
Mounting: RECESSED					Wires: 4							
CKT	Circuit Description	Trip	Poles	A	B	C	Poles	Trip	Circuit Description	CKT		
1	RECEPT RM M1064 (EXISTING)	20 A	1	0 VA	0 VA		1	20 A	RECEPT RM M1079 (EXISTING)	2		
3	RECEPT RM M1063 (EXISTING)	20 A	1		0 VA	0 VA	1	20 A	RECEPT RM M1079 (EXISTING)	4		
5	RECEPT RM M1-106 (EXISTING)	20 A	1			0 VA	0 VA	1	20 A	RECEPT RM M1060 (EXISTING)	6	
7	ELEC WATER FOUNTAIN (EXISTING)	20 A	1	0 VA	0 VA		1	20 A	RECEPT RM M1060 (EXISTING)	8		
9	RECEPT M1-106, 067 (EXISTING)	20 A	1		0 VA	0 VA	1	20 A	RECEPT RM M1060 (EXISTING)	10		
11	MAG LOCK DOOR (EXISTING)	20 A	1			0 VA	0 VA	1	20 A	RECEPT RM M1060 (EXISTING)	12	
13				0 VA			1	20 A	MOTORIZED FIRE DAMPER	14		
15										16		
17										18		
19										20		
21										22		
23										24		
25										26		
27										28		
29										30		
31										32		
33										34		
35										36		
37										38		
39										40		
41										42		
Total Load:				0 VA	0 VA	0 VA						
Total Amps:				0 A	0 A	0 A						

Notes:

Notes:											
--------	--	--	--	--	--	--	--	--	--	--	--

Branch Panel: PNL X													
Location: MECH ROOM 162				Volts: 120/208 Wye				A.I.C. Rating:					
Supply From:				Phases: 3				Mains Type: MLO					
Mounting: RECESSED				Wires: 4				Mains Rating: 225 A					
CKT	Circuit Description			Trip	Poles	A	B	C	Poles	Trip	Circuit Description	CKT	
1	--			--	--	1055.6 VA				3	15 A	CMU-236	2
3	EXISTING CKT.			20 A	1		0 VA	1055.6 VA		--	--	--	4
5	EXISTING CKT.			20 A	1			0 VA	1055.6 VA	--	--	--	6
7	EXISTING CKT.			20 A	1	0 VA	0 VA			1	20 A EXISTING CKT.	8	
9	EXISTING CKT.			20 A	1		0 VA	0 VA		1	20 A EXISTING CKT.	10	
11	EXISTING CKT.			20 A	1			0 VA	0 VA	1	20 A EXISTING CKT.	12	
13	EXISTING CKT.			20 A	1	0 VA	0 VA			1	20 A EXISTING CKT.	14	
15	EXISTING CKT.			20 A	1		0 VA	0 VA		1	20 A EXISTING CKT.	16	
17	EXISTING CKT.			20 A	1			0 VA	0 VA	1	20 A EXISTING CKT.	18	
19	EXISTING CKT.			20 A	1	0 VA	0 VA			1	20 A EXISTING CKT.	20	
21	EXISTING CKT.			20 A	1		0 VA	0 VA		1	20 A EXISTING CKT.	22	
23	EXISTING CKT.			20 A	1			0 VA	0 VA	1	20 A EXISTING CKT.	24	
Total Load:						1056 VA	1056 VA	1056 VA					
Total Amps:						9 A	9 A	9 A					
Load Classification				Connected Load		Demand Factor		Estimated Demand		Panel Totals			
Equipment				3167 VA		100.00%		3167 VA					
										Total Conn. Load: 3167 VA			
										Total Est. Demand: 3167 VA			
										Total Conn. Current: 9 A			
										Total Est. Demand Current: 9 A			
Notes:													



265000 - LIGHTING FIXTURE SCHEDULE						
TAG	DESCRIPTION	MANUFACTURER	CATALOG NUMBER	WATTAGE / CCT / LAMP / CRI	VOLTAGE	REMARKS
A1	2'X4' RECESSED LED WITH BEVEL OPTION. DLC LISTED WITH 6500 LUMEN PACKAGE.	COOPER METALUX	24PD-65-PB1-L835	50W/3500K/LED/80+	UNV	
A1-EM	SAME AS A1 WITH EMERGENCY BATTERY PACK OPTION	COOPER METALUX	24PD-65-PB1-EL7W-L835	50W/3500K/LED/80+	UNV	
A2	2'X4' RECESSED LED WITH BEVEL OPTION. DLC LISTED WITH 3500 LUMEN PACKAGE.	COOPER METALUX	26PW-35-PB1-L835	26W/3500K/LED/80+	UNV	
A2-EM	SAME AS A2 WITH EMERGENCY BATTERY PACK OPTION	COOPER METALUX	24PD-35-PB1-EL7W-L835	26W/3500K/LED/80+	UNV	
A3	2'X4' RECESSED LED WITH BEVEL OPTION. DLC LISTED WITH 8500 LUMEN PACKAGE.	COOPER METALUX	24PD-85-PB1-L835	65W/3500K/LED/80+	UNV	
B1	2'X2' RECESSED LED WITH BEVEL OPTION. DLC LISTED WITH 3000 LUMEN PACKAGE.	COOPER METALUX	22PD-30-PB1-L835	25W/3500K/LED/80+	UNV	
B1-EM	SAME AS B1 WITH EMERGENCY BATTERY PACK OPTION	COOPER METALUX	22PD-30-PB1-EL7W-L835	25W/3500K/LED/80+	UNV	
B2	2'X2' RECESSED LED WITH BEVEL OPTION. DLC LISTED WITH 6500 LUMEN PACKAGE.	COOPER METALUX	22PD-65-PB1-L835	56W/3500K/LED/80+	UNV	
B2-EM	SAME AS B2 WITH EMERGENCY BATTERY PACK OPTION	COOPER METALUX	22PD-65-PB1-EL7W-L835	56W/3500K/LED/80+	UNV	
B3	2'X2' RECESSED LED WITH BEVEL OPTION. DLC LISTED WITH 5500 LUMEN PACKAGE.	COOPER METALUX	22PD-55-PB1-L835	46W/3500K/LED/80+	UNV	
B3-EM	SAME AS B3 WITH EMERGENCY BATTERY PACK OPTION	COOPER METALUX	22PD-55-PB1-EL7W-L835	46W/3500K/LED/80+	UNV	
C1	6-INCH LED SELF-FLANGED, LENSED DOWNLIGHT WITH 2000 LUMEN PACKAGE.	COOPER HALO	PR6FS24D010	20W/3500K/LED/80+	UNV	
C1-EM	SAME AS C1 WITH EMERGENCY BATTERY PACK OPTION	COOPER HALO	PR6FS24D010-REM7	20W/3500K/LED/80+	UNV	
D1	ROUND 55" SUSPENDED DIRECT/INDIRECT LED FIXTURE WITH MOSSWALL WASABI	INTRA LIGHTING - ACUSTO	12830-2-U-C-3-0-1-2-2	140W/3500K/LED/80+	UNV	
E1	ROUND 24" SUSPENDED DIRECT/INDIRECT LED FIXTURE WITH SATIN OPAL	INTRA LIGHTING - WAVE ROUND	12610-3-U-C-1-0-1	29W/3500K/LED/80+	UNV	
ELU	EMERGENCY LIGHTING UNIT - UL924 COMPLAINT WITH DUAL VOLTAGE INPUT, BROWNOUT CIRCUIT, SEALED NICKEL CADMIUM BATTERYBACK-UP	COOPER ATLITE	ATLEDO-A-100-SD	LED	UNV	
F1	DIRECT/INDIRECT 4' LINEAR LED FIXTURE STRUCTURE MOUNTED WITH 6500 LUMEN PACKAGE.	COOPER NEO-RAY	S921DIP-W535-ST4S-4-UDD-W	68W/3500K/LED/80+	UNV	
F1-EM	SAME AS F1 WITH EMERGENCY BATTERY PACK OPTION	COOPER NEO-RAY	S921DIP-W535-ST4S-4-UDD-W-EL7W	68W/3500K/LED/80+	UNV	
F2	DIRECT/INDIRECT 8' LINEAR LED FIXTURE STRUCTURE MOUNTED WITH 6500 LUMEN PACKAGE.	COOPER NEO-RAY	S921DIP-W535-ST8S-4-UDD-W	136W/3500K/LED/80+	UNV	
F2-EM	SAME AS F2 WITH EMERGENCY BATTERY PACK OPTION	COOPER NEO-RAY	S921DIP-W535-ST8S-4-UDD-W-EL7W	136W/3500K/LED/80+	UNV	
G1	DIRECT LED LINEAR RECESSED FIXTURE. DLC LISTED	COOPER NEO-RAY	S124DR-S-795D-35-U-DD	6.8W/FT/3500K/LED/80+	UNV	REFER TO FLOOR PLA FOR FIXTURE LENGTHS
X1	WALL MOUNTED EXIT FIXTURE WITH DUAL VOLTAGE INPUT, SELF-DIAGNOSTIC, LONG LIFE LED, BROWNOUT CIRCUIT, OVERLOAD/SHORT CIRCUIT PROTECTION	COOPER SURE-LITES	EUX7-R-WH-SD	LED	UNV	
X2	SAME AS X1 - CEILING MOUNTED	COOPER SURE-LITES	EUX7-R-WH-SD	LED	UNV	

### Branch Panel: LP-1

Location: ELECT. RM 258  
Supply From:  
Mounting: RECESSED

Volts: 120/208 Wye  
Phases: 3  
Wires: 4

A.I.C. Rating:  
Mains Type: 400 MLO  
Mains Rating: 400 A

CKT	Circuit Description	Trip	Poles	A	B	C	Poles	Trip	Circuit Description	CKT
1	LTG GALLERY 501B	20 A	1	1662.2 VA	892.2 VA			1	20 A LTG RM 111A, 111B, 111C, 111D, 107,....	2
3	CORRIDOR LTG	20 A	1		1088.2 VA	1497.8 VA		1	20 A LTG RM 118, 5, 6, 7, 8, 9, 10, 11, 12, 13,....	4
5	LTG - RM 168	20 A	1			1533.3 VA	1657.8 VA	1	20 A LTG - CIRCULAR IN 168	6
7	LTG - 115, 116, 117, 119,	20 A	1	1177.8 VA	1454.9 VA			1	20 A Other	8
9	LTG - RM 168	20 A	1		1688.3 VA	906.7 VA		1	20 A LTG - RM 168	10
11	LTG - RM 168	20 A	1			672.8 VA	634.6 VA	1	20 A LTG CORRIDOR B	12
13	LTG 113	20 A	1	946 VA	1393.4 VA			1	20 A LTG RM 168, 20, 164, 165, 117	14
15	LTG - RM 160, 159, 157	20 A	1		788.6 VA	1735.7 VA		1	20 A LTG RM 121, 121A, 120, 120A	16
17										18
19										20
21										22
23										24
25										26
27										28
29										30
31										32
33										34
35										36
37										38
39										40
41										42
Total Load:				6447 VA	7665 VA	4430 VA				
Total Amps:				56 A	66 A	37 A				

Load Classification	Connected Load	Demand Factor	Estimated Demand	Panel Totals
Lighting	12651 VA	100.00%	12651 VA	
Other	5895 VA	100.00%	5895 VA	
				Total Conn. Load: 18324 VA
				Total Est. Demand: 18324 VA
				Total Conn. Current: 51 A
				Total Est. Demand Current: 51 A

Notes:

Electrical Equipment Schedule														
TAG	DESCRIPTION	VOLTAGE	PHAS E	AMPS - (FLA/MCA)	POWER PANEL	CIRCUIT NUMBER	BREAKER RATING	WIRE	PROVIDE DISCONNECT	DISCONNECT	VFD	PROVIDE DUCT SMOKE	FSD	Notes
AC-1A	INDOOR UNIT	208 V	1	25 MCA	68	23.25	15A-2P	(2)#12, #12G, IN 3/4" C.	No	MC FURNISHED/EC INSTALLED	No	No	No	1
AC-1B	INDOOR UNIT	208 V	1	25 MCA	68	27.29	15A-2P	(2)#12, #12G, IN 3/4" C.	No	MC FURNISHED/EC INSTALLED	No	No	No	1
AC-1C	INDOOR UNIT	208 V	1	1.6 MCA	68	23.25	15A-2P	(2)#12, #12G, IN 3/4" C.	No	MC FURNISHED/EC INSTALLED	No	No	No	1
AC-1D	INDOOR UNIT	208 V	1	1.6 MCA	68	23.25	15A-2P	(2)#12, #12G, IN 3/4" C.	No	MC FURNISHED/EC INSTALLED	No	No	No	1
AC-1E	INDOOR UNIT	208 V	1	2.3 MCA	68	28.30	15A-2P	(2)#12, #12G, IN 3/4" C.	No	MC FURNISHED/EC INSTALLED	No	No	No	1
AC-2A	INDOOR UNIT	208 V	1	25 MCA	68	24.26	15A-2P	(2)#12, #12G, IN 3/4" C.	No	MC FURNISHED/EC INSTALLED	No	No	No	1
AC-2B	INDOOR UNIT	208 V	1	25 MCA	68	27.29	15A-2P	(2)#12, #12G, IN 3/4" C.	No	MC FURNISHED/EC INSTALLED	No	No	No	1
ACC-2B6	INDOOR UNIT	208 V	1	2 MCA	LPE-10	4.6	15A-2P	(2)#12, #12G, IN 3/4" C.	No	MC FURNISHED/EC INSTALLED	No	No	No	1
ACC-2	OUTDOOR AIR UNIT	480 V	3	37.2 FLA	MPH-1	1.3.5	50A-3P	(3)#6, #10G, IN 1" C.	No	MC FURNISHED/EC INSTALLED	No	No	No	1
ACC-N	OUTDOOR AIR UNIT	480 V	3	18.4 MCA	MPH-1	25.27.29	25A-3P	(3)#10, #10G, IN 3/4" C.	No	MC FURNISHED/EC INSTALLED	No	No	No	1
ACC-S	OUTDOOR AIR UNIT	480 V	3	18.4 MCA	MPH-1	20.22.24	25A-3P	(3)#10, #10G, IN 3/4" C.	No	MC FURNISHED/EC INSTALLED	No	No	No	1
CMU-236	MAKEUP AIR UNIT	208 V	3	10.99 MCA	PNL X	2.4.6	15A-3P	(3)#12, #12G, IN 3/4" C.	No	MC FURNISHED/EC INSTALLED	No	No	No	1
CP-AC1A	CONDENSATE DRAIN PUMP	120 V	1	1.5 FLA	68	44	15A-1P	(2)#12, #12G, IN 3/4" C.	No	MC FURNISHED/EC INSTALLED	No	No	No	1
CP-AC1B	CONDENSATE DRAIN PUMP	120 V	1	1.5 FLA	68	43	15A-1P	(2)#12, #12G, IN 3/4" C.	No	MC FURNISHED/EC INSTALLED	No	No	No	1
CP-AC1C	CONDENSATE DRAIN PUMP	120 V	1	1.5 FLA	68	42	15A-1P	(2)#12, #12G, IN 3/4" C.	No	MC FURNISHED/EC INSTALLED	No	No	No	1
CP-AC1D	CONDENSATE DRAIN PUMP	120 V	1	1.5 FLA	68	42	15A-1P	(2)#12, #12G, IN 3/4" C.	No	MC FURNISHED/EC INSTALLED	No	No	No	1
CP-AC1E	CONDENSATE DRAIN PUMP	120 V	1	1.5 FLA	68	44	15A-1P	(2)#12, #12G, IN 3/4" C.	No	MC FURNISHED/EC INSTALLED	No	No	No	1
CP-AC2A	CONDENSATE DRAIN PUMP	120 V	1	1.5 FLA	68	44	15A-1P	(2)#12, #12G, IN 3/4" C.	No	MC FURNISHED/EC INSTALLED	No	No	No	1
CP-AC2B	CONDENSATE DRAIN PUMP	120 V	1	1.5 FLA	68	43	15A-1P	(2)#12, #12G, IN 3/4" C.	No	MC FURNISHED/EC INSTALLED	No	No	No	1
CP-AC2D	CONDENSATE DRAIN PUMP	120 V	1	1.5 FLA	68	43	15A-1P	(2)#12, #12G, IN 3/4" C.	No	MC FURNISHED/EC INSTALLED	No	No	No	1
CP-AC2E	CONDENSATE DRAIN PUMP	120 V	1	1.5 FLA	68	44	15A-1P	(2)#12, #12G, IN 3/4" C.	No	MC FURNISHED/EC INSTALLED	No	No	No	1
EF-2C	EXHAUST FAN	120 V	1	9.8 FLA	B1L	32	15A-2P	(2)#12, #12G, IN 3/4" C.	No	MC FURNISHED/EC INSTALLED	No	No	No	1.2
FOU-2A	FAN COIL UNIT	208 V	1	3.8 MCA	LPE-10	4.6	15A-2P	(2)#12, #12G, IN 3/4" C.	No	MC FURNISHED/EC INSTALLED	No	No	No	1
FOU-2B	FAN COIL UNIT	208 V	1	3.8 MCA	LPE-10	4.6	15A-2P	(2)#12, #12G, IN 3/4" C.	No	MC FURNISHED/EC INSTALLED	No	No	No	1
FOU-500	FAN COIL UNIT	208 V	1	6 FLA	PP-A(R)	38.40	15A-2P	(2)#12, #12G, IN 3/4" C.	No	MC FURNISHED/EC INSTALLED	No	No	No	1
FOU-501	FAN COIL UNIT	208 V	1	6 FLA	PP-A(R)	38.40	15A-2P	(2)#12, #12G, IN 3/4" C.	No	MC FURNISHED/EC INSTALLED	No	No	No	1
HV-2	INDOOR UNIT	480 V	3	28 MCA	MPH-1	14.16.18	40A-3P	(3)#6, #10G, IN 1" C.	No	MC FURNISHED/EC INSTALLED	No	No	No	1.2
HVAC-1	ROOF TOP UNIT	480 V	3	28 MCA	MPH-1	19.21.23	40A-3P	(3)#6, #10G, IN 1" C.	No	MC FURNISHED/EC INSTALLED	No	No	No	1.2
HVAC-2	ROOF TOP UNIT	480 V	3	28 MCA	MPH-1	7.18.19	40A-3P	(3)#6, #10G, IN 1" C.	No	MC FURNISHED/EC INSTALLED	No	No	No	1.2
HVAC-3	ROOF TOP UNIT	480 V	3	28 MCA	MPH-1	13.15.17	30A-3P	(3)#10, #10G, IN 3/4" C.	No	MC FURNISHED/EC INSTALLED	No	No	No	1.2
HVAC-10	ROOF TOP UNIT	480 V	3	28 MCA	MPH-1	1.1	50A-3P	(3)#6, #10G, IN 1" C.	No	MC FURNISHED/EC INSTALLED	No	No	No	1.2
HVAC-11	ROOF TOP UNIT	480 V	3	38 MCA	MPH-1	8.10.12	50A-3P	(3)#6, #10G, IN 1" C.	No	MC FURNISHED/EC INSTALLED	No	No	No	1.2
HVAC-12	ROOF TOP UNIT	480 V	3	38 MCA	MPH-1	8.10.12	50A-3P	(3)#6, #10G, IN 1" C.	No	MC FURNISHED/EC INSTALLED	No	No	No	1.2
REF-1	EXHAUST FAN	120 V	1	5.6 FLA	68	<unavailable>	20A-1P	(2)#12, #12G, IN 3/4" C.	No	MC FURNISHED/EC INSTALLED	No	No	No	1
UV-1A	UNIT VENTILATOR	208 V	1	3.3 FLA	68	35.37	15A-2P	(2)#12, #12G, IN 3/4" C.	No	MC FURNISHED/EC INSTALLED	No	No	No	1
UV-1B	UNIT VENTILATOR	208 V	1	3.3 FLA	68	35.37	15A-2P	(2)#12, #12G, IN 3/4" C.	No	MC FURNISHED/EC INSTALLED	No	No	No	1
UV-1C	UNIT VENTILATOR	208 V	1	2.6 FLA	68	34.36	15A-2P	(2)#12, #12G, IN 3/4" C.	No	MC FURNISHED/EC INSTALLED	No	No	No	1
UV-1D	UNIT VENTILATOR	208 V	1	2.3 FLA	68	31.33	15A-2P	(2)#12, #12G, IN 3/4" C.	No	MC FURNISHED/EC INSTALLED	No	No	No	1
UV-1E	UNIT VENTILATOR	208 V	1	2.3 FLA	68	31.33	15A-2P	(2)#12, #12G, IN 3/4" C.	No	MC FURNISHED/EC INSTALLED	No	No	No	1
UV-1F	UNIT VENTILATOR	208 V	1	2.3 FLA	68									



REV.	DATE	ITEM
1	11/23/22	BID ADDENDUM #1

**NOTICE**

THESE DRAWINGS ARE BASED ON CONSTRUCTION DRAWINGS NOT PREPARED BY BBS ARCHITECTS, LANDSCAPE ARCHITECTS AND ENGINEERS, P.C. AND THEREFORE, MAY NOT REPRESENT THE CONDITIONS AS CONSTRUCTED AT THE TIME. ALL EXISTING CONDITIONS SHOWN ARE REPRESENTED AS SUGGESTIVE INFORMATION AS THEY MAY NOT HAVE BEEN BUILT AND DETAIL PER THE ORIGINAL DOCUMENTS OR PER THE OWNER'S INFORMATION.

ORIGINAL DOCUMENTS

KEY PLAN  
NO SCALE

BRIARCLIFF MANOR U.F.S.D.  
PHASE 2 BOND IMPROVEMENTS  
BRIARCLIFF MANOR MIDDLE / HIGH SCHOOL  
444 PLEASANTVILLE RD. BRIARCLIFF MANOR, NY 10510

ELECTRICAL DETAILS

PROJECT

DWG TITLE

DRWG. BY: EEA  
CHK. BY: AG


THIS DRAWING, PREPARED FOR THE SPECIFIC PROJECT INDICATED IS AN INSTRUMENT OF SERVICE AND THE PROPERTY OF BBS ARCHITECTS, LANDSCAPE ARCHITECTS AND ENGINEERS, P.C. REPRISAL OR ANY USE OF THIS DRAWING FOR ANY OTHER PROJECT IS PROHIBITED. ANY ALTERATION OR REPRODUCTION OF THIS DOCUMENT IS ALSO PROHIBITED WITHOUT THE WRITTEN CONSENT OF THE ARCHITECT OR ENGINEER.

**BBS**  
ARCHITECTS  
LANDSCAPE ARCHITECTS  
ENGINEERS  
244 EAST MAIN STREET  
PATCHOGUE  
NEW YORK 11772  
T: 631.475.0349  
F: 631.475.0361  
187 WOLF ROAD, STE. 305  
ALBANY  
NEW YORK 12205  
T: 518.621.7650  
F: 518.621.7655  
www.bbsarchitecture.com

SED NO. 66-14-02-02-0-004-023  
DISTRICT BRIARCLIFF MANOR U.F.S.D.  
PROJECT PHASE 2 CAPITAL BOND IMPROVEMENTS  
DWG TITLE ELECTRICAL DETAILS

SCALE: 12" = 1'-0"  
DATE: 07/07/22  
BID PAU DATE: 06/29/22  
FILE NO. 21-274C

E10.05 HSMS

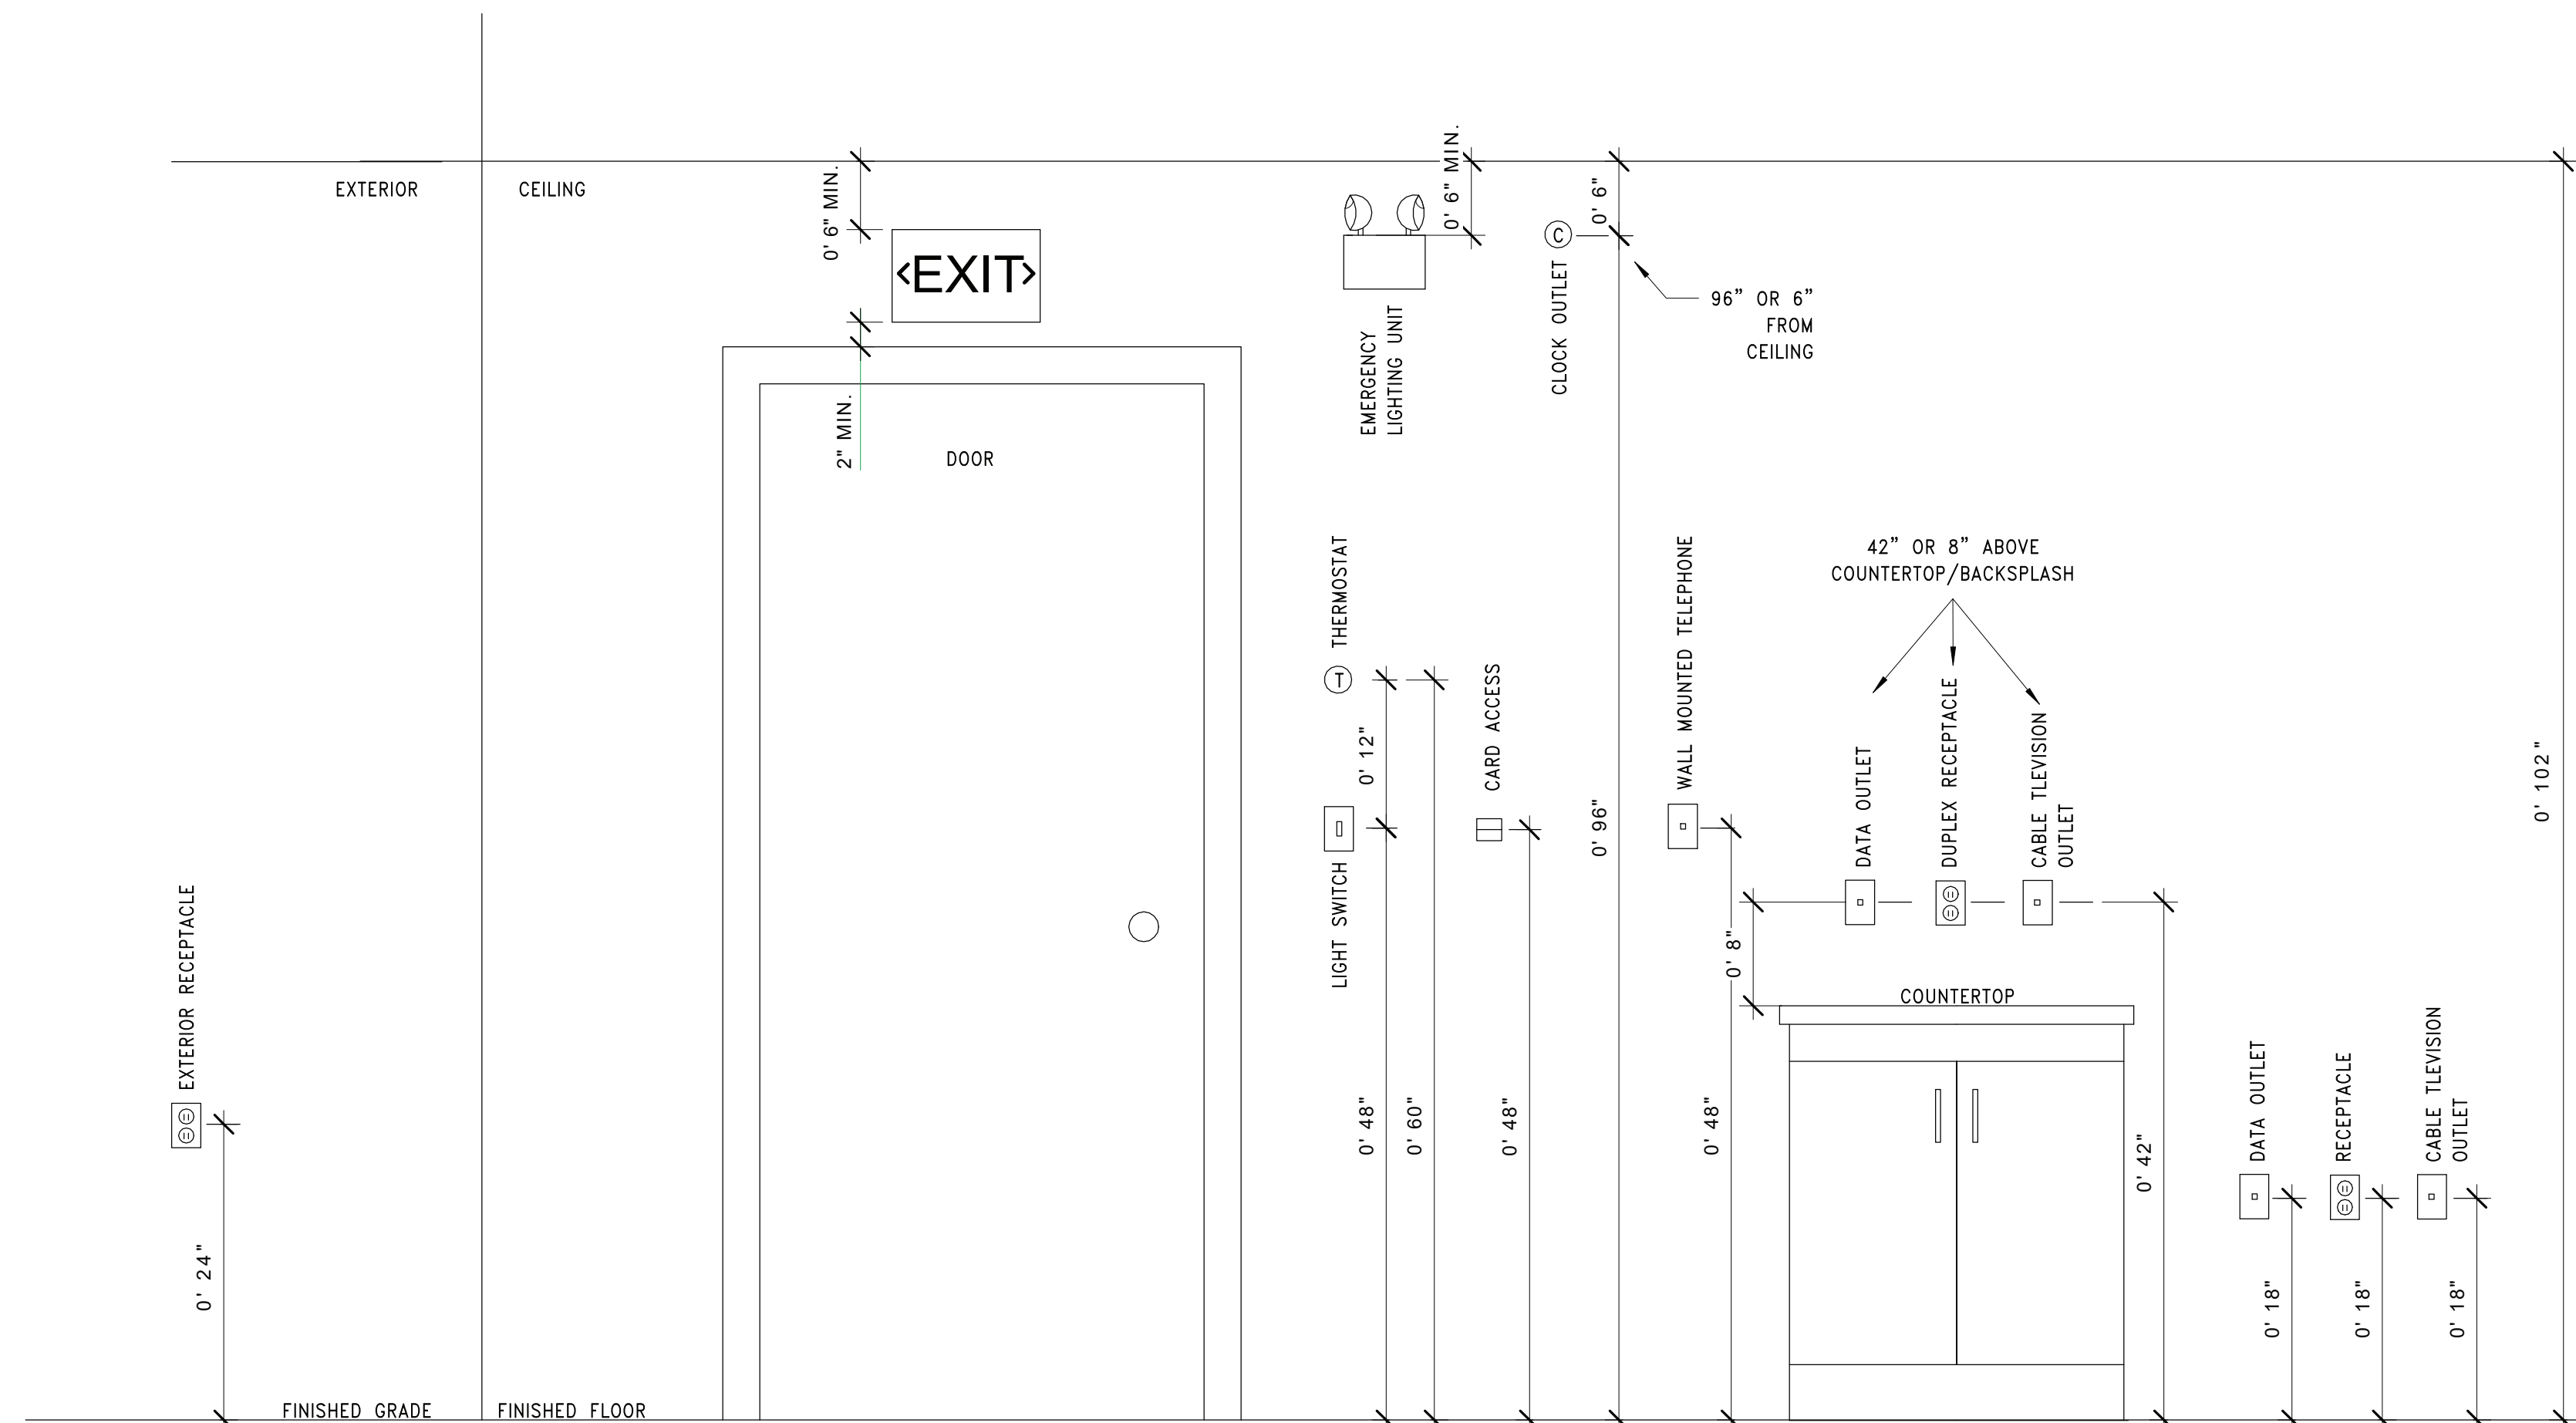


MOUNTING ELEVATIONS NOTES:

1. MOUNTING HEIGHTS NOTED ARE STANDARD, IF SPECIFIC MOUNTING HEIGHTS ARE NOT NOTED ON THE PLANS OR IN THE SPECIFICATIONS.

3 TYPICAL MOUNTING HEIGHT DETAIL

SCALE: NTS

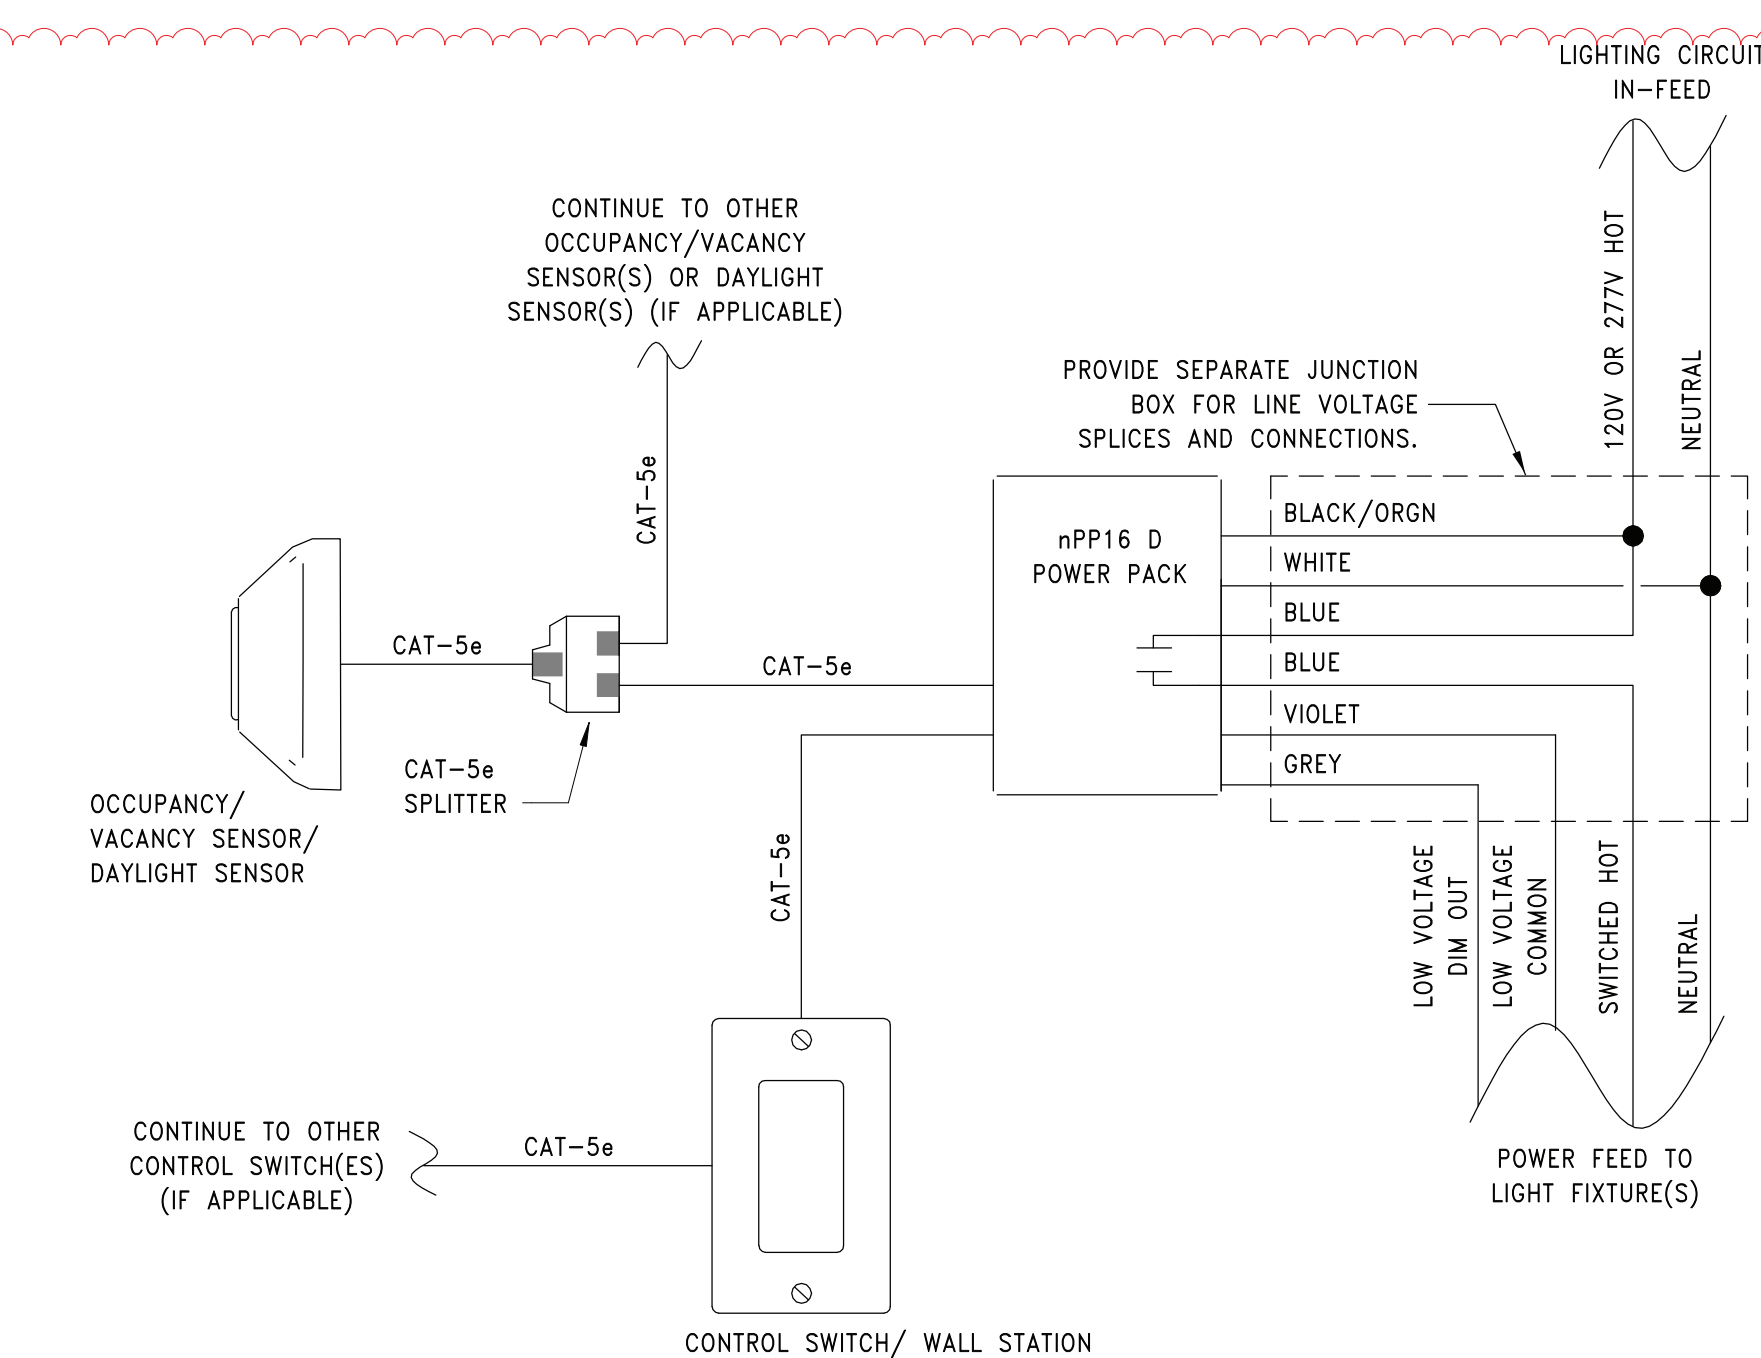


NOTES:

1. ONE POWER PACK REQUIRED PER CONTROL ZONE. TYPICAL CONTROL ZONES ARE OCCUPANCY/VACANCY OR DAYLIGHT SENSING.

2 LIGHTING CONTROLS DETAIL

SCALE: 12" = 1'-0"

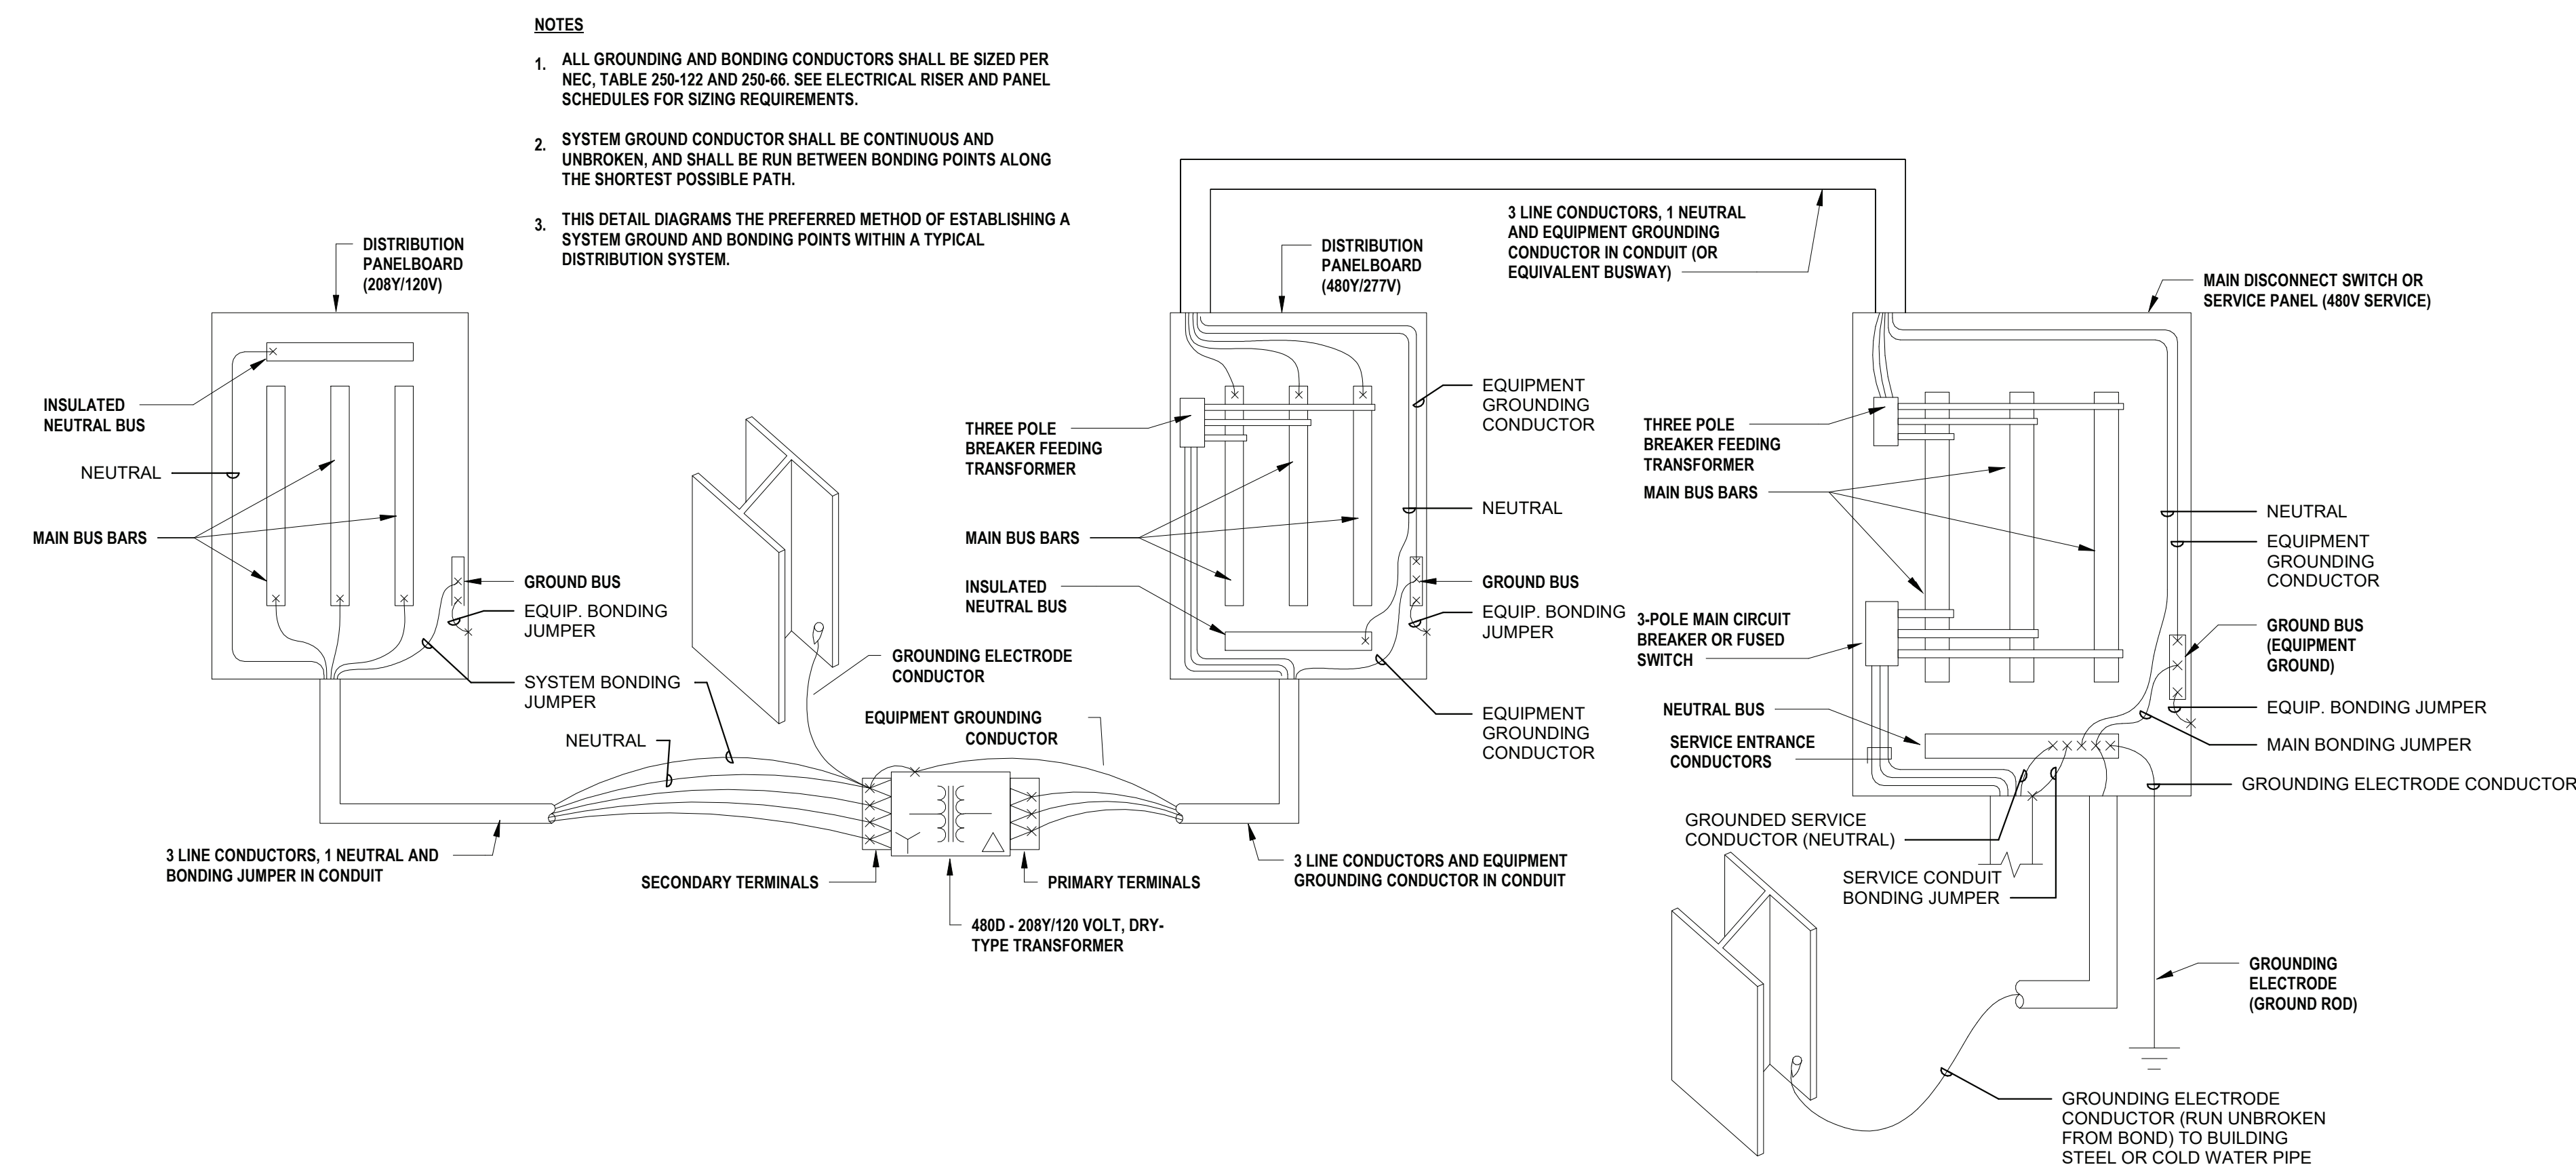

NOTES

1. ALL GROUNDING AND BONDING CONDUCTORS SHALL BE SIZED PER NEC, TABLE 250-122 AND 250-66. SEE ELECTRICAL RISER AND PANEL SCHEDULES FOR SIZING REQUIREMENTS.
2. SYSTEM GROUND CONDUCTOR SHALL BE CONTINUOUS AND UNBROKEN, AND SHALL BE RUN BETWEEN BONDING POINTS ALONG THE SHORTEST POSSIBLE PATH.
3. THIS DETAIL DIAGRAMS THE PREFERRED METHOD OF ESTABLISHING A SYSTEM GROUND AND BONDING POINTS WITHIN A TYPICAL DISTRIBUTION SYSTEM.

1 TYPICAL SYSTEM GROUND & BONDING DETAIL

SCALE: N.T.S.




DEMOLITION LEGEND	
	EXISTING CONSTRUCTION TO BE REMOVED. PATCH ALL SURFACES AFFECTED BY DEMOLITION WORK. COORDINATE EXTENT OF DEMOLITION WORK WITH PROPOSED CONSTRUCTION.
	EXISTING FLOOR SLAB TO BE SAWCUT TO ACCOMMODATE NEW UNDER SLAB UTILITIES AND MODIFICATIONS. REFER TO TYPICAL SAWCUT DETAIL FOR ADDITIONAL INFORMATION.

DEMOLITION AND REMOVAL NOTES:	
1	G.C. TO REMOVE AND DISPOSE OF EXISTING CMU PARTITION WALL AND TILE IN ITS ENTIRETY.
1A	EXISTING METAL STUD AND GYP. BD. PARTITION TO BE REMOVED IN ITS ENTIRETY BY G.C.; INCLUDING ANY/ALL DOORS, FRAMES, TRIM, VISION PANELS, MECHANICAL AND ELECTRICAL DEVICES, WALL FINISHES, ETC. - G.C. TO COORDINATE REMOVALS WITH ALL TRADES. REFER TO STRUCTURAL DRAWINGS FOR LOAD BEARING WALL LOCATIONS AND ASSOCIATED REQUIRED WORK SCOPE.
1B	G.C. TO REMOVE AND DISPOSE OF EXISTING POURED CONCRETE AND CMU PARTITION WALL AND TILE IN ITS ENTIRETY.
2	REMOVE AND DISPOSE OF EXISTING HUNG CEILINGS AND GRID IN ITS ENTIRETY TO ALLOW FOR NEW. G.C. SHALL REMOVE ALL LIGHTING. E.C. TO PROVIDE ALL DISCONNECTS.
3	REMOVE, STORE, AND REINSTALL EXISTING HUNG CEILING TILES AS REQUIRED FOR MECHANICAL WORK. EXISTING CEILING GRID TO REMAIN. G.C. TO COORDINATE WITH M.C.
4	G.C. SHALL REMOVE EXISTING TILE FLOOR AND BASE IN ITS ENTIRETY DOWN TO EXISTING CONCRETE SUBSTRATE. PATCH/REPAIR EXISTING CONCRETE SUBSTRATE AS REQUIRED FOR NEW FLOOR FINISH.
5	G.C. SHALL REMOVE AND DISPOSE OF EXISTING ABANDONED DUCTWORK. G.C. SHALL MAKE PENETRATIONS TO FIT NEW VENTILATION SYSTEM AND FINISH TO MATCH. PROVIDE LINTEL WHERE NEEDED.
6	P.C. SHALL REMOVE AND DISPOSE OF EXISTING PLUMBING FIXTURES. REMOVE CARRIERS AND PLUMBING AS NEEDED. COORDINATE WITH PLUMBING DRAWINGS AND NEW CONSTRUCTION PLANS.
6A	P.C. SHALL REMOVE AND RE-INSTALL OF EXISTING PLUMBING FIXTURES. RELOCATE CARRIERS AND PLUMBING AS NEEDED. COORDINATE WITH PLUMBING DRAWINGS AND NEW CONSTRUCTION PLANS.
7	G.C. SHALL REMOVE AND DISPOSE OF EXISTING WINDOWS, HARDWARE AND FRAMES IN THEIR ENTIRETY. PREP/PATCH WALL OPENING FOR NEW WALL INFILL.
8	G.C. SHALL REMOVE EXISTING DOOR/FRAME/HARDWARE IN ITS ENTIRETY.
9	G.C. SHALL REMOVE AND DISPOSE OF EXISTING TOILET ROOM PARTITION STALLS.
10	P.C. SHALL REMOVE AND DISPOSE OF EXISTING WATER CLOSETS IN ITS ENTIRETY.
11	P.C. SHALL REMOVE AND DISPOSE OF EXISTING SINKS AND CARRIERS AND PLUMBING.
12	G.C. SHALL REMOVE AND DISPOSE OF EXISTING COUNTERTOP.
13	G.C. SHALL REMOVE AND DISPOSE EXISTING RECESSED TRASH BIN
14	G.C. SHALL REMOVE, SALVAGE AND RE-INSTALL EXISTING DOOR AND HARDWARE. EXISTING METAL FRAME TO REMAIN, PATCH AND REPAIR AS NEED, AND PAINT.


REV.	DATE	ITEM
1	11/28/2022	ADDENDUM # 1

**NOTICE**


THESE DRAWINGS ARE BASED ON CONSTRUCTION DRAWINGS NOT PREPARED BY BBS ARCHITECTS, LANDSCAPE ARCHITECTS AND ENGINEERS, P.C. AND THEREFORE, MAY NOT REPRESENT THE CONDITIONS AS CONSTRUCTED AT THE TIME. ALL EXISTING CONDITIONS SHOWN ARE REPRESENTED, AS SUGGESTIVE INFORMATION AS THEY MAY NOT HAVE BEEN BUILT AND DETAIL FOR THE ORIGINAL DOCUMENTS OR FOR THE OWNER'S INFORMATION.

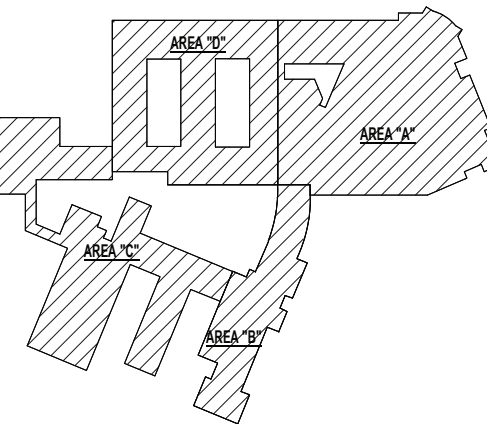


KEY PLAN  
NO SCALE

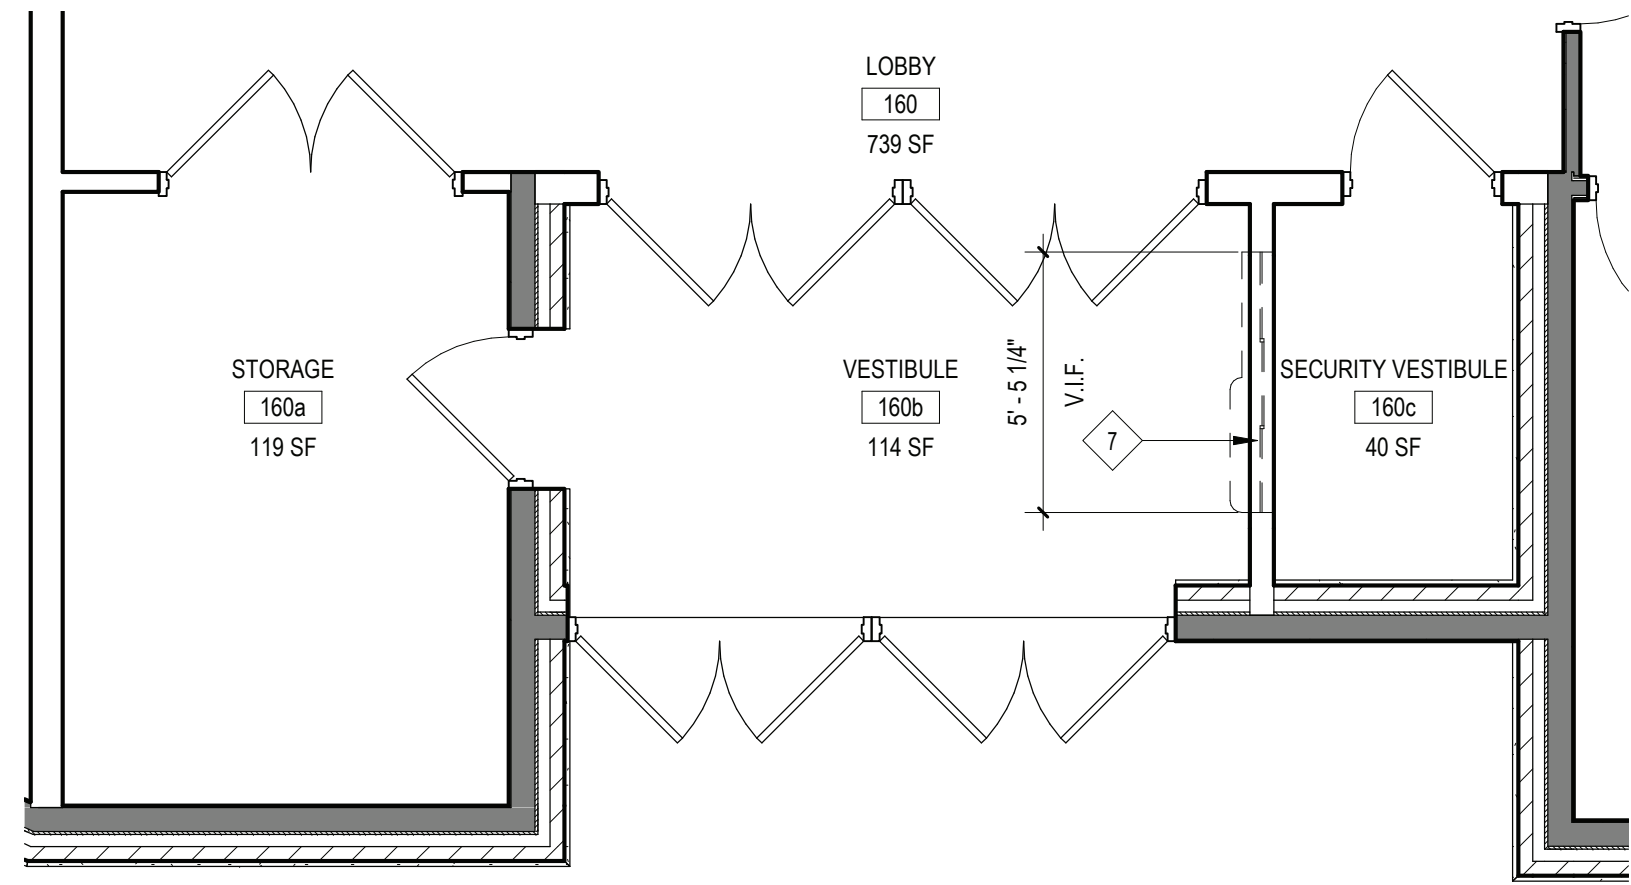


4 DEMO PLAN @ MAIN SECURITY VESTIBULE  
SCALE: 1/4" = 1'-0"

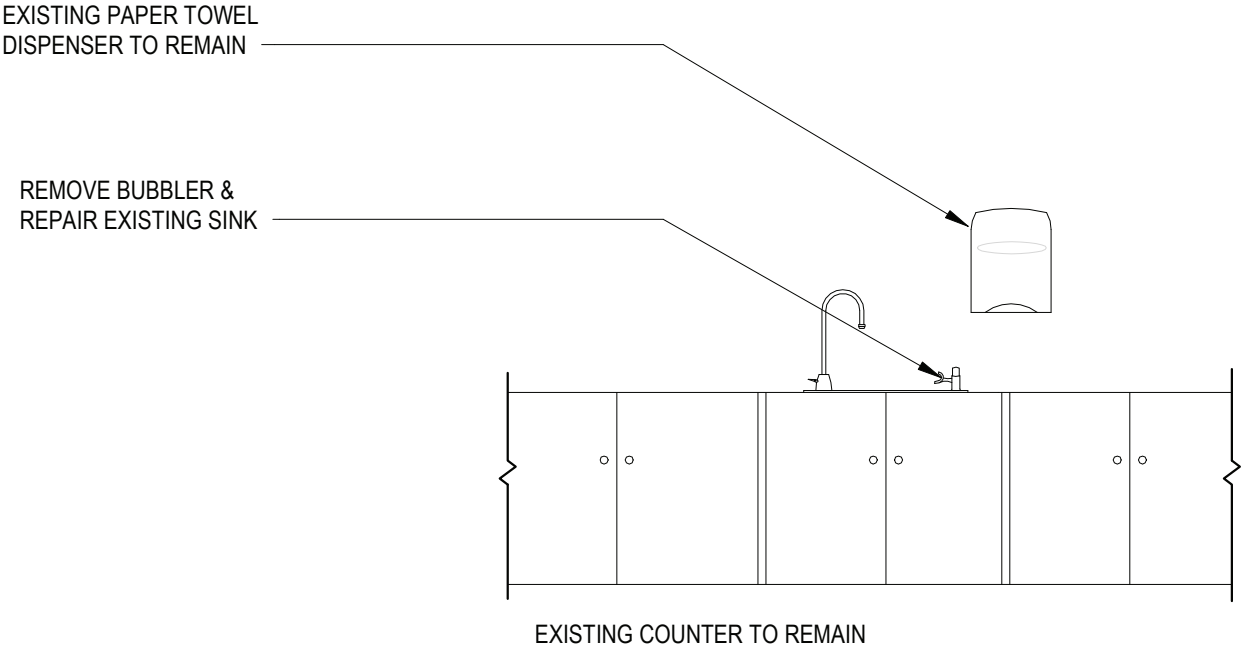


6 EXISTING ELEVATION @ 217 SINK  
SCALE: 1/2" = 1'-0"

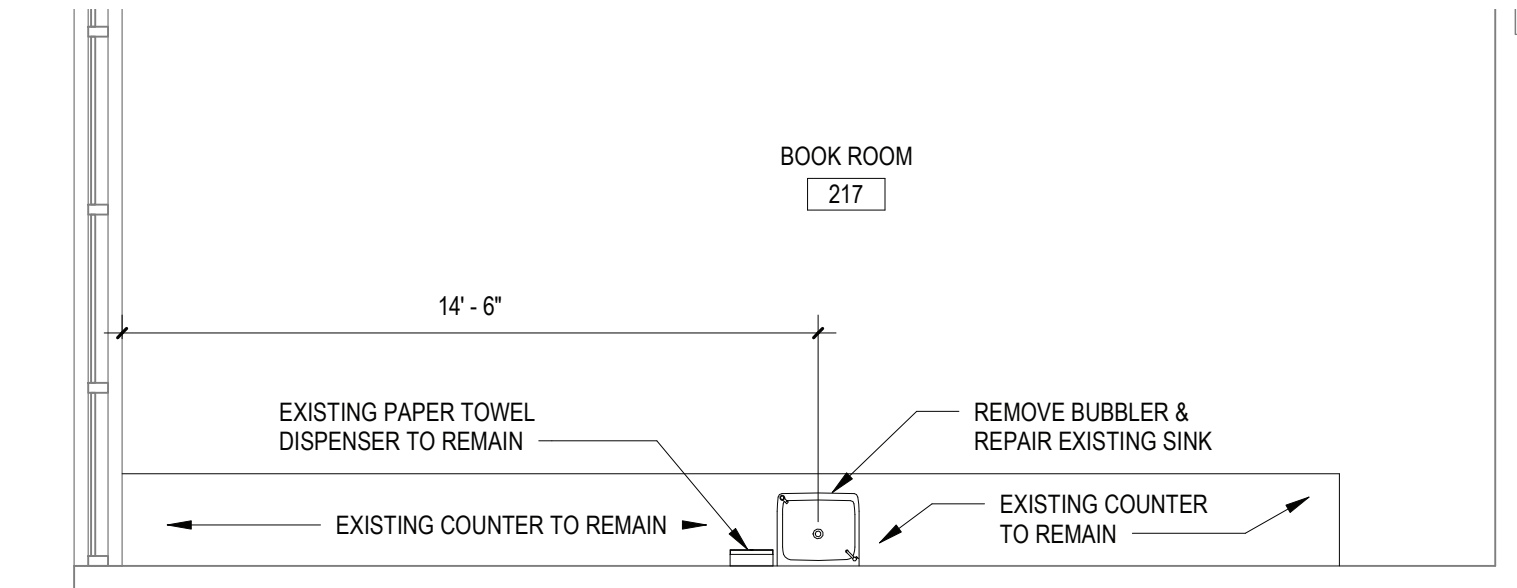


5 DEMO PLAN @ BOOK ROOM 217  
SCALE: 1/4" = 1'-0"

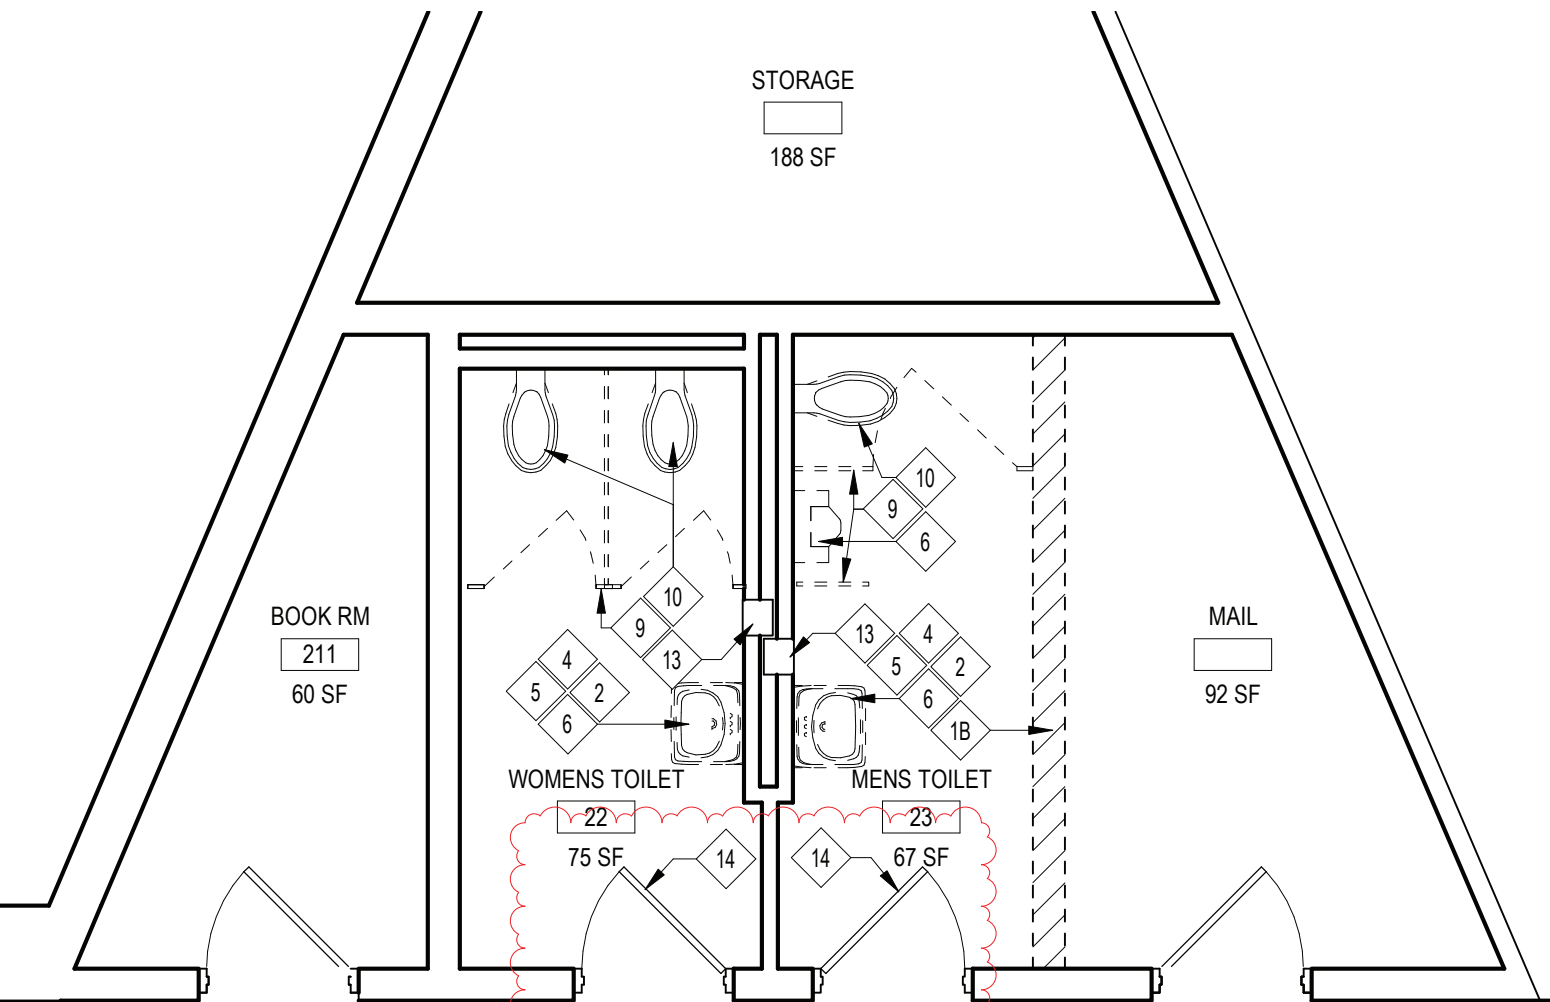

3 DEMO PLAN @ TOILET ROOMS 22 & 23  
SCALE: 1/4" = 1'-0"

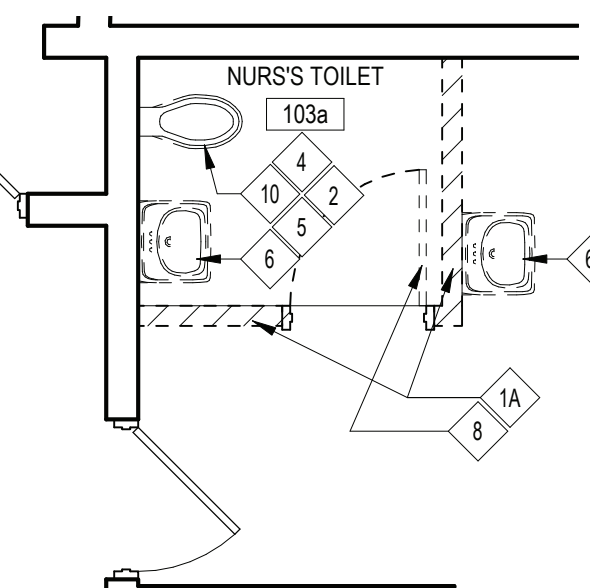

2 DEMO PLAN @ NURSES BATHROOM  
SCALE: 1/4" = 1'-0"

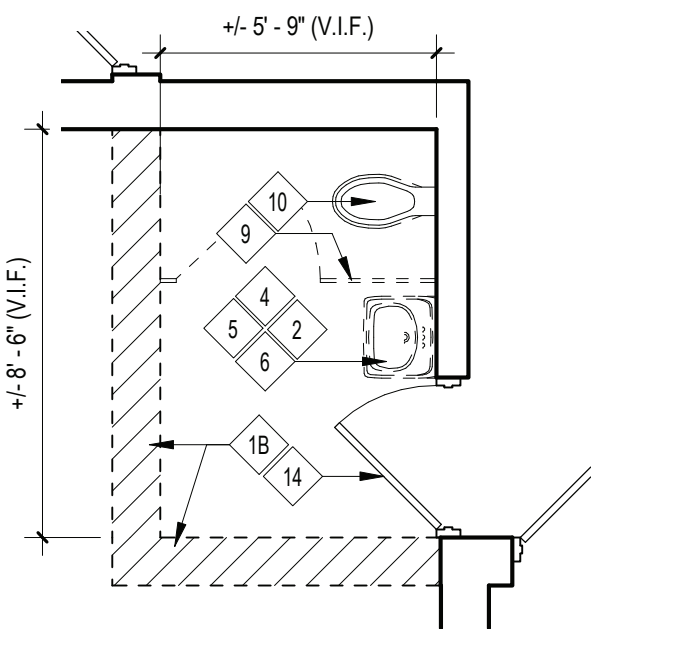

1 DEMO PLAN TOILET ROOM 43  
SCALE: 1/4" = 1'-0"

BRIARCLIFF MANOR U.F.S.D.  
PHASE 2 BOND IMPROVEMENTS  
TODD ELEMENTARY SCHOOL  
45 INGHAM ROAD, BRIARCLIFF MANOR, NY 10510

PROJECT  
DWG TITLE

DRWG. BY: R.K.  
CHK. BY: G.E.O.

THIS DRAWING, PREPARED FOR THE SPECIFIC PROJECT INDICATED IN AN INSTRUMENT OF SERVICE AND THE PROPERTY OF BBS ARCHITECTS, LANDSCAPE ARCHITECTS AND ENGINEERS, P.C., IS NOT TO BE REPRODUCED OR USED IN ANY MANNER FOR ANY OTHER PROJECT WITHOUT THE WRITTEN CONSENT OF BBS ARCHITECTS, LANDSCAPE ARCHITECTS AND ENGINEERS, P.C.

**BBS**  
ARCHITECTS  
LANDSCAPE ARCHITECTS  
ENGINEERS

BRANCH PROJECT CONTACT  
187 WOLF ROAD, STE. 205  
ALBANY, NEW YORK 12205  
T: 518.621.7650

244 EAST MAIN STREET  
PATCHOGUE, NEW YORK 11772  
T: 631.475.0349  
F: 631.475.0361

www.bbsarchitecture.com

SER. NO. 66-14-02-02-0-002-021

DISTRICT BRIARCLIFF MANOR U.F.S.D.

PROJECT PHASE 2 BOND IMPROVEMENTS

DWG TITLE DEMO PLAN RESTROOM AND VESTIBULE

SCALE: AS NOTED


DATE: 11/28/2022

BID PAU DATE: 11/28/2022

FILE NO. 21-274D

A1.01 TES



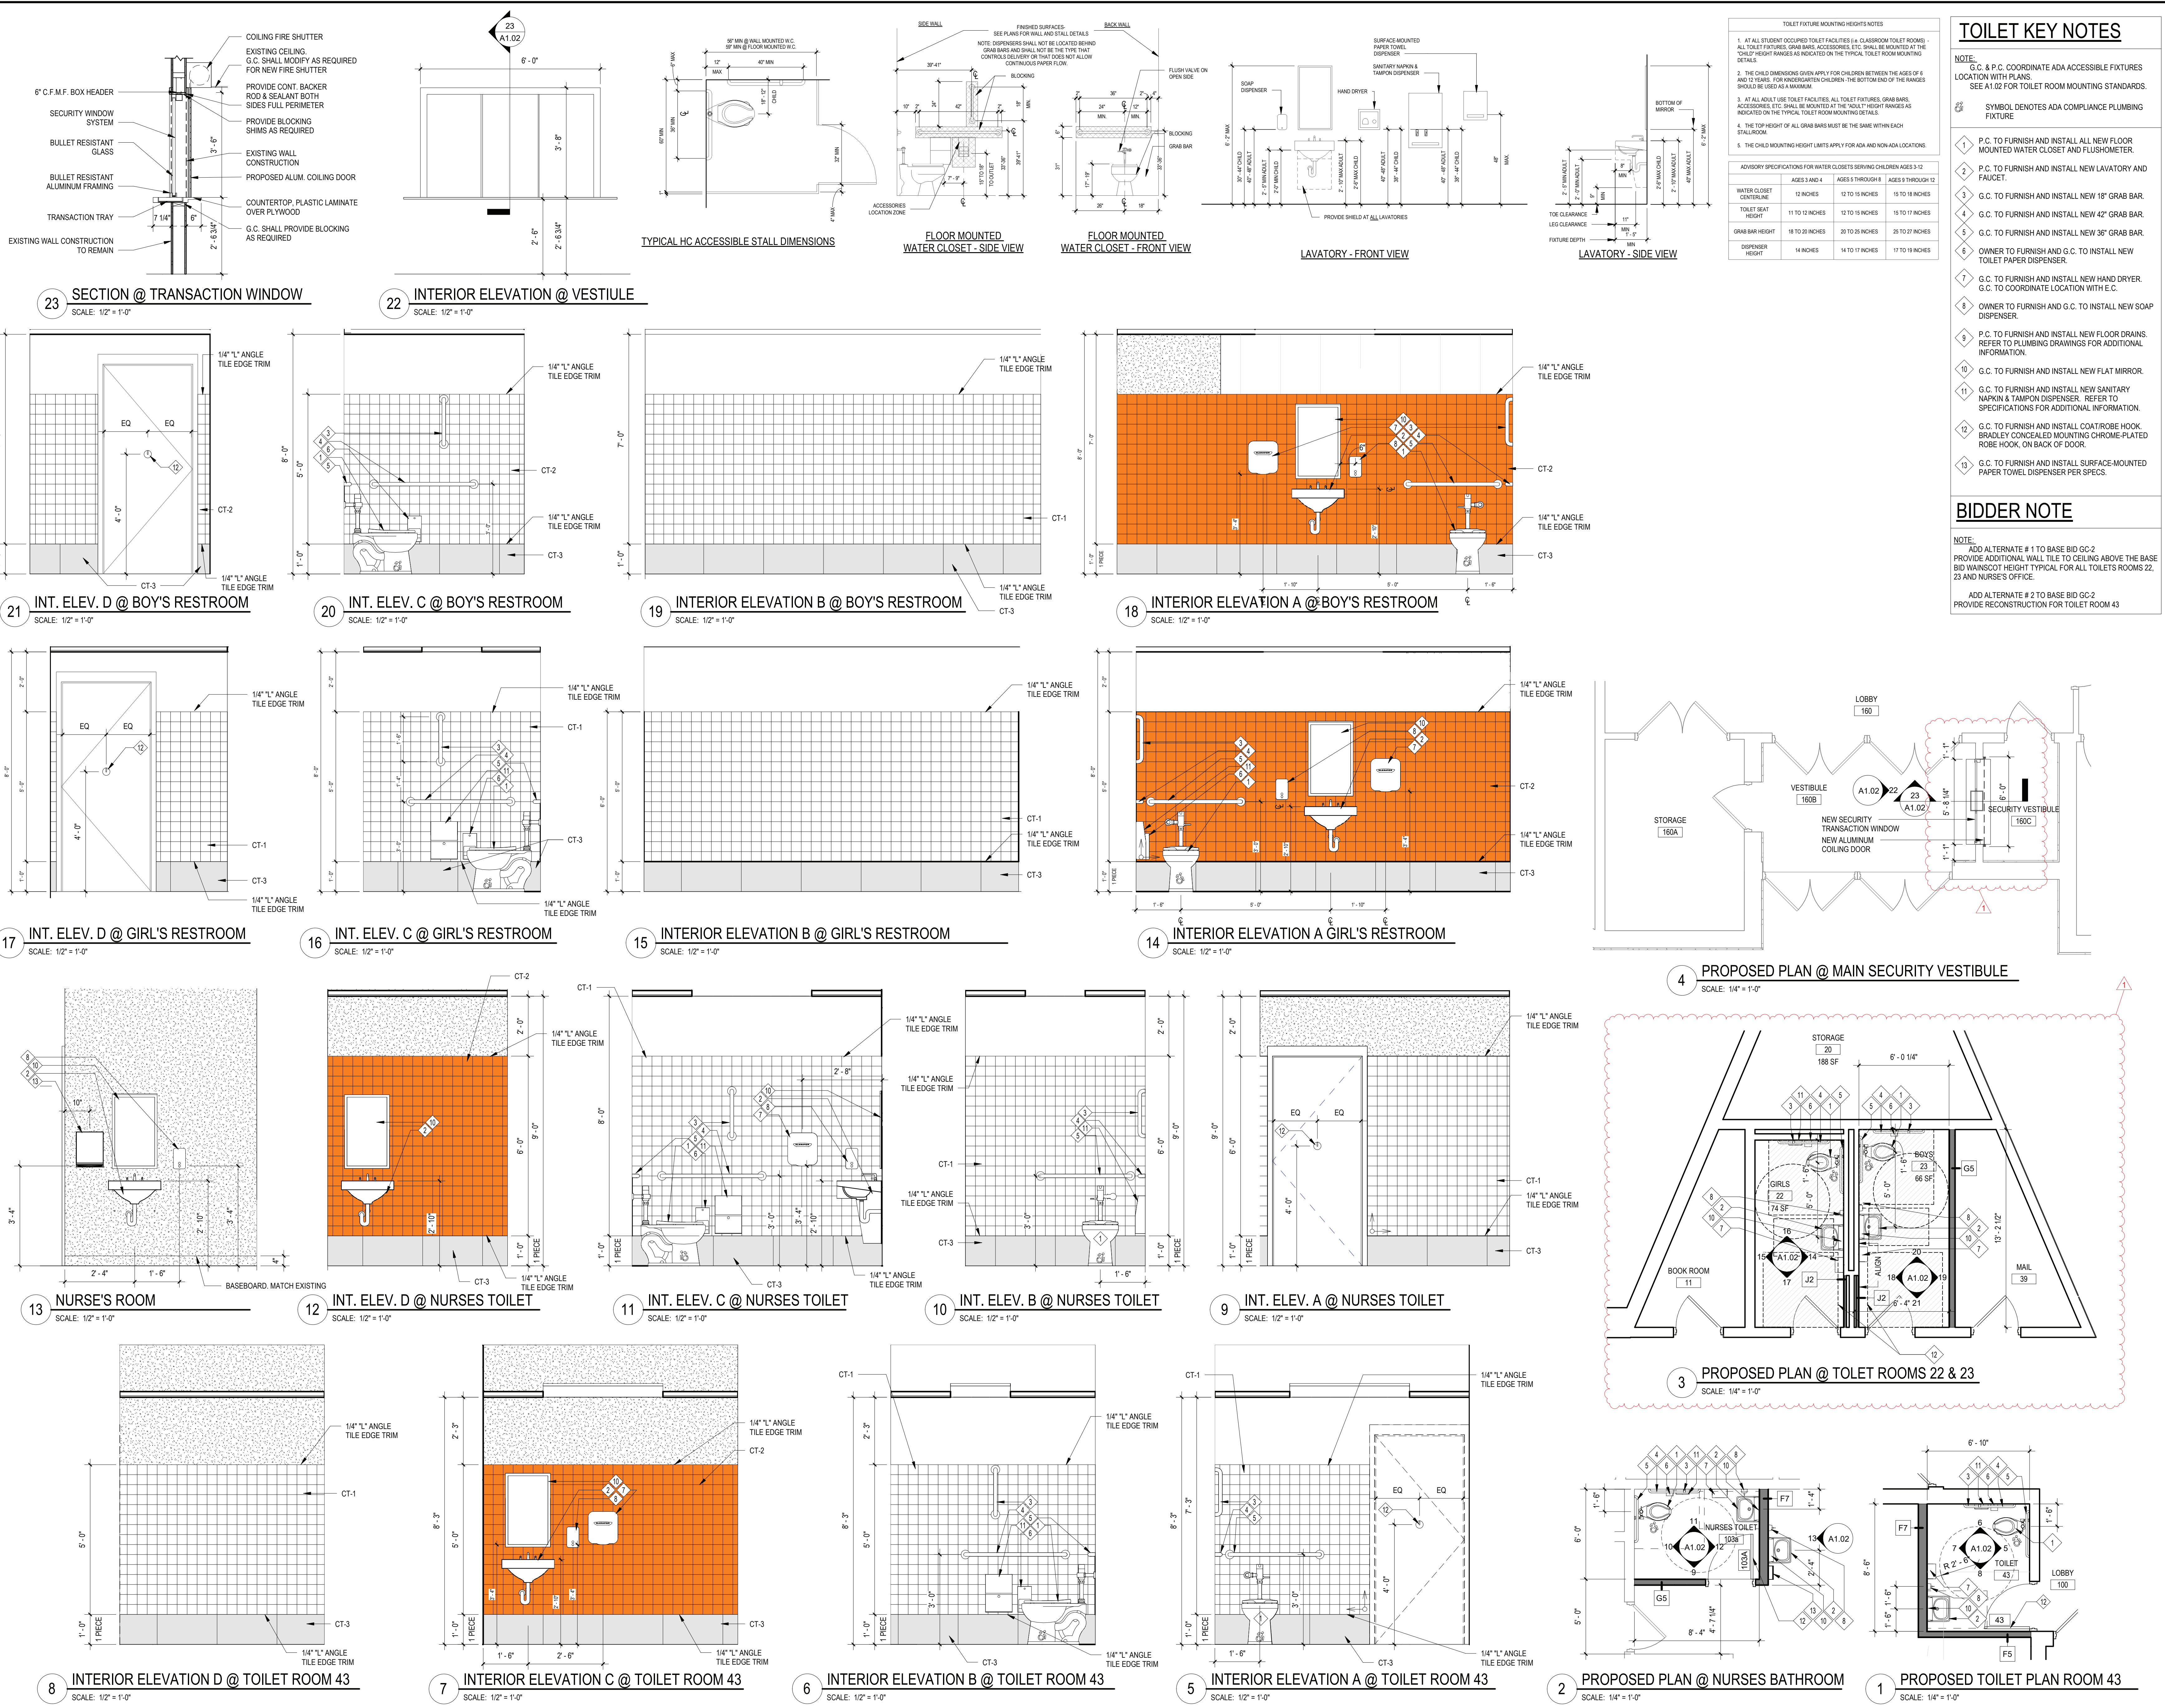

REV.	DATE	ITEM
1	11/28/2022	ADDENDUM # 1

**NOTICE**

THESE DRAWINGS ARE BASED ON CONSTRUCTION DRAWINGS NOT PREPARED BY BBS ARCHITECTS, LANDSCAPE ARCHITECTS AND ENGINEERS, P.C. AND THEREFORE, MAY NOT REPRESENT THE CONDITIONS AS CONSTRUCTED AT THE TIME. ALL EXISTING CONDITIONS AS SHOWN ARE REPRESENTED AS SUGGESTIVE INFORMATION AS THEY MAY NOT HAVE BEEN BUILT AND REPRODUCED FOR THE ORIGINAL DOCUMENTS OF THE OWNER'S INFORMATION.

**PROJECT**  
BRIARCLIFF MANOR U.F.S.D.  
PHASE 2 BOND IMPROVEMENTS  
TODD ELEMENTARY SCHOOL  
45 INGHAM ROAD, BRIARCLIFF MANOR, NY 10510

**DWG TITLE**  
PROPOSED RESTROOMS AND VESTIBULE

**DRWG. BY:** R.K.  
**CHK. BY:** G.E.O.

THIS DRAWING, PREPARED FOR THE SPECIFIC PROJECT INDICATED IN AN INSTRUMENT OF SERVICE AND THE PROPERTY OF BBS ARCHITECTS, LANDSCAPE ARCHITECTS AND ENGINEERS, P.C., IS NOT TO BE REPRODUCED OR USED FOR ANY OTHER PROJECT WITHOUT THE WRITTEN CONSENT OF BBS ARCHITECTS, LANDSCAPE ARCHITECTS AND ENGINEERS, P.C.

**BBS**  
ARCHITECTS  
LANDSCAPE ARCHITECTS  
ENGINEERS

BRANCH PROJECT CONTACT: 244 EAST MAIN STREET  
187 WOLF ROAD, STE. 205  
ALBANY, NEW YORK 12205  
T: 518.621.7650 F: 518.475.0349

www.bbsarchitecture.com

**SED. NO.** 66-14-02-02-002-021

**DISTRICT** BRIARCLIFF MANOR U.F.S.D.

**PROJECT** PHASE 2 BOND IMPROVEMENTS

**DWG TITLE** PROPOSED RESTROOMS AND VESTIBULE

**SCALE:** AS NOTED

**DATE:** 11/28/2022

**BID PAU DATE:** 11/28/2022

**FILE NO.** 21-274D

**A1.02** **TES**




ABBREVIATIONS:											
ACT.....	ACOUSTIC CEILING TILE			CWT.....	CERAMIC WALL TILE			MS.....	MARBLE SADDLE (ADA)		
CPT.....	CARPET			EPOXY.....	EPOXY TERRAZZO			NA.....	NOT APPLICABLE		
C.M.U.....	CONCRETE MASONRY UNIT			GTW.....	GLAZED TILE WAINSCOT			NIC.....	NOT IN CONTRACT		
CONC.....	CONCRETE			GYP.....	GYPSUM BOARD			PCB.....	PORCELAIN TILE COVE BASE		
PFT.....	PORCELAIN FLOOR TILE			RT.....	RUBBER TILE			VINYL.....	SLIP-RESISTANT FLOORING		
PLAST.....	PLASTER			TERR.....	TERRAZZO			WD.....	WOOD		
RB.....	RUBBER COVE BASE			VCT.....	VINYL COMPOSITION TILE			WM.....	WALK OFF MAT		
RF.....	RUBBER FLOORING			VET.....	VINYL ENHANCED TILE						

DOOR SCHEDULE - TODD ELEMENTARY SCHOOL PH2																						
	LOCATION		SIGNAGE	DOOR							FRAME			HARDWARE	DETAILS				FIRE RATING	REMARKS	DOOR NO.	
	FROM ROOM	TO ROOM		LEAF	WIDTH	HEIGHT	THICKNESS	TYPE	MATERIAL	GLAZING	TYPE	MATERIAL	GLAZING		HEAD	JAMB	SILL	THOLD				
43	LOBBY (100)	TOILET (43)	D2	1	3'-0"	7'-0"	1 3/4"	D1	WD				02	H4	J4							43
103A	NURSE (103)	NURSES TOILET (103a)	D2	1	3'-0"	7'-0"	1 3/4"	D1	WD	---			02	H4	J4							103A

G.C. TO PROVIDE AND INSTALL C2 SIGNAGES FOR ROOMS 22 AND 23

FINISH SCHEDULE										
RM. NO.	LOCATION	FLOOR		BASE		WALLS		CEILING	REMARKS	
		MATERIAL	FINISH	MATERIAL	FINISH	MATERIAL	FINISH			
	GIRLS	VCT1	VCT1	RUBBER BASE	RCB2	CERAMIC TILE/PAINTED	CT3	ACT1		
	BOYS	VCT1	VCT1	RUBBER BASE	RCB2	CERAMIC TILE/PAINTED	CT3	ACT1		
	NURSE (103)	VCT1	VCT1	RUBBER BASE	RCB2	CERAMIC TILE/PAINTED	CT3	ACT1		
	NEAR ROOM 125	VCT1	VCT1	RUBBER BASE	RCB2	CERAMIC TILE/PAINTED	CT3	ACT1		

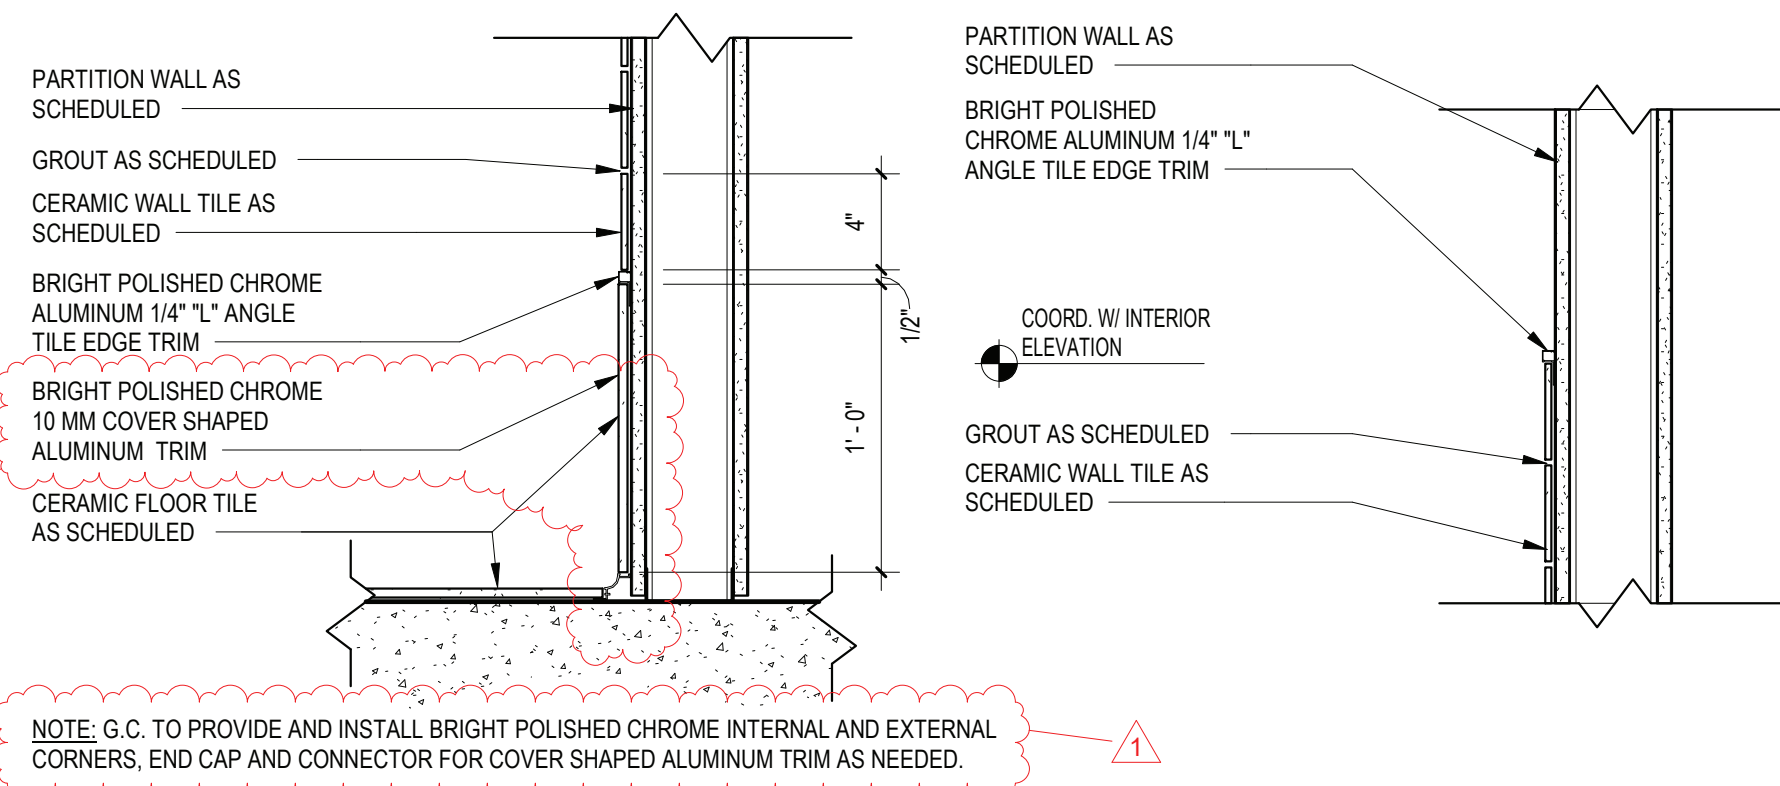

1 TILE TRIM DETAIL  
SCALE: 1 1/2" = 1'-0"

- ### FINISH NOTES
- ALL FINISH TYPES (STYLE/COLOR/PATTERN) SHALL CONFORM TO THE STANDARD OF QUALITY INDICATED BY THE PROJECT MANUAL. FINAL STYLE/COLOR/PATTERN TO BE SELECTED BY ARCHITECT.
  - ALL CMU SURFACES SHALL BE PRIMED WITH INTERIOR & EXTERIOR BLOCK FILLER M88 INDUSTRIAL MAINTENANCE BY BENJAMIN MOORE. PRIOR TO FINISH PAINT APPLICATION.
  - ALL WINDOWS IN AREA OF WORK ARE TO HAVE NEW SHADES OR BLINDS SUPPLIED AND INSTALLED BY GC. (1) PER WINDOW UNIT. G.C. SHALL SUBMIT SHOP DRAWINGS FOR APPROVAL.
  - NEW AND EXISTING DOOR FRAMES ASSOCIATED IN SCOPE OF WORK SHALL BE PREPPED AND PAINTED WITH BENJAMIN MOORE LATEX SEMI-GLOSS PAINT BY GC. COLOR AS SELECTED BY ARCHITECT.
  - REFER TO FLOOR PLANS FOR TILE PATTERNS.
  - G.C. SHALL PREP/PRIME AND PAINT ALL SHEET METAL PIPE ENCLOSURES (INSTALLED BY MC). COLOR AS SELECTED BY ARCHITECT.
  - BEFORE PAINTING, CONCRETE SURFACES MUST CURE 30 DAYS. BLOCK AND PLASTER SURFACES MUST CURE FOR 30 DAYS.
  - ALL NEW WOOD WINDOW SILLS, MOLDING AND TRIM SHALL RECEIVE A "STAINED" FINISH AND RECEIVE (3) COATS OF 'BENWOOD' POLYURETHANE FINISH LOW LUSTER NO. 436 BY 'BENJAMIN MOORE' OR APPROVED EQUAL. STAIN COLOR OR AS SELECTED BY ARCHITECT. GC SHALL SUBMIT PHYSICAL COLOR SAMPLE FOR REVIEW AND APPROVAL.
  - ALL FINISHES SHALL BE PROVIDED AND INSTALLED BY GC UNLESS OTHERWISE NOTED. REFER TO SPEC SECTION 09900 FOR ADDITIONAL INFORMATION.
  - ALL INTERIOR FINISHES IN CORRIDOR SHALL BE CLASS 'A' RATED.
  - PATCH, REPAIR AND FINISH CEILING, WALLS, AND FLOOR @ POINTS OF DEMOLITION TO MATCH EXISTING ADJACENT. EXISTING FINISHES TO REMAIN.
  - SHOULD ANY FINISH MATERIALS BE DISCONTINUED BY MANUFACTURER, GC MUST REPLACE WITH CLOSEST MATCH AT NO ADDITIONAL COST, AND SUBMIT TO ARCHITECT FOR APPROVAL PRIOR TO INSTALLATION.
  - REFER TO REFLECTED CEILING PLANS AND FINISH FLOOR PLANS FOR ADDITIONAL INFORMATION.
  - DOOR FRAMES TO BE PREPPED & PAINTED AS PER SPEC. COLOR AS SELECTED BY ARCHITECT.
  - G.C. SHALL PREP, PRIME & PAINT SHEETROCK CEILINGS UNLESS OTHERWISE NOTED FINISH AS PER SPEC. COLOR: WHITE. FLAT FINISH.
  - REFER TO FINISH FLOOR PLANS FOR TILE PATTERNS - THE TILE PATTERNS MAY NOT REPRESENT THE FINAL PATTERNS TO BE DESIGNED, INSTALLED & TURNED OVER TO OWNER. THE BID SHALL BE BASED ON THE TILE MIX & PERCENTAGES, AS INDICATED IN THE PROJECT MANUAL.
  - REFER TO REFLECTED CEILING PLANS, TOILET ROOM TILE PLANS, AND FINISHED FLOOR PLANS FOR ADDITIONAL FINISH INFORMATION.
  - GENERAL CONTRACTOR SHALL PERFORM A BOND TEST IN ACCORDANCE WITH MANUFACTURER'S SPECIFICATIONS PRIOR TO INSTALLATION OF NEW V.C.T. FLOORING.
  - CONTRACTOR SHALL INSTALL PATCH PLUS BY 'MAPEI' OR APPROVED EQUAL OVER SUBSTRATE AND/OR CONCRETE SLAB TO PROVIDE A FLOOR SURFACE IN ACCORDANCE WITH MANUFACTURER'S WRITTEN INSTRUCTIONS AND AS SPECIFIED FOR INSTALLATION OF NEW FINISH FLOOR MATERIALS.
- PRIME CONTRACTOR TO PROVIDE ALL REQUIRED SADDLES, THRESHOLDS, REDUCER STRIPS, TRANSITION STRIPS AND OR FLAT PLATES AS REQUIRED TO PROVIDE A FINISHED, ADA COMPLIANT TRANSITION AT NUMEROUS FLOORING TRANSITIONS AND TERMINATIONS.

- ### GYPSUM BOARD FINISHING
- GENERAL CONTRACTOR SHALL CONFORM TO THE REQUIREMENTS OF GYPSUM ASSOCIATION TRADE PUBLICATION GA-214-06 'RECOMMENDED LEVELS OF GYPSUM BOARD FINISH' & 3.106 OF SPECIFICATION SECTION 09250.
- LEVEL 0 - FOR USE IN TEMPORARY CONSTRUCTION, OR WHERE FINAL FINISH/DECORATION HAS NOT BEEN DETERMINED.
- LEVEL 1 - FOR USE AT PLENUM AREAS, ABOVE CEILING, IN ATTICS & IN AREAS WHERE THE ASSEMBLY WOULD GENERALLY BE CONCEALED OR IN BUILDING CORRIDORS & OTHER AREAS NOT NORMALLY OPEN TO THE PUBLIC VIEW.
- LEVEL 2 - FOR USE AT LOCATIONS WHERE WATER-RESISTANT GYPSUM BACKING BOARD IS INSTALLED AS A TILE SUBSTRATE AND FOR USE IN GARAGES, WAREHOUSE STORAGE OR OTHER SIMILAR AREAS WHERE SURFACE APPEARANCES ARE NOT OF PRIMARY CONCERN.
- LEVEL 3 - FOR USE IN APPEARANCE AREAS THAT ARE TO RECEIVE HEAVY OR MEDIUM TEXTURE FINISHES BEFORE FINAL PAINTING, OR WHERE HEAVY - GRADE WALL COVERINGS ARE TO BE APPLIED AS THE FINAL DECORATION.
- LEVEL 4 - FOR USE WHERE LIGHT TEXTURE OR WALL COVERINGS ARE TO BE APPLIED, OR WHERE ECONOMY IS OF THE ARCHITECT'S CONCERN.
- LEVEL 5 - FOR USE WHERE GLOSS, SEMI-GLOSS, ENAMEL OR NON-TEXTURED FLAT PAINTS ARE SPECIFIED, OR WHERE SEVERE LIGHTING CONDITIONS OCCUR (IN THE OPTION OF THE ARCHITECT.)

### WALL TYPES:

TYPE P1:	PAINT BY SHERWIN WILLIAMS LATEX EGGSHELL ENAMEL COLOR: AS SELECTED BY ARCHITECT	TYPE P2:	PAINT BY SHERWIN WILLIAMS LATEX EGGSHELL ENAMEL COLOR: AS SELECTED BY ARCHITECT
TYPE CT1:	4" X 4" CERAMIC WALL TILE MANUFACTURER: CREATIVE MATERIAL CO. COLLECTION: MOSA COLOR: 15THIRTY - 15010 - MATTE (WHITE MATTE) NOTE: GROUT FOR CT1 TO BE CUSTOM - #381 BRIGHT WHITE. SPACED AT 1/16" UNLESS OTHERWISE NOTED.	TYPE CT2:	4" X 4" CERAMIC WALL TILE MANUFACTURER: CREATIVE MATERIAL CO. COLLECTION: MOSA COLOR: 17980 - GLOSSY (ORANGE) NOTE: GROUT FOR CT1 TO BE CUSTOM - #381 BRIGHT WHITE. SPACED AT 1/16" UNLESS OTHERWISE NOTED.
TYPE CT3:	12" X 3/4" CERAMIC FLOOR TILE MANUFACTURER: CREATIVE MATERIAL CO. COLLECTION: FRAMMENTO COLOR: BEIGE MACRO - NATURAL - RECTIFIED (BEIGE TERRAZZO) NOTE: GROUT FOR CT3 TO BE CUSTOM - #380 HAYSTACK. SPACED AT 1/16" UNLESS OTHERWISE NOTED.		

### RUBBER BASE TYPES:






TYPE RCB1:	RUBBER COVE BASE BY "JOHNSONITE" COLOR AS SELECTED BY ARCHITECT (CORRIDORS)	TYPE RCB2:	RUBBER COVE BASE BY "JOHNSONITE"
------------	--------------------------------------------------------------------------------	------------	----------------------------------

### CEILING TILE TYPES:

TYPE ACT1:	ACOUSTIC CEILING TILE BY "ARMSTRONG" SIZE: 24" X 24" X 3/4" STYLE: #1911 ULTIMA BEVELED REGULAR (CORRIDORS/CLASSROOMS/OFFICES)	TYPE ACT2:	ACOUSTIC CEILING TILE BY "ARMSTRONG" SIZE: 24" X 24" X 5/8" STYLE: # 770 CORTEGA SQUARE LAY-IN (STORAGE ROOMS/CUSTODIAL)
CEILING GRID: CEILING GRID BY "ARMSTRONG", 15/16" PRELUDE, WHITE, U.O.N. NOTE: ALL CEILING TILE & GRID TO BE WHITE UNLESS OTHERWISE NOTED.			

### FLOOR MATERIAL TYPES

TYPE VCT1:	12" X 12" VINYL COMPOSITION TILE MANUFACTURER: ARMSTRONG EXCELON IMPERIAL COLOR: AS SELECTED BY ARCHITECT (CLASSROOMS, CORRIDOR)	TYPE CT4:	12" X 24" CERAMIC FLOOR TILE MANUFACTURER: CREATIVE MATERIAL CO. COLLECTION: FRAMMENTO COLOR: BEIGE MACRO - NATURAL - RECTIFIED (BEIGE TERRAZZO) NOTE: ALL GROUT FOR FLOORS TO BE CUSTOM - #380 HAYSTACK. SPACED AT 1/16" UNLESS OTHERWISE NOTED.
------------	----------------------------------------------------------------------------------------------------------------------------------------	-----------	---------------------------------------------------------------------------------------------------------------------------------------------------------------------------------------------------------------------------------------------------------------

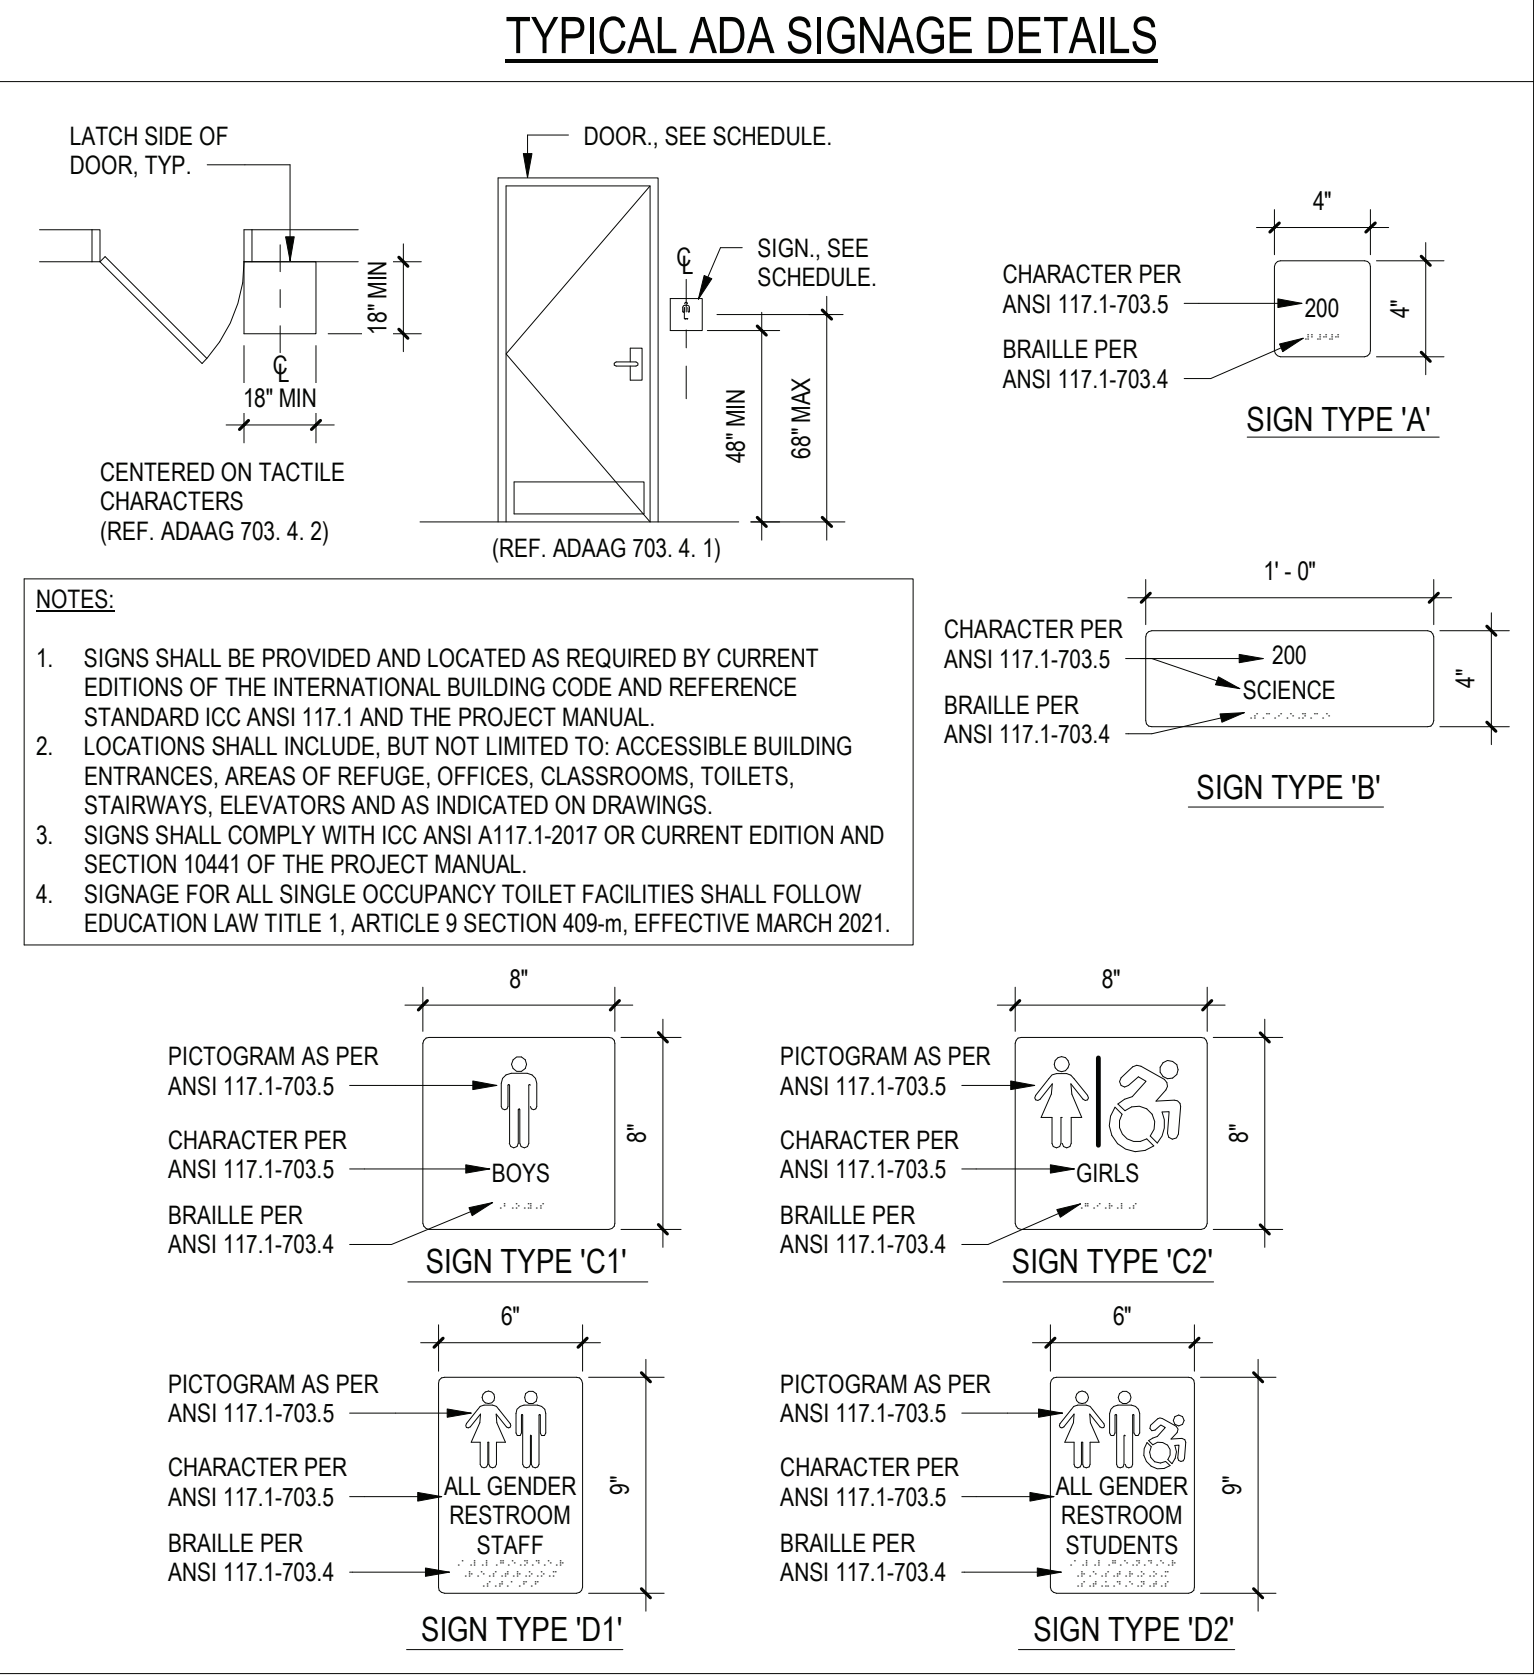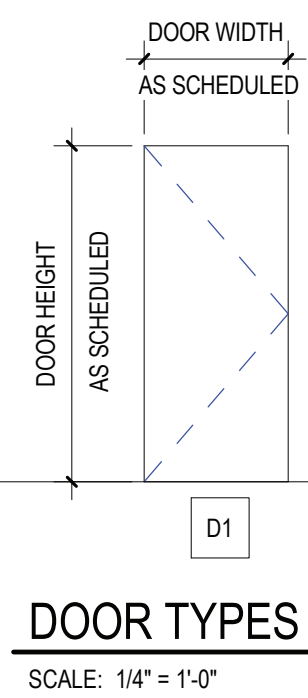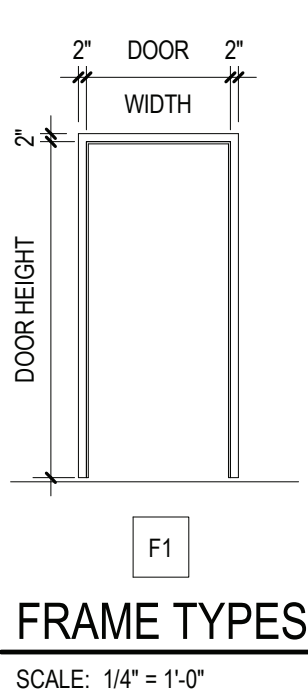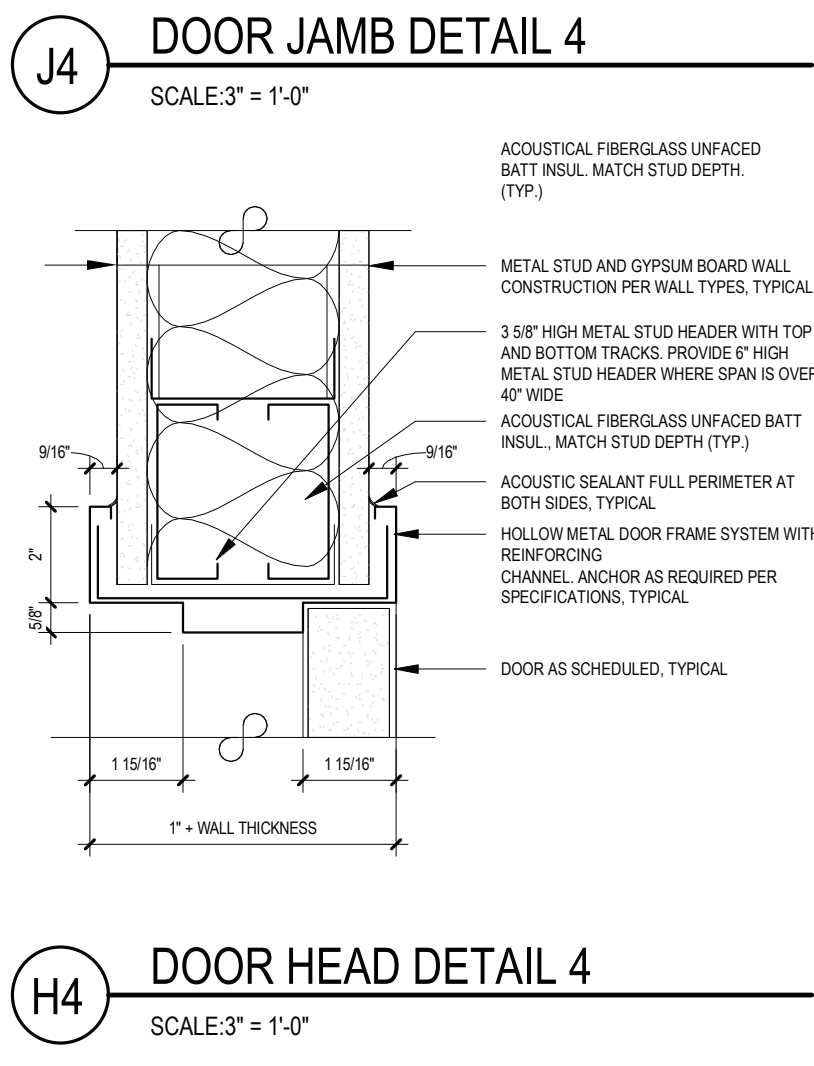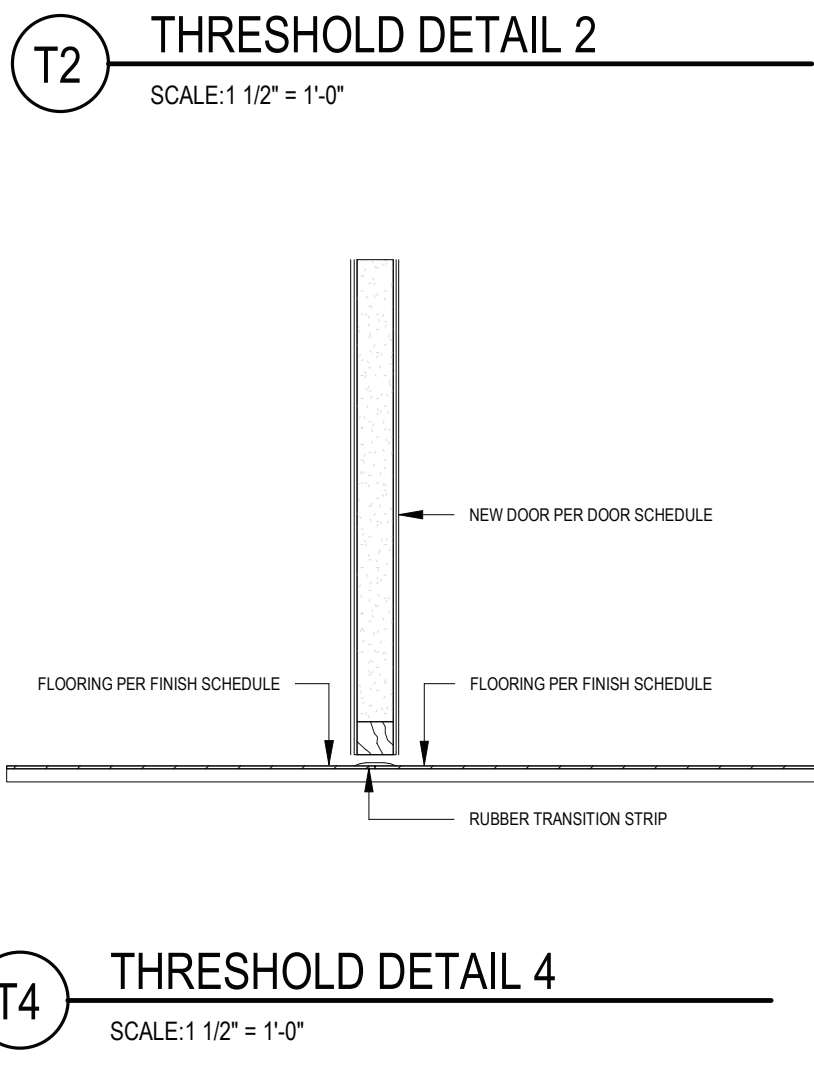

REV.	DATE	ITEM
	11/28/2022	ADDENDUM # 1
NOTICE		
THESE DRAWINGS ARE BASED ON CONSTRUCTION DRAWINGS NOT PREPARED BY BBS ARCHITECTS, LANDSCAPE ARCHITECTS AND ENGINEERS, P.C. AND THEREFORE, MAY NOT REPRESENT THE CONDITIONS AS CONSTRUCTED AT THE TIME. ALL EXISTING CONDITIONS AS SHOWN ARE REPRESENTED, AS SUGGESTIVE INFORMATION AS THEY MAY NOT HAVE BEEN BUILT AND STAINED PER THE ORIGINAL DOCUMENTS OR PER THE OWNER'S INFORMATION.		
PROJECT		
BRIARCLIFF MANOR U.F.S.D. PHASE 2 BOND IMPROVEMENTS TODD ELEMENTARY SCHOOL 45 INGHAM ROAD, BRIARCLIFF MANOR, NY 10510		
DWG/STILE		
DRWG. BY: R.K. CHK. BY: G.E.O.		
THIS DRAWING, PREPARED FOR THE SPECIFIC PROJECT INDICATED IS AN INSTRUMENT OF SERVICE AND THE PROPERTY OF BBS ARCHITECTS, LANDSCAPE ARCHITECTS AND ENGINEERS, P.C. REPRODUCTION OR ANY USE OF THIS DRAWING FOR ANY OTHER PROJECT IS PROHIBITED. ANY ALTERATION OR REPRODUCTION OF THIS DOCUMENT IS ALSO PROHIBITED WITHOUT THE WRITTEN CONSENT OF THE ARCHITECT OR ENGINEER.		
BBS ARCHITECTS LANDSCAPE ARCHITECTS ENGINEERS		
BRANCH PROJECT CONTACT: 244 EAST MAIN STREET 187 WOLF ROAD, STE. 205 PATCHOGUE, NEW YORK 11772 NEW YORK 12205 T. 631.475.0349 T. 516.621.7650 F. 631.475.0361 www.bbsarchitecture.com		
SED NO. 66-14-02-02-0-002-021		
DISTRICT: BRIARCLIFF MANOR U.F.S.D.		
PROJECT: PHASE 2 BOND IMPROVEMENTS		
DWG TITLE: DOOR SCHEDULE, FINISH SCHEDULE AND DETAILS		
SCALE: AS NOTED		
DATE: 12/1/2022		
BID PAU DATE: 12/15/25 PM		
FILE NO.: 21-274D		
A8.01		TES



SYMBOL LEGEND	
	ROOM TAG, CEILING TILE TYPE and FINISH CEILING ELEVATION (ABOVE FINISH FLOOR)
	OPEN TO STRUCTURE AND DECK ABOVE - PAINT (G.C.)
	NEW SUSPENDED ACOUSTICAL CEILING AND GRID - SEE FINISH SCHEDULE (G.C.)
	EXISTING SUSPENDED ACOUSTICAL CEILING AND GRID
	GYPSUM BOARD SOFFIT OVER METAL FRAMING - TAPE, SPACKLE & PAINT (G.C.)
	RECESSED OR SURFACE MOUNTED LIGHT FIXTURE BY E.C. REFER TO ELECTRICAL DRAWINGS FOR INFO. (E.C.)
	EXIT SIGN. REFER TO ELECTRICAL DWGS. FOR ADDITIONAL INFO. (E.C.)
	CEILING MOUNTED SPEAKER. REFER TO ELECTRICAL DWGS. FOR ADDITIONAL INFO. (E.C.)
	SMOKE/HEAT DETECTORS. REFER TO ELECTRICAL DWGS. FOR ADDITIONAL INFO. (E.C.)
	OCCUPANCY SENSOR. REFER TO ELECTRICAL DWGS. FOR ADDITIONAL INFO. (E.C.)
	CEILING GRILLE/REGISTER. REFER TO MECHANICAL DWGS. FOR ADDITIONAL INFO (M.C.)
	16" x 16" ACCESS PANEL

TYPICAL REFLECTED CEILING NOTES	
1.	CEILING PLANS MAY NOT INDICATE ALL MECHANICAL AND/OR ELECTRICAL CEILING ITEMS. REFER TO ELECTRICAL & MECHANICAL DRAWINGS FOR ADD'L INFO.
2.	ALL FIXTURES SHALL BE CENTERED WITHIN THE GRID, U.O.N.
3.	SUPPORT OF ALL ARCHITECTURAL COMPONENTS (I.E. HUNG CEILING SYSTEMS, GRIDS, ETC.) SHALL BE INSTALLED TO WITHSTAND SEISMIC LOADS IN ACCORDANCE WITH THE IBC SECTION 1621, FOR SEISMIC DESIGN CATEGORY 'B' AND IMPORTANCE FACTOR 1.0. BASED UPON THE ABOVE, NO SPECIFIC SEISMIC RESTRAINTS ARE REQUIRED.
4.	ALL ACOUSTICAL HUNG CEILING GRID SYSTEMS SHALL BE INSTALLED IN CONFORMANCE WITH ASTM C636 "STANDARD PRACTICE FOR INSTALLATION OF METAL CEILING SUSPENSION SYSTEMS FOR ACOUSTICAL TILE AND LAY-IN PANELS" REQUIREMENTS.
5.	ACOUSTICAL CEILINGS SHALL HAVE A FLAME SPREAD OF 25 OR LESS COMPLYING WITH ASTM E-84; SMOKE DEVELOPED RATINGS OF 50 OR LESS COMPLYING WITH PERFORMANCE REQUIREMENTS AND PHYSICAL CHARACTERISTICS OF THE SPECIFIED CEILINGS AS INDICATED IN THE REFLECTED CEILING PLAN. (ASTM E-1284)
6.	ACOUSTICAL CEILINGS SHALL HAVE A MINIMUM NOISE REDUCTION COEFFICIENT (NRC) RATING OF 0.65.
7.	ALL LIGHTING FIXTURES REMAIN EXCEPT WHERE NOTED. ELECTRICAL CONTRACTOR TO DE-ENERGIZE DURING DEMOLITION AND INSTALLATION OF NEW CEILING. ELECTRICAL CONTRACTOR TO RE-INSTALL ALL OTHER ELECTRICAL DEVICES (SPEAKERS, SMOKE DETECTORS, FIRE ALARM STROBES, ETC.) WHETHER NOTED ON PLAN OR NOT. REFER TO ELECTRICAL DRAWINGS FOR ADD'L INFO.
8.	CEILING GRID SHALL BE ARRANGED TO BE SPACED EQUALLY IN EACH DIRECTION W/ NO TILE LESS THAN 6" UNLESS OTHERWISE REQUIRED.
9.	PROVIDE CEILING EXPANSION JOINT AT ALL NEW TO EXISTING INTERACTIONS AND WHERE INDICATED ON PLAN. REFER TO WALL SECTIONS AND SPECIFICATIONS.
10.	ALL AREAS NOTED AS 'OPEN' AND/OR 'NO CEILING (CLG)' SHALL BE PAINTED. (INCLUDING DECK, STRUCTURE, DUCTWORK, ETC.
11.	UNLESS OTHERWISE NOTED, ALL SOFFITS AND WINDOW POCKETS SHALL BE 5/8" TYPE 'X' GYP. BOARD OVER 18 GA. COLD FORMED FRAMING AT 16" O.C.

FIRE STOP/ACOUSTICAL SEALING NOTES	
1.	ALL PIPING PENETRATIONS THROUGH CORRIDOR WALLS AS WELL AS ALL FIRE RATED WALLS (SUCH AS STORAGE ROOMS, CLOSETS, BOILER ROOMS, ETC) AND ALL OTHER FIRE RATED FLOORS OR STRUCTURES SHALL BE FIRE STOPPED.
2.	ALL PENETRATIONS THROUGH ALL OTHER WALLS, FLOORS, ETC. (I.E. CLASSROOMS AND LIBRARIES) SHALL BE ACOUSTICALLY SEALED IN ACCORDANCE WITH ANSI S12.60-2002 REQUIREMENTS. THE SEALANT MATERIALS SHALL BE "SPEC-SEAL, SMOKE AND SOUND ACOUSTIC SEALANT" AS MANUFACTURED BY STI, OR ARCHITECT APPROVED EQUAL. SEALANT SHALL MEET ASTM C919 FOR SEALANTS IN ACOUSTICAL APPLICATIONS.
3.	THE FIRE STOP MATERIALS SHALL BE HILTI TYPE FS-657 FIRE BLOCK, FS-ONE SEALANT, CP-672 JOINT SPRAY, CP-601S ELASTOMERIC SEALANT, 6P-606 FLEXIBLE SEALANT, CP-643 OR CP-642 COLLAR, CP-616 PUTTY STICK, OR FS-635 TROWEL ABLE COMPOUND, AS SUITABLE.
4.	CONTRACTOR SHALL SUBMIT SHOP DRAWINGS OF PRODUCTS TO BE USED FOR APPROVAL BY ARCHITECT.
5.	FIRESTOP MATERIALS OTHER THAN HILTI SHALL INCLUDE FULL TECHNICAL DATA WITH SHOP DRAWINGS TO DEMONSTRATE EQUALITY WITH THE SPECIFIED FIRE STOPS.

REV.	DATE	ITEM
1	11/28/2022	ADDENDUM # 1

**NOTICE**

THESE DRAWINGS ARE BASED ON CONSTRUCTION DRAWINGS NOT PREPARED BY BBS ARCHITECTS, LANDSCAPE ARCHITECTS AND ENGINEERS, P.C. AND THEREFORE, MAY NOT REPRESENT THE CONDITIONS AS CONSTRUCTED AT THE TIME. ALL EXISTING CONDITIONS SHOWN ARE REPRESENTED, AS SUGGESTIVE INFORMATION AS THEY MAY NOT HAVE BEEN BUILT AND DETAINED PER THE ORIGINAL DOCUMENTS OR PER THE OWNER'S INFORMATION.

PROJECT	BRIARCLIFF MANOR U.F.S.D. PHASE 2 BOND IMPROVEMENTS TODD ELEMENTARY SCHOOL 45 INGHAM ROAD, BRIARCLIFF MANOR, NY 10510
	REFLECTED CEILING PLANS
DWG TITLE	

DRWG. BY:	R.K.
CHK. BY:	G.E.O.

THIS DRAWING, PREPARED FOR THE SPECIFIC PROJECT INDICATED IS AN INSTRUMENT OF SERVICE AND THE PROPERTY OF BBS ARCHITECTS, LANDSCAPE ARCHITECTS AND ENGINEERS, P.C. REPRISALMENT OR ANY USE OF THIS DRAWING FOR ANY OTHER PROJECT IS PROHIBITED. ANY ALTERATION OR REPRODUCTION OF THIS DOCUMENT IS ALSO PROHIBITED WITHOUT THE WRITTEN CONSENT OF THE ARCHITECT OR ENGINEER.

BBS

ARCHITECTS  
LANDSCAPE ARCHITECTS  
ENGINEERS

BRANCH PROJECT CONTACT  
187 WOLF ROAD, STE. 205  
ALBANY  
NEW YORK 12205  
T: 518.621.7650

244 EAST MAIN STREET  
PATCHOGUE  
NEW YORK 11772  
T: 631.475.0349  
F: 631.475.0361

www.bbsarchitecture.com

SED. NO.	66-14-02-02-0-002-021
DISTRICT	BRIARCLIFF MANOR U.F.S.D.
PROJECT	PHASE 2 BOND IMPROVEMENTS
DWG TITLE	REFLECTED CEILING PLANS
SCALE:	AS NOTED
DATE:	11/28/2022
BID PAU DATE:	11/22/26 AM
FILE NO.	21-274D

A10.01    TES

3 PROPOSED CEILING PLAN @ TOILET ROOM NEAR ROOM 125  
SCALE: 1/4" = 1'-0"

2 PROPOSED CEILING PLAN @ NURSES TOILET ROOM  
SCALE: 1/4" = 1'-0"

1 PROPOSED CEILING PLAN @ TOILET ROOMS 22 & 23  
SCALE: 1/4" = 1'-0"