

# UNIVENT REPLACEMENT AT HAVERSTRAW ELEMENTARY

**HAVERSTRAW ELEMENTARY SCHOOL**  
**16 Grant Street**  
**Haverstraw, NY 10927**  
**SED# 50-02-01-06-0-009-018**

**OWNER:**  
**NORTH ROCKLAND**  
**CENTRAL SCHOOL DISTRICT**  
**65 Chapel Street**  
**Garnerville, NY 10923**

**ARCHITECT:**  
**MICHAEL SHILALE ARCHITECTS, LLP**  
**140 Park Avenue**  
**New City, NY 10956**

**PME ENGINEER:**  
**GREENMAN-PEDERSON, INC.**  
**400 Rella Boulevard, Suite 207**  
**Montabello, NY 10901**

## GENERAL NOTES

1. ALL PLAN DIMENSIONS ARE NOMINAL U.O.N. DIMENSIONS TO THE FINISHED FACE OF AN ELEMENT OR WALL WILL BE DESIGNATED WITH AN "F" AS SHOWN.
2. G.C. TO VERIFY ALL DIMENSIONS IN THE FIELD AND IS TO NOTIFY ARCHITECT IF THERE ARE ANY DISCREPANCIES.

	CONCRETE MASONRY UNIT
	BRICK
	RIGID INSULATION
	CONCRETE
	GRAVEL OR STONE
	EARTH
	EIFS
	ASPHALT PAVING
	SAND/MORTAR/GYPSUM BOARD
	STEEL
	ACT
	ROUGH WOOD
	BRONZE

## MATERIALS LEGEND

	DOOR NUMBER
	KEY NOTE
	PARTITION TYPE
	REVISION NUMBER
	WINDOW TYPE
	MECHANICAL EQUIPMENT
	EXISTING PARTITION
	EXISTING PARTITION TO BE REMOVED
	NEW PARTITION (SEE PARTITION LEGEND A-101)
	NEW DOOR
	EXISTING DOOR
	EXISTING DOOR TO BE REMOVED
	EXISTING WINDOW
	NEW WINDOW
	ROOM NAME/NUMBER IDENTIFICATION
	DRAWING NUMBER/WALL SECTION/ELEVATION REFERENCE
	SHEET NUMBER
	DETAIL NUMBER/DETAIL REFERENCE
	SHEET NUMBER
	COLUMN LINE DESIGNATION

## SYMBOLS LEGEND

ALTERNATE NO. 1: WORK PHASING. PHASE A TO BE IN SUMMER OF 2022 AND PHASE B TO BE IN SUMMER OF 2023. SEE ARCHITECTURAL AND MECHANICAL FLOOR PLANS FOR PHASE A AND PHASE B LOCATIONS.

ALTERNATE NO. 2: WORK PHASING. PHASE A TO BE IN SUMMER OF 2022 AND PHASE B TO BE DURING FALL OF 2022 2ND SHIFT. SEE ARCHITECTURAL AND MECHANICAL FLOOR PLANS FOR PHASE A AND PHASE B LOCATIONS.

ALTERNATE NO. 3: PROVIDE NEW POWER SUPPLY TO UVS AS SHOWN ON E-101, E-102 AND E-103.

ALTERNATE NO. 4: GYPSUM LINE SET ENCLOSURES. LINE SET ENCLOSURES TO BE MADE OF GYPSUM INSTEAD OF WOOD AT ALL LOCATIONS. SEE DETAIL 4/A-503.

## ALTERNATES

DRAWING No.	DRAWING TITLE	DATE
A-000	COVER SHEET	02-17-22
B-100	CODE ANALYSIS	12-17-21
S-101	ROOF PLAN & GENERAL NOTES	12-17-21
S-102	ROOF PARTIAL PLANS	12-17-21
S-103	SECTIONS & TYPICAL DETAILS	12-17-21
S-104	SECTIONS & TYPICAL DETAILS S-2	12-17-21
D-101	FIRST FLOOR DEMO PLAN	12-17-21
D-102	SECOND FLOOR DEMO PLAN	12-17-21
D-103	THIRD FLOOR DEMO PLAN	12-17-21
D-104	ROOF DEMO PLAN	12-17-21
A-101	PROPOSED FIRST FLOOR PLAN	01-28-22
A-102	PROPOSED SECOND FLOOR PLAN	01-24-22
A-103	PROPOSED THIRD FLOOR PLAN	01-24-22
A-104	PROPOSED ROOF PLAN	12-17-21
A-400	REFLECTED CEILING PLAN	12-17-21
A-500	DETAILS	02-17-22
A-501	UNIT ELEVATIONS	12-17-21
A-501.1	UNIT ELEVATIONS	12-17-21
A-502	DETAILS	02-17-22
A-503	DETAILS	02-17-22
M-001	MECHANICAL NOTES	01-24-22
M-002	MECHANICAL SCHEDULES	02-17-22
M-003	MECHANICAL SCHEDULES 2	02-17-22
M-004	CONTROLS	02-17-22
M-005	VENTILATION SCHEDULE	12-17-21
M-006	UV SCHEDULE	02-17-22
M-061	HVAC DEMO FIRST FLOOR PLAN	01-24-22
M-062	HVAC DEMO SECOND FLOOR PLAN	01-24-22
M-063	HVAC DEMO THIRD FLOOR PLAN	01-24-22
M-101	FIRST FLOOR PLAN MECHANICAL	01-24-22
M-102	SECOND FLOOR PLAN MECHANICAL	01-24-22
M-103	THIRD FLOOR PLAN MECHANICAL	02-17-22
M-104	ROOF PLAN MECHANICAL	02-17-22
M-301	HVAC PIPING - 1ST FLOOR PLAN	12-17-21
M-302	HVAC PIPING - 2ND FLOOR PLAN	12-17-21
M-303	HVAC PIPING - 3RD FLOOR PLAN	02-17-22
M-401	VRF PIPING RISERS	12-17-21
M-501	MECHANICAL DETAILS	01-24-22
M-502	MECHANICAL DETAILS 2	12-17-21
FA-001	FIRE ALARM SYSTEM COVER SHEET	12-17-21
FA-101	THIRD FLOOR PLAN FIRE ALARM	12-17-21
FA-102	ROOF PLAN FIRE ALARM	12-17-21
E-001	ELECTRICAL COVER SHEET	12-17-21
E-060	BASEMENT DEMO PLAN ELECTRICAL	01-28-22
E-061	FIRST FLOOR ELECTRICAL DEMO PLAN	12-17-21
E-062	SECOND FLOOR ELECTRICAL DEMO PLAN	12-17-21
E-063	THIRD FLOOR ELECTRICAL DEMO PLAN	12-17-21
E-100	BASEMENT PLAN ELECTRICAL	01-28-22
E-101	FIRST FLOOR PLAN ELECTRICAL	02-17-22
E-102	SECOND FLOOR PLAN ELECTRICAL	02-17-22
E-103	THIRD FLOOR PLAN ELECTRICAL	02-17-22
E-104	ROOF PLAN ELECTRICAL	02-17-22
E-201	ELECTRICAL SCHEDULES & RISER	12-17-21
E-301	ELECTRICAL DETAILS	12-17-21

## LIST OF DRAWINGS

 
- ALLOWANCE NO. 1: PROVIDE ALLOWANCE TO CLEAN EXISTING MAIN DUCTWORK FOR 20 LINEAR FEET PER UNIT.
- ALLOWANCE NO. 2: PROVIDE ALLOWANCE TO REPLACE EXISTING SUPPLY AND RETURN PIPING AND INSULATION FOR 20 LINEAR FEET PER UNIT.
- ALLOWANCE NO. 3: PROVIDE A PROPOSAL FROM A THIRD PARTY HVAC COMMISSIONING AGENT CONTRACTOR IS TO INCLUDE THIS AMOUNT IN THEIR BASE BID. CONTRACTOR WILL ISSUE A CREDIT CHANGE ORDER TO THE OWNER FOR THE COMMISSIONING PROPOSAL AMOUNT. OWNER WILL CONTRACT DIRECTLY WITH THE COMMISSIONING AGENT.
- ALLOWANCE NO. 4: PROVIDE ALLOWANCE FOR THE RELOCATION OF 40 ELECTRICAL DEVICES THAT REQUIRE RELOCATION DUE TO THE INCREASED SIZE OF THE NEW UNIT VENTILATORS.
- ALLOWANCE NO. 5: CONTRACTOR TO INCLUDE ALLOWANCE FOR LF OF LINE SET ENCLOSURE NOTED ON DRAWINGS.
- ALLOWANCE NO. 6: CONTRACTOR SHALL INCLUDE IN THEIR BID AN ALLOWANCE FOR 10' OF PIPING/ INSULATION FOR EACH UV AND 20' AT EACH RTU. SEE DRAWINGS 3/M-501 AND 4/M-501.
- ALLOWANCE NO. 7: CONTRACTOR TO INCLUDE ALLOWANCE FOR LF OF WIRE MOLD NOTED ON DRAWINGS.
- ALLOWANCE NO. 8: ELECTRICAL CONTRACTOR TO PROVIDE NEW POWER CONNECTIONS TO 10 UVS.

## ALLOWANCES

- UNIT PRICE NO. 1: PROVIDE UNIT PRICE TO INCREASE OR REDUCE BY 10'-0" THE LINE SET COVER. SEE DETAIL 5/A-500.
- UNIT PRICE NO. 2: PROVIDE UNIT PRICE PER SQUARE FOOT OF VCT REPLACEMENT.
- UNIT PRICE NO. 3: PROVIDE A UNIT PRICE FOR LF OF WOOD BASE REPLACEMENT.
- UNIT PRICE NO. 4: PROVIDE A UNIT PRICE TO INCREASE OR REDUCE BY 10'-0" OF WIRE MOLD.
- UNIT PRICE NO. 5: PROVIDE A UNIT PRICE TO INCREASE OR REDUCE BY 10'-0" OF PIPING/INSULATION.
- UNIT PRICE NO. 6: PROVIDE A UNIT PRICE TO PROVIDE NEW POWER SUPPLY WHERE EXISTING POWER SUPPLY IS NOT USABLE.

## UNIT PRICES

7	02-17-22	ADDENDUM 7
6	01-28-21	ADDENDUM 5
5	01-24-21	ADDENDUM 3
4	01-14-21	ADDENDUM 1
3	12-17-21	ISSUED FOR BID
2	11-19-21	SED ADDENDUM 1
1	08-30-21	BIDDING DOCUMENTS
No.	Date	Revisions



Drawn by	MAL
Checked by	MS/JC
Project No.	41048
Scale	AS NOTED
Date	08-30-21

<b>GREENMAN PEDERSON, INC</b> 400 BELLA BOULEVARD MONTABELLO, NY 10901	
Mechanical & Electrical Engineer:	Structural Engineer:


**UNIVENT REPLACEMENT AT  
HAVERSTRAW ELEMENTARY**  
**SED# 50-02-01-06-0-009-018**  
16 Grant Street  
Haverstraw, NY 10927  
COUNTY OF ROCKLAND

**MSA**  
**MICHAEL SHILALE ARCHITECTS, L.L.P.**  
140 Park Avenue New City, NY 10956 Tel 945-7054200  
www.mshila.com

**COVER SHEET**

Drawing No. **A-000**

© COPYRIGHT, MICHAEL SHILALE ARCHITECTS LLP. ALL RIGHTS RESERVED.

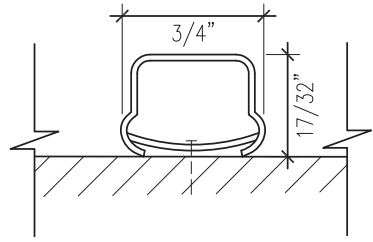


## 7 WIRE MOLD DETAIL

SCALE: 1:1

CODE	MATERIAL	MANUFACTURER	PRODUCT	CATALOG NO.	FINISH	COLOR	REMARKS
PT1	LATEX FINISH	BENJAMIN MOORE	REGAL AQUA PEARL	310	EGGSHELL	BY ARCH	(1) COAT PT4, (2) COATS PT1
PT4	LATEX PRIMER	BENJAMIN MOORE	LATEX PRIMER	273	FLAT	BY ARCH	
PT5	LATEX FINISH	BENJAMIN MOORE	DTM ACRYLIC	M29	SEMI-GLOSS	BY ARCH	(3) COAT PT6

## FINISH MATERIAL SCHEDULE

NOTE: CONTRACTOR SHALL PATCH PLASTER AND PAINT ALL DAMAGED AREA AROUND UV CASE.

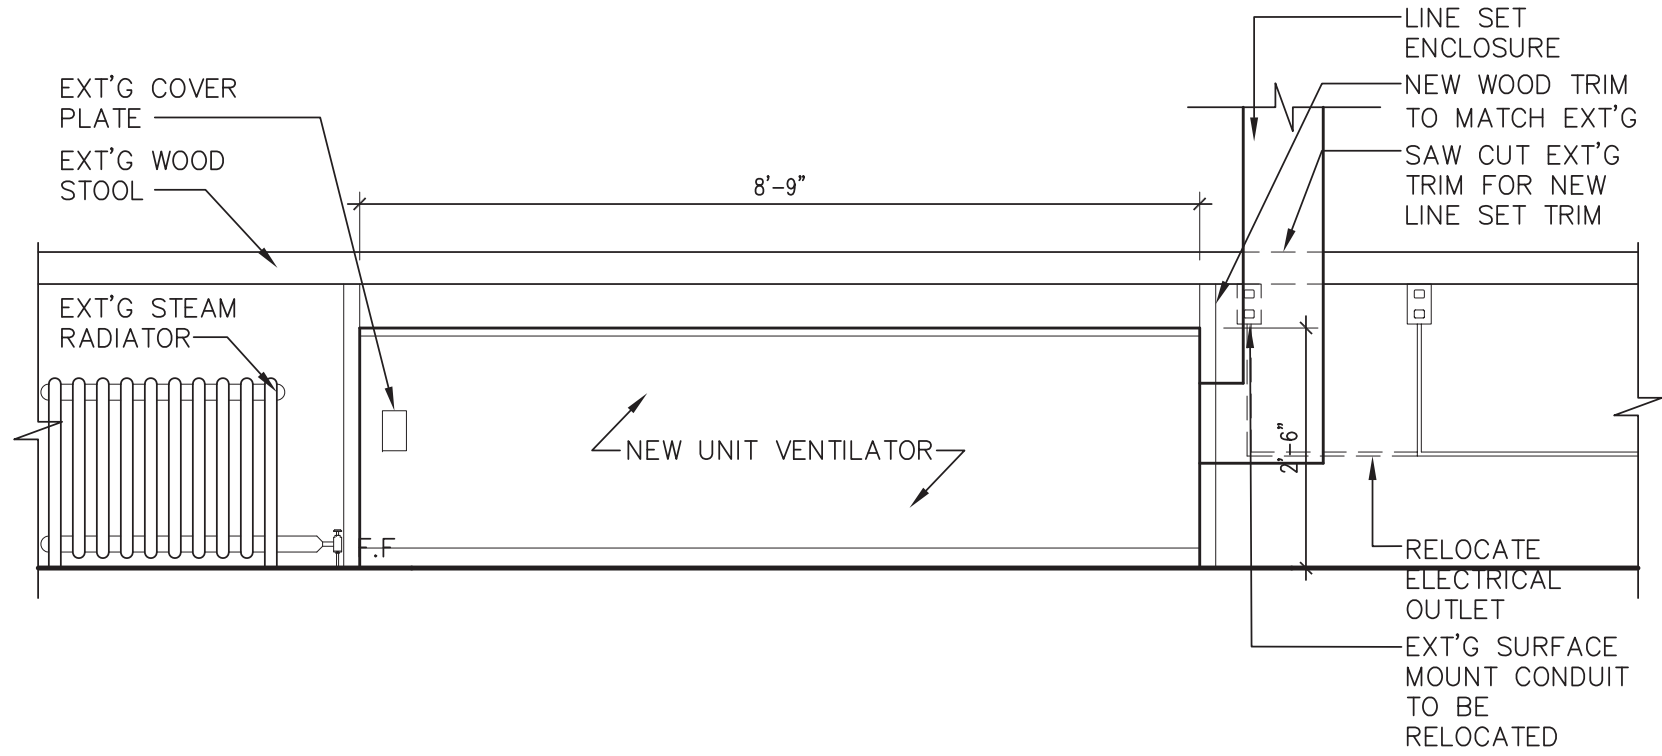


PLAN DESIGNATION C

## 4 NEW 1500 CFM UNIVENT ELEVATION (TYP.)

SCALE: 1/2" = 1'-0"

NOTE: CONTRACTOR SHALL PATCH PLASTER AND PAINT ALL DAMAGED AREA AROUND UV CASE.

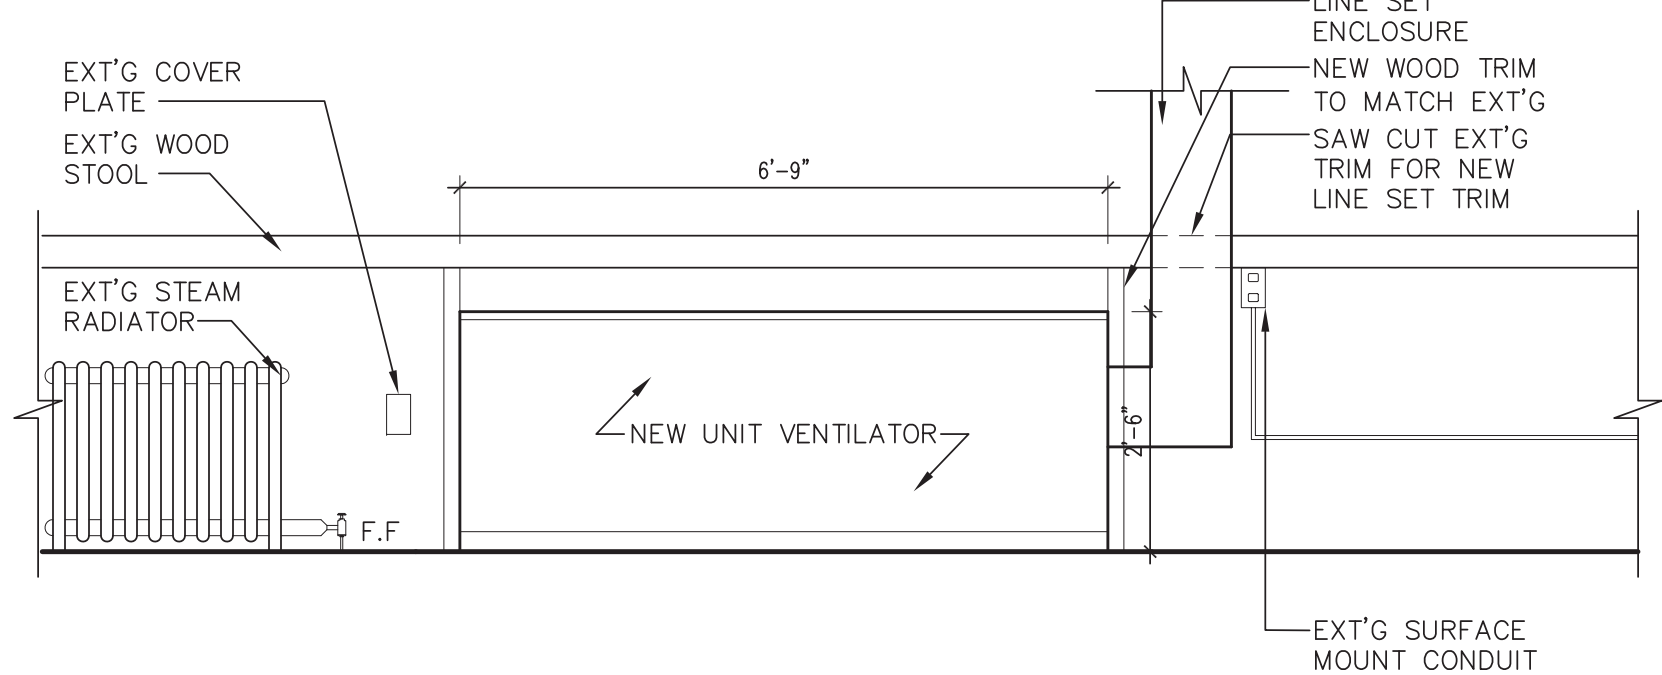


PLAN DESIGNATION B

## 3 NEW 1000 CFM UNIVENT ELEVATION (TYP.)

SCALE: 1/2" = 1'-0"

NOTE: CONTRACTOR SHALL PATCH PLASTER AND PAINT ALL AREAS EXPOSED BY THE NEW SMALLER UV CASE.

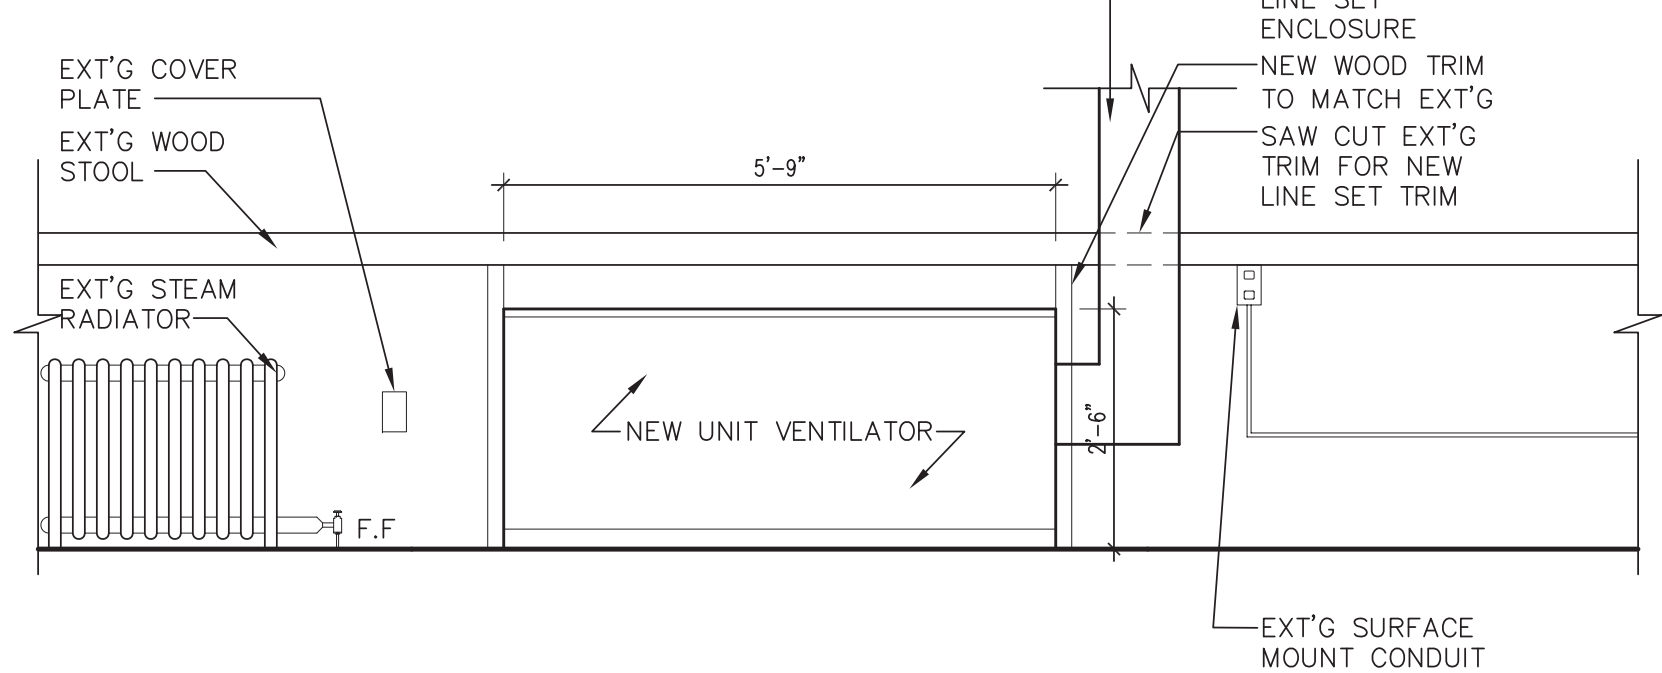


PLAN DESIGNATION A

## 2 NEW 750 CFM UNIVENT ELEVATION (TYP.)

SCALE: 1/2" = 1'-0"


## 1 EXISTING UNIVENT ELEVATION (TYP.)

SCALE: 1/2" = 1'-0"

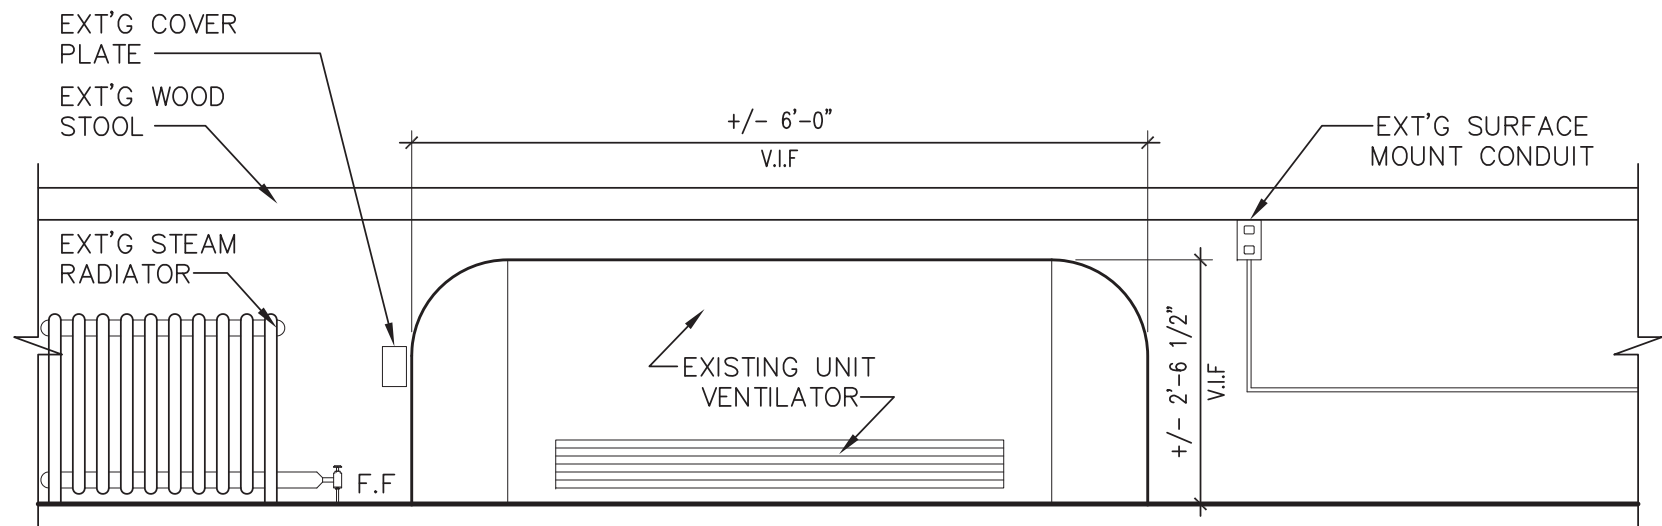


## 6 LINE SET ENCLOSURE

SCALE: 3" = 1'-0"

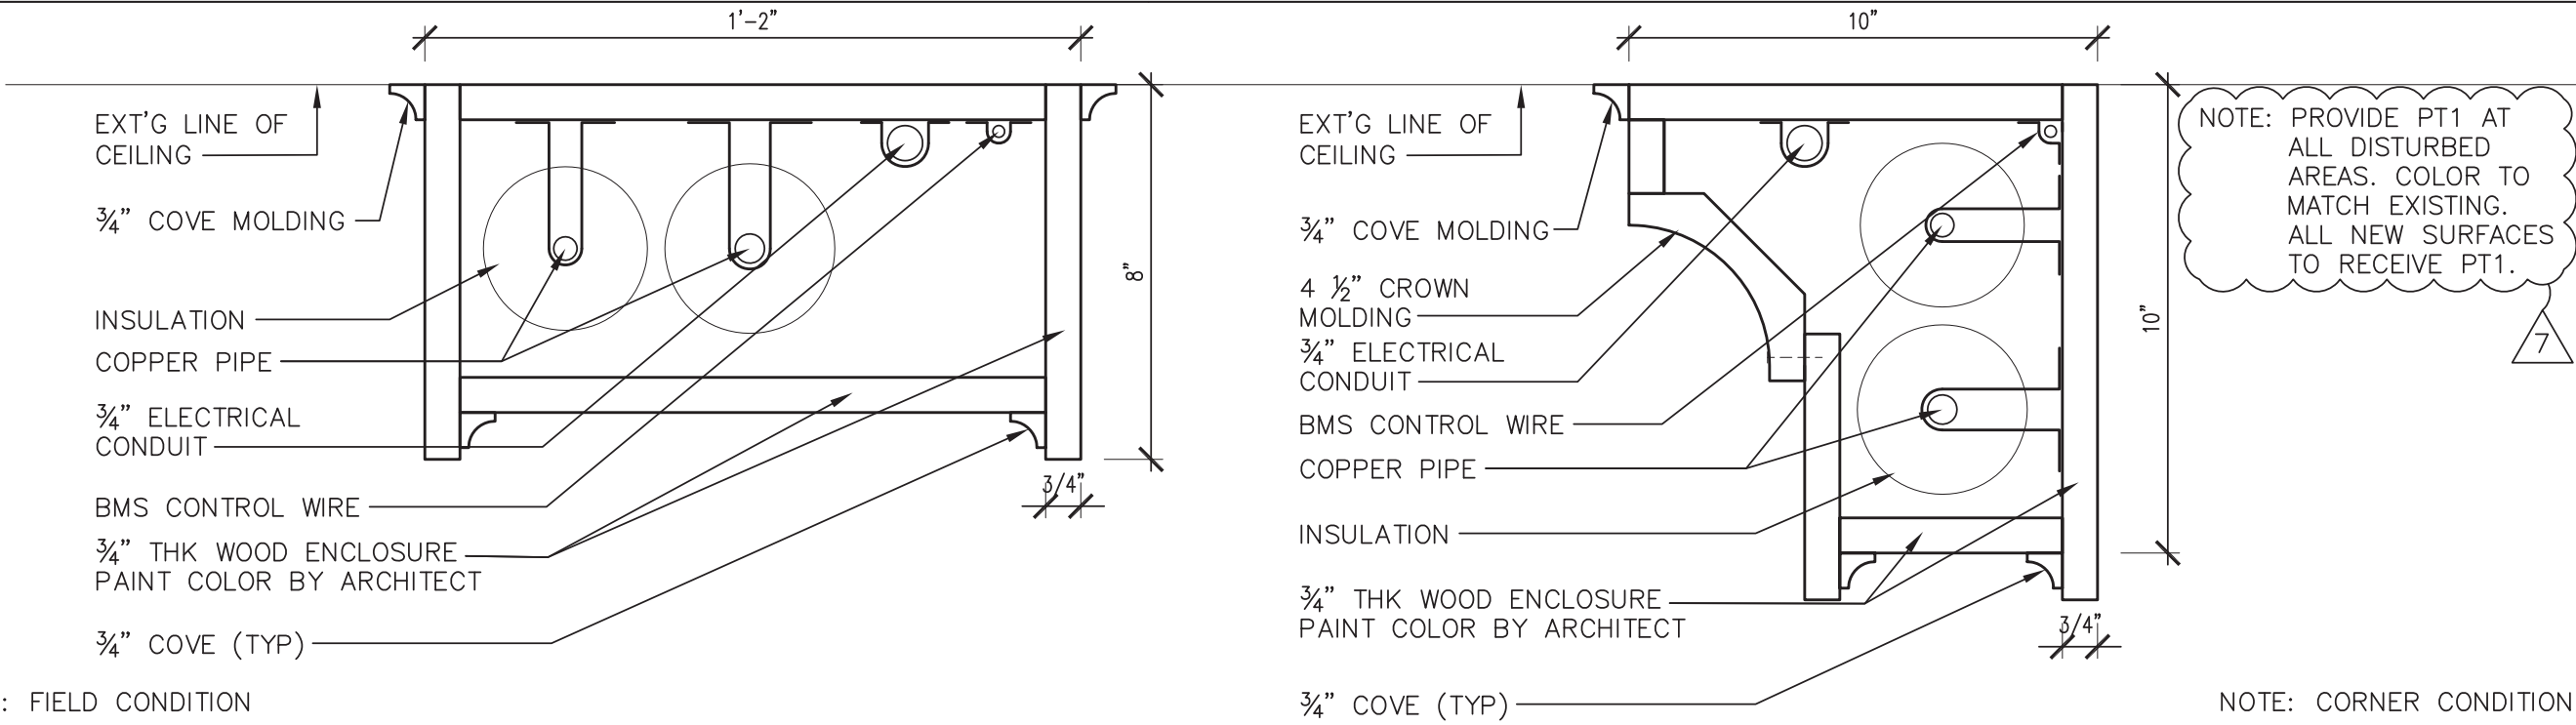


NOTE: CORNER CONDITION

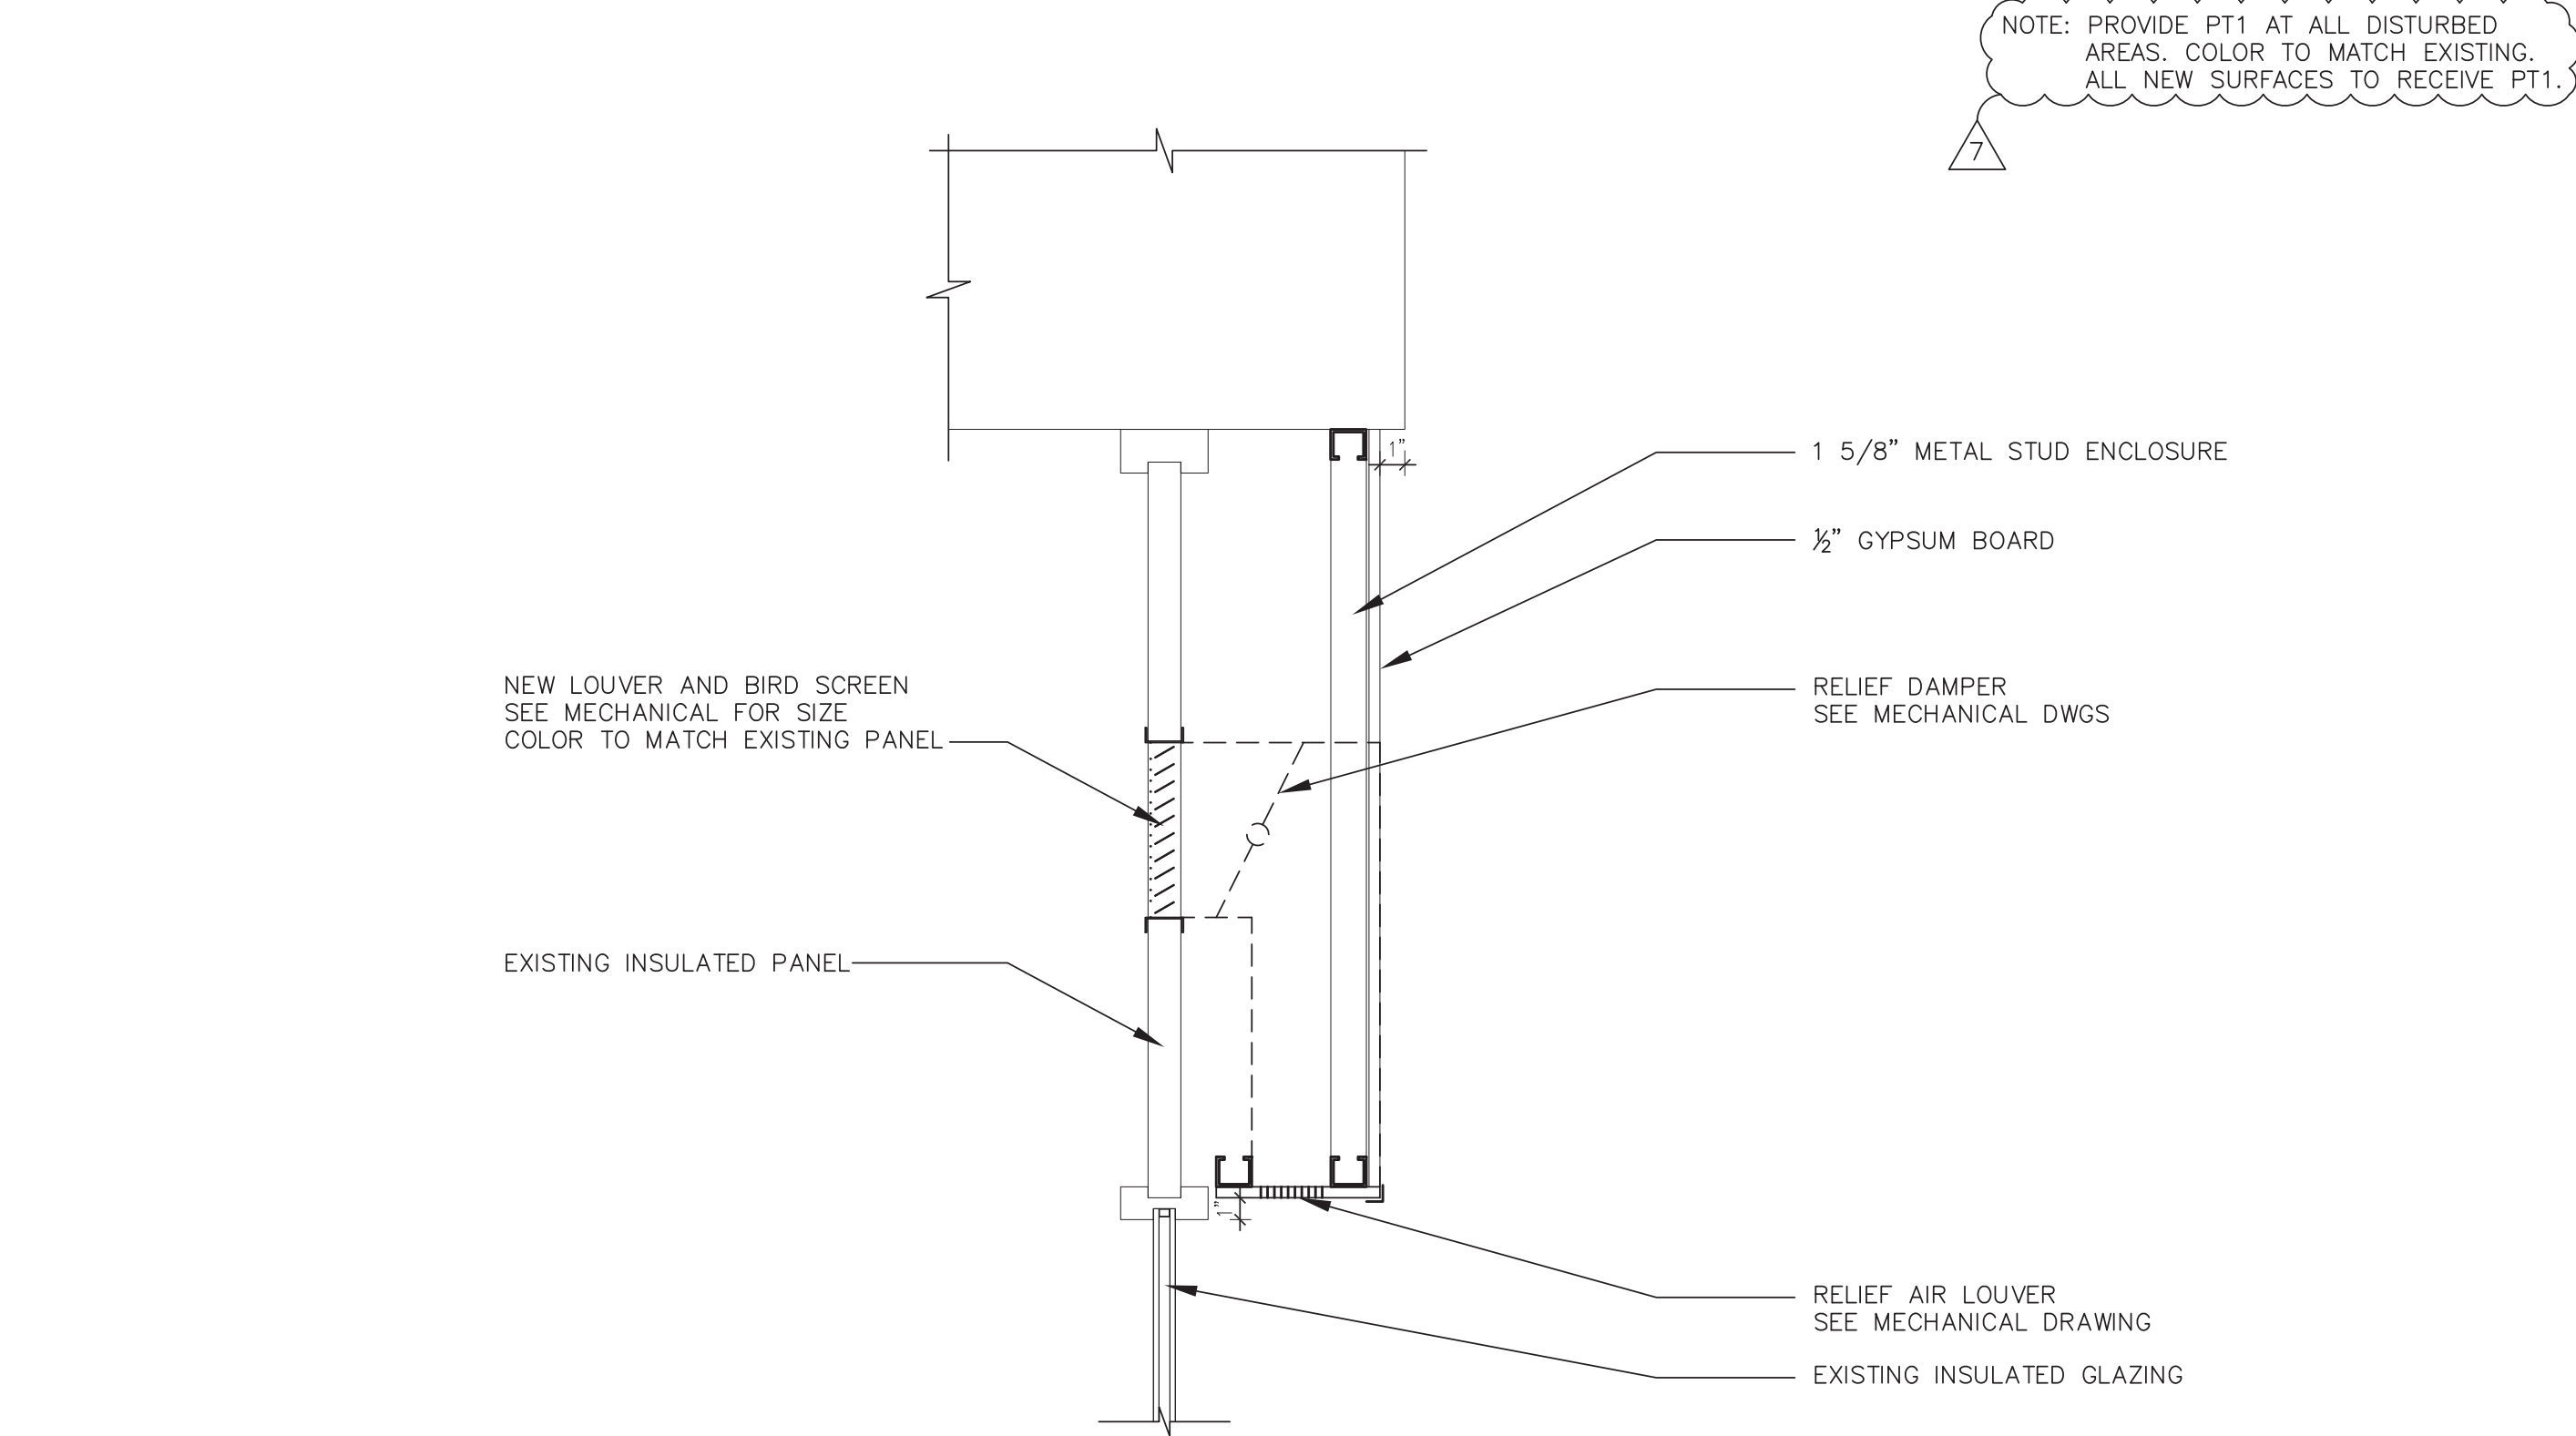

## 5 RELIEF AIR GYPSUM ENCLOSURE

SCALE: 1 1/2" = 1'-0"

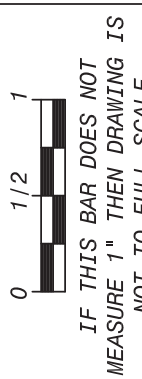

IF THIS BAR DOES NOT MEASURE 1", THEN DRAWING IS NOT TO FULL SCALE

No.	Date	Revisions
1	08-30-21	BIDDING DOCUMENTS
2	11-19-21	SED ADDENDUM 1
3	12-17-21	ISSUED FOR BID
6	01-28-21	ADDENDUM 5
7	02-17-22	ADDENDUM 7

Drawn by	MAL/JR
Checked by	MS/JC
Project No.	41048
Scale	AS NOTED
Date	08-30-21

<b>GREENMAN PEDERSEN, INC</b> 400 BELLA BOULEVARD MONTBELLO, NY 10901	
<i>Mechanical &amp; Electrical Engineer.</i>	<i>Structural Engineer.</i>


<b>UNIVENT REPLACEMENT AT HAVERSTRAW ELEMENTARY</b>	<b>SED # 50-02-01-06-0-009-018</b>	<b>COUNTY OF ROCKLAND</b>
18 Grant Street Haverstraw, NY 10927		

<b>MSA</b>	<b>MICHAEL SHILALE ARCHITECTS, L.L.P.</b>
140 Park Avenue New City, NY 10656 Tel 945-065600 www.mshale.com	

<b>DETAILS</b>	<b>A-500</b>
----------------	--------------

 © COPYRIGHT, MICHAEL SHILALE ARCHITECTS, ALL RIGHTS RESERVED.  
Drawing Title





7

4

LINE SET ENCLOSURE - GYPSUM

SCALE: 3"=1'-0"

EXT'G LINE OF CEILING

INSULATION

COPPER PIPE

3/4" ELECTRICAL CONDUIT

BMS CONTROL WIRE

1 5/8" METAL STUD ENCLOSURE

1/2" GYPSUM BOARD

PAINT COLOR BY ARCHITECT

EXT'G LINE OF CEILING

INSULATION

COPPER PIPE

3/4" ELECTRICAL CONDUIT

BMS CONTROL WIRE

1 5/8" METAL STUD ENCLOSURE

1/2" GYPSUM BOARD

PAINT COLOR BY ARCHITECT

NOTE: FIELD CONDITION

NOTE: CORNER CONDITION

NOTE: PROVIDE PT1 AT ALL DISTURBED AREAS. COLOR TO MATCH EXISTING. ALL NEW SURFACES TO RECEIVE PT1.

7

3

CLOSET AT ROOM # 185

SCALE: 1/2" = 1'-0"

NEW DOOR  
36" X 6'-8"

CONTINUOUS HINGES:  
MARKAR(FM-300 EDGE MOUNT)

HEAVY DUTY LOCK SET:  
CORBIN RUSWIN  
CL3300(CL3355, AZD)

NOTE: PROVIDE PT1 AT ALL DISTURBED AREAS. COLOR TO MATCH EXISTING. ALL NEW SURFACES TO RECEIVE PT1.

0a

s

PLAN DESIGNATION

BOTTOM SIDE OF DECKING

CONTINUOUS METAL RUNNER  
ANCHOR TO DECKING

METAL STUD  
BRACING AS REQ'D

TYP. SUSP. CEILING

4" METAL STUDS @ 16" O.C.

1/2" GYP BD

CONTINUOUS METAL RUNNER  
ANCHOR TO FLOOR DECK

TOP OF FLOOR DECK

8" ABS. PVC TILE

2

ROOFING DETAIL AT NEW HVAC CURB

SCALE: 3" = 1'-0"

NEW ALUMINUM FASCIA  
(COLOR BY ARCHITECT)

STRIPPING

METAL SET IN MASTIC PRIME  
FLANGE BEFORE STRIPPING

NEW BUILT-UP ROOFING SYSTEM

CONTINUOUS CLEAT

TURN DOWN ONE PLY OF FELT

ALLOW VENTED BASE PLY TO  
BREATHE. DO NOT SEAL

NEW COUNTERFLASHING RECEIVER

NEW COUNTERFLASHING

NEW TERMINATION BAR

NEW RIGID INSULATION

EXISTING TERMINATION BAR

1 PLY GRANULATED SURFACE BASE FLASHING

2 PLIES NON-GRANULATED BASE FLASHING

NEW WOOD NAILER

RUN FLASHING SHEET  
UNDER CLEAT AND NAIL

NEW PREFABRICATED  
INSULATED EQUIPMENT CURB  
SEE MECHANICAL DWGS.

EXISTING BUILT UP  
ROOFING SYSTEM

EXISTING ROOF DECK

END OF EXISTING BASE  
FLASHING

1'-0"

8"

6"

4 1/2"

NOTES:

1. ROOFING CONTRACTOR SHALL SUBMIT CUT SHEETS ON TYPE OF BUILT UP ROOFING MATERIAL, PRIOR TO PURCHASE OF MATERIALS.

2. ANY CHANGES THAT MAY EXIST OR OCCUR DURING CONSTRUCTION, THAT DIFFERS FROM DETAILS SHOWN, MUST BE REPORTED TO THE ARCHITECT PRIOR TO PROCEEDING W/ WORK IN AREA.

3. BOTTOM OF EXISTING WALL TO BE RECONSTRUCTED TO THE EXTENT NECESSARY TO RAISE EXISTING WEEP.

1

SOFFIT DETAIL

SCALE: 1 1/2" = 1'-0"

(2) LAYERS 5/8" ABUSE RESISTANT  
GYP. (PT1)

SUPPLY DIFFUSER  
SEE MECHANICAL  
DWGS

3-5/8" MTL.  
FRAMING AS REQD'

METAL CORNER  
BEAD AT  
GYPSUM (TYP)

1'-0"

ALIGN

COORDINATE WITH MECHANICAL DWGS

1'-0"

ALIGN

1 1/2"

ALIGN

EXISTING EXTERIOR  
OF BUILDING

3-5/8" MTL  
FRAMING AS REQD'

EXT'G INSULATED  
PANEL

INSTALL NEW FAI IN  
EXT'G INSULATED PANEL  
SEE MECHANICAL DWGS

UNIT VENTILATOR  
REFER TO MEP &  
STRUCTURAL DRAWINGS  
FOR HANGING DETAILS

B.O. UNIT VENTILATOR  
9'-6"

METAL CORNER  
BEAD AT  
GYPSUM (TYP)

EXT'G WINDOW  
AND FRAME

INTERIOR WALL

NOTE: PROVIDE PT1 AT ALL DISTURBED AREAS. COLOR TO MATCH EXISTING. ALL NEW SURFACES TO RECEIVE PT1.

0 1/2 1

IF THIS BAR DOES NOT  
MEASURE 1", THEN DRAWING IS  
NOT TO FULL SCALE

7

02-17-22 ADDENDUM 7

3 12-17-21 ISSUED FOR BID

2 11-19-21 SED ADDENDUM 1

1 08-30-21 BIDDING DOCUMENTS

No.

Date

Revisions

Drawn by MAL/JR

Checked by MS/JC

Project No. 41048

Scale AS NOTED

Date 08-30-21

GREENMAN  
PEDERSEN, INC  
400 BELLA BOULEVARD  
MONTBELLO, NY 10901

Mechanical  
& Electrical  
Engineer

Structural  
Engineer

UNIVENT REPLACEMENT  
AT  
HAVERSTRAW  
ELEMENTARY

SED # 50-02-01-06-0-009-018

18 Grant Street  
Haverstraw, NY 10927

COUNTY OF ROCKLAND

MSA

MICHAEL SHILALE ARCHITECTS, L.L.P.  
140 Park Avenue New York, NY 10022 Tel 945-0656000  
info@msa.com

DETAILS

Drawing No. A-503

© COPYRIGHT, MICHAEL SHILALE ARCHITECTS, ALL RIGHTS RESERVED.

Drawing Title

OUTDOOR CONDENSING UNIT SCHEDULE NOTES:

1. NOMINAL COOLING CAPACITIES ARE BASED ON INDOOR COIL EAT OF 80/67°F (DB/WB), OUTDOOR OF 95°F (DB)
2. NOMINAL HEATING CAPACITIES ARE BASED ON INDOOR COIL EAT OF 70°F (DB), OUTDOOR OF 43°F (WB)
3. FACTORY REPRESENTATIVE SHALL PROVIDE ON-SITE ASSISTANCE FOR THE BMS INTEGRATION OF THE CITY MULTI EQUIPMENT.
4. FOR SYSTEMS WITH MULTIPLE MODULES, REFRIGERANT PIPE DIMENSIONS INDICATE TOTAL SYSTEM COMBINED PIPING DOWNSTREAM OF MODULE TWINNING.
5. ADDED FIELD CHARGE LISTED IS IN ADDITION TO FACTORY CHARGE, THIS MUST BE UPDATED BASED UPON FINAL AS-BUILT PIPING LAYOUT.
6. COOLING EFFICIENCY FOR CONDENSING UNITS MUST BE 10% GREATER THAN LIMITS SET IN 2020 ECC NYS C406.2-10.5
7. FACTORY REPRESENTATIVE SHALL STARTUP AND COMMISSION CITY MULTI EQUIPMENT UPON COMPLETION OF EQUIPMENT INSTALLATION.
8. FACTORY REPRESENTATIVE SHALL PROVIDE ON-SITE ASSISTANCE FOR THE BMS INTEGRATION OF THE CITY MULTI EQUIPMENT.
9. ACCEPTABLE MANUFACTURER'S ARE DAIKIN OR TRANE

Tag Reference	System Tag	Model Number	Type (double / Main / Sub)	Number of Ports	Connected Capacity to BC	Voltage / Phase	Power Cooling 208V/230V (kW)	Power Heating 208V/230V (kW)	MCA 208/230	Notes / Options
BC-1	CU-1	TCMBM0108JA11N4	Main	8	160,000.0	208/230V/1-phase	0.137/0.176	0.076/0.098	0.83/0.97	1, 2, 3, 4
BC-2	CU-2	TCMBM0108JA11N4	Main	8	150,000.0	208/230V/1-phase	0.137/0.176	0.076/0.098	0.83/0.97	1, 2, 3, 4
BC-3	CU-3	TCMBM0108JA11N4	Main	8	164,000.0	208/230V/1-phase	0.137/0.176	0.076/0.098	0.83/0.97	1, 2, 3, 4
BC-4	CU-4	TCMBM0108JA11N4	Main	8	156,000.0	208/230V/1-phase	0.137/0.176	0.076/0.098	0.83/0.97	1, 2, 3, 4
BC-5	CU-5	TCMBM0108JA11N4	Main	8	148,000.0	208/230V/1-phase	0.137/0.176	0.076/0.098	0.83/0.97	1, 2, 3, 4
BC-6	CU-6	TCMBM0108JA11N4	Main	8	132,000.0	208/230V/1-phase	0.137/0.176	0.076/0.098	0.83/0.97	1, 2, 3, 4
BC-7	CU-7	TCMBM0108JA11N4	Main	8	92,000.0	208/230V/1-phase	0.137/0.176	0.076/0.098	0.83/0.97	1, 2, 3, 4
BC-8	CU-8	TCMBM0108JA11N4	Main	8	140,000.0	208/230V/1-phase	0.137/0.176	0.076/0.098	0.83/0.97	1, 2, 3, 4
BC-9	CU-9	TCMBM1016JA11N4	Main	16	169,000.0	208/230V/1-phase	0.258/0.333	0.137/0.176	1.57/1.82	1, 2, 3, 4
BC-10	CU-10	TCMBM0108JA11N4	Main	8	158,000.0	208/230V/1-phase	0.137/0.176	0.076/0.098	0.83/0.97	1, 2, 3, 4
BC-11	CU-11	TCMBM0108JA11N4	Main	8	102,000.0	208/230V/1-phase	0.137/0.176	0.076/0.098	0.83/0.97	1, 2, 3, 4
BC-12	CU-12	TCMBM0108JA11N4	Main	8	150,000.0	208/230V/1-phase	0.137/0.176	0.076/0.098	0.83/0.97	1, 2, 3, 4

5. ACCEPTABLE MANUFACTURER'S ARE DAIKIN OR TRANE.

ACCEPTABLE MANUFACTURER'S ARE DAIKIN OR TRANE

**PACKAGED ROOFTOP UNIT SCHEDULE NOTES:**

1. PROVIDE SINGLE ZONE VARIABLE AIR VOLUME (SZAV) CONTROL AND VARIABLE SPEED COMPRESSORS (TRANE ePLEX OR EQUAL).
2. PROVIDE LOW LEAKAGE REFERENCE OR COMPARATIVE ANALYSIS ECONOMIZER WITH FAULT DETECTION DIAGNOSIS AND BAROMETRIC RELIEF DAMPER.
3. PROVIDE CO2 BASED DEMAND CONTROLLED VENTILATION FIELD INSTALLED, WALL MOUNTED CO2 SENSORS. SEE SPEC 237313, 2.20 FOR MORE INFO.
4. PROVIDE ROOF CURB, 24" HIGH U.O.N. REFER TO DETAIL 6/M502.
5. PROVIDE DISCONNECT SWITCH AND POWERED CONVENIENCE OUTLET.
6. PROVIDE WITH MANUFACTURER'S STANDARD STEAM HEATING COIL SECTION. REFER TO THE STEAM COIL SCHEDULE ON THIS DRAWING.
7. PROVIDE DUCT SMOKE DETECTORS FOR BOTH THE SUPPLY AND RETURN AIR. SEE GENERAL NOTE #5 ON M-004.
8. PROVIDE MOTORIZED DAMPERS AT OUTSIDE AND EXHAUST AIR OPENINGS. SEE HVAC NOTE #16 ON M-001.
9. PROVIDE EXHAUST AIR PROST PROTECTION FOR OTHER REQUIRED SENSORS AND CONTROLS. SEE DRAWING M-004, SPEC 230993 AND 237313.
10. PROVIDE UNIT MOUNTED DISCONNECT SWITCH WITH VFD. SEE DRAWING M-004.
11. PROVIDE ENERGY RECOVERY VENTILATOR(ENERGY WHEEL) FOR RTU-2, AUDITORIUM.

7	02-17-22	ADDENDUM 7
6	01-28-21	ADDENDUM 5
3	12-17-21	ISSUED FOR BID
2	11-19-21	SED ADDENDUM 1
1	08-30-21	BIDDING DOCUMENTS
No.	Date	Revisions

Drawn by	WM
Checked by	ERF
Project No.	41048
Scale	AS NOTED
Date	08-30-21

Mechanical & Electrical Engineer:	GREENMAN PEDERSEN, INC 400 BELLA BOULEVARD MONTEBELLO, NY 10001
Structural Engineer:	— — —

UNIVENT REPLACEMENT  
AT  
HAVERSTRAW  
ELEMENTARY  
SED# 50-02-01-06-0-009-018

The logo for Michael Shilale Architects, LLP features the letters 'M', 'S', and 'A' in a large, bold, sans-serif font. Each letter is filled with a horizontal gradient, transitioning from a light gray at the top to a dark gray at the bottom. The letters are positioned vertically, with 'M' at the top, 'S' in the middle, and 'A' at the bottom.

**MICHAEL SHILALE ARCHITECTS, LLP:**

New City, NY 10956 Tel 845-708-9200  
140 Park Avenue  
[www.shilale.com](http://www.shilale.com)

Drawing Title

MECHANICAL SCHEDULES

Drawing No.

M-002

VRF HEAT RECOVERY INDOOR UNIT SCHEDULE																		
Tag Reference	Related System	Room Name	Model	Type	Nominal Cooling Capacity (BTU/h)	Nominal Heating Capacity (BTU/h)	Cooling Design Entering Temp DB/WB (°F)	Heating Design Entering Temp DB/WB (°F)	Cooling Total Capacity (BTU/h)	Cooling Sensible Capacity (BTU/h)	Heating Capacity (BTU/h)	Estimated Cooling Coil LAT (°F)	Estimated Heating Coil LAT (°F)	Refrig Pipe Dim Liquid/Suction (inch)	Voltage / Phase	Power 208V Cooling/Heating (kW)	Electrical MCA/MFS	Notes / Options
UV-101	CU-1	CR 101	30000 Btu/h LEV Kit	LEV KIT	30,000.0	34,000.0	78.0/67.9	72.0	30,157.2	Dependent on 3rd Party Coil	21,809.8	78.0	72.0	3/8 / 5/8	208/230V/1-phase	0.012 / 0.012	/16	1, 2, 3, 4, 5, 6
UV-102	CU-1	CR 102	30000 Btu/h LEV Kit	LEV KIT	30,000.0	34,000.0	78.0/67.9	72.0	30,157.2	Dependent on 3rd Party Coil	21,809.8	78.0	72.0	3/8 / 5/8	208/230V/1-phase	0.012 / 0.012	/16	1, 2, 3, 4, 5, 6
UV-103	CU-1	CR 103	30000 Btu/h LEV Kit	LEV KIT	30,000.0	34,000.0	78.0/67.9	72.0	30,157.2	Dependent on 3rd Party Coil	21,809.8	78.0	72.0	3/8 / 5/8	208/230V/1-phase	0.012 / 0.012	/16	1, 2, 3, 4, 5, 6
UV-104	CU-1	CR 104	30000 Btu/h LEV Kit	LEV KIT	30,000.0	34,000.0	78.0/67.9	72.0	30,157.2	Dependent on 3rd Party Coil	21,809.8	78.0	72.0	3/8 / 5/8	208/230V/1-phase	0.012 / 0.012	/16	1, 2, 3, 4, 5, 6
AC-1A	CU-1	AP 105D	TPLFY005FM140A	Ceiling-Cassette (Four-Way)	5,000.0	5,600.0	78.0/67.9	72.0	5,026.2	3,757.3	5,592.2	65.4	83.9	1/4 / 1/2	208/230V/1-phase	0.02 / 0.02	0.24/15	1, 2, 3, 4, 5, 6
AC-1B	CU-1	Kitchenette 105	TPLFY005FM140A	Ceiling-Cassette (Four-Way)	5,000.0	5,600.0	78.0/67.9	72.0	5,026.2	3,757.3	5,592.2	65.4	83.9	1/4 / 1/2	208/230V/1-phase	0.02 / 0.02	0.24/15	1, 2, 3, 4, 5, 6
UV-106	CU-1	CR 106	30000 Btu/h LEV Kit	LEV KIT	30,000.0	34,000.0	78.0/67.9	72.0	30,157.2	Dependent on 3rd Party Coil	21,809.8	78.0	72.0	3/8 / 5/8	208/230V/1-phase	0.012 / 0.012	/16	1, 2, 3, 4, 5, 6
UV-201	CU-2	CR 201	30000 Btu/h LEV Kit	LEV KIT	30,000.0	34,000.0	78.0/67.9	72.0	30,157.2	Dependent on 3rd Party Coil	23,416.3	78.0	72.0	3/8 / 5/8	208/230V/1-phase	0.012 / 0.012	/16	1, 2, 3, 4, 5, 6
UV-202	CU-2	CR 202	30000 Btu/h LEV Kit	LEV KIT	30,000.0	34,000.0	78.0/67.9	72.0	30,157.2	Dependent on 3rd Party Coil	23,416.3	78.0	72.0	3/8 / 5/8	208/230V/1-phase	0.012 / 0.012	/16	1, 2, 3, 4, 5, 6
UV-203	CU-2	CR 203	30000 Btu/h LEV Kit	LEV KIT	30,000.0	34,000.0	78.0/67.9	72.0	30,157.2	Dependent on 3rd Party Coil	23,416.3	78.0	72.0	3/8 / 5/8	208/230V/1-phase	0.012 / 0.012	/16	1, 2, 3, 4, 5, 6
UV-204	CU-2	CR 204	30000 Btu/h LEV Kit	LEV KIT	30,000.0	34,000.0	78.0/67.9	72.0	30,157.2	Dependent on 3rd Party Coil	23,416.3	78.0	72.0	3/8 / 5/8	208/230V/1-phase	0.012 / 0.012	/16	1, 2, 3, 4, 5, 6
UV-205	CU-2	CR 205	30000 Btu/h LEV Kit	LEV KIT	30,000.0	34,000.0	78.0/67.9	72.0	30,157.2	Dependent on 3rd Party Coil	23,416.3	78.0	72.0	3/8 / 5/8	208/230V/1-phase	0.012 / 0.012	/16	1, 2, 3, 4, 5, 6
UV-301	CU-3	CR 301	30000 Btu/h LEV Kit	LEV KIT	30,000.0	34,000.0	78.0/67.9	72.0	30,157.2	Dependent on 3rd Party Coil	21,619.9	78.0	72.0	3/8 / 5/8	208/230V/1-phase	0.012 / 0.012	/16	1, 2, 3, 4, 5, 6
UV-302	CU-3	CR 302	30000 Btu/h LEV Kit	LEV KIT	30,000.0	34,000.0	78.0/67.9	72.0	30,157.2	Dependent on 3rd Party Coil	21,619.9	78.0	72.0	3/8 / 5/8	208/230V/1-phase	0.012 / 0.012	/16	1, 2, 3, 4, 5, 6
UV-303	CU-3	CR 303	36000 Btu/h LEV Kit	LEV KIT	36,000.0	40,000.0	78.0/67.9	72.0	36,188.6	Dependent on 3rd Party Coil	25,435.1	78.0	72.0	3/8 / 5/8	208/230V/1-phase	0.012 / 0.012	/16	1, 2, 3, 4, 5, 6
UV-304	CU-3	CR 304	30000 Btu/h LEV Kit	LEV KIT	30,000.0	34,000.0	78.0/67.9	72.0	30,157.2	Dependent on 3rd Party Coil	21,619.9	78.0	72.0	3/8 / 5/8	208/230V/1-phase	0.012 / 0.012	/16	1, 2, 3, 4, 5, 6
AC-3A	CU-3	CR 305	TPEFYP008MA143A	Ceiling-Concealed (Ducted)	8,000.0	9,000.0	78.0/67.9	72.0	8,041.9	5,558.7	5,722.9	60.6	89.8	1/4 / 1/2	208/230V/1-phase	0.06 / 0.04	1.05/15	1, 2, 3, 4, 5, 6, 8
UV-306	CU-3	CR 306	30000 Btu/h LEV Kit	LEV KIT	30,000.0	34,000.0	78.0/67.9	72.0	30,157.2	Dependent on 3rd Party Coil	21,619.9	78.0	72.0	3/8 / 5/8	208/230V/1-phase	0.012 / 0.012	/16	1, 2, 3, 4, 5, 6
AC-4A	CU-4	Main Office 105A	TPEFYP008MA143A	Ceiling-Concealed (Ducted)	8,000.0	9,000.0	78.0/67.9	72.0	8,041.9	5,558.7	5,939.3	60.6	90.4	1/4 / 1/2	208/230V/1-phase	0.06 / 0.04	1.05/15	1, 2, 3, 4, 5, 6, 8
AC-4B	CU-4	Principal 105C	TPEFYP008MA143A	Ceiling-Concealed (Ducted)	6,000.0	6,700.0	78.0/67.9	72.0	6,031.4	4,892.2	4,421.5	78.0	85.7	1/4 / 1/2	208/230V/1-phase	0.06 / 0.04	1.05/15	1, 2, 3, 4, 5, 6, 8
AC-4C	CU-4	Conference 105B	TPEFYP008MA143A	Ceiling-Concealed (Ducted)	8,000.0	9,000.0	78.0/67.9	72.0	8,041.9	5,558.7	5,939.3	60.6	90.4	1/4 / 1/2	208/230V/1-phase	0.06 / 0.04	1.05/15	1, 2, 3, 4, 5, 6, 8
UV-206	CU-4	CR 206	30000 Btu/h LEV Kit	LEV KIT	30,000.0	34,000.0	78.0/67.9	72.0	30,157.2	Dependent on 3rd Party Coil	21,619.9	78.0	72.0	3/8 / 5/8	208/230V/1-phase	0.012 / 0.012	/16	1, 2, 3, 4, 5, 6
UV-207	CU-4	CR 207	30000 Btu/h LEV Kit	LEV KIT	30,000.0	34,000.0	78.0/67.9	72.0	30,157.2	Dependent on 3rd Party Coil	22,437.3	78.0	72.0	3/8 / 5/8	208/230V/1-phase	0.012 / 0.012	/16	1, 2, 3, 4, 5, 6
UV-208	CU-4	CR 208	30000 Btu/h LEV Kit	LEV KIT	30,000.0	34,000.0	78.0/67.9	72.0	30,157.2	Dependent on 3rd Party Coil	22,437.3	78.0	72.0	3/8 / 5/8	208/230V/1-phase	0.012 / 0.012	/16	1, 2, 3, 4, 5, 6
UV-307	CU-4	CR 307	36000 Btu/h LEV Kit	LEV KIT	36,000.0	40,000.0	78.0/67.9	72.0	36,188.6	Dependent on 3rd Party Coil	26,396.8	78.0	72.0	3/8 / 5/8	208/230V/1-phase	0.012 / 0.012	/16	1, 2, 3, 4, 5, 6
AC-4D	CU-4	CR 309	TPEFYP008MA143A	Ceiling-Concealed (Ducted)	8,000.0	9,000.0	78.0/67.9	72.0	8,041.9	5,558.7	5,939.3	60.6	90.4	1/4 / 1/2	208/230V/1-phase	0.06 / 0.04	1.05/15	1, 2, 3, 4, 5, 6, 8
UV-186	CU-5	Music 186	30000 Btu/h LEV Kit	LEV KIT	30,000.0	34,000.0	78.0/67.9	72.0	30,157.2	Dependent on 3rd Party Coil	23,116.6	78.0	72.0	3/8 / 5/8	208/230V/1-phase	0.012 / 0.012	/16	1, 2, 3, 4, 5, 6
AC-5C	CU-5	Music 185	TPVFYP018AM141A	Multi-Position Air Handler	18,000.0	40,000.0	78.0/67.9	72.0	18,094.3	11,937.6	13,598.0	58.8	93.6	1/4 / 1/2	208/230V/1-phase	0.13 / 0.13	3.0/15	1, 2, 3, 4, 5, 6
UV-190	CU-5	Home Ec 190	30000 Btu/h LEV Kit	LEV KIT	30,000.0	34,000.0	78.0/67.9	72.0	30,157.2	Dependent on 3rd Party Coil	23,116.6	78.0	72.0	3/8 / 5/8	208/230V/1-phase	0.012 / 0.012	/16	1, 2, 3, 4, 5, 6
UV-195A	CU-5	Home Ec 195A	30000 Btu/h LEV Kit	LEV KIT	30,000.0	34,000.0	78.0/67.9	72.0	30,157.2	Dependent on 3rd Party Coil	23,116.6	78.0	72.0	3/8 / 5/8	208/230V/1-phase	0.012 / 0.012	/16	1, 2, 3, 4, 5, 6
AC-5A	CU-5	Office 220A	TPLFY005FM140A	Ceiling-Cassette (Four-Way)	5,000.0	5,600.0	78.0/67.9	72.0	5,026.2	3,757.3	3,807.4	65.4	84.7	1/4 / 1/2	208/230V/1-phase	0.02 / 0.02	0.24/15	1, 2, 3, 4, 5, 6
AC-5B	CU-5	Office 220B	TPLFY005FM140A	Ceiling-Cassette (Four-Way)	5,000.0	5,600.0	78.0/67.9	72.0	5,026.2	3,757.3	3,807.4	65.4	84.7	1/4 / 1/2	208/230V/1-phase	0.02 / 0.02	0.24/15	1, 2, 3, 4, 5, 6
UV-105B	CU-5	Conference 105B	30000 Btu/h LEV Kit	LEV KIT	30,000.0	34,000.0	78.0/67.9	72.0	30,157.2	Dependent on 3rd Party Coil	23,116.6	78.0	72.0	3/8 / 5/8	208/230V/1-phase	0.012 / 0.012	/16	1, 2, 3, 4, 5, 6
UV-180A-1	CU-6	Room 180A	36000 Btu/h LEV Kit	LEV KIT	36,000.0	40,000.0	78.0/67.9	72.0	36,188.6	Dependent on 3rd Party Coil	27,023.6	78.0	72.0	3/8 / 5/8	208/230V/1-phase	0.012 / 0.012	/16	1, 2, 3, 4, 5, 6
UV-180A-2	CU-6	Room 180A	36000 Btu/h LEV Kit	LEV KIT	36,000.0	40,000.0	78.0/67.9	72.0	36,188.6	Dependent on 3rd Party Coil	27,023.6	78.0	72.0	3/8 / 5/8	208/230V/1-phase	0.012 / 0.012	/16	1, 2, 3, 4, 5, 6
UV-175	CU-6	Room 175	60000 Btu/h LEV Kit	LEV KIT	60,000.0	66,000.0	78.0/67.9	72.0	60,314.4	Dependent on 3rd Party Coil	44,589.0	78.0	72.0	3/8 / 3/4	208/230V/1-phase	0.012 / 0.012	/16	1, 2, 3, 4, 5, 6
UV-221	CU-7	Locker Rm 221	36000 Btu/h LEV Kit	LEV KIT	36,000.0	40,000.0	78.0/67.9	72.0	36,188.6	Dependent on 3rd Party Coil	32,571.1	78.0	72.0	3/8 / 5/8	208/230V/1-phase	0.012 / 0.012	/16	1, 2, 3, 4, 5, 6
UV-222	CU-7	Locker Rm 222	36000 Btu/h LEV Kit	LEV KIT	36,000.0	40,000.0	78.0/67.9	72.0	36,188.6	Dependent on 3rd Party Coil	32,571.1	78.0	72.0	3/8 / 5/8	208/230V/1-phase	0.012 / 0.012	/16	1, 2, 3, 4, 5, 6
AC-7A	CU-7	Office 222C	TPLFY005FM140A	Ceiling-Cassette (Four-Way)	5,000.0	5,600.0	78.0/67.9	72.0	5,026.2	3,757.3	4,560.0	65.4	87.2	1/4 / 1/2	208/230V/1-phase	0.02 / 0.02	0.24/15	1, 2, 3, 4, 5, 6, 7
AC-7B	CU-7	Office 222B	TPLFY005FM140A	Ceiling-Cassette (Four-Way)	5,000.0	5,600.0	78.0/67.9	72.0	5,026.2	3,757.3	4,560.0	65.4	87.2	1/4 / 1/2	208/230V/1-phase	0.02 / 0.02	0.24/15	1, 2, 3, 4, 5, 6, 7
AC-7C	CU-7	Office 221B	TPLFY005FM140A	Ceiling-Cassette (Four-Way)	5,000.0	5,600.0	78.0/67.9	72.0	5,026.2	3,757.3	4,560.0	65.4	87.2	1/4 / 1/2	208/230V/1-phase	0.02 / 0.02	0.24/15	1, 2, 3, 4, 5, 6, 7
AC-7D	CU-7	Office 221C	TPLFY005FM140A	Ceiling-Cassette (Four-Way)	5,000.0	5,600.0	78.0/67.9	72.0	5,026.2	3,757.3	4,560.0	65.4	87.2	1/4 / 1/2	208/230V/1-phase	0.02 / 0.02	0.24/15	1, 2, 3, 4, 5, 6, 7
UV-207-1	CU-8	Library 207	36000 Btu/h LEV Kit	LEV KIT	36,000.0	40,000.0	78.0/67.9	72.0	36,188.6	Dependent on 3rd Party Coil	25,745.5	78.0	72.0	3/8 / 5/8	208/230V/1-phase	0.012 / 0.012	/16	1, 2, 3, 4, 5, 6
UV-207-2	CU-8	Library 207	36000 Btu/h LEV Kit	LEV KIT	36,000.0	40,000.0	78.0/67.9	72.0	36,188.6	Dependent on 3rd Party Coil	25,745.5	78.0	72.0	3/8 / 5/8	208/230V/1-phase	0.012 / 0.012	/16	1, 2, 3, 4, 5, 6
UV-311	CU-8	Science 311	60000 Btu/h LEV Kit	LEV KIT	60,000.0	66,000.0	78.0/67.9	72.0	60,314.4	Dependent on 3rd Party Coil	42,480.1	78.0	72.0	3/8 / 3/4	208/230V/1-phase	0.012 / 0.012	/16	1, 2, 3, 4, 5, 6
AC-8A	CU-8	Office 209A	TPEFYP008MA143A	Ceiling-Concealed (Ducted)	8,000.0	9,000.0	78.0/67.9	72.0	8,041.9	5,558.7	5,792.7	60.6	90.0	1/4 / 1/2	208/230V/1-phase	0.06 / 0.04	1.05/15	1, 2, 3, 4, 5, 6, 8
AC-9A	CU-9	Office 107B	TPEFYP006MA143A	Ceiling-Concealed (Ducted)	6,000.0	6,700.0	78.0/67.9	72.0	5,598.1	4,738.6	4,071.2	63.1	84.6	1/4 / 1/2	208/230V/1-phase	0.06 / 0.04	1.05/15	1, 2, 3, 4, 5, 6, 8
AC-9B	CU-9	Office 107F	TPEFYP006MA143A	Ceiling-Concealed (Ducted)	6,000.0	6,700.0	78.0/67.9	72.0	5,598.1	4,738.6	4,071.2	63.1	84.6	1/4 / 1/2	208/230V/1-phase	0.06 / 0.04	1.05/15	1, 2, 3, 4, 5, 6, 8
AC-9C	CU-9	Office 107D	TPEFYP006MA143A	Ceiling-Concealed (Ducted)	6,000.0	6,700.0	78.0/67.9	72.0	5,598.1	4,738.6	4,071.2	63.1	84.6	1/4 / 1/2	208/230V/1-phase	0.06 / 0.04	1.05/15	1, 2, 3, 4, 5, 6, 8
AC-9E	CU-9	Office 107E	TPEFYP006MA143A	Ceiling-Concealed (Ducted)	6,000.0	6,700.0	78.0/67.9	72.0	5,598.1	4,738.6	4,071.2	63.1	84.6	1/4 / 1/2	208/230V/1-phase	0.06 / 0.04	1.05/15	1, 2, 3, 4, 5, 6, 8
AC-9I	CU-9	Office 108E	TPLFY005FM140A	Ceiling-Cassette (Four-Way)	5,000.0	5,												


1. DUCT SMOKE DETECTORS SHALL BE PROVIDED IN MAIN SUPPLY AND RETURN DUCT FOR SYSTEMS OVER 1,000 CFM AND ALSO UPSTREAM OF EACH STORY RETURN DUCT/ RISER CONNECTION WHERE RETURN AIR RISERS SERVE TWO OR MORE STORIES FOR SYSTEMS OVER 15,000 CFM.
2. INTEGRATE AIR FLOW MEASURING APPARATUS INTO THE BMS/DDC NETWORK. PROVIDE ONE OUTSIDE AIR FLOW MEASURING STATION FOR EACH OUTSIDE AIR INTAKE PORT. PROVIDE FACTORY INSTALLED AIRFLOW STATION.
3. PROVIDE NEW THERMOSTATS WITH LOCK BOXES IN ROOMS BEING SERVED BY AHU. CONTRACTOR SHALL PROVIDE ALL ASSOCIATED CONTROL WIRING.
4. SAFETY SHUTDOWN DEVICES SHALL BE HARDWIRED TO THE FAN STARTER CIRCUIT IN ADDITION TO THE DDC SYSTEM. COORDINATE WITH MANUFACTURER FOR SHUTDOWN UNDER ALL MODES OF OPERATION.
5. MECHANICAL CONTRACTOR SHALL HIRE A FIRE ALARM SUBCONTRACTOR. FIRE ALARM CONTRACTOR TO FURNISH FIRE ALARM SYSTEM COMPLIANT SMOKE DETECTORS TO THE MECHANICAL CONTRACTOR WHO SHALL IN TURN FURNISH THEM TO THE CENTRAL AIR HANDLING UNIT MANUFACTURER FOR FACTORY INSTALLATION OR TO THE SHEET METAL CONTRACTOR FOR FIELD DUCTWORK INSTALLATION FOR THE FLOOR RETURN/RISER RETURN CONNECTIONS AS APPLICABLE. CONTRACTOR SHALL PROVIDE ALL SIGNAL AND CONTROL POWER WIRING TO UNIT.
6. ACCEPTABLE MANUFACTURER: DAIKIN OR TRANE

## GENERAL NOTES

VFD	VARIABLE FREQUENCY DRIVE	DCV	DEMAND CONTROL VENTILATION
TLL-1	TEMPERATURE LOW LIMIT	CO2	CARBON DIOXIDE
TCC	TEMPERATURE CONTROLS CONTRACTOR	DI	DIGITAL INPUT
TS-1	OUTSIDE AIR TEMP	DO	DIGITAL OUTPUT
TS-2	MIXED AIR TEMP	AI	ANALOG INPUT
TS-3	HEATING COIL DISCHARGE	AO	ANALOG OUTPUT
TS-4	DISCHARGE AIR TEMP	LO	LONWORKS NETWORK CONNECTION
TS-5	RETURN AIR TEMP	PSL	PRESSURE SWITCH LOW
FE	FLOW ELEMENT	PSH	PRESSURE SWITCH HIGH
FM	FLOW METER	DPS/I	DIFF. PRESSURE SWITCH/INDICATOR
BI	BINARY INPUT	AD	DPR ACTUATORS
BO	BINARY OUTPUT	BMS	BUILDING MANAGEMENT SYSTEM
OA	DISCHARGE AIR	RTU	ROOFTOP UNIT
SA	SUPPLY AIR	VRF	VARIABLE REFRIGERANT FLOW
RA	RETURN AIR	STM SUP	STEAM SUPPLY
IDU	INDOOR UNIT	COND	CONDENSATE RETURN
ODU	OUTDOOR UNIT	WCI	WIRELESS COMMUNICATION INTERFACE
FLTG	FLOATING	MA ACT	MIXED AIR ACTIVE
TEMP	TEMPERATURE	SF STS	SUPPLY FAN STATUS
STPT	SETPOINT	SPD	SPEED
VAL	VALVE	CMD	COMMAND
EC	ELECTRICAL CONTRACTOR	---	FIELD INSTALLED WIRING




## LEGEND

- POINTS LIST NOTES:
- LEGEND:
- X = PROVIDE QUANTITY AS REQUIRED TO INCLUDE ALL INSTANCES OF THE INDICATED FEATURE. INCLUDE MULTIPLE POINTS WITHIN EACH MECHANICAL SYSTEM AS NECESSARY. COORDINATE WITH EQUIPMENT VENDOR.
- B = INFORMATION PROVIDED TO EACH SYSTEM VIA NETWORK BROADCAST.
- NVO = NETWORK VARIABLE OUTPUT, NVI = NETWORK VARIABLE INPUT
- KEY NOTES:
- ① THE POINT LISTED HEREIN ARE THE MINIMUM POINTS REQUIRED FOR THE CONTROL AND MONITORING OF THIS EQUIPMENT. THIS POINT LIST IS TYPICAL FOR EACH MECHANICAL/ELECTRICAL SYSTEM OF THIS TYPE. IF THE SEQUENCE OF OPERATION REQUIRES ADDITIONAL OR DIFFERING INFORMATION, IT MUST BE PROVIDED BY THE RESPECTIVE PROVIDER OF THE CONTROLS FOR THIS TYPE OF EQUIPMENT AS COORDINATED BY THE GENERAL AND MECHANICAL CONTRACTORS.
- ② THE TCC SHALL PROVIDE ALL DIGITAL ALARM LOGIC. ALL DIGITAL ALARMS SHALL BE COMPATIBLE WITH THE EXISTING SIEMENS BMS SYSTEM.
- ③ THE TCC SHALL PROVIDE ALL TRENDING AND ANALOG ALARMING VIA THE SOFTWARE USED AT THE EXISTING SIEMENS BMS SYSTEM.
- ④ PROVIDE ACCUMULATED AIR FLOW FOR VALIDATION OF PURGE-MODE AND FOR PERMANENT VALIDATION OF OCCUPANT VENTILATION.
- ⑤ PROVIDE MANUAL RESET DEVICE. NOTE THAT THIS DEVICE BOTH ALARMS IN THE BMS AND IS HARDWIRED TO THE VFDs FOR SHUTDOWN OF THE FANS IN ALL OPERATING CONDITIONS OF THE VFD.
- ⑥ PROVIDE THE ALARM WHEN AT THE CALCULATED DIFFERENTIAL BETWEEN OUTSIDE AIR AND SPACE AIR CO2 VALUE IS 1000 ppm.
- ⑦ PROVIDE LON COMMUNICATION CONNECTION TO THIS DEVICE MAPPING ALL REQUIRED POINTS INTO THE LNS DATABASE.

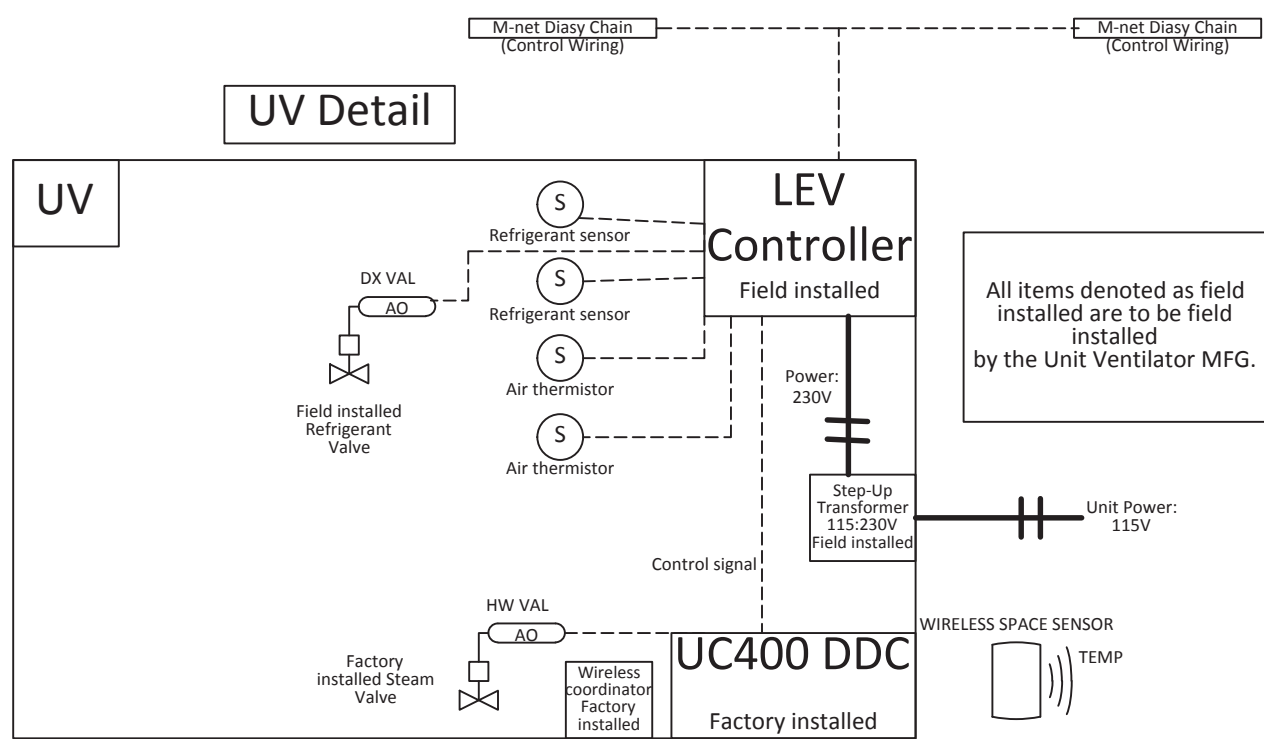

## 4 LEV KIT WIRING DIAGRAM

SCALE: N.T.S.

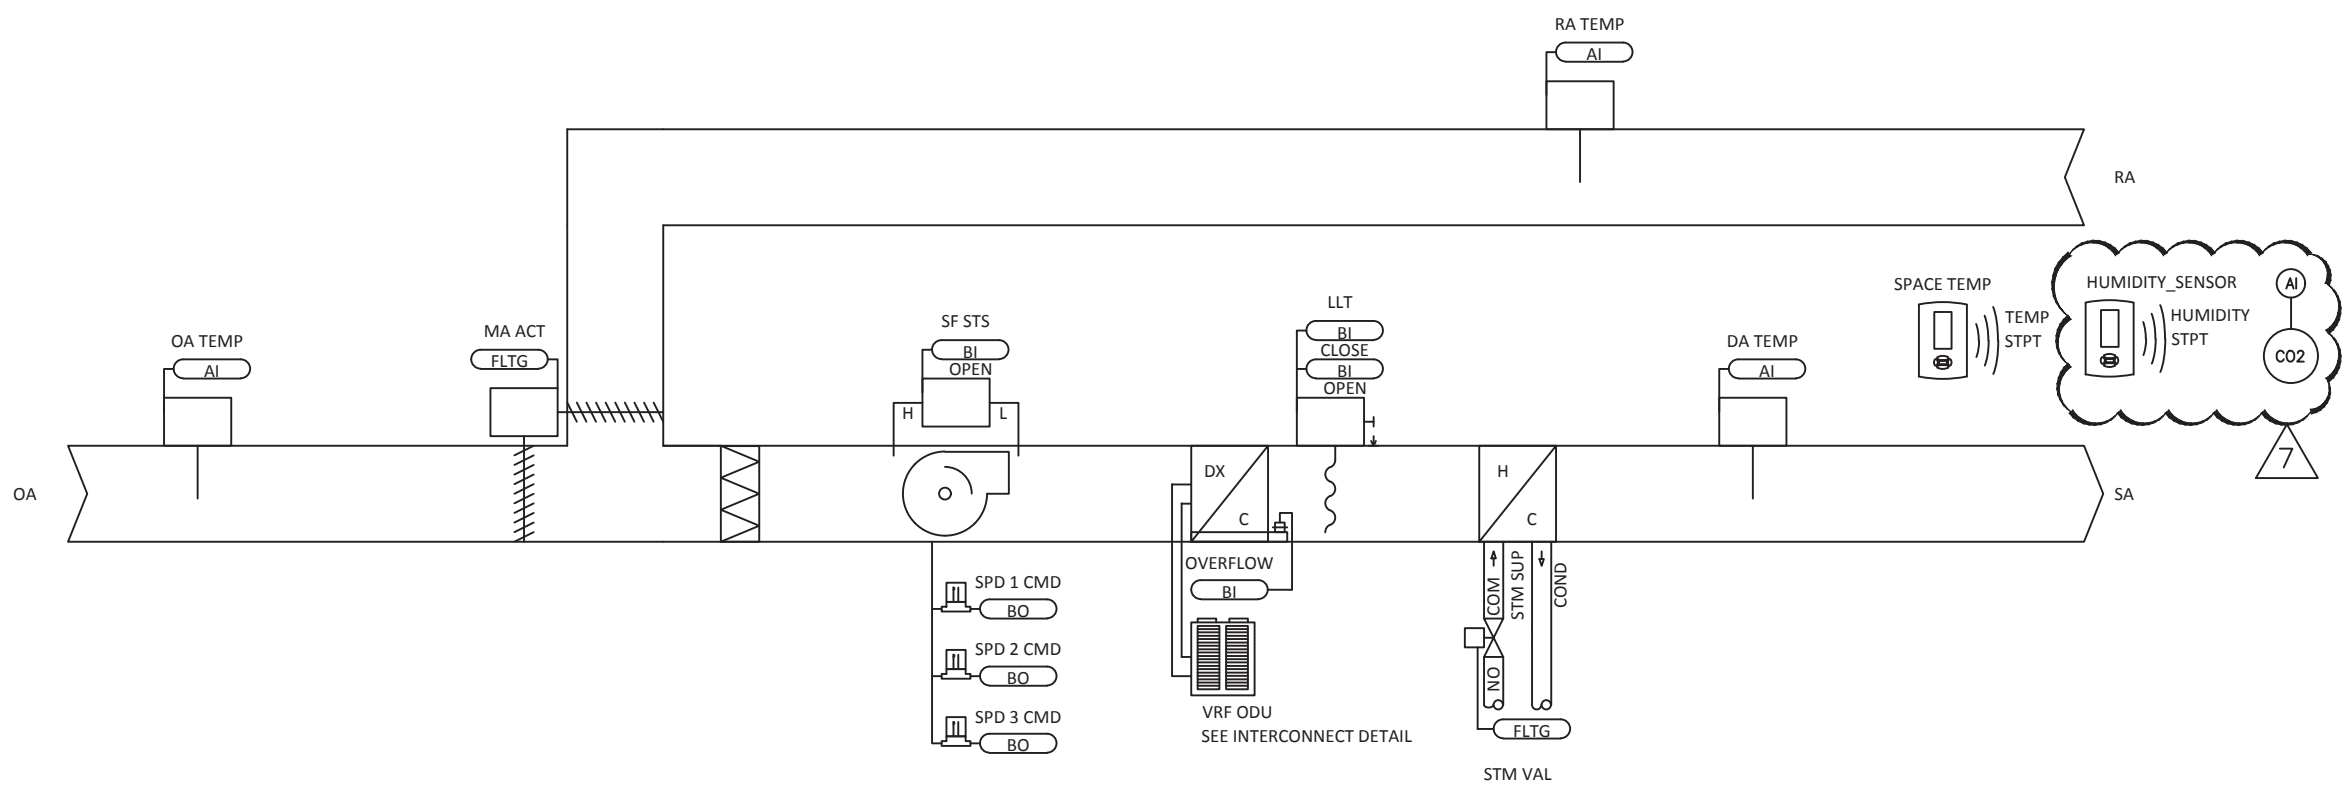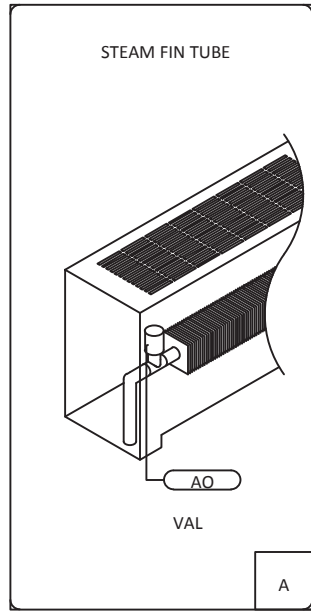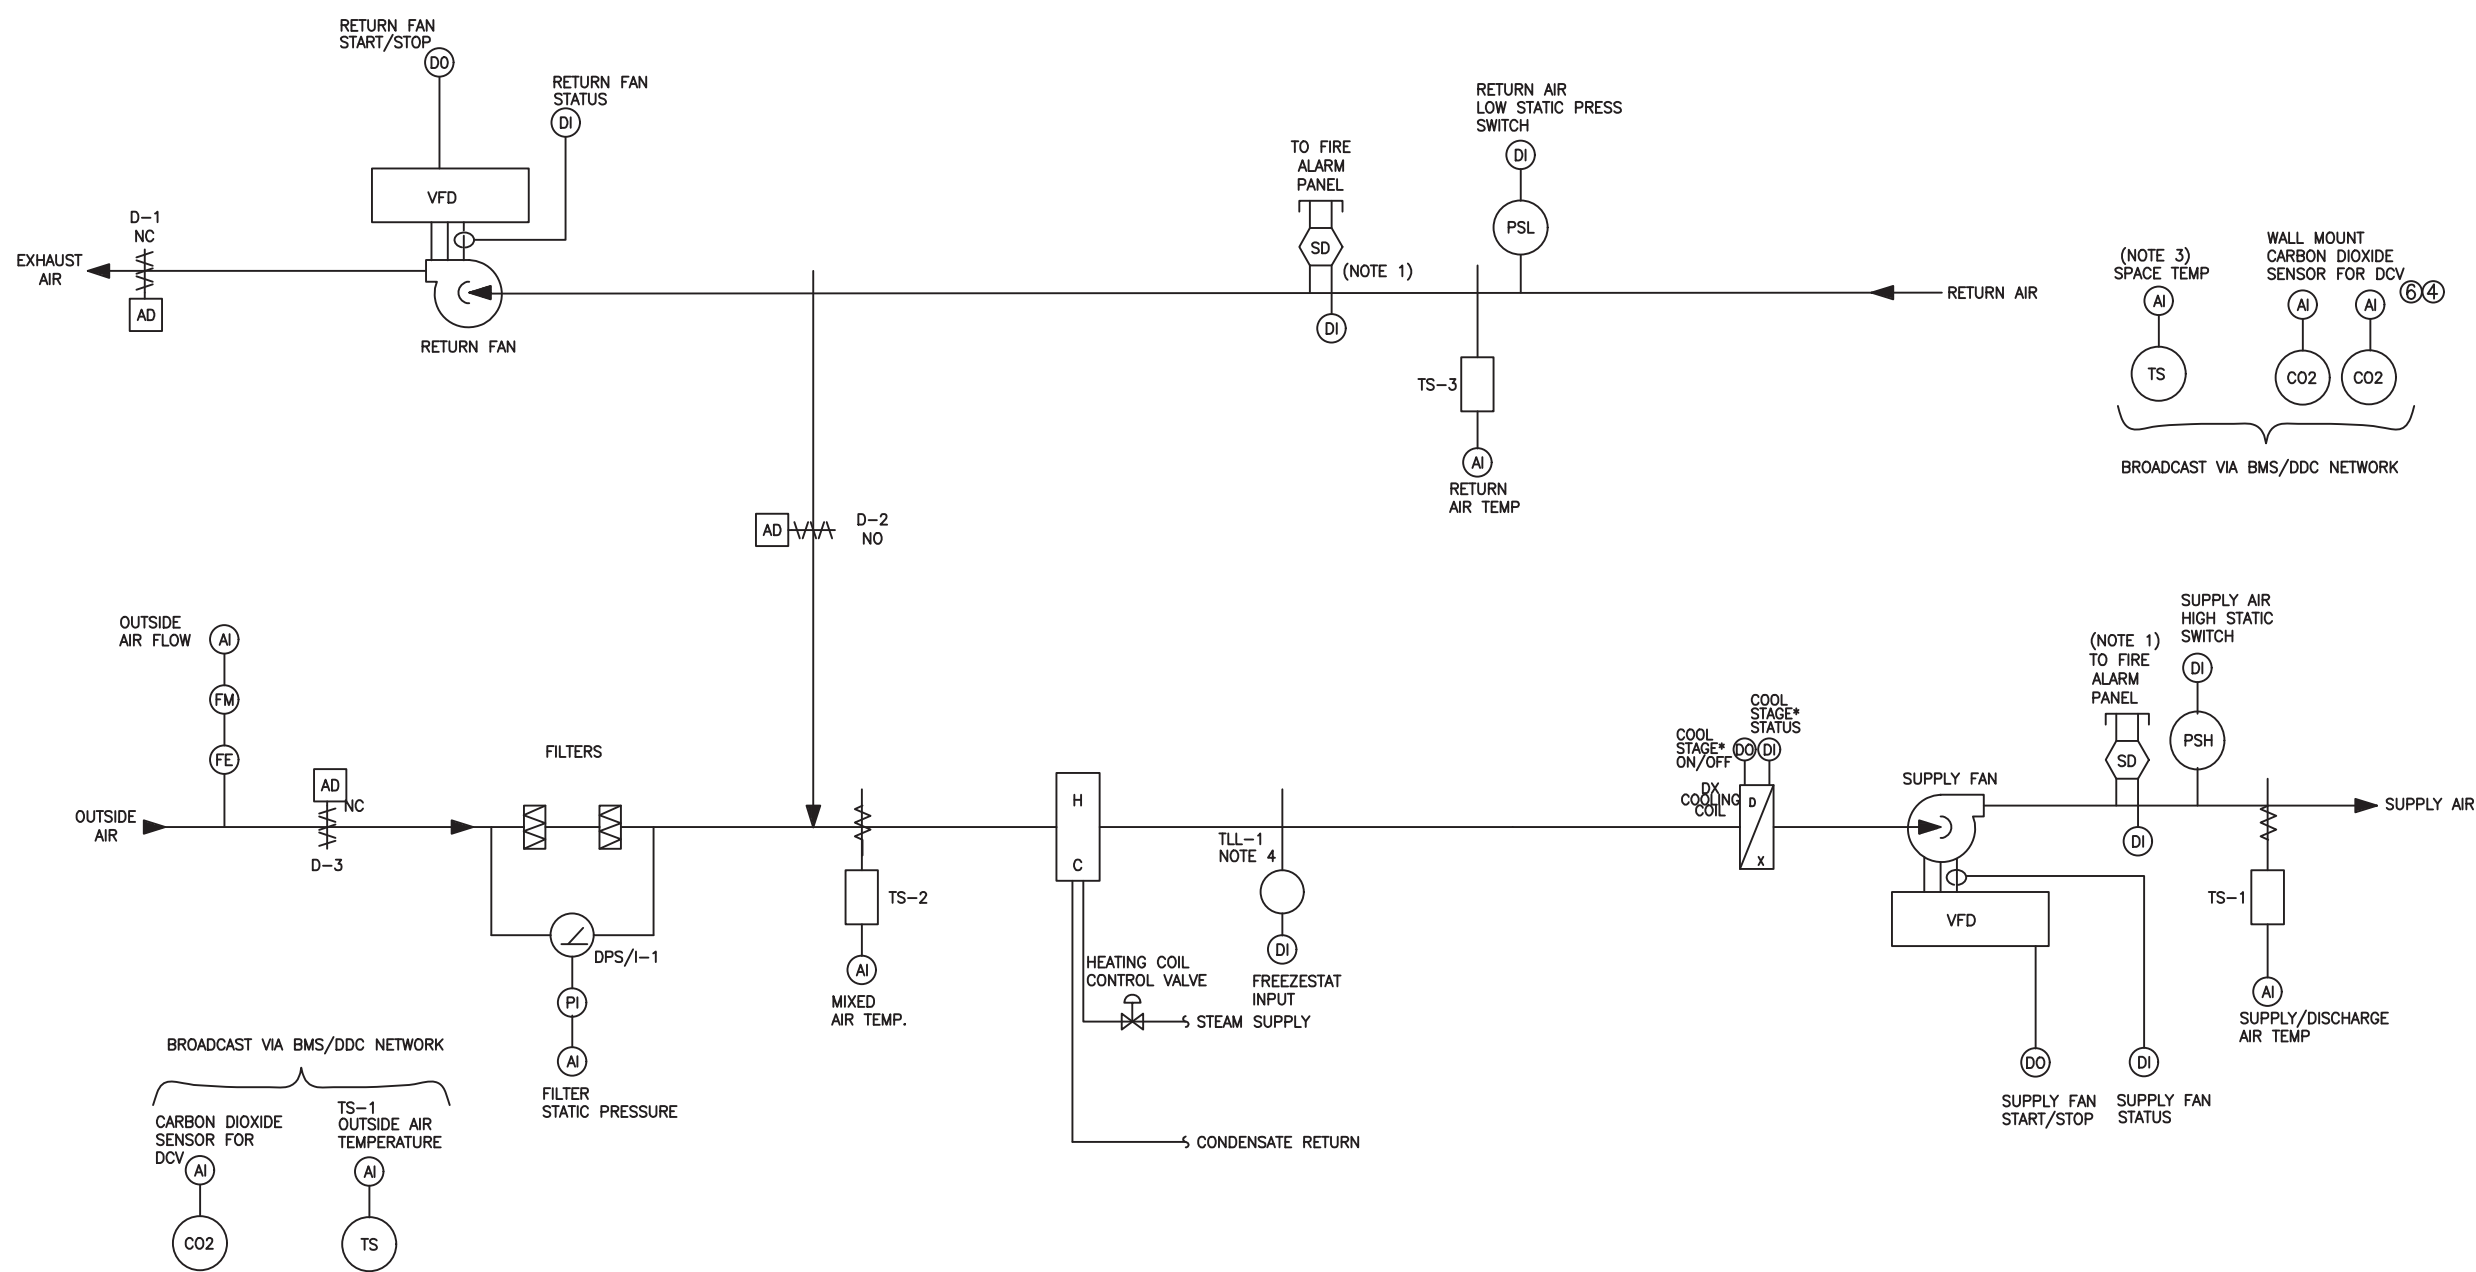

UNIT VENTILATOR SCHEDULE

SEE SCHEDULE NOTES 14, 15, 16 FOR ALL UNITS

7

UNIT TAG	LOCATION	TOTAL SUPPLY AIRFLOW (CFM)	MINIMUM OUTSIDE AIRFLOW (CFM)		MAXIMUM OUTSIDE AIRFLOW (CFM)	COOLING						HEATING				FILTER	ELECTRICAL			UNIT WEIGHT (LBS)	UNIT DIMENSIONS (LxDxH, IN) (V.I.F.)	BASIS OF DESIGN	REMARKS
			COOLING	HEATING		EADB (°F)	EAWB (°F)	LADB (°F)	LADB (°F)	MIN. SENSIBLE CAPACITY (BTU/H)	MIN. TOTAL CAPACITY (BTU/H)	EADB (°F)	LADB (°F)	STEAM PRESSURE (PSIG)	REQUIRED TOTAL CAPACITY (BTU/H)		MCA	MAX FUSE SIZE	VOLT/PH/HZ				
UV-101	101	750	400	400	750	80.0	67.0	54.7	52.4	17,810	28,250	12.0	102.6	2.0	63,200	13	4.5	15	115/1/60	320	69x21.25x30	TRANE VUVE0750	SEE NOTES 1-10
UV-102	102	750	400	400	750	80.0	67.0	54.7	52.4	17,810	28,250	12.0	102.6	2.0	63,200	13	4.5	15	115/1/60	320	69x21.25x30	TRANE VUVE0750	SEE NOTES 1-10
UV-103	103	750	400	400	750	80.0	67.0	54.7	52.4	17,810	28,250	12.0	102.6	2.0	63,200	13	4.5	15	115/1/60	320	69x21.25x30	TRANE VUVE0750	SEE NOTES 1-10
UV-104	104	750	375	375	750	80.0	67.0	54.7	52.4	17,810	28,250	12.0	102.6	2.0	63,200	13	4.5	15	115/1/60	320	69x21.25x30	TRANE VUVE0750	SEE NOTES 1-10
UV-105B	105	750	375	375	750	80.0	67.0	54.7	52.4	17,810	28,250	12.0	102.6	2.0	63,200	13	4.5	15	115/1/60	320	69x21.25x30	TRANE VUVE0750	SEE NOTES 1-10,11
UV-106	106	750	375	375	750	80.0	67.0	54.7	52.4	17,810	28,250	12.0	102.6	2.0	63,200	13	4.5	15	115/1/60	320	69x21.25x30	TRANE VUVE0750	SEE NOTES 1-10
UV-107	107	750	400	400	750	80.0	67.0	54.7	52.4	17,810	28,250	12.0	102.6	2.0	63,200	13	4.5	15	115/1/60	320	69x21.25x30	TRANE VUVE0750	SEE NOTES 1-10
UV-109	109	750	400	400	750	80.0	67.0	54.7	52.4	17,810	28,250	12.0	102.6	2.0	63,200	13	4.5	15	115/1/60	320	69x21.25x30	TRANE VUVE0750	SEE NOTES 1-10
UV-110	110	750	475	475	750	80.0	67.0	54.7	52.4	17,810	28,250	12.0	102.6	2.0	63,200	13	4.5	15	115/1/60	320	69x21.25x30	TRANE VUVE0750	SEE NOTES 1-10
UV-111	111	750	400	400	750	80.0	67.0	54.7	52.4	17,810	28,250	12.0	102.6	2.0	63,200	13	4.5	15	115/1/60	320	69x21.25x30	TRANE VUVE0750	SEE NOTES 1-10
UV-175	175	1500	850	850	1500	80.0	67.0	55.4	52.2	30,890	51,010	12.0	116.3	2.0	129,700	13	9.0	15	115/1/60	470	105x21.25x30	TRANE VUVE1500	SEE NOTES 1-10
UV-180A-1	180A	1000	525	525	1000	80.0	67.0	54.7	51.8	21,720	35,670	12.0	124.2	2.0	106,950	13	4.5	15	120/1/60	375	82.25x35.6x16.6	TRANE HUV1001	SEE NOTES 1-10,12
UV-180A-2	180A	1000	525	525	1000	80.0	67.0	54.7	51.8	21,720	35,670	12.0	124.2	2.0	106,950	13	4.5	15	120/1/60	375	82.25x35.6x16.6	TRANE HUV1001	SEE NOTES 1-10,12
UV-186	186	1000	500	500	1000	80.0	67.0	54.7	51.8	21,720	35,670	12.0	112.5	2.0	85,380	13	4.5	15	115/1/60	405	81x21.25x30	TRANE VUVE1000	SEE NOTES 1-10,11
UV-190	190	750	365	365	750	80.0	67.0	54.7	52.4	17,810	28,250	12.0	102.6	2.0	63,200	13	4.5	15	115/1/60	320	69x21.25x30	TRANE VUVE0750	SEE NOTES 1-10
UV-195A	195A	750	435	435	750	80.0	67.0	54.7	52.4	17,810	28,250	12.0	102.6	2.0	63,200	13	4.5	15	115/1/60	320	69x21.25x30	TRANE VUVE0750	SEE NOTES 1-10
UV-201	201	750	400	400	750	80.0	67.0	54.7	52.4	17,810	28,250	12.0	102.6	2.0	63,200	13	4.5	15	115/1/60	320	69x21.25x30	TRANE VUVE0750	SEE NOTES 1-10
UV-202	202	750	400	400	750	80.0	67.0	54.7	52.4	17,810	28,250	12.0	102.6	2.0	63,200	13	4.5	15	115/1/60	320	69x21.25x30	TRANE VUVE0750	SEE NOTES 1-10
UV-203	203	750	400	400	750	80.0	67.0	54.7	52.4	17,810	28,250	12.0	102.6	2.0	63,200	13	4.5	15	115/1/60	320	69x21.25x30	TRANE VUVE0750	SEE NOTES 1-10
UV-204	204	750	300	300	750	80.0	67.0	54.7	52.4	17,810	28,250	12.0	102.6	2.0	63,200	13	4.5	15	115/1/60	320	69x21.25x30	TRANE VUVE0750	SEE NOTES 1-10
UV-306	306	1000	500	500	1000	80.0	67.0	54.7	51.8	21,720	35,670	12.0	112.5	2.0	85,380	13	4.5	15	115/1/60	405	81x21.25x30	TRANE VUVE1000	SEE NOTES 1-10
UV-307	307	1000	400	400	1000	80.0	67.0	54.7	51.8	21,720	35,670	12.0	112.5	2.0	85,380	13	4.5	15	115/1/60	405	81x21.25x30	TRANE VUVE1000	SEE NOTES 1-10
UV-310	310	750	400	400	750	80.0	67.0	54.7	52.4	17,810	28,250	12.0	102.6	2.0	63,200	13	4.5	15	115/1/60	320	105x21.25x30	TRANE VUVE1500	SEE NOTES 1-10
UV-311	311	1500	625	625	1500	80.0	67.0	55.4	52.2	30,890	51,010	12.0	116.3	2.0	129,700	13	9.0	15	115/1/60	470	105x21.25x30	TRANE VUVE1500	SEE NOTES 1-10
UV-312	312	750	400	400	750	80.0	67.0	54.7	52.4	17,810	28,250	12.0	102.6	2.0	63,200	13	4.5	15	115/1/60	320	69x21.25x30	TRANE VUVE0750	SEE NOTES 1-10
UV-313	313	1500	575	575	1500	80.0	67.0	55.4	52.2	30,890	51,010	12.0											

UNIT VENTILATOR SCHEDULE NOTES:

1. PROVIDE VARIABLE VOLUME SPEED CONTROL ECM MOTORS. MOTOR CONTROL TO BE FIELD INSTALLED.
2. PROVIDE LOW LEAKAGE OUTSIDE AIR DAMPER, CLASS 1 MOTORIZED DAMPERS, LOW LEAKAGE TYPE FOR OUTSIDE AIR AND EXHAUST OPENINGS. AIR LEAKAGE SHALL NOT BE GREATER THAN 4CFM/FT<sup>2</sup> AND BE IN ACCORDANCE WITH AMCA 5000.
3. PROVIDE FIXED DRY-BULB ECONOMIZER WITH FAULT DETECTION DIAGNOSIS.
4. PROVIDE DISCONNECT SWITCH.
5. CONTRACTOR TO VERIFY STEAM HEAT COIL PIPING CONNECTIONS AND NEW DX COIL PIPING CONNECTIONS PRIOR TO ORDERING. STEAM HEAT COILS SHALL MATCH EXISTING LOCATIONS. TYPICAL LOCATIONS ARE AS FOLLOWS: ELECTRICAL - LH SIDE, STEAM - RH SIDE, DX - RH SIDE.
6. AT COMPLETION OF UV INSTALLATION, CONTRACTOR SHALL INSTALL MERV-13 FILTERS FURNISHED BY THE UNIT MANUFACTURER.
7. PROVIDE MODULATING TWO-WAY STEAM CONTROL VALVE.
8. CABINET COLOR TO BE OF DELUXE BEIGE FINISH U.O.N. BY ARCHITECT AND/OR FACILITIES.
9. PROVIDE HEAVY GAUGE FRONT PANEL AND CUT-TO-FIT FILLER PANELS ON BOTH SIDES OF THE UNIT VENTILATOR TO MATCH THE INSTALLED WIDTH OF THE EXISTING UNITS AND ENCLOSE EXISTING PIPING.
10. PROVIDE FIELD INSTALLED DDC CONTROLS TO SATISFY SEQUENCE OF OPERATIONS, COORDINATE/INTEGRATE WITH EXISTING SIEMENS BMS. SEE DRAWING M004 FOR MORE INFO. PROVIDE LEV KIT AS PER INDOOR UNIT SCHEDULE, SEE DRAW

NOTES:

- FURNISH AND INSTALL NEW VERTICAL UNIT VENTILATOR. REFER TO THE UNIT VENTILATOR SCHEDULE ON DRAWING M-006 AND DETAILS ON DRAWING M-501. CONNECT OUTSIDE AIR DUCT TO EXISTING OUTSIDE AIR OPENING/LOUVER.
- FURNISH AND INSTALL NEW VERTICAL UNIT VENTILATOR. UTILIZE EXISTING ORIGINAL BUILT-IN CABINETY ENCLASURE. REFER TO THE UNIT VENTILATOR SCHEDULE ON DRAWING M-006 AND DETAILS ON DRAWING M-501. CONNECT OUTSIDE AIR DUCT TO EXISTING OUTSIDE AIR OPENING/LOUVER.
- FURNISH AND INSTALL NEW HORIZONTAL UNIT VENTILATOR WITH NEW CEILING SUPPORTS. REFER TO THE UNIT VENTILATOR SCHEDULE ON DRAWING M-006 AND DETAILS ON DRAWING M-501.
- FURNISH AND INSTALL NEW EVAPORATOR/AC INDOOR UNIT. REFER TO VRF HEAT RECOVERY INDOOR UNIT SCHEDULE ON DRAWING M-003 AND DETAILS ON DRAWING M-501.
- FURNISH AND INSTALL NEW OUTSIDE AIR INTAKE LOUVER AT WINDOW INSULATED PANEL. GC TO PROVIDE OPENING TO ACCOMMODATE NEW LOUVER. COORDINATE OPENINGS WITH THE ARCHITECT AND GC. FURNISH AND INSTALL OUTSIDE AIR DUCT CONNECTION TO LOUVER WITH VOLUME DAMPER, SEE PLANS FOR DUCT SIZE.
- EXISTING OUTSIDE AIR WALL LOUVER TO REMAIN. SIZE VARIES PER EACH ROOM. CONNECT OA INTAKE DUCT TO EXISTING LOUVER. SEE DETAILS ON DRAWING M-501.
- FURNISH AND INSTALL NEW PROGRAMMABLE ELECTRONIC THERMOSTAT WITH LOCKING GUARD. INTEGRATE WITH THE SIEMENS BMS.
- FURNISH AND INSTALL NEW RELIEF AIR LOUVER 24x12 WITH MOTORIZED DAMPER(24x12), PROVIDE NEW OPENING AT INSULATED PANEL. COORDINATE OPENINGS WITH GC, SEE ARCHITECTURAL DETAILS. SEE DETAIL 9/M-501.
- PROVIDE SUPPLY DIFFUSER WITH VOLUME DAMPER AND ASSOCIATED INSULATED DUCTWORK AS INDICATED. FLEX DUCT SHALL BE LIMITED TO 3'-0" MAX. BASIS OF DESIGN, FOR CEILING: TITUS TMS OR EQUAL, FOR SIDE: TITUS 300/350 OR EQUAL.
- PROVIDE 24x24 RETURN GRILLE IN EXISTING LAY-IN ACOUSTIC CEILING OR NEW SOFFIT. BASIS OF DESIGN: TITUS 45F OR EQUAL.
- THE EXISTING DOOR UNDERCUT IS SUFFICIENT FOR AIR TRANSFER TO THE ADJACENT SPACE.
- PROVIDE NEW DOOR UNDERCUT IN SPACE FOR SUFFICIENT AIR TRANSFER OF RELIEF AIR, SEE ARCHITECT DRAWINGS.
- FURNISH AND INSTALL NEW WALL MOUNT CARBON DIOXIDE SENSOR FOR NEW RTU. REFER TO DRAWING M-004 FOR CONTROL DIAGRAM. MOUNT THE SENSOR ON INSIDE WALL OR PANEL APPROXIMATELY 54" ABOVE THE FLOOR (OR OTHERWISE DIRECTED) TO ALLOW EXPOSURE TO THE AVERAGE ZONE TEMPERATURE. FOR ACCURATE TEMPERATURE SENSING DO NOT MOUNT DEVICE ON OUTSIDE WALL, ADJACENT TO PIPES, IN DIRECT SUNLIGHT, NEAR RADIANT HEAT SOURCES, AIR DUCTS, ETC. THAT COULD IMPACT SENSING ACCURACY. REFER TO MANUFACTURER'S IOM INSTRUCTIONS FOR MORE INFO.
- PROVIDE NEW NON-FLANGED LOUVER AT EXISTING OPENING. INFILL EXISTING OPENING TO ACCOMMODATE NEW LOUVER. SEE ARCHITECT'S PLANS FOR PATCHING AND REPAIR DETAILS AT BUILDING FACADE.
- FURNISH AND INSTALL DUCT SMOKE DETECTOR ON STRAIGHT DUCT, COORDINATE INSTALLATION WITH ELECTRICAL. FURNISH AND INSTALL FIRE SMOKE DAMPER AT ROOF PENETRATION. (TYP. 4).
- CONTRACTOR RESPONSIBLE TO FIELD VERIFY AND MEASURE ROUTING OF NEW DUCTWORK AT STAGE AREA FOR THE NEW RTUs. AVOID ANY CONFLICTS/INTERFERENCE WITH EXISTING CONDITIONS, SUCH AS THE CABLES AND PULLEYS FOR THE STAGE CURTAINS. DUCTWORK SHALL BE ROUTED HIGH AT WALL. SUPPLY DUCTWORK IS TO BE INSULATED. RETURN DUCTWORK TO BE PAINTED BLACK. VERIFY FINISH REQUIREMENTS WITH ARCHITECT.
- ALTERNATE 5: INSTALL NEW STEAM HEATING COIL. SEE STEAM HEATING COIL SCHEDULE ON M-002. SEE DRAWING M-303 FOR PIPING LOCATION AND DETAIL 3/M501.

GENERAL NOTE:



FOR PIPING LAYOUT FOR EACH NEW EQUIPMENT, REFER TO DRAWINGS M-301, M-302 AND M-303.

NOTES

NOTE: ANY GC WORK NOT RELATED TO INSTALLATION OF MECHANICAL EQUIPMENT TO BE PART OF PHASE A.

PHASE B WORK. ALL WORK REGARDING UV AND CU INSTALLATION WITHIN THIS AREA TO BE PERFORMED IN PHASE B.

PHASE A WORK. ALL WORK REGARDING UV AND CU INSTALLATION WITHIN THIS AREA TO BE PERFORMED IN PHASE A.

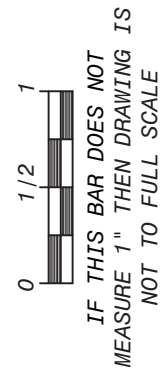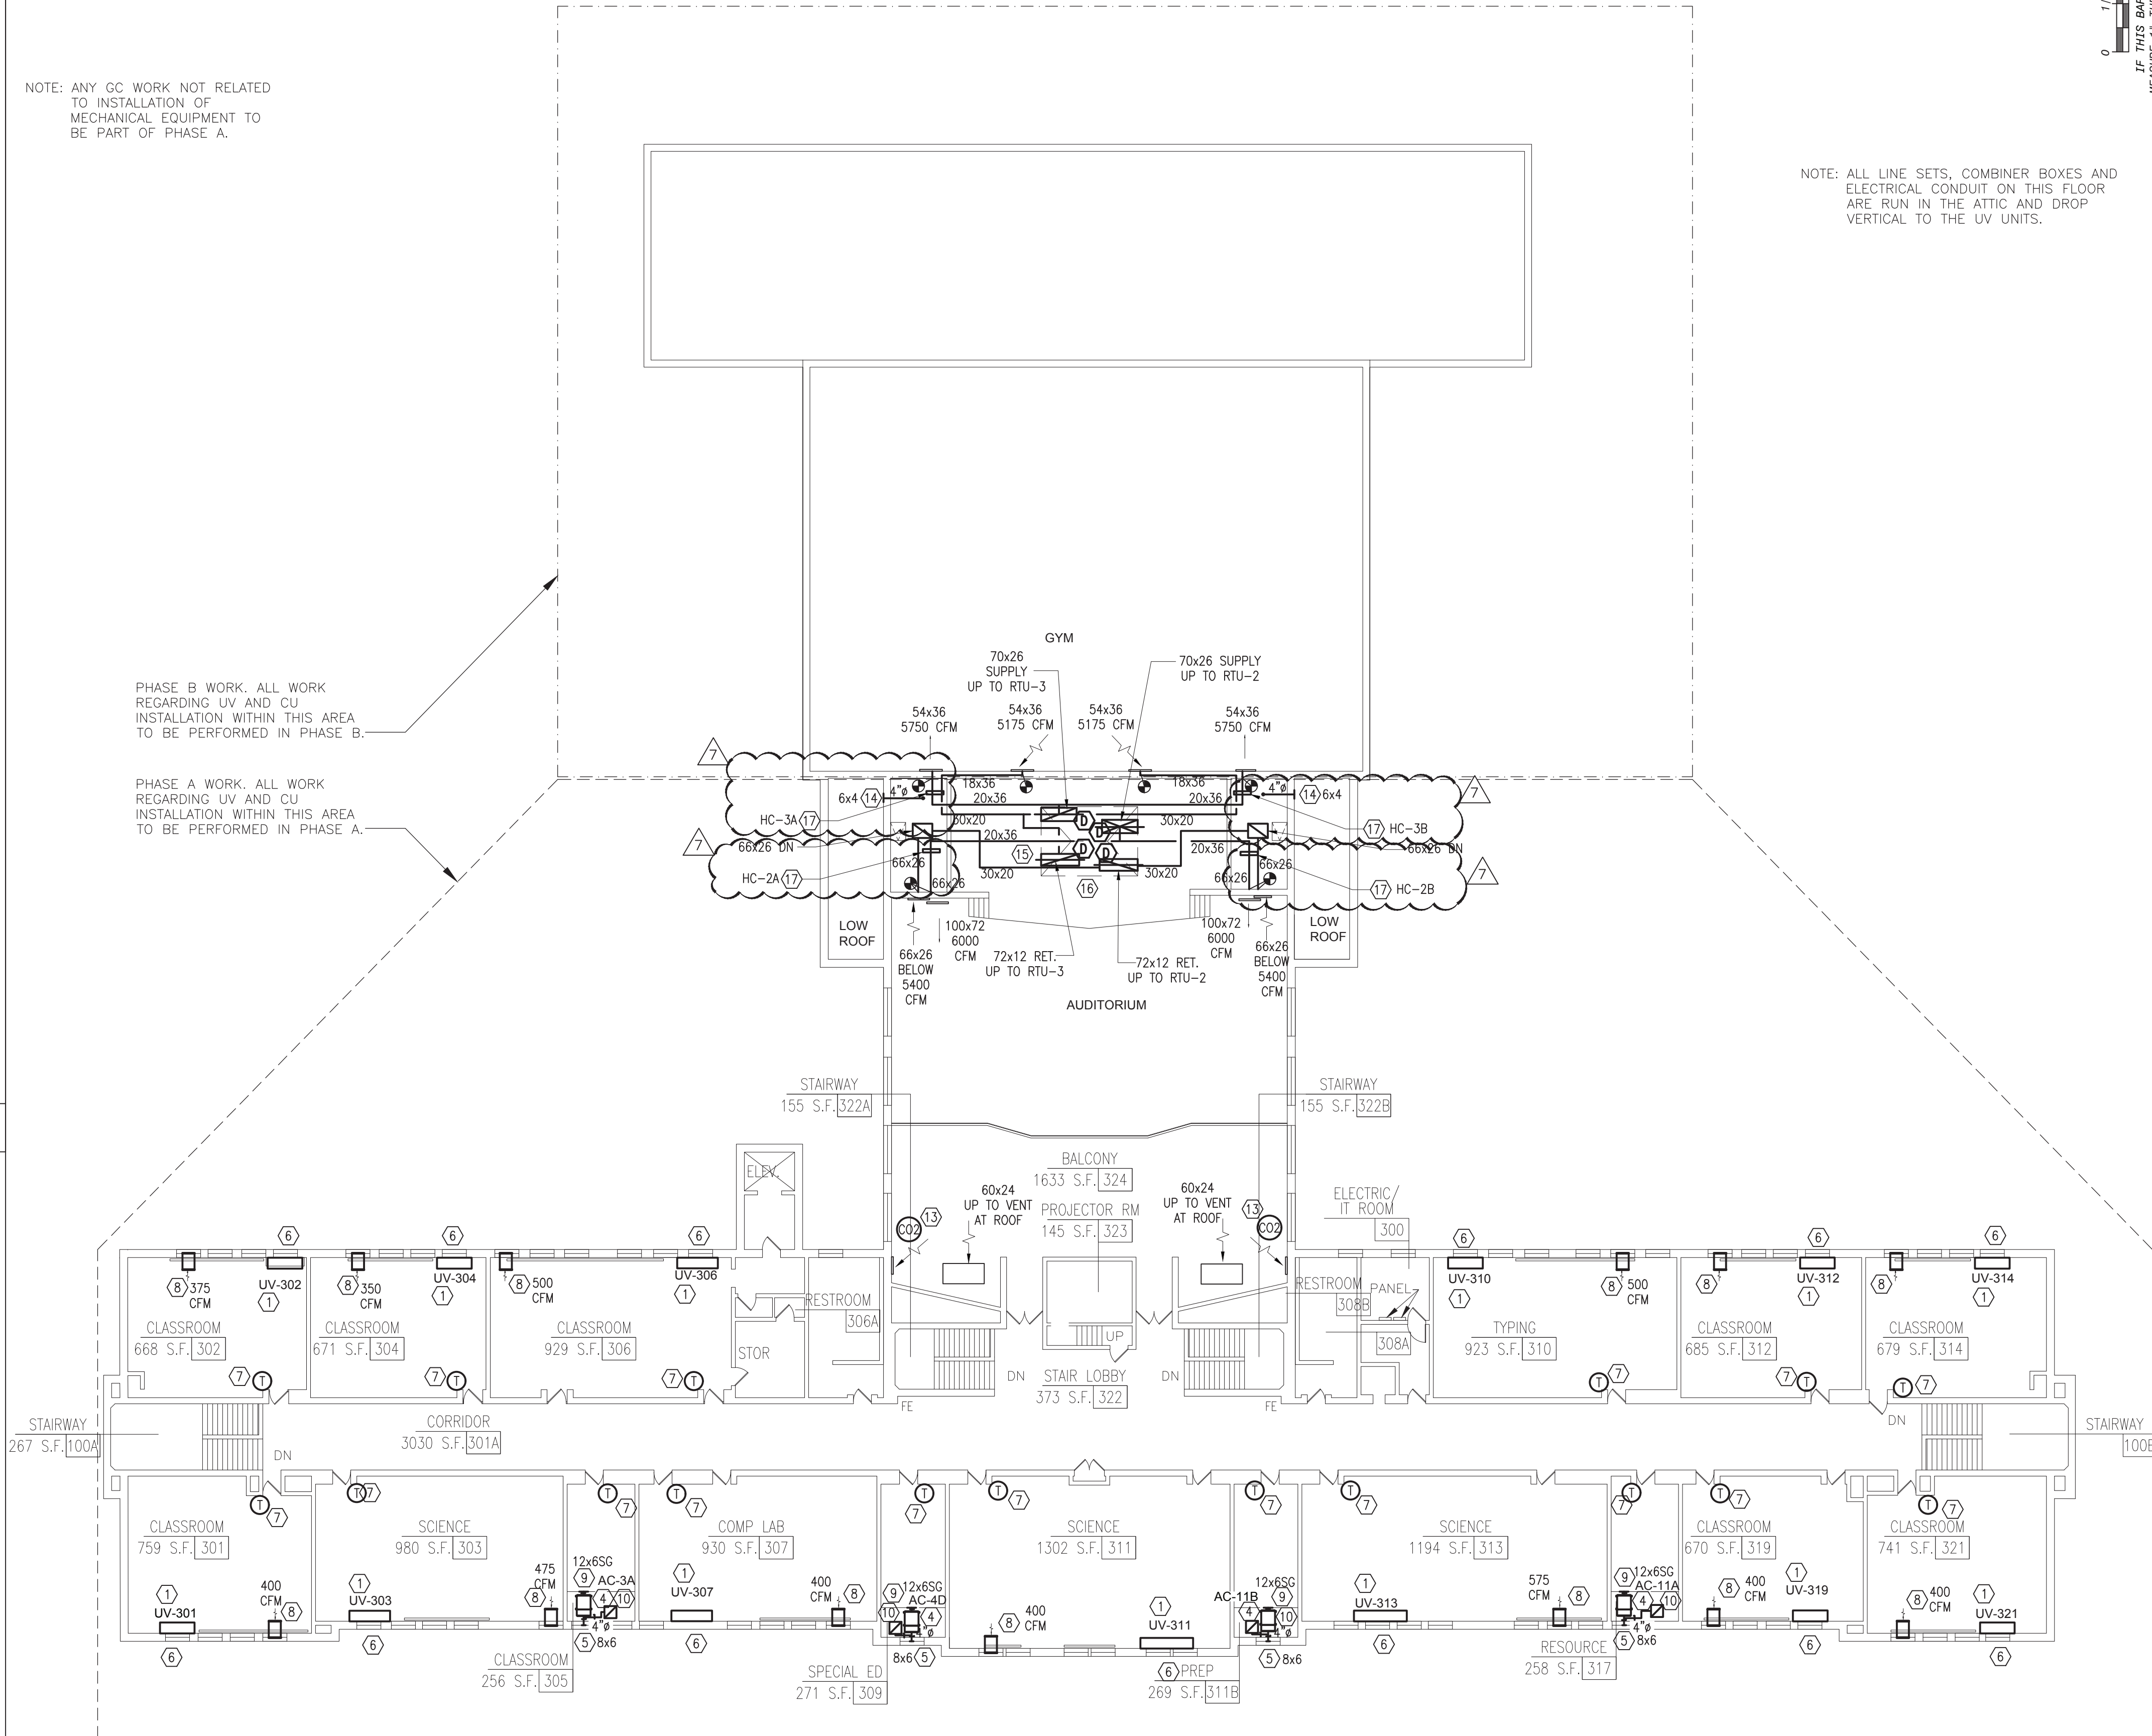

NOTE: ALL LINE SETS, COMBINER BOXES AND ELECTRICAL CONDUIT ON THIS FLOOR ARE RUN IN THE ATTIC AND DROP VERTICAL TO THE UV UNITS.

1 THIRD FLOOR PLAN  
SCALE: 1/16" = 1'-0"




© COPYRIGHT, MICHAEL SHILALE ARCHITECTS, ALL RIGHTS RESERVED.

Drawing Title

3RD FLOOR  
PLAN -  
MECHANICAL

Drawing No.

M-103

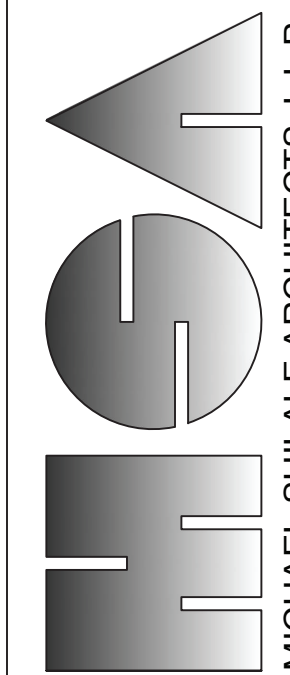

MICHAEL SHILALE ARCHITECTS, L.L.P.  
New City, NY 10956 Tel 845-708-9200  
140 Park Avenue  
www.shilale.com

UNIVENT REPLACEMENT  
AT  
HAVERSTRAW  
ELEMENTARY  
SED# 50-02-01-06-0-009-018  
18 Grant Street  
Haverstraw, NY 10627  
COUNTY OF ROCKLAND

GREENMAN  
PEDERSEN, INC  
400 BELLA BOULEVARD  
MONTICELLO, NY 10901  
Mechanical  
Structural  
Engineer:  
Engineer:

Drawn by WM  
Checked by ERF  
Project No. 41048  
Scale AS NOTED  
Date 08-30-21  
Revisions

NOTES:

1

DEMOLISH EXISTING GRAVITY VENTILATOR AND DAMPER AT ROOF. DEMOLISH ASSOCIATED DUCTWORK DIRECTLY BELOW ROOF. DISCONNECT DAMPER FROM SIEMENS BMS CONTROL.

2

PROVIDE NEW OUTDOOR CONDENSING UNIT, SEE SCHEDULE ON DRAWING M-002. MOUNT UNIT ON MODIFIED ROOF CURB/DUNNAGE, SEE STRUCTURAL DRAWINGS.

3

PROVIDE NEW DX PIPING FROM BRANCH CONTROLLER, SEE FLOOR BELOW. FOR ROOF CURB AND ROOF SUPPORT DETAIL, SEE DRAWING M-502 AND ARCHITECTURAL DRAWINGS FOR PROPER SEALING FOR PIPE SIZES, SEE DRAWING M-401.

4

PROVIDE NEW ROOFTOP AIR HANDLING UNIT AT LOCATION OF EXISTING SKYLIGHT, SEE SCHEDULE ON DRAWING M-002. GC TO DEMO EXISTING SKYLIGHT. MOUNT AHUS ON NEW ROOF CURB. PROVIDE ADEQUATE CLEARANCE AS PER MANUFACTURER'S IOM. SEE DETAILS FOR MORE INFO.

5

EXISTING GRAVITY VENTILATOR TO REMAIN.

6

PROVIDE NEW CONDENSATE DRAINAGE, TERMINATE ON ROOF TO NEAREST DRAIN. PROVIDE SPLASH BLOCK. SEE DETAIL 5/M501 FOR SUPPORT OF PIPING ON ROOF.

7

PROVIDE NEW STEAM AND CONDENSATE PIPING, CONNECT TO EXISTING MAIN. SEE DETAIL 3/M501. PROVIDE FACTORY ASSEMBLED PIPE CABINET WITH ROOFTOP AIR HANDLING UNIT. EXTEND BASE FLASHING TO CURB.

8


ALTERNATE 5: OMIT INSTALLATION OF NEW STEAM & CONDENSATE PIPING ON ROOF. SEE DRAWING M-303 FOR SCOPE OF WORK.

NOTES

NOTE: ANY GC WORK NOT RELATED TO INSTALLATION OF MECHANICAL EQUIPMENT TO BE PART OF PHASE A.

PHASE B WORK. ALL WORK REGARDING UV AND CU INSTALLATION WITHIN THIS AREA TO BE PERFORMED IN PHASE B.


PHASE A WORK. ALL WORK REGARDING UV AND CU INSTALLATION WITHIN THIS AREA TO BE PERFORMED IN PHASE A.

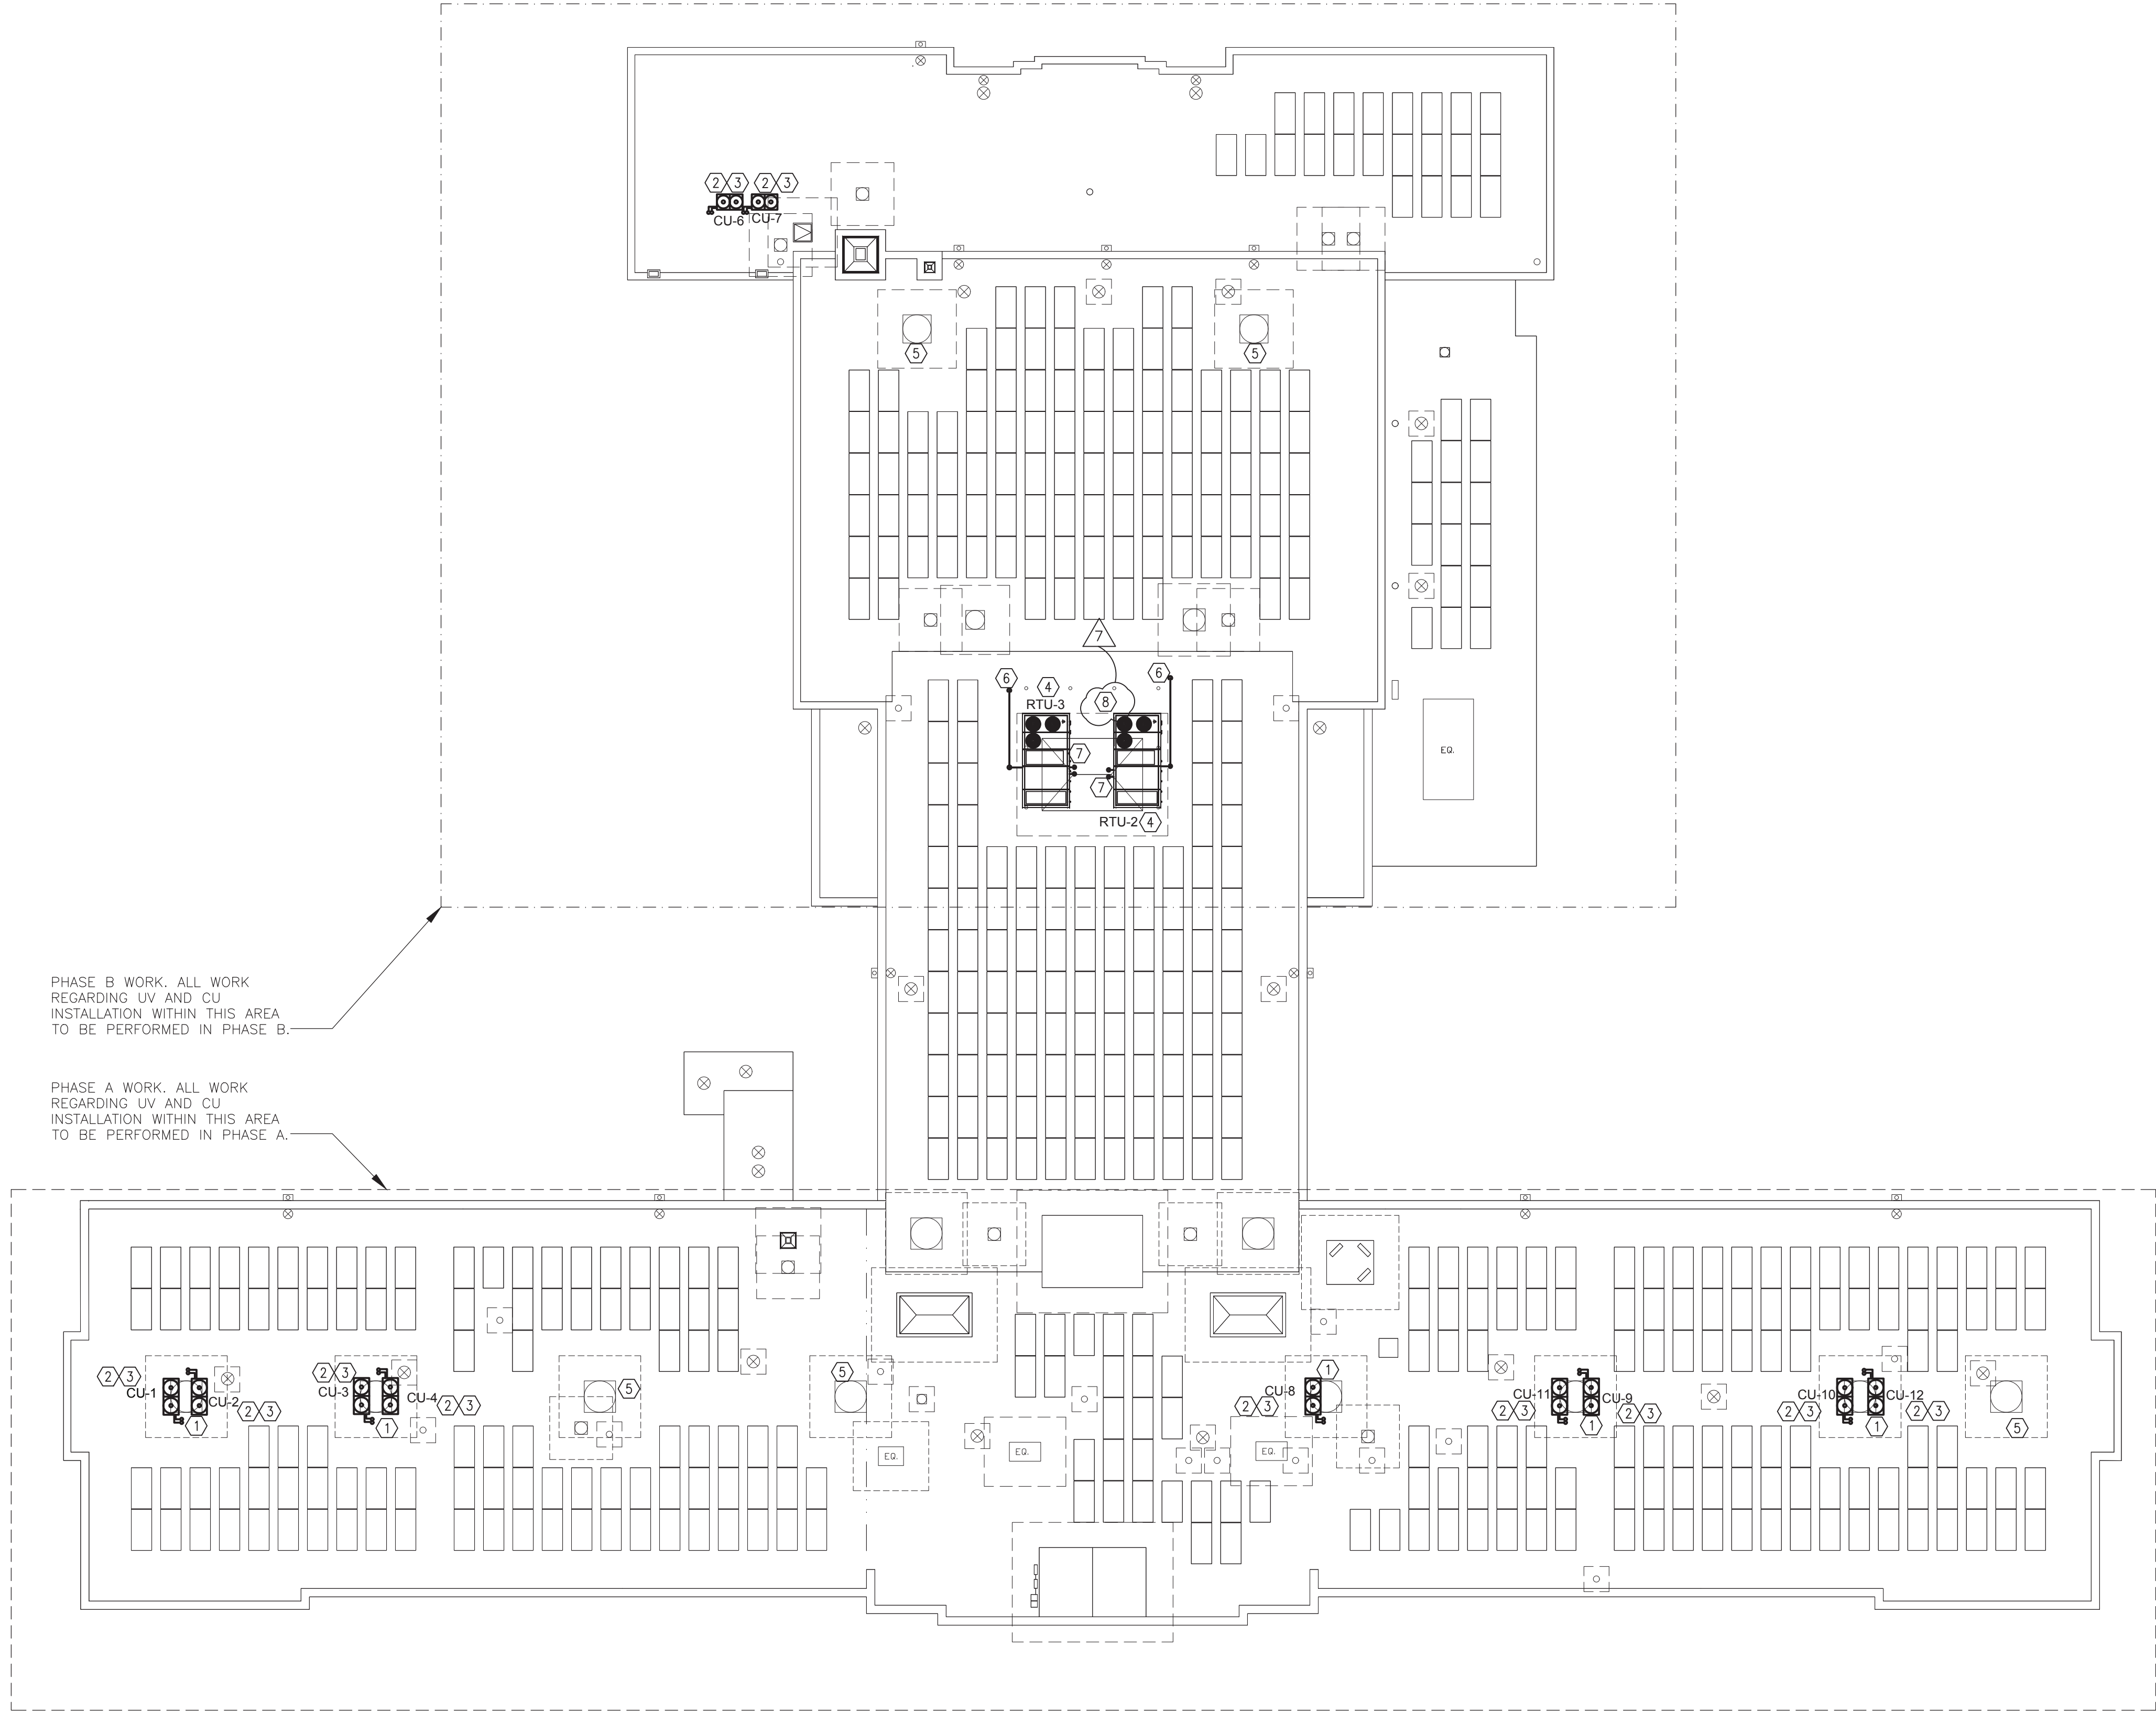

1

ROOF PLAN

SCALE: 1/16" = 1'-0"

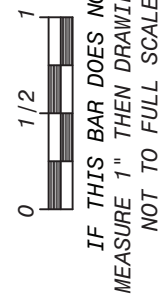

© COPYRIGHT, MICHAEL SHILALE ARCHITECTS. ALL RIGHTS RESERVED.

Drawing Title

ROOF PLAN -  
MECHANICAL

Drawing No.

M-104

GREENMAN  
PEDERSEN, INC  
400 BELLA BOULEVARD  
MONTROSE, NY 10901

Mechanical  
Electrical  
Engineer:


Structural  
Engineer:

UNIVENT REPLACEMENT  
AT  
HAVERSTRAW  
ELEMENTARY

SED# 50-02-01-06-0-009-018

18 Grant Street  
Haverstraw, NY 10627

COUNTY OF ROCKLAND

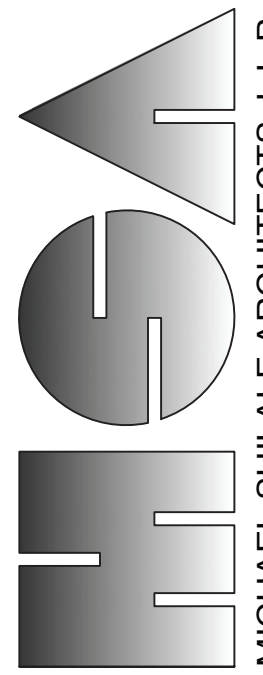

MICHAEL SHILALE ARCHITECTS, L.L.P.  
140 Park Avenue  
New City, NY 10958 Tel 845-708-9200  
www.shilale.com

ROOF PLAN -  
MECHANICAL

Drawing No.

M-104

Drawn by

WM

Checked by

ERF

Project No.

41048

Scale

AS NOTED

Date

08-30-21

GREENMAN  
PEDERSEN, INC  
400 BELLA BOULEVARD  
MONTROSE, NY 10901

Mechanical  
Electrical  
Engineer:


Structural  
Engineer:

UNIVENT REPLACEMENT  
AT  
HAVERSTRAW  
ELEMENTARY

SED# 50-02-01-06-0-009-018

18 Grant Street  
Haverstraw, NY 10627

COUNTY OF ROCKLAND

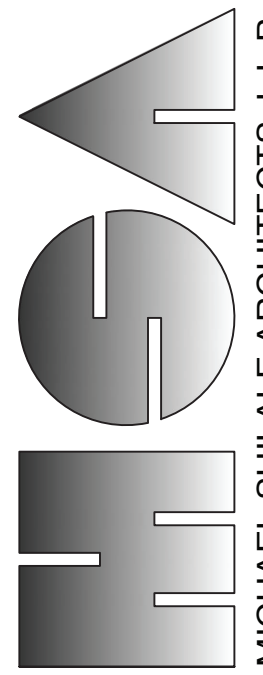

MICHAEL SHILALE ARCHITECTS, L.L.P.  
140 Park Avenue  
New City, NY 10958 Tel 845-708-9200  
www.shilale.com

ROOF PLAN -  
MECHANICAL

Drawing No.

M-104

No.	Date	Revisions
1	08-30-21	BIDDING DOCUMENTS
2	11-19-21	SED ADDENDUM 1
3	12-17-21	ISSUED FOR BID
6	01-28-22	ADDENDUM 5
7	02-17-22	ADDENDUM 7



Drawn by	WM
Checked by	ERF
Project No.	41048
Scale	AS NOTED
Date	08-30-21

Mechanical Electrical Engineer:	GREENMAN PEDERSEN, INC 400 BELLA BOULEVARD MONTROSE, NY 10901
Structural Engineer:	- - -



UNIVENT REPLACEMENT AT HAVERSTRAW ELEMENTARY	SED# 50-02-01-06-0-009-018	COUNTY OF ROCKLAND
18 Grant Street Haverstraw, NY 10627		

MICHAEL SHILALE ARCHITECTS, L.L.P. 140 Park Avenue New City, NY 10958 Tel 845-708-9200 www.shilale.com
--

- ① FURNISH AND INSTALL NEW STEAM PIPING AND INSULATION AT COIL CONNECTIONS AT NEW UNIT VENTILATOR. SEE DETAIL 4/M-501. ALL PENETRATIONS THROUGH FIRE-RATED CONSTRUCTION SHALL BE SLEEVED/FIRESTOPPED, SEE DETAILS ON M-502. PROVIDE ADEQUATE SUPPORTS THROUGHOUT, SEE DETAILS ON M-502.
- ② FURNISH AND INSTALL NEW DX PIPING WITH INSULATION AT NEW INDOOR UNIT. FOR PIPE SIZES REFER TO DRAWING M-401. ALL PENETRATIONS THROUGH FIRE-RATED CONSTRUCTION SHALL BE SLEEVED/FIRESTOPPED, SEE DETAILS ON M-502. PROVIDE ADEQUATE SUPPORTS THROUGHOUT, SEE DETAILS ON M-502.
- ③ FURNISH AND INSTALL LEV KIT FOR NEW UNIT VENTILATOR, SEE VRF INDOOR UNIT SCHEDULE ON DRAWING M-003.
- ④ FURNISH AND INSTALL NEW BRANCH CIRCUIT CONTROLLER, SEE BC CONTROLLER SCHEDULE ON DRAWING M-002. FURNISH AND INSTALL 3/4" CONDENSATE DRAINAGE PIPING FOR EACH BRANCH CONTROLLER. TERMINATE DRAIN IN AIR GAP AT NEAREST JANITOR SINK. FOLLOW MANUFACTURER'S IOM MANUAL FOR ADDITIONAL INSTRUCTIONS.
- ⑤ FURNISH AND INSTALL ENCLOSURE TO CONCEAL EXPOSED PIPING CONNECTED TO UNIT. SEE ARCH PLANS FOR DETAILS, FINISH AND COLOR. ENCLOSURE SHALL BE REMOVABLE AND CONSTRUCTED OF 24 GA STEEL. ENCLOSURE SHALL BE PAINTED TO MATCH EXISTING FINISHES. VERIFY COLOR FINISH WITH ARCHITECT AND FACILITIES.
- ⑥ FURNISH AND INSTALL NEW STEAM SUPPLY AND RETURN PIPING AND INSULATION AT COIL CONNECTIONS FOR NEW RTU. SEE DETAIL 3/M-501. FIRESTOP ALL RATED PENETRATIONS, SEE DRAWING M-502.
- ⑦ AT EACH UNIT VENTILATOR, FURNISH AND INSTALL NEW 3/4" CONDENSATE DRAIN FROM DRAIN PAN. TERMINATE AT BUILDING EXTERIOR WALL, SEE DETAIL 1/M501.
- ⑧ AT EACH APVATOR INDOOR UNIT, FURNISH AND INSTALL NEW 3/4" CONDENSATE DRAIN. TERMINATE DRAIN AT BUILDING EXTERIOR WALL THROUGH INSULATED PANEL BENEATH NEW OUTSIDE AIR LOUVER.
- ⑨ ALTERNATE #5: PROVIDE NEW STEAM HEATING COIL, SEE STEAM HEATING COIL SCHEDULE ON M-002. SEE DET. 3/M501 FOR PIPING, VALVE AND CONTROL ARRANGEMENTS.

FOR APPROXIMATE REFRIGERANT PIPE SIZES AND LENGTHS, SEE VRF PIPING RISERS DRAWING M-401.

## NOTES

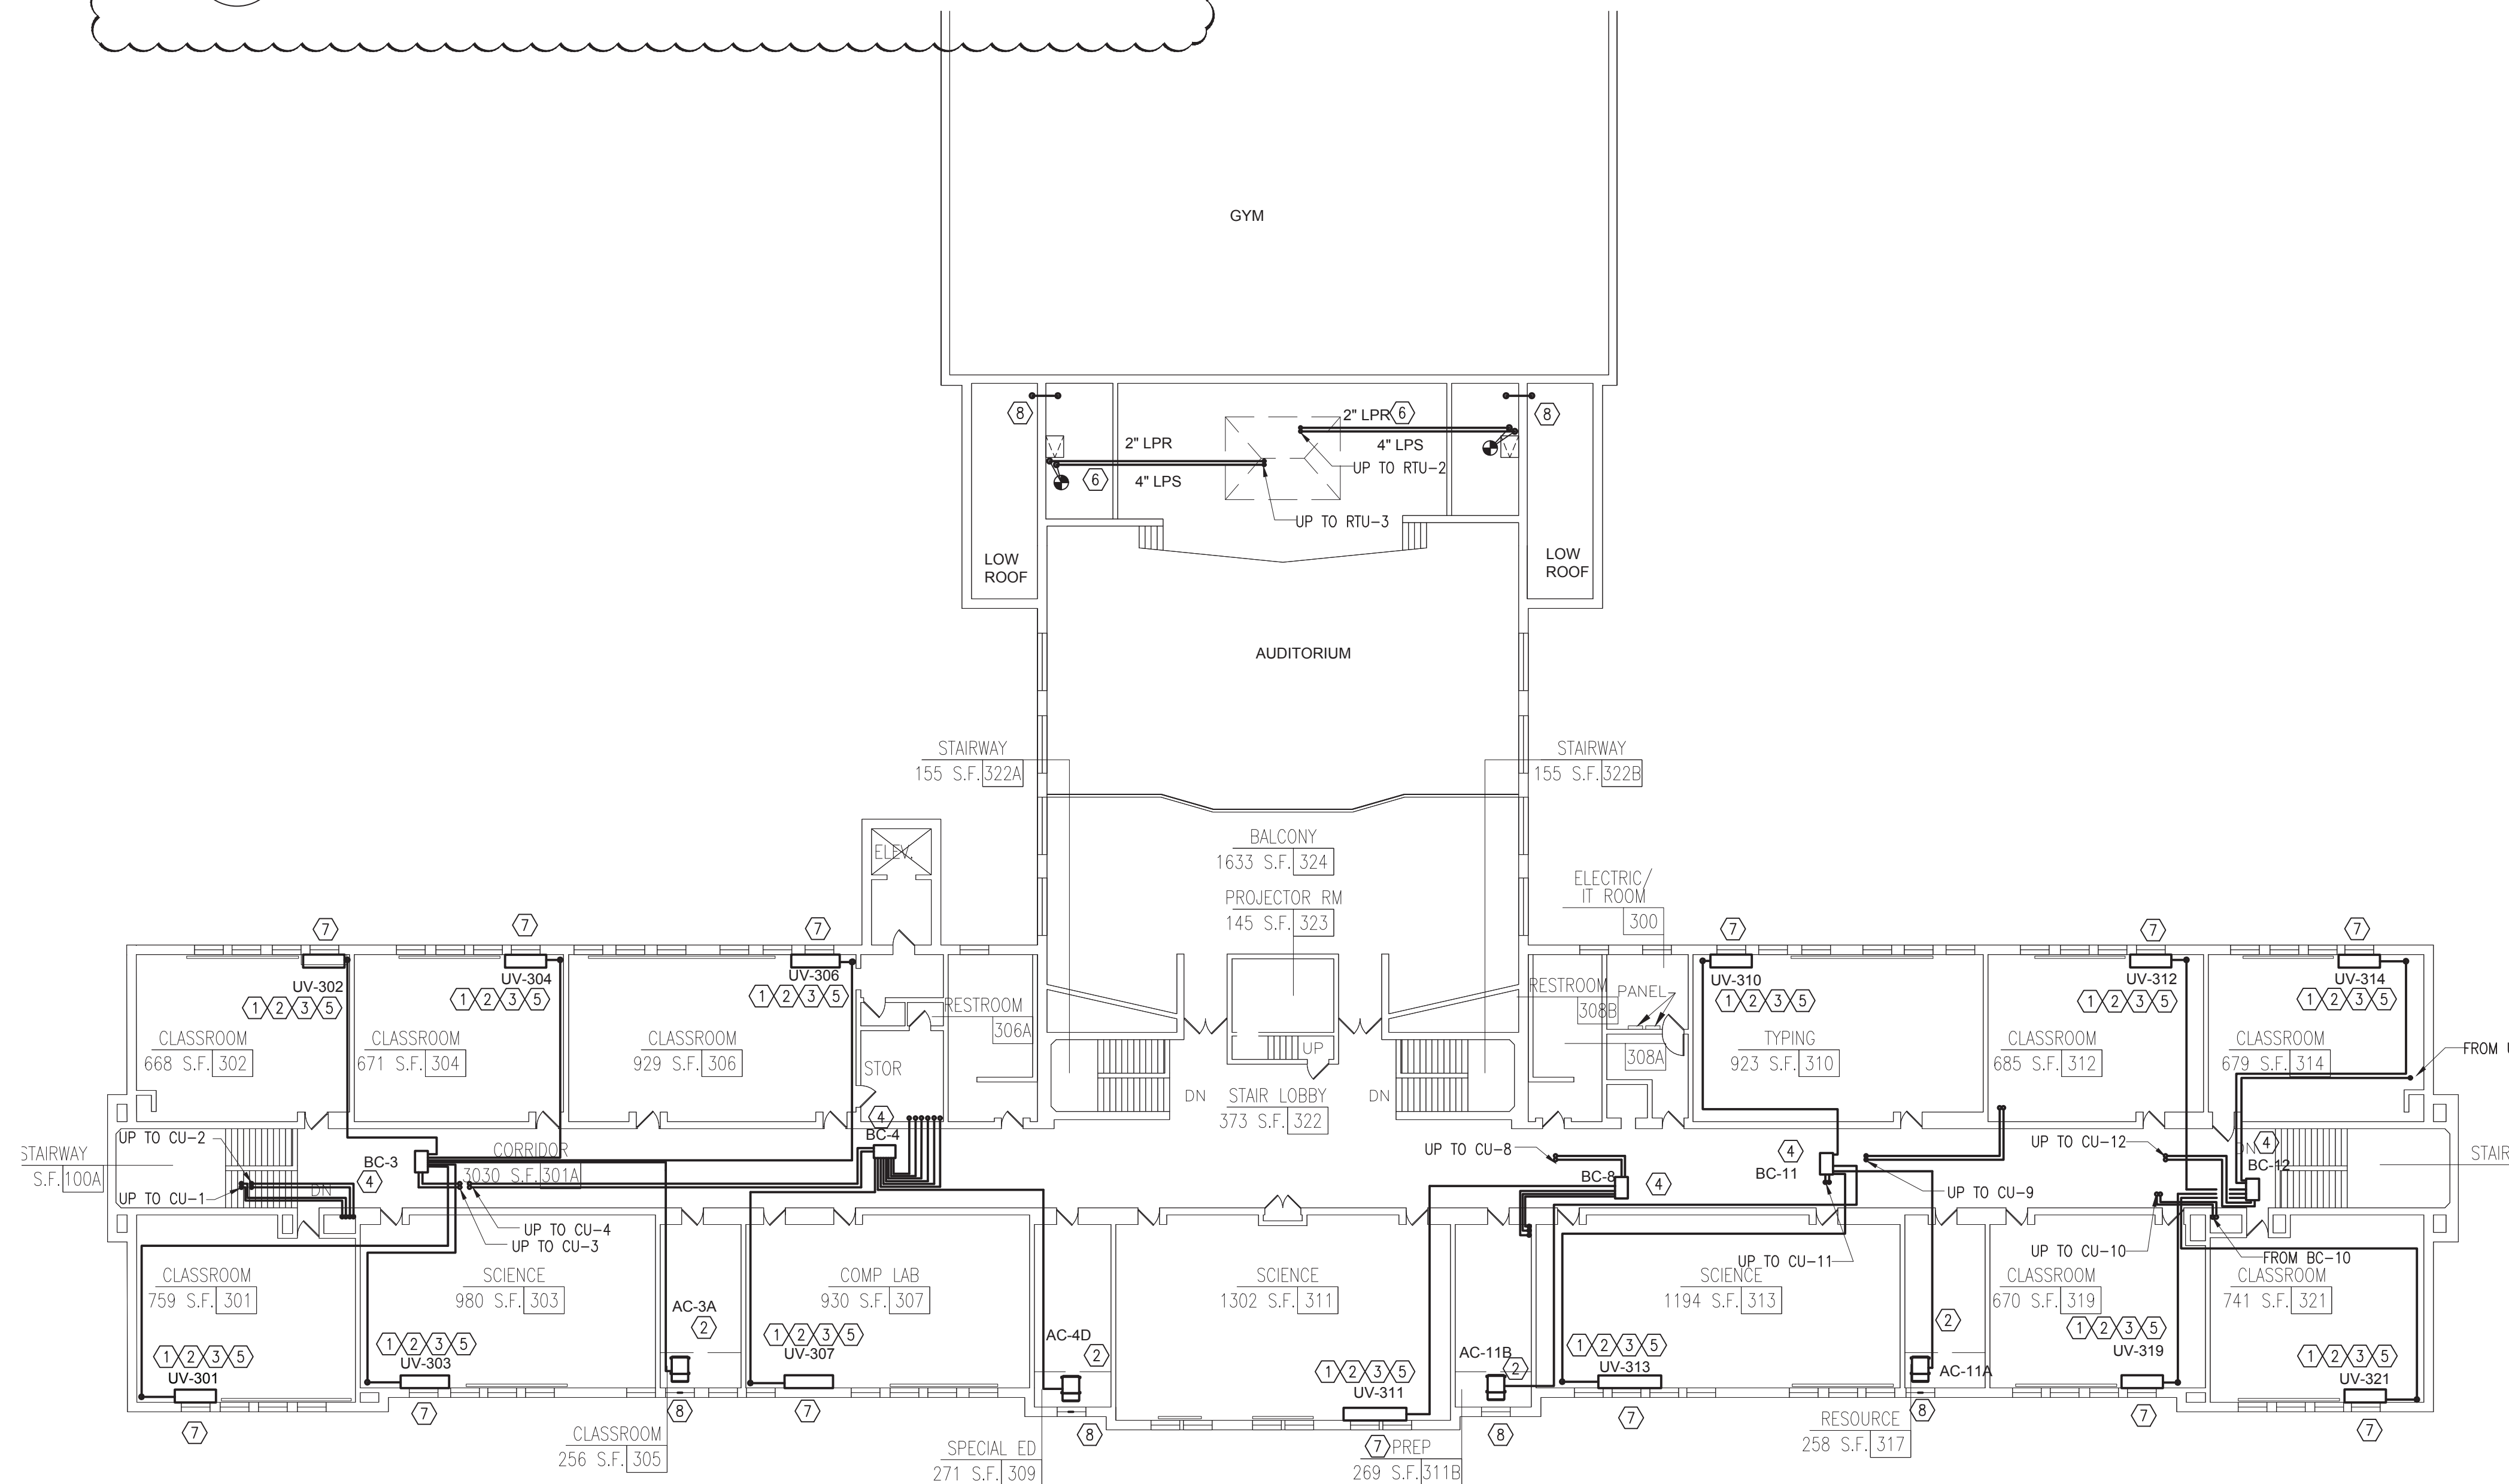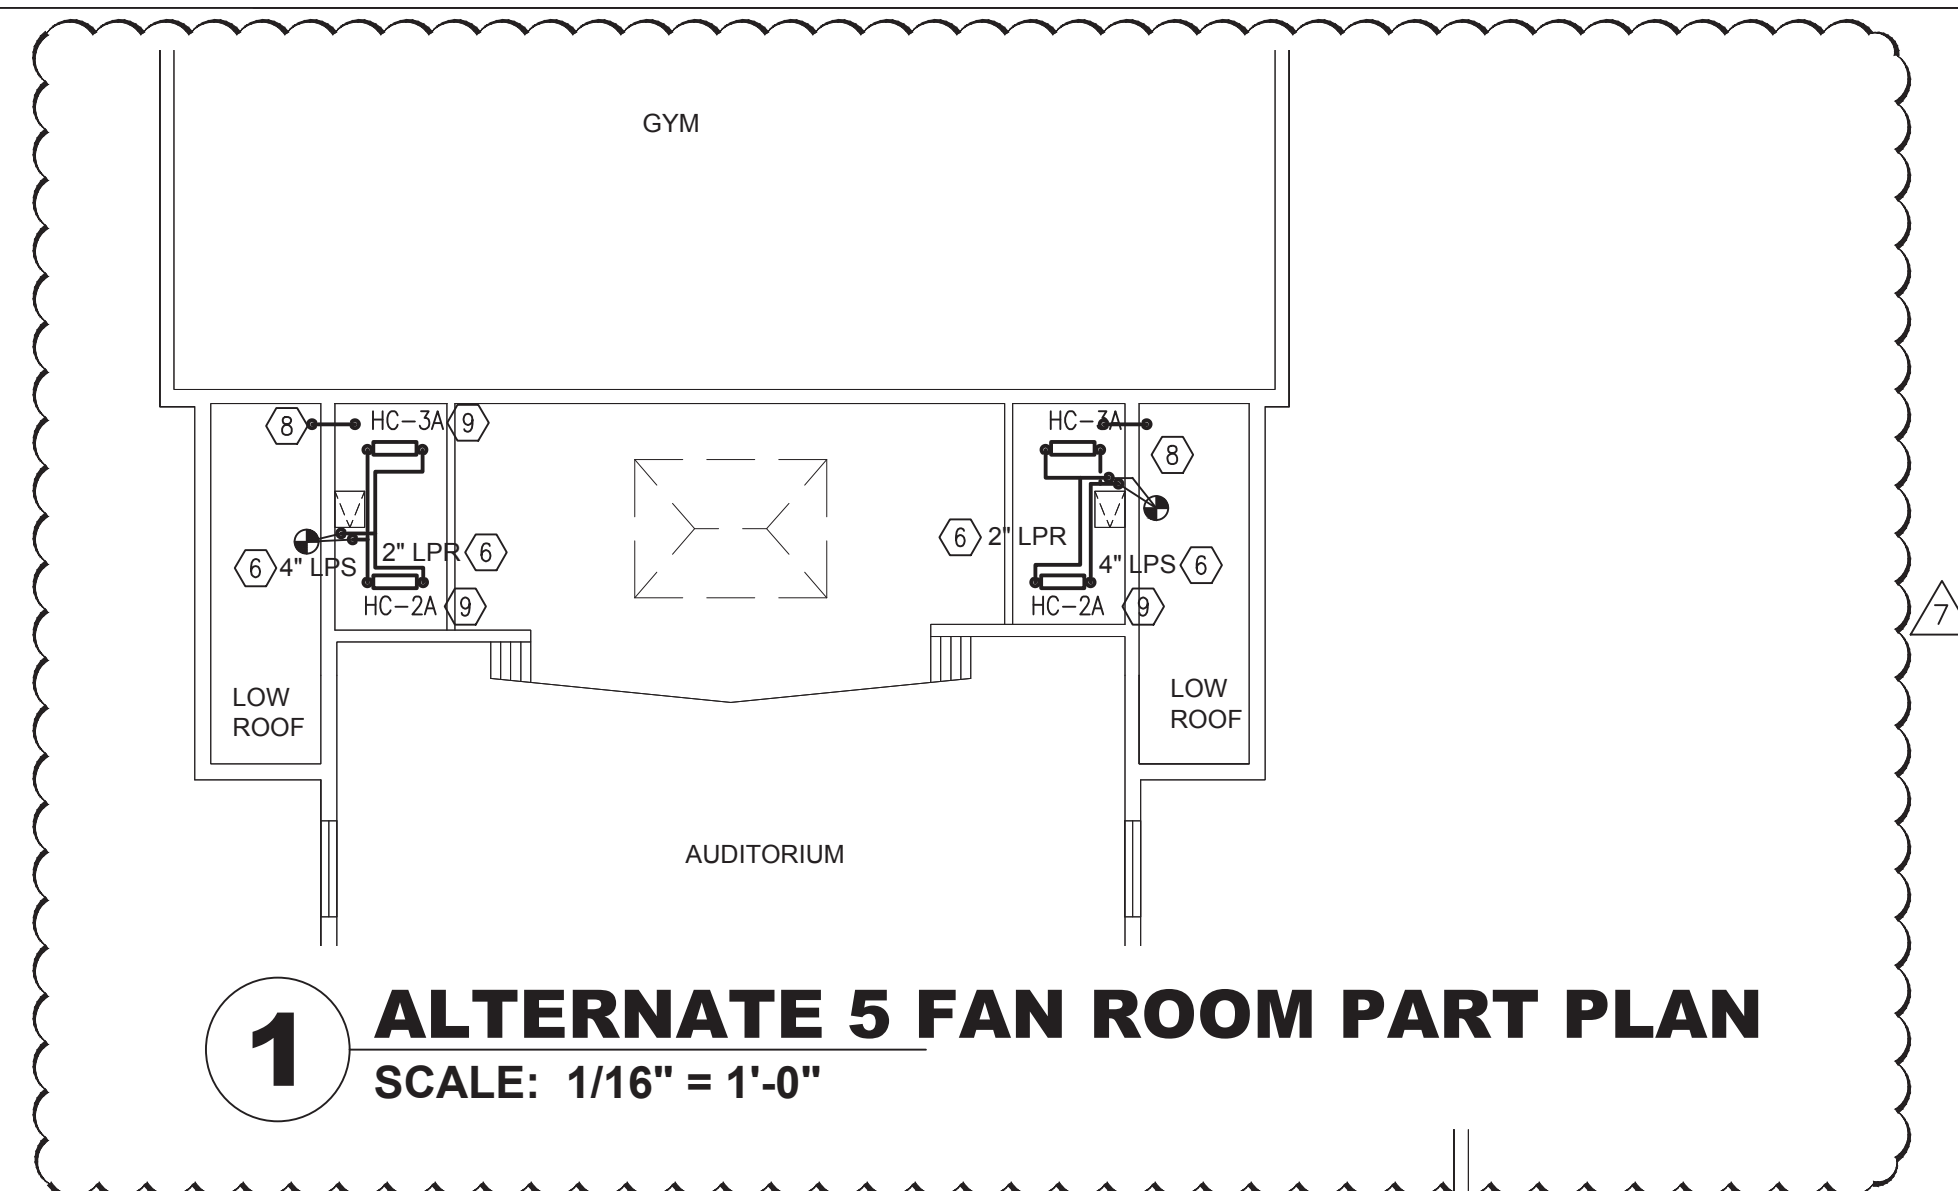

## 1 THIRD FLOOR PLAN

SCALE: 1/16" = 1'-0"



© COPYRIGHT, MICHAEL SHILALE ARCHITECTS, ALL RIGHTS RESERVED.

Drawing	Title
---------	-------

Drawing Title  
**HVAC PIPING -  
3RD FLOOR  
PLAN**

Drawing No.

# M-303

UNIVENT REPLACEMENT  
AT  
HAVERSTRAW  
ELEMENTARY  
SED# 50-02-01-06-0-009-018

<p>Mechanical &amp; Electrical Engineer:</p>	<p><b>GREENMAN PEDERSEN, INC</b> 400 BELLA BOULEVARD MONTEBELLO, NY 10901</p>
--	---

Drawn by	WM
Checked by	ERF
Project No.	41048
Scale	AS NOTED
Date	08-30-21

[illegible]

1. REFER TO ADDITIONAL INSTALLATION NOTES ON DRAWING E-001.
2. ALL NEW BRANCH CIRCUIT SHALL BE RUN WITH MINIMUM OF 2#12+1#12G IN 3/4" CONDUIT, UNLESS OTHERWISE NOTED. FOR LIGHTING AND POWER BRANCH CIRCUIT, MC CABLE SHALL BE INSTALLED FOR RECESSED INSTALLATION ONLY. EITHER IN NEW WALLS OR ABOVE HUNG CEILING WHERE POSSIBLE. REFER TO PANEL SCHEDULES IN DRAWING E-201 FOR ALL FEEDER AND BRANCH CIRCUIT SIZE INFORMATION.
3. PROVIDE LABELS ON ALL ELECTRICAL EQUIPMENT INDICATING CIRCUIT ORIGINATION.
4. UPDATE ALL EXISTING PANEL DIRECTORIES AFFECTED BY NEW WORK.
5. CONTRACTOR SHALL PERFORM AMP PROBE READINGS ON EXISTING SERVICE EQUIPMENT BEFORE AND AFTER WORK TO ENSURE EQUIPMENT WILL NOT BE LOADED BEYOND ITS MAX AMPCACITY.
6. CONTRACTOR SHALL MAINTAIN CONTINUITY TO ALL EXISTING CIRCUITRY TO REMAIN WHICH ARE AFFECTED BY THE SCOPE OF WORK; CONTRACTOR SHALL FURNISH ALL NECESSARY JUNCTION BOXES, CONDUIT, AND WIRES AS REQUIRED TO KEEP CONTINUITY.
7. REFER TO MECHANICAL PLANS FOR EQUIPMENT TO BE SUPPLIED BY OTHER TRADES AND INSTALLED/WIRED UNDER THIS SECTION. COORDINATE LOCATION OF DEVICES WITH OTHER CONTRACTORS.
8. PROVIDE FIRESTOPPING FOR ALL PENETRATIONS TO MATCH EXISTING FIRE RATING WHERE APPLICABLE. ALL CORE DRILLS SHALL BE VERIFIED BY BUILDING REPRESENTATIVE PRIOR TO COMMENCING WORK. XRAY ALL FLOOR SLABS PRIOR TO ROUGH-INS FOR CORE DRILL WORK.
9. THE CONTRACTOR SHALL FIELD ROUTE FEEDER FOR NEW POWER PANELS. COORDINATE EXACT ROUTING PATH WITH OWNER. SUBMIT A PROPOSED ROUTING PATH TO ENGINEER OF RECORD FOR APPROVAL PRIOR TO RUNNING ANY CONDUIT OR WIRE ASSOCIATED WITH THIS FEEDER.
10. REFER TO DRAWING E-102 FOR LOCATIONS OF NEW PANELS THAT WILL FEED NEW EQUIPMENTS.
11. AT EACH NEW UNIVENT, THE CONTRACTOR SHALL RELOCATE TWO (2) EXISTING DUPLEX RECEPTACLES AND TWO (2) EXISTING DATA OUTLETS. EXTEND ALL WIRING AND CONDUIT TO THE NEW LOCATION. FIELD DETERMINE WITH THE SCHOOL THE IDEAL LOCATION FOR THE NEW DEVICES. RELOCATE THESE OUTLETS TOWARDS THE EXISTING ROUTING OF EXISTING CONDUIT IN ORDER TO AVOID NEW HOME RUNS OF DATA CABLE.
12. DISCONNECT SWITCH FOR UNIT VENTILATORS IS PROVIDED BY HVAC CONTRACTOR. COORDINATE WITH HVAC CONTRACTOR.
13. ALL GROUNDING SHALL BE PROVIDED BY THE CONTRACTOR AS PER NEC 2017.



# 1 FIRST FLOOR PLAN

SCALE: 1/16" = 1'-0"

7	02-17-22	ADDENDUM 7
6	01-28-21	ADDENDUM 5
3	12-17-21	ISSUED FOR BID
2	11-19-21	SED ADDENDUM 1
1	08-30-21	BIDDING DOCUMENTS
No.	Date	Revisions

Drawn by	FC
Checked by	SH
Project No.	41048
Scale	AS NOTED
Date	08-30-21

Mechanical & Electrical Engineer:	GREENMAN PEDERSEN, INC 400 BELLA BOULEVARD MONTEBELLO, NY 10801
Structural Engineer:	— — —

UNIVENT REPLACEMENT  
AT  
HAVERSTRAW  
ELEMENTARY  
SED# 50-02-01-06-0-009-018  
16 Grant Street  
Haverstraw, NY 10927  
COUNTY OF ROCKLAND



**MICHAEL SHILALE ARCHITECTS, LLP.**  
 New City, NY 10556 Tel 845-708-9200  
 140 Park Avenue  
[www.shilale.com](http://www.shilale.com)

Drawing Title	<b>FIRST FLOOR PLAN - ELECTRICAL</b>
Drawing No.	<b>E-101</b>

1. REFER TO ADDITIONAL INSTALLATION NOTES ON DRAWING E-001.
2. ALL NEW BRANCH CIRCUIT SHALL BE RUN WITH MINIMUM OF 2#12+1#12G IN 3/4" CONDUIT, UNLESS OTHERWISE NOTED. FOR LIGHTING AND POWER BRANCH CIRCUIT, MC CABLE SHALL BE INSTALLED FOR RECESSED INSTALLATION ONLY, EITHER IN NEW WALLS OR ABOVE HUNG CEILING WHERE POSSIBLE. REFER TO PANEL SCHEDULES IN DRAWING E-201 FOR ALL OTHER FEEDER AND BRANCH CIRCUIT SIZE INFORMATION.
3. PROVIDE LABELS ON ALL ELECTRICAL EQUIPMENT INDICATING CIRCUIT ORIGINATION.
4. UPDATE ALL EXISTING PANEL DIRECTORYS AFFECTED BY NEW WORK.
5. CONTRACTOR SHALL PERFORM AMP PROBE READINGS ON EXISTING SERVICE EQUIPMENT BEFORE AND AFTER WORK TO ENSURE EQUIPMENT WILL NOT BE LOADED BEYOND ITS MAX CAPACITY.
6. CONTRACTOR SHALL MAINTAIN CONTINUITY TO ALL EXISTING CIRCUITRY TO REMAIN WHICH ARE AFFECTED BY THE SCOPE OF WORK; CONTRACTOR SHALL FURNISH ALL NECESSARY JUNCTION BOXES, CONDUIT, AND WIRES AS REQUIRED TO KEEP CONTINUITY.
7. REFER TO MECHANICAL PLANS FOR EQUIPMENT TO BE SUPPLIED BY OTHER TRADES AND INSTALLED/WIRED UNDER THIS SECTION. COORDINATE LOCATION OF DEVICES WITH OTHER CONTRACTORS.
8. PROVIDE FIRESTOPPING FOR ALL PENETRATIONS TO MATCH EXISTING FIRE RATING WHERE APPLICABLE. ALL CORE DRILLS SHALL BE VERIFIED BY BUILDING REPRESENTATIVE PRIOR TO COMMENCING WORK. XRAY ALL FLOOR SLABS PRIOR TO ROUGH-INS FOR CORE DRILL WORK.
9. THE CONTRACTOR SHALL FIELD ROUTE FEEDER FOR NEW POWER PANELS. COORDINATE EXACT ROUTING PATH WITH OWNER. SUBMIT A PROPOSED ROUTING PATH TO ENGINEER OF RECORD FOR APPROVAL PRIOR TO RUNNING ANY CONDUIT OR WIRE ASSOCIATED WITH THIS FEEDER.
10. REFER TO DRAWING E-102 FOR LOCATIONS OF NEW PANELS THAT WILL FEED NEW EQUIPMENTS.
11. AT EACH NEW UNIVENT, THE CONTRACTOR SHALL RELOCATE TWO (2) EXISTING DUPLEX RECEPTABLES AND TWO (2) EXISTING DATA OUTLETS. EXTEND ALL WIRING AND CONDUIT TO THE NEW LOCATION. FIELD DETERMINE WITH THE SCHOOL THE IDEAL LOCATION FOR THE NEW DEVICES. RELOCATE THESE OUTLETS TOWARDS THE EXISTING ROUTING OF EXISTING CONDUIT IN ORDER TO AVOID NEW HOME RUNS OF DATA CABLE.
12. DISCONNECT SWITCH FOR UNIT VENTILATORS IS PROVIDED BY HVAC CONTRACTOR. COORDINATE WITH HVAC CONTRACTOR.
13. ALL GROUNDING SHALL BE PROVIDED BY THE CONTRACTOR AS PER NEC 2017.
14. ALL 120/208V PANELS AND DISTRIBUTION BOARD NEEDS TO BE INSTALLED IN SUCH A WAY SO THAT A 3 FEET CLEARANCE IN FRONT OF THE PANELS IS BEING MAINTAINED AS REQUIRED BY NEC 2017.



© COPYRIGHT, MICHAEL SHILALE ARCHITECTS, ALL RIGHTS RESERVED.

wing Title  
**2ND FLOOR  
 PLAN -  
 ELECTRICAL**

Drawing No.

# E-102

7	02-17-22	ADDENDUM 7
6	01-28-21	ADDENDUM 5
3	12-17-21	ISSUED FOR BID
2	11-19-21	SED ADDENDUM 1
1	08-30-21	BIDDING DOCUMENTS
No.	Date	Revisions

Drawn by	FC
Checked by	SH
Project No.	41048
Scale	AS NOTED
Date	08-30-21

Mechanical & Electrical Engineer:	GREENMAN PEDERSEN, INC 400 BELLA BOULEVARD MONTEBELLO, NY 10001
Structural Engineer:	— — —


UNIVENT REPLACEMENT

HAVERSTRAW  
ELEMENTARY

SED# 50-02-01-06-0-009-018

16 Grant Street  
Haverstraw, NY 10827

COUNTY OF ROCKLAND

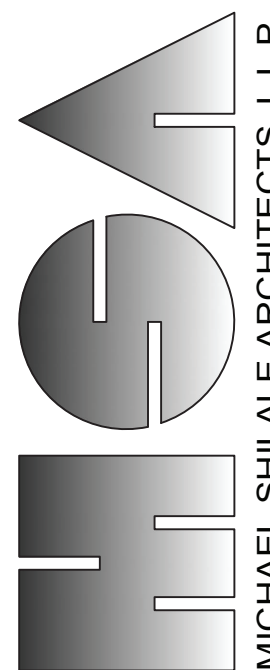


MICHAEL SHILALE ARCHITECTS, L.L.P.

140 Park Avenue New City, NY 10956 Tel 845-708-9200  
www.shilale.com

ELECTRICAL NOTES:

1. REFER TO ADDITIONAL INSTALLATION NOTES ON DRAWING E-001.
2. ALL NEW BRANCH CIRCUIT SHALL BE RUN WITH MINIMUM OF 2#12+1#12G IN 3/4" CONDUIT, UNLESS OTHERWISE NOTED. FOR LIGHTING AND POWER BRANCH CIRCUIT, MC CABLE SHALL BE INSTALLED FOR RECESSED INSTALLATION ONLY, EITHER IN NEW WALLS OR ABOVE HUNG CEILING WHERE POSSIBLE. REFER TO PANEL SCHEDULES IN DRAWING E-201 FOR ALL OTHER FEEDER AND BRANCH CIRCUIT SIZE INFORMATION.
3. PROVIDE LABELS ON ALL ELECTRICAL EQUIPMENT INDICATING CIRCUIT ORIGINATION.
4. UPDATE ALL EXISTING PANEL DIRECTORIES AFFECTED BY NEW WORK.
5. CONTRACTOR SHALL PERFORM AMP PROBE READINGS ON EXISTING SERVICE EQUIPMENT BEFORE AND AFTER WORK TO ENSURE EQUIPMENT WILL NOT BE LOADED BEYOND ITS MAX AMPACITY.
6. CONTRACTOR SHALL MAINTAIN CONTINUITY TO ALL EXISTING CIRCUITRY TO REMAIN WHICH ARE AFFECTED BY THE SCOPE OF WORK; CONTRACTOR SHALL FURNISH ALL NECESSARY JUNCTION BOXES, CONDUIT, AND WIRES AS REQUIRED TO KEEP CONTINUITY.
7. REFER TO MECHANICAL PLANS FOR EQUIPMENT TO BE SUPPLIED BY OTHER TRADES AND INSTALLED/WIRED UNDER THIS SECTION. COORDINATE LOCATION OF DEVICES WITH OTHER CONTRACTORS.
8. PROVIDE FIRESTOPPING FOR ALL PENETRATIONS TO MATCH EXISTING FIRE RATING WHERE APPLICABLE. ALL CORE DRILLS SHALL BE VERIFIED BY BUILDING REPRESENTATIVE PRIOR TO COMMENCING WORK. XRAY ALL FLOOR SLABS PRIOR TO ROUGH-INS FOR CORE DRILL WORK.
9. THE CONTRACTOR SHALL FIELD ROUTE FEEDER FOR NEW POWER PANELS. COORDINATE EXACT ROUTING PATH WITH OWNER. SUBMIT A PROPOSED ROUTING PATH TO ENGINEER OF RECORD FOR APPROVAL PRIOR TO RUNNING ANY CONDUIT OR WIRE ASSOCIATED WITH THIS FEEDER.
10. REFER TO DRAWING E-102 FOR LOCATIONS OF NEW PANELS THAT WILL FEED NEW EQUIPMENTS.
11. AT EACH NEW UNIVENT, THE CONTRACTOR SHALL RELOCATE TWO (2) EXISTING DUPLEX RECEPTACLES AND TWO (2) EXISTING DATA OUTLETS. EXTEND ALL WIRING AND CONDUIT TO THE NEW LOCATION. FIELD DETERMINE WITH THE SCHOOL THE IDEAL LOCATION FOR THE NEW DEVICES. RELOCATE THESE OUTLETS TOWARDS THE EXISTING ROUTING OF EXISTING CONDUIT IN ORDER TO AVOID NEW HOME RUNS OF DATA CABLE.
12. DISCONNECT SWITCH FOR UNIT VENTILATORS IS PROVIDED BY HVAC CONTRACTOR. COORDINATE WITH HVAC CONTRACTOR.
13. ALL GROUNDING SHALL BE PROVIDED BY THE CONTRACTOR AS PER NEC 2017.

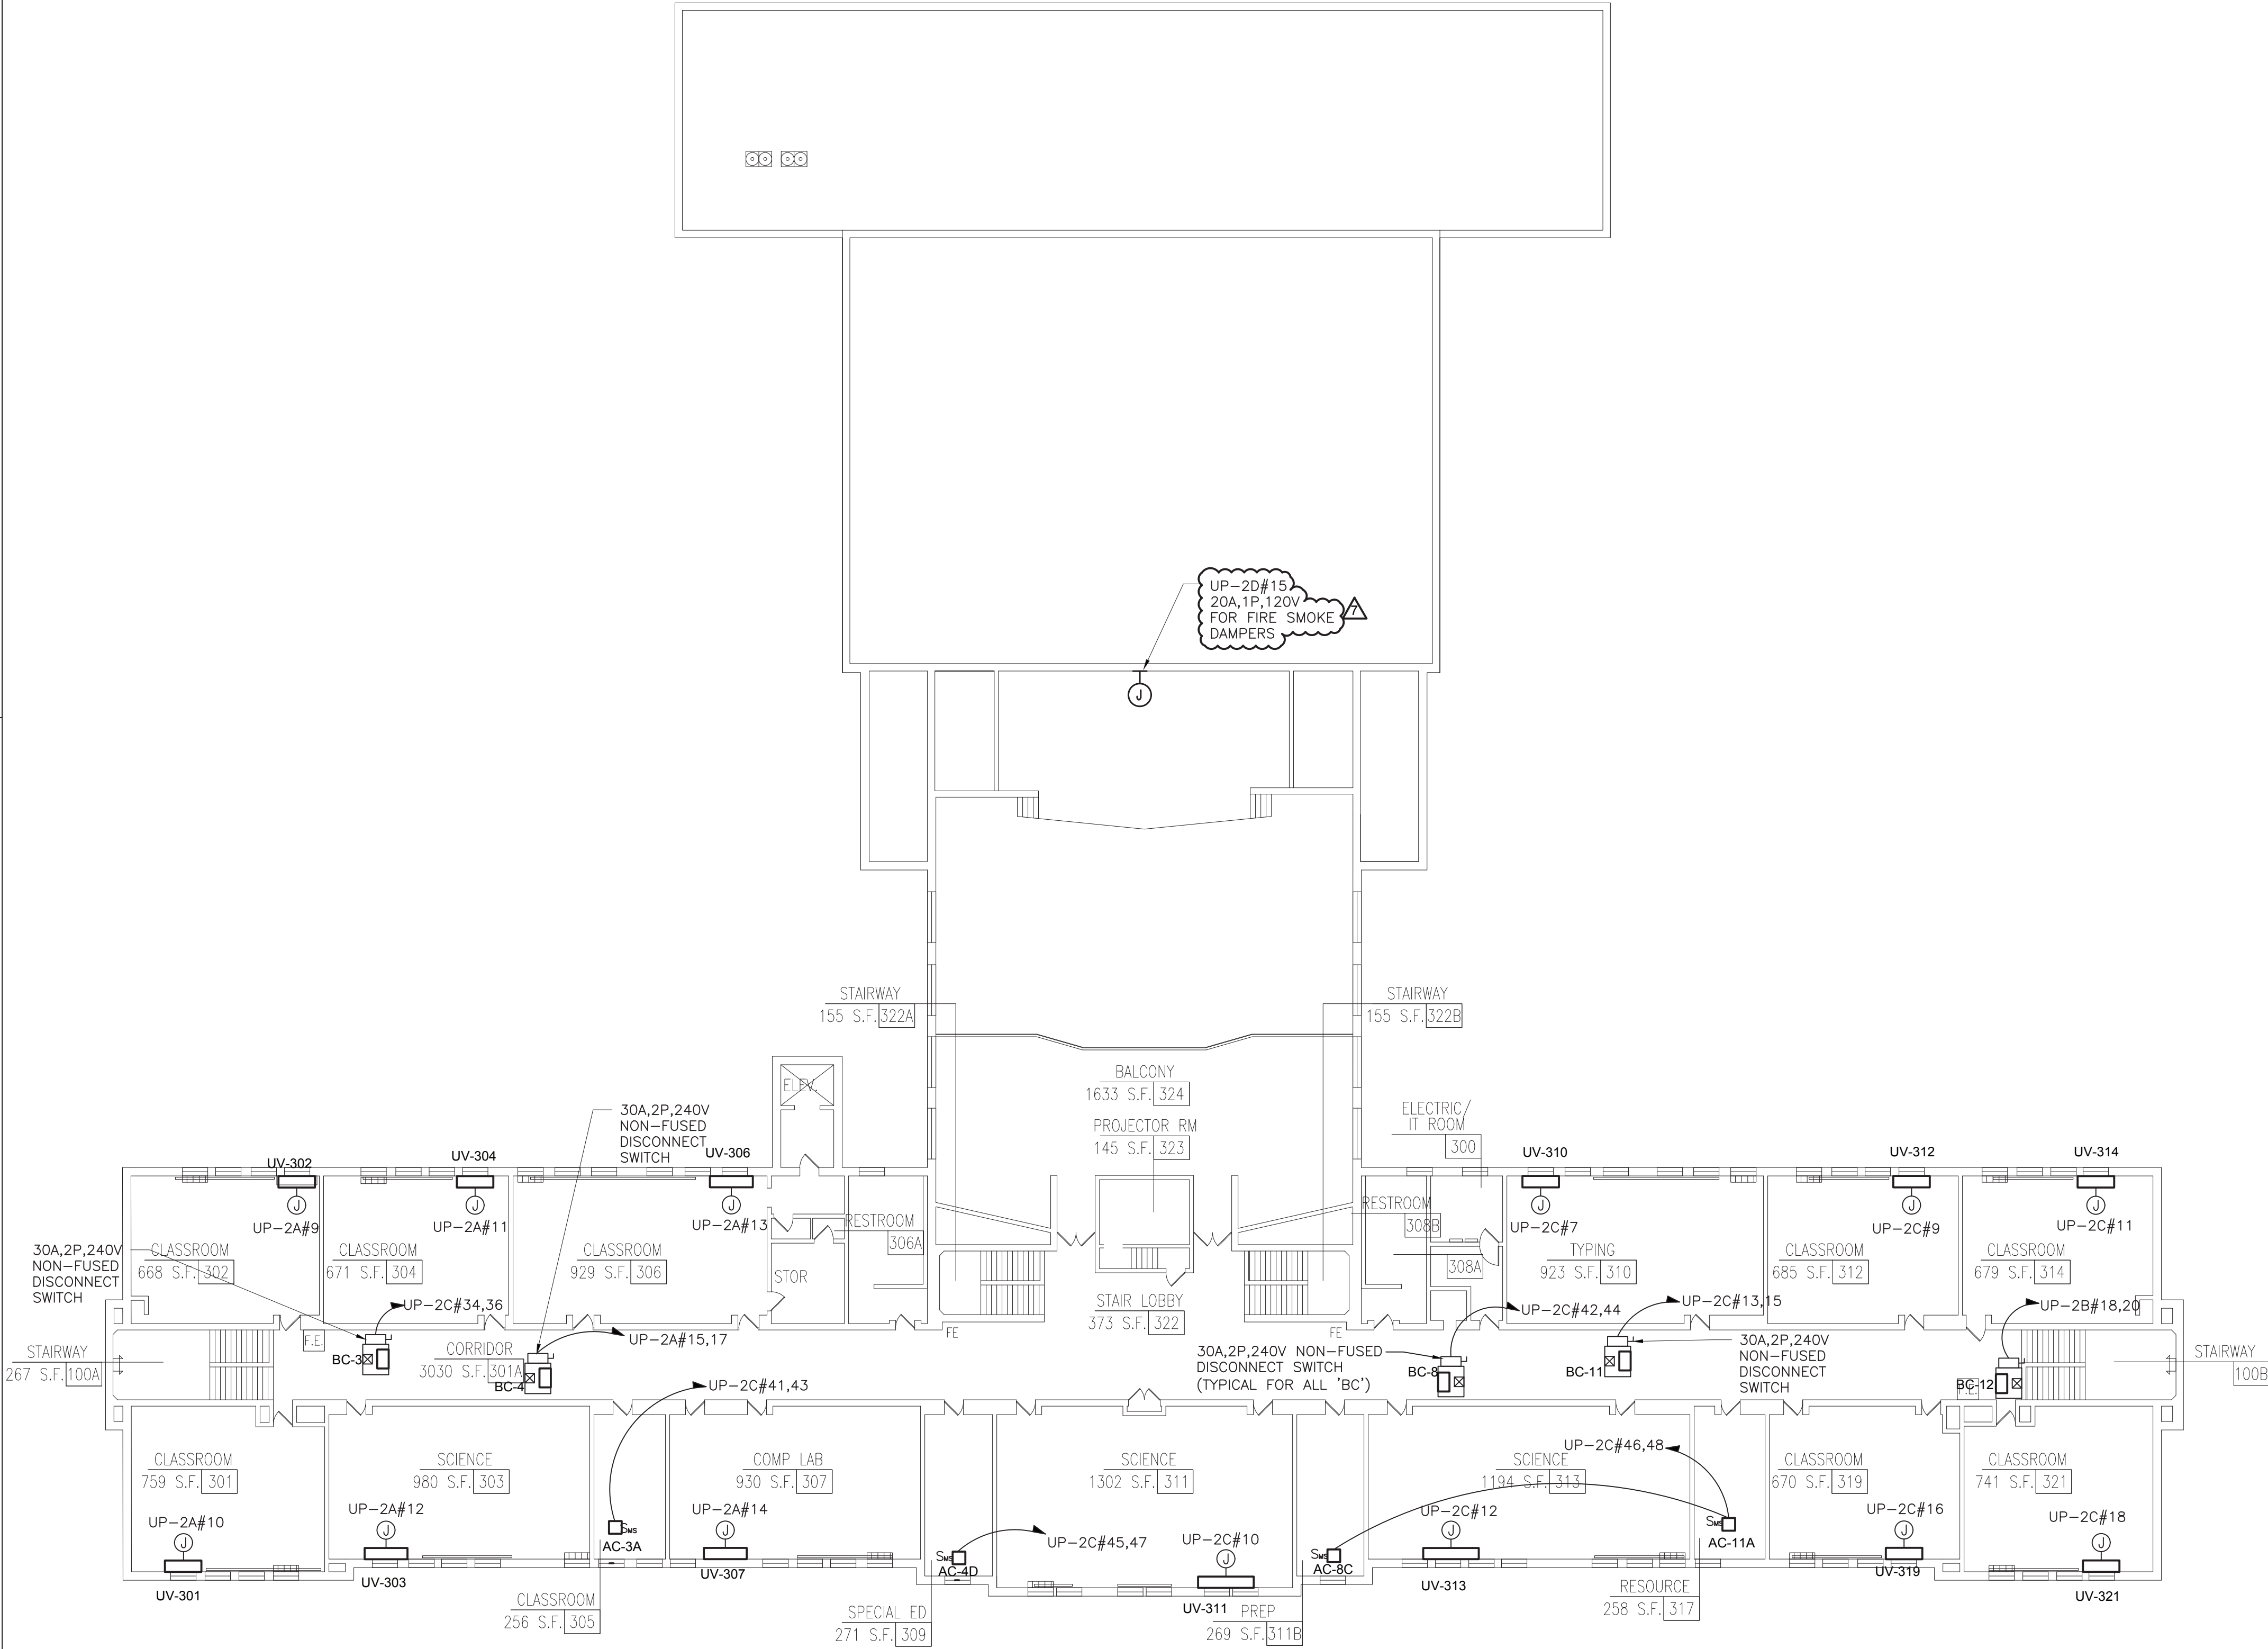


**1 THIRD FLOOR PLAN**  
SCALE: 1/16" = 1'-0"

0 1/2 1  
IF THIS BAR DOES NOT  
MEASURE 1" THEN DRAWING IS  
NOT TO FULL SCALE



No.	Date	Revisions
7	02-17-22	ADDENDUM 7
6	01-28-21	ADDENDUM 5
3	12-17-21	ISSUED FOR BID
2	11-19-21	SED ADDENDUM 1
1	08-30-21	BIDDING DOCUMENTS

 

Drawn by	FC
Checked by	SH
Project No.	41048
Scale	AS NOTED
Date	08-30-21

<b>GREENMAN PEDERSEN, INC</b> 400 BELLA BOULEVARD MONTICELLO, NY 10801	
Mechanical Electrical Engineer:	
Structural Engineer:	

<b>UNIVENT REPLACEMENT AT HAVERSTRAW ELEMENTARY</b> SED# 50-02-01-06-0-009-018 18 Grant Street Haverstraw, NY 10627 COUNTY OF ROCKLAND
--


<b>MSA</b> MICHAEL SHILALE ARCHITECTS, L.L.P. 140 Park Avenue New City, NY 10956 Tel 845-708-9200 www.shilale.com
--

<b>3RD FLOOR PLAN - ELECTRICAL</b>	<b>E-103</b>
------------------------------------	--------------

© COPYRIGHT, MICHAEL SHILALE ARCHITECTS, ALL RIGHTS RESERVED.

ELECTRICAL NOTES:

1. REFER TO ADDITIONAL INSTALLATION NOTES ON DRAWING E-001.
2. ALL NEW BRANCH CIRCUIT SHALL BE RUN WITH MINIMUM OF 2#12+1#12G IN 3/4" CONDUIT, UNLESS OTHERWISE NOTED. FOR LIGHTING AND POWER BRANCH CIRCUIT, MC CABLE SHALL BE INSTALLED FOR RECESSED INSTALLATION ONLY, EITHER IN NEW WALLS OR ABOVE HUNG CEILING WHERE POSSIBLE. REFER TO PANEL SCHEDULES IN DRAWING E-201 FOR ALL OTHER FEEDER AND BRANCH CIRCUIT SIZE INFORMATION.
3. PROVIDE LABELS ON ALL ELECTRICAL EQUIPMENT INDICATING CIRCUIT ORIGINATION.
4. UPDATE ALL EXISTING PANEL DIRECTORIES AFFECTED BY NEW WORK.
5. CONTRACTOR SHALL PERFORM AMP PROBE READINGS ON EXISTING SERVICE EQUIPMENT BEFORE AND AFTER WORK TO ENSURE EQUIPMENT WILL NOT BE LOADED BEYOND ITS MAX AMPACITY.
6. CONTRACTOR SHALL MAINTAIN CONTINUITY TO ALL EXISTING CIRCUITRY TO REMAIN WHICH ARE AFFECTED BY THE SCOPE OF WORK; CONTRACTOR SHALL FURNISH ALL NECESSARY JUNCTION BOXES, CONDUIT, AND WIRES AS REQUIRED TO KEEP CONTINUITY.
7. REFER TO MECHANICAL PLANS FOR EQUIPMENT TO BE SUPPLIED BY OTHER TRADES AND INSTALLED/WIRED UNDER THIS SECTION. COORDINATE LOCATION OF DEVICES WITH OTHER CONTRACTORS.
8. PROVIDE FIRESTOPPING FOR ALL PENETRATIONS TO MATCH EXISTING FIRE RATING WHERE APPLICABLE. ALL CORE DRILLS SHALL BE VERIFIED BY BUILDING REPRESENTATIVE PRIOR TO COMMENCING WORK. XRAY ALL FLOOR SLABS PRIOR TO ROUGH-INS FOR CORE DRILL WORK.
9. THE CONTRACTOR SHALL FIELD ROUTE FEEDER FOR NEW POWER PANELS. COORDINATE EXACT ROUTING PATH WITH OWNER. SUBMIT A PROPOSED ROUTING PATH TO ENGINEER OF RECORD FOR APPROVAL PRIOR TO RUNNING ANY CONDUIT OR WIRE ASSOCIATED WITH THIS FEEDER.
10. ALL EXTERIOR RUNS SHALL BE IN RIGID GALVANIZED STEEL CONDUIT.
11. ALL GROUNDING SHALL BE PROVIDED BY THE CONTRACTOR AS PER NEC 2017.
12. ALL DISCONNECT SWITCH ON ROOF SHALL BE WEATHER PROOF.

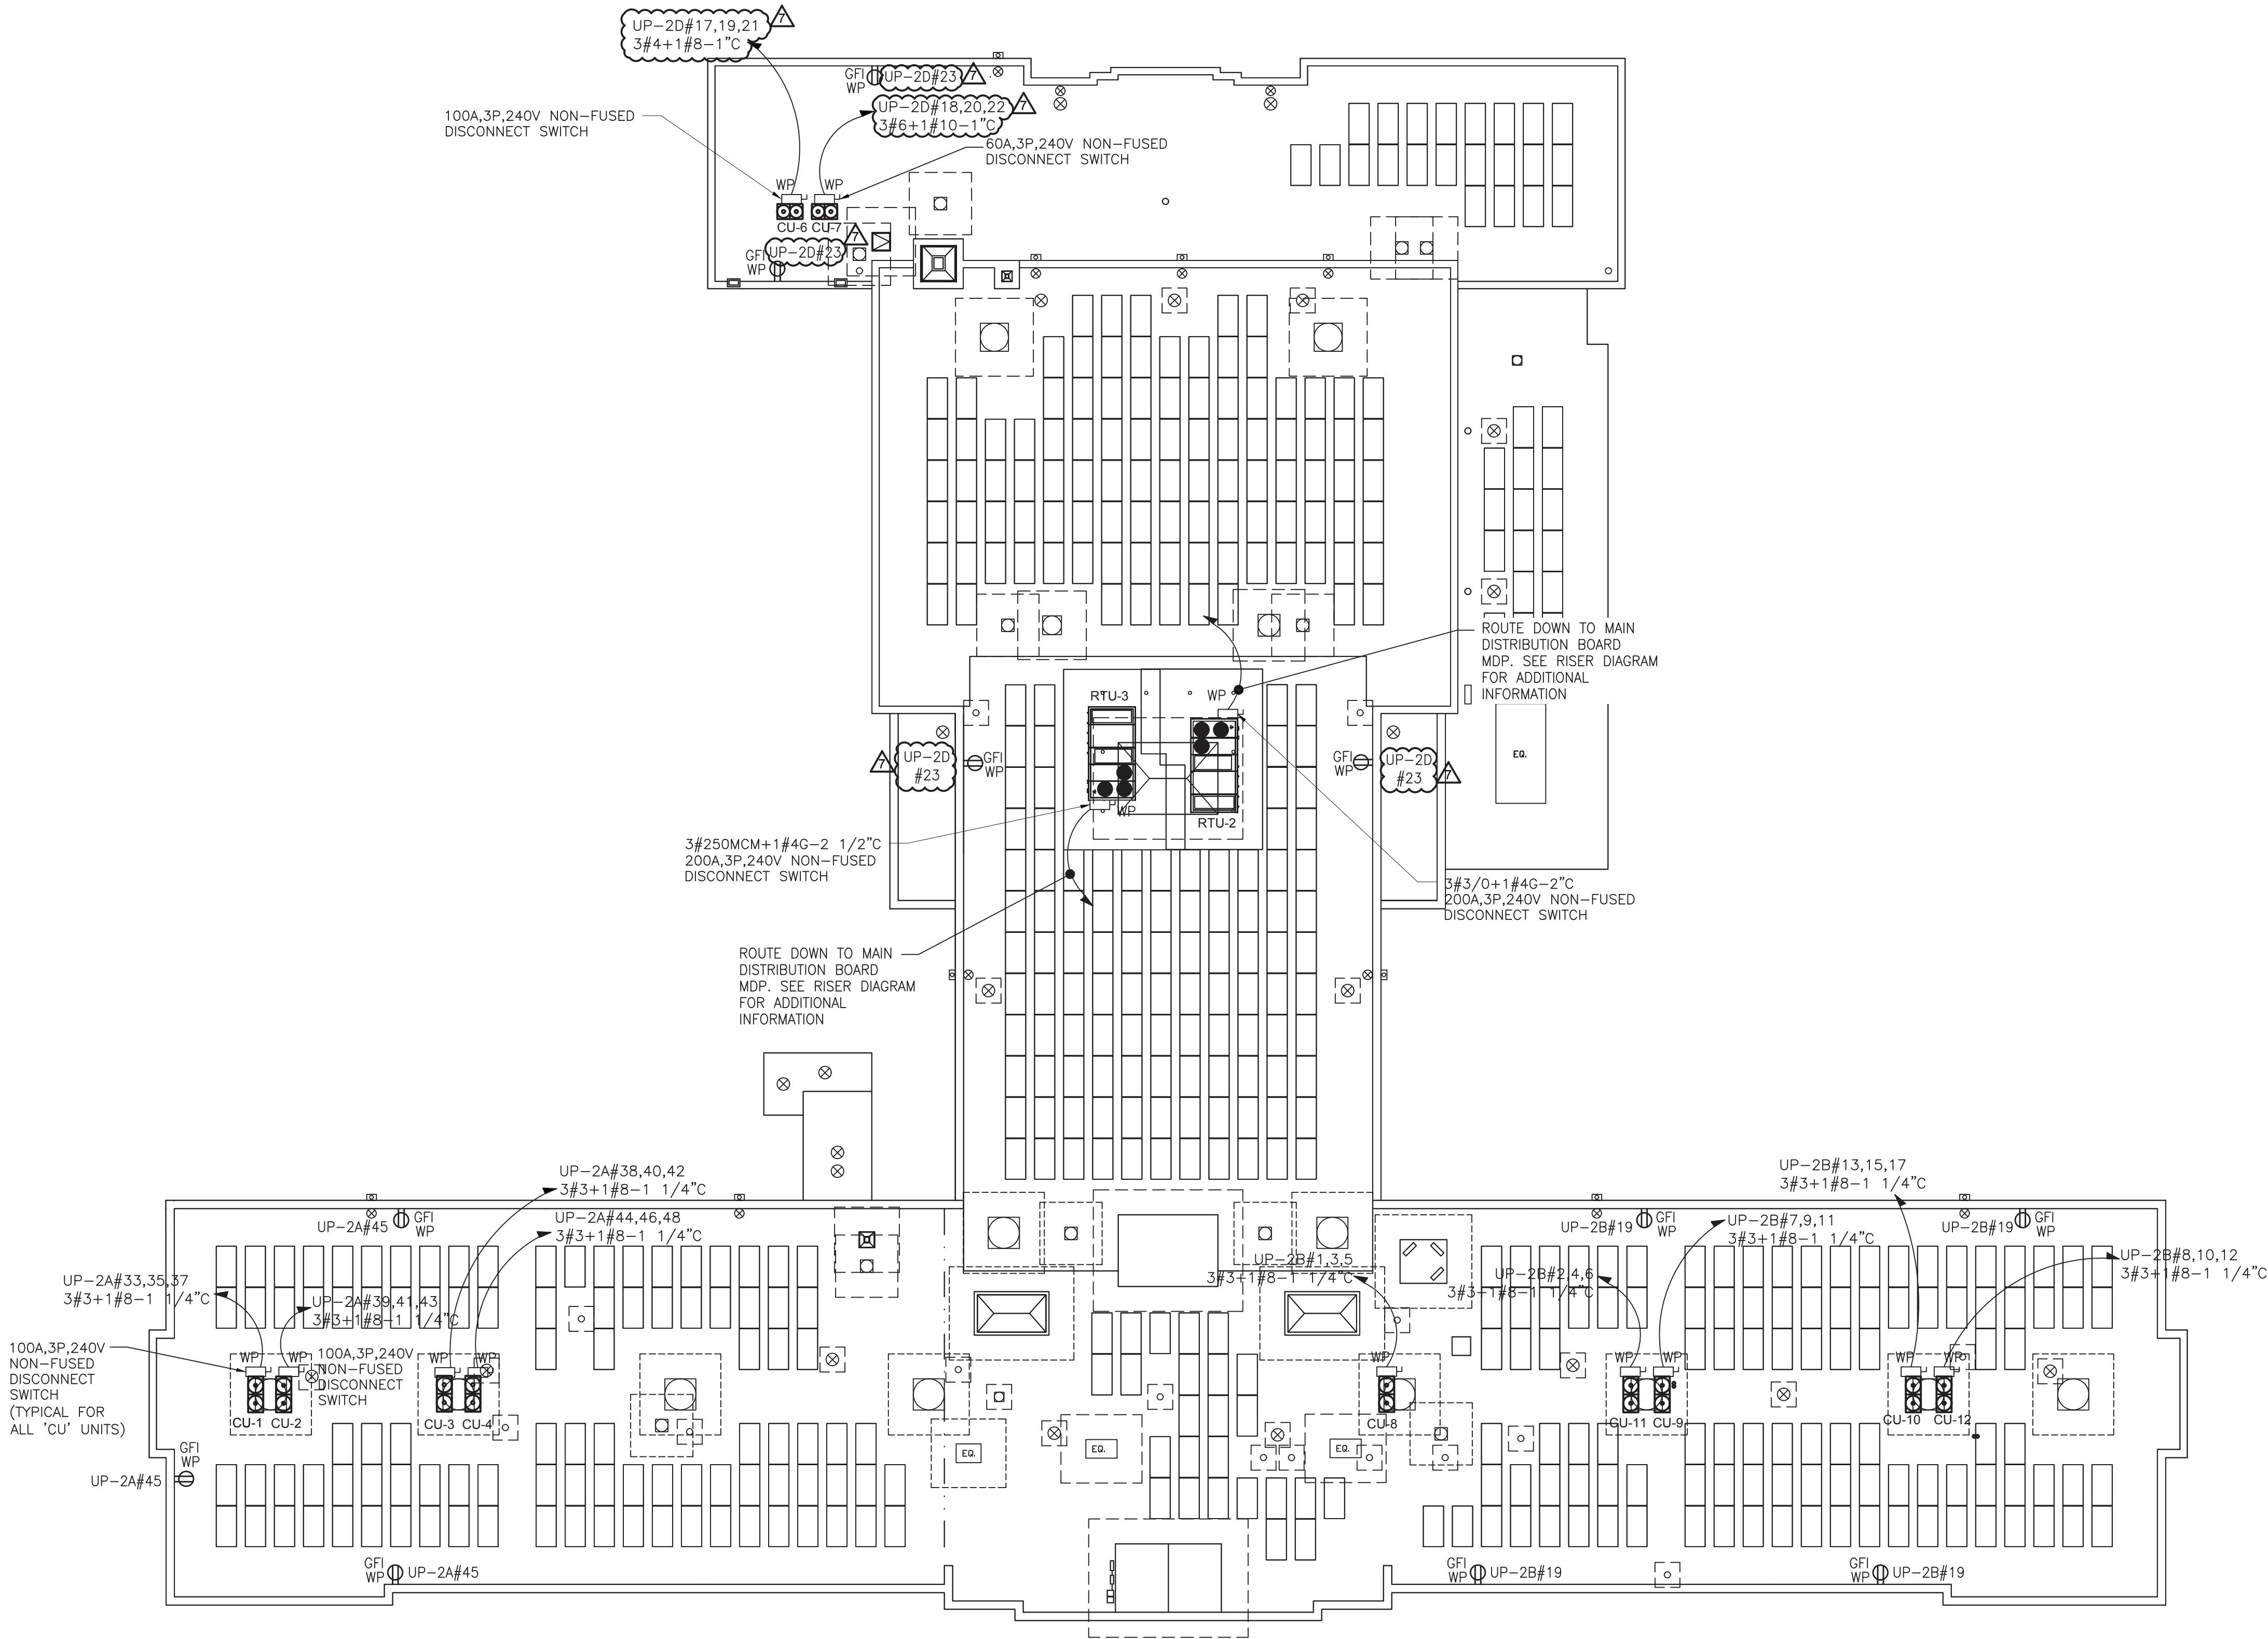

**1 ROOF PLAN**  
SCALE: 1/16" = 1'-0"



PLAN NORTH

0 1/2 1  
IF THIS BAR DOES NOT  
MEASURE 1" THEN DRAWING IS  
NOT TO FULL SCALE

No.	Date	Revisions
7	02-17-22	ADDENDUM 7
6	01-28-21	ADDENDUM 5
3	12-17-21	ISSUED FOR BID
2	11-19-21	SED ADDENDUM 1
1	08-30-21	BIDDING DOCUMENTS



Drawn by	FC
Checked by	SH
Project No.	41048
Scale	AS NOTED
Date	08-30-21

GREENMAN PEDERSEN, INC 400 BELLA BOULEVARD MONTEBELLA, NY 10601	
Mechanical Electrical Engineer:	Structural Engineer:

UNIVENT REPLACEMENT AT HAVERSTRAW ELEMENTARY	SED# 50-02-01-06-0-009-018	COUNTY OF ROCKLAND
18 Grant Street Haverstraw, NY 10627		

<b>MSA</b>	MICHAEL SHILALE ARCHITECTS, L.L.P. 140 Park Avenue New City, NY 10958 Tel 845-708-9200 www.shilale.com
------------	--

Roof Plan - ELECTRICAL	E-104
---------------------------	-------

© COPYRIGHT, MICHAEL SHILALE ARCHITECTS, ALL RIGHTS RESERVED.

PANEL SCH.	UP-2A	FRAME/TRIP	MLO	MCB / MLO.									
PANEL LOC.	CLOSET												
120 / 208	VOLT, 3PH, 4W, GND	AMP BUS SIZE	400 AMP	PANEL SHORT CIRCUIT RATING: > 22 KAIC									
FDR DATA	CIR. NO.	LOAD DESCRIPTION	C.B. POLE NO.	C.B. LOAD VA	PHASE A	PHASE B	PHASE C	C.B. LOAD VA	C.B. TRIP A	C.B. POLE NO.	LOAD DESCRIPTION	CIR. NO.	FDR DATA
No. WIRE GND												No. WIRE GND	
2 12 12	1	2ND FLOOR UNVENT	1	15	600	1200		600	15	1	2ND FLOOR UNVENT	2	2 12 12
2 12 12	3	2ND FLOOR UNVENT	1	15	600		1200	600	15	1	2ND FLOOR UNVENT	4	2 12 12
2 12 12	5	2ND FLOOR UNVENT	1	15	600		1200	600	15	1	2ND FLOOR UNVENT	6	2 12 12
2 12 12	7	2ND FLOOR UNVENT	1	15	600	1200		600	15	1	2ND FLOOR UNVENT	8	2 12 12
2 12 12	9	3RD FLOOR UNVENT	1	15	600		1200	600	15	1	3RD FLOOR UNVENT	10	2 12 12
2 12 12	11	3RD FLOOR UNVENT	1	15	600		1200	600	15	1	3RD FLOOR UNVENT	12	2 12 12
2 12 12	13	3RD FLOOR UNVENT	1	15	600	1200		600	15	1	3RD FLOOR UNVENT	14	2 12 12
2 12 12	15	BC-4	2	20	250		850	600	15	1	1ST FLOOR UNVENT	16	2 12 12
2 12 12	17							600	15	1	1ST FLOOR UNVENT	18	2 12 12
2 12 12	19	BC-2	2	20	250	850		600	15	1	1ST FLOOR UNVENT	20	2 12 12
2 12 12	21							600	15	1	1ST FLOOR UNVENT	22	2 12 12
2 12 12	23	BC-1	2	20	250		250	20	1		SPARE	24	
2 12 12	25							600	15	1	1ST FLOOR UNVENT	26	2 12 12
2 12 12	27	SPARE	1	20			600	600	15	1	1ST FLOOR UNVENT	28	2 12 12
2 12 12	29	SPARE	1	20			600	600	15	1	1ST FLOOR UNVENT	30	2 12 12
2 12 12	31	SPARE	1	20		0		20	1		SPARE	32	
3 3 8	33							6840	20	1	SPARE	34	
3 3 8	35	CU-1	3	90	6840	13680		6840	90	3	EXTERIOR RECEPTACLE (1)	36	2 12 12
3 3 8	37							6840	90	3	CU-3	38	3 3 8
3 3 8	39							6840	90	3	CU-4	40	3 3 8
3 3 8	41							6840	90	3	CU-5	42	3 3 8
3 3 8	43							6840	90	3	CU-6	44	3 3 8
2 12 12	45	ROOF RECEPTACLES	1	20	540		7380	6840	90	3	CU-7	46	3 3 8
2 12 12	47	SPARE	1	20				6840	20	1	SPARE	48	
2 12 12	49	1ST FLOOR UNVENT	1	15	600	600		600	15	1	SPARE	50	
2 12 12	51	SPARE	1	20			0	20	1		SPARE	52	
2 12 12	53	SPARE	1	20			0	20	1		SPARE	54	
2 12 12	55	SPARE	1	20			0	20	1		SPARE	56	
2 12 12	57	SPARE	1	20			0	20	1		SPARE	58	
2 12 12	59	SPARE	1	20			0	20	1		SPARE	60	

PANEL TYPE : NEMA 1	PHASE CONN.	32360	32600	32060	VA	20	% SPARE CAPACITY
MOUNTING: SURFACE	TOTAL CONN. LOAD	97.92	272	AMPS	100	% DEMAND FACTOR	
FED FROM:	CON and SPR. LOAD	117.504					
	TOT. DEM. LOAD	117.504					
	TOT. DEM. LOAD	326.5451312	@	208	VOLTS	REMARKS:	

PANEL SCH.		UP-2B		FRAMTRIP		MLO		MCB / MLO.																									
PANEL LOC.		CLOSET																															
120 / 208		VOLT, 3PH, 4W, GND		AMP BUS SIZE		400 AMP		PANEL SHORT CIRCUIT RATING: >		22	KAIC																						
FDR DATA		CIR NO.		LOAD DESCRIPTION		C.B. POLE NO.		C.B. TRIP A		C.B. LOAD VA		PHASE A		PHASE B		PHASE C		C.B. LOAD VA		C.B. TRIP A		C.B. POLE NO.		LOAD DESCRIPTION		CIR NO.		FDR DATA					
No. WIRE GND																										No. WIRE GND							
3		3		8		3		80		5880		12720				6840		80		3		3		CU-11		4		3		3		8	
																										6							
																										8							
3		3		8		3		90		5840		13680				6840		90		3		3		CU-12		10		3		3		8	
																										12							
																										14							
3		3		8		3		90		5840		7090		7090		250		20		2				BC-9		16		2		12		12	
																										18		2		12		12	
																										20		2		12		12	
2		12		12				20		720		970				250		20		2				BC-12		22		2		12		12	
																										24		2		12		12	
																										26		2		12		12	
																										28		2		12		12	
																										30		2		12		12	
																										32		2		12		12	
																										34		2		12		12	
																										36		2		12		12	
2		12		12				20		250				850		600		15		1				2ND FLOOR UNIVENT		38		2		12		12	
																										40		2		12		12	
																										42		2		12		12	
																										44		2		12		12	
PANEL SCH.		UP-2C		FRAME/TRIP		MLO		MCB / MLO											
PANEL LOC.		CLOSET																	
120 / 208		VOLT, 3PH, 4W, GND		AMP BUS SIZE		200 AMP		PANEL SHORT CIRCUIT RATING: >		22	KA/IC								
FDR.DATA		CIR. NO.	LOAD DESCRIPTION		C.B. POLE NO.	C.B. TRIP A	C.B. LOAD VA	PHASE A	PHASE B	PHASE C	C.B. LOAD VA	C.B. TRIP A	C.B. POLE NO.	LOAD DESCRIPTION	CIR. NO.	FDR.DATA			
No.	WIRE	GND													No.	WIRE	GND		
2	12	12	1	2ND FLOOR UNVENT	1	15	600	1200			600	15	1	2ND FLOOR UNVENT	2	2	12	12	
2	12	12	3	2ND FLOOR UNVENT	1	15	600		600		600	15	1	2ND FLOOR UNVENT	4	2	12	12	
2	12	12	5	2ND FLOOR UNVENT	1	15	600			1200	600	15	1	2ND FLOOR UNVENT	6	2	12	12	
2	10	10	7	3RD FLOOR UNVENT	1	15	1200	1800			600	15	1	2ND FLOOR UNVENT	8	2	12	12	
2	12	12	9	3RD FLOOR UNVENT	1	15	600		1200		600	15	1	2ND FLOOR UNVENT	10	2	12	12	
2	12	12	11	3RD FLOOR UNVENT	1	15	600			1800	1200	15	1	3RD FLOOR UNVENT	12	2	10	10	
2	12	12	13	BC-11	2	20	250	250			600	20	1	SPARE	14	2	12	12	
2	12	12	15				250		850		600	15	1	3RD FLOOR UNVENT	16	2	12	12	
2	12	12	17	BC-10	2	20	250	850			850	600	15	1	3RD FLOOR UNVENT	18	2	12	12
2	12	12	19				250	850			600	15	1	1ST FLOOR UNVENT	20	2	12	12	
2	12	12	21	AC-9(F,G,H,I,J)	2	20	250		850		600	15	1	1ST FLOOR UNVENT	22	2	12	12	
2	12	12	23				250		850		600	15	1	1ST FLOOR UNVENT	24	2	12	12	
2	12	12	25				6840	7440			600	15	1	1ST FLOOR UNVENT	26	2	12	12	
3	3	8	27	CU-5	3	90	6840		7440		600	15	1	1ST FLOOR UNVENT	28	2	12	12	
2	12	12	29				6840		7440		600	15	1	1ST FLOOR UNVENT	30	2	12	12	
2	12	12	31	SPARE	1	20		0			250	20	1	SPARE	32	2	12	12	
2	12	12	33	SPARE	1	20			250		250	20	2	BC-3	34	2	12	12	
2	12	12	35	SPARE	1	20				250	250	20	2	BC-3	36	2	12	12	
2	12	12	37	SPARE	1	20			250		250	20	2	AC-4(A,B,C)	38	2	12	12	
2	12	12	39	SPARE	1	20				250	250	20	2	AC-4(A,B,C)	40	2	12	12	
2	12	12	41	AC-3A	2	20	250			500	250	20	2	BC-8	42	2	12	12	
2	12	12	43				250	500			250	20	2	BC-8	44	2	12	12	
2	12	12	45	AC-4D	2	20	250		500		250	20	2	AC-11A & AC-8C	46	2	12	12	
2	12	12	47	SPARE	1	20	250			500	250	20	1	SPARE	48				
2	12	12	49	SPARE	1	20		0			20	1	1	SPARE	50				
2	12	12	51	SPARE	1	20			0		20	1	1	SPARE	52				
2	12	12	53	SPARE	1	20				0	20	1	1	SPARE	54				
2	12	12	55	SPARE	1	20		0			20	1	1	SPARE	56				
2	12	12	57	SPARE	1	20				0	20	1	1	SPARE	58				
2	12	12	59	SPARE	1	20				0	20	1	1	SPARE	60				

PANEL TYPE : NEMA 1	PHASE CONN.	12290	11940	13390	VA	20	% SPARE CAPACITY
MOUNTING: SURFACE	TOTAL CONN. LOAD	37.62	105	AMPS	100	% DEMAND FACTOR	
FED FROM:	CON and SPR. LOAD	45.144					
	TOT. DEM. LOAD	45.144					
	TOT.DEM. LOAD	125.4557581	@	208	VOLTS	REMARKS:	

PANEL SCH.		UP-2D		FRAME/TRIP		MLO				MCB / MLO																			
PANEL LOC.		CLOSET																											
120 / 208		VOLT, 3PH, 4W, GND				AMP BUS SIZE		200 AMP		PANEL SHORT CIRCUIT RATING: >				22 KA/IC															
FDR.DATA		CIR. NO.		LOAD DESCRIPTION		C.B. POLE NO.		C.B. TRIP A		C.B. LOAD VA		PHASE A		PHASE B		PHASE C		C.B. LOAD VA		C.B. TRIP A		C.B. POLE NO.		LOAD DESCRIPTION		CIR. NO.		FDR.DATA	
No. WIRE GND																										No. WIRE GND			
2 12 12		1		BC-7		2		20		250		500						250		20		1		AC-5(A-B)		2		2 12 12	
		3								250				500				250								4		2 12 12	
2 10 10		5		2ND FLOOR UN/VENT		1		20		600						850		250		20		1		BC-6		6		2 12 12	
2 10 10		7		1ST FLOOR UN/VENT		1		20		600		850						250								8		2 12 12	
2 10 10		9		1ST FLOOR UN/VENT		1		20		600				850				250		20		1		BC-5		10		2 12 12	
2 12 12		11		1ST FLOOR UN/VENT		1		20		1200						1450		250		20						12		2 12 12	
2 12 12		13		2ND FLOOR UN/VENT		1		20		600		850						250		20		1		AC-7(A,B,C,D)		14		2 12 12	
2 12 12		15		FIRE SMOKE DAMPERS		1		20		500				750				250		20						16		2 12 12	
3 4 8		17		CU-6		3		80		5884		10804				10804		4920		60		3		CU-7		18		3 6 10	
		19								5884		10804						4920								20			
		21								5884		10804						4920								22			
2 12 12		23		ROOF RECEPTACLES		1		20		720						720		20		1				SPARE		24			
		25		SPARE		1		20				0						20		1				SPARE		26			
		27		SPARE		1		20						0				20		1				SPARE		28			
		29		SPARE		1		20								0		20		1				SPARE		30			
		31		SPARE		1		20				0						20		1				SPARE		32			
PANEL TYPE: NEMA 1						PHASE CONN.						13004		12904		13824		VA		20 % SPARE CAPACITY									
MOUNTING: SURFACE						TOT. CONN. LOAD						39.732						110		AMPS		100 % DEMAND FACTOR							
FED FROM:						CON. AND SPR. LOAD						47.6784																	
						TOT. DEM. LOAD						47.6784																	
						TOT DEM. LOAD						132.4988884						@		VOLTS		REMARKS:							
																				208									