










AS - BUILT ROUGH PLUMBING  
BLDG. F - 2ND FLOOR NORTH BATHROOM

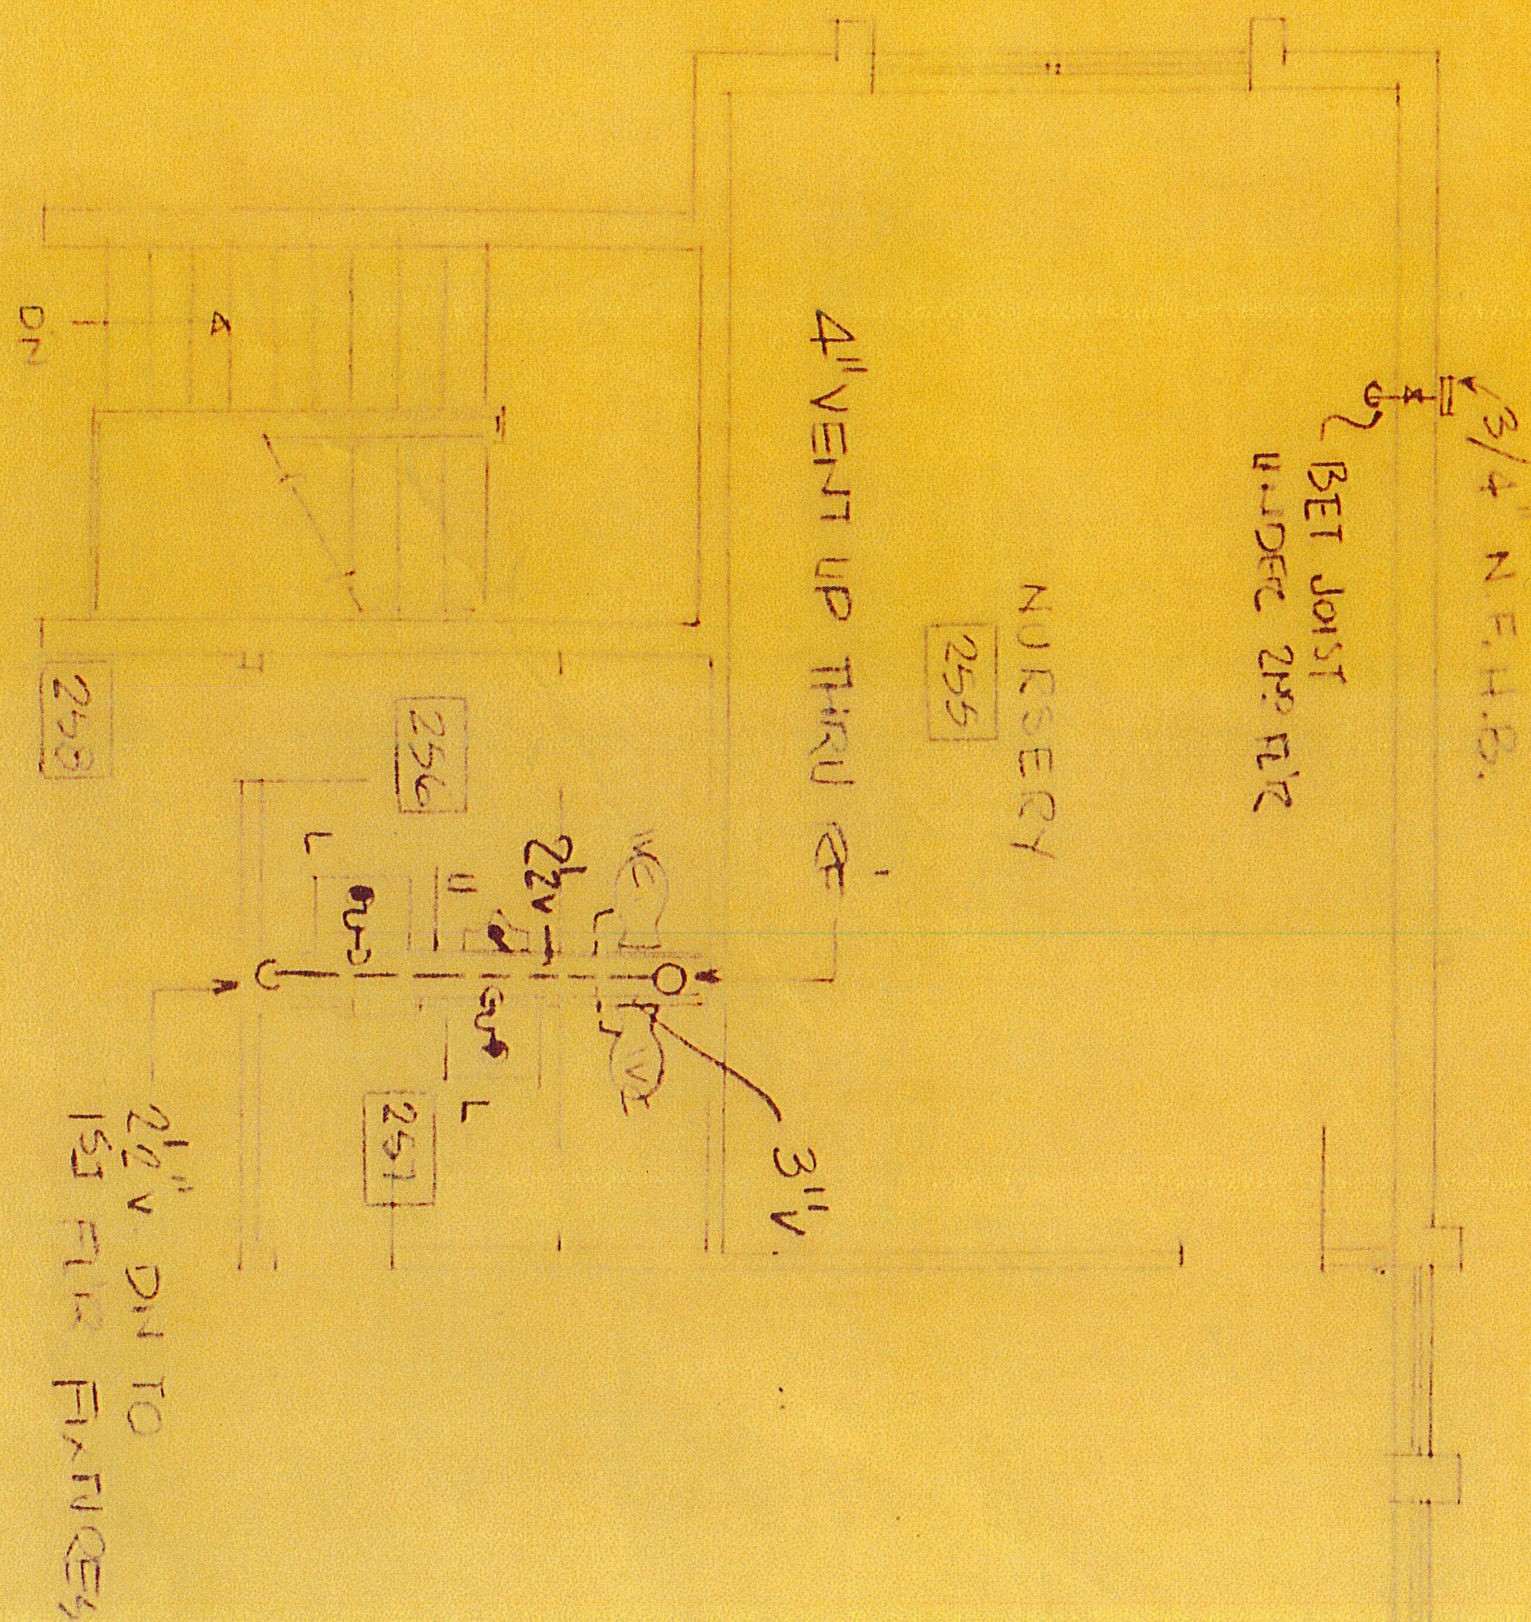


WAITING  
253

OFFICE  
259



AS - BUILT ROUGH PLUMBING  
BLDG. F - 2ND FLOOR EAST BATHROOM

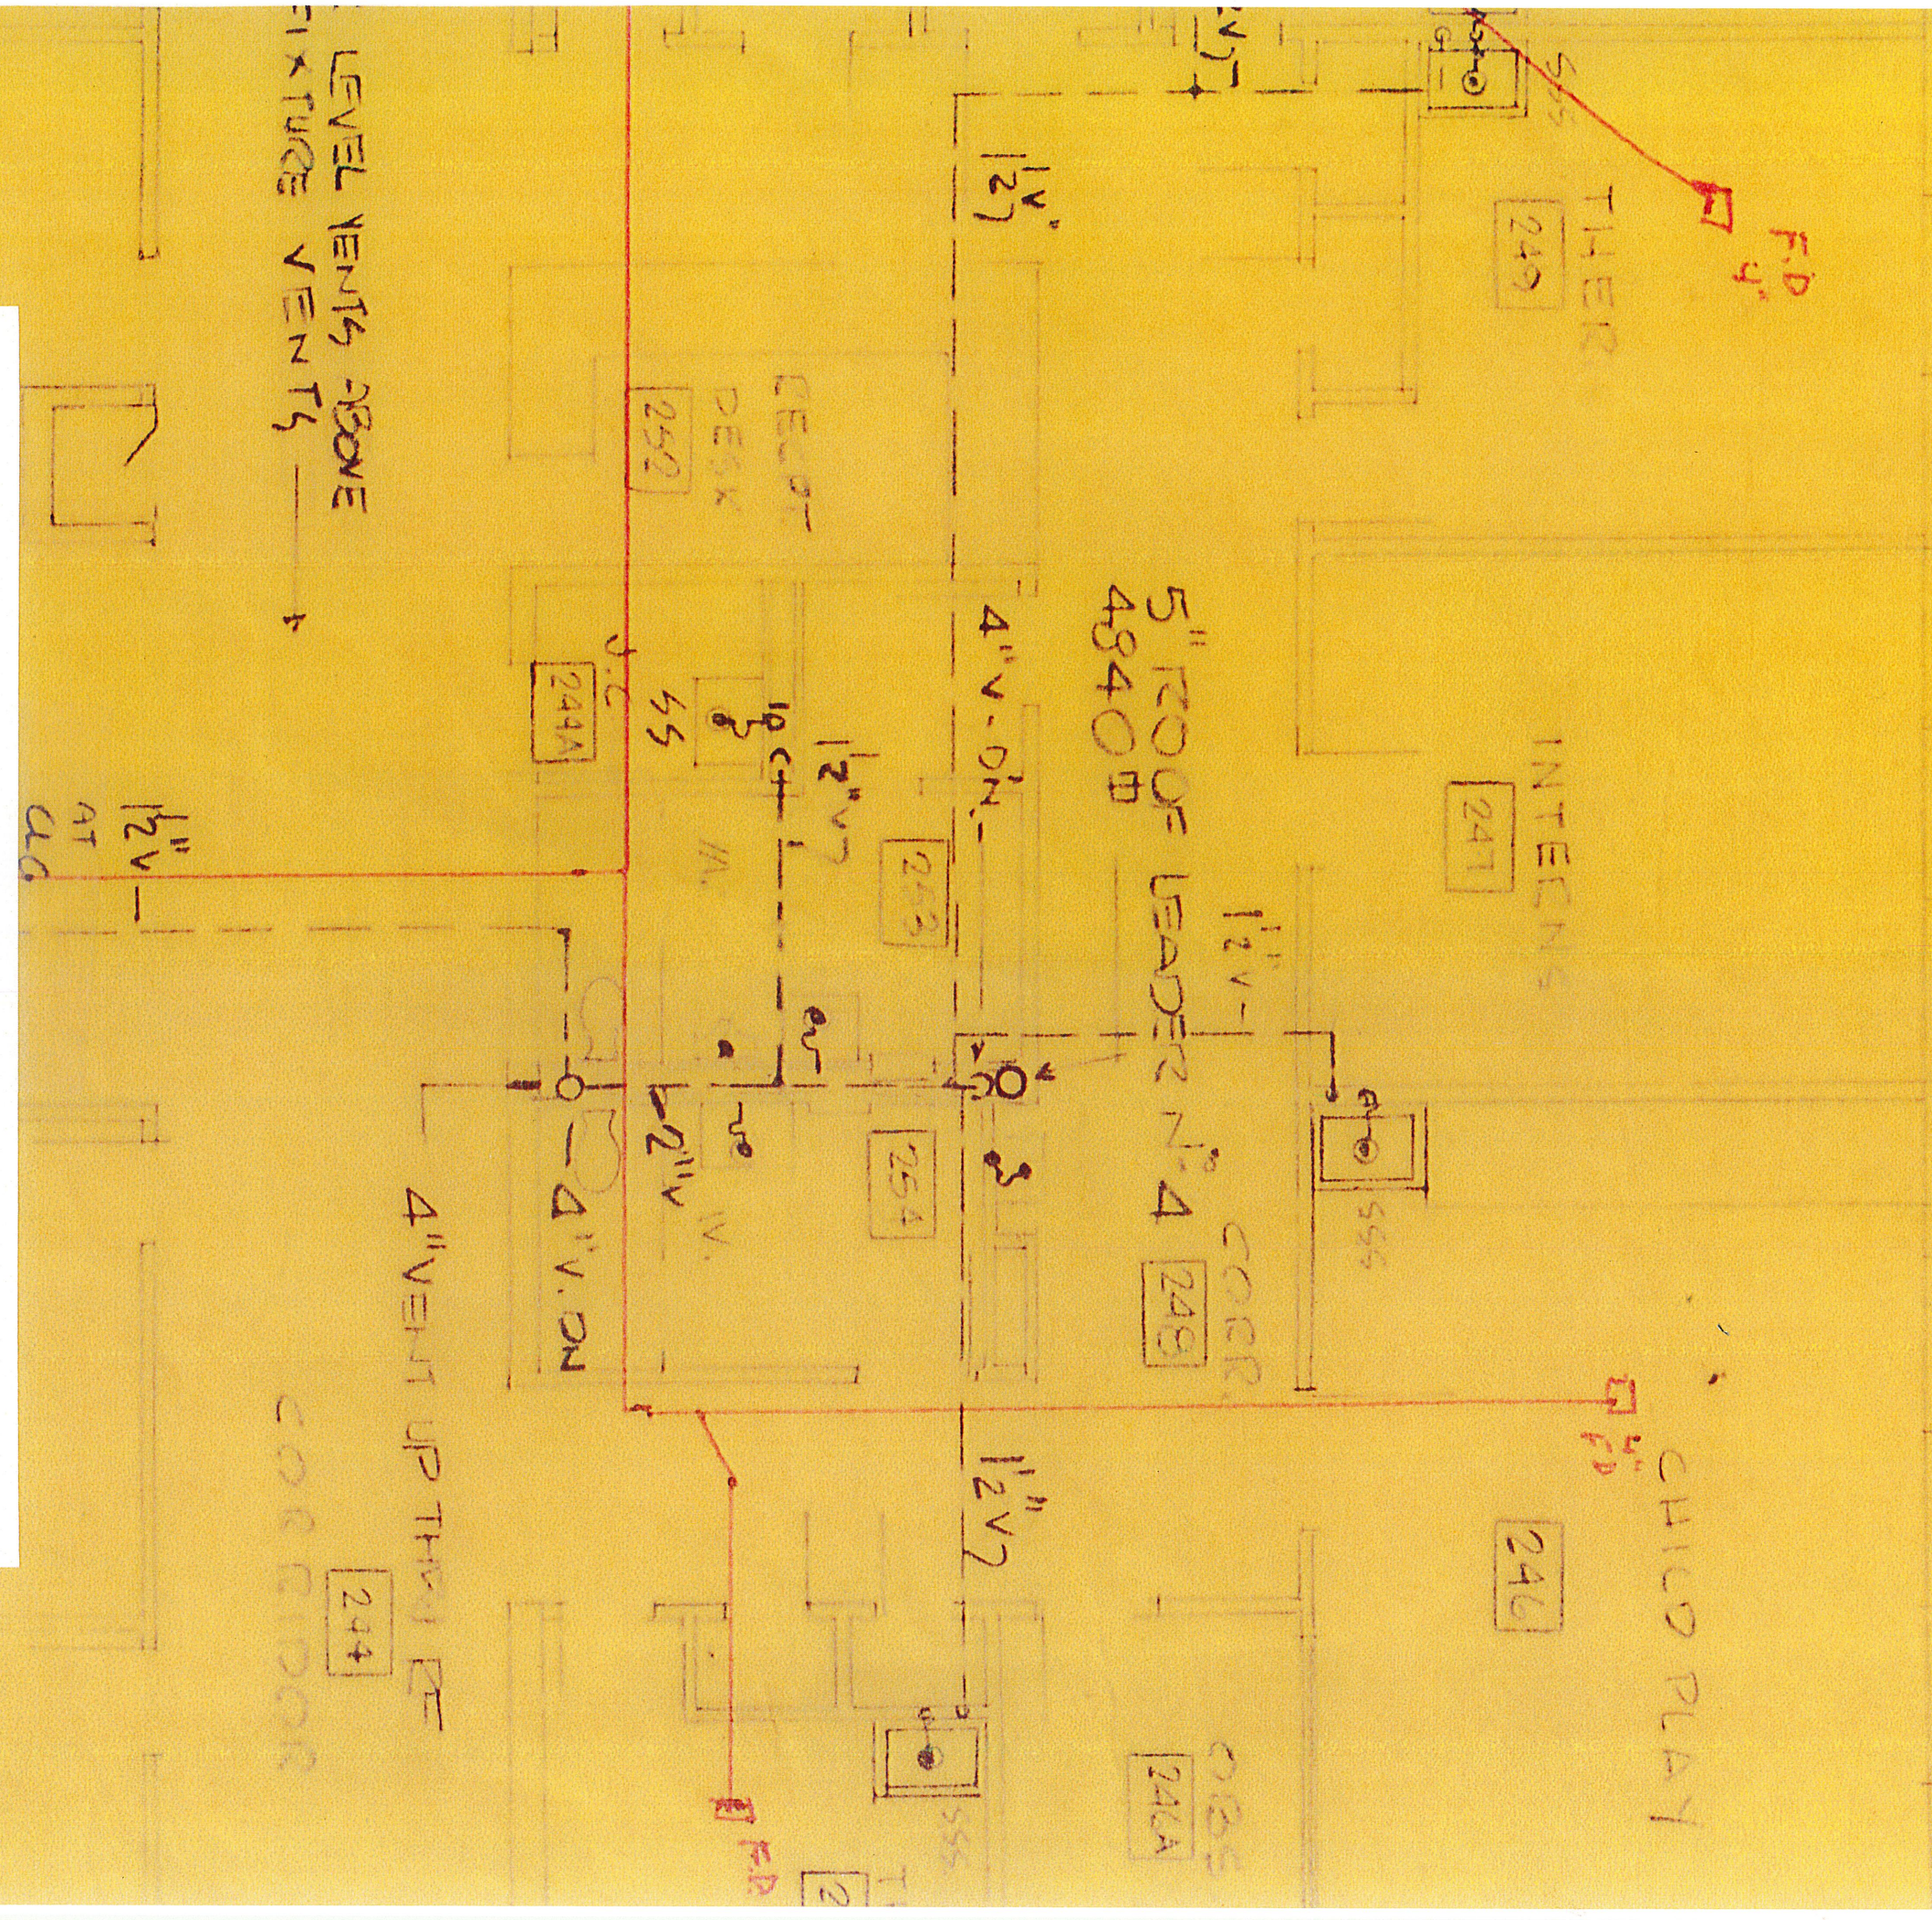

LEVEL VENTS ABOVE  
FIXTURE VENTS

4" VENT UP THRU RF  
CORRIDOR

5" ROOF LEADER N<sup>o</sup> 4  
4840 #

CHILD PLAY

241

240

239

238

249

247

248

246

244A

252

244A

243

254

244

555

555

241

240

239

238

249

247

248

246

244A

252

244A

243

254

244

555

555

555


555

555

555



**AS - BUILT ROUGH PLUMBING**  
**BLDG. F - 2ND FLOOR SOUTH BATHROOM**

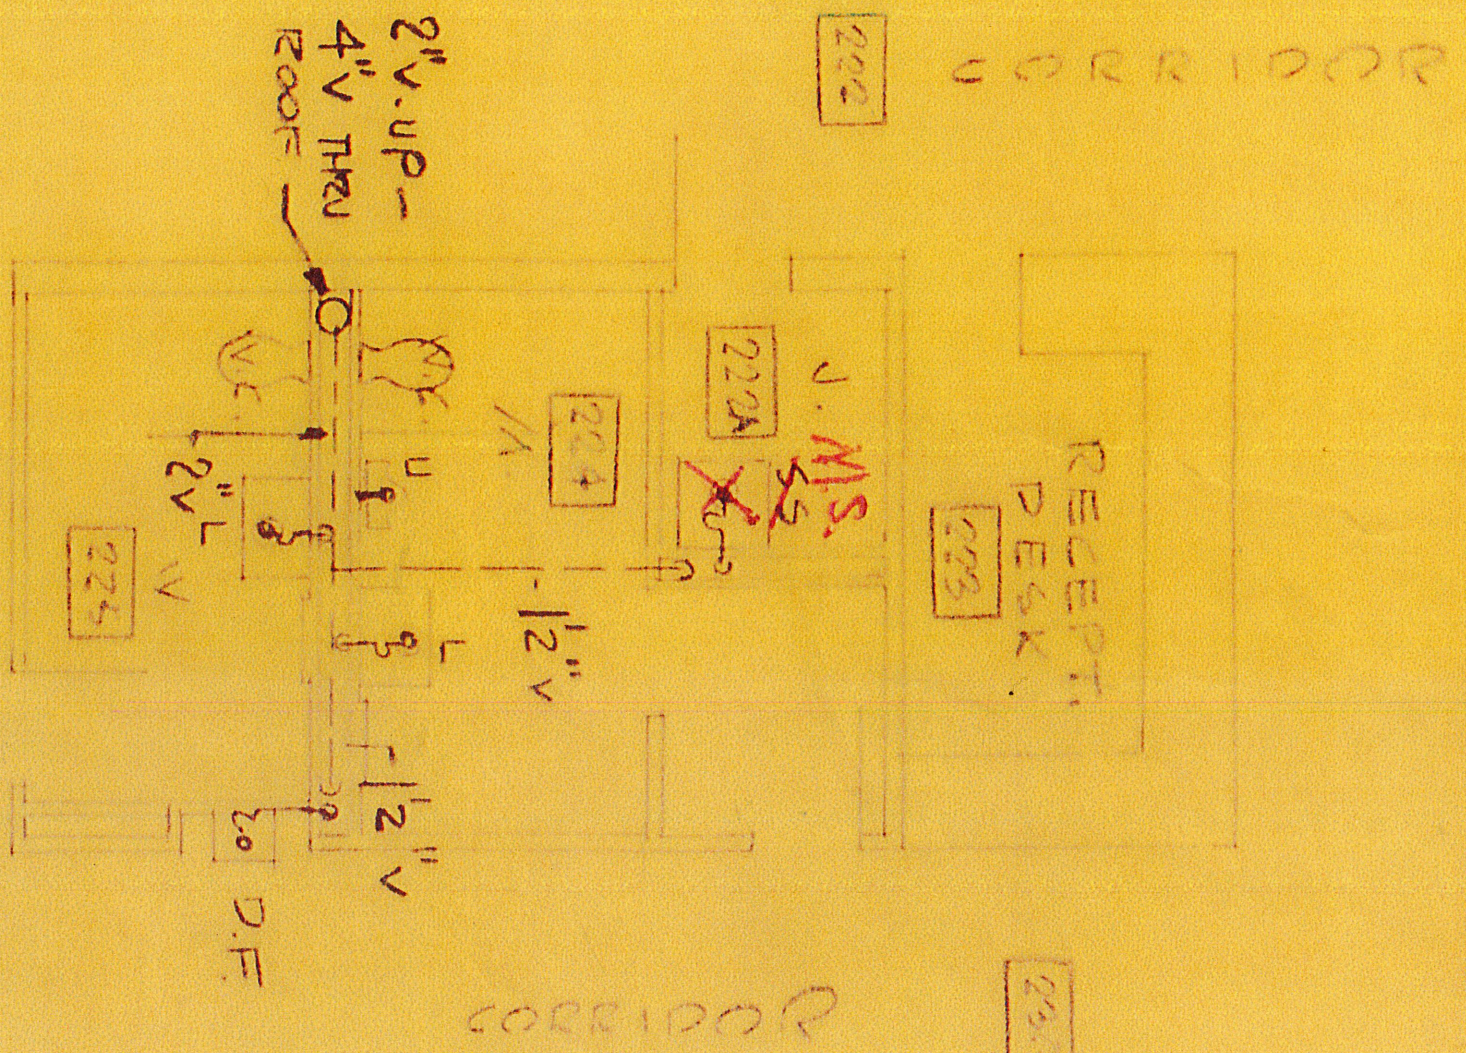

5" ROOF LEADER N°1  
4840 #

STAIR N°2

