

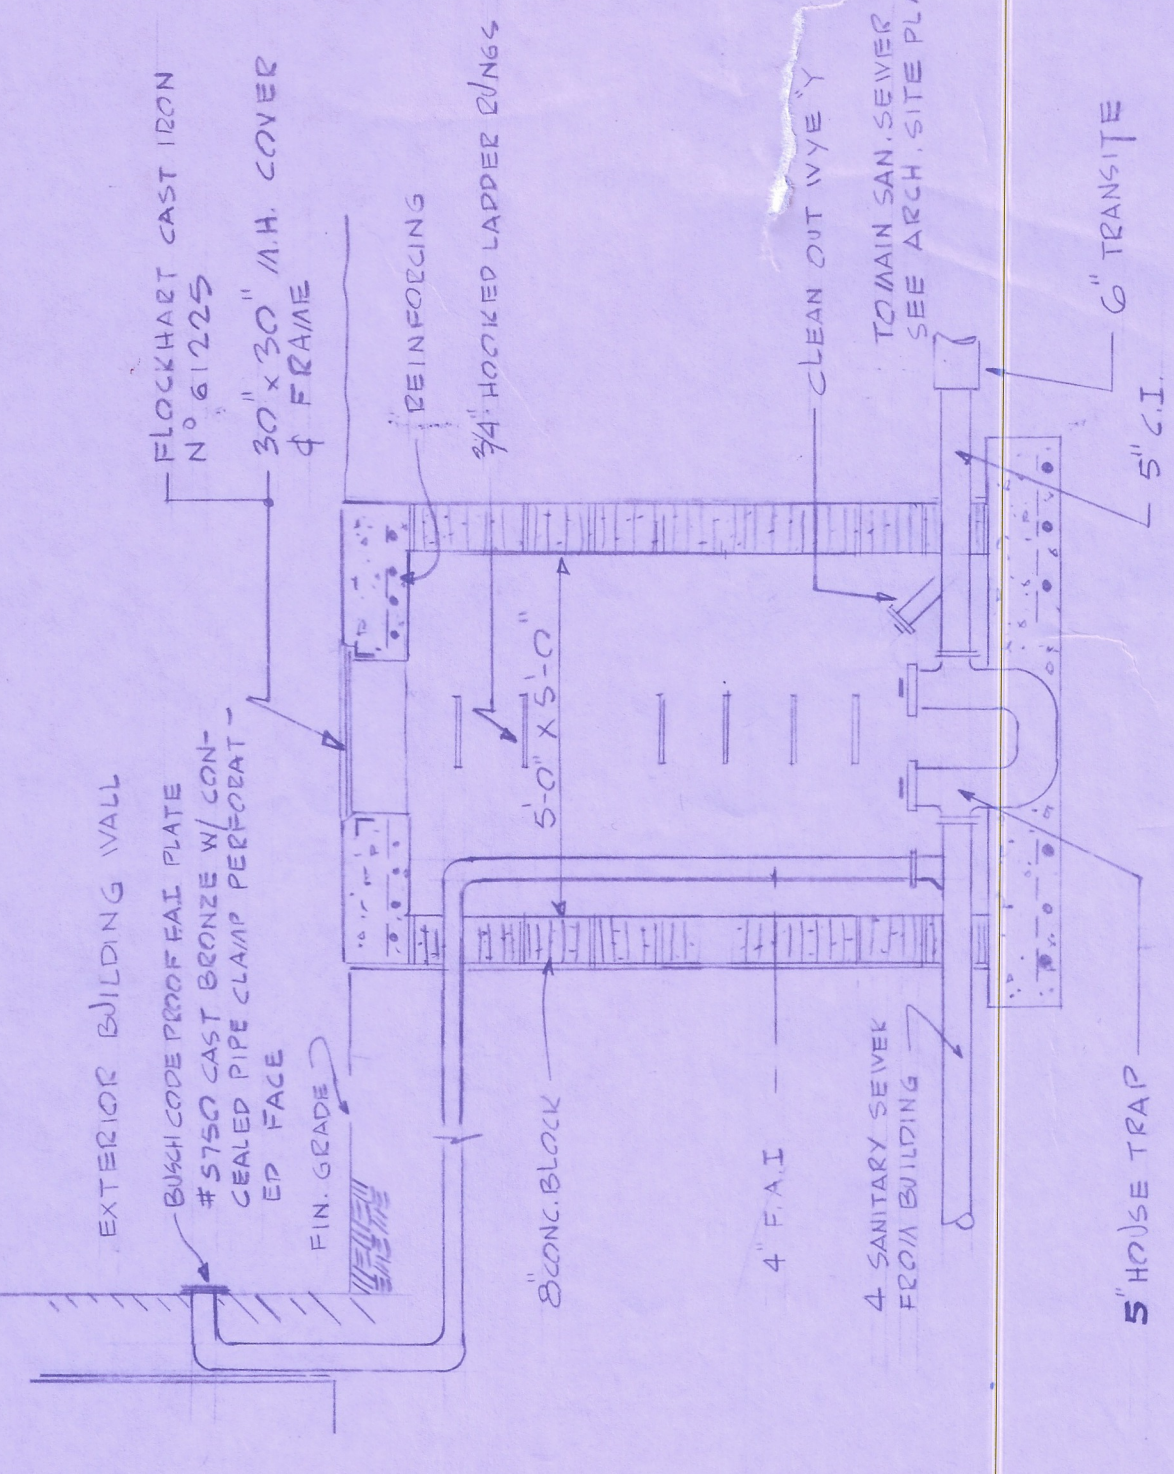
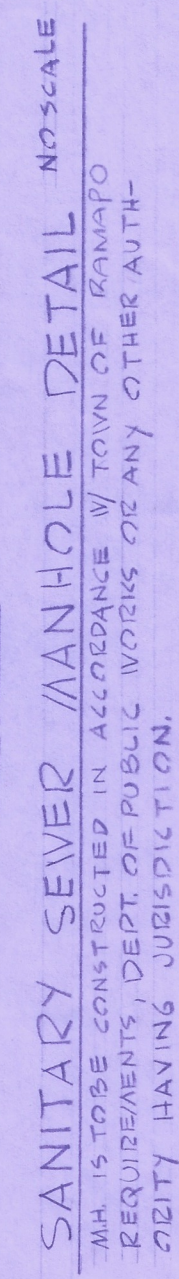
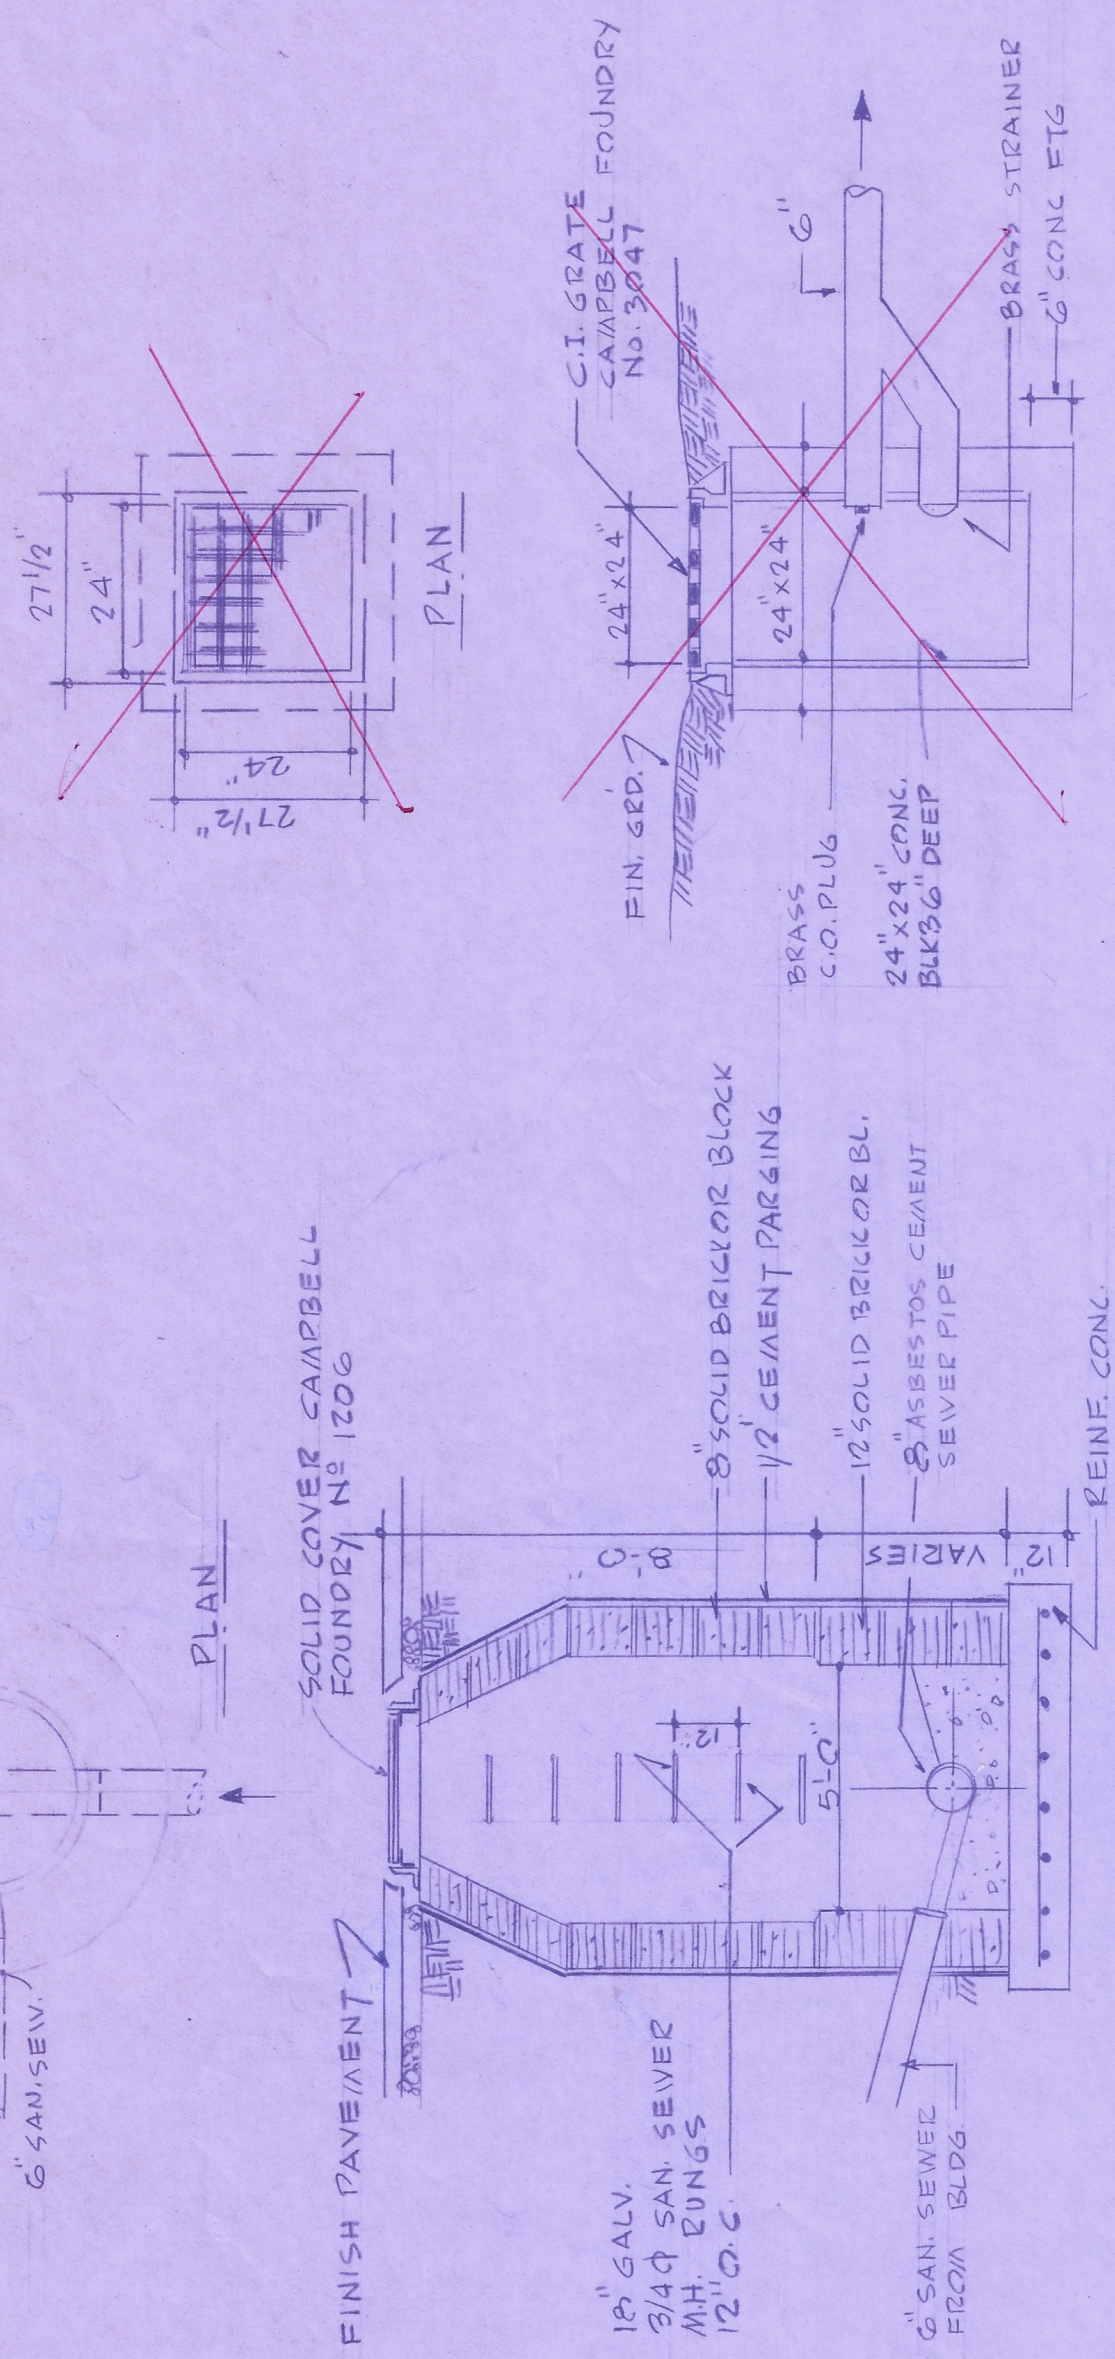
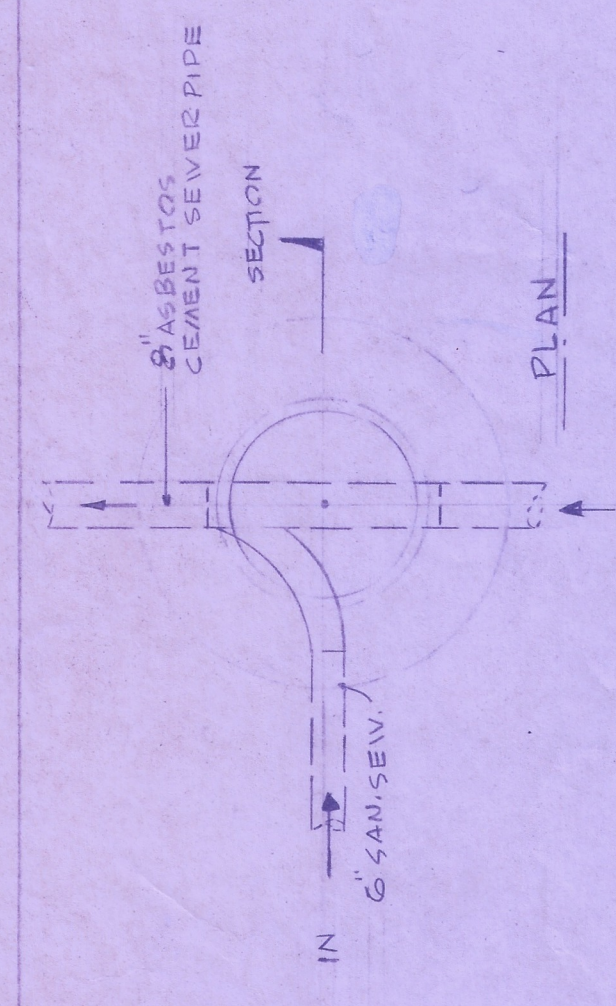
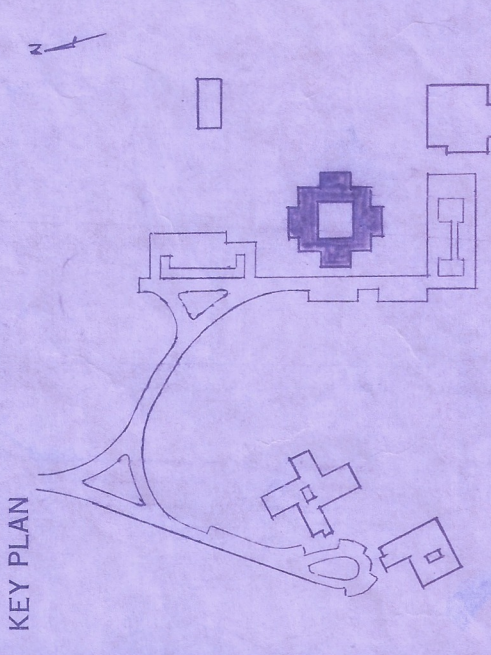


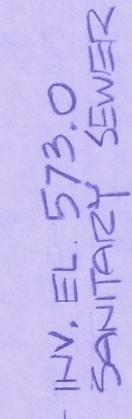

TYPICAL H. TRAP SANITARY SEWER MANHOLE DETAIL

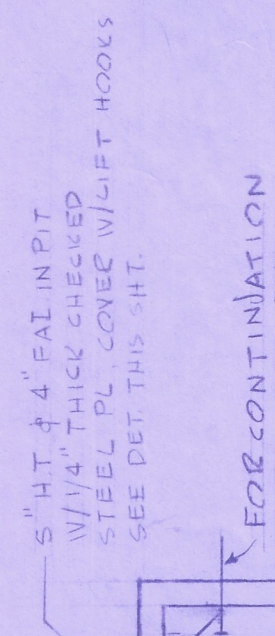

REV.	DATE	DESCRIPTION
		MENTAL HEALTH FACILITIES BUILDINGS PROJECT #15-100-PR-7 AT THE SUMMIT PARK HEALTH AND WELFARE COMPLEX SANATORIUM ROAD, PARSON, NEW YORK COUNTY BOARD OF SUPERVISORS ROBERT F. SLOVIC, CHAIRMAN PAUL F. MUDOT JOHN F. MALEYNEY PHILIP J. TORELLA JOHN B. LOVETT KEY PLAN

THIS CERTIFIES THAT THE INFORMATION SHOWN ON THIS DRAWING INDICATES THE ACTUAL AS-BUILT CONDITION OF THE INSTALLATION.

SIGNED Donna Dwyer
SWORN TO BY DEWEENT
THIS 11th DAY OF AUGUST 1990
Attest: Donna Dwyer
Residing in Kootenai County
Idaho
Commission Expires August 05, 1997