


on the job and this office must be notified of any variation from these dimesions and conditions shown hereon in writting.

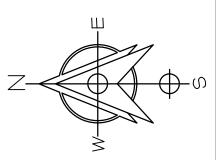


# CAPITAL, LLC 1345 AVENUE OF


THE AMERICAS NEW YORK, NY 10105

Project Information PROPOSED SITE DEVELOPMENT

**PLANS** 1060 NEPPERHAN AVENUE CITY OF YONKERS WESTCHESTER CO. NEW YORK

Job No.	21-082
Scale	AS NOTED
Date	27 DEC 2021
Drawn By	C.R. / M.M.

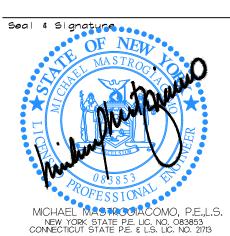

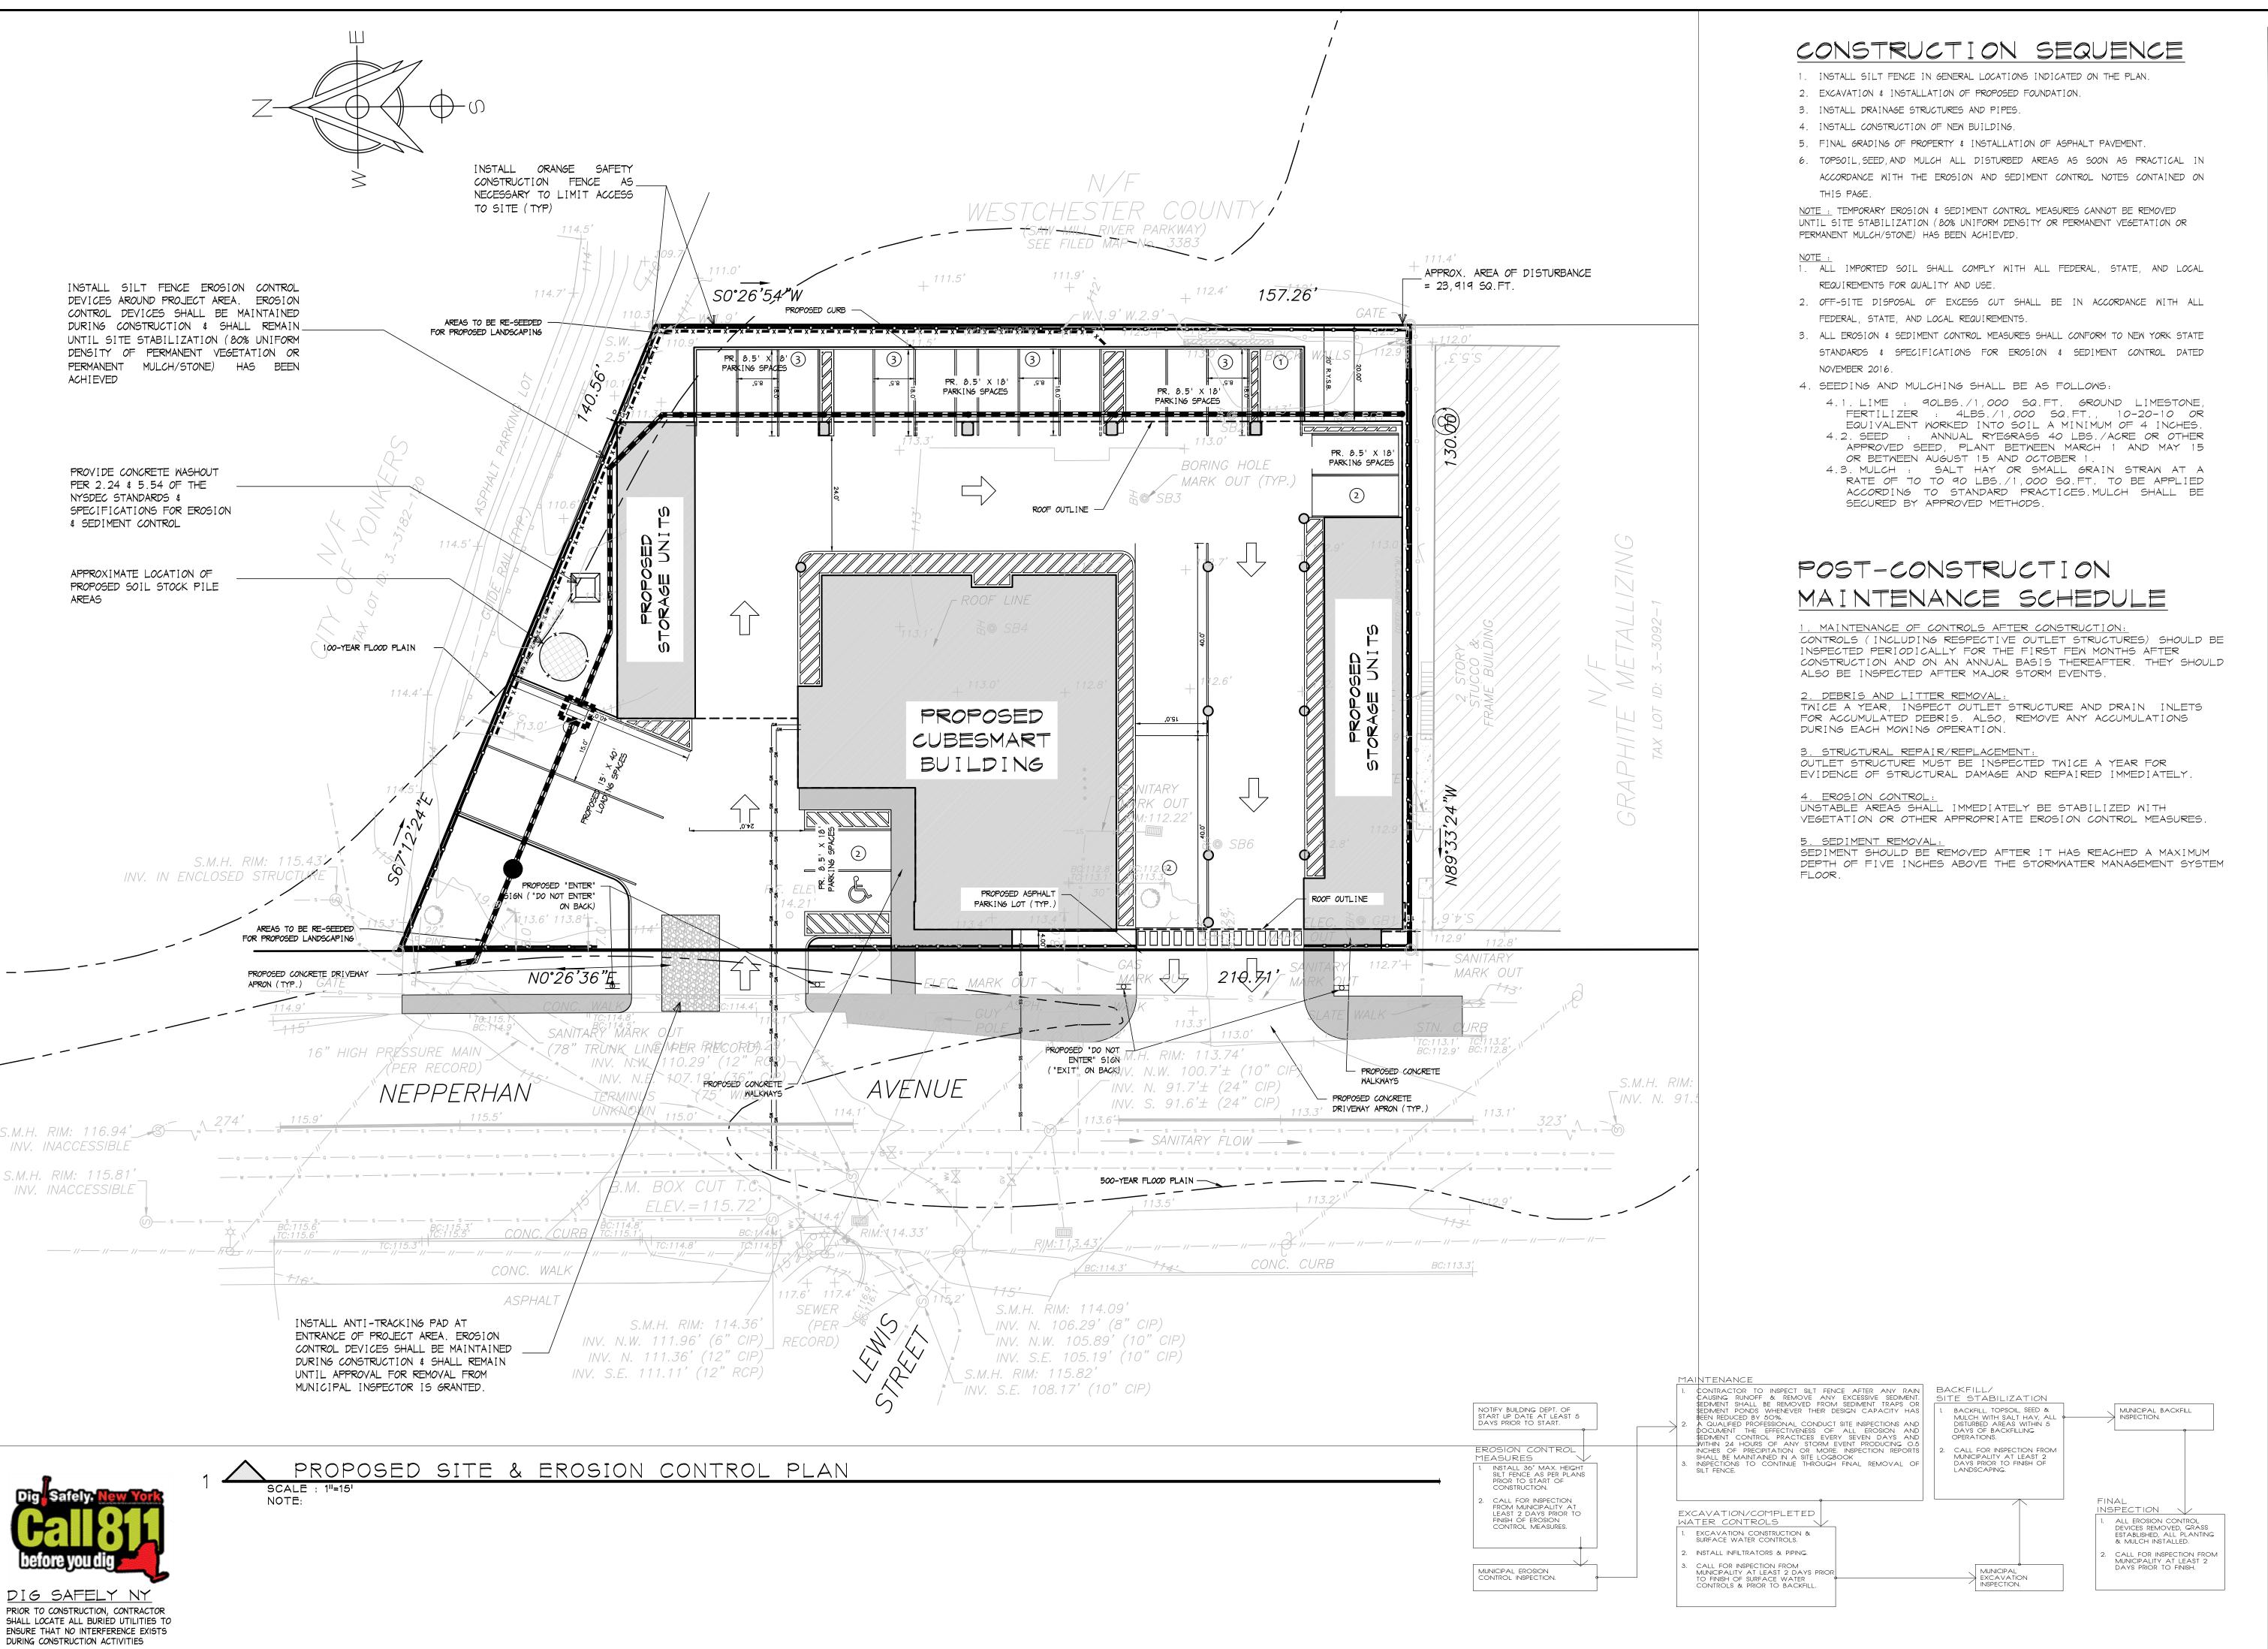

MASTROGIACOMO

ENGINEERING P.C

CONSULTING ENGINEERING & LAND SURVEYING

10 Midland Avenue, Suite 204A

Port Chester, New York 10578

Tel. 914.920.6872 EFex 206.888.6226

WWW.Masengpo.com


Licensed in New York a connecticut

All ideas, designs, arrangements and plans indicated or represented are owned by and the property of this office and were created, evolved and developed for use and is connection with this specific project. None of such ideas designs, arrangements or plans shall be used by or disclosed to any person, firm or corporation for any purpose whatsoever without written permission or Mastrogiacomo Engineering, P.C.

percedence over scaled dimensions. Contractors shall verify and be responsible for all dimensions and conditions on the job and this office must be notified of any variation from these dimesions and conditions shown hereon in writting.

It is a violation of the New York State Education Law for any person, unless acting under the direction of a Licensed Professional Engineer, to alter any item on this drawing and/or related specification. all alterations must be made in compliance with the New York State Education Law. the Professional Engineer whose seal appears hereon assumes no responsibility for any such alteration or re-use without his consent.

Drawing North

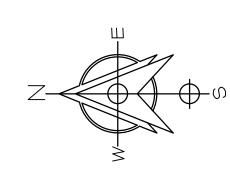

t Name and Address

# KDL CAPITAL,

1345 AVENUE OF THE AMERICAS NEW YORK, NY

W YORK, N 10105

# Project Information PROPOSED SITE DEVELOPMENT

PLANS

51 tuated At

1060 NEPPERHAN

AVENUE

CITY OF YONKERS

WESTCHESTER CO.

NEW YORK

b No. 21-082

ale AS NOTED

te 27 DEC 2021

awn By C.R. / M.M.

Drawn By
Checked By
Sheet

C10


Seal & Signature

OF NEW

MASTROC

083853

MICHAEL MASTROPIACOMO, P.E.

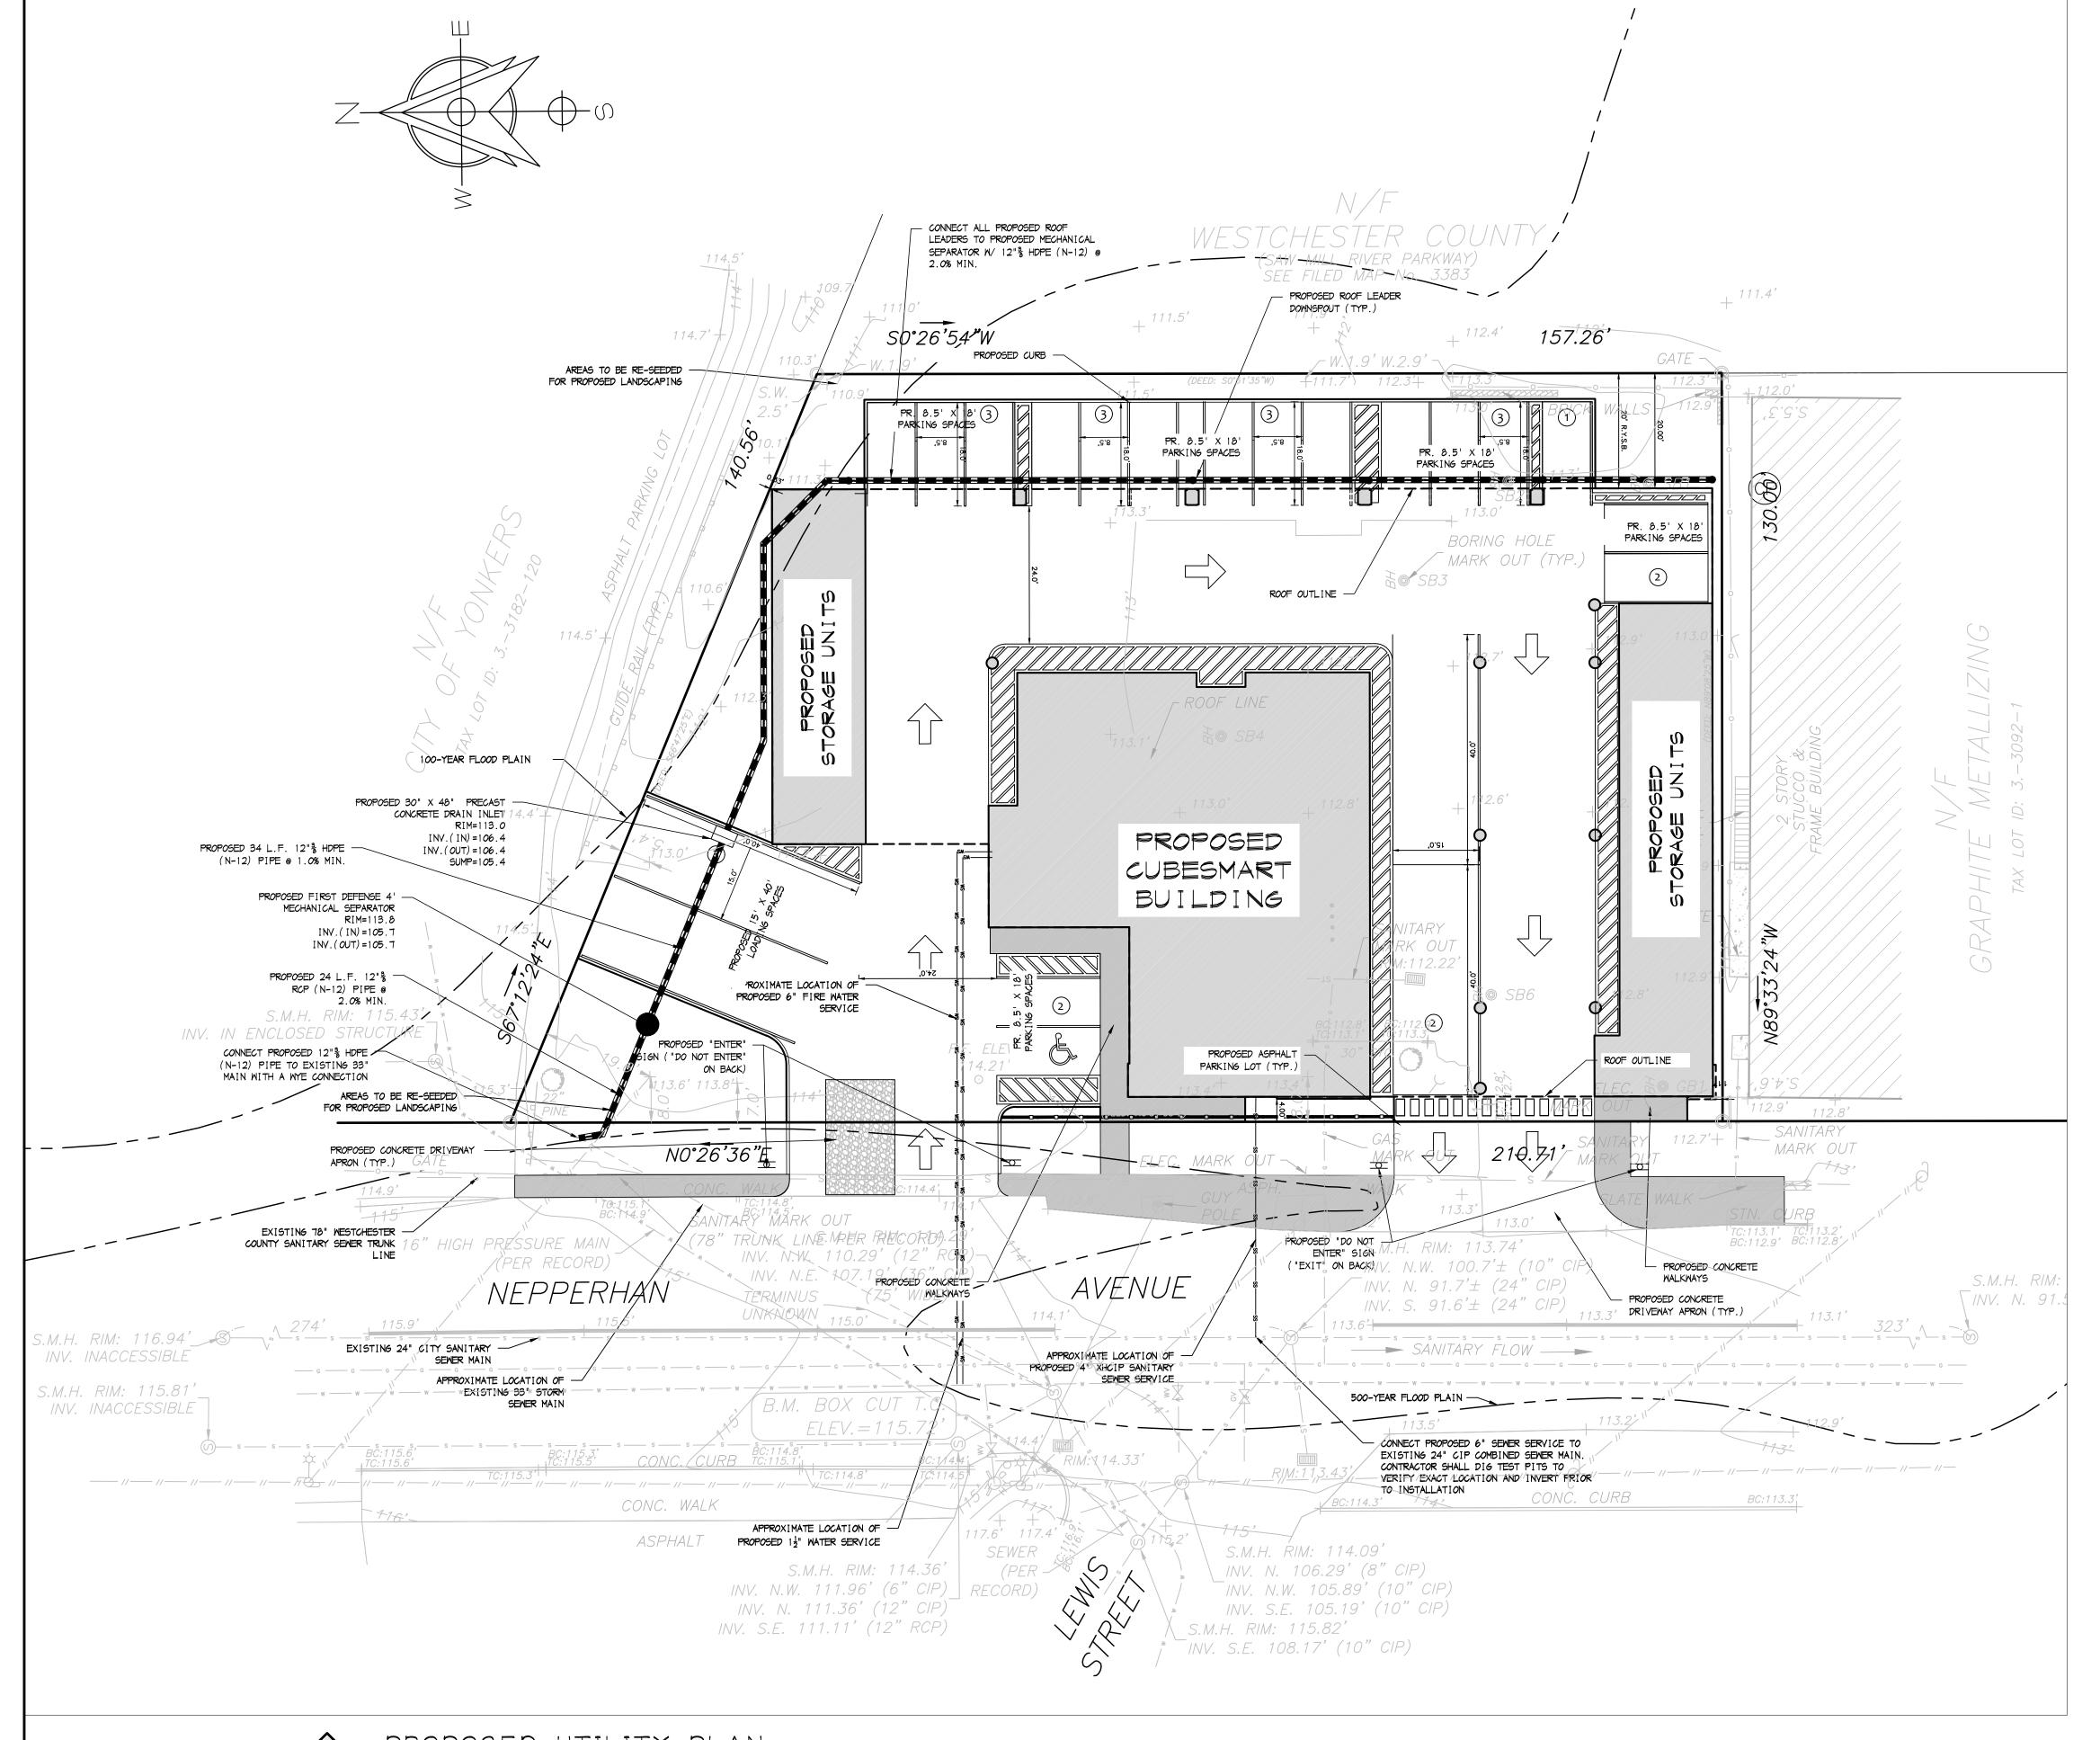

ENGINEERING, P.C 10 Midland Avenue, Suite 204A 

11 ideas, designs, arrangements and plans indicated o represented are owned by and the property of this office and were created, evolved and developed for use and in connection with this specific project. None of such ideas, designs, arrangements or plans shall be used by disclosed to any person, firm or corporation for a purpose whatsoever without written permission Mastrogiacomo Engineering, P.C.

WWW.masengpc.com Licensed in NBM York 4 CONNECTICUT


Mritten dimensions on these drawings shall have precedence over scaled dimensions. Contractors shall verify and be responsible for all dimensions and conditions on the job and this office must be notified of any variation from these dimesions and conditions shown hereon in writting.

It is a violation of the New York State Education Law f any person, unless acting under the direction of a Licensed Professional Engineer, to alter any item on this drawing and/or related specification. all alterations must be made in compliance with the New York State Education Law. the Professional Engineer whose seal appears hereon assumes no responsibility for any such alteration or resurse without his consent.

alteration or re-use without his consent.

Revisions

Drawing North

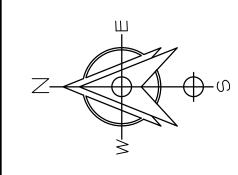

# Client Name and Address KDL CAPITAL, LLC 1345 AVENUE OF

THE AMERICAS NEW YORK, NY


10105 Project Information PROPOSED

# SITE DEVELOPMENT **PLANS**

1060 NEPPERHAN AVENUE CITY OF YONKERS WESTCHESTER CO. NEW YORK


′ I		
	Job No.	21-08
	Scale	AS NOTE
)	Date	27 DEC 201
)	Drawn By	C.R. / M.N
.	Classicad Dir	h.4.h


Checked By

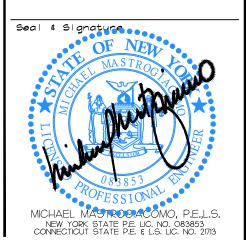


PROPOSED UTILITY PLAN SCALE : 1"=15' NOTE:




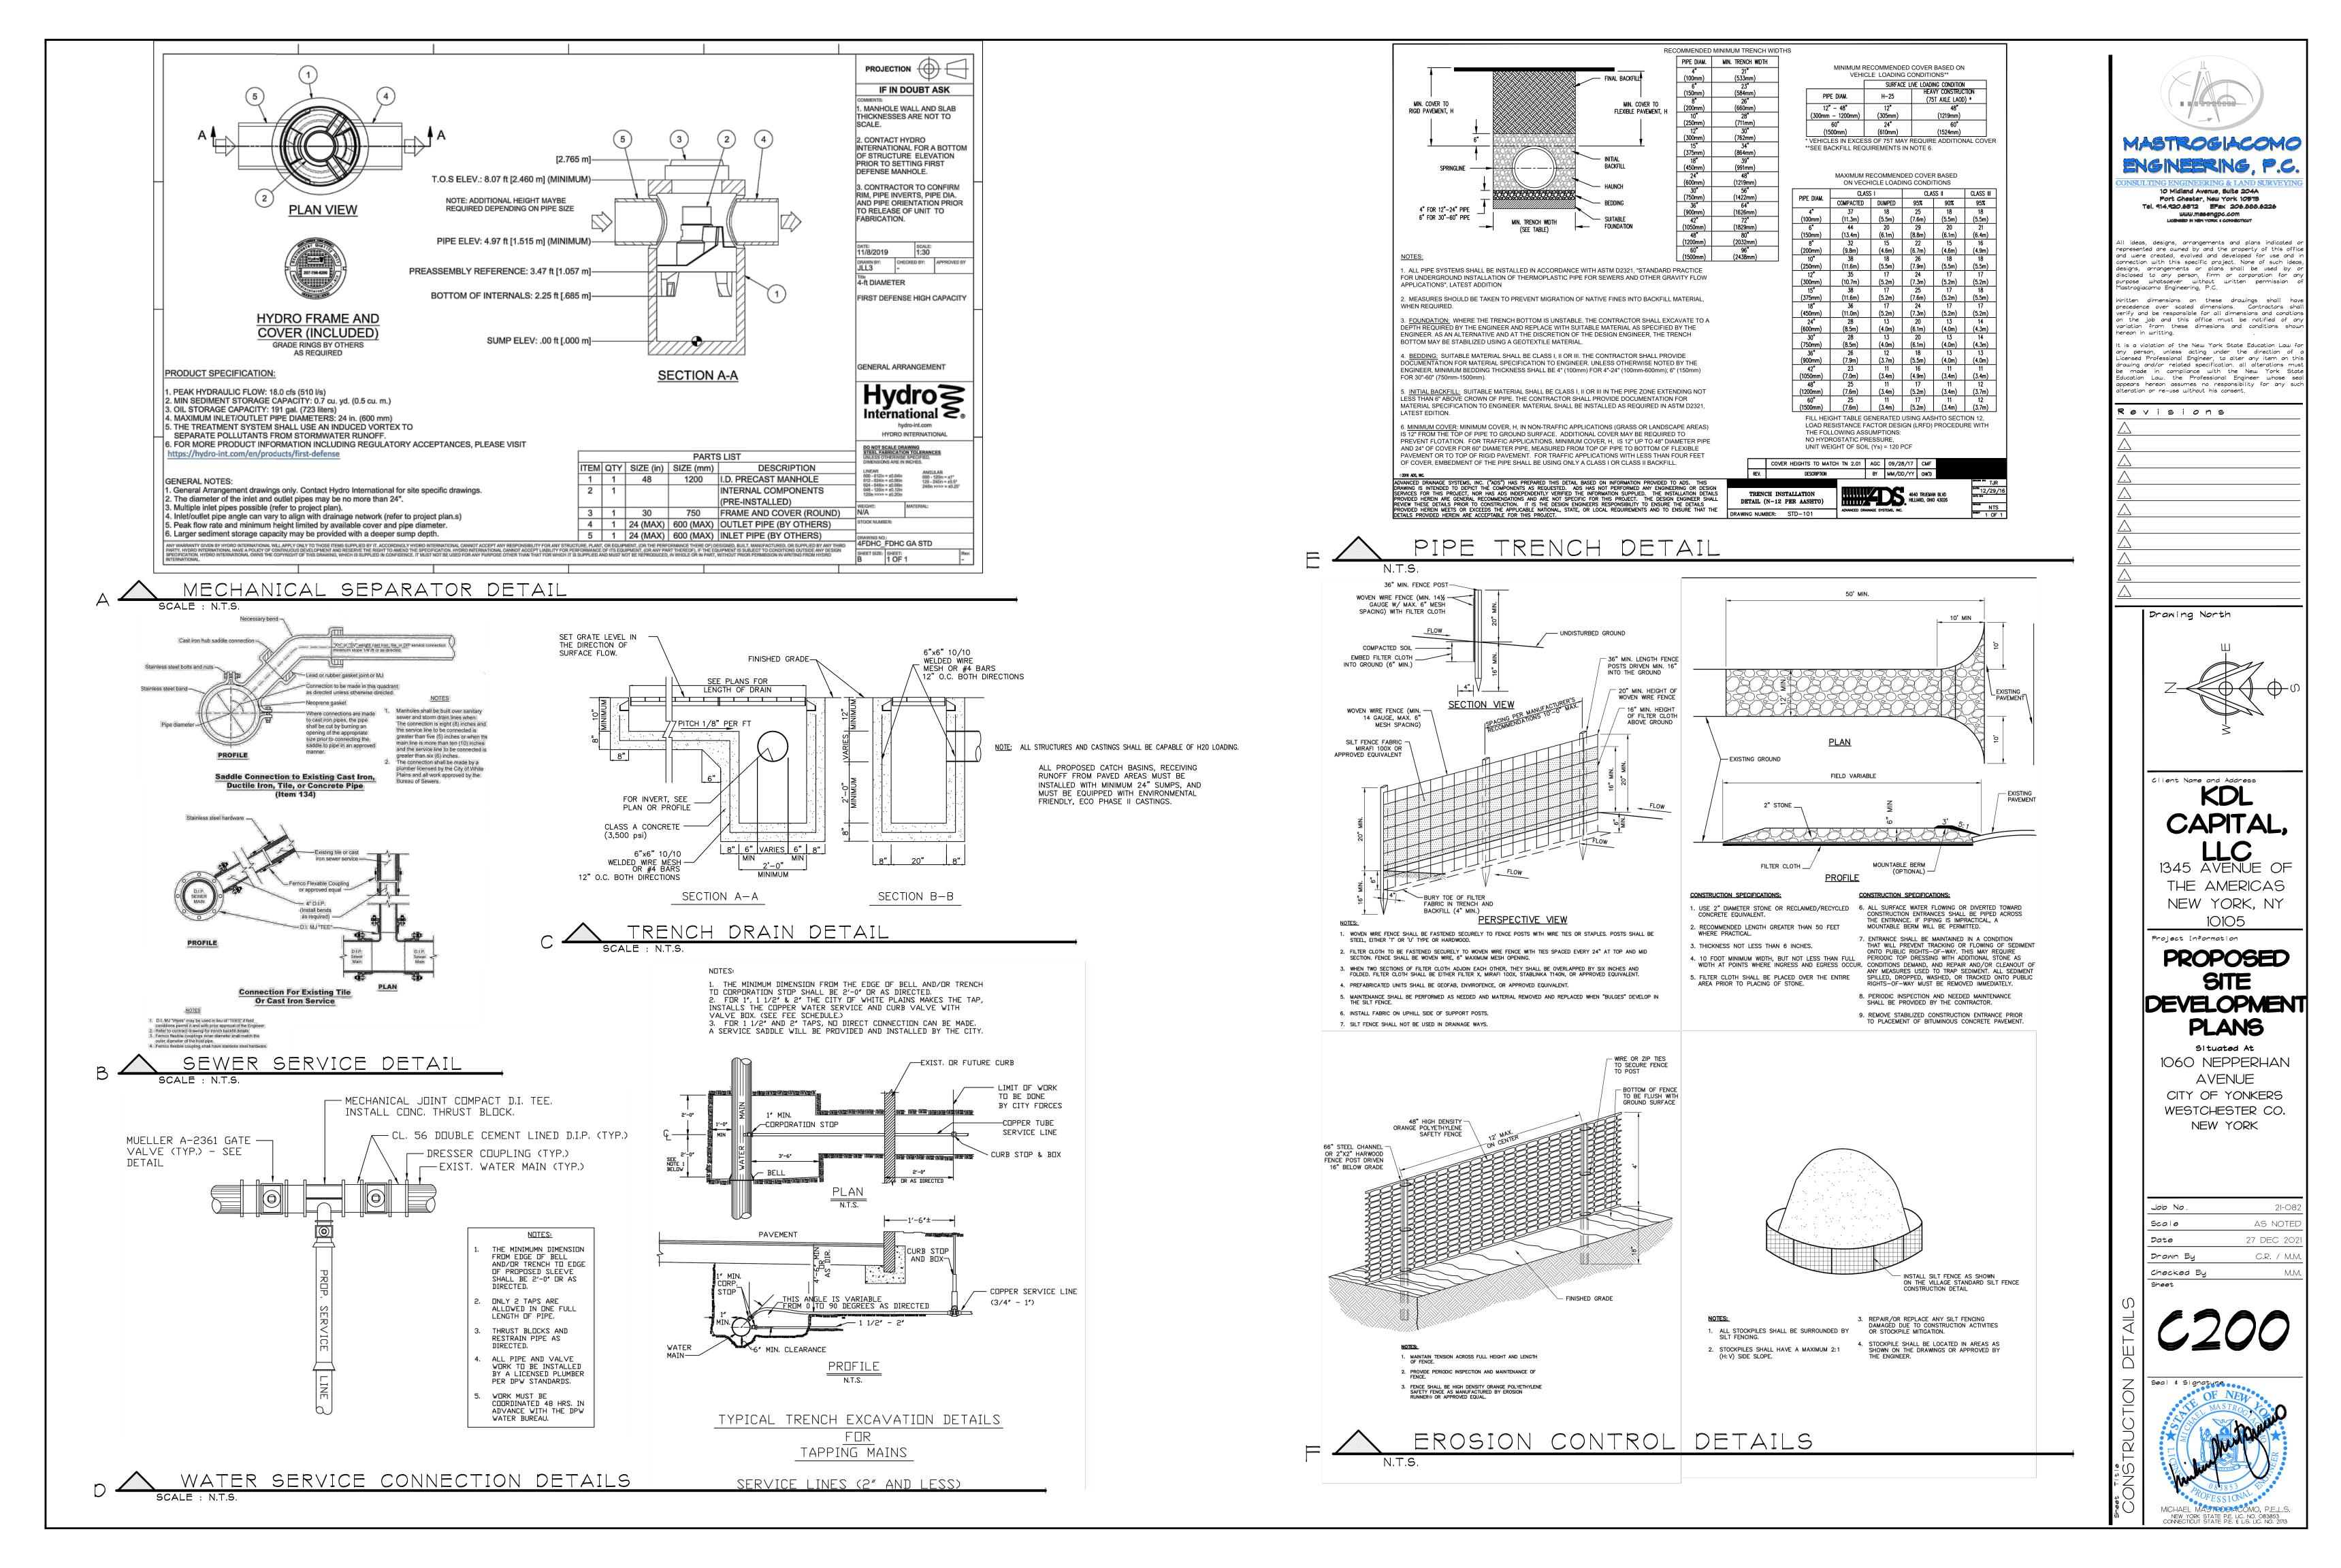

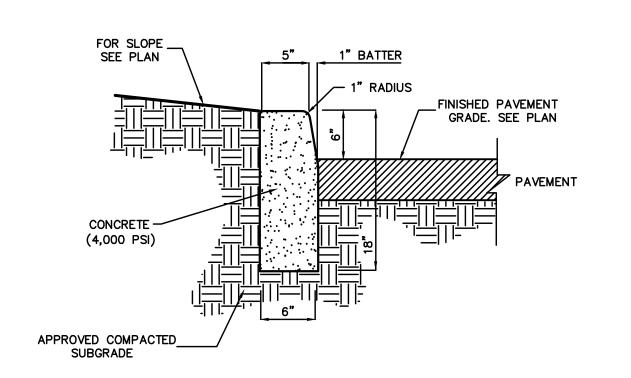

# CONCRETE CURB DETAIL

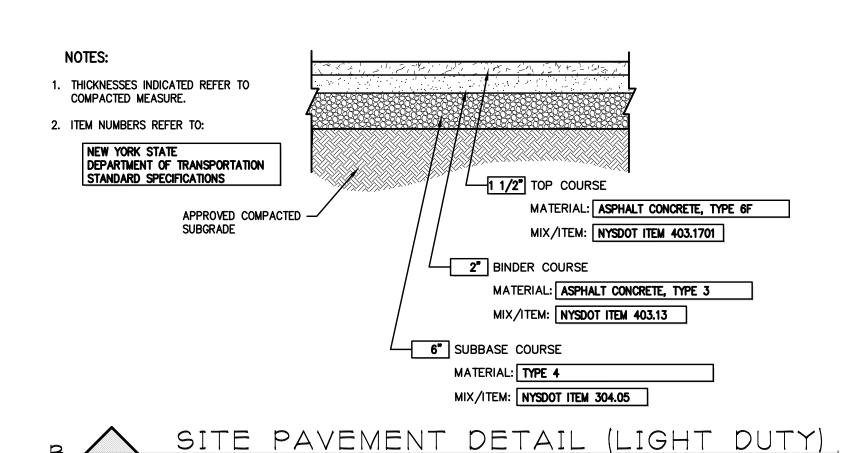


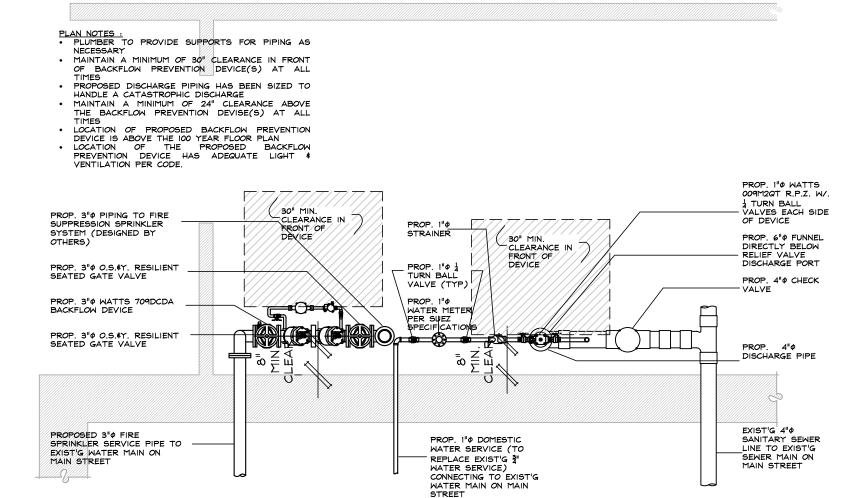


## GENERAL NOTES - BACKFLOW DEVICE

- GENERAL SPECIFICATIONS

   ENGINEER NOT ENGAGED FOR CONSTRUCTION SUPERVISION. . VERIFY ALL DIMENSIONS & CONDITIONS PRIOR TO COMMENCEMENT OF ANY & ALL WORK. ALL DISCREPANCIES BETWEEN THESE PLANS \$ ACTUAL FIELD CONDITIONS SHALL BE NOTIFIED TO THE ENGINEER IN WRITING PRIOR TO COMMENCEMENT OF WORK. · ALL WORK SHALL COMPLY WITH THE MUNICIPAL PLUMBING CODES, RULES & REGULATIONS; WATER CONVEYOR CODES & THE
- WESTCHESTER COUNTY DEPARTMENT OF HEALTH. . ALL WORK SHALL BE PERFORMED BY A LICENSED PLUMBER IN THE LOCAL MUNICIPALITY. • TESTING OF THE D.C.V. DEVICE INSTALLED SHALL BE PERFORMED BY A CERTIFIED TESTER ACCEPTABLE BY THE DEPARTMENT OF • ALL FEES MUST BE PAID, PLANS SUBMITTED \$ APPROVED, \$ PERMITS OBTAINED BEFORE \$ WORK MAY BEGIN.
- . THE WATER SERVICE TO THE EXISTING RESIDENCE SHALL BE SHUT OFF BEFORE WORK BEGINS. . THE D.C.V. DEVICE SHALL BE TESTED ONCE A YEAR # ALL RESULTS SHALL BE FORWARDED TO THE DEPARTMENT OF HEALTH. • THE D.C.V. DEVICE SHALL BE OVERHAULED EVERY FIVE (5) YEARS \$ OVERHAULED.
- . THE DOUBLE CHECK VALVE BACKFLOW PREVENTOR SHALL CONSIST OF INDEPENDENTLY OPERATING, SPRING LOADED, "Y" PATTERN CHECK VALVES & ONE HYDRAULICALLY DEPENDENT DIFFERENTIAL RELIEF VALVE. THE DEVICE SHALL AUTOMATICALLY REDUCE THE PRESSURE IN THE "ZONE" BETWEEN THE CHECK VALVES TO AT LEAST FIVE (5) P.S.I. LOWER THAN THE INLET PRESSURE. SHOULD THE DIFFERENTIAL BETWEEN THE UPSTREAM & THE ZONE OF THE UNIT DROP TO TWO (2) PSI, THE DIFFERENTIAL RELIEF VALVE SHALL OPEN & MAINTAIN THE PROPER DIFFERENTIAL. . MAINLINE VALVE BODY & CAPS INCLUDING RELIEF VALVE BODY & COVER SHALL BE BRONZE.
- . CHECK VALVE MOVING MEMBER SHALL BE CENTER STEM GUIDED. ALL HYDRAULIC SENSING PASSAGES SHALL BE INTERNALLY LOCATED WITHIN THE MAINLINE BODIES. DIAPHRAGM TO SEAT AREA RATIO SHALL BE 10 : 1 MINIMUM.
- . CHECK VALVE COMPONENTS SHALL BE CONSTRUCTED SO THEY MAY BE SERVICED WITHOUT REMOVING THE VALVE BODY FROM THE LINE. ALL SEAT DISCS SHALL BE REVERSIBLE # SHUT OFF VALVES SHALL BE FULL PORTED. . THE DEVICE SHALL BE RATED TO 175 P.S.I. WATER WORKING PRESSURE # WATER TEMPERATURE RANGE FROM 35°F TO 100°F. • THE DEVICE SHALL MEET THE REQUIREMENTS OF A.S.S.E. STANDARD 101-3, A.W.W.A. STANDARD CODE C506-78, \$ U.S.C. FOUNDATION FOR CROSS CONNECTION CONTROL # HYDRAULIC RESEARCH, SIXTH EDITION.
- THE LOCATION OF THE PROPOSED D.C.V. WILL PROVIDE ADEQUATE LIGHT \$ HEAT. . THE PROPOSED D.C.V. SHALL BE INSTALLED IN AN AREA PROTECTED FROM THE HIGHEST POSSIBLE FLOOD PLAIN. • AN O.S.H.A. APPROVED LADDER IS REQUIRED FOR DEVICES INSTALLED AT A HEIGHT OF 5'-O" & GREATER.
- . WHERE THE DISTANCE BETWEEN THE WATER METER \$ THE BACKFLOW PREVENTOR DEVICE IS GREATER THAN 10'-0", ALL EXPOSED PIPING SHALL BE STENCILED "FEED LINE TO BACKFLOW PREVENTOR - DO NOT TAP" AT 5'-0" INTERVALS.

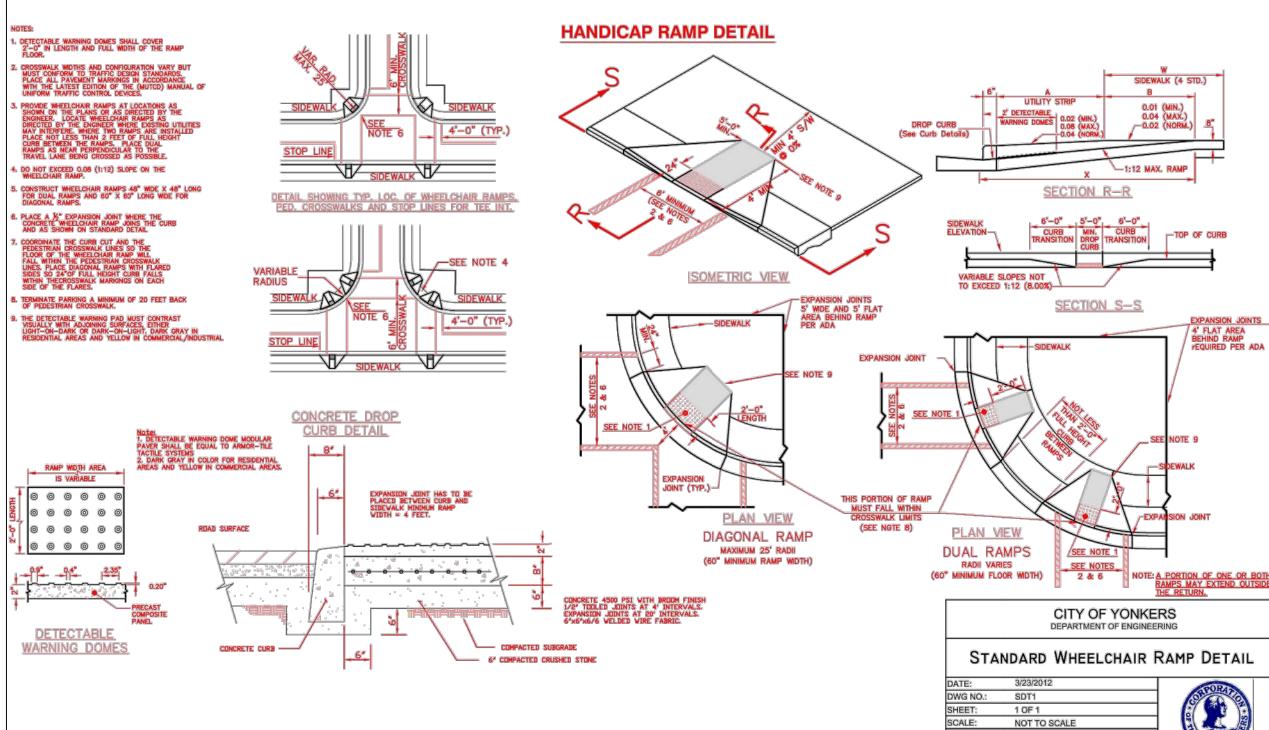


# OF YONKERS STANDARD DETAILS

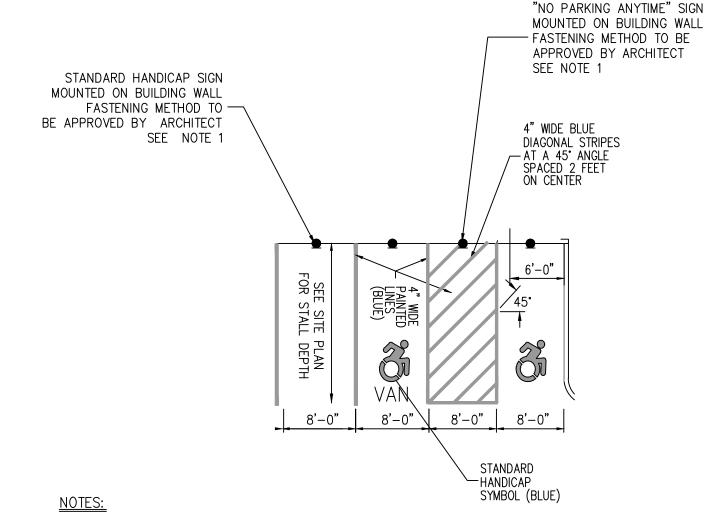


- 1. THEY SHALL CONTRAST VISUALLY WITH ADJOINING SURFACES, EITHER LIGHT-ON-DARK OR DARK-ON-LIGHT IN ACCORDANCE WITH SECTION 4.29.2, FEDERAL REGISTER, VOLUME 56, NO. 144, RULES AND REGULATIONS, APPENDIX A TO PART 36 - STANDARDS FOR ACCESSIBLE DESIGN (AMERICANS WITH DISABILITIES ACT), DATED JULY 26, 1991 AND SUBSEQUENT REVISIONS.
- 2. SLOPES IN HANDICAP PARKING AREAS SHALL NOT EXCEED 1.5%.
- 3. SEE SITE PLANS/SIGN TABLE FOR SIGN DESIGNATIONS, LOCATIONS AND SPECIFICATIONS.


# E H.C. STRIPING DETAIL

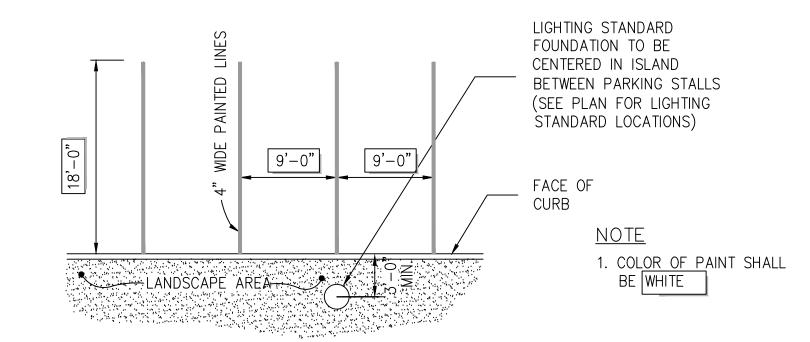

# PARKING STRIPING DETAIL

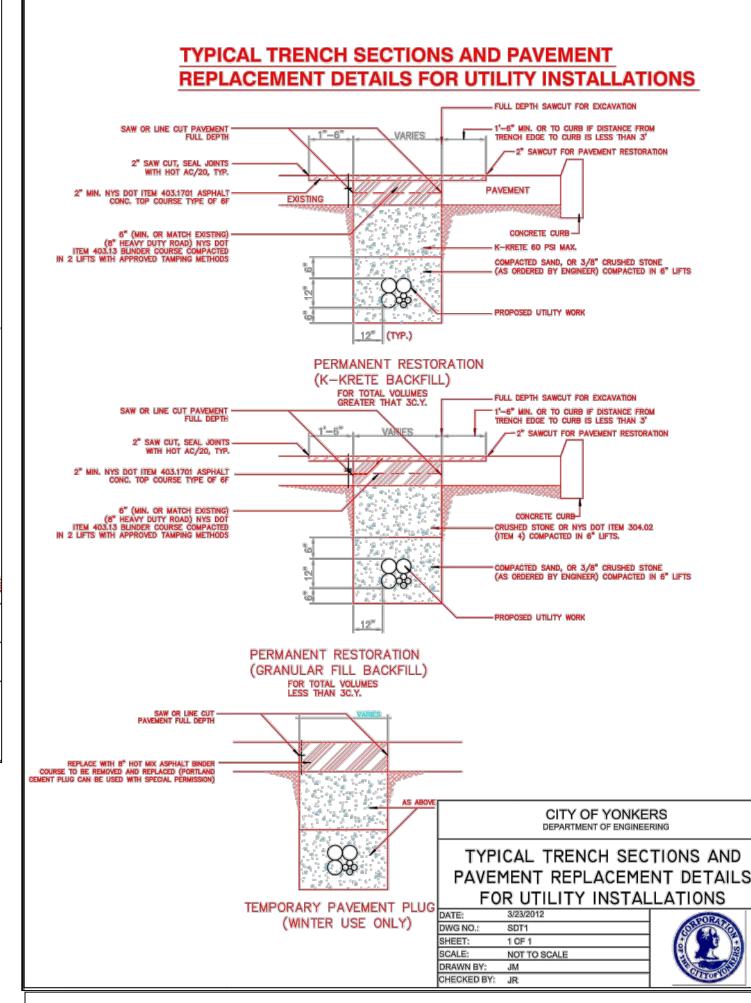


# **CONCRETE SIDEWALK AND CURB** RESTORATION DETAIL

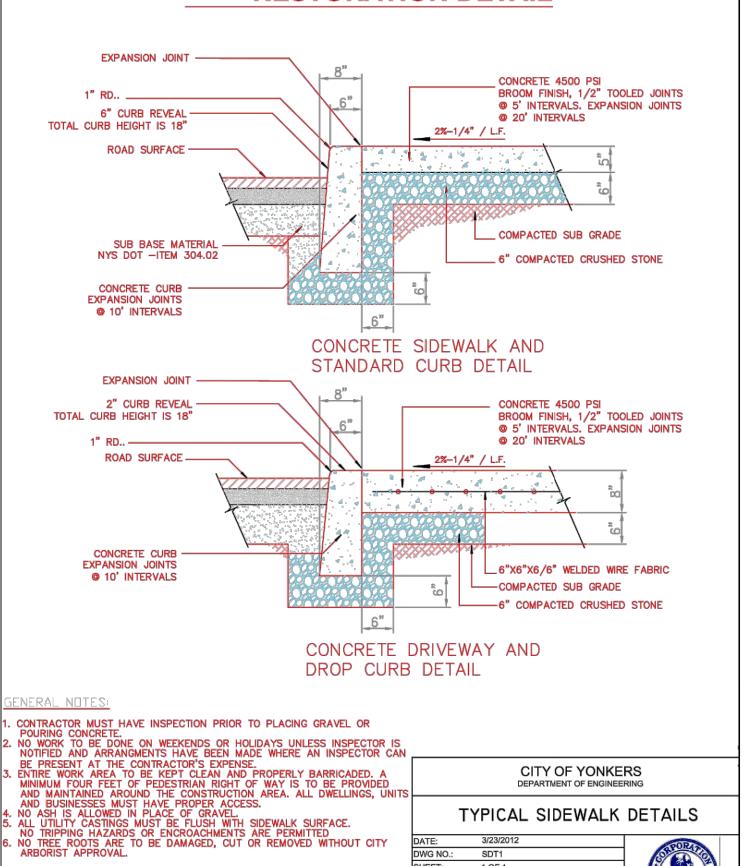

1 OF 1 NOT TO SCALE



Drawing North

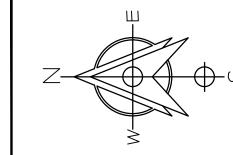

lient Name and Address **KDL** CAPITAL,

1345 AVENUE OF THE AMERICAS NEW YORK, NY

10105 Project Information


# PROPOSED SITE DEVELOPMENT **PLANS**

1060 NEPPERHAN AVENUE CITY OF YONKERS WESTCHESTER CO. NEW YORK

Job No.	21-082
Scale	AS NOTED
Date	27 DEC 2021
Drawn By	C.R. / M.M.
Charked Bu	N 1 N 1






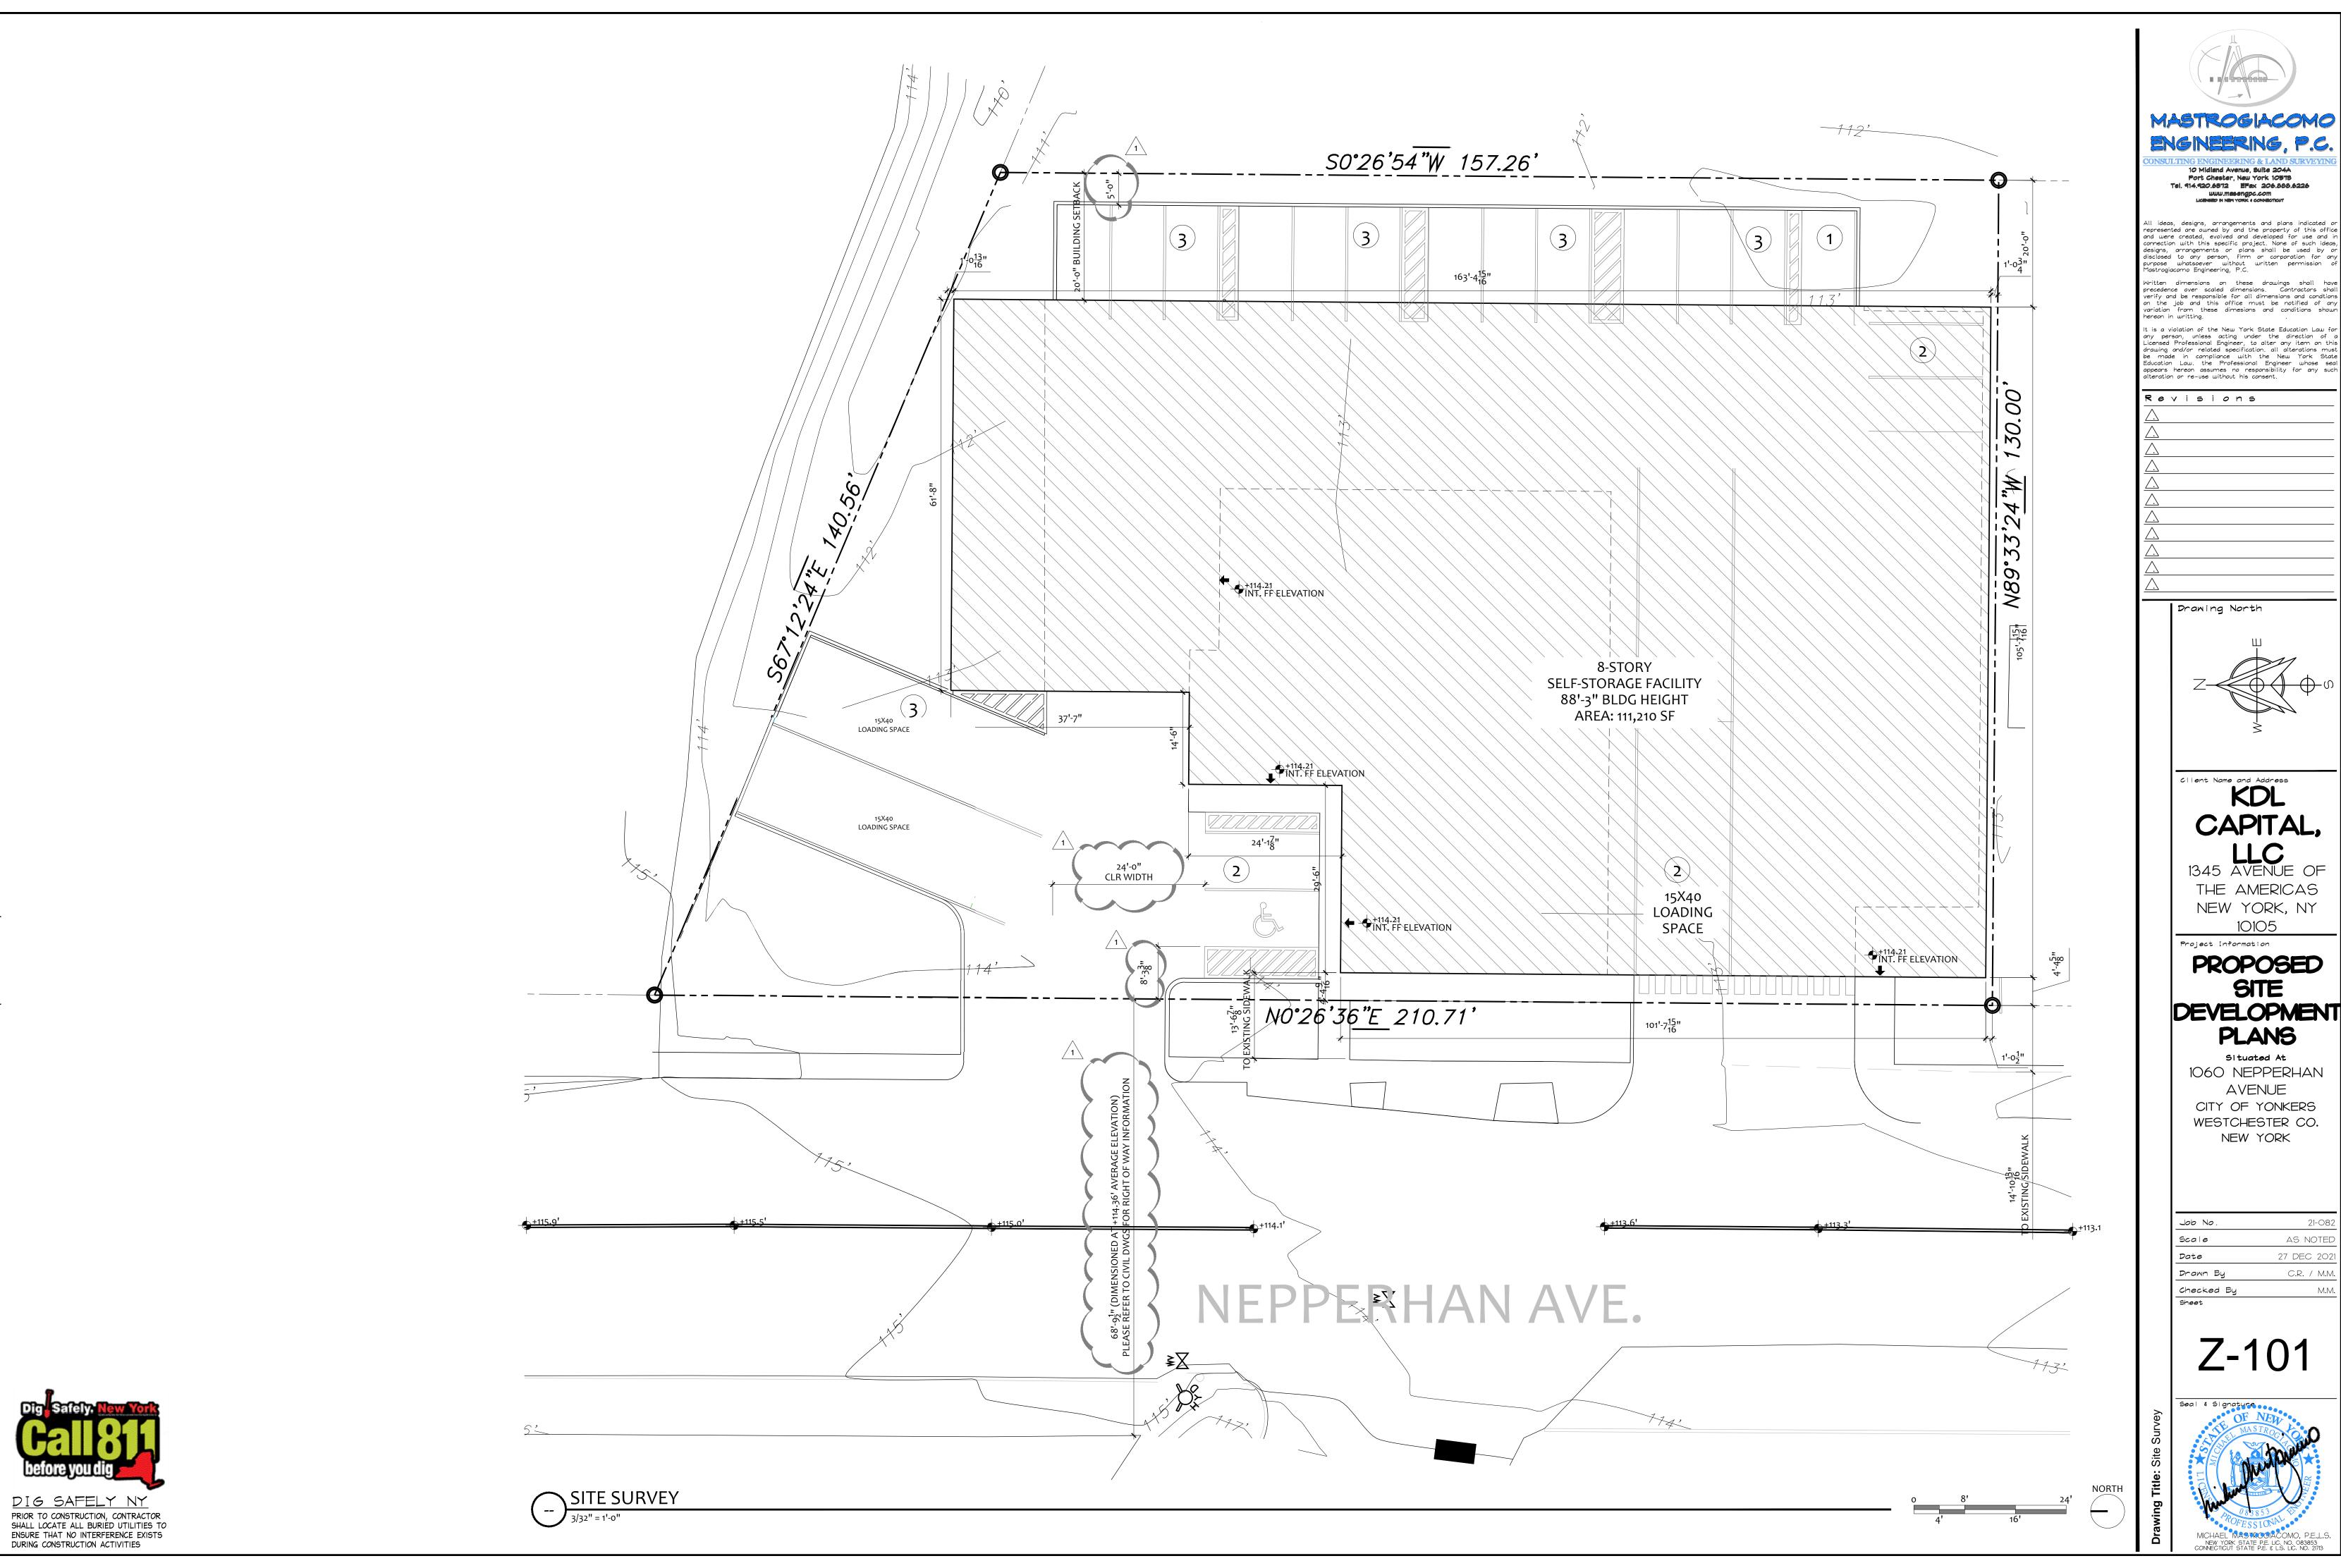



All ideas, designs, arrangements and plans indicated or represented are owned by and the property of this office and were created, evolved and developed for use and in connection with this specific project. None of such ideas, designs, arrangements or plans shall be used by or disclosed to any person, firm or corporation for any purpose whatsoever without written permission of Mastrogiacomo Engineering, P.C.

Written dimensions on these drawings shall have precedence over scaled dimensions. Contractors shall verify and be responsible for all dimensions and conditions on the job and this office must be notified of any variation from these dimesions and conditions shown hereon in writting.

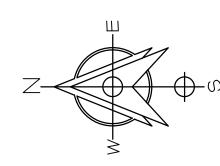

# Client Name and Address CAPITAL,


THE AMERICAS NEW YORK, NY

Project Information PROPOSED

SITE DEVELOPMENT **PLANS** 

51 tuated At 1060 NEPPERHAN AVENUE CITY OF YONKERS WESTCHESTER CO. NEW YORK

Job No.	21-082
Scale	AS NOTED
Date	27 DEC 2021
Drawn By	C.R. / M.M.
Checked Bu	M M

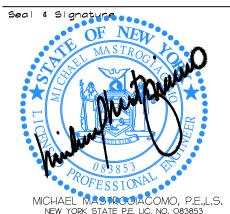

#### **ZONING ANALYSIS**

#### REFERENCE DATA

**ADDRESS** 1060 NEPPERHAN AVE. YONKERS, NY 10701 SECTION 003 BLOCK 3092 LOTS 011 PARCEL ID 3092011 TOTAL LOT AREA 23,878 SF SITE PROPERTY CLASS 440-WAREHOUSE ZONING DISTRICT I - INDUSTRIAL USE GROUP STORAGE OCCUPANCY GROUP S-1 CONSTRUCTION TYPE ALLOWED FAR 7.5

GOVERNING ORDINANCE: ZONING ORDINANCE OF THE CITY OF YONKERS, NEW YORK OF 2000, PART V: LAND USE, CHAPTER 43 ZONING

### FLOOR AREA CALCULATIONS

1ST FLOOR AREA 14,900SF - 12,153.19 SF MECH/PARKING = 2,746.81 SF 2ND FLOOR AREA 13,762.73 SF 3RD FLOOR AREA 13,752.73 SF 4TH FLOOR AREA 13,603.00 SF 5TH FLOOR AREA 13,757.64 SF 6TH FLOOR AREA 13,757.68 SF 7TH FLOOR AREA 13,604.55 SF 8TH FLOOR AREA 13,678.66 SF TOTAL BUILDING GSF 98,663.40 SF TOTAL ZONING FLOOR AREA: 111,210 GSF / 23,878 SF = 4.13 FAR

TOTAL ZONING FLOOR AREA: 111,210 GSF / 23,878 SF = 4.13 F

#### YARD REGULATIONS

MINIMUM REQUIRED REAR YARD IN I DISTRICT (TABLE 43-3): 20'-0"

#### PROVIDED REAR YARD: 20'-0"

NO REGULATIONS ON MINIMUM REQUIREMENTS FOR: LOT WIDTH, FRONT YARD, SIDE YARD AS PER TABLE 43-3

THE SIDE YARD SETBACK IN I DISTRICT MAY BE ZERO FEET.

### BUILDING COVERAGE REGULATIONS

75% MAXIMUM BUILDING COVERAGE PERMITTED

14,900 BUILDING FOOTPRINT / 23,878 SITE AREA = 62.4%

#### HEIGHT REGULATIONS

ZONING ORDINANCE, SCHEDULE A SCHEDULE OF DIMENSIONAL REGULATIONS, TABLE 43-3, NOTE: 6

THE MAXIMUM PERMITTED HEIGHT IN TEH I DISTRICT SHALL BE TWO TIMES THE WIDTH OF THE STREET RIGH-OF-WAY ON WHICH IT FRONTS. IF IT FRONTS ON MORE THAN ONE STREET, THE MAXIMUM PERMITTED HEIGHT SHALL BE TWO TIMES THE WIDTH OF THE WIDER STREET RIGHT-OF-WAY (STREET RIGHT-OF-WAY IS MEASURED FROM THE DIVIDING LINE BETWEEN STREET AND A LOT, ALSO REFERRED TO AS FRONT LOT LINE, SHOWN IN ILLUSTRATION 6 OF ARTICLE II DEFINITIONS OF THE ZONING CODE).

NEPPERHAN AVE WIDTH: 68.8 FT X 2 = 137.6FT ALLOWED

AS PER 2020 NYSBC HIGH RISE BUILDING IS A BUILDING WITH AN OCCUPIED FLOOR LOCATED MORE THAN 75 FEET ABOVE THE LOWEST LEVEL OF FIRE DEPARTMENT VEHICLE ACCESS.

HIGHEST OCCUPIED LEVEL = 74FT 9IN AFF

# PARKING & LOADING BERTHS REQUIREMENTS

TOTAL BUILDING AREA: 98,663.4 GSF

### OFF-STREET PARKING

1 PARKING SPACE FOR THE OFFICE, PLUS 1 PARKING SPACE PER 7,500 SQUARE FEET OF GROSS FLOOR AREA

98,663.4 / 7,500 = 13.16 = 14 + 1 (OFFICE) = 15 SPACES REQ'D

17 PARKING SPACES PROVIDED

### LOADING SPACES

2 LOADING SPACES, MINIMUM, PLUS 1 LOADING SPACE PER 50,000 SQUARE FEET OF GROSS FLOOR AREA

98,663.4 / 50,000 = 1.97 = 2 +2 = 4 LOADING SPACE REQ'D

4 LOADING SPACE PROVIDED



PRIOR TO CONSTRUCTION, CONTRACTOR SHALL LOCATE ALL BURIED UTILITIES TO ENSURE THAT NO INTERFERENCE EXISTS DURING CONSTRUCTION ACTIVITIES

MASTROGIACOMO
ENGINEERING, P.C.

CONSULTING ENGINEERING & LAND SURVEYING

10 Midland Avenue, Suite 204A
Port Chester, New York 10578
Tel. 914.920.6872 EFax 206.888.6226

WWW.Massengpc.com
LICENSED IN NEW YORK & CONNECTICUT


All ideas, designs, arrangements and plans indicated or represented are owned by and the property of this office and were created, evolved and developed for use and in connection with this specific project. None of such ideas, designs, arrangements or plans shall be used by or disclosed to any person, firm or corporation for any purpose whatsoever without written permission of Mastrogiacomo Engineering, P.C.

Written dimensions on these drawings shall have precedence over scaled dimensions. Contractors shall verify and be responsible for all dimensions and conditions on the job and this office must be notified of any variation from these dimesions and conditions shown hereon in writting.

It is a violation of the New York State Education Law for any person, unless acting under the direction of a Licensed Professional Engineer, to alter any item on this drawing and/or related specification. all alterations must be made in compliance with the New York State Education Law. the Professional Engineer whose seal appears hereon assumes no responsibility for any such alteration or re-use without his consent.

Ré	<b>&gt;</b>	i s	i	0 n	s		
$\overline{\triangle}$							
$\overline{\triangle}$							
Drawing North

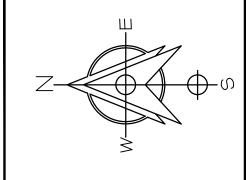

Client Name and Address

# CAPITAL, LLC

1345 AVENUE OF THE AMERICAS NEW YORK, NY

10105

Project Information

# PROPOSED SITE DEVELOPMENT PLANS

SITUATED AT

1060 NEPPERHAN

AVENUE


CITY OF YONKERS


WESTCHESTER CO.

NEW YORK

Job No.	21-082
Scale	AS NOTED
Date	27 DEC 2021
Drawn By	C.R. / M.M.
Checked By	M.M.

7 400

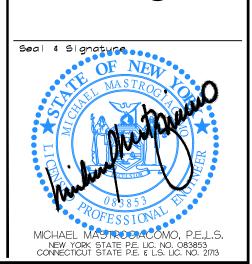

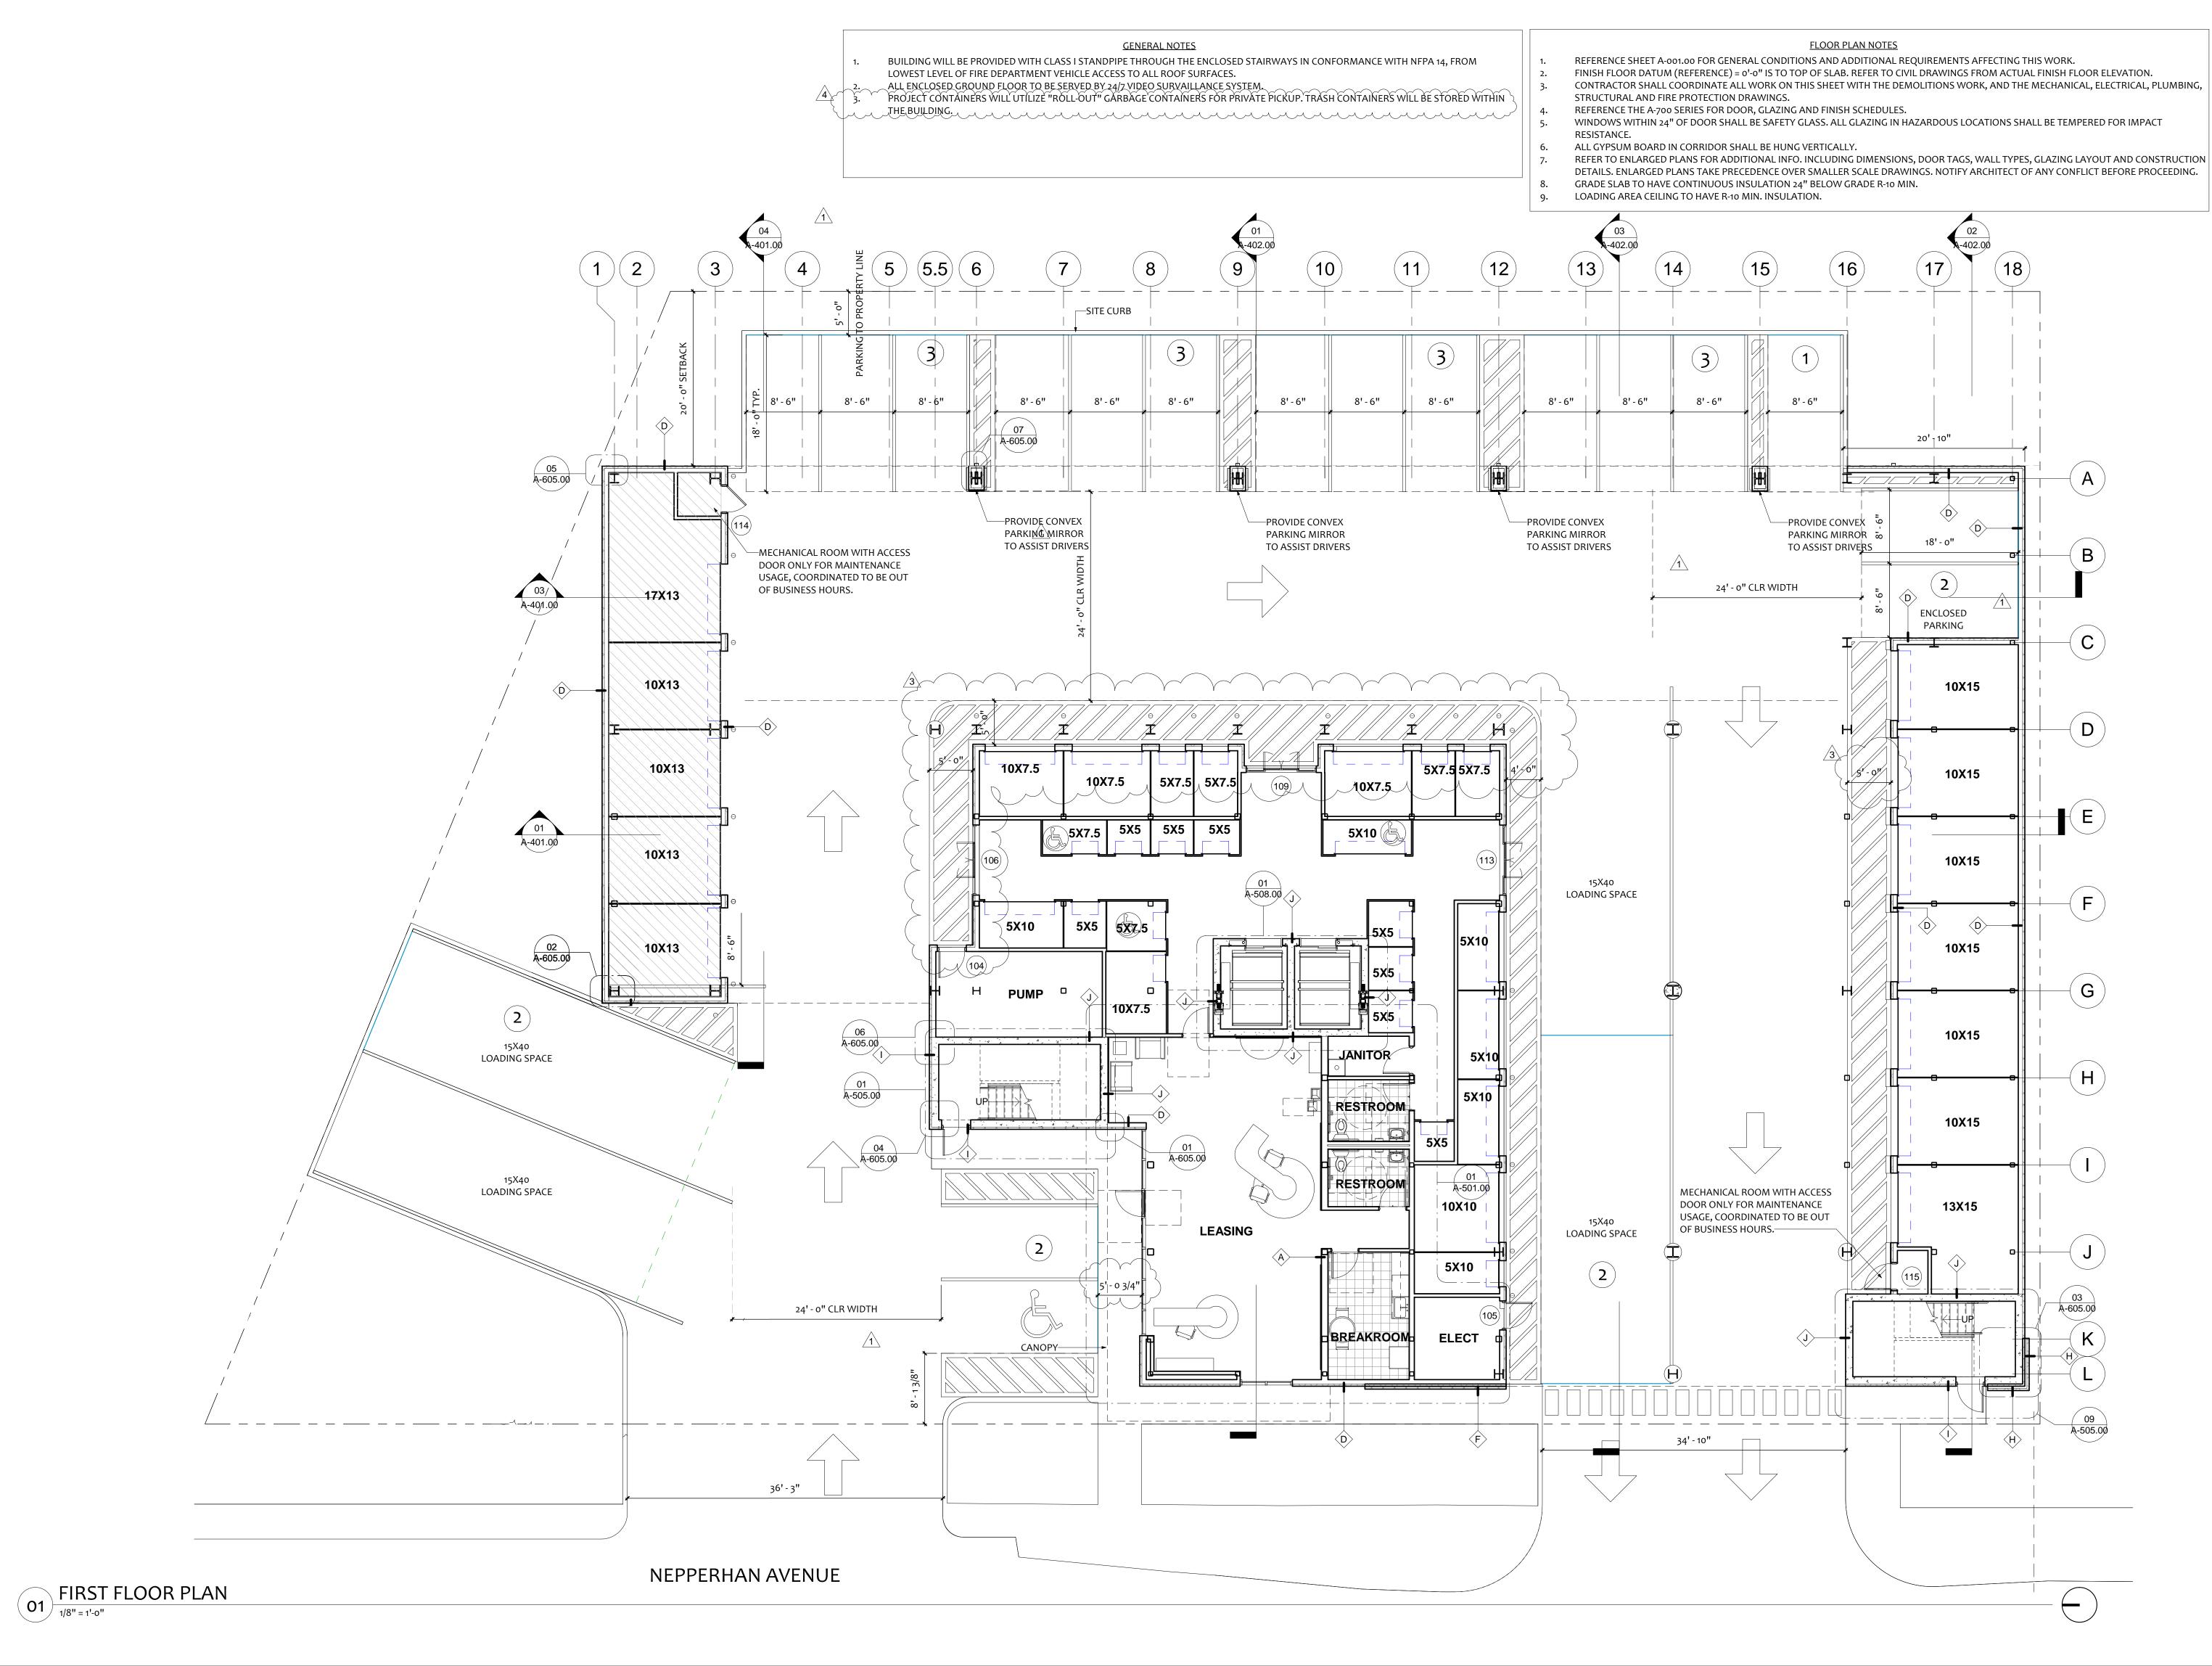

COPYRIGHT STATEMENT These documents, their contents, and the ideas, designs, and concepts

presented here-in are the property of Kimberly Day McCann and were created and developed only for the use on and in connection with the project specified here-in. None of the ideas, designs,

arrangements and plans shall be used by or disclosed to any person, firm or corporation for any purpose whatsoever without the express written permission of Kimberly Day McCann.

WARNING: Reproduction here-of is a criminal offense under U.S.C. SEC 506. Unauthorized disclosure may constitute trade secret misappropiation in violation of 1.C24-2-41-1 ET.SEQ and other laws. The ideas, arrangements and designs here-in may be patented or be subject of a pending patent application.

25 OCT 2021



☐ Kimberly Day McCann, AIA │NY. REG.#ARo38775

**KIMBERLY** DAY McCANN **ARCHITECT** 

© Copyright 201 KIMBERLY DAY McCANN ARCHITECT All Rights Reserved Worldwide

PROJECT NAME:

**CUBESMART** YONKERS, NY

1060 Nepperhan Ave. Yonkers, NY 10701

PROJECT CLIENT:

KDL Capital, LLC

1345 Avenue of the Americas, New York, NY 10105

PROJECT LEAD: Gilberto Torres 407-745-5300 gtorres@eleven18architecture.com

PROJECT TEAM: KM, GT, MN, BC

DOB STAMP

DOB BSCAN

REVISIONS # DATE DESC. 2021.06.09 PERMIT SUBMITTAL 1 | 2021.08.19 | ZONING 2021.10.25 | AMMEND.

A-201.00

First Floor Plan


BUILDING WILL BE PROVIDED WITH CLASS I STANDPIPE THROUGH THE ENCLOSED STAIRWAYS IN CONFORMANCE WITH NFPA 14, FROM LOWEST LEVEL OF FIRE DEPARTMENT VEHICLE ACCESS TO ALL ROOF SURFACES. ALL ENCLOSED GROUND FLOOR TO BE SERVED BY 24/7 VIDEO SURVAILLANCE SYSTEM.

FLOOR PLAN NOTES REFERENCE SHEET A-001.00 FOR GENERAL CONDITIONS AND ADDITIONAL REQUIREMENTS AFFECTING THIS WORK.

- FINISH FLOOR DATUM (REFERENCE) = 0'-0" IS TO TOP OF SLAB. REFER TO CIVIL DRAWINGS FROM ACTUAL FINISH FLOOR ELEVATION.
  - CONTRACTOR SHALL COORDINATE ALL WORK ON THIS SHEET WITH THE DEMOLITIONS WORK, AND THE MECHANICAL, ELECTRICAL, PLUMBING, STRUCTURAL AND FIRE PROTECTION DRAWINGS.
- REFERENCE THE A-700 SERIES FOR DOOR, GLAZING AND FINISH SCHEDULES. WINDOWS WITHIN 24" OF DOOR SHALL BE SAFETY GLASS. ALL GLAZING IN HAZARDOUS LOCATIONS SHALL BE TEMPERED FOR IMPACT
- RESISTANCE. ALL GYPSUM BOARD IN CORRIDOR SHALL BE HUNG VERTICALLY.
- REFER TO ENLARGED PLANS FOR ADDITIONAL INFO. INCLUDING DIMENSIONS, DOOR TAGS, WALL TYPES, GLAZING LAYOUT AND CONSTRUCTION DETAILS. ENLARGED PLANS TAKE PRECEDENCE OVER SMALLER SCALE DRAWINGS. NOTIFY ARCHITECT OF ANY CONFLICT BEFORE PROCEEDING.
- GRADE SLAB TO HAVE CONTINUOUS INSULATION 24" BELOW GRADE R-10 MIN.

LOADING AREA CEILING TO HAVE R-10 MIN. INSULATION. a pending patent application.

HVAC UNIT CLOSET PLAN TYP. 1/4" = 1'-0"

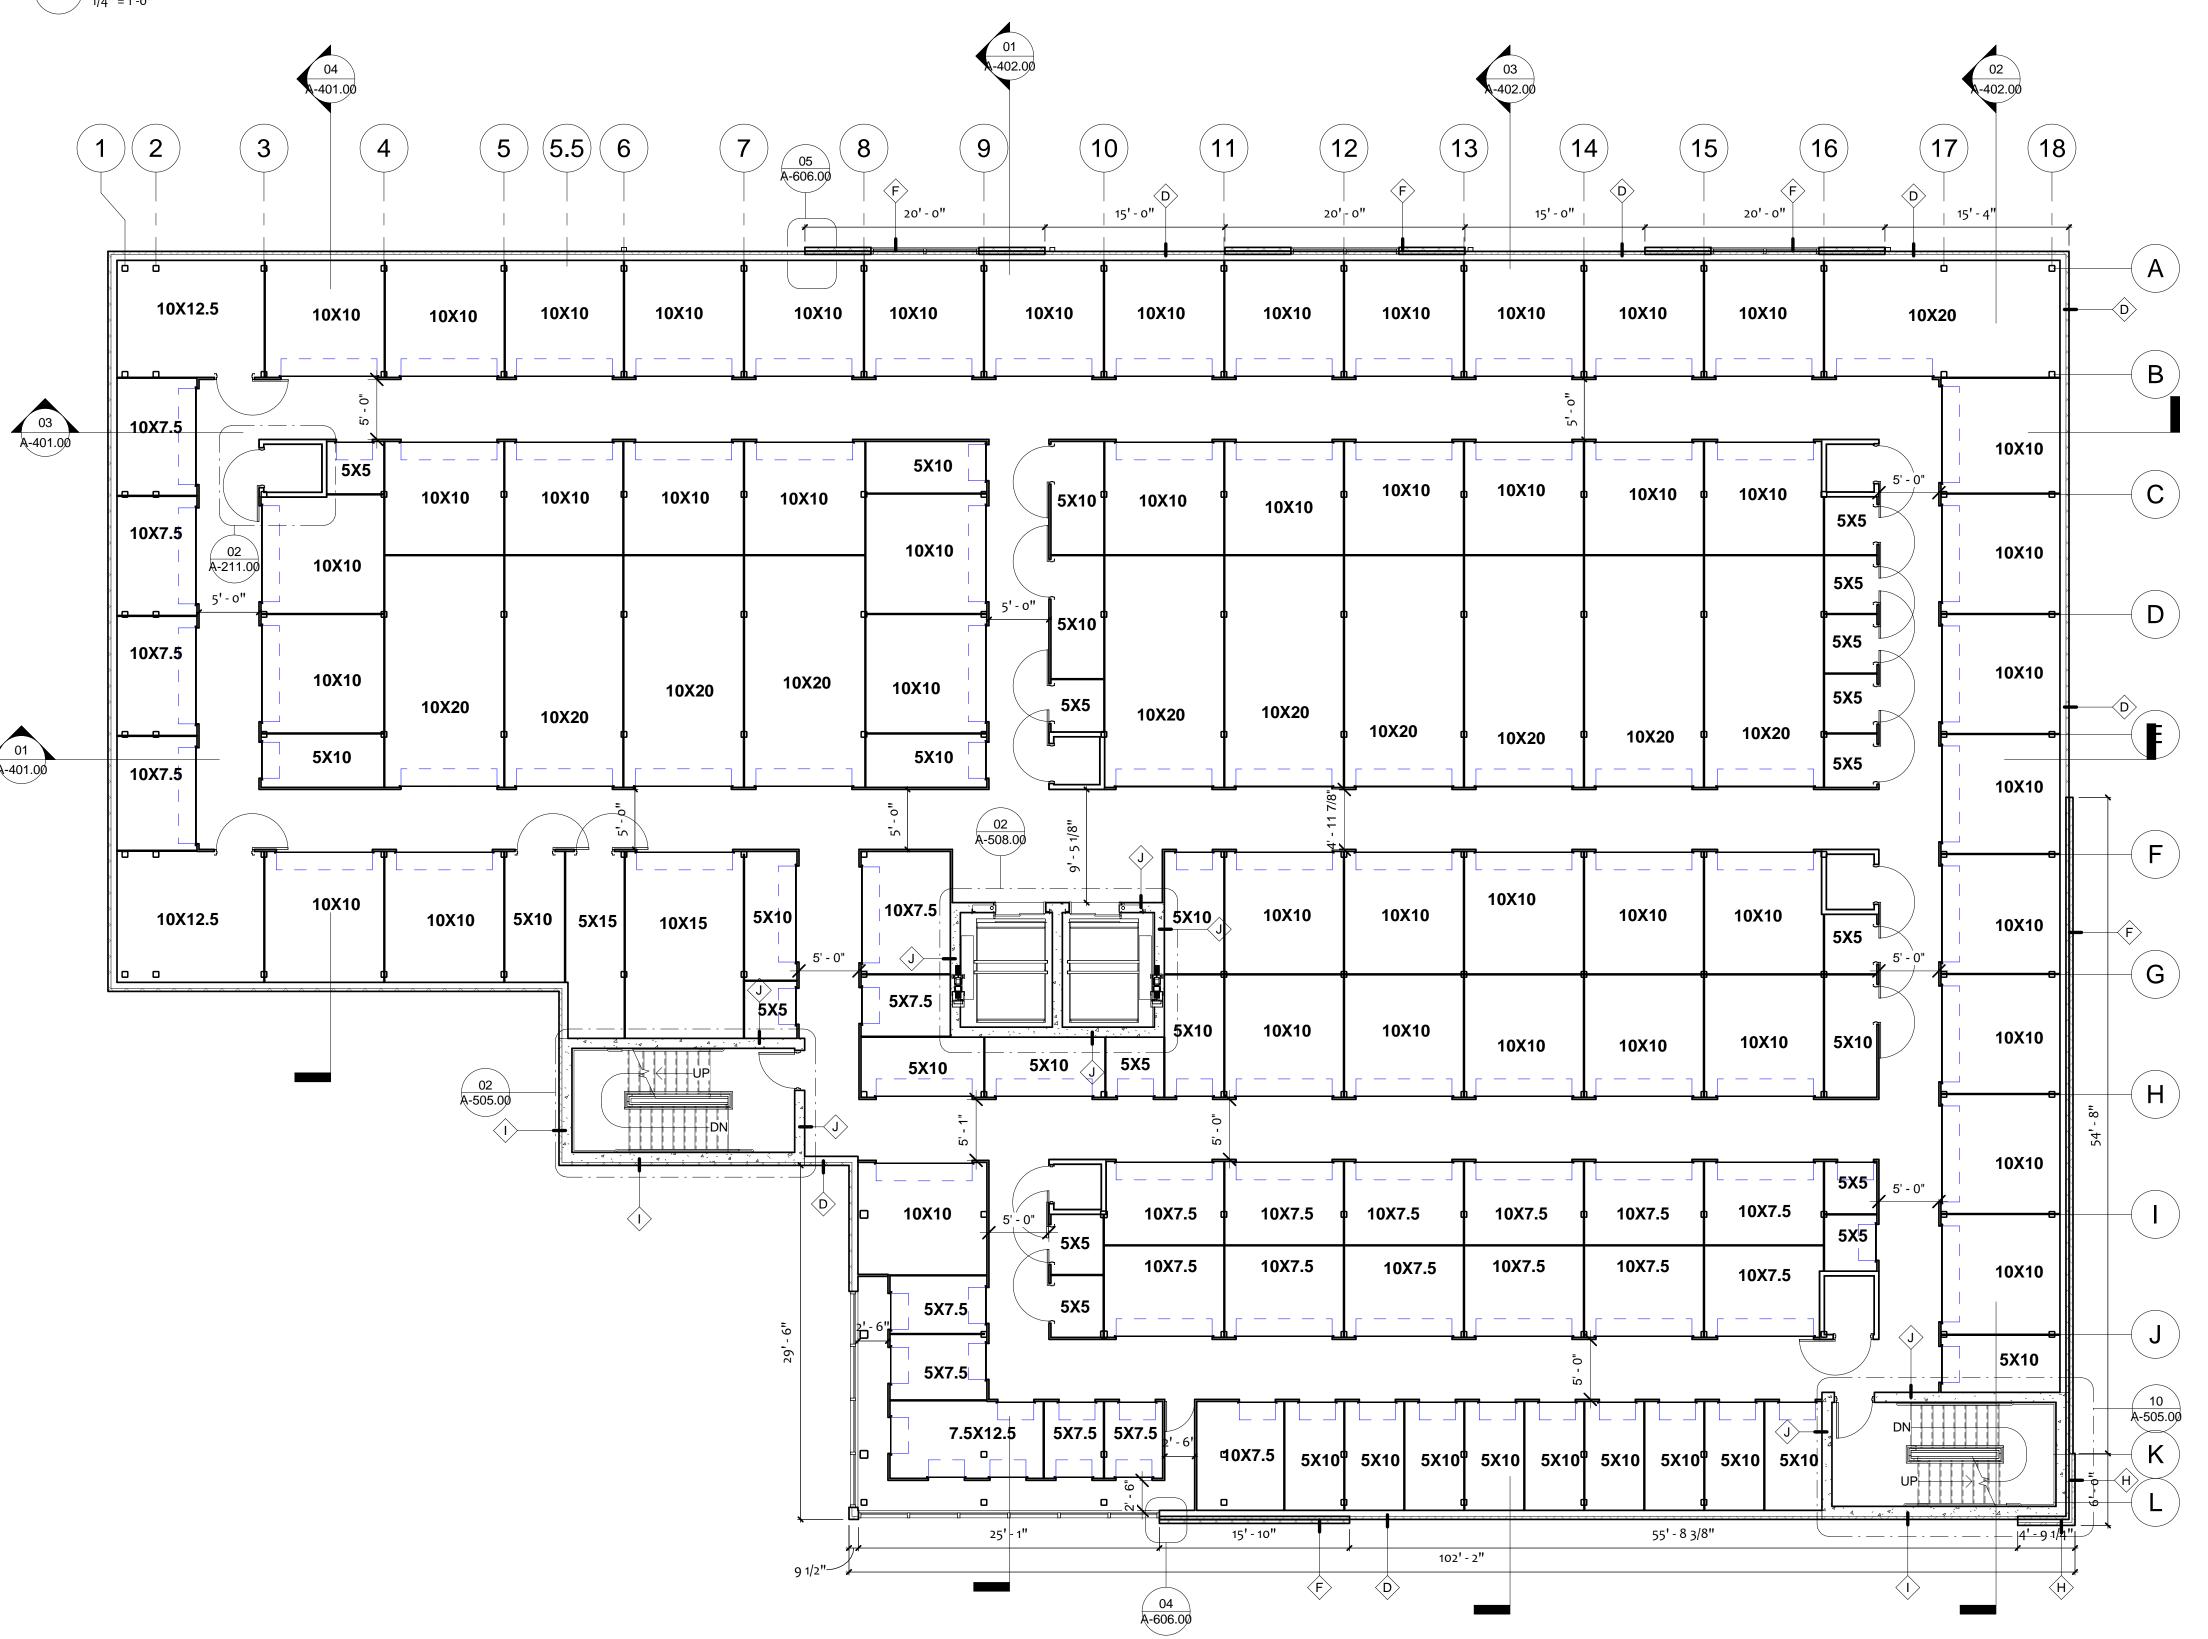

COPYRIGHT STATEMENT These documents, their contents, and the ideas, designs, and concepts

presented here-in are the property of Kimberly Day McCann and were created and developed only for the use on and in connection with the project specified here-in. None of the ideas, designs, arrangements and plans shall be used by or disclosed to any person, firm or

corporation for any purpose whatsoever

without the express written permission of Kimberly Day McCann.

WARNING: Reproduction here-of is a criminal offense under U.S.C. SEC 506. Unauthorized disclosure may constitute trade secret misappropiation in violation of 1.C24-2-41-1 ET.SEQ and other laws. The ideas, arrangements and designs here-in may be patented or be subject of

25 OCT 2021



☐ Kimberly Day McCann, AIA │NY. REG.#ARo38775

KIMBERLY DAY McCANN **ARCHITECT** 

© Copyright 201 KIMBERLY DAY McCANN ARCHITECT All Rights Reserved Worldwide

PROJECT NAME:

**CUBESMART** YONKERS, NY

1060 Nepperhan Ave. Yonkers, NY 10701

PROJECT CLIENT:

KDL Capital, LLC

1345 Avenue of the Americas, New York, NY 10105

PROJECT LEAD: Gilberto Torres 407-745-5300 gtorres@eleven18architecture.com

PROJECT TEAM: KM, GT, MN, BC

DOB STAMP

DOB BSCAN

	REVISIONS				
#	DATE	DESC.			
	2021.06.09	PERMIT SUBMITTAL			

- BUILDING WILL BE PROVIDED WITH CLASS I STANDPIPE THROUGH THE ENCLOSED STAIRWAYS IN CONFORMANCE WITH NFPA 14, FROM LOWEST LEVEL OF FIRE DEPARTMENT VEHICLE ACCESS TO ALL ROOF SURFACES.
- ALL ENCLOSED GROUND FLOOR TO BE SERVED BY 24/7 VIDEO SURVAILLANCE SYSTEM.

FLOOR PLAN NOTES

- REFERENCE SHEET A-001.00 FOR GENERAL CONDITIONS AND ADDITIONAL REQUIREMENTS AFFECTING THIS WORK.
- FINISH FLOOR DATUM (REFERENCE) = o'-o'' IS TO TOP OF SLAB. REFER TO CIVIL DRAWINGS FROM ACTUAL FINISH FLOOR ELEVATION. CONTRACTOR SHALL COORDINATE ALL WORK ON THIS SHEET WITH THE DEMOLITIONS WORK, AND THE MECHANICAL, ELECTRICAL, PLUMBING,
  - STRUCTURAL AND FIRE PROTECTION DRAWINGS. REFERENCE THE A-700 SERIES FOR DOOR, GLAZING AND FINISH SCHEDULES.
- WINDOWS WITHIN 24" OF DOOR SHALL BE SAFETY GLASS. ALL GLAZING IN HAZARDOUS LOCATIONS SHALL BE TEMPERED FOR IMPACT RESISTANCE.
- ALL GYPSUM BOARD IN CORRIDOR SHALL BE HUNG VERTICALLY.
- REFER TO ENLARGED PLANS FOR ADDITIONAL INFO. INCLUDING DIMENSIONS, DOOR TAGS, WALL TYPES, GLAZING LAYOUT AND CONSTRUCTION
- DETAILS. ENLARGED PLANS TAKE PRECEDENCE OVER SMALLER SCALE DRAWINGS. NOTIFY ARCHITECT OF ANY CONFLICT BEFORE PROCEEDING.
- GRADE SLAB TO HAVE CONTINUOUS INSULATION 24" BELOW GRADE R-10 MIN.
- LOADING AREA CEILING TO HAVE R-10 MIN. INSULATION.

arrangements and plans shall be used by or disclosed to any person, firm or corporation for any purpose whatsoever without the express written permission of Kimberly Day McCann. WARNING: Reproduction here-of is a

COPYRIGHT STATEMENT These documents, their contents, and

the ideas, designs, and concepts presented here-in are the property of

Kimberly Day McCann and were created

and developed only for the use on and in connection with the project specified here-in. None of the ideas, designs,

criminal offense under U.S.C. SEC 506. Unauthorized disclosure may constitute trade secret misappropiation in violation of 1.C24-2-41-1 ET.SEQ and other laws. The ideas, arrangements and designs here-in may be patented or be subject of a pending patent application.



☐ Kimberly Day McCann, AIA │NY. REG.#ARo38775

# **KIMBERLY** DAY McCANN **ARCHITECT**

© Copyright 201 KIMBERLY DAY McCANN ARCHITECT All Rights Reserved Worldwide

PROJECT NAME: **CUBESMART** 

YONKERS, NY

1060 Nepperhan Ave. Yonkers, NY 10701

PROJECT CLIENT:

KDL Capital, LLC


1345 Avenue of the Americas, New York, NY 10105


PROJECT LEAD: Gilberto Torres 407-745-5300 gtorres@eleven18architecture.com

PROJECT TEAM: KM, GT, MN, BC DOB STAMP

DOB BSCAN

REVISIONS				
#	DATE	DESC.		
	2021.06.09	PERMIT		
		SUBMITTAL		
	1			

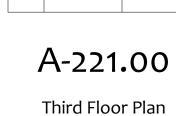

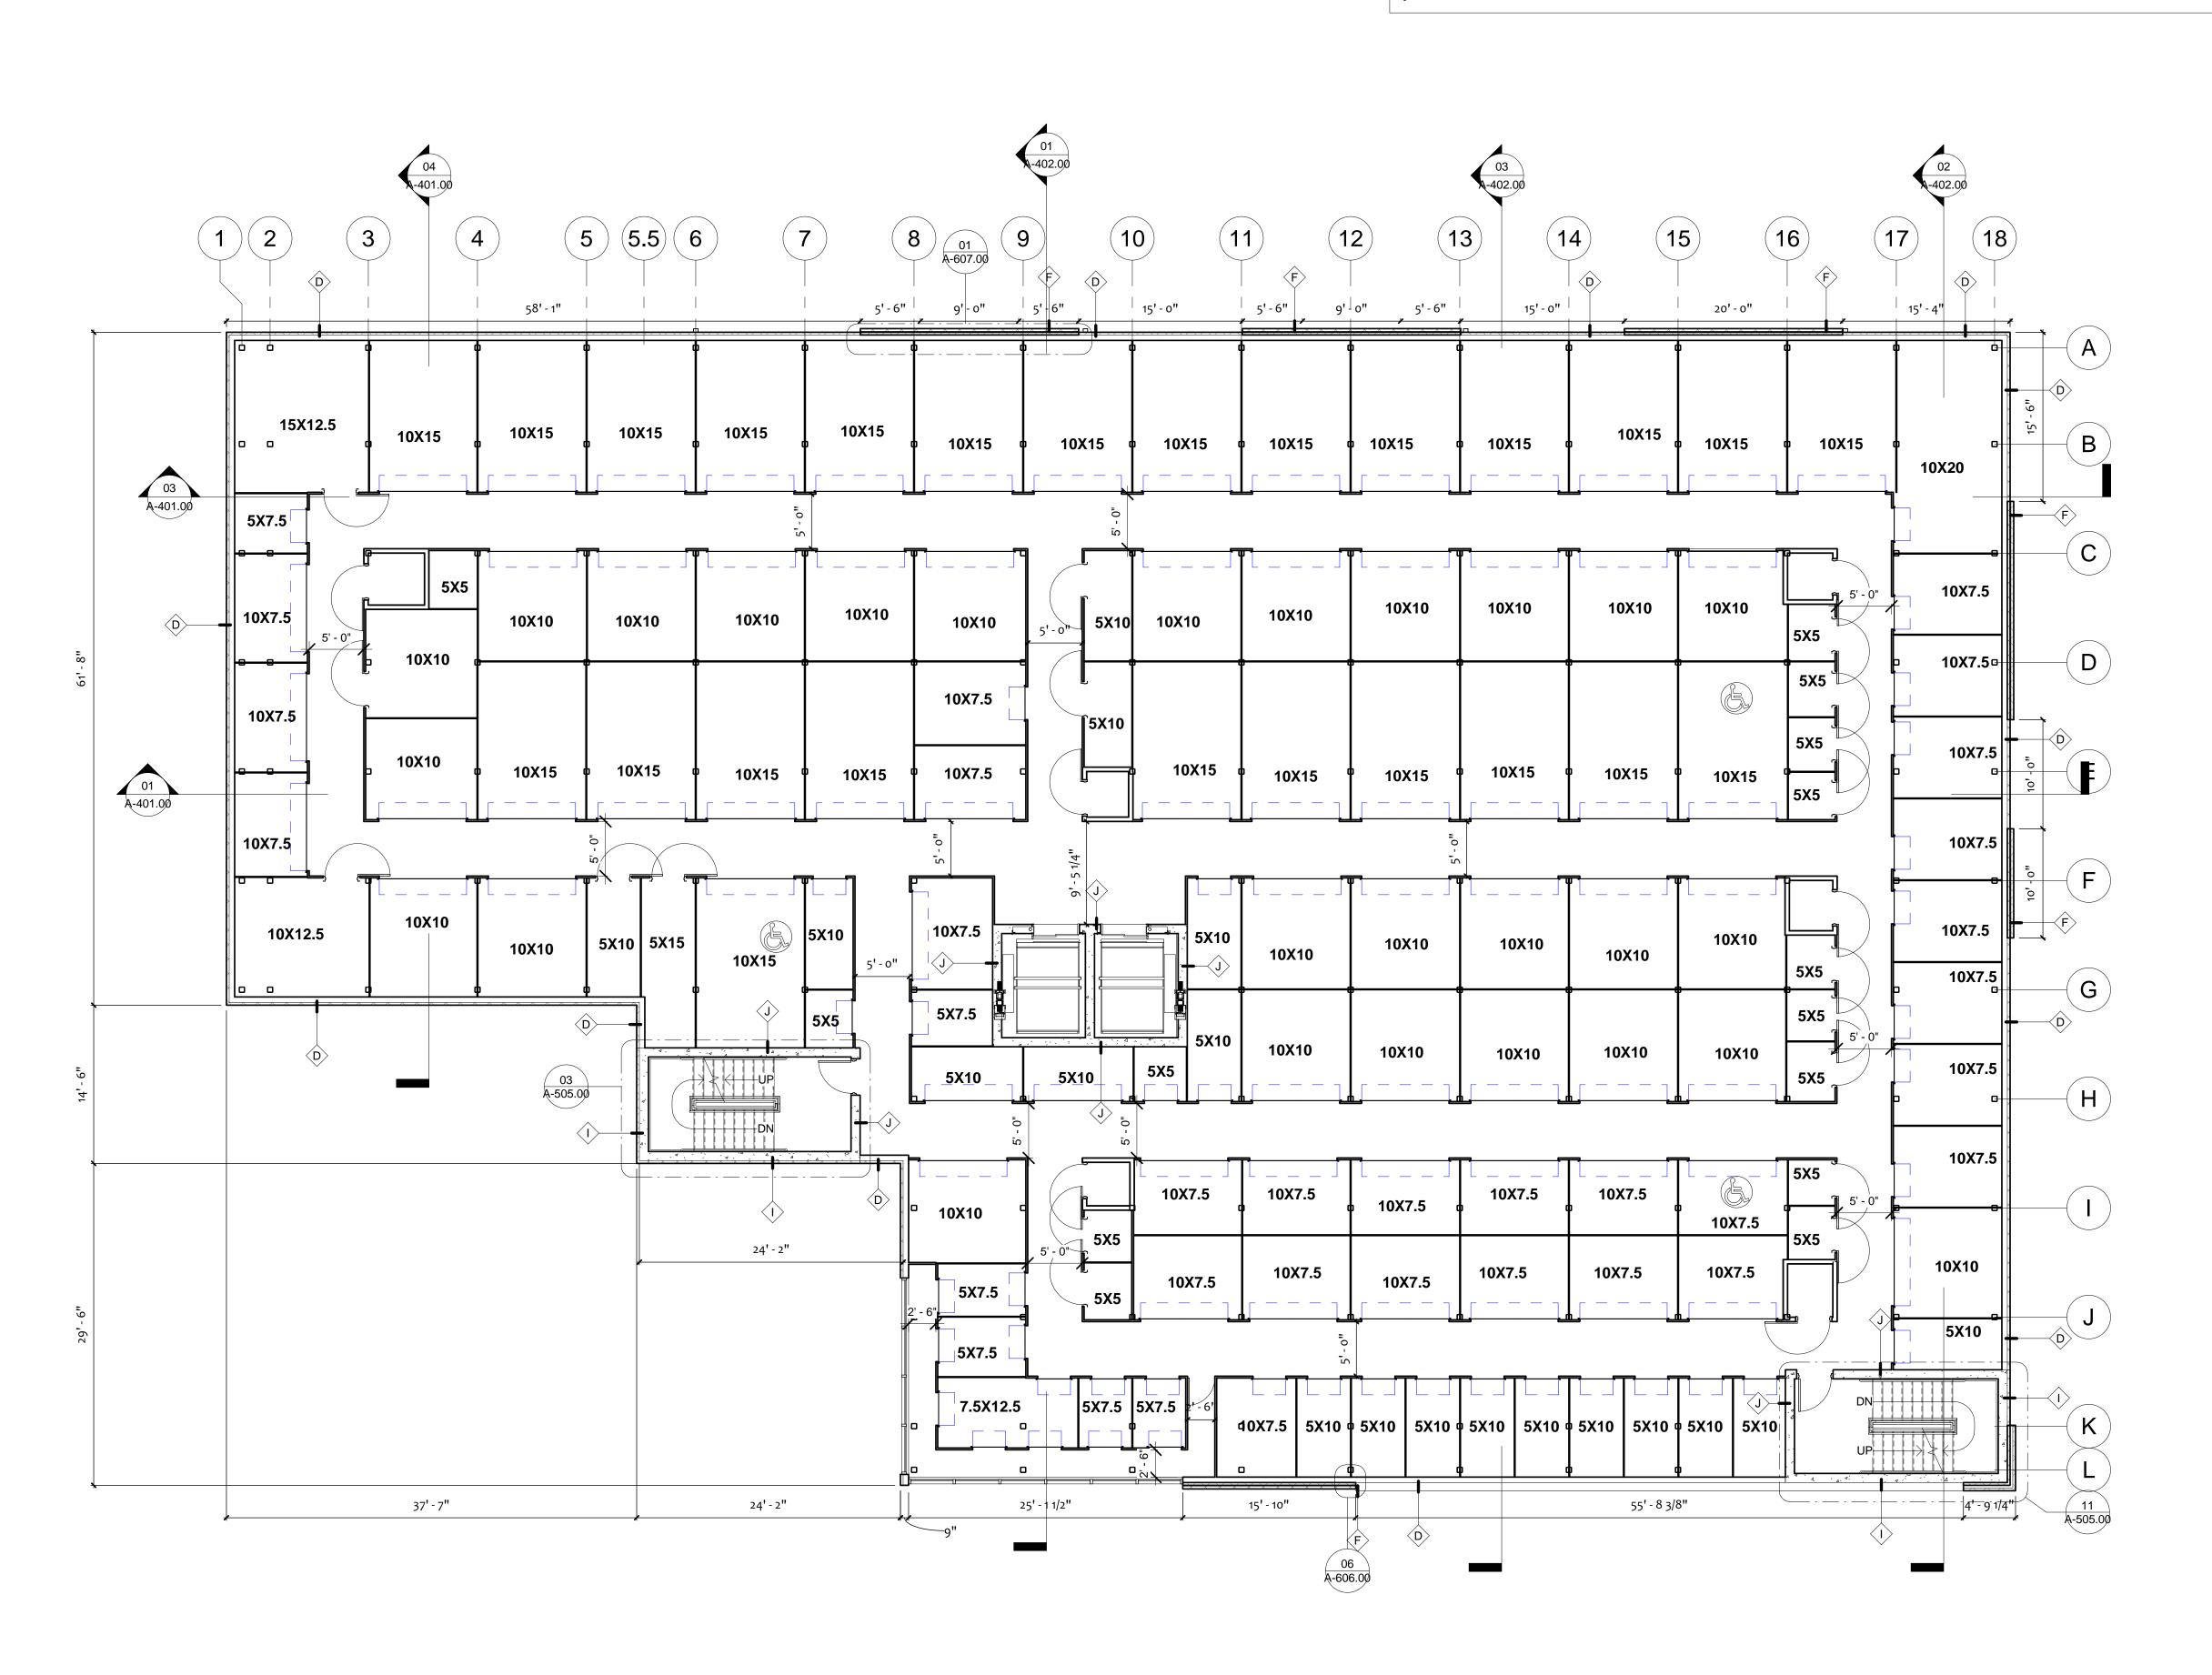

- BUILDING WILL BE PROVIDED WITH CLASS I STANDPIPE THROUGH THE ENCLOSED STAIRWAYS IN CONFORMANCE WITH NFPA 14, FROM LOWEST LEVEL OF FIRE DEPARTMENT VEHICLE ACCESS TO ALL ROOF SURFACES.
- ALL ENCLOSED GROUND FLOOR TO BE SERVED BY 24/7 VIDEO SURVAILLANCE SYSTEM.

**FLOOR PLAN NOTES** 

- . REFERENCE SHEET A-001.00 FOR GENERAL CONDITIONS AND ADDITIONAL REQUIREMENTS AFFECTING THIS WORK.
- 2. FINISH FLOOR DATUM (REFERENCE) = 0'-0" IS TO TOP OF SLAB. REFER TO CIVIL DRAWINGS FROM ACTUAL FINISH FLOOR ELEVATION.
  3. CONTRACTOR SHALL COORDINATE ALL WORK ON THIS SHEET WITH THE DEMOLITIONS WORK, AND THE MECHANICAL, ELECTRICAL, PLUMBING, STRUCTURAL AND FIRE PROTECTION DRAWINGS.
  - REFERENCE THE A-700 SERIES FOR DOOR, GLAZING AND FINISH SCHEDULES.
- 5. WINDOWS WITHIN 24" OF DOOR SHALL BE SAFETY GLASS. ALL GLAZING IN HAZARDOUS LOCATIONS SHALL BE TEMPERED FOR IMPACT
- RESISTANCE.
- ALL GYPSUM BOARD IN CORRIDOR SHALL BE HUNG VERTICALLY.
- 7. REFER TO ENLARGED PLANS FOR ADDITIONAL INFO. INCLUDING DIMENSIONS, DOOR TAGS, WALL TYPES, GLAZING LAYOUT AND CONSTRUCTION DETAILS. ENLARGED PLANS TAKE PRECEDENCE OVER SMALLER SCALE DRAWINGS. NOTIFY ARCHITECT OF ANY CONFLICT BEFORE PROCEEDING.
- 8. GRADE SLAB TO HAVE CONTINUOUS INSULATION 24" BELOW GRADE R-10 MIN.
- LOADING AREA CEILING TO HAVE R-10 MIN. INSULATION.

WARNING: Reproduction here-of is a criminal offense under U.S.C. SEC 506. Unauthorized disclosure may constitute trade secret misappropiation in violation of 1.C24-2-41-1 ET.SEQ and other laws. The ideas, arrangements and designs here-in may be patented or be subject of a pending patent application.

COPYRIGHT STATEMENT
These documents, their contents, and

the ideas, designs, and concepts presented here-in are the property of

Kimberly Day McCann and were created

and developed only for the use on and in connection with the project specified here-in. None of the ideas, designs,

arrangements and plans shall be used by or disclosed to any person, firm or

corporation for any purpose whatsoever

without the express written permission of Kimberly Day McCann.





Kimberly Day McCann, AIA NY. REG.#ARo38775

# KIMBERLY DAY McCANN ARCHITECT

© Copyright 201 KIMBERLY DAY McCANN ARCHITECT All Rights Reserved Worldwide

PROJECT NAME:

CUBESMART YONKERS, NY

1060 Nepperhan Ave. Yonkers, NY 10701

PROJECT CLIENT:

KDL Capital, LLC

1345 Avenue of the Americas, New York, NY 10105

PROJECT LEAD:
Gilberto Torres
407-745-5300
gtorres@eleven18architecture.com

PROJECT TEAM: KM, GT, MN, BC

DOB STAMP

DOB BSCAN

REVISIONS					
#	DATE	DESC.			
	2021.06.09	PERMIT SUBMITTAL			

A-231.00

Fourth Floor Plan

O1 FOURTH FLOOR PLAN

1/8" = 1'-0"



- BUILDING WILL BE PROVIDED WITH CLASS I STANDPIPE THROUGH THE ENCLOSED STAIRWAYS IN CONFORMANCE WITH NFPA 14, FROM LOWEST LEVEL OF FIRE DEPARTMENT VEHICLE ACCESS TO ALL ROOF SURFACES.
- ALL ENCLOSED GROUND FLOOR TO BE SERVED BY 24/7 VIDEO SURVAILLANCE SYSTEM.

FLOOR PLAN NOTES

- 1. REFERENCE SHEET A-001.00 FOR GENERAL CONDITIONS AND ADDITIONAL REQUIREMENTS AFFECTING THIS WORK.
- 2. FINISH FLOOR DATUM (REFERENCE) = 0'-0" IS TO TOP OF SLAB. REFER TO CIVIL DRAWINGS FROM ACTUAL FINISH FLOOR ELEVATION.
  3. CONTRACTOR SHALL COORDINATE ALL WORK ON THIS SHEET WITH THE DEMOLITIONS WORK, AND THE MECHANICAL, ELECTRICAL, PLUMBING, STRUCTURAL AND FIRE PROTECTION DRAWINGS.
- REFERENCE THE A-700 SERIES FOR DOOR, GLAZING AND FINISH SCHEDULES.
- . WINDOWS WITHIN 24" OF DOOR SHALL BE SAFETY GLASS. ALL GLAZING IN HAZARDOUS LOCATIONS SHALL BE TEMPERED FOR IMPACT RESISTANCE.
- 6. ALL GYPSUM BOARD IN CORRIDOR SHALL BE HUNG VERTICALLY.
- 7. REFER TO ENLARGED PLANS FOR ADDITIONAL INFO. INCLUDING DIMENSIONS, DOOR TAGS, WALL TYPES, GLAZING LAYOUT AND CONSTRUCTION
- DETAILS. ENLARGED PLANS TAKE PRECEDENCE OVER SMALLER SCALE DRAWINGS. NOTIFY ARCHITECT OF ANY CONFLICT BEFORE PROCEEDING.
- GRADE SLAB TO HAVE CONTINUOUS INSULATION 24" BELOW GRADE R-10 MIN.
- LOADING AREA CEILING TO HAVE R-10 MIN. INSULATION.

or disclosed to any person, firm or corporation for any purpose whatsoever without the express written permission of Kimberly Day McCann. WARNING: Reproduction here-of is a criminal offense under U.S.C. SEC 506. Unauthorized disclosure may constitute

COPYRIGHT STATEMENT
These documents, their contents, and

the ideas, designs, and concepts presented here-in are the property of

Kimberly Day McCann and were created

and developed only for the use on and in connection with the project specified here-in. None of the ideas, designs,

arrangements and plans shall be used by





Kimberly Day McCann, AIA NY. REG.#ARo38775

# KIMBERLY DAY McCANN ARCHITECT

© Copyright 201 KIMBERLY DAY McCANN ARCHITECT All Rights Reserved Worldwide

PROJECT NAME:

CUBESMART YONKERS, NY

1060 Nepperhan Ave. Yonkers, NY 10701

PROJECT CLIENT:

KDL Capital, LLC

1345 Avenue of the Americas, New York, NY 10105

PROJECT LEAD:
Gilberto Torres
407-745-5300
gtorres@eleven18architecture.com

PROJECT TEAM: KM, GT, MN, BC


DOB STAMP

DOB BSCAN

	<b>REVISIONS</b>				
#	DATE	DESC.			
	2021.06.09	PERMIT SUBMITTA			

A-241.00

Fifth Floor Plan

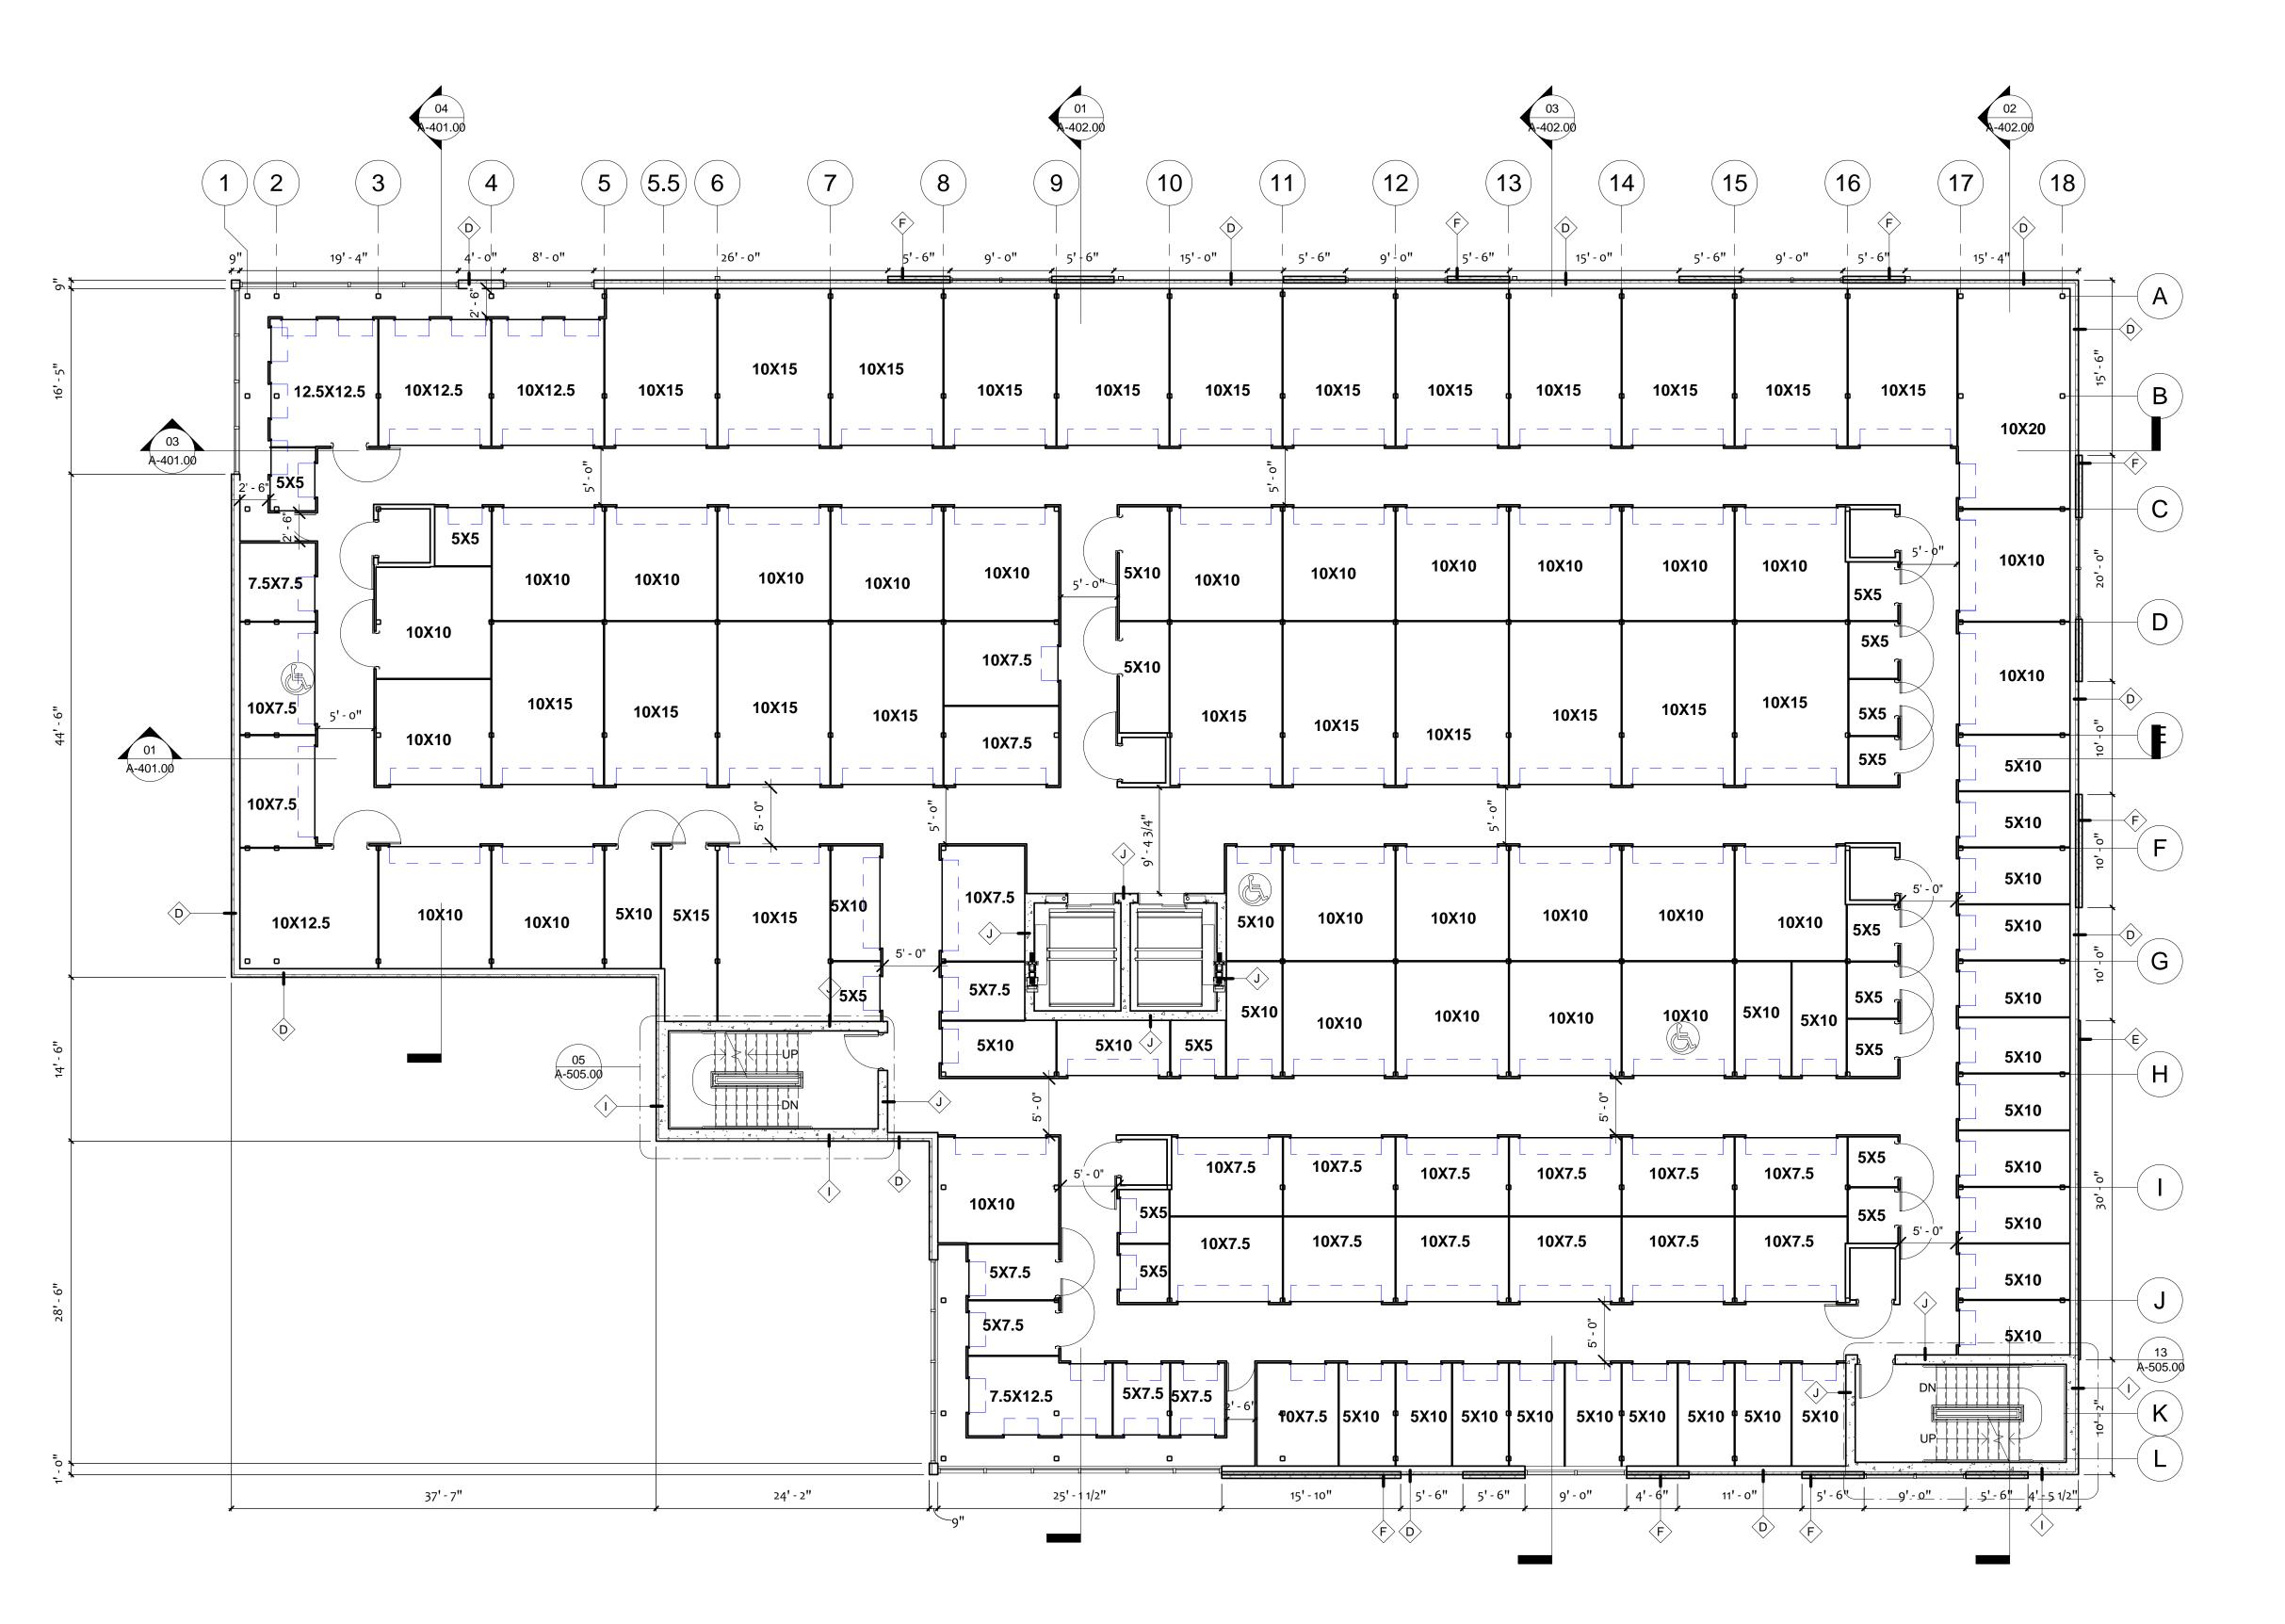

(8)

10X15

10X10

10X15

5X10

9' - 0"

10X15

10X10

10X7.5

10X7.5

5X7.5

5X7.5

5X10

5X10

5X10

10X15

<u>D</u>

24' - 2"

5X10

BUILDING WILL BE PROVIDED WITH CLASS I STANDPIPE THROUGH THE ENCLOSED STAIRWAYS IN CONFORMANCE WITH NFPA 14, FROM LOWEST LEVEL OF FIRE DEPARTMENT VEHICLE ACCESS TO ALL ROOF SURFACES.

**A**-402.00

10X15

5X10

(10)

10X15

10X10

10X15

**1** 5X10

5X5

10X7.5

\_5X10\_

5X5

5X5

45X10 |5X10 |5X10 | 5X10

25' - 10 1/2"

10X15

10X10

10X15

10X10

10X10

10X7.5

10X7.5

9

ALL ENCLOSED GROUND FLOOR TO BE SERVED BY 24/7 VIDEO SURVAILLANCE SYSTEM.

(5.5)

10X15

10X10

10X15

5X10 | 5X15 |

26' - 0 1/2"

10X15

10X10

10X15

10X15

8' - o"

10X12.5

10X10

10X15

10X10

06 A-505.00

5X5

10X10

10X10

37' - 7"

FLOOR PLAN NOTES

- 1. REFERENCE SHEET A-001.00 FOR GENERAL CONDITIONS AND ADDITIONAL REQUIREMENTS AFFECTING THIS WORK.
- FINISH FLOOR DATUM (REFERENCE) = 0'-0" IS TO TOP OF SLAB. REFER TO CIVIL DRAWINGS FROM ACTUAL FINISH FLOOR ELEVATION.
   CONTRACTOR SHALL COORDINATE ALL WORK ON THIS SHEET WITH THE DEMOLITIONS WORK, AND THE MECHANICAL, ELECTRICAL, PLUMBING, STRUCTURAL AND FIRE PROTECTION DRAWINGS.
- 4. REFERENCE THE A-700 SERIES FOR DOOR, GLAZING AND FINISH SCHEDULES.
- . WINDOWS WITHIN 24" OF DOOR SHALL BE SAFETY GLASS. ALL GLAZING IN HAZARDOUS LOCATIONS SHALL BE TEMPERED FOR IMPACT RESISTANCE.
- ALL GYPSUM BOARD IN CORRIDOR SHALL BE HUNG VERTICALLY.

(13)

10X15

10X10

10X15

10X10

10X10

10X7.5

10X7.5

\$ 5X10 | 5X10 | 5X10 | 5X10 | 5X10 |

15' - 0"

10X15

10X10

10X15

10X10

10X7.5

10X7.5

4' - 6"

5X10 | 5X10 | 5X10 | 5X10

10X15

10X10

10X15

10X10

10X7.5

10X7.5

- REFER TO ENLARGED PLANS FOR ADDITIONAL INFO. INCLUDING DIMENSIONS, DOOR TAGS, WALL TYPES, GLAZING LAYOUT AND CONSTRUCTION
- DETAILS. ENLARGED PLANS TAKE PRECEDENCE OVER SMALLER SCALE DRAWINGS. NOTIFY ARCHITECT OF ANY CONFLICT BEFORE PROCEEDING.

5' - 6"

10X15

5X5

5X5

(17)

10X20

10X10

10X10

5X10

(C)

(D)

(G)

-(H)

GRADE SLAB TO HAVE CONTINUOUS INSULATION 24" BELOW GRADE R-10 MIN.

(15)

9' - 0"

10X15

10X10

10X15

10X10

10X7.5

10X7.5

\$5X10 | 5X10 | 5X10 | 5X10

LOADING AREA CEILING TO HAVE R-10 MIN. INSULATION.

WARNING: Reproduction here-of is a criminal offense under U.S.C. SEC 506. Unauthorized disclosure may constitute trade secret misappropiation in violation of 1.C24-2-41-1 ET.SEQ and other laws. The ideas, arrangements and designs here-in may be patented or be subject of a pending patent application.

COPYRIGHT STATEMENT
These documents, their contents, and

the ideas, designs, and concepts

presented here-in are the property of

Kimberly Day McCann and were created

and developed only for the use on and in connection with the project specified here-in. None of the ideas, designs,

arrangements and plans shall be used by or disclosed to any person, firm or

corporation for any purpose whatsoever

without the express written permission of Kimberly Day McCann.

25 OCT 2021

TERED ARCHITCH COLAN DAY MCCACA A SECOND STATE OF NEW YORK

> Kimberly Day McCann, AIA NY. REG.#AR038775

KIMBERLY
DAY
McCANN
ARCHITECT

© Copyright 201 KIMBERLY DAY McCANN ARCHITECT All Rights Reserved Worldwide

PROJECT NAME:

CUBESMART

YONKERS, NY

1060 Nepperhan Ave. Yonkers, NY 10701

PROJECT CLIENT:

KDL Capital, LLC

1345 Avenue of the Americas, New York, NY 10105

PROJECT LEAD:
Gilberto Torres
407-745-5300
gtorres@eleven18architecture.com

PROJECT TEAM: KM, GT, MN, BC

DOB STAMP

DOB BSCAN

REVISIONS				
#	DATE	DESC.		
	2021.06.09	PERMIT SUBMITTAL		

A-251.00

Sixth Floor Plan

O1 SIXTH FLOOR PLAN

1/8" = 1'-0"

 $( \, {f 1} \, \, ) ( \, {f 2} \, \, )$ 

03

A-401.00

(  ${f 3}$  )

19' - 3 1/2"

12.5X12.5

7.5X7.5

10X7.5

10X7.5

10X12.5

- BUILDING WILL BE PROVIDED WITH CLASS I STANDPIPE THROUGH THE ENCLOSED STAIRWAYS IN CONFORMANCE WITH NFPA 14, FROM LOWEST LEVEL OF FIRE DEPARTMENT VEHICLE ACCESS TO ALL ROOF SURFACES.
- ALL ENCLOSED GROUND FLOOR TO BE SERVED BY 24/7 VIDEO SURVAILLANCE SYSTEM.

FLOOR PLAN NOTES

- REFERENCE SHEET A-001.00 FOR GENERAL CONDITIONS AND ADDITIONAL REQUIREMENTS AFFECTING THIS WORK.
- FINISH FLOOR DATUM (REFERENCE) = o'-o'' IS TO TOP OF SLAB. REFER TO CIVIL DRAWINGS FROM ACTUAL FINISH FLOOR ELEVATION. CONTRACTOR SHALL COORDINATE ALL WORK ON THIS SHEET WITH THE DEMOLITIONS WORK, AND THE MECHANICAL, ELECTRICAL, PLUMBING,
  - STRUCTURAL AND FIRE PROTECTION DRAWINGS.
- REFERENCE THE A-700 SERIES FOR DOOR, GLAZING AND FINISH SCHEDULES. WINDOWS WITHIN 24" OF DOOR SHALL BE SAFETY GLASS. ALL GLAZING IN HAZARDOUS LOCATIONS SHALL BE TEMPERED FOR IMPACT
- RESISTANCE. ALL GYPSUM BOARD IN CORRIDOR SHALL BE HUNG VERTICALLY.
- REFER TO ENLARGED PLANS FOR ADDITIONAL INFO. INCLUDING DIMENSIONS, DOOR TAGS, WALL TYPES, GLAZING LAYOUT AND CONSTRUCTION
- DETAILS. ENLARGED PLANS TAKE PRECEDENCE OVER SMALLER SCALE DRAWINGS. NOTIFY ARCHITECT OF ANY CONFLICT BEFORE PROCEEDING.
- GRADE SLAB TO HAVE CONTINUOUS INSULATION 24" BELOW GRADE R-10 MIN. LOADING AREA CEILING TO HAVE R-10 MIN. INSULATION.

criminal offense under U.S.C. SEC 506. Unauthorized disclosure may constitute trade secret misappropiation in violation of 1.C24-2-41-1 ET.SEQ and other laws. The ideas, arrangements and designs here-in may be patented or be subject of

COPYRIGHT STATEMENT These documents, their contents, and

the ideas, designs, and concepts presented here-in are the property of

Kimberly Day McCann and were created

arrangements and plans shall be used by or disclosed to any person, firm or


corporation for any purpose whatsoever

without the express written permission of Kimberly Day McCann.

WARNING: Reproduction here-of is a

and developed only for the use on and in connection with the project specified here-in. None of the ideas, designs,

a pending patent application. 25 OCT 2021

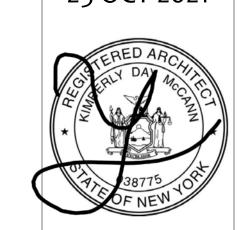

☐ Kimberly Day McCann, AIA │NY. REG.#ARo38775

# **KIMBERLY** DAY McCANN **ARCHITECT**

© Copyright 201 KIMBERLY DAY McCANN ARCHITECT All Rights Reserved Worldwide

PROJECT NAME:

**CUBESMART** YONKERS, NY

1060 Nepperhan Ave. Yonkers, NY 10701

PROJECT CLIENT:

KDL Capital, LLC

1345 Avenue of the Americas, New York, NY 10105

PROJECT LEAD: Gilberto Torres 407-745-5300 gtorres@eleven18architecture.com

PROJECT TEAM: KM, GT, MN, BC

DOB STAMP

DOB BSCAN

REVISIONS					
#	DATE	DESC.			
	2021.06.09	PERMIT SUBMITTA			

A-261.00

Seventh Floor Plan



( 8 )

10X15

10X15

BUILDING WILL BE PROVIDED WITH CLASS I STANDPIPE THROUGH THE ENCLOSED STAIRWAYS IN CONFORMANCE WITH NFPA 14, FROM LOWEST LEVEL OF FIRE DEPARTMENT VEHICLE ACCESS TO ALL ROOF SURFACES.

9

(10)

10X15

163' - 5"

10X15

ALL ENCLOSED GROUND FLOOR TO BE SERVED BY 24/7 VIDEO SURVAILLANCE SYSTEM.

(5.5)

10X15

10X15

10X15

24' - 2"

FLOOR PLAN NOTES

- REFERENCE SHEET A-001.00 FOR GENERAL CONDITIONS AND ADDITIONAL REQUIREMENTS AFFECTING THIS WORK.
- FINISH FLOOR DATUM (REFERENCE) = o'-o'' IS TO TOP OF SLAB. REFER TO CIVIL DRAWINGS FROM ACTUAL FINISH FLOOR ELEVATION. CONTRACTOR SHALL COORDINATE ALL WORK ON THIS SHEET WITH THE DEMOLITIONS WORK, AND THE MECHANICAL, ELECTRICAL, PLUMBING, STRUCTURAL AND FIRE PROTECTION DRAWINGS.
- REFERENCE THE A-700 SERIES FOR DOOR, GLAZING AND FINISH SCHEDULES.

(15)

10X15

10X15

76' - 1 1/2"

102' - 0"

- WINDOWS WITHIN 24" OF DOOR SHALL BE SAFETY GLASS. ALL GLAZING IN HAZARDOUS LOCATIONS SHALL BE TEMPERED FOR IMPACT RESISTANCE.
- ALL GYPSUM BOARD IN CORRIDOR SHALL BE HUNG VERTICALLY.
- REFER TO ENLARGED PLANS FOR ADDITIONAL INFO. INCLUDING DIMENSIONS, DOOR TAGS, WALL TYPES, GLAZING LAYOUT AND CONSTRUCTION

(17)

10X20

10X15

- DETAILS. ENLARGED PLANS TAKE PRECEDENCE OVER SMALLER SCALE DRAWINGS. NOTIFY ARCHITECT OF ANY CONFLICT BEFORE PROCEEDING. GRADE SLAB TO HAVE CONTINUOUS INSULATION 24" BELOW GRADE R-10 MIN.
- LOADING AREA CEILING TO HAVE R-10 MIN. INSULATION.

14

(12)

10X15

10X15

(13)

10X15

Unauthorized disclosure may constitute trade secret misappropiation in violation of 1.C24-2-41-1 ET.SEQ and other laws. The ideas, arrangements and designs here-in may be patented or be subject of a pending patent application.

COPYRIGHT STATEMENT These documents, their contents, and

the ideas, designs, and concepts presented here-in are the property of

Kimberly Day McCann and were created

arrangements and plans shall be used by or disclosed to any person, firm or

corporation for any purpose whatsoever

without the express written permission of Kimberly Day McCann.

WARNING: Reproduction here-of is a criminal offense under U.S.C. SEC 506.

and developed only for the use on and in connection with the project specified here-in. None of the ideas, designs,

25 OCT 2021



☐ Kimberly Day McCann, AIA NY. REG.#AR038775

# KIMBERLY DAY McCANN **ARCHITECT**

© Copyright 201 KIMBERLY DAY McCANN ARCHITECT All Rights Reserved Worldwide

PROJECT NAME:

**CUBESMART** YONKERS, NY

1060 Nepperhan Ave. Yonkers, NY 10701

PROJECT CLIENT:

KDL Capital, LLC

1345 Avenue of the Americas, New York, NY 10105

PROJECT LEAD: Gilberto Torres 407-745-5300 gtorres@eleven18architecture.com

PROJECT TEAM: KM, GT, MN, BC

DOB STAMP

DOB BSCAN

16 A-505.00

	REVISION	SNC
#	DATE	DESC.

A-271.00

Eighth Floor Plan

O1 EIGHTH FLOOR PLAN

1/8" = 1'-0"

37' - 7"

(  $\mathbf{3}$  )

15X12.5

03 A-401.00 5X7.5 5X5 10X7.5 10X10 10X10 10X10 10X10 10X10 10X10 ∭5X10 10X10 10X10 10X10 10X10 10X10 10X10 5X5 10X7.5 10X7.5 10X10 5X10 10X15 10X10 10X7.5 5X10 A-401.00 5X10 10X7.5 5X10 5X7.5 5X10 10X10 10X10 10X12.5 10X10 10X10 10X10 5X10 10X10 10X15 5X15 (G)5X10 5X10 | 5X10 | 5X10 | 5X10 | 10X10 10X10 5X10 5X10 5X5 (H)08 A-505.00 5X10 5X10 5X10 10X7.5 10X7.5 10X7.5 10X7.5 10X7.5 10X7.5 5X10 5X5 5X10 10X7.5 10X7.5 5X5 10X7.5 10X7.5 10X7.5 10X7.5 5X10 5X10 5X10 10X15 5X10 5X10 5X10 5X10 5X10 5X10 5X10 5X10

#### **ROOF PLAN NOTES**

- REFERENCE SHEET A-001.00 FOR GENERAL CONDITIONS AND ADDITIONAL
- REQUIREMENTS AFFECTING THIS WORK.

  2. FINISH FLOOR DATUM (REFERENCE) = 0'-0" IS TO TOP OF SLAB. REFER TO CIVIL DRAWINGS FROM ACTUAL FINISH FLOOR ELEVATION.
- 3. CONTRACTOR SHALL COORDINATE ALL WORK ON THIS SHEET WITH THE DEMOLITIONS WORK, AND THE MECHANICAL, ELECTRICAL, PLUMBING, STRUCTURAL AND FIRE PROTECTION DRAWINGS.
- 4. ROOFING SYSTEM SHALL BE DESIGNED, FABRICATED AND INSTALLED TO WITHSTAND WIND SPEED DESIGN IDENTIFIED ON STRUCTURAL DRAWINGS.
- FURNISH ALL LABOR, MATERIALS AND EQUIPMENT REQUIRED TO INSTALL A COMPLETE ROOFING SYSTEM, COMPLETE WITH ALL ACCESSORIES AND INCIDENTALS REQUIRED BY THE ROOFING MANUFACTURER.
- REQURIED BY THE ROOFING MANUFACTURER.

  6. INSTALLER SHALL PROVIDE CERTIFICATION FROM ROOFING SYSTEM MANUFACTURER
- THAT INSTALLER IS APPROVED FOR INSTALLATION OF SPECIFIED SYSTEM.

  7. CONTRACTOR SHALL PROVIDE MANUFACTURERS STANDARD WARRANTY AGREEING TO PROMPT REPAIR OF LEAKS RESULTING FROM DEFECTIVE MATERIALS OR WORKMANSHIP FOR A PERIOD OF 15 YEARS.


(3) (13) (12) (14) (17) ( 8 )9 (10) (5.5) (11) (15) (18) 4" X 8" OVERFLOW 4" X 8" OVERFLOW-4" X 8" OVERFLOW— 4" X 8" OVERFLOW 4" DNSPT W/ SCUPPER-4" DNSPT W/ SCUPPER 4" DNSPT W/ SCUPPER— 4" DNSPT W/ SCUPPER-T/PARAPETI T/PARAPET (A)540" REQUIRED BORDER CLEARANCE (B)-RIGID INSULATION TO -RTUs EQUIPMENT, CREATE DRAIN RIDGE -RTUs EQUIPMENT, SEE SEE MECH DWGS MECH DWGS + 88' - 3" T/PARAPET (C)60 MIL TPO ROOF MEMBRANE ADHERED ON (2) 3 IN. LAYER OF RIGID INSULATION TO  $\bigcirc$ MEET R-30, INSTALLED ON AIR —RTUs EQUIPMENT, SEE AND VAPOR BARRIER MECH DWGS  $(\mathsf{E})$ —RTUs EQUIPMENT, SEE MECH DWGS -ROOF WALK PADS + 88' - 3"、 T/PARAPET T (G)-RIGID INSULATION TO + 88' - 3" T/PARAPET CREATE DRAIN RIDGE  $(\mathsf{H})$ —RTUs EQUIPMENT, SEE MECH DWGS RTUs EQUIPMENT, SEE MECH DWGS + 88' - 3" T/PARAPET 60 MIL TPO ROOF MEMBRANE ADHERED ON (2) 3 IN. LAYER OF RIGID INSULATION TO MEET R-30, INSTALLED ON AIR AND VAPOR BARRIER S-50TB BILCO ROOF HATCH— + 88' - 3" T/PARAPET + 88' - 3" T/PARAPET T

COPYRIGHT STATEMENT
These documents, their contents, and
the ideas, designs, and concepts
presented here-in are the property of
Kimberly Day McCann and were created
and developed only for the use on and in
connection with the project specified

Kimberly Day McCann and were created and developed only for the use on and in connection with the project specified here-in. None of the ideas, designs, arrangements and plans shall be used by or disclosed to any person, firm or corporation for any purpose whatsoever without the express written permission of Kimberly Day McCann.

WARNING: Reproduction here-of is a criminal offense under U.S.C. SEC 506. Unauthorized disclosure may constitute trade secret misappropiation in violation of 1.C24-2-41-1 ET.SEQ and other laws. The ideas, arrangements and designs here-in may be patented or be subject of a pending patent application.

25 OCT 2021

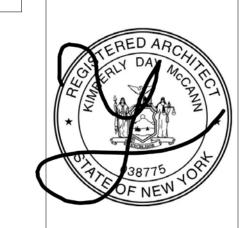

Kimberly Day McCann, AIA
NY. REG.#AR038775

KIMBERLY
DAY
McCANN
ARCHITECT

© Copyright 201 KIMBERLY DAY McCANN ARCHITECT All Rights Reserved Worldwide

PROJECT NAME:

CUBESMART YONKERS, NY

1060 Nepperhan Ave. Yonkers, NY 10701

PROJECT CLIENT:

KDL Capital, LLC

1345 Avenue of the Americas, New York, NY 10105

PROJECT LEAD:
Gilberto Torres
407-745-5300
gtorres@elevent8architecture.com

PROJECT TEAM: KM, GT, MN, BC


DOB STAMP

DOB BSCAN

	REVISION	SNC
#	DATE	DESC.
	2021.06.09	PERMIT SUBMITTAL

A-281.00

Roof Plan

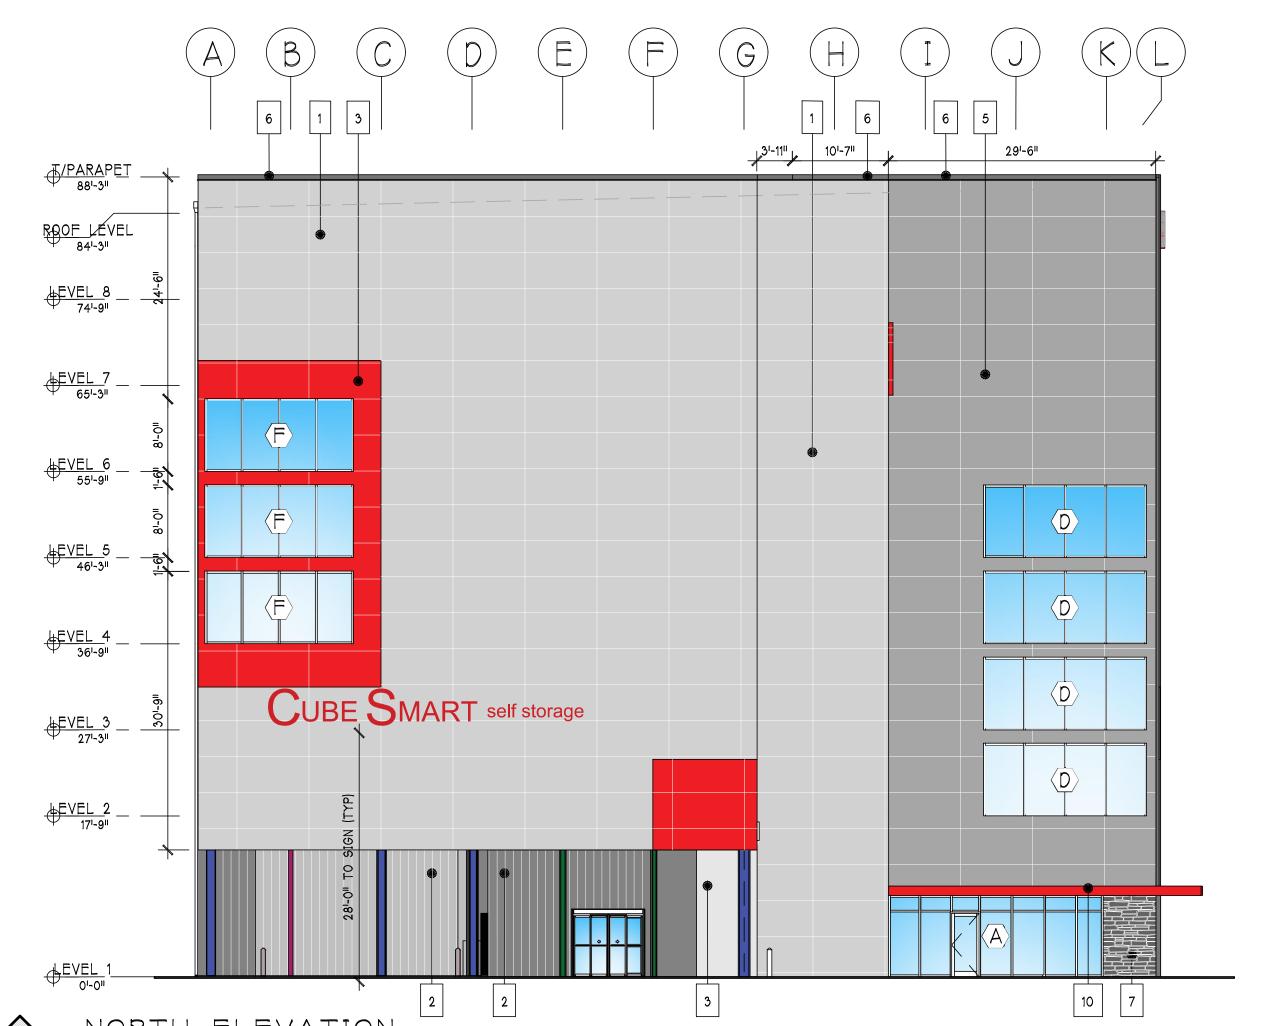

NEPPERHAN ABENUE ELEVATION

SCALE : 3/32" = 1'-0"

		FINISH S	CHEDULE	
TAG	MATERIAL	MANUFACTURER	COLOR	COMMENTS
1	INSULATED METAL PANEL	MBCI, CF ARCHITECTUAL/ HORIZONTAL	POLAR WHITE	
2	INSULATED METAL PANEL	MBCI, CF ARCHITECTUAL/ HORIZONTAL	SMOKE GRAY	
3	INSULATED METAL PANEL	MBCI, CF ARCHITECTUAL/ HORIZONTAL	BRITE RED	
4	NOT USED			
5	INSULATED METAL PANEL	MBCI, CF ARCHITECTUAL/ HORIZONTAL	REGAL GRAY	
6	PRE-FINISHED COPING CAP	ТВО	TO MATCH ADJACENT FINISH	
7	STONE VENEER	CORONADO/HONEY LEDGE	HURON	INSTALLED ON HPCI BARRIER MBCI INSULATED PANEL SYSYEM
8	DOOR FINISH	ТВО	TO MATCH SW7067 CITYSCAPE OR EQ	
9	DOOR FINISH	ТВО	CLEAR ANODIZED FINISH	
10	METAL CANOPY	TBD	TO MATCH SW6871 POSITIVE RED OR EQ	

#### **ELEVATION NOTES**

- REFERENCE SHEET A-002 FOR GENERAL CONDITIONS AND ADDITIONAL REQUIREMENTS AFFECTING THIS WORK.
- 2. FINISH FLOOR DATUM (REFERENCE)=0'-0" IS TO TOP OF SLAB, REFER TO
- CIVIL DRAWINGS FROM ACTUAL FINISH FLOOR ELEVATION. 3. CONTRACTORS SHALL COORDINATE ALL WORK ON THE STREET WITH THE

DEMOLITIONS WORK, AND THE MECHANICAL, ELECTRICAL, PLUMBING,

- STRUCTURAL AND FIRE PROTECTION DRAWINGS. 4. ALL PRE-MANUFACTURED TRIM, MOLDINGS, CLADDING & COMPONENTS SHALL BE FASTENED AND ADHERED TO BUILDING PER MANUFACTURER SPECIFICATIONS TO WITHSTAND DESIGN WIND PRESSURE IDENTIFIED ON
- STRUCTURAL DRAWINGS. 5. COORDINATE WITH ARCHITECT THE LOCATION OF ALL ADDITIONAL CONTROL JOINTS REQUIRED BUT NOT INDICATED ON PLANS.
- 6. ALL EXTERIOR SURFACES TO BE PAINTED IN FIELD OR BE PROVIDED WITH FACTORY OR SHOP APPLIED FINISH AS REQUIRED. ALL COLORS SHALL BE SELECTED BY ARCHITECT, APPROVED BY OWNER

#### ELEVATION NOTES

- LOWEST FIRE ACCESS LEVEL TO BE GROUND LEVEL.
- 2. SIGNAGE SHOWN FOR REFERENCE ONLY, ACTUAL BUILDING SIGNAGE TO BE
- 3. HIGHEST OCCUPIED LEVEL LOCATED AT 74'-9" UNDER THE 75'-0" REQUIREMENT TO BE CONSIDERED A HIGH RISE BUILDING
- 4. ALL ILLUMINATED SIGNAGE WILL BE TURNED OFF AT CLOSE OF BUSNIESS

- PERMITTED SEPARATELY.
- IN CONJUNCTION WITH THE CITY OF YONKERS CODE 43-121 B(8)



ideas, designs, arrangements and plans indicated epresented are owned by and the property of this office and were created, evolved and developed for use and connection with this specific project. None of such ideas designs, arrangements or plans shall be used by disclosed to any person, firm or corporation for

www.masengpc.com

purpose whatsoever without written permission Mastrogiacomo Engineering, P.C. Mritten dimensions on these drawings shall precedence over scaled dimensions. Contractors sh verify and be responsible for all dimensions and condition on the job and this office must be notified of an variation from these dimesions and conditions show hereon in writting.

is a violation of the New York State Education Law any person, unless acting under the direction of Licensed Professional Engineer, to alter any item on the drawing and/or related specification. all alterations mu be made in compliance with the New York State Education Law, the Professional Engineer whose sea appears hereon assumes no responsibility for any such

R	<b>≥</b> ∨	' i	S	i	0	n	S		
$\overline{\triangle}$									
$\triangle$									
$\triangle$									
Drawing North

# **KDL** CAPITAL,

LLC 1345 AVENUE OF THE AMERICAS NEW YORK, NY

10105 Project Information

# PROPOSED **EXTERIOR ELEVATIONS**

Situated At 1060 NEPPERHAN AVENUE CITY OF YONKERS WESTCHESTER CO. NEW YORK

	Job No.	22
	Scale	AS NO
$\rightarrow$	Date	22 JAN :
	Drawn By	
$\square$	Checked By	
\d	Sheet	

A-301.00 Exterior Building Elevations

## DRAFT PLANNING BOARD RESOLUTION

RESOLUTION TO APPROVE A SITE PLAN APPLICATION FOR A SELF STORAGE BUILDING AT BLOCK: 3092, LOT: 11, ON THE PROPERTY KNOWN AS 1050 NEPPERHAN AVENUE, PURSUANT TO ARTICLE IX OF THE YONKERS ZONING ORDINANCE.

### Findings:

- 1. The proposed redevelopment of this site includes the demolition of the existing single story structure and parking lot to be replaced with a new 8-story self-storage facility.
- 2. The Planning Board initiated the Lead Agency Determination/Coordinated review process on October 13, 2021 and declared its acceptance of Lead Agency and issued a Negative Declaration pursuant to SEQRA on December
- 3. The initial application has been revised multiple times. The board has received and reviewed the current version of the site plan set prepared by Mastrogiacomo Engineering, PC, dated December 27, 2021.
- 4. Under the parking regulations for a self-storage use, the proposed plans indicate 16 parking spaces are required by code, and 17 have been provided on the plans. In addition, based on the total square footage of the building, four (4) loading spaces have been provided on site.
- 5. The applicant has represented that the facility shall be staffed during all hours of operation.

The application as presented to the Planning Board at its meeting of January 12, 2022 is approved with the following

- 1. No temporary signs shall be placed on the sidewalk. No banners, pennants, streamers, or temporary signs shall be flown from the canopy, ground sign or building.
- 2. The applicant shall revise the building elevations and signage package to a. Remove the telephone number from the building wall signage.
  - b. Remove all signage from the eastern (saw mill river parkway facing) elevation c. Lower north and south facing wall signage to a maximum of 28 feet above grade d. Indicate via notation that all illuminated signage will be turned off at close of business in conjunction with §43-121 B (8)
- 3. Any additional modifications to the approved site plans or building designs shall be submitted to the Planning Board for a site plan amendment.
- 4. A copy of the text from this resolution in its entirety shall be included on the approved plans.
- 5. The applicant shall submit four (4) printed sets and electronic PDFs of the site plans and revised signage package to the Planning Bureau for endorsement and circulation within two weeks of the Board's approval.

### The Planning Board renders its decision based upon facts and findings available to it, specifically:


- 1. Report by the Fire Department, dated October 8, 2021 and January 6, 2022.
- 2. Report by the Planning Bureau, dated October 8, 2021.
- 3. Report by the Department of Engineering, dated October 8, 2021, November 5, 2021, December 7, 2021 and January 6, 2022.
- 4. General knowledge of the area.


January 12, 2022 Motion by: Seconded by

By a vote of:

Page 1 of 1

G:\Dept\Planning Board\SECTION 3\Block 3092 Lot 11; 1050 Nepperhan Avenue\2021 Site Plan Application - Cube Smart\2022.01.12 Draft Planning Board Resolution 1050 Nepperhan Ave.docx

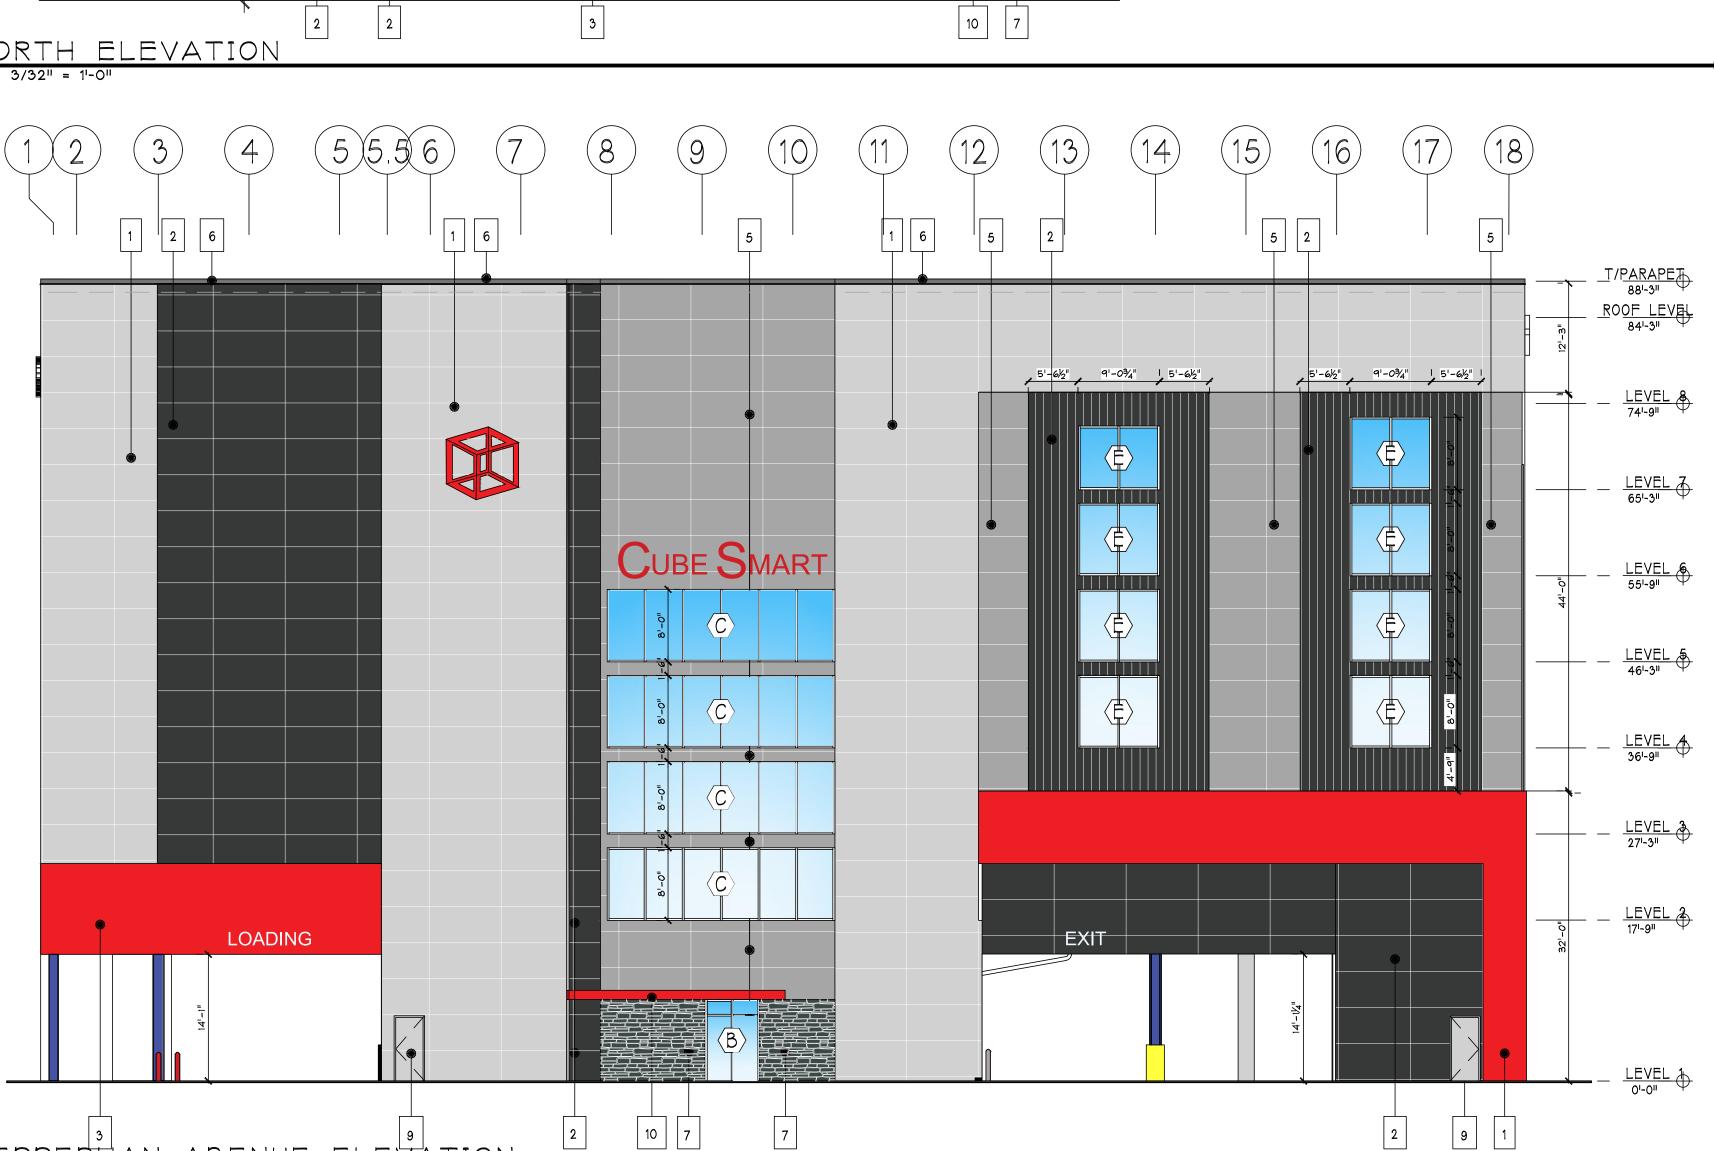

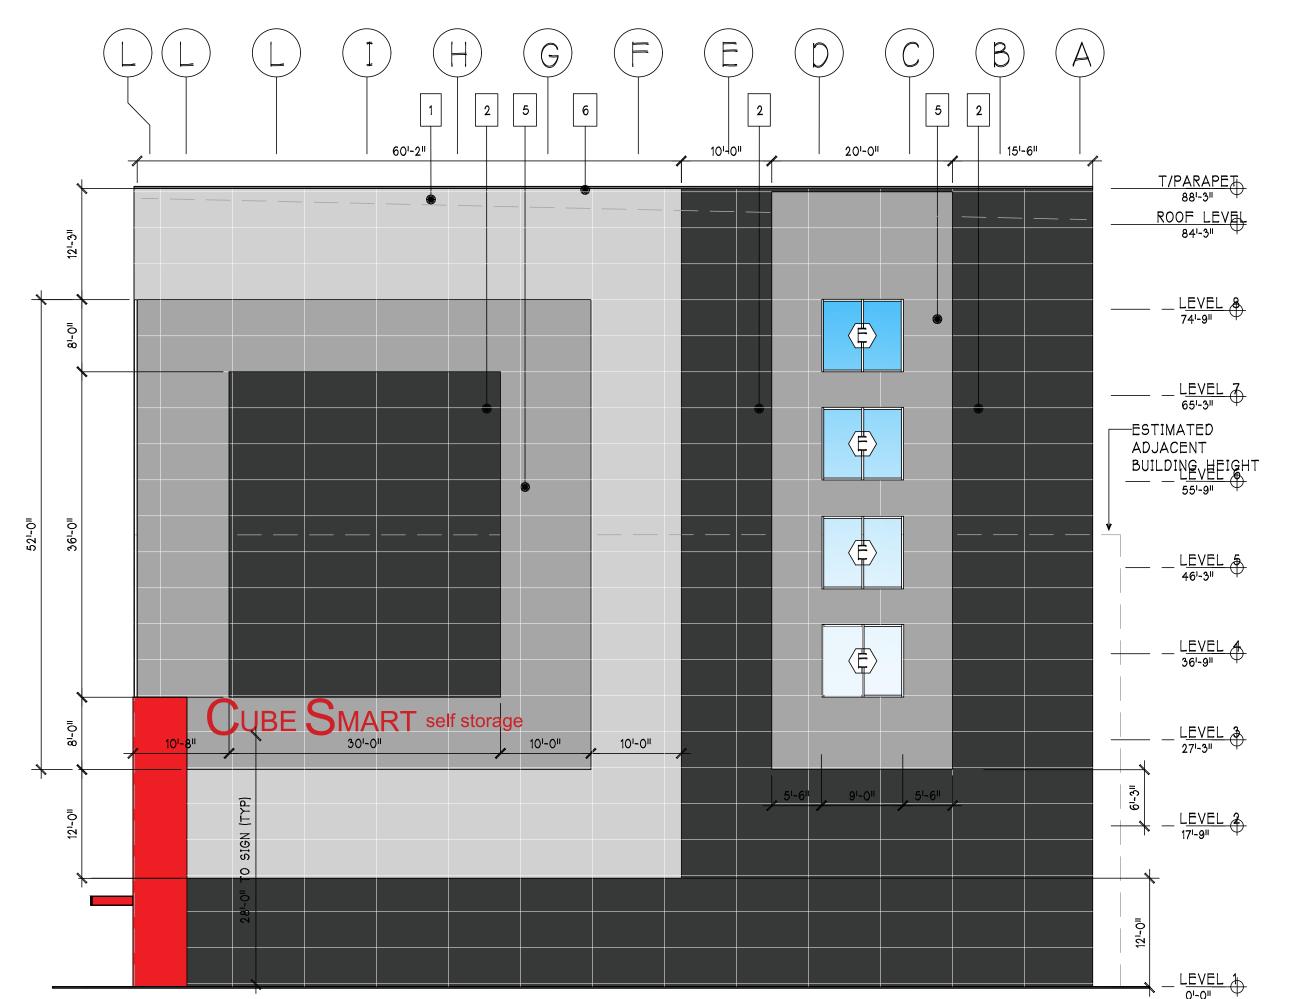

EAST ELEVATION

		FINISH S	CHEDULE	
TAG	MATERIAL	MANUFACTURER	COLOR	COMMENTS
1	INSULATED METAL PANEL	MBCI, CF ARCHITECTUAL/ HORIZONTAL	POLAR WHITE	
2	INSULATED METAL PANEL	MBCI, CF ARCHITECTUAL/ HORIZONTAL	SMOKE GRAY	
3	INSULATED METAL PANEL	MBCI, CF ARCHITECTUAL/ HORIZONTAL	BRITE RED	
4	NOT USED			
5	INSULATED METAL PANEL	MBCI, CF ARCHITECTUAL/ HORIZONTAL	REGAL GRAY	
6	PRE-FINISHED COPING CAP	ТВО	TO MATCH ADJACENT FINISH	
7	STONE VENEER	CORONADO/HONEY LEDGE	HURON	INSTALLED ON HPCI BARRIER MBCI INSULATED PANEL SYSYEM
8	DOOR FINISH	ТВО	TO MATCH SW7067 CITYSCAPE OR EQ	
9	DOOR FINISH	ТВО	CLEAR ANODIZED FINISH	
10	METAL CANOPY	ТВО	TO MATCH SW6871 POSITIVE RED OR EQ	

ELEVATION NOTES

1. REFERENCE SHEET A-002 FOR GENERAL CONDITIONS AND ADDITIONAL REQUIREMENTS AFFECTING THIS WORK.

2. FINISH FLOOR DATUM (REFERENCE)=0'-0" IS TO TOP OF SLAB, REFER TO CIVIL DRAWINGS FROM ACTUAL FINISH FLOOR ELEVATION.

3. CONTRACTORS SHALL COORDINATE ALL WORK ON THE STREET WITH THE DEMOLITIONS WORK, AND THE MECHANICAL, ELECTRICAL, PLUMBING, STRUCTURAL AND FIRE PROTECTION DRAWINGS.

4. ALL PRE-MANUFACTURED TRIM, MOLDINGS, CLADDING & COMPONENTS SHALL BE FASTENED AND ADHERED TO BUILDING PER MANUFACTURER SPECIFICATIONS TO WITHSTAND DESIGN WIND PRESSURE IDENTIFIED ON STRUCTURAL DRAWINGS.

5. COORDINATE WITH ARCHITECT THE LOCATION OF ALL ADDITIONAL CONTROL JOINTS REQUIRED BUT NOT INDICATED ON PLANS.

6. ALL EXTERIOR SURFACES TO BE PAINTED IN FIELD OR BE PROVIDED WITH FACTORY OR SHOP APPLIED FINISH AS REQUIRED. ALL COLORS SHALL BE SELECTED BY ARCHITECT, APPROVED BY OWNER.

#### ELEVATION NOTES

1. LOWEST FIRE ACCESS LEVEL TO BE GROUND LEVEL.

2. SIGNAGE SHOWN FOR REFERENCE ONLY, ACTUAL BUILDING SIGNAGE TO BE PERMITTED SEPARATELY.

3. HIGHEST OCCUPIED LEVEL LOCATED AT 74'-9" UNDER THE 75'-0" REQUIREMENT TO BE CONSIDERED A HIGH RISE BUILDING.

4. ALL ILLUMINATED SIGNAGE WILL BE TURNED OFF AT CLOSE OF BUSNIESS IN CONJUNCTION WITH THE CITY OF YONKERS CODE 43-121 B(8)

MASTROGIACOMO ENGINEERING, P.C.

All ideas, designs, arrangements and plans indicated or represented are owned by and the property of this office and were created, evolved and developed for use and ir connection with this specific project. None of such ideas, designs, arrangements or plans shall be used by or disclosed to any person, firm or corporation for any purpose whatsoever without written permission of Mastrogiacomo Engineering, P.C.

10 Midland Avenue, Suite 204A

Written dimensions on these drawings shall have precedence over scaled dimensions. Contractors shall verify and be responsible for all dimensions and condition on the job and this office must be notified of an variation from these dimesions and conditions show

alteration or re-use without his consent.

hereon in writting.

It is a violation of the New York State Education Law for any person, unless acting under the direction of a Licensed Professional Engineer, to alter any item on this drawing and/or related specification. all alterations must be made in compliance with the New York State Education Law. the Professional Engineer whose seal appears hereon assumes no responsibility for any such

R e	٧	i s	i 0	2	5		
$\overline{\triangle}$							
$\overline{\triangle}$							
-							

Drawing North

# client Name and Address

# CAPITAL, LLC 1345 AVENUE OF

THE AMERICAS

NEW YORK, NY

10105

# PROPOSED EXTERIOR ELEVATIONS

51 tuated At
1060 NEPPERHAN
AVENUE
CITY OF YONKERS
WESTCHESTER CO.
NEW YORK

	Job No.	22-00
	Scale	AS NOTE
_	Date	22 JAN 202
$\leq$	Drawn By	М.М
	Checked By	M.M
'/ I	Sheet	

A-302.00

Exterior Building Elevation

MICHAEL MASTROCACOMO, P.E.,L.S.

NINETICLI STATE PE EL S. NO. 83853

#### DRAFT PLANNING BOARD RESOLUTION

RESOLUTION TO APPROVE A SITE PLAN APPLICATION FOR A SELF STORAGE BUILDING AT BLOCK: 3092, LOT: 11, ON THE PROPERTY KNOWN AS 1050 NEPPERHAN AVENUE, PURSUANT TO ARTICLE IX OF THE YONKERS ZONING ORDINANCE.

### Findings:

- 1. The proposed redevelopment of this site includes the demolition of the existing single story structure and parking lot to be replaced with a new 8-story self-storage facility.
- 2. The Planning Board initiated the Lead Agency Determination/Coordinated review process on October 13, 2021 and declared its acceptance of Lead Agency and issued a Negative Declaration pursuant to SEQRA on December 8, 2021.
- 3. The initial application has been revised multiple times. The board has received and reviewed the current version of the site plan set prepared by Mastrogiacomo Engineering, PC, dated December 27, 2021.
- 4. Under the parking regulations for a self-storage use, the proposed plans indicate 16 parking spaces are required by code, and 17 have been provided on the plans. In addition, based on the total square footage of the building, four (4) loading spaces have been provided on site.
- 5. The applicant has represented that the facility shall be staffed during all hours of operation.

The application as presented to the Planning Board at its meeting of January 12, 2022 is approved with the following conditions:

- 1. No temporary signs shall be placed on the sidewalk. No banners, pennants, streamers, or temporary signs shall be flown from the canopy, ground sign or building.
- 2. The applicant shall revise the building elevations and signage package to a. Remove the telephone number from the building wall signage.
  - b. Remove all signage from the eastern (saw mill river parkway facing) elevation c. Lower north and south facing wall signage to a maximum of 28 feet above grade d. Indicate via notation that all illuminated signage will be turned off at close of business in
- 3. Any additional modifications to the approved site plans or building designs shall be submitted to the Planning Board for a site plan amendment.
- 4. A copy of the text from this resolution in its entirety shall be included on the approved plans.
- 5. The applicant shall submit four (4) printed sets and electronic PDFs of the site plans and revised signage package to the Planning Bureau for endorsement and circulation within two weeks of the Board's approval.

### The Planning Board renders its decision based upon facts and findings available to it, specifically:

- 1. Report by the Fire Department, dated October 8, 2021 and January 6, 2022.
- Report by the Planning Bureau, dated October 8, 2021.
   Report by the Department of Engineering, dated October 8, 2

conjunction with §43-121 B (8)


- 3. Report by the Department of Engineering, dated October 8, 2021, November 5, 2021, December 7, 2021 and January 6, 2022.
- 4. General knowledge of the area.

Date: January 12, 2022 Motion by: Seconded by:

By a vote of:

Page 1 of 1

G:\Dept\Planning Board\SECTION 3\Block 3092 Lot 11; 1050 Nepperhan Avenue\2021 Site Plan Application - Cube Smart\2022.01.12 Draft Planning Board Resolution 1050 Nepperhan Ave.docx

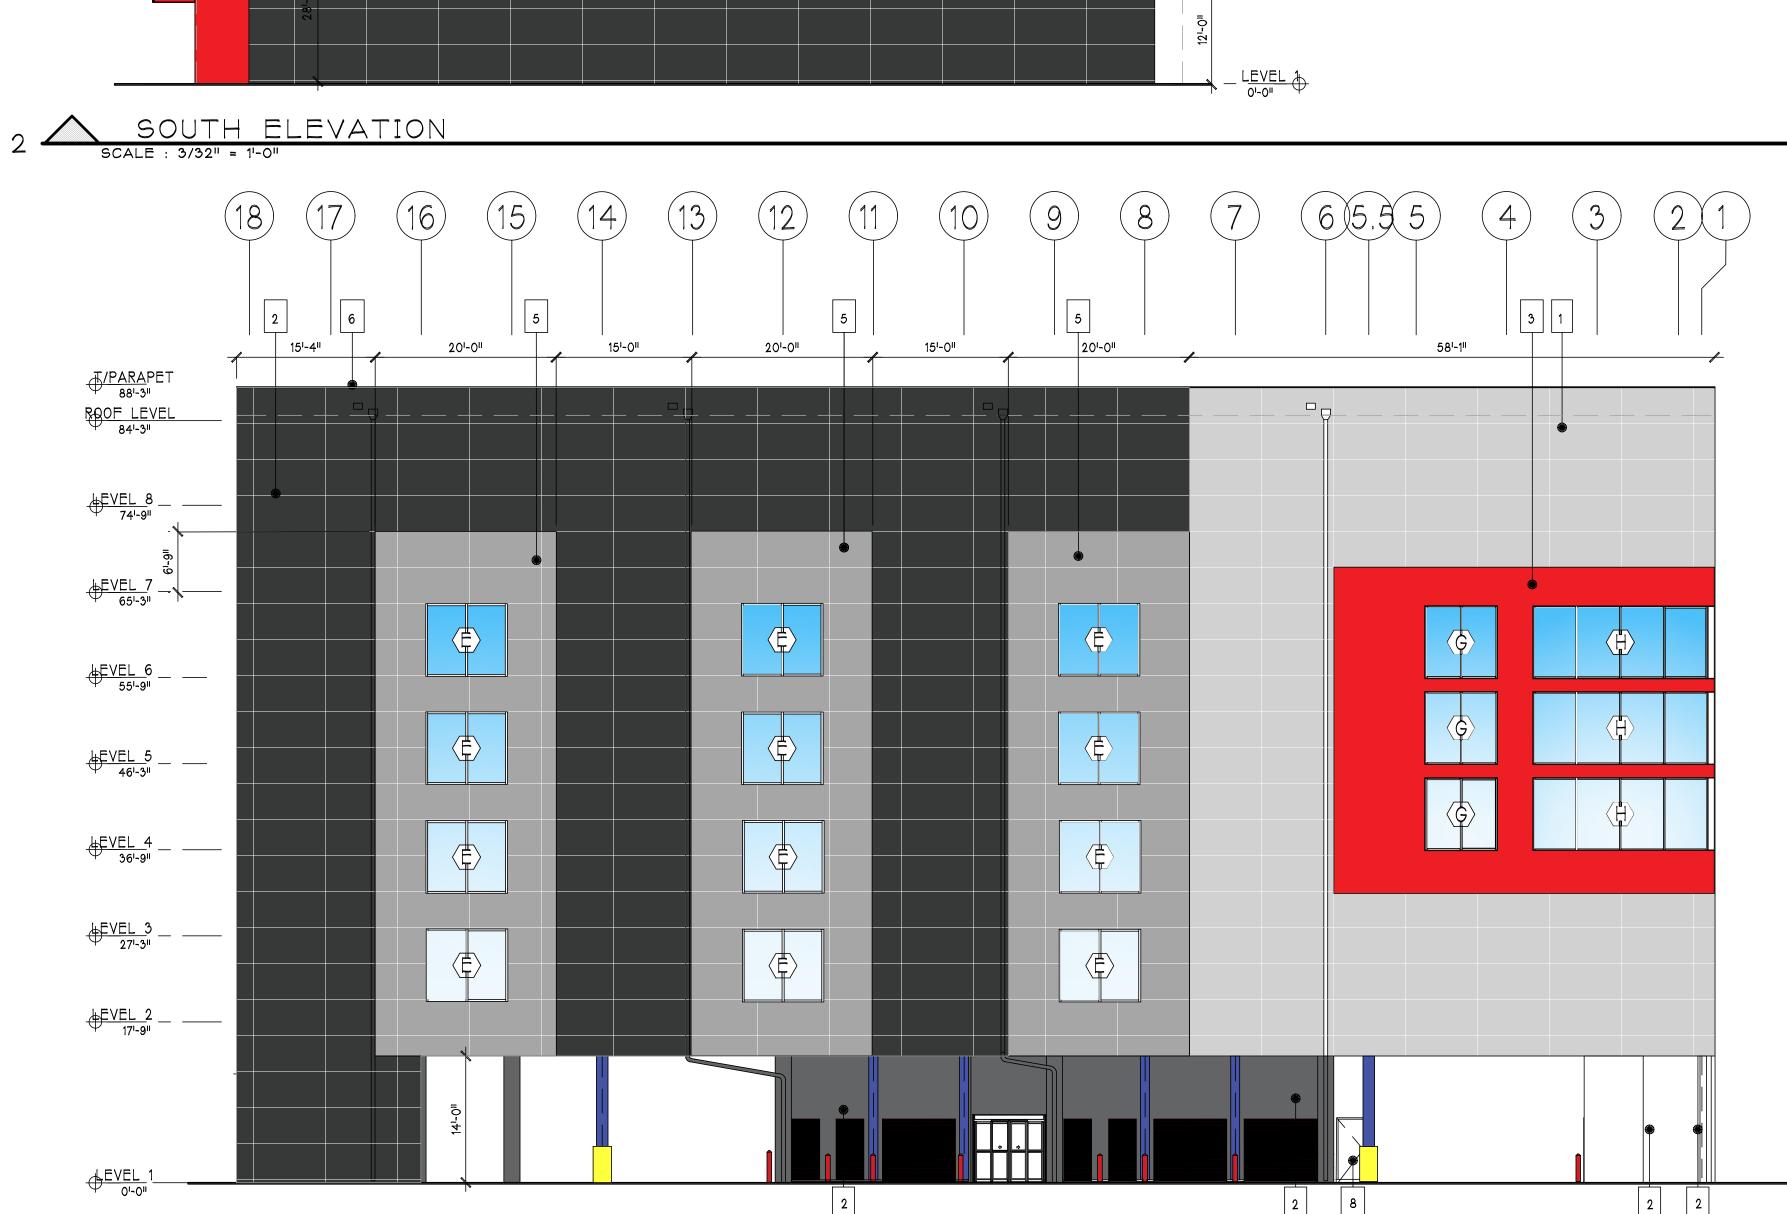



NEPPERHAN SOUTH PERSPECTIVE



O2 SAW MILL RIVER PKWY



NEPPERHAN NORTH PERSPECTIVE

COPYRIGHT STATEMENT
These documents, their contents, and the ideas, designs, and concepts presented here-in are the property of Kimberly Day McCann and were created and developed only for the use on and in connection with the project specified here-in. None of the ideas, designs, arrangements and plans shall be used by or disclosed to any person, firm or corporation for any purpose whatsoever without the express written permission of Kimberly Day McCann.

WARNING: Reproduction here-of is a criminal offense under U.S.C. SEC 506. Unauthorized disclosure may constitute trade secret misappropiation in violation of 1.C24-2-41-1 ET.SEQ and other laws. The ideas, arrangements and designs here-in may be patented or be subject of a pending patent application.



Kimberly Day McCann, AIA NY. REG.#ARo38775

# KIMBERLY DAY McCANN ARCHITECT

© Copyright 201 KIMBERLY DAY McCANN ARCHITECT All Rights Reserved Worldwide

PROJECT NAME:

CUBESMART YONKERS, NY

1060 Nepperhan Ave. Yonkers, NY 10701

PROJECT CLIENT:

KDL Capital, LLC

1345 Avenue of the Americas, New York, NY 10105

PROJECT LEAD:
Gilberto Torres
407-745-5300
gtorres@eleven18architecture.com

PROJECT TEAM: KM, GT, MN, BC

DOB STAMP

DOB BSCAN

REVISIONS					
#	DATE	DESC.			

CA-310

Concept Perspective

