

**General Mail Facility
Mid-Hudson**

UNITED STATES POSTAL SERVICE
FACILITIES SERVICE CENTER
WINDSOR, CT.
U.S. MAIL
USPS Proj # 61Q004

Architect
320 West 13th St.,
New York, N.Y. 10014

Leroy Callender/P.C.
Structural Engineer


Syska & Hennessy
Mechanical Engineer

Joseph A. Sedlak
Mechanization Engineer

Quennell Rothchild Associates
Landscape Architect

Notes

Key Plan

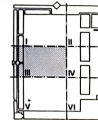


AS BUILT		2/12/9
MECH. COORD		2/22/9
No.	Description	Check Date
Revisions		
Date 4-01-88	Drawn NG	
Arch Job # 8634	Check LHC	
Graphic Scale		

Drawing Title
GMF MEZZ. & L.O.G.
FRAMING PLAN QUAD. III



Drawing No.

S-203

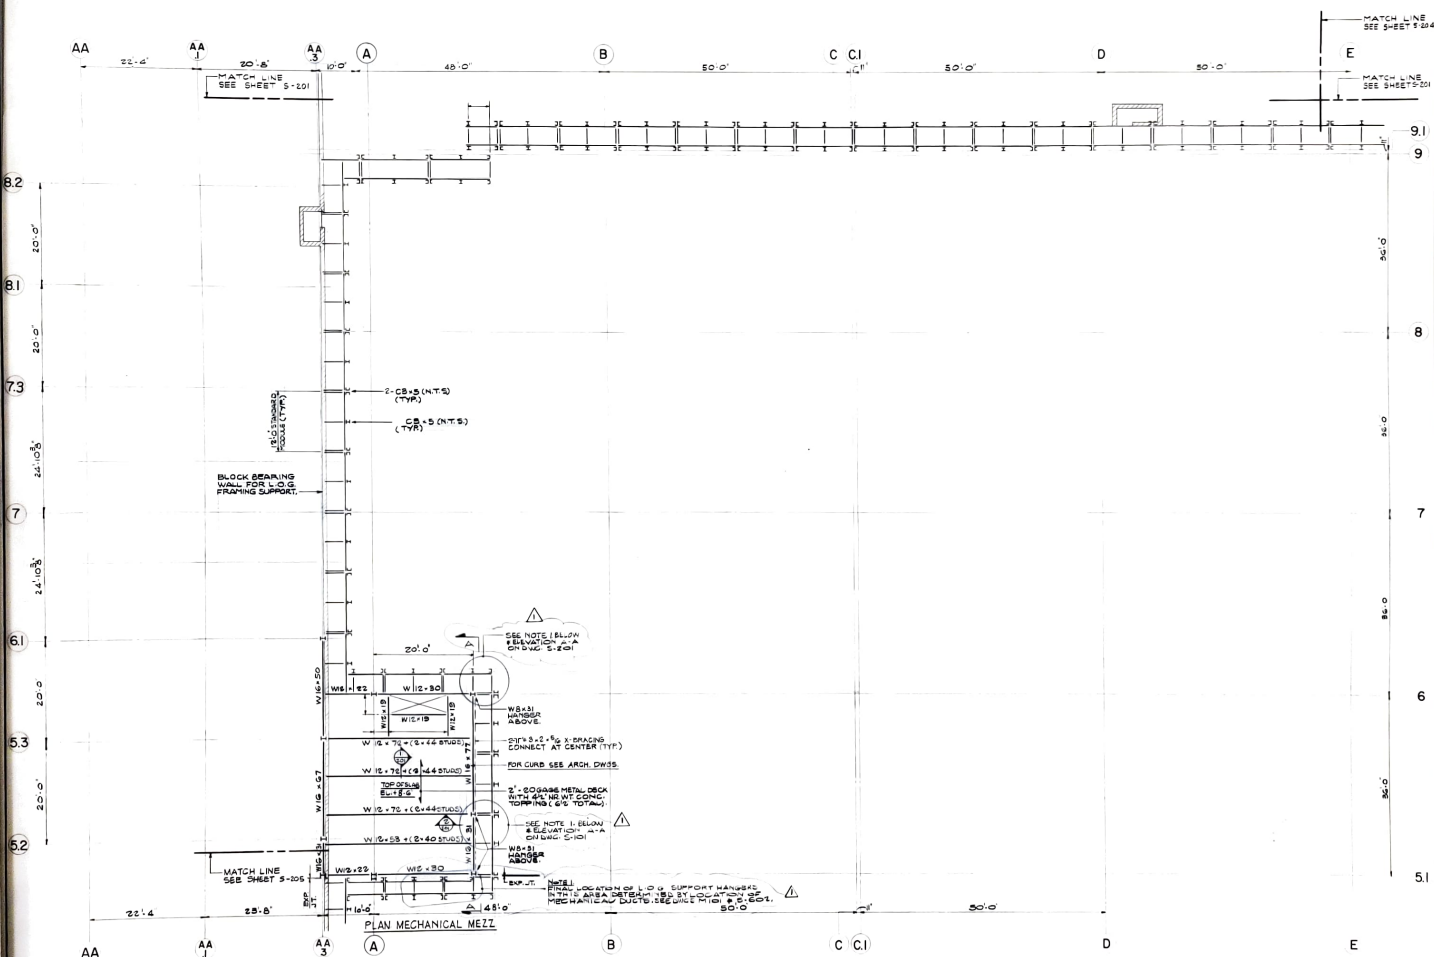

FOR NOTES SEE DWG. S-202