

UNITED STATES POSTAL SERVICE

General Mail Facility
Mid-Hudson
Newburgh, New York




James Stewart Polshek
and Partners
Architect
320 West 13th St.
New York, N.Y. 10014

Leroy Callender P.C.
Structural Engineer
Sykes & Hennessy
Mechanical Engineer
Joseph A. Sestak
Mechanization Engineer
Quennell Rothchild Associates
Landscape Architect

Notes


Key Plan

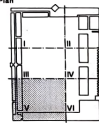

As BUILT	01/79
No. Description	Check Date
Revisions	Drawn NG
4-11-88	Check HM
Arch Job #	
834	
Graphic Scale	

Drawing Title
**GMF ROOF FRAMING
PLAN - QUADRANT V**

Drawing No.
5-305

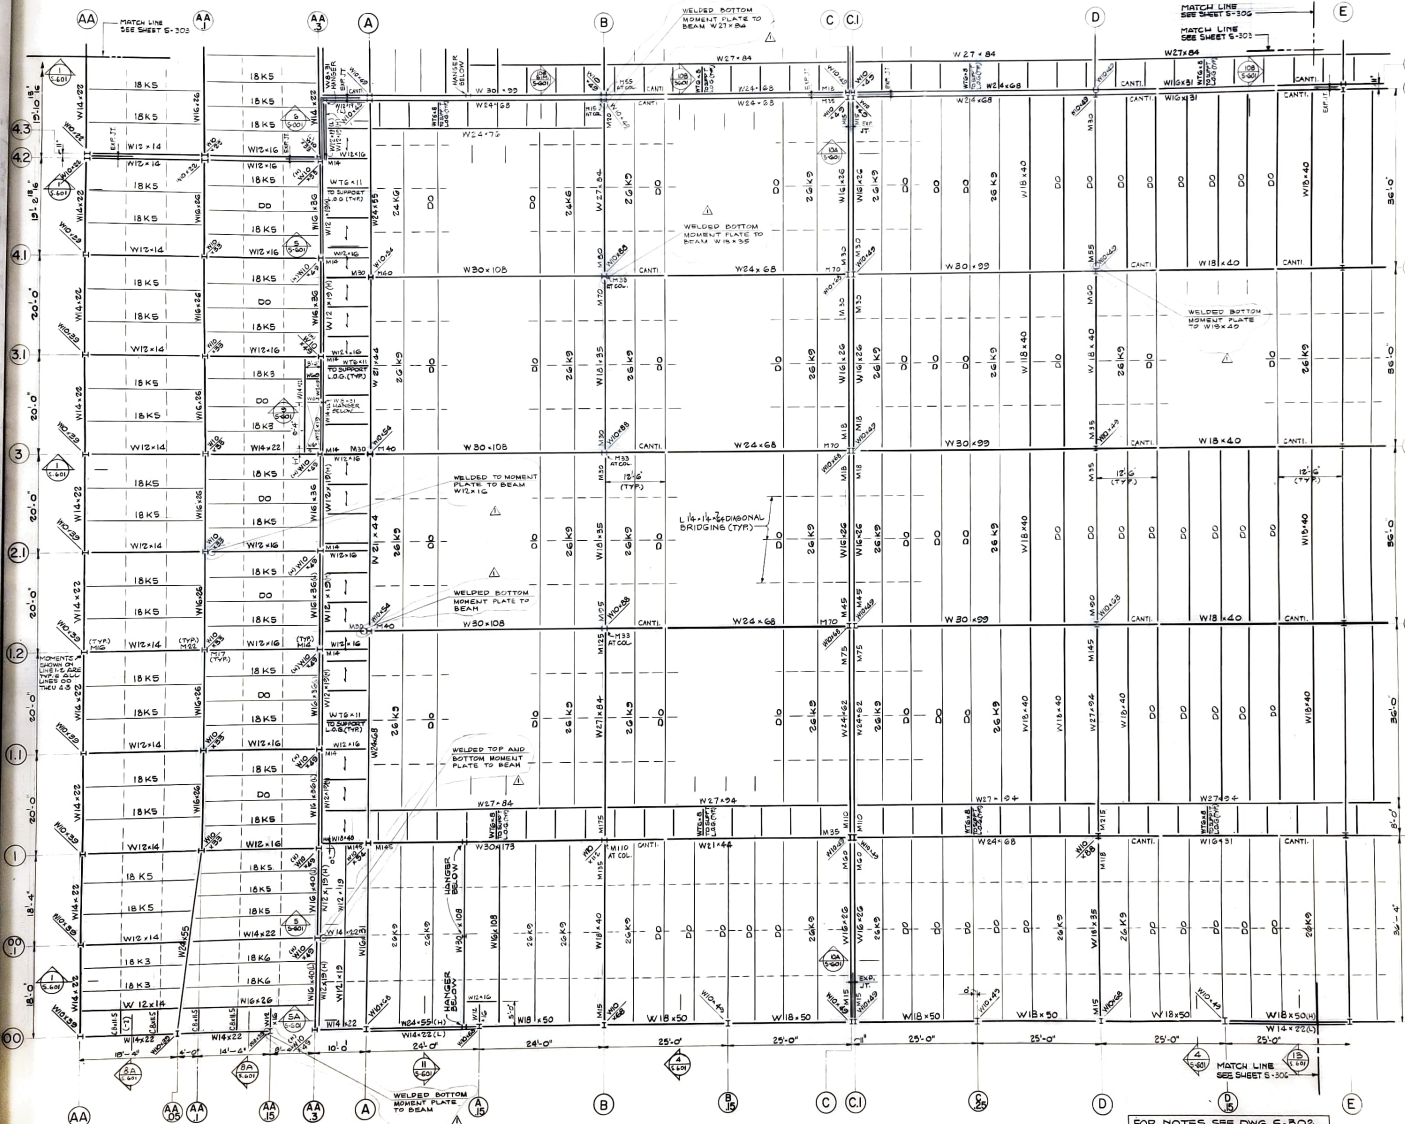

FOR NOTES SEE DWG 5-302