

UNITED STATES POSTAL SERVICE

General Mail Facility
Mid-Hudson
Newburgh, New York





James Stewart Polishak
and Partners
Architect
200 WEST 11TH ST.
NEW YORK, NY 10014



Enyo Chander/C
Structural Engineer
Joseph A. Sedak
Mechanical Engineer
Mechanical Engineer
Quamail Robinson Associates
Landscape Architect

Notes

Key Plan

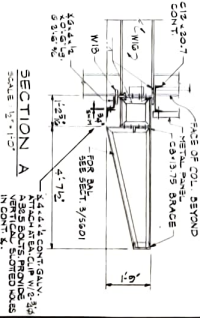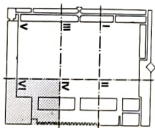

FRAMING ABOVE ENTRANCE

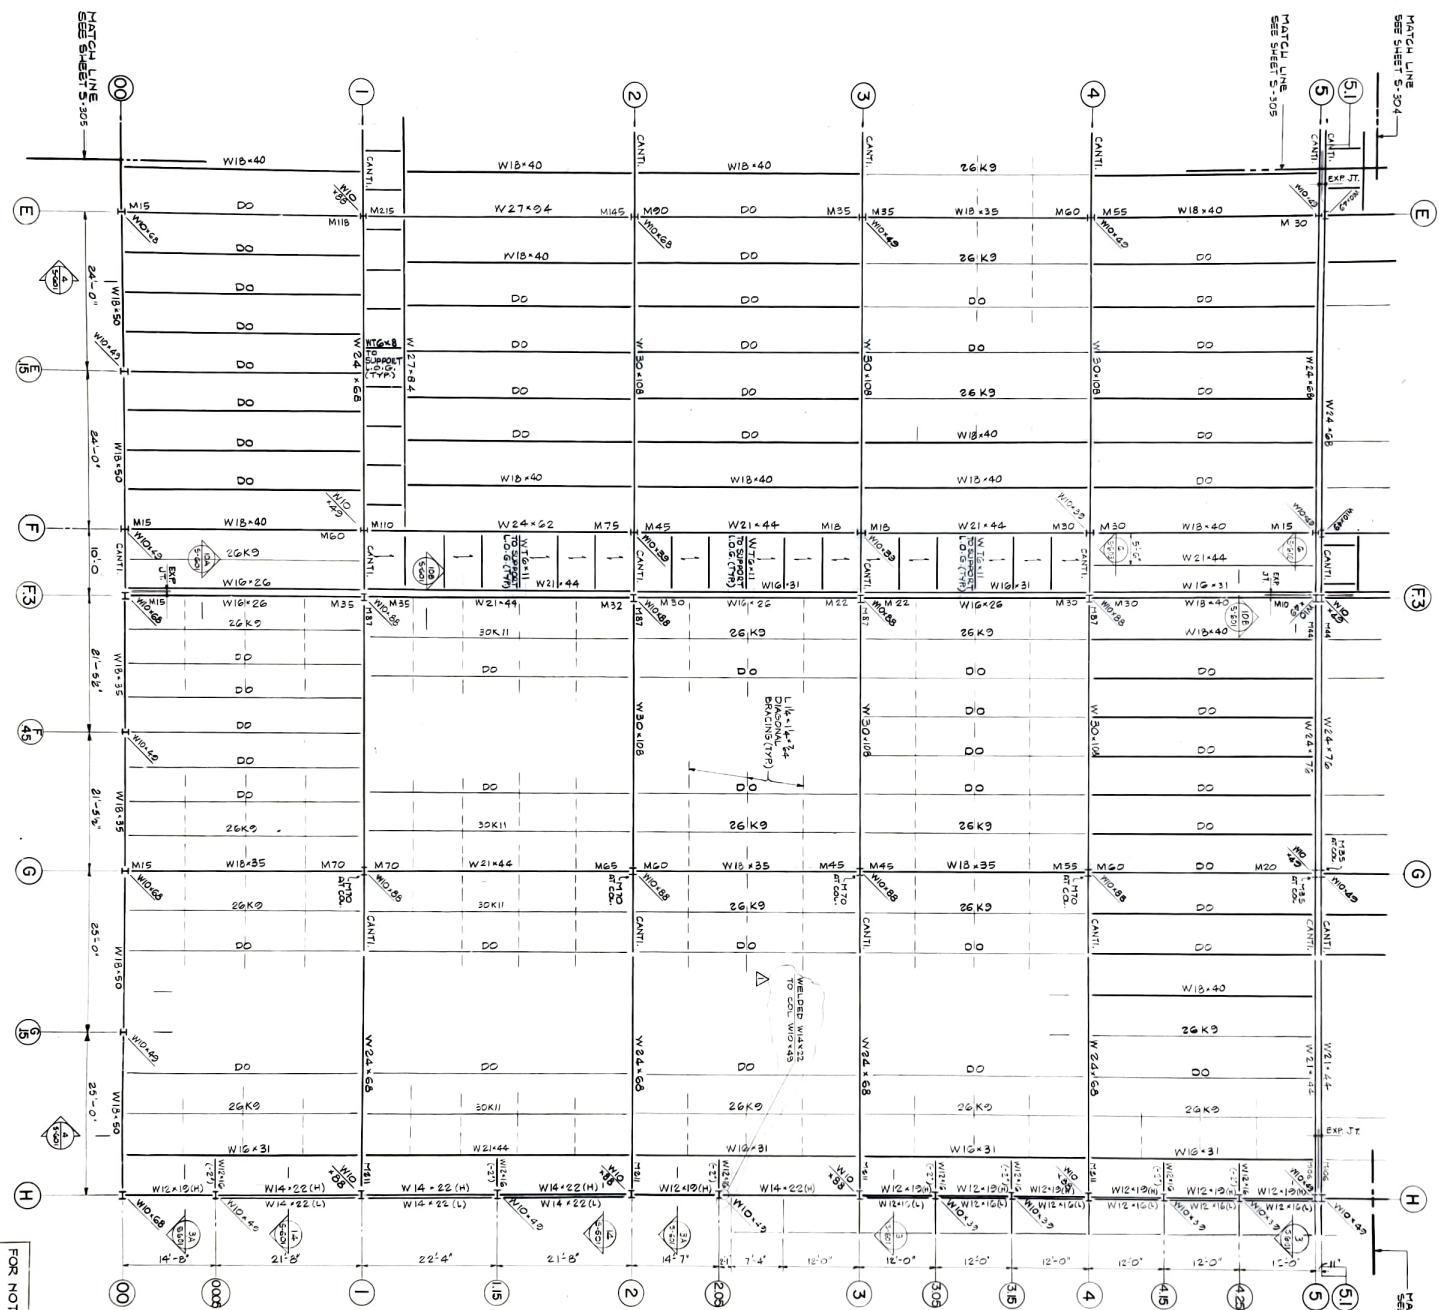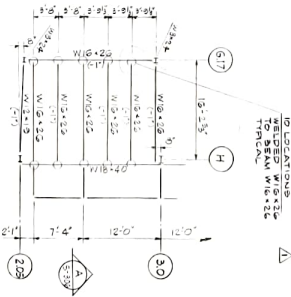

FOR NOTES SEE DWG. S-302

Revisions	Drawn By	Check By
1. AS BUILT	5/7/93	
2. NO. DESCRIPTION	CHECK DATE	
3. DATE	SS	
4. FOR NO. 4	CHECK IN	
5. REB4		
Graphic Scale		
Drawing Title		
GMF ROOF FRAMING		
PLAN-QUADRANT VI		
Drawing No.		
S-306		