

UNITED STATES POSTAL SERVICE

General Mail Facility
Mid-Hudson

Newburgh, New York




James Stewart Polshek
and Partners
Architect
320 West 13th St.
New York, N.Y. 10014


Leroy Callender/P.C.
Structural Engineer
Sybka & Hennessy
Mechanical Engineer

Joseph A. Sedlak
Mechanical Engineer
Quinnell Rothchild Associates
Landscape Architect


Notes

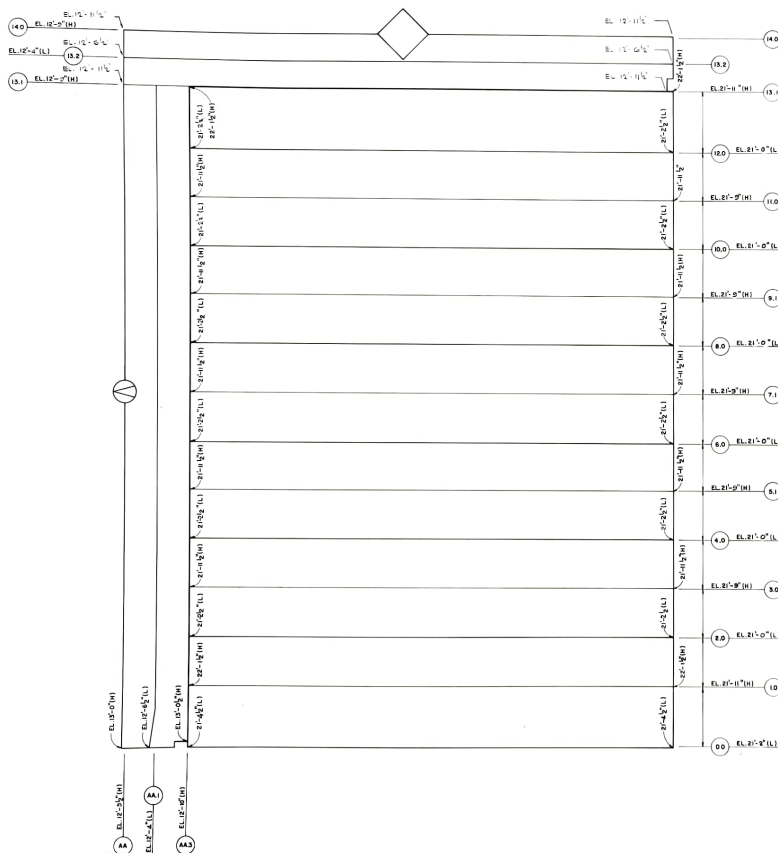

ELEVATIONS AT TOP OF STRUCTURAL STEEL BEAMS (W)

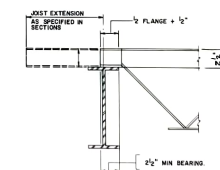

WHEN ROOF BEAM IS PERPENDICULAR TO K-SERIES JOIST

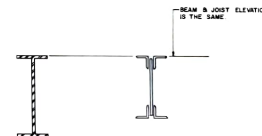

WHEN ROOF BEAM IS PARALLEL TO K-SERIES JOIST

TYPICAL JOIST SUPPORT DETAIL

AS BUILT	5.17.01
NO. DESCRIPTION	CHECK DATE
DATE	DRAWN
APP'D	CHECK
GRAPHIC SCALE	

Drawing Title
TOP OF STRUCTURAL
STEEL ELEVATIONS
AND MISC. DETAILS



Drawing No.

5-507