

Bid Addendum No. 4

November 19, 2024

Valley Central School District 2023 Capital Project – Phase 1

CSArch Project No. 187-2302.01

SED Control No. Varies



Architect's Seal

This Bid Addendum No. 4 forms part of the Contract Documents and modifies the original bidding documents dated October 18, 2024. Bid Addendum No. 3 consists of (4) cover sheet page, (6) specification sections, (29) full size 30"x42" drawing sheets, and responses to bidder requests for information.

GENERAL INFORMATION

1. Bid Addendum No. 1 was issued to bidders on October 25, 2024.
2. Bid Addendum No. 2 was issued to bidders on November 1, 2024.
3. Bid Addendum No. 3 was issued to bidders on November 8, 2024.
4. Bid Addendum No. 4 was issued to bidders on November 19, 2024.

REVISIONS TO THE PROJECT MANUAL

1. **DELETE** previously revised specification section 000110 – Table of Contents. **REPLACE** with the attached revised specification section 000110 – Table of Contents.
2. **DELETE** previously revised specification section 000115 – List of Drawing Sheets. **REPLACE** with the attached revised specification section 000115 – List of Drawing Sheets.
3. **ADD** attached new specification section 011200.03 – Vendor (Siemens) Supplied HVAC Controls Schedule.
4. **DELETE** original specification section 012100 - Allowances. **REPLACE** with the attached revised specification section 012100 - Allowances.
5. **DELETE** original specification section 012300 - Alternates. **REPLACE** with the attached revised specification section 012300 - Alternates.
6. **DELETE** original specification section 283100 – Fire Detection and Alarm. **REPLACE** with the attached revised specification section 283100 – Fire Detection and Alarm.

REVISIONS TO THE CONSTRUCTION DRAWINGS

VOLUME 01 OF 08 – BEREA ELEMENTARY SCHOOL

1. **DELETE** previously revised drawing sheet BES G000. **REPLACE** with attached revised drawing sheet BES G000.
2. **DELETE** original drawing sheet BES C100. **REPLACE** with attached revised drawing sheet BES C100.
3. **DELETE** original drawing sheet BES C130. **REPLACE** with attached revised drawing sheet BES C130.

4. **DELETE** original drawing sheet BES C530. **REPLACE** with attached revised drawing sheet BES C530.
5. **DELETE** previously revised drawing sheet BES A111. **REPLACE** with attached revised drawing sheet BES A111.
6. **ADD** new drawing sheet BES A401.
7. **DELETE** original drawing sheet BES AF001. **REPLACE** with attached revised drawing sheet BES AF001.
8. **DELETE** original drawing sheet BES AF111. **REPLACE** with attached revised drawing sheet BES AF111.
9. **DELETE** original drawing sheet BES AF112. **REPLACE** with attached revised drawing sheet BES AF112.
10. **ADD** new drawing sheet BES M201.
11. **ADD** new drawing sheet BES E201.

VOLUME 02 OF 08 – EAST COLDENHAM ELEMENTARY SCHOOL

1. **DELETE** original drawing sheet ECES AF111. **REPLACE** with attached revised drawing sheet ECES AF111.

VOLUME 03 OF 08 – MONTGOMERY ELEMENTARY SCHOOL

1. **DELETE** original drawing sheet MES AF111. **REPLACE** with attached revised drawing sheet MES AF111.

VOLUME 04 OF 08 – MAYBROOK ALTERNATIVE LEARNING CENTER

1. **DELETE** original drawing sheet MAY AF121. **REPLACE** with attached revised drawing sheet MAY AF121.

VOLUME 05 OF 08 – VALLEY CENTRAL HIGH SCHOOL

1. **DELETE** previously revised drawing sheet VCHS G000. **REPLACE** with attached revised drawing sheet VCHS G000.
2. **DELETE** original drawing sheet VCHS AA300 in its entirety.
3. **DELETE** previously revised drawing sheet VCHS AD112. **REPLACE** with attached revised drawing sheet VCHS AD112.
4. **DELETE** previously revised drawing sheet VCHS A112. **REPLACE** with attached revised drawing sheet VCHS A112.
5. **DELETE** original drawing sheet VCHS AF001. **REPLACE** with attached revised drawing sheet VCHS AF001.
6. **DELETE** original drawing sheet VCHS AF112. **REPLACE** with attached revised drawing sheet VCHS AF112.
7. **DELETE** previously revised drawing sheet VCHS M003. **REPLACE** with attached revised drawing sheet VCHS M003.
8. **DELETE** previously revised drawing sheet VCHS MD212. **REPLACE** with attached revised drawing sheet VCHS MD212.
9. **DELETE** previously revised drawing sheet VCHS M212. **REPLACE** with attached revised drawing sheet VCHS M212.
10. **DELETE** previously revised drawing sheet VCHS ED211. **REPLACE** with attached revised drawing sheet VCHS ED211.

11. **DELETE** previously revised drawing sheet VCHS E211. **REPLACE** with attached revised drawing sheet VCHS E211.
12. **DELETE** previously revised drawing sheet VCHS E301. **REPLACE** with attached revised drawing sheet VCHS E301.

VOLUME 06 OF 08 – VALLEY CENTRAL MIDDLE SCHOOL

1. **DELETE** original drawing sheet VCMS AF111. **REPLACE** with attached revised drawing sheet VCMS AF111.

VOLUME 07 OF 08 – WALDEN ELEMENTARY SCHOOL

1. **DELETE** original drawing sheet WES AA100. **REPLACE** with attached revised drawing sheet WES AA100.
2. **DELETE** previously revised drawing sheet WES AD111. **REPLACE** with attached revised drawing sheet WES AD111.
3. **DELETE** original drawing sheet WES AF111. **REPLACE** with attached revised drawing sheet WES AF111.

VOLUME 08 OF 08 – ADMINISTRATION BUILDING

1. N/A

RESPONSES TO BIDDER REQUESTS FOR INFORMATION

1. Who is currently running the BMS System at the schools listed
 - a. *Response: HVAC controls are provided by Owner unless otherwise noted in the documents. Vendor is either Siemens or Trane depending on the building. Refer to the revised DDC Temperature Controls Notes released in Addendum #2 on the mechanical sheets for each building. Also Refer to Addendum #3 and #4 for scope of work for Siemens and Trane.*
2. Did the school district pre purchase all Trane and Mitsubishi Mechanical Equipment and or all the Mechanicals including furnaces and boilers from Lochinvar
 - a. *Response: District has pre-purchased some of the equipment, the remainder should be furnished by the Mechanical Contractor. Refer to Trane Equipment proposals in Addendum #3 for a detailed listing of all equipment that is being furnished by the Owner.*
3. In the bid form do we add the allowance, alternate, unit price to our base bid price? I do not see it on the bid 012200/012100/012300 form nor in the specs. Please make clarification of this as we are preparing our bids.
 - a. *Response: Allowances to be provided as part of the the Base Bid value. Alternates to be provided in addition to the Base Bid value and shall be listed on Bid Forms. Unit Prices will be utilized in all Base Bid and Alternate work. Prices to be included on Bid Forms.Refer to clarifications on Allowances & Alternates in Bid Addendum #4.*

4. Please specify the existing fire alarm on East Coldenham & Admin Bldg. It does not specify in any on the plans or specs. Please advise ASAP.
 - a. *Response: Please refer to revised Section 283100 in Addendum #4, information has been added regarding the existing fire alarm system in each building.*

5. We reached out to Technical Glass Products (TGP), the basis of design for the required fire-rated assemblies on this project. Their response is as follows:
 - The Designer Series with FireLite forced-entry glazing is available but limits the span to 13'-6". This glazing is not bullet-resistant; it prevents physical breach but allows projectiles to pass through.
 - Alternatively, they can provide FireFrames, but this system lacks security glazing. A separate film would be needed to achieve any security rating.

Please advise on how you would like us to proceed.

- a. *Response: If glazing system assembly cannot be provided to obtain the fire rating and ballistic rating specified, provide fire rated glazing (rating to match required storefront system fire-rating) with security film applied to glazing to meet ballistic rating specified.*
6. On Sheet WES AF111 for the Main Office (Room 11), two floor finishes (LVT-1 and CPT-1) are specified. However, only LVT-1 is represented in the hatch pattern on the drawing. Could you please confirm if CPT-1 is required in the floor finish?
 - a. *Response: Refer to revisions to floor finishes in Bid Addendum #4.*
 7. Addendum #3 Specification Section 028213- C Summary of Work Table 5 shows VCHS AA300 as 50 sq/ft of estimated removal, when you refer to Drawing VCHS AA300 Legend shows 625 sq/ft but does not show where this occurs. Please clarify what sq/ft is required to be removed and where this occurs.
 - a. *Response: Subsequent testing has been completed and Roofing at Valley Central High School is negative for ACM. Drawing sheet AA300 will be deleted in its entirety in Bid Addendum #4.*

END OF BID ADDENDUM NO. 4

SECTION 000110 - TABLE OF CONTENTS

VOLUME 01 OF 03 - DIVISION 00 - 02

PROCUREMENT AND CONTRACTING REQUIREMENTS

Division 00 -- Procurement and Contracting Requirements

000010 - Certifications Page

000011 - Certifications Page

000012 - Certifications Page

000110 - Table of Contents

000115 - List of Drawing Sheets

001113 - Advertisement for Bids

002113 - Instructions to Bidders

003100.01 - Berea Elementary School Phasing Plans - Phase 1

003100.02 - East Coldenham Elementary School Phasing Plans - Phase 1

003100.03 - Maybrook Alternative Learning Center Phasing Plans - Phase 1

003100.04 - Montgomery Elementary School Phasing Plans - Phase 1

003100.05 - Valley Central High School Phasing Plans - Phase 1

003100.06 - Valley Central Middle School Phasing Plans - Phase 1

003110 - Project Construction Milestone Schedule

004101 - Bid Form Contract No. 1-01 - General and Abatement Construction (GAC)

004102 - Bid Form Contract No. 1-02 - Mechanical and Plumbing Construction (MPC)

004103 - Bid Form Contract No. 1-03 - Electrical Construction (EC)

004313 - AIA A310 Bid Bond

004333 - Proposed Products Form

004336 - Proposed Subcontractors Form

004513 - AIA A305 Contractor's Qualifications Statement

- 004519 - Certificate of Non-Collusion
- 004520 - Iran Divestment Act Certification
- 004543 - Corporate Resolutions
- 005216.01 - AIA A132 Owner/Contractor Agreement, Construction Manager As Advisor
- 006112 - AIA A312 Payment Bond
- 006113 - AIA A312 Performance Bond
- 006114 - AIA C106 Digital Data Licensing Agreement
- 006276.01 - AIA G732 Application And Certification For Payment, Construction Manager As Advisor
- 006276.02 - AIA G703 Continuation Sheet
- 006380 - Demonstration & Training Log
- 006519 - AIA G706 Contractor's Affidavit Of Payment Of Debts And Claims
- 006520 - AIA G706A Contractor's Affidavit Of Release Of Liens
- 006521 - AIA G707 Consent Of Surety To Final Payment
- 007216.01 - AIA A232 General Conditions Of The Contract For Construction, Construction Manager As Advisor
- 007343 - Prevailing Rate of Wages
- 008310 - Submittal Cover
- 008320 - Request for Information

SPECIFICATIONS

- Division 01 -- General Requirements
 - 011200 - Summary - Multiple Primes
 - 011200.01 - Vendor (Trane USA, Inc) Supplied HVAC Equipment Schedule
 - 011200.02 - Vendor (Trane USA, Inc) Supplied HVAC Controls Schedule
 - 011200.03 - Vendor (Siemens) Supplied HVAC Controls Schedule
 - 011400 - Work Restrictions
 - 011410 - NYSED 155.5 Regulations



- 012100 - Allowances
- 012200 - Unit Prices
- 012300 - Alternates
- 012600 - Contract Modification Procedures
- 012900 - Payment Procedures
- 012973 - Schedule of Values
- 013100 - Project Management And Coordination
- 013150 - Safety And Health
- 013200 - Construction Progress Documentation
- 013300 - Submittal Procedures
- 014000 - Quality Requirements
- 014100 - Special Inspections And Structural Testing
- 014200 - References And Definitions
- 015000 - Temporary Facilities And Controls
- 016000 - Product Requirements
- 017300 - Execution
- 017310 - Cutting And Patching
- 017400 - Warranties
- 017700 - Closeout Procedures
- 017820 - Operations And Maintenance Data
- 017839 - Project Record Documents
- 017900 - Demonstration And Training

- Division 02 -- Existing Conditions
- 023313 - Underground Utility Locator Service
- 024119 - Selective Structural Demolition And Shoring
- 028213 - Asbestos Abatement

VOLUME 02 OF 03 - DIVISION 03 - 34

Division 03 -- Concrete

033000 - Cast-In-Place Concrete

034500 - Precast Architectural Concrete

Division 04 -- Masonry

040110.01 - Masonry Cleaning

040120.63 - Brick Masonry Repair

040120.64 - Brick Masonry Repointing

042000 - Concrete Unit Masonry

042613 - Masonry Veneer

Division 05 -- Metals

051200 - Structural Steel Framing

055213 - Pipe And Tube Railings

Division 06 -- Wood, Plastics, and Composites

061053 - Miscellaneous Rough Carpentry

061600 - Sheathing

Division 07 -- Thermal and Moisture Protection

072100 - Thermal Insulation

072500 - Weather Barriers

072600 - Vapor Retarders

075323 - Ethylene-Propylene-Diene-Monomer (EPDM) Roofing

077200 - Roof Accessories

078413 - Penetration Firestopping

078446 - Fire-Resistive Joint Systems

079200 - Joint Sealants

Division 08 -- Openings

081113 - Hollow Metal Doors And Frames

081416 - Flush Wood Doors

083343 - Overhead Coiling Smoke Curtains

083453 - Security Doors

081113 - Hollow Metal Doors And Frames

085113 - Aluminum Windows

085653 - Security Windows

087100 - Door Hardware

087113 - Power Door Operators

088000 - Glazing

088813 - Fire-Resistant Glazing

088853 - Security Glazing

089119 - Fixed Louvers

Division 09 -- Finishes

090561.13 - Moisture Vapor Emission Control

092216 - Non-Structural Metal Framing

092900 - Gypsum Board

093013 - Ceramic Tiling

095113 - Acoustical Panel Ceilings

096513 - Resilient Base And Accessories

096519 - Resilient Tile Flooring

096813 - Tile Carpeting

099100 - Painting

Division 10 -- Specialties

- 101100 - Visual Display Units
- 101423 - Interior Panel Signage
- 102123 - Cubicle Curtains And Track
- 102641 - Bullet Resistant Panels
- 102800 - Toilet And Custodial Accessories
- 104416 - Fire Extinguishers And Cabinets

Division 11 -- Equipment

- 116833 - Tennis Court Equipment

Division 12 -- Furnishings

- 122413 - Roller Window Shades
- 123216 - Plastic Laminate-Clad Casework
- 123661 - Solid Surfacing Materials
- 124813 - Entrance Floor Mats And Frames

Division 13 -- Special Construction (NOT USED)

Division 14 -- Conveying Equipment (NOT USED)

Division 21 -- Fire Suppression (NOT USED)

Division 22 -- Plumbing

- 220500 - General Plumbing Requirements
- 220502 - Plumbing Demolition
- 220529 - Supports and Sleeves
- 220553 - Plumbing Identification
- 220719 - Piping Insulation
- 221000 - Plumbing Piping

- 221030 - Plumbing Specialties
- 221613 - Natural Gas Piping
- 223500 - DOMESTIC-WATER HEAT EXCHANGERSDomestic Water Heat Exchangers
- 224200 - Plumbing Fixtures

- Division 23 -- Heating, Ventilating, and Air-Conditioning (HVAC)
- 230500 - General Mechanical Requirements
- 230502 - Mechanical Demolition
- 230513 - Common Motor Requirements
- 230515 - Variable Frequency Drives
- 230529 - Supports and Sleeves
- 230548 - Vibration Controls for HVAC
- 230553 - Mechanical Identification
- 230593 - Testing, Adjusting, and Balancing
- 230713 - Duct Insulation
- 230719 - Pipe Insulation
- 230800 - Commissioning of HVAC Systems
- 230900 - Building Automation System
- 230993 - Sequence of Operations
- 232113 - Hydronic Piping
- 232123 - HVAC Pumps
- 232513 - Water Treatment for Closed-Loop Hydronic Systems
- 233113 - Metal Ductwork
- 233300 - Air Duct Accessories
- 233423 - Power Ventilators
- 233713 - Registers, Grilles and Diffusers
- 235133 - Insulated Sectional Chimneys

- 235216 - Condensing Boilers
- 236423 - Air-Cooled, Scroll Water Chillers
- 237232 - Packaged Energy Recovery Ventilators
- 237313 - Indoor Air Handling Units
- 237401 - Packaged Rooftop Heating and Cooling Units
- 238129 - Variable Refrigerant-Flow HVAC Systems
- 238216 - Ducted Heating Coils
- 238223 - Unit Ventilators
- 238236 - Finned-Tube Radiation Heaters
- 238241 - Unit Heaters

- Division 25 -- Integrated Automation (NOT USED)

- Division 26 -- Electrical
- 260500 - General Electrical Requirements
- 260519 - Low-Voltage Electrical Power Conductors And Cables
- 260526 - Grounding And Bonding For Electrical Systems
- 260529 - Hangers And Supports For Electrical Systems
- 260533 - Raceways And Boxes For Electrical Systems
- 260534 - Manholes And Handholes
- 260543 - Underground Ducts And Raceways For Electrical Systems
- 260544 - Sleeves And Sleeve Seals For Electrical Raceways And Cabling
- 260553 - Identification For Electrical Systems
- 260923 - Lighting Control Devices
- 262416 - Panelboards
- 262726 - Wiring Devices
- 262816 - Enclosed Switches And Circuit Breakers
- 265119 - LED Interior Lighting

265219 - Emergency And Exit Lighting

Division 27 -- Communications (NOT USED)

Division 28 -- Electronic Safety and Security

283100 - Fire Detection And Alarm

Division 31 -- Earthwork

312000 - Excavation and Fill

312319 - Dewatering

312513 - Erosion and Sediment Controls

Division 32 -- Exterior Improvements

321216 - Asphalt Paving

323113 - Chain Link Fences And Gates

329200 - Topsoil and Seeding

Division 33 -- Utilities

334100 - Storm Utility Drainage Piping

Division 34 -- Transportation (NOT USED)

VOLUME 03 OF 03 - APPENDIX

APP 1A - Limited Hazardous Materials Pre-Renovation Survey Report - Berea
Elementary School

APP 1B - Limited Hazardous Materials Pre-Renovation Survey Report - East Coldenham
Elementary School

APP 1C - Limited Hazardous Materials Pre-Renovation Survey Report - Maybrook
Alternative Learning Center (formally Maybrook Elementary School)

APP 1D - Limited Hazardous Materials Pre-Renovation Survey Report - Montgomery
Elementary School

APP 1E - Limited Hazardous Materials Pre-Renovation Survey Report - Valley Central
High School

APP 1F - Limited Hazardous Materials Pre-Renovation Survey Report - Walden
Elementary School

APP 1G - Limited Hazardous Materials Pre-Renovation Survey Report - Valley Central
Middle School

END OF SECTION

SECTION 000115 - LIST OF DRAWING SHEETS

VOLUME 01 OF 08 - BEREA ELEMENTARY SCHOOL (BES)

GENERAL DRAWINGS

BES G000 COVER & SHEET INDEX
BES G001 SYMBOLS, ABBREVIATIONS, MISC AND PARTITION TYPES
BES G111 OVERALL FLOOR PLAN - FIRST FLOOR

LIFE SAFETY DRAWINGS

BES LS111 LIFE SAFETY PLANS - FIRST FLOOR
BES LS112 SMOKE ZONE PLANS

HAZARDOUS MATERIALS DRAWINGS

BES AA100 ASBESTOS ABATEMENT FIRST FLOOR AREA A

CIVIL DRAWINGS

BES C100 KEY PLAN
BES C130 SITE, GRADING AND ESC PLAN
BES C530 DETAILS

ARCHITECTURAL DEMOLITION DRAWINGS

BES AD111 REMOVALS PLAN - FIRST FLOOR - AREA A
BES AD121 REMOVALS PLAN - FIRST FLOOR - AREA B
BES AD811 REFLECTED CEILING DEMO PLAN - FIRST FLOOR AREA A
BES AD812 REFLECTED CEILING DEMO PLAN - FIRST FLOOR AREAB

ARCHITECTURAL DRAWINGS

BES A111 ENLARGED FLOOR PLAN - FIRST FLOOR - AREA A
BES A112 ENLARGED FLOOR PLAN - FIRST FLOOR - AREAB
BES A201 EXTERIOR ELEVATIONS
BES A202 EXTERIOR ELEVATIONS
BES A351 PLAN AND SECTION DETAILS
BES A401 ROOF PLAN AND DETAILS
BES A601 ENLARGED PLAN AND INTERIOR ELEVATIONS
BES A602 ENLARGED PLAN AND INTERIOR ELEVATIONS



ARCHITECTURAL DRAWINGS

BES A651 CASEWORK DETAILS
BES A811 REFLECTED CEILING PLAN - FIRST FLOOR AREA A
BES A812 REFLECTED CEILING PLAN - FIRST FLOOR AREA B
BES A901 DOOR, WINDOW, & STOREFRONT DETAILS

ARCHITECTURAL FINISH DRAWINGS

BES AF001 MATERIAL SCHEDULE
BES AF002 SIGNAGE TYPES AND SCHEDULE
BES AF111 ENLARGED FLOOR FINISHES PLAN - FIRST FLOOR - AREA A
BES AF112 ENLARGED FLOOR FINISHES PLAN - FIRST FLOOR - AREA B

FURNITURE DRAWINGS

BES FE111 FLOOR FURNITURE PLAN - FIRST FLOOR - AREA A

PLUMBING GENERAL DRAWINGS

BES P001 PLUMBING NOTES, SCHEDULE, LEGEND, & DETAILS

PLUMBING DEMOLITION DRAWINGS

BES PD111 PLUMBING DEMOLITION PLAN - PART 1
BES PD112 PLUMBING DEMOLITION PLAN - PART 2

PLUMBING DRAWINGS

BES P111 PLUMBING PLAN - PART 1
BES P112 PLUMBING PLAN - PART 2

MECHANICAL GENERAL DRAWINGS

BES M001 MECHANICAL NOTES, LEGENDS, SCHEDULES & DETAILS
BES M002 MECHANICAL SCHEDULES & DETAILS

MECHANICAL DEMOLITON DRAWINGS

BES MD111 MECHANICAL DEMOLITION PLAN - PART 1
BES MD112 MECHANICAL DEMOLITION PLAN - PART 2

MECHANICAL DRAWINGS

BES M111 MECHANICAL PLAN - PART 1
BES M112 MECHANICAL PLAN - PART 2

BES M201 MECHANICAL ROOF PLAN 

MECHANICAL DRAWINGS

ELECTRICAL GENERAL DRAWINGS

BES E001 ELECTRICAL NOTES, LEGENDS, SCHEDULES & DETAILS

ELECTRICAL DEMOLITION DRAWINGS

BES ED111 ELECTRICAL DEMOLITION PLAN - PART 1

BES ED112 ELECTRICAL DEMOLITION PLAN - PART 2

ELECTRICAL DRAWINGS

BES E111 ELECTRICAL PLAN - PART 1

BES E112 ELECTRICAL PLAN - PART 2

BES E201 ELECTRICAL ROOF PLAN



BES E211 LIGHTING PLAN - PART 1

BES E212 LIGHTING PLAN - PART 2

VOLUME 02 OF 08 - EAST COLDENHAM ELEMENTARY SCHOOL (ECES)

GENERAL DRAWINGS

ECES G000 COVER & SHEET INDEX

ECES G001 SYMBOLS, ABBREVIATIONS, MISC, AND PARTITION TYPES

ECES G111 OVERALL FLOOR PLAN - FIRST FLOOR

LIFE SAFETY DRAWINGS

ECES LS111 LIFE SAFETY PLAN - FIRST FLOOR

ECES LS112 SMOKE ZONE PLANS

HAZARDOUS MATERIALS DRAWINGS

ECES AA100 ASBESTOS ABATEMENT FIRST FLOOR AREA A

ARCHITECTURAL DEMOLITION DRAWINGS

ECES AD111 ENLARGED REMOVAL PLAN AND RCP

ARCHITECTURAL DRAWINGS

ECES A111 ENLARGED FLOOR PLAN, RCP AND DETAILS

ECES A201 EXTERIOR ELEVATIONS

ECES A202 EXTERIOR ELEVATIONS

ARCHITECTURAL DRAWINGS

ECES A901 DOOR, WINDOW, & STOREFRONT DETAILS

ARCHITECTURAL FINISH DRAWINGS

ECES AF001 SIGNAGE TYPES AND SCHEDULE

MECHANICAL GENERAL DRAWINGS

ECES M001 MECHANICAL NOTES, LEGENDS, SCHEDULES & DETAILS

MECHANICAL DEMOLITION DRAWINGS

ECES MD111 MECHANICAL DEMOLITION PLAN

MECHANICAL DRAWINGS

ECES M111 MECHANICAL PLAN

ELECTRICAL GENERAL DRAWINGS

ECES E001 ELECTRICAL NOTES, LEGENDS, DETAILS & SCHEDULES

ELECTRICAL DEMOLITION DRAWINGS

ECES ED111 ELECTRICAL DEMOLITION PLAN

ELECTRICAL DRAWINGS

ECES E111 ELECTRICAL PLAN

VOLUME 03 OF 08 - MONTGOMERY ELEMENTARY SCHOOL (MES)

GENERAL DRAWINGS

MES G000 COVER & SHEET INDEX

MES G001 SYMBOLS, ABBREVIATIONS, MISC, AND PARTITION TYPES

MES G111 OVERALL FLOOR PLAN - FIRST FLOOR

LIFE SAFETY DEMOLITION DRAWINGS

MES LS111 FIRST FLOOR LIFE SAFETY PLAN

MES LS112 SMOKE ZONE PLANS

HAZARDOUS MATERIALS DRAWINGS

MES AA100 ASBESTOS ABATEMENT FIRST FLOOR AREA C

ARCHITECTURAL DEMOLITION DRAWINGS

MES AD111 ENLARGED REMOVAL PLAN - FIRST FLOOR - AREA C

ARCHITECTURAL DRAWINGS

MES A111 ENLARGED NEW WORK PLAN - FIRST FLOOR - AREA C

MES A201 EXTERIOR ELEVATIONS

MES A202 EXTERIOR ELEVATIONS

MES A811 REFLECTED CEILING PLAN - FIRST FLOOR - AREA C

MES A901 DOOR, WINDOW, & STOREFRONT DETAILS

ARCHITECTURAL FINISH DRAWINGS

MES AF001 SIGNAGE TYPES AND SCHEDULE

MES AF111 MATERIAL SCHEDULE & FLOOR FINISHES PLAN - AREA C

PLUMBING DRAWINGS

MES P001 PLUMBING NOTES, SCHEDULE, LEGEND & DETAILS

PLUMBING DRAWINGS

MES P111 PLUMBING PLANS

MECHANICAL GENERAL DRAWINGS

MES M001 MECHANICAL NOTES, LEGENDS, SCHEDULES & DETAILS

MECHANICAL DEMOLITION DRAWINGS

MES MD111 MECHANICAL DEMOLITION PLAN

MECHANICAL DRAWINGS

MES M111 MECHANICAL PLAN

ELECTRICAL GENERAL DRAWINGS

MES E001 ELECTRICAL NOTES, LEGEND, SCHEDULES & DETAILS

ELECTRICAL DEMOLITION DRAWINGS

MES ED111 ELECTRICAL DEMOLITION PLAN

ELECTRICAL DRAWINGS

MES E111 ELECTRICAL PLAN

VOLUME 04 OF 08 - MAYBROOK ALTERNATIVE LEARNING CENTER (MAY)

GENERAL DRAWINGS

MAY G000 COVER & SHEET INDEX
MAY G001 SYMBOLS, ABBREVIATIONS, MISC, AND PARTITION TYPES
MAY G111 OVERALL FLOOR PLAN - FIRST FLOOR

LIFE SAFETY DRAWINGS

MAY LS111 LIFE SAFETY PLAN - FIRST FLOOR
MAY LS112 SMOKE ZONE PLANS

HAZARDOUS MATERIALS DRAWINGS

MAY AA100 ASBESTOS ABATEMENT FIRST FLOOR AREA A

ARCHITECTURAL DEMOLITION DRAWINGS

MAY AD121 ENLARGED REMOVAL PLAN - FIRST FLOOR - AREA A
MAY AD821 REFLECTED CEILING REMOVAL PLAN - FIRST FLOOR - AREA A

ARCHITECTURAL DRAWINGS

MAY A121 ENLARGED FLOOR PLAN - FIRST FLOOR - AREA A
MAY A821 REFLECTED CEILING PLAN - FIRST FLOOR - AREA A
MAY A901 DOOR & WINDOW DETAILS

ARCHITECTURAL FINISH DRAWINGS

MAY AF001 SIGNAGE TYPES AND SCHEDULE
MAY AF121 MATERIAL SCHEDULE & FINISH FLOOR PLAN - AREA A

FURNITURE DRAWINGS

MAY FE121 PARTIAL FURNITURE PLAN - FIRST FLOOR - AREA A

MECHANICAL GENERAL DRAWINGS

MAY M001 MECHANICAL NOTES, LEGENDS, SCHEDULES & DETAILS

MECHANICAL DEMOLITION DRAWINGS

MAY MD111 MECHANICAL DEMOLITION PLAN

MECHANICAL DRAWINGS

MAY M111 MECHANICAL PLAN

ELECTRICAL GENERAL DRAWINGS

MAY E001 ELECTRICAL NOTES, LEGENDS, SCHEDULES & DETAILS

ELECTRICAL DEMOLITION DRAWINGS

MAY ED111 ELECTRICAL DEMOLITION PLAN

ELECTRICAL DRAWINGS

MAY E111 ELECTRICAL PLAN

VOLUME 05 OF 08 - VALLEY CENTRAL HIGH SCHOOL (VCHS)

GENERAL DRAWINGS

VCHS G000 COVER & SHEET INDEX
VCHS G001 SYMBOLS, ABBREVIATIONS, MISC, AND PARTITION TYPES
VCHS G101 OVERALL FLOOR PLAN - BASEMENT
VCHS G111 OVERALL FLOOR PLAN - FIRST FLOOR
VCHS G121 OVERALL FLOOR PLAN - SECOND FLOOR
VCHS G401 OVERALL ROOF PLAN

LIFE SAFETY DRAWINGS

VCHS LS101 BASEMENT LIFE SAFETY PLAN
VCHS LS111 FIRST FLOOR LIFE SAFETY PLAN
VCHS LS112 SMOKE ZONE PLANS

HAZARDOUS MATERIALS DRAWINGS

VCHS AA100 ASBESTOS ABATEMENT FIRST FLOOR AREA C
VCHS AA200 ASBESTOS ABATEMENT SECOND FLOOR AREA C



ARCHITECTURAL DEMOLITION DRAWINGS

VCHS AD111 FIRST FLOOR REMOVAL PLAN - AREA A
VCHS AD112 FIRST FLOOR REMOVAL PLAN - AREA C & D

ARCHITECTURAL DEMOLITION DRAWINGS

VCHS AD401 ROOF REMOVAL PLAN - AREA C & D
VCHS AD802 REFLECTED CEILING REMOVAL PLAN - AREA C & D

ARCHITECTURAL DRAWINGS

VCHS A101 BOILER ROOM PLANS AND DETAILS
VCHS A111 ENLARGED VESTIBULE PLAN, SECTION AND DETAILS
VCHS A112 AREA C & D - FIRST FLOOR NEW WORK PLAN
VCHS A201 EXTERIOR ELEVATIONS
VCHS A202 EXTERIOR ELEVATIONS
VCHS A402 ROOF PLAN - AREA A, C, & D
VCHS A801 REFLECTED CEILING PLAN AND CEILING DETAIL - AREA A
VCHS A802 FIRST FLOOR REFLECTED CEILING PLAN - AREA C & D
VCHS A901 DOOR, WINDOW, & STOREFRONT DETAILS

ARCHITECTURAL FINISH DRAWINGS

VCHS AF001 MATERIAL SCHEDULE
VCHS AF002 SIGNAGE TYPES AND SCHEDULE
VCHS AF112 AREA C & D - FLOOR FINISHES PLAN

PLUMBING GENERAL DRAWINGS

VCHS P001 PLUMBING NOTES, SCHEDULE, LEGEND & DETAILS

PLUMBING DEMOLITION DRAWINGS

VCHS PD301 BOILER ROOM PLUMBING DEMOLITION PLAN

PLUMBING DRAWINGS

VCHS P301 PLUMBING PLAN

MECHANICAL GENERAL DRAWINGS

VCHS M001 MECHANICAL NOTES, LEGEND, SCHEDULE & DETAILS
VCHS M002 MECHANICAL SCHEDULES
VCHS M003 MECHANICAL SCHEDULES
VCHS M004 MECHANICAL DETAILS
VCHS M005 TEMPERATURE CONTROLS NOTES, LEGEND & SCHEMATICS
VCHS M006 MECHANICAL PIPING DIAGRAMS

MECHANICAL DEMOLITION DRAWINGS

VCCHS MD111 MECHANICAL DEMOLITION PLAN
VCCHS MD211 MECHANICAL DEMOLITON PLAN - PART 1
VCCHS MD212 MECHANICAL DEMOLITION PLAN - PART 2
VCCHS MD301 MECHANICAL DEMOLITION PLAN

MECHANICAL DRAWINGS

VCCHS M111 SECURITY VESTIBULE MECHANICAL PLAN
VCCHS M211 MECHANICAL PLAN - PART 1
VCCHS M212 MECHANICAL PLAN - PART 2
VCCHS M301 MECHANICAL PLAN

ELECTRICAL GENERAL DRAWINGS

VCCHS E001 ELECTRICAL NOTES, LEGEND, DETAILS & SCHEDULES
VCCHS E002 ELECTRICAL PANEL SCHEDULES

ELECTRICAL DEMOLITION DRAWINGS

VCCHS ED111 ELECTRICAL DEMOLITION PLAN
VCCHS ED211 ELECTRICAL DEMOLITION PLAN
VCCHS ED301 ELECTRICAL DEMOLITION PLAN

ELECTRICAL DRAWINGS

VCCHS E111 ELECTRICAL PLAN
VCCHS E211 ELECTRICAL PLAN
VCCHS E301 ELECTRICAL PLAN

VOLUME 06 OF 08 - VALLEY CENTRAL MIDDLE SCHOOL (VCMS)

GENERAL DRAWINGS

VCMS G000 COVER & SHEET INDEX
VCMS G001 SYMBOLS, ABBREVIATIONS, MISC, AND PARTITION TYPES
VCMS G111 OVERALL FLOOR PLAN - FIRST FLOOR

LIFE SAFETY DRAWINGS

VCMS LS101 LIFE SAFETY PLANS
VCMS LS102 SMOKE ZONE PLANS

HAZARDOUS MATERIALS DRAWINGS

VCMS AA100 ASBESTOS ABATEMENT FIRST FLOOR AREA A

ARCHITECTURAL DEMOLITION DRAWINGS

VCMS AD111 ENLARGED REMOVAL PLAN - FIRST FLOOR - AREA A

ARCHITECTURAL DRAWINGS

VCMS A111 ENLARGED FLOOR PLANS AND SECTION - AREA A

VCMS A201 EXTERIOR ELEVATIONS

VCMS A202 EXTERIOR ELEVATIONS

VCMS A811 REFLECTED CEILING PLAN - FIRST FLOOR - AREA A

VCMS A901 DOOR, WINDOW, & STOREFRONT DETAILS

ARCHITECTURAL FINISH DRAWINGS

VCMS AF001 SIGNAGE TYPES AND SCHEDULE

MECHANICAL GENERAL DRAWINGS

VCMS M001 MECHANICAL NOTES, LEGENDS, SCHEDULES & DETAILS

MECHANICAL DEMOLITION DRAWINGS

VCMS MD111 MECHANICAL DEMOLITION PLAN

MECHANICAL DRAWINGS

VCMS M111 MECHANICAL PLAN

ELECTRICAL GENERAL DRAWINGS

VCMS E001 ELECTRICAL NOTES, LEGENDS, & SCHEDULES

ELECTRICAL DEMOLITION DRAWINGS

VCMS ED111 ELECTRICAL DEMOLITION PLAN

ELECTRICAL DRAWINGS

VCMS E111 ELECTRICAL PLAN

VOLUME 07 OF 08 - WALDEN ELEMENTARY SCHOOL (WES)

GENERAL DRAWINGS

WES	G000	COVER & SHEET INDEX
WES	G001	SYMBOLS, ABBREVIATIONS, AND MISC
WES	G111	OVERALL FLOOR PLAN - FIRST FLOOR
WES	G121	OVERALL FLOOR PLAN - SECOND FLOOR

LIFE SAFETY DRAWINGS

WES	LS101	LIFE SAFETY PLANS
WES	LS102	SMOKE ZONE PLANS

HAZARDOUS MATERIALS DRAWINGS

WES	AA100	ASBESTOS ABATEMENT FIRST FLOOR AREA C
-----	-------	---------------------------------------

ARCHITECTURAL DEMOLITION DRAWINGS

WES	AD111	REMOVAL PLANS - FIRST & SECOND FLOOR
-----	-------	--------------------------------------

STRUCTURAL DRAWINGS

WES	S100	STRUCTURAL NOTES, PLANS, AND DETAILS
-----	------	--------------------------------------

ARCHITECTURAL DRAWINGS

WES	A111	NEW WORK PLANS - FIRST AND SECOND FLOOR
WES	A601	ELEVATIONS AND SECTIONS
WES	A651	CASEWORK DETAILS
WES	A701	PARTITION TYPES
WES	A702	PARTITION TYPES
WES	A811	REFLECTED CEILING PLANS, DEMO PLANS, AND DETAILS
WES	A901	DOOR, WINDOW, & STOREFRONT DETAILS

ARCHITECTURAL FINISH DRAWINGS

WES	AF001	SIGNAGE TYPES AND SCHEDULE
WES	AF111	MATERIAL SCHEDULE, FURNITURE, AND FLOOR FINISH PLANS

PLUMBING GENERAL DRAWINGS

WES	P001	PLUMBING NOTES, SCHEDULE, LEGEND & DETAILS
-----	------	--

PLUMBING DRAWINGS

WES	P111	PLUMBING PLANS
-----	------	----------------

MECHANICAL GENERAL DRAWINGS

WES M001 MECHANICAL NOTES, LEGENDS, SCHEDULES & DETAILS

MECHANICAL DEMOLITION DRAWINGS

WES MD111 MECHANICAL DEMOLITION PLANS

MECHANICAL DRAWINGS

WES M111 MECHANICAL PLANS

ELECTRICAL GENERAL DRAWINGS

WES E001 ELECTRICAL NOTES, LEGENDS, SCHEDULES & DETAILS

ELECTRICAL DEMOLITION DRAWINGS

WES ED111 ELECTRICAL DEMOLITION PLANS

ELECTRICAL DRAWINGS

WES E111 ELECTRICAL PLANS

VOLUME 08 OF 08 - ADMINISTRATION BUILDING (ADMIN)

GENERAL DRAWINGS

ADMIN G000 COVER & SHEET IN

ADMIN G001 SYMBOLS, ABBREVIATIONS, AND MISC.

ARCHITECTURAL DRAWINGS

ADMIN A101 OVERALL FLOOR PLAN

PLUMBING GENERAL DRAWINGS

ADMIN P001 PLUMBING NOTES, LEGEND & DETAILS

PLUMBING DRAWINGS

ADMIN P111 PLUMBING PLANS

MECHANICAL GENERAL DRAWINGS

ADMIN M001 MECHANICAL NOTES, LEGEND, SCHEDULES & DETAILS

MECHANICAL DRAWINGS

ADMIN M111 MECHANICAL PLANS

ELECTRICAL GENERAL DRAWINGS

ADMIN E001 ELECTRICAL NOTES, LEGENDS, & SCHEDULES

ELECTRICAL DRAWINGS

ADMIN E111 ELECTRICAL PLANS

END OF SECTION

This page intentionally left blank

Phase 1, Contractor Coordination Notes for Siemens controls, 11-18-2024

Berea Elementary School:

Heat Pump and Indoor Units, VRF System

1. Siemens shall provide Indoor unit Thermostat installation and wiring
2. Siemens shall provide inter-connecting control wiring between indoor units and outdoor unit and VRF BACnet controller

VAV Terminal Unit with HW Reheat

1. Mechanical contractor to install control valve furnished by Siemens
2. Electrical contractor to provide 120V power wiring to each VAV terminal unit as shown Electrical drawings

Duct Reheat Coil

1. Mechanical contractor to install control valve furnished by Siemens

Energy Recovery Ventilator

1. Siemens shall provide fire-alarm shut-down interconnect wiring
2. Siemens shall provide area/room sensor installation and wiring
3. Siemens shall provide BACnet communications wiring to Siemens Supervisory control panel

Maybrook Alternative Learning Center:

Split AC-unit

1. Siemens shall provide indoor unit Thermostat installation and wiring
2. Siemens shall provide inter-connecting control wiring between indoor units and outdoor units

FCU Outdoor Air Intake Damper

1. Siemens shall furnish, install and wire damper actuator

Montgomery Elementary School:

Split AC-unit

1. Siemens shall provide Indoor unit Thermostat installation and wiring
2. Siemens shall provide inter-connecting control wiring between indoor units and outdoor units

FCU Outdoor Air Intake Damper

1. Siemens shall furnish, install and wire damper actuator

Valley Central Middle School

Split AC-unit

1. Siemens shall provide indoor unit Thermostat installation and wiring
2. Siemens shall provide inter-connecting control wiring between indoor units and outdoor units

Hot Water Unit Heaters

1. Mechanical contractor to install control valve furnished by Siemens

SECTION 012100 - ALLOWANCES

PART 1 GENERAL

1.1 RELATED DOCUMENTS

- A. Drawings and general provisions of the Contract, including General and Supplementary Conditions and other Division 01 Specification Sections, apply to this Section.

1.2 SUMMARY

- A. Section includes administrative and procedural requirements governing allowances.
 - 1. Certain items are specified in the Contract Documents by allowances. Allowances have been established in lieu of additional requirements and to defer selection of actual materials and equipment to a later date when direction will be provided to Contractor.
- B. Types of allowances include the following:
 - 1. Contingency Allowances

1.3 INFORMATIONAL SUBMITTALS

- A. Submit invoices or delivery slips to show actual quantities of materials delivered to the site for use in fulfillment of each allowance cost proposal.
- B. Submit time sheets and other documentation to show labor time and cost for installation of allowance items that include installation as part of the allowance cost proposal.
- C. Coordinate and process submittals for allowance items in same manner as for other portions of the Work.

1.4 COORDINATION

- A. Coordinate allowance items with other portions of the Work. Furnish templates as required to coordinate installation.

1.5 ALLOWANCES

- A. Use the allowance only as directed by Architect for Owner's purposes and only by change documentation that indicate amounts to be charged against the allowance.

- B. Contractor's overhead, administrative expenses, project management, profit, and related costs for labor, products and equipment ordered by Owner under allowances are to be included within the allowance, and thereby included in the Contract Sum.
- C. Change Orders authorizing use of allowances will include all related Contractor's costs including but not limited to, procurement, installation, insurance, equipment rental, and similar costs as applicable to the specific allowance.

1.6 ADJUSTMENT OF ALLOWANCES

- A. Allowance Adjustment: To adjust allowances, the Architect will prepare a Change Order reflective of approved costs, utilizing Unit Prices if applicable, that will result in Allowance Remaining, if any.
 - 1. Contractor shall include installation costs in purchase amount only where indicated as part of the proposal request.
 - 2. Owner reserves the right to establish the quantity of work-in-place by independent quantity survey, measure, or count.
 - 3. At Project closeout, credit unused amounts remaining in the allowance to Owner by deductive credit Change Order.
- B. Contractor shall submit claims for increased costs because of a change in scope or nature of the allowance described in the Contract Documents, whether for the purchase order amount or Contractor's work.
 - 1. Contractor shall not include Contractor's or subcontractors' indirect expense in the cost proposal amount unless it is clearly shown that the nature or extent of work has changed from what could have been foreseen from information in the Contract Documents.
 - 2. No change to Contractor's indirect expense is permitted for selection of higher- or lower-priced materials or systems of the same scope and nature as originally indicated.

PART 2 PRODUCTS (NOT USED)

PART 3 EXECUTION

3.1 SCHEDULE OF ALLOWANCES:

A. The following Contingency Allowances shall be included in the Base Bid value for each respective Contract:

- 1. For Contract No. 1-01 – General and Abatement Construction (GAC):
 - a. Contingency Allowance No. **CA-GAC-1-01-001**: General and Abatement Construction Contingency Allowance for work at all buildings in the amount of \$50,000.00 lump sum.



2. For Contract No. 1-02 – Mechanical and Plumbing Construction (MPC):
 - a. Contingency Allowance No. **CA-MPC-1-02-001**: Mechanical and Plumbing Construction Contingency Allowance for work at all buildings in the amount of \$40,000.00 lump sum.
3. For Contract No. 1-03 – Electrical Construction (EC):
 - a. Contingency Allowance No. **CA-EC-1-03-001**: Electrical Construction Contingency Allowance for work at all buildings in the amount of \$35,000.00 lump sum.

END OF SECTION

This page intentionally left blank

SECTION 012300 - ALTERNATES

PART 1 GENERAL

1.1 RELATED DOCUMENTS

- A. Drawings and general provisions of the Contract, including General and Supplementary Conditions and other Division 01 Specification Sections, apply to this Section.

1.2 SUMMARY

- A. Section includes administrative and procedural requirements for alternates.

1.3 DEFINITIONS

- A. Alternate: An amount proposed by bidders and stated on the Bid Form for certain work defined in the bidding requirements that may be added to or deducted from the base bid amount if Owner decides to accept a corresponding change either in the amount of construction to be completed or in the products, materials, equipment, systems, or installation methods described in the Contract Documents.
 - 1. Alternates described in this Section are part of the Work only if enumerated in the Agreement.
 - 2. The cost or credit for each alternate is the net addition to or deduction from the Contract Sum to incorporate alternate into the Work. No other adjustments are made to the Contract Sum.

1.4 PROCEDURES

- A. Coordination: Revise or adjust affected adjacent work as necessary to completely integrate work of the alternate into Project.
 - 1. Include as part of each alternate, miscellaneous devices, accessory objects, and similar items incidental to or required for a complete installation whether indicated as part of alternate or not.
- B. Notification: Immediately following award of the Contract, notify each party involved, in writing, of the status of each alternate. Indicate if alternates have been accepted, rejected, or deferred for later consideration. Include a complete description of negotiated revisions to alternates.
- C. Execute accepted alternates under the same conditions as other work of the Contract.

- D. Schedule: A schedule of alternates is included at the end of this Section. Specification Sections referenced in schedule contain requirements for materials necessary to achieve the work described under each alternate.

PART 2 PRODUCTS (NOT USED)

PART 3 EXECUTION

3.1 SCHEDULE OF ALTERNATES

A. Each Prime Contractor shall provide value for each Alternate where indicated on the Bid Form for each respective Contract:

1. For Contract No. 1-01 – General and Abatement Construction (GAC):
 - a. ADD Alternate No. **ALT-GAC-1-01-001**: For all General and Abatement Construction work at Walden Elementary School.
2. For Contract No. 1-02 – Mechanical and Plumbing Construction (MPC):
 - a. ADD Alternate No. **ALT-MPC-1-02-001**: For all Mechanical and Plumbing Construction work at Walden Elementary School.
3. For Contract No. 1-03 – Electrical Construction (EC):
 - a. ADD Alternate No. **ALT-EC-1-03-001**: For all Electrical Construction work at Walden Elementary School.



END OF SECTION

SECTION 283100 - FIRE DETECTION AND ALARM

PART 1 GENERAL

1.1 SUMMARY

- A. Section includes:
1. Fire-alarm control panel (FACP).
 2. Manual fire alarm pull stations.
 3. System smoke detectors.
 4. Carbon Monoxide detectors.
 5. Heat detectors.
 6. Beam Smoke detectors.
 7. Notification appliances.
 8. Magnetic door holders.
 9. Fire Alarm Annunicator Panel (FAAP).
 10. Addressable interface device.
 11. Digital alarm communicator transmitter.
 12. Network communications.
 13. System printer.
 14. Device Guards.

1.2 definitions

- A. EMT: Electrical Metallic Tubing.
- B. FACP: Fire Alarm Control Panel.
- C. HLI: High Level Interface.
- D. NICET: National Institute for Certification in Engineering Technologies.
- E. PC: Personal computer.
- F. VESDA: Very Early Smoke-Detection Apparatus.

1.3 SUBMITTALS

- A. Product Data: For each type of product, including finished options and accessories.
1. Include construction details, material descriptions, dimensions, profiles and finishes.
 2. Include rated capacities, operating characteristics, and electrical characteristics.
- B. Shop Drawings: For fire alarm system:

1. Floor plans (minimum 1/8-inch scale) with room names and numbers, showing device locations and interconnecting conduit and wire. Include location of fire/smoke rated or barrier walls.
2. Drawings shall show proposed layout and anchorage of equipment and appurtenances and equipment relationship to other parts of the work, including clearances for maintenance and operation.
3. Scaled detail drawings of FACP and FAAP panel fronts.
4. Wiring diagram for each device. Include connection details to auxiliary equipment.
5. Riser diagram showing devices, equipment, and interconnecting conduit and wire. Indicate points of connection to other equipment such as, damper actuators, kitchen hood fire protection systems, pre-action fire protection systems, clean agent fire protection systems, elevator machine rooms and shafts, electric door locking hardware, fire door releases, magnetic door holders, and other related devices and equipment.
6. Complete narrative of the sequence of operation.
7. Sequence of operation matrix table including a complete line-by-line listing of fire alarm initiating devices, corresponding device address, and input/output matrix.
8. Voltage drop calculations.
9. Battery sizing calculations.
 - a. Visual alarm power supply sizing calculations.
10. Power supply calculations for magnetic door holders, and electric door locking hardware.
11. Wire identification schedule.
12. Include statement from manufacturer that all equipment and components have been tested as a system and meet all requirements in this specification and in NFPA 72. All drawings must be stamped and signed by a Professional Engineer registered in New York State, for approval by the Fire Marshal and NYSED.

1.4 CLOSeOUT SUBMITtALS

- A. Operation and Maintenance Data: For fire-alarm systems and components to include in emergency, operation, and maintenance manuals. Include the following:
 1. Comply with the "Records" section of the "Inspection, Testing and Maintenance" chapter in NFPA 72.
 2. Provide "Fire Alarm and Emergency Communications System Record of Completion Documents" according to the "Completion Documents" Article in the "Documentation" section of the "Fundamentals" chapter in NFPA 72.
 3. Complete wiring diagrams showing connections between all devices and equipment. Each conductor shall be numbered at every junction point with indication of origination and termination points.
 4. Riser diagram.

5. Device addresses.
6. Record copy of site-specific software. This software shall also be in an electronic format to allow an alternate Authorized Distributor to add, change, or modify in any way, the existing system data base.
7. Provide "Inspection and Testing Form" according to the "Inspection, Testing and Maintenance" chapter in NFPA 72, and include the following:
 - a. Equipment tested.
 - b. Frequency of testing of installed components.
 - c. Frequency of inspection of installed components.
 - d. Requirements and recommendations related to results of maintenance.
 - e. Manufacturer's user training manuals.
8. Manufacturer's required maintenance related to system warranty requirements.
9. Abbreviated operating instructions for mounting at fire-alarm control unit and each annunciator unit.

1.5 QUALITY ASSURANCE

- A. Installer Qualifications: Personnel shall be trained and certified by manufacturer for installation of units required for this Project.
- B. Installer Qualifications: Installation shall be by personnel certified by NICET as fire alarm Level III technician.
- C. NFPA Certification: Obtain certification according to NFPA 72 by a UL-listed alarm company.
- D. Manufacturer and equipment supplier shall have a minimum of ten years' prior experience in New York State. Equipment supplier shall have 24-hour parts and labor service available with a maximum 4-hour response time. There shall be a minimum of 2 Independent Authorized Distributors within a 50-mile radius of project. Proprietary equipment shall not be acceptable.

1.6 PROJECT CONDITIONS

- A. Perform a full test of the existing system prior to starting to work. Document any equipment or components not functioning as designed.
- B. Use of Devices during Construction: Protect devices during construction unless devices are placed in service to protect the facility during construction.

1.7 SYSTEM ZONING

- A. Alarm Initiating Devices:
 1. Provide a separate, individual zone for each manual pull station, area smoke detector, duct smoke detector, area heat detector, and water flow switch.

- B. Fire Audible and Visual Alarm Strobes:
 - 1. Each floor of the building (above and below grade) shall be a separate, individual zone.
 - 2. Each stairwell shall be a separate, individual zone.
 - 3. Each exterior area shall be a separate individual zone.
- C. Fire Alarm Control zones:
 - 1. Air Handling Fan systems: Provide one (1) shutdown contact for each air handling fan systems. Contacts shall initiate the shutdown of fan system and closing of dampers on associated floor.
 - 2. Provide two (2) open/close contact for each floor's/zone's dampers grouped as a function of being in the supply or return air streams.
 - 3. Provide one (1) recall contact for each elevator control panel to recall elevator to ground floor.
 - 4. Provide one (1) release control contact for all door lock systems.
- D. Initiating and signaling device wiring circuits/loops/channels shall be loaded to no more than 80 percent (80%) capacity to allow for the installation of future devices.

1.8 WARRANTY

- A. Special Warranty: Manufacturer agrees to repair or replace fire-alarm system equipment and components that fail in materials or workmanship within specified warranty period.
 - 1. Warranty Extent: All equipment and components not covered in the Maintenance Service Agreement.
- B. Warranty Period: Three years from date of Substantial Completion.

PART 2 PRODUCTS

2.1 ACCEPTABLE MANUFACTURERS

- A. The existing fire alarm system in each building is listed below. All new fire detection and alarm system components shall be of the same manufacturer and must meet all requirements of the contract documents.
 - 1. *Valley Central High School/Middle School – Edwards EST3 Control Panel*
 - 2. *Berea Elementary School – Simplex 4010 Control Panel*
 - 3. *East Coldenham Elementary School – Simplex 4010 Control Panel*
 - 4. *Maybrook ALC – Simplex 4010ES Control Panel*
 - 5. *Montgomery Elementary School – Mircom FX-350 Control Panel*
 - 6. *Walden Elementary School – Simplex 4010 Control Panel*
 - 7. *Administration Building – Mircom FA-300 Control Panel*



B. Existing Fire Alarm Vendor Contact Info:
Sean Werlau
Open Systems Metro
(914) 241-0057 - Office
(914) 640-9314 - Mobile



C. Products for this project shall be of the latest design that has been in service for at least two (2) years, and no more than 4 years. Obsolete or discontinued models are not acceptable.

2.2 DESCRIPTION

- A. Fire alarm System shall be EST EST4 voice system.
- B. Fire alarm system infrastructure including conduit, wiring, backboxes, etc. and all associated labor and installation is in the scope of this contract.
- C. Shop drawings and submittal review/approval, testing and programming, project management and closeout documentation shall be by the fire alarm system manufacturer's authorized representative.
- D. Provide a microprocessor-controlled, electrically supervised fire alarm system in accordance with the Contract Documents. Provide detailed system design, all equipment, tools, drawings, labor, materials, accessories, and approvals from governing agencies required to furnish, install, start up, and test a complete operating fire alarm system. Systems shall be provided and placed into operation in accordance with the requirements of the Authority Having Jurisdiction (AHJ).
- E. Labor, materials including conduit and wiring, and accessories not specifically called for in the Contract Documents but required to provide complete, operating, and approved systems, shall be provided within the scope of this contract.
- F. Determine, coordinate, and incorporate the design and construction requirements of the architectural, structural, fire protection and mechanical systems, and auxiliary systems including food service, fire doors and windows, elevators, and other related systems, to fully meet all code requirements.
- G. The fire alarm system manufacturer and Contractor shall provide all required documentation, obtain all required permits and approvals, and shall provide all devices and accessories in the quantities and locations necessary for a fully functional and code-compliant system.
- H. Programming of system shall be based on final room names and numbers, which may not necessarily be the same as those used on the construction documents.

- I. Noncoded, UL-certified addressable system, with multiplexed signal transmission and voice/strobe evacuation.
- J. The Fire Alarm Control Panel (FACP) and Fire Alarm Annunciator Panel (FAAP) shall be connected in a network configuration to become components for a distributed intelligence system.
- K. The fire detection and alarm system shall be the fully addressable type. Each fire alarm initiating device shall be a separate, individual zone. Provide interface modules to connect non-addressable devices to addressable wiring channels.
- L. All components provided shall be listed for use with the selected system.
- M. Electrical Components, Devices, and Accessories: Listed and labeled as defined in NFPA 70, by a qualified testing agency, and marked for intended location and application.

2.3 SYSTEMS OPERATIONAL DESCRIPTION

- A. Fire alarm signal initiation shall be by one or more of the following devices and systems:
 - 1. Manual pull stations.
 - 2. Heat detectors.
 - 3. Smoke detectors.
 - 4. Duct smoke detectors.
 - 5. Waterflow Switch.
- B. Fire alarm signal shall initiate the following actions:
 - 1. Continuously operate alarm notification appliances, including voice evacuation notices.
 - 2. Identify alarm and specific initiating device at FACP, connected network control panels, off-premises network control panels, and remote annunciators.
 - 3. Indicate device in alarm on the graphic annunciator.
 - 4. Transmit an alarm signal to the remote alarm receiving station.
 - 5. Unlock electric door locks in designated egress paths.
 - 6. Release fire and smoke doors held open by magnetic door holders.
 - 7. Activate voice/alarm communication system.
 - 8. Switch heating, ventilating, and air-conditioning equipment controls to fire alarm mode.
 - 9. Close smoke dampers in air ducts of designated air conditioning duct systems.
 - 10. Activate emergency shutoffs for gas and fuel supplies.
 - 11. Record events in the system memory.
- C. Detection of carbon monoxide by a carbon monoxide detector shall:
 - 1. Activate a distinct carbon monoxide alarm at the FACP.

- a. Carbon monoxide signal shall be a separate and distinct signal from the fire alarm system.
 2. Activate distinct local carbon monoxide visual/audible notification appliances for associated carbon monoxide detector in alarm condition.
 3. Activate carbon monoxide detector sounder base (if present).
 4. Send a distinct carbon monoxide detector supervisory signal to central office.
- D. Supervisory signal initiation shall be by one or more of the following devices and actions:
1. Independent fire detection and suppression systems.
 2. User disabling of zones or individual devices.
 3. Loss of communication with any panel on the network.
- E. System trouble signal initiation shall be by one or more of the following devices and actions:
1. Open circuits, shorts, and grounds in designated circuits.
 2. Opening, tampering with, or removing alarm-initiating and supervisory signal-initiating devices.
 3. Loss of communication with any addressable sensor, input module, relay, control module, remote annunciator, printer interface, or Ethernet module.
 4. Loss of primary power at FACP.
 5. Ground or a single break in internal circuits of FACP.
 6. Abnormal AC voltage at FACP.
 7. Break in standby battery circuitry.
 8. Failure of battery charging.
 9. Abnormal position of any switch at FACP or annunciator.
 10. Voice signal amplifier failure.
- F. System Supervisory Signal Actions:
1. Identify specific device initiating the event at FACP, off-premises network control panels, and remote annunciators.
 2. After a time delay of 200 seconds, transmit a trouble or supervisory signal to the remote alarm receiving station.
 3. Display system status on FAAP.
- 2.4 FIRE ALARM CONTROL Panel (FACP)
- A. General Requirements for FACP:
1. Field-programmable, microprocessor-based, modular, power-limited design with electronic modules, complying with UL 864.
 - a. System software and programs shall be held in nonvolatile flash, electrically erasable, programmable, read-only memory, retaining the information through failure of primary and secondary power supplies.

- b. Include a real-time clock for time annotation of events on the event recorder and printer.
 - c. Provide communication between the FACP and remote circuit interface panels, annunciators, and displays.
 - d. The FACP shall be listed for connection to a central station signaling system service.
 - e. Provide nonvolatile memory for system database, logic, and operating system and event history. The system shall require no manual input to initialize in the event of a complete power down condition. The FACP shall provide a minimum 500-event history log.
2. Addressable Initiation Device Circuits: The FACP shall indicate which communication zones have been silenced and shall provide selective silencing of alarm notification appliance by building communication zone.
 3. Addressable Control Circuits for Operation of Notification Appliances and Mechanical Equipment: The FACP shall be listed for releasing service.
- B. Alphanumeric Display and System Controls: Arranged for interface between human operator at FACP and addressable system components including annunciation and supervision. Display alarm, supervisory, and component status messages and the programming and control menu.
1. Annunciator and Display: Liquid-crystal type, three line(s) of 80 characters, minimum.
 2. Keypad: Arranged to permit entry and execution of programming, display, and control commands and to indicate control commands to be entered into the system for control of smoke-detector sensitivity and other parameters.
- C. Initiating Device, Notification Appliance, and Signaling Line Circuits:
1. Pathway Class Designations: NFPA 72, Class B.
 2. Pathway Survivability: Level 0. Staged evacuation Level 2 or 3.
 3. Install no more than 100 addressable devices on each signaling-line circuit.
 4. Serial Interfaces:
 - a. One dedicated RS 485 port for remote station operation using point ID DACT.
 - b. One RS 485 port for remote annunciators, Ethernet module, or multi-interface module (printer port).
 - c. One USB or RS 232 port for PC configuration.
 - d. One RS 232 port for VESDA HLI connection.
 - e. One RS 232 port for voice evacuation interface.
- D. Smoke Alarm Verification:
1. Smoke alarm verification shall not be enabled.
- E. Elevator recall shall be initiated only by one of the following alarm-initiating devices:
1. Elevator lobby detectors except the lobby detector on the designated floor.

2. Smoke detector in elevator machine room.
 3. Smoke detectors in elevator hoistway.
 4. Waterflow switch activation.
 5. Elevator controller shall be programmed to move the cars to the alternate recall floor if lobby detectors located on the designated recall floors are activated.
 6. Water-flow alarm connected to sprinkler in an elevator shaft and elevator machine room shall shut down elevators associated with the location without time delay.
 7. Water-flow switch associated with the sprinkler in the elevator pit may have a delay to allow elevators to move to the designated floor.
- F. Notification Appliance Circuit:
1. Audible appliances shall sound in a three-pulse temporal pattern, as defined in NFPA 72.
 2. Where notification appliances provide signals to sleeping areas, the alarm signal shall be a 520-Hz square wave with an intensity 15 dB above the average ambient sound level or 5 dB above the maximum sound level, or at least 75 dBA, whichever is greater, measured at the pillow.
 3. Visual alarm appliances shall flash in synchronization where multiple appliances are in the same field of view, as defined in NFPA 72.
- G. Door Controls:
1. Door hold-open devices that are controlled by smoke detectors at doors in smoke-barrier walls shall be connected to fire alarm system.
- H. Remote Smoke-Detector Sensitivity Adjustment:
1. Controls shall select specific addressable smoke detectors for adjustment, display their current status and sensitivity settings, and change those settings. Allow controls to be used to program repetitive, time-scheduled, and automated changes in sensitivity of specific detector groups. Record sensitivity adjustments and sensitivity-adjustment schedule changes in system memory, and print out the final adjusted values on system printer.
- I. Transmission to Remote Alarm Receiving Station:
1. Automatically transmit alarm, supervisory, and trouble signals to a remote alarm station.
- J. Voice/Alarm Signaling Service: Central emergency communication system with redundant preamplifiers, amplifiers, and tone generators provided as a special module that is part of fire-alarm control unit.
1. Indicate number of alarm channels for automatic, simultaneous transmission of different announcements to different zones or for manual transmission of announcements by use of the central-control microphone. Amplifiers shall comply with UL 1711.
 - a. System shall provide a minimum of 8 digital audio channels.

- b. Allow the application of, and evacuation signal to, indicated number of zones and, at the same time, allow voice paging to the other zones selectively or in any combination.
 - c. Programmable tone and message sequence selection.
 - d. Standard digitally recorded messages for "Evacuation" and "All Clear."
 - e. Generate tones to be sequenced with audio messages of type recommended by NFPA 72 and that are compatible with tone patterns of notification-appliance circuits of fire-alarm control unit.
 2. Status Annunciator: Indicate the status of various voice/alarm speaker zones and the status of firefighters two-way telephone communications zones.
 3. Preamplifiers, amplifiers, and tone generators shall automatically transfer to backup units, on primary equipment failure.
 4. Primary Power: 24V DC obtained from 120V AC service and a power supply module. Initiating devices, notification appliances, signaling lines, trouble signals, supervisory signals supervisory and digital alarm communicator transmitters and digital alarm radio transmitters shall be powered by 24V DC source.
 5. Alarm current draw of entire fire alarm system shall not exceed 80 percent of the power-supply module rating.
 - K. Primary Power: 24-V dc obtained from 120-V ac service and a power supply module. Initiating device, notification appliances, signaling lines, trouble signals, supervisor signals, supervisory and digital alarm communicator transmitters and digital alarm radio transmitters shall be powered by 24- V dc source.
 - L. Secondary Power: Provide sufficient battery capacity to operate the entire system upon loss of power as required by NFPA 72 Section 10.6.7.2.1. Battery capacity shall be calculated for minimum 24 hours of capacity in nonalarm (standby) mode and then 15 minutes at maximum connected load after that time period for audio voice systems and 24/5 for non-audio systems. The on-site emergency power system shall not be used when sizing the battery supply. The system shall automatically transfer to the standby batteries upon power failure. Battery charging and recharging shall be automatic.
- 2.5 MANUAL FIRE ALARM PULL STATIONS (EST siga-270 SERIES)
- A. General Requirements: Comply with UL 38. Boxes shall be finished in red with molded, raised-letter operating instructions in contrasting color; shall show visible indication of operation; and shall be mounted on recessed outlet box. If indicated as surface mounted, provide manufacturer's surface back box.
 1. Single-action mechanism, pull-lever type; with integral addressable module arranged to communicate manual-station status (normal, alarm, or trouble) to FACP.
 2. Station Reset: Key-operated switch.

2.6 SYSTEM SMOKE DETECTORS (EST SIGA-PD)

A. General Requirements:

1. Comply with UL 268 and FM approved; operating at 24V DC, nominal, Photoelectric type.
2. Base Mounting: Detector and associated electronic components shall be mounted in a twist-lock module that connects to a fixed base. Provide terminals in the fixed base for connection to building wiring.
3. Self-Restoring: Detectors do not require resetting or readjustment after actuation to restore them to normal operation.
4. Integral Visual-Indicating Light: LED type, indicating detector alarm/power-on status.
5. Thirty (30) mesh insect screen and magnetically activated test.
6. Remote Control: Unless otherwise indicated, detectors shall be digital-addressable type, individually monitored at FACP for calibration, sensitivity, and alarm condition and individually adjustable for sensitivity by FACP.
 - a. Rate-of-rise temperature characteristic of combination smoke- and heat-detection units shall be selectable at FACP for 15 or 20 deg F per minute.
 - b. Multiple levels of detection sensitivity for each sensor.

B. Photoelectric Smoke Detectors:

1. Detector address shall be accessible from FACP and shall be able to identify the detector's location within the system and its sensitivity setting.
2. An operator at FACP, having the designated access level, shall be able to manually access the following for each detector:
 - a. Primary status.
 - b. Device type.
 - c. Present average value.
 - d. Present sensitivity selected.
 - e. Sensor range (normal, dirty, etc.).

C. Duct Smoke Detectors: Photoelectric type complying with UL 268A, 24V DC. (EST SIGA-SD)

1. Detector address shall be accessible from fire-alarm control unit and shall be able to identify the detector's location within the system and its sensitivity setting.
2. An operator at fire-alarm control unit, having the designated access level, shall be able to manually access the following for each detector:
3. Primary status.
4. Device type.
5. Present average value.
6. Present sensitivity selected.
7. Sensor range (normal, dirty, etc.).

8. Weatherproof Duct Housing Enclosure: NEMA 250, Type 4X; NRTL listed for use with the supplied detector for smoke detection in HVAC system ducts.
9. Duct detector and housing shall be calibrated and adjusted for sensitivity at the manufacturer's factor to U.L. standards. Detector and housing shall be self-compensating for the effect of air velocity, temperature, humidity and atmospheric pressure.
10. Each duct detector shall be provided with sampling tubes sized according to duct size, air velocity, and installation conditions.
11. Each duct detector shall be provided with remote alarm LED on a single gang plate, surface or flush mounted.

2.7 CARBON MONOXIDE DETECTORS (est siga-cod)

- A. General: Carbon monoxide detector listed for connection to fire-alarm system.
 1. Mounting: Adapter plate for outlet box mounting.
 2. Testable by introducing test carbon monoxide into the sensing cell.
 3. Detector shall provide alarm contacts and trouble contacts.
 4. Detector shall send trouble alarm when nearing end-of-life, power supply problems, or internal faults.
 5. Comply with UL 2075.
 6. Locate, mount, and wire according to manufacturer's written instructions.
 7. Provide means for addressable connection to fire-alarm system.
 8. Detector base shall provide a temporal 4 alarm signal.

2.8 HEAT DETECTORS (EST SIGA-HRD)

- A. General Requirements for Heat Detectors: Comply with UL 521.
 1. Temperature sensors shall test for and communicate the sensitivity range of the device.
- B. Heat Detector, Combination Type: Actuated by either a fixed temperature of 135 deg F or a rate of rise that exceeds 15 deg F per minute unless otherwise indicated.
 1. Mounting: Twist-lock base interchangeable with smoke-detector bases.
 2. Integral Addressable Module: Arranged to communicate detector status (normal, alarm, or trouble) to FACP.

2.9 BEAM smoke detector (EST 5000 SERIES)

- A. Shall be photoelectric, four-wire, 24 VDC transmitter and receiver (beam type) smoke detector and shall be field adjustable to U.L. Standards for sensitivity (20, 30, 40, 50, 60 and 70% beam obscuration).
- B. The transmitter unit shall utilize a solid-state infrared (IR), crystal locked beam source which shall enable the receiver unit to distinguish the detection beam from all types of

EFL, including fluorescent, mercury and sodium lighting.

- C. The detector receiver shall provide automatic digital compensation circuitry to adjust for dust accumulation, component aging and temperature changes and also be able to discriminate between smoke obscuration and beam interruption.
- D. The detector shall utilize solid-state components for long life reliability and provide a range of from thirty feet (30') to three hundred fifty feet (350') with the beam transmitter and receiver optics being adjustable $\pm 90^\circ$ in the horizontal plane and $\pm 10^\circ$ in the vertical plane.
- E. Detectors shall be listed for U.L. Standard 268.
- F. Detector Address: Accessible from fire-alarm control unit and able to identify the detector's location within the system and its sensitivity setting.
- G. An operator at fire-alarm control unit, having the designated access level, shall be able to manually access the following for each detector:
 - 1. Primary status.
 - 2. Device type.
 - 3. Present average value.
 - 4. Present sensitivity selected.
 - 5. Sensor range (normal, dirty, etc.).

2.10 NOTIFICATION APPLIANCES (EST genesis series)

- A. General Requirements for Notification Appliances: Connected to notification-appliance signal circuits, zoned as indicated, equipped for mounting as indicated, and with screw terminals for system connections.
 - 1. Combination Devices: Factory-integrated audible and visible devices in a single-mounting assembly, equipped for mounting as indicated, and with screw terminals for system connections.
- B. Horns: Electric-vibrating-polarized type, 24-V dc; with provision for housing the operating mechanism behind a grille. Comply with UL 464. Horns shall produce a sound-pressure level of 90 dBA, measured 10 feet from the horn, using the coded signal prescribed in UL 464 test protocol.
- C. Visible Notification Appliances: Xenon strobe lights complying with UL 1971, with clear or nominal white polycarbonate lens mounted on an aluminum faceplate. The word "FIRE" is engraved in minimum 1-inch high letters on the lens.
 - 1. Rated Light Output:
 - a. 15/30/75/110 cd, selectable in the field.
 - 2. Mounting: Wall mounted unless otherwise indicated.
 - 3. For units with guards to prevent physical damage, light output ratings shall be determined with guards in place.

4. Flashing shall be in a temporal pattern, synchronized with other units.
5. Strobe Leads: Factory connected to screw terminals.
6. Mounting Faceplate: Factory finished, red.

D. Voice/Tone Notification Appliances:

1. Speakers shall be EST High Fidelity capable of providing 520hz.
2. Comply with UL 1480.
3. Speakers for Voice Notification: Locate speakers for voice notification to provide the intelligibility requirements of the "Notification Appliances" and "Emergency Communications Systems" chapters of NFPA 72.
4. Speaker shall be capable of field selection of speaker voltage (25 and 70.7 Vrms) and power settings (1/4 W, 1/2 W, 1 W, 2 W).
 - a. Final settings shall be field adjusted to match the acoustical environment of each speaker.

E. Exit Marking Audible Notification Appliance:

1. Exit marking audible notification appliances shall meet the audibility requirements in NFPA 72.
2. Provide exit marking audible notification appliances at the entrance to all building exits.
3. Provide exit marking audible notification appliances at the entrance to areas of refuge with audible signals distinct from those used for building exit marking.

2.11 MAGNETIC door holders. (Edwards 1500 series)

A. Description: Units are equipped for wall or floor mounting as indicated and are complete with matching doorplate.

1. Electromagnets: Require no more than 3 W to develop 35-lbf of holding force.
2. Wall-Mounted Units: Flush mounted unless otherwise indicated.
3. Rating: 24-V dc.

B. Material and Finish: Brushed aluminum.

2.12 Fire alarm ANNUNCIATOR panel (FAAP)

A. Graphic Annunciator Panel: Mounted in an aluminum frame with nonglare, minimum 3/16-inch thick, clear acrylic cover over graphic representation of the facility. Detector locations shall be represented by red LED lamps. Normal system operation shall be indicated by a lighted, green LED. Trouble and supervisory alarms shall be represented by an amber LED.

1. Comply with UL 864.
2. Shall Operate from 24-V dc power supplied by the FACP.
3. Include built-in voltage regulation, reverse polarity protection, RS 232/422 serial communications, and a lamp test switch.

4. Surface mounted in a NEMA 250, Type 1 cabinet, with key lock and no exposed screws or hinges.
5. Graphic representation of the facility floorplan, and each detector shall be represented by an LED in its actual location. Floorplan shall be at 1/8-inch per foot scale or larger.
6. The LED representing a detector shall flash two times per second while detector is an alarm.
 - a. ADDRESSABLE INTERFACE DEVICE

B. General:

1. Include address-setting means on the module.
2. Store an internal identifying code for control panel use to identify the module type.
3. Listed for controlling HVAC fan motor controllers.
4. Devices shall be flush mounted in finished areas and surface mounted with back box in unfinished areas.

C. Monitor Module (SIGA-CT series): Microelectronic module providing a system address for alarm-initiating devices for wired applications with normally open contacts using NFPA 72A Style B (Class B, Two-Wire) circuit supervision. Module responds to polling signals from FACP/Transponder and shall report alarm initiating/supervisory circuit status changes to it.

D. Control Module (EST SIGA-CRH): Microelectronic module with one (1) individual addressable control relay with double-pole/double-throw (DPDT) contacts rated at two (7.0A) @ 120VAC/28VDC. Module response to control signals from FACP/Transponder.

2.13 DIGITAL ALARM COMMUNICATOR TRANSMITTER

- A. Digital alarm communicator transmitter shall be acceptable to the remote central station and shall comply with UL 632.
- B. Functional Performance: Unit shall receive an alarm, supervisory, or trouble signal from FACP and automatically capture two telephone line(s) and dial a preset number for a remote central station. When contact is made with central station(s), signals shall be transmitted. If service on either line is interrupted for longer than 45 seconds, transmitter shall initiate a local trouble signal and transmit the signal indicating loss of telephone line to the remote alarm receiving station over the remaining line. Transmitter shall automatically report telephone service restoration to the central station. If service is lost on both telephone lines, transmitter shall initiate the local trouble signal.
- C. Addressable communications circuits from system transponders shall be electrically supervised in accordance with NFPA 72A Style 6 (Class A, four-wire) standards, monitoring for alarm (shorts), trouble (opens), and ground faults. When wired in the

Style 6 (Class A, four-wire) configuration, a single open or ground fault shall not prevent the receipt of an alarm condition. Addressable communications circuits shall utilize two (2) cables of two (2) No. 18 AWG twisted conductors from the transponder to the connected addressable devices.

- D. Local functions and display at the digital alarm communicator transmitter shall include the following:
 - 1. Verification that both telephone lines are available.
 - 2. Programming device.
 - 3. LED display.
 - 4. Manual test report function and manual transmission clear indication.
 - 5. Communications failure with the central station or FACP.
- E. Digital data transmission shall include the following:
 - 1. Address of the alarm-initiating device.
 - 2. Address of the supervisory signal.
 - 3. Address of the trouble-initiating device.
 - 4. Loss of ac supply.
 - 5. Loss of power.
 - 6. Low battery.
 - 7. Abnormal test signal.
 - 8. Communication bus failure.
- F. Secondary Power: Integral rechargeable battery and automatic charger.
- G. Self-Test: Conducted automatically every 24 hours with report transmitted to central station.

2.14 NETWORK COMMUNICATIONS

- A. Provide network communications for fire alarm system according to fire alarm manufacturer's written requirements.
- B. Provide network communications pathway per manufacturer's written requirements and requirements in NFPA 72 and NFPA 70.
- C. Provide integration gateway using BACnet for connection to building automation system when required.

2.15 system printer. (EST PTIS)

- A. General: Provide a dot-matrix type, listed and labeled as an integral part of the fire alarm system.

2.16 DEVICE GUARDS

- A. Description: Welded wire mesh of size and shape for the device requiring protection.
 - 1. Factory fabricated and furnished by device manufacturer.
 - 2. Finish: Paint of color to match the protected device.
 - 3. Guards must be UL cross listed with devices being used.

PART 3 EXECUTION

3.1 EXAMINATION

- A. Examine areas and conditions for compliance with requirements for ventilation, temperature, humidity, and other conditions affecting performance of the Work.
 - 1. Verify that manufacturer's written instructions for environmental conditions have been permanently established in spaces where equipment and wiring are installed, before installation begins.
- B. Examine roughing-in for electrical connections to verify actual locations of connections before installation.
- C. Proceed with installation only after unsatisfactory conditions have been corrected.

3.2 EQUIPMENT INSTALLATION

- A. Comply with NFPA 72, NFPA 101, and requirements of authorities having jurisdiction for installation and testing of fire alarm equipment. Install all electrical wiring to comply with requirements in NFPA 70 including, but not limited to, Article 760, "Fire Alarm Systems."
 - 1. Devices placed in service before all other trades have completed cleanup shall be replaced.
 - 2. Devices installed but not yet placed in service shall be protected from construction dust, debris, dirt, moisture, and damage according to manufacturer's written storage instructions.
- B. Install wall-mounted equipment, with tops of cabinets not more than 78 inches above the finished floor.
- C. Manual Fire Alarm Pull Stations:
 - 1. Install manual fire alarm pull station in the normal path of egress within 60 inches of the exit doorway.
- D. Smoke or Heat Detector Spacing:
 - 1. Comply with the "Smoke-Sensing Fire Detectors" section in the "Initiating Devices" chapter in NFPA 72, for smoke-detector spacing.

2. Comply with the "Heat-Sensing Fire Detectors" section in the "Initiating Devices" chapter in NFPA 72, for heat-detector spacing.
 3. Smooth ceiling spacing shall not exceed 30 feet.
 4. Spacing of detectors for irregular areas, for irregular ceiling construction, and for high ceiling areas shall be determined according to Annex A or Annex B in NFPA 72.
 5. HVAC: Locate detectors not closer than 36 inches from air-supply diffuser or return-air opening.
 6. Lighting Fixtures: Locate detectors not closer than 12 inches from any part of a lighting fixture and not directly above pendant mounted or indirect lighting.
- E. Install a cover on each smoke detector that is not placed in service during construction. Cover shall remain in place except during system testing. Remove cover prior to system turnover.
- F. Remote Status and Alarm Indicators: Install in a visible location near each smoke detector, sprinkler water-flow switch, and valve-tamper switch that is not readily visible from normal viewing position.
- G. Audible Alarm Indicating Devices: Install not less than 6 inches below the ceiling. Install bells and horns on flush-mounted back boxes with the device-operating mechanism concealed behind a grille. Install all devices at the same height unless otherwise indicated.
- H. Visible Alarm-Indicating Devices: Install adjacent to each alarm horn and at least 6 inches below the ceiling. Install all devices at the same height unless otherwise indicated.
- I. Device Location-Indicating Lights: Locate in public space near the device they monitor.

3.3 PATHWAYS

- A. Fire alarm pathway and circuit wiring installation shall comply with NEC Article 760.
- B. Where exposed, all fire alarm circuits shall be installed in dedicated EMT conduit.
- C. Where existing wall devices are being replaced in the same location, install new fire alarm circuit wiring in existing conduit within wall (where available).
- D. Pathways above recessed ceilings and in nonaccessible locations may be plenum-rated cable.
- E. All pathways must be independently supported from the structure above.
- F. Where passing through a wall or floor, provide a metal raceway or rigid nonmetallic conduit sleeve.
- G. All penetrations of rated walls and floors shall be properly fire-stopped.

3.4 IDENTIFICATION

- A. Provide an identification nameplate for each equipment cabinet. Nameplates shall correspond with labeling identified in the submittal drawings.
- B. Fire alarm conduit shall be permanently labeled "FIRE ALARM" every 30 feet.
- C. Fire alarm junction boxes shall be painted red.
- D. All initiating and indicating devices shall be labeled with self-adhesive tape with black lettering and identification labeling according to circuit loop and device address/number.
- E. Color code all wiring per recommended standards. Tag all wires in terminal cabinets with tie wrap tags with inked identification.
- F. Install framed instructions in a location visible from FACP.

3.5 GROUNDING

- A. Ground FACP and associated circuits; comply with IEEE 1100. Install a ground wire from main service ground to FACP.
- B. Ground shielded cables at the control panel location only. Insulate shield at device location.

3.6 testing

- A. The fire alarm system manufacturer or manufacturer's authorized representative shall test and inspect components, assemblies, and equipment installations, including connections.
- B. Tests shall be witnessed by District (Owner), Engineer of Record, and the Fire Department.
- C. The following tests and inspections shall be performed:
 - 1. Visual Inspection: Conduct visual inspection prior to testing.
 - a. Inspection shall be based on completed record Drawings and system documentation that is required by NFPA 72.
 - b. Comply with the "Visual Inspection Frequencies" table in the "Inspection" section of the "Inspection, Testing and Maintenance" chapter in NFPA 72; retain the "Initial/Reacceptance" column and list only the installed components.
 - 2. System Testing: Comply with the "Test Methods" table in the "Testing" section of the "Inspection, Testing and Maintenance" chapter in NFPA 72.

3. Test audible appliances for the public operating mode according to manufacturer's written instructions. Perform the test using a portable sound-level meter complying with Type 2 requirements in ANSI S1.4.
 4. Test visible appliances for the public operating mode according to manufacturer's written instructions.
 5. System manufacturer shall prepare the "Fire Alarm System Record of Completion" in the "Documentation" section of the "Fundamentals" chapter in NFPA 72 and the "Inspection and Testing Form" in the "Records" section of the "Inspection, Testing and Maintenance" chapter in NFPA 72.
- D. Reacceptance Testing: Perform reacceptance testing to verify the proper operation of added or replaced devices and appliances.
- E. Fire alarm system will be considered defective if it does not pass tests and inspections.

3.7 closeout documentation

- A. The fire alarm system manufacturer or manufacturer's authorized representative shall prepare and submit to the Engineer of Record all NFPA 72 required closeout documentation including, but not limited to:
1. System Record of Completion
 2. Notification Appliance Power Panel Supplementary Record of Completion
 3. System Record of Inspection and Testing
 4. Notification Appliance Supplementary Record of Inspection and Testing
 5. Initiating Device Supplementary Record of Inspection and Testing
 6. Periodic Inspection, Testing and Maintenance Documentation
- B. Record Drawings, to include:
1. Minimum 1/8" scale floorplan drawings indicating all final device types, locations, ratings, settings and addresses
 2. Wiring diagram of each device type
 3. Riser diagram showing devices, device addresses, equipment, and interconnecting conduit and wire
 4. Narrative of sequence of operation
 5. Sequence of operation matrix (includes complete line-by-line listing for fire alarm initiating devices, device address and input/output matrix)
 6. Voltage drop calculations
 7. Battery sizing calculations
 8. Visual alarm power supply sizing calculations
 9. Power supply calculations for door holders
 10. Wire identification schedule
 11. Legend

- C. Operation and Maintenance Data: For fire-alarm systems and components to include in emergency, operation, and maintenance manuals.
- D. Operating instructions for mounting at fire-alarm control unit and each annunciator unit.
- E. Warranty documentation.
- F. All closeout documentation shall be signed and sealed by a Registered Professional Engineer in New York State.

3.8 maintenance service

- A. Initial Maintenance Service: Beginning at Substantial Completion, maintenance service shall include 12 months' full maintenance by skilled employees of manufacturer's designated service organization. Include preventive maintenance, repair or replacement of worn or defective components, lubrication, cleaning, and adjusting as required for proper operation. Parts and supplies shall be manufacturer's authorized replacement parts and supplies.
 - 1. Include visual inspections according to the "Visual Inspection Frequencies" table in the "Testing" paragraph of the "Inspection, Testing and Maintenance" chapter in NFPA 72.
 - 2. Perform tests in the "Test Methods" table in the "Testing" paragraph of the "Inspection, Testing and Maintenance" chapter in NFPA 72.
- B. Perform tests per the "Testing Frequencies" table in the "Testing" paragraph of the "Inspection, Testing and Maintenance" chapter in NFPA 72.

3.9 DEMONSTRATION

- A. Engage a factory-authorized service representative to train Owner's maintenance personnel to adjust, operate, and maintain fire alarm system.

END OF SECTION

VALLEY CENTRAL SCHOOL DISTRICT BEREA ELEMENTARY SCHOOL 2023 CAPITAL PROJECT - PHASE 1

ISSUED FOR BID: 10/18/24

CSARCH - ARCHITECTS

BLAKE ENGINEERING, PLLC - M.E.P. ENGINEERS


PASSERO ASSOCIATES - SITE/CIVIL AND STRUCTURAL ENGINEERS

AECC ENVIRONMENTAL CONSULTING - HAZARDOUS MATERIALS DESIGNERS

STATE EDUCATION DEPARTMENT PROJECT CONTROL NUMBER:
2023 CAPITAL PROJECT - PHASE 1 44-13-01-06-0-017-014

THE DESIGN OF THIS PROJECT CONFORMS TO APPLICABLE PROVISIONS OF THE NEW YORK STATE UNIFORM FIRE PREVENTION AND BUILDING CODE, THE NEW YORK STATE ENERGY CONSERVATION CONSTRUCTION CODE, AND THE MANUAL OF PLANNING STANDARDS OF THE NEW YORK STATE EDUCATION DEPARTMENT.

CSArch PROJECT NO. 187-2302.01

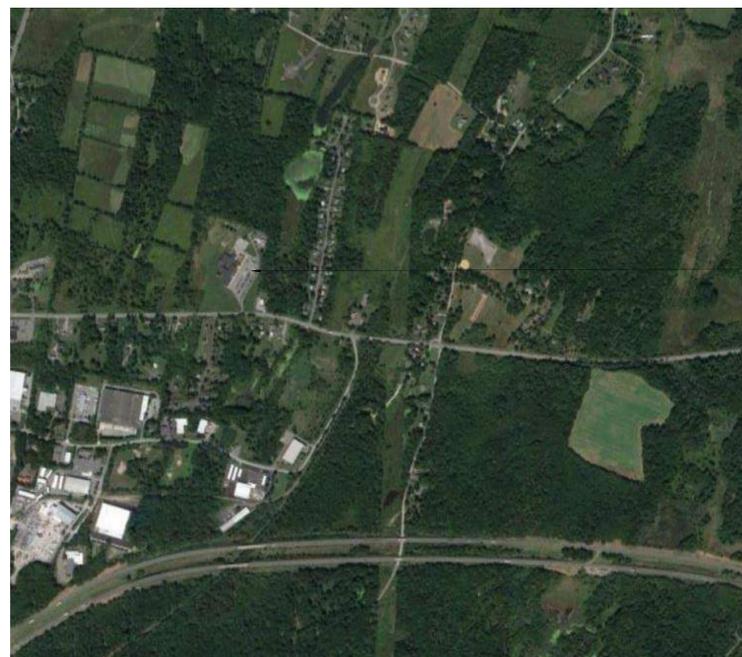

Berea Elementary School

VICINITY MAP

NTS





DRAWING LIST

GENERAL DRAWINGS		PLUMBING GENERAL DRAWINGS	
BES G000	COVER & SHEET INDEX	BES P001	PLUMBING NOTES, SCHEDULE, LEGEND, & DETAILS
BES G001	SYMBOLS, ABBREVIATIONS, MISC. AND PARTITION TYPES	PLUMBING DEMOLITION DRAWINGS	
BES G111	OVERALL FLOOR PLAN - FIRST FLOOR	BES PD111	PLUMBING DEMOLITION PLAN - PART 1
LIFE SAFETY DRAWINGS		BES PD112	PLUMBING DEMOLITION PLAN - PART 2
BES LS111	LIFE SAFETY PLANS - FIRST FLOOR	PLUMBING DRAWINGS	
BES LS112	SMOKE ZONE PLANS	BES P111	PLUMBING PLAN - PART 1
HAZARDOUS MATERIALS DRAWINGS		BES P112	PLUMBING PLAN - PART 2
BES AA100	ASBESTOS ABATEMENT FIRST FLOOR AREA A	MECHANICAL GENERAL DRAWINGS	
CIVIL DRAWINGS		BES M001	MECHANICAL NOTES, LEGENDS, SCHEDULES & DETAILS
BES C100	KEY PLAN	BES M002	MECHANICAL SCHEDULES & DETAILS
BES C130	SITE, GRADING AND ESC PLAN	MECHANICAL DEMOLITION DRAWINGS	
BES C530	DETAILS	BES MD111	MECHANICAL DEMOLITION PLAN - PART 1
ARCHITECTURAL DEMOLITION DRAWINGS		BES MD112	MECHANICAL DEMOLITION PLAN - PART 2
BES AD111	REMOVALS PLAN - FIRST FLOOR - AREA A	MECHANICAL DRAWINGS	
BES AD121	REMOVALS PLAN - FIRST FLOOR - AREA B	BES M111	MECHANICAL PLAN - PART 1
BES AD811	REFLECTED CEILING DEMO PLAN - FIRST FLOOR AREA A	BES M112	MECHANICAL PLAN - PART 2
BES AD812	REFLECTED CEILING DEMO PLAN - FIRST FLOOR AREA B	BES M201	MECHANICAL ROOF PLAN
ARCHITECTURAL DRAWINGS		ELECTRICAL GENERAL DRAWINGS	
BES A111	ENLARGED FLOOR PLAN - FIRST FLOOR - AREA A	BES E001	ELECTRICAL NOTES, LEGENDS, SCHEDULES & DETAILS
BES A112	ENLARGED FLOOR PLAN - FIRST FLOOR - AREA B	ELECTRICAL DEMOLITION DRAWINGS	
BES A201	EXTERIOR ELEVATIONS	BES ED111	ELECTRICAL DEMOLITION PLAN - PART 1
BES A202	EXTERIOR ELEVATIONS	BES ED112	ELECTRICAL DEMOLITION PLAN - PART 2
BES A351	PLAN AND SECTION DETAILS	ELECTRICAL DRAWINGS	
BES A401	ROOF PLANS AND DETAILS	BES E111	ELECTRICAL PLAN - PART 1
BES A601	ENLARGED PLAN AND INTERIOR ELEVATIONS	BES E112	ELECTRICAL PLAN - PART 2
BES A602	ENLARGED PLAN AND INTERIOR ELEVATIONS	BES E201	ELECTRICAL ROOF PLAN
BES A651	CASEWORK DETAILS	BES E211	LIGHTING PLAN - PART 1
BES A811	REFLECTED CEILING PLAN - FIRST FLOOR AREA A	BES E212	LIGHTING PLAN - PART 2
BES A812	REFLECTED CEILING PLAN - FIRST FLOOR AREA B	ARCHITECTURAL FINISH DRAWINGS	
BES A901	DOOR, WINDOW, & STOREFRONT DETAILS	BES AF001	MATERIAL SCHEDULE
ARCHITECTURAL FINISH DRAWINGS		BES AF002	SIGNAGE TYPES AND SCHEDULE
BES AF001	MATERIAL SCHEDULE	BES AF111	ENLARGED FLOOR FINISHES PLAN - FIRST FLOOR - AREA A
BES AF002	SIGNAGE TYPES AND SCHEDULE	BES AF112	ENLARGED FLOOR FINISHES PLAN - FIRST FLOOR - AREA B
BES AF111	ENLARGED FLOOR FINISHES PLAN - FIRST FLOOR - AREA A	FURNITURE DRAWINGS	
BES AF112	ENLARGED FLOOR FINISHES PLAN - FIRST FLOOR - AREA B	BES FE111	FLOOR FURNITURE PLAN - FIRST FLOOR - AREA A
FURNITURE DRAWINGS			
BES FE111	FLOOR FURNITURE PLAN - FIRST FLOOR - AREA A		




EXPIRATION DATE: 02/28/2025

VOLUME 1 OF 8

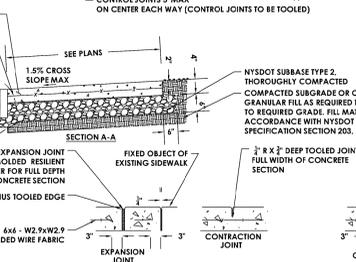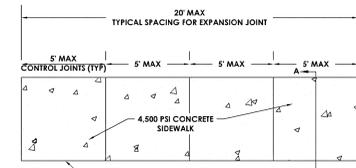


- NOTES:**
- SIDEWALK WIDTH SHALL BE MEASURED FROM THE BACK OF THE CURB UNLESS OTHERWISE SPECIFIED.
 - WHERE IT IS NECESSARY TO PLACE FILL FOR PURPOSE OF BRINGING THE SURGRADE ELEVATION UP TO A SPECIFIED GRADE, THE FILL MATERIAL PLACED SHALL BE IN ACCORDANCE WITH NYS DOT STANDARD SPECIFICATION SECTION 203, LATEST EDITION.
 - NYSDOT SUBBASE TYPE 2 SHALL CONFORM TO NYSDOT STANDARD SPECIFICATION SECTION 304, LATEST EDITION.
 - CONCRETE SHALL NOT BE PLACED UNLESS THE AMBIENT AIR SURFACE TEMPERATURE IS ABOVE 40 DEGREES UNLESS DISCUSSED WITH OWNER AND ENGINEER.
 - SIDEWALKS SHALL HAVE A CROSS SLOPE OF 1.5% PER FOOT UNLESS OTHERWISE SPECIFIED ON THE PLANS.
 - ALL EXPOSED CONCRETE SURFACES SHALL BE BROOM FINISHED AND THE EDGES SHALL BE FINISHED WITH A 1/2" RADIUS EDGING TOOL.
 - THE FINISHED CONCRETE SURFACE SHALL BE TREATED WITH CONCRETE SEALER, RATE AND METHOD OF APPLICATION SHALL BE IN ACCORDANCE WITH MANUFACTURER'S RECOMMENDATIONS.

1 TYPICAL SIDEWALK DETAIL
N.T.S.

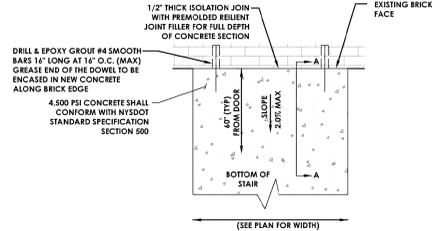


TOP OF STAIR - PLAN VIEW
N.T.S.

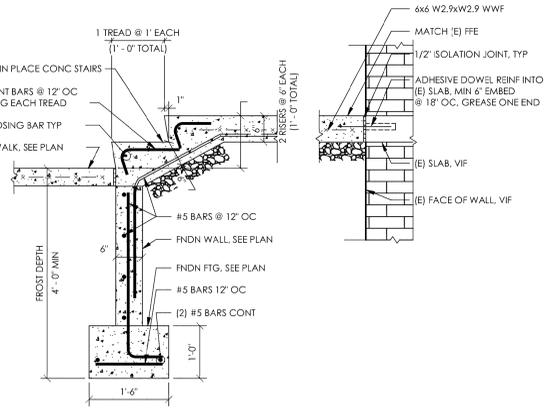


SECTION A-A
3/4" = 1'-0"


2 EXTERIOR STAIR

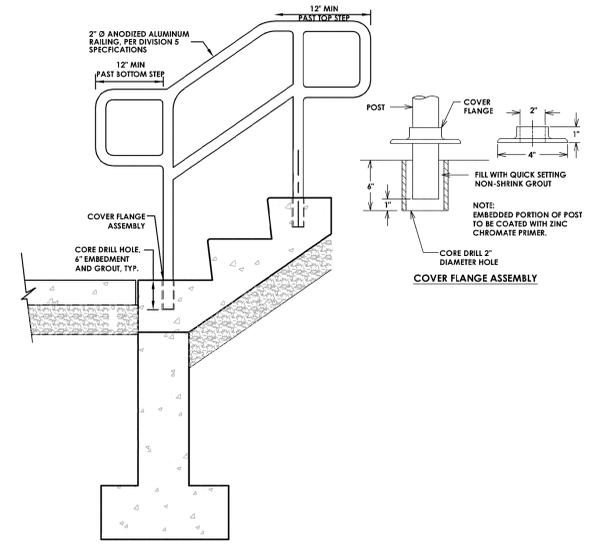


3 STAIRCASE HANDRAIL
N.T.S.

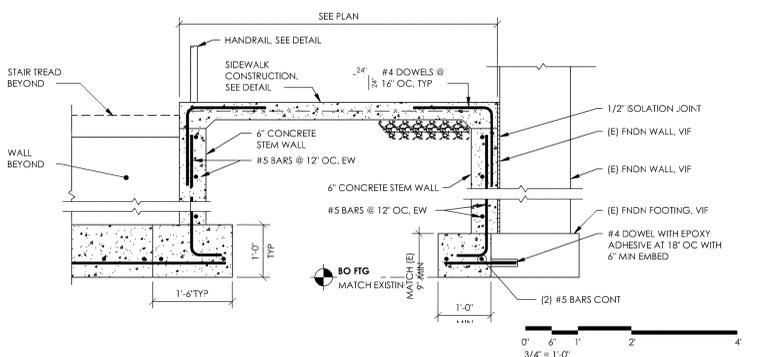


4 EXTERIOR RAMP

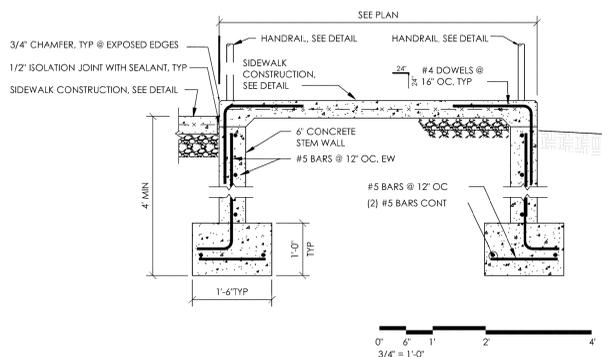


5 EXTERIOR RAMP

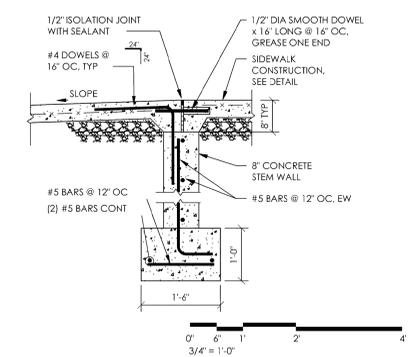

6 EXTERIOR RAMP

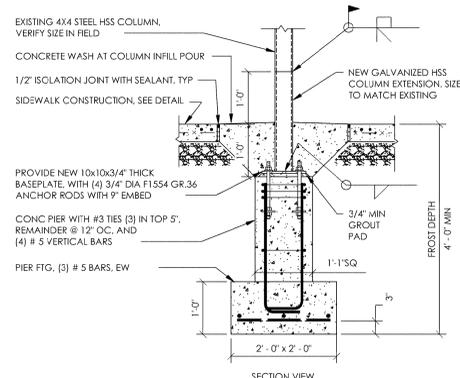


7 EXTERIOR FNDN

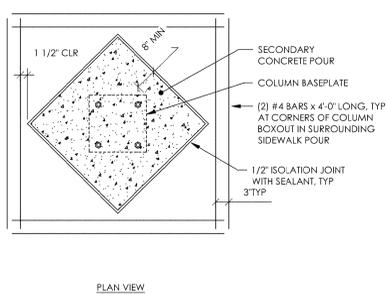


PLAN VIEW

NOTE: AFTER WELDING, PAINT WITH ZINC RICH COATING THEN APPLY HIGH PERFORMANCE COATING TO COLUMN EXTENSION TO MATCH EXISTING PAINT TEXTURE, COLOR, AND FINISH

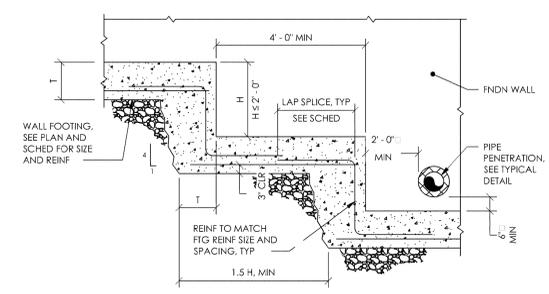


8 TYPICAL WALL FOOTING STEP DETAIL
N.T.S.

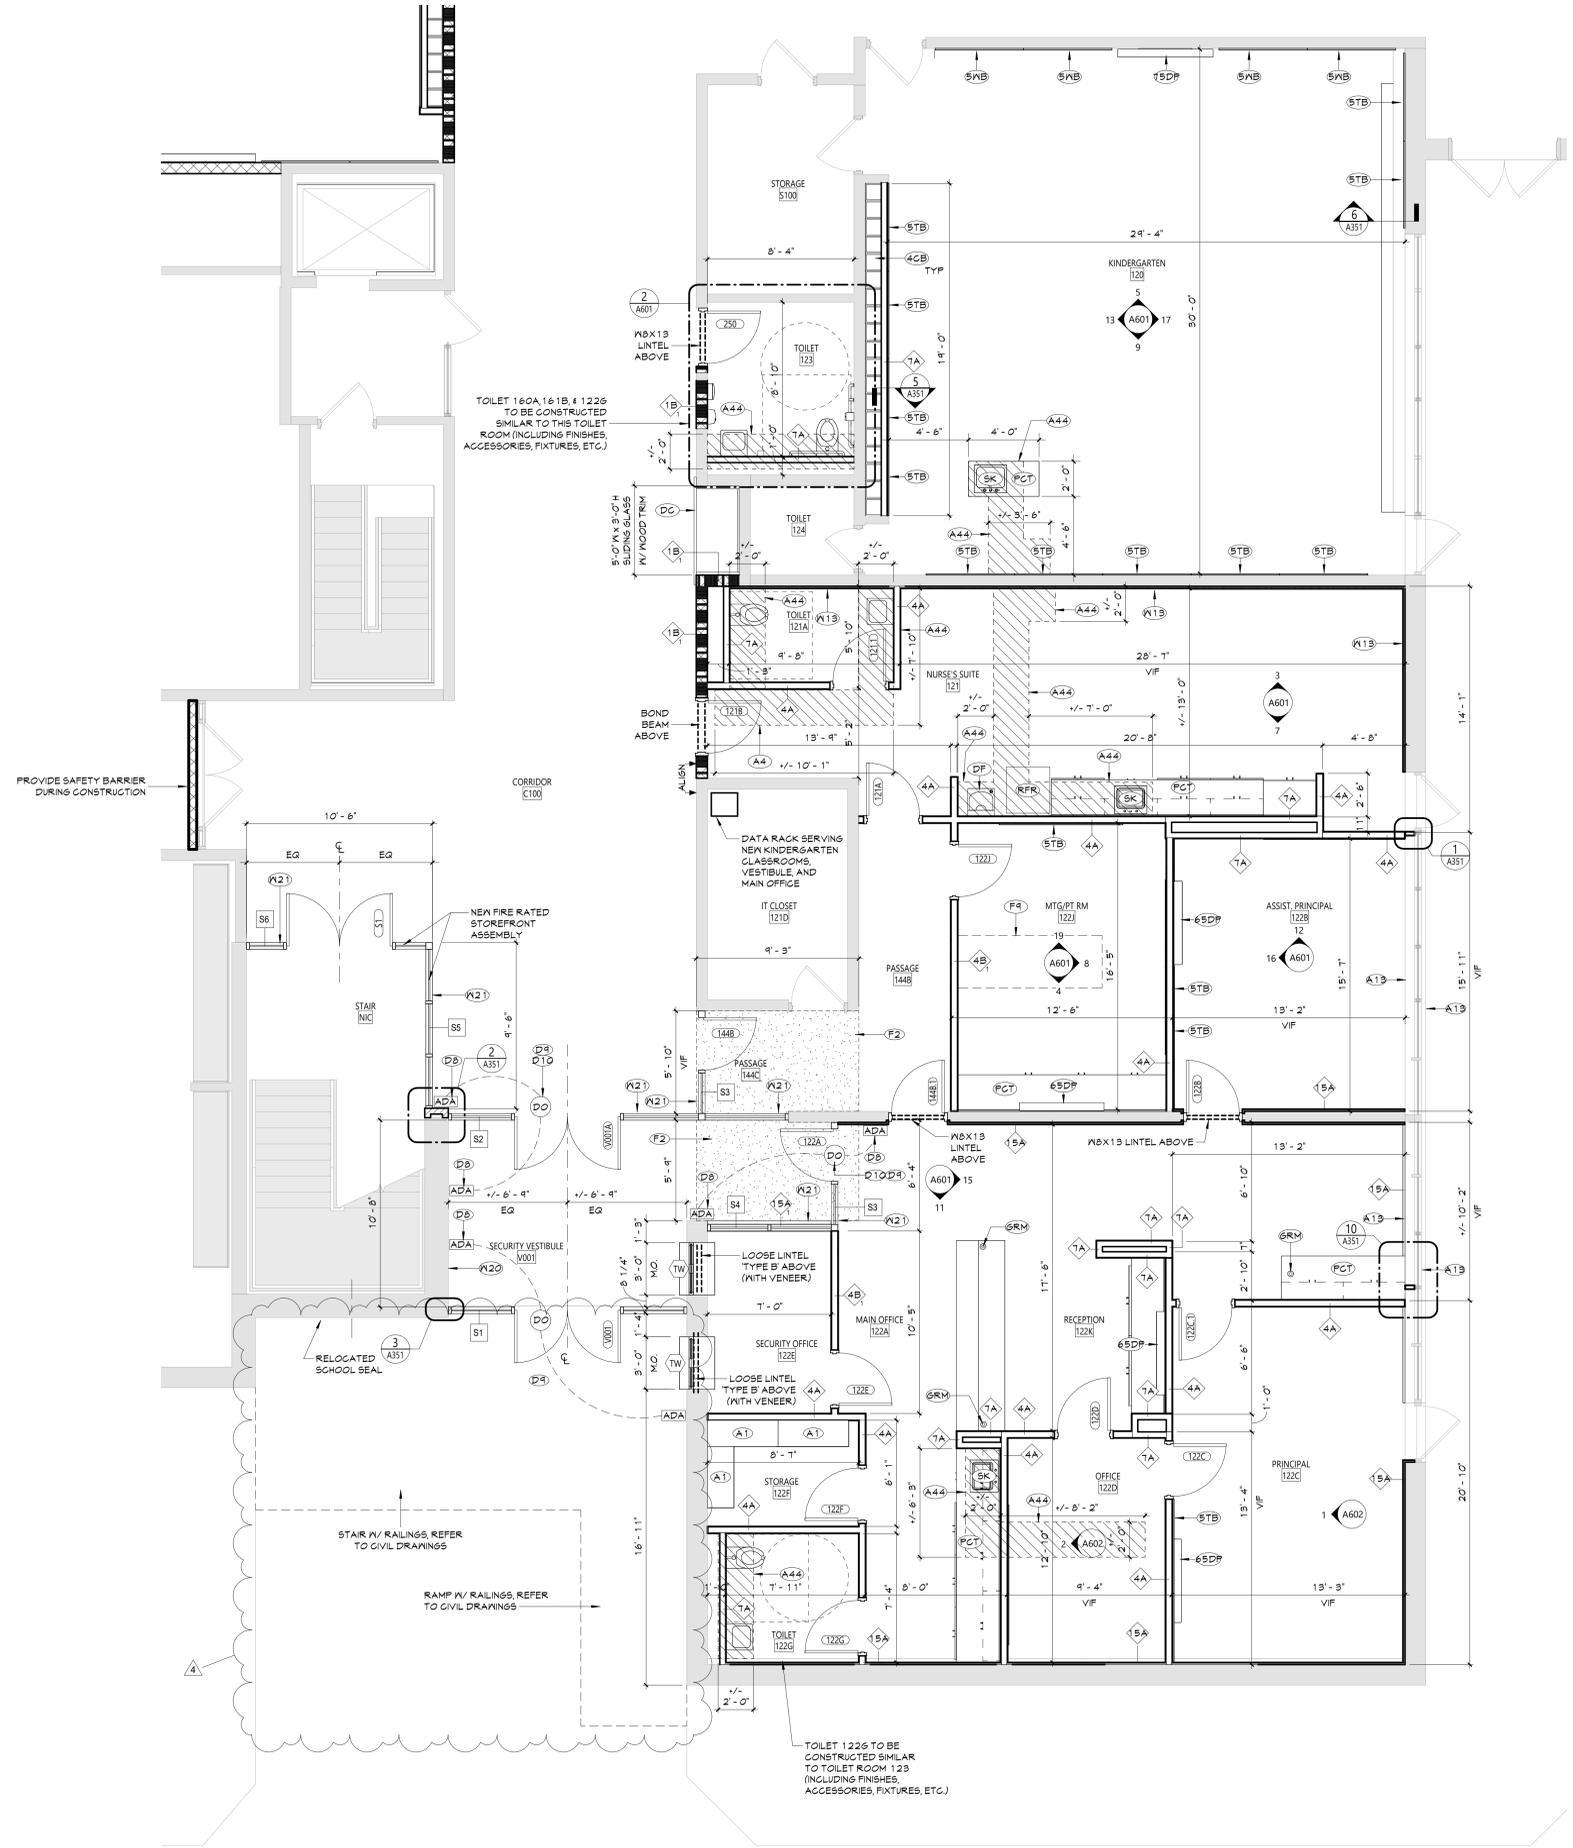

GENERAL NOTES	
1.	REFER TO SHEET 6001 FOR ADDITIONAL GENERAL NOTES.
2.	REFER TO A600 SERIES DRAWINGS FOR ADDITIONAL DIMENSIONS AND DETAILED INFORMATION OF CABINETRY.
3.	REFER TO A800 SERIES DRAWINGS FOR DOOR, STOREFRONT, CURTAIN WALL, WINDOW AND LOUVER SCHEDULES, DETAILS AND NOTES.
4.	REFER TO SHEET A101 FOR PARTITION TYPES AND ADDITIONAL NOTES.

NEW WORK KEYNOTES	
#	Description
4CB	CUBBIE, 4"
5TB	TACKABLE SURFACE BOARD, 5"
6SB	WHITEBOARD, 5"
6SDP	65" FR DISPLAY
7SDP	75" FR DISPLAY MONITOR
A1	PROVIDE METAL SHELVES
A4	PROVIDE TOILET PAPER DISPENSER
A13	PATCH MALL TO MATCH WHERE MECHANICAL UNIT HAS PREVIOUSLY REMOVED
A44	PROVIDE TRENCHING OF FLOOR SLAB TO ACCOMMODATE PIPING WORK. PATCH CONCRETE SLAB AFTER COMPLETION OF PIPING WORK. COORDINATE EXTENT OF TRENCHING WITH PLUMBING DRAWINGS.
DB	PROVIDE SPECIFIED ADA PADDLE SWITCH TIED INTO NEW RELAY AND CONNECTED TO DOOR OPERATOR AS INDICATED. COORDINATE WORK WITH DOOR HARDWARE AND SECURITY VENDOR.
DP	INSTALL POWER SUPPLY/POWER TRANSFER FOR ELECTRIFIED DOOR HARDWARE
D10	PROVIDE SPECIFIED DOOR OPERATOR AND SPECIFIED SENSING SENSOR TIED INTO NEW RELAY AND CONNECTED TO ADA PADDLE SWITCH AS INDICATED. COORDINATE WORK WITH DOOR HARDWARE AND SECURITY VENDOR.
DC	NEW DISPLAY CASE. SEE PLAN FOR DIMENSIONS. SILL TO BE AT 3'-0" AFF. INFILL AROUND ALL SIDES WITH METAL STUDS AND PAINTED GNB.
DF	DRINKING FOUNTAIN. REFER TO PLUMBING DRAWINGS
F2	PROVIDE SELF-LEVELING CEMENTITIOUS UNDERLAYMENT TO ACHIEVE LEVEL SURFACE FOR FINISHED FLOORING.
F4	TRENCH SLAB TO PROVIDE CONDUIT FOR POWER/DATA FLOOR BOXES. INFILL TRENCH WITH NEW CONCRETE WHEN ELECTRICAL INSTALLATIONS ARE COMPLETE. PROVIDE SCHEDULED FLOOR FINISH. COORDINATE WITH ELECTRICAL DRAWINGS.
GRM	GROUNDING IN COUNTERTOP FOR DATA CONNECTIONS. COORDINATE LOCATIONS WITH ELECTRICAL DRAWINGS.
PCT	FLAM COUNTER TOP, CONTINUOUS
RFR	REFRIGERATOR, NOT IN CONTRACT
SK	SINK, REFER TO PLUMBING DRAWINGS
W13	PROVIDE 1/2" GNB, PAINTED, ON METAL FURRING OVER EXISTING GNB MALL.
W20	REINSTALL SALVAGED PLAQUES IN NEW LOCATION. VERIFY LOCATION WITH OWNER.
W21	PROVIDE METAL STUD PARTITION WITH 5/8" TYPE X GYPSUM MALL BOARD (BOTH SIDES) ABOVE NEW STOREFRONT FRAMING SYSTEM. PARTITION TO BE MOUNTED TO STRUCTURAL DECK ABOVE.

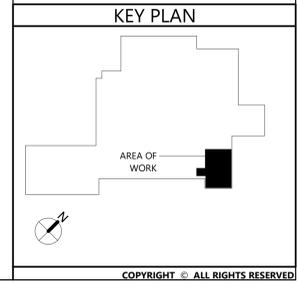

1 AREA A - PARTIAL FIRST FLOOR PLAN
A111 1/4" = 1'-0"

19 Front St., Newburgh - New York 12550-7601
845-561-1319 www.csarch.com

CS ARCH

Valley Central School District
Berea Elementary School
2023 CAPITAL PROJECT - PHASE 1

Project Title

EXPIRATION DATE: 02/28/2025


NO.	DATE	DESCRIPTION
4	11/16/24	BID ADDENDUM #4
3	11/16/24	BID ADDENDUM #3
2	11/16/24	BID ADDENDUM #2
1	10/25/24	BID ADDENDUM #1

Drawn By: *Autistic*
Checked By: *44-13-01-06-0-017-014*
Proj. #: *187-2302.01*
CSArch Proj. #: *187-2302.01*
Issued for Bid: *10/18/24*


Sheet Title
ENLARGED FLOOR PLAN - FIRST FLOOR - AREA A

Sheet No.
BES A111


CONSTRUCTION DOCUMENTS

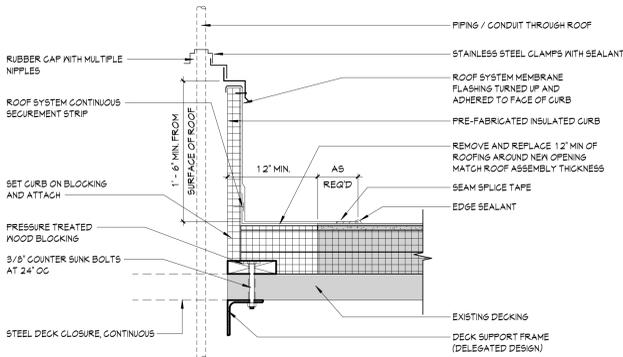

3 PIPE BOOT/CURB DETAIL
A401 1/2" = 1'-0"

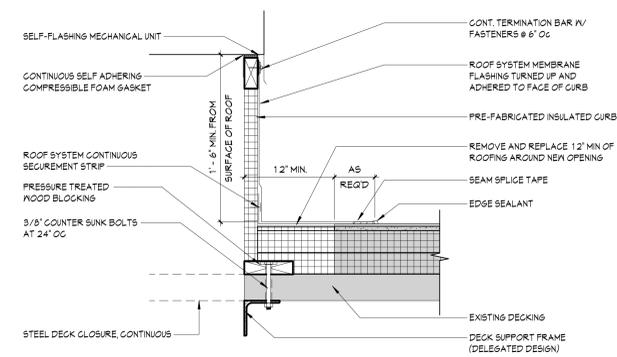

2 EQUIPMENT CURB DETAIL
A401 1/2" = 1'-0"

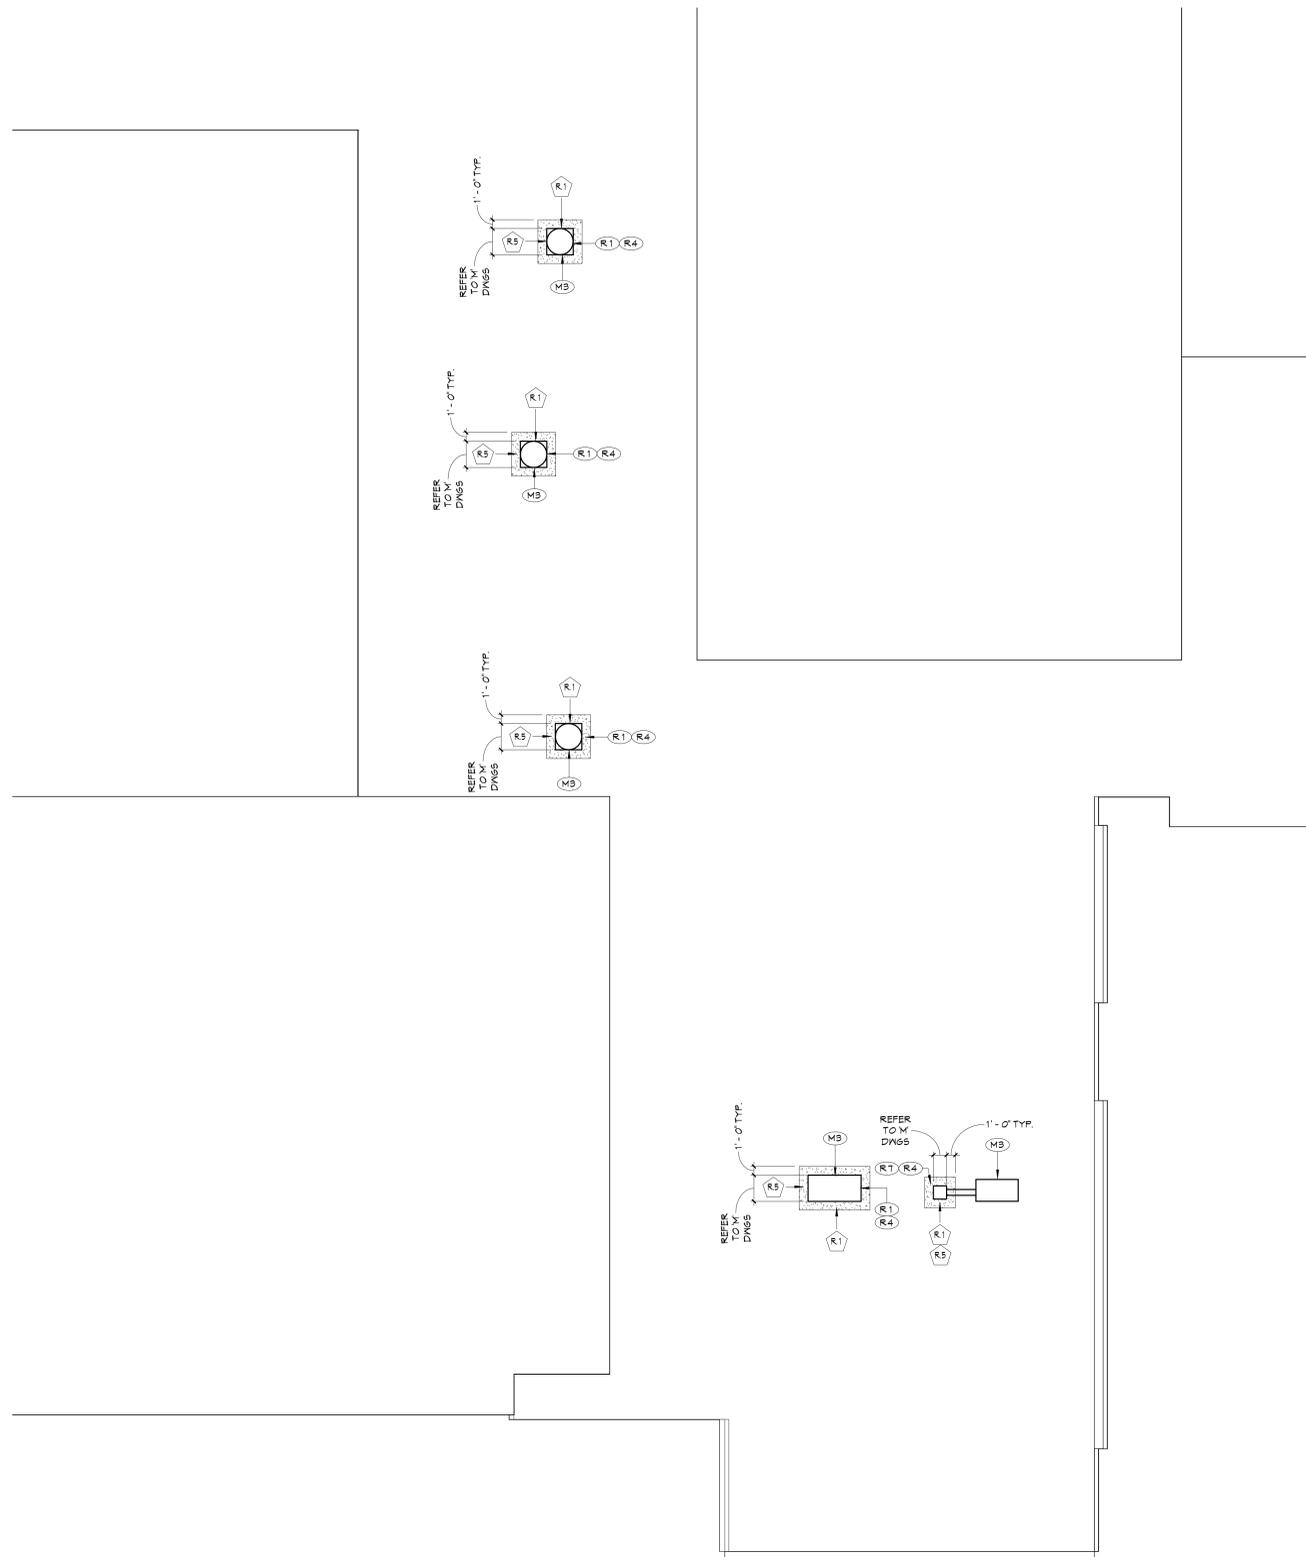

1 ROOF PLAN - DEMOLITION AND NEW WORK
A401 1/8" = 1'-0"

GENERAL REMOVAL NOTES

- COORDINATE ALL REMOVALS WITH NEW CONSTRUCTION.
- PATCH AND REPLACE EXISTING AND NEWLY CREATED HOLES IN WALLS (DUE TO REMOVAL) WITH MATERIALS TO MATCH EXISTING CONSTRUCTION.
- SALVAGED ITEMS SHALL BE TURNED OVER TO OWNER UNO.
- ALL KEYED REMOVALS SHALL INCLUDE REMOVAL OF ANY AND ALL ANCHORING SYSTEMS INCLUDING OBJECTS EMBEDDED INTO EXISTING WALLS.
- REFER TO ASBESTOS AND MEP DRAWINGS FOR ADDITIONAL REMOVAL INFORMATION.
- PROVIDE TEMPORARY SHORING AS NECESSARY AT ALL AREAS OF WALL REMOVAL AND NEW WALL PENETRATIONS.
- DRILL CORNERS OF ALL NEW SANGUIT OPENING PRIOR TO SANGUTTING, TO PREVENT CUTTING INTO SCHEDULED CONSTRUCTION TO REMAIN.

GENERAL NOTES

- REFER TO SHEET 6001 FOR ADDITIONAL GENERAL NOTES.
- REFER TO A600 SERIES DRAWINGS FOR ADDITIONAL DIMENSIONS AND DETAILED INFORMATION OF CABINETRY.
- REFER TO A100 SERIES DRAWINGS FOR DOOR, STOREFRONT, CURTAINWALL, WINDOW AND LOUVER SCHEDULES, DETAILS AND NOTES.
- REFER TO SHEET A101 FOR PARTITION TYPES AND ADDITIONAL NOTES.

DEMOLITION KEYNOTES

#	Description
R.1	REMOVE PORTION OF EXISTING ROOF SYSTEM INCLUDING ROOF DECKING TO PROVIDE A NEW ROOF OPENING TO ACCOMMODATE MECHANICAL WORK. REFER TO MEP DRAWINGS.
R.5	REMOVE 12" MINIMUM OF EXISTING ROOFING SYSTEM AROUND THE PERIMETER OF NEW ROOF OPENING TO ACCOMMODATE MEP WORK.

NEW WORK KEYNOTES


#	Description
M.3	MECHANICAL EQUIPMENT. REFER TO MEP DRAWINGS.
R.1	PROVIDE ROOF FLASHING AROUND NEW EQUIPMENT CURB.
R.4	PROVIDE 12" MINIMUM OF NEW ROOFING SYSTEM AROUND THE PERIMETER OF NEW ROOF EQUIPMENT.
R.1	PROVIDE PIPE PORTAL.

19 Front St., Newburgh - New York 12550-7601
845-561-3379 www.csarch.com



VALLEY CENTRAL SCHOOL DISTRICT
BEREA ELEMENTARY SCHOOL
2023 CAPITAL PROJECT - PHASE 1

Project Title

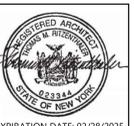

NO.	DATE	BY	DESCRIPTION
1	11/16/24		BID ADDENDUM #1

Drawn By:	AutCAD
Checked By:	44-13-01-06-0-017-014
CSArch Proj. #:	187-2302.01
Issued for Bid:	3/1/18/24

Sheet Title
ROOF PLAN AND DETAILS

Sheet No.
BES A401
CONSTRUCTION DOCUMENTS



ROOM FINISH SCHEDULE									
ROOM NUMBER	ROOM NAME	Room Style	FLOOR			Wall Finish	Accent_Wall	CEILING	Comments
			FINISH	BASE					
105	COUNSELOR	COUNSELOR	ETR	ETR_RB-2	ETR/PNT-5				
120	KINDERGARTEN	CLASSROOM ETR	ETR_VCT-1	ETR_RB-2	PNT-1				
121	NURSE'S SUITE	NURSE	LVT-1	RB-1	PNT-1	PNT-2			
121A	TOILET	TOILET	CFT-1	CTB-1	CWT-1,2,3,4				
121D	IT CLOSET	IT CLOSET	LVT-1	RB-1	PNT-1				
122A	MAIN OFFICE	OFFICE LVT	LVT-1	RB-1	PNT-1				
122AA	STORAGE	CLASSROOM STORAGE	LVT-2	RB-1	PNT-1				
122B	ASSIST. PRINCIPAL	OFFICE CPT	CPT-1	RB-1	PNT-1				
122C	PRINCIPAL	OFFICE CPT	CPT-1	RB-1	PNT-1				
122D	OFFICE	OFFICE CPT	CPT-1	RB-1	PNT-1				
122E	SECURITY OFFICE	OFFICE CPT	CPT-1	RB-1	PNT-1				
122F	STORAGE	STORAGE OFFICES	LVT-1	RB-1	PNT-1				
122G	TOILET	TOILET	CFT-1	CTB-1	CWT-1,2,3,4				
122J	MTG/PT RM	OFFICE CPT	CPT-1	RB-1	PNT-1				
122K	RECEPTION	OFFICE LVT	LVT-1	RB-1	PNT-1				
123	TOILET	TOILET	CFT-1	CTB-1	CWT-1,2,3,4				
144B	PASSAGE	OFFICE LVT	LVT-1	RB-1	PNT-1				
160	KINDERGARTEN	CLASSROOM	LVT-2,3	RB-1	PNT-1				
160A	TOILET	TOILET	CFT-1	CTB-1	CWT-1,2,3,4				
161	KINDERGARTEN	CLASSROOM	LVT-2,3	RB-1	PNT-1				
161.1	STORAGE	CLASSROOM STORAGE	LVT-2	RB-1	PNT-1				
161B	TOILET	TOILET	CFT-1	CTB-1	CWT-1,2,3,4				
162	STORAGE	CLASSROOM STORAGE	LVT-2	RB-1	PNT-1				
238	CORRIDOR	CORRIDOR C100	ETR	ETR_TB-1	ETR/PNT-3,4				
C100	CORRIDOR	CORRIDOR C100	ETR	ETR_TB-1	ETR/PNT-3,4				
V001	SECURITY VESTIBULE	VESTIBULE	ETR_LVT-1	ETR_RB-1	ETR/PNT-1				

MATERIALS LEGEND					
MATERIAL	MANUFACTURER	MODEL	COLOR #/NAME	SIZE	NOTE
CARPET TILE					
CPT-1	PATCRAFT	ON NEUTRAL GROUND - RAW EDGE	00580 MOIRE	18" X 36"	OFFICES (ASHLAR)
CERAMIC FLOOR TILE					
CFT-1	DALTILE	PORTFOLIO	PF04 DOVE GREY MATTE	12" X 24"	TYP. FLOOR
CERAMIC TILE BASE					
CTB-1	DALTILE	COLOR WHEEL LINEAR	X114 DESERT GRAY GLOSS	4"	TOILETS
CERAMIC WALL TILE					
CWT-1	DALTILE	COLOR WHEEL LINEAR	0190 ARCTIC WHITE GLOSS	4" X 12"	GENERAL WALL TILE
CWT-2	DALTILE	COLOR WHEEL LINEAR	1174 SEA BREEZE GLOSS	4" X 12"	GENERAL WALL TILE
CWT-3	DALTILE	COLOR WHEEL LINEAR	X114 DESERT GRAY GLOSS	4" X 12"	GENERAL WALL TILE
CWT-4	DALTILE	COLOR WHEEL LINEAR	0182 SUEDE GRAY GLOSS	4" X 12"	GENERAL WALL TILE
LAMINATE					
PLAM-1	WILSONART	LAMINATE	5034-38 HANDSPUN DOVE		WORKSURFACE OFFICE
PLAM-2	WILSONART	LAMINATE	8221-38 SAP WALNUT		CASEWORK BASE OFFICE
PLAM-3	WILSONART	LAMINATE	AS SELECTED FROM FULL RANGE OF COLOR / MATCH EXISTING		CASEWORK CLASSROOMS
LUXURY VINYL TILE					
LVT-1	MANNINGTON COMMERCIAL	COLOR ANCHOR - GROOVE	C141 MISTY MOUNTAIN	6" X 36"	MAIN OFFICE SUITE (SQUARE EDGE)
LVT-2	MANNINGTON COMMERCIAL	COLOR ANCHOR - GROOVE	C141 MISTY MOUNTAIN	18" X 18"	CLASSROOM (SQUARE EDGE)
LVT-3	MANNINGTON COMMERCIAL	COLOR ANCHOR - GROOVE	C109 ISLAND BLUE	18" X 18"	CLASSROOM ACCENT (SQUARE EDGE)
PAINT					
PNT-1	SHERWIN WILLIAMS	EGG-SHELL	SW 7631 CITY LOFT		GENERAL WALL PAINT
PNT-2	SHERWIN WILLIAMS	EGG-SHELL	SW 6516 DOWN POUR		ACCENT WALL PAINT
PNT-3	SHERWIN WILLIAMS	EGG-SHELL	AS SELECTED FROM FULL RANGE OF COLOR / MATCH EXISTING		CORRIDOR
PNT-4	SHERWIN WILLIAMS	EGG-SHELL	AS SELECTED FROM FULL RANGE OF COLOR / MATCH EXISTING		CORRIDOR
PNT-5	SHERWIN WILLIAMS	EGG-SHELL	AS SELECTED FROM FULL RANGE OF COLOR / MATCH EXISTING		COUNSELOR
PNT-6	SHERWIN WILLIAMS	SEMI-GLOSS	SW 7615 SEA SERPENT		HM DOOR PAINT
PNT-7	SHERWIN WILLIAMS	FLAT	SW 7005 PURE WHITE		GYP. CEILING
RUBBER BASE					
RB-1	TARKETT	BASEWORKS	92 BLUE LAGOON	4"	TYPICAL
RB-2	TARKETT	BASEWORKS	AS SELECTED FROM FULL RANGE OF COLOR / MATCH EXISTING	4"	PATCH @ CLASSROOM
TERRAZZO BASE					
TB-1	TERRAZZO		AS SELECTED FROM FULL RANGE OF COLOR / MATCH EXISTING	MATCH EXISTING	CORRIDOR
VINYL COMPOSITION TILE					
VCT-1	ARMSTRONG	STANDARD EXCELON	AS SELECTED FROM FULL RANGE OF COLOR / MATCH EXISTING	12" X 12"	PATCH @ CLASSROOM

DISCLAIMER NOTE
 MANUFACTURER'S NAMES AND FINISH INFORMATION ARE INDICATED AS REFERENCED TO THE ARCHITECT'S BASIS-OF-DESIGN SELECTIONS AND HAVE BEEN DETERMINED PRIOR TO BID. THE CONTRACTOR AND OWNER ARE HEREBY NOTIFIED THAT FINISHES INSTALLED IN THE WORK ARE SUBJECT TO CHANGE IN RESPONSE TO SUBMITTALS, CONFIRMED SELECTIONS, PRODUCT AVAILABILITY AND THE SUBSEQUENT COORDINATION OF FINISHES BY ARCHITECT AND MAY DIFFER FROM PRODUCTS LISTED HEREIN.

ABBREVIATIONS
 ACMU ARCHITECTURAL CONCRETE MASONRY UNIT
 AGT ACOUSTICAL GELING TILE
 AFG ACOUSTICAL PANEL CEILING
 ABT BIO-BASED TILE
 BRK BRICK
 CFT CERAMIC FLOOR TILE
 CMU CONCRETE MASONRY UNIT
 CONG CONCRETE
 CARPET CARPET
 CTB CERAMIC TILE BASE
 CWT CERAMIC WALL TILE
 ETR EXISTING TO REMAIN
 EXP EXPOSED
 EXST EXISTING
 FAC/OFF FACTORY FINISH
 GMB GYP/PSM WALL BOARD
 LMC LINEAR METAL CEILING
 LVT LUXURY VINYL TILE
 MSS MISSISSIPPI STORAGE SYSTEM
 MYP METAL WALL PANEL
 PCON POLISHED CONCRETE
 FLAM PLASTIC LAMINATE
 PLAS PLASTER
 PNT PAINT
 RAF RESILIENT ATHLETIC FLOORING
 RB RUBBER BASE
 RF RESINOUS FLOORING
 RST RUBBER STAIR TREAD / LANDING
 RT RUBBER TILE FLOORING
 SCONG SEALED CONCRETE
 SS STAINLESS STEEL
 STF SYNTHETIC TURF FLOORING
 STL STEEL
 TB TERRAZZO BASE
 TERR TERRAZZO
 TP TOILET PARTITIONS
 TYP TYPICAL
 VGT VINYL COMPOSITION TILE
 VGTAS VINYL COMPOSITION TILE ANTI-STATIC
 VNG VINYL WALLCOVERING
 WAF WOOD ATHLETIC FLOORING
 WD WOOD
 WOM WALK-OFF MAT

- GENERAL FINISH NOTES**
1. ALL EXPOSED SURFACES OF NEW PARTITIONS ARE TO BE PAINTED.
 2. WHEN ANY WORK IS PERFORMED ON ANY EXISTING WALL, THE ENTIRE WALL SURFACE IS TO BE PAINTED CORNER TO CORNER, UNLESS NOTED OTHERWISE.
 3. ALL ELECTRIC, MECHANICAL COMPONENTS AND TELEPHONE PANELS EXPOSED IN A ROOM TO MATCH WALL COLOR.
 4. ALL NEW GMB CEILINGS, FASCIA, AND SOFFITS TO BE PAINTED PNT-1.
 5. NEW HM DOORS, DOOR FRAMES AND WINDOW FRAMES AND ETR CORRIDOR DOOR & WINDOW FRAMES AS SCHEDULED ON A600 SERIES DRAWINGS.

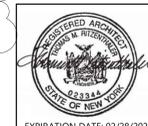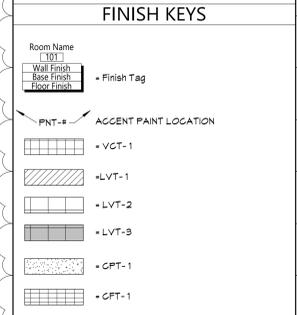


NO.	DATE	DESCRIPTION
4	11/16/24	BID ADDENDUM #1

Drawn By: AS
 Checked By: AS
 Proj. #: 44-13-01-06-0-017-014
 CSArch Proj. #: 187-2302.01
 Issued for Bid: 10/18/24

Sheet Title
 MATERIAL SCHEDULE

Sheet No.
 BES AF001
 CONSTRUCTION DOCUMENTS

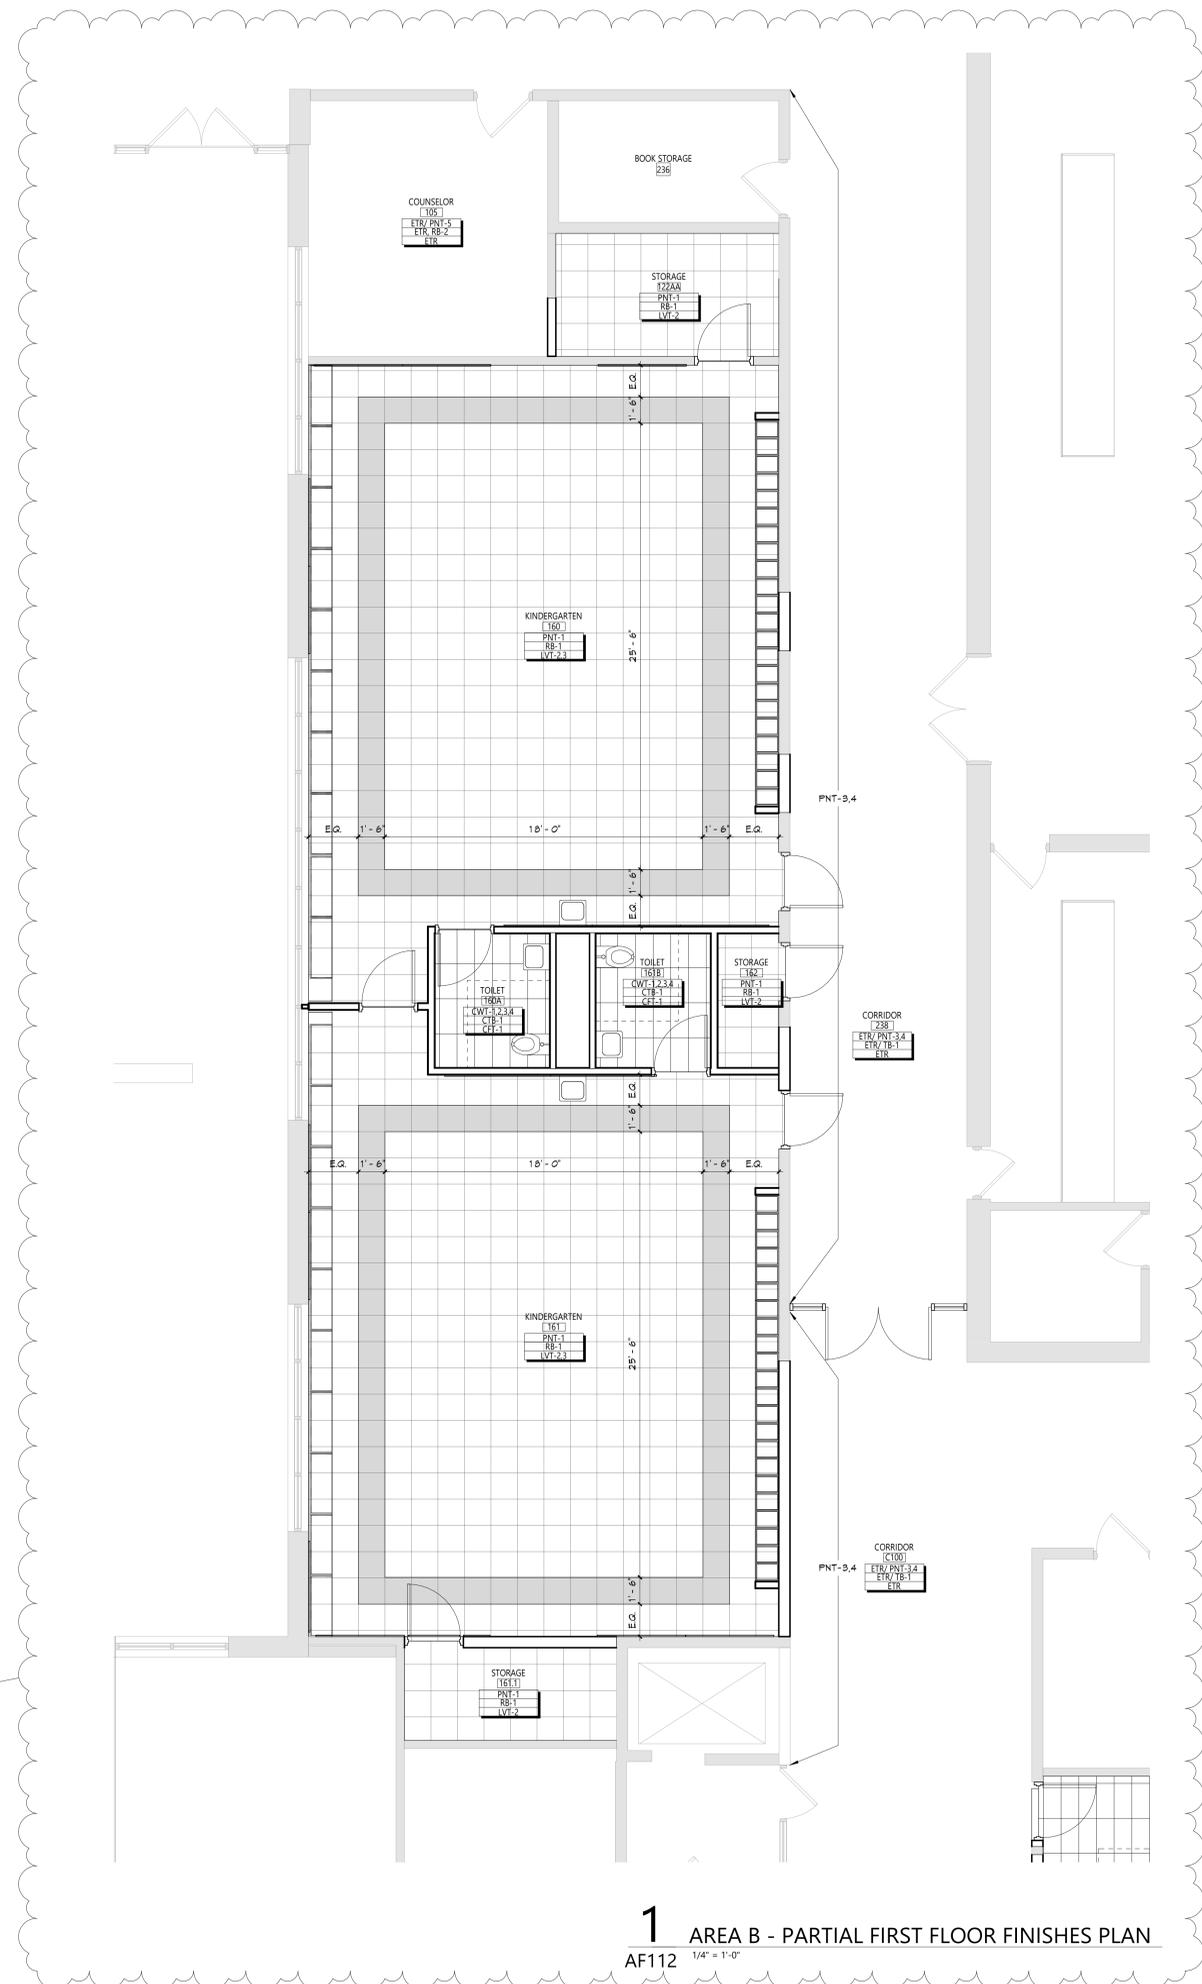

1 AREA B - PARTIAL FIRST FLOOR FINISHES PLAN
AF112 1/4" = 1'-0"

DISCLAIMER NOTE

MANUFACTURER'S NAMES AND FINISH INFORMATION ARE INDICATED AS REFERENCED TO THE ARCHITECT'S BASIS-OF-DESIGN SELECTIONS AND HAVE BEEN DETERMINED PRIOR TO BID. THE CONTRACTOR AND OWNER ARE HEREBY NOTIFIED THAT FINISHES INSTALLED IN THE WORK ARE SUBJECT TO CHANGE IN RESPONSE TO SUBMITTALS, CONFIRMED SELECTIONS, PRODUCT AVAILABILITY AND THE SUBSEQUENT COORDINATION OF FINISHES BY ARCHITECT AND MAY DIFFER FROM PRODUCTS LISTED HEREIN.

ABBREVIATIONS

ACHU	ARCHITECTURAL CONCRETE MASONRY UNIT
ACT	ACOUSTICAL CEILING TILE
APC	ACOUSTICAL PANEL CEILING
BBT	BIO-BASED TILE
BRK	BRICK
CFT	CERAMIC FLOOR TILE
CMU	CONCRETE MASONRY UNIT
CONC	CONCRETE
CPT	CARPET
CTB	CERAMIC TILE BASE
CMT	CERAMIC MALL TILE
ETR	EXISTING TO REMAIN
EXP	EXPOSED
EXST	EXISTING
FACT/FF	FACTORY FINISH
GNB	GYPHUM WALL BOARD
LMC	LINEAR METAL CEILING
LVT	LUXURY VINYL TILE
MSS	MUSIC STORAGE SYSTEM
MMP	METAL MALL PANEL
PCON	POLISHED CONCRETE
FLAM	PLASTIC LAMINATE
FLAS	PLASTER
PNT	PAINT
RAF	RESILIENT ATHLETIC FLOORING
RS	RUBBER BASE
RF	RESINOUS FLOORING
RST	RUBBER STAIR TREAD / LANDING
RT	RUBBER TILE FLOORING
SGONC	SEALED CONCRETE
SS	STAINLESS STEEL
STF	SYNTHETIC TURF FLOORING
STL	STEEL
TB	TERRAZZO BASE
TERR	TERRAZZO
TP	TOILET PARTITIONS
TYP	TYPICAL
VCT	VINYL COMPOSITION TILE
VCTAS	VINYL COMPOSITION TILE ANTI-STATIC
VNG	VINYL WALLCOVERING
MAF	WOOD ATHLETIC FLOORING
MOOD	WOOD
MD	MOOD
MM	WALK-OFF MAT

GENERAL FINISH NOTES

1. ALL EXPOSED SURFACES OF NEW PARTITIONS ARE TO BE PAINTED.
2. WHEN ANY WORK IS PERFORMED ON ANY EXISTING WALL, THE ENTIRE WALL SURFACE IS TO BE PAINTED CORNER TO CORNER, UNLESS NOTED OTHERWISE.
3. ALL ELECTRIC, MECHANICAL COMPONENTS AND TELEPHONE PANELS EXPOSED IN A ROOM TO MATCH WALL COLOR.
4. ALL NEW GNB CEILINGS, FASCIAS, AND SOFFITS TO BE PAINTED PNT-1.
5. NEW HM DOORS, DOOR FRAMES AND WINDOW FRAMES AND ETR CORRIDOR DOOR & WINDOW FRAMES AS SCHEDULED ON A500 SERIES DRAWINGS.

FINISH KEYS


Room Name (101)

Wall Finish	• Finish Tag
Base Finish	
Floor Finish	

PNT-# ACCENT PAINT LOCATION

- VCT-1
- LVT-1
- LVT-2
- LVT-3
- CPT-1
- CFT-1

KEY PLAN

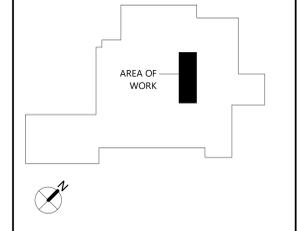

EXPIRATION DATE: 02/28/2025

NO.	DATE	BID ADDENDUM #	DESCRIPTION
4	11/16/24		


Drawn By: AS
Checked By: CSArch
Proj. #: 44-13-01-05-0-017-014
CSArch Proj. #: 187-2302.01
Issued for Bid: 10/18/24

Sheet Title
ENLARGED FLOOR FINISHES PLAN - FIRST FLOOR - AREA B

Sheet No.
BES AF112
CONSTRUCTION DOCUMENTS



1 Mechanical Roof Plan
 Scale: 1/8" = 1'-0"

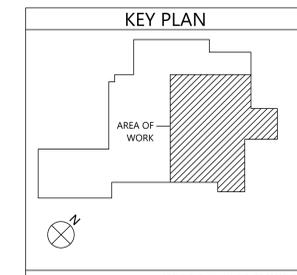

NO.	DATE	DESCRIPTION
1	5/19/24	ISSUED FOR BIDDING
2	5/19/24	REVISED PER RFI #1

Drawn By: BJK
 Checked By: BJK
 Proj. #: 44-13-01-06-0-017-014
 CSArch Proj. #: 187-2302.01
 Issued for Bid: 10/18/24


Sheet Title
MECHANICAL ROOF PLAN

Sheet No.
BES M201

CONSTRUCTION DOCUMENTS



1 Electrical Roof Plan
E201 Scale: 1/8" = 1'-0"

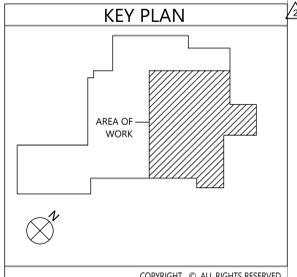

VALLEY CENTRAL SCHOOL DISTRICT
BEREA ELEMENTARY SCHOOL
2023 CAPITAL PROJECT - PHASE 1

19 Front St., Newburgh, New York 12550-7601
845-561-3179 www.csarchpc.com



Consultant

BLAKE ENGINEERING PLLC
www.blake-engineering.com

Project Title



NO.	DATE	DESCRIPTION
1	10/18/24	ISSUED FOR BID
2	5/19/24	REVISED

Drawn By: BJK
Checked By: BJK
Proj. #: 44-13-01-06-0-017-014
CSArch Proj. #: 187-2302.01
Issued for Bid: 10/18/24

Sheet Title

ELECTRICAL
ROOF PLAN

Sheet No.

BES
E201

CONSTRUCTION DOCUMENTS

COPYRIGHT © ALL RIGHTS RESERVED.

MATERIALS LEGEND					
MATERIAL	MANUFACTURER	MODEL	COLOR #/NAME	SIZE	NOTE
LUXURY VINYL TILE					
LVT-1	MANNINGTON COMMERCIAL	COLOR ANCHOR - GROOVE	C141 MISTY MOUNTAIN	6" x 36"	MAIN OFFICE
PAINT					
PNT-1	SHERWIN WILLIAMS	EGGSHELL	AS SELECTED FROM FULL RANGE OF COLOR / MATCH EXISTING		VESTIBULES / LOBBY
PNT-2	SHERWIN WILLIAMS	EGGSHELL	AS SELECTED FROM FULL RANGE OF COLOR / MATCH EXISTING		OFFICE
PNT-3	SHERWIN WILLIAMS	SEMI-GLOSS	AS SELECTED FROM FULL RANGE OF COLOR / MATCH EXISTING		HM DOOR & DOOR FRAMES
PLASTIC LAMINATE					
PLAM-1	WILSONART	LAMINATE	5034 HANDSPUN DOVE		WORKSURFACE
PLAM-2	WILSONART	LAMINATE	D315 PLATINUM		CASEWORK
RUBBER BASE					
RB-1	TARKETT	BASEWORKS	AS SELECTED FROM FULL RANGE OF COLOR	4"	TYP. WALL BASE

ROOM FINISH SCHEDULE							
ROOM NUMBER	ROOM NAME	FLOOR		Wall Finish	Accent Wall	CEILING	Comments
		FINISH	BASE				
100	SECURITY VESTIBULE	ETR	RB-1	PNT-1			
101	VESTIBULE	ETR	RB-1	PNT-1			
102	LOBBY	ETR	ETR/ RB-1	ETR/ PNT-1			
103	MAIN OFFICE	LVT-1	RB-1	ETR/ PNT-2			

DISCLAIMER NOTE

MANUFACTURER'S NAMES AND FINISH INFORMATION ARE INDICATED AS REFERENCED TO THE ARCHITECT'S BASIS-OF-DESIGN SELECTIONS AND HAVE BEEN DETERMINED PRIOR TO BID. THE CONTRACTOR AND OWNER ARE HEREBY NOTIFIED THAT FINISHES INSTALLED IN THE WORK ARE SUBJECT TO CHANGE IN RESPONSE TO SUBMITTALS, CONFIRMED SELECTIONS, PRODUCT AVAILABILITY AND THE SUBSEQUENT COORDINATION OF FINISHES BY ARCHITECT AND MAY DIFFER FROM PRODUCTS LISTED HEREIN.

ABBREVIATIONS


ACMU	ARCHITECTURAL CONCRETE MASONRY UNIT
ACT	ACOUSTICAL CEILING TILE
APG	ACOUSTICAL PANEL CEILING
BBT	BIO-BASED TILE
BRK	BRICK
CFT	CERAMIC FLOOR TILE
CMU	CONCRETE MASONRY UNIT
CGC	CONCRETE
CRT	CARPET
CTB	CERAMIC TILE BASE
CMT	CERAMIC TILE MASONRY UNIT
ETR	EXISTING TO REMAIN
EXP	EXPOSED
EXBT	EXISTING
FAJ/FF	FACTORY FINISH
GNB	GYPSUM WALL BOARD
LMC	LINEAR METAL CEILING
MBS	MUSIC STORAGE SYSTEM
MWP	METAL WALL PANEL
PCON	POLISHED CONCRETE
PLAM	PLASTIC LAMINATE
PLAS	PLASTER
FNT	PAINT
RAF	RESILIENT ATHLETIC FLOORING
RB	RUBBER BASE
RF	RESINOUS FLOORING
RST	RUBBER STAIR TREAD / LANDING
RT	RUBBER TILE FLOORING
SCONG	SEALED CONCRETE
SS	STAINLESS STEEL
STF	SYNTHETIC TURF FLOORING
STL	STEEL
TERR	TERRAZZO
TP	TOILET PARTITIONS
TYP	TYPICAL
VCT	VINYL COMPOSITION TILE
VGTAS	VINYL COMPOSITION TILE ANTI-STATIC
VVC	VINYL WALLCOVERING
WAF	WOOD ATHLETIC FLOORING
WOD	WOOD
WOM	WALK-OFF MAT

GENERAL FINISH NOTES

- ALL EXPOSED SURFACES OF NEW PARTITIONS ARE TO BE PAINTED.
- WHEN ANY WORK IS PERFORMED ON ANY EXISTING WALL, THE ENTIRE WALL SURFACE IS TO BE PAINTED CORNER TO CORNER, UNLESS NOTED OTHERWISE.
- ALL ELECTRIC, MECHANICAL COMPONENTS AND TELEPHONE PANELS EXPOSED IN A ROOM TO MATCH WALL COLOR.

FINISH KEYS

Room Name (101)	Finish Tag
Wall Finish	
Base Finish	
Floor Finish	
PNT-#	ACCENT PAINT LOCATION
LVT-1	

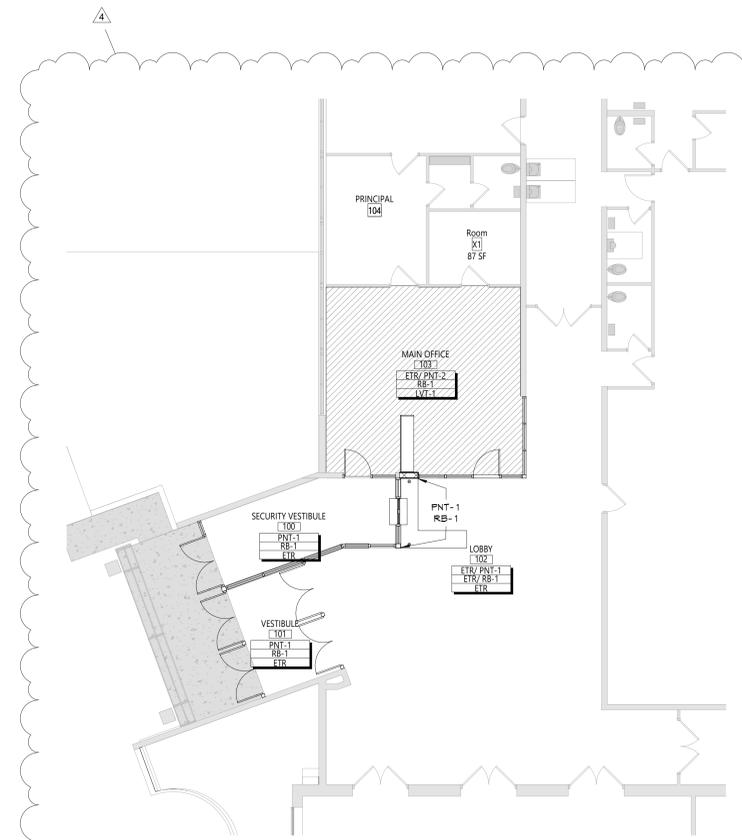

1 AREA A - PARTIAL FIRST FLOOR FINISH PLAN
AF111 1/8" = 1'-0"

ROOM FINISH SCHEDULE							
ROOM NUMBER	ROOM NAME	FLOOR		Wall Finish	Accent Wall	CEILING	Comments
		FINISH	BASE				
101	SECURITY VESTIBULE	LVT-1	RB-1	ETR/ PNT-1			
102	SRO	LVT-1	RB-1	ETR/ PNT-1			
103	MAIN OFFICE	LVT-1	RB-1	PNT-1			
X44	CORRIDOR	ETR	ETR/ RB-1	ETR/ PNT-1			

MATERIALS LEGND						
MATERIAL	MANUFACTURER	MODEL	COLOR #/NAME	SIZE	NOTE	
LUXURY VINYL TILE						
LVT-1	MANNINGTON COMMERCIAL	COLOR ANCHOR - GROOVE	C141 MISTY MOUNTAIN	6" x 36"	TYP. FIELD	
PAINT						
PNT-1	SHERWIN WILLIAMS	EGG-SHELL	AS SELECTED FROM FULL RANGE OF COLOR / MATCH EXISTING		GENERAL WALL PAINT	
PNT-2	SHERWIN WILLIAMS	SEMI-GLOSS	AS SELECTED FROM FULL RANGE OF COLOR / MATCH EXISTING		HM DOOR AND TRIM PAINT	
PLASTIC LAMINATE						
PLAM-1	WILSONART	LAMINATE	5034 HANDSPUN DOVE		WORKSURFACE	
PLAM-2	WILSONART	LAMINATE	D315 PLATINUM		CASEWORK	
RUBBER BASE						
RB-1	TARKETT	BASEWORKS	40 BLACK	MATCH EXISTING	TYP. BASE	



DISCLAIMER NOTE
 MANUFACTURER'S NAMES AND FINISH INFORMATION ARE INDICATED AS REFERENCED TO THE ARCHITECT'S BASIS-OF-DESIGN SELECTIONS AND HAVE BEEN DETERMINED PRIOR TO BID. THE CONTRACTOR AND OWNER ARE HEREBY NOTIFIED THAT FINISHES INSTALLED IN THE WORK ARE SUBJECT TO CHANGE IN RESPONSE TO SUBMITTALS, CONFIRMED SELECTIONS, PRODUCT AVAILABILITY AND THE SUBSEQUENT COORDINATION OF FINISHES BY ARCHITECT AND MAY DIFFER FROM PRODUCTS LISTED HEREIN.

ABBREVIATIONS


ACMU ARCHITECTURAL CONCRETE MASONRY UNIT
 ACT ACOUSTICAL CEILING TILE
 AFG ACOUSTICAL PANEL CEILING
 BBT BIO-BASED TILE
 BRK BRICK
 CFT CERAMIC FLOOR TILE
 CMU CONCRETE MASONRY UNIT
 CONC CONCRETE
 CRT CARPET
 CTB CERAMIC TILE BASE
 GWT CERAMIC WALL TILE
 ETR EXISTING TO REMAIN
 EXP EXPOSED
 EXST EXISTING
 FAC/FF FACTORY FINISH
 GNB GYPSUM WALL BOARD
 LMG LINEAR METAL CEILING
 MBS MDSB STORAGE SYSTEM
 MXP METAL WALL PANEL
 PCON POLISHED CONCRETE
 PLAM PLASTIC LAMINATE
 PLAS PLASTER
 FNT PAINT
 RAF RESILIENT ATHLETIC FLOORING
 RB RUBBER BASE
 RF RESINOUS FLOORING
 RST RUBBER STAIR TREAD / LANDING
 RT RUBBER TILE FLOORING
 SCONG SEALED CONCRETE
 SS STAINLESS STEEL
 STF SYNTHETIC TURF FLOORING
 STL STEEL
 TERR TERRAZZO
 TP TOILET PARTITIONS
 TYP TYPICAL
 VGT VINYL COMPOSITION TILE
 VGTAS VINYL COMPOSITION TILE ANTI-STATIC
 VVC VINYL WALLCOVERING
 WAF WOOD ATHLETIC FLOORING
 WD WOOD
 WOM WALK-OFF MAT

GENERAL FINISH NOTES

- ALL EXPOSED SURFACES OF NEW PARTITIONS ARE TO BE PAINTED.
- WHEN ANY WORK IS PERFORMED ON ANY EXISTING WALL, THE ENTIRE WALL SURFACE IS TO BE PAINTED CORNER TO CORNER, UNLESS NOTED OTHERWISE.

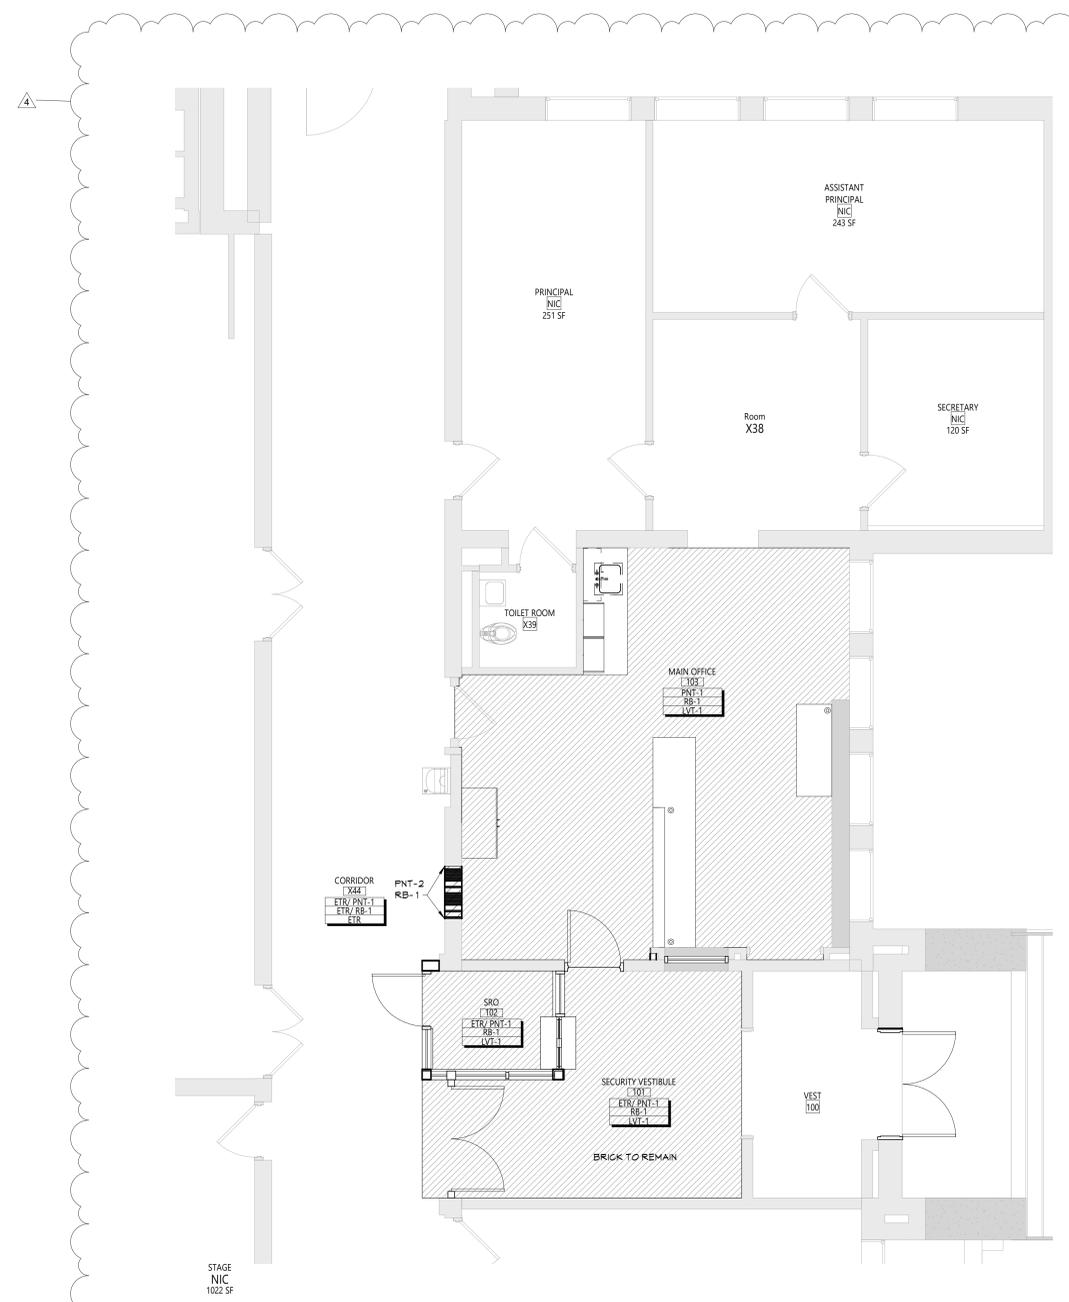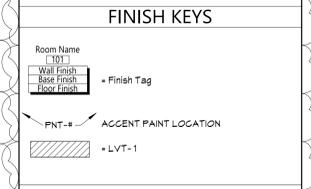

1 PARTIAL FINISH PLAN- FIRST FLOOR- AREA C
 AF111 1/4" = 1'-0"

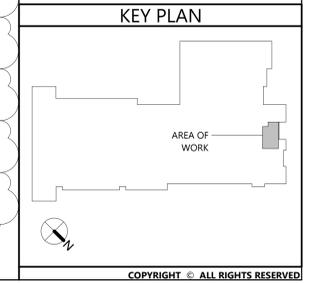

19 Front St., Newburgh, New York 12550-7601
 845-561-1319 www.csarch.com

CS ARCH

Consultant

**VALLEY CENTRAL SCHOOL DISTRICT
 MONTGOMERY ELEMENTARY SCHOOL
 2023 CAPITAL PROJECT - PHASE 1**

Project Title

EXPIRATION DATE: 02/28/2025

NO.	DATE	BID ADDENDUM #	DESCRIPTION
4	11/16/24		

Drawn By: AS
 Checked By: 44-13-01-06-0-004-015
 CSArch Proj. #: 187-2302-01
 Issued for Bid: 10/18/24

Sheet Title
MATERIAL SCHEDULE & FLOOR FINISHES PLAN - AREA C

Sheet No.
MES AF111

CONSTRUCTION DOCUMENTS

C:\Users\skawron\Documents\187-2302-01_VCSO_MES_skawron\ERW.rvt

ROOM FINISH SCHEDULE							
ROOM NUMBER	ROOM NAME	FLOOR		Wall Finish	Accent_Wall	CEILING	Comments
		FINISH	BASE				
22	MAIN OFFICE	LVT-1	RB-1	PNT-1			
22A	VESTIBULE	LVT-1	RB-1	PNT-1			
22B	SECURITY	LVT-1	RB-1	PNT-1			

MATERIALS LEGEND						
MATERIAL	MANUFACTURER	MODEL	COLOR #/NAME	SIZE	NOTE	
PAINT						
PNT-1	SHERWIN WILLIAMS	EGG-SHELL	AS SELECTED FROM FULL RANGE OF COLOR/ MATCH EXISTING		GENERAL WALL PAINT	
PNT-2	SHERWIN WILLIAMS	SEMI-GLOSS	AS SELECTED FROM FULL RANGE OF COLOR/ MATCH EXISTING		DOOR AND TRIM	
PLASTIC LAMINATE						
PLAM-1	WILSONART	LAMINATE	5034 HANDSPUN DOVE		WORKSURFACE	
PLAM-2	WILSONART	LAMINATE	D315 PLATINUM		CASEWORK	
RUBBER BASE						
RB-1	TARKETT	BASEWORKS	40 BLACK	4"	TYP. BASE	
VINYL COMPOSITION TILE						
LVT-1	MANNINGTON COMMERCIAL	COLOR ANCHOR - GROOVE	C141 MISTY MOUNTAIN	6" x 36"	TYP. FLOOR	

DISCLAIMER NOTE
 MANUFACTURER'S NAMES AND FINISH INFORMATION ARE INDICATED AS REFERENCED TO THE ARCHITECT'S BASIS-OF-DESIGN SELECTIONS AND HAVE BEEN DETERMINED PRIOR TO BID. THE CONTRACTOR AND OWNER ARE HEREBY NOTIFIED THAT FINISHES INSTALLED IN THE WORK ARE SUBJECT TO CHANGE IN RESPONSE TO SUBMITTALS, CONFIRMED SELECTIONS, PRODUCT AVAILABILITY AND THE SUBSEQUENT COORDINATION OF FINISHES BY ARCHITECT AND MAY DIFFER FROM PRODUCTS LISTED HEREIN.

ABBREVIATIONS

ACMU	ARCHITECTURAL CONCRETE MASONRY UNIT
ACT	ACOUSTICAL CEILING TILE
APG	ACOUSTICAL PANEL CEILING
BBT	BIO-BASED TILE
BRK	BRICK
CFT	CERAMIC FLOOR TILE
CMU	CONCRETE MASONRY UNIT
CGNC	CONCRETE
CRT	CARPET
CTB	CERAMIC TILE BASE
QNT	CERAMIC WALL TILE
ETR	EXISTING TO REMAIN
EXP	EXPOSED
EXST	EXISTING
FAC/FFF	FACTORY FINISH
GWB	GYPSUM WALL BOARD
LMG	LINEAR METAL CEILING
MBS	MUSIC STORAGE SYSTEM
MWP	METAL WALL PANEL
PCON	POLISHED CONCRETE
PLAM	PLASTIC LAMINATE
PLAS	PLASTER
PNT	PAINT
RAF	RESILIENT ATHLETIC FLOORING
RB	RUBBER BASE
RF	RESINOUS FLOORING
RST	RUBBER STAIR TREAD / LANDING
RT	RUBBER TILE FLOORING
SCONG	SEALED CONCRETE
SS	STAINLESS STEEL
STF	SYNTHETIC TURF FLOORING
STL	STEEL
TERR	TERRAZZO
TP	TOILET PARTITIONS
TYP	TYPICAL
VCT	VINYL COMPOSITION TILE
VCTAS	VINYL COMPOSITION TILE ANTI-STATIC
VVC	VINYL WALLCOVERING
WAF	WOOD ATHLETIC FLOORING
WOD	WOOD
WOM	WALK-OFF-MAT

GENERAL FINISH NOTES


- ALL EXPOSED SURFACES OF NEW PARTITIONS ARE TO BE PAINTED.
- WHEN ANY WORK IS PERFORMED ON ANY EXISTING WALL, THE ENTIRE WALL SURFACE IS TO BE PAINTED CORNER TO CORNER, UNLESS NOTED OTHERWISE.
- ALL ELECTRIC, MECHANICAL COMPONENTS AND TELEPHONE PANELS EXPOSED IN A ROOM TO MATCH WALL COLOR.

FINISH KEYS

Room Name [101]
 Wall Finish [101]
 Base Finish [101]
 Floor Finish [101] - Finish Tag

PNT-# - ACCENT PAINT LOCATION

[101] - LVT-1

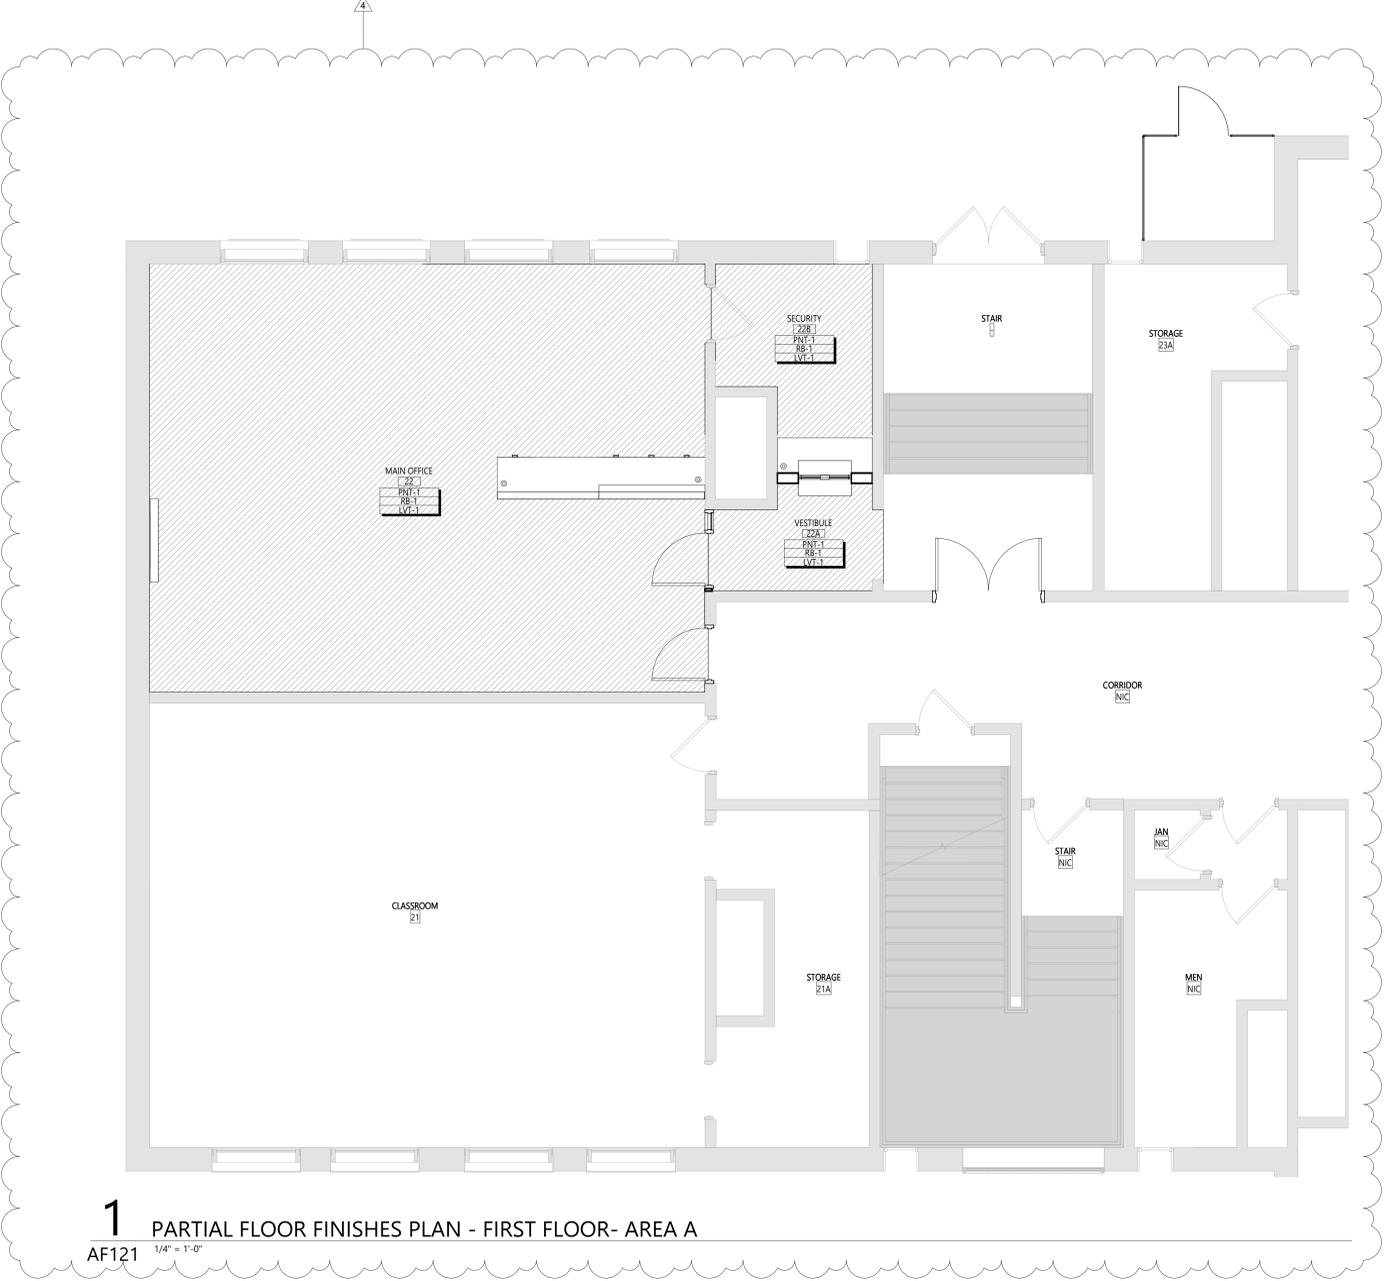

1 PARTIAL FLOOR FINISHES PLAN - FIRST FLOOR- AREA A
 AF121 1/4" = 1'-0"

KEY PLAN

AREA OF WORK

A B C

Sheet Title
 MATERIAL SCHEDULE & FINISH FLOOR PLAN - AREA A

Sheet No.
 MAY AF121

COPYRIGHT © ALL RIGHTS RESERVED
 CONSTRUCTION DOCUMENTS

19 Front St., Newburgh - New York 12550-7601
 845-561-1319 www.csarch.com

CS ARCH

Valley Central School District
 Maybrook Alternative Learning Center
 2023 Capital Project - Phase 1

Project Title

EXPIRATION DATE: 02/28/2025

NO.	DATE	BID ADDENDUM #	DESCRIPTION
1	11/16/24		

Drawn By: AS
 Checked By: [Signature]
 Proj. #: 44-13-01-06-0-002-013
 CSArch Proj. #: 187-2302-01
 Issued for Bid: 10/18/24

C:\Users\akawron\Documents\187-2302-01_VCSO MAY_akawron\ESRW.rvt

VALLEY CENTRAL SCHOOL DISTRICT VALLEY CENTRAL HIGH SCHOOL 2023 CAPITAL PROJECT - PHASE 1

ISSUED FOR BID: 10/18/24

CSARCH - ARCHITECTS

BLAKE ENGINEERING, PLLC - M.E.P. ENGINEERS

PASSERO ASSOCIATES - SITE/CIVIL AND STRUCTURAL ENGINEERS


AECC ENVIRONMENTAL CONSULTING - HAZARDOUS MATERIALS DESIGNERS

STATE EDUCATION DEPARTMENT PROJECT CONTROL NUMBER:

2023 CAPITAL PROJECT - PHASE 1 44-13-01-06-0-015-033

THE DESIGN OF THIS PROJECT CONFORMS TO APPLICABLE PROVISIONS OF THE NEW YORK STATE UNIFORM FIRE PREVENTION AND BUILDING CODE, THE NEW YORK STATE ENERGY CONSERVATION CONSTRUCTION CODE, AND THE MANUAL OF PLANNING STANDARDS OF THE NEW YORK STATE EDUCATION DEPARTMENT.

CSArch PROJECT NO. 187-2302.01

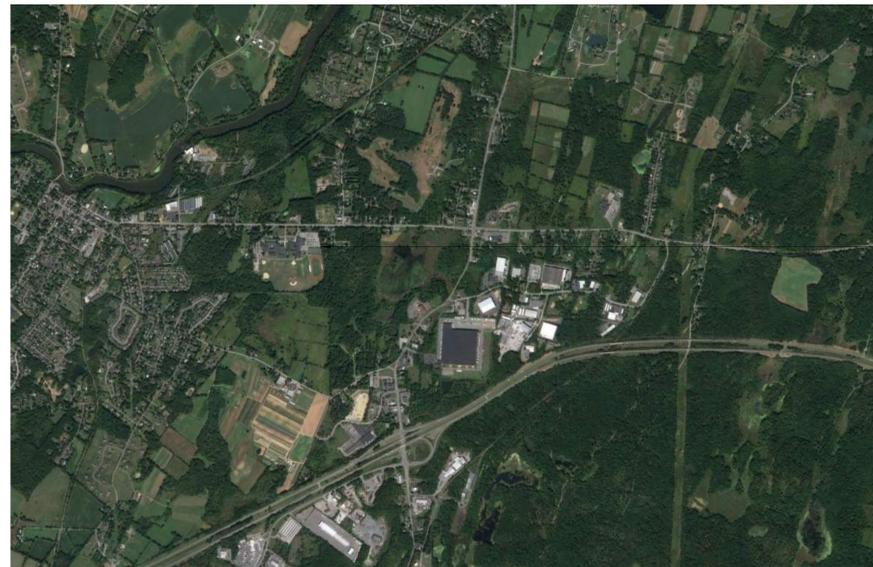

Valley Central High School
1175 NY-17K
Montgomery, NY 12549

VICINITY MAP

NTS




DRAWING LIST

GENERAL DRAWINGS	VCHS G000 COVER & SHEET INDEX VCHS G001 SYMBOLS, ABBREVIATIONS, MISC. & PARTITION TYPES VCHS G101 OVERALL FLOOR PLAN - BASEMENT VCHS G111 OVERALL FLOOR PLAN - FIRST FLOOR VCHS G121 OVERALL FLOOR PLAN - SECOND FLOOR VCHA G401 OVERALL ROOF PLAN	PLUMBING GENERAL DRAWINGS	VCHS P001 PLUMBING NOTES, SCHEDULE, LEGEND & DETAILS
LIFE SAFETY DRAWINGS	VCHS LS101 BASEMENT LIFE SAFETY PLAN VCHS LS111 FIRST FLOOR LIFE SAFETY PLAN VCHS LS112 SMOKE ZONE PLANS	PLUMBING DEMOLITION DRAWINGS	VCHS PD301 BOILER ROOM PLUMBING DEMOLITION PLAN
HAZARDOUS MATERIALS DRAWINGS	VCHS AA100 ASBESTOS ABATEMENT FIRST FLOOR AREA C VCHS AA200 ASBESTOS ABATEMENT SECOND FLOOR AREA C	PLUMBING DRAWINGS	VCHS P301 PLUMBING PLAN
ARCHITECTURAL DEMOLITION DRAWINGS	VCHS AD111 FIRST FLOOR REMOVAL PLAN - AREA A VCHS AD112 FIRST FLOOR REMOVAL PLAN - AREA C & D VCHS AD401 ROOF REMOVAL PLAN - AREA C & D VCHS AD802 REFLECTED CEILING REMOVAL PLAN - AREA C & D	MECHANICAL GENERAL DRAWINGS	VCHS M001 MECHANICAL NOTES, LEGEND, SCHEDULE & DETAILS VCHS M002 MECHANICAL SCHEDULES VCHS M003 MECHANICAL SCHEDULES VCHS M004 MECHANICAL DETAILS VCHS M005 TEMPERATURE CONTROLS NOTES, LEGEND & SCHEMATICS VCHS M006 MECHANICAL PIPING DIAGRAMS
ARCHITECTURAL DRAWINGS	VCHS A101 BOILER ROOM PLANS AND DETAILS VCHS A111 ENLARGED VESTIBULE PLAN, SECTION AND DETAILS VCHS A112 AREA C & D - FIRST FLOOR NEW WORK PLAN VCHS A201 EXTERIOR ELEVATIONS VCHS A202 EXTERIOR ELEVATIONS VCHS A402 ROOF PLAN - AREA A, C, & D VCHS A801 REFLECTED CEILING PLAN & CEILING DETAIL - AREA A VCHS A802 FIRST FLOOR REFLECTED CEILING PLAN - AREA C & D VCHS A901 DOOR, WINDOW, & STOREFRONT DETAILS	MECHANICAL DEMOLITION DRAWINGS	VCHS MD111 MECHANICAL DEMOLITION PLAN VCHS MD211 MECHANICAL DEMOLITION PLAN - PART 1 VCHS MD212 MECHANICAL DEMOLITION PLAN - PART 2 VCHS MD301 MECHANICAL DEMOLITION PLAN
ARCHITECTURAL FINISH DRAWINGS	VCHS AF001 MATERIAL SCHEDULE VCHS AF002 SIGNAGE TYPES AND SCHEDULE VCHS AF112 AREA C & D - FLOOR FINISHES PLAN	MECHANICAL DRAWINGS	VCHS M111 SECURITY VESTIBULE MECHANICAL PLAN VCHS M211 MECHANICAL PLAN - PART 1 VCHS M212 MECHANICAL PLAN - PART 2 VCHS M301 MECHANICAL PLAN
		ELECTRICAL GENERAL DRAWINGS	VCHS E001 ELECTRICAL NOTES, LEGEND, DETAILS & SCHEDULES VCHS E002 ELECTRICAL PANEL SCHEDULES
		ELECTRICAL DEMOLITION DRAWINGS	VCHS ED111 ELECTRICAL DEMOLITION PLAN VCHS ED211 ELECTRICAL DEMOLITION PLAN VCHS ED301 ELECTRICAL DEMOLITION PLAN
		ELECTRICAL DRAWINGS	VCHS E111 ELECTRICAL PLAN VCHS E211 ELECTRICAL PLAN VCHS E301 ELECTRICAL PLAN




EXPIRATION DATE: 02/28/2025

VOLUME 5 OF 8

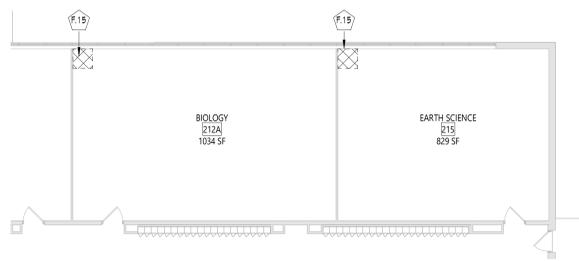

2 SECOND FLOOR REMOVAL PLAN - AREA D
AD112 3/32" = 1'-0"

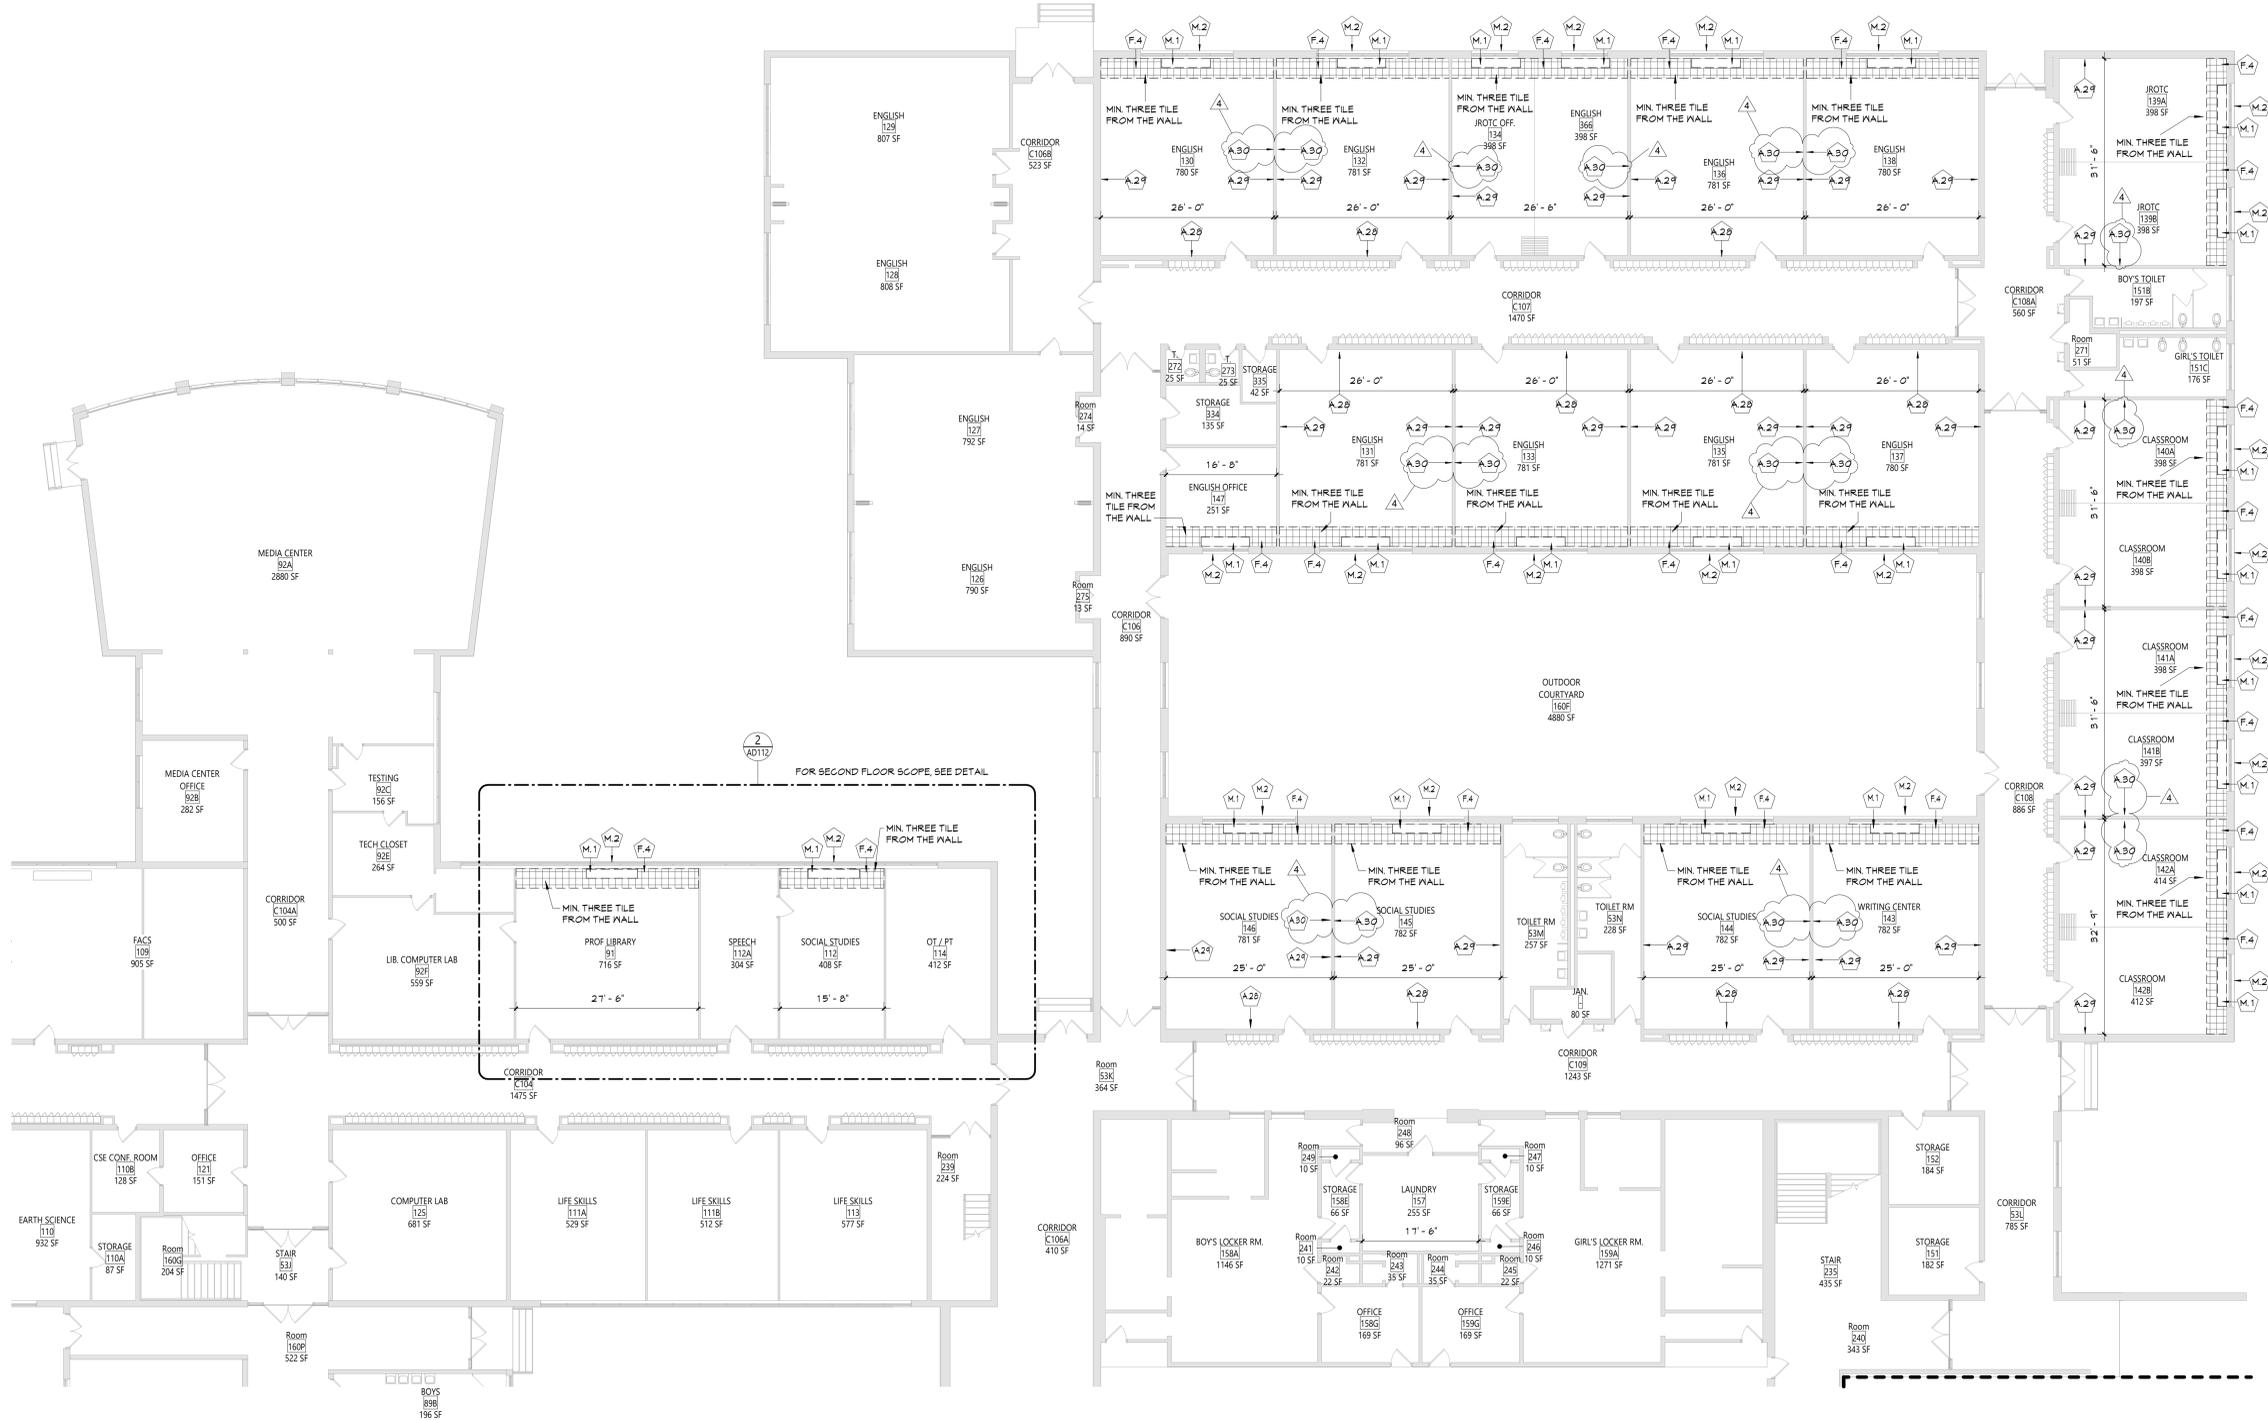

1 FIRST FLOOR REMOVAL PLAN - AREA C & D
AD112 3/32" = 1'-0"


GENERAL NOTES

- COORDINATE ALL REMOVALS WITH NEW CONSTRUCTION.
- PATCH AND REPLACE EXISTING WITH NEWLY CREATED HOLES IN WALLS (DUE TO REMOVAL) WITH MATERIALS TO MATCH EXISTING CONSTRUCTION.
- SALVAGED ITEMS SHALL BE TURNED OVER TO OWNER UNO.
- ALL KEYPED REMOVALS SHALL INCLUDE REMOVAL OF ANY AND ALL ANCHORING SYSTEMS INCLUDING OBJECTS EMBEDDED INTO EXISTING WALLS.
- REFER TO ASBESTOS AND MEP DRAWINGS FOR ADDITIONAL REMOVAL INFORMATION.
- PROVIDE TEMPORARY SHORING AS NECESSARY AT ALL AREAS OF WALL REMOVAL AND NEW WALL PENETRATIONS.
- DRILL CORNERS OF ALL NEW SANGUIT OPENING PRIOR TO SANGUITTING, TO PREVENT CUTTING INTO SCHEDULED CONSTRUCTION TO REMAIN.

DEMOLITION KEYNOTES

#	Description
A.28	REMOVE EXISTING 10' WIDE BY 4' HIGH TACKBOARD/CHALKBOARD. PATCH WALL AS REQUIRED.
A.29	REMOVE EXISTING 20' WIDE BY 4' HIGH TACKBOARD/SHALKBOARD. PATCH WALL AS REQUIRED.
A.30	OWNER TO REMOVE DIGITAL DISPLAY BOARD ONLY. REMOVE WALL MOUNTED BRACKET ASSOCIATED WITH DIGITAL DISPLAY BOARD AND SALVAGE FOR REINSTALLATION.
F.4	REMOVE 3 ROWS OF VGT TILE FROM EXTERIOR WALL WITH THE REMOVAL OF UNIT VENTS.
F.15	SANGUIT AND REMOVE EXISTING FLOOR FINISH AND CONCRETE SLAB TO ACCOMMODATE NEW VERTICAL MECHANICAL CHASE.
M.1	UNIT VENTILATOR. REFER TO MECHANICAL DRAWINGS FOR ADDITIONAL INFORMATION.
M.2	EXTERIOR WALL GRILL. REFER TO MECHANICAL DRAWINGS FOR ADDITIONAL INFORMATION.

KEY PLAN

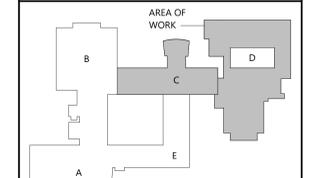

19 Front St., Newburgh - New York 12550-7601
845-561-3179 www.csarch.com

CS ARCH

**VALLEY CENTRAL SCHOOL DISTRICT
VALLEY CENTRAL HIGH SCHOOL
2023 CAPITAL PROJECT - PHASE 1**

Project Title



EXPIRATION DATE: 02/28/2025

#	DATE	DESCRIPTION
1	11/19/24	BID ADDENDUM #1
2	11/16/24	BID ADDENDUM #2
3		


Drawn By: *[Signature]* Author
Checked By: *[Signature]* 44-13-01-06-0-015-033
CSArch Proj. #: 187-2302-01
Issued for Bid: 10/18/24

Sheet Title
**FIRST FLOOR
REMOVAL
PLAN - AREA C
& D**


Sheet No.
**VCHS
AD112**

CONSTRUCTION DOCUMENTS

COPYRIGHT © ALL RIGHTS RESERVED

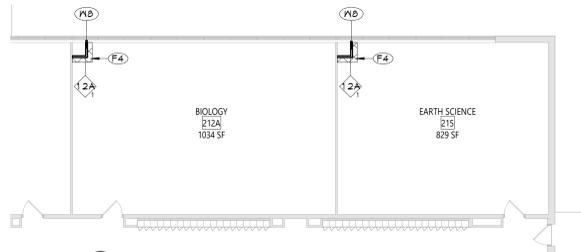

2 AREA C - SECOND FLOOR PLAN
A112 3/32" = 1'-0"

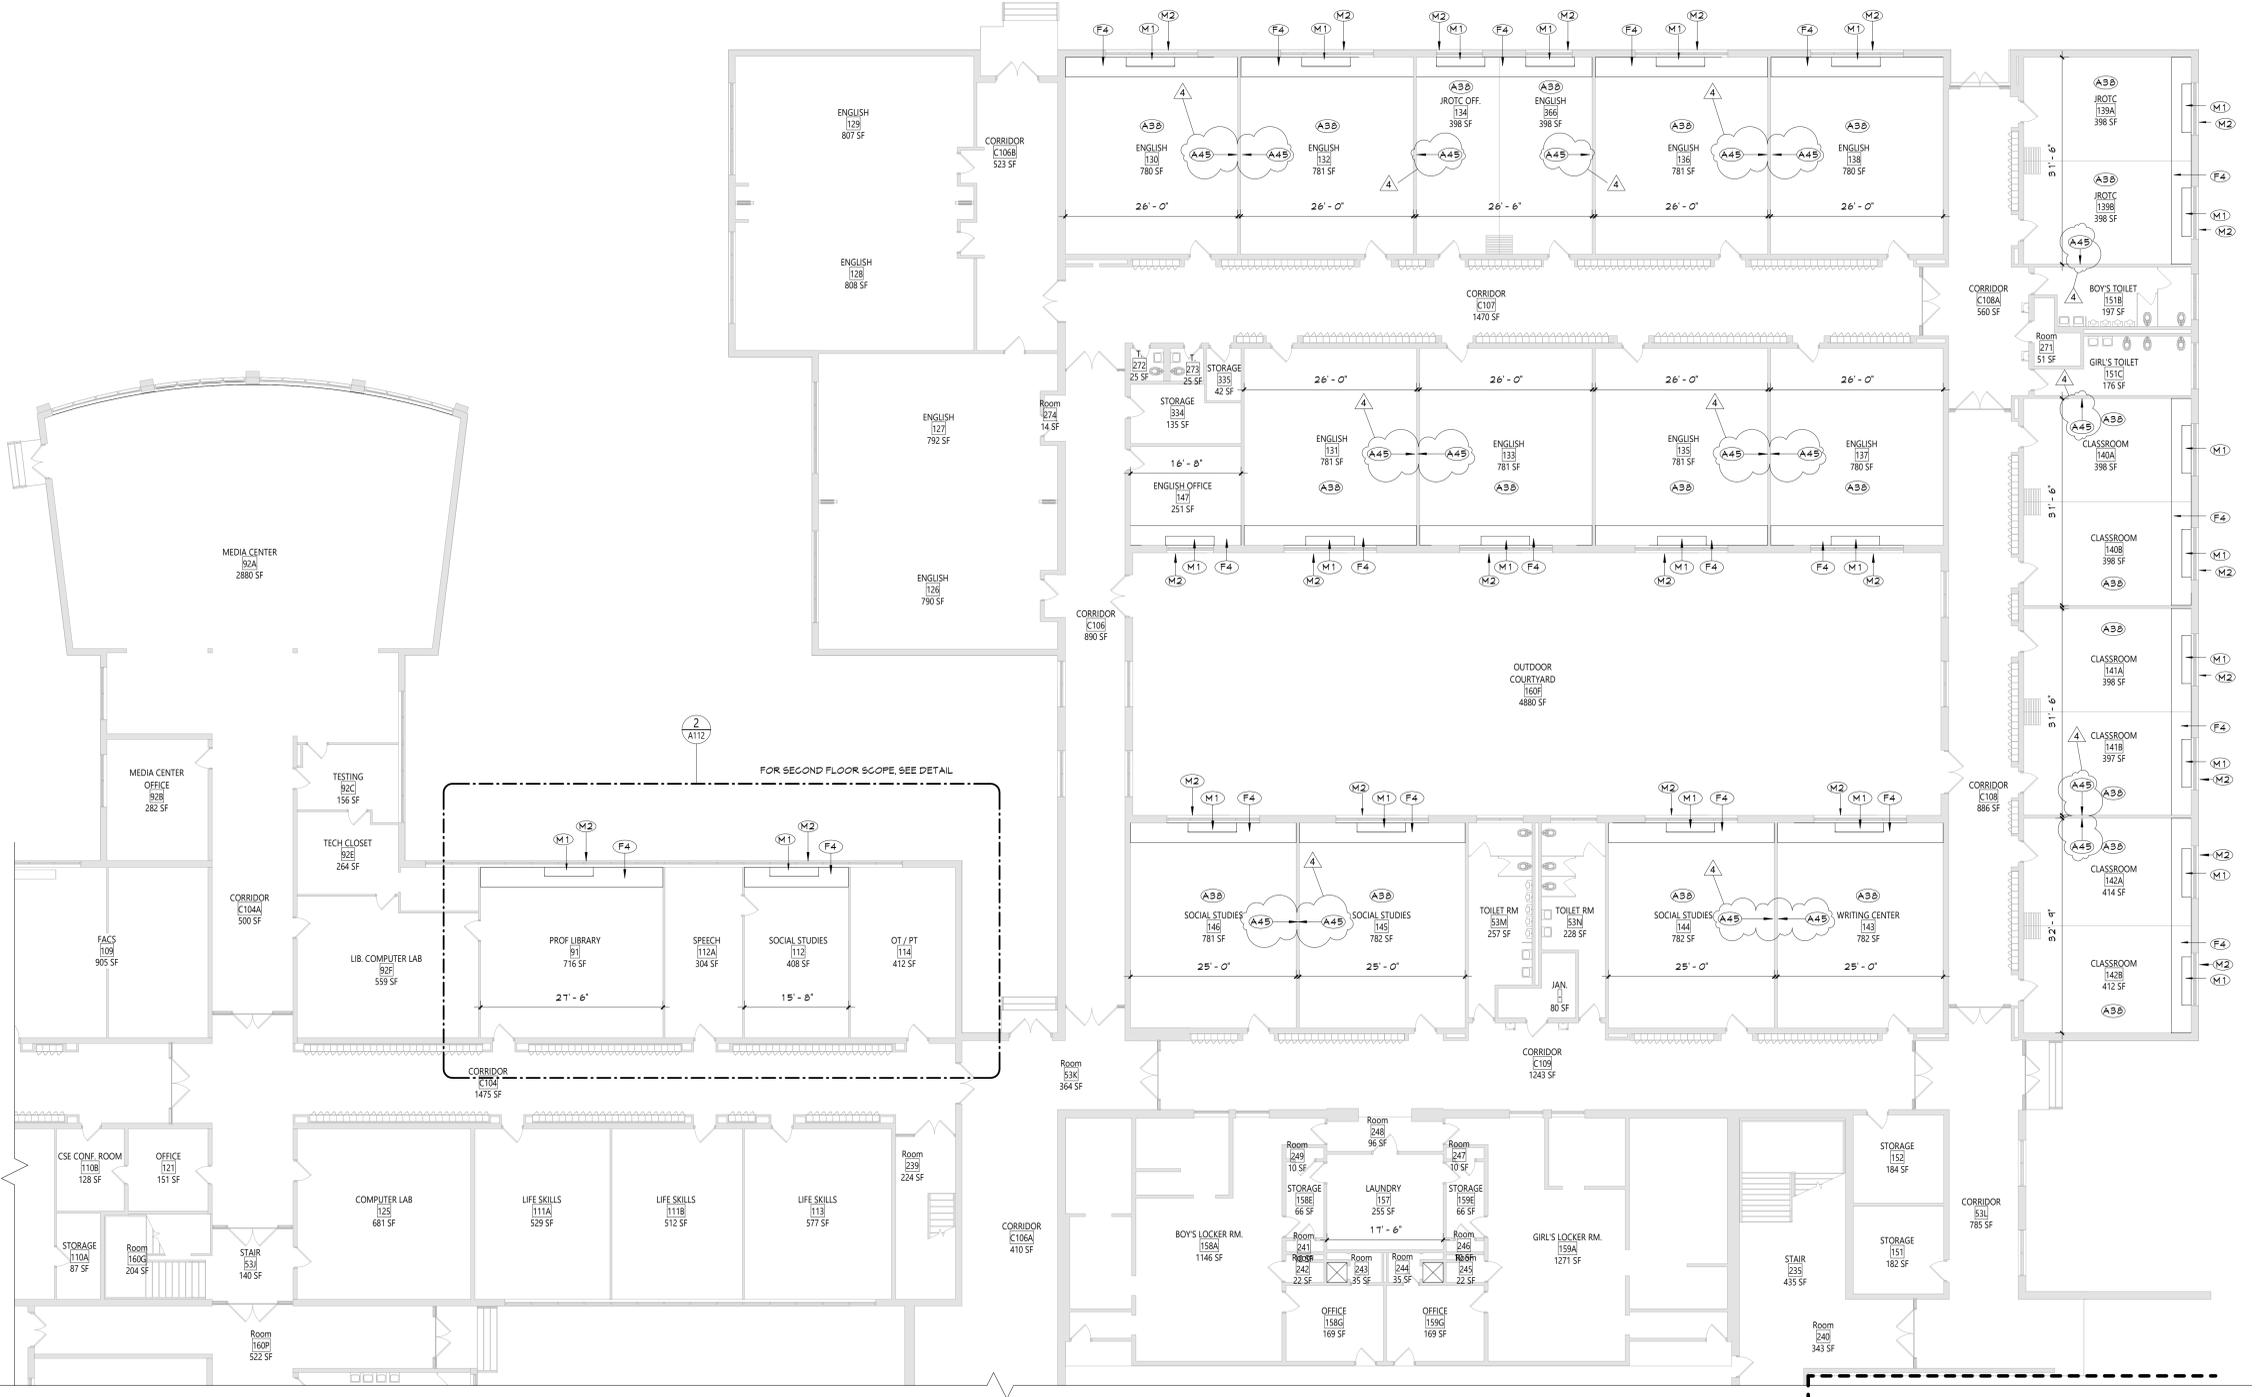

1 AREA C & D - FIRST FLOOR NEW WORK PLAN
A112 3/32" = 1'-0"


GENERAL NOTES

- REFER TO SHEET 001 FOR ADDITIONAL GENERAL NOTES.
- REFER TO A900 SERIES DRAWINGS FOR DOOR, STOREFRONT, CURTAIN WALL, WINDOW AND LOUVER SCHEDULES, DETAILS AND NOTES.
- REFER TO SHEET 001 FOR PARTITION TYPES AND ADDITIONAL NOTES.

NEW WORK KEYNOTES

#	Description
A3B	PAINT ALL WALLS IN ROOM.
A4S	REINSTALL SALVAGED WALL MOUNTED BRACKET FOR DIGITAL DISPLAY BOARD AFTER THE COMPLETION OF THE CHALKBOARD REMOVAL. COORDINATE FINAL LOCATION WITH OWNER. OWNER TO REINSTALL DIGITAL DISPLAY BOARD ON BRACKET.
F4	PROVIDE NEW 12'x12' VCT FLOORING AND RUBBER WALL BASE WHERE FLOORING HAS PREVIOUSLY REMOVED.
M1	UNIT VENT. REFER TO MEP DRAWINGS.
M2	CONDENSING UNIT. REFER TO MEP DRAWINGS.
M3	PROVIDE NEW CHAIN LINK FABRIC FOR MECHANICAL EQUIPMENT.

KEY PLAN

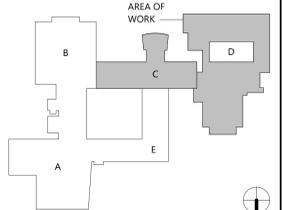

19 Front St., Newburgh - New York 12550-7601
845-561-1319 www.csarch.com



**VALLEY CENTRAL SCHOOL DISTRICT
VALLEY CENTRAL HIGH SCHOOL
2023 CAPITAL PROJECT - PHASE 1**

Project Title



EXPIRATION DATE: 02/28/2025

#	DATE	DESCRIPTION
1	11/19/24	BID ADDENDUM #1
2	11/26/24	BID ADDENDUM #2

Drawn By:	Author
Checked By:	44-13-01-06-0-015-033
Proj. #:	187-2302.01
CSArch Proj. #:	10/18/24
Issued for Bid:	

Sheet Title
AREA C & D - FIRST FLOOR NEW WORK PLAN

Sheet No.
VCHS A112

CONSTRUCTION DOCUMENTS

C:\Users\jmlle\Documents\187-2302.01 VCHS\Drawings\A112.dwg

COPYRIGHT © ALL RIGHTS RESERVED

ROOM FINISH SCHEDULE							
ROOM NUMBER	ROOM NAME	FLOOR		Wall Finish	Accent_Wall	CEILING	Comments
		FINISH	BASE				
91	PROF LIBRARY	ETR/VCT-1	ETR/RB-3	ETR			
112	SOCIAL STUDIES	ETR/VCT-1	ETR/RB-3	ETR			
130	ENGLISH	ETR/VCT-1	ETR/RB-3	ETR			
131	ENGLISH	ETR/VCT-1	ETR/RB-3	ETR			
132	ENGLISH	ETR/VCT-1	ETR/RB-3	ETR			
133	ENGLISH	ETR/VCT-1	ETR/RB-3	ETR			
134	JROTC OFF.	ETR/VCT-1	ETR/RB-3	ETR			
135	ENGLISH	ETR/VCT-1	ETR/RB-3	ETR			
136	ENGLISH	ETR/VCT-1	ETR/RB-3	ETR			
137	ENGLISH	ETR/VCT-1	ETR/RB-3	ETR			
138	ENGLISH	ETR/VCT-1	ETR/RB-3	ETR			
139A	JROTC	ETR/VCT-1	ETR/RB-3	ETR			
139B	JROTC	ETR/VCT-1	ETR/RB-3	ETR			
140A	CLASSROOM	ETR/VCT-1	ETR/RB-3	ETR			
140B	CLASSROOM	ETR/VCT-1	ETR/RB-3	ETR			
141A	CLASSROOM	ETR/VCT-1	ETR/RB-3	ETR			
141B	CLASSROOM	ETR/VCT-1	ETR/RB-3	ETR			
142A	CLASSROOM	ETR/VCT-1	ETR/RB-3	ETR			
142B	CLASSROOM	ETR/VCT-1	ETR/RB-3	ETR			
143	WRITING CENTER	ETR/VCT-1	ETR/RB-3	ETR			
144	SOCIAL STUDIES	ETR/VCT-1	ETR/RB-3	ETR			
145	SOCIAL STUDIES	ETR/VCT-1	ETR/RB-3	ETR			
146	SOCIAL STUDIES	ETR/VCT-1	ETR/RB-3	ETR			
147	ENGLISH OFFICE	ETR/VCT-1	ETR/RB-3	ETR			
284	RECEPTION	ETR	ETR/RB-2	ETR/PNT-1			
285	VESTIBULE	ETR	RB-1	PNT-1			
286	SECURITY OFF.	ETR	RB-1	PNT-1			
287	VESTIBULE	ETR	RB-1	PNT-1			
366	ENGLISH	ETR/VCT-1	ETR/RB-3	ETR			
C111	CORRIDOR	ETR	ETR/RB-1	ETR/PNT-1,2			



MATERIALS LEGEND					
MATERIAL	MANUFACTURER	MODEL	COLOR #/NAME	SIZE	NOTE
PAINT					
PNT-1	SHERWIN WILLIAMS	EG-SHELL	AS SELECTED FROM FULL RANGE OF COLOR/ MATCH EXISTING		GENERAL WALL PAINT
PNT-2	SHERWIN WILLIAMS	EGGSHELL	AS SELECTED FROM FULL RANGE OF COLOR/ MATCH EXISTING		ACCENT
PNT-3	SHERWIN WILLIAMS	SEMI-GLOSS	AS SELECTED FROM FULL RANGE OF COLOR/ MATCH EXISTING		HM DOOR PAINT
PLASTIC LAMINATE					
PLAM-1	WILSONART	LAMINATE	5043 HANDSPUN DOVE		WORKSURFACE
PLAM-2	WILSONART	LAMINATE	D315 PLATINUM		CASEWORK
RUBBER BASE					
RB-1	TARKETT	BASEWORKS	40 BLACK	4"	VESTIBULE/ SECURITY OFFICE
RB-2	TARKETT	BASEWORKS	AS SELECTED FROM FULL RANGE OF COLOR/ MATCH EXISTING	MATCH EXISTING	RECEPTION
RB-3	TARKETT	BASEWORKS	AS SELECTED FROM FULL RANGE OF COLOR/ MATCH EXISTING	MATCH EXISTING	CLASSROOMS
VINYL COMPOSITION TILE					
VCT-1	ARMSTRONG	STANDARD EXCELON	AS SELECTED FROM FULL RANGE OF COLOR/ MATCH EXISTING	12" X 12"	CLASSROOMS

DISCLAIMER NOTE
 MANUFACTURER'S NAMES AND FINISH INFORMATION ARE INDICATED AS REFERENCED TO THE ARCHITECT'S BASIS-OF-DESIGN SELECTIONS AND HAVE BEEN DETERMINED PRIOR TO BID. THE CONTRACTOR AND OWNER ARE HEREBY NOTIFIED THAT FINISHES INSTALLED IN THE WORK ARE SUBJECT TO CHANGE IN RESPONSE TO SUBMITTALS, CONFIRMED SELECTIONS, PRODUCT AVAILABILITY AND THE SUBSEQUENT COORDINATION OF FINISHES BY ARCHITECT AND MAY DIFFER FROM PRODUCTS LISTED HEREIN.


ABBREVIATIONS
 ACMU ARCHITECTURAL CONCRETE MASONRY UNIT
 ACT ACoustICAL CEILING TILE
 APG ACoustICAL PANEL CEILING
 BBT BIO-BASED TILE
 BRK BRICK
 CFT CERAMIC FLOOR TILE
 CMU CONCRETE MASONRY UNIT
 CGC CONCRETE
 CRT CERAMIC TILE
 CTB CERAMIC TILE BASE
 GNT CERAMIC WALL TILE
 ETR EXISTING TO REMAIN
 EXP EXPOSED
 EXST EXISTING
 FAC/FF FACTORY FINISH
 GNB GYPStUM WALL BOARD
 LMG LINEAR METAL CEILING
 MSB MUGB STORAGE SYSTEM
 MWP METAL WALL PANEL
 PCGN POLISHED CONCRETE
 PLAM PLASTIC LAMINATE
 PLAS PLASTER
 PNT PAINT
 RAF RESILIENT ATHLETIC FLOORING
 RB RUBBER BASE
 REF RESINOUS FLOORING
 RST RUBBER STAIR TREAD / LANDING
 RT RUBBER TILE FLOORING
 SCONG SEALED CONCRETE
 SS SOLID SURFACE
 STF SYNTHETIC TURF FLOORING
 STL STEEL
 TB TERRAZZO BASE
 TERR TERRAZZO
 TP TYPICAL PARTITIONS
 TYP TYPICAL
 VCT VINYL COMPOSITION TILE
 VCTAS VINYL COMPOSITION TILE ANTI-STATIC
 VMC VINYL WALLCOVERING
 WAF WOOD ATHLETIC FLOORING
 WD WOOD
 WDM WALK-OFF MAT

GENERAL FINISH NOTES

- ALL EXPOSED SURFACES OF NEW PARTITIONS ARE TO BE PAINTED.
- WHEN ANY WORK IS PERFORMED ON ANY EXISTING WALL, THE ENTIRE WALL SURFACE IS TO BE PAINTED CORNER TO CORNER, UNLESS NOTED OTHERWISE.

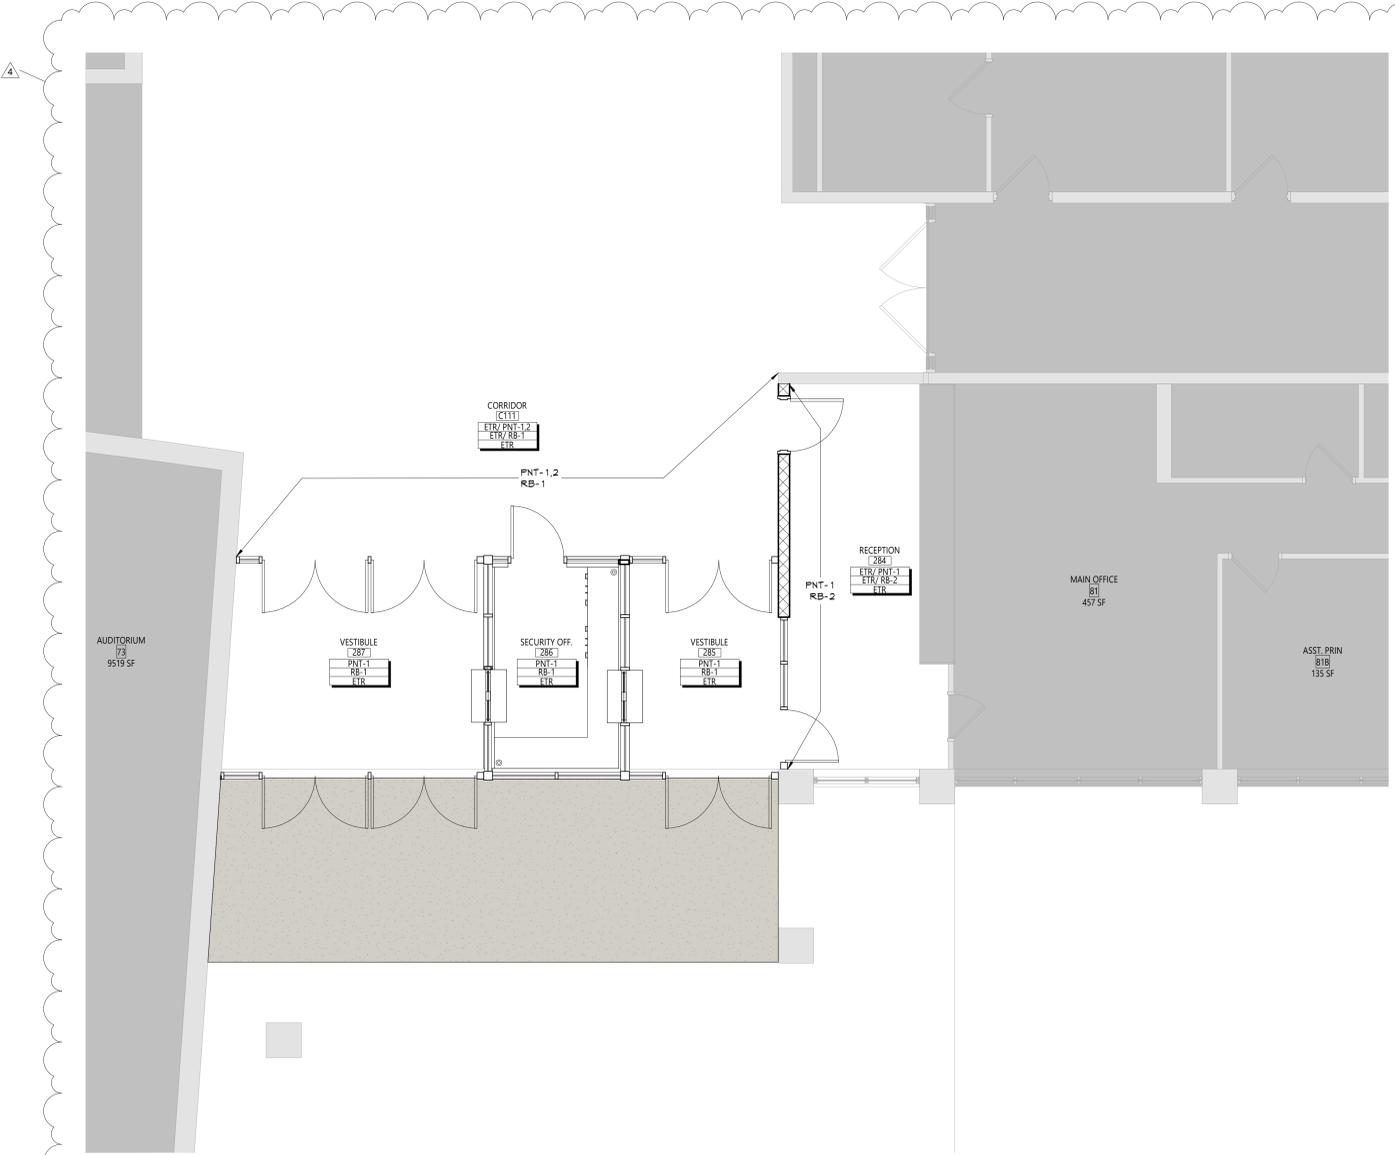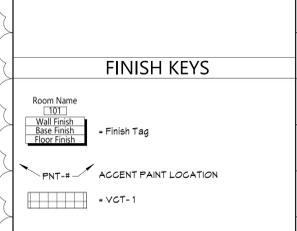

1 AREA A - PARTIAL FIRST FLOOR FINISH PLAN
 AF001 1/4" = 1'-0"

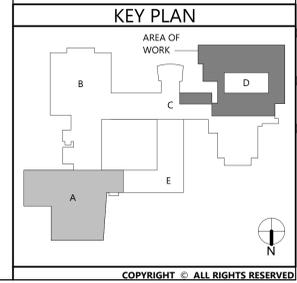

19 Front St., Newburgh - New York 12550-7601
 845-561-3179 www.csarch.com

CS ARCH

Valley Central School District
 Valley Central High School
 2023 Capital Project - Phase 1

Project Title

EXPIRATION DATE: 02/28/2025

NO.	DATE	BID ADDENDUM #	DESCRIPTION
4	11/16/24		

Drawn By: [Signature] Auditor
 Checked By: [Signature] Checker
 Proj. #: 44-13-01-06-0-015-033
 CSArch Proj. #: 187-2302-01
 Issued for Bid: 3/1/18/24


Sheet Title
MATERIAL SCHEDULE AND ENLARGED VESTIBULE

Sheet No.
VCHS AF001

COPYRIGHT © ALL RIGHTS RESERVED
 CONSTRUCTION DOCUMENTS

C:\Users\skawron\Documents\187-2302-01 VCHS VCHS_sskawron\EBRW-04

C:\Users\skawron\Documents\187-2302.01 VCSO VCHS -skawron\LEBRW-04

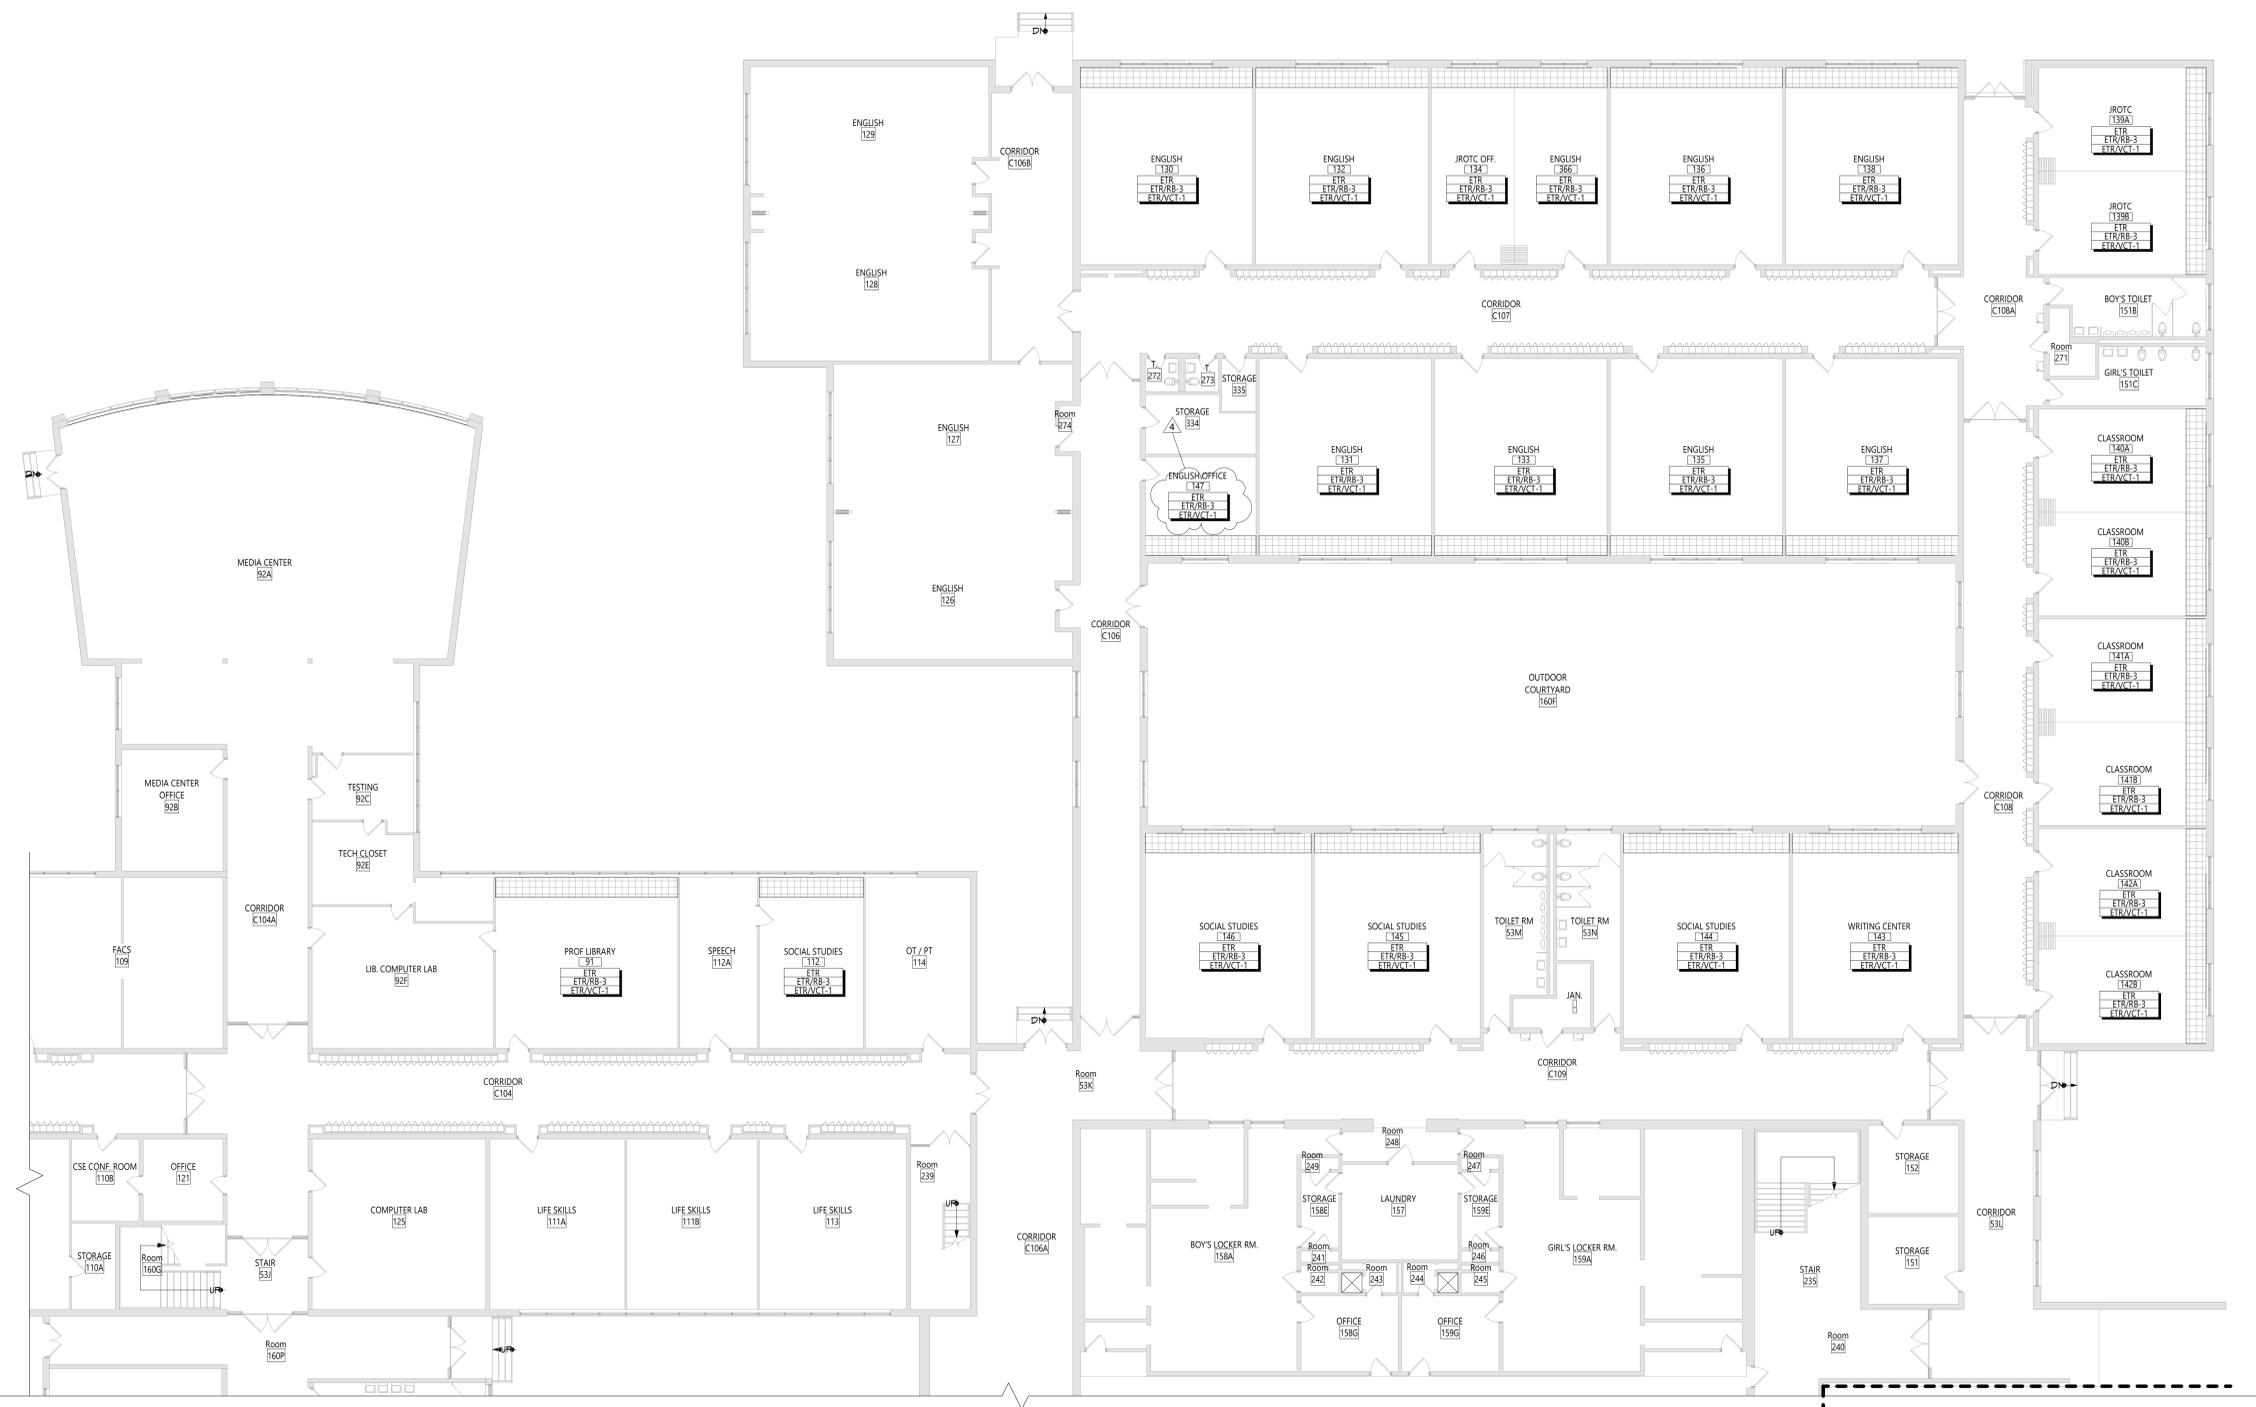

1
 AF112 3/32" = 1'-0"
 AREA C & D - FIRST FLOOR FINISHES PLAN

DISCLAIMER NOTE
 MANUFACTURER'S NAMES AND FINISH INFORMATION ARE INDICATED AS REFERENCED TO THE ARCHITECT'S BASIS-OF-DESIGN SELECTIONS AND HAVE BEEN DETERMINED PRIOR TO BID. THE CONTRACTOR AND OWNER ARE HEREBY NOTIFIED THAT FINISHES INSTALLED IN THE WORK ARE SUBJECT TO CHANGE IN RESPONSE TO SUBMITTALS, CONFIRMED SELECTIONS, PRODUCT AVAILABILITY AND THE SUBSEQUENT COORDINATION OF FINISHES BY ARCHITECT AND MAY DIFFER FROM PRODUCTS LISTED HEREIN.

ABBREVIATIONS

ACMU	ARCHITECTURAL CONCRETE MASONRY UNIT
ACT	ACOUSTICAL CEILING TILE
APG	ACOUSTICAL PANEL CEILING
BBT	BIO-BASED TILE
BRK	BRICK
CFT	CERAMIC FLOOR TILE
CMU	CONCRETE MASONRY UNIT
CONC	CONCRETE
CPT	CARPET
CTB	CERAMIC TILE BASE
QMT	CERAMIC WALL TILE
ETR	EXISTING TO REMAIN
EXP	EXPOSED
EXST	EXISTING
FAC/FF	FACTORY FINISH
GWB	GYPSUM WALL BOARD
LMG	LINEAR METAL CEILING
MSS	MUSIC STORAGE SYSTEM
MWP	METAL WALL PANEL
PCON	POLISHED CONCRETE
FLAM	PLASTIC LAMINATE
PLAS	PLASTER
FNT	PAINT
RAF	RESILIENT ATHLETIC FLOORING
RB	RUBBER BASE
RF	RESINOUS FLOORING
RST	RUBBER STAIR TREAD / LANDING
RT	RUBBER TILE FLOORING
SCONC	SEALED CONCRETE
SS	SOLID SURFACE
STF	SYNTHETIC TURF FLOORING
STL	STEEL
TB	TERRAZZO BASE
TERR	TERRAZZO
TYP	TYPICAL
TP	TOILET PARTITIONS
TVP	TYPICAL
VGT	VINYL COMPOSITION TILE
VGTAS	VINYL COMPOSITION TILE ANTI-STATIC
VMG	VINYL WALLCOVERING
WAF	WOOD ATHLETIC FLOORING
WD	WOOD
WOM	WALK-OFF MAT

GENERAL FINISH NOTES

- ALL EXPOSED SURFACES OF NEW PARTITIONS ARE TO BE PAINTED.
- WHEN ANY WORK IS PERFORMED ON ANY EXISTING WALL, THE ENTIRE WALL SURFACE IS TO BE PAINTED CORNER TO CORNER, UNLESS NOTED OTHERWISE.

FINISH KEYS

Room Name	[]	Finish Tag
Wall Finish	[]	
Base Finish	[]	
Floor Finish	[]	
FNT - #	[]	ACCENT PAINT LOCATION
VCT - 1	[]	

KEY PLAN

19 Front St., Newburgh - New York 12550-7601
 845-561-1319 www.csarch.com

CS ARCH

Consultant

**VALLEY CENTRAL SCHOOL DISTRICT
 VALLEY CENTRAL HIGH SCHOOL
 2023 CAPITAL PROJECT - PHASE 1**

Project Title

EXPIRATION DATE: 02/28/2025

NO.	DATE	DESCRIPTION
1	11/16/24	BID ADDENDUM #1

Drawn By: []
 Checked By: []
 Proj. #: 44-13-01-06-0-015-033
 CSArch Proj. #: 187-2302.01
 Issued for Bid: 10/18/24

Sheet Title
AREA C & D - FLOOR FINISHES PLAN

Sheet No.
VCHS AF112

COPYRIGHT © ALL RIGHTS RESERVED
 CONSTRUCTION DOCUMENTS

FAN SCHEDULE												
EQUIPMENT TAG	MANUFACTURER	MODEL	SERVICE	FAN C.F.M.	R.P.M.	EXTERNAL STATIC PRESSURE INCH H ₂ O	MOTOR					REMARKS
							POWER (HP)	FLA	VOLT.	PHASE	HZ	
EF-91	GREENHECK	G-140-VG	CLASSROOM 91	450 / 1,250	885	0.25	1/4	3.8	120	1	60	PROVIDE W/ FAN SPEED CONTROLLER, 24" HIGH INSULATED ROOF CURB & BACKDRAFT DAMPER
EF-112	GREENHECK	G-140-VG	CLASSROOM 112	450 / 1,250	885	0.25	1/4	3.8	120	1	60	PROVIDE W/ FAN SPEED CONTROLLER, 24" HIGH INSULATED ROOF CURB & BACKDRAFT DAMPER
EF-130	GREENHECK	G-140-VG	CLASSROOM 131	450 / 1,250	885	0.25	1/4	3.8	120	1	60	PROVIDE W/ FAN SPEED CONTROLLER, 24" HIGH INSULATED ROOF CURB & BACKDRAFT DAMPER
EF-131	GREENHECK	G-140-VG	CLASSROOM 131	450 / 1,250	885	0.25	1/4	3.8	120	1	60	PROVIDE W/ FAN SPEED CONTROLLER, 24" HIGH INSULATED ROOF CURB & BACKDRAFT DAMPER
EF-132	GREENHECK	G-140-VG	CLASSROOM 132	450 / 1,250	885	0.25	1/4	3.8	120	1	60	PROVIDE W/ FAN SPEED CONTROLLER, 24" HIGH INSULATED ROOF CURB & BACKDRAFT DAMPER
EF-133	GREENHECK	G-140-VG	CLASSROOM 133	450 / 1,250	885	0.25	1/4	3.8	120	1	60	PROVIDE W/ FAN SPEED CONTROLLER, 24" HIGH INSULATED ROOF CURB & BACKDRAFT DAMPER
EF-134A	GREENHECK	G-100-VG	CLASSROOM 134A	225 / 750	1194	0.25	1/4	3.8	120	1	60	PROVIDE W/ FAN SPEED CONTROLLER, 24" HIGH INSULATED ROOF CURB & BACKDRAFT DAMPER
EF-134B	GREENHECK	G-100-VG	CLASSROOM 134B	225 / 750	1194	0.25	1/4	3.8	120	1	60	PROVIDE W/ FAN SPEED CONTROLLER, 24" HIGH INSULATED ROOF CURB & BACKDRAFT DAMPER
EF-135	GREENHECK	G-140-VG	CLASSROOM 135	450 / 1,250	885	0.25	1/4	3.8	120	1	60	PROVIDE W/ FAN SPEED CONTROLLER, 24" HIGH INSULATED ROOF CURB & BACKDRAFT DAMPER
EF-136	GREENHECK	G-140-VG	CLASSROOM 136	450 / 1,250	885	0.25	1/4	3.8	120	1	60	PROVIDE W/ FAN SPEED CONTROLLER, 24" HIGH INSULATED ROOF CURB & BACKDRAFT DAMPER
EF-145	GREENHECK	G-140-VG	CLASSROOM 145	450 / 1,250	885	0.25	1/4	3.8	120	1	60	PROVIDE W/ FAN SPEED CONTROLLER, 24" HIGH INSULATED ROOF CURB & BACKDRAFT DAMPER
EF-146	GREENHECK	G-140-VG	CLASSROOM 146	450 / 1,250	885	0.25	1/4	3.8	120	1	60	PROVIDE W/ FAN SPEED CONTROLLER, 24" HIGH INSULATED ROOF CURB & BACKDRAFT DAMPER

CONDENSING BOILER SCHEDULE									
EQUIPMENT TAG	MANUFACTURER	MODEL	INPUT (MBH)		THERMAL EFFICIENCY	GROSS OUTPUT (MBH)	TURNDOWN RATIO	REMARKS	
			MIN.	MAX.					
B-1	LOCHINVAR	FB 3001	150	3000	96.0%	2883	20:1	FURNISH W/ ADD'L HIGH LIMIT & LOW WATER CUTOFF; BOILERS TO BE UL-795 LISTED & IN COMPLIANCE WITH ASME CSD-1	
B-2	LOCHINVAR	FB 3001	150	3000	96.0%	2883	20:1	FURNISH W/ ADD'L HIGH LIMIT & LOW WATER CUTOFF; BOILERS TO BE UL-795 LISTED & IN COMPLIANCE WITH ASME CSD-1	
B-3	LOCHINVAR	FB 3001	150	3000	96.0%	2883	20:1	FURNISH W/ ADD'L HIGH LIMIT & LOW WATER CUTOFF; BOILERS TO BE UL-795 LISTED & IN COMPLIANCE WITH ASME CSD-1	
B-4	LOCHINVAR	FB 3001	150	3000	96.0%	2883	20:1	FURNISH W/ ADD'L HIGH LIMIT & LOW WATER CUTOFF; BOILERS TO BE UL-795 LISTED & IN COMPLIANCE WITH ASME CSD-1	
B-5	LOCHINVAR	FB 3001	150	3000	96.0%	2883	20:1	FURNISH W/ ADD'L HIGH LIMIT & LOW WATER CUTOFF; BOILERS TO BE UL-795 LISTED & IN COMPLIANCE WITH ASME CSD-1	
B-6	LOCHINVAR	FB 3001	150	3000	96.0%	2883	20:1	FURNISH W/ ADD'L HIGH LIMIT & LOW WATER CUTOFF; BOILERS TO BE UL-795 LISTED & IN COMPLIANCE WITH ASME CSD-1	

AIR GRILLE/DIFFUSER SCHEDULE													
EQUIPMENT TAG	MANUFACTURER (OR ACCEPT. EQUAL)	MODEL	AIR DEVICE TYPE	AIRFLOW (CFM)		MAX AIR PRESS. DROP (IN. W.C.)	MOUNTING	PANEL/FRAME SIZE (IN.)	NECK SIZE (IN.)	MAX NC	DAMPER	FINISH	NOTES
				MIN.	MAX.								
D-1	KRUEGER	PLQ-10-F23-24x24-PR10-IB-44	SQUARE PLAQUE FACE DIFFUSER	301	450	0.10	LAY-IN	24"x24"	10"Ø	20	OBD	WHITE	FURNISH W/ INSULATED BACKPAN
D-2	KRUEGER	880-H-48-24-F22-NONE-00-01-00-44	DOUBLE DEFLECTION SUPPLY GRILLE	0	3500	0.10	WALL MTD.	50"x26"	48"x24"	20	OBD	WHITE	
D-3	KRUEGER	5DMGDR-H-14-8-20-01-81	DUCT MOUNTED SUPPLY GRILLE	0	200	0.10	DUCT MTD.	16"x10"	14"x8"	20	OBD	CLEAR ANOD.	FURNISH W/ DAMPER/EXTRACTOR
R-1	KRUEGER	S80P-20x20-F23-24x24-00-00-00-44	PERFORATED FACE RETURN GRILLE	0	1,600	0.10	LAY-IN	24"x24"	20"x20"	25	-	WHITE	FURNISH & INSTALL FULL-SIZE SHEET METAL PLENUM BOX ON REAR OF GRILLE, PAINT INSIDE FLAT BLACK
R-2	KRUEGER	S80H-36x12-F22-NONE-00-00-00-01	35° DEFLECTION RETURN GRILLE	0	1,300	0.10	DUCT MTD.	36"x14"	36"x12"	25	-	MILL	FURNISH & INSTALL FULL-SIZE SHEET METAL PLENUM BOX ON REAR OF GRILLE, PAINT INSIDE FLAT BLACK

VENTILATION SCHEDULE																
SYSTEM	SPACE SERVED	SPACE TYPE	SPACE AREA (SQ. FT.)	OCCUPANTS PER 1000 SQ. FT.	# OF OCCUPANTS (NOTE 1)	CFM PER PERSON	CFM PER SQ. FT.	CALCULATED VENTILATION RATE (CFM)	ZONE AIR DISTRIBUTION EFFECTIVENESS	ADJUSTED VENTILATION RATE (CFM)	PROVIDED VENTILATION RATE (CFM)	EA CFM PER FIXTURE	EA CFM PER SQ. FT.	MIN EA RATE (CFM)	EA PROVIDED (CFM)	
UV-91	CLASSROOM 91	LIBRARY	715	35	30	10	0.12	386	0.9	429	440	-	-	-	450	
UV-112	CLASSROOM 112	CLASSROOM	720	35	30	10	0.12	394	0.9	437	440	-	-	-	450	
UV-130	CLASSROOM 130	CLASSROOM	780	35	30	10	0.12	394	0.9	437	440	-	-	-	450	
UV-131	CLASSROOM 131	CLASSROOM	780	35	30	10	0.12	394	0.9	437	440	-	-	-	450	
UV-132	CLASSROOM 132	CLASSROOM	780	35	30	10	0.12	394	0.9	437	440	-	-	-	450	
UV-133	CLASSROOM 133	CLASSROOM	780	35	30	10	0.12	394	0.9	437	440	-	-	-	450	
UV-134A	CLASSROOM 134A	CLASSROOM	398	35	15	10	0.12	198	0.9	220	210	-	-	-	225	
UV-134B	CLASSROOM 134B	CLASSROOM	398	35	15	10	0.12	198	0.9	220	210	-	-	-	225	
UV-135	CLASSROOM 135	CLASSROOM	780	35	30	10	0.12	394	0.9	437	440	-	-	-	450	
UV-136	CLASSROOM 136	CLASSROOM	780	35	30	10	0.12	394	0.9	437	440	-	-	-	450	
UV-137	CLASSROOM 137	CLASSROOM	780	35	30	10	0.12	394	0.9	437	440	-	-	-	450	
UV-138	CLASSROOM 138	CLASSROOM	780	35	30	10	0.12	394	0.9	437	440	-	-	-	450	
UV-139A	CLASSROOM 139A	CLASSROOM	398	35	15	10	0.12	198	0.9	220	210	-	-	-	225	
UV-139B	CLASSROOM 139B	CLASSROOM	398	35	15	10	0.12	198	0.9	220	210	-	-	-	225	
UV-140A	CLASSROOM 140A	CLASSROOM	398	35	15	10	0.12	198	0.9	220	210	-	-	-	225	
UV-140B	CLASSROOM 140B	CLASSROOM	398	35	15	10	0.12	198	0.9	220	210	-	-	-	225	
UV-141A	CLASSROOM 141A	CLASSROOM	398	35	15	10	0.12	198	0.9	220	210	-	-	-	225	
UV-141B	CLASSROOM 141B	CLASSROOM	398	35	15	10	0.12	198	0.9	220	210	-	-	-	225	
UV-142A	CLASSROOM 142A	CLASSROOM	398	35	15	10	0.12	198	0.9	220	210	-	-	-	225	
UV-142B	CLASSROOM 142B	CLASSROOM	398	35	15	10	0.12	198	0.9	220	210	-	-	-	225	
UV-143	CLASSROOM 143	CLASSROOM	782	35	30	10	0.12	394	0.9	437	440	-	-	-	450	
UV-144	CLASSROOM 144	CLASSROOM	782	35	30	10	0.12	394	0.9	437	440	-	-	-	450	
UV-145	CLASSROOM 145	CLASSROOM	782	35	30	10	0.12	394	0.9	437	440	-	-	-	450	
UV-146	CLASSROOM 146	CLASSROOM	782	35	30	10	0.18	394	0.9	437	440	-	-	-	450	
UV-158	BOYS LOCKER ROOM	LOCKER ROOMS	1303	0	0	0	0	0	0	0	650	-	0.5	650	650	
UV-159	BOYS LOCKER ROOM OFFICE	OFFICE SPACE	169	5	1	5	0.06	15	0.8	19	650	-	-	-	650	
UV-159	GIRLS LOCKER ROOM	LOCKER ROOMS	1303	0	0	0	0	0	0	0	650	-	0.5	650	650	
UV-159	GIRLS LOCKER ROOM OFFICE	OFFICE SPACE	169	5	1	5	0.06	15	0.8	19	650	-	-	-	650	

NOTES:
 1. QUANTITY OF OCCUPANTS FOR STANDARD CLASSROOMS ARE 30 OCCUPANTS BASED ON NYSED STATISTICAL DATA. ALL OTHER OCCUPANCIES ARE BASED UPON OCCUPANT DENSITIES FROM THE 2015 INTERNATIONAL MECHANICAL CODE

PUMP SCHEDULE																
EQUIPMENT TAG	MANUFACTURER (OR ACCEPT. EQUAL)	MODEL	LOCATION	AREA SERVED	PUMP TYPE	CIRCULATING FLUID			MOTOR					NOTES		
						FLUID	G.P.M.	HEAD (FT.)	TEMP. (°F)	NOM. H.P.	VOLT.	PHASE	HZ		RPM	FLA
BP-1	GRUNDFOS	TPE3 65-150-S -A-G-A-BQOE	BOILER ROOM	BOILER #1	IN-LINE	HOT WATER	144	32	180	1.5	208	1	60	1760	6.7	1-3
BP-2	GRUNDFOS	TPE3 65-150-S -A-G-A-BQOE	BOILER ROOM	BOILER #2	IN-LINE	HOT WATER	144	32	180	1.5	208	1	60	1760	6.7	1-3
BP-3	GRUNDFOS	TPE3 65-150-S -A-G-A-BQOE	BOILER ROOM	BOILER #3	IN-LINE	HOT WATER	144	32	180	1.5	208	1	60	1760	6.7	1-3
BP-4	GRUNDFOS	TPE3 65-150-S -A-G-A-BQOE	BOILER ROOM	BOILER #4	IN-LINE	HOT WATER	144	32	180	1.5	208	1	60	1760	6.7	1-3
BP-5	GRUNDFOS	TPE3 65-150-S -A-G-A-BQOE	BOILER ROOM	BOILER #5	IN-LINE	HOT WATER	144	32	180	1.5	208	1	60	1760	6.7	1-3
BP-6	GRUNDFOS	TPE3 65-150-S -A-G-A-BQOE	BOILER ROOM	BOILER #6	IN-LINE	HOT WATER	144	32	180	1.5	208	1	60	1760	6.7	1-3
P-1/2/3	GRUNDFOS	DELTA HCU 3 NBS 030-110 3x208V	BOILER ROOM	BUILDING	BASE MOUNTED	HOT WATER	980	100	180	20 (3)	208	3	60	1760	165.6	1-3
P-4/5/6	GRUNDFOS	DELTA HCU 3 CRE 32-2-1 3x208V	BOILER ROOM	HAGGAR WING	BASE MOUNTED	CHILLED WATER	225	110	44	7-1/2 (3)	208	3	60	1760	61	1-3
P-7	GRUNDFOS	TPE3 80-180-S -A-G-A-BQOE	BOILER ROOM	DOMESTIC WATER HEATER	IN-LINE	HOT WATER	225	25	180	3	208	3	60	1760	11	1-3
P-8	GRUNDFOS	TPE3 80-180-S -A-G-A-BQOE	BOILER ROOM	DOMESTIC WATER HEATER	IN-LINE	HOT WATER	225	25	180	3	208	3	60	1760	11	1-3

NOTES:
 1. CLOSE COUPLED IN-LINE CENTRIFUGAL PUMP W/ VARIABLE FREQUENCY CONTROLLED MOTOR & DIFFERENTIAL PRESSURE TRANSMITTER
 2. PROVIDE W/ SUCTION DIFFUSER
 3. PROVIDE W/ MULTI-PURPOSE VALVE
 4. INSULATE PUMP BODY & ALL ASSOCIATED PIPING, VALVES, ACCESSORIES
 5. TRIPLEX SKID PACKAGE W/ (2) ACTIVE PUMPS & (1) BACKUP PUMP W/ FACTORY INSTALLED HEADERS & CONTROLS

19 Front St., Newburgh, New York 12550-7601
 845-561-3179 www.csarch.com



Consultant

VALLEY CENTRAL SCHOOL DISTRICT
 VALLEY CENTRAL HIGH SCHOOL
 2023 CAPITAL PROJECT - PHASE 1


Project Title



1	DESIGN	BO ADONUM #1
2	ISSUE	REV ADONUM #2
3	DATE	DESCRIPTION

Drawn By: BJK
 Checked By: 44-13-01-06-015-033
 CSArch Proj. #: 187-2302.01
 Issued for Bid: 10/18/24

</

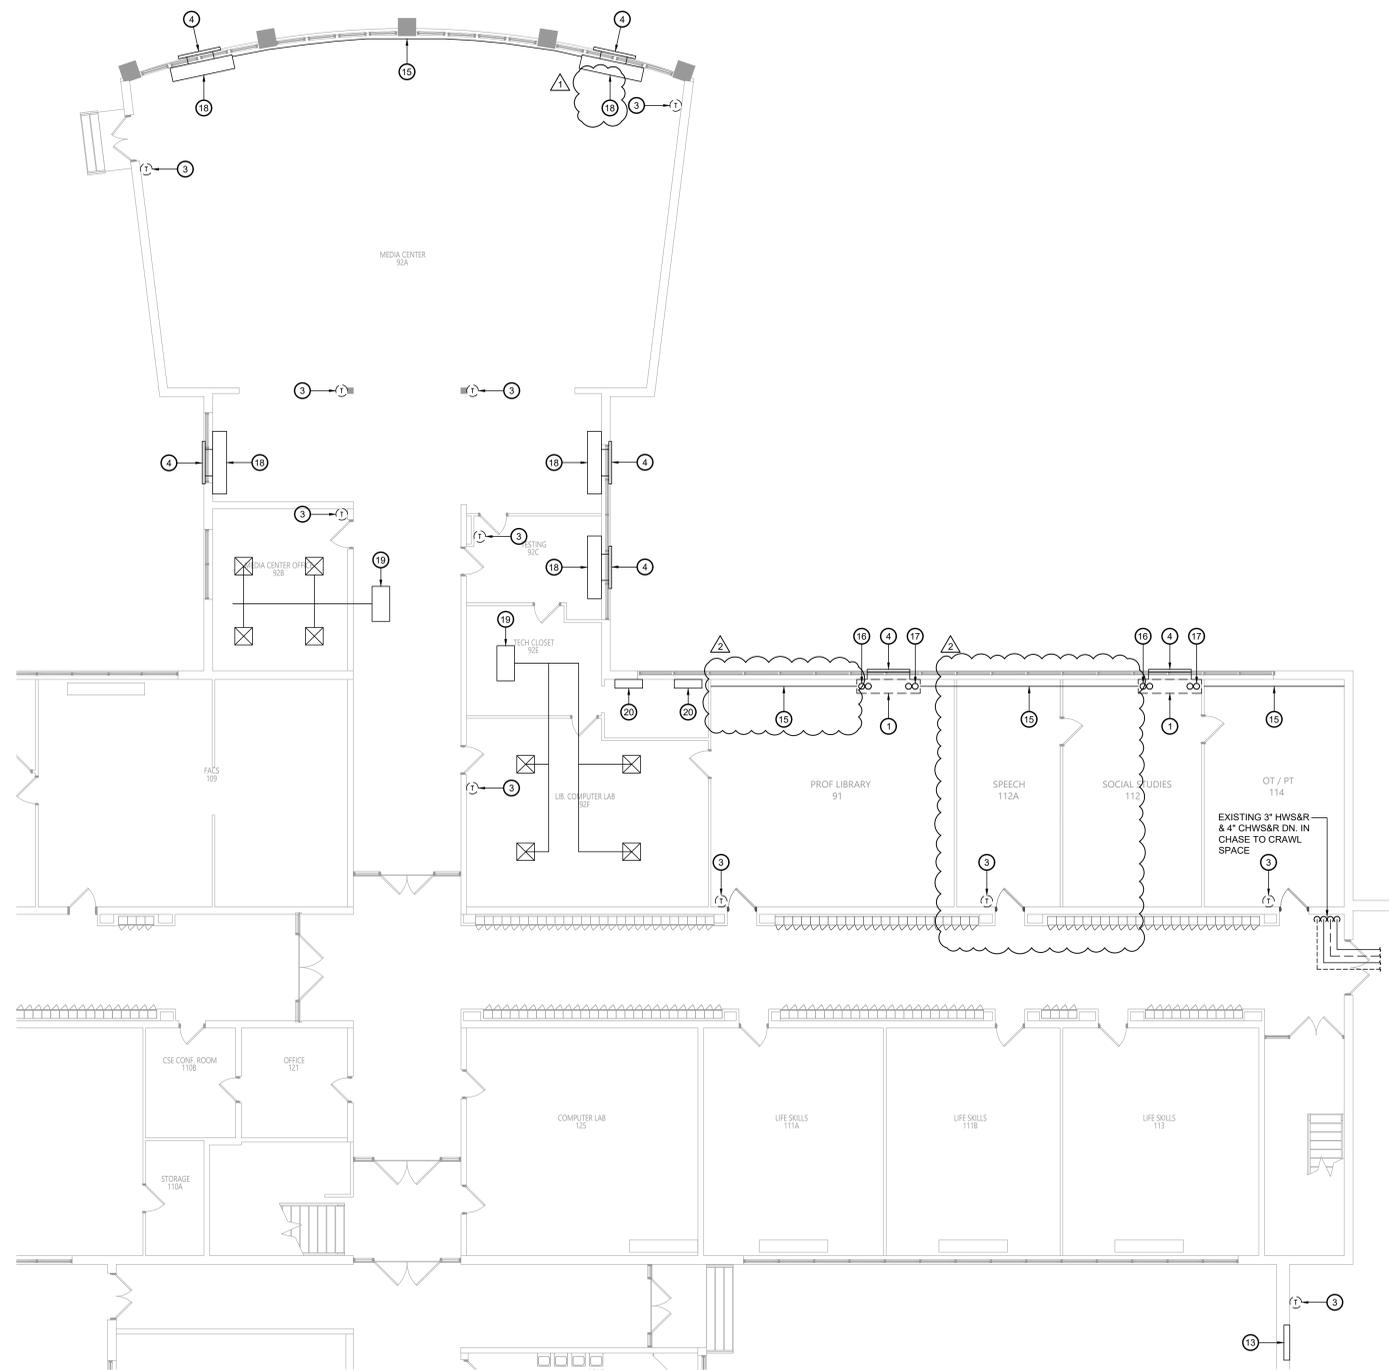


1 Mechanical Demolition Plan - Part 2
MD212 Scale: 1/8" = 1'-0"

Sheet Notes:

1. TEMPERATURE CONTROLS SCOPE - REMOVE & REPLACE ALL EXISTING PNEUMATIC HVAC CONTROL SYSTEMS SERVING THIS AREA OF THE BUILDING. OWNER TO PROVIDE ALL MATERIALS & WIRING INCLUDING DEVICES, ACTUATORS, SENSORS, WIRING, CONDUIT, ETC. TO CONVERT ALL EQUIPMENT OVER TO REPLACEMENT DDC SYSTEM. MECHANICAL CONTRACTOR TO DEMOLISH & INSTALL ALL CONTROL VALVES AND ANY PIPING RELATED ACCESSORIES I.E. PORTS FOR SENSORS, ETC.; FIELD VERIFY EXISTING CONDITIONS PRIOR TO THE START OF WORK.

Key Notes:

- 1 DISCONNECT, REMOVE & PROPERLY DISPOSE OF EXISTING UNIT VENTILATOR AND ALL ASSOCIATED PIPING, ACCESSORIES, CONTROLS, ETC.
- 2 DISCONNECT, REMOVE & PROPERLY DISPOSE OF EXISTING HOT WATER & CHILLED WATER PIPING AND ALL ASSOCIATED VALVES, INSULATION, HANGERS, SUPPORTS, ETC.
- 3 DISCONNECT, REMOVE & PROPERLY DISPOSE OF EXISTING THERMOSTAT AND ASSOCIATED WIRING OR PNEUMATIC TUBING; MAINTAIN EXISTING BOX AND CONDUIT FOR REPLACEMENT UNIT WHERE COMPATIBLE.
- 4 EXISTING OUTSIDE AIR LOUVER AND WALL SLEEVE TO REMAIN
- 5 EXISTING DRAFT STOP TO BE DISCONNECTED, REMOVED & PROPERLY DISPOSED OF;
- 6 DISCONNECT, REMOVE & PROPERLY DISPOSE OF EXISTING RELIEF AIR TRANSFER GRILLE & DUCTWORK;
- 7 DISCONNECT, REMOVE & PROPERLY DISPOSE OF EXISTING ROOFTOP MOUNTED RELIEF AIR HOOD & ALL ASSOCIATED DUCTWORK
- 8 DISCONNECT, REMOVE & PROPERLY DISPOSE OF EXISTING DUCTED HORIZONTAL UNIT VENTILATOR AND ALL ASSOCIATED PIPING, ACCESSORIES, CONTROLS, ETC.
- 9 EXISTING SUPPLY AIR GRILLE/DIFFUSER & DUCT TO REMAIN
- 10 EXISTING RETURN AIR GRILLE & DUCT TO REMAIN
- 11 EXISTING OUTSIDE AIR LOUVER & DUCT TO REMAIN
- 12 EXISTING EXHAUST AIR GRILLES & DUCT TO REMAIN
- 13 EXISTING CABINET HEATER TO REMAIN; DISCONNECT, REMOVE & PROPERLY DISPOSE OF ALL ASSOCIATE PNEUMATIC CONTROLS; PROVIDE ELECTRONICALLY CONTROLLED VALVE(S) & DAMPER(S) CONNECTED TO BUILDING AUTOMATION SYSTEM.
- 14 EXISTING EXHAUST FAN ON ROOF TO REMAIN
- 15 EXISTING FINNED TUBE RADIATION TO REMAIN; DISCONNECT, REMOVE & PROPERLY DISPOSE OF ALL ASSOCIATE PNEUMATIC CONTROLS; PROVIDE ELECTRONICALLY CONTROLLED VALVE(S) CONNECTED TO BUILDING AUTOMATION SYSTEM.
- 16 REMOVE 3/4" HWS & HW/R PIPING DN, THRU FLOOR INTO CRAWL SPACE & CAP AT MAIN; PIPING WILL BE EXTENDED & CONNECTED TO REPLACEMENT UNIT
- 17 REMOVE 1-1/4" CHWS & CHWR PIPING DN, THRU FLOOR INTO CRAWL SPACE & CAP AT MAIN; PIPING WILL BE EXTENDED & CONNECTED TO REPLACEMENT UNIT
- 18 EXISTING FLOOR MOUNTED VERTICAL UNIT VENTILATOR (HW HEATING & CHW COOLING) TO REMAIN; DISCONNECT, REMOVE & PROPERLY DISPOSE OF EXISTING CONTROLS & ASSOCIATED PNEUMATIC CONTROLS, TUBING, ETC.
- 19 EXISTING DUCTED FAN COIL (HW HEATING & CHW COOLING) TO REMAIN; DISCONNECT, REMOVE & PROPERLY DISPOSE OF EXISTING CONTROLS & ASSOCIATED PNEUMATIC CONTROLS, TUBING, ETC.
- 20 EXISTING FLOOR MOUNTED FAN COIL (HW HEATING & CHW COOLING) TO REMAIN; DISCONNECT, REMOVE & PROPERLY DISPOSE OF EXISTING CONTROLS & ASSOCIATED PNEUMATIC CONTROLS, TUBING, ETC.
- 21 DISCONNECT, REMOVE & PROPERLY DISPOSE OF EXISTING FINNED TUBE RADIATION AND ALL ASSOCIATED PIPING, ENCLOSURE, ACCESSORIES, CONTROLS, ETC.

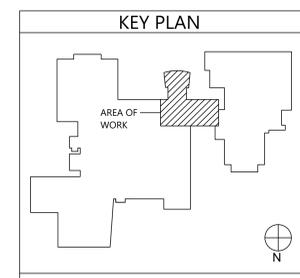

19 Front St., Newburgh, New York 12550-7901
845-561-3179 www.csarchpc.com



Consultant

VALLEY CENTRAL SCHOOL DISTRICT
VALLEY CENTRAL HIGH SCHOOL
2023 CAPITAL PROJECT - PHASE 1

Project Title



NO.	DATE	DESCRIPTION
1	10/18/24	ISSUED FOR BID


Drawn By: BJK
Checked By: BJK
Prog. #: 44-13-01-06-0-015-033
CSArch Proj. #: 187-2302.01
Issued for Bid: 10/18/24

Sheet Title
MECHANICAL DEMOLITION PLAN - PART 2

Sheet No.
VCHS MD212



CONSTRUCTION DOCUMENTS



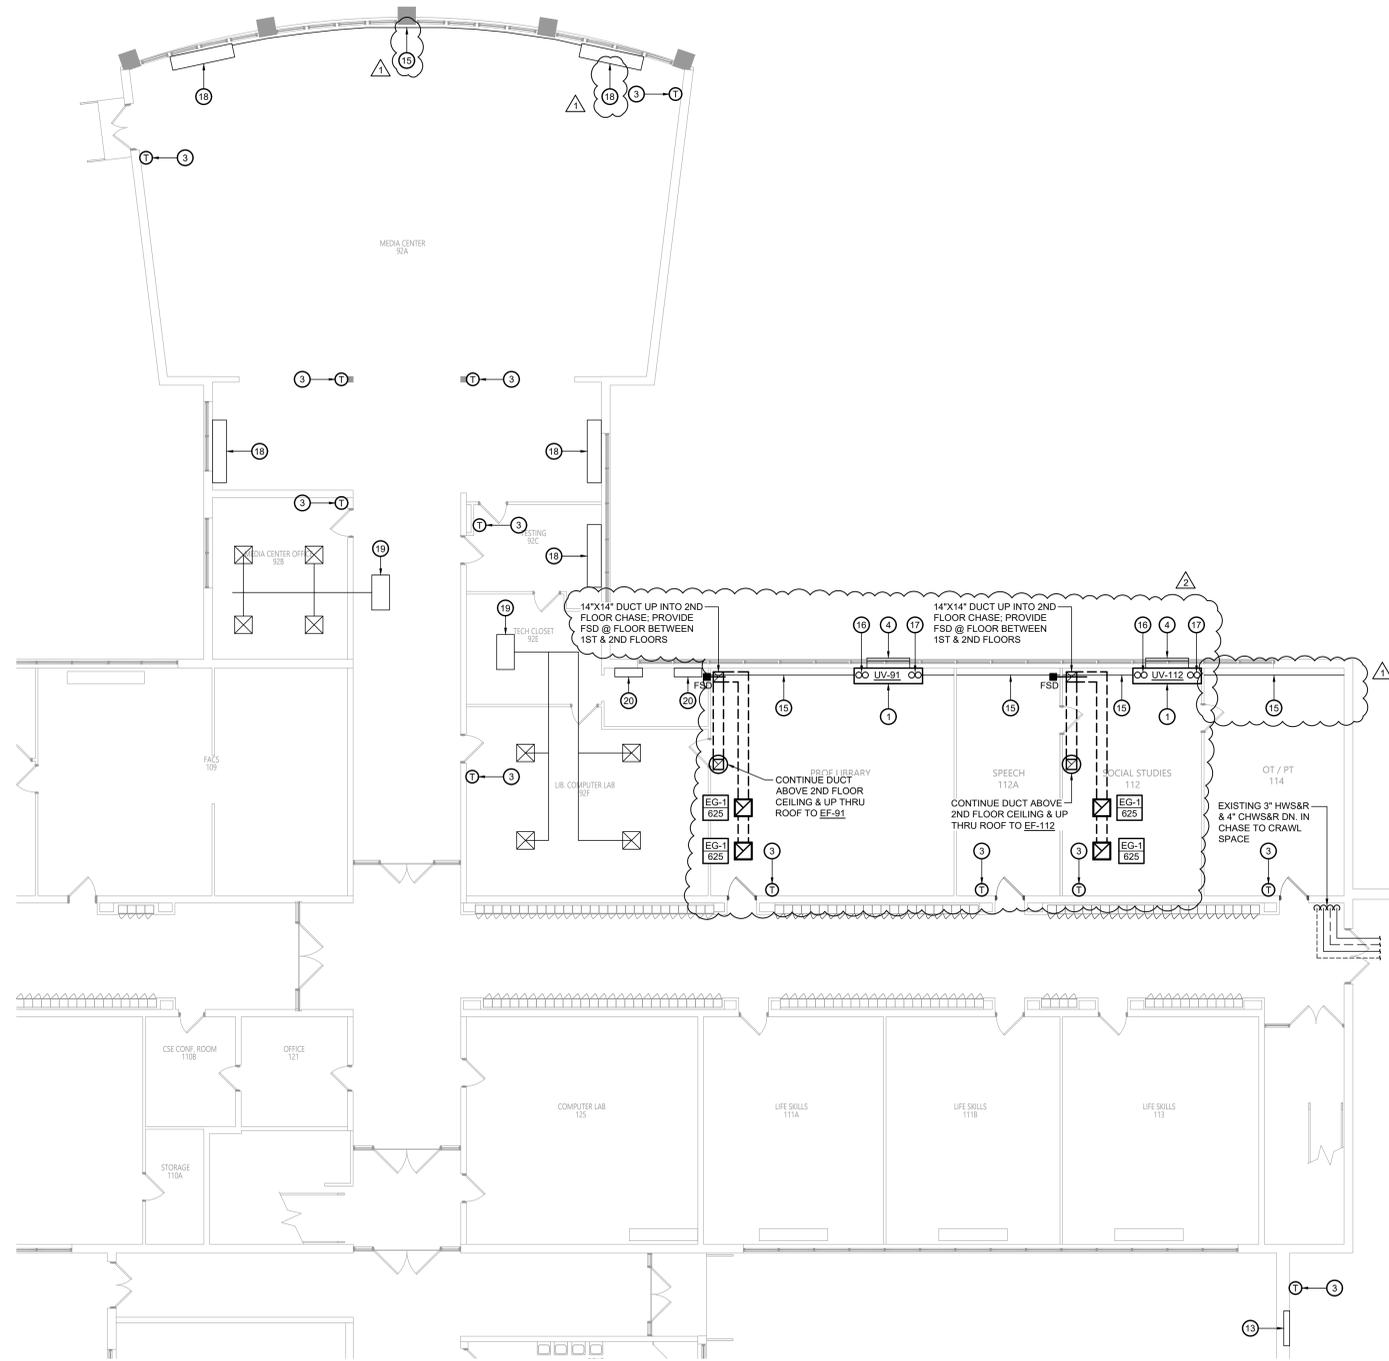

- Key Notes:**
- 1 NEW UNIT VENTILATOR
 - 2 3/4" HWS/HWR & 1-1/4" CHWS/CHWR TO UV INSIDE DRAFT STOP. CONNECT TO EXISTING PIPING AT WALL
 - 3 NEW THERMOSTAT
 - 4 EXISTING OUTSIDE AIR LOUVER AND WALL SLEEVE TO REMAIN
 - 5 NEW DRAFT STOP INSTALLED ON BOTH SIDE OF UV
 - 6 NEW DUCTED HORIZONTAL UNIT VENTILATOR. CONNECT TO EXISTING HW & CHW PIPING AND SUPPLY. RETURN & OUTSIDE AIR DUCTWORK. VERIFY EXACT ROUTING & SIZES IN FIELD
 - 7 EXISTING SUPPLY AIR GRILLE/DIFFUSER & DUCT TO REMAIN
 - 8 EXISTING RETURN AIR GRILLE & DUCT TO REMAIN
 - 9 EXISTING OUTSIDE AIR LOUVER & DUCT TO REMAIN
 - 10 EXISTING EXHAUST AIR GRILLES & DUCT TO REMAIN
 - 11 EXISTING CABINET HEATER TO REMAIN. DISCONNECT. REMOVE & PROPERLY DISPOSE OF ALL ASSOCIATE PNEUMATIC CONTROLS. PROVIDE ELECTRONICALLY CONTROLLED VALVE(S) & DAMPER(S) CONNECTED TO BUILDING AUTOMATION SYSTEM
 - 12 EXISTING EXHAUST FAN ON ROOF TO REMAIN
 - 13 EXISTING FINNED TUBE RADIATION TO REMAIN. DISCONNECT. REMOVE & PROPERLY DISPOSE OF ALL ASSOCIATE PNEUMATIC CONTROLS. PROVIDE ELECTRONICALLY CONTROLLED VALVE(S) CONNECTED TO BUILDING AUTOMATION SYSTEM. MODIFY PIPING & ENCLOSURE AS NEEDED TO ACCOUNT FOR SIZE DIFFERENCE OF REPLACEMENT UNIT VENTILATOR
 - 14 PROVIDE 3/4" HWS & HWR PIPING UP THRU FLOOR FROM CRAWL SPACE TO NEW UV
 - 15 PROVIDE 1-1/4" CHWS & CHWR PIPING UP THRU FLOOR FROM CRAWL SPACE TO NEW UV
 - 16 EXISTING FLOOR MOUNTED VERTICAL UNIT VENTILATOR (HW HEATING & CHW COOLING) TO REMAIN. PROVIDE ELECTRONICALLY CONTROLLED VALVE(S) & DAMPER(S) CONNECTED TO BUILDING AUTOMATION SYSTEM
 - 17 EXISTING DUCTED FAN COIL (HW HEATING & CHW COOLING) TO REMAIN. PROVIDE ELECTRONICALLY CONTROLLED VALVE(S) & DAMPER(S) CONNECTED TO BUILDING AUTOMATION SYSTEM
 - 18 EXISTING FLOOR MOUNTED FAN COIL (HW HEATING & CHW COOLING) TO REMAIN. PROVIDE ELECTRONICALLY CONTROLLED VALVE(S) & DAMPER(S) CONNECTED TO BUILDING AUTOMATION SYSTEM
 - 19 EXISTING FLOOR MOUNTED FAN COIL (HW HEATING & CHW COOLING) TO REMAIN. PROVIDE ELECTRONICALLY CONTROLLED VALVE(S) & DAMPER(S) CONNECTED TO BUILDING AUTOMATION SYSTEM
 - 20

1 Mechanical Plan - Part 2
Scale: 1/8" = 1'-0"

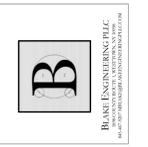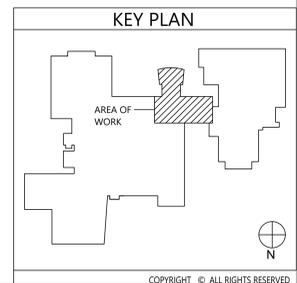

VALLEY CENTRAL SCHOOL DISTRICT
VALLEY CENTRAL HIGH SCHOOL
2023 CAPITAL PROJECT - PHASE 1



NO.	DATE	DESCRIPTION
1	10/18/24	ISSUED FOR BID

Drawn By: BJK
Checked By: BJK
Proj. #: 44-13-01-06-0-015-033
CSArch Proj. #: 187-2302.01
Issued for Bid: 10/18/24

Sheet Title: MECHANICAL PLAN - PART 2

Sheet No: VCHS M212

CONSTRUCTION DOCUMENTS

Key Notes:

- 1 EXISTING UNIT VENTILATOR TO BE REMOVED, DISCONNECT, REMOVE & PROPERLY DISPOSE OF ALL ASSOCIATED CONDUITS, WIRING, DISCONNECTS, ETC.; REMOVE ALL CONDUITS AND WIRING BACK TO SOURCE



ELECTRICAL DEMOLITION NOTES:
 AREAS INDICATED WITHIN DASHED LINES ARE TO HAVE EXISTING CEILINGS REMOVED. ELECTRICAL CONTRACTOR TO REMOVE ALL ELECTRICAL DEVICES WITHIN THESE CEILINGS. APPROXIMATE DEVICE LOCATIONS INDICATED FOR REFERENCE. CONTRACTOR TO FIELD VERIFY EXACT QUANTITY AND LOCATIONS.

- DISCONNECT, REMOVE & PROPERLY DISPOSE OF EXISTING LIGHT FIXTURES AND ASSOCIATED COMPONENTS INCLUDING HANGERS AND WIRING/CONDUIT. REMOVE WIRING BACK TO SWITCH.
- DISCONNECT, REMOVE & PROPERLY DISPOSE OF EXISTING LIGHT SWITCHES AND COVER PLATES. MAINTAIN EXISTING BOX, CONDUIT AND CIRCUIT FOR RECONNECTION TO REPLACEMENT SWITCH.
- DISCONNECT & REMOVE ALL CEILING DEVICES INCLUDING FIRE ALARM, WIRELESS ACCESS POINTS, SPEAKERS, ETC. AND STORE. MAINTAIN EXISTING WIRING FOR REINSTALLATION.

ELECTRICAL CONTRACTOR TO TIE-UP & SUPPORT ALL UNSUPPORTED WIRING, CABLING & CONDUIT ABOVE THE CEILINGS BEING REMOVED & REPLACED



**VALLEY CENTRAL SCHOOL DISTRICT
 VALLEY CENTRAL HIGH SCHOOL
 2023 CAPITAL PROJECT - PHASE 1**




NO.	DATE	DESCRIPTION
1	5/19/24	ISSUED FOR BIDDING
2	10/18/24	ISSUED FOR BIDDING

Drawn By: BJK
 Checked By: BJK
 Proj. #: 44-13-01-06-015-033
 CSArch Proj. #: 187-2302.01
 Issued for Bid: 10/18/24

Sheet Title: **ELECTRICAL DEMOLITION PLAN**

Sheet No.: **VCHS MD211**


CONSTRUCTION DOCUMENTS

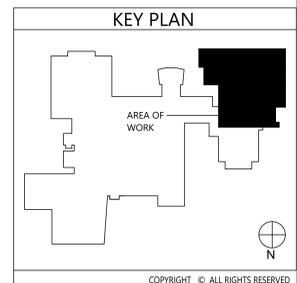

1 Electrical Demolition Plan
 ED211 Scale: 1/8" = 1'-0"

Key Notes:

1 PROVIDE WIRING AND CONDUIT TO UNIT VENTILATOR FROM NEW CIRCUIT BREAKER IN EXISTING PANELBOARD

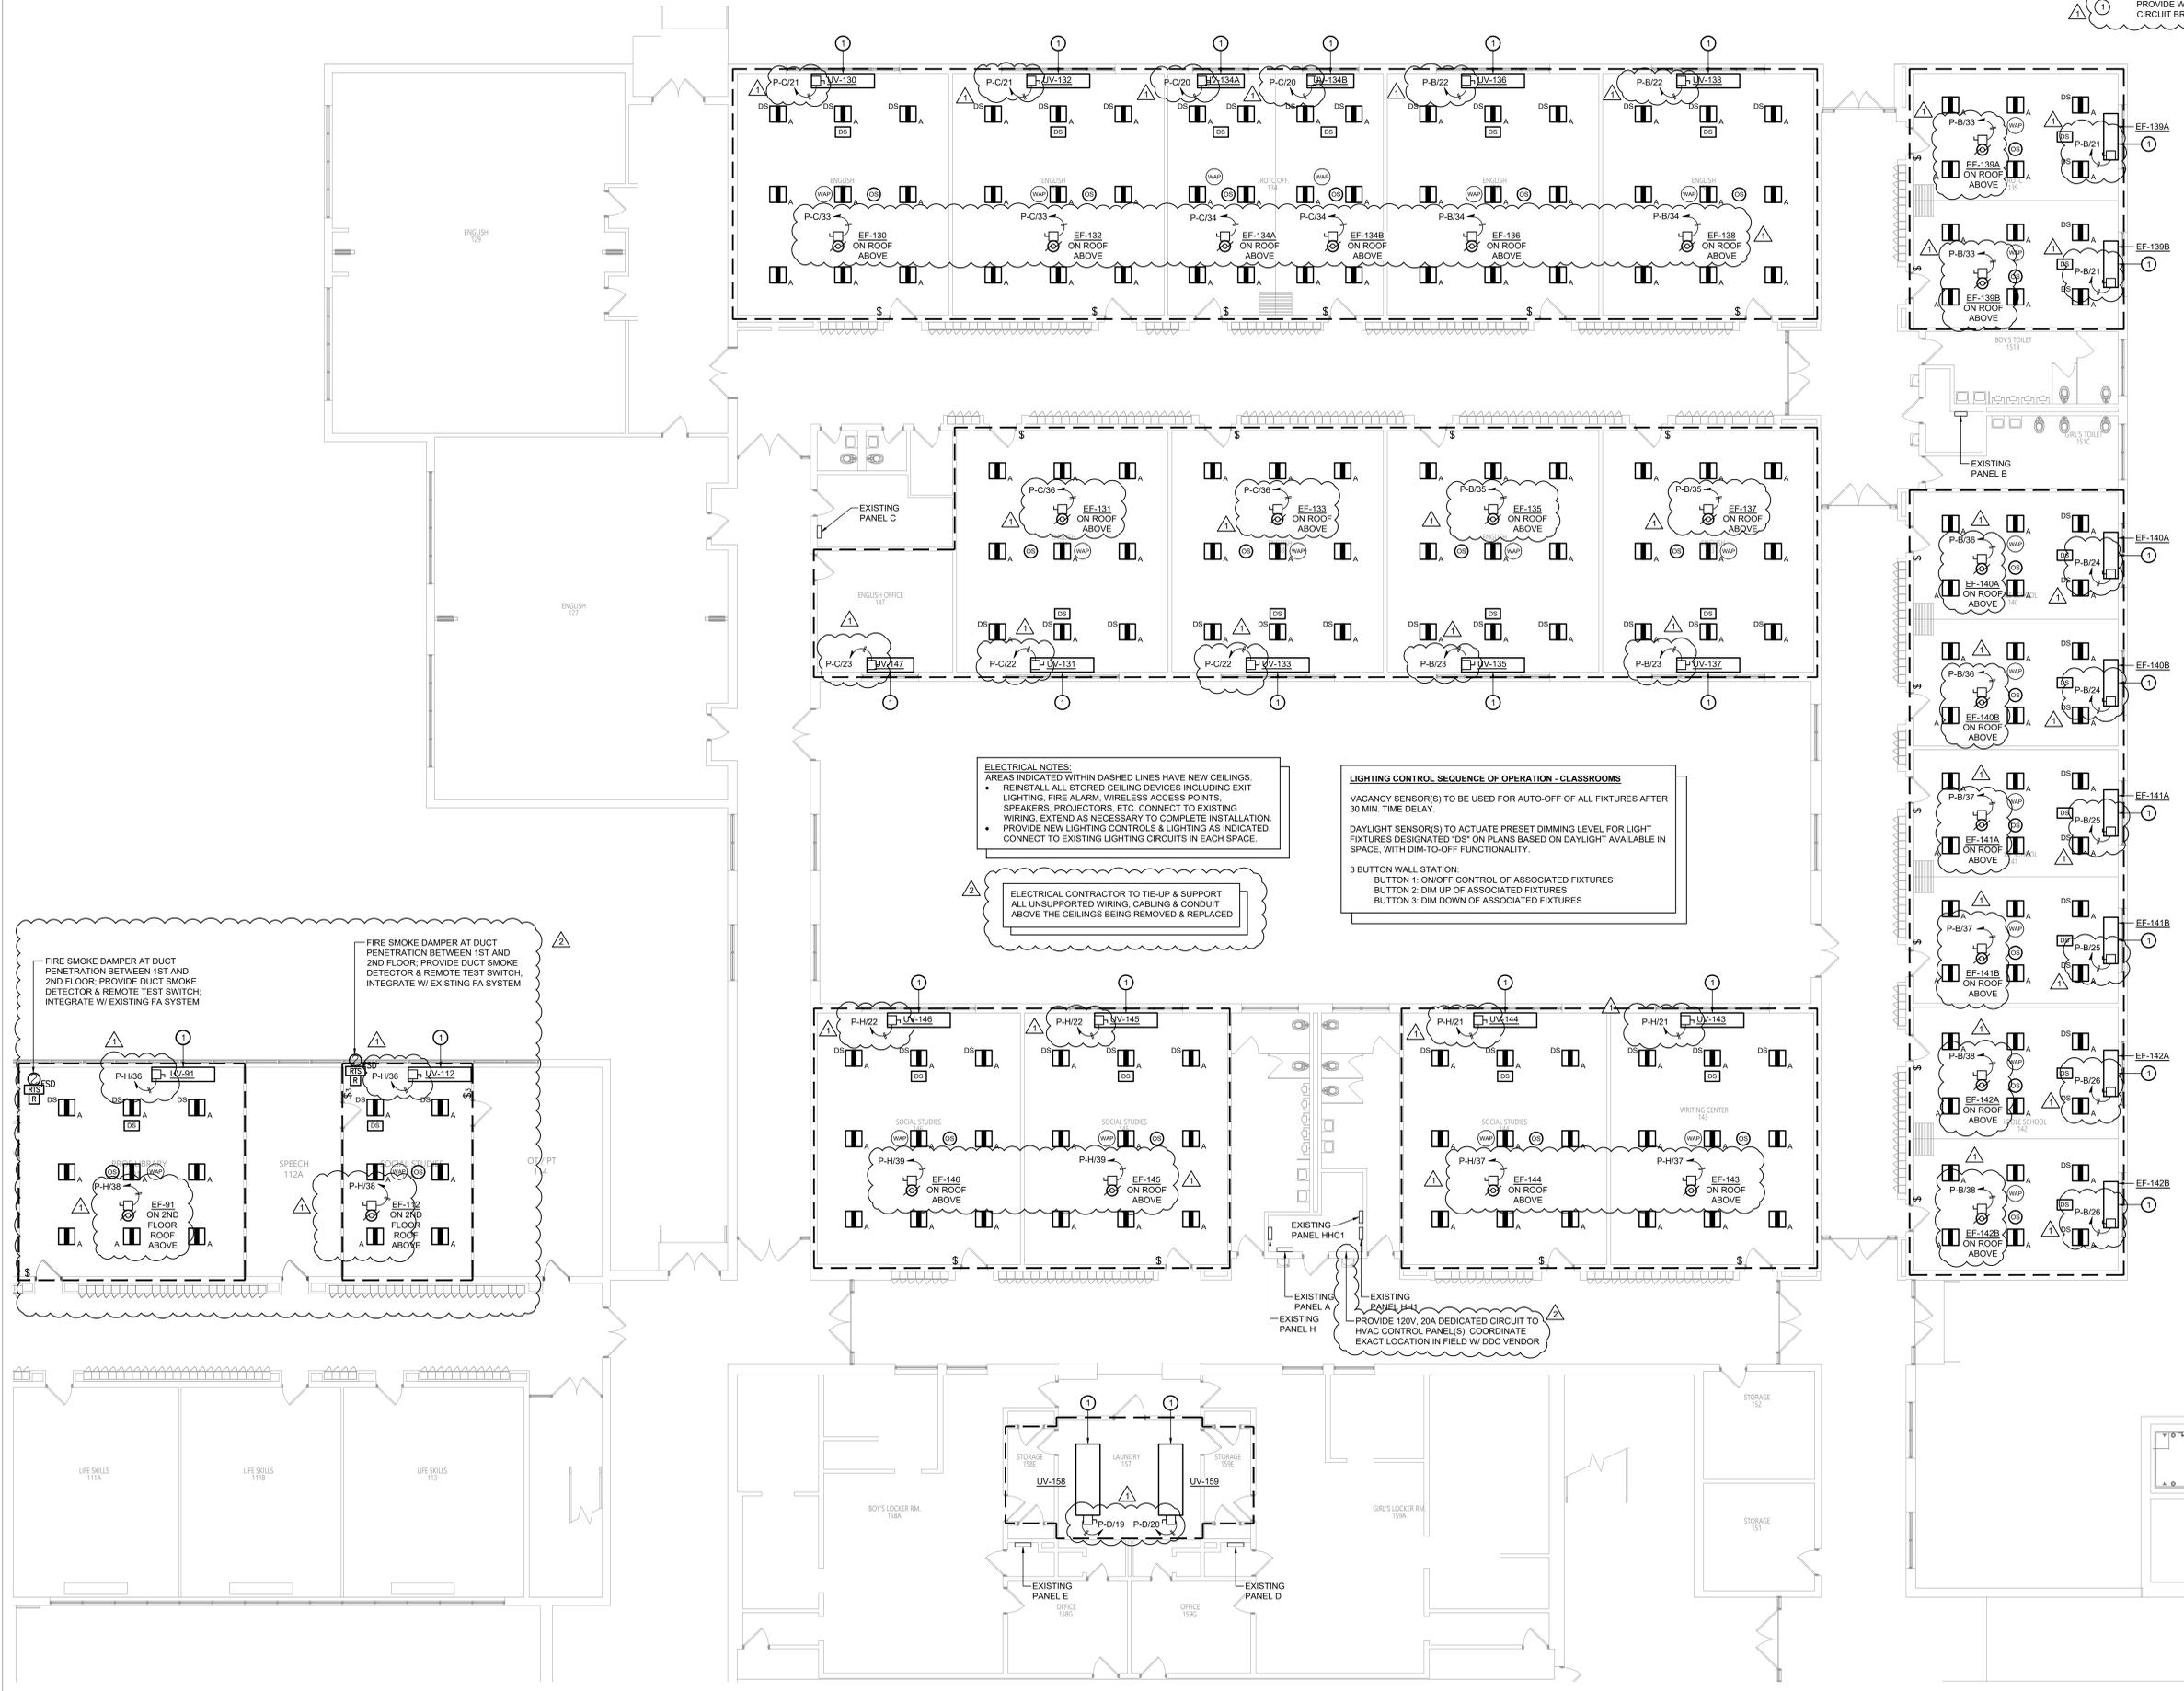

ELECTRICAL NOTES:
 AREAS INDICATED WITHIN DASHED LINES HAVE NEW CEILING.
 REINSTALL ALL STORED CEILING DEVICES INCLUDING EXIT LIGHTING, FIRE ALARM, WIRELESS ACCESS POINTS, SPEAKERS, PROJECTORS, ETC. CONNECT TO EXISTING WIRING, EXTEND AS NECESSARY TO COMPLETE INSTALLATION.
 PROVIDE NEW LIGHTING CONTROLS & LIGHTING AS INDICATED. CONNECT TO EXISTING LIGHTING CIRCUITS IN EACH SPACE.

ELECTRICAL CONTRACTOR TO TIE-UP & SUPPORT ALL UNSUPPORTED WIRING, CABLING & CONDUIT ABOVE THE CEILINGS BEING REMOVED & REPLACED

LIGHTING CONTROL SEQUENCE OF OPERATION - CLASSROOMS
 VACANCY SENSOR(S) TO BE USED FOR AUTO-OFF OF ALL FIXTURES AFTER 30 MIN. TIME DELAY.
 DAYLIGHT SENSOR(S) TO ACTUATE PRESET DIMMING LEVEL FOR LIGHT FIXTURES DESIGNATED "DS" ON PLANS BASED ON DAYLIGHT AVAILABLE IN SPACE, WITH DIM-TO-OFF FUNCTIONALITY.
 3 BUTTON WALL STATION:
 BUTTON 1: ON/OFF CONTROL OF ASSOCIATED FIXTURES
 BUTTON 2: DIM UP OF ASSOCIATED FIXTURES
 BUTTON 3: DIM DOWN OF ASSOCIATED FIXTURES

FIRE SMOKE DAMPER AT DUCT PENETRATION BETWEEN 1ST AND 2ND FLOOR. PROVIDE DUCT SMOKE DETECTOR & REMOTE TEST SWITCH; INTEGRATE W/ EXISTING FA SYSTEM

FIRE SMOKE DAMPER AT DUCT PENETRATION BETWEEN 1ST AND 2ND FLOOR. PROVIDE DUCT SMOKE DETECTOR & REMOTE TEST SWITCH; INTEGRATE W/ EXISTING FA SYSTEM




**VALLEY CENTRAL SCHOOL DISTRICT
 VALLEY CENTRAL HIGH SCHOOL
 2023 CAPITAL PROJECT - PHASE 1**



NO.	DATE	DESCRIPTION
1	10/24	ISSUED FOR BIDDING
2	11/04	REVISED FOR BIDDING


Drawn By: BJK
 Checked By: BJK
 Project No.: 44-13-01-06-015-033
 CSArch Proj. #: 187-2302.01
 Issued for Bid: 10/18/24

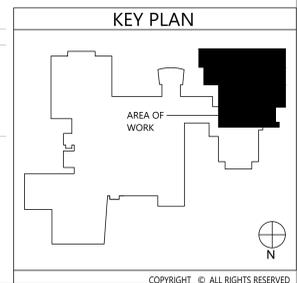


1 Electrical Plan
 E211 Scale: 1/8" = 1'-0"

Key Notes:

- ① NEW LIGHT FIXTURE; CONNECT TO EXISTING LIGHTING CIRCUIT & SWITCHING SERVING BOILER ROOM; FIELD VERIFY EXACT LAYOUT BASED ON EXISTING INFRASTRUCTURE & LAYOUT OF NEW PIPING & EQUIPMENT WITHIN SPACE
- ② VFD FURNISHED BY MECHANICAL CONTRACTOR W/ PUMP; ELECTRICAL CONTRACTOR TO MOUNT & WIRE VFD

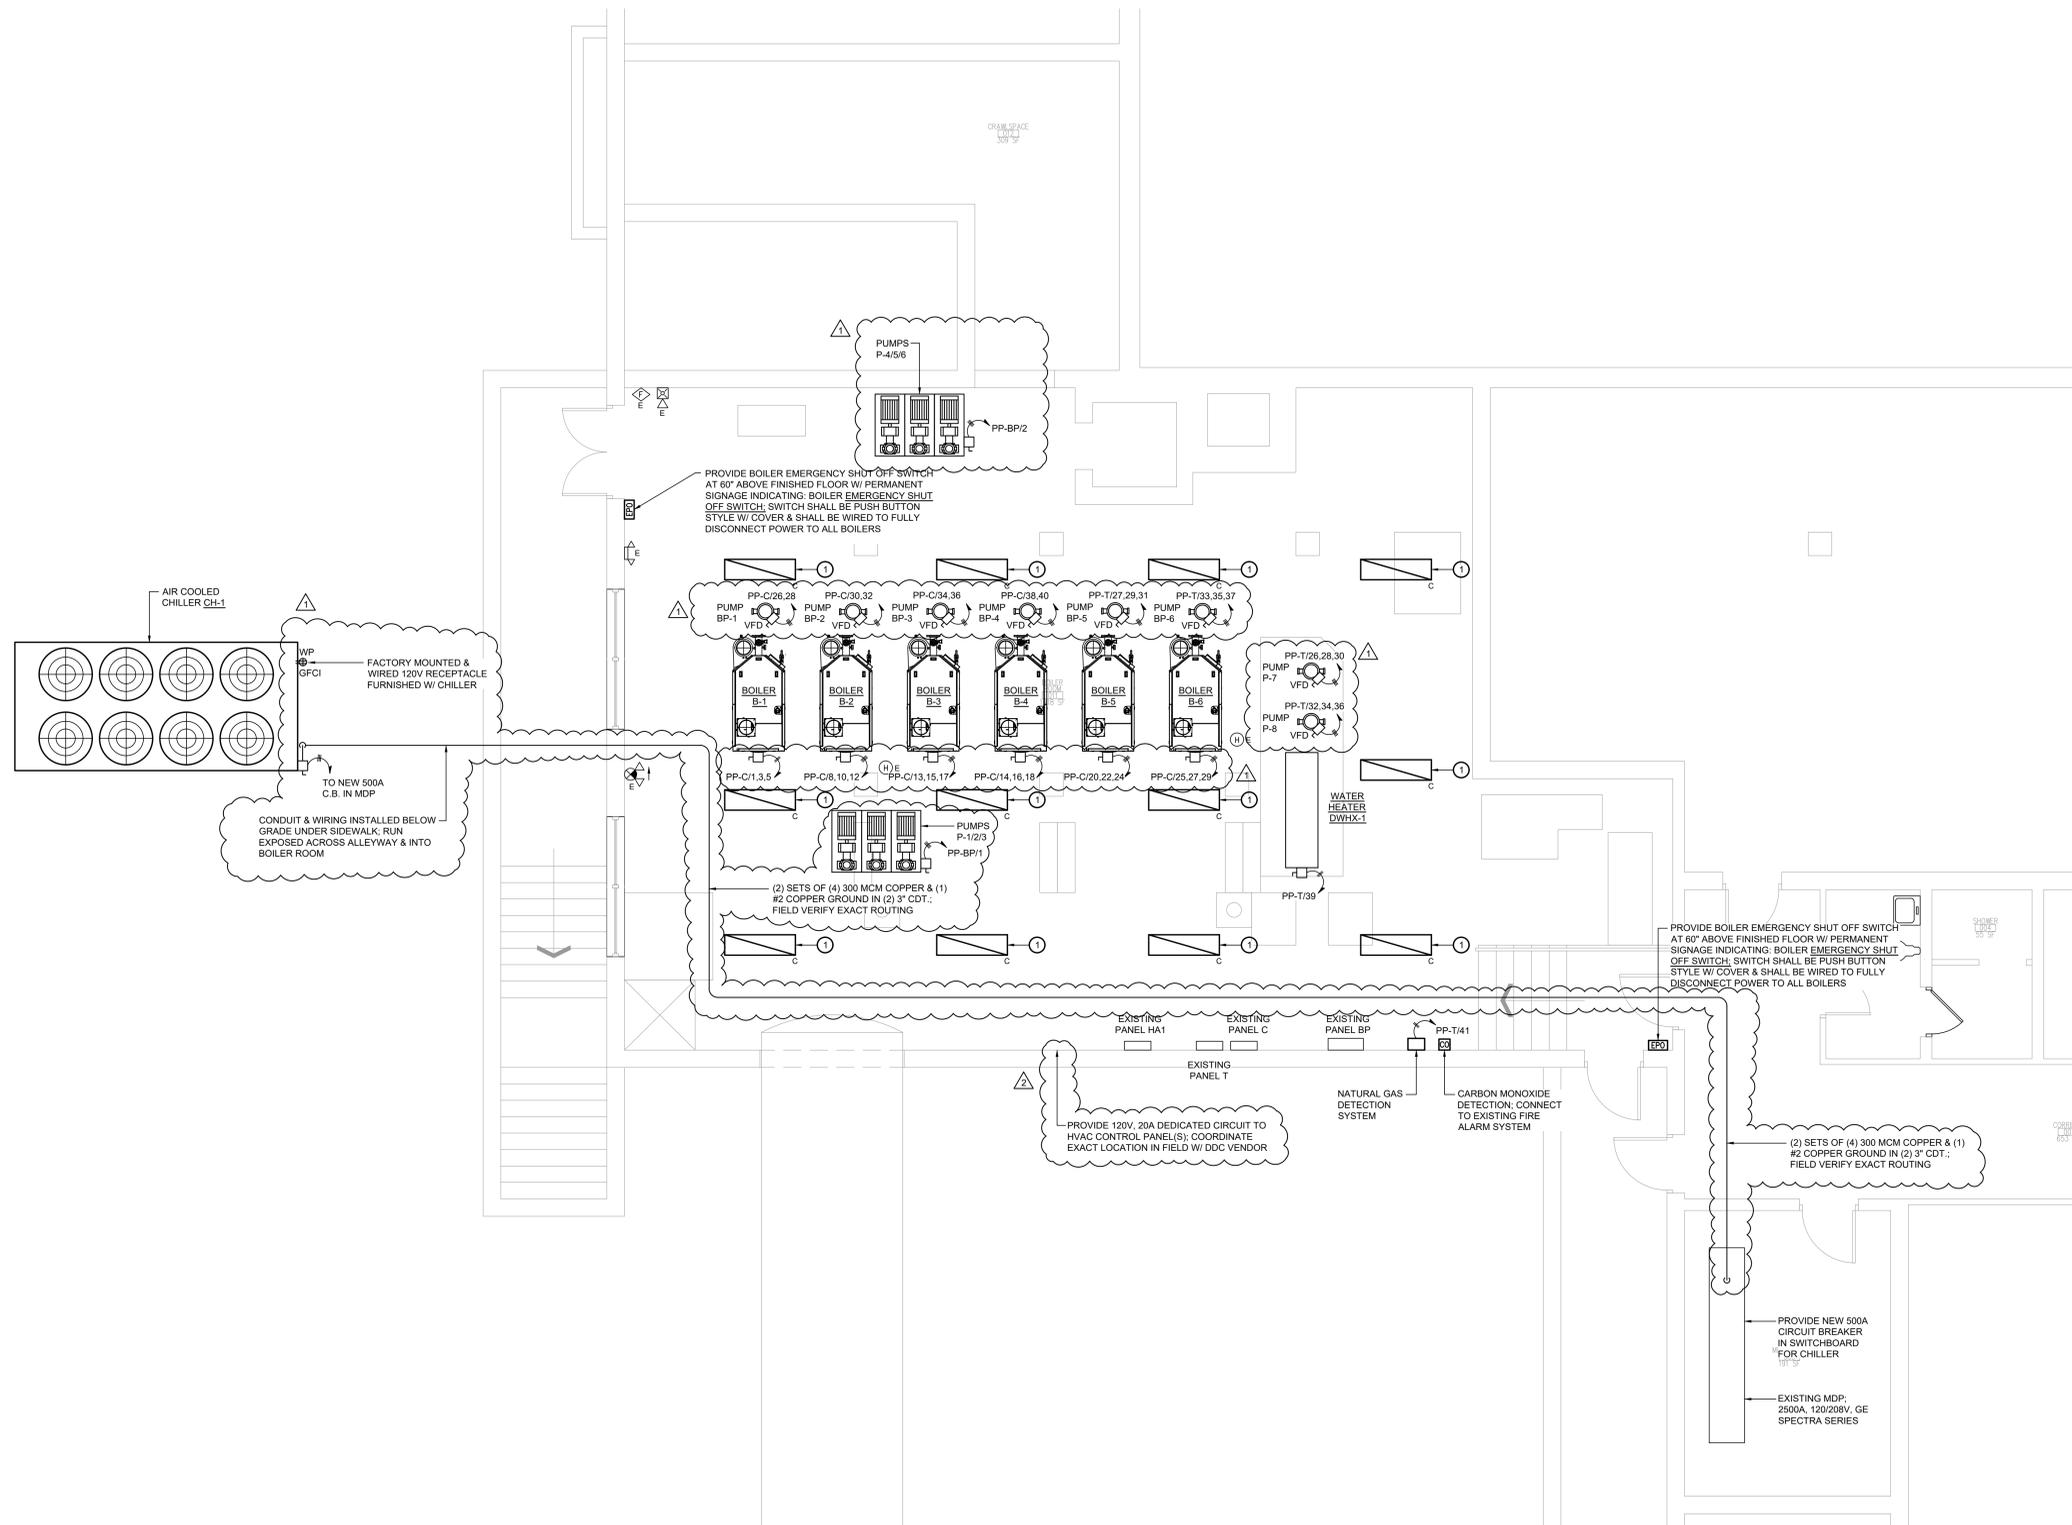

1 Electrical Plan
E301 Scale: 1/4" = 1'-0"

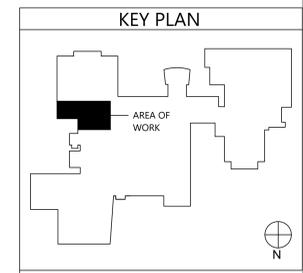

19 Front St., Newburgh, New York 12550-7601
845-561-3179 www.csarch.com



Consultant

BLAKE ENGINEERING & ELECTRIC
INCORPORATED
A PROFESSIONAL ENGINEERING FIRM

VALLEY CENTRAL SCHOOL DISTRICT
VALLEY CENTRAL HIGH SCHOOL
2023 CAPITAL PROJECT - PHASE 1

Project Title



NO.	DATE	DESCRIPTION
1	10/18/24	ISSUED FOR BID

Drawn By: BJK
Checked By: BJK
Proj. #: 44-13-01-06-0-015-033
CSArch Proj. #: 187-2302.01
Issued for Bid: 10/18/24

Sheet Title

ELECTRICAL PLAN

Sheet No.
VCHS
E301

CONSTRUCTION DOCUMENTS

CSARCH

ROOM FINISH SCHEDULE							
ROOM NUMBER	ROOM NAME	FLOOR			Accent_Wall	CEILING	Comments
		FINISH	BASE	Wall Finish			
1295	SECURITY OFFICE	ETR	RB-1	PNT-1			
1296	EAST LOBBY	ETR	ETR/RB-1	ETR/PNT-1		PNT-2	
V001	VESTIBULE	ETR	ETR/RB-1	ETR/PNT-1			

MATERIALS LEGEND					
MATERIAL	MANUFACTURER	MODEL	COLOR #/NAME	SIZE	NOTE
PAINT					
PNT-1	SHERWIN WILLIAMS	EGG-SHELL	AS SELECTED FROM FULL RANGE OF COLOR/ MATCH EXISTING		GENERAL WALL PAINT
PNT-2	SHERWIN WILLIAMS	FLAT	SW 7005 PURE WHITE		CEILING PAINT
PLASTIC LAMINATE					
PLAM-1	WILSONART	LAMINATE	5034 HANDSPUN DOVE		WORKSURFACE
PLAM-2	WILSONART	LAMINATE	D315 PLATINUM		CASEWORK
RUBBER BASE					
RB-1	TARKETT	BASEWORKS	38 PEWTER CG	MATCH EXISTING	MATCH EXISTING TERRAZZO BASE HEIGHT


DISCLAIMER NOTE
 MANUFACTURER'S NAMES AND FINISH INFORMATION ARE INDICATED AS REFERENCED TO THE ARCHITECT'S BASIS-OF-DESIGN SELECTIONS AND HAVE BEEN DETERMINED PRIOR TO BID. THE CONTRACTOR AND OWNER ARE HEREBY NOTIFIED THAT FINISHES INSTALLED IN THE WORK ARE SUBJECT TO CHANGE IN RESPONSE TO SUBMITTALS, CONFIRMED SELECTIONS, PRODUCT AVAILABILITY AND THE SUBSEQUENT COORDINATION OF FINISHES BY ARCHITECT AND MAY DIFFER FROM PRODUCTS LISTED HEREIN.

ABBREVIATIONS

ACMU ARCHITECTURAL CONCRETE MASONRY UNIT
 ACT ACOUSTICAL CEILING TILE
 APC ACOUSTICAL PANEL CEILING
 BBT BIO-BASED TILE
 BRK BRICK
 CFT CERAMIC FLOOR TILE
 CMU CONCRETE MASONRY UNIT
 CONC CONCRETE
 CRT CERAMIC TILE BASE
 CTB CERAMIC TILE BASE
 GNT CERAMIC WALL TILE
 ETR EXISTING TO REMAIN
 EXP EXPOSED
 EXST EXISTING
 FAC/FF FACTORY FINISH
 GNB GYPSUM WALL BOARD
 LMG LINEAR METAL CEILING
 MBS MUBIG STORAGE SYSTEM
 MWP METAL WALL PANEL
 PCON POLISHED CONCRETE
 PLAM PLASTIC LAMINATE
 PLAS PLASTER
 PNT PAINT
 RAF RESILIENT ATHLETIC FLOORING
 RB RUBBER BASE
 RF RESINOUS FLOORING
 RST RUBBER STAIR TREAD / LANDING
 RT RUBBER TILE FLOORING
 SCONG SEALED CONCRETE
 SS STAINLESS STEEL
 STF SYNTHETIC TURF FLOORING
 STL STEEL
 TERR TERRAZZO
 TB TERRAZZO BASE
 TP TOILET PARTITIONS
 TYP TYPICAL
 VGT VINYL COMPOSITION TILE
 VGTAS VINYL COMPOSITION TILE ANTI-STATIC
 VMC VINYL WALLCOVERING
 WAF WOOD ATHLETIC FLOORING
 WD WOOD
 WDM WALK-OFF MAT

GENERAL FINISH NOTES

- ALL EXPOSED SURFACES OF NEW PARTITIONS ARE TO BE PAINTED.
- WHEN ANY WORK IS PERFORMED ON ANY EXISTING WALL, THE ENTIRE WALL SURFACE IS TO BE PAINTED CORNER TO CORNER, UNLESS NOTED OTHERWISE.
- ALL NEW GNB CEILINGS, FASCIAS, AND SOFFITS TO BE PAINTED PNT-2.

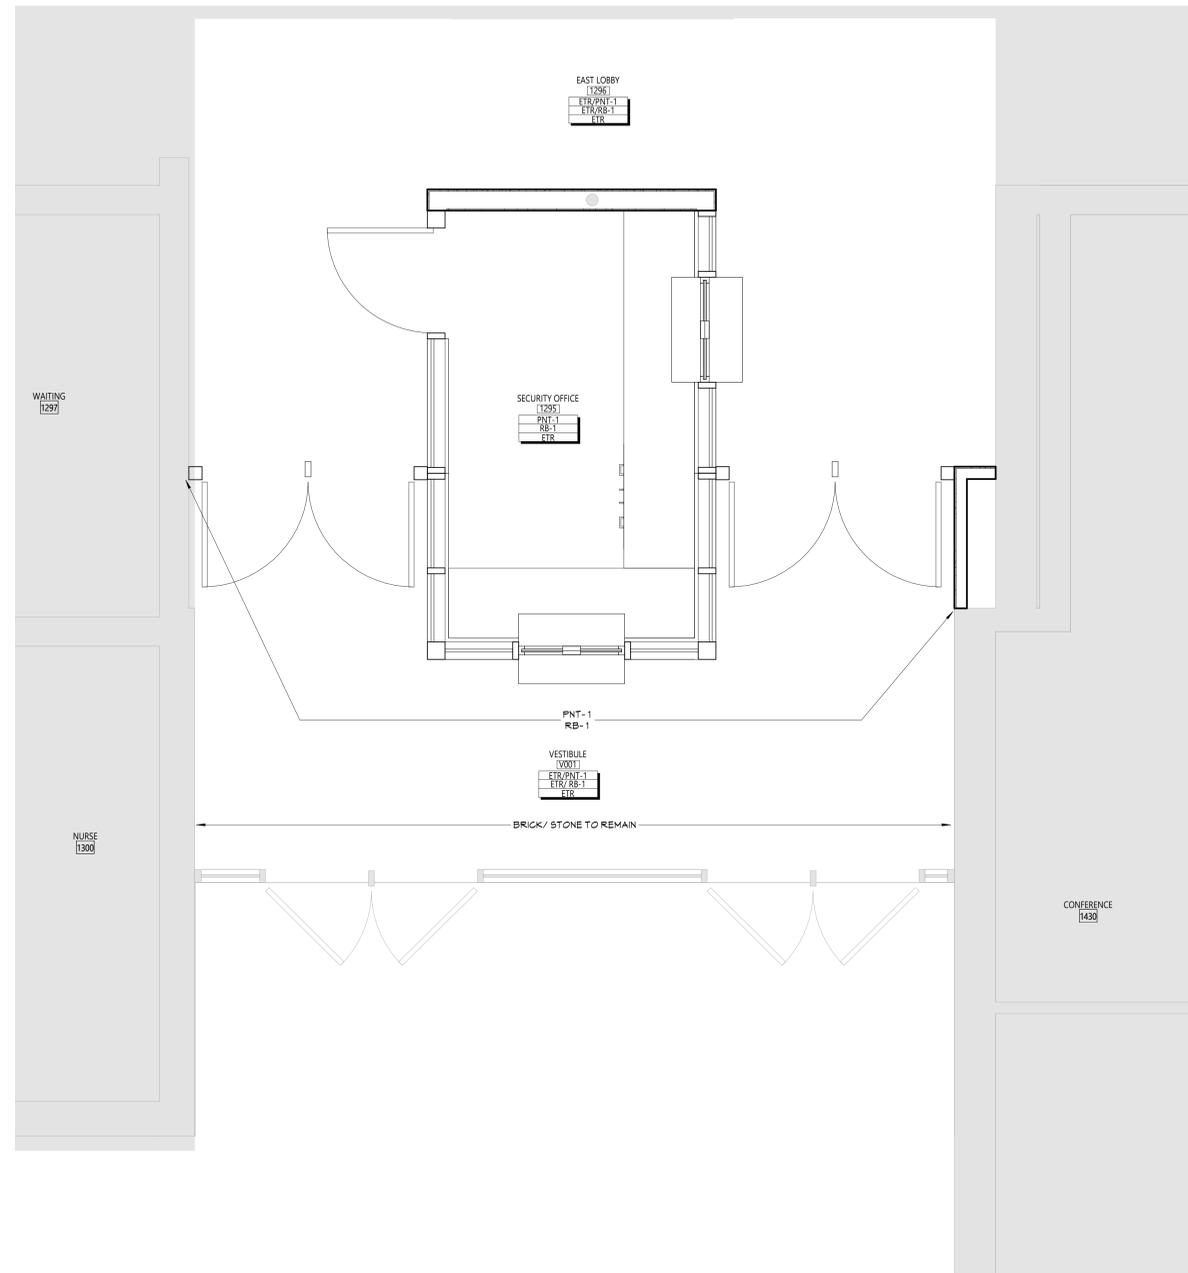


FINISH KEYS

Room Name (101)
 Wall Finish (101)
 Base Finish (101)
 Floor Finish (101)

• Finish Tag

PNT-# ACCENT PAINT LOCATION

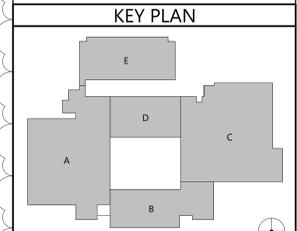

1 PARTIAL FLOOR FINISH PLAN - FIRST FLOOR - AREA A
 AF111 1/2" = 1'-0"

19 Front St., Newburgh - New York 12550-7601
 845-561-1319 www.csarch.com

CS ARCH

Consultant

**VALLEY CENTRAL SCHOOL DISTRICT
 VALLEY CENTRAL MIDDLE SCHOOL
 2023 CAPITAL PROJECT - PHASE 1**

Project Title

EXPIRATION DATE: 02/28/2025

NO.	DATE	DESCRIPTION
4	11/16/24	BID ADDENDUM #4

Drawn By: AS
 Checked By: 44-13-01-06-0-016-023
 Proj. #: 187-2302-01
 CSArch Proj. #: 10/18/24
 Issued for Bid:

Sheet Title
MATERIAL SCHEDULE AND FINISH PLAN

Sheet No.
VCMS AF111

CONSTRUCTION DOCUMENTS

COPYRIGHT © ALL RIGHTS RESERVED



C:\Users\skawron\Documents\187-2302-01_VCSO_VCMS_addendum\USERBWP.rvt

GENERAL NOTES:

1. CONTRACTOR TO PROTECT THEIR EMPLOYEES WITH ADEQUATE PERSONAL PROTECTIVE EQUIPMENT AT ALL TIMES WHEN PERFORMING WORK ON THIS PROJECT.
2. DISTRICT TO PROVIDE A WATER SUPPLY AND AN ELECTRICAL POWER SOURCE ON THIS PROJECT TO CONDUCT WORK ACTIVITIES. CONTRACTOR TO PROVIDE ALL INTERCONNECTS FOR WATER/POWER AND TO ENSURE THAT ALL TEMPORARY WATER/POWER SOURCES ARE PROPERLY INSTALLED BY A LICENSED PLUMBER/ELECTRICIAN.
3. CONTRACTOR'S EMPLOYEES SHALL WEAR PROTECTIVE SUITS AND HALF-FACE RESPIRATORS (AT A MINIMUM) AT ALL TIMES, REGARDLESS OF ANY NEGATIVE EXPOSURE ASSESSMENT REPORTS / DATA.

ASBESTOS ABATEMENT NOTES:

1. CONTRACTOR SHALL OBSERVE ALL FEDERAL, STATE, AND LOCAL REGULATIONS GOVERNING ASBESTOS ABATEMENT.
2. ASBESTOS ABATEMENT PROCEDURES SHALL BE CONDUCTED IN A MANNER CONSISTENT WITH PROJECT SPECIFICATION 028213.
3. THE SCOPE OF ABATEMENT WORK INVOLVES THE REMOVAL OF ASBESTOS-CONTAINING MATERIALS FROM THE AREAS INDICATED ON THE AA SERIES DRAWINGS.
4. THE CONTRACTOR ASSUMES THE RESPONSIBILITY FOR THE MEANS AND METHODS UTILIZED TO COMPLETE THE PROJECT IN A TIMELY, PROFESSIONAL, LEGAL, AND SAFE MANNER.
5. THE CONTRACTOR ACKNOWLEDGES THAT THE PROVIDED DRAWINGS MAY NOT BE TO SCALE. IT IS THE RESPONSIBILITY OF THE CONTRACTOR TO CONDUCT A PRE-BID WALKTHROUGH AND SATISFY THEMSELVES OF THE QUANTITIES OF ASBESTOS-CONTAINING MATERIALS, PRESUMED ASBESTOS-CONTAINING MATERIALS AND THAT THEY SHALL BE CONTRACTUALLY OBLIGATED TO HANDLE AND DISPOSE OF ON THIS PROJECT.
6. DECONTAMINATION ENCLOSURES SHALL BE CONSTRUCTED IN ACCORDANCE WITH THE REQUIREMENTS OF NYS/DOL ICR 56. THE LOCATIONS OF THESE ENCLOSURES, STAGING AREAS, WASTE DUMPSTERS / TRAILERS / VEHICLES, POWER AND WATER SOURCES SHALL BE IDENTIFIED TO DISTRICT REPRESENTATIVES AND THE PROJECT DESIGNER SEVENTY-TWO (72) HOURS PRIOR TO THE COMMENCEMENT OF ANY ACTIVITIES ON-SITE. THE CONTRACTOR ACCEPTS THAT DISTRICT REPRESENTATIVES AND/OR THE PROJECT DESIGNER MAY MODIFY THIS PLAN FOR ANY REASON DEEMED NECESSARY. THE CONTRACTOR MAY NOT PROCEED WITH ABATEMENT ACTIVITIES UNTIL THEY HAVE THE APPROVAL OF DISTRICT REPRESENTATIVES AND THE PROJECT DESIGNER.
7. THE DISTRICT (OR THEIR DESIGNATED PERSONNEL) SHALL BE RESPONSIBLE FOR HIRING THE PROJECT MONITORING FIRM ON THIS PROJECT. THE CONTRACTOR SHALL RECOGNIZE THE SELECTED FIRM'S PERSONNEL AS THE BUILDING OWNER'S REPRESENTATIVE. THE CONTRACTOR SHALL BE RESPONSIBLE FOR THE COLLECTION OF PERSONAL AIR SAMPLES FOR THEIR EMPLOYEES DURING THIS PROJECT.
8. CONTRACTOR SHALL COORDINATE AND SCHEDULE ALL WORK WITH DISTRICT REPRESENTATIVES AND THE MONITORING FIRM.

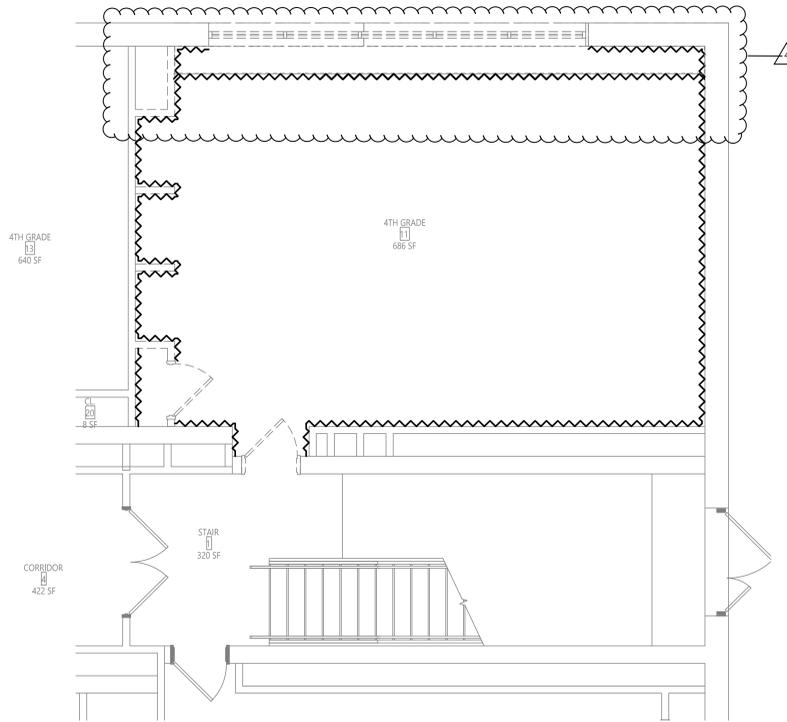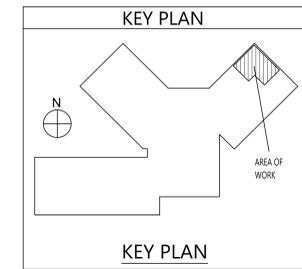

1 AREA C - PARTIAL FIRST FLOOR ABATEMENT PLAN
AA100 1/4" = 1'-0"

**ADD ALTERNATE
ALT-GAC-1-01-001**

LEGEND:
 ASBESTOS-CONTAINING (GOME BASE MASTIC TO BE REMOVED (APPROX. 62 SF))

19 Front St., Newburgh, New York 12550-7601
845-561-3179 www.csarchpc.com



**VALLEY CENTRAL SCHOOL DISTRICT
WALDEN ELEMENTARY SCHOOL
2023 CAPITAL PROJECT - PHASE 1**

Project Title

NO.	DATE	DESCRIPTION
1	11/19/24	ISS ADDENDUM #4
2	11/20/24	ISS ADDENDUM #3


Drawn By: WF
Checked By: BS
Proj. #: 44-13-01-06-015-033
CSArch Proj. #: 187-2302-01
Issued for Bid: 10/18/24

**ASBESTOS
ABATEMENT
FIRST FLOOR
AREA C**


Sheet No. **WES
AA100**

CONSTRUCTION DOCUMENTS

C:\Users\jmliller\Documents\187-2302.01 VCSO WES_finales\010.dwg

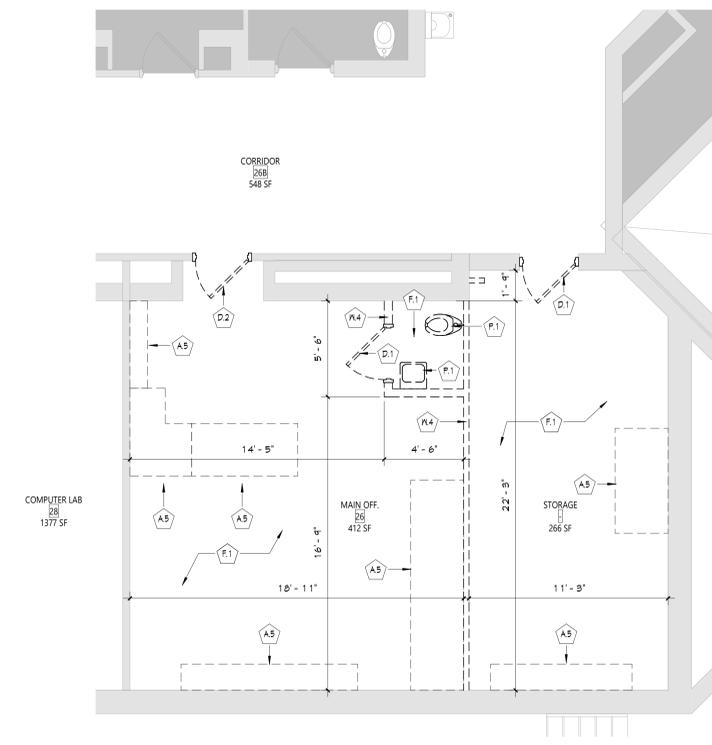

2 AREA B - PARTIAL SECOND FLOOR REMOVAL PLAN
AD111 1/4" = 1'-0"

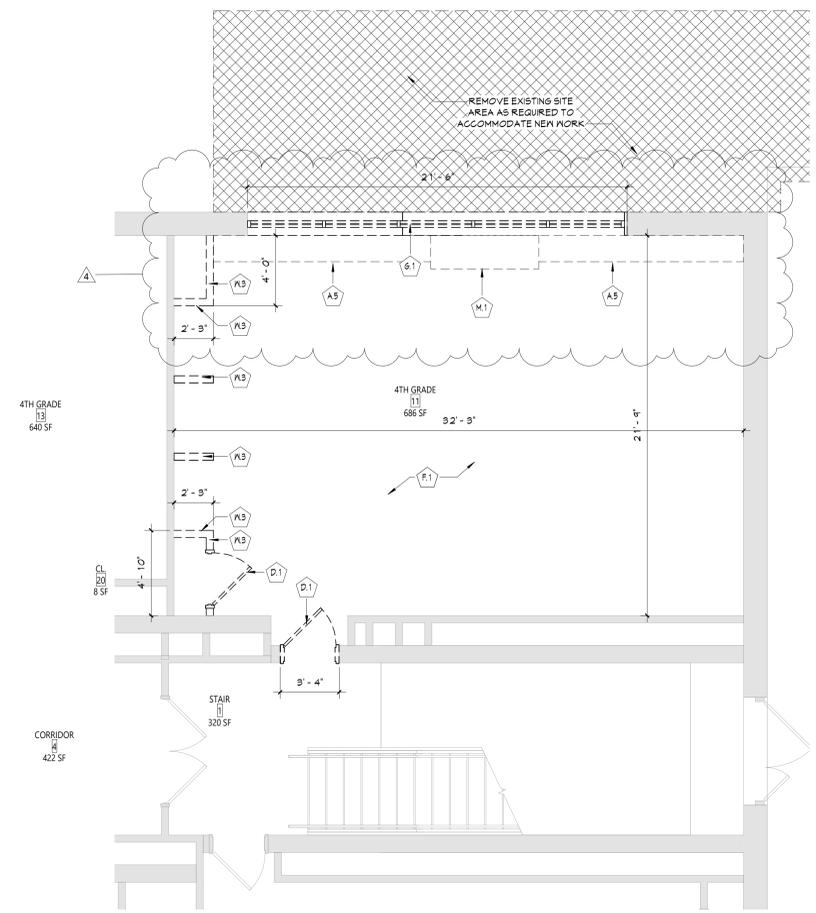

1 AREA C - PARTIAL FIRST FLOOR REMOVAL PLAN
AD111 1/4" = 1'-0"

- GENERAL NOTES**
- COORDINATE ALL REMOVALS WITH NEW CONSTRUCTION.
 - PATCH AND REPLACE EXISTING AND NEWLY CREATED HOLES IN WALLS (DUE TO REMOVAL) WITH MATERIALS TO MATCH EXISTING CONSTRUCTION.
 - SALVAGED ITEMS SHALL BE TURNED OVER TO OWNER UNO.
 - ALL KEYED REMOVALS SHALL INCLUDE REMOVAL OF ANY AND ALL ANCHORING SYSTEMS INCLUDING OBJECTS EMBEDDED INTO EXISTING WALLS.
 - REFER TO ASBESTOS AND MEP DRAWINGS FOR ADDITIONAL REMOVAL INFORMATION.
 - PROVIDE TEMPORARY SHORING AS NECESSARY AT ALL AREAS OF WALL REMOVAL AND NEW WALL PENETRATIONS.
 - DRILL CORNERS OF ALL NEW SANGUIT OPENING PRIOR TO SANGUITTING, TO PREVENT CUTTING INTO SCHEDULED CONSTRUCTION TO REMAIN.
- DEMOLITION KEYNOTES**
- | # | Description |
|-----|--|
| A.5 | REMOVE BUILT-IN CASEWORK IN ITS ENTIRETY. |
| D.1 | REMOVE DOOR, HARDWARE, AND FRAME IN ITS ENTIRETY. |
| D.2 | REMOVE DOOR AND HARDWARE, FRAME TO REMAIN. |
| F.1 | REMOVE FLOOR FINISH INCLUDING ALL PADDING, ADHESIVES AND WALL BASE, TO SLAB BELOW. |
| G.1 | REMOVE WINDOW UNIT SYSTEM IN ITS ENTIRETY, INCLUDING ALL METAL SILL FLASHING, FLASHINGS AND FASTENERS. |
| M.1 | UNIT VENTILATOR, REFER TO MECHANICAL DRAWINGS FOR ADDITIONAL INFORMATION. |
| P.1 | PLUMBING REMOVAL. |
| M.5 | REMOVE STUD PARTITION IN ITS ENTIRETY. |
| M.4 | REMOVE WALL TO THE EXTENT SHOWN. |

ADD ALTERNATE
ALT-GAC-1-01-001

KEY PLAN

REMOVAL PLANS - FIRST & SECOND FLOOR

Sheet No. **WES AD111**

COPYRIGHT © ALL RIGHTS RESERVED

CONSTRUCTION DOCUMENTS

19 Front St., Newburgh - New York 12550-7601
845-561-1319 www.csarch.com

CS ARCH

Project Title
**VALLEY CENTRAL SCHOOL DISTRICT
WALDEN ELEMENTARY SCHOOL
2023 CAPITAL PROJECT - PHASE 1**

Project Title



EXPIRATION DATE: 02/28/2025

#	DATE	DESCRIPTION
1	11/19/24	BID ADDENDUM #1
2	11/26/24	BID ADDENDUM #2
3		
4		


Drawn By: [Signature] Author: [Signature]
Checked By: [Signature] Checker: [Signature]
Proj. #: 44-13-01-06-0-009-021
CSArch Proj. #: 187-2302.01
Issued for Bid: 10/18/24

ROOM FINISH SCHEDULE							
ROOM NUMBER	ROOM NAME	FLOOR		Wall Finish	Accent Wall	CEILING	Comments
		FINISH	BASE				
11	MAIN OFFICE	LVT-1, CPT-1	RB-1	PNT-1			
11B	PRINCIPAL	CPT-1	RB-1	PNT-1			
19	CORRIDOR	ETR	ETR/ RB-2	ETR/ PNT-3			
24	4th GRADE CLASSROOM	LVT-1	RB-1	PNT-1			
94	SECURITY	CPT-1	RB-1	PNT-1			
95	VEST	LVT-1	RB-1	PNT-1			
99	TOILET	CFT-1	CTB-1	CWT-1, 2, 3, 4			


MATERIALS LEGEND						
MATERIAL	MANUFACTURER	MODEL	COLOR #/NAME	SIZE	NOTE	
CARPET TILE						
CPT-1	PATCRAFT	ON NEUTRAL GROUND - RAW EDGE	00580 MOIRE	18" X 36"	OFFICES (ASHLAR)	
CERAMIC FLOOR TILE						
CFT-1	DALTILE	PORTFOLIO	PF04 DOVE GREY MATTE	12" X 24"	TOILETS	
CERAMIC WALL BASE						
CTB-1	DALTILE	COLOR WHEEL LINEAR	X114 DESERT GRAY GLOSS	4"	TOILETS	
CERAMIC WALL TILE						
CWT-1	DALTILE	COLOR WHEEL LINEAR	0190 ARCTIC WHITE GLOSS	4" X 12"	GENERAL WALL TILE	
CWT-2	DALTILE	COLOR WHEEL LINEAR	1174 SEA BREEZE GLOSS	4" X 12"	GENERAL WALL TILE	
CWT-3	DALTILE	COLOR WHEEL LINEAR	X114 DESERT GRAY GLOSS	4" X 12"	GENERAL WALL TILE	
CWT-4	DALTILE	COLOR WHEEL LINEAR	0182 SUEDE GRAY GLOSS	4" X 12"	GENERAL WALL TILE	
LUXURY VINYL TILE						
LVT-1	MANNINGTON COMMERCIAL	COLOR ANCHOR - GROOVE	C141 MISTY MOUNTAIN	6" X 36"	TYP. FLOOR (SQUARE EDGE)	
PAINT						
PNT-1	SHERWIN WILLIAMS	EGG-SHELL	SW 7631 CITY LOFT		GENERAL WALL PAINT	
PNT-2	SHERWIN WILLIAMS	SEMI-GLOSS	SW 7615 SEA SERPENT		HM DOOR PAINT	
PNT-3	SHERWIN WILLIAMS	EGGSHELL	AS SELECTED FROM FULL RANGE OF COLOR / MATCH EXISTING		CORRIDOR	
PLASTIC LAMINATE						
PLAM-1	WILSONART	LAMINATE	5034-38 HANDSPUN DOVE		WORKSURFACE OFFICE	
PLAM-2	WILSONART	LAMINATE	8221-38 SAP WALNUT		CASEWORK	
RUBBER BASE						
RB-1	TARKETT	BASEWORKS	92 BLUE LAGOON	4"	TYP. BASE	

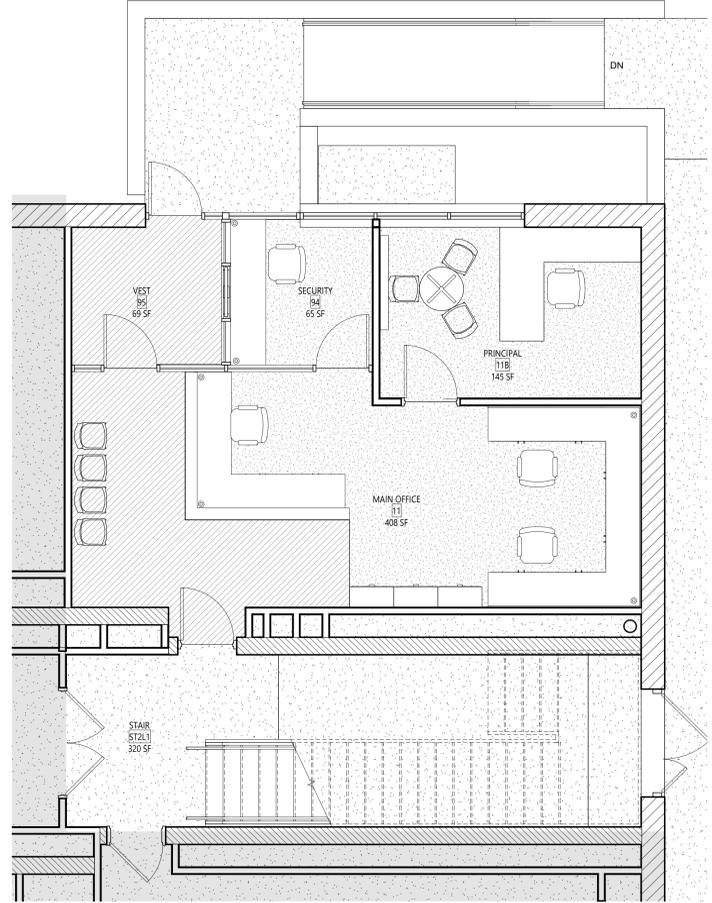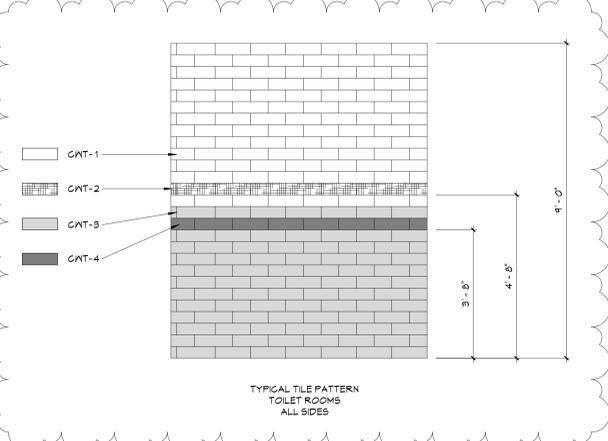

3 AREA C - PARTIAL FIRST FLOOR FURNITURE PLAN
AF111 1/4" = 1'-0"

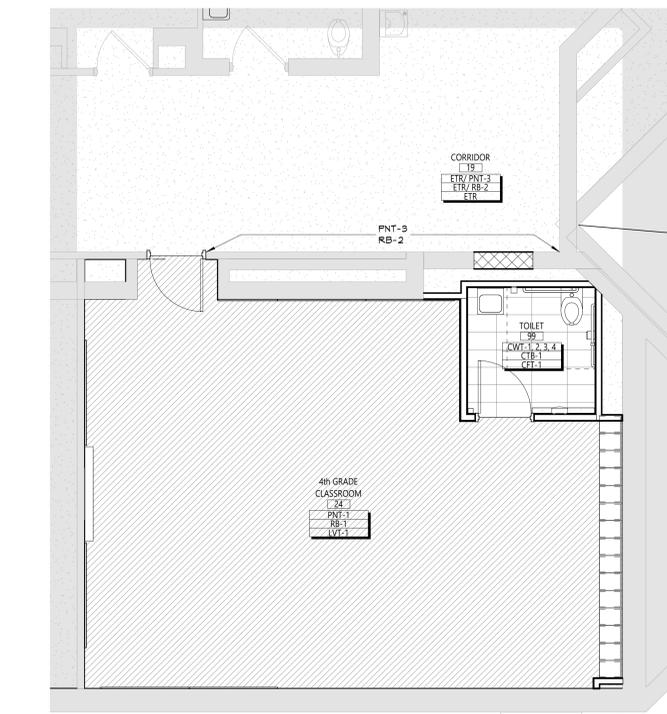

2 AREA B - PARTIAL SECOND FLOOR FINISH PLAN
AF111 1/4" = 1'-0"

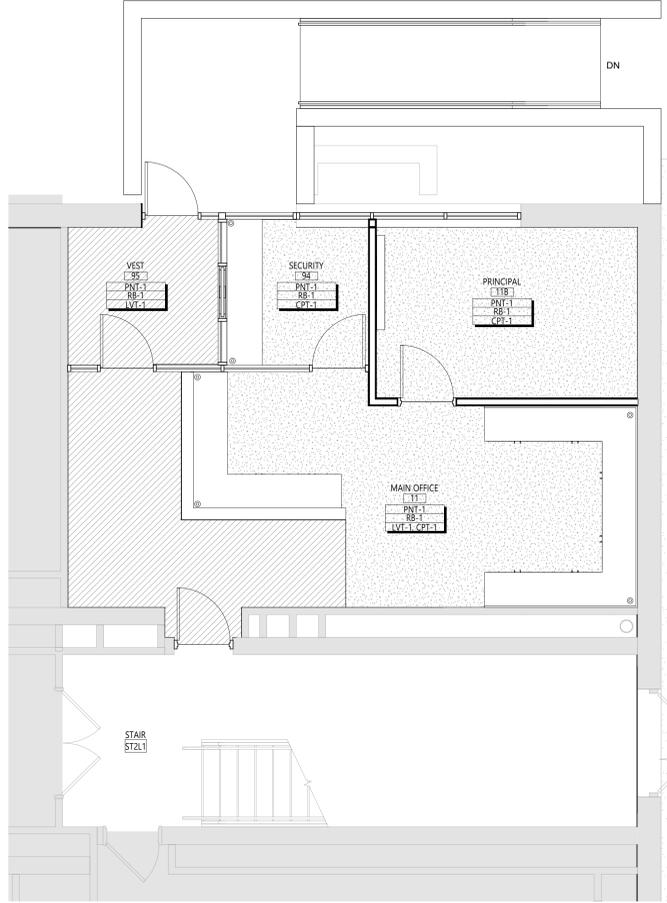


1 AREA C - PARTIAL FIRST FLOOR FINISH PLAN
AF111 1/4" = 1'-0"

DISCLAIMER NOTE
MANUFACTURER'S NAMES AND FINISH INFORMATION ARE INDICATED AS REFERENCED TO THE ARCHITECT'S BASIS-OF-DESIGN SELECTIONS AND HAVE BEEN DETERMINED PRIOR TO BID. THE CONTRACTOR AND OWNER ARE HEREBY NOTIFIED THAT FINISHES INSTALLED IN THE WORK ARE SUBJECT TO CHANGE IN RESPONSE TO SUBMITTALS, CONFIRMED SELECTIONS, PRODUCT AVAILABILITY AND THE SUBSEQUENT COORDINATION OF FINISHES BY ARCHITECT AND MAY DIFFER FROM PRODUCTS LISTED HEREIN.


ABBREVIATIONS

ACMU	ARCHITECTURAL CONCRETE MASONRY UNIT
ACT	ACOUSTICAL CEILING TILE
APG	ACOUSTICAL PANEL CEILING
BBT	BIO-BASED TILE
BRK	BRICK
CFT	CERAMIC FLOOR TILE
CMU	CONCRETE MASONRY UNIT
CGNC	CONCRETE
CRFT	CARPET
CTB	CERAMIC TILE BASE
CMT	CERAMIC MALL TILE
ETR	EXISTING TO REMAIN
EXP	EXPOSED
EXST	EXISTING
FAC/JFF	FACTORY FINISH
GWB	GYPSONUM WALL BOARD
LMG	LINEAR METAL CEILING
MSS	MUSIC STORAGE SYSTEM
MWP	METAL WALL PANEL
PCON	POLISHED CONCRETE
FLAM	PLASTIC LAMINATE
PLAS	PLASTER
FNT	FAINT
RAF	RESILIENT ATHLETIC FLOORING
RB	RUBBER BASE
RF	RESINOUS FLOORING
RST	RUBBER STAIR TREAD / LANDING
RT	RUBBER TILE FLOORING
SCONG	SEALED CONCRETE
SS	STAINLESS STEEL
STF	SYNTHETIC TURF FLOORING
STL	STEEL
TERR	TERRAZZO
TP	TOILET PARTITIONS
TYP	TYPICAL
VGT	VINYL COMPOSITION TILE
VGTAS	VINYL COMPOSITION TILE ANTI-STATIC
VVC	VINYL WALLCOVERING
WAF	WOOD ATHLETIC FLOORING
WOP	WOOD
WOM	WALK-OFF MAT

- GENERAL FINISH NOTES**
- ALL EXPOSED SURFACES OF NEW PARTITIONS ARE TO BE PAINTED.
 - WHEN ANY WORK IS PERFORMED ON ANY EXISTING WALL, THE ENTIRE WALL SURFACE IS TO BE PAINTED CORNER TO CORNER, UNLESS NOTED OTHERWISE.
 - NEW HM DOORS, DOOR FRAMES AND WINDOW FRAMES AND ETR CORRIDOR DOOR & WINDOW FRAMES AS SCHEDULED ON A600 SERIES DRAWINGS.

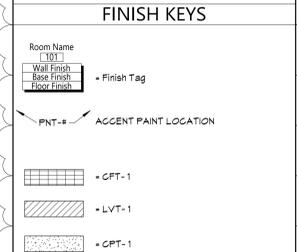

**ADD ALTERNATE
ALT-GAC-1-01-001**

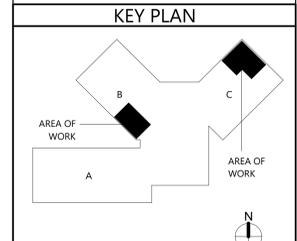

19 Front St., Newburgh - New York 12550-7601
845-581-3379 www.csarch.com

CS ARCH

Valley Central School District
Walden Elementary School
2023 Capital Project - Phase 1

Project Title

EXPIRATION DATE: 02/28/2025

NO.	DATE	BID ADDENDUM #	DESCRIPTION
1	11/16/24		

Drawn By: AS
Checked By: 44-13-01-06-0-009-021
CSArch Proj. #: 187-2302.01
Issued for Bid: 10/18/24

Sheet Title
MATERIAL SCHEDULE, FURNITURE, AND FLOOR FINISH PLANS

Sheet No.
WES AF111

CONSTRUCTION DOCUMENTS

C:\Users\skawron\Documents\187-2302.01_VCSO WES_aka\wos\AF111.rvt

COPYRIGHT © ALL RIGHTS RESERVED