


FILE: \\VE-FILES\PUBLIC\DRAWINGS\RHINEBECK (V)22-2498 WTP C-001 - 002 EX & PR PROCESS FLOW DIAG. Sewer: 11/7/2024, 4:42:59 PM. Plotted: 11/7/2024, 4:43:27 PM. User: Anthony Morita, Lat/SavedBy: morita

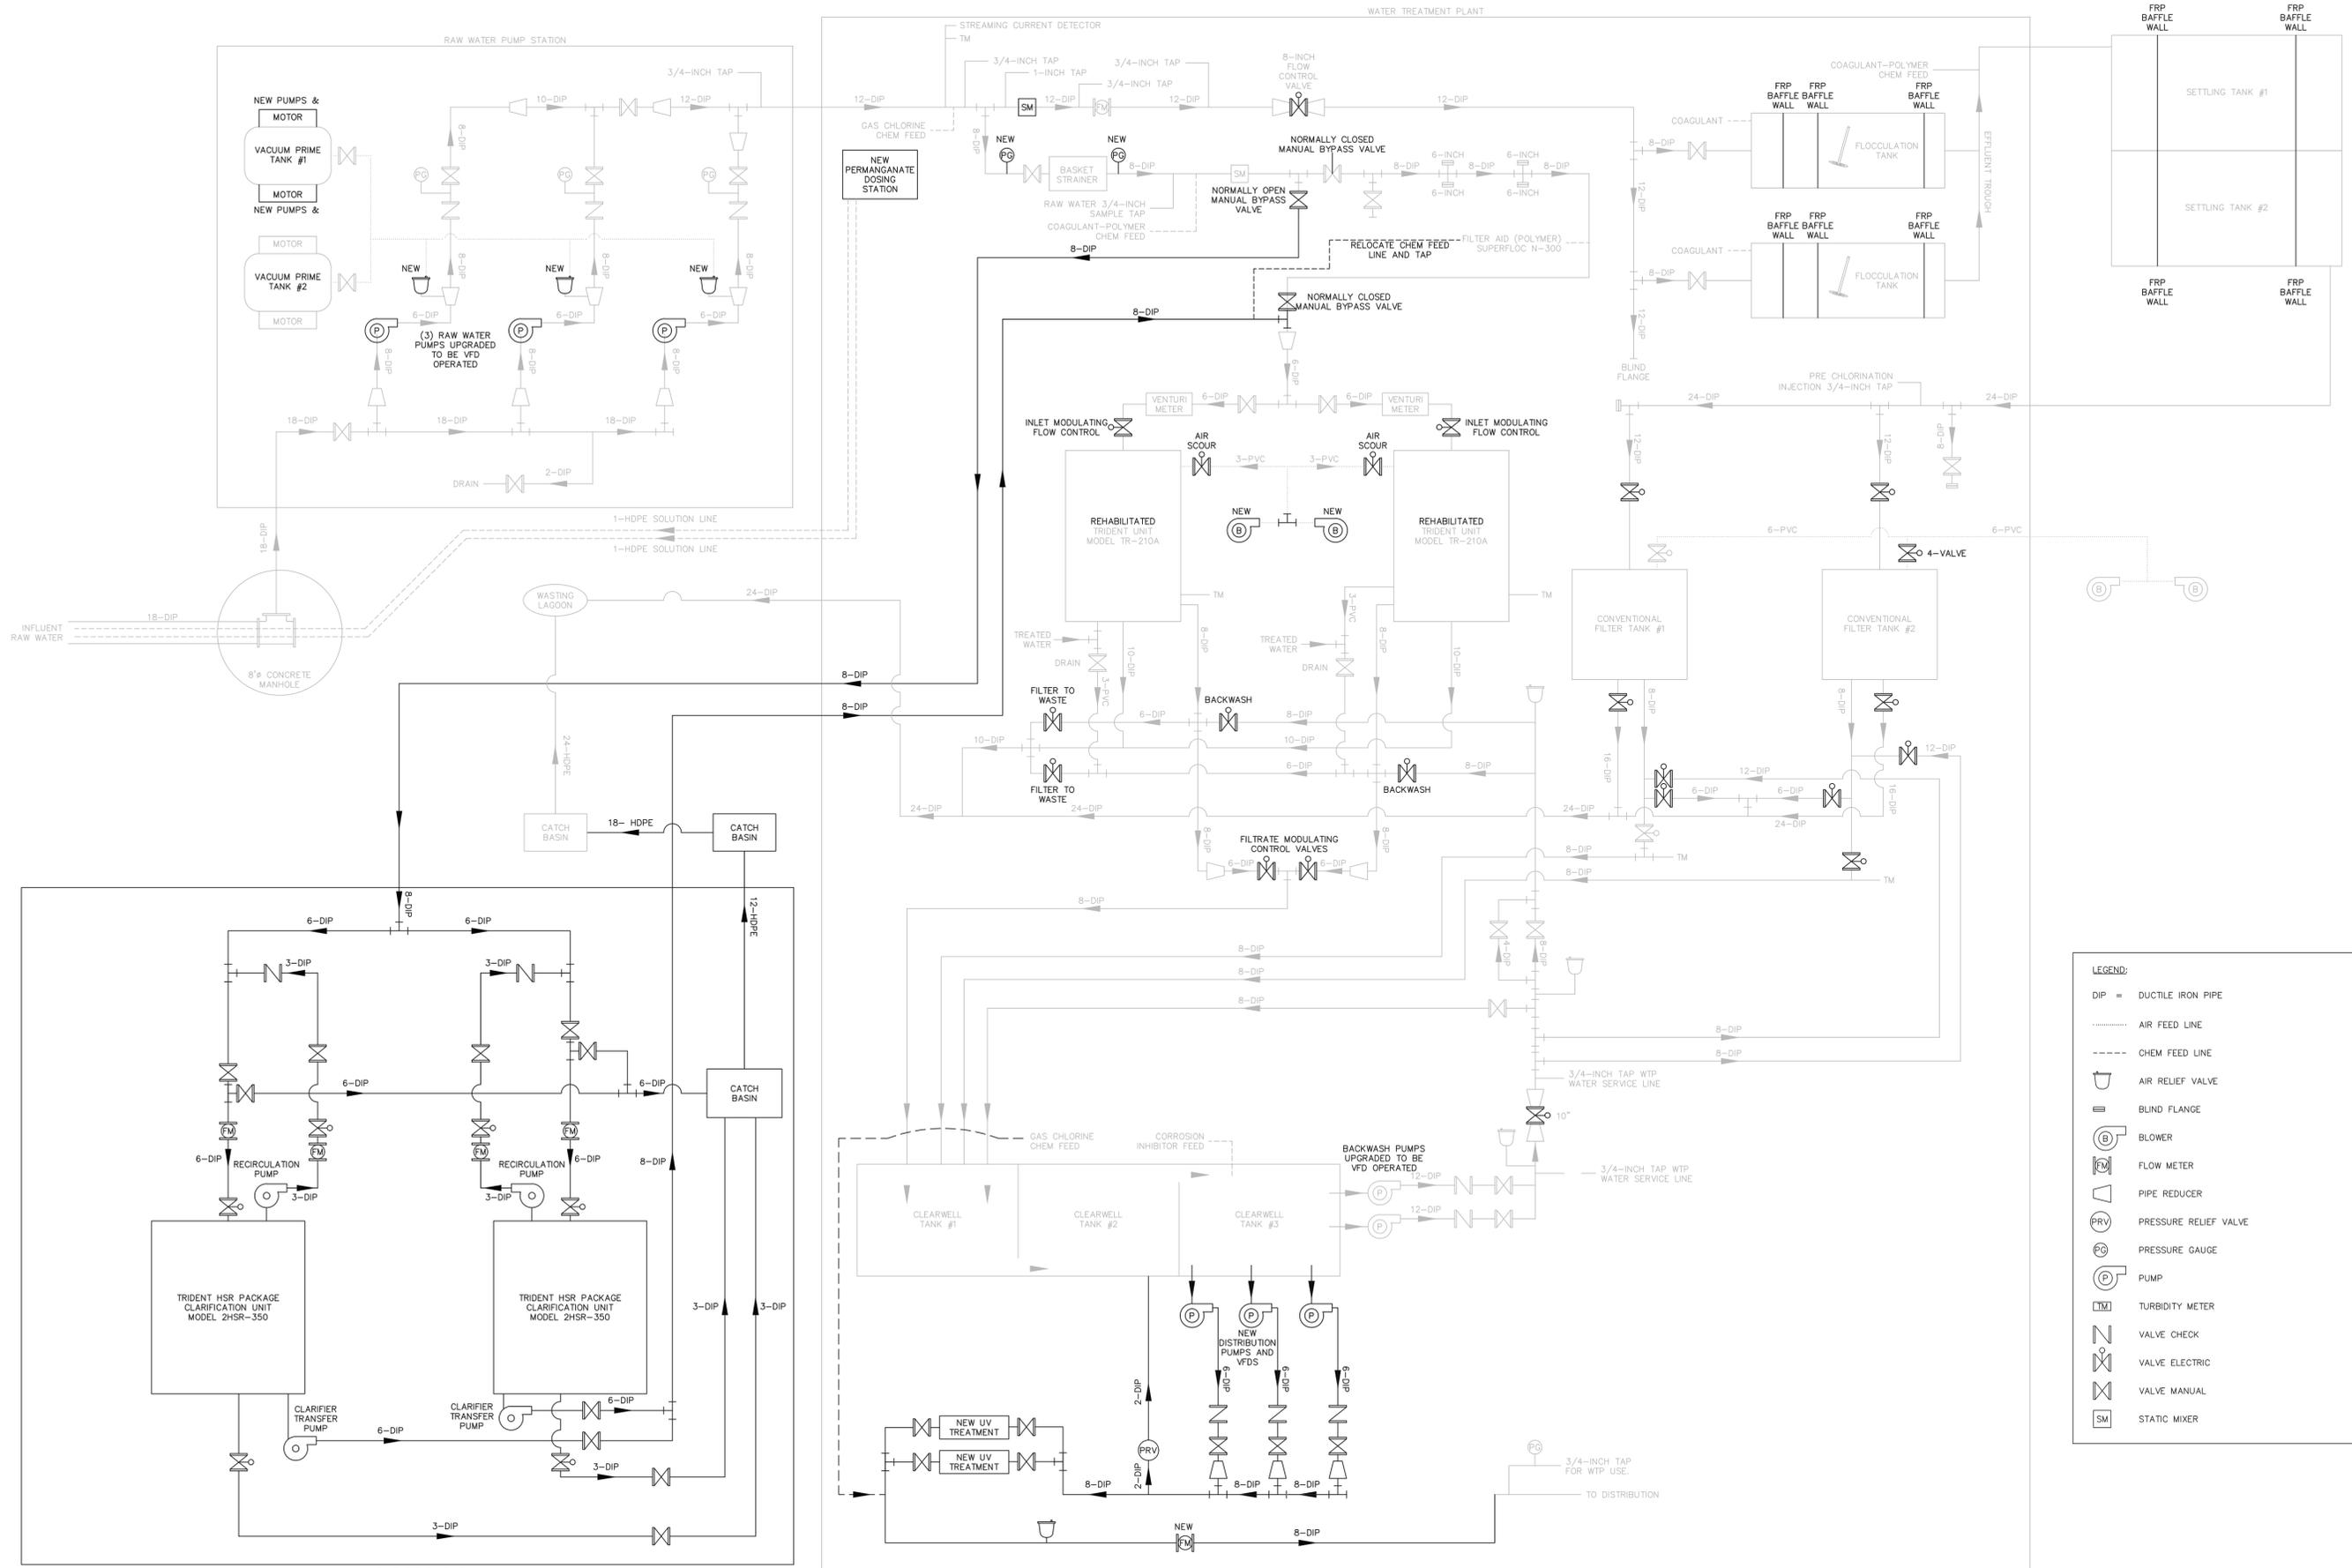


**LEGEND:**

- DIP = DUCTILE IRON PIPE
- ..... AIR FEED LINE
- CHEM FEED LINE
- ☐ AIR RELIEF VALVE
- ☐ BLIND FLANGE
- ⊙ BLOWER
- ⊙ FLOW METER
- ⊙ PIPE REDUCER
- ⊙ PRESSURE RELIEF VALVE
- ⊙ PRESSURE GAUGE
- ⊙ PUMP
- ⊙ TURBIDITY METER
- ⊙ VALVE CHECK
- ⊙ VALVE ELECTRIC
- ⊙ VALVE MANUAL
- SM STATIC MIXER

DATE: 11/1/2024  
 DRAWN BY:  
 SCALE:  
 REVIEWED BY: RF  
 PROJECT NO.:  
 FILE:

**DELAWARE ENGINEERING, D.P.C.**  
 CIVIL AND ENVIRONMENTAL ENGINEERING  
 28 MADISON AVENUE EXTENSION, ALBANY, NY 12203 - 518.452.1290  
 55 SOUTH MAIN ST., ONEONTA, NY 13820 - 607.432.8073  
 100 W. STATE ST., BINGHAMTON, NY 13902 - 607.734.8644  
 8 TOWNSEND STREET, WALTON, NY 13854 - 607.866.9262  
 16 EAST MARKET ST., RED HOOK, NY 12571 - 518.452.1290  
 548 BROADWAY, MONTICELLO, NY 12701 - 845.791.7777

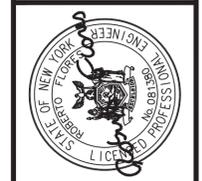

| NO. | DATE     | DESCRIPTION           |
|-----|----------|-----------------------|
| 1.  | 06/21/24 | MAY 2024 DOH COMMENTS |
| 2.  | 10/02/24 | SEPT. 24 DOH COMMENTS |

**RHINEBECK WTP  
 PLANT IMPROVEMENTS  
 VILLAGE OF RHINEBECK  
 DUTCHESS COUNTY, NEW YORK**


**PROPOSED  
 PROCESS FLOW  
 DIAGRAM**

SHEET:  
**C-002**




WARNING - IT IS A VIOLATION OF NEW YORK EDUCATION LAW SECTION 7209.2, FOR ANY PERSON, UNLESS HE IS ACTING UNDER THE DIRECTION OF A LICENSED PROFESSIONAL ENGINEER OR LAND SURVEYOR, TO ALTER THIS DOCUMENT IN ANY WAY. IF ALTERED THE ALTERING PERSON SHALL COMPLY WITH THE REQUIREMENTS OF NEW YORK EDUCATION LAW, SECTION 7209.2.



File: H:\DRAWINGS\RHINEBECK\032-2496\WPA-C-101 - 105 - EXISTING FLOOR PLANS & SECTIONS.DWG Saved: 10/29/2024 12:11:42 PM Plotted: 11/1/2024 4:47:51 PM User: Anthony Mantua LastSavedBy: mantua

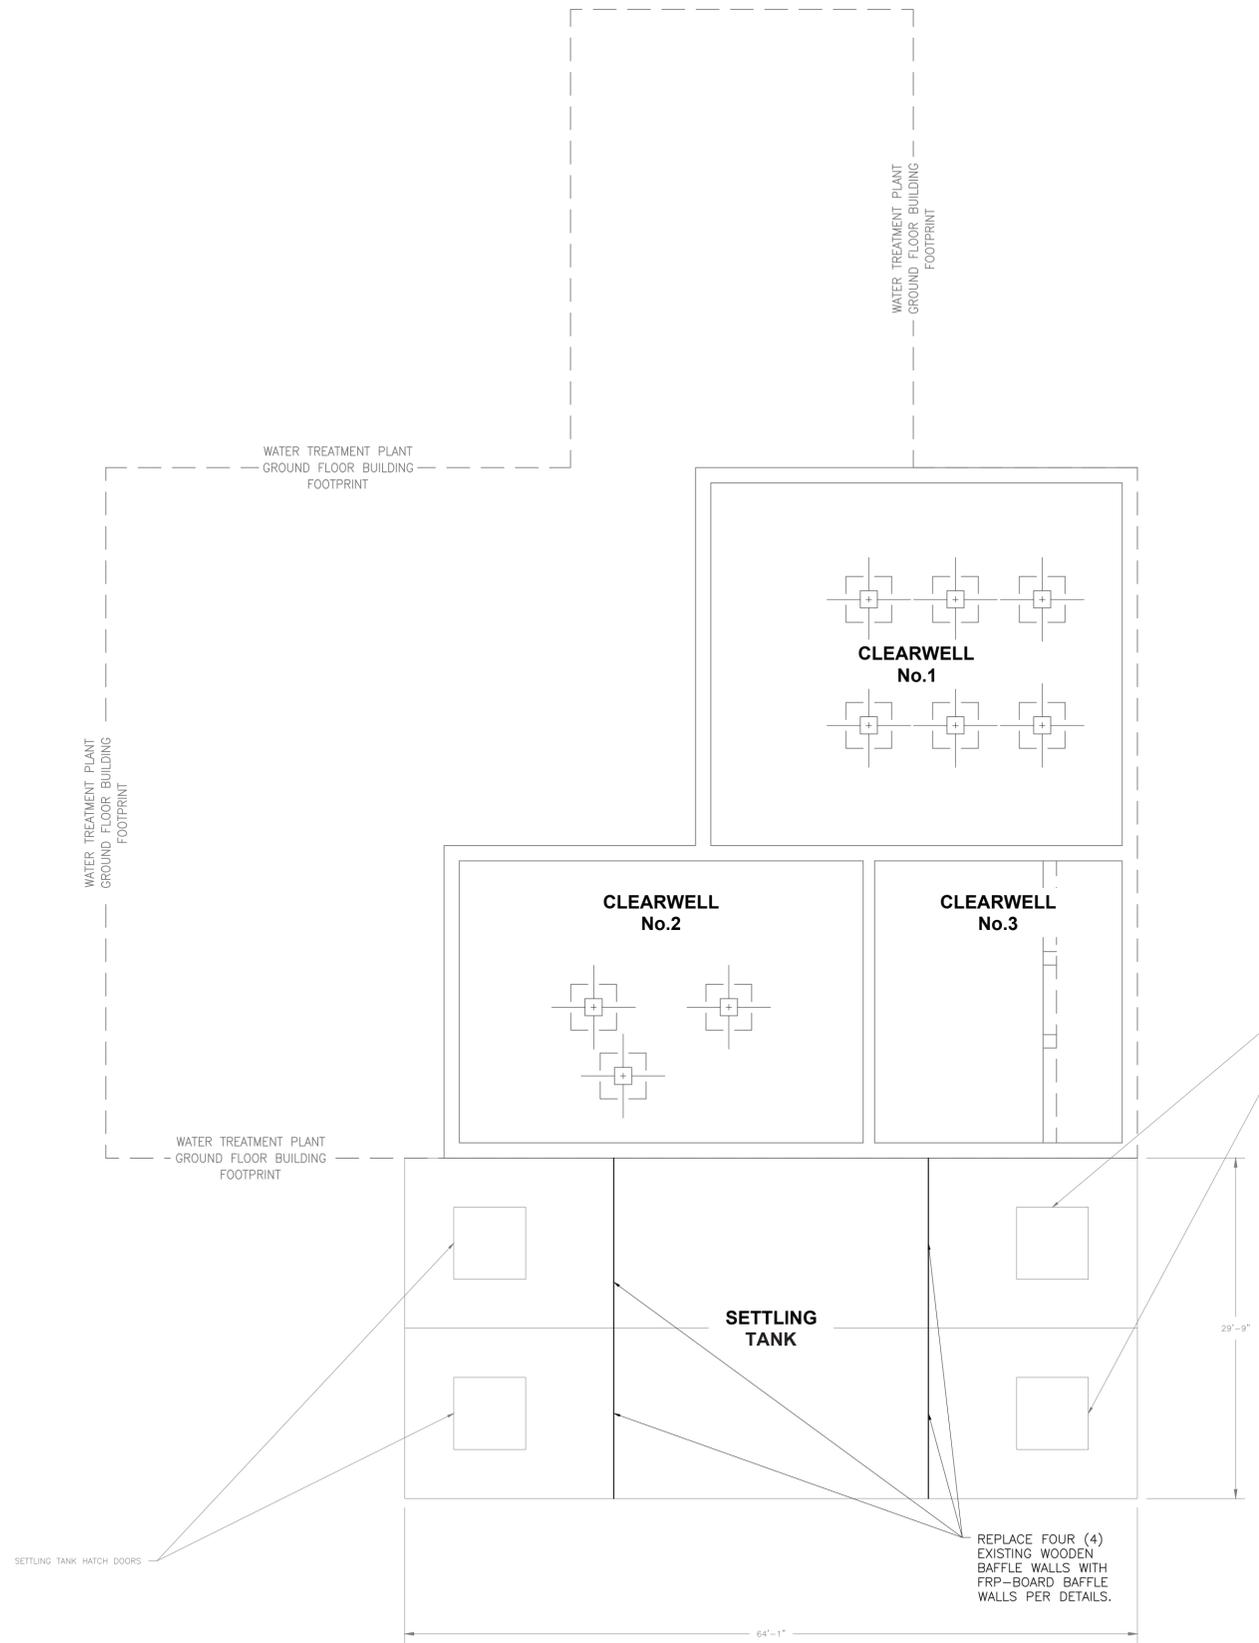

**PROPOSED UPGRADES TO EXISTING SETTLING TANKS**  
SCALE: 1/8"=1'-0"

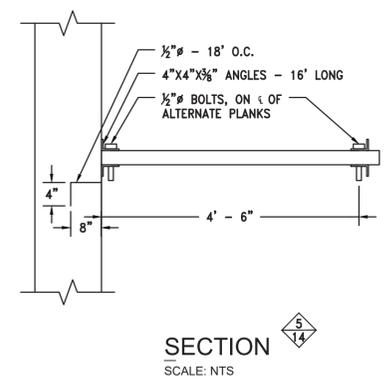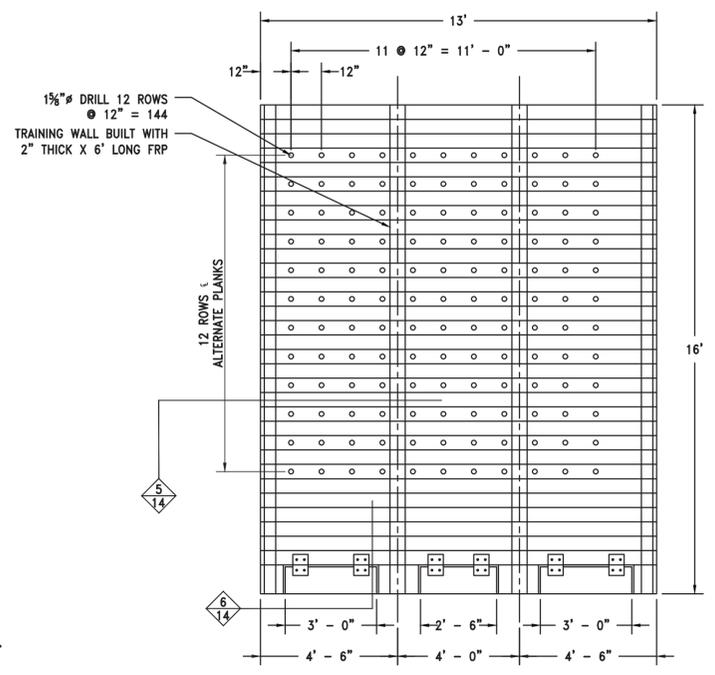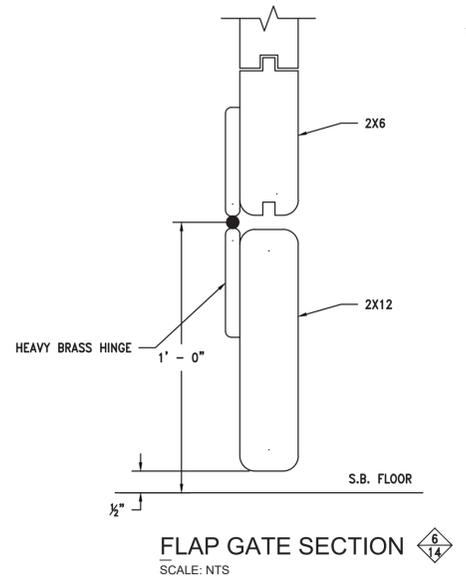

DATE: 10/29/2024  
DRAWN BY:  
SCALE:  
REVIEWED BY: RF  
PROJECT NO.:  
FILE:

**DELAWARE ENGINEERING, D.P.C.**  
CIVIL AND ENVIRONMENTAL ENGINEERING  
28 MADISON AVENUE EXTENSION, ALBANY, NY 12203 - 518.452.1290  
53 NORTH MAIN STREET, ALBANY, NY 12204 - 518.452.1290  
6 TOWNSEND STREET, WALTON, NY 13856 - 607.885.9235  
16 EAST MARKET ST., RED HOOK, NY 12571 - 518.452.1290  
548 BROADWAY, MONTICELLO, NY 12071 - 845.791.7777



| NO. | DATE     | DESCRIPTION           |
|-----|----------|-----------------------|
| 1.  | 06/21/24 | MAY 2024 DOH COMMENTS |

RHINEBECK WTP  
PLANT IMPROVEMENTS  
VILLAGE OF RHINEBECK  
DUTCHESS COUNTY, NEW YORK


PROPOSED UPGRADES TO  
EXISTING SETTLING TANKS

SHEET:  
**C-104**


WARNING - IT IS A VIOLATION OF NEW YORK EDUCATION LAW SECTION 2209.2, FOR ANY PERSON, UNLESS HE IS ACTING UNDER THE DIRECTION OF A LICENSED PROFESSIONAL ENGINEER OR LAND SURVEYOR, TO ALTER THIS DOCUMENT IN ANY WAY. IF ALTERED THE ALTERING PERSON SHALL COMPLY WITH THE REQUIREMENTS OF NEW YORK EDUCATION LAW, SECTION 2209.2.



(3) NEW HIGHLIFT PUMPS, 700 GPM @ 422 TDH, GOULDS VT-12WAHC, OR EQUAL. PROVIDE ISOLATION VALVES, SWING CHECK VALVES WITH CLOSED LIMIT SWITCHES AND EXTERNAL SPRING-LOADED LEVERS, REQUIRED FITTINGS, PRESSURE GAUGES, AND CONTROLS

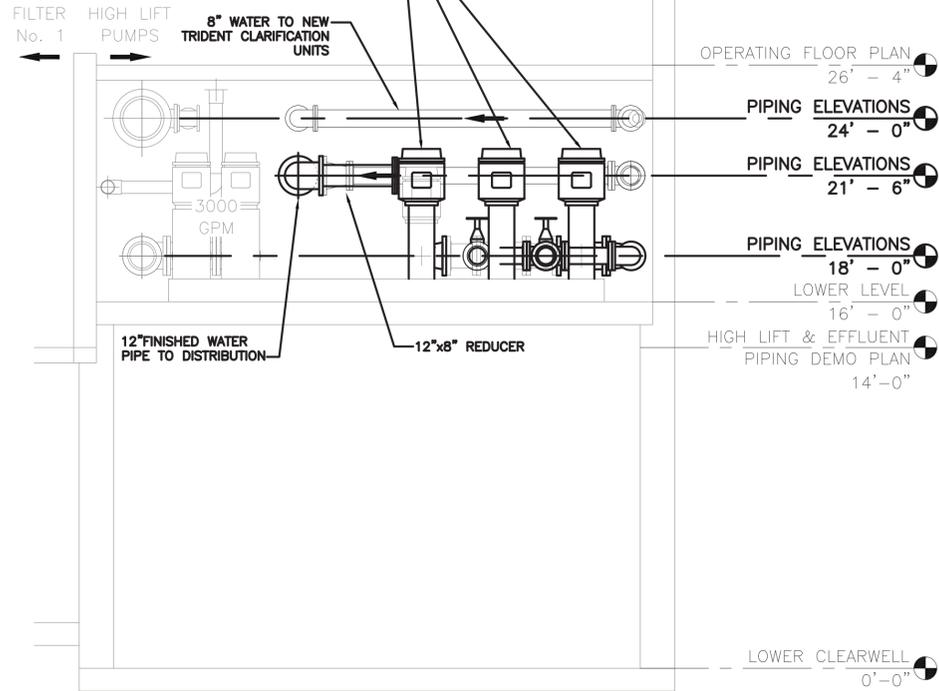

(3) NEW HIGHLIFT PUMPS, 700 GPM @ 422 TDH, GOULDS VT-12WAHC, OR EQUAL. PROVIDE ISOLATION VALVES, SWING CHECK VALVES WITH CLOSED LIMIT SWITCHES AND EXTERNAL SPRING-LOADED LEVERS, REQUIRED FITTINGS, PRESSURE GAUGES, AND CONTROLS

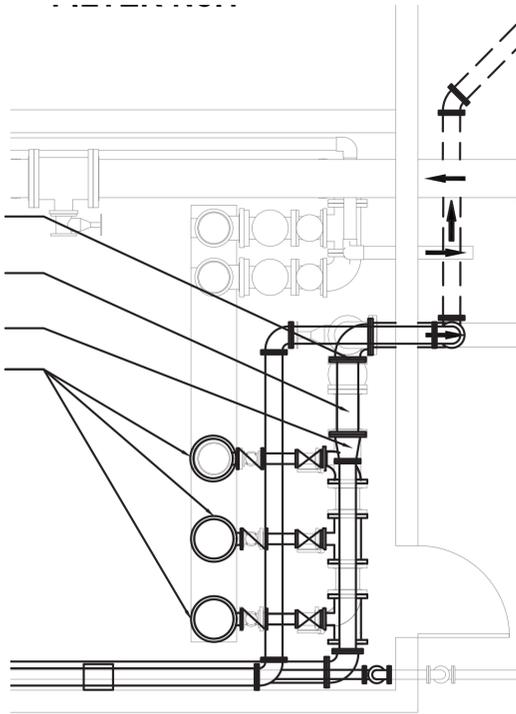


NOTES:

- ALL UTILITIES TO BE CONFIRMED IN THE FIELD BY THE CONTRACTOR. CONTRACTOR SHALL PROVIDE COST IN BASE BID TO LOCATE ALL EXISTING SANITARY, WATER AND ELECTRIC LINES ON SITE BY A QUALIFIED PROFESSIONAL LOCATING SERVICE.
- CONTRACTOR SHALL HOLD ALL UTILITIES LINES AS REQUIRED AT NO ADDITIONAL COST TO THE OWNER.
- CONTRACTOR SHALL PROVIDE ALL S.S. SUPPORTS.
- ALL JOINTS SHALL BE RESTRAINED.
- ALL HARDWARE SHALL BE S.S.
- ALL PLUG VALVES SHALL BE GEAR ACTUATED PLUG VALVES.
- ALL PLUG VALVES IN EQ AND WTP TANKS VALVE VAULT SHALL HAVE EXTENDED S.S. OPERATORS WITH VALVE BOX COVERS. PROVIDE ALL S.S. SUPPORTS, COUPLINGS, AND ALL APPURTENANCES.

A HIGH LIFT PUMP NEW PIPING SECTION  
C-202 SCALE: 1/4"=1'-0"


HIGH LIFT PUMP NEW PIPING PLAN  
SCALE: 1/4"=1'-0"

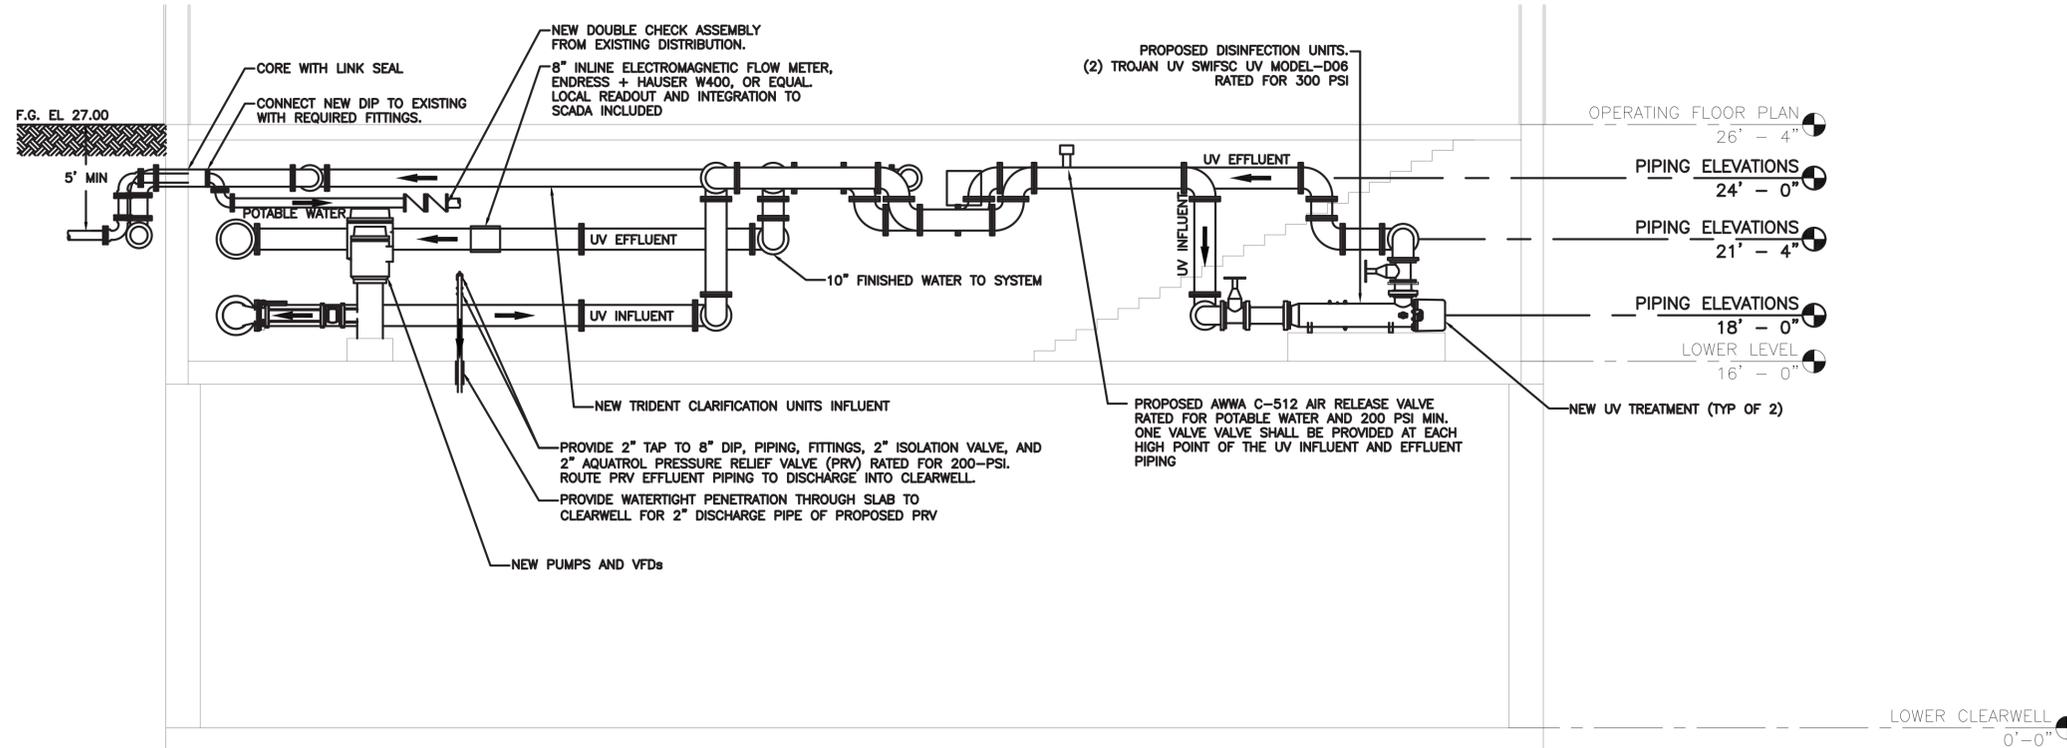

B FILTER AND UV TREATMENT PIPING SECTION  
C-202 SCALE: 1/4"=1'-0"

DATE: 11/1/2024  
DRAWN BY:  
SCALE:  
REVIEWED BY: RF  
PROJECT NO.:  
FILE:

**DELAWARE ENGINEERING, D.P.C.**  
CIVIL AND ENVIRONMENTAL ENGINEERING  
28 MADISON AVENUE EXTENSION, ALBANY, NY 12203 - 518.452.1290  
55 SOUTH MAIN STREET, ALBANY, NY 12204 - 518.452.9777  
6 TOWNSEND STREET, WALTON, NY 13856 - 607.686.9235  
16 EAST MARKET ST., RED HOOK, NY 12571 - 518.452.1290  
548 BROADWAY, MONTICELLO, NY 12701 - 845.791.7777

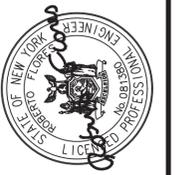

| NO. | DATE     | DESCRIPTION           |
|-----|----------|-----------------------|
| 1.  | 06/21/24 | MAY 2024 DOH COMMENTS |
| 2.  | 10/02/24 | SEPT. 24 DOH COMMENTS |
| 3.  | 11/24    | ADDENDUM #1           |


RHINEBECK WTP  
PLANT IMPROVEMENTS  
VILLAGE OF RHINEBECK  
DUTCHESS COUNTY, NEW YORK

NEW PIPING SECTIONS

SHEET:  
C-202

WARNING - IT IS A VIOLATION OF NEW YORK EDUCATION LAW SECTION 2209.2, FOR ANY PERSON, UNLESS HE IS ACTING UNDER THE DIRECTION OF A LICENSED PROFESSIONAL ENGINEER OR LAND SURVEYOR, TO ALTER THIS DOCUMENT IN ANY WAY. IF ALTERED THE ALTERING PERSON SHALL COMPLY WITH THE REQUIREMENTS OF NEW YORK EDUCATION LAW, SECTION 2209.2.

File: H:\DRAWINGS\RHINEBECK (V)\2-2496 WTP\C-201 - 205 - PROPOSED FLOOR PLANS & SECTIONS.DWG Sheet: 11/1/2024 9:22:20 AM Plotter: 11/1/2024 9:31:21 AM User: isa Briles LastSavedBy: isa Briles

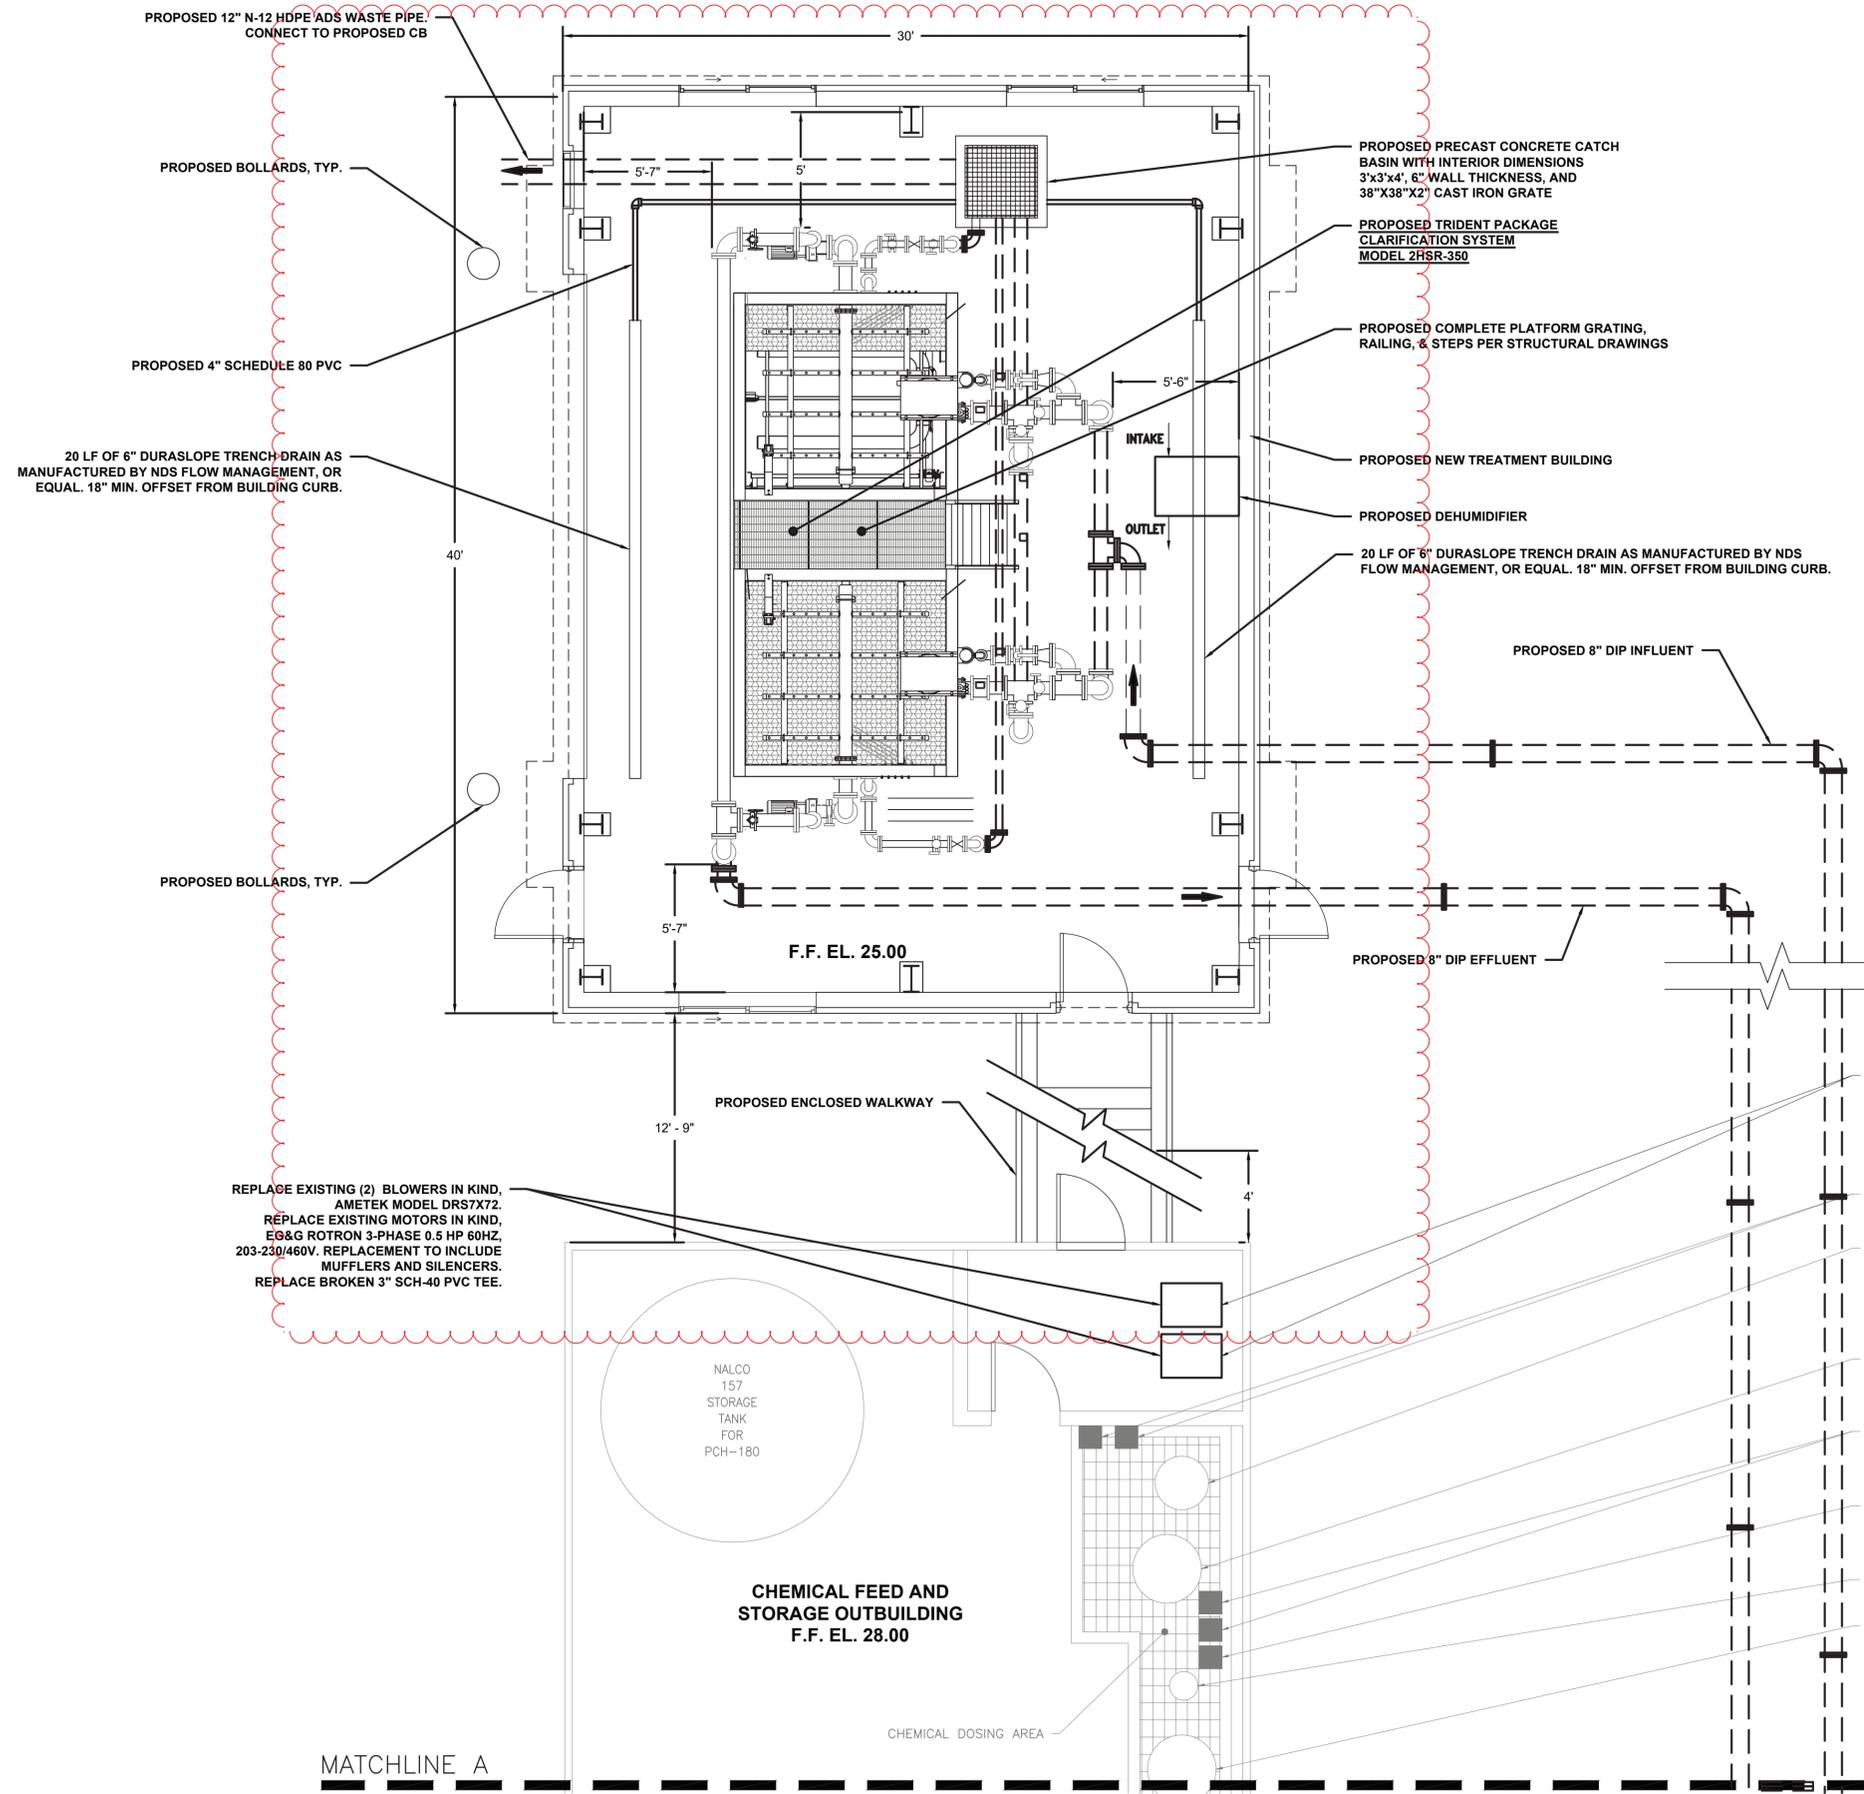

- NOTES:**
1. ALL UTILITIES TO BE CONFIRMED IN THE FIELD BY THE CONTRACTOR. CONTRACTOR SHALL PROVIDE COST IN BASE BID TO LOCATE ALL EXISTING SANITARY, WATER AND ELECTRIC LINES ON SITE BY A QUALIFIED PROFESSIONAL LOCATING SERVICE.
  2. CONTRACTOR SHALL HOLD ALL UTILITIES LINES AS REQUIRED AT NO ADDITIONAL COST TO THE OWNER.
  3. CONTRACTOR SHALL PROVIDE ALL S.S. SUPPORTS.
  4. ALL JOINTS SHALL BE RESTRAINED.
  5. ALL HARDWARE SHALL BE S.S.
  4. ALL PLUG VALVES SHALL BE GEAR ACTUATED PLUG VALVES.
  5. ALL PLUG VALVES IN EQ AND WTP TANKS VALVE VAULT SHALL HAVE EXTENDED S.S. OPERATORS WITH VALVE BOX COVERS. PROVIDE ALL S.S. SUPPORTS, COUPLINGS, AND ALL APPURTENANCES.

DATE: 11/1/2024  
 DRAWN BY:  
 SCALE:  
 REVIEWED BY: RF  
 PROJECT NO.:  
 FILE:

**DELAWARE ENGINEERING, D.P.C.**  
 CIVIL AND ENVIRONMENTAL ENGINEERING  
 28 MADISON AVENUE EXTENSION, ALBANY, NY 12203 - 518.452.1290  
 55 SOUTH MAIN STREET, ALBANY, NY 12204 - 518.452.9962  
 6 TOWNSEND STREET, WALTON, NY 13856 - 607.686.9235  
 16 EAST MARKET ST., RED HOOK, NY 12571 - 518.452.1290  
 548 BROADWAY, MONTICELLO, NY 12701 - 845.791.7777



| NO. | DATE     | DESCRIPTION           |
|-----|----------|-----------------------|
| 1.  | 06/21/24 | MAY 2024 DOH COMMENTS |
| 2.  | 11/01/24 | ADDENDUM #1           |

RHINEBECK WTP  
 PLANT IMPROVEMENTS  
 VILLAGE OF RHINEBECK  
 DUTCHESS COUNTY, NEW YORK

NEW FILTER BUILDING  
 PIPING PLAN

SHEET:  
**C-204**

File: H:\DRAWINGS\RHINEBECK\03\2-2496\WPA\C-201 - 205 - PROPOSED FLOOR PLANS & SECTIONS.DWG Sheet: 11/1/2024 9:22:20 AM Plotted: 11/1/2024 9:31:39 AM User: Irl Braglia LantSawdy - IrlBraglia

WARNING - IT IS A VIOLATION OF NEW YORK EDUCATION LAW SECTION 2209.2, FOR ANY PERSON, UNLESS HE IS ACTING UNDER THE DIRECTION OF A LICENSED PROFESSIONAL ENGINEER OR LAND SURVEYOR, TO ALTER THIS DOCUMENT IN ANY WAY. IF ALTERED THE ALTERING PERSON SHALL COMPLY WITH THE REQUIREMENTS OF NEW YORK EDUCATION LAW, SECTION 2209.2.

**APPLICABLE CODE:**

THE NEW YORK STATE UNIFORM FIRE PREVENTION AND BUILDING CODE (THE "UNIFORM CODE"); CONSTRUCTION SHALL CONFORM TO THE CURRENT EDITIONS OF THE 2018 INTERNATIONAL BUILDING CODE (IBC), THE 2020 NEW YORK STATE CODE SUPPLEMENT, THE 2018 INTERNATIONAL ENERGY CONSERVATION CODE (IECC), THE 2020 SUPPLEMENT TO THE NEW YORK STATE ENERGY CONSERVATION CONSTRUCTION CODE, AS WELL AS ALL OTHER CURRENT LOCAL, STATE, AND FEDERAL CODES AND REGULATIONS APPLICABLE TO THIS PROJECT. CONTRACTOR SHALL CONSTRUCT THE PROJECT IN ACCORDANCE WITH THE APPLICABLE CODES.

**BUILDING DATE & CODE**

**OCCUPANCY CLASSIFICATION:** (CHAPTERS 3 & 5)

SINGLE  MIXED  NON-SEPARATED  COMBINATION

IF SEPARATED, FIRE RESISTANCE RATING OF FIRE BARRIER (TABLE 508.4): \_\_\_\_\_ HR

OCCUPANCY CLASSIFICATION(S): U

USES: HIGHWAY VEHICLE & MISCELLANEOUS STORAGE

**CONSTRUCTION CLASSIFICATION (CHAPTER 6):** IIB

**AUTOMATIC SPRINKLER SYSTEM PROVIDED:**  YES  NO

NFPA STANDARD:  13  13R

**HEIGHT & AREA - ACTUAL** (CHAPTER 5)

|                                |                |                   |
|--------------------------------|----------------|-------------------|
| BUILDING HEIGHT                | HEIGHT IN FEET | HEIGHT IN STORIES |
|                                | 28' - 3"       | 1                 |
| BUILDING AREA SUMMARY          | BUILDING AREA  |                   |
| FIRST                          | 11,644 SF      |                   |
| TOTAL (NOT INCLUDING BASEMENT) | 11,644 SF      |                   |

**HEIGHT & AREA - ALLOWABLE** (CHAPTER 5)

AREA PER TABLE 504.3 & 506.2

| OCCUPANCY CLASSIFICATION | TABULAR AREA | TABULAR HEIGHT |         |
|--------------------------|--------------|----------------|---------|
|                          |              | FEET           | STORIES |
| U                        | 8,500 SF     | 55 FT          | 2       |

INCREASE DUE TO FRONTAGE ALLOWED, THEREFORE ALLOWABLE AREA INCREASED TO 14,875 SF

**FIRE RESISTANCE OF BUILDING ELEMENTS:**  
BASED ON CONSTRUCTION TYPE IIB

| STRUCTURAL FRAME             | REQUIRED | PROVIDED | SECTION      |
|------------------------------|----------|----------|--------------|
| BEARING WALLS (EXTERIOR)     | NA       | NA       | TABLE 601    |
| BEARING WALLS (INTERIOR)     | NA       | NA       | TABLE 601    |
| NON-BEARING WALLS (EXTERIOR) | 0        | 0        | TABLE 601    |
| NON-BEARING WALLS (INTERIOR) | 0        | 0        | TABLE 601    |
| FLOOR CONSTRUCTION           | 0        | 0        | TABLE 601    |
| ROOF CONSTRUCTION            | 0        | 0        | TABLE 601    |
| VERTICAL EXIT ENCLOSURE      | NA       | NA       | 713.4        |
| SHAFT ENCLOSURE              | NA       | NA       | 713.4        |
| CORRIDORS                    | NA       | NA       | TABLE 1020.1 |

**INTERIOR FINISHES:**  
BASED ON MOST RESTRICTIVE

| USE GROUP B                | REQUIRED | PROVIDED | SECTION      |
|----------------------------|----------|----------|--------------|
| WALLS & CEILING: EXITS     | NA       | NA       | TABLE 803.13 |
| WALLS & CEILING: CORRIDORS | NA       | NA       | TABLE 803.13 |
| WALLS & CEILING: ROOMS     | NA       | NA       | TABLE 803.13 |
| FLOORS                     | NA       | NA       | TABLE 803.13 |

**CODE:**

- ALL WORK SHALL CONFORM TO FEDERAL, STATE AND LOCAL CODES AS INTERPRETED BY THE LOCAL AUTHORITY HAVING JURISDICTION.
- DO NOT INSTALL FIRE EXTINGUISHERS/CABINETS/BRACKETS UNTIL ALL LOCATIONS HAVE BEEN REVIEWED AND APPROVED BY THE CODE AUTHORITY HAVING JURISDICTION. CONTRACTOR SHALL COORDINATE WITH FIRE MARSHAL PRIOR TO INSTALLATION.
- THE ARCHITECT'S CERTIFICATION ON THIS PROJECT IS ONLY FOR THE CONSTRUCTION WORK SHOWN TO BE DONE. IT DOES NOT CONSTITUTE APPROVAL OF ANY PRE-EXISTING CONDITIONS OR REVIEW OF THOSE CONDITIONS FOR CODE COMPLIANCE.
- THE ARCHITECT'S CERTIFICATION ON THIS PROJECT IS FOR COMPLIANCE WITH THE BUILDING CODE OF NEW YORK STATE AND ITS VARIOUS REFERENCE STANDARDS, FOR PURPOSES OF OBTAINING A BUILDING PERMIT THROUGH THE AUTHORITY HAVING JURISDICTION AND TO CONVEY CONSTRUCTION REQUIREMENTS FOR THE PROJECT. CERTIFICATION DOES NOT GUARANTEE COMPLIANCE WITH LOCAL CODES THAT MAY APPLY.
- GENERAL CONDITIONS OF THE CONTRACT FOR CONSTRUCTION, AIA DOCUMENT A201-2007 AND ANY OTHER DOCUMENTS AS PROVIDED BY THE OWNER SHALL BE INCORPORATED INTO THE OWNER-CONTRACTOR CONTRACT BY REFERENCE.
- CONSTRUCTION SHALL CONFORM TO CURRENT EDITIONS OF THE NEW YORK STATE UNIFORM FIRE PREVENTION AND BUILDING CODE (THE "UNIFORM CODE"); CONSTRUCTION SHALL CONFORM TO CURRENT EDITIONS OF THE 2018 INTERNATIONAL BUILDING CODE (IBC), THE 2020 NEW YORK STATE UNIFORM CODE SUPPLEMENT, THE 2018 INTERNATIONAL ENERGY CONSERVATION CODE (IECC), THE 2020 SUPPLEMENT TO THE NEW YORK STATE ENERGY CONSERVATION CONSTRUCTION CODE, 2010 AMERICANS WITH DISABILITIES ACT (ADA) STANDARDS FOR ACCESSIBLE DESIGN (28 CFR PART 36, SUBPART D), 2009 ADA ACCESSIBILITY AND USABLE BUILDINGS AND FACILITIES (CIVILANSI A117.1-2009), AS WELL AS WITH ALL OTHER CURRENT LOCAL, STATE AND FEDERAL CODES AND REGULATIONS APPLICABLE TO THIS PROJECT. CONTRACTOR SHALL CONSTRUCT THE PROJECT IN ACCORDANCE WITH THE APPLICABLE CODES RELEVANT TO THIS PROJECT.
- CONTRACTOR IS RESPONSIBLE FOR OBTAINING ALL REQUIRED PERMITS AND PAYMENT OF ALL PERMIT AND APPLICATION FEES FOR THE CONSTRUCTION OF THE PROJECT.
- TO THE BEST OF MY KNOWLEDGE, BELIEF AND PROFESSIONAL JUDGEMENT, THESE PLANS ARE IN CONFORMANCE WITH THE 2020 SUPPLEMENT OF THE NEW YORK STATE ENERGY CONSERVATION CONSTRUCTION CODE.
- THE FOLLOWING IS AN EXCERPT FROM THE NEW YORK EDUCATION LAW ARTICLE 145 SECTION 7209 AND APPLIES TO THESE DRAWINGS: "IT IS A VIOLATION OF THIS LAW FOR ANY PERSON UNLESS HE IS ACTING UNDER THE DIRECT SUPERVISION OF A LICENSED ARCHITECT TO ALTER AN ITEM IN ANY WAY." IF ANY ITEM BEARING THE SEAL OF AN ARCHITECT IS ALTERED, THE ALTERING ARCHITECT SHALL AFFIX HIS SEAL AND NOTATION "ALTERED BY" FOLLOWED BY HIS SIGNATURE AND DATE OF SUCH ALTERATION AND SPECIFIC DESCRIPTION OF THE ALTERATION.

**FIRE PROTECTION SYSTEMS:**  
SIZE AND LOCATION OF FIRE AREAS INDICATED ON CODE COMPLIANCE DRAWING(S)

| FIRE PROTECTION SYSTEM     | REQUIRED | PROVIDED | SECTION |
|----------------------------|----------|----------|---------|
| AUTOMATIC SPRINKLER        | -        | -        | 903     |
| ALTERNATIVE AUTO FIRE EXIT | -        | -        | 904     |
| STANDPIPE                  | -        | -        | 905     |
| PORTABLE FIRE EXTINGUISHER | NO       | YES      | 906     |
| FIRE ALARM & DETECTION     | -        | -        | 907     |
| EMERGENCY ALARM            | -        | -        | 908     |
| SMOKE CONTROL SYSTEM       | -        | -        | 909     |
| SMOKE & HEAT VENTS         | -        | -        | 910     |
| FIRE COMMAND CENTER        | -        | -        | 911     |

**MEANS OF EGRESS:**  
DESIGN OCCUPANT LOAD SUMMARY

| FLOOR LEVEL | DESIGN OCCUPANT LOAD |
|-------------|----------------------|
| FIRST       | 58                   |
| TOTAL       | 58                   |

NOTE: DESIGN OCCUPANT LOAD FOR MEANS OF EGRESS SIZING.

| MEANS OF EGRESS ELEMENT     | REQUIRED | PROVIDED | SECTION        |
|-----------------------------|----------|----------|----------------|
| NUMBER OF EXITS             | 2        | 6        | TABLE 1006.2.1 |
| EXIT ACCESS TRAVEL DISTANCE | 300      | 75       | TABLE 1017.2   |
| DEAD-END LIMIT              | 20       | -        | 1020.4         |
| COMMON PATH OF TRAVEL LIMIT | 75       | 75       | 1006.2.1       |

| EGRESS WIDTH            | REQUIRED | PROVIDED | SECTION  |
|-------------------------|----------|----------|----------|
| DOORS - FIRST FLOOR     | 2.8      | 36       | 1005.3.2 |
| STAIRS                  | NA       | NA       | 1005.3.1 |
| CORRIDORS - FIRST FLOOR | 44" MIN  | -        | 1020.2   |

**PLUMBING FIXTURE REQUIREMENTS:**

| OCCUPANCY CLASSIFICATION | OCCUPANT LOAD | WATER CLOSETS |          |          |          | URINALS  |          | D.F.     |          | LAVATORIES |          |          |          |
|--------------------------|---------------|---------------|----------|----------|----------|----------|----------|----------|----------|------------|----------|----------|----------|
|                          |               | REQUIRED      | PROVIDED | REQUIRED | PROVIDED | REQUIRED | PROVIDED | REQUIRED | PROVIDED | REQUIRED   | PROVIDED | REQUIRED | PROVIDED |
| U                        | 58            | 0             | 0        | 0        | 0        | 0        | 0        | 0        | 0        | 0          | 0        | 0        | 0        |

SEPARATE FACILITIES FOR EACH GENDER REQUIRED?  YES  NO 2902.2

SEPARATE EMPLOYEE FACILITIES REQUIRED?  YES  NO 2902.2


LOCATION OF EMPLOYEE FACILITIES COMPLIES?  YES  NO 2902.2

LOCATION OF PUBLIC FACILITIES COMPLIES?  YES  NO 2902.2

OTHER PLUMBING FIXTURE REQUIREMENTS?  Lavatories will be provided in new highway garage facility

**ENERGY CODE REQUIREMENTS**


- THE NEW STRUCTURE COMPLIES WITH THE 2020 NYS BUILDING CODE REQUIREMENTS, PRESCRIPTIVE METHOD
- CLIMATE ZONE (IECCNYS TABLE C301.1): 5A - SARATOGA COUNTY
- ROOF (IECCNYS C402.1.4): METAL BUILDING  
 • REQUIRED: U ≤ 0.035  
 • PROVIDED: U = 0.022  
 • NOTE: PRE-ENGINEERED BUILDING MANUFACTURER IS RESPONSIBLE FOR PROVIDING ENERGY CODE REQUIREMENTS IN WALL AND ROOF ASSEMBLY AS STIPULATED IN THE CONTRACT DOCUMENTS.
- WALLS, ABOVE GRADE (IECCNYS C402.1.4): METAL BUILDING  
 • REQUIRED: U ≤ 0.052  
 • PROVIDED: U = 0.039  
 • NOTE: PRE-ENGINEERED BUILDING MANUFACTURER IS RESPONSIBLE FOR PROVIDING ENERGY CODE REQUIREMENTS IN WALL AND ROOF ASSEMBLY AS STIPULATED IN THE CONTRACT DOCUMENTS.
- WALLS, BELOW GRADE (IECCNYS C402.1.3): CONCRETE  
 • REQUIRED: R ≥ 7.5 CI  
 • PROVIDED: R = 10 CI
- FLOORS (IECCNYS C402.1.3): UNHEATED SLAB-ON-GRADE  
 • REQUIRED: R ≥ 10  
 • PROVIDED: R = 10
- DOORS (IECCNYS C402.1.3): OPAQUE NON-SWINGING DOORS  
 • REQUIRED: R ≥ 4.75  
 • PROVIDED: R = NA
- DOORS (IECCNYS C402.1.4): SWINGING DOORS  
 • REQUIRED: U ≤ 0.37  
 • PROVIDED: U = NA
- FENESTRATION REQUIREMENTS (IECCNYS C402.4):  
 A. FIXED  
 • REQUIRED: U ≤ 0.38  
 • PROVIDED: U = NA  
 B. ENTRANCE DOOR  
 • REQUIRED: U ≤ 0.77  
 • PROVIDED: U = 0.43  
 C. OPERABLES  
 • REQUIRED: U ≤ 0.45  
 • PROVIDED: U = NA
- MAXIMUM FENESTRATION ALLOWABLE (IECCNYS C402.4.1):  
 • REQUIRED: 0.30  
 • PROVIDED: NA  
 • REQUIRED TOTAL: 2125 SF  
 • PROVIDED TOTAL: 0 SF
- MINIMUM SKYLIGHT FENESTRATION (IECCNYS C402.4.2):  
 • NOT APPLICABLE
- WRITTEN STATEMENT:  
 • TO THE BEST OF OUR KNOWLEDGE, BELIEF, AND PROFESSIONAL JUDGEMENT, THE DESIGN IS IN COMPLIANCE WITH THE ENERGY CODE. THIS STATEMENT IS BEING PROVIDED AS REQUIRED OF THE 2020 NYS ENERGY CODE SUPPLEMENT, SECTION C103.2.2.

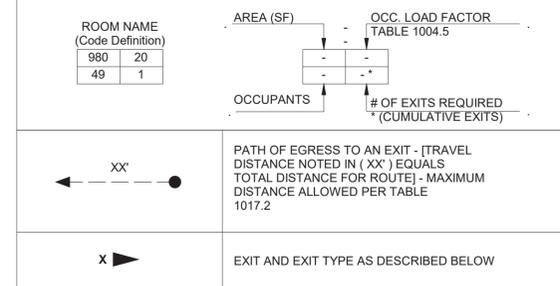

**EXIT REQUIREMENTS BY TYPE**

| EXIT | OCCUP. LOAD | REQUIRED WIDTH (INCHES)* | PROVIDED WIDTH (INCHES) | NOTES                              |
|------|-------------|--------------------------|-------------------------|------------------------------------|
| A    | 9           | 1.8                      | 36                      | MIN WIDTH PER 1010.1.1 = 32 INCHES |
| B    | 14          | 2.8                      | 36                      | MIN WIDTH PER 1010.1.1 = 32 INCHES |


\* REQUIRED WIDTH CALCULATED 1005.3.2: 0.2 INCHES PER OCCUPANT

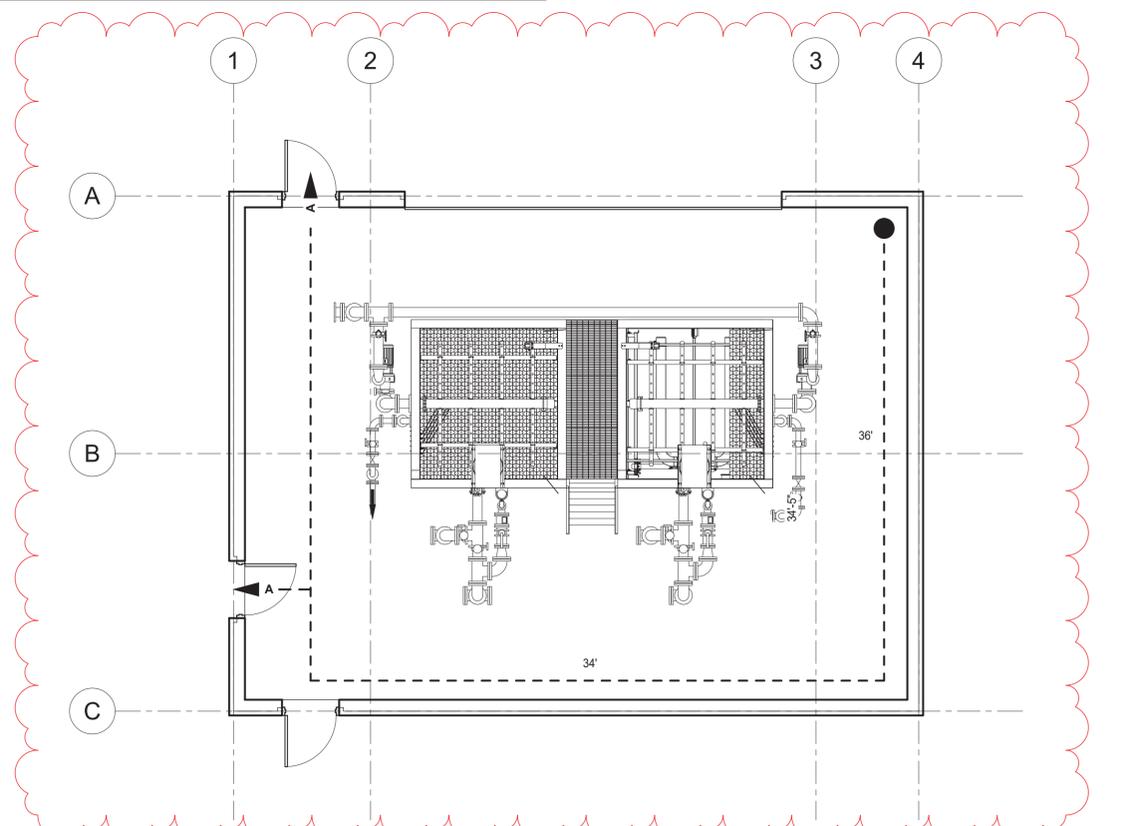

DATE: 11.2024  
 DRAWN BY: IB  
 SCALE: As Indicated  
 REVIEWED BY: AM  
 PROJECT NO.: 22-2496  
 FILE:

**DELAWARE ENGINEERING, P.C.**  
 CIVIL AND ENVIRONMENTAL ENGINEERING

28 MADISON AVENUE EXTENSION, ALBANY, NY 12203 - 518.462.1290  
 55 SOUTH MAIN ST., ONEONTA, NY 13820 - 507.432.8073  
 100 WEST 14TH ST., NEW YORK, NY 10011 - 212.697.4290  
 548 BROADWAY, MANTICHEL, NY 12751 - 845.791.7177  
 223 MAIN ST., GOSHEN, NY 10824 - 845.615.9232

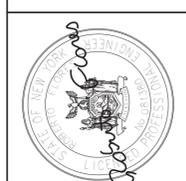

**REVISIONS**


| NO. | DATE       | DESCRIPTION |
|-----|------------|-------------|
| 1   | 11/01/2024 | ADDENDUM #1 |

**RHINEBECK WTP IMPROVEMENTS VILLAGE OF RHINEBECK DUTCHESS COUNTY, NY**

**CODE COMPLIANCE & LIFE SAFETY PLANS**

SHEET: **A001**

WARNING - IT IS A VIOLATION OF NEW YORK EDUCATION LAW SECTION 7209.2, FOR ANY PERSON, UNLESS HE IS ACTING UNDER THE DIRECTION OF A LICENSED PROFESSIONAL ENGINEER OR LAND SURVEYOR, TO ALTER THIS DOCUMENT IN ANY WAY. IF ALTERED THE ALTERING PERSON SHALL COMPLY WITH THE REQUIREMENTS OF NEW YORK EDUCATION LAW, SECTION 7209.2.

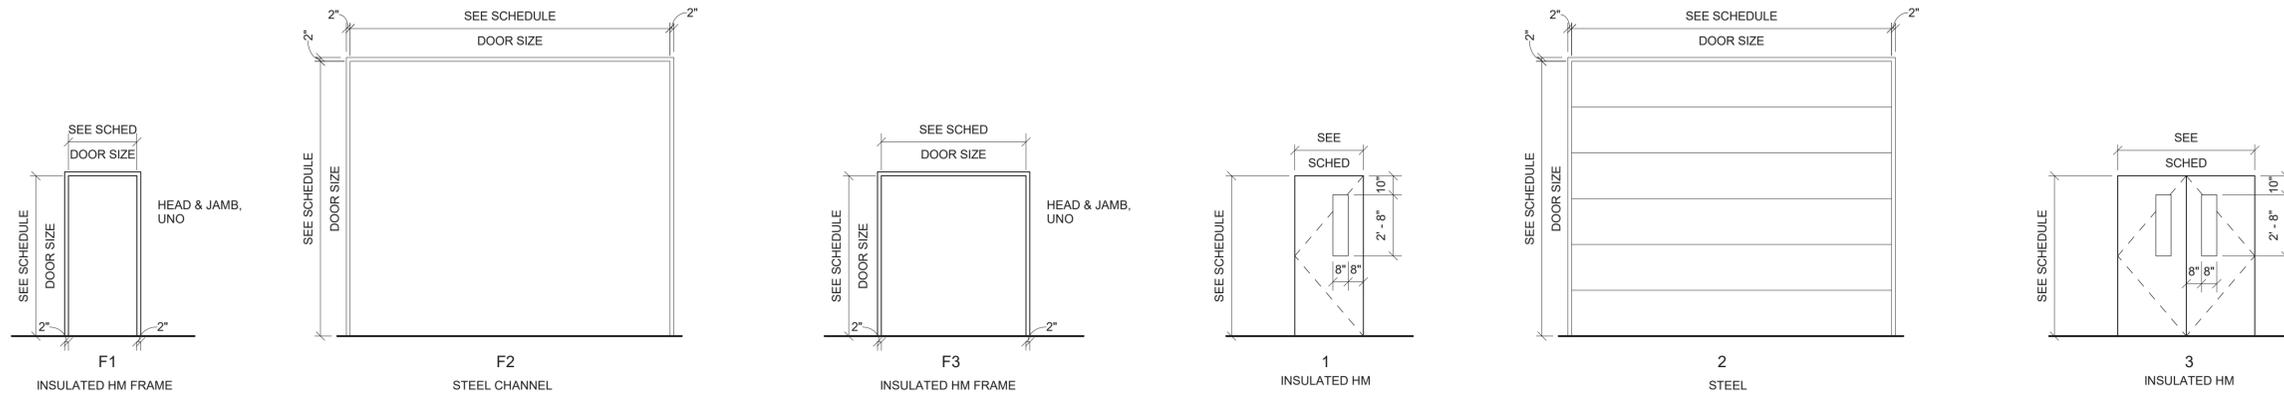

**DOOR FRAME TYPES**

**DOOR TYPES**

1 DOOR FRAME & TYPES  
A003 N.T.S

| Type Mark | DOOR SIZE    |             |          |          | DOOR      |      |                        |                       | FRAME |                     |              |                       | DOOR FIRE RATING | MANUFACTURER              | REMARKS  | HARDWARE GROUP |
|-----------|--------------|-------------|----------|----------|-----------|------|------------------------|-----------------------|-------|---------------------|--------------|-----------------------|------------------|---------------------------|--|----------------|
|           | ROUGH HEIGHT | ROUGH WIDTH | HEIGHT   | WIDTH    | THICKNESS | TYPE | MATERIAL               | FINISH                | TYPE  | DEPTH               | MATERIAL     | FINISH                |                  |                           |  |                |
| C-130     | 15' - 0"     | 22' - 0"    | 15' - 0" | 22' - 0" | 1 3/4"    | 1    | INSULATED HOLLOW METAL | PAINT, COLOR BY OWNER | F2    | 2" (W) x 5 3/4" (D) | HOLLOW METAL | PAINT, COLOR BY OWNER | N/A              | OVERHEAD DOOR CORPORATION | SECTIONAL OVERHEAD DOORS<br>422 SERIES INSULATED STEEL DOORS | D1             |
| C131      | 7' - 2"      | 3' - 4"     | 7' - 0"  | 3' - 0"  | 1 3/4"    | 1    | INSULATED HOLLOW METAL | PAINT, COLOR BY OWNER | F1    | 2" (W) x 5 3/4" (D) | HOLLOW METAL | PAINT, COLOR BY OWNER | N/A              | CECO ASSA-ABLOY           | LEGION FLUSH   | D1             |
**ABBREVIATIONS:**  
 HM HOLLOW METAL  
 PF PREFINISHED  
 PT SEMI-GLOSS PAINT  
 STL STEEL

**HARDWARE SCHEDULE:**  
 D1: 1. (3) 4-1/2" x 4-1/2" HINGES  
 2. (1) STORAGE LOCKSET  
 3. (1) CLOSER  
 4. WEATHERSTRIPPING  
 5. (1) SWEEP  
 6. (1) THRESHOLD  
 D2: 1. WEATHERSTRIPPING  
 D3: 1. (6) 4-1/2" x 4-1/2" HINGES  
 2. (1) STORAGE LOCKSET  
 3. (2) CLOSER  
 4. (2) SWEEP  
 D4: 1. (3) 4-1/2" x 4-1/2" HINGES  
 2. (1) PRIVACY LOCKSET  
 3. (1) CLOSER  
 4. (1) SWEEP  
 5. (1) WALL STOP  
 D5: 1. (3) 4-1/2" x 4-1/2" HINGES  
 2. (1) STORAGE LOCKSET  
 3. (1) CLOSER  
 4. (1) SWEEP

| Window Schedule |             |              |             |        |       |                  |             |         |              |               |
|-----------------|-------------|--------------|-------------|--------|-------|------------------|-------------|---------|--------------|---------------|
| Type Mark       | Head Height | Window Size  |             |        |       | Window Materials |             |         | Manufacturer | Egress Window |
|                 |             | Rough Height | Rough Width | Height | Width | Frame Finish     | Trim Finish | Glazing |              |               |

DATE: 11.2024  
 DRAWN BY: IB  
 SCALE: As indicated  
 REVIEWED BY: AM  
 PROJECT NO.: 22-2496  
 FILE:

**DELAWARE ENGINEERING, D.P.C.**  
 CIVIL AND ENVIRONMENTAL ENGINEERING  
 28 MADISON AVENUE EXTENSION, ALBANY, NY 12203 - 518.452.1290  
 55 SOUTH MAIN ST. CONENITA, NY 13520 - 507.432.8073  
 140 WEST 14TH ST. NEW YORK, NY 10011 - 212.454.7290  
 548 BROADWAY, MONTICELLO, NY 12761 - 845.791.7777  
 223 MAIN ST. GOSHEN, NY 10824 - 845.615.9232



| NO. | DATE       | DESCRIPTION |
|-----|------------|-------------|
| 1   | 11/01/2024 | ADDENDUM #1 |

RHINEBECK WTP  
 IMPROVEMENTS  
 VILLAGE OF RHINEBECK  
 DUTCHESS COUNTY, NY


DOOR & WINDOW  
 OPENING SCHEDULE &  
 DETAILS

SHEET:  
**A003**


WARNING - IT IS A VIOLATION OF NEW YORK EDUCATION LAW SECTION 7209.2, FOR ANY PERSON, UNLESS HE IS ACTING UNDER THE DIRECTION OF A LICENSED PROFESSIONAL ENGINEER OR LAND SURVEYOR, TO ALTER THIS DOCUMENT IN ANY WAY. IF ALTERED THE ALTERING PERSON SHALL COMPLY WITH THE REQUIREMENTS OF NEW YORK EDUCATION LAW, SECTION 7209.2.

**NOTES:**

- EPOXY COAT ALL FLOORS AS INDICATED ON PLAN
- REPAIR LEAKS BY EXISTING ELECTRIC
- REPLACE EXISTING DOORS CALLED OUT ON PLAN

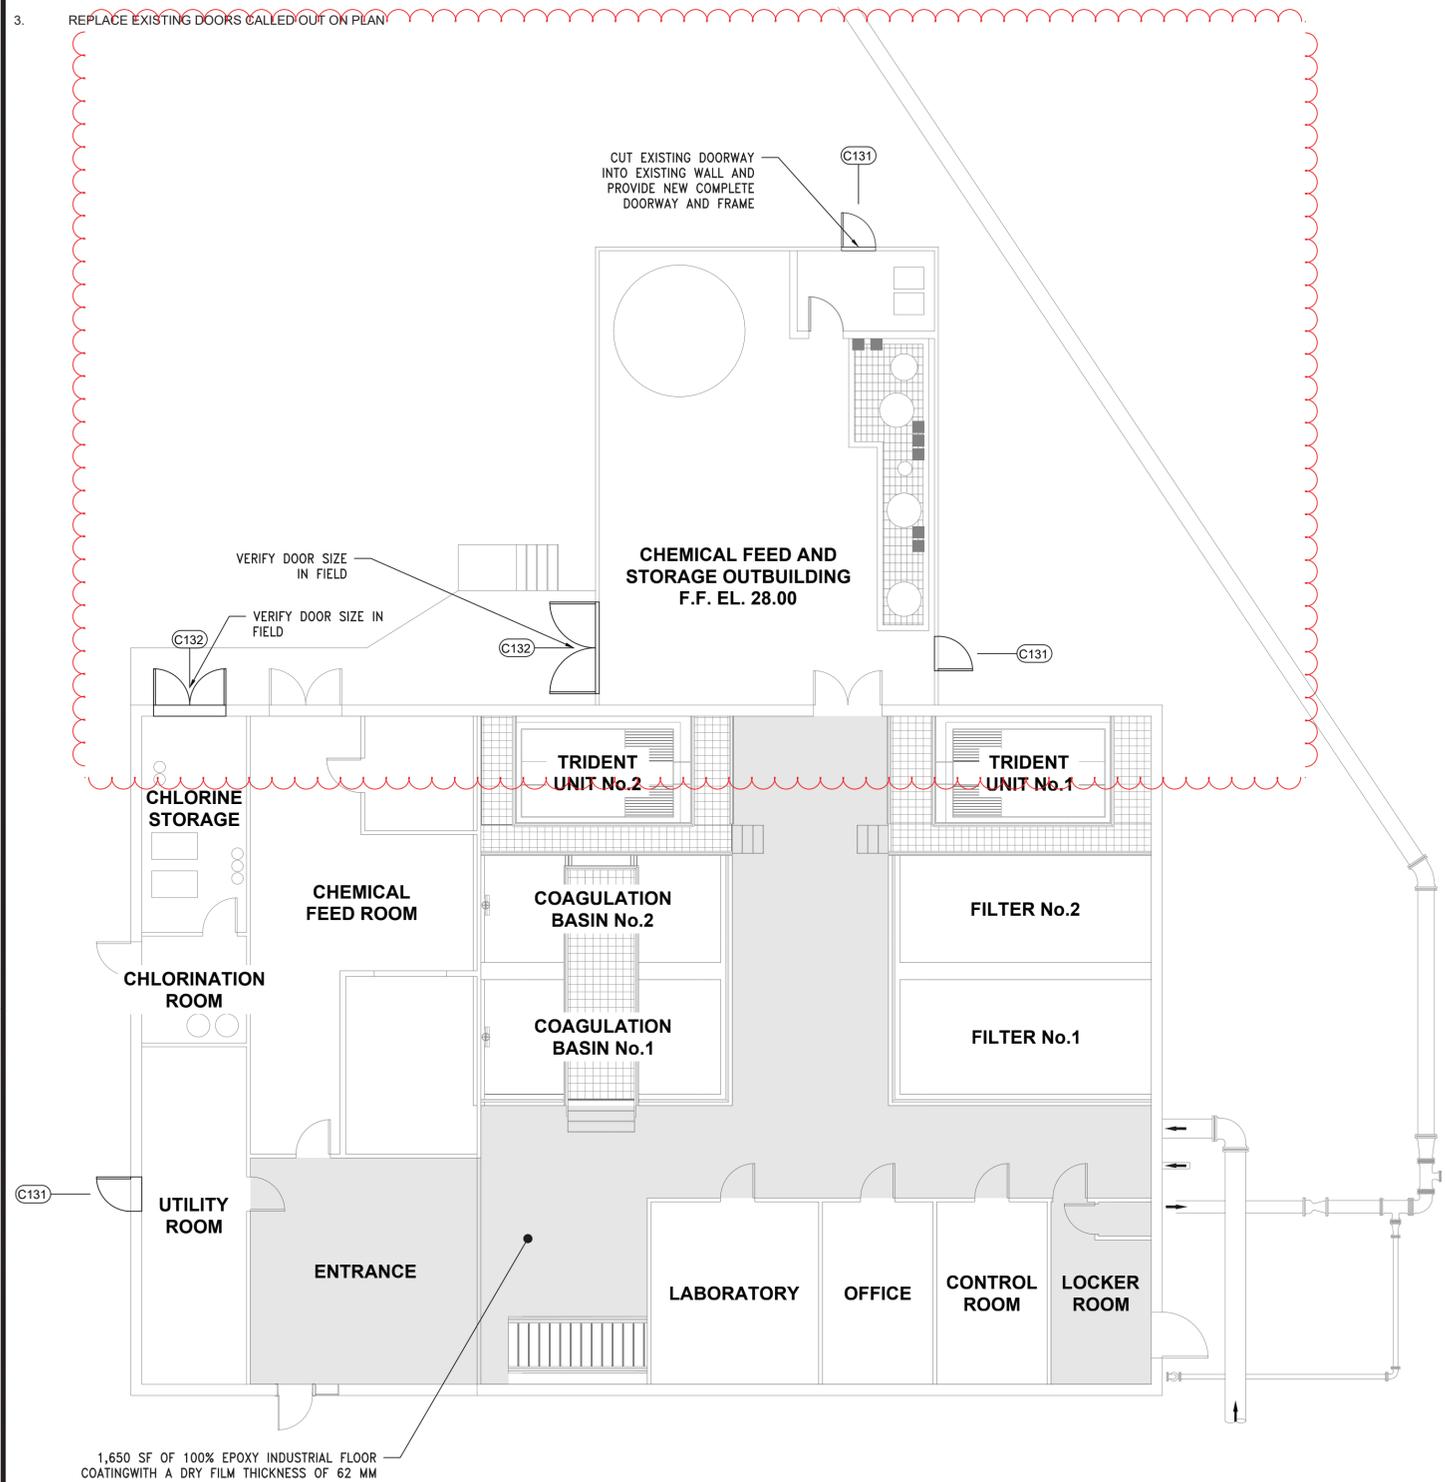

**OPERATING ARCHITECTURAL FLOOR PLAN**  
SCALE: 1/8"=1'-0"

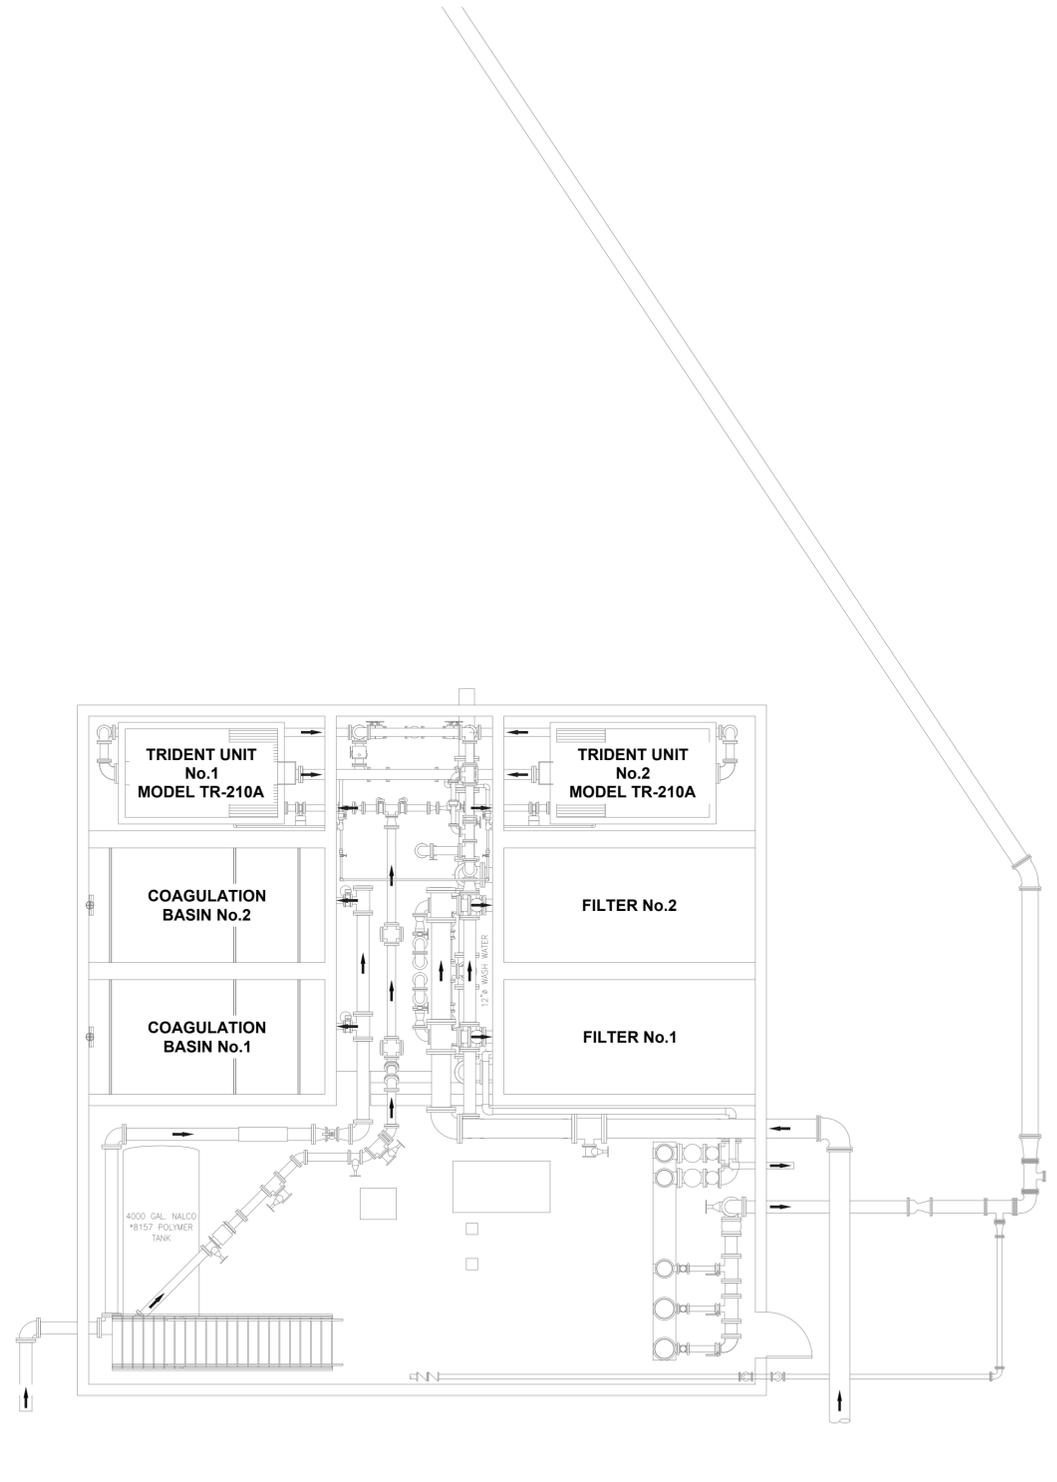

**LOWER ARCHITECTURAL FLOOR**  
SCALE: 1/8"=1'-0"

File: H:\DRAWINGS\RHINEBECK\032-2496\WPA\A-100 - EXISTING BUILDING.DWG, Saved: 11/7/2024, 9:07:19 AM, Plotted: 11/7/2024, 9:32:26 AM, User: Iris Boiles LastSavedBy: brolieb

DATE: 11/1/2024  
DRAWN BY:  
SCALE:  
REVIEWED BY: RF  
PROJECT NO.:  
FILE:

**DELAWARE ENGINEERING, D.P.C.**  
CIVIL AND ENVIRONMENTAL ENGINEERING

28 MADISON AVENUE EXTENSION, ALBANY, NY 12203 - 518.452.1290  
55 SOUTH MAIN STREET, ALBANY, NY 12204 - 518.452.1290  
6 TOWNSEND STREET, WALTON, NY 13856 - 607.885.9235  
16 EAST MARKET ST., RED HOOK, NY 12571 - 518.452.1290  
548 BROADWAY, MONTICELLO, NY 12701 - 845.791.7777



| NO. | DATE     | DESCRIPTION           |
|-----|----------|-----------------------|
| 1.  | 06/21/24 | MAY 2024 DOH COMMENTS |
| 2.  | 11/01/24 | ADDENDUM #1           |

RHINEBECK WTP  
PLANT IMPROVEMENTS  
VILLAGE OF RHINEBECK  
DUTCHESS COUNTY, NEW YORK

WTP REHAB FLOOR PLAN

SHEET:  
**A-100**


WARNING - IT IS A VIOLATION OF NEW YORK EDUCATION LAW SECTION 2209.2, FOR ANY PERSON, UNLESS HE IS ACTING UNDER THE DIRECTION OF A LICENSED PROFESSIONAL ENGINEER OR LAND SURVEYOR, TO ALTER THIS DOCUMENT IN ANY WAY. IF ALTERED THE ALTERING PERSON SHALL COMPLY WITH THE REQUIREMENTS OF NEW YORK EDUCATION LAW, SECTION 2209.2.

**ARCHITECTURAL LEGEND**

-  INDICATES KEYED NOTE.
-  INDICATES NEW WALL, REF WALL SCHEDULE.
-  INDICATES NEW WINDOW, REF WINDOW SCHEDULE ON 'A' DWGS
-  INDICATES NEW DOOR, REF DOOR SCHEDULE ON 'A' DWGS
-  INDICATES NEW GRIDLINE

**PLAN NOTES**

1. ALL ELEVATIONS ARE REFERENCED FROM 0'-0" = LEVEL 1 FINISH FLOOR.
2. GRIDLINES ARE LOCATED AT EXTERIOR FACE OF PEMB STEEL LINES.
3. DETAILS ON THESE PLANS ARE INTENDED TO DEPICT THE GENERAL CONSTRUCTION METHODS FOR THIS STRUCTURE. CONNECTIONS, DETAILS AND CONDITIONS NOT SPECIFICALLY SHOWN THAT ARE SIMILAR TO THOSE THAT ARE SPECIFIED SHALL BE ASSUMED ONE AND THE SAME. IF QUESTIONS REGARDING THE APPLICATION OF DETAILS ARE ENCOUNTERED, NOTIFY THE ARCHITECT / ENGINEER FOR CLARIFICATION IN A TIMELY MANNER PRIOR TO BID OPENING.
4. DIMENSIONS AT DOORS ARE ROUGH OPENING OF STRUCTURAL FRAME.
5. REFER TO SPECIFICATION 074116, 074213.19, AND 133419 FOR REQUIRED WARRANTIES.
6. CONTRACTOR TO PROVIDE PROOF OF MANUFACTURER'S INSTALLATION CERTIFICATION AND TRAINING.
7. CONTRACTOR TO PROVIDE DOCUMENTATION OF THE NECESSARY MANUFACTURER'S INSTALLATION, CERTIFICATION AND TRAINING CAN BE OBTAINED PRIOR TO INSTALLATION OF THE PEMB STRUCTURE.

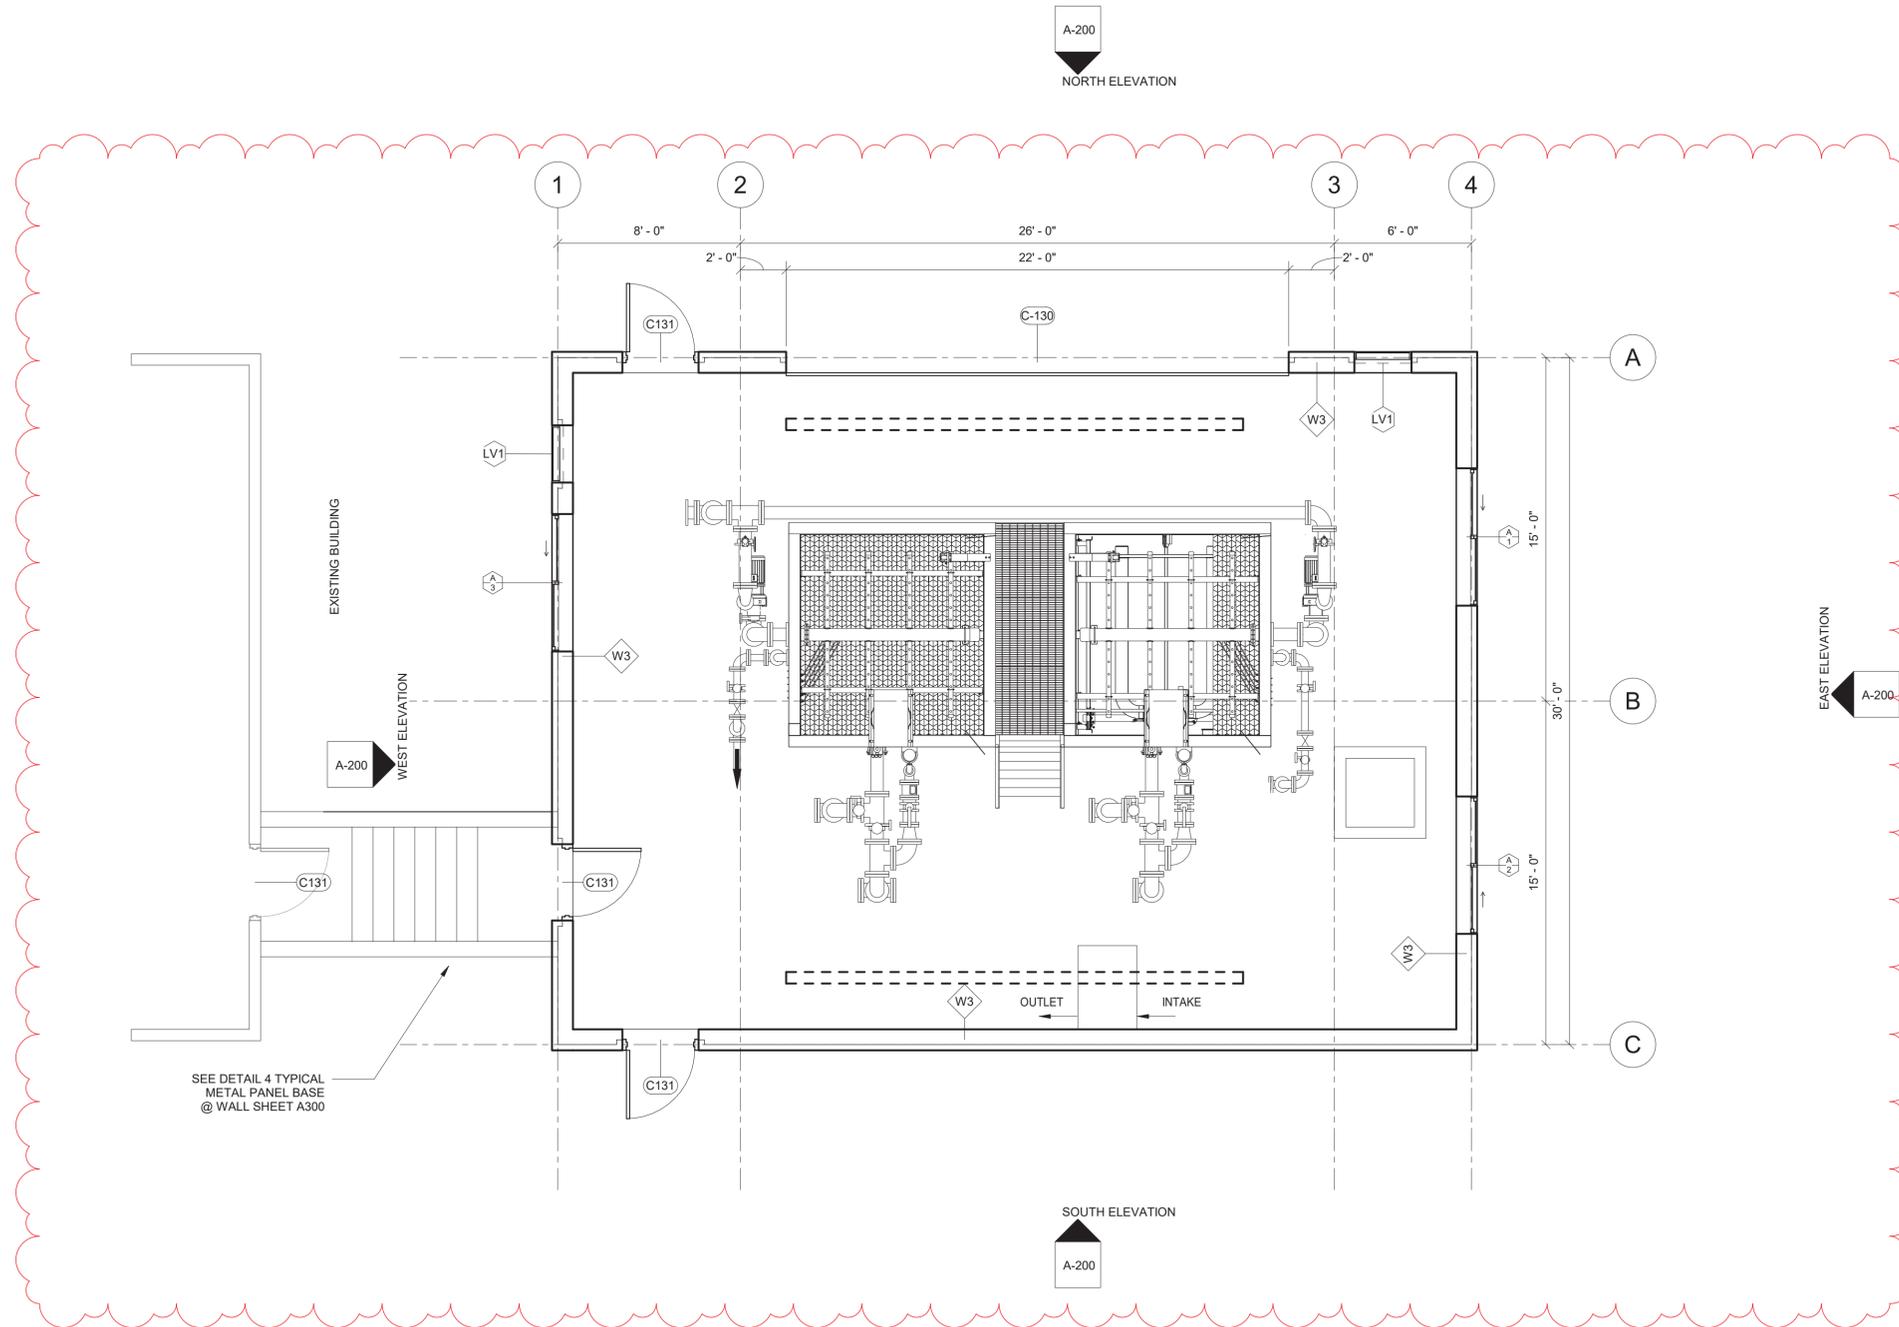

DATE: 11.2024  
 DRAWN BY: IB  
 SCALE: As indicated  
 REVIEWED BY: AM  
 PROJECT NO.: 22-2496  
 FILE:

**DELAWARE ENGINEERING, D.P.C.**  
 CIVIL AND ENVIRONMENTAL ENGINEERING  
 28 MADISON AVENUE EXTENSION, ALBANY, NY 12203 - 518.462.1290  
 55 SOUTH MAIN ST., CONENONTA, NY 13520 - 507.432.8073  
 100 WEST 14TH ST., NEW YORK, NY 10011 - 212.457.4290  
 548 BROADWAY, MANTICHELLO, NY 12170 - 518.545.7917  
 223 MAIN ST., GOSHEN, NY 10824 - 845.615.9232




| NO. | DATE       | DESCRIPTION |
|-----|------------|-------------|
| 1   | 11/01/2024 | ADDENDUM #1 |

**RHINEBECK WTP  
 IMPROVEMENTS  
 VILLAGE OF RHINEBECK  
 DUTCHESS COUNTY, NY**

**FIRST FLOOR PLAN**

SHEET:  
**A101**


LEGEND

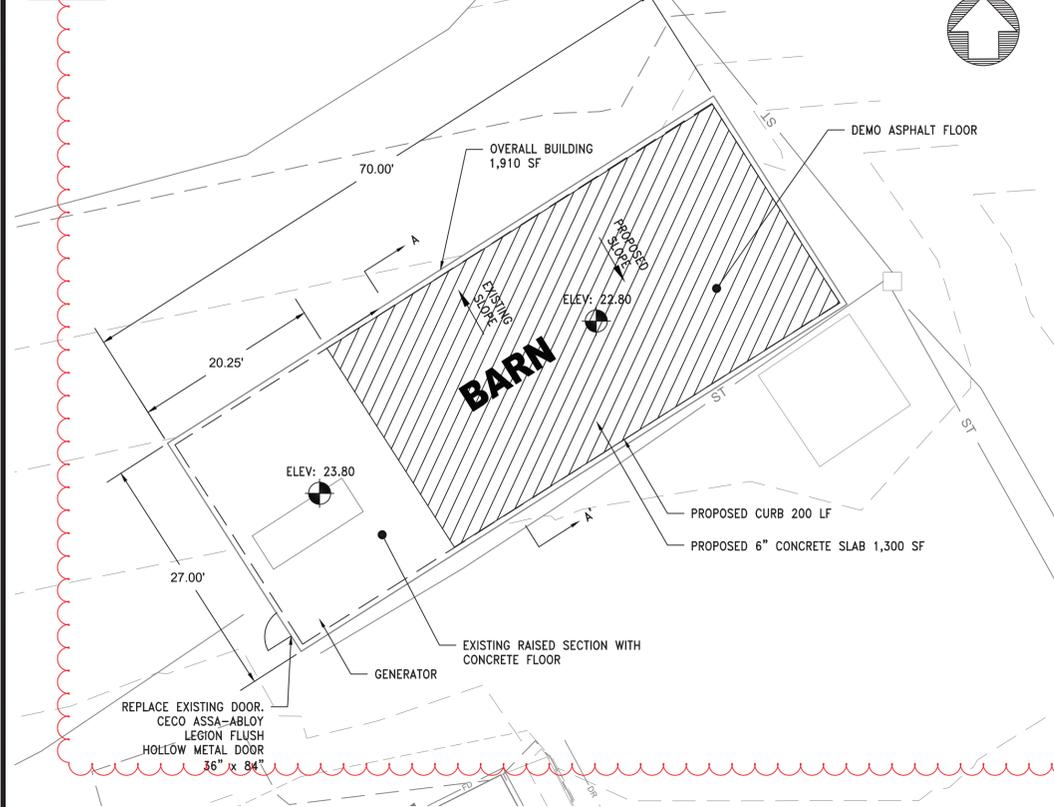


SITE PLAN  
SCALE: 1" = 10'

NOTES:


1. CONCRETE CURB TO BE CAST AROUND EXISTING WOODEN POSTS/ COLUMNS.
2. REPLACE ALL EXISTING FASCIA BOARDS, SOFFITS, DRIP EDGES, & VENTS.
3. REPLACE EXISTING ROLL-UP OVERHEAD DOORS IN KIND.
4. CLOSE ALL OPENINGS IN ALL WALLS TO ENSURE THE BUILDINGS PROTECTED FROM THE ELEMENTS.
5. THERE IS NO EXISTING OR PROPOSED INSULATION.
6. REPLACE ALL THREE OVERHEAD LIFTING SECTIONAL ROLL-UP DOORS, OPENING DIMENSIONS 8'H X 10'W.
7. PROVIDE ONE TRUSS MOUNTED LED LIGHT AND ONE WALL POST MOUNTED RECEPTACLE 15' O.C. ALONG THE LENGTH OF THE BUILDING.

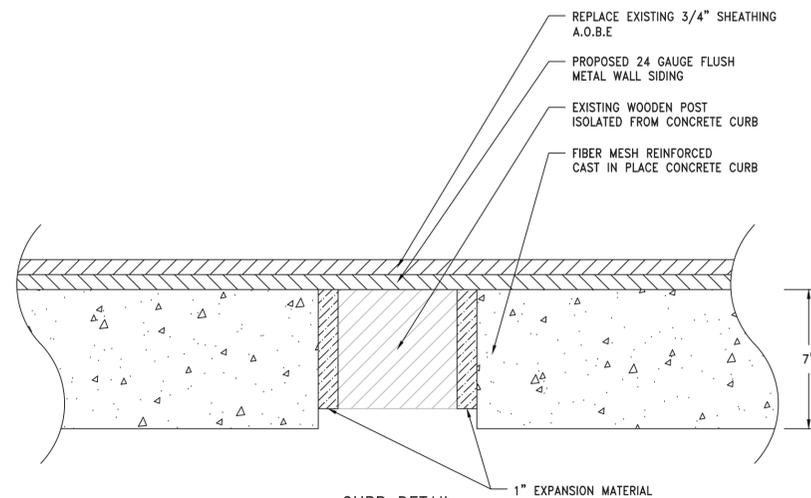

CURB DETAIL  
PLAN VIEW

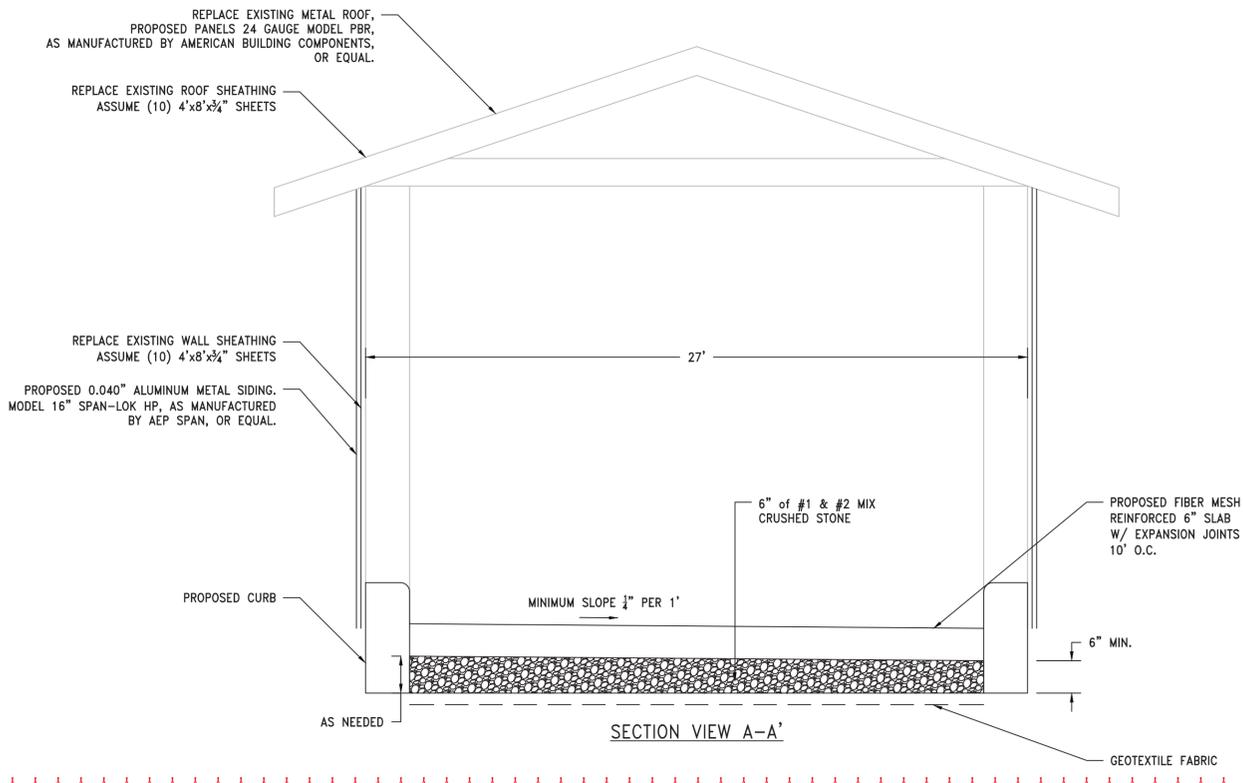

SECTION VIEW A-A'

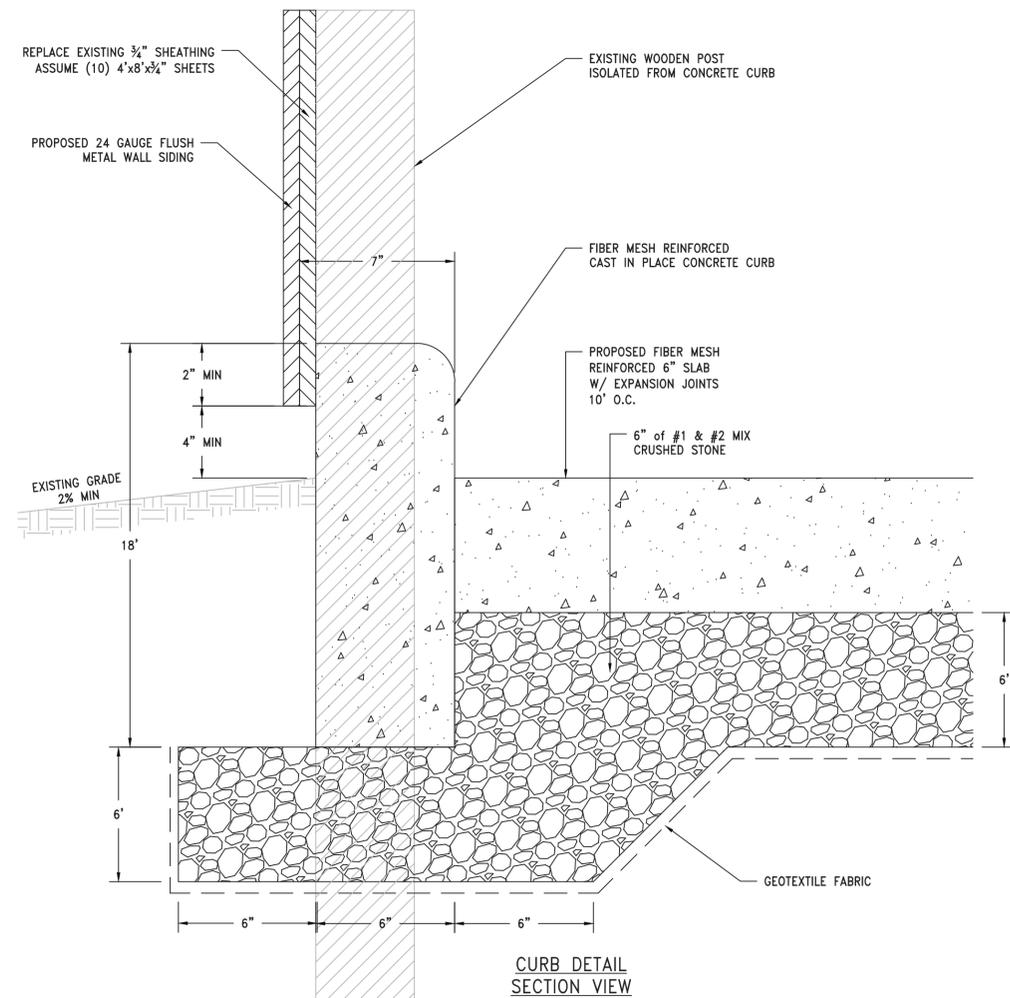

CURB DETAIL  
SECTION VIEW

DATE: 11/1/2024  
 DRAWN BY:  
 SCALE:  
 REVIEWED BY: RF  
 PROJECT NO.:  
 FILE:

**DELAWARE ENGINEERING, D.P.C.**  
 CIVIL AND ENVIRONMENTAL ENGINEERING



28 MADISON AVENUE EXTENSION, ALBANY, NY 12203 - 518.452.1290  
 55 SOUTH MAIN ST. ONEONTA, NY 13820 - 607.432.8073  
 1000 W. STATE ST. MALDEN, NY 13862  
 6 TOWNSEND STREET, MALDEN, NY 13861 - 607.868.9232  
 16 EAST MARKET ST., RED HOOK, NY 12571 - 518.452.1290  
 548 BROADWAY, MONTICELLO, NY 12071 - 845.791.7777



| NO. | DATE     | DESCRIPTION |
|-----|----------|-------------|
| 1.  | 11/01/24 | ADDENDUM #1 |

RHINEBECK WTP  
 PLANT IMPROVEMENTS  
 VILLAGE OF RHINEBECK  
 DUTCHESS COUNTY, NEW YORK

PROPOSED UPGRADES TO  
 EXISTING BARN


SHEET:  
**A-102**

WARNING - IT IS A VIOLATION OF NEW YORK EDUCATION LAW SECTION 7209.2, FOR ANY PERSON, UNLESS HE IS ACTING UNDER THE DIRECTION OF A LICENSED PROFESSIONAL ENGINEER OR LAND SURVEYOR, TO ALTER THIS DOCUMENT IN ANY WAY. IF ALTERED THE ALTERING PERSON SHALL COMPLY WITH THE REQUIREMENTS OF NEW YORK EDUCATION LAW, SECTION 7209.2.


File: H:\DRAWINGS\RHINEBECK (V)\22-2496 WPA-A-102 - BARN UPGRADES.DWG Saved: 11/1/2024 9:59:39 AM Plotted: 11/1/2024 9:59:49 AM User: IRL Broome LantSawaby, brookel

**ELEVATION NOTES**


- ALL ELEVATIONS ARE REFERENCED FROM 0'-0" = LEVEL 1 FINISH FLOOR.
- GRIDLINES ARE LOCATED AT EXTERIOR FACE OF PEMB STEEL LINES.
- DETAILS ON THESE PLANS ARE INTENDED TO DEPICT THE GENERAL CONSTRUCTION METHODS FOR THIS STRUCTURE. CONNECTIONS, DETAILS AND CONDITIONS NOT SPECIFICALLY SHOWN THAT ARE SIMILAR TO THOSE THAT ARE SPECIFIED SHALL BE ASSUMED ONE AND THE SAME. IF QUESTIONS REGARDING THE APPLICATION OF DETAILS ARE ENCOUNTERED, NOTIFY THE ARCHITECT / ENGINEER FOR CLARIFICATION IN A TIMELY MANNER PRIOR TO BID OPENING.
- ALIGN JOINTS OF 42" ROOF PANELS WITH JOINTS OF 42" WALL PANELS.
- DOOR, WINDOW, & STOREFRONT MANUFACTURER RESPONSIBLE FOR DESIGN OF ALL CONNECTIONS TO JAMBS, SILLS, & HEADERS.
- DIMENSIONS SHOWN ON ELEVATIONS ARE ROUGH OPENING OF STRUCTURAL FRAME.
- REFER TO SPECIFICATION 074116, 074213.19, AND 133419 FOR REQUIRED WARRANTIES.
- CONTRACTOR TO PROVIDE PROOF OF MANUFACTURER'S INSTALLATION CERTIFICATION AND TRAINING.
- CONTRACTOR TO PROVIDE DOCUMENTATION OF THE NECESSARY MANUFACTURER'S INSTALLATION, CERTIFICATION AND TRAINING CAN BE OBTAINED PRIOR TO INSTALLATION OF THE PEMB STRUCTURE.
- ROOF PANELS SHALL BE 36" WIDE, 6" THICK, 24 GAUGE METAL SPAN INSULATED PANELS, LS-36, OR EQUAL.
- WALL PANELS SHALL BE 36" WIDE, 3" THICK, 24-GAUGE METAL SPAN INSULATED PANELS, LS-36 OR EQUAL.

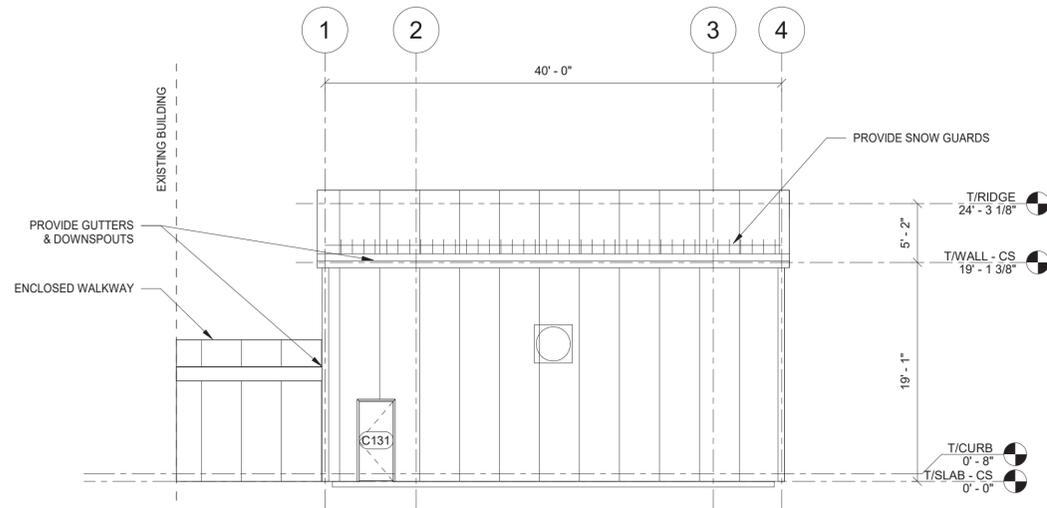


4 SOUTH ELEVATION  
A-200 1/8" = 1'-0"

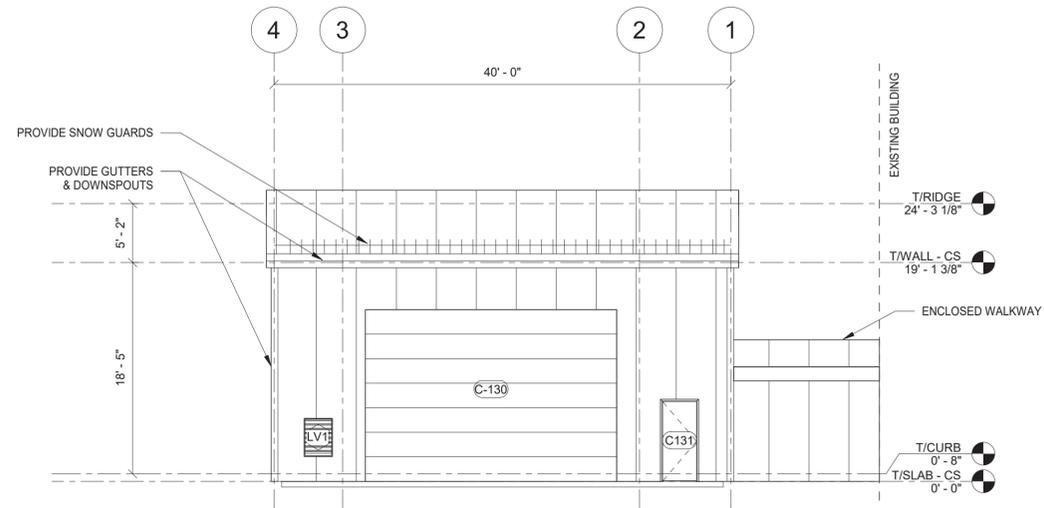

3 NORTH ELEVATION  
A-200 1/8" = 1'-0"

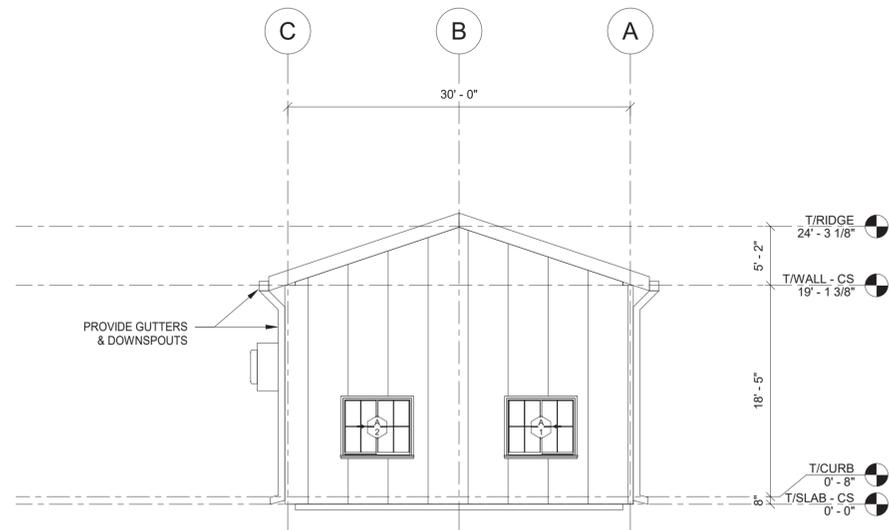


2 EAST ELEVATION  
A-200 1/8" = 1'-0"

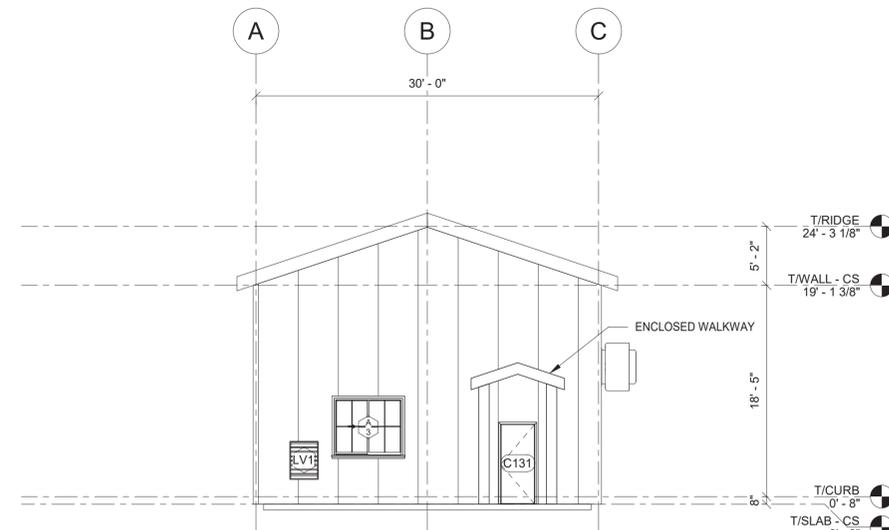

1 WEST ELEVATION  
A-200 1/8" = 1'-0"

DATE: 11.2024  
DRAWN BY: IB  
SCALE: As Indicated  
REVIEWED BY: AM  
PROJECT NO.: 22-2496  
FILE:

**DELAWARE ENGINEERING, P.C.**  
CIVIL AND ENVIRONMENTAL ENGINEERING  
28 MADISON AVENUE EXTENSION, ALBANY, NY 12203 - 518.462.1290  
55 SOUTH MAIN ST., CONENOTA, NY 13520 - 507.432.8073  
100 WEST 14TH ST., NEW YORK, NY 10011 - 212.697.4790  
548 BROADWAY, MANHATTAN, NY 10012 - 212.697.4790  
223 MAIN ST., GOSHEN, NY 10824 - 845.615.9232

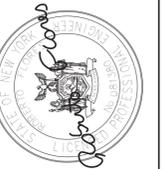

| NO. | DATE       | DESCRIPTION |
|-----|------------|-------------|
| 1   | 11/01/2024 | ADDENDUM #1 |

**RHINEBECK WTP  
IMPROVEMENTS  
VILLAGE OF RHINEBECK  
DUTCHESS COUNTY, NY**

**ELEVATIONS**

SHEET:  
**A-200**

**ABBREVIATIONS:**

|         |  |
|---------|--|
| #       | INCH                                       |
| #       | NUMBER, POUND                              |
| *       | AND  |
| '       | FEET                                       |
| (E)     | EXISTING                                   |
| (N)     | NEW  |
| @       | AT   |
| A=      | AXIAL FORCE                                |
| AB      | ANCHOR BOLT                                |
| ABV     | ABOVE                                      |
| ACI     | AMERICAN CONCRETE INSTITUTE                |
| ADD     | ADDENDUM, ADDITION                         |
| ADJ     | ADJUST, ADJUSTABLE                         |
| AESS    | ARCHITECTURALLY EXPOSED STRUCTURAL STEEL   |
| AFF     | ABOVE FINISHED FLOOR                       |
| ALT     | ALTERNATE                                  |
| ALUM    | ALUMINUM                                   |
| APPROX  | APPROXIMATE                                |
| ARCH    | ARCHITECTURAL                              |
| ASTM    | AMERICAN SOCIETY FOR TESTING AND MATERIALS |
| AVG     | AVERAGE                                    |
| AWS     | AMERICAN WELDING SOCIETY                   |
| B/      | BOTTOM OF                                  |
| BW      | BETWEEN                                    |
| BALC    | BALCONY                                    |
| BD      | BOARD                                      |
| BEV     | BEVEL                                      |
| BKR     | BACKER                                     |
| BLDG    | BUILDING                                   |
| BLK     | BLOCK                                      |
| BLKG    | BLOCKING                                   |
| BM      | BEAM                                       |
| BOC     | BOTTOM OF CURB                             |
| BOT/BTM | BOTTOM                                     |
| BOW     | BOTTOM OF WALL                             |
| BP      | BASEPLATE                                  |
| BRDG    | BRIDGE, BRIDGING                           |
| BRG     | BEARING                                    |
| BRK     | BRICK                                      |
| BSMT    | BASEMENT                                   |
| BU      | BUILT-UP                                   |
| C       | CHANNEL                                    |
| C=      | COMPRESSION FORCE                          |
| CEM     | CEMENT, CEMENTITIOUS                       |
| CGS     | CENTER OF GRAVITY OF STRAND                |
| CIP     | CAST IN PLACE                              |
| CJ      | CONTROL JOINT                              |
| CJP     | COMPLETE JOINT PENETRATION                 |
| CL      | CENTER LINE                                |
| CLG     | CEILING                                    |
| CLR     | CLEAR                                      |
| CMU     | CONCRETE MASONRY UNIT                      |
| COL     | COLUMN                                     |
| COMP    | COMPOSITE, COMPENSATION                    |
| CONC    | CONCRETE                                   |
| COND    | CONDITION                                  |
| CONN    | CONNECTION                                 |
| CONSTR  | CONSTRUCTION                               |
| CONT    | CONTINUOUS                                 |
| COORD   | COORDINATE                                 |
| CORR    | CORRIDOR                                   |
| CTR     | CENTER                                     |
| CTRL    | CONTROL                                    |
| CTSK    | COUNTERSINK                                |
| CJ      | CUBIC                                      |
| CUST    | CUSTOM                                     |
| CY      | CUBIC YARD                                 |
| DBA     | DEFORMED BAR ANCHOR                        |
| DBL     | DOUBLE                                     |
| DEFL    | DEFLECTION                                 |
| DEG     | DEGREE                                     |
| DEMO    | DEMOLITION                                 |
| DEPT    | DEPARTMENT                                 |
| DET     | DETAIL                                     |
| DIA - Ø | DIAMETER                                   |
| DIAG    | DIAGONAL                                   |
| DIM     | DIMENSION                                  |
| DKG     | DECKING                                    |
| DL      | DEAD LOAD                                  |
| DWG     | DRAWING                                    |
| DWGS    | DRAWINGS                                   |
| DWL     | DOWEL                                      |
| EA      | EACH                                       |
| EF      | EACH FACE                                  |
| EIFS    | EXTERIOR INSULATED FINISH SYSTEM           |
| EJ      | EXPANSION JOINT                            |
| EL      | ELEVATION                                  |
| ELEC    | ELECTRICAL                                 |
| ELEV    | ELEVATOR                                   |
| ENGR    | ENGINEER                                   |
| EOD     | EDGE OF DECK                               |
| EOP     | EDGE OF PLATE                              |
| EOR     | ENGINEER OF RECORD                         |
| EOS     | EDGE OF SLAB                               |
| EQ      | EQUAL                                      |
| EQPT    | EQUIP                                      |
| ES      | EACH SIDE                                  |
| EW      | EACH WAY                                   |
| EXIST   | EXISTING                                   |
| EXP     | EXPANSION                                  |
| EXT     | EXTERIOR                                   |

|        |  |
|--------|--|
| F TO F | FACE TO FACE                             |
| Fc     | CONCRETE COMPRESSIVE STRENGTH            |
| FAB    | FABRICATIONS/FABRICATED                  |
| FB     | FLAT BAR                                 |
| FD     | FLOOR DRAIN                              |
| FF     | FINISH FLOOR                             |
| FFE    | FINISH FLOOR ELEVATION                   |
| FIN    | FINISH                                   |
| FLR    | FLOOR                                    |
| FNDN   | FOUNDATION                               |
| FOC    | FACE OF CONCRETE                         |
| FOF    | FACE OF FINISH                           |
| FOM    | FACE OF MASONRY                          |
| FOS    | FACE OF STUD                             |
| FR     | FIRE RATED, FIRE RESISTIVE               |
| FRM    | FRAMED, FRAMING                          |
| FRT    | FIRE RETARDANT TREATED                   |
| FT     | FOOT, FEET                               |
| FTG    | FOOTING                                  |
| FUT    | FUTURE                                   |
| Fy     | YIELD STRESS                             |
| GA     | GAUGE                                    |
| GALV   | GALVANIZED                               |
| GB     | GRADE BEAM                               |
| GC     | GENERAL CONTRACTOR                       |
| GEN    | GENERAL                                  |
| GL     | GLU-LAMINATED                            |
| GLB    | GLU-LAMINATED BEAM                       |
| GND    | GROUND                                   |
| GR     | GRADE                                    |
| GYP    | GYPSPUM                                  |
| GYP BD | GYPSPUM BOARD                            |
| HAS    | HEADED ANCHOR STUD                       |
| HC     | HOLLOW CORE                              |
| HCP    | HOLLOW CORE PLANK                        |
| HDR    | HEADER                                   |
| HEX    | HEXAGONAL                                |
| HI     | HIGH                                     |
| HM     | HOLLOW METAL                             |
| HORIZ  | HORIZONTAL                               |
| HSS    | HOLLOW STRUCTURAL SECTION                |
| HT     | HEIGHT                                   |
| HVAC   | HEATING - VENTILATION - AIR CONDITIONING |
| IBC    | INTERNATIONAL BUILDING CODE              |
| ICF    | INSULATED CONCRETE FORMS                 |
| ID     | INSIDE DIAMETER                          |
| IJ     | ISOLATION JOINT                          |
| IN     | INCH, INCHES                             |
| INFO   | INFORMATION                              |
| INSP   | INSPECTION                               |
| INSUL  | INSULATION                               |
| INT    | INTERIOR                                 |
| INV    | INVERT                                   |
| JT     | JOINT, JOINTS                            |
| k      | KILOPOUND (1000 POUNDS)                  |
| K-FT   | KIP-FOOT (1000 POUND - FEET)             |
| KIP    | KILOPOUND (1000 POUNDS)                  |
| L      | ANGLE, LEFT, LENGTH                      |
| LAM    | LAMINATE, LAMINATED                      |
| LAT    | LATERAL                                  |
| LB     | POUND                                    |
| LF     | LINEAL FEET, LINEAR FOOTAGE              |
| LG     | LONG                                     |
| LIN    | LINEAR                                   |
| LIN FT | LINEAL FEET, LINEAR FOOTAGE              |
| LL     | LIVE LOAD                                |
| LLH    | LONG LEG HORIZONTAL                      |
| LLV    | LONG LEG VERTICAL                        |
| LNTL   | LINTEL                                   |
| LONG   | LONGITUDINAL                             |
| LS     | LONG SLOTTED                             |
| LSH    | LONG SIDE HORIZONTAL                     |
| LSL    | LAMINATED STRAND LUMBER                  |
| LSV    | LONG SIDE VERTICAL                       |
| LT WT  | LIGHT WEIGHT                             |
| LVL    | LAMINATED VENEER LUMBER                  |
| MAX    | MAXIMUM                                  |
| MB     | MACHINE BOLT                             |
| MC     | MISCELLANEOUS CHANNEL                    |
| MCJ    | MASONRY CONTROL JOINT                    |
| MECH   | MECHANICAL                               |
| MEMB   | MEMBRANE                                 |
| MEP    | MECHANICAL, ELECTRICAL, PLUMBING         |
| MEZZ   | MEZZANINE                                |
| MFR    | MANUFACTURER                             |
| MIN    | MINIMUM                                  |
| MISC   | MISCELLANEOUS                            |
| MO     | MASONRY OPENING                          |
| MTL    | METAL                                    |
| MTL    | METAL                                    |
| MUL    | MULLION                                  |
| N      | NORTH                                    |
| NIC    | NOT IN CONTRACT                          |
| NO     | NUMBER                                   |
| NOM    | NOMINAL                                  |
| NTS    | NOT TO SCALE                             |
| NW     | NORMAL WEIGHT                            |

|        |   |
|--------|---|
| OC     | ON CENTER                                   |
| OD     | OUTSIDE DIAMETER                            |
| OPNG   | OPENING                                     |
| OPP    | OPPOSITE                                    |
| OSB    | ORIENTED STRAND BOARD                       |
| OWSJ   | OPEN WEB STEEL JOIST                        |
| P/L    | PROPERTY LINE                               |
| PAF    | POWDER ACTUATED FASTENER                    |
| PC     | PRECAST                                     |
| PCF    | POUNDS PER CUBIC FOOT                       |
| Pd     | DRIFTED SNOW LOAD                           |
| PE     | PROFESSIONAL ENGINEER                       |
| PEMB   | PRE ENGINEERED METAL BUILDING               |
| PERF   | PERFORATE, PERFORATED, PERFORMANCE          |
| PERIM  | PERIMETER                                   |
| PERP   | PERPENDICULAR                               |
| Pf     | FLAT ROOF SNOW LOAD                         |
| PJP    | PARTIAL JOINT PENETRATION                   |
| PL     | PLATE                                       |
| PLF    | POUNDS PER LINIER FOOT                      |
| PLYWD  | PLYWOOD                                     |
| PMEJ   | PREMOLDED EXPANSION JOINT                   |
| PMF    | PREMOLDED FILLER                            |
| PNL    | PANEL                                       |
| PREFAB | PREFABRICATED                               |
| PREFIN | PREFINISHED                                 |
| Ps     | SLOPED ROOF SNOW LOAD                       |
| PSF    | POUNDS PER SQUARE FOOT                      |
| PSI    | POUNDS PER SQUARE INCH                      |
| PSL    | PARALLEL STRAND LUMBER                      |
| PT     | PRESSURE TREATED                            |
| PTD    | PAINTED                                     |
| QTY    | QUANTITY                                    |
| R      | RISER                                       |
| R=     | BEAM END SHEAR REACTION                     |
| RADIUS | RADIUS                                      |
| RCP    | REFLECTED CEILING PLAN                      |
| RD     | ROOF DRAIN                                  |
| REF    | REFER - REFERENCE                           |
| REIN   | REINFORCING                                 |
| REQ'D  | REQUIRED                                    |
| REV    | REVISION                                    |
| RO     | ROUGH OPENING                               |
| SCHED  | SCHEDULE                                    |
| SCL    | STRUCTURAL COMPOSITE LUMBER                 |
| SE     | STRUCTURAL ENGINEER                         |
| SECT   | SECTION                                     |
| SF     | SQUARE FEET                                 |
| SGL    | SINGLE                                      |
| SHT    | SHEET                                       |
| SHTG   | SHEATHING                                   |
| SIM    | SIMILAR                                     |
| SIMP   | SIMPSON STRONG TIE                          |
| SL     | SNOIW LOAD                                  |
| SOG    | SLAB ON GRADE                               |
| SPEC   | SPECIFICATIONS                              |
| SQ     | SQUARE                                      |
| SS     | STAINLESS STEEL                             |
| STD    | STANDARD                                    |
| STL    | STEEL                                       |
| STRUCT | STRUCTURAL                                  |
| SUSP   | SUSPENDED                                   |
| SYS    | SYSTEM                                      |
| T      | TREAD                                       |
| T&B    | TOP AND BOTTOM                              |
| T&G    | TONGUE AND GROOVE                           |
| T/     | TOP OF                                      |
| T=     | TENSION FORCE                               |
| TAN    | TANGENT                                     |
| THK    | THICK                                       |
| THRD   | THREADED                                    |
| TOB    | TOP OF BEAM                                 |
| TOC    | TOP OF COLUMN, TOP OF CURB, TOP OF CONCRETE |
| TOF    | TOP OF FOOTING                              |
| TOJ    | TOP OF JOIST                                |
| TOL    | TOP OF LINTEL, LANDING                      |
| TOL    | TOLERANCE                                   |
| TOP    | TOP OF PIER, TOP OF PLATE                   |
| TOPV   | TOP OF PAVEMENT                             |
| TOS    | TOP OF STEEL, TOP OF SLAB                   |
| TOW    | TOP OF WALL                                 |
| TRANS  | TRANSVERSE                                  |
| TRANSL | TRANSLUCENT                                 |
| TYP    | TYPICAL                                     |
| UNO    | UNLESS NOTED OTHERWISE                      |
| UTIL   | UTILITY                                     |
| VERT   | VERTICAL                                    |
| VERIFY | VERIFY                                      |
| VIF    | VERIFY IN FIELD                             |
| W      | SNOW DRIFT WIDTH                            |
| WITH   | WITH  |
| W/O    | WITHOUT                                     |
| WCJ    | WALL CONTRACTION JOINT                      |
| WD     | WOOD  |
| WF     | WIDE FLANGE                                 |
| WP     | WORK POINT                                  |
| WR     | WATER RESISTANT, WATER RESISTIVE            |
| WS     | WATERSTOP                                   |
| WT     | WEIGHT                                      |
| WWF    | WELDED WIRE FABRIC                          |

**PROJECT DESCRIPTION:**

- PRE-ENGINEERED METAL BUILDING.
- STEEL-FRAMED COVERED WALKWAY

**GENERAL:**

- THE STRUCTURAL DRAWINGS ARE A PORTION OF THE CONTRACT DOCUMENTS AND ARE INTENDED TO BE USED IN CONJUNCTION WITH THE ARCHITECTURAL, CIVIL, MECHANICAL, AND ELECTRICAL DRAWINGS. THE CONTRACTOR IS RESPONSIBLE FOR COORDINATING THE REQUIREMENTS FROM THE ENTIRE SET OF CONTRACT DOCUMENTS (INCLUDING THE PROJECT SPECIFICATIONS) INTO THEIR WORK.
- THESE GENERAL NOTES SUPPLEMENT THE PROJECT SPECIFICATIONS. REFER TO THE PROJECT SPECIFICATIONS FOR ADDITIONAL REQUIREMENTS.
- NOTES AND DETAILS ON THE STRUCTURAL DRAWINGS SHALL TAKE PRECEDENCE OVER THE GENERAL STRUCTURAL NOTES AND TYPICAL DETAILS.
- VERIFY ALL DIMENSIONS WITH THE ARCHITECTURAL DRAWINGS.
- DETAILS ON THESE PLANS ARE INTENDED TO DEPICT THE GENERAL CONSTRUCTION METHODS FOR THIS STRUCTURE. CONNECTIONS, DETAILS, AND CONDITIONS NOT SPECIFICALLY SHOWN THAT ARE SIMILAR TO THOSE THAT ARE SPECIFIED SHALL BE ASSUMED ONE AND THE SAME. IF QUESTIONS REGARDING THE APPLICATION OF DETAILS ARE ENCOUNTERED, NOTIFY THE ARCHITECT/ENGINEER FOR CLARIFICATION IN A TIMELY MANNER PRIOR TO BID OPENING.

**CODE REQUIREMENTS:**

- CONFORM TO 2018 INTERNATIONAL BUILDING CODE AS ADOPTED W/ AMMENDMENTS BY THE 2020 NYS BUILDING CODE.
- ALL REFERENCE TO OTHER CODES AND STANDARDS (ACI, ASCE, ASTM, ETC.) SHALL BE FOR THE EDITIONS LISTED IN CHAPTER 35 OF THE IBC.


**TEMPORARY CONDITIONS:**

- THE STRUCTURE HAS BEEN DESIGNED TO FUNCTION AS A UNIT UPON COMPLETION. THE CONTRACTOR IS RESPONSIBLE FOR FURNISHING ALL TEMPORARY BRACING AND/OR SUPPORT REQUIRED AS A RESULT OF THE CONTRACTOR'S CONSTRUCTION METHODS AND/OR SEQUENCES.
- CONTRACTOR'S CONSTRUCTION METHODS AND/OR SEQUENCES SHALL RECOGNIZE AND CONSIDER THE EFFECTS OF THERMAL MOVEMENTS OF STRUCTURAL ELEMENTS DURING THE CONSTRUCTION PERIOD.

**DESIGN CRITERIA:**

- DESIGN CRITERIA ASSUMED FOR PRELIMINARY FOUNDATION DESIGN - VERIFICATION REQUIRED UPON RECEIPT OF MANUFACTURER'S ENGINEERED SHOP DRAWINGS AND BASE REACTION CALCULATIONS. DESIGN WAS BASED ON THE STRENGTH AND DEFLECTION CRITERIA OF THE IBC. IN ADDITION TO THE DEAD LOADS, THE FOLLOWING LOADS AND ALLOWANCES WERE USED FOR DESIGN, WITH LIVE LOADS (LL) REDUCED IN ACCORDANCE WITH THE IBC:

|                                     |         |              |
|-------------------------------------|---------|--------------|
| A. RISK CATEGORY                    | III     |              |
| B. DEAD LOADS                       | UNIFORM |              |
| 1. ROOF                             |         |              |
| • 6" INSULATED METAL ROOF PANEL     | 6 PSF   |              |
| • COLLATERAL                        | 20 PSF  |              |
| TOTAL ROOF DEAD LOAD                | 26 PSF  |              |
| C. LIVE LOADS                       | UNIFORM | CONCENTRATED |
| 1. ROOF                             | 20 PSF  | 2000 LBS     |
| 2. SLAB-ON-GRADE                    | 200 PSF | 2000 LBS     |
| D. SNOW LOADS                       | UNIFORM |              |
| 1. GROUND SNOW LOAD, Pg             | 40 PSF  |              |
| 2. FLAT ROOF SNOW LOAD, Pf          | 37 PSF  |              |
| 3. EXPOSURE FACTOR, Ce              | 1.0     |              |
| 4. THERMAL FACTOR, Ct               | 1.2     |              |
| 5. IMPORTANCE FACTOR, Is            | 1.1     |              |
| 6. SLOPE FACTOR, Cs                 | 1.0     |              |
| 7. SLOPED ROOF SNOW LOAD, Ps & Pbal | 37 PSF  |              |
| 8. UNBALANCED SLOPED ROOF SNOW LOAD |         |              |
| A. WINDWARD - FROM EAVE TO RIDGE    | 12 PSF  |              |
| B. LEeward - FROM RIDGE TO 8' - 0"  | 58 PSF  |              |
| C. LEeward - FROM 8' 0" TO EAVE     | 37 PSF  |              |
| 9. SNOW DRIFT                       | N/A     |              |

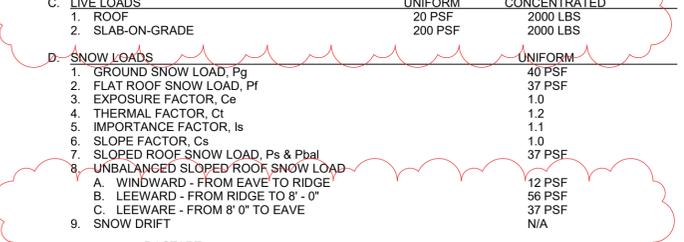

|   |             |  |
|---|-------------|--|
| E. WIND LOADS                                       |             |  |
| 1. WIND VELOCITY, V <sub>ULT</sub>                  | 120 MPH     |  |
| 2. WIND VELOCITY, V <sub>ASD</sub>                  | 93 MPH      |  |
| 3. EXPOSURE CATEGORY                                | C           |  |
| 4. INTERNAL PRESSURE COEFFICIENT, GC <sub>if</sub>  | +/-0.18     |  |
| 5. COMPONENTS & CLADDING PRESSURES - STRENGTH LEVEL | UNIFORM     |  |
| • ZONE 1 - ROOF INTERIOR                            | +20/-63 PSF |  |
| • ZONE 2r - ROOF RIDGE                              | +20/-92PSF  |  |
| • ZONE 2e - ROOF EAVE                               | +20/-63 PSF |  |
| • ZONE 2h - ROOF RAKE                               | +20/-63 PSF |  |
| • ZONE 3r - ROOF RIDGE CORNER                       | +20/-109PSF |  |
| • ZONE 3e - ROOF EAVE CORNER                        | +20/-92 PSF |  |
| • ZONE 4 - WALL SURFACE                             | +34/-37 PSF |  |
| • ZONE 5 - WALL CORNER                              | +34/-46 PSF |  |
| OVERHANG  |             |  |
| • ZONE 1 - ROOF INTERIOR                            | -77 PSF     |  |
| • ZONE 2r - ROOF RIDGE                              | -106 PSF    |  |
| • ZONE 2e - ROOF EAVE                               | -78 PSF     |  |
| • ZONE 2h - ROOF RAKE                               | -106 PSF    |  |
| • ZONE 3r - ROOF RIDGE CORNER                       | -141 PSF    |  |
| • ZONE 3e - ROOF EAVE CORNER                        | -124 PSF    |  |

|  |   |  |
|--|---|--|
| F. SEISMIC LOADS   |   |  |
| 1. SITE CLASS  | D   |  |
| 2. IMPORTANCE FACTOR, I <sub>b</sub>                             | 1.25  |  |
| 3. SEISMIC DESIGN CATEGORY                                       | B   |  |
| 4. EARTHQUAKE SPECTRAL RESPONSE, S <sub>s</sub>                  | 0.171   |  |
| 5. EARTHQUAKE SPECTRAL RESPONSE (1 SECOND), S <sub>1</sub>       | 0.053   |  |
| 6. DESIGN SPECTRAL RESPONSE, S <sub>DS</sub>                     | 0.183   |  |
| 7. DESIGN SPECTRAL RESPONSE (1 SECOND), S <sub>D1</sub>          | 0.086   |  |
| 8. SEISMIC RESISTING SYSTEM                                      |   |  |
| • STEEL SYSTEMS NOT SPECIFICALLY DETAILED FOR SEISMIC RESISTANCE | 3.0   |  |
| 9. RESPONSE MODIFICATION FACTOR, R                               | 3   |  |
| 10. DEFLECTION AMPLIFICATION FACTOR, Cd                          | 3   |  |
| 11. SEISMIC RESPONSE COEFFICIENT, Cs                             | 0.076   |  |
| 12. BASE SHEAR, V  | 25 KIPS (ASD WIND)                                  |  |
| 13. ANALYSIS PROCEDURE   | EQUIVALENT LATERAL FORCE PER ASCE 7-16 SECTION 12.8 |  |

**FOUNDATIONS:**

- FOUNDATION DESIGN IS BASED ON GEOTECHNICAL REPORT, DATED JUNE 28, 2024 AND ADDENDA PREPARED BY ATLANTIC TESTING LABORATORIES, REPORT # CD10726-E-01-06-24. SOIL BEARING PRESSURE NOT TO EXCEED 3000 PSF FOR FOOTINGS WITHIN BUILDING FOOTPRINT. REFER TO GEOTECHNICAL REPORT FOR ALL PROJECT REQUIREMENTS PERTAINING TO EARTHWORK, INCLUDING BUT NOT LIMITED TO, EXCAVATION, BACKFILLING, COMPACTION, AND MATERIALS.
- FOUNDATION SYSTEM - CONCRETE WALLS, COLUMN PIERS, SLABS-ON-GRADE AND SPREAD FOOTINGS.
- ALL FOOTINGS SHALL BE A MINIMUM OF 54" BELOW LOWEST FINAL GRADE FOR EXTERIOR FOOTINGS AND 12" FOR INTERIOR FOOTINGS FOR BEARING ON MEDIUM PLASTICITY SOILS.
- FOUNDATION UNITS SHALL BE CENTERED UNDER SUPPORTED STRUCTURAL MEMBERS, UNLESS NOTED OTHERWISE ON THE DRAWINGS.
- THE CONTRACTOR SHALL REVIEW ALL GEOTECHNICAL ENGINEER RECOMMENDATIONS PRIOR TO THE COMMENCEMENT OF ANY SITE WORK.
- STRUCTURAL FILL MATERIALS, PLACEMENT, AND COMPACTION REQUIREMENTS SHALL BE IN ACCORDANCE WITH THE GEOTECHNICAL REPORT.
- IMPORTED ENGINEERED STRUCTURAL FILL PLACED AS FILL BENEATH PROPOSED FOUNDATIONS/SLABS-ON-GRADE, AND AS BACKFILL, SHALL BE A MATERIAL CONSISTING OF PREDOMINATELY GRANULAR SOILS, FREE FROM ORGANIC MATTER, CLAY, ICE, DEBRIS, OR OTHER DELETERIOUS MATERIAL; SUCH AS IS OUTLINED IN THE GEOTECHNICAL REPORT. THE PROPOSED MATERIAL FOR ENGINEERED FILL SHALL BE REVIEWED AND APPROVED BY THE PROJECT ENGINEER.
- PLACEMENT OF ALL FILL SHALL BE OBSERVED AND TESTED FOR RELATIVE COMPACTION BY A QUALIFIED TECHNICIAN UNDER THE GUIDANCE OF THE GEOTECHNICAL ENGINEER. MINIMUM TESTING FREQUENCY SHALL BE ESTABLISHED BY THE GEOTECHNICAL ENGINEER.
- THE CONTRACTOR SHALL NOTIFY THE GEOTECHNICAL ENGINEER PRIOR TO COMMENCEMENT OF FILLING OPERATIONS.
- ALL GENERAL EXCAVATIONS AND FOOTINGS SHALL BE INSPECTED AND APPROVED PRIOR TO THE PLACEMENT OF ANY SOIL BACKFILL AND/OR CONCRETE.
- ALL FILL, BACKFILL AND COMPACTION ACTIVITIES, PARTICULARLY DURING WET WEATHER CONDITIONS, SHALL FOLLOW RECOMMENDATIONS OF THE GEOTECHNICAL ENGINEER.
- PLACE BACKFILL AND FILL MATERIALS IN HORIZONTAL LAYERS NOT MORE THAN 8" IN LOOSE DEPTH FOR MATERIAL COMPACTED BY HEAVY COMPACTION EQUIPMENT, AND NOT MORE THAN 6" IN LOOSE DEPTH FOR MATERIAL COMPACTED BY HAND-OPERATED TAMPERS.
- ALL FOUNDATION ELEMENTS ARE TO BE PLACED ON UNDISTURBED APPROVED NATIVE SOIL OR ON APPROVED COMPACTED STRUCTURAL FILL AS OUTLINED IN THE GEOTECHNICAL REPORT. STRUCTURAL FILL SHALL EXTEND 1'-0" MINIMUM BEYOND THE FOUNDATION ELEMENT AND THEN DOWNWARD TO NATURAL SOILS AT A SLOPE OF 2 HORIZ. TO 1 VERT.
- BACKFILL AND FILL MATERIALS SHALL BE COMPACTED TO 95% OF MAXIMUM DRY DENSITY ACCORDING TO THE MODIFIED PROCTOR TEST (ASTM D-1557).
- BACKFILL AGAINST FOUNDATION WALLS BELOW GRADE SO THAT THE DIFFERENCE IN THE FILL LEVEL ON OPPOSITE SIDES OF THE WALL DOES NOT EXCEED 1'-0" AT ANY TIME.
- EACH PRIME CONTRACTOR SHALL PROVIDE ALL TRENCHING WORK REQUIRED FOR ITS CONTRACT, INCLUDING TRENCH EXCAVATION, AND BACKFILL (WITH ACCEPTABLE FILL, SEE GEOTECHNICAL REPORT) TO WITHIN 1'-0" OF FINISH GRADE/FLOOR. ALL TRENCHING WORK WITHIN THE BUILDING FOOTPRINT SHALL BE COORDINATED WITH THE GENERAL CONTRACTOR. GENERAL CONTRACTOR MUST ACCEPT, IN WRITING, THE QUALITY OF THE TRENCH BACKFILL OF OTHER PRIME CONTRACTORS BEFORE BEGINNING WORK OVER THE TOP OF THE TRENCH.
- EXCAVATION AND BACKFILL OPERATIONS SHALL BE MAINTAINED IN A DRY CONDITION. SURFACE AND INFILTRATING WATER SHALL BE REMOVED BY SITE GRADING AND PUMPING FROM PUMPS AS REQUIRED.
- NO FOUNDATION CONCRETE SHALL BE PLACED IN WATER OR ON FROZEN SUBGRADE MATERIAL.
- PROTECT IN-PLACE FOUNDATIONS AND SLABS FROM FROST PENETRATION UNTIL THE PROJECT IS COMPLETED.
- THE CONTRACTOR IS RESPONSIBLE FOR EXCAVATION SAFETY. EXCAVATIONS MUST BE PERFORMED IN ACCORDANCE WITH THE CURRENT OCCUPATIONAL SAFETY AND HEALTH ADMINISTRATION (OSHA) STANDARDS.
- PROVIDE TEMPORARY OR PERMANENT SUPPORTS WHETHER SHORING, SHEETING OR BRACING SO THAT NO HORIZONTAL MOVEMENT OR VERTICAL SETTLEMENT OCCURS TO EXISTING STRUCTURES, STREETS OR UTILITIES ADJACENT TO THE PROJECT SITE.

**CONCRETE:**

- ALL CONCRETE WORK SHALL CONFORM TO "ACI 318 - BUILDING CODE REQUIREMENTS FOR STRUCTURAL CONCRETE" AND CHAPTER 19 OF THE NEW YORK STATE BUILDING CODE.
- CONCRETE STRENGTHS SHALL BE VERIFIED BY STANDARD 28-DAY CYLINDER TESTS PER ASTM C39, UNLESS NOTED OTHERWISE, AND SHALL BE AS INDICATED IN SPECIFICATION 03300 & BELOW

| LOCATION                  | EXPOSURE CLASS | AIR CONTENT | Fc   | MAX W/C RATIO |
|---------------------------|----------------|-------------|------|---------------|
| INT. SLAB-ON-GRADE        | F0 S0 W0 C0    | 1.0% - 3.0% | 4000 | 0.50          |
| EXT. SLAB-ON-GRADE        | F3 S0 W0 C2    | 4.5% - 7.5% | 5000 | 0.40          |
| PIERS/FDN/RETAINING WALLS | F2 S0 W0 C1    | 4.5% - 7.5% | 4500 | 0.45          |
| FOOTINGS                  | F0 S1 W0 C1    | 1.0% - 3.0% | 4000 | 0.50          |

- MINIMUM CEMENT CONTENT PER CUBIC YARD SHALL BE AS INDICATED IN ACI 301 TABLE 4.2.2.1 & SPECIFICATION 033000.
- THE CONTRACTOR SHALL SUBMIT CONCRETE MIX DESIGNS, ALONG WITH TEST DATA COMPLIANT WITH ACI-318 CHAPTER 5, A MINIMUM OF TWO WEEKS PRIOR TO PLACING CONCRETE.
- UNLESS NOTED OTHERWISE, ALL CONCRETE SHALL BE NORMAL WEIGHT CONCRETE (145 PCF) WITH ALL CEMENT CONFORMING TO ASTM C150, TYPE I / II. MAXIMUM AGGREGATE SIZE SHALL BE 1-1/2" FOR FOOTINGS AND 3/4" FOR WALLS AND SLABS, CONFORMING TO ASTM C33.
- NO WATER MAY BE ADDED TO CONCRETE IN THE FIELD UNLESS IT CONFORMS TO THE APPROVED MIX DESIGN AND IS SPECIFICALLY APPROVED IN WRITING BY THE CONCRETE SUPPLIER.
- NOTE 7 REMOVED.
- A WATER REDUCING ADMIXTURE CONFORMING TO ASTM C494 USED IN STRICT CONFORMANCE WITH THE MANUFACTURER'S RECOMMENDATIONS SHALL BE INCORPORATED INTO CONCRETE MIX DESIGNS. A HIGH RANGE WATER REDUCING ADMIXTURE CONFORMING TO ASTM C494 TYPE "F" OR TYPE "G" MAY BE USED IN CONCRETE MIXES, PROVIDED THAT THE SLUMP DOES NOT EXCEED 10-INCHES.
- CONCRETE SHALL BE PLACED IN ONE CONTINUOUS OPERATION WHEREVER PRACTICAL. CONSTRUCTION JOINTS IN BEAMS, JOISTS, AND SLABS SHALL BE LOCATED AT MID-SPAN WITH REINFORCING CONTINUING THROUGH AS IF THE JOINT DID NOT OCCUR. VERTICAL CONSTRUCTION JOINTS IN WALLS SHALL BE LOCATED MIDWAY BETWEEN COLUMNS OR PLASTERS.
- SLEEVES, OPENING, CONDUITS, AND OTHER EMBEDDED ITEMS NOT SHOWN ON THE STRUCTURAL DRAWINGS SHALL BE APPROVED BY THE STRUCTURAL ENGINEER PRIOR TO PLACING CONCRETE. CONDUITS EMBEDDED IN SLABS SHALL NOT BE LARGER IN OUTSIDE DIMENSION THAN ONE-THIRD THE THICKNESS OF THE SLAB AND SHALL NOT BE SPACED CLOSER THAN THREE DIAMETERS ON-CENTER.
- THE CONTRACTOR SHALL PROVIDE SHOP DRAWINGS FOR THE LAYOUT OF CONSTRUCTION AND CONTROL JOINTS FOR CONCRETE SLABS-ON-GRADE. THE JOINTS SHALL BE LOCATED AT MAXIMUM 10'-0" ON-CENTER, EACH WAY, FORMING RECTANGLES WITH A LENGTH TO WIDTH RATIO NOT EXCEEDING 1.5 IN ANY DIRECTION. CONTROL JOINTS SHALL INTERSECT AT COLUMN BLOCKOUTS, AT ENDS OF BEARING WALLS, AND AT ALL RE-ENTRANT CORNERS IN THE SLAB.
- ALL BOLTS AND/OR ANCHOR RODS EMBEDDED INTO CONCRETE SHALL CONFORM TO ASTM SPECIFICATION F1554 GRADE 36 UNLESS NOTED OTHERWISE ON THE STRUCTURAL DRAWINGS.
- ANCHOR RODS ARE TO BE LOCATED BY MEANS OF TEMPLATE. ANCHOR RODS SHALL NOT BE HAND SET OR WET SET.
- ANCHOR RODS AND EMBEDDED ITEMS SHALL BE SET IN ACCORDANCE WITH THE AISC CODE OF STANDARD PRACTICE SECTION 7.5.
- WHERE NEW CONCRETE IS PLACED AGAINST EXISTING CONCRETE, THE EXISTING CONCRETE SURFACE SHALL BE CLEANED AND ROUGHENED TO A MINIMUM 1/4" AMPLITUDE.
- PROVIDE 3/4" CHAMFERS ON ALL EXPOSED CONCRETE EDGES, UNLESS NOTED OTHERWISE.
- PREPARATION, CONSTRUCTION, AND PROTECTION OF CONCRETE DURING COLD WEATHER OR HOT WEATHER SHALL CONFORM TO ACI 318 26.5.4, 26.5.5, AND ACI 306R AND 305R.

|           |          |
|-----------|----------|
| DATE:     | 01.23.24 |
| DRAWN BY: | EK       |
| SCALE:    | 1        |

**REINFORCING STEEL:**

- REINFORCING STEEL SHALL BE DETAILED, FABRICATED, AND PLACED IN ACCORDANCE TO "ACI 318 — BUILDING CODE REQUIREMENTS FOR STRUCTURAL CONCRETE" AND "ACI 315—MANUAL OF STANDARD PRACTICE FOR DETAILING REINFORCED CONCRETE STRUCTURES."
- ALL REINFORCING STEEL SHALL CONFORM TO THE FOLLOWING SPECIFICATIONS AND GRADES UNLESS NOTED OTHERWISE ON THE STRUCTURAL DRAWINGS:
  - SMOOTH WELDED WIRE FABRIC—ASTM A185
  - ALL OTHER REINFORCEMENT—ASTM A615, GRADE 60
- REINFORCING STEEL TO BE WELDED SHALL CONFORM TO ASTM A706. WELDING OF REINFORCING STEEL SHALL CONFORM TO AWS D1.4. ALL WELDING SHALL BE DONE BY AWS CERTIFIED WELDERS USING LOW HYDROGEN E70XX ELECTRODES.
- REINFORCING STEEL SHALL BE SECURELY TIED IN-PLACE WITH #16 ANNEALED IRON WIRE. BARS IN BEAMS, SLABS, AND FOUNDATIONS SHALL BE SUPPORTED ON WELL-CURED CONCRETE BLOCKS, OR APPROVED METAL CHAIRS, AS SPECIFIED BY THE "CRSI MANUAL OF STANDARD PRACTICE," MSP-1.
- ALL REINFORCEMENT SHALL BE FREE OF LOOSE MILL AND RUST SCALE, OIL, DIRT, OR COATINGS OF ANY KIND THAT REDUCE THE BOND STRENGTH TO THE CONCRETE.
- REINFORCEMENT STEEL SHALL NOT BE DISPLACED OR ALTERED FOR THE CONVENIENCE OF OTHER TRADES UNLESS APPROVED BY THE STRUCTURAL ENGINEER OF RECORD.
- "WET SETTING" OF REINFORCING STEEL, ANCHOR RODS, EMBEDDED PLATES AND INSERTS IS NOT PERMITTED.
- ALL REINFORCEMENT SHALL BE CONTINUOUS WITH ADEQUATE LAP LENGTHS AT SPLICE LOCATIONS.
- THE FOLLOWING MINIMUM LAP SPLICE LENGTHS SHALL BE PROVIDED FOR ALL REINFORCING STEEL:

| TYPICAL LAP SPLICE SCHEDULE (IN) |           |            |           |            |           |            |
|----------------------------------|-----------|------------|-----------|------------|-----------|------------|
| BAR SIZE                         | 4,000 PSI |            | 4,500 PSI |            | 5,000 PSI |            |
|                                  | TOP BARS  | OTHER BARS | TOP BARS  | OTHER BARS | TOP BARS  | OTHER BARS |
| #3                               | 16        | 16         | 16        | 16         | 16        | 16         |
| #4                               | 20        | 16         | 19        | 16         | 19        | 16         |
| #5                               | 25        | 20         | 24        | 19         | 23        | 17         |
| #6                               | 30        | 24         | 28        | 23         | 26        | 21         |
| #7                               | 49        | 38         | 46        | 36         | 43        | 34         |
| #8                               | 62        | 47         | 58        | 45         | 55        | 42         |
| #9                               | 76        | 58         | 71        | 55         | 68        | 52         |
| #10                              | 91        | 71         | 86        | 67         | 82        | 64         |
| #11                              | 110       | 85         | 103       | 80         | 98        | 76         |

- FOR CENTER-TO-CENTER SPACING LESS THAN SHOWN BELOW MULTIPLY THE ABOVE VALUES BY THE FACTOR INDICATED:
 

| BAR | SPACING  | FACTOR |
|-----|----------|--------|
| #3  | < 1.875" | 1.5    |
| #4  | < 2.500" | 1.7    |
| #5  | < 3.125" | 2.0    |
| #6  | < 3.750" | 2.2    |
| #7  | < 3.875" | 2.1    |
| #8  | < 4.000" | 2.0    |
| #9  | < 4.125" | 1.9    |
| #10 | < 4.375" | 1.7    |
| #11 | < 4.500" | 1.6    |
- TABLE VALUES APPLY FOR CLEAR COVER GREATER THAN OR EQUAL TO 1-1/2". CONTACT ENGINEER OF RECORD IF CONDITIONS VARY.
- TOP BARS ARE HORIZONTAL BARS WITH MORE THAN 12" OF CONCRETE CAST BELOW THE BAR.
- VALUES ARE FOR UNCOATED BARS.

- THE FOLLOWING MINIMUM CONCRETE COVER SHALL BE PROVIDED FOR ALL REINFORCING STEEL:

| MINIMUM CONCRETE COVER (CAST-IN-PLACE)                             |  |
|--|--|
| USE  | CLEAR COVER                                |
| FORMED CONCRETE SURFACES IN CONTACT W/ EARTH OR EXPOSED TO WEATHER | 2" CLEAR COVER<br>1.5" CLEAR COVER TO TIES |
| SLAB-ON-GRADE BARS   | 2" CLEAR COVER FROM TOP OF SLAB            |
| CONCRETE CAST AGAINST EARTH  | 3"   |

- CONTINUE HORIZONTAL WALL BARS THROUGH PILASTERS, COLUMNS AND INTERSECTING WALLS.
- PROVIDE HOOKED FOOTING DOWELS OF THE SAME SIZE AND SPACING AS THE VERTICAL WALL REINFORCEMENT. LAP SPLICE DOWELS TO THE VERTICAL WALL REINFORCEMENT AND TERMINATE WITH STANDARD 90 DEGREE HOOK INTO THE FOOTING. HOOK SHALL LAY IN-PLANE WITH BOTTOM REINFORCEMENT.
- AT SLAB AND WALL OPENINGS, PROVIDE A MINIMUM OF TWO #5 BARS OVER, UNDER, AND AT THE SIDES OF THE OPENING. EXTEND THESE BARS A LAP DISTANCE (OR A MINIMUM OF 2'-0") PAST THE OPENING ON ALL SIDES.
- PROVIDE ONE #5 FOR SINGLE LAYER, AND TWO #5 FOR DOUBLE LAYER REINFORCING, 4'-0" LONG, DIAGONALLY AT EACH CORNER OF ALL WALL AND SLAB OPENINGS.
- REFERENCE TYPICAL DETAILS FOR THE DISPOSITION OF REINFORCEMENT AT WALL CORNERS, WALL INTERSECTIONS, AND FOR BARS IN SMALL WALL SECTIONS.
- PROVIDE #5 CARRIER BAR AT 3'-0" MAX SPACING FOR ALL SLAB, JOIST, AND WALL REINFORCING NOT SUPPORTED BY OTHER TRANSVERSE REINFORCEMENT.
- PROVIDE CORNER BARS AT CORNERS AND INTERSECTIONS FOR WALLS AND FOUNDATIONS EQUAL IN SIZE, NUMBER, AND SPACING TO HORIZONTAL REINFORCING. SIZE CORNER BARS TO PROVIDE A FULL LAP WITH HORIZONTAL REINFORCEMENT ON EACH LEG.

**SHORING AND RE-SHORING:**

- SHORING AND RE-SHORING IS THE CONTRACTOR'S RESPONSIBILITY AND SHALL CONFORM TO ACI 347-04 AND ACI 347.2R-05.
- SHORING AND SUPPORTING FORMWORK SHALL NOT BE REMOVED FROM HORIZONTAL MEMBERS BEFORE THE CONCRETE STRENGTH HAS REACHED AT LEAST 70 PERCENT OF THE SPECIFIED DESIGN STRENGTH AS DETERMINED FROM FIELD CURED CYLINDERS. IN ADDITION, SHORING SHALL NOT BE REMOVED SOONER THAN THE FOLLOWING:

| SHORING AND RE-SHORING         |  |  |
|--------------------------------|--|--|
| ELEMENT                        | MINIMUM REMOVAL TIME   | COMMENTS   |
| WALLS, COLUMNS, AND BEAM SIDES | 12 HR. CUMULATIVE WITH 50 DEGREES FAHRENHEIT SURROUNDING TEMPERATURE | WHERE FORMS ALSO SUPPORT FORMWORK FOR SLABS OR SOFFITS, THE REMOVAL TIME OF THE LATTER GOVERNS |

**CONCRETE ACCESSORIES:**

- DEFORMED BAR ANCHORS (D.B.A.) SHALL BE NELSON TYPE D2L (ICC ESR-2907) OR APPROVED EQUAL.
- HEADED SHEAR STUDS SHALL BE NELSON HEADED ANCHORS WITH FLUXED ENDS (ICC ESR-2856) OR APPROVED EQUAL.
- HEADED SHEAR STUDS AND DEFORMED BAR ANCHORS SHALL BE AUTOMATICALLY END-WELDED WITH THE MANUFACTURER'S STANDARD EQUIPMENT AND IN ACCORDANCE WITH THE ASSOCIATED ICC REPORTS.
- PERMANENTLY EXPOSED EMBEDDED PLATES AND ANGLES SHALL BE HOT-DIPPED GALVANIZED AFTER FABRICATION. EMBEDDED ITEMS SHALL NOT BE LOADED, NOR SHALL WELDS BE APPLIED, FOR A MINIMUM OF 7-DAYS AFTER CASTING OF CONCRETE.
- PROVIDE WATERSTOPS AT ALL HORIZONTAL AND VERTICAL CONCRETE JOINTS WHERE INDICATED ON DRAWINGS AND DETAILS. WATERSTOPS INDICATED TO BE HYDROPHILIC STRIP WATERSTOP SHALL MAINTAIN A MINIMUM CLEAR COVER OF 3 INCHES. REFER TO MANUFACTURER'S WRITTEN INSTRUCTIONS FOR ADDITIONAL INFORMATION.
- APPROVED POST-INSTALLED ANCHORS ARE AS FOLLOWS:

| APPROVED POST-INSTALLED CONCRETE ANCHORS |                        |              |
|--|------------------------|--------------|
| TYPE                                     | ANCHOR                 | ICC REPORT   |
| CONCRETE SCREW                           | SIMPSON TITEN HD       | ICC ESR-2713 |
|  | HILTI KWIK HUS-EZ      | ICC ESR-3027 |
| EPOXY ADHESIVE                           | SIMPSON SET-XP         | ICC ESR-2508 |
|  | HILTI HIT-RE 500V3     | ICC ESR-2322 |
| EXPANSION                                | SIMPSON STRONG-BOLT II | ICC ESR-3814 |
|  | HILTI KWIK BOLT TZ     | ICC ESR-1917 |

- ALL ANCHORS SHALL BE INSTALLED IN STRICT CONFORMANCE TO THE APPLICABLE ICC REPORT.
- REINFORCEMENT SHALL NOT BE CUT IN NEW, OR EXISTING CONCRETE DURING INSTALLATION OF POST-INSTALLED ANCHORS.
- ANCHORS THAT ARE LEFT EXPOSED TO WEATHER SHALL BE STAINLESS STEEL OR HOT-DIPPED GALVANIZED.

**EPOXY REPAIR ADHESIVE:**

- EPOXY REPAIR ADHESIVE SHALL CONFORM TO ASTM C881 AND SHALL BE A TWO-COMPONENT, LIQUID EPOXY WITH NON-SAG CONSISTENCY AND LONG POT LIFE. THE EPOXY ADHESIVE SHALL BE SUITABLE FOR USE ON DRY OR DAMP SURFACES.
- ADHESIVE SHALL MEET THE FOLLOWING MINIMUM REQUIREMENTS:
  - 14 DAY BOND STRENGTH (SLANT SHEAR) = 1690 PSI
  - 7 DAY TENSILE STRENGTH = 7150 PSI
  - 7 DAY COMPRESSIVE STRENGTH = 12000 PSI
  - LINEAR COEFFICIENT OF SHRINKAGE = 0.008 (MAX VALUE)
- HOLE SIZES AND INSTALLATION SHALL BE IN STRICT ACCORDANCE WITH THE MANUFACTURER'S RECOMMENDATIONS AND THE REQUIREMENTS SET FORTH IN THE APPROVED ICC EVALUATION REPORT.
- REINFORCEMENT SHALL NOT BE CUT OR DAMAGED IN EITHER NEW OR EXISTING CONCRETE DURING INSTALLATION.

**PRE-ENGINEERED METAL BUILDING (PEMB):**

- THE PRE-ENGINEERED BUILDING SUPPLIER SHALL FURNISH THE FRAME REACTIONS TO THE ENGINEER OF RECORD, PRIOR TO COMMENCEMENT OF FOUNDATION CONSTRUCTION. THE REACTIONS FURNISHED SHALL BE THE MAXIMUM, WORST-CASE REACTIONS RESULTING FROM LOAD CASES.
- SUBMIT ENGINEERED AND CHECKED SHOP DRAWINGS AND CALCULATIONS TO THE ENGINEER FOR REVIEW. SHOP DRAWINGS AND CALCULATIONS SHALL BE SIGNED AND SEALED BY A REGISTERED PROFESSIONAL ENGINEER IN THE LOCAL JURISDICTION. SUBMITTALS SHALL INCLUDE PLANS LOCATING AND DEFINING ALL ELEMENTS FURNISHED BY THE MANUFACTURER, WITH ALL MAJOR OPENINGS SHOWN, SECTIONS AND DETAILS SHOWING CONNECTIONS, BASEPLATES, WALL CONDITIONS AND ROOF CONDITIONS OF THE PRE-ENGINEERED BUILDING. ALL SUBMITTAL MATERIAL MUST BE REVIEWED AND APPROVED BY THE ENGINEER PRIOR TO CONSTRUCTION AND INSTALLATION.
- THE PRE-ENGINEERED BUILDING SUPPLIER SHALL FURNISH ANCHOR ROD INFORMATION TO THE FOUNDATION CONTRACTOR. ANCHOR ROD PATTERNS SHOWN ON THE FOUNDATION DETAILS ARE SCHEMATIC ONLY. THE GENERAL CONTRACTOR SHALL FURNISH AND SUPPLY THE ANCHOR RODS FOR INSTALLATION IN FOUNDATIONS.
- ALL ANCHOR RODS SHALL BE F1554 GRADE 36. EMBED ANCHOR RODS 18" MINIMUM INTO CONCRETE PIERS; FINAL ANCHOR BOLT LAYOUT AND EMBEDMENTS SHALL BE CONFIRMED UPON RECEIPT OF PEMB REACTIONS AND DRAWINGS.
- ALL STEEL SHALL BE FACTORY PRIMED.
- PRE-ENGINEERED METAL BUILDING STEEL SHALL BE AS FOLLOWS:

- RIGID CLEAR SPAN FRAMES: I-SHAPED FRAME SECTIONS FABRICATED FROM SHOP-WELDED, BUILT-UP STEEL PLATES OR STRUCTURAL-STEEL SHAPES. INTERIOR COLUMNS WHERE SHOWN SHALL BE FABRICATED FROM ROUND STEEL PIPES OR TUBES, OR SHOP-WELDED, BUILT-UP STEEL PLATES.
  - FRAME CONFIGURATION: SINGLE GABLE.
  - EXTERIOR COLUMN: TAPERED.
  - RAFTER: TAPERED.
- END-WALL FRAMING: MANUFACTURER'S STANDARD PRIMARY END-WALL FRAMING FABRICATED FOR FIELD-BOLTED ASSEMBLY TO COMPLY WITH THE FOLLOWING:
  - END-WALL RAFTERS: C-SHAPED, COLD-FORMED, STRUCTURAL-STEEL SHEET; OR I-SHAPED SECTIONS FABRICATED FROM SHOP-WELDED, BUILT-UP STEEL PLATES OR STRUCTURAL-STEEL SHAPES.
- SECONDARY FRAMING: MANUFACTURER'S STANDARD SECONDARY FRAMING, INCLUDING PURLINS, GIRTS, EAVE STRUTS, FLANGE BRACING, BASE MEMBERS, GABLE ANGLES, CLIPS, HEADERS, JAMBS, AND OTHER MISCELLANEOUS STRUCTURAL MEMBERS. UNLESS OTHERWISE INDICATED, FABRICATE FRAMING FROM EITHER COLD-FORMED, STRUCTURAL-STEEL SHEET OR ROLL-FORMED, METALLIC-COATED STEEL SHEET, PREPAINTED WITH COIL COATING, TO COMPLY WITH THE FOLLOWING:
  - PURLINS: C- OR Z-SHAPED SECTIONS; FABRICATED FROM BUILT-UP STEEL PLATES, STEEL SHEET, OR STRUCTURAL-STEEL SHAPES; MINIMUM 2-1/2-INCH- (64-MM) WIDE FLANGES.
  - GIRTS: C- OR Z-SHAPED SECTIONS; FABRICATED FROM BUILT-UP STEEL PLATES, STEEL SHEET, OR STRUCTURAL-STEEL SHAPES. FORM ENDS OF Z-SECTIONS WITH STIFFENING LIPS ANGLED 40 TO 50 DEGREES FROM FLANGE, WITH MINIMUM 2-1/2-INCH- (64-MM) WIDE FLANGES.
  - EAVE STRUTS: UNEQUAL-FLANGE, C-SHAPED SECTIONS; FABRICATED FROM BUILT-UP STEEL PLATES, STEEL SHEET, OR STRUCTURAL-STEEL SHAPES; TO PROVIDE ADEQUATE BACKUP FOR METAL PANELS.
  - FLANGE BRACING: MINIMUM 2-BY-2-BY-1/8-INCH (51-BY-51-BY-3-MM) STRUCTURAL-STEEL ANGLES OR 1-INCH- (25-MM) DIAMETER, COLD-FORMED STRUCTURAL TUBING TO STIFFEN PRIMARY-FRAME FLANGES.
  - SAG BRACING: MINIMUM 1-BY-1-BY-1/8-INCH (25-BY-25-BY-3-MM) STRUCTURAL-STEEL ANGLES.
  - BASE OR SILL ANGLES: MANUFACTURER'S STANDARD BASE ANGLE, MINIMUM 3-BY-2-INCH (76-BY-51-MM), FABRICATED FROM ZINC-COATED (GALVANIZED) STEEL SHEET.
  - PURLIN AND GIRT CLIPS: MANUFACTURER'S STANDARD CLIPS FABRICATED FROM STEEL SHEET. PROVIDE GALVANIZED CLIPS WHERE CLIPS ARE CONNECTED TO GALVANIZED FRAMING MEMBERS.
  - FRAMING FOR OPENINGS: CHANNEL SHAPES; FABRICATED FROM COLD-FORMED, STRUCTURAL-STEEL SHEET OR STRUCTURAL-STEEL SHAPES. FRAME HEAD AND JAMB OF DOOR OPENINGS AND HEAD, JAMB, AND SILL OF OTHER OPENINGS.
- BRACING: PROVIDE ADJUSTABLE WIND BRACING AS FOLLOWS:
  - RIGID PORTAL FRAMES: FABRICATED FROM SHOP-WELDED, BUILT-UP STEEL PLATES OR STRUCTURAL-STEEL SHAPES TO MATCH PRIMARY FRAMING; OF SIZE REQUIRED TO WITHSTAND DESIGN LOADS.

**ALUMINUM:**

- STRUCTURAL ALUMINUM SHALL BE DOMESTIC ALLOY 6061-T6. QUALITY, FABRICATIONS, ASSEMBLY, AND ERECTION SHALL BE IN ACCORDANCE WITH THE ALUMINUM ASSOCIATION'S SPECIFICATION FOR ALUMINUM STRUCTURES, LATEST EDITION.
 

| MATERIAL                                   |           |
|--|-----------|
| A. SHEET AND PLATE:                        | ASTM B209 |
| B. ROLLED BARS AND RODS:                   | ASTM B211 |
| C. EXTRUDED BARS, RODS, SHAPES, AND TUBES: | ASTM B221 |
| D. ROLLED OR EXTRUDED STRUCTURAL SHAPES:   | ASTM B308 |
| E. EXTRUDED STRUCTURAL PIPE AND TUBE:      | ASTM B429 |
- FASTENERS: UNLESS DETAILED OTHERWISE, ALL FASTENERS SHALL BE 316 STAINLESS STEEL. ALUMINUM BOLTS, WHERE SPECIFIED SHALL BE 2024-T4 OR 6061-T6 ALLOY.
- ALL WELDING SHALL CONFORM WITH AWS D.1.2, LATEST STRUCTURAL WELDING CODE-ALUMINUM.
- DESIGN AND DETAILING OF THE CONNECTIONS IS THE RESPONSIBILITY OF THE FABRICATOR AND FABRICATOR'S ENGINEER. ENGINEER SHALL BE REGISTERED IN THE LOCAL JURISDICTION. USE RATIONAL ENGINEERING DESIGN AND STANDARD PRACTICE FOR THE CRITERIA SET FORTH IN THE CONTRACT DOCUMENTS. THE DETAILS SHOWN ON THE DRAWINGS ARE CONCEPTUAL AND DO NOT INDICATE THE REQUIRED WELD SIZES OR NUMBER OF BOLTS UNLESS SPECIFICALLY NOTED.
- ALL ALUMINUM ITEMS SHALL BE ANODIZED UNLESS OTHERWISE NOTED. ANODIZING FINISH SHALL COMPLY WITH STANDARDS FOR ANODIZED ARCHITECTURAL ALUMINUM BY THE ALUMINUM ASSOCIATION. DO NOT ANODIZE ALUMINUM SURFACES WITHIN 3 INCHES OF ANY SURFACE INDICATED TO BE FIELD WELDED. ANODIZED FINISH SHALL BE CLEAR ANODIZED PER AA-M10C11C21A41 WITH A MINIMUM 0.7 MIL COATING.
- WHERE THE CONTACT OF DISSIMILAR METALS MAY CAUSE ELECTROLYSIS OR WHERE ALUMINUM WILL COME IN CONTACT WITH CONCRETE, MORTAR OR PLASTER, THE CONTACT SURFACE OF THE ALUMINUM SHALL BE COATED WITH 1 COAT OF ZINC CHROMATE PRIMER AND 1 HEAVY COAT OF ALUMINUM PIGMENTED ASPHALT PAINT.
- THOROUGHLY CLEAN STRUCTURAL ALUMINUM. REMOVE OIL, GREASE, AND SIMILAR CONTAMINANTS IN ACCORDANCE WITH SSPC SP-1 "SOLVENT CLEANING".
- THOROUGHLY CLEAN STRUCTURAL ALUMINUM. REMOVE OIL, GREASE, AND SIMILAR CONTAMINANTS IN ACCORDANCE WITH SSPC SP-1 "SOLVENT CLEANING".
- ALUMINUM GRATING & STAIR TREADS SHALL BE 6063-T6 AND HAVE A CLEAR ANODIZED PER AA-M10C11C21A41 WITH A MINIMUM 0.7 MIL COATING.

DATE: 01.23.24  
 DRAWN BY: EK  
 SCALE: 1/2" = 1'-0"  
 REVIEWED BY: CAM  
 PROJECT NO.: 22-2496  
 FILE:

**DELAWARE ENGINEERING, D.P.C.**  
 CIVIL AND ENVIRONMENTAL ENGINEERING  
 28 MADISON AVENUE EXTENSION, ALBANY, NY 12203 - 518.452.1290  
 55 SOUTH MAIN ST., ONEONTA, NY 13820 - 607.432.8073  
 16 EAST MARKET ST., RED HOOK, NY 12571 - 518.452.1290  
 548 BROADWAY, MONTICELLO, NY 12701 - 845.791.7777  
 223 MAIN ST., GOSHEN, NY 10924 - 845.615.9324



| NO. | REVISIONS  |             |
|-----|------------|-------------|
|     | DATE       | DESCRIPTION |
| 1   | 11/17/2024 | ADDENDUM #1 |

RHINEBECK WTP  
 IMPROVEMENTS  
 VILLAGE OF RHINEBECK  
 DUTCHESS COUNTY, NY

GENERAL STRUCTURAL  
 NOTES

SHEET:  
**S002**

| SPECIAL INSPECTIONS - STEEL   |       |      |          |                      |                        |
|---|-------|------|----------|----------------------|------------------------|
| Inspections & Test  | Cont. | Per. | IBC Ref. | Required For Project | Referenced Standard    |
| Steel Construction  |       |      |          | Yes                  |                        |
| 1. Structural Steel   |       |      |          | Yes                  |                        |
| a. Inspection Tasks Prior To Welding  |       |      |          | Yes                  |                        |
| iii. Manufacturer certifications for welding consumables available  |       | X    | 1705.2.1 | Yes                  | AISC 360 Table N.5.4-1 |
| i. Welder Qualification records and continuity records  | X     |      | 1705.2.1 | Yes                  | AISC 360 Table N.5.4-1 |
| ii. Welding Procedure Specifications (WPS) Available  | X     |      | 1705.2.1 | Yes                  | AISC 360 Table N.5.4-1 |
| iv. Material identification (type/grade)  |       | X    | 1705.2.1 | Yes                  | AISC 360 Table N.5.4-1 |
| v. Welder identification system   |       | X    | 1705.2.1 | Yes                  | AISC 360 Table N.5.4-1 |
| vi. Fit up of groove welds (including joint geometry)   |       | X    | 1705.2.1 | Yes                  | AISC 360 Table N.5.4-1 |
| vii. Fit up of CJP groove welds of HSS, T, Y, and K-joints without backing (including joint geometry)   |       | X    | 1705.2.1 | Yes                  | AISC 360 Table N.5.4-1 |
| viii. Configuration and finish of access holes  |       | X    | 1705.2.1 | Yes                  | AISC 360 Table N.5.4-1 |
| ix. Fit-up of fillet welds  |       | X    | 1705.2.1 | Yes                  | AISC 360 Table N.5.4-1 |
| x. Check Welding equipment  |       | X    | 1705.2.1 | Yes                  | AISC 360 Table N.5.4-1 |
| b. Inspection Tasks During Welding  |       |      |          | Yes                  |                        |
| i. Control and Handling of welding consumables.   |       | X    | 1705.2.1 | Yes                  | AISC 360 Table N.5.4-2 |
| ii. No welding over cracked tack welds.   |       | X    | 1705.2.1 | Yes                  | AISC 360 Table N.5.4-2 |
| iii. Environmental Conditions   |       | X    | 1705.2.1 | Yes                  | AISC 360 Table N.5.4-2 |
| iv. Verify WPS followed   |       | X    | 1705.2.1 | Yes                  | AISC 360 Table N.5.4-2 |
| v. Verify Welding Techniques  |       | X    | 1705.2.1 | Yes                  | AISC 360 Table N.5.4-2 |
| vi. Placement and installation of steel headed stud anchors   |       | X    | 1705.2.1 | Yes                  | AISC 360 Table N.5.4-2 |
| c. Inspection Tasks after Welding   |       |      |          | Yes                  |                        |
| i. Welds cleaned  |       | X    | 1705.2.1 | Yes                  | AISC 360 Table N.5.4-3 |
| ii. Size, length, and location of welds   |       | X    | 1705.2.1 | Yes                  | AISC 360 Table N.5.4-3 |
| iii. Welds meet visual acceptance criteria  |       | X    | 1705.2.1 | Yes                  | AISC 360 Table N.5.4-3 |
| iv. Arc strikes   |       | X    | 1705.2.1 | Yes                  | AISC 360 Table N.5.4-3 |
| v. K-area   |       | X    | 1705.2.1 | Yes                  | AISC 360 Table N.5.4-3 |
| vi. Weld access holes in rolled heavy shapes and built-up heavy shapes  |       | X    | 1705.2.1 | Yes                  | AISC 360 Table N.5.4-3 |
| vii. Backing removed and weld tabs removed (if required)  |       | X    | 1705.2.1 | Yes                  | AISC 360 Table N.5.4-3 |
| viii. Repair activities   |       | X    | 1705.2.1 | Yes                  | AISC 360 Table N.5.4-3 |
| iv. Document acceptance or rejection of welded joint or member  |       | X    | 1705.2.1 | Yes                  | AISC 360 Table N.5.4-3 |
| x. No prohibited welds have been added without the approval of the EOR  |       | X    | 1705.2.1 | Yes                  | AISC 360 Table N.5.4-3 |
| d. Inspection Tasks Prior to Bolting  |       |      |          | Yes                  |                        |
| i. Manufacturer's certification available for fastener materials  |       | X    | 1705.2.1 | Yes                  | AISC 360 Table N.5.6-1 |
| ii. Fasteners marked in accordance with ASTM requirements   |       | X    | 1705.2.1 | Yes                  | AISC 360 Table N.5.6-1 |
| iii. Proper fasteners selected for the joint detail (grade, type, bolt length if threads are to be excluded from shear plane)                         |       | X    | 1705.2.1 | Yes                  | AISC 360 Table N.5.6-1 |
| iv. Proper bolting procedure selected for joint detail  |       | X    | 1705.2.1 | Yes                  | AISC 360 Table N.5.6-1 |
| v. Connecting elements, including the appropriate faying surface condition and hole preparation, if specified, meet applicable requirements.          |       | X    | 1705.2.1 | Yes                  | AISC 360 Table N.5.6-1 |
| vi. Pre-installation verification testing by installation personnel observed and documented for fastener assemblies and methods used.                 |       | X    | 1705.2.1 | Yes                  | AISC 360 Table N.5.6-1 |
| vii. Proper storage provided for bolts, nuts, washers and other fastener components. X 1705.2.1.1   |       | X    | 1705.2.1 | Yes                  | AISC 360 Table N.5.6-1 |
| AISC 360 Table N.5.6-1  |       |      |          |                      |                        |
| e. Inspection Tasks During Bolting  |       |      |          | Yes                  |                        |
| i. Fastener assemblies, of suitable condition, placed in all holes and washers (if required) are positioned as required.                              |       | X    | 1705.2.1 | Yes                  | AISC 360 Table N.5.6-2 |
| ii. Joint brought to the snug-tight condition prior to the pretensioning operation.   |       | X    | 1705.2.1 | Yes                  | AISC 360 Table N.5.6-2 |
| iii. Fastener component not turned by the wrench prevented from rotating.   |       | X    | 1705.2.1 | Yes                  | AISC 360 Table N.5.6-2 |
| iv. Fasteners are pretensioned in accordance with the RCSC Specification, progressing systematically from the most rigid point toward the free edges. |       | X    | 1705.2.1 | Yes                  | AISC 360 Table N.5.6-2 |
| f. Inspection Tasks After Bolting   |       |      |          | Yes                  |                        |
| i. Document acceptance or rejection of bolted connections.  |       | X    | 1705.2.1 | Yes                  | AISC 360 Table N.5.6-3 |

| SPECIAL INSPECTIONS - CONCRETE  |       |      |                   |                      |   |
|---|-------|------|-------------------|----------------------|---|
| Inspections & Test  | Cont. | Per. | IBC Ref.          | Required For Project | Referenced Standard   |
| Concrete Construction   |       |      |                   | Yes                  |   |
| 1. Inspect reinforcement, including prestressing tendons, and verify placement.   |       | X    | 1705.3            | Yes                  | ACI 318 Ch. 20, 25.2, 25.3, 26.6.1-26.6.3 IBC 1908.4                |
| 2. Reinforcing Bar Welding:   |       |      | 1705.3            | No                   |   |
| a. Verify weldability of reinforcing bars other than ASTM A706.   |       | X    | 1705.3            | No                   | AWS D1.4 ACI 318: 26.6.4  |
| b. Inspect single pass fillet welds, maximum 5/16"  |       | X    | 1705.3            | No                   | AWS D1.4 ACI 318: 26.6.4  |
| c. Inspect all other welds  |       | X    | 1705.3            | No                   | AWS D1.4 ACI 318: 26.6.4  |
| 3. Inspect anchors cast in concrete.  |       | X    | 1705.3            | Yes                  | ACI 318: 17.8.2   |
| 4. Inspect anchors post-installed in hardened concrete members.   |       |      | 1705.3            | Yes                  |   |
| a. Adhesive anchors installed in horizontally or upwardly inclined orientations to resist sustained tension loads   |       | X    | 1705.3            | Yes                  | ACI 318: 17.8.2.4   |
| b. Mechanical anchors and adhesive anchors not defined in item 4a.  |       | X    | 1705.3            | Yes                  | ACI 318: 17.8.2   |
| 5. Verify use of required design mix  |       | X    | 1705.3            | Yes                  | ACI 318: Ch. 19, 26.4.3, 26.4.4; IBC 1904.1, 1904.2, 1908.2, 1908.3 |
| 6. Prior to concrete placement, fabricate specimens for strength tests, perform slump and air content tests, and determine the temperature of concrete.               |       | X    | 1705.3            | Yes                  | ASTM C172, ASTM C31, ACI 318: 26.5, 26.12; IBC 1908.10              |
| 7. Inspect concrete and shotcrete placement for proper application techniques.  |       | X    | 1705.3            | Yes                  | ACI 318: 26.5; IBC 1908.6, 1908.7, 1908.8                           |
| 8. Verify maintenance of specified curing temperature and techniques.   |       | X    | 1705.3            | Yes                  | ACI 318: 26.5.3-26.5.5 IBC: 1908.9                                  |
| 9. Inspect Prestressed concrete for:  |       |      | 1705.3            | No                   |   |
| a. Application of prestressing forces   |       | X    | 1705.3            | No                   | ACI 318: 26.10  |
| b. Grouting of bonded prestressing tendons  |       | X    | 1705.3            | No                   | ACI 318: 26.10  |
| 10. Inspect erection of precast concrete members  |       | X    | 1705.3            | No                   | ACI 318: Ch. 26.9   |
| 11. Verify in-situ concrete strength, prior to stressing tendons in post-tensioned concrete and prior to removal of shores and forms from beams and structural slabs. |       | X    | 1705.3            | No                   | ACI 318: 26.11.2  |
| 12. Inspect formwork for shape, location and dimensions of the concrete member being formed.  |       | X    | 1705.3            | Yes                  | ACI 318: 26.11.2b   |
| 13. Fabricated Items - Precast Concrete   |       | X    | 1704.2.5; 1705.10 | No                   |   |

| SPECIAL INSPECTIONS - FOUNDATIONS   |       |      |          |                      |                     |
|---|-------|------|----------|----------------------|---------------------|
| Inspections & Test  | Cont. | Per. | IBC Ref. | Required For Project | Referenced Standard |
| Foundations   |       |      |          | Yes                  |                     |
| A. Soils  |       |      |          | Yes                  |                     |
| 1. Verify materials below shallow foundations are adequate to achieve the design bearing capacity.  |       | X    | 1705.6   | Yes                  |                     |
| 2. Verify excavations are extended to a proper depth and have reached proper material.  |       | X    | 1705.6   | Yes                  |                     |
| 3. Perform classification and testing of compacted fill materials.  |       | X    | 1705.6   | Yes                  |                     |
| 4. Verify use of proper materials, densities and lift thicknesses during placement and compaction of compacted fill.  |       | X    | 1705.6   | Yes                  |                     |
| 5. Prior to placement of compacted fill, inspect subgrade and verify that site has been prepared properly.  |       | X    | 1705.6   | Yes                  |                     |
| B. Driven Deep Foundations  |       |      |          | No                   |                     |
| 1. Verify element materials, sizes and lengths, comply with the requirements.   |       | X    | 1705.7   | No                   |                     |
| 2. Determine capacities of test elements and conduct additional load tests, as required.  |       | X    | 1705.7   | No                   |                     |
| 3. Inspect driving operations and maintain complete and accurate records for each element.  |       | X    | 1705.7   | No                   |                     |
| 4. Verify placement locations and plumbness, confirm type and size of hammer, record number of blows per foot of penetration, determine required penetrations to achieve design capacity, record tip and butt elevations and document any damage to foundation element. |       | X    | 1705.7   | No                   |                     |
| 5. For steel elements, perform additional special inspections in accordance with Section 1705.2.  |       | --   | 1705.7   | No                   |                     |
| 6. For concrete elements and concrete-filled elements, perform tests and additional special inspections in accordance with Section 1705.3.  |       | --   | 1705.7   | No                   |                     |
| 7. For specialty elements, perform additional inspections as determined by the registered design professional in responsible charge.  |       | --   | 1705.7   | No                   |                     |
| C. Cast-in-place Deep Foundations   |       |      |          | No                   |                     |
| 1. Inspect drilling operations and maintain complete and accurate records for each element.   |       | X    | 1705.8   | No                   |                     |
| 2. Verify placement locations and plumbness, confirm element diameters, bell diameters (if applicable), lengths, embedment into bedrock (if applicable) and adequate end-bearing strata capacity. Record concrete or grout volumes.                                     |       | X    | 1705.8   | No                   |                     |
| 3. For concrete elements, perform tests and additional special inspections in accordance with Section 1705.3.   |       | --   | 1705.8   | No                   |                     |
| D. Helical Pile Foundations   |       | X    | 1705.9   | No                   |                     |

**SPECIAL INSPECTION AND TESTING:**

1. SPECIAL INSPECTION WILL BE PROVIDED BY THE OWNER BASED ON THE REQUIREMENTS OF THE CURRENT EDITION OF THE NYSBC AS SUMMARIZED IN THE SPECIAL INSPECTION AND TESTING PROGRAM ON SHEET S003. THE CONTRACTOR SHALL PROVIDE SUFFICIENT NOTICE AND ACCESS FOR THE SPECIAL INSPECTOR TO PERFORM THESE INSPECTIONS.

**STRUCTURAL OBSERVATION:**

1. THE STRUCTURAL ENGINEER OF RECORD (SER) WILL PERFORM STRUCTURAL OBSERVATIONS BASED ON THE REQUIREMENTS OF THE IBC AT THE STAGES OF CONSTRUCTION LISTED BELOW. THE CONTRACTOR SHALL PROVIDE SUFFICIENT NOTICE AND ACCESS FOR THE SER TO PERFORM THESE OBSERVATIONS:

| STRUCTURAL OBSERVATIONS                    |                    |                      |
|--|--------------------|----------------------|
| CONSTRUCTION PHASE                         | OBSERVATION BY SER | COMMENTS             |
| PRIOR TO FIRST CONCRETE POUR               | X                  | REF FOOTNOTE A, B, C |
| AT COMPLETION OF HORIZONTAL ROOF DIAPHRAGM | X                  | REF FOOTNOTE A, B    |
| PRIOR TO COVERING STRUCTURAL ELEMENTS      | X                  | REF FOOTNOTE A, B    |
| AS REQUIRED TO ADDRESS STRUCTURAL ISSUES   | X                  | REF FOOTNOTE A, B    |

- A. STRUCTURAL OBSERVATIONS ARE INTENDED TO VERIFY GENERAL CONFORMANCE WITH THE STRUCTURAL DRAWINGS. SPECIAL INSPECTIONS AND TESTING ARE STILL REQUIRED.
- B. A FIELD REPORT WILL BE SUBMITTED TO THE BUILDING DEPARTMENT FOLLOWING EACH VISIT.
- C. STRUCTURAL OBSERVATION TO OCCUR AFTER THE REINFORCING STEEL HAS BEEN INSTALLED.

**SUBMITTALS:**


1. SHOP DRAWINGS SHALL BE SUBMITTED TO THE ENGINEER PRIOR TO THE FABRICATION AND CONSTRUCTION OF ALL STRUCTURAL ITEMS INCLUDING THE FOLLOWING:

| SUBMITTALS   |                  |                           |          |
|--|------------------|---------------------------|----------|
| ITEM   | SUBMITTAL (A, C) | DEFERRED SUBMITTAL (B, C) | COMMENTS |
| CONCRETE MIX DESIGNS   | X                |                           |          |
| CONCRETE REINFORCEMENT   | X                |                           |          |
| REINFORCING STEEL MILL CERTS                                   | X                |                           |          |
| CONCRETE ANCHORAGES  | X                |                           |          |
| EMBEDDED STEEL ITEMS   | X                |                           |          |
| PRE-ENGINEERED METAL BUILDING SHOP DRAWINGS AND BASE REACTIONS | X                | X                         |          |
| ALUMINUM GUARDRAILS  | X                | X                         |          |
| ALUMINUM STAIRS, GRATING, AND FRAMING                          | X                |                           |          |

- A. IF THE SHOP DRAWINGS DIFFER FROM OR ADD TO THE DESIGN OF THE STRUCTURAL DRAWINGS, THEY SHALL BEAR THE SEAL AND SIGNATURE OF A STRUCTURAL ENGINEER REGISTERED IN NEW YORK STATE. ANY MODIFICATIONS TO THE STRUCTURAL DRAWINGS SHALL BE SUBMITTED TO THE ENGINEER AND ARE SUBJECT TO REVIEW AND ACCEPTANCE BY THE STRUCTURAL ENGINEER OF RECORD.
- B. DESIGN DRAWINGS, SHOP DRAWINGS, AND CALCULATIONS FOR THE DESIGN AND FABRICATION OF ITEMS THAT ARE DESIGNED BY OTHERS SHALL BEAR THE SEAL AND SIGNATURE OF A STRUCTURAL ENGINEER REGISTERED IN NEW YORK STATE. CALCULATIONS SHALL BE INCLUDED FOR ALL CONNECTIONS TO THE STRUCTURE CONSIDERING LOCALIZED EFFECTS ON STRUCTURAL ELEMENTS INDUCED BY THE CONNECTION LOADS. DESIGN SHALL BE BASED UPON THE REQUIREMENTS OF THE NYSBC AND AS NOTED UNDER "DESIGN CRITERIA."
- C. FIELD ENGINEERED DETAILS DEVELOPED BY THE CONTRACTOR THAT DIFFER FROM, OR ADD TO, THE STRUCTURAL DRAWINGS SHALL BEAR THE SEAL AND SIGNATURE OF A STRUCTURAL ENGINEER REGISTERED IN NEW YORK STATE AND SHALL BE SUBMITTED TO THE ARCHITECT PRIOR TO CONSTRUCTION. ANY SUCH DETAILS ARE SUBJECT TO REVIEW AND ACCEPTANCE BY THE STRUCTURAL ENGINEER OF RECORD.

DATE: 01.23.24  
DRAWN BY: EK  
SCALE: 1/2" = 1'-0"  
REVIEWED BY: CAM  
PROJECT NO.: 22-2496  
FILE:

**DELAWARE ENGINEERING, D.P.C.**  
CIVIL AND ENVIRONMENTAL ENGINEERING  
28 MADISON AVENUE EXTENSION, ALBANY, NY 12203 - 518.452.1290  
55 SOUTH MAIN ST., ONEONTA, NY 13820 - 607.432.8073  
16 EAST MARKET ST., RED HOOK, NY 12571 - 518.452.1290  
548 BROADWAY, MONTICELLO, NY 12701 - 845.791.7777  
223 MAIN ST., COBHEN, NY 10924 - 845.615.9332

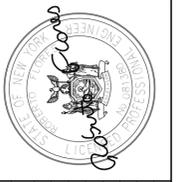

| NO. | REVISIONS  |             |
|-----|------------|-------------|
|     | DATE       | DESCRIPTION |
| 1   | 11/12/2024 | ADDENDUM #1 |

**RHINEBECK WTP IMPROVEMENTS VILLAGE OF RHINEBECK DUTCHESS COUNTY, NY**

**SPECIAL INSPECTION & SUBMITTALS**

SHEET: **S003**

**STRUCTURAL LEGEND**

- INDICATES FOUNDATION TYPE MARK. REFERENCE THE FOUNDATION SCHEDULE.
- INDICATES FLOOR/ROOF STEP.
- INDICATES TOP FOUNDATION WALL STEP.
- INDICATES TOP FOOTING STEP.
- INDICATES STRUCTURAL WALL BELOW.
- INDICATES KEYED NOTE.
- INDICATES NEW GRIDLINE.

**FOUNDATION PLAN NOTES**

1. ALL ELEVATIONS REFERENCED FROM 0'-0" = FF.
2. VERIFY ALL DIMENSIONS WITH THE ARCHITECTURAL DRAWINGS AND METAL BUILDING DRAWINGS. GRIDLINES ARE LOCATED AT OUTSIDE FACE OF CONCRETE FOUNDATION WALLS AND CENTERLINE OF COLUMNS WHERE INDICATED.
3. DETAILS ON THESE PLANS ARE INTENDED TO DEPICT THE GENERAL CONSTRUCTION METHOD FOR THIS STRUCTURE. CONNECTIONS, DETAILS AND CONDITIONS NOT SPECIFICALLY SHOWN THAT ARE SIMILAR TO THOSE THAT ARE SPECIFIED SHALL BE ASSUMED ONE AND THE SAME. IF QUESTIONS ARISE REGARDING THE APPLICATION OF DETAILS ARE ENCOUNTERED, NOTIFY THE STRUCTURAL ENGINEER OF RECORD FOR CLARIFICATION IN A TIMELY MANNER PRIOR TO BID OPENING.
4. REFERENCE MEP DRAWINGS FOR ALL ELEVATIONS, PIPE PENETRATIONS, ETC. REFER TO STRUCTURAL DETAILS CORRESPONDING TO SPECIFIC ITEMS SUCH AS PIPE PENETRATIONS, OPENINGS, ETC.
5. VERIFY SIZE AND LOCATION OF ALL SLAB AND WALL PENETRATIONS.
6. ALL WALL FOOTINGS ARE WF1, UNLESS OTHERWISE NOTED. WALL FOOTINGS ARE CENTERED ON FOUNDATION WALLS.
7. TOP OF FOOTING ELEVATION IS 4' - 0" UNLESS OTHERWISE NOTED.
8. ALL STEM WALLS TO BE 8" THICK UNO ON PLAN, REINFORCEMENT TO BE #5@12" OC, EW, CENTER OF WALL.
9. TOP OF FOUNDATION WALL ELEVATION IS 1'-0" UNLESS OTHERWISE NOTED.
10. TOP OF PIER ELEVATION IS 0'-0" UNLESS OTHERWISE NOTED.
11. NOTE 11 REMOVED.

**WALL FOOTING SCHEDULE**

| MARK | WIDTH   | THICKNESS | LONG. REINF.       | TRANS. REINF.   |
|------|---------|-----------|--------------------|-----------------|
| WF1  | 2' - 0" | 1' - 0"   | (3) #5, EQ SP, BTM | #5 @18" OC, BTM |


**FOOTING SCHEDULE**

| MARK | LENGTH  | WIDTH   | THICKNESS | LONG. REINF.       | TRANS. REINF.      |
|------|---------|---------|-----------|--------------------|--------------------|
| F1   | 3' - 6" | 3' - 6" | 1' - 0"   | (4) #5, EQ SP, BTM | (4) #5, EQ SP, BTM |
| F2   | 5' - 6" | 5' - 6" | 1' - 0"   | (6) #5, EQ SP, BTM | (6) #5, EQ SP, BTM |


**PIER SCHEDULE**

| MARK | SIZE    | VERT REINF    | TIES                        |
|------|---------|---------------|-----------------------------|
| P1   | 22"x22" | (8) #5, EQ SP | 1 @2".1 @3", REMAINDER @10" |
| P2   | 16"x22" | (8) #5, EQ SP | 1 @2".1 @3", REMAINDER @10" |
| P3   | 16"x20" | (8) #5, EQ SP | 1 @2".1 @3", REMAINDER @10" |

- KEYNOTES**
1. PIPE PENETRATION THROUGH FOUNDATION WALL; REFER TO MECH PLANS AND S300 FOR ADDITIONAL INFORMATION
  2. PRECAST CATCH BASIN PER CIVIL/MECH
  3. EXISTING FOUNDATIONS, VERIFY LOCATION AND T/FTG ELEVATION IN FIELD

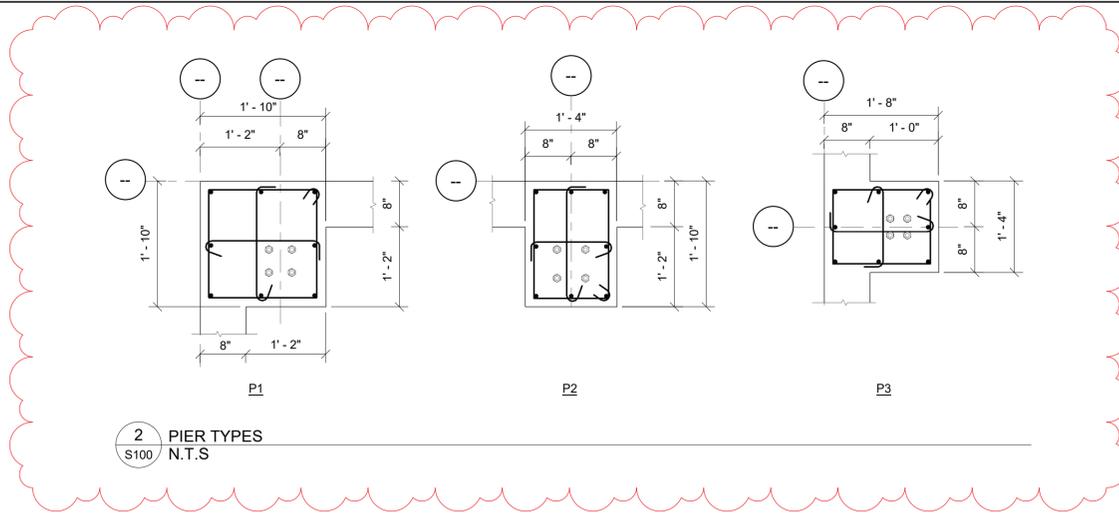

2 PIER TYPES  
S100 N.T.S

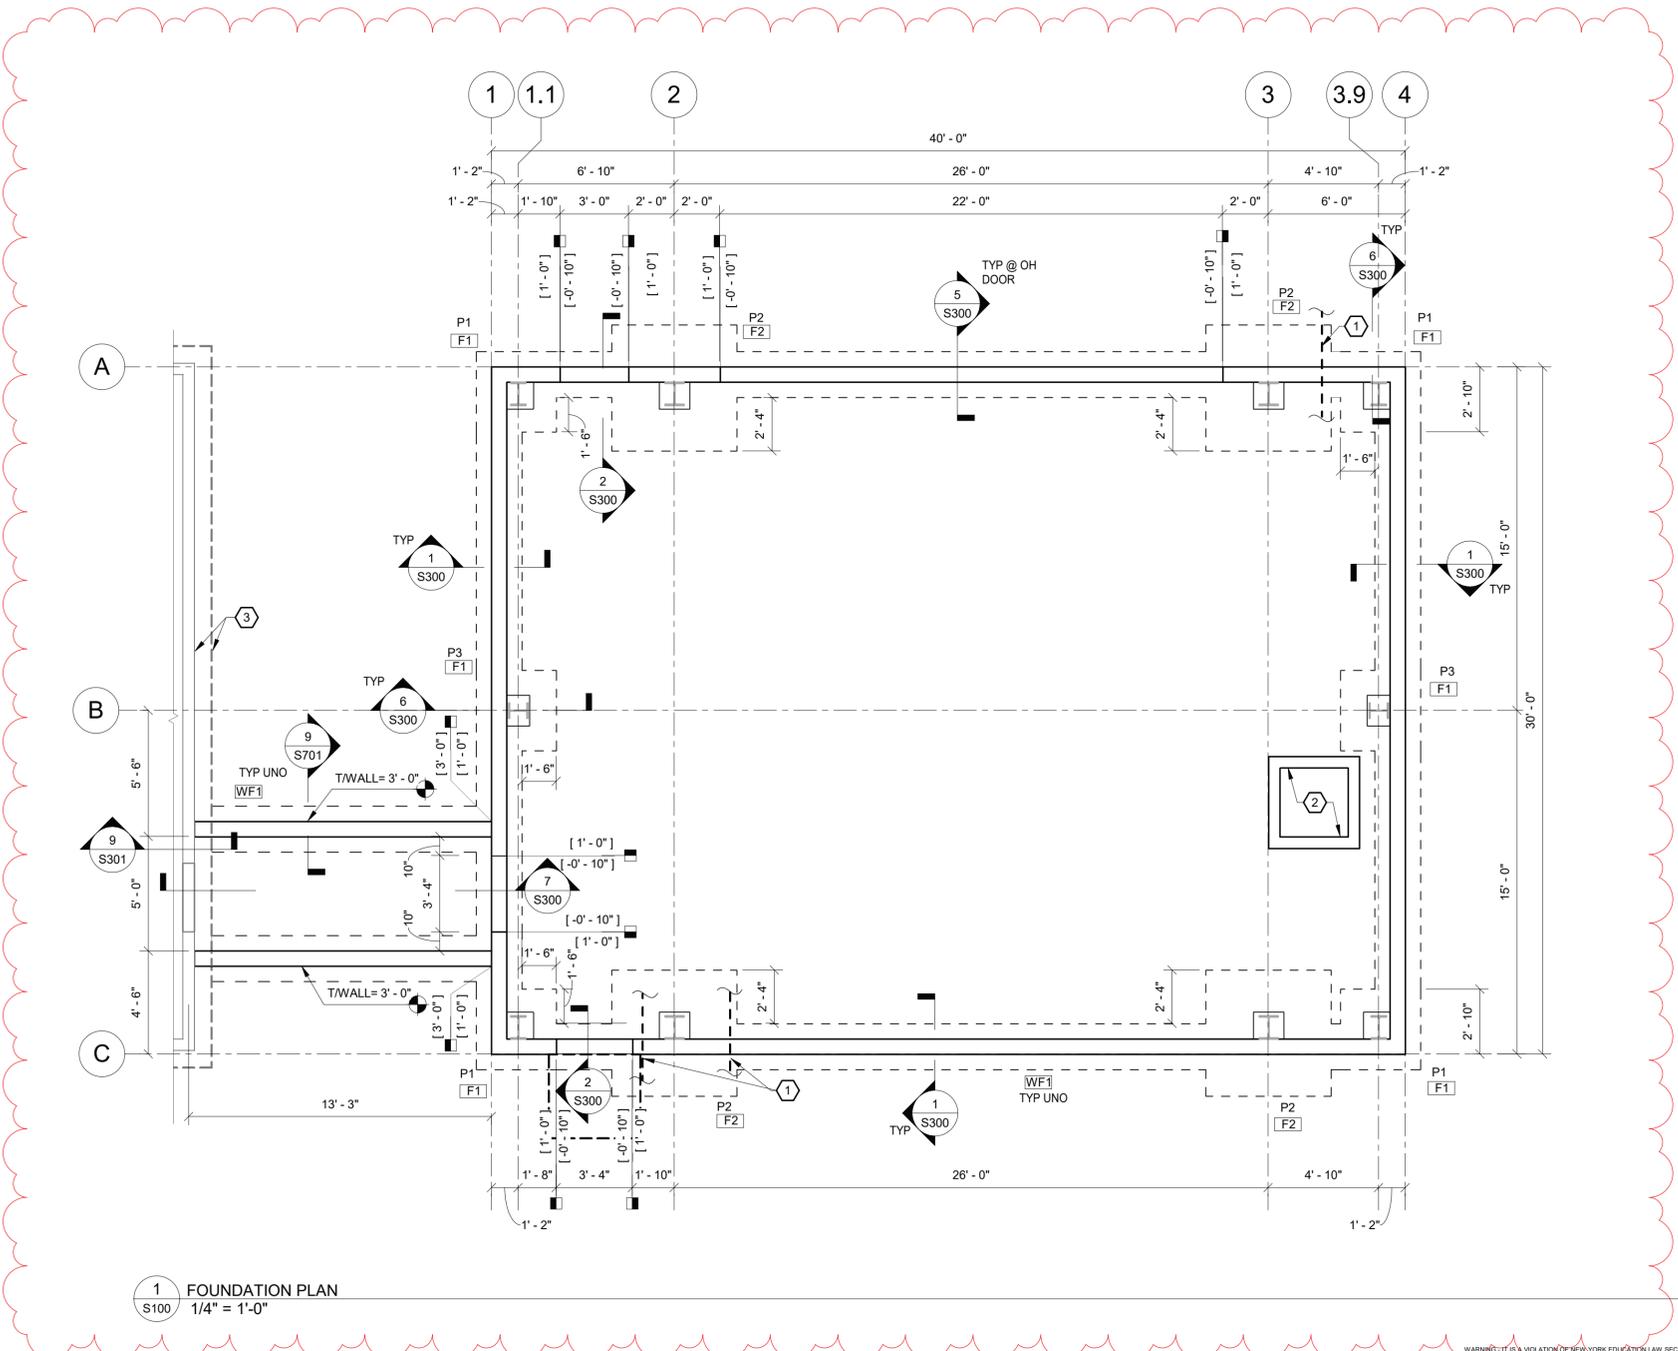

1 FOUNDATION PLAN  
S100 1/4" = 1'-0"

DATE: 01.23.24  
DRAWN BY: EK  
SCALE: As Indicated  
REVIEWED BY: CAM  
PROJECT NO.: 22-2496  
FILE:

**DELAWARE ENGINEERING, D.P.C.**  
CIVIL AND ENVIRONMENTAL ENGINEERING  
28 MADISON AVENUE EXTENSION, ALBANY, NY 12203 - 518.452.1290  
55 SOUTH MAIN ST., ONEONTA, NY 13820 - 607.432.8073  
16 EAST MARKET ST., RED HOOK, NY 12571 - 518.452.1290  
548 BROADWAY, MONTICELLO, NY 12701 - 845.791.7777  
223 MAIN ST., GOUGHEN, NY 10924 - 845.615.9332



**REVISIONS**

| NO. | DATE       | DESCRIPTION |
|-----|------------|-------------|
| 1   | 11/12/2024 | ADDENDUM #1 |

**RHINEBECK WTP IMPROVEMENTS**  
VILLAGE OF RHINEBECK  
DUTCHESS COUNTY, NY

**FOUNDATION PLAN**

SHEET: **S100**

WARNING: IT IS A VIOLATION OF NEW YORK EDUCATION LAW SECTION 2209.2, FOR ANY PERSON UNLESS HE IS ACTING UNDER THE DIRECTION OF A LICENSED PROFESSIONAL ENGINEER OR LAND SURVEYOR, TO ALTER THIS DOCUMENT IN ANY WAY. IF ALTERED THE ALTERING PERSON SHALL COMPLY WITH THE REQUIREMENTS OF NEW YORK EDUCATION LAW, SECTION 2209.2.

**STRUCTURAL LEGEND**

- INDICATES FOUNDATION TYPE MARK, REFERENCE THE FOUNDATION SCHEDULE.
- INDICATES FLOOR/ROOF STEP.
- INDICATES TOP FOUNDATION WALL STEP.
- INDICATES TOP FOOTING STEP.
- INDICATES STRUCTURAL WALL BELOW.
- INDICATES KEYED NOTE.
- INDICATES NEW GRIDLINE.

**FRAMING PLAN NOTES**


1. ALL ELEVATIONS ARE REFERENCED FROM 0'-0" = FF = 25.0'.
2. VERIFY ALL DIMENSIONS WITH THE ARCHITECTURAL DRAWINGS AND THE METAL BUILDING DRAWINGS. GRIDLINES ARE LOCATED AT EXTERIOR FACE OF CONCRETE FOUNDATION WALLS AND CENTERLINE OF COLUMNS WHERE INDICATED.
3. DETAILS ON THESE PLANS ARE INTENDED TO DEPICT THE GENERAL CONSTRUCTION METHODS FOR THIS STRUCTURE. CONNECTIONS, DETAILS AND CONDITIONS NOT SPECIFICALLY SHOWN THAT ARE SIMILAR TO THOSE THAT ARE SPECIFIED SHALL BE ASSUMED ONE AND THE SAME. IF QUESTIONS REGARDING THE APPLICATION OF DETAILS ARE ENCOUNTERED, NOTIFY THE ENGINEER FOR CLARIFICATION IN A TIMELY MANNER PRIOR TO BID OPENING.
4. REFERENCE MEP DRAWINGS FOR ALL ELEVATIONS, PIPE PENETRATIONS, ETC. REFER TO STRUCTURAL DETAILS CORRESPONDING TO SPECIFIC ITEMS SUCH AS PIPE PENETRATIONS, OPENINGS, ETC.
5. REFERENCE ARCHITECTURAL DRAWINGS FOR ADDITIONAL INFORMATION FOR ALL DOORS.
6. INDICATES SPAN DIRECTION OF 1 1/2" SERRATED ALUMINUM GRATING W/ 3/16" BEARING BARS @ 1 3/16" OC AND CROSS BARS @ 2" OC. ALL EDGES OF GRATING AND OPENINGS IN GRATING SHALL BE BANDED.
7. ALL GRATING SHALL CONFORM TO ANSINAAM MBG 531. ATTACH TO SUPPORTING STEEL WITH MANUFACTURER'S STANDARD HOLD DOWN CLIPS. GRATING AND HARDWARE SHALL HAVE EITHER STAINLESS STEEL TYPE 316 FINISH OR ANODIZED FINISH.

**KEYNOTES**


- 1 8" NORMAL WEIGHT SLAB-ON-GRADE. REINFORCE WITH #5 @ 16" OC EW, PER 3/S301
- 2 CONTROL JOINT, CONTINUE THROUGH AND INCLUDE IN HOUSEKEEPING PAD WHERE APPLICABLE, TYPICAL PER 5/S301
- 3 14" THICK CAST-IN-PLACE EQUIPMENT PAD (SLAB-ON-GRADE); REINFORCE WITH #5@12" OC, EW, T&B. FINAL DIMENSIONS OF PAD TO BE COORDINATED WITH EQUIPMENT MANUF; PAD EXTENTS TO BE MIN 6" GREATER THAN EQUIPMENT EXTENTS EA SIDE. T/PAD PER PLAN
- 4 BOLLARD, TYPICAL PER 11/S300.
- 5 ALUMINUM STAIRS, CONTR TO SUBMIT AS PART OF DELEGATED DESIGN
- 6 ALUMINUM POST TO BE RT4x4x0.188, REFERENCE 3/S701 FOR ATTACHMENT TO SLAB
- 7 THICK DASHED LINE INDICATES EXTENTS OF ALUMINUM HANDRAIL PER 1/S701
- 8 TRENCH DRAIN, 6" WIDE x 20' - 0" LONG DURO-SLOPE BY NDS W/ GALVANIZED DS-221 GRATING OR APPROVED EQUAL, PER 9/S301.
- 9 SLAB OPENING FOR CATCH BASIN, PER MECHANICAL

**ROOF FRAMING PLAN NOTES**


1. ALL ELEVATIONS ARE REFERENCED FROM 0'-0" = FF = 25.0'.
2. INDICATES SPAN DIRECTION OF 3" TYPE N METAL ROOF DECK, 20 GAGE, GALVANIZED (G90). FASTEN TO STEEL SUPPORTS (END AND INTERIOR SUPPORTS) WITH HILTI X-ENP19 PAF IN A 36/4 PATTERN. SIDELAP FASTENING TO BE HILTI SCREW S-SLC0102 AT 12" OC. FASTENER SUBSTITUTION ACCEPTABLE UPON APPROVAL OF PROPOSED FASTENER DOCUMENTATION BY THE EOR.
3. ALL WELDED FRAME TO BE FABRICATED AS ONE UNIT WITH MITERED CORNERS.

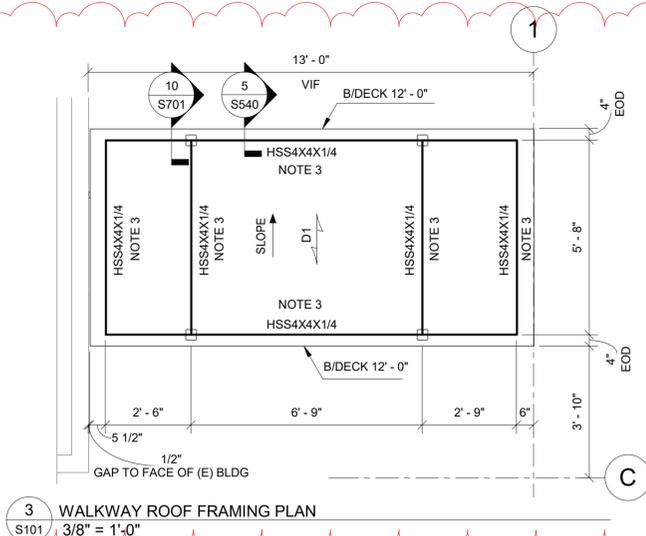

3 WALKWAY ROOF FRAMING PLAN  
S101 3/8" = 1'-0"

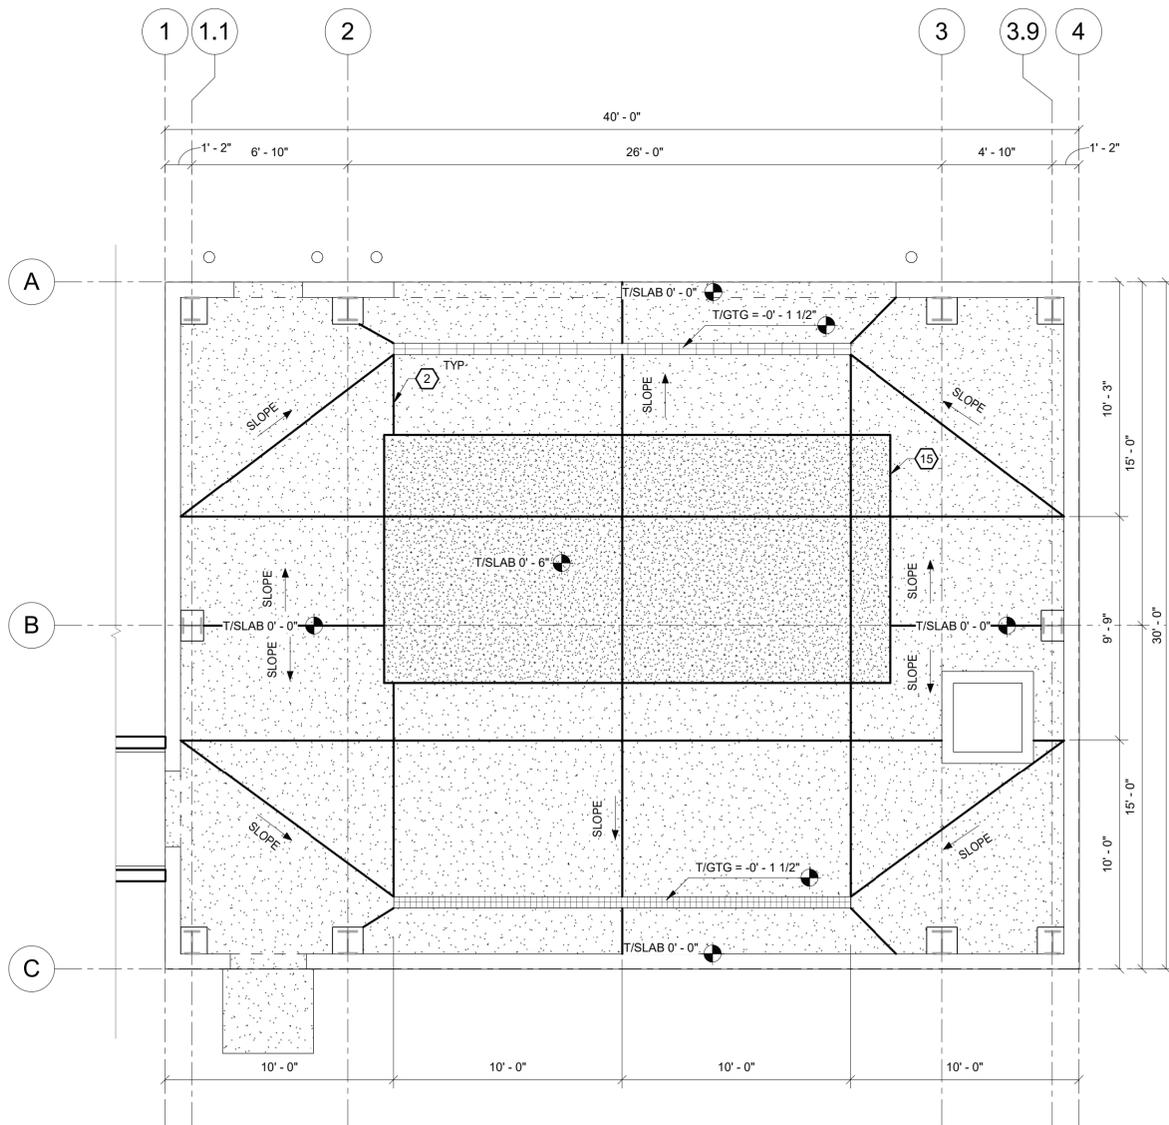


2 SLAB PLAN  
S101 1/4" = 1'-0"

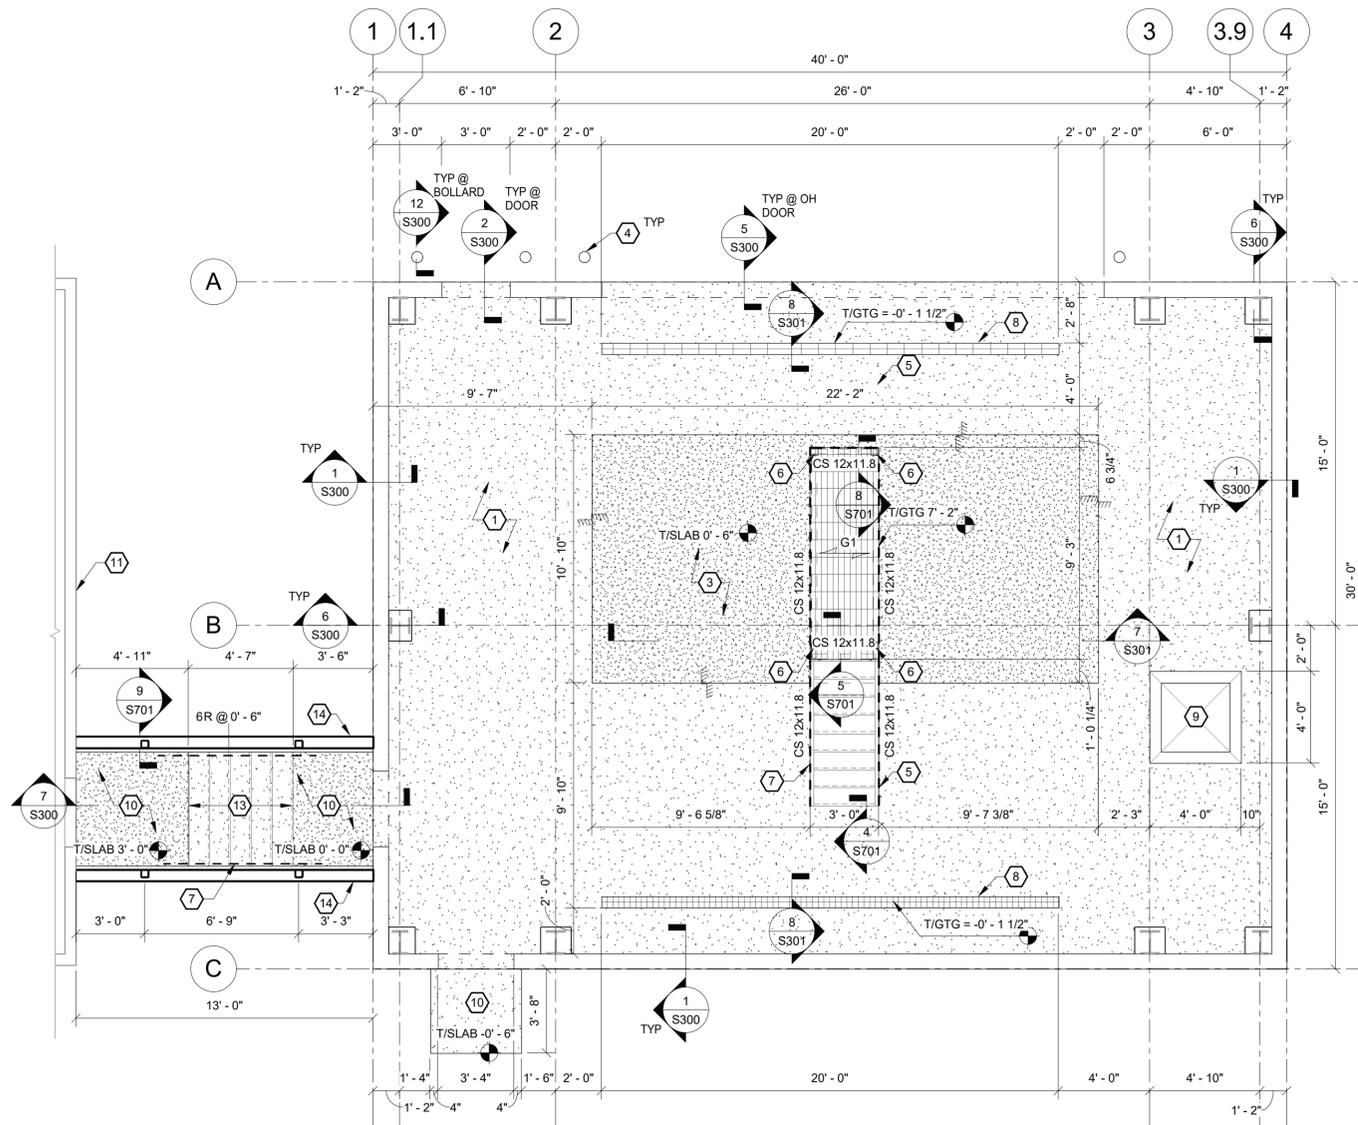

1 FIRST FLOOR STRUCTURAL FRAMING PLAN  
S101 1/4" = 1'-0"

DATE: 01.23.24  
DRAWN BY: EK  
SCALE: As Indicated  
REVIEWED BY: CAM  
PROJECT NO.: 22-2496  
FILE:

**DELAWARE ENGINEERING, P.C.**  
CIVIL AND ENVIRONMENTAL ENGINEERING  
28 MADISON AVENUE EXTENSION, ALBANY, NY 12203 - 518.452.1290  
55 SOUTH MAIN ST., ONEONTA, NY 13820 - 607.432.8073  
16 EAST MARKET ST., RED HOOK, NY 12571 - 518.452.1290  
548 BROADWAY, MONTICELLO, NY 12701 - 845.791.7777  
223 MAIN ST., GOSHEN, NY 10924 - 845.615.9332

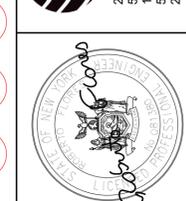


| NO. | DATE       | DESCRIPTION |
|-----|------------|-------------|
| 1   | 11/17/2024 | ADDENDUM #1 |

**RHINEBECK WTP IMPROVEMENTS VILLAGE OF RHINEBECK DUTCHESS COUNTY, NY**


**FIRST FLOOR FRAMING PLAN**

SHEET: **S101**


WARNING: IT IS A VIOLATION OF NEW YORK EDUCATION LAW SECTION 2209.2, FOR ANY PERSON UNLESS HE IS ACTING UNDER THE DIRECTION OF A LICENSED PROFESSIONAL ENGINEER OR LAND SURVEYOR, TO ALTER THIS DOCUMENT IN ANY WAY. IF ALTERED THE ALTERING PERSON SHALL COMPLY WITH THE REQUIREMENTS OF NEW YORK EDUCATION LAW, SECTION 2209.2.

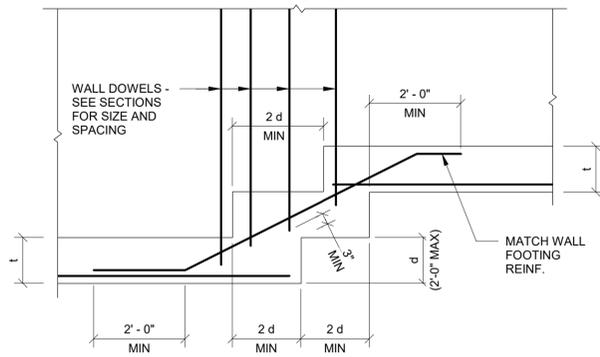


13 TYPICAL STEPPED FOOTING DETAIL  
S300 N.T.S

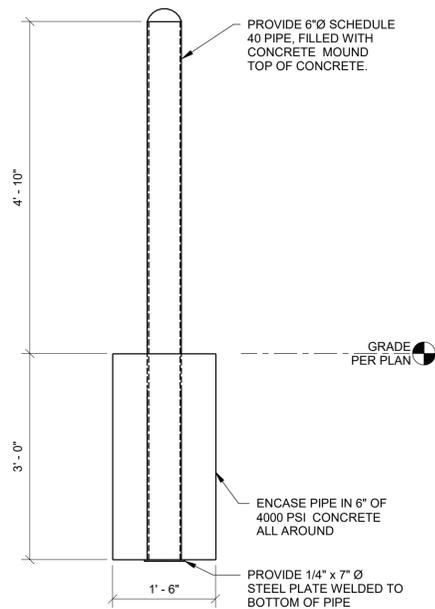

12 TYPICAL 6" BOLLARD SECTION  
S300 N.T.S

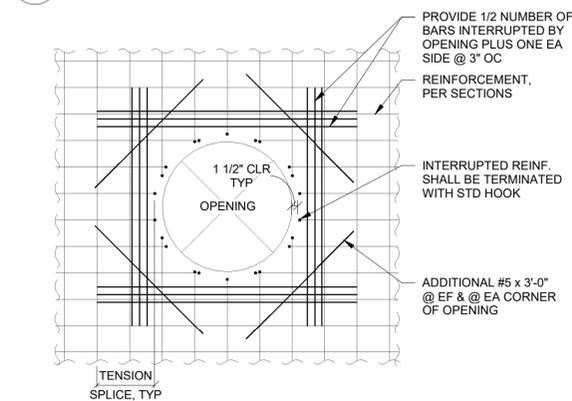


11 TYPICAL WALL SLEEVE OPENING  
S300 N.T.S

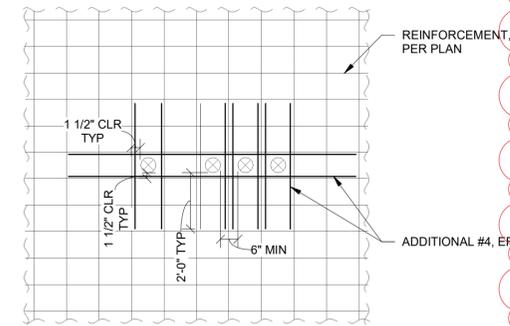


10 TYPICAL MULTIPLE WALL SLEEVE OPENING DETAIL  
S300 N.T.S

10 TYPICAL MULTIPLE WALL SLEEVE OPENING DETAIL  
S300 N.T.S

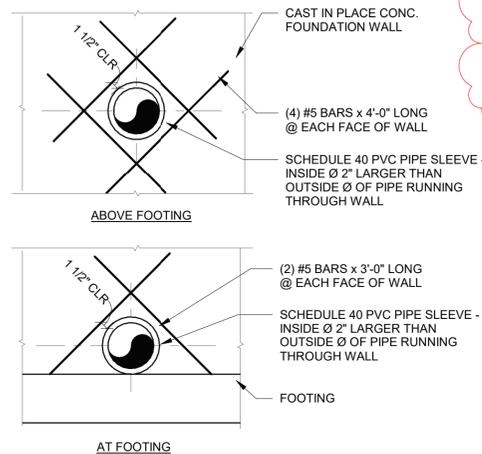


9 TYPICAL WALL REINFORCING FOR PIPE OPENING  
S300 N.T.S

9 TYPICAL WALL REINFORCING FOR PIPE OPENING  
S300 N.T.S

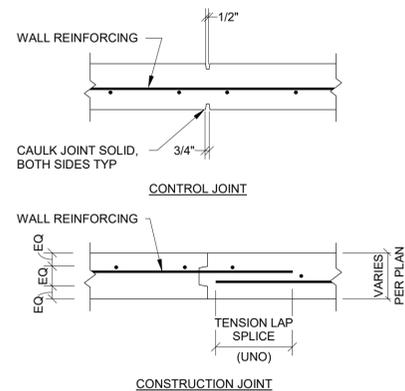


8 TYPICAL CONCRETE WALL JOINT DETAILS  
S300 N.T.S


8 TYPICAL CONCRETE WALL JOINT DETAILS  
S300 N.T.S

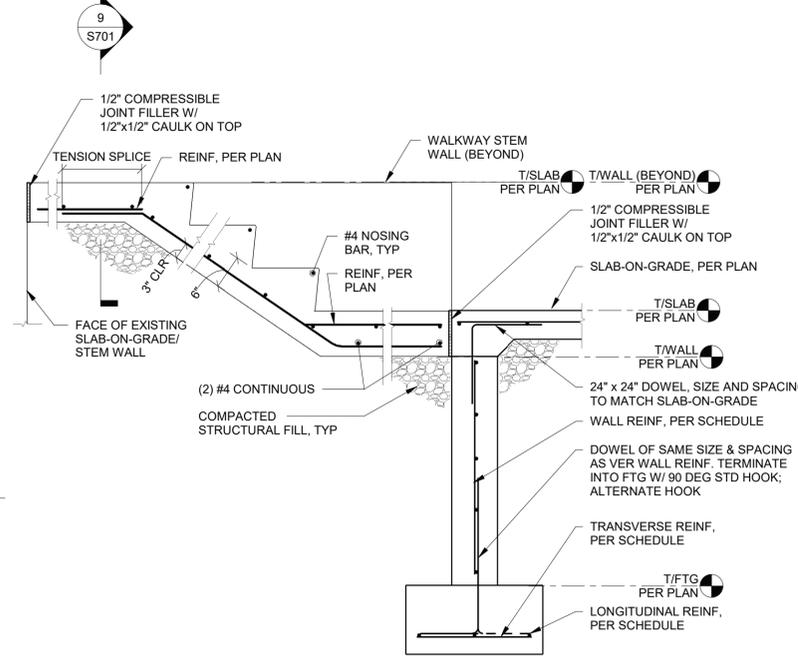


7 DETAIL @ WALKWAY SLAB  
S300 N.T.S

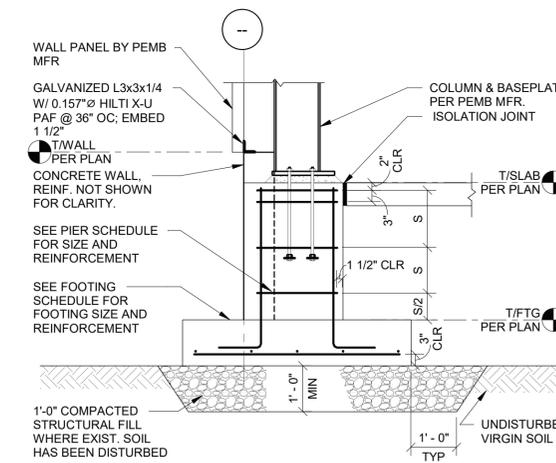


6 PEMB SPREAD FTG WITH PIER  
S300 N.T.S

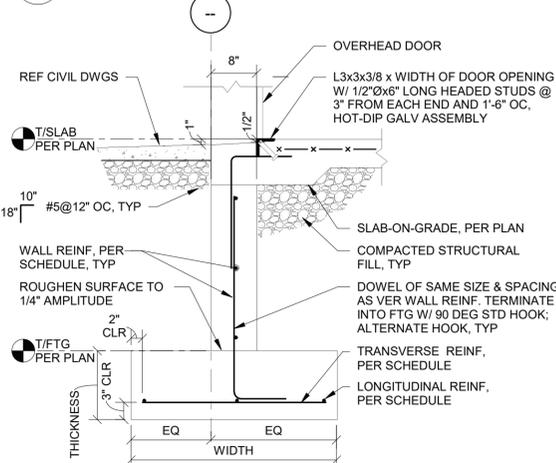


5 TYPICAL FDN DETAIL @ VEHICLE DOOR  
S300 N.T.S

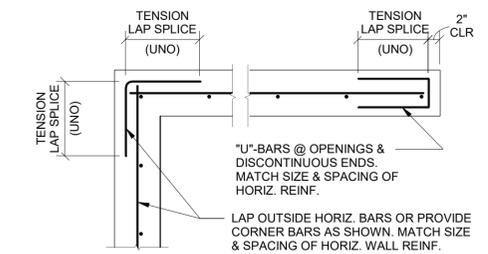


4 TYPICAL CONCRETE WALL CORNER & END DETAIL  
S300 N.T.S

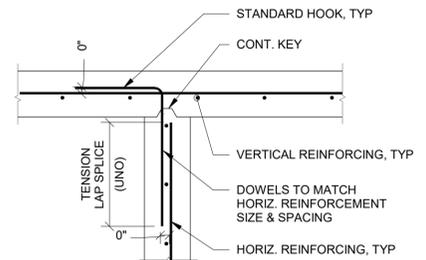

3 TYPICAL CONCRETE WALL INTERSECTION DETAIL  
S300 N.T.S

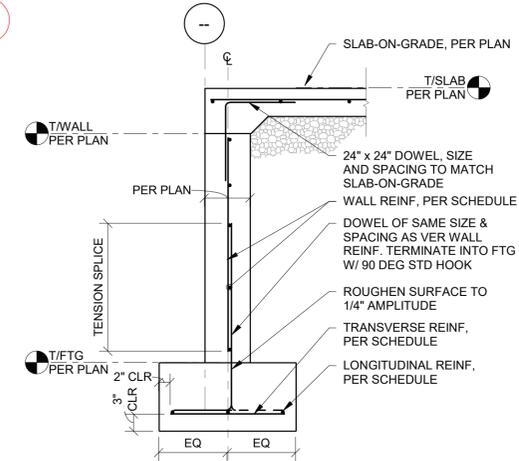


2 TYPICAL FOUNDATION WALL DETAIL  
S300 N.T.S

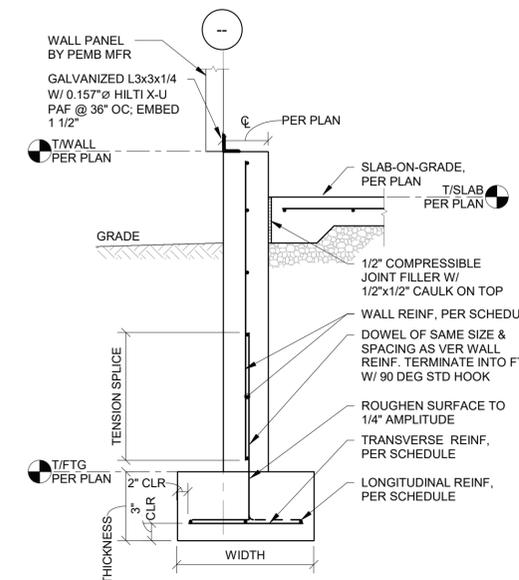

1 TYPICAL FOUNDATION WALL DETAIL  
S300 N.T.S

DATE: 01.23.24  
DRAWN BY: EK  
SCALE: As Indicated  
REVIEWED BY: CAM  
PROJECT NO.: 22-2496  
FILE:

**DELAWARE ENGINEERING, D.P.C.**  
CIVIL AND ENVIRONMENTAL ENGINEERING  
28 MADISON AVENUE EXTENSION, ALBANY, NY 12203 - 518.452.1290  
55 SOUTH MAIN ST., ONEONTA, NY 13820 - 607.432.8073  
16 EAST MARKET ST., RED HOOK, NY 12571 - 518.452.1290  
548 BROADWAY, MONTICELLO, NY 12701 - 845.791.7777  
223 MAIN ST., GOBHEN, NY 10924 - 845.615.9332

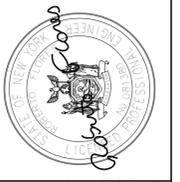


| NO. | DATE       | DESCRIPTION | ADDENDUM #1 |
|-----|------------|-------------|-------------|
| 1   | 11/12/2024 |             |             |

RHINEBECK WTP  
IMPROVEMENTS  
VILLAGE OF RHINEBECK  
DUTCHESS COUNTY, NY

CONCRETE DETAILS

SHEET:  
**S300**


WARNING: IT IS A VIOLATION OF NEW YORK EDUCATION LAW SECTION 2209.2, FOR ANY PERSON UNLESS HE IS ACTING UNDER THE DIRECTION OF A LICENSED PROFESSIONAL ENGINEER OR LAND SURVEYOR, TO ALTER THIS DOCUMENT IN ANY WAY. IF ALTERED THE ALTERING PERSON SHALL COMPLY WITH THE REQUIREMENTS OF NEW YORK EDUCATION LAW, SECTION 2209.2.

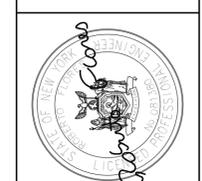


| NO. | DATE       | DESCRIPTION |
|-----|------------|-------------|
| 1   | 11/17/2024 | ADDENDUM #1 |

**RHINEBECK WTP IMPROVEMENTS VILLAGE OF RHINEBECK DUTCHESS COUNTY, NY**


**CONCRETE DETAILS**

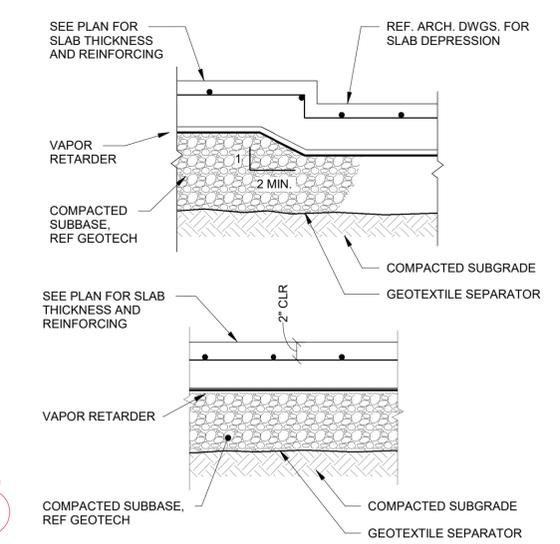

**3 TYPICAL SLAB-ON-GRADE CONSTRUCTION**  
 S301 N.T.S


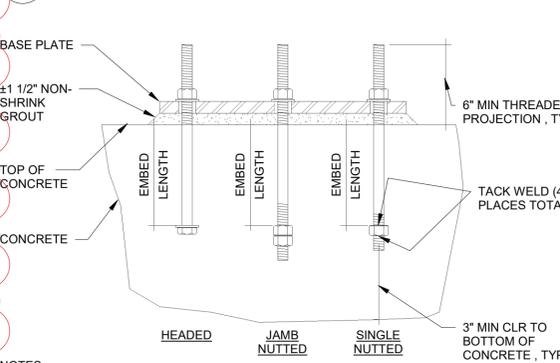


**2 TYPICAL ANCHOR ROD EMBEDMENT DETAIL**  
 S301 N.T.S

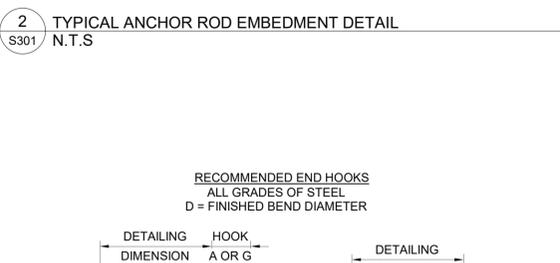


| BAR SIZE | D, IN. | 180° HOOKS, IN. |        | 90° HOOKS, N. |    |
|----------|--------|-----------------|--------|---------------|----|
|          |        | A OR G          | J      | A OR G        | N  |
| #3       | 2 1/4  | 5               | 3      | 6             | 8  |
| #4       | 3      | 6               | 4      | 8             | 10 |
| #5       | 3 3/4  | 7               | 5      | 10            | 12 |
| #6       | 4 1/2  | 8               | 6      | 12            | 14 |
| #7       | 5 1/4  | 10              | 7      | 14            | 16 |
| #8       | 6      | 11              | 8      | 16            | 19 |
| #9       | 9 1/2  | 15              | 11 3/4 | 19            | 22 |
| #10      | 10 3/4 | 17              | 13 1/4 | 22            | 24 |
| #11      | 12     | 19              | 15 3/4 | 24            | 31 |
| #12      | 18 1/4 | 27              | 21 3/4 | 31            |    |




**1 TYPICAL REBAR END HOOK DETAIL**  
 S301 N.T.S

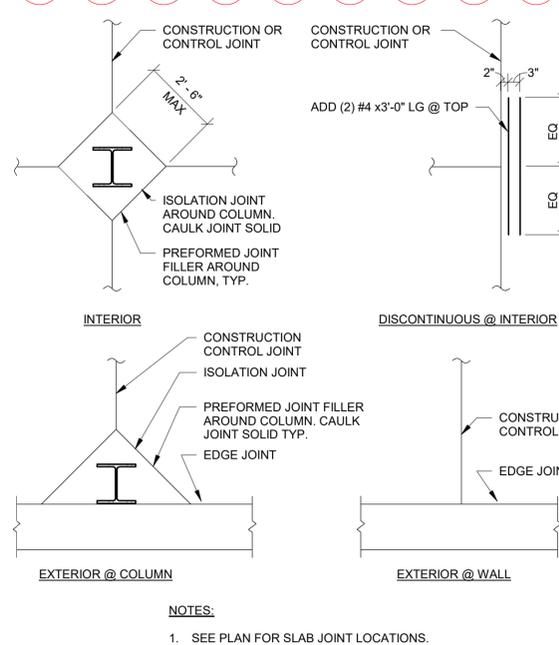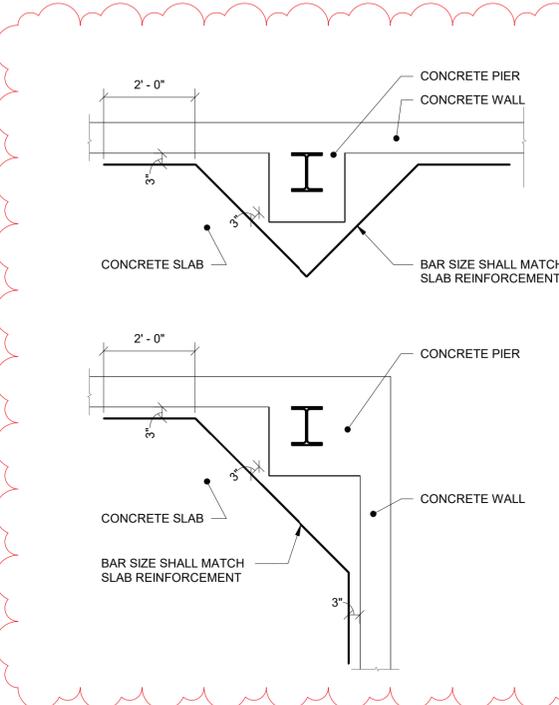


**4 TYPICAL SLAB-ON-GRADE JOINT DETAILS**  
 S301 N.T.S

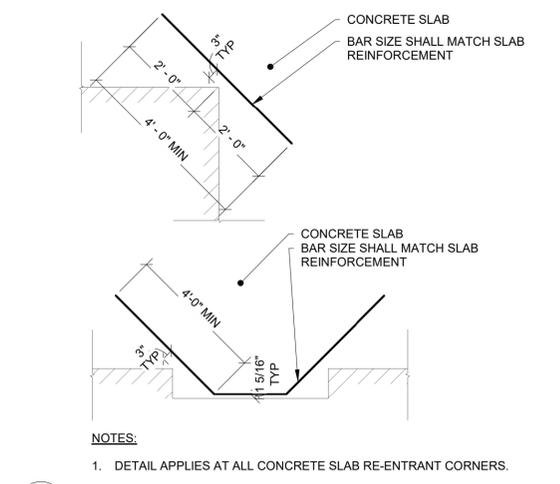


**6 TYPICAL RE-ENTRANT CORNER PLAN DETAILS**  
 S301 N.T.S

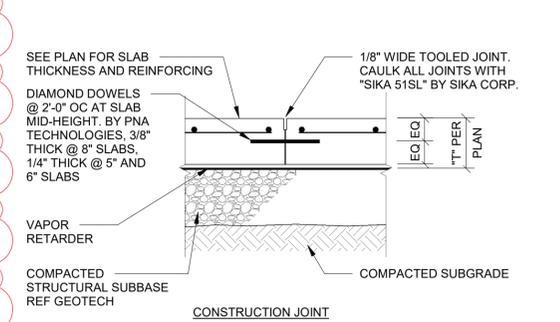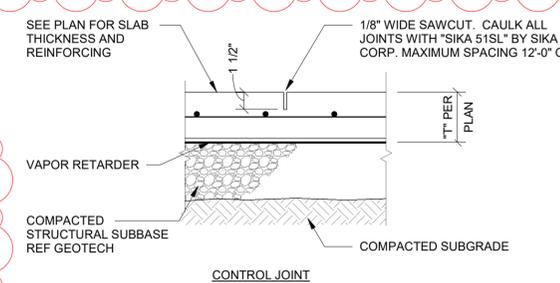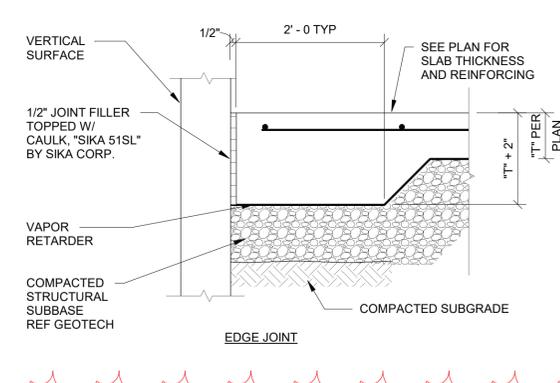


**5 TYPICAL SLAB-ON-GRADE JOINTS**  
 S301 N.T.S

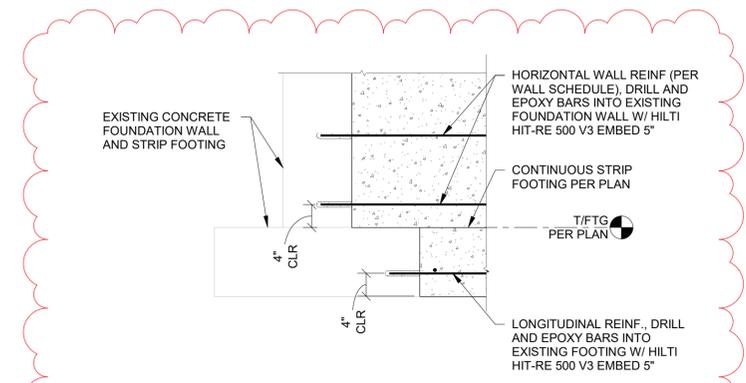

**9 INTERIOR SPREAD FOOTING @ EXISTING FOOTING**  
 S301 N.T.S

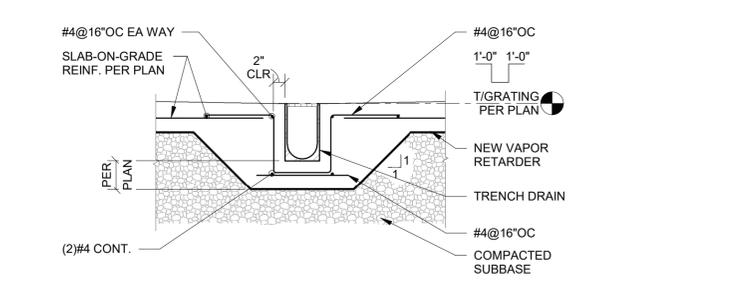

**8 TYPICAL TRENCH DRAIN DETAIL @ NEW SLAB**  
 S301 N.T.S

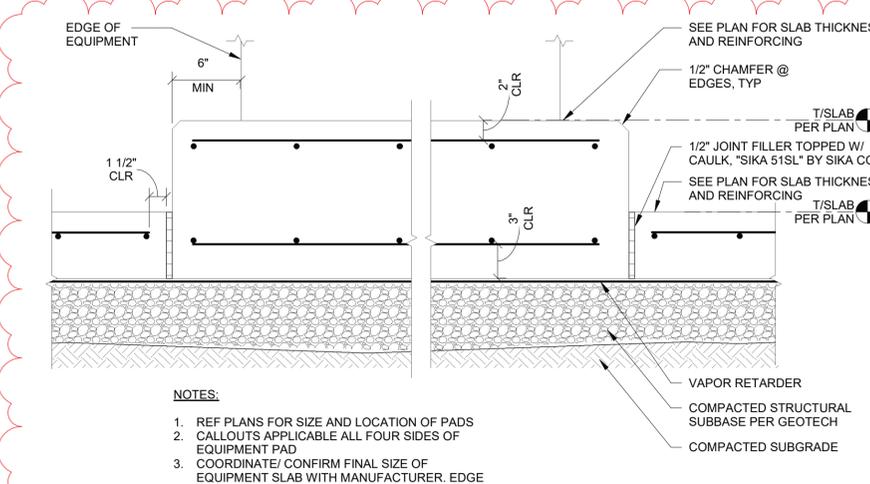


**7 EQUIPMENT SLAB**  
 S301 N.T.S

WARNING: IT IS A VIOLATION OF NEW YORK EDUCATION LAW SECTION 2209.2, FOR ANY PERSON UNLESS HE IS ACTING UNDER THE DIRECTION OF A LICENSED PROFESSIONAL ENGINEER OR LAND SURVEYOR, TO ALTER THIS DOCUMENT IN ANY WAY. IF ALTERED THE ALTERING PERSON SHALL COMPLY WITH THE REQUIREMENTS OF NEW YORK EDUCATION LAW, SECTION 2209.2.

DATE: 01.23.24  
 DRAWN BY: EK  
 SCALE: As indicated  
 REVIEWED BY: CAM  
 PROJECT NO.: 22-2496  
 FILE:

**DELAWARE ENGINEERING, D.P.C.**  
 CIVIL AND ENVIRONMENTAL ENGINEERING  
 28 MADISON AVENUE EXTENSION, ALBANY, NY 12203 - 518.452.1290  
 55 SOUTH MAIN ST., ONEONTA, NY 13820 - 607.432.8073  
 16 EAST MARKET ST., RED HOOK, NY 12571 - 518.452.1290  
 548 BROADWAY, MONTICELLO, NY 12701 - 845.791.7777  
 223 MAIN ST., GOBHEN, NY 10924 - 845.615.9332

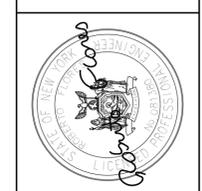


| NO. | DATE       | DESCRIPTION |
|-----|------------|-------------|
| 1   | 11/12/2024 | ADDENDUM #1 |


**RHINEBECK WTP IMPROVEMENTS**  
 VILLAGE OF RHINEBECK  
 DUTCHESS COUNTY, NY

**CFS DETAILS**


SHEET: **S540**

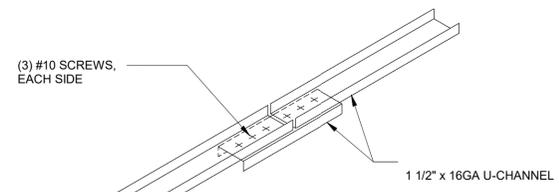


4 CFMF U-BRIDGING SPLICE DETAIL  
 S540 N.T.S

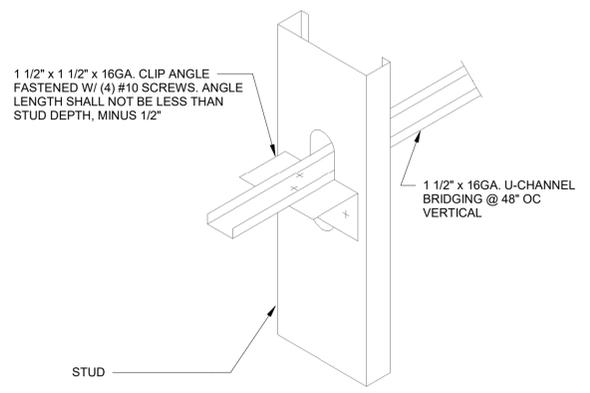


3 CFMF WALL U-BRIDGING CONNECTION  
 S540 N.T.S

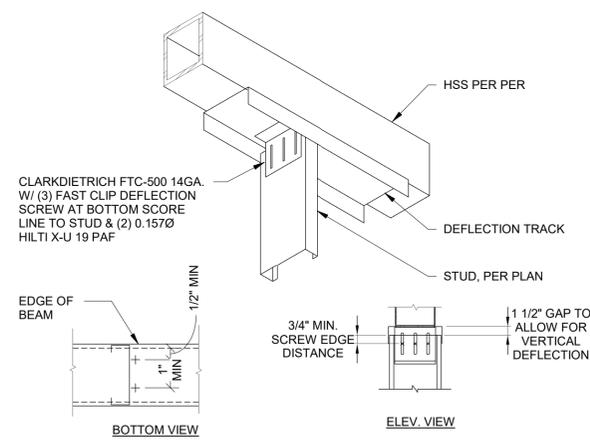

2 CFMF TYPICAL DEFLECTION TRACK @ BEAM  
 S540 N.T.S

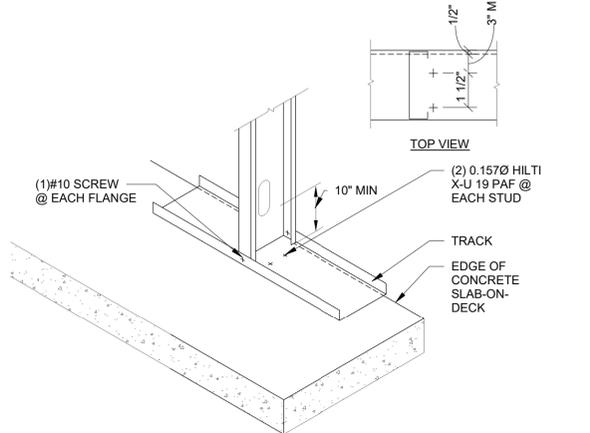


1 CFMF TRACK CONNECTION @ SLAB  
 S540 N.T.S

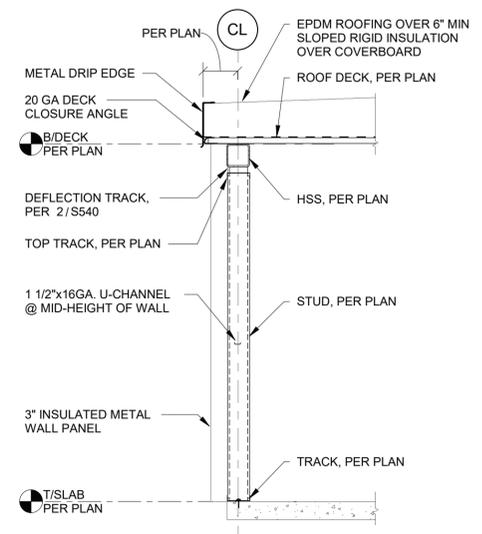


5 CFMF WALL DETAIL  
 S540 N.T.S


WARNING - IT IS A VIOLATION OF NEW YORK EDUCATION LAW SECTION 2209.2, FOR ANY PERSON UNLESS HE IS ACTING UNDER THE DIRECTION OF A LICENSED PROFESSIONAL ENGINEER OR LAND SURVEYOR, TO ALTER THIS DOCUMENT IN ANY WAY. IF ALTERED THE ALTERING PERSON SHALL COMPLY WITH THE REQUIREMENTS OF NEW YORK EDUCATION LAW, SECTION 2209.2.

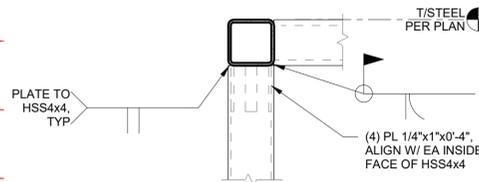


10 FIXED CONNECTION @ HSS  
S701 N.T.S

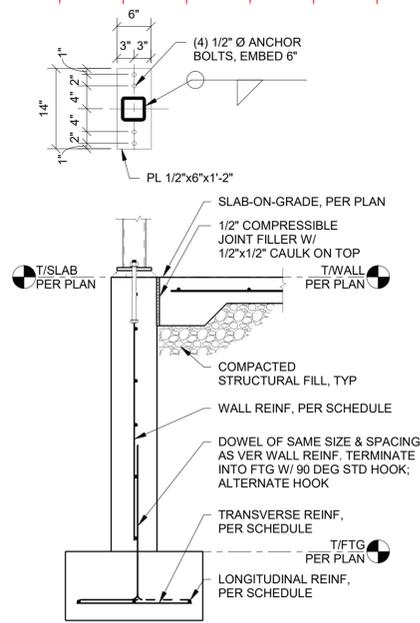

9 DETAIL @ WALKWAY SLAB  
S701 N.T.S

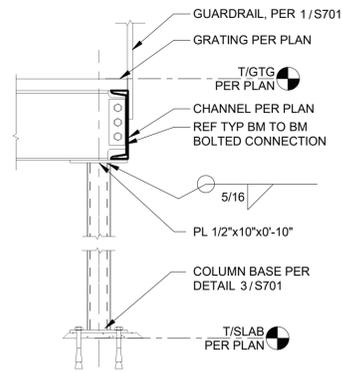


8 POST BASE @ SLAB  
S701 N.T.S

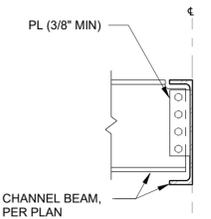


NOTES:  
1. AT ALL BEAM CONNECTIONS, PROVIDE NUMBER OF 3/4\"/>

6 BEAM TO BEAM CONNECTION  
S701 N.T.S

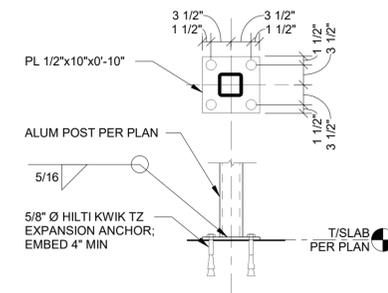


3 POST BASE @ SLAB  
S701 N.T.S

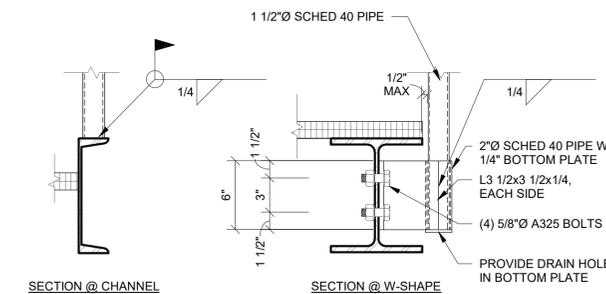


2 TYPICAL GUARDRAIL POST BASE CONNECTIONS  
S701 N.T.S

NOTE:  
ALL GUARDRAIL AND HANDRAIL SHALL BE DESIGNED AND SUBMITTED TO THE ENGINEER AS A DELEGATED SUBMITTAL AS SPECIFIED IN THE GENERAL STRUCTURAL NOTES. THE ELEVATION AND DETAILS SHOWN ARE FOR REFERENCE ONLY.

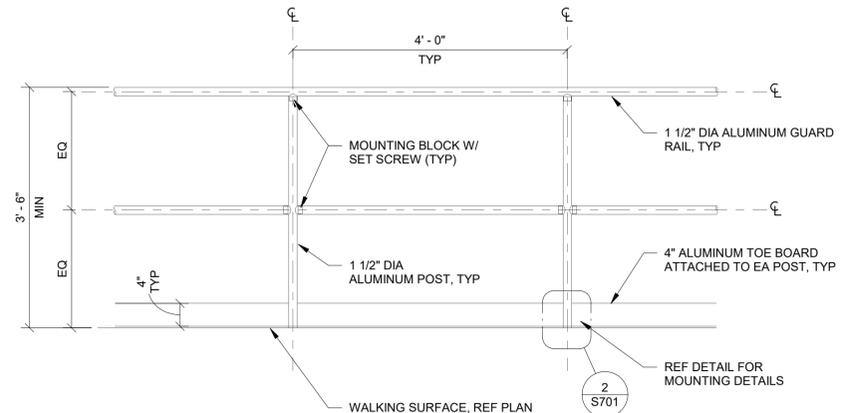


1 TYPICAL GUARDRAIL ELEVATION  
S701 N.T.S


NOTES:  
1. SEAL CONCRETE SURFACE W/ (2) COATS 'SEAL-HARD', BY L-M CONSTRUCTION CHEMICAL CO.  
2. ALL SLAB-ON-GRADE REBAR SHALL BE EPOXY COATED.  
3. SLAB-ON-GRADE, POLE FOOTING NOT BY PANEL MANUF.  
4. REFER TO CIVIL/ELEC FOR LOCATION

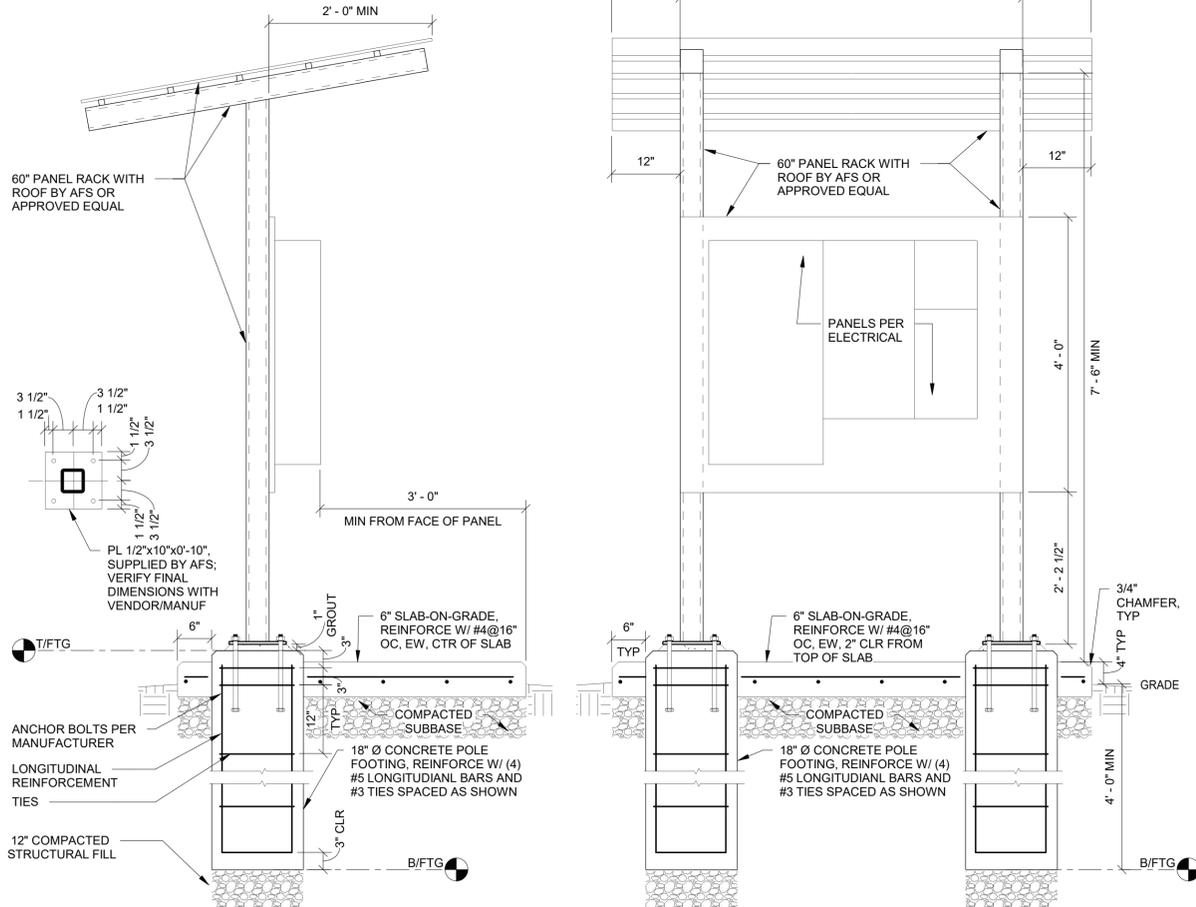

7 ELECTRICAL KIOSK  
S701 N.T.S

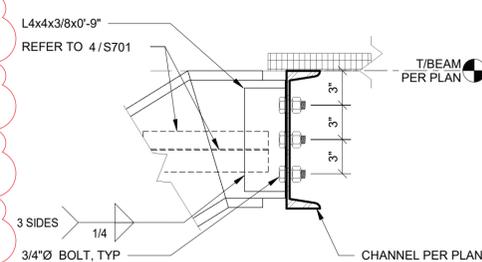

5 STAIR STRINGER CONNECTION  
S701 N.T.S

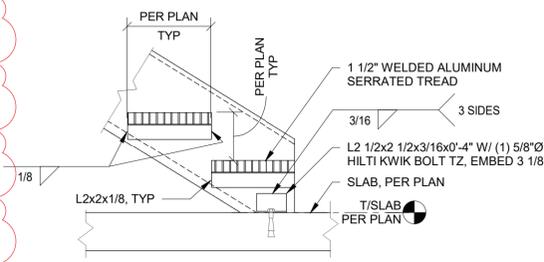

4 STAIR STRINGER @ SLAB  
S701 N.T.S

DATE: 01.23.24  
DRAWN BY: EK  
SCALE: As indicated  
REVIEWED BY: CAM  
PROJECT NO.: 22-2496  
FILE:

**DELAWARE ENGINEERING, D.P.C.**  
CIVIL AND ENVIRONMENTAL ENGINEERING  
28 MADISON AVENUE EXTENSION, ALBANY, NY 12203 - 518.452.1290  
55 SOUTH MAIN ST., ONEONTA, NY 13820 - 607.432.8073  
16 EAST MARKET ST., RED HOOK, NY 12571 - 518.452.1290  
548 BROADWAY, MONTICELLO, NY 12701 - 845.791.7777  
223 MAIN ST., GOUGHEN, NY 10924 - 845.615.9332




| NO. | DATE       | DESCRIPTION |
|-----|------------|-------------|
| 1   | 11/12/2024 | ADDENDUM #1 |

**RHINEBECK WTP IMPROVEMENTS VILLAGE OF RHINEBECK DUTCHESS COUNTY, NY**

**MISC DETAILS**


SHEET: **S701**

WARNING - IT IS A VIOLATION OF NEW YORK EDUCATION LAW SECTION 2209.2, FOR ANY PERSON UNLESS HE IS ACTING UNDER THE DIRECTION OF A LICENSED PROFESSIONAL ENGINEER OR LAND SURVEYOR, TO ALTER THIS DOCUMENT IN ANY WAY. IF ALTERED THE ALTERING PERSON SHALL COMPLY WITH THE REQUIREMENTS OF NEW YORK EDUCATION LAW, SECTION 2209.2.

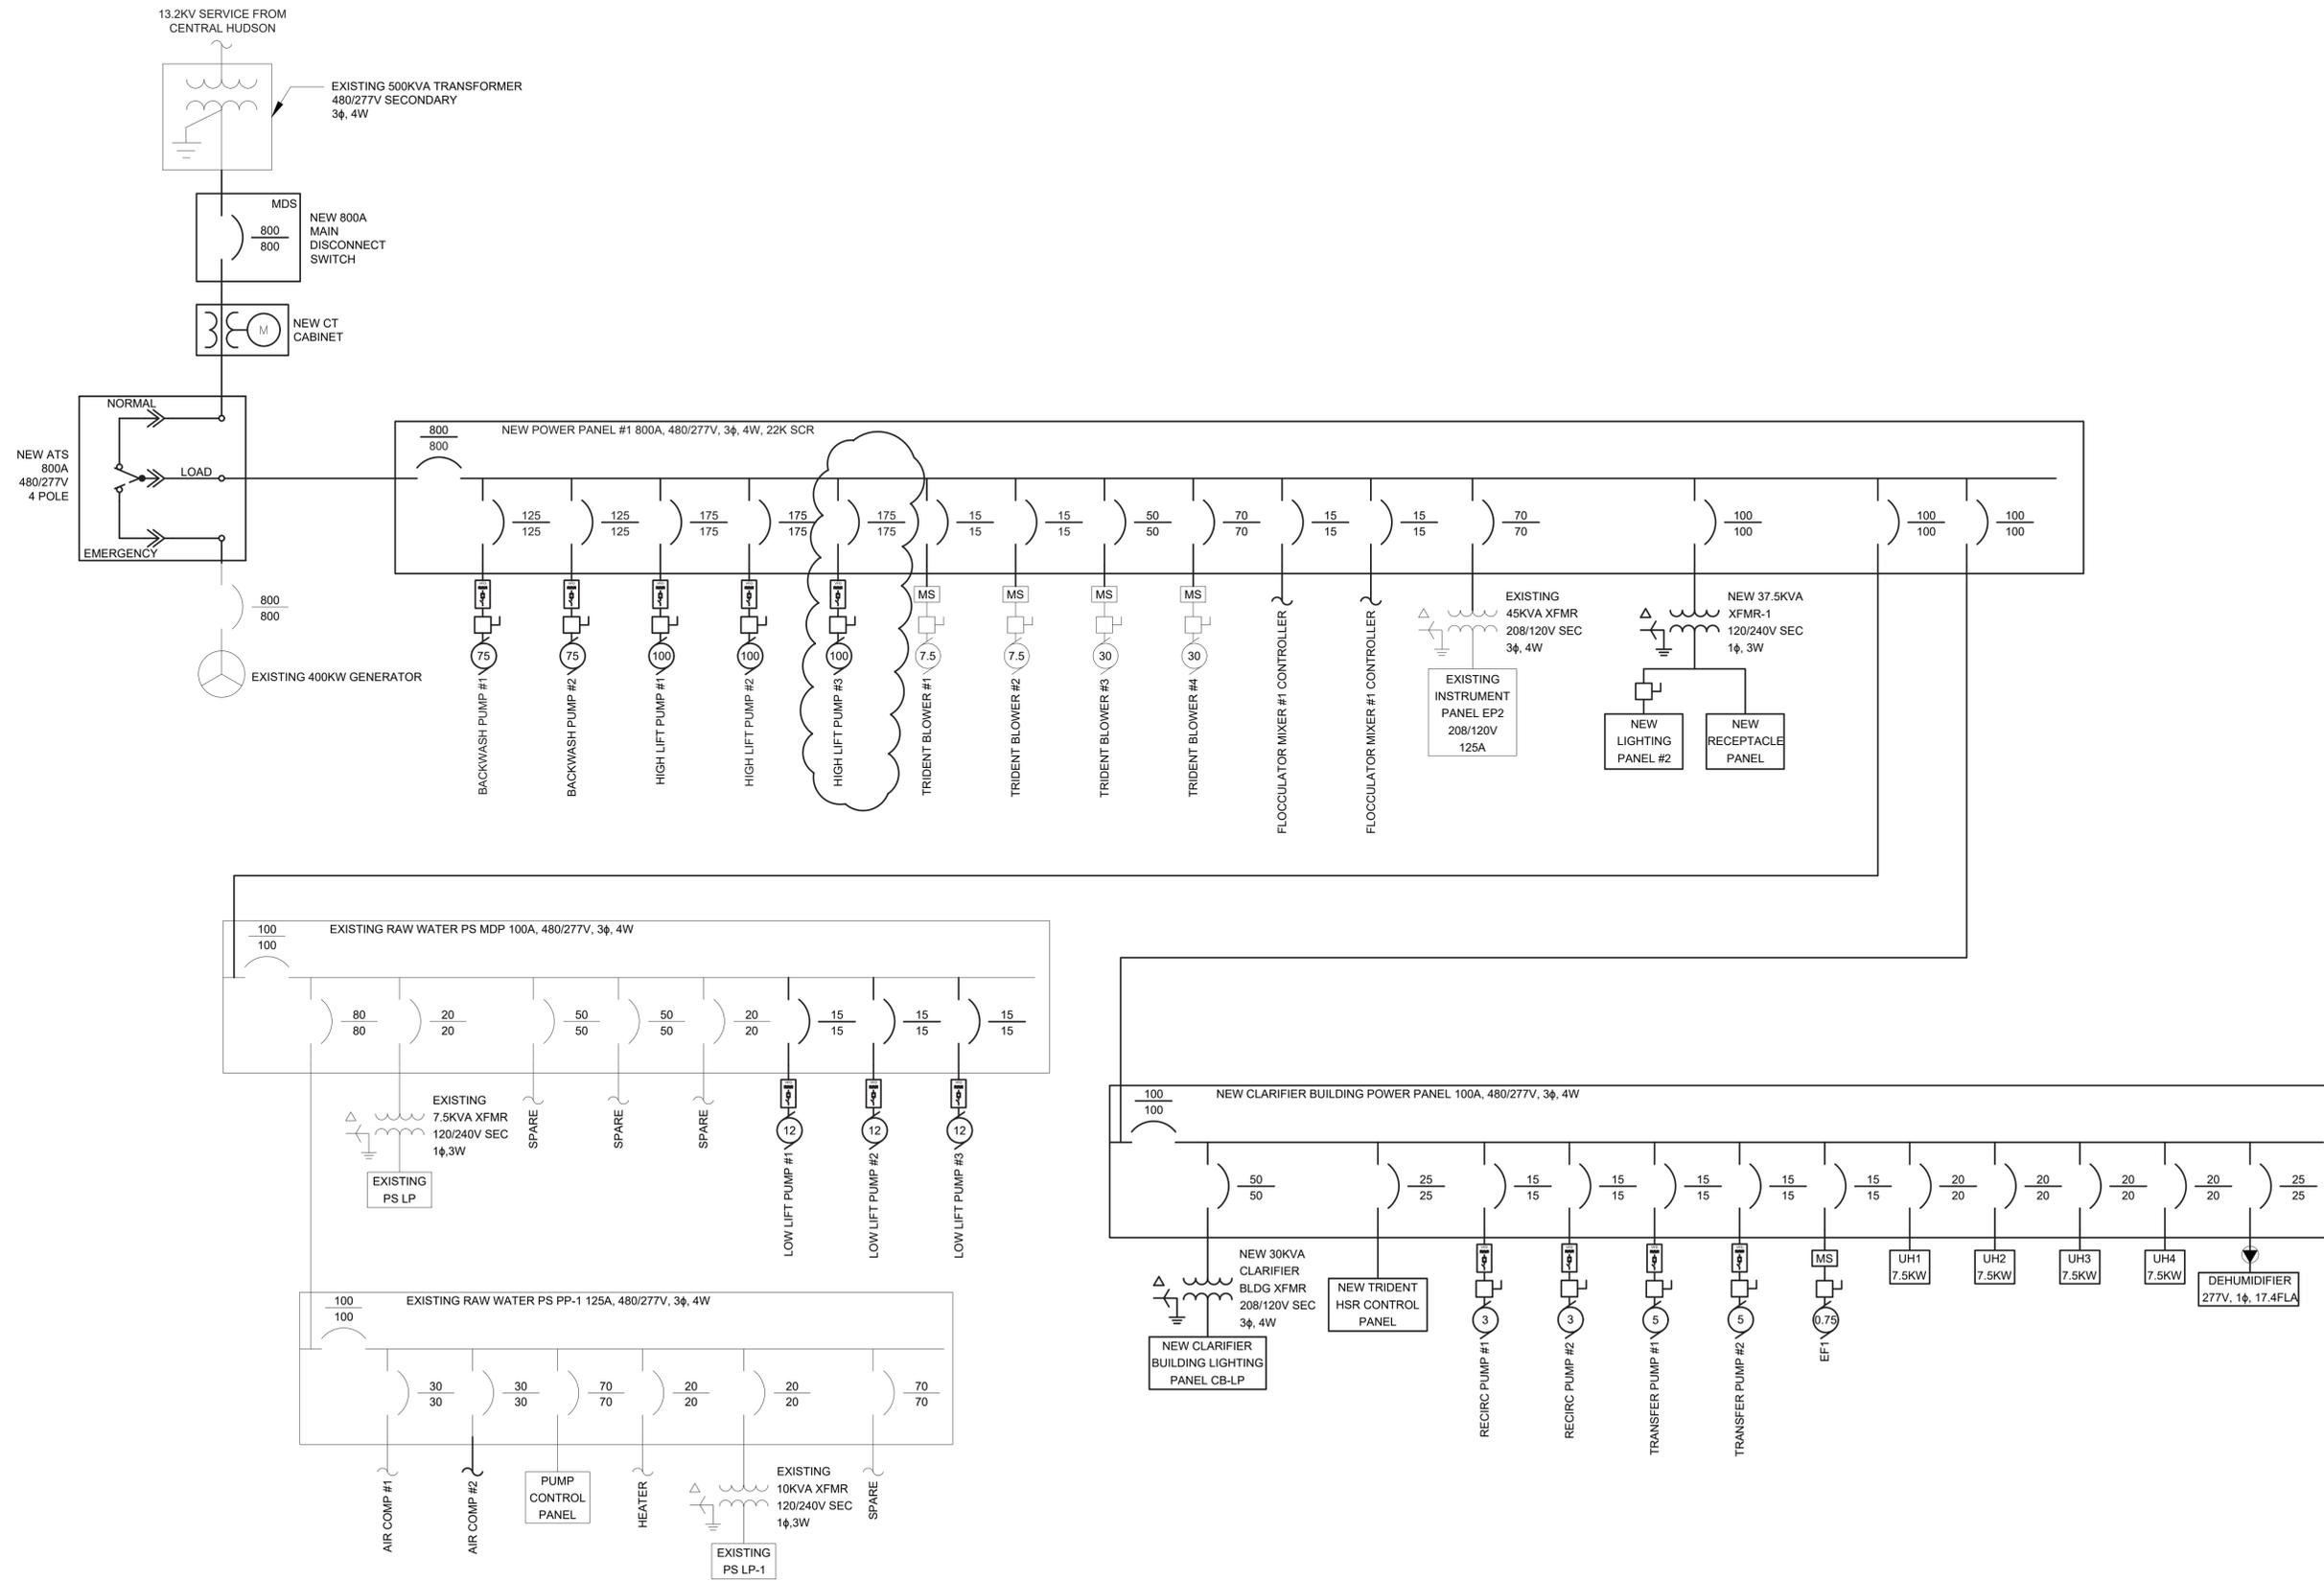

DATE: 10/28/2024  
 DRAWN BY: EMB  
 SCALE: NTS  
 REVIEWED BY: RF  
 PROJECT NO.:  
 FILE:

**DELAWARE ENGINEERING, D.P.C.**  
 CIVIL AND ENVIRONMENTAL ENGINEERING  
 28 MADISON AVENUE EXTENSION, ALBANY, NY 12203 - 518.452.1290  
 55 SOUTH MAIN ST., ONEONTA, NY 13820 - 607.432.8073  
 1000 W. STATE ST., MALDEN, MA 02148 - 617.886.8662  
 8 TOWNSEND STREET, MALDEN, NY 13861 - 518.452.1290  
 16 EAST MARKET ST., RED HOOK, NY 12571 - 518.452.1290  
 548 BROADWAY, MONTICELLO, NY 12070 - 845.791.7777

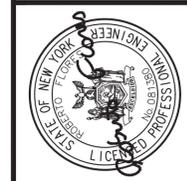

| NO. | DATE     | DESCRIPTION |
|-----|----------|-------------|
| 1.  | 11/01/24 | ADDENDUM #1 |

RHINEBECK WTP  
 PLANT IMPROVEMENTS  
 VILLAGE OF RHINEBECK  
 DUTCHESS COUNTY, NEW YORK

ONE LINE DIAGRAM

SHEET:  
**E-003**


WARNING - IT IS A VIOLATION OF NEW YORK EDUCATION LAW SECTION 7209.2, FOR ANY PERSON, UNLESS HE IS ACTING UNDER THE DIRECTION OF A LICENSED PROFESSIONAL ENGINEER OR LAND SURVEYOR, TO ALTER THIS DOCUMENT IN ANY WAY. IF ALTERED THE ALTERING PERSON SHALL COMPLY WITH THE REQUIREMENTS OF NEW YORK EDUCATION LAW, SECTION 7209.2.

| CONDUIT AND CABLE SCHEDULE |         |       |        |          |                                       |            |                                       |           |
|----------------------------|---------|-------|--------|----------|---------------------------------------|------------|---------------------------------------|-----------|
| CONDUIT                    |         | CABLE |        | PURPOSE  | FROM                                  | VIA        | TO                                    | REMARKS   |
| NO.                        | SIZE    | QTY.  | SIZE   |          |                                       |            |                                       |           |
| A1.1                       | (x2) 4" | 4/EA  | 600MCM | POWER    | UTILITY                               |            | MDS                                   |           |
| A1.2                       | (x2) 4" | 4/EA  | 600MCM | POWER    |                                       |            | CT CABINET                            |           |
| A1.3                       | (x2) 4" | 4/EA  | 600MCM | POWER    |                                       |            | ATS                                   |           |
| A1.4                       | (x2) 3" | 4/EA  | 350MCM | POWER    | EXISTING GENERATOR CONNECTION FEED    |            | ATS                                   | EX CABLES |
| A1.5                       | (x2) 4" | 4/EA  | 600MCM | POWER    |                                       |            | NEW POWER PANEL #1                    |           |
| A2.1                       | 1"      | 4     | #4     | POWER    | NEW POWER PANEL #1                    |            | EXISTING 45KVA XFMR                   |           |
| A2.2                       | 1-1/4"  | 4     | #3     | POWER    | NEW POWER PANEL #1                    |            | NEW 37.5KVA XFMR-1                    |           |
| A2.3                       | 1-1/4"  | 4     | #3     | POWER    | NEW 37.5KVA XFMR-1                    | DISCONNECT | NEW LIGHTING PANEL                    |           |
| A2.4                       | 1-1/4"  | 4     | #3     | POWER    | NEW 37.5KVA XFMR-1                    |            | NEW RECEPTACLE PANEL                  |           |
| B1.1                       | 3/4"    | 4     | #12    | POWER    | NEW POWER PANEL #1                    |            | EXISTING TRIDENT BLOWER #1 MS         |           |
| B1.2                       | 3/4"    | 4     | #12    | POWER    | NEW POWER PANEL #1                    |            | EXISTING TRIDENT BLOWER #2 MS         |           |
| B1.3                       | 3/4"    | 4     | #8     | POWER    | NEW POWER PANEL #1                    |            | EXISTING TRIDENT BLOWER #3 MS         |           |
| B1.4                       | 3/4"    | 4     | #8     | POWER    | NEW POWER PANEL #1                    |            | EXISTING TRIDENT BLOWER #4 MS         |           |
| B2.1                       | 3/4"    | 1     | CAT6   | CONTROL  | FILTER #1 RIO                         |            | MAIN CONTROL PANEL                    |           |
| B2.2                       | 3/4"    | 1     | CAT6   | CONTROL  | FILTER #2 RIO                         |            | MAIN CONTROL PANEL                    |           |
| C1.1                       | 1-1/2"  | 4     | #2     | POWER    | NEW POWER PANEL #1                    |            | NEW CLARIFIER BUILDING POWER PANEL    |           |
| C1.2                       | 3/4"    | 4     | #8     | POWER    | NEW CLARIFIER BUILDING POWER PANEL    |            | NEW CLARIFIER BUILDING XFMR           |           |
| C1.3                       | 1"      | 4     | #2     | POWER    | NEW CLARIFIER BUILDING XFMR           |            | NEW CLARIFIER BUILDING LIGHTING PANEL |           |
| C1.4                       | 3/4"    | 4     | #10    | POWER    | NEW CLARIFIER BUILDING POWER PANEL    |            | NEW TRIDENT HSR CONTROL PANEL         |           |
| C1.5                       | 3/4"    | 1     | CAT6   | CONTROL  | MAIN CONTROL PANEL                    |            | NEW TRIDENT HSR CONTROL PANEL         |           |
| C1.6                       | 3/4"    | 3     | #12    | POWER    | NEW CLARIFIER BUILDING LIGHTING PANEL |            | UNIT A CONTROL PANEL                  |           |
| C1.7                       | 3/4"    | 1     | CAT6   | CONTROL  | NEW TRIDENT HSR CONTROL PANEL         |            | UNIT A CONTROL PANEL                  |           |
| C1.8                       | 3/4"    | 3     | #12    | POWER    | NEW CLARIFIER BUILDING LIGHTING PANEL |            | UNIT B CONTROL PANEL                  |           |
| C1.9                       | 3/4"    | 1     | CAT6   | CONTROL  | NEW TRIDENT HSR CONTROL PANEL         |            | UNIT B CONTROL PANEL                  |           |
| C2.1                       | 3/4"    | 4     | #12    | POWER    | NEW CLARIFIER BUILDING POWER PANEL    |            | CLARIFIER TRANSFER PUMP #1 VFD        |           |
| C2.2                       | 3/4"    | 4     | #12    | POWER    | CLARIFIER TRANSFER PUMP #1 VFD        | DISCONNECT | CLARIFIER TRANSFER PUMP #1            |           |
| C2.3                       | 3/4"    | 1     | CAT6   | CONTROL  | UNIT A CONTROL PANEL                  |            | CLARIFIER TRANSFER PUMP #1 VFD        |           |
| C2.4                       | 3/4"    | 4     | #12    | POWER    | NEW CLARIFIER BUILDING POWER PANEL    |            | RECIRC PUMP #1 VFD                    |           |
| C2.5                       | 3/4"    | 4     | #12    | POWER    | RECIRC PUMP #1 VFD                    | DISCONNECT | RECIRC PUMP #1                        |           |
| C2.6                       | 3/4"    | 1     | CAT6   | CONTROL  | UNIT A CONTROL PANEL                  |            | RECIRC PUMP #1 VFD                    |           |
| C2.7                       | 3/4"    | 4     | #12    | POWER    | UNIT A CONTROL PANEL                  | DISCONNECT | CLARIFIER #1 DRIVE UNIT               |           |
| C3.1                       | 3/4"    | 4     | #12    | POWER    | NEW CLARIFIER BUILDING POWER PANEL    |            | CLARIFIER TRANSFER PUMP #2 VFD        |           |
| C3.2                       | 3/4"    | 4     | #12    | POWER    | CLARIFIER TRANSFER PUMP #2 VFD        | DISCONNECT | CLARIFIER TRANSFER PUMP #2            |           |
| C3.3                       | 3/4"    | 1     | CAT6   | CONTROL  | UNIT B CONTROL PANEL                  |            | CLARIFIER TRANSFER PUMP #2 VFD        |           |
| C3.4                       | 3/4"    | 4     | #12    | POWER    | NEW CLARIFIER BUILDING POWER PANEL    |            | RECIRC PUMP #2 VFD                    |           |
| C3.5                       | 3/4"    | 4     | #12    | POWER    | RECIRC PUMP #2 VFD                    | DISCONNECT | RECIRC PUMP #2                        |           |
| C3.6                       | 3/4"    | 1     | CAT6   | CONTROL  | UNIT B CONTROL PANEL                  |            | RECIRC PUMP #2 VFD                    |           |
| C3.7                       | 3/4"    | 4     | #12    | POWER    | UNIT B CONTROL PANEL                  | DISCONNECT | CLARIFIER #2 DRIVE UNIT               |           |
| C4.1                       | 3/4"    | 3     | #12    | POWER    | NEW CLARIFIER BUILDING LIGHTING PANEL |            | INFLUENT ACTUATED VALVE #1            |           |
| C4.2                       | 3/4"    | 8     | #14    | CONTROL  | UNIT A CONTROL PANEL                  |            | INFLUENT ACTUATED VALVE #1            |           |
| C4.3                       | 3/4"    | 3     | #12    | POWER    | NEW CLARIFIER BUILDING LIGHTING PANEL |            | SLUDGE RECYCLE VALVE #1               |           |
| C4.4                       | 3/4"    | 8     | #14    | CONTROL  | UNIT A CONTROL PANEL                  |            | SLUDGE RECYCLE VALVE #1               |           |
| C4.5                       | 3/4"    | 3     | #12    | POWER    | NEW CLARIFIER BUILDING LIGHTING PANEL |            | SLUDGE BLOWDOWN VALVE #1              |           |
| C4.6                       | 3/4"    | 8     | #14    | CONTROL  | UNIT A CONTROL PANEL                  |            | SLUDGE BLOWDOWN VALVE #1              |           |
| C4.7                       | 3/4"    | 3     | #12    | POWER    | NEW CLARIFIER BUILDING LIGHTING PANEL |            | CLARIFIER TRANSFER VALVE #1           |           |
| C4.8                       | 3/4"    | 8     | #14    | CONTROL  | UNIT A CONTROL PANEL                  |            | CLARIFIER TRANSFER VALVE #1           |           |
| C5.1                       | 3/4"    | 3     | #12    | POWER    | NEW CLARIFIER BUILDING LIGHTING PANEL |            | INFLUENT ACTUATED VALVE #2            |           |
| C5.2                       | 3/4"    | 8     | #14    | CONTROL  | UNIT B CONTROL PANEL                  |            | INFLUENT ACTUATED VALVE #2            |           |
| C5.3                       | 3/4"    | 3     | #12    | POWER    | NEW CLARIFIER BUILDING LIGHTING PANEL |            | SLUDGE RECYCLE VALVE #2               |           |
| C5.4                       | 3/4"    | 8     | #14    | CONTROL  | UNIT B CONTROL PANEL                  |            | SLUDGE RECYCLE VALVE #2               |           |
| C5.5                       | 3/4"    | 3     | #12    | POWER    | NEW CLARIFIER BUILDING LIGHTING PANEL |            | SLUDGE BLOWDOWN VALVE #2              |           |
| C5.6                       | 3/4"    | 8     | #14    | CONTROL  | UNIT B CONTROL PANEL                  |            | SLUDGE BLOWDOWN VALVE #2              |           |
| C5.7                       | 3/4"    | 3     | #12    | POWER    | NEW CLARIFIER BUILDING LIGHTING PANEL |            | CLARIFIER TRANSFER VALVE #2           |           |
| C5.8                       | 3/4"    | 8     | #14    | CONTROL  | UNIT B CONTROL PANEL                  |            | CLARIFIER TRANSFER VALVE #2           |           |
| C6.1                       | 3/4"    | 3     | #12    | POWER    | NEW CLARIFIER BUILDING LIGHTING PANEL |            | INLET METER #1                        |           |
| C6.2                       | 3/4"    | 1     | 16TS   | CONTROL  | UNIT A CONTROL PANEL                  |            | INLET METER #1                        |           |
| C6.3                       | 3/4"    | 3     | #12    | POWER    | NEW CLARIFIER BUILDING LIGHTING PANEL |            | INLET METER #2                        |           |
| C6.4                       | 3/4"    | 1     | 16TS   | CONTROL  | UNIT B CONTROL PANEL                  |            | INLET METER #2                        |           |
| C6.5                       | 3/4"    | 3     | #12    | POWER    | NEW CLARIFIER BUILDING LIGHTING PANEL |            | SLUDGE RECIRC METER #1                |           |
| C6.6                       | 3/4"    | 1     | 16TS   | CONTROL  | UNIT A CONTROL PANEL                  |            | SLUDGE RECIRC METER #1                |           |
| C6.7                       | 3/4"    | 3     | #12    | POWER    | NEW CLARIFIER BUILDING LIGHTING PANEL |            | SLUDGE RECIRC METER #2                |           |
| C6.8                       | 3/4"    | 1     | 16TS   | CONTROL  | UNIT B CONTROL PANEL                  |            | SLUDGE RECIRC METER #2                |           |
| C7.1                       | 3/4"    | 1     | 16TS   | CONTROL  | UNIT A CONTROL PANEL                  |            | LEVEL TRANSMITTER #1                  |           |
| C7.2                       | 3/4"    | 1     | 16TS   | CONTROL  | UNIT B CONTROL PANEL                  |            | LEVEL TRANSMITTER #2                  |           |
| C7.3                       | 3/4"    | 3     | #12    | POWER    | NEW CLARIFIER BUILDING LIGHTING PANEL |            | TURBIDIMETER ASSEMBLY #1              |           |
| C7.4                       | 3/4"    | 1     | 16TS   | CONTROL  | UNIT A CONTROL PANEL                  |            | TURBIDIMETER ASSEMBLY #1              |           |
| C7.5                       | 3/4"    | 1     | VSC    | PWR/CTRL | TURBIDIMETER CONTROLLER #1            |            | TURBIDIMETER SENSOR #1                |           |
| C7.6                       | 3/4"    | 3     | #12    | POWER    | NEW CLARIFIER BUILDING LIGHTING PANEL |            | TURBIDIMETER ASSEMBLY #2              |           |
| C7.7                       | 3/4"    | 1     | 16TS   | CONTROL  | UNIT B CONTROL PANEL                  |            | TURBIDIMETER ASSEMBLY #2              |           |
| C7.8                       | 3/4"    | 1     | VSC    | PWR/CTRL | TURBIDIMETER CONTROLLER #2            |            | TURBIDIMETER SENSOR #2                |           |
| C8.1                       | 3/4"    | 4     | #12    | POWER    | NEW CLARIFIER BUILDING LIGHTING PANEL |            | DOOR OPENER MOTOR                     |           |
| C8.2                       | 3/4"    | 6     | #14    | CONTROL  | DOOR OPENER CONTROLLER                |            | DOOR OPENER MOTOR                     |           |


| CONDUIT AND CABLE SCHEDULE |        |       |       |          |                                    |            |                                  |              |
|----------------------------|--------|-------|-------|----------|------------------------------------|------------|----------------------------------|--------------|
| CONDUIT                    |        | CABLE |       | PURPOSE  | FROM                               | VIA        | TO                               | REMARKS      |
| NO.                        | SIZE   | QTY.  | SIZE  |          |                                    |            |                                  |              |
| D1.1                       | 3/4"   | 3     | #12   | POWER    | NEW POWER PANEL #1                 |            | FLOCCULATOR MIXER #1 CONTROLLER  |              |
| D1.2                       | 3/4"   | 3     | #12   | POWER    | NEW POWER PANEL #1                 |            | FLOCCULATOR MIXER #2 CONTROLLER  |              |
| P1.1                       | 2"     | 4     | 2/0   | POWER    | NEW POWER PANEL #1                 |            | NEW HIGH SERVICE PUMP #1 VFD     |              |
| P1.2                       | 2"     | 4     | 2/0   | POWER    | NEW HIGH SERVICE PUMP #1 VFD       | DISCONNECT | NEW HIGH SERVICE PUMP #1         |              |
| P1.3                       | 3/4"   | 1     | CAT6  | CONTROL  | MAIN CONTROL PANEL                 |            | NEW HIGH SERVICE PUMP #1 VFD     |              |
| P1.4                       | 3/4"   | 4     | #14   | CONTROL  | MAIN CONTROL PANEL                 |            | HIGH SERVICE PUMP #1 CHECK VALVE | LIMIT SWITCH |
| P2.1                       | 2"     | 4     | 2/0   | POWER    | NEW POWER PANEL #1                 |            | NEW HIGH SERVICE PUMP #2 VFD     |              |
| P2.2                       | 2"     | 4     | 2/0   | POWER    | NEW HIGH SERVICE PUMP #2 VFD       | DISCONNECT | NEW HIGH SERVICE PUMP #2         |              |
| P2.3                       | 3/4"   | 1     | CAT6  | CONTROL  | MAIN CONTROL PANEL                 |            | NEW HIGH SERVICE PUMP #2 VFD     |              |
| P2.4                       | 3/4"   | 4     | #14   | CONTROL  | MAIN CONTROL PANEL                 |            | HIGH SERVICE PUMP #2 CHECK VALVE | LIMIT SWITCH |
| P3.1                       | 2"     | 4     | 2/0   | POWER    | NEW POWER PANEL #1                 |            | NEW HIGH SERVICE PUMP #3 VFD     |              |
| P3.2                       | 2"     | 4     | 2/0   | POWER    | NEW HIGH SERVICE PUMP #3 VFD       | DISCONNECT | NEW HIGH SERVICE PUMP #3         |              |
| P3.3                       | 3/4"   | 1     | CAT6  | CONTROL  | MAIN CONTROL PANEL                 |            | NEW HIGH SERVICE PUMP #3 VFD     |              |
| P3.4                       | 3/4"   | 4     | #14   | CONTROL  | MAIN CONTROL PANEL                 |            | HIGH SERVICE PUMP #3 CHECK VALVE | LIMIT SWITCH |
| P4.1                       | 1-1/4" | 4     | #1    | POWER    | NEW POWER PANEL #1                 |            | NEW BACKWASH PUMP #1 VFD         |              |
| P4.2                       | 1-1/4" | 4     | #1    | POWER    | NEW BACKWASH PUMP #1 VFD           | DISCONNECT | NEW BACKWASH PUMP #1             |              |
| P4.3                       | 3/4"   | 1     | CAT6  | CONTROL  | MAIN CONTROL PANEL                 |            | NEW BACKWASH PUMP #1 VFD         |              |
| P5.1                       | 1-1/4" | 4     | #1    | POWER    | NEW POWER PANEL #1                 |            | NEW BACKWASH PUMP #2 VFD         |              |
| P5.2                       | 1-1/4" | 4     | #1    | POWER    | NEW BACKWASH PUMP #2 VFD           | DISCONNECT | NEW BACKWASH PUMP #2             |              |
| P5.3                       | 3/4"   | 1     | CAT6  | CONTROL  | MAIN CONTROL PANEL                 |            | NEW BACKWASH PUMP #2 VFD         |              |
| L1.1                       | 1-1/2" | 4     | #2    | POWER    | NEW POWER PANEL #1                 |            | EXISTING RAW WATER PS MDP        |              |
| L1.2                       | 2"     | 1     | FIBER | CONTROL  | MAIN CONTROL PANEL                 |            | NEW RAW WATER CONTROL PANEL      |              |
| L1.3                       | 3/4"   | 3     | #12   | POWER    | EXISTING PS LP-1                   |            | NEW RAW WATER CONTROL PANEL      |              |
| L2.1                       | 3/4"   | 4     | #8    | POWER    | EXISTING RAW WATER PS MDP          |            | NEW RAW WATER PUMP #1 VFD        |              |
| L2.2                       | 3/4"   | 4     | #8    | POWER    | NEW RAW WATER PUMP #1 VFD          |            | NEW RAW WATER PUMP #1            |              |
| L2.3                       | 3/4"   | 1     | CAT6  | CONTROL  | NEW RAW WATER PUMP #1 VFD          |            | NEW RAW WATER CONTROL PANEL      |              |
| L2.4                       | 3/4"   | 8     | #14   | CONTROL  | NEW RAW WATER PUMP #1 VFD          |            | NEW RAW WATER PUMP #1 THERM/SEAL |              |
| L3.1                       | 3/4"   | 4     | #8    | POWER    | EXISTING RAW WATER PS MDP          |            | NEW RAW WATER PUMP #2 VFD        |              |
| L3.2                       | 3/4"   | 4     | #8    | POWER    | NEW RAW WATER PUMP #2 VFD          |            | NEW RAW WATER PUMP #2            |              |
| L3.3                       | 3/4"   | 1     | CAT6  | CONTROL  | NEW RAW WATER PUMP #2 VFD          |            | NEW RAW WATER CONTROL PANEL      |              |
| L3.4                       | 3/4"   | 8     | #14   | CONTROL  | NEW RAW WATER PUMP #2 VFD          |            | NEW RAW WATER PUMP #2 THERM/SEAL |              |
| L4.1                       | 3/4"   | 4     | #8    | POWER    | EXISTING RAW WATER PS MDP          |            | NEW LOW LIFT PUMP #3 VFD         |              |
| L4.2                       | 3/4"   | 4     | #8    | POWER    | NEW RAW WATER PUMP #3 VFD          |            | NEW RAW WATER PUMP #3            |              |
| L4.3                       | 3/4"   | 1     | CAT6  | CONTROL  | NEW RAW WATER PUMP #3 VFD          |            | NEW RAW WATER CONTROL PANEL      |              |
| L4.4                       | 3/4"   | 8     | #14   | CONTROL  | NEW RAW WATER PUMP #3 VFD          |            | NEW RAW WATER PUMP #3 THERM/SEAL |              |
| L5.1                       | 3/4"   | 4     | #14   | CONTROL  | NEW RAW WATER CONTROL PANEL        |            | EXISTING AIR COMPRESSOR CP 1     |              |
| L5.2                       | 3/4"   | 4     | #14   | CONTROL  | NEW RAW WATER CONTROL PANEL        |            | EXISTING AIR COMPRESSOR CP 2     |              |
| M1.1                       | 3/4"   | 3     | #12   | POWER    | PUMP STATION PANEL                 |            | MIXER MS/DC                      |              |
| M1.2                       | 3/4"   | 10    | #14   | CONTROL  | PUMP STATION PANEL                 |            | MIXER CONTROL PANEL              |              |
| M1.3                       | 3/4"   | 4     | #12   | POWER    | MIXER CONTROL PANEL                |            | MIXER                            |              |
| M1.4                       | 3/4"   | 10    | #14   | CONTROL  | MIXER CONTROL PANEL                |            | MIXER                            |              |
| U1.1                       | 3/4"   | 3     | #8    | POWER    | EXISTING INSTRUMENT POWER PANEL    |            | UV CP #1                         |              |
| U1.2                       | 3/4"   | 1     | CAT6  | CONTROL  | MAIN CONTROL PANEL                 |            | UV CP #1                         |              |
| U1.3                       | 3/4"   | -     | VSC   | PWR/CTRL | UV CP #1                           |            | UV UNIT #1                       |              |
| U2.1                       | 3/4"   | 3     | #8    | POWER    | EXISTING INSTRUMENT POWER PANEL    |            | UV CP #2                         |              |
| U2.2                       | 3/4"   | 1     | CAT6  | CONTROL  | MAIN CONTROL PANEL                 |            | UV CP #2                         |              |
| U2.3                       | 3/4"   | -     | VSC   | PWR/CTRL | UV CP #2                           |            | UV UNIT #2                       |              |
| F1.1                       | 3/4"   | 3     | #12   | POWER    | EXISTING INSTRUMENT POWER PANEL    |            | NEW EFFLUENT FM TRANSMITTER      |              |
| F1.2                       | 3/4"   | 1     | 16TS  | CONTROL  | MAIN CONTROL PANEL                 |            | NEW EFFLUENT FM TRANSMITTER      |              |
| F1.3                       | 3/4"   | 1     | VSC   | PWR/CTRL | NEW EFFLUENT FM TRANSMITTER        |            | NEW EFFLUENT FLOW METER          |              |
| F2.1                       | 3/4"   | 3     | #12   | POWER    | EXISTING INSTRUMENT POWER PANEL    |            | NEW CLARIFIER FLOW CONTROL VALVE |              |
| F2.2                       | 3/4"   | 8     | #14   | CONTROL  | MAIN CONTROL PANEL                 |            | NEW CLARIFIER FLOW CONTROL VALVE |              |
| H1.1                       | 3/4"   | 4     | #12   | POWER    | NEW CLARIFIER BUILDING POWER PANEL | MS/DC      | EF1                              |              |
| H1.2                       | 3/4"   | 3     | #12   | POWER    | LV1                                |            | EF1 MS/DC                        |              |
| H1.3                       | 3/4"   | 3     | #12   | POWER    | LV2                                |            | EF1 MS/DC                        |              |
| H1.4                       | 3/4"   | 2     | #12   | CONTROL  | TSTAT                              |            | EF1 MS/DC                        |              |
| H1.5                       | 3/4"   | 2     | #12   | CONTROL  | HSTAT                              |            | EF1 MS/DC                        |              |
| H2.1                       | 3/4"   | 4     | #12   | POWER    | NEW CLARIFIER BUILDING POWER PANEL | DISCONNECT | UH1                              |              |
| H2.2                       | 3/4"   | 4     | #12   | POWER    | NEW CLARIFIER BUILDING POWER PANEL | DISCONNECT | UH2                              |              |
| H2.3                       | 3/4"   | 2     | #12   | CONTROL  | TSTAT                              |            | UH1                              |              |
| H2.4                       | 3/4"   | 2     | #12   | CONTROL  | TSTAT                              |            | UH2                              |              |
| H2.5                       | 3/4"   | 4     | #12   | POWER    | NEW CLARIFIER BUILDING POWER PANEL | DISCONNECT | UH3                              |              |
| H2.6                       | 3/4"   | 4     | #12   | POWER    | NEW CLARIFIER BUILDING POWER PANEL | DISCONNECT | UH4                              |              |
| H2.7                       | 3/4"   | 2     | #12   | CONTROL  | TSTAT                              |            | UH3                              |              |
| H2.8                       | 3/4"   | 2     | #12   | CONTROL  | TSTAT                              |            | UH4                              |              |
| H3.1                       | 3/4"   | 3     | #12   | POWER    | NEW CLARIFIER BUILDING POWER PANEL |            | DEHUMIDIFIER 277V RECEPTACLE     |              |
| H3.2                       | 3/4"   | 2     | #12   | CONTROL  | DEHUMIDIFIER                       |            | DEHUMIDIFIER HSTAT               |              |

DATE: 10/28/2024  
DRAWN BY: EMB  
SCALE: NTS  
REVIEWED BY: RF  
PROJECT NO.:  
FILE:

**DELAWARE ENGINEERING D.P.C.**  
CIVIL AND ENVIRONMENTAL ENGINEERING  
28 MADISON AVENUE EXTENSION, ALBANY, NY 12203 - 518.452.1200  
55 SOUTH MAIN ST. ONEONTA, NY 13820 - 607.432.8073  
1000 W. STATE ST. ALBANY, NY 12206 - 518.452.1200  
6 TOWNSEND STREET, WALLINGFORD, NY 13856 - 607.866.9262  
16 EAST MARKET ST., RED HOOK, NY 12571 - 518.452.1200  
548 BROADWAY, MONTICELLO, NY 12701 - 845.791.7777

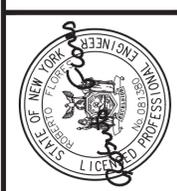


| NO. | DATE |
|-----|------|
|-----|------|

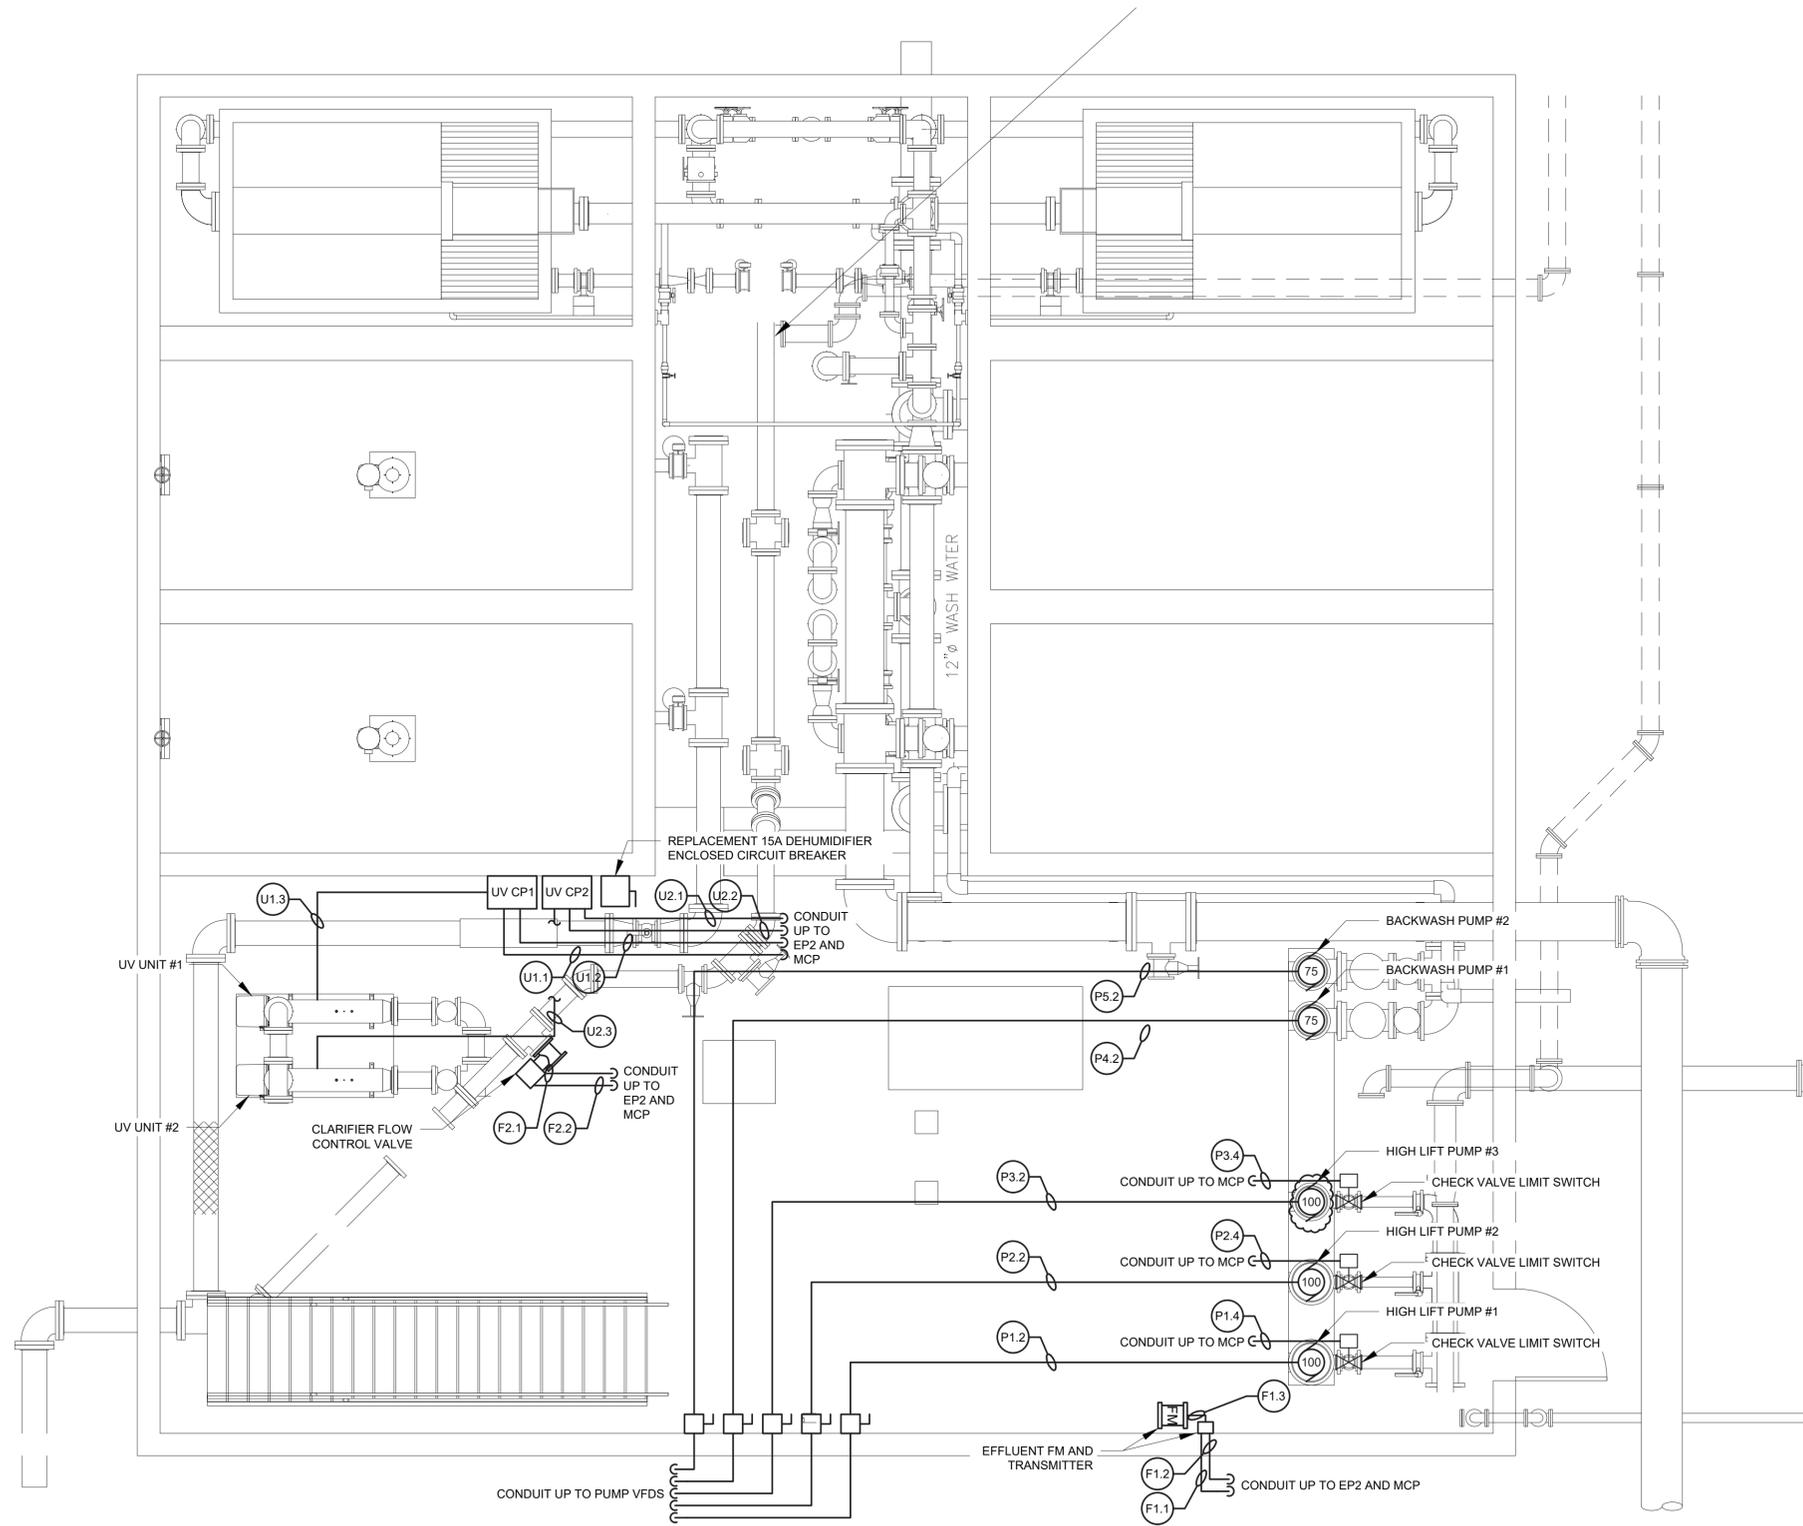

DATE: 10/28/2024  
 DRAWN BY: EMB  
 SCALE: AS SHOWN  
 REVIEWED BY: RF  
 PROJECT NO.:  
 FILE:

**DELAWARE ENGINEERING, D.P.C.**  
 CIVIL AND ENVIRONMENTAL ENGINEERING  
 28 MADISON AVENUE EXTENSION, ALBANY, NY 12203 - 518.452.1290  
 55 SOUTH MAIN ST. ONEONTA, NY 13820 - 607.432.8073  
 1100 STATE ST. MALDEN, MA 02148 - 617.878.6662  
 8 TOWNSEND STREET, MALDEN, NY 13851 - 607.866.9292  
 16 EAST MARKET ST., RED HOOK, NY 12571 - 518.452.1290  
 548 BROADWAY, MONTICELLO, NY 12071 - 845.791.7777

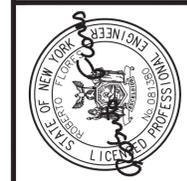

| NO. | DATE     | DESCRIPTION |
|-----|----------|-------------|
| 1.  | 11/01/24 | ADDENDUM #1 |

RHINEBECK WTP  
 PLANT IMPROVEMENTS  
 VILLAGE OF RHINEBECK  
 DUTCHESS COUNTY, NEW YORK

LOWER LEVEL  
 ELECTRICAL PLAN

SHEET:  
**E-104**

WARNING - IT IS A VIOLATION OF NEW YORK EDUCATION LAW SECTION 2209.2, FOR ANY PERSON, UNLESS HE IS ACTING UNDER THE DIRECTION OF A LICENSED PROFESSIONAL ENGINEER OR LAND SURVEYOR, TO ALTER THIS DOCUMENT IN ANY WAY. IF ALTERED THE ALTERING PERSON SHALL COMPLY WITH THE REQUIREMENTS OF NEW YORK EDUCATION LAW, SECTION 2209.2.

Belt Drive Upblast Centrifugal Wall Exhaust Fan

| MARK INFORMATION |      | FAN INFORMATION |              |                           |         |                      |              | MOTOR INFORMATION |          |           |          |          |          |       |
|------------------|------|-----------------|--------------|---------------------------|---------|----------------------|--------------|-------------------|----------|-----------|----------|----------|----------|-------|
| QTY              | MARK | MODEL           | VOLUME (CFM) | TOTAL EXTERNAL SP (IN WG) | FAN RPM | OPERATING POWER (HP) | WEIGHT (LB.) | SIZE (HP)         | V/CP     | ENCLOSURE | MOTORRPM | WINDINGS | NEC FLA* | SONES |
| 1                | EF1  | CUBE-300-7      | 5,300        | 0.29                      | 415     | 0.54                 | 216          | 0.75              | 460/60/3 | TF        | 1725     | 1        | 1.6      | 7.3   |

\*NEC FLA - Based on table 430.250 or 430.248 of National Electrical Code 2020. Actual motor FLA may vary for sizing thermal overload, consult factory\*

EF1 : SELECTED OPTIONS AND ACCESSORIES

- Standard Curb Cap Size - 40 Square
- Sidewall Mounting - Fan Configured for Wall-Mounted Applications
- Curb will be Through Wall, 6 in. Wall Thickness
- UL/cUL 705 Listed - "Power Ventilators"
- Switch, NEMA-1, Toggle,
- Foam Curb Seal (Factory Applied)
- Damper Shipped Loose, WD-330-PB-34X34, Gravity Operated, Coated, Nominal Size
- Coated with Permatector, Concrete Gray-RAL 7023, Fan And Attached Acc
- Hood Hasps
- Stainless Steel Fasteners - 300 Series
- Stainless Steel Shaft - 300 Series
- Wiring Pigtail, Internal, General, 9 ft from Unit of Flexible Metal Conduit
- Birdscreen: Stainless Steel, nom. 69% Free Area
- Bearings with Grease Fittings, L10 life of 100,000 hrs (L50 avg. life 500,000 hrs)
- Conduit Chase Qty 1

LOUVER SCHEDULE

| MARK TYPE | ID # | TAG | QTY | MODEL   | WIDTH | HEIGHT |
|-----------|------|-----|-----|---------|-------|--------|
| LV1       | 1-1  | LV1 | 2   | ECD-601 | 32    | 40     |

UNIT HEATER SCHEDULE


| ID   | LOCATION       | MANUFACTURER & MODEL NUMBER | TYP        | KW  | BTU    | AIRFLOW (CFM) | VOLT/PH/HZ | MAX MTG HGT (FT) | NOTES                             |
|------|----------------|-----------------------------|------------|-----|--------|---------------|------------|------------------|-----------------------------------|
| UH-1 | CLARIFIER BLDG | MODINE NEW-480360-075       | HORIZONTAL | 7.5 | 25,600 | 700           | 460/3/60   | 8.5              | NEW ADJUSTABLE WALL MOUNT BRACKET |
| UH-2 | CLARIFIER BLDG | MODINE NEW-480360-075       | HORIZONTAL | 7.5 | 25,600 | 700           | 460/3/60   | 8.5              | NEW ADJUSTABLE WALL MOUNT BRACKET |
| UH-3 | CLARIFIER BLDG | MODINE NEW-480360-075       | HORIZONTAL | 7.5 | 25,600 | 700           | 460/3/60   | 8.5              | NEW ADJUSTABLE WALL MOUNT BRACKET |
| UH-4 | CLARIFIER BLDG | MODINE NEW-480360-075       | HORIZONTAL | 7.5 | 25,600 | 700           | 460/3/60   | 8.5              | NEW ADJUSTABLE WALL MOUNT BRACKET |

DEHUMIDIFIER SCHEDULE


| CAPACITY          | LOCATION       | MANUFACTURER & MODEL NUMBER | TYP        | KW   | BTU/H  | AIRFLOW (CFM) | VOLT/PH/HZ | NOTES  |
|-------------------|----------------|-----------------------------|------------|------|--------|---------------|------------|--|
| PPD AT 80%/60% RH | CLARIFIER BLDG | ANDEN A710V3                | HORIZONTAL | 6.35 | 16,168 | 700           | 277/1/60   | CEILING HANGERS AND WALL MOUNTS INCLUDED AS NEEDED<br>PROVIDE A HARD-PIPE PVC DRIP LINE TO THE PROPOSED CB IN THE ROOM |

HVAC NOTES:

- EXHAUST FANS AND LOUVERS SHALL BE GREENHECK OR APPROVED EQUAL
- HYDRONIC HEATERS SHALL BE MODINE.
- ALL EQUIPMENT INSTALLATION SHALL BE IN ACCORDANCE WITH THE MANUFACTURER'S RECOMMENDATIONS.
- EXHAUST FANS SHALL HAVE HONEYWELL T6051A1016IU COOLING THERMOSTATS AS SHOWN. HONEYWELL H4661166 LINE VOLTAGE HUMIDISTATS SHALL BE INSTALLED WHERE SHOWN. SINGLE POLE SWITCHES W/PILOT LIGHT (EXP AS REQUIRED) SHALL PROVIDE MANUAL OVERRIDE WHERE SHOWN. THE FAN SHALL RUN ON CLOSED CONTACTS IN ANY CONTROL. GREENHECK CAPS FILE WILL BE PROVIDED UPON REQUEST.
- ALL HEATERS SHALL HAVE HONEYWELL T4 PRO TH4110U2005 PROGRAMMABLE THERMOSTATS. AQUASTATS SHALL PROVIDE FAN CONTROL FOR UNIT HEATERS.
- ALL HYDRONIC PIPING SHALL BE TYPE L COPPER W/1" FIBERGLASS INSULATION INSTALLED AS A REVERSE RETURN SYSTEM.
- THE WEIGHT OF THE UNIT HEATERS, FANS AND OTHER HVAC EQUIPMENT SHALL BE VERIFIED BEFORE PURCHASE AND THE APPROPRIATE HANGERS AND SUPPORTS WILL BE CONFIRMED AND PROVIDED BY THE CONTRACTOR. THE CONTRACTOR IS RESPONSIBLE FOR DETERMINING AND PROVIDING ALL NECESSARY SUPPORTS, BRACES, PADS, CONNECTIONS, ETC. TO MAKE THE UNIT FULLY FUNCTIONAL AND OPERATIONAL IN ACCORDANCE WITH THE MANUFACTURER'S INSTRUCTIONS.
- THE DRAWINGS SHOW THE GENERAL ARRANGEMENT OF THE EQUIPMENT AND THE MAJOR COMPONENTS. THE CONTRACTOR IS RESPONSIBLE FOR INSTALLING A FULLY OPERATIONAL UNIT COMPLETE WITH ANCILLARY CONNECTIONS SUCH AS AIR, WATER, POWER, FUEL, AND INSTRUMENTATION.
- CONTRACTOR SHALL COORDINATE MOUNTING AND INSTALLATION OF ALL UNITS, AND ACCESSORY DEVICES TO BE COMPATIBLE WITH AMBIENT AND ENVIRONMENTAL CONDITIONS OF INSTALLATION LOCATION.
- CONTRACTOR SHALL PROVIDE PENETRATIONS AND RESPECTIVE FLASHING THROUGH WALLS, FLOORS, AND CEILINGS AS NECESSARY TO ROUTE VENTING PIPES, CONDENSATE PIPES, AND ANY OTHER ACCESSORIES NECESSARY FOR THE PROPE FUNCTION OF THE HVAC UNITS.
- CONTRACTOR SHALL BE RESPONSIBLE FOR PIPING AND CONNECTING UNITS TO FUEL SOURCES, IF APPLICABLE.
- IF DAMPERS ARE TO BE INSTALLED IN A ROOM CONTAINING A GENERATOR, THE CONTRACTOR SHALL COORDINATE THE NORMAL POSITION OF THE DAMPERS WITH THE ENGINEER PRIOR TO INSTALLATION.

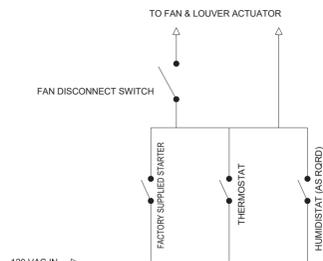


TYPICAL EXHAUST FAN WIRING SCHEMATIC

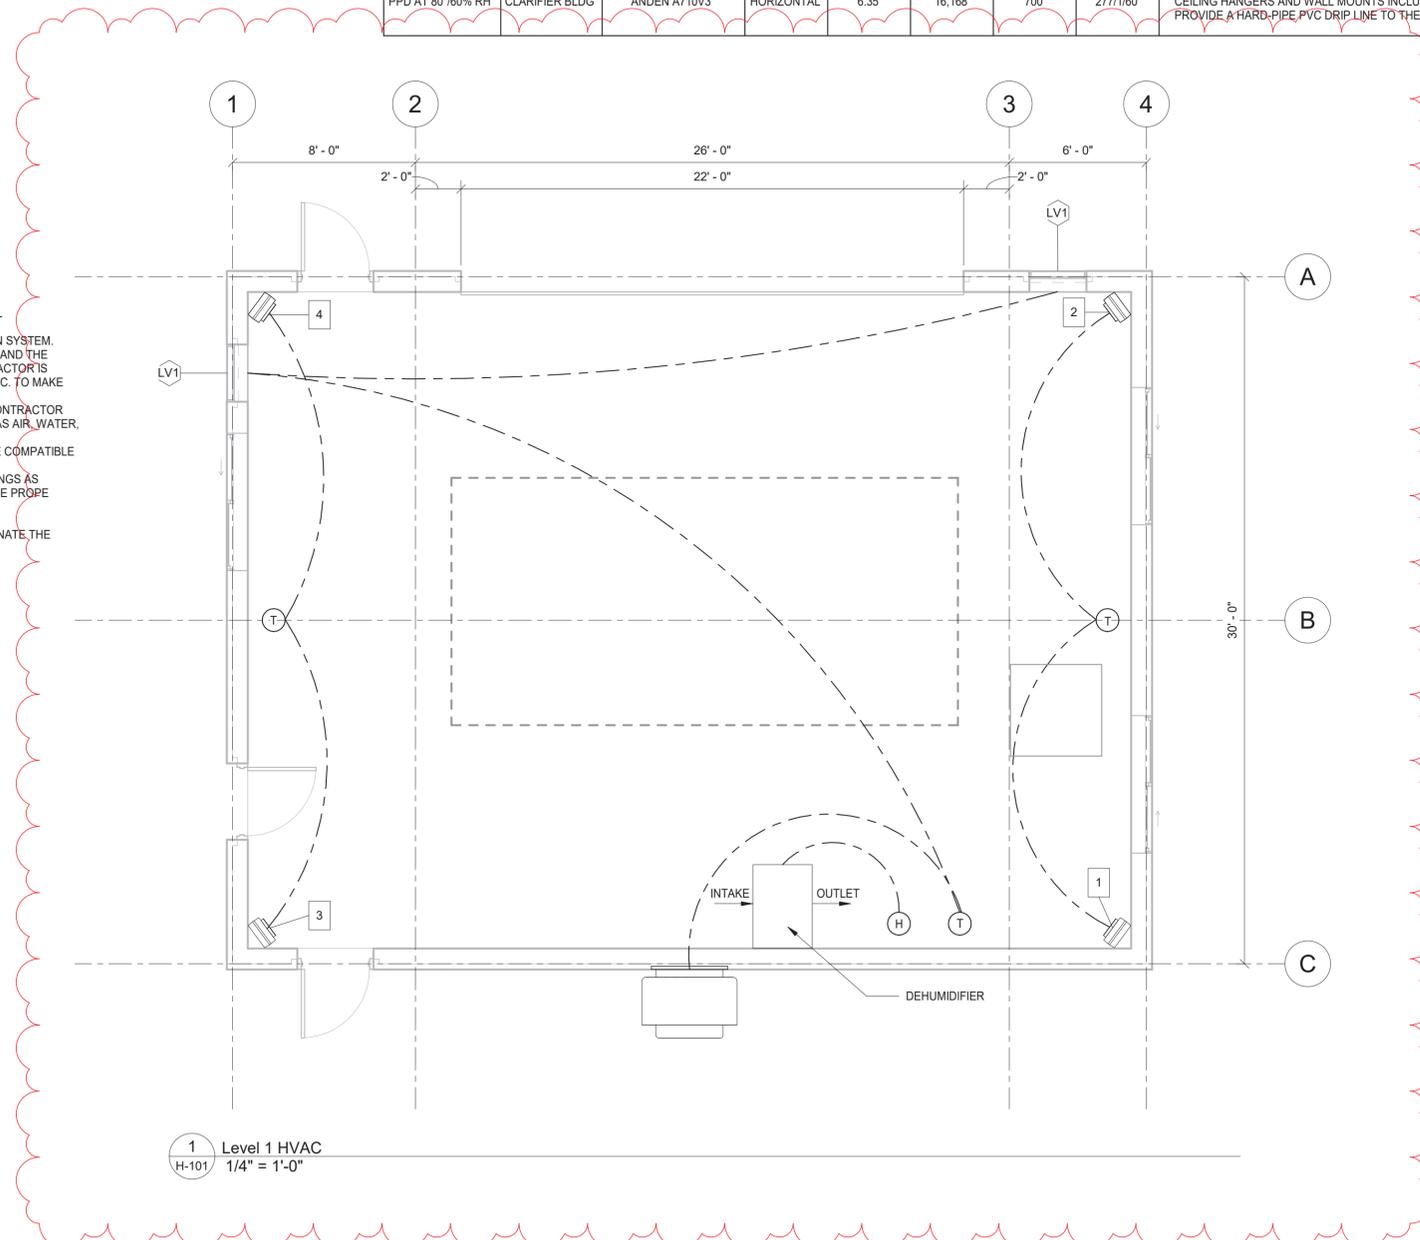

1 Level 1 HVAC  
H-101 1/4" = 1'-0"

DATE: 11.2024  
DRAWN BY: IB  
SCALE: As Indicated  
REVIEWED BY: Approver  
PROJECT NO.: 22-2496  
FILE:

**DELAWARE ENGINEERING, P.C.**  
CIVIL AND ENVIRONMENTAL ENGINEERING  
28 MADISON AVENUE EXTENSION, ALBANY, NY 12203 - 518.462.1290  
55 SOUTH MAIN ST., CONENITA, NY 13620 - 507.432.8073  
100 WEST 14TH ST., NEW YORK, NY 10011 - 212.457.4260  
548 BROADWAY, MONTICELLO, NY 12761 - 845.791.1777  
223 MAIN ST., GOSHEN, NY 10824 - 845.615.9232

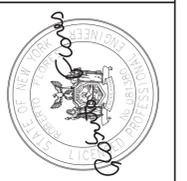

REVISIONS

| NO. | DATE       | DESCRIPTION |
|-----|------------|-------------|
| 1   | 11/01/2024 | ADDENDUM #1 |

RHINEBECK WTP  
IMPROVEMENTS  
VILLAGE OF RHINEBECK  
DUTCHESS COUNTY, NY

HVAC FLOOR PLN

SHEET:  
**H-101**

WARNING - IT IS A VIOLATION OF NEW YORK EDUCATION LAW SECTION 2209.2, FOR ANY PERSON, UNLESS HE IS ACTING UNDER THE DIRECTION OF A LICENSED PROFESSIONAL ENGINEER OR LAND SURVEYOR, TO ALTER THIS DOCUMENT IN ANY WAY. IF ALTERED THE ALTERING PERSON SHALL COMPLY WITH THE REQUIREMENTS OF NEW YORK EDUCATION LAW, SECTION 2209.2.