

Bid Addendum No. 1

June 25, 2025

City School District of New Rochelle – 2023 Capital Project – Phase 2B

CSArch Project No. 188-2301.02

SED Control Nos. 66-11-00-01-0-001-031; 66-11-00-01-0-003-018



Architect's Seal

This Bid Addendum No. 1 forms part of the Contract Documents and modifies the original bidding documents dated June 13, 2025. Bid Addendum No. 1 consists of two (2) pages, seven (7) specification Sections, thirty-six (36) full-size drawings, and responses to written Bidder questions not already addressed within revised documents.

GENERAL INFORMATION

1. Bid Addendum No. 1 issued to all Bidders / Plan Holders on June 25, 2025.

REVISIONS TO THE PROJECT MANUAL

1. DELETE Section 000110 Table of Contents. ADD revised Section 000010 in its entirety.
2. DELETE Section 000115 Drawing Index. ADD revised Section 000115 in its entirety.
3. DELETE Section 055000 Metal Fabrications. ADD revised Section 055000 in its entirety.
4. DELETE Section 055133 Metal Ladders. ADD revised Section 055133 in its entirety.
5. DELETE Section 118129 Facility Fall Protection in its entirety.
6. DELETE Section 190500 Theatrical Lighting and Controls Basic Requirements. ADD revised Section 190500 in its entirety.
7. DELETE Section 265561 Electrical Work for Theatrical Lighting. ADD revised Section 265561 in its entirety.
8. DELETE Section 265565 Theatrical Lighting Miscellaneous Equipment. ADD revised Section 265565 in its entirety.

REVISIONS TO THE CONTRACT DRAWINGS

1. DELETE sheet NRHS G000 Cover. ADD revised sheet NRHS G000 in its entirety.
2. DELETE sheet NRHS AD601 Area G – Second Floor Demolition Plan. ADD revised sheet NRHS AD601 in its entirety.
3. DELETE sheet NRHS AD817 Area G – Second Floor Demolition RCP. ADD revised sheet NRHS AD817 in its entirety.
4. DELETE sheet NRHS AD827 Area G – Third Floor Demolition Plan. ADD revised sheet NRHS AD827 in its entirety.
5. DELETE sheet NRHS A601 Enlarged Auditorium Second Floor Plan. ADD revised sheet NRHS A601 in its entirety.
6. DELETE sheet NRHS E101 Auditorium Main Level Electrical Plan. ADD revised sheet NRHS E101 in its entirety.
7. DELETE sheet NRHS E102 Auditorium Upper Level Electrical Plan. ADD revised sheet NRHS E102 in its entirety.
8. DELETE sheet NRHS E103 Auditorium Step & Aisle Lighting Plan. ADD revised sheet NRHS E103 in its entirety.
9. DELETE sheet NRHS E104 House Lighting Driver Cabinet Schedules. ADD revised sheet NRHS E104 in its entirety.
10. DELETE sheet NRHS E201 Aud. Main Level Electrical for Theatrical Ltg. Plan. ADD revised sheet NRHS E201 in its entirety.

11. DELETE sheet NRHS E203 Theatrical Lighting Schedules & Details. ADD revised sheet NRHS E203 in its entirety.
12. DELETE sheet NRHS E301 Auditorium Main Level Electrical for A/V Plan. ADD revised sheet NRHS E301 in its entirety.
13. DELETE sheet IEYMS G000 Cover. ADD revised sheet IEYMS G000 in its entirety.
14. DELETE sheet IEYMS G001 Symbols, Abbreviations, and Partition. ADD revised sheet IEYMS G001 in its entirety.
15. ADD sheet IEYMS S001 Structural General Notes in its entirety.
16. ADD sheet IEYMS S101 First Floor Framing Plan – Area B in its entirety.
17. ADD sheet IEYMS S102 First Floor Framing Plan – Area C in its entirety.
18. ADD sheet IEYMS S103 Second Floor Framing Plan – Area B in its entirety.
19. ADD sheet IEYMS S104 Second Floor Framing Plan – Area C in its entirety.
20. ADD sheet IEYMS S105 Roof Framing Plan – Area B in its entirety.
21. ADD sheet IEYMS S106 Roof Framing Plan – Area C in its entirety.
22. ADD sheet IEYMS S701 Typical Details in its entirety.
23. DELETE sheet IEYMS AD105 Area B – Partial Ground Floor Demo Plan. ADD revised sheet IEYMS AD105 in its entirety.
24. DELETE sheet IEYMS AD106 Area C – Partial Ground Floor Demo Plan. ADD revised sheet IEYMS AD106 in its entirety.
25. DELETE sheet IEYMS AD112 Area B – Partial First Floor Demo Plan. ADD revised sheet IEYMS AD112 in its entirety.
26. DELETE sheet IEYMS AD116 Area C – Partial First Floor Demo Plan. ADD revised sheet IEYMS AD116 in its entirety.
27. DELETE sheet IEYMS AD125 Area B – Partial Second Floor Demo Plan. ADD revised sheet IEYMS AD126 in its entirety.
28. DELETE sheet IEYMS AD126 Area C – Partial Second Floor Demo Plan. ADD revised sheet IEYMS AD126 in its entirety.
29. DELETE sheet IEYMS A116 Area C – Partial First Floor Plan. ADD revised sheet IEYMS A116 in its entirety.
30. DELETE sheet IEYMS A126 Area C – Partial Second Floor Plan. ADD revised sheet IEYMS A126 in its entirety.
31. DELETE sheet IEYMS A802 Area B – Partial Ground Floor RCP. ADD revised sheet IEYMS A802 in its entirety.
32. DELETE sheet IEYMS A803 Area C – Partial Ground Floor RCP. ADD revised sheet IEYMS A803 in its entirety.
33. DELETE sheet IEYMS A812 Area B – Partial First Floor RCP. ADD revised sheet IEYMS A812 in its entirety.
34. DELETE sheet IEYMS A813 Area C – Partial First Floor RCP. ADD revised sheet IEYMS A813 in its entirety.
35. DELETE sheet IEYMS A822 Area B – Partial Second Floor RCP. ADD revised sheet IEYMS A822 in its entirety.
36. DELETE sheet IEYMS A823 Area C – Partial Second Floor RCP. ADD revised sheet IEYMS A823 in its entirety.

RESPONSES TO WRITTEN BIDDER QUESTIONS

1. Section 01141`0, Article 3.3, Paragraph B references 'Construction Phasing drawings'. These seem to have been omitted, along with any general phasing requirements. RESPONSE: Refer to Section 003113 Preliminary Schedule. No Phasing Drawings are anticipated. The awarded GC shall submit a Project Schedule and Logistics Plan upon award for District review and approval. This includes dumpster and staging locations.

END OF BID ADDENDUM NO. 1

DOCUMENT 000110 - TABLE OF CONTENTS – REVISED AS PART OF BID ADDENDUM 1

Volume 1

DIVISION 00 – PROCUREMENT AND CONTRACTING REQUIREMENTS

Introductory Information

000014	Certification Page
000110	Table of Contents – REVISED AS PART OF BID ADDENDUM 1
000115	Drawing Index – REVISED AS PART OF BID ADDENDUM 1

Procurement Requirements

001113	Advertisement for Bids
002113	Instructions to Bidders
003113	Preliminary Schedule

Procurement Forms and Supplements

004116.01	Bid Form Contract No. 11 – General Construction Work (GC-03)
004116.02	Bid Form Contract No. 12 – Mechanical Construction Work (MC-03)
004116.03	Bid Form Contract No. 13 – Electrical Construction Work (EC-03)
004313	A310 Bid Bond
004325	Substitution Request Form
004333	Proposed Equivalent List
004336	Proposed Subcontractors Form
004513	A305 Contractor’s Qualification Statement
004519	Non-Collusion Affidavit
004520	Iran Divestment Act Affidavit
004543	Corporate Resolutions
004600	Sexual Harassment Written Policy & Training Certification Form

Contracting Requirements & Supplements

005216	A132 Standard Form of Agreement Between Owner and Contractor, Construction Manager as Adviser Edition
006113.13	A312 Payment Bond
006113.14	A312 Performance Bond
006114	C106 Digital Data Licensing Agreement
006273	G732 Schedule of Values
006274	G703 Schedule of Values Continuation Sheet

Closeout Forms

006519.13	G706 Contractor's Affidavit of Payment of Debts and Claims
006519.16	G706A Contractor's Affidavit of Release of Liens
006519.17	G707 Consent of Surety to Final Payment

Conditions of the Contract & Supplementary Conditions

007216	A232 General Conditions of the Contract for Construction, Construction Manager as Adviser Edition
007343	Wage Rates

Project Forms

008300	Project Forms
008310	Submittal Cover Sheet
008320	Request For Information
008325	Change In Condition
008330	Request For Shutdown
008340	Daily Report Cover
008350	Labor Rate Sheet
008370	Two-Week Look Ahead Schedule
008380	Bi-Weekly Material / Equipment Status Report
008440	Substantial Completion Request For Inspection
008450	Test Report / Inspection Log
008470	Submittal Schedule

DIVISION 01 – GENERAL REQUIREMENTS

011200	Multiple Contract Summary
011400	Work Restrictions
011410	NYSED 155.5 Uniform Safety Standards

Price and Payment Procedures

012100	Allowances
012500	Substitution Procedures
012600	Contract Modification Procedures
012900	Payment Procedures
012973	Schedule of Values

Administrative Requirements

013100	Project Management and Coordination
013150	Safety and Health
013200	Construction Progress Documentation
013233	Photographic Documentation
013300	Submittal Procedures

Quality Requirements

014000	Quality Requirements
014200	References
014533	Code-Required Special Inspections and Procedures

Temporary Facilities

015000	Temporary Facilities and Controls
--------	-----------------------------------

Product Requirements

016000	Product Requirements
--------	----------------------

Execution and Closeout requirements

017300	Execution
017329	Cutting and Patching
017413	Cleaning-Up
017700	Closeout Procedures
017823	Operation and Maintenance Data
017836	Warranties
017839	Project Record Documents
017900	Demonstration and Training
019113	General Commissioning Requirements

DIVISION 02 – EXISTING CONDITIONS

023313	Underground Utility Locator Service
024100	Demolition

Volume 2

DIVISION 03 – CONCRETE

033000	Cast-In-Place Concrete
035400	Cementitious Underlayment

DIVISION 04 – MASONRY

042000 Unit Masonry

DIVISION 05 – METALS

055000 Metal Fabrications – REVISED AS PART OF BID ADDENDUM 1

055133 Metal Ladders – REVISED AS PART OF BID ADDENDUM 1

055213 Pipe and Tube Railings

DIVISION 06 – WOOD and PLASTICS

061053 Miscellaneous Rough Carpentry

061600 Sheathing

064023 Interior Architectural Woodwork

DIVISION 07 – THERMAL AND MOISTURE PROTECTION

072100 Thermal Insulation

075323 Ethylene-Propylene-Diene-Monomer (EPDM) Roofing

076200 Sheet Metal Flashing and Trim

078413 Penetration Firestopping

078443 Joint Firestopping

079200 Joint Sealants

079219 Acoustical Joint Sealants

DIVISION 08 – OPENINGS

083113 Access Doors and Frames

089119 Fixed Louvers

DIVISION 09 – FINISHES

092116.23 Gypsum Board Shaft Wall Assemblies

092216 Non-Structural Metal Framing

092310 Patching Large Holes in Plaster with Plaster

092320 Patching Small Chips and Cracks in Plaster

092900 Gypsum Board

095113 Acoustical Panel Ceilings

096466 Wood Flooring

096513 Resilient Base and Accessories

096519 Resilient Tile Flooring

096613 Portland Cement Terrazzo Flooring
096816 Sheet Carpeting
099100 Painting

~~DIVISION 11 – EQUIPMENT~~

~~118129 Facility Fall Protection – DELETED AS PART OF BID ADDENDUM 1~~

DIVISION 12 – FURNISHINGS

126100 Fixed Audience Seating (For Reference)

DIVISION 19 – THEATRICAL EQUIPMENT AND CONTROLS

190500 Theatrical Lighting and Controls Basic Requirements – **REVISED AS PART OF BID ADDENDUM 1**

DIVISION 22 – PLUMBING

220500 General Plumbing Requirements
220502 Plumbing Demolition
220529 Supports and Sleeves
220553 Plumbing Identification
221613 Natural Gas Piping

DIVISION 23 – HEATING, VENTILATING AND AIR CONDITIONING

230500 General Mechanical Requirements
230502 Mechanical Demolition
230513 Common Motor Requirements
230515 Variable Frequency Drives
230529 Supports and Sleeves
230553 Mechanical Identification
230593 Testing, Adjusting, and Balancing
230713 Duct Insulation
230800 Commissioning of HVAC Systems
230900 Building Automation System
230993 Sequence of Operations
233113 Metal Ductwork
233300 Air Duct Accessories
233713 Registers, Grilles, and Diffusers
237433 Dedicated Outdoor-Air Units

DIVISION 26 – ELECTRICAL

260010	Basic Electrical Requirements
260050	General Materials and Methods
260500	General Electrical Requirements
260501	Electrical Materials and Equipment
260519	Low-Voltage Electrical Power Conductors and Cables
260526	Grounding and Bonding for Electrical Systems
260529	Hangers and Supports for Electrical Systems
260533	Raceways and Boxes for Electrical Systems
260544	Sleeves and Sleeve Seals for Electrical Raceways and Cabling
260553	Identification for Electrical Systems
260921	Lighting Controls
260923	Lighting Control Devices
262416	Panelboards
262726	Wiring Devices
262816	Enclosed Switches and Circuit Breakers
265001	Lighting Fixture Schedule
265119	LED Interior Lighting
265561	Electrical Work for Theatrical Lighting – REVISED AS PART OF BID ADDENDUM 1
265565	Theatrical Lighting Miscellaneous Equipment – REVISED AS PART OF BID ADDENDUM 1
265569	Electrical Work for theatrical Audio/Video

DIVISION 27 – COMMUNICATIONS

270010	Basic Communications Requirements
270050	General Materials and Methods
271001	Telecom Cabling Systems – Pathways
275111	Existing Public Address Systems

DIVISION 28 – ELECTRONIC SAFETY AND SECURITY

280010	Basic Electronic Safety and Security Requirements
280050	General Materials and Methods
283100	Fire Detection and Alarm
284605	Existing Fire Alarm System

APPENDICES

Appendix A TSI drawings (FOR REFERENCE)

END OF DOCUMENT 000110

SECTION 000115 – DRAWING INDEX – **REVISED AS PART OF BID ADDENDUM 1**

PART 1 – GENERAL

A. DRAWING PROJECT TITLE:

- City School District of the City of New Rochelle – 2023 Capital Project – Phase 2B

B. This Drawing Index completes the Project Documents. Bidder shall verify receipt of all within the separately bound drawings:

NEW ROCHELLE HIGH SCHOOL – Volume 1 of 2

GENERAL DRAWINGS

G000	COVER
G001	SYMBOLS, ABBREVIATIONS, AND MISC
G100	OVERALL GROUND FLOOR PLAN
G110	OVERALL FIRST FLOOR PLAN
G120	OVERALL SECOND FLOOR PLAN

LIFE SAFETY DRAWINGS

LS101	AREA 'A&B' FIRST FLOOR LIFE SAFETY PLAN
LS102	AREA 'A&B' SECOND FLOOR LIFE SAFETY PLAN
LS103	AREA 'C' FIRST & SECOND FLOOR LIFE SAFETY PLAN
LS104	AREA 'D' FIRST FLOOR LIFE SAFETY PLAN
LS105	AREA 'E' ALL FLOORS LIFE SAFETY PLANS
LS106	AREA 'F' ALL FLOORS LIFE SAFETY PLAN
LS107	AREA 'G' SECOND AND THIRD LIFE SAFETY PLAN
LS108	AREA 'H' FIRST AND SECOND LIFE SAFETY PLAN
LS109	LIFE SAFETY DIAGRAMS

ARCHITECTURAL DEMOLITION DRAWINGS

AD601	AREA 'G' SECOND FLOOR DEMOLITION PLAN
AD817	AREA 'G' SECOND FLOOR DEMOLITION RCP
AD827	AREA 'G' THIRD FLOOR DEMOLITION RCP

ARCHITECTURAL DRAWINGS

A117	AREA 'G' SECOND FLOOR NEW WORK PLAN
A127	AREA 'G' THIRD FLOOR NEW WORK PLAN
A601	ENLARGED AUDITORIUM SECOND FLOOR PLAN
A603	AUDITORIUM ELEVATIONS
A604	AUDITORIUM ELEVATIONS
A605	AUDITORIUM DETAILS
A817	AREA 'G' PARTIAL SECOND FLOOR RCP
A827	AREA 'G' PARTIAL THIRD FLOOR RCP

ARCHITECTURAL FINISH DRAWINGS

AF001 ENLARGED AUDITORIUM FIRST FLOOR FINISH PLAN

ELECTRICAL GENERAL DRAWINGS

E001 ELECTRICAL LEGEND AND ABBREVIATIONS

ELECTRICAL DEMOLITION DRAWINGS

ED101 AUDITORIUM MAIN LEVEL ELECTRICAL REMOVALS PLAN

ED102 AUDITORIUM UPPER LEVEL ELECTRICAL REMOVALS PLAN

ELECTRICAL DRAWINGS

E100 AUDITORIUM LOWER LEVEL ELECTRICAL PLAN

E101 AUDITORIUM MAIN LEVEL ELECTRICAL PLAN

E102 AUDITORIUM UPPER LEVEL ELECTRICAL PLAN

E103 AUDITORIUM STEP & AISLE LIGHTING PLAN

E104 HOUSE LIGHTS DRIVER CABINET SCHEDULES

E105 ELECTRICAL DETAILS

E201 AUD. MAIN LEVEL ELECTRICAL for THEATRICAL LIGHTING PLAN

E202 AUD. UPPER LEVEL ELECTRICAL for THEATRICAL LIGHTING PLAN

E203 THEATRICAL LIGHTING SCHEDULES & DETAILS

E301 AUDITORIUM MAIN LEVEL ELECTRICAL FOR A/V PLAN

E302 AUDITORIUM UPPER LEVEL ELECTRICAL FOR A/V PLAN

E401 THEATRICAL A/V/L RACK CONDUIT & CABLE SCHEDULES

E402 EXISTING LIGHTING CONTROL SYSTEM DIAGRAM

E403 EXISTING SOUND SYSTEM DIAGRAM

ISAAC E. YOUNG MIDDLE SCHOOL – Volume 2 of 2

GENERAL DRAWINGS

G000 COVER

G001 SYMBOLS, ABBREVIATIONS, AND MISC

G100 OVERALL GROUND FLOOR PLAN

G110 OVERALL FIRST FLOOR PLAN

G120 OVERALL SECOND FLOOR PLAN

LIFE SAFETY DRAWINGS

LS100 OVERALL GROUND FLOOR LIFE SAFETY PLAN

LS101 AREA 'A' – PARTIAL GROUND FLOOR LIFE SAFETY PLAN

LS102 AREA 'B' – PARTIAL GROUND FLOOR LIFE SAFETY PLAN

LS103 AREA 'C' – PARTIAL GROUND FLOOR LIFE SAFETY PLAN

LS110 OVERALL FIRST FLOOR LIFE SAFETY PLAN

LS111 AREA 'A' – PARTIAL FIRST FLOOR LIFE SAFETY PLAN

LS112 AREA 'B' – PARTIAL FIRST FLOOR LIFE SAFETY PLAN

LS113 AREA 'C' – PARTIAL FIRST FLOOR LIFE SAFETY PLAN

LS120 OVERALL SECOND FLOOR LIFE SAFETY PLAN

LS121 AREA 'A' – PARTIAL SECOND FLOOR LIFE SAFETY PLAN
LS122 AREA 'B' – PARTIAL SECOND FLOOR LIFE SAFETY PLAN
LS123 AREA 'C' – PARTIAL SECOND FLOOR LIFE SAFETY PLAN
LS124 LIFE SAFETY DIAGRAM

STRUCTURAL GENERAL DRAWINGS

S001 STRUCTURAL GENERAL NOTES

STRUCTURAL DRAWINGS

S101 FIRST FLOOR FRAMING PLAN – AREA B
S102 FIRST FLOOR FRAMING PLAN – AREA C
S103 SECOND FLOOR FRAMING PLAN – AREA B
S104 SECOND FLOOR FRAMING PLAN – AREA C
S105 ROOF FRAMING PLAN – AREA B
S106 ROOF FRAMING PLAN – AREA C
S701 TYPICAL DETAILS

ARCHITECTURAL DEMOLITION DRAWINGS

AD105 AREA 'B' – PARTIAL GROUND FLOOR DEMO PLAN
AD106 AREA 'C' – PARTIAL GROUND FLOOR DEMO PLAN
AD112 AREA 'B' – PARTIAL FIRST FLOOR DEMO PLAN
AD116 AREA 'C' – PARTIAL FIRST FLOOR DEMO PLAN
AD125 AREA 'B' – PARTIAL SECOND FLOOR DEMO PLAN
AD126 AREA 'C' – PARTIAL SECOND FLOOR DEMO PLAN
AD402 AREA 'B' – PARTIAL ROOF DEMOLITION PLAN
AD403 AREA 'C' – PARTIAL ROOF DEMOLITION PLAN
AD802 AREA 'B' – PARTIAL GROUND FLOOR DEMO RCP
AD803 AREA 'C' – PARTIAL GROUND FLOOR DEMO RCP
AD812 AREA 'B' – PARTIAL FIRST FLOOR DEMO RCP
AD813 AREA 'C' – PARTIAL FIRST FLOOR DEMO RCP
AD822 AREA 'B' – PARTIAL SECOND FLOOR DEMO RCP
AD823 AREA 'C' – PARTIAL SECOND FLOOR DEMO RCP

ARCHITECTURAL DRAWINGS

A105 AREA 'B' – PARTIAL GROUND FLOOR PLAN
A106 AREA 'C' – PARTIAL GROUND FLOOR PLAN
A112 AREA 'B' – PARTIAL FIRST FLOOR PLAN
A116 AREA 'C' – PARTIAL FIRST FLOOR PLAN
A125 AREA 'B' – PARTIAL SECOND FLOOR PLAN
A126 AREA 'C' – PARTIAL SECOND FLOOR PLAN
A402 AREA 'B' – PARTIAL ROOF PLAN
A403 AREA 'C' – PARTIAL ROOF PLAN
A802 AREA 'B' – PARTIAL GROUND FLOOR RCP
A803 AREA 'C' – PARTIAL GROUND FLOOR RCP
A812 AREA 'B' – PARTIAL FIRST FLOOR RCP

A813	AREA 'C' – PARTIAL FIRST FLOOR RCP
A822	AREA 'B' – PARTIAL SECOND FLOOR RCP
A823	AREA 'C' – PARTIAL SECOND FLOOR RCP

ARCHITECTURAL FINISH DRAWINGS

AF001	MATERIAL AND ROOM FINISH SCHEDULE
AF105	AREA B – PARTIAL GROUND FLOOR FINISH PLAN
AF106	AREA C – PARTIAL GROUND FLOOR FINISH PLAN
AF112	AREA B – PARTIAL FIRST FLOOR FINISH PLAN
AF116	AREA C – PARTIAL FIRST FLOOR FINISH PLAN
AF125	AREA B – PARTIAL SECOND FLOOR FINISH PLAN
AF126	AREA C – PARTIAL SECOND FLOOR FINISH PLAN

PLUMBING GENERAL DRAWINGS

P001	PLUMBING NOTES, SCHEDULE, LEGEND & DETAILS
------	--

PLUMBING DRAWINGS

P111	AREA 'A' – FIRST FLOOR PLUMBING PLAN
P131	AREA 'A' – ROOF PLUMBING PLAN
P132	AREA 'B' – ROOF PLUMBING PLAN
P133	AREA 'C' – ROOF PLUMBING PLAN

MECHANICAL GENERAL DRAWINGS

M001	MECHANICAL NOTES, LEGENDS, SCHEDULE & DETAILS
M002	MECHANICAL SCHEDULES
M003	TEMPERATURE CONTROLS, NOTES, LEGEND & SCHEMATICS

MECHANICAL DEMOLITION DRAWINGS

MD102	AREA B GROUND FLOOR MECHANICAL DEMOLITION PLAN
MD103	AREA C GROUND FLOOR MECHANICAL DEMOLITION PLAN
MD112	AREA B 1 ST FLOOR MECHANICAL DEMOLITION PLAN
MD113	AREA C 1 ST FLOOR MECHANICAL DEMOLITION PLAN
MD122	AREA B 2 ND FLOOR MECHANICAL DEMOLITION PLAN
MD123	AREA C 2 ND FLOOR MECHANICAL DEMOLITION PLAN
MD132	AREA B ROOF MECHANICAL DEMOLITION PLAN
MD133	AREA C ROOF MECHANICAL DEMOLITION PLAN

MECHANICAL DRAWINGS

M102	AREA B GROUND FLOOR MECHANICAL PLAN
M103	AREA C GROUND FLOOR MECHANICAL PLAN
M112	AREA B 1 ST FLOOR MECHANICAL PLAN
M113	AREA C 1 ST FLOOR MECHANICAL PLAN
M122	AREA B 2 ND FLOOR MECHANICAL PLAN
M123	AREA C 2 ND FLOOR MECHANICAL PLAN
M132	AREA B ROOF MECHANICAL PLAN
M133	AREA C ROOF MECHANICAL PLAN

ELECTRICAL GENERAL DRAWINGS

E001 ELECTRICAL NOTES, LEGEND, DETAILS & SCHEDULES

ELECTRICAL DEMOLITION DRAWINGS

ED102 AREA B GROUND FLOOR ELECTRICAL DEMOLITION PLAN
ED103 AREA C GROUND FLOOR ELECTRICAL DEMOLITION PLAN
ED112 AREA B 1ST FLOOR ELECTRICAL DEMOLITION PLAN
ED113 AREA C 1ST FLOOR ELECTRICAL DEMOLITION PLAN
ED122 AREA B 2ND FLOOR ELECTRICAL DEMOLITION PLAN
ED123 AREA C 2ND FLOOR ELECTRICAL DEMOLITION PLAN
ED132 AREA B ROOF ELECTRICAL DEMOLITION PLAN
ED133 AREA C ROOF ELECTRICAL DEMOLITION PLAN

ELECTRICAL DRAWINGS

E102 AREA B GROUND FLOOR ELECTRICAL PLAN
E103 AREA C GROUND FLOOR ELECTRICAL PLAN
E112 AREA B 1ST FLOOR ELECTRICAL PLAN
E113 AREA C 1ST FLOOR ELECTRICAL PLAN
E122 AREA B 2ND FLOOR ELECTRICAL PLAN
E123 AREA C 2ND FLOOR ELECTRICAL PLAN
E132 AREA B ROOF ELECTRICAL PLAN
E133 AREA C ROOF ELECTRICAL PLAN

END OF SECTION 000115

THIS PAGE INTENTIONALLY LEFT BLANK

SECTION 055000 - METAL FABRICATIONS – REVISED AS PART OF BID ADDENDUM 1

PART 1 - GENERAL

1.1 PRODUCTS FURNISHED BUT NOT INSTALLED UNDER THIS SECTION

- A. Loose Lintels: Installed under Section 042000 or 042113 and 042200.

1.2 REFERENCES

- A. Except as shown or specified otherwise, the Work of this Section shall meet the requirements of the following:
1. Design, Fabrication, and Erection: "Specification for Structural Steel Buildings, Allowable Stress Design and Plastic Design" adopted by the American Institute of Steel Construction, June 1, 1989 (AISC Specification).
 - a. Design and Fabrication of Cold-Formed Shapes: "Specification for the Design of Cold-Formed Steel Structural Members", by the American Iron and Steel Institute (AISI Specification).
 2. Welding: "Structural Welding Code - Steel, AWS D1.1", or "Structural Welding Code - Sheet Steel, AWS D1.3", by the American Welding Society (AWS Codes).
- B. Organizations:
1. AISC: American Institute of Steel Construction, One East Wacker Dr., Suite 700, Chicago, IL 60601-1802, 866-275-2472, www.aisc.org.
 2. AISI: American Iron and Steel Institute, 1140 Connecticut Ave., NW, Suite 705, Washington, D.C. 20036, (202) 452-7100, www.steel.org.
 3. AWS: American Welding Society, 550 N.W. LeJeune Rd., Miami, FL 33126, (800) 443-9353, www.aws.org.
 4. ANSI: American National Standards Institute, 1819 L Street, NW, 6th Floor, Washington, DC 20036, (202) 293-8020, www.ansi.org.
 5. ASTM: ASTM International, 100 Barr Harbor Dr., PO Box C700, West Conshohocken, PA, 19428-2959, (610) 832-9500, www.astm.org.
 6. SSPC: The Society for Protective Coatings, 40 24th Street, 6th Floor, Pittsburgh PA 15222-4656, (877) 281-7772, www.sspc.org.

1.3 SUBMITTALS

- A. Shop Drawings: Show application to project. Furnish setting drawings and templates for installation of bolts and anchors in other Work. Indicate shop and field welds by standard AWS welding symbols in accordance with AWS A2.4.
- B. Product Data: Catalog sheets, specifications, and installation instructions for each fabricated item specified, except submit data for fasteners only when directed.
- C. Quality Control Submittals:
1. Certificates: Copy of certificates required under Quality Assurance Article.

1.4 QUALITY ASSURANCE

A. Certificates:

1. Affidavit by the structural steel manufacturer certifying that structural steel items meet the contract requirements.
 - a. Submit evidence of steel material compliance with this Specification. Evidence shall consist of certification of source of material, copies of purchase orders and manufacturer's certifications. For stock material, submit copies of latest mill or purchase orders for material replacement.

- B. Galvanizing: Stamp galvanized items with galvanizer's name, weight of coating, and applicable ASTM number.

1.5 DELIVERY AND STORAGE

- A. Coordinate delivery of items to be built into other construction to avoid delay.
- B. Promptly cover and protect steel items delivered to the Site.

PART 2 - PRODUCTS

2.1 MATERIALS

- A. Steel Plates, Shapes and Bars: ASTM A 36, except as specified or shown otherwise.
- B. Angles: ASTM A 36 or ASTM A 572, Grade 50.
- C. Anchors: Except where shown or specified, select anchors of type, size, style, grade, and class required for secure installation of metal fabrications. For exterior use and where built into exterior walls, anchors shall be galvanized or of corrosive-resistant materials.
 1. Wedge-Type Concrete Inserts: Galvanized box-type ferrous casting, designed to accept 3/4 inch diameter bolt having special wedge-shaped head; either malleable iron or cast steel.
 - a. Bolts: Carbon steel bolts having special wedge-shaped heads, nuts, washers and shims.
- D. Fasteners: Except where shown or specified, select fasteners of type, size, style, grade, and class required for secure installation of metal fabrications. For exterior use and where built into exterior walls, fasteners shall be galvanized.
 1. Standard Bolts and Nuts: ASTM A 307, Grade A, regular hexagon head.
 2. Machine Screws: ASME B18.6.3.
 3. Plain Washers: Round, ASME B18.22.1.
 4. Lock Washers: Helical, spring type, ASME B18.21.1.

- E. Shop Paint (General): Universal shop primer; fast-curing, lead- and chromate-free, universal modified-alkyd primer complying with MPI#79 and compatible with topcoat.
 - 1. Use primer containing pigments that make it easily distinguishable from zinc-rich primer.
- F. Shop Paint for Galvanized Steel: Epoxy zinc-rich primer; complying with MPI#20 and compatible with topcoat.
- G. Bedding Mortar:
 - 1. Shrink-Resistant Grout (Non-Staining): Factory-packaged, non-ferrous mortar grouting compound selected from the following:
 - a. Masterflow 713 by Master Builders, 23700 Chagrin Blvd., Cleveland, OH 44122 (800) 227-3350.
 - b. SonogROUT by Sonneborn, Chemrex, Inc., 57-46 Flushing Ave., Maspeth, NY 11378, (800) 433-9517.
 - c. Five Star Grout by Five Star Products, Inc., 425 Stillson Rd., Fairfield, CT 06430, (800) 243-2206.
 - d. Crystex by L&M Construction Chemicals, 14851 Calhoun Rd., Omaha, NB 68152, (800) 362-3331.
 - e. Non-Corrosive, Non-Shrink Grout by A.C. Horn, Inc., Tamm Industries, 7405 Production Dr., Mentor, OH 44060, (800) 862-2667.

2.2 MISCELLANEOUS FRAMING AND SUPPORTS

- A. Fabricate metal framing and supports to support related items required by the Work. Fabricate of welded construction unless otherwise indicated. Preassemble to largest extent possible.
- B. When required to be built into other Work, equip units with integral anchors spaced not more than 24 inches on center.
- C. Galvanize exterior steel framing and supports.

2.3 LOOSE LINTELS

- A. Structural steel shape lintels, fabricated for openings and recesses in masonry walls and partitions as indicated. Loose lintels bearing on masonry or concrete shall have a minimum end bearing length of 6 inches at each end, unless otherwise shown.
- B. Galvanize lintels to be installed in exterior walls.

2.4 FABRICATION

- A. Use materials of size and thickness indicated. If not indicated, use material of required size and thickness to produce adequate strength and durability for the

intended use of the finished product. Furnish suitable, compatible anchors and fasteners to support assembly.

- B. Fabricate items to be exposed to view of material entirely free of surface blemish, including pitting, seam marks, roller marks, rolled trade names, and roughness. Remove surface blemishes by grinding or by welding and grinding prior to cleaning, treating, and finishing. Ease exposed edges to a radius of approximately 1/32 inch unless otherwise shown.
- C. Joints: Fabricate accurately for close fit. Weld exposed joints continuously unless otherwise indicated or approved. Dress exposed welds flush and smooth.
- D. Connections: Form exposed connections with flush, smooth, hairline joints. Use concealed fasteners wherever possible. Use Phillips flathead (countersunk) bolts or screws for exposed fasteners, unless otherwise shown or specified.
 - 1. Furnish flat washer under connections requiring raised bolt heads.
 - 2. Furnish lock washer under nuts when through-bolting occurs.
- E. Punch, reinforce, drill, and tap metal Work as required to receive hardware and other appurtenant items.
- F. Galvanizing:
 - 1. In addition to specific items specified or noted to be galvanized, galvanize items attached to, embedded in, or supporting exterior masonry (including interior wythe of exterior masonry walls) and concrete Work.
 - 2. Unless otherwise specified or noted, items indicated to be galvanized shall receive a zinc coating by the hot-dip process, after fabrication, complying with the following:
 - a. ASTM A 123 for plain and fabricated material, and assembled products.
 - b. ASTM A 153 for iron and steel hardware.
- G. Shop Painting:
 - 1. Cleaning Steel: Thoroughly clean all steel surfaces. Remove oil, grease, and similar contaminants in accordance with SSPC SP-1 "Solvent Cleaning". Remove loose mill scale, loose rust, weld slag and spatter, and other detrimental material in accordance with SSPC SP-2 "Hand Tool Cleaning", SSPC SP-3 "Power Tool Cleaning", or SSPC SP-7 "Brush-Off Blast Cleaning".
 - 2. Galvanized Items:
 - a. Galvanized items which are to be finish painted under Section 099101 shall be rinsed in hot alkali or in an acid solution and then in clear water.
 - b. Welded and abraded areas of galvanized surfaces shall be wire brushed and repaired with a coating of cold galvanizing compound.
 - 3. Apply one coat of shop paint to all steel surfaces except as follows:
 - a. Do not shop paint steel surfaces to be field welded and steel to be encased in cast-in-place concrete.

- b. Apply 2 coats of shop paint, before assembly, to steel surfaces inaccessible after assembly or erection, except surfaces in contact.
- c. Do not paint galvanized items which are not to be finished painted under Section 099101.
- 4. Apply paint and compound on dry surfaces in accordance with the manufacturer's printed instructions, and to the following minimum thickness per coat:
 - a. Shop Paint (General): 4.0 mils wet film.
 - b. Shop Paint for Galvanized Steel: 3.0 mils wet film.

PART 3 - EXECUTION

3.1 PREPARATION

- A. Temporarily brace and secure items which are to be built into concrete, masonry, or similar construction.
- B. Isolate non-ferrous metal surfaces to be permanently fastened in contact with ferrous metal surfaces, concrete, or masonry by coating non-ferrous metal surface with bituminous mastic, prior to installation.

3.2 INSTALLATION

- A. Fit and set fabricated metal Work accurately in location, alignment, and elevation. Securely fasten in place. Cut off exposed threaded portion of bolts flush with nut.
- B. Set loose items on cleaned bearing surfaces, using wedges or other adjustments as required. Solidly pack open spaces with bedding mortar or grout.
- C. Attached Work: Fasten to concrete and solid masonry with expansion anchors and to hollow masonry with toggle bolts in cells, unless otherwise indicated. Drill holes for fasteners to exact required size using power tools.

END OF SECTION 055000

THIS PAGE INTENTIONALLY LEFT BLANK

SECTION 055133 METAL LADDERS - REVISED AS PART OF BID ADDENDUM 1

PART 1 GENERAL

1.1 SECTION INCLUDES

- A. Fixed Ladder Systems:
 - 1. Caged fixed ladders.

1.2 RELATED SECTIONS

- A. Section 061053 – Miscellaneous Rough Carpentry.

1.3 REFERENCES

- A. Occupational Safety and Health Administration of the United States (OSHA):
 - 1. OSHA 1910.23: Fixed Ladders.
 - 2. OSHA 1910.29: Fall Protection systems and falling object protection.
- B. American National Standards Institute (ANSI):
 - 1. ANSI A14.3: Ladders - Fixed - Safety Requirements.

1.4 SUBMITTALS

- A. Submit under provisions of Section 013000 - Administrative Requirements.
- B. Product Data: Manufacturer's data sheets on each product to be used, including:
 - 1. Preparation instructions and recommendations.
 - 2. Storage and handling requirements and recommendations.
 - 3. Installation methods.
- C. Shop Drawings: Provide plan, section, elevation and perspective view drawings as necessary to depict appropriate installation procedures including location, mounting, attachment, and penetration flashing as applicable.

1.5 QUALITY ASSURANCE

- A. Manufacturer Qualifications: All primary products specified in this section will be supplied by a single manufacturer with a minimum of ten (10) years' experience.

- B. Installer Qualifications: All products listed in this section are to be installed by a single installer with a minimum of five (5) years' demonstrated experience in installing products of the same type and scope as specified.
- C. Mock-Up: Provide a mock-up for evaluation of surface preparation techniques and application workmanship.
 - 1. Finish areas designated by Architect.
 - 2. Do not proceed with remaining work until workmanship, color, and sheen are approved by Architect.
 - 3. Rebuild mock-up area as required to produce acceptable work.

1.6 DELIVERY, STORAGE, AND HANDLING

- A. Store products in manufacturer's unopened packaging until ready for installation. Protect all components off the ground, away from standing water on a hard, level surface.

1.7 PROJECT CONDITIONS

- A. Maintain environmental conditions (temperature, humidity, and ventilation) within limits recommended by manufacturer for optimum results. Do not install products under environmental conditions outside manufacturer's recommended limits.

1.8 WARRANTY

- A. Warranty: At project closeout, submit an executed copy of the manufacturer's five-year standard limited warranty against manufacturing defect, outlining its terms, conditions, and exclusions from coverage.

PART 2 PRODUCTS

2.1 MANUFACTURERS

- A. Basis of Design: Kattsafe, 5199 E 500 S, Suite 100, Whitestown, IN 46075. Tel: 888-637-7872; Email: [request info \(sales@kattsafe.com\)](mailto:request%20info%20(sales@kattsafe.com)); Web: <https://www.kattsafe.com>.
- B. Precision Ladders, LLC. PO Box 2279, Morristown, TN, 37816-2279. Tel: 800-225-7814; Email: info@PrecisionLadders.com; Web: www.PrecisionLadders.com.
- C. ALACO Ladder Co. 5167 G St. Chino, CA, 91710-5143. Tel: 888-310-7040; Email: [request info \(sales@alacoladder.com\)](mailto:request%20info%20(sales@alacoladder.com)); Web: <http://alacoladder.com>.

- D. Requests for substitutions will be considered in accordance with provisions of Section 016000 - Product Requirements.

2.2 CAGED ACCESS LADDERS:

- A. Modular Caged Aluminum Fixed Ladder for safe access to elevated areas. A Cage is considered a form of fall protection on ladders greater than 24 ft (7320 mm).
- B. Model RL41: Caged fixed ladder with grabrails.
 - 1. Material: High tensile 6106-T6 aluminum, mill finish.
 - 2. Ladder Height: Fall protection required over 24 ft (7320 mm). Refer to 'Ladder Fall Arrest System' under 'Ladder Accessories.'
 - 3. Ladder Width: 24 inches (610 mm).
 - 4. Ladder Weight: 6.4 lbs (2.9 kg) per 40 inch (1016 mm) section.
 - 5. Cage Weight: 18 lbs (8.16 kg) per 40 inch (1016 mm) section.
 - 6. Capacity: Unit shall support a 1000 lbs (453.6 kg) loading without failure, and individual treads shall withstand a 1000 lbs (453.6 kg) loading without failure.
 - 7. Performance Standard: Units designed and manufactured to meet or exceed OSHA 1910.23.

2.3 FIXED LADDER ACCESSORIES

- A. Ladder Fall Arrest System:
 - 1. Model RL50SYS: Fall arrest kit includes fall arrest mounting brackets, tensioner, termination device, sign and stainless hardware.
 - 2. Model SL228.10: Arresta Shuttle locking device with energy absorbing lanyard (1 required per user).
 - 3. Model SL230F: Stainless steel (316) cable Specify wall height.
 - 4. Capacity: For single person use; 1400 lbs (635 kg) rated.
 - 5. Performance Standard: Units designed and manufactured to meet or exceed OSHA 1910.29 and ANSI A14.3.

PART 3 - EXECUTION

3.1 EXAMINATION

- A. Do not begin installation until substrates have been properly prepared.
- B. If substrate preparation is the responsibility of another installer, notify Architect of unsatisfactory preparation before proceeding.

3.2 PREPARATION

- A. Clean surfaces thoroughly prior to installation.
- B. Prepare surfaces using the methods recommended by the manufacturer for achieving the best result for the substrate under the project conditions.

3.3 INSTALLATION

- A. Install in accordance with manufacturer's instructions, approved submittals, and in proper relationship with adjacent construction.

3.4 PROTECTION

- A. Protect installed products until completion of the project.
- B. Touch-up, repair, or replace damaged products before Substantial Completion.

END OF SECTION 055133

SECTION 190500 – THEATRICAL LIGHTING AND CONTROLS BASIC REQUIREMENTS – **REVISED
AS PART OF BID ADDENDUM 1**

PART 1 – GENERAL

1.1 GENERAL REQUIREMENTS

- A. Drawings and general provisions of the Contract, including General and Supplementary conditions and Division 01 Specification Sections, apply to this Section.
- B. It is the responsibility of the Electrical Contractor to fully coordinate the integration and installation of all equipment and furnishings as described in this section with a Theatrical Systems Integrator (TSI) to ensure proper operation of the system.
- C. One company shall be responsible for the installation of all aspects of the theatrical rigging equipment with a Theatrical Systems Integrator (TSI) to ensure proper operation of the system. Work under this section shall include furnishing all labor, materials, tools, transportation services, supervision, etc., necessary to complete installation of the stage rigging equipment as well as any other items as herein listed, all as described in these specifications, as illustrated on the accompanying drawings; or as directed by the Owner's Representative.

1.2 SYSTEM DESCRIPTION

- A. The system shall be designed for the control of architectural lighting, theatrical lighting, and audiovisual equipment. The system shall consist of factory pre-wired dimming and processing rack enclosures containing dimmers, relays, power supplies, breakers, terminals and/or control electronics.
- B. The system shall be primarily controlled via unified touch panel controls as specified.
- C. System shall work in conjunction with specified low-voltage control stations and specified control consoles.
- D. The system shall include theatrical lighting fixtures and audiovisual equipment and accessories as specified herein.

- E. The system is designed to meet specific operational requirements for the Owner and their representatives. Deviations from performance will not be accepted.

1.3 WORK INCLUDED

- A. The Electrical Contractor, as part of the work of this section, shall provide, install, and test a complete unified audiovisual and lighting control system as specified herein for areas indicated on the drawings and circuit schedules.
- B. The Electrical Contractor shall furnish all conduit, wire, connectors, hardware and other incidental items necessary for the complete and proper operation of the unified audiovisual and lighting control system.
- C. It is the responsibility of the Electrical Contractor to obtain the services of a qualified Theatrical Systems Integrator to provide the system described herein.
- D. Attach all load wires in relay panel per load schedules.
- E. Bring branch fed power feed into new relay enclosure and terminate per manufacturers' specifications.
- F. On-site training of operations personnel on the use and maintenance of the systems and equipment provided as part of this specification.
- G. New dimming and control equipment shall be appropriately sized to accommodate all existing loads, as well as leave room for future expansion.

1.4 QUALITY ASSURANCE

- A. All equipment, where applicable standards have been established, shall be built to the standards of Underwriters Laboratories, Inc., the National Electric Code and the United States Institute for Theater Technology. Permanently installed power distribution equipment such as dimmer racks and distribution shall be UL and C-UL Listed, and/or CE marked (where applicable) and bear the appropriate labels. Portable equipment such as consoles and fixtures shall be UL and C-UL Listed, ETL Listed and/or CE marked (where applicable) and bear the appropriate labels.

1.5 SCOPE

- A. Due to the complexity of this system and the specific combination of equipment and services required for professional installation, equipment in this specification shall be purchased from an approved Theater Systems Integrator (TSI) hired by the general contractor.

- B. This is a single source specification, one Theatrical Systems Integrator (TSI) shall be responsible for supplying the unified audiovisual and lighting control equipment, audiovisual equipment, stage lighting fixtures, dead hung rigging, Project Management, stage lighting fixture hanging and focusing, audiovisual tuning and alignment, and programming of the system prior to Owner's possession.

- C. The Theatrical Systems Integrator shall be a sub-contractor to and fully coordinated by the Division 26 Electrical Contractor.

- D. The Theatrical Systems Integrator shall be responsible for supervising the installation of the unified audiovisual and lighting control equipment. Specifically; provide a dedicated Project Manager, to schedule shipments of equipment, coordinate deliveries, answer system inquiries, and generally oversee the installation of the unified audiovisual control equipment, audiovisual equipment, theatrical rigging, and circuit distribution.

- E. It is the responsibility of the Theater Systems Integrator, in conjunction with the manufacturers, to provide the following:
 - 1. Verification of dimensions and conditions in contract documents prior to equipment installation.
 - 2. Coordination of scheduling and delivery of materials to job site.
 - 3. Testing and inspection of completed installation.
 - 4. Electronic PDF sets of submittals and shop drawings for approval by Architect prior to installation.
 - 5. Turn-on/Energization of unified audiovisual and lighting control system, initial programming of system and components.
 - 6. System training for owner representatives
 - 7. Coordination with associated trades in the field.

1.6 Contractor Responsibility Matrix

Item	GC		EC		TSI	
	Furnish	Install	Furnish	Install	Furnish	Install
<u>Control & Power</u>						
Power Feeds			X	X		
Power Disconnects			X	X		
Dimming Enclosures/System Controlled Relay Panels				X	X	
Control Rack Internal Equipment					X	X
Control Rack				X	X	
Interconnections From Control Rack to Peripheral Components			X	X		
Line Voltage Wire			X	X		
Line Voltage Wire Terminals			X	X		
Low Voltage Wire			X	X		
Low Voltage Terminations			X	X		
Conduit			X	X		
<u>Power and Data Distribution</u>						
Power Outlet Boxes			x	x		
Branch Wiring from Power Control Enclosures to Outlet Boxes			x	x		
Data Outlet Boxes				x	x	
Low Voltage Wiring To Outputs Inside Outlet Boxes & Inputs For Consoles			x	x		
Low Voltage Wiring from Outlet Boxes to			X	X	X	

Consoles and other Peripherals						
Consoles Plug-In Stations				X	X	
Containment			X	X		
<u>Peripheral Components</u>						
Lighting Fixtures and Accessories				X	X	
Lighting Control Console and Accessories					X	X
Speakers and Accessories				X	X	
Audio Console and Accessories					X	X
Projectors, Projector Screens, and Accessories				X	X	
Cameras and Accessories				X	X	
Video Console and Accessories					X	X
Faceplate/Wallplates				X	X	
<u>Miscellaneous</u>						
Fire Stop			X	X		
Cutting/Patching/Painting	X	X				
Protection of Existing Floors/Walls/Surfaces	X	X				
Disposal/Cleanup/Carting	X	X				
System Commissioning					X	
System Training					X	
Temporary Work Lights and Power			X	X		
Ventilation	X	X				

PART 2 - THEATRICAL SYSTEMS INTEGRATOR (TSI)

2.1 General

- A. The provider of the system herein described shall be acknowledged in business as a Theatrical Systems Integration Company, hereafter referred to as TSI. This company shall employ full-time Systems Integrators and Project Managers with experience in completing work of similar or greater size and scope. The role of the TSI in this project shall be to provide all equipment listed in this section to the Electrical Contractor for installation. The TSI shall furnish a complete working system to the Electrical Contractor, meeting the intent of this specification. The TSI shall coordinate delivery schedules and installation of equipment with the Electrical Contractor. Additionally, the TSI shall be responsible for all documentation for equipment in this section, system record drawings, final testing of the system and training of the Owner's personnel as required by this specification.

2.2 Description

- A. The TSI shall have experience in the operation and installation of similar equipment associated with the construction and/or renovation of facilities similar in scope to this project.
- B. The TSI shall be an authorized service provider of the specified unified audiovisual and lighting system.
- C. The TSI shall be an authorized dealer for an adequate number of manufacturers of system products necessary to provide a complete working system meeting the intent of this specification. System products shall include, but are not limited to, the following:
 - 1. Unified Audiovisual and Lighting Control System
 - 2. Lighting Fixtures
 - 3. Power Distribution Equipment
 - 4. Speakers
 - 5. Microphones
 - 6. Projectors and Projection Screens
 - 7. Audiovisual Accessories

8. Stage Accessories
 9. Static Electric Onstage Line Sets
- D. The TSI shall be located within fifty (50) miles of the job site.
- E. The TSI shall offer a Maintenance and Service Contract.
- F. The TSI shall have on staff at least two (2) full-time manufacturer-certified field service technicians and have technical support and assistance accessible twenty-four (24) hours a day, seven (7) days a week.
- G. For a 2-year warranty period, the TSI shall be responsible as the Owner's sole contact for the remedy, repair, or replacement of system deficiencies.

2.3 Project Management

- A. The Systems Integration Company shall designate a dedicated Project Manager. The TSI's Project Manager shall be the main contact between the Systems Integrator, Manufacturers, Architects, Engineers and Contractors from contract award until final sign off.
- B. The TSI's Project Manager shall attend a Kick-Off Meeting at the project site or a place to be designated. The objectives of the Kick-Off Meeting are:
1. Introduce the Project Team Members.
 2. Review the Project Schedule.
 3. Review the Scope of Work and any additional materials and documents not in the Scope of Work.

2.4 Approved Theatrical Systems Integration Companies shall be the following:

- A. PureTek Group
315 Wootton Street
Boonton, NJ 07005
Ph: (973) 915-3133

2.5 Warranty

- A. All systems, including all parts and labor, shall be under full warranty for a period of not less than two (2) years from the date of written final acceptance. In the event that any of the equipment should fail to produce capacities or meet design characteristics as specified, it shall be replaced with equipment that will meet requirements without additional cost. After occupancy, any necessary work performed shall be done at the convenience of the Owner's operational schedule, including overtime, if required.

PART 2 – PRODUCTS

1. Unified Rigging Audio Visual Lighting Controls

A. Acceptable Systems

1.unRAVL

B. Control Rack – General

1. Provide multi-microprocessor based, solid state rigging-audio-video-lighting processors (RAVL-P) that functions independently and in conjunction with lighting consoles, audio consoles, and video consoles.
2. RAVL-P shall be capable of controlling dimming racks, relay panels, addressable LED system (where applicable), automated lighting fixtures, automated hoists rigging systems, audio consoles, projectors, motorized projection screens, digital displays, speakers, and other devices via appropriate protocols (DMX, RDM, sACN, Dante, dry contact).
3. Digital network control system capable of remote access by manufacturer with the following features:
 - a. System diagnostics including detection of fault condition in hardware or connected devices.
 - b. Access to all connected devices for complete programming including scheduling of time-of-day events and device parameters necessary to meet required sequence of operations.
 - c. Browser-based interface to verify system functionality.
 - d. On-demand access to manufacturer technical support for remote troubleshooting, diagnostics, configuration, and programming.
4. Programming of system integration backbone to be done via javascript and shall not require proprietary software packages not available for download and installation by the system installer and end customer.
5. Programming of system and system updates to be performed by certified integrator

6.RAVL-P Functions:

- a. One-Touch control for system presets (rigging, audio, video, lighting) via Presets Menu.
- b. Full control over audio input/output active selection and levels of input/output.
- c. Control over video signal distribution. Signals for different video transmission devices can be routed to any or all of the available video outputs as indicated on the touch screen. Video signals in to be shown in thumbnails on the video signal distribution control page.
- d. Full granular control of lighting levels, color (where applicable), and focus (where applicable), including entry station and touchscreen presets. Creation of cues and cues activation available through touchscreen interface.
- e. Control over power sequencing of the audio and visual projection systems. Power control includes power cycling of the following items:
 - 1) Rack power in the following proper sequence to not damage equipment:
 - i. Power speaker amplifiers (8 amplifiers sequenced)
 - ii. Power microphone systems
 - iii. Power audio mixer systems
 - 2) Video projector
 - 3) Theatrical lighting electrical pipes system power
- f. Priority setting for lighting control
 - 1) Priority setting to be fully customizable
 - 2) Default setting to have touchscreen and entry stations at a lower priority than console.
 - 3) Console to have full and exclusive control of lighting system when connected and powered on.
- g. QR Code provided for external device to connect and control system. Device must be on same network as control system.

7.Audio Powered Output Properties

- a. Control Rack to have eight (8) audio power amplifier to power external passive speakers:

- 1) Amp A: 8-channel power amplifier with integrated DSP, 4 x 800 Watts RMS @ 4-Ohms Output
- b. Features
- 1) Professional power amplifier for high and low-impedance loads
 - 2) Digital signal processor (DSP) with FIR-filters (FIR-Drive)
 - 3) USB 2.0 connection for PC remote control and supervision
 - 4) Four (4) balanced analogue audio inputs on 3.81 mm Euroblock connectors (Input 1 and 2 can be switched to AES/EBU digital input and output)
 - 5) Four (4) power outputs in 5.08mm Euroblock format
 - 6) Two (2) Ethernet ports capable of supporting transmission of four (4) Dante® digital inputs and four (4) Dante® outputs
 - 7) Four (4) configurable GPIO (General Purpose Input/Output) ports
 - 8) Standby control input
- c. Digital Signal Processing
- 1) AD: 24 Bit @48kHz
 - 2) DA: 24 Bit @48kHz
 - 3) Limiters: Compressor on processing channels, Peak limiter on output channel (also used in dBTechnologies preset)
- d. Amplifier
- 1) Protection package: Thermal protection, output short circuit, RMS output current protection, high frequency protection, power limiter, clip limiter
 - 2) Audio and logic connectors:
 - i. Input:
4 x Analogue (Euroblock) or 2 x Analogue + AES/EBU (user configurable)
 - ii. Output:
4 x amplified outputs, AES/EBU (configurable)
4 x Dante® channels
 - iii. Remote connectivity:
 1. 2x Ethernet RJ45
 2. 1x USB-B

3. 3.81mm Euroblock format, which can be used as GPI, GPO, analogue and as a dedicated standby input
- e. Technical specifications:
 - 1) Type: Switching mode, Class D Amplifier
 - 2) Impedance: Minimum 4 Ω
 - 3) Frequency Response (8-Ohm): 20 Hz – 20 kHz (± 0.5 dB)
 - 4) Amplifier gain: 31 dB
 - 5) Signal/noise ratio: > 103 dB(A)
 - 6) Input sensitivity: +4 dBU
 - 7) Maximum input level: +18 dBU
 - 8) Crosstalk: 100 dB
 - 9) Input impedance: 20 kOhm
8. Communication Protocols:
 - a. ANSI E1.11-2004 (USITT DMX-512/1990)
 - b. ANSI/PLASA E1.20 (RDM)
 - c. ANSI/PLASA E1.31 (sACN)
 - d. ANSI/PLASA E1.17 (ACN)
 - e. IEEE 802.3 Ethernet
 - f. IEEE 802.3af Power-over-Ethernet (PoE)
 - g. IEEE 802.1AB Link Layer Discovery Protocol (LLDP)
 - h. IEEE 802.1Q VLAN Support
 - i. IEEE 802.1w Rapid Spanning Tree Protocol (RSTP)
 - j. RS-232
 - k. Contact closure input and output
 - l. Dante Protocol
9. Control capacity
 - a. DMX Universes: 63,999 sACN Universes (8 universes on non-networked DMX-512 port input/output per gateway)
 - b. Audio I/O: 64 input / 64 output
 - c. Video I/O: No hard limit; Networked video streams limited by system bandwidth
10. Rack Attributes:
 - a. Equipment rack shall be EIA compliant 19", steel cabinet.
 - b. Color: Powder coat black
 - c. Rackrail Type: 10-32

11. Physical attributes (rack)
 - a. Overall height: 68.25 in
 - b. Center section height: 65.38 in
 - c. Racking height: 61.25 in
 - d. Rack spaces: 35 SP
 - e. Weight capacity: 300 lbs
12. Electrical
 - a. 120Vac
 - b. (4) 20A dedicated circuits in (4) Quad Edison receptacles
 - c. 2600W
 - d. Internal 2000VA UPS system to power critical components in the event of a power failure or brownout.
13. Heat Generation
 - a. 8,840 BTU
14. Foot Print
 - a. From mounting surface: 39.6 in
 - b. Width: 47 in
 - c. Height: 68.25 in
15. Environmental
 - a. Operating temperature
 - 1) Minimum: 40 degrees Fahrenheit
 - 2) Maximum: 100 degrees Fahrenheit
 - b. Operating non-condensing humidity
 - 1) Minimum: 20 percent
 - 2) Maximum: 85 percent
 - c. Cooling method: Passive convection.

C. Touchscreen

- 1.Touchscreen stations shall consist of backlit LED display
 - a. Minimum viewable display size: 10.1 in
 - b. Minimum resolution: 1280x800
 - c. Bezel: Aluminum
 - d. Touch interface: Capacitive with LED backlight
 - e. Viewing angle: 170° horizontal and vertical
 - f. Finish: Black
 - g. Provide metal backbox and mounting frames
- 2.Electrical

- a. Powered device: 1 Watt via PoE
 - b. Integral RGB LED status indicator light
3. Input/Output:
- a. (2) RS-232 (Up to 115k Baud)
 - b. USB Type-C
 - c. IR (Bi-Directional)
 - d. RJ-45 10/100/1000M PoE (PD)
 - e. Digital I/O
 - 1) (2) with A/D capability
 - 2) Output Voltage: 5v
 - 3) Output Power: 17mA
 - 4) Input Max Voltage: 12VDC @ 500mW
 - f. Relay
 - 1) 2) Normally Open
 - 2) Max Current: 2A
4. Connect to control system using category 6 or better wire.
5. Master stations shall provide control of lighting processor presets, audio processor presets, video processor presets, sequences, fade times, macros, timeclock events, projector screen motor and interfaced external systems.
6. Master stations shall operate using graphic buttons, faders, and other images on programmable control pages.
7. Secondary stations capable of having customizable control pages that differ from the Master station.
8. Master and Secondary stations to have a QR code page enabling third party mobile devices to display and control the respective control pages.
9. There shall be at least 60 custom control pages available for programming and customization.
10. Status indication shall be tracked across all stations in real-time, including tracking of fades on graphical fader controls.
11. Stations shall allow programming of multiple-level passcodes, page lockout, and visibility. Touchscreen shall have the capability to program at least 10 passcodes with fully customizable control pages per passcode.
12. Passcode timeout lockout to be custom programmed.
13. Control pages shall include:
- a. unRAVL presets

- b. House lighting levels and presets
 - c. Theatrical lighting levels, presets, cues
 - d. Audio levels and presets
 - e. Video feed selection
 - f. System Tutorial
 - g. Student Education
 - h. Settings
14. Page layout and interface functionality shall be determined by the RAVL Consultant following approval of shop drawings. Programming services shall be provided by the Manufacturer.
15. Environmental
- a. Operating temperature
 - 1) Minimum: 40 degrees Fahrenheit
 - 2) Maximum: 100 degrees Fahrenheit
 - b. Operating non-condensing humidity
 - 1) Minimum: 20 percent
 - 2) Maximum: 85 percent
 - c. Cooling method: Passive convection.

D. Entry Stations

1. System snapshot, playback, preset, and fader wall station.
2. Connect to control system using category 6 or better wire.
3. Power coat variants:
 - a. White
 - b. Black
4. Variants:
 - a. Two Button
 - b. Four Button
 - c. One Slider
 - d. Two Slider
 - e. Three Slider
5. Mechanical
 - a. Housing
 - 1) Mounting:
 - i. Stainless steel single piece front plate
 - ii. Injection molded polycarbonate back box
 - 2) Stainless steel decorator wall plate powder coat variants:
 - i. Black.
 - ii. White.

- b. Mounting: 2 inches wide by 3 inches tall electrical box
 - 1) Maximum Wall Station Width: 6-inserts
 - i. First Insert: 1 Primary
 - ii. Maximum Additional Inserts: 5 Secondary
 - c. Ports
 - 1) Primary Variant
 - i. One 8-pin male header connector for Secondary Variant.
 - ii. One power over ethernet RJ45 jack.
 - 2) Secondary Variant
 - i. One 8-pin male header connectors.
6. Electrical
- a. Powered device: 1 Watt via PoE
 - b. Single-color integral LED status indicators:
 - 1) One activity.
 - 2) One link.
 - c. One tri-colored integral LED status indicator per button or slider.
7. Functional
- a. Standalone and independent operation
 - b. Maximum IP address based on networking architecture.
 - c. Configuration
 - 1) Configuration via unRAVL system computer.
 - i. Subsequent configuration via integral interface, specified herein.
 - 2) Priority Control: Highest Takes Precedence.
 - d. Primary Variant
 - 1) Connect via header with secondary variants.
 - 2) Button Variant
 - i. Independent playback of recorded scenes.
 - 1. Snapshot program.
 - 2. Record Allow
 - a. Is True: Push and hold individual button for 5 seconds to record current state.
 - b. Is False: Push and hold has no function.
 - 3) Slider Variant: Manual control of recorded scenes.
 - e. Secondary Variant
 - 1) Primary variant dependent.
 - 2) Connect via header with primary or secondary variants.
 - 3) Button Variant: Independent playback of recorded scenes.
 - 4) Slider Variant: Manual control of recorded scenes.

- f. Tri-color integral LED status indicator
 - 1) Button Variant
 - i. Amber: No sACN source found for selected universe.
 - ii. Dark Amber: Lock button configured, inactive.
 - iii. Light Amber: Lock button configured, active.
 - iv. Blue: Button is currently pressed and held.
 - v. Light Blue: Snapshot activated, in progress.
 - vi. Green: Snapshot recording complete.
 - vii. Grey: Inactive recorded snapshot.
 - viii. Magenta: Snapshot is overridden by slider.
 - ix. Red: Record Allow is true.
 - x. Dark Red: Record Allow is false.
 - xi. Pink: Priority override, active.
 - xii. Purple: Snapshot deactivated, in progress.
 - xiii. Seafoam: Priority override, inactive.
 - xiv. Teal: Snapshot activated to override current snapshot.
 - xv. Yellow: Deactivate snapshot.
 - 2) Slider Variant
 - i. Green: Grand master slider at full.
 - ii. Red: Grand master slider is not at full.
 - iii. White: Zone intensity as indicated.
 - g. Protocol: sACN
 - h. Slider variant: 256 programmable unique intensity states.
- 8.Environmental
- a. Operating temperature
 - 1) Minimum: 14 degrees Fahrenheit
 - 2) Maximum: 122 degrees Fahrenheit
 - b. Operating non-condensing humidity
 - 1) Minimum: 5 percent
 - 2) Maximum: 95 percent
 - c. Cooling method: Passive convection.
- E. Relay Panel
- 1.Connect to control system using category 6 or better wire.
 - 2.Outputs: [4] [8] [12] [16] [24] [32] [40] [48] Individual relays per panel, with an equal number of individual 0-10 V(dc) dimming outputs.
 - 3.Field Configurable Relays (FCR):
 - a. Field configurable to operate in single-, double-, or triple-pole relay groupings.
 - b. Field configurable to operate as normally closed or normally open.

- c. Provides visual status of current state and manual override control of each relay.
 - d. Minimum Relay Contact Ratings:
 - 1) 40 A at 120-480 V(ac) Ballast.
 - 2) 16 A at 120-277 V(ac) Electronic.
 - 3) 20 A at 120-277 V(ac) Tungsten.
 - 4) 20 A at 48V (dc) Resistive.
 - 5) 2 HP at 120 V(ac).
 - 6) 3 HP at 240-277 V(ac).
 - 7) 65kA SCCR at 480 V(ac).
4. Dimming Output Rating: Minimum of 100 mA sink current per dimming output.
5. Relay and dimming outputs individually programmable.
6. Listing: UL 924 for control of emergency lighting circuits.
7. Power Supply: Integrated 120-277 V(ac) supply.
8. Low-Voltage Sensor Input:
- a. Configurable to support any of the following input types:
 - 1) Indoor Photosensor.
 - 2) Outdoor Photosensor.
 - 3) Occupancy Sensor.
 - 4) Contact Closure.
 - b. Low-voltage sensor input provides 24 V(dc) power for sensor so additional auxiliary power supplies are not required.
 - c. Sensor input supports all standard sequence of operations.
9. Integrated Digital Time Clock for local schedule control.
10. Contact Closure Input: One for each group of eight output relays that acts as a panel override to activate the normally configured state of all associated relays (i.e., normally open or normally closed).
11. Panel supplies current limited low-voltage power to other networked devices connected via low-voltage network cable.
12. Enclosure:
- a. Enclosure Rating: NEMA 1.
 - b. Mounting: [Surface] [Flush] mounted.
 - c. Cover: [Hinged cover with keyed lock] [Screw-fastened and plenum rated].

PART 3 – EXECUTION

1. PROTECTION OF EQUIPMENT

- a. It shall be the responsibility of the Electrical Contractor to receive, store, and protect the equipment in this section from damage and deterioration during all phases of work from the delivery of materials to the completed installation.

2. INSTALLATION

- a. The Electrical Contractor shall install system components as located on the architectural drawings. Installation shall be in accordance with architectural requirements, manufacturer's written instructions, TSI's shop drawings, recognized industry practice, applicable requirements of the National Electrical Code and UL standards, and in accordance with OSHA and local codes.
- b. The Electrical Contractor shall be licensed to operate as an Electrical Contractor in the state of New Jersey. The Electrical Contractor shall provide a copy of their License and an Insurance Certificate for this project.
- c. The Electrical Contractor shall be responsible for providing all bonding, job permits, and related fees as applicable.
- d. The Electrical Contractor shall be responsible for removal and disposal of all waste materials created by this installation process including but not limited to shipping and packaging materials, and items removed from existing system.
- e. The Electrical Contractor shall be responsible for all lifts, ladders, scaffolding and/or other devices required for the complete installation of this system.
- f. The Electrical Contractor shall be responsible for coordinating the installation, testing, and commissioning of the system with the Theatrical Systems Integrator.
- g. All load circuit conductors and data wiring for these systems shall be installed in a manner that is concealed above hung ceiling, below floors or in walls whenever possible and in metallic conduit, metal wireways, surface metal raceways, or other approved cable containment. Use of metal-sheathed or armored cable shall not be accepted without prior approval.
- h. All branch load circuits shall be live tested before connecting the loads to the dimmer system load terminals. Each circuit shall require separate neutrals.
- i. The Electrical Contractor shall not provide power to the Unified Rigging Audio Visual Lighting Control System until connections are site-verified by the Theatrical Systems Integrator.
- j. The Electrical Contractor shall be responsible for return visits by the Theatrical Systems Integrator due to incomplete or incorrect wiring or connections.
- k. The General Contractor shall be responsible for all painting and patching that may be required as a product of this installation process.

3. THEATRICAL SYSTEMS INTEGRATOR'S SERVICES

- a. The Theatrical Systems Integrator shall be responsible for the hanging, focusing, and addressing of the theatrical lighting fixtures.
 - b. The Theatrical Systems Integrator, with the assistance of the Electrical Contractor, shall be responsible for the tuning, adjusting, and programming of the audio and visual systems.
 - c. The Theatrical Systems Integrator shall be responsible for final testing of system functionality. The Electrical Contractor shall provide 21-day notice to schedule testing with the TSI upon completion of the installation.
 - d. Upon completion of installation, commissioning, and testing, the Theatrical Systems Integrator shall be responsible for demonstrating system operation to owner's representatives.
 - e. Upon completion of installation, commissioning, and testing, the Theatrical Systems Integrator shall be responsible for providing adequate training on system operation and maintenance to owner's representatives as per section [].03.06.
 - f. The Theatrical Systems Integrator shall be responsible for providing adequate training on system operation and maintenance to owner's representatives as per section [].03.06.
 - g. The Theatrical Systems Integrator shall be responsible for providing adequate guidance to accessing and administering student education resources as per section [].03.06.
4. COMMISSIONING
- a. Upon completion of commissioning, TSI shall demonstrate operation to owners representatives.
5. EDUCATION AND TRAINING
- a. System Training
 - i. Upon completion of the formal check-out, the Theatrical Systems Integrator shall demonstrate operation and maintenance of the system to the owner's representatives. Training session shall not exceed six working hours. For venues with motorized rigging, the training session shall not exceed eight working hours.
 - ii. Scheduling for training sessions shall be made in writing to the Theatrical Systems Integrator with at least 21-day notice prior to the date of system training.
 - iii. (2) additional 8-hour days of training and system maintenance with the Theatrical Systems Integrator are included as part of system warranty.

Training dates must be utilized within (3) years of date of completion of formal check-out.

- iv. System instructions including video and written documentation are to be accessible via Unified Rigging Audio Visual Lighting Control System touch panel controller.

b. Student Education Package

- i. At least twenty (20) hours of video content created for the sole purpose of student education is to be accessible to cast on projection screen via Unified Rigging Audio Visual Lighting Controls touchpanel control presets.
- ii. Student education content to be designed in accordance to the curriculum for the United States Institute for Theatre Technology BACKstage Examination and is to be instructed by credentialed industry professionals.
- iii. Content designed as manufacturer technology overview or manufacturer technology instructions as utilized for marketing or industry professional instruction will not be accepted.
- iv. TSI shall provide training to owner's representatives for video access and BACKstage examination registration.

6. WARRANTY AND SERVICE

a. System Warranty

- i. Manufacturers shall warrant Unified Rigging Audio Visual Lighting System products under normal use and service to be free from defects in functionality for a period of two (2) years from date of delivery.
- ii. Warranty shall cover repair or replacement of such parts determined defective upon inspection.
- iii. Installation shall be warranted by the installing contractor as required by the project specifications.
- iv. Warranty shall not cover any labor expended or materials used to repair any equipment without manufacturer's prior written authorization.
- v. Warranty does not cover any product or part of a product subject to accident, negligence, alteration, abuse, or misuse.
- vi. Warranty does not cover any accessories or parts not supplied by the manufacturer.

END OF SECTION 190500

SECTION 265561 – ELECTRICAL WORK FOR THEATRICAL LIGHTING – REVISED AS PART OF BID
ADDENDUM 1

PART 1 - GENERAL

1.1 SUMMARY

- A. Section Includes: Electrical work associated with the installation of theatrical lighting systems and equipment.

1.2 RELATED SECTIONS

- A. Division 19- All Sections.
- B. 265565- Theatrical Lighting Miscellaneous Equipment.
- C. 265569- Electrical Work for Theatrical Audio/Video.

PART 2 - PRODUCTS

2.1 RACEWAYS, BOXES, BUILDING WIRE, GROUNDING, ETC.

- A. Comply with 260501- Electrical Materials and Equipment.

2.2 THEATRICAL LIGHTING EQUIPMENT AND DEVICES

- A. General: As specified and furnished under Division 19 and as indicated on the Division 19 Drawings.

2.3 THEATRICAL LIGHTING CABLES

- A. General: As specified herein and/or on the Drawings.
- B. Confirmation: Confirm all required wire/cable types with the Division 19 Theatrical Equipment Contractor, prior to ordering cable or commencing work.

PART 3 - EXECUTION

3.1 GENERAL

- A. Summary: In general, Theatrical Lighting systems and equipment are to be furnished by Division 19 and are to be installed and wired by Division 26. Line voltage wire terminations to be performed by Division 26. All low voltage control wiring terminations to be performed by Division ~~19~~ 26 (under the supervision of Div. 19). See 190500- Theatrical Lighting and Controls Basic Requirements below Responsibility Matrix for further specifics of the division of responsibilities.

1. Exception: Provide (furnish, and install) all theatrical lighting miscellaneous equipment specified under 265565- Theatrical Lighting Miscellaneous Equipment.
 - B. Scope: Provide all electrical work associated with theatrical lighting systems and equipment as indicated on the Electrical Drawings and as specified herein.
 - C. Preparation: Obtain and review all Theatrical Lighting Product Data, Shop Drawings and manufacturers' installation instructions, and become thoroughly familiar with requirements of same, prior to commencing work. Examine actual equipment to verify proper connection locations and requirements.
 - D. Coordination: Sequence electrical rough-in and wiring to coordinate with the installation and start up schedule and work of Division 19- Theatrical Equipment.
 - E. Protection of Equipment: During installation, and up to the date of System Acceptance, the Division 26 Contractor shall be under obligation to protect the Theatrical Lighting Contractor's finished and unfinished work, and all items furnished by Division 19 to Division 26 for installation by Division 26) against damage and loss. In the event of such damage or loss, the Division 26 Contractor shall replace or repair such work/item at no cost to the Division 19 Contractor.
- 3.2 RACEWAYS, BOXES, WIRE, GROUNDING, ETC.
 - A. General: Comply with 260501- Electrical Materials and Equipment.
 - B. Raceways: Provide all raceways required for Theatrical Lighting systems and equipment. This includes all those indicated and/or required for both line voltage power circuits and low voltage control lines.
 - C. Boxes: Unless Theatrical Equipment device/station is furnished with a custom box (confirm with Division 19), provide all necessary pull, junction, outlet and back boxes indicated and required for all Theatrical Lighting devices, control stations, etc.
 - D. Locations: All exact outlet locations are subject to Architect/Engineer's approval.
- 3.3 WIRE AND CABLE INSTALLATION
 - A. General: Provide all line voltage and low voltage control wires/cables as indicated and required by Division 19 for satisfactory operation of all Division 19 provided equipment, devices and control stations. At equipment and device boxes, leave slack cables in lengths as required ~~for proper terminations, by the Theatrical Lighting Equipment Manufacturer's Installation Technician.~~
 - B. Line Voltage Power Wiring: Install all line voltage wiring in specified metal raceway, sized as indicated and per NEC. Install all wiring without splices, unless specifically approved.
 - C. Low Voltage Control Wiring (Plenum Rated Cables Only): May be run without raceway only when concealed within interior building construction (e.g. above suspended ceilings), and unless raceway protection is necessary for protection and/or proper system operation.

Run cables together in groups, and away from other electrical lines as much as possible. Neatly support and secure all cables to building structure (do not droop cables). Securely fasten cables at least every 5 feet and within 12 inches of outlet boxes.

1. All Non-Plenum Rated Cables: Must be installed in metal conduit.
2. All Cables to be installed in Unfinished Areas: (E.g. Mechanical, Electrical and Storage Rooms, Whitney Auditorium Stage and Control Booth, all rooms on Ground Floor below the Whitney Auditorium, etc.). Provide conduit protection for all cables installed in these areas.
3. Cables to be Installed on Catwalk Level (Above Whitney Auditorium Ceiling): Provide conduit protection for all cables installed on the Catwalk Level, unless indicated or approved otherwise.

D. For All Low Voltage Control Wiring Required to be Installed in Raceways:

1. Size: All raceways to be sized as indicated or per NEC, allowing minimum 25% spare fill capacity, whichever is larger.
2. Where cable(s) penetrate fire rated barriers, would be left exposed or susceptible to damage, install in specified metal raceway.
3. On Stage Walls and Horizontal Runs Above Stage: All cables running along or up Stage walls, and all cables running overhead above Stage are to be installed in existing and/or new specified metal raceways. Prime and paint (Matte Black) all such new conduits, and all existing conduits remaining which are not already completely painted Black.

- E. Low Voltage Cable Splices: Install all wiring without splices, unless specifically approved. All splices (if approved) to be made up in outlet or junction boxes. Exposed splices will not be permitted.

3.4 THEATRICAL LIGHTING EQUIPMENT AND DEVICES

- A. General: (For Division 19 furnished equipment required to be installed by Division 26)- Accept equipment and devices from Division 19, and confirm in undamaged condition. Resolve any discrepancies before proceeding. Install equipment and devices per the respective manufacturer's written instructions and as directed by the Theatrical Lighting Contractor.
- B. Coordination: Coordinate the details of equipment and device installation and wiring requirements with Division 19.

3.5 THEATRICAL LIGHTING RESPONSIBILITY MATRIX

- A. General: Refer to 190500- Theatrical Lighting and Controls Basic Requirements. Responsibility and specific division of work between Division 19 and Division 26 for

CSArch
188-2301.02

City School District of the City of New Rochelle
2023 Capital Project – Phase 2B

Theatrical Lighting systems and equipment, and the electrical work related thereto shall be as delineated therein, per the following table (see next page):

ELECTRICAL WORK FOR THEATRICAL LIGHTING (BID ADD. 1)

265561 - 4

THEATRICAL LIGHTING SYSTEMS/EQUIPMENT RESPONSIBILITY MATRIX								
ITEM	NOTES	FURNISHED BY	INSTALLED BY	BOX & RACEWAY ROUGH-IN BY	PERMANENT POWER CABLES PROVIDED BY	PERMANENT CONTROL CABLES PROVIDED BY	PERMANENT POWER CABLES TERMINATED BY	PERMANENT CONTROL CABLES TERMINATED BY
RIGGING WORK		DIV. 19	DIV. 19	-	-	-	-	-
LIGHTING CONTROL PANELS	1	DIV. 19	DIV. 26	DIV. 26	DIV. 26	DIV. 26	DIV. 26	DIV. 19
ARCH. LIGHTING CONTROL STATIONS	-	DIV. 19	DIV. 19	DIV. 26	DIV. 26	DIV. 26	DIV. 26	DIV. 19
LIGHTING CONTROL CONSOLE	-	DIV. 19	DIV. 19	-	-	-	-	-
STAGE ELECTRIC CONNECTOR STRIPS	2	DIV. 26	DIV. 19/26	DIV. 26	DIV. 26	DIV. 26	DIV. 26	DIV. 19
RECEPTACLE BOXES		DIV. 26	DIV. 26	DIV. 26	DIV. 26	-	DIV. 26	-
GRID IRON J BOXES (POWER)	-	DIV. 26	DIV. 26	DIV. 26	DIV. 26	-	DIV. 26	-
GRID IRON J BOXES (NETWORK & DMX)	-	DIV. 26	DIV. 26	DIV. 26	-	DIV. 26	-	DIV. 19
THEATRICAL LIGHTING CONTROL STATIONS	-	DIV. 19	DIV. 26	DIV. 26	-	DIV. 26	-	DIV. 19
THEATRICAL LIGHTING FIXTURES	3,4,5	DIV. 19	DIV. 19	-	-	-	-	-
NOTES								
1	DIV. 19 MEANS THE DIVISION 19 THEATRICAL LIGHTING CONTRACTOR/INTEGRATOR.							
2	DIV. 26 MEANS THE DIVISION 26 ELECTRICAL CONTRACTOR.							
1	INCLUDES RACEWAYS, AND FEEDER AND BRANCH CIRCUIT CONDUCTORS, AND CONNECTING BRANCH CIRCUIT CONDUCTORS AND CONTROL CABLES.							
2	RIGGING/MOUNTING OF CONNECTORS STRIPS TO BE BY DIV. 19. ELECTRICAL TO BE AS INDICATED HEREIN.							
3	FIXTURES TO BE LOCATED, CLAMPED AND SAFETIED BY DIV. 19.							
4	FIXTURES TO BE CONNECTED TO 120V POWER RECEPT/PIGTAIL AND DMX BY DIV. 19.							
5	FIXTURES TO BE AIMED, FOCUSED AND SHUTTERED BY DIV. 19.							

Formatted Table

Formatted Table

Formatted Table

Formatted Table

END OF SECTION 265561

CSArch
188-2301.02

City School District of the City of New Rochelle
2023 Capital Project – Phase 2

THIS PAGE INTENTIONALLY LEFT BLANK

| ELECTRICAL WORK FOR THEATRICAL LIGHTING (BID ADD. 1)

265561-5

SECTION 265565 – THEATRICAL LIGHTING MISCELLANEOUS EQUIPMENT – REVISED AS PART OF
BID ADDENDUM 1

PART 1 - GENERAL

1.1 SUMMARY

- A. Scope of Work: Provide miscellaneous electrical work associated with theatrical lighting systems including: Grid iron boxes, connector strips, receptacle boxes, and other specified electrical or related items.

1.2 RELATED SECTIONS

- A. Division 19- All Sections.
- B. 265561- Electrical Work for Theatrical Lighting.
- C. 265569- Electrical Work for Theatrical Audio/Video.

1.3 QUALITY ASSURANCE

- A. Manufacturers: Shall have continuously engaged in the production of theatrical lighting equipment for at least fifteen years.

1.4 GUARANTEE

- A. Manufacturer's Warranty: Including all parts, labor and travel to replace defective materials and workmanship, for a period of two years.

1.5 SUBMITTALS

- A. Product Data: Manufacturer's descriptive literature for each type of theatrical lighting equipment and accessory to be submitted under this Section.
- B. Shop Drawings:
 - 1. Complete description, specifications and detailed and dimensioned factory drawings and wiring diagrams for all grid iron boxes and connector strips.

PART 2 - PRODUCTS

2.1 GRID IRON JUNCTION BOXES- POWER AND DMX

- A. General: To be furnished under Division 19. Acceptable Manufacturers: ETC; Altman; SSRC.
- B. Description: General: Grid iron junction boxes (combination power and DMX) designed for connection between incoming hard conduit and /wire/cable feeds and outgoing multi-

conductor cable drops to connector strip terminal boxes located on dead hung or flying pipe battens.

~~C.—Description: U.L. listed, code gauge, cold rolled steel housing containing terminal strip(s) of appropriate quantity/size for respective circuit terminations, with factory installed ground lugs. Terminal strip shall be of the barriered, screw clamp type for #14-8 AWG wires in quantities as specified, indicated or required. Housing shall be designed for surface mounting. Finish shall be flat black enamel. When cable drops are used, Kellems grips of appropriate size shall be supplied for termination at box, one per drop. Each terminal block phase terminal to be identified as to respective Lighting Control Panel circuit number (and each neutral terminal to be identified same plus "N").~~

~~D.—Multi-Conductor Cables: 10-gauge, multi-conductor, 90°C, type "SO" feeder cable, per ASTM D-1679, for connecting stage terminal box runs to the grid iron junction boxes. Provide as required, in sufficient lengths to allow free batten travel to both high and low trim positions without cable conflicts and/or binding. Include Kellems grip strain relief devices properly sized for the respective cable(s), at both cable ends as detailed on the Drawings.~~

~~2.2—GRID IRON JUNCTION BOXES—NETWORK/DMX~~

~~A.—Acceptable Manufacturers: ETC; Altman; SSRC.~~

~~B.—General: Similar to power grid iron junction boxes above, but as required to accommodate two incoming and outgoing Cat-6 network cables with RJ45 jacks for both in and out.~~

~~2.3.2.2~~ CONNECTOR STRIPS

~~A. General: To be furnished under Division 19. Acceptable Manufacturers: ETC #9900 Series; or equal by Altman or SSRC.~~

~~B.—Description: Lengths and general configurations as detailed in the Drawings. General: U.L. listed, 0.125 extruded #6063-T5 aluminum or 18-gauge steel wire-way, 4.75" x 3.375" in cross-section in lengths specified, containing terminal strips for feed connections, and wire extending to pigtails terminating in female connectors as specified. Cover sections shall be interlocking and formed of the same aluminum alloy.~~

~~C.—Compartments: Separate compartment for line voltage and low voltage wiring.~~

~~D.—Length: As indicated on Drawings.~~

~~E.—Finish and Identification: Strip finish shall be electrostatic black paint with pigtails identified by adjacent two-inch high white identification numbers on the vertical surface. (Identification on both sides for stage electrics; only on upstage side for front of house electrics.)~~

~~F.—Wire: 125°C XLP-rated wiring of proper size and quantity to connect the individual outlets to the terminal blocks in circuits of capacity as specified or indicated.~~

- ~~G. Power Terminal Boxes: NEMA-1 enclosure with screw-on cover, with molded barrier type terminal blocks with tubular screw clamps suitable for connecting multi-conductor feed cables or incoming wire. Two terminals per circuit shall be provided, to accept #14-8 AWG wires.~~
- ~~H. Network/DMX Terminal Boxes: NEMA-1 enclosure with screw-on cover, in and out RJ-45 network connector jacks.~~
- ~~I. Pigtails: Unless indicated otherwise, 12" long black type "SO" cable with 2#12 and 1#12 ground conductors.~~
- ~~J. Pigtail Spacing: 36" unless indicated otherwise.~~
- ~~K. Pigtail Connectors: All black color, industrial grade, 125V, 20-amp, 2-pin plus ground NEMA L5-20R twist-lock female connector body equal to LeGrand/P&S #L520CBK or Hubbell #HBL2313BK.~~
- ~~L. Network Outlets/Jacks: RJ45, located as indicated.~~
- ~~M. DMX-Out Outlets/Jacks: Female 5-pin XLR type.~~
- ~~N. Mounting Hardware: Include black 7-gauge steel double-pipe hanger brackets equal to ETC Type 26, in quantities as required for maximum 60" bracket spacing along full length of connector strip.~~
- ~~O. Pipe Battens: Existing and/ or new to be provided under Division 19.~~

2.42.3 RECEPTACLE BOXES

- A. Acceptable Manufacturers: ETC; Altman; SSRC.
- B. Description: U.L. Listed, surface mount, 18-gauge steel box with 14-gauge steel cover with black fine-textured powdercoat finish, terminal strips for all required field wiring, and with receptacle(s) as indicated.
- C. Edison Receptacles: Black, duplex, nylon face, 125V, 20A NEMA 5-20R, Industrial Extra Heavy-Duty Grade, P&S #PS5362 series or Hubbell #HBL5352 series.
- D. Twist-Lock Receptacles: Black, single, nylon face, 125V, 20A NEMA L5-20R, Industrial Spec Grade, P&S #L520R series or Hubbell #HBL2310 series.

2.52.4 IDENTIFICATION

- A. Receptacles and Pigtails: All receptacle box receptacles and connector strip pigtails to be permanently identified (for connector strips, on both the House and Stage sides) with respective Lighting Control Panel circuit number, in 2" high (connector strips) or 1.25" high (receptacle boxes) white lettering.
- B. Network/DMX Outlets: To be clearly identified as to function and respective network patch panel port, etc.

PART 3 - EXECUTION

3.1 GENERAL

- A. Installation: Install theatrical lighting miscellaneous equipment, complete with all necessary accessory hangers, clamps, grips, brackets, outlet boxes, and miscellaneous hardware/devices required for a complete installation as recommended by the respective equipment manufacturers and industry standard practices.

3.2 EQUIPMENT AND DEVICE MOUNTING ~~AND SUPPORT~~

~~A. General: See Division 19.~~

B.A. Mounting Heights: Confirm all mounting heights with the Architect and Division 19.

3.3 GRID IRON JUNCTION BOXES

- A. General: Installation and wiring by Division 26.
- B. Final Power Terminations: By Division 26.
- C. Final Network and DMX Control Terminations: By Division 2619.

3.4 CONNECTOR STRIPS

- A. Mounting: By Division 19.
- B. Power Terminal Box Connections: By Division 2619.
- C. Network Terminal Box Connections: By Division 19.

3.5 RECEPTACLE BOXES

- A. General: Installation and wiring by Division 26.
- B. Final Power Terminations: By Division 26.

END OF SECTION 265565

CITY SCHOOL DISTRICT OF NEW ROCHELLE

NEW ROCHELLE HIGH SCHOOL

2023 CAPITAL PROJECT - PHASE 2B



265 Clove Rd, New Rochelle, NY 10801

ISSUED FOR BID: 06/13/2025

BID ADDENDUM #1: 06/25/2025




CSARCH - ARCHITECTS

GREENMAN - PEDERSEN, INC. - MEP & STRUCTURAL ENGINEER

STATE EDUCATION DEPARTMENT PROJECT CONTROL NUMBER:
2023 CAPITAL PROJECT - PHASE 2B 66-11-00-01-0-001-031

THE DESIGN OF THIS PROJECT CONFORMS TO APPLICABLE PROVISIONS OF THE NEW YORK STATE UNIFORM FIRE PREVENTION AND BUILDING CODE, THE NEW YORK STATE ENERGY CONSERVATION CONSTRUCTION CODE, AND THE MANUAL OF PLANNING STANDARDS OF THE NEW YORK STATE EDUCATION DEPARTMENT.

CSArch PROJECT NO. 188-2301.02

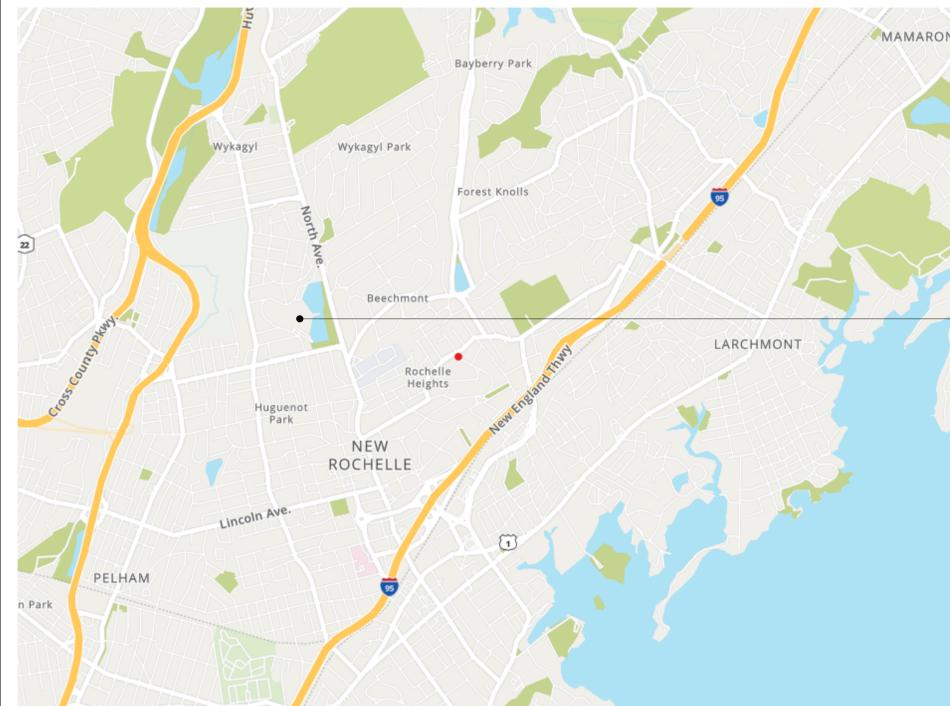

NEW ROCHELLE HIGH SCHOOL
265 CLOVE ROAD,
NEW ROCHELLE, NY 10801

VICINITY MAP


NTS



DRAWING LIST - VOLUME 1

GENERAL DRAWINGS	
G001	SYMBOLS, ABBREVIATIONS & MISC
G100	OVERALL FIRST FLOOR PLAN
G101	OVERALL SECOND FLOOR PLAN
G102	OVERALL THIRD FLOOR PLAN
LIFE SAFETY DRAWINGS	
LS101	AREA 'A&B' FIRST FLOOR LIFE SAFETY PLAN
LS102	AREA 'A&B' SECOND FLOOR LIFE SAFETY PLAN
LS103	AREA 'C' FIRST & SECOND FLOOR LIFE SAFETY PLAN
LS104	AREA 'D' FIRST FLOOR LIFE SAFETY PLAN
LS105	AREA 'E' ALL FLOORS LIFE SAFETY PLAN
LS106	AREA 'F' ALL FLOORS LIFE SAFETY PLANS
LS107	AREA 'G' SECOND AND THIRD FLOOR LIFE SAFETY PLAN
LS108	AREA 'H' FIRST AND SECOND FLOOR LIFE SAFETY PLAN
LS109	LIFE SAFETY DIAGRAMS
ARCHITECTURAL DEMOLITION DRAWINGS	
A0601	AREA 'G' - SECOND FLOOR DEMOLITION PLAN
A0617	AREA 'G' - SECOND FLOOR DEMOLITION RCP
A0627	AREA 'G' - THIRD FLOOR DEMOLITION RCP
ARCHITECTURAL DRAWINGS	
A117	AREA 'G' - SECOND FLOOR NEW WORK PLAN
A127	AREA 'G' - THIRD FLOOR NEW WORK PLAN
A601	ENLARGED AUDITORIUM SECOND FLOOR PLAN
A602	AUDITORIUM ELEVATIONS
A604	AUDITORIUM ELEVATIONS
A605	AUDITORIUM DETAILS
A817	AREA 'G' PARTIAL SECOND FLOOR RCP
A827	AREA 'G' PARTIAL THIRD FLOOR RCP
ARCHITECTURAL FINISH DRAWINGS	
AF101	ENLARGED AUDITORIUM FIRST FLOOR FINISH PLAN
ELECTRICAL GENERAL DRAWINGS	
E001	ELECTRICAL LEGEND AND ABBREVIATIONS
ELECTRICAL DEMOLITION DRAWINGS	
ED101	AUDITORIUM MAIN LEVEL ELECTRICAL REMOVALS PLAN
ED102	AUDITORIUM UPPER LEVEL ELECTRICAL REMOVALS PLAN
ELECTRICAL DRAWINGS	
E400	AUDITORIUM LOWER LEVEL ELECTRICAL PLAN
E401	AUDITORIUM MAIN LEVEL ELECTRICAL PLAN
E101	AUDITORIUM UPPER LEVEL ELECTRICAL PLAN
E102	AUDITORIUM UPPER LEVEL ELECTRICAL PLAN
E103	AUDITORIUM STEP & AISLE LIGHTING PLAN
E104	HOUSE LIGHTING DRIVER CABINET SCHEDULES
E105	ELECTRICAL DETAILS
E201	AUD. MAIN LEVEL ELECTRICAL FOR THEATRICAL (TG. PLAN)
E202	AUD. UPPER LEVEL ELECTRICAL FOR THEATRICAL (TG. PLAN)
E203	THEATRICAL LIGHTING SCHEDULES & DETAILS
E301	AUDITORIUM MAIN LEVEL ELECTRICAL FOR AV PLAN
E302	AUDITORIUM UPPER LEVEL ELECTRICAL FOR AV PLAN
E401	THEATRICAL AV/L RACK CONDUIT & CABLE SCHEDULES
E402	EXISTING LIGHTING CONTRL SYSTEM DIAGRAM
E403	EXISTING SOUND SYSTEM DIAGRAM

C:\Users\collura\Documents\188-2301\00_NEW_ROCHELLE_HS_collura\XREF.dwg

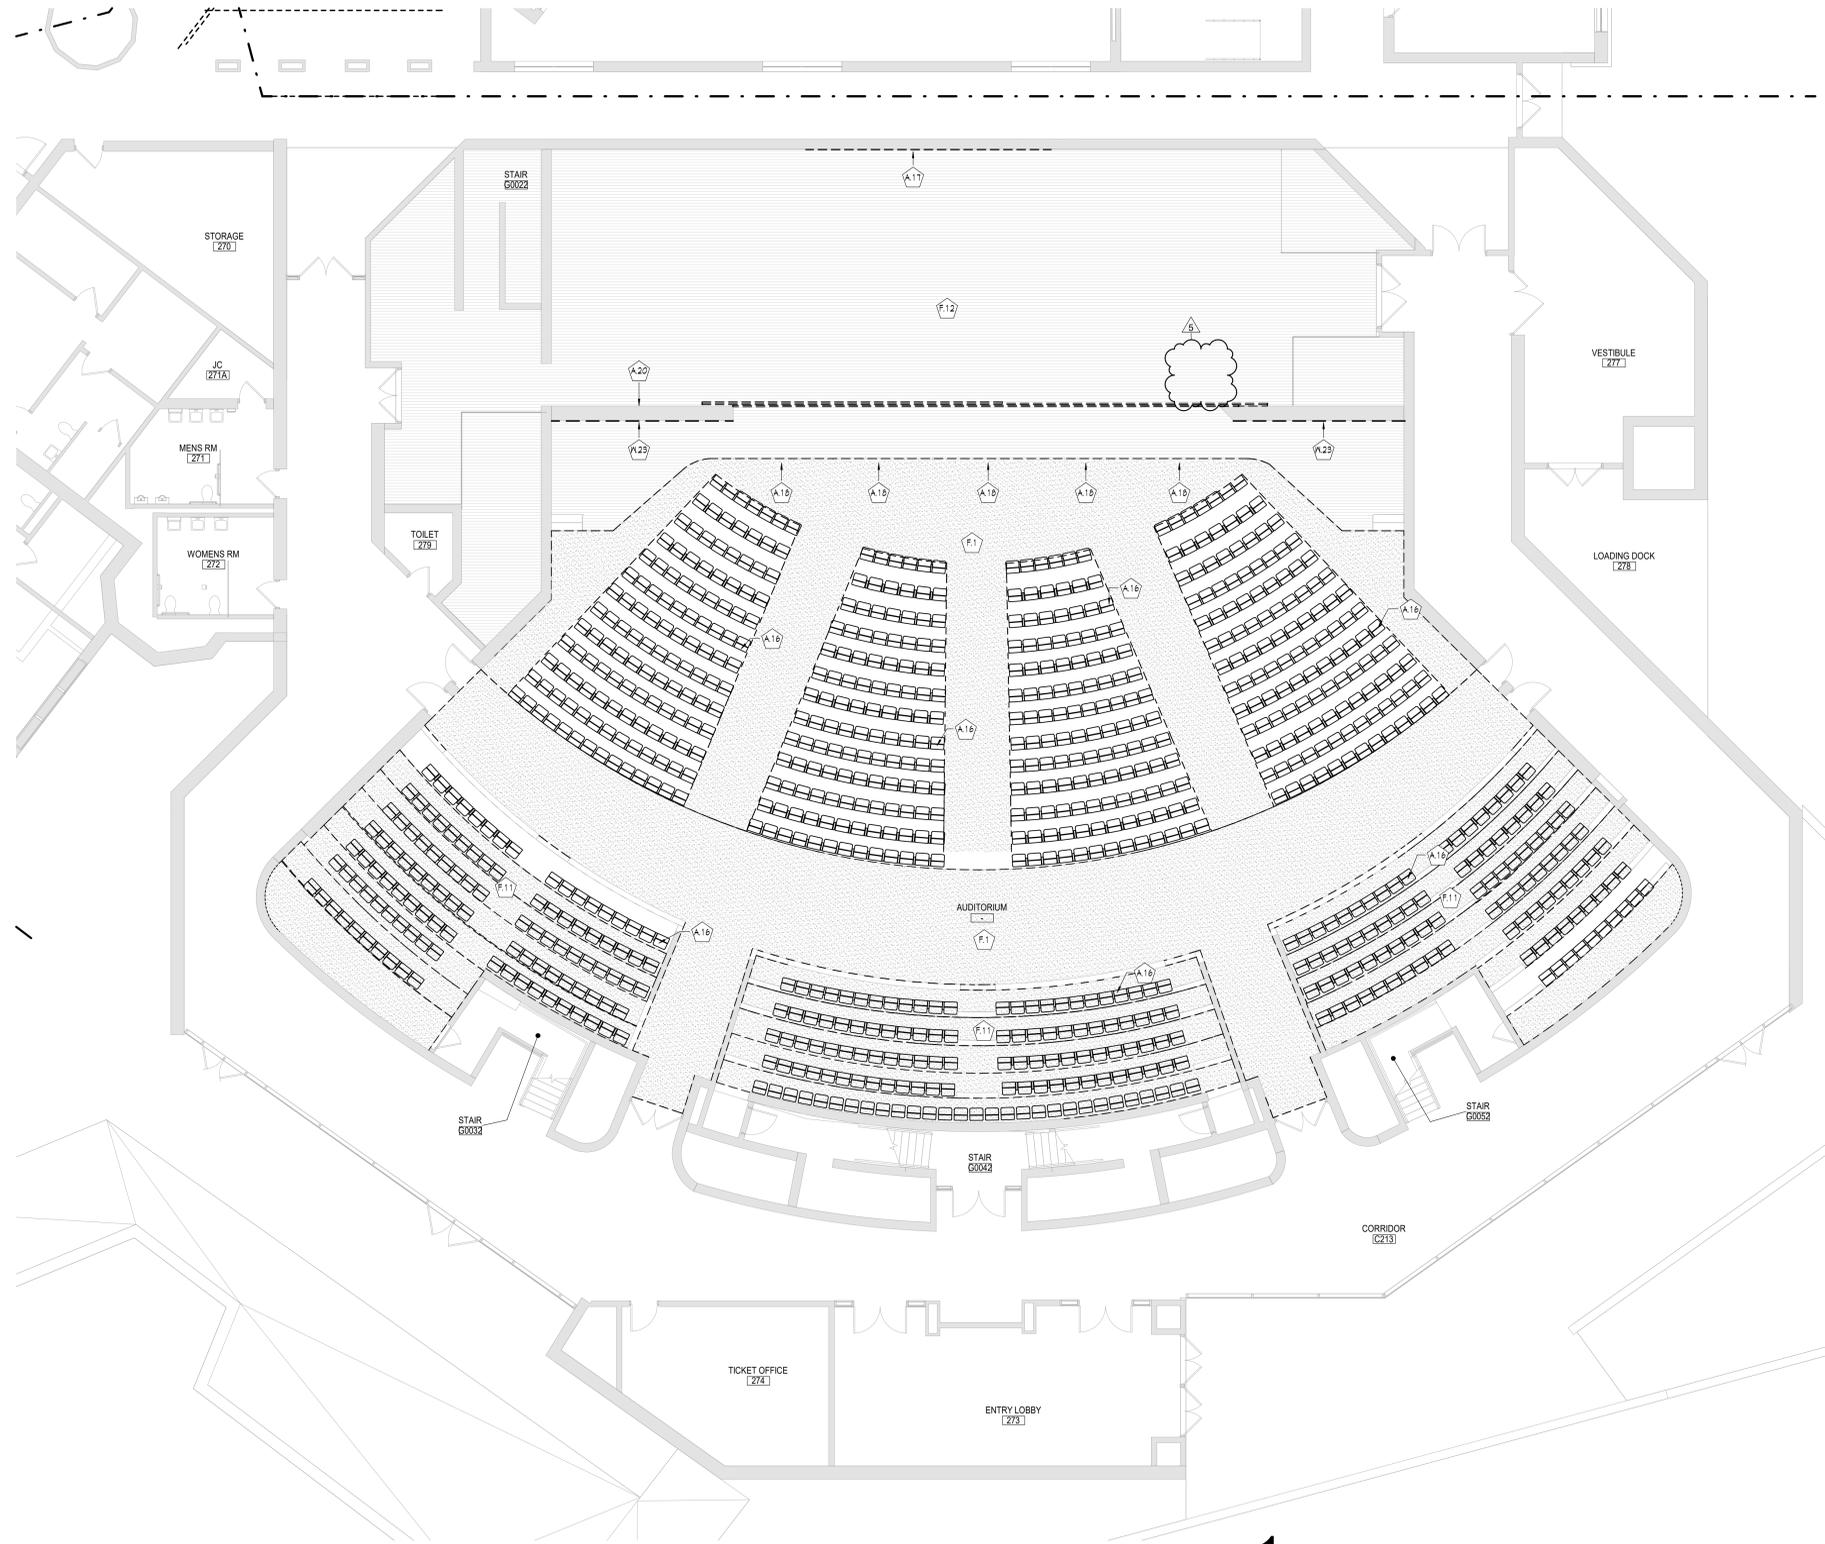


GENERAL DEMOLITION NOTES

1. COORDINATE ALL REMOVALS WITH NEW CONSTRUCTION.
2. PATCH AND REPLACE EXISTING AND NEWLY CREATED HOLES IN WALLS (DUE TO REMOVAL) WITH MATERIALS TO MATCH EXISTING CONSTRUCTION.
3. SALVAGED ITEMS SHALL BE TURNED OVER TO OWNER, UNLESS OTHERWISE NOTED.
4. ALL KEYED REMOVALS SHALL INCLUDE REMOVAL OF ANY AND ALL ANCHORING SYSTEMS INCLUDING OBJECTS.
5. REFER TO MEP DRAWINGS FOR ADDITIONAL REMOVAL INFORMATION.
6. PROTECT EXISTING WORK AND CONSTRUCTION AT ALL AREAS OF WALL REMOVAL AND NEW WALL PENETRATIONS.
7. DRILL CORNERS OF ALL NEW SAWCUT OPENING PRIOR TO SAWCUTTING TO PREVENT CUTTING INTO SCHEDULED CONSTRUCTION TO REMAIN.
8. GRIND FLOOR SMOOTH TO MATCH EXISTING ADJACENT FLOOR FINISH ELEVATION FOR CLEAN FINISH, UNDER ANY MASONRY WALLS TO BE FULLY REMOVED.

KEYNOTES

#	DESCRIPTION
A.16	REMOVE EXISTING FIXED SEATING.
A.17	REMOVE AND SALVAGE EXISTING MIRROR SYSTEM FOR REINSTALLATION AT A LATER DATE.
A.18	REMOVE 4'-6" OF WOODEN STAGE FACE TO ACCOMMODATE NEW ELECTRICAL BOXES. FRONT FACE TO BE FLUSH WITH EXISTING WOODEN STAGE. REFER TO ELECTRICAL.
A.20	REMOVE EXISTING CATWALK ACCESS LADDER IN ITS ENTIRETY.
F.1	REMOVE FLOOR FINISH, INCLUDING ALL PADDING, ADHESIVES AND WALL BASE, TO SLAB BELOW.
F.11	REMOVE ALL RUBBER TREADS, RISERS, AND TRANSITIONS TO SLAB BELOW.
F.12	REFINISH EXISTING WOOD STAGE FLOORING, INCLUDING APRON AND STAIRS.
W.23	REMOVE WOODEN PANELS SECURED TO THE WALL, INCLUDING FASTENERS, ADHESIVES, ETC.

KEY PLAN

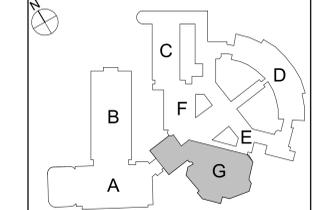

40 Beaver St., Albany, New York 12207-1511
518-463-8686 www.csarch.com



Project Title

**CITY SCHOOL DISTRICT OF NEW ROCHELLE
NEW ROCHELLE HIGH SCHOOL
2023 CAPITAL PROJECT - PHASE 2B**

Project Title



Expiration Date: 02/28/2025

NO.	DATE	DESCRIPTION

Drawn By: JC
Checked By: MJ
Proj. #: 66-11-00-01-0-001-031
CSArch Proj. #: 188-2301.02
Issued for Bid: 06/13/2025


Sheet Title
**AREA G -
SECOND
FLOOR
DEMOLITION
PLAN**

Sheet No.
**NRHS
AD601**

CONSTRUCTION DOCUMENTS

1 AUDITORIUM SECOND FLOOR DEMOLITION PLAN
AD601 1/8" = 1'-0"

COPYRIGHT © ALL RIGHTS RESERVED

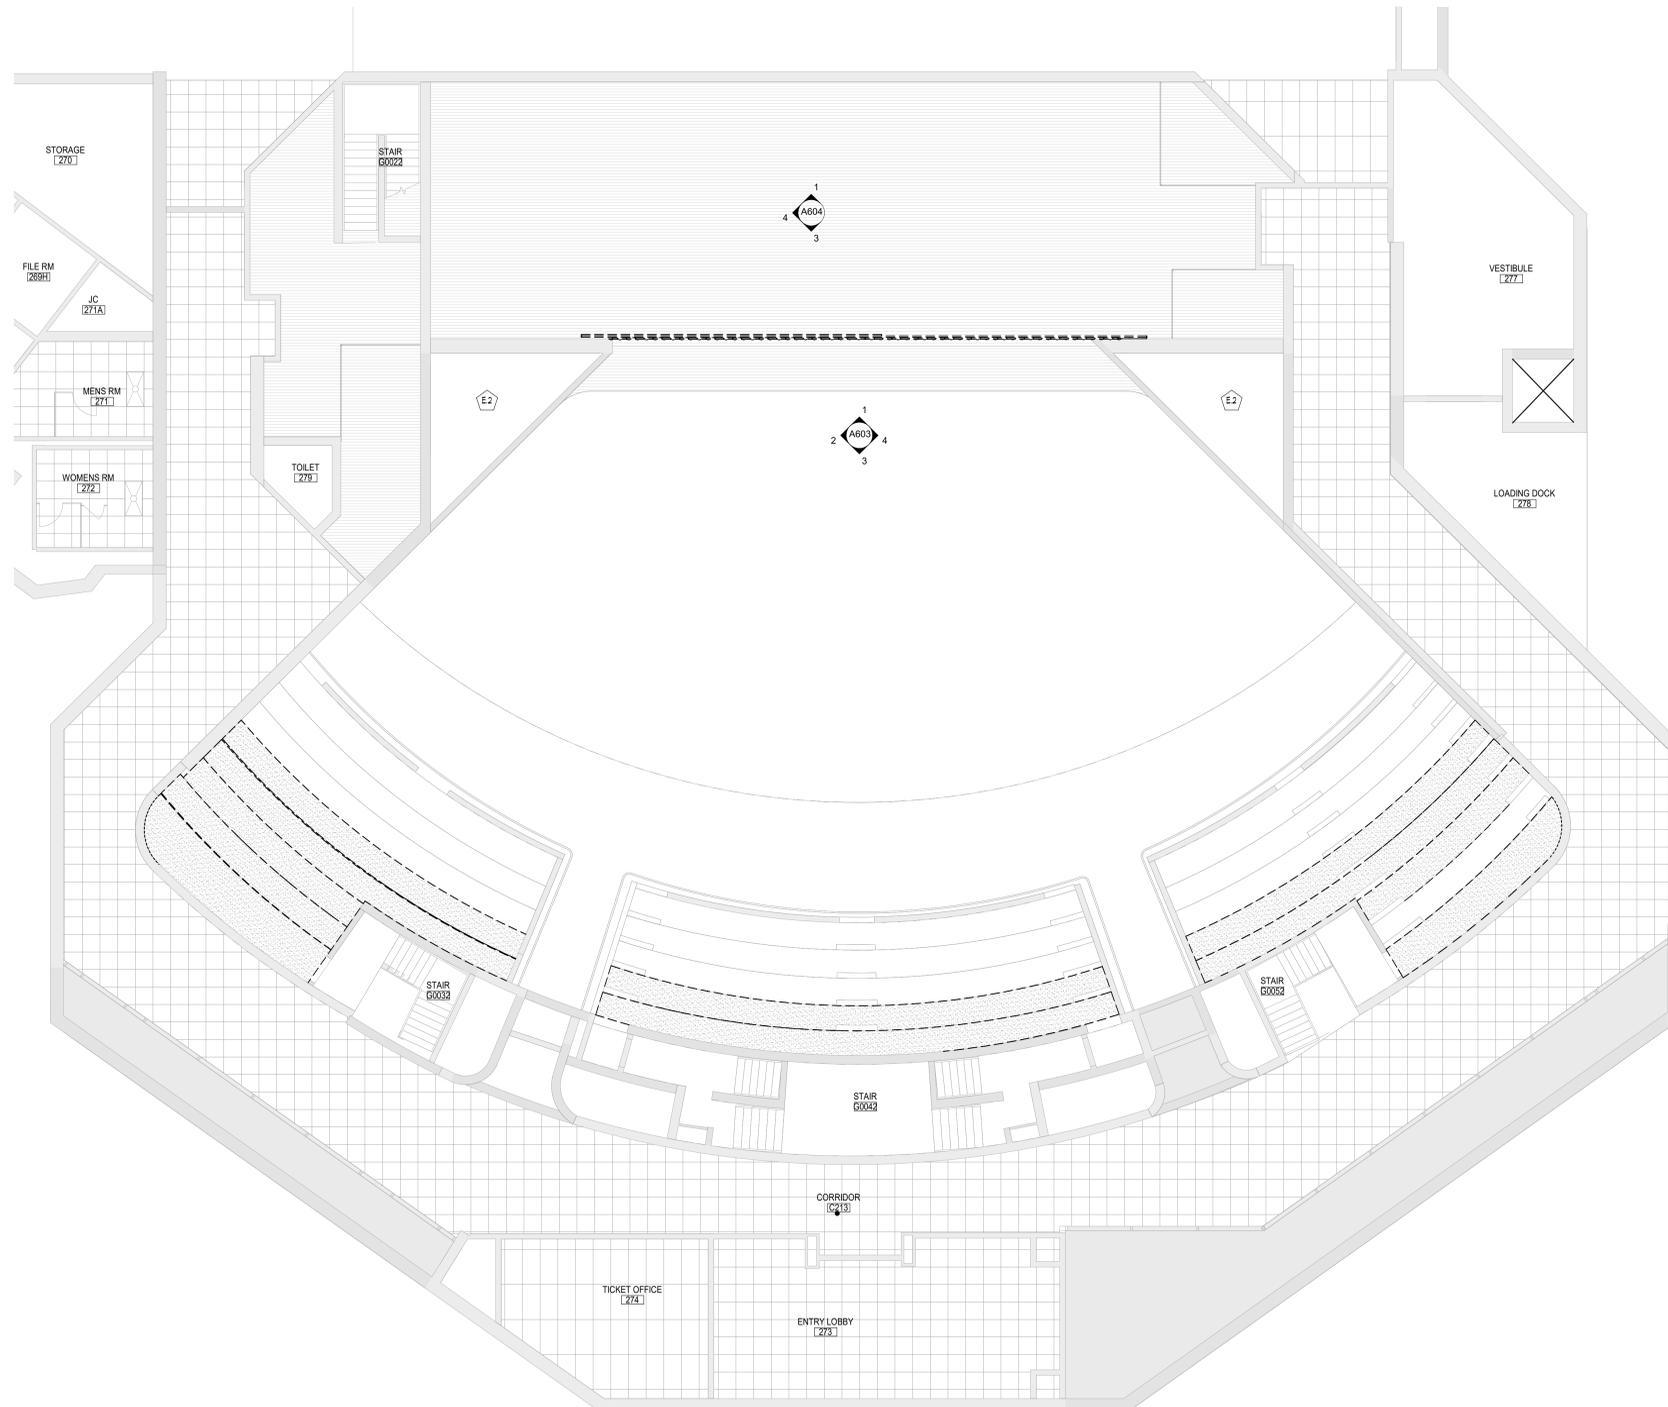

1 AREA 'G' SECOND FLOOR DEMOLITION RCP
AD817 1/8" = 1'-0"

GENERAL DEMOLITION NOTES

- COORDINATE ALL REMOVALS WITH NEW CONSTRUCTION.
- PATCH AND REPLACE EXISTING AND NEWLY CREATED HOLES IN WALLS (DUE TO REMOVAL) WITH MATERIALS TO MATCH EXISTING CONSTRUCTION.
- SALVAGED ITEMS SHALL BE TURNED OVER TO OWNER, UNLESS OTHERWISE NOTED.
- ALL KEYED REMOVALS SHALL INCLUDE REMOVAL OF ANY AND ALL ANCHORING SYSTEMS INCLUDING OBJECTS.
- REFER TO MEP DRAWINGS FOR ADDITIONAL REMOVAL INFORMATION.
- PROTECT EXISTING WORK AS NECESSARY AT ALL AREAS OF WALL REMOVAL AND NEW WALL PENETRATIONS.
- DRILL CORNERS OF ALL NEW SAWCUT OPENING PRIOR TO SAWCUTTING TO PREVENT CUTTING INTO SCHEDULED CONSTRUCTION TO REMAIN.
- GRIND FLOOR SMOOTH TO MATCH EXISTING ADJACENT FLOOR FINISH ELEVATION FOR CLEAN FINISH, UNDER ANY MASONRY WALLS TO BE FULLY REMOVED.

CEILING LEGEND

- GWB OR PLASTER CEILING, REFER TO DETAILS AND ROOM FINISH SCHEDULE
- 2X4 SUSPENDED ACOUSTICAL PANEL CEILING SYSTEM
- SPLINE CEILING SYSTEM
- CEILING HEIGHT ABOVE FINISHED FLOOR

REMOVAL LEGEND


- ELECTRICAL EQUIPMENT, REFER TO ELECTRICAL DRAWINGS FOR ADDITIONAL INFORMATION.**
- 2'x4' LIGHT FIXTURE
 - 2'x2' LIGHT FIXTURE
 - 1'x1' LIGHT FIXTURE
 - PENDANT LIGHT FIXTURE
 - RECESSED DOWN LIGHT
 - CEILING MOUNTED EXIT SIGN

- MECHANICAL EQUIPMENT, REFER TO MECHANICAL DRAWINGS FOR ADDITIONAL INFORMATION.**
- HVAC SUPPLY GRILLE
 - HVAC RETURN GRILLE

KEYNOTES


#	DESCRIPTION
E.2	ELECTRICAL REMOVAL, TYPICAL REFER TO 'E' DRAWINGS.

KEY PLAN

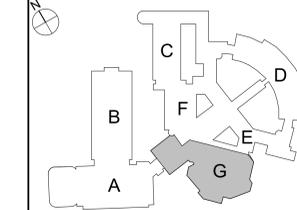

Consultant

**CITY SCHOOL DISTRICT OF NEW ROCHELLE
NEW ROCHELLE HIGH SCHOOL
2023 CAPITAL PROJECT - PHASE 2B**

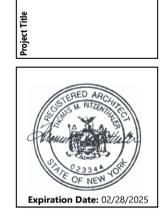

NO.	DATE	BID ADDENDUM #1	DESCRIPTION


Drawn By: KC
Checked By: MZ
Proj. #: 66-11-00-01-0-001-031
CSArch Proj. #: 188-2301.02
Issued for Bid: 06/13/2025

Sheet Title
**AREA G -
SECOND
FLOOR
DEMOLITION
RCP**

Sheet No.
**NRHS
AD817**

CONSTRUCTION DOCUMENTS

C:\Users\collin\Documents\188-2301\00_NEW_ROCHELLE_HS_collin\XREF.dwg

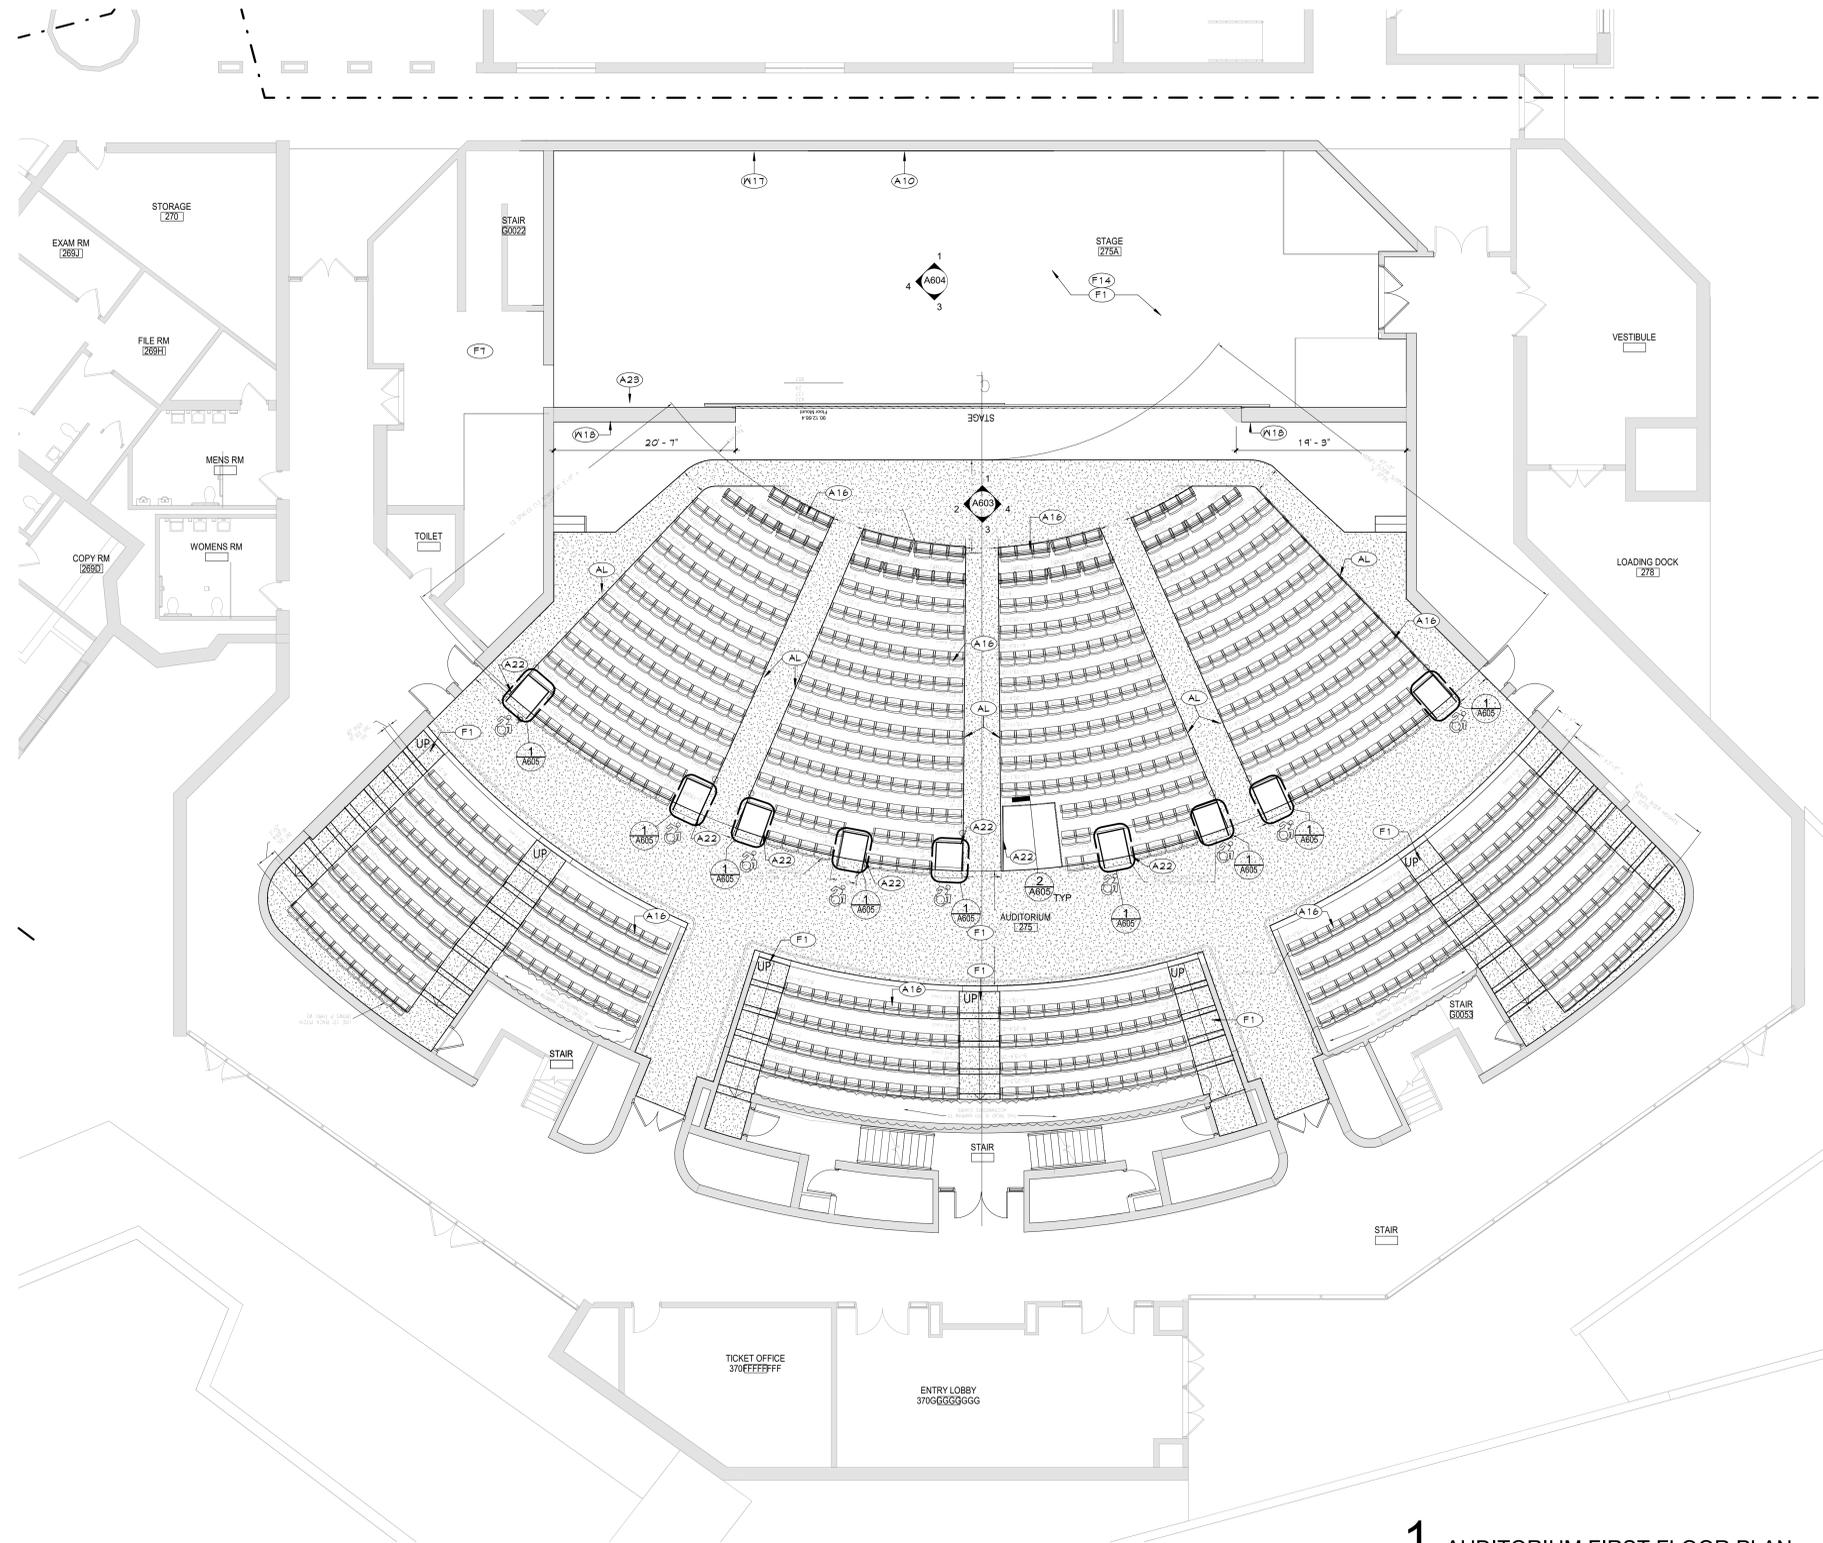

1 AUDITORIUM FIRST FLOOR PLAN
A601 1/8" = 1'-0"


GENERAL NOTES

1. REFER TO SHEET 6001 FOR ADDITIONAL GENERAL NOTES.
2. REFER TO LS 100 SERIES DRAWINGS FOR LIFE SAFETY PLANS AND DETAILED INFORMATION.
3. REFER TO A600 SERIES DRAWINGS FOR ADDITIONAL DIMENSIONS AND ENLARGED WORK PLANS.
4. REFER TO A600 SERIES DRAWINGS ADDITIONAL DIMENSIONS AND DETAILED INFORMATION OF CEILING SCOPE.

KEYNOTES

#	DESCRIPTION
A10	REINSTALL EXISTING DANCE MIRROR, INCLUDING HANDRAIL AND PLATE COVERS.
A16	OWNER INSTALLS NEW THEATRICAL SEATING.
A22	PROVIDE NEW RAILING FOR AUDITORIUM PLATFORM.
A23	PROVIDE NEW LADDER AND FALL PROTECTION CAGE AS SPECIFIED.
AL	AISLE LIGHTING
F1	PROVIDE NEW FLOOR FINISH, (TYPICAL FOR ROOM, UNLESS NOTED OTHERWISE); REFER TO "AF" DRAWINGS.
F7	REFINISH EXISTING WOOD FLOORING.
F14	REFINISH EXISTING WOOD PLANK STAGE FLOORING.
W17	PREP AND PAINT WALL SURFACE TO EXTENTS SHOWN.
W18	PATCH WALL TO MATCH ADJACENT WALL THICKNESS AND FINISH.

KEY PLAN

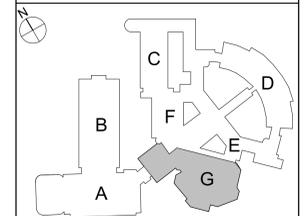

40 Beaver St. - Albany - New York 12207-1511
510-463-8666 www.csarch.com



**CITY SCHOOL DISTRICT OF NEW ROCHELLE
NEW ROCHELLE HIGH SCHOOL
2023 CAPITAL PROJECT - PHASE 2B**

Project Title



Expiration Date: 02/28/2025

NO.	DATE	DESCRIPTION
1	06/13/2025	BID ADDENDUM #1


Drawn By: JC
Checked By: MJ
Proj. #: 66-11-00-01-0-001-031
CSArch Proj. #: 188-2301.02
Issued for Bid: 06/13/2025

Sheet Title
**ENLARGED
AUDITORIUM
SECOND
FLOOR PLAN**

Sheet No.
**NRHS
A601**



CONSTRUCTION DOCUMENTS

COPYRIGHT © ALL RIGHTS RESERVED

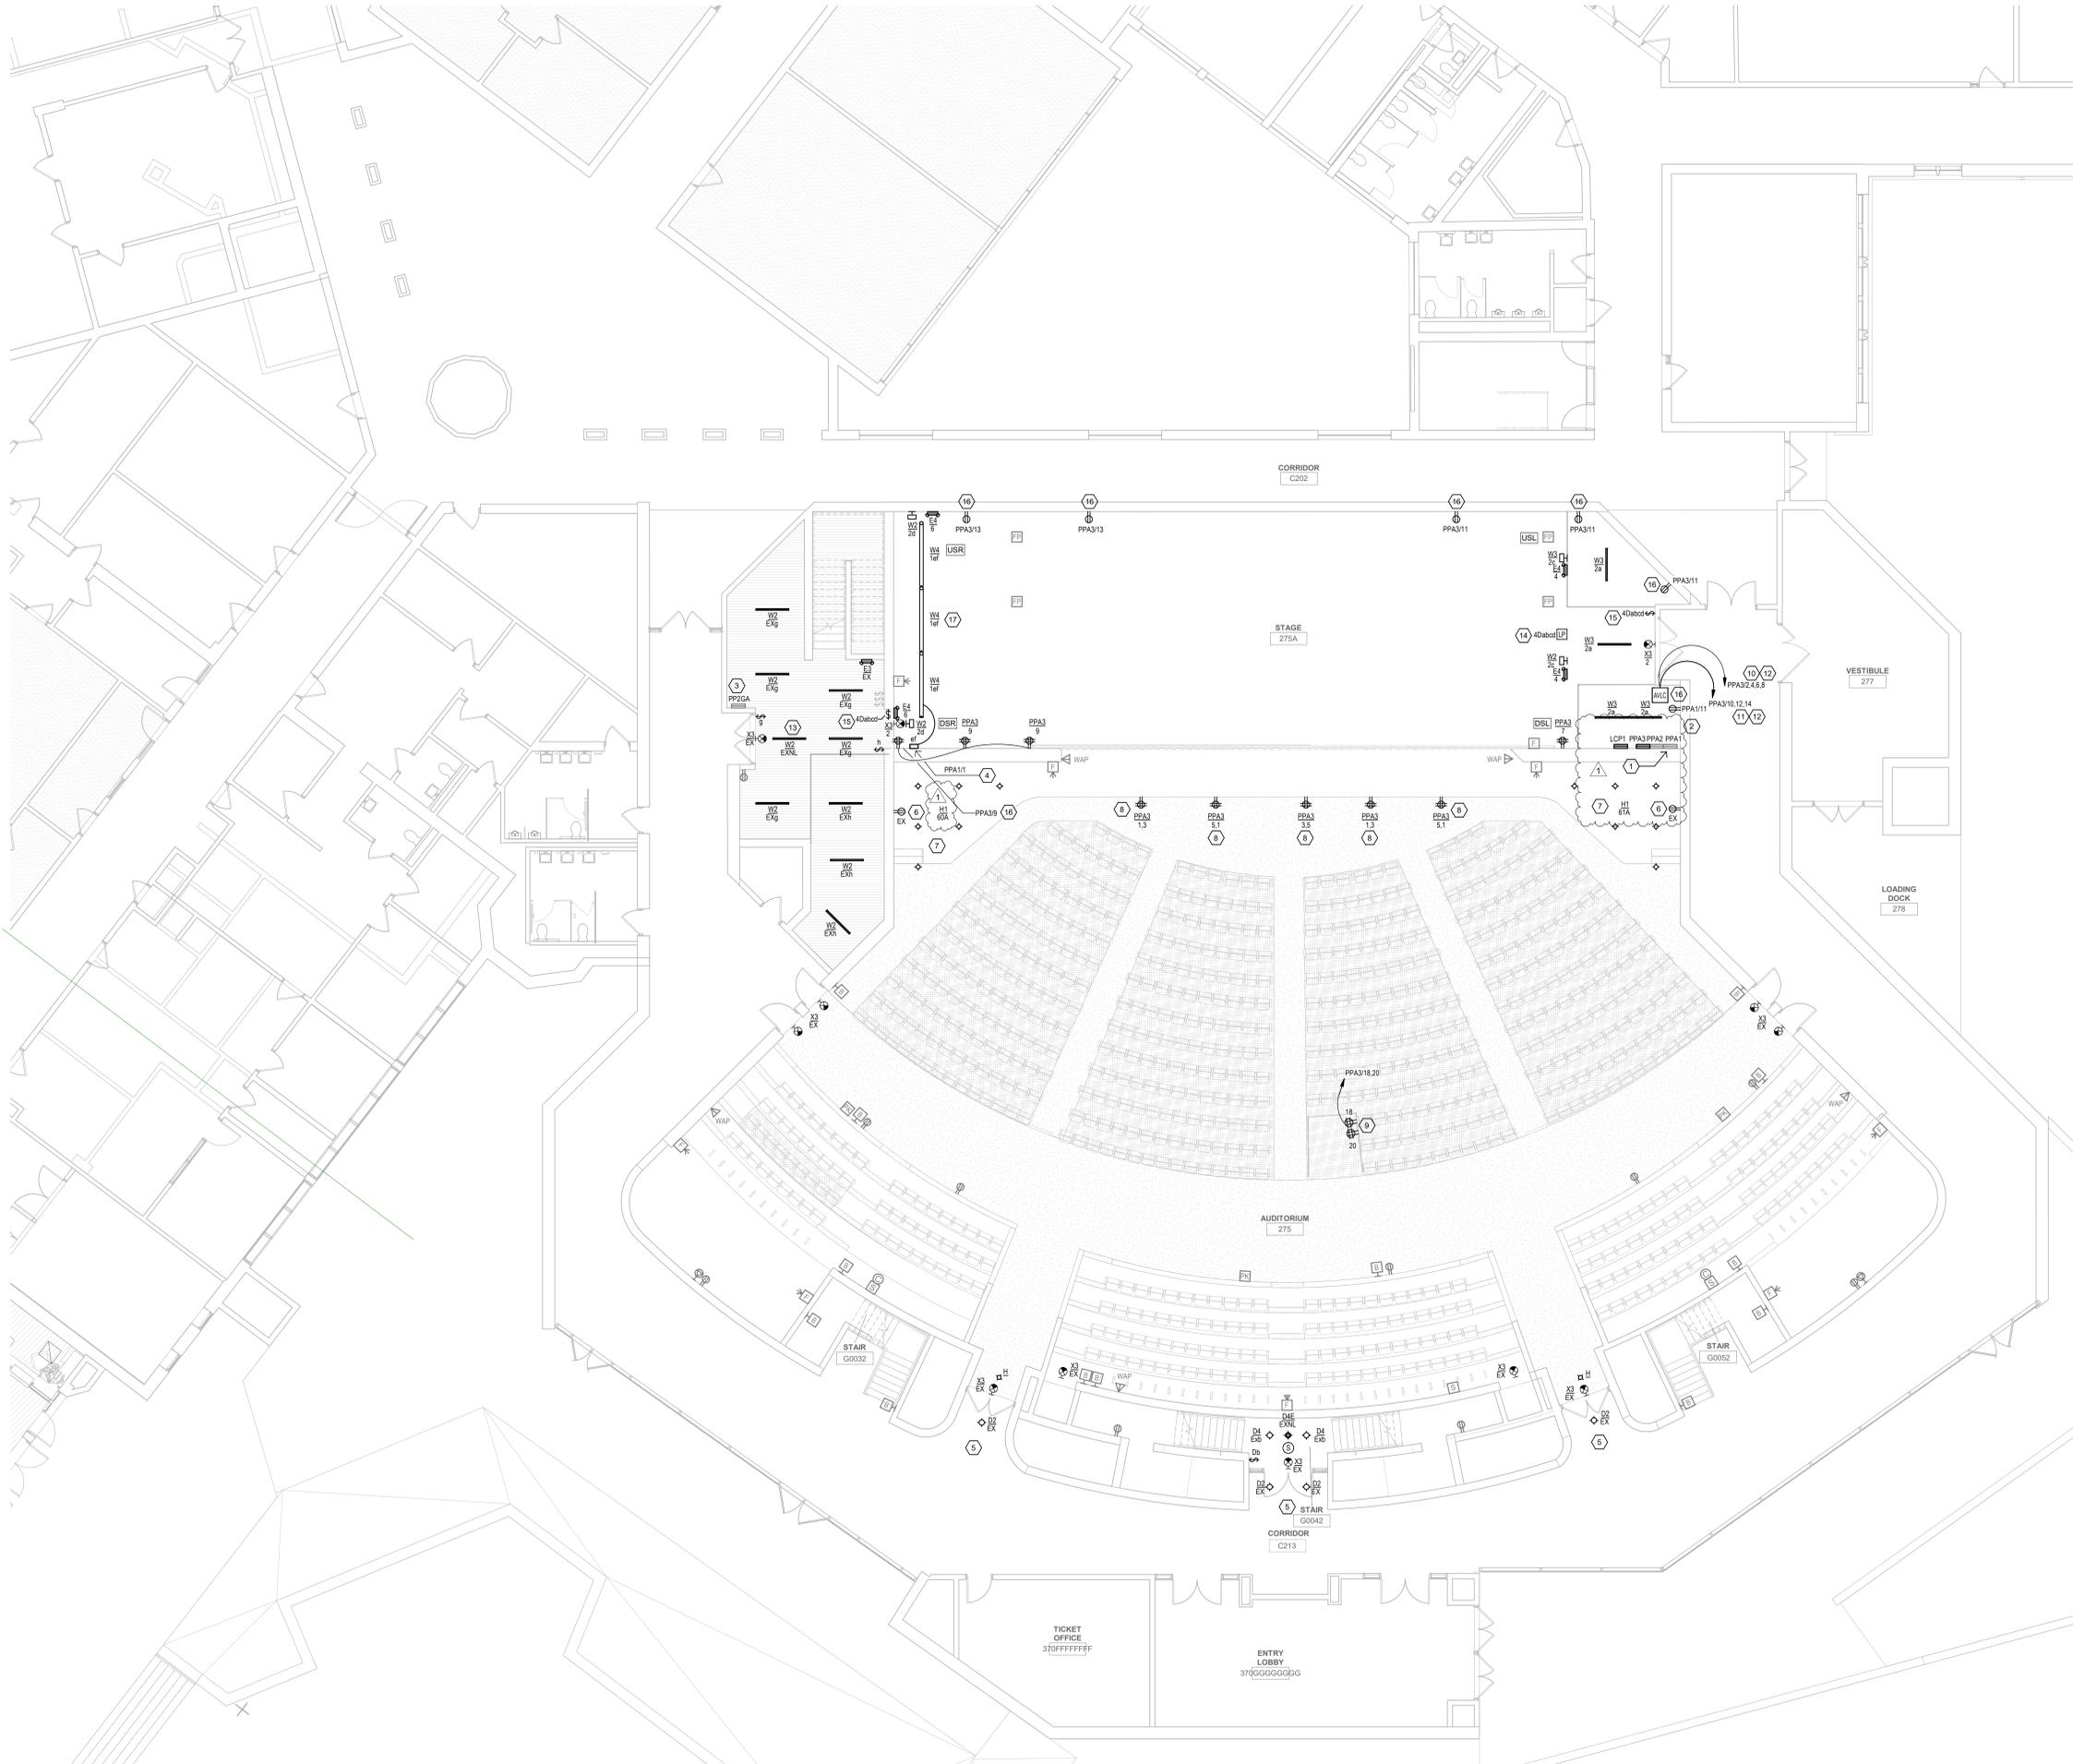

- GENERAL NOTES**
- A. LIGHT GRAY LINES INDICATE EXISTING ELECTRICAL ITEMS TO REMAIN, UNLESS INDICATED OTHERWISE.
 - B. SOLID BLACK LINES INDICATE ELECTRICAL NEW WORK, UNLESS INDICATED OTHERWISE.
 - C. "X" INDICATES NEW LOCATION FOR EXISTING ELECTRICAL ITEM (SEE DWG. E101 FOR ORIGINAL LOCATION). CLEAN, CHECKOUT, REINSTALL AND RECONNECT ITEM PER ORIGINAL. EXTENDING EXISTING CIRCUITING IN KIND AS REQUIRED.
 - D. "EX" INDICATES CONNECT TO EXISTING 120V, 20A LIGHTING OR RECEPTACLE CIRCUIT (AS INDICATED IN ROOM VICINITY). EXTEND CIRCUITING AS REQUIRED.
 - E. BRANCH CIRCUITS: ALL BRANCH CIRCUITS TO BE 1/2" C, 2#12 & 1#12G OR EQUIVALENT TYPE "MC" CABLE WHERE PERMITTED BY SPEC. 200501 UNLESS INDICATED OR REQUIRED OTHERWISE BY NEC.
 - F. FIRE ALARM INITIATING DEVICES: CONNECT TO EXISTING FIRE ALARM INITIATING CONTROL LOOP IN VICINITY (CONFIRM ADEQUATE CAPACITY).
 - G. FIRE ALARM NOTIFICATION DEVICES: CONNECT TO EXISTING FIRE ALARM NOTIFICATION CIRCUIT(S) IN VICINITY (CONFIRM ADEQUATE CAPACITY).
 - H. STAGE WORK LIGHTS CIRCUITS: #2-4 ARE TO EXISTING 208V CIRCUIT BREAKERS IN EXISTING PANELBOARD PPA1 (MADE AVAILABLE BY REMOVALS WORK).
 - I. TYPE "W3" STAGE WORK LIGHTS: TO BE MOUNTED UP HIGH AS DIRECTED BY A/E.

- KEYED NOTES**
- 1. TWO EXISTING 120/208V, 3-PHASE, 4-WIRE (NORMAL) PANELBOARDS TO REMAIN.
 - 2. NEW PANELBOARD: SEE SCHEDULE ON DWG. E105. FEED PANELBOARD FROM NEW 100A/3P CIRCUIT BREAKER #44-46-48 IN EXISTING PANELBOARD PPA2 USING 1-1/4" #2 & #3.
 - 3. EXISTING 120/208V, 3-PHASE, 4-WIRE (EMERGENCY) PANELBOARD TO REMAIN.
 - 4. CONTROLLER FOR TYPE "W3" INDEX RAIL LIGHTING FIXTURES: CONNECT CONTROLLER TO INDICATED 120V CIRCUIT. CONNECT TO TYPE "W3" LIGHTING FIXTURES FOR SEPARATE CONTROL OF WHITE ("W") AND BLUE ("B") LIGHTS.
 - 5. CONNECT NEW LIGHTING FIXTURES TO EXISTING CORRIDOR LIGHTING CIRCUIT AND CONTROLS.
 - 6. REPLACE EXISTING RECEPTACLE WITH NEW BLACK RECEPTACLE AND BLACK COVERPLATE.
 - 7. CONNECT EACH TYPE "H1" LIGHTING FIXTURE TO RESPECTIVE DRIVER IN HOUSE LIGHTS DRIVER CABINET HLD-1 (HLD-2). SEE DWG. E102 FOR CABINET LOCATIONS. SEE 1/E105 AND DWG. E104 FOR DRIVER CABINET DETAIL AND SCHEDULES.
 - 8. LOCATE QUAD RECEPTACLE ADJACENT TO DANITE OUTLET (SEE DWG. E301) IN FACE OF APRON PER DETAIL 2/E105.
 - 9. EXACT LOCATION AND MOUNTING TO MID-HOUSE CONTROL STATION REALING, ETC. AS DIRECTED BY A/E.
 - 10. 1" C, #812 & 1#12G.
 - 11. 1" C, #812 & 2#12 SPARES & 1#12G.
 - 12. CONNECTING CIRCUITS TO RACEWAY STRIP DEVICES IN RACK AS DIRECTED BY DIV. 19.
 - 13. UNSWITCHED NIGHT LIGHT.
 - 14. FOUR 0-10V DIMMING LIGHTING PACKS FOR CONTROL OF STAGE WORK LIGHTS IN GROUP AS INDICATED. FIELD LOCATE UP ON HIGH WALL.
 - 15. FOUR ZONE ON-OFF-RAISE-LOWER LIGHTING CONTROL STATION FOR CONTROL OF STAGE WORK LIGHTS IN GROUPS AS INDICATED.
 - 16. PROVIDE NEW RECEPTACLE IN EXISTING OUTLET BOX. PROVIDE INDICATED NEW CIRCUIT WIRES USING EXISTING CONDUITS (RE-ROUTE TO NEW PANELBOARD PPA3).
 - 17. INDEX RAIL LIGHTS TO BE SUSPENDED AT SAME HEIGHT AS EXISTING WERE USING WIRE ROPES (TWO PER FIXTURE) SECURED TO LOADING BRIDGE STRUCTURE ABOVE, BY DIV. 19. COORDINATE AS REQUIRED.

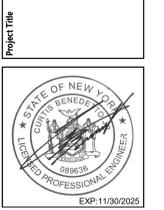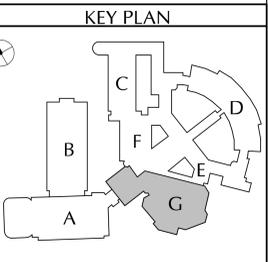


NO.	DATE	DESCRIPTION
1	05/20/25	ISSUE FOR BIDDING


Drawn By: JRM/PT
 Checked By: CB
 Proj. #: 66-11-00-01-00-031
 CSArch Proj. #: 188-2301.02
 Issued for Bid: 05/30/2025

C:\Users\jfreeman\OneDrive - Greenman-Pedersen, Inc\Documents\240013 024 NEW ROCHELLE HS MEP_Made_jfreeman\3VALU1.rvt

1 AUDITORIUM MAIN LEVEL ELECTRICAL PLAN
 E101 1/8" = 1'-0"

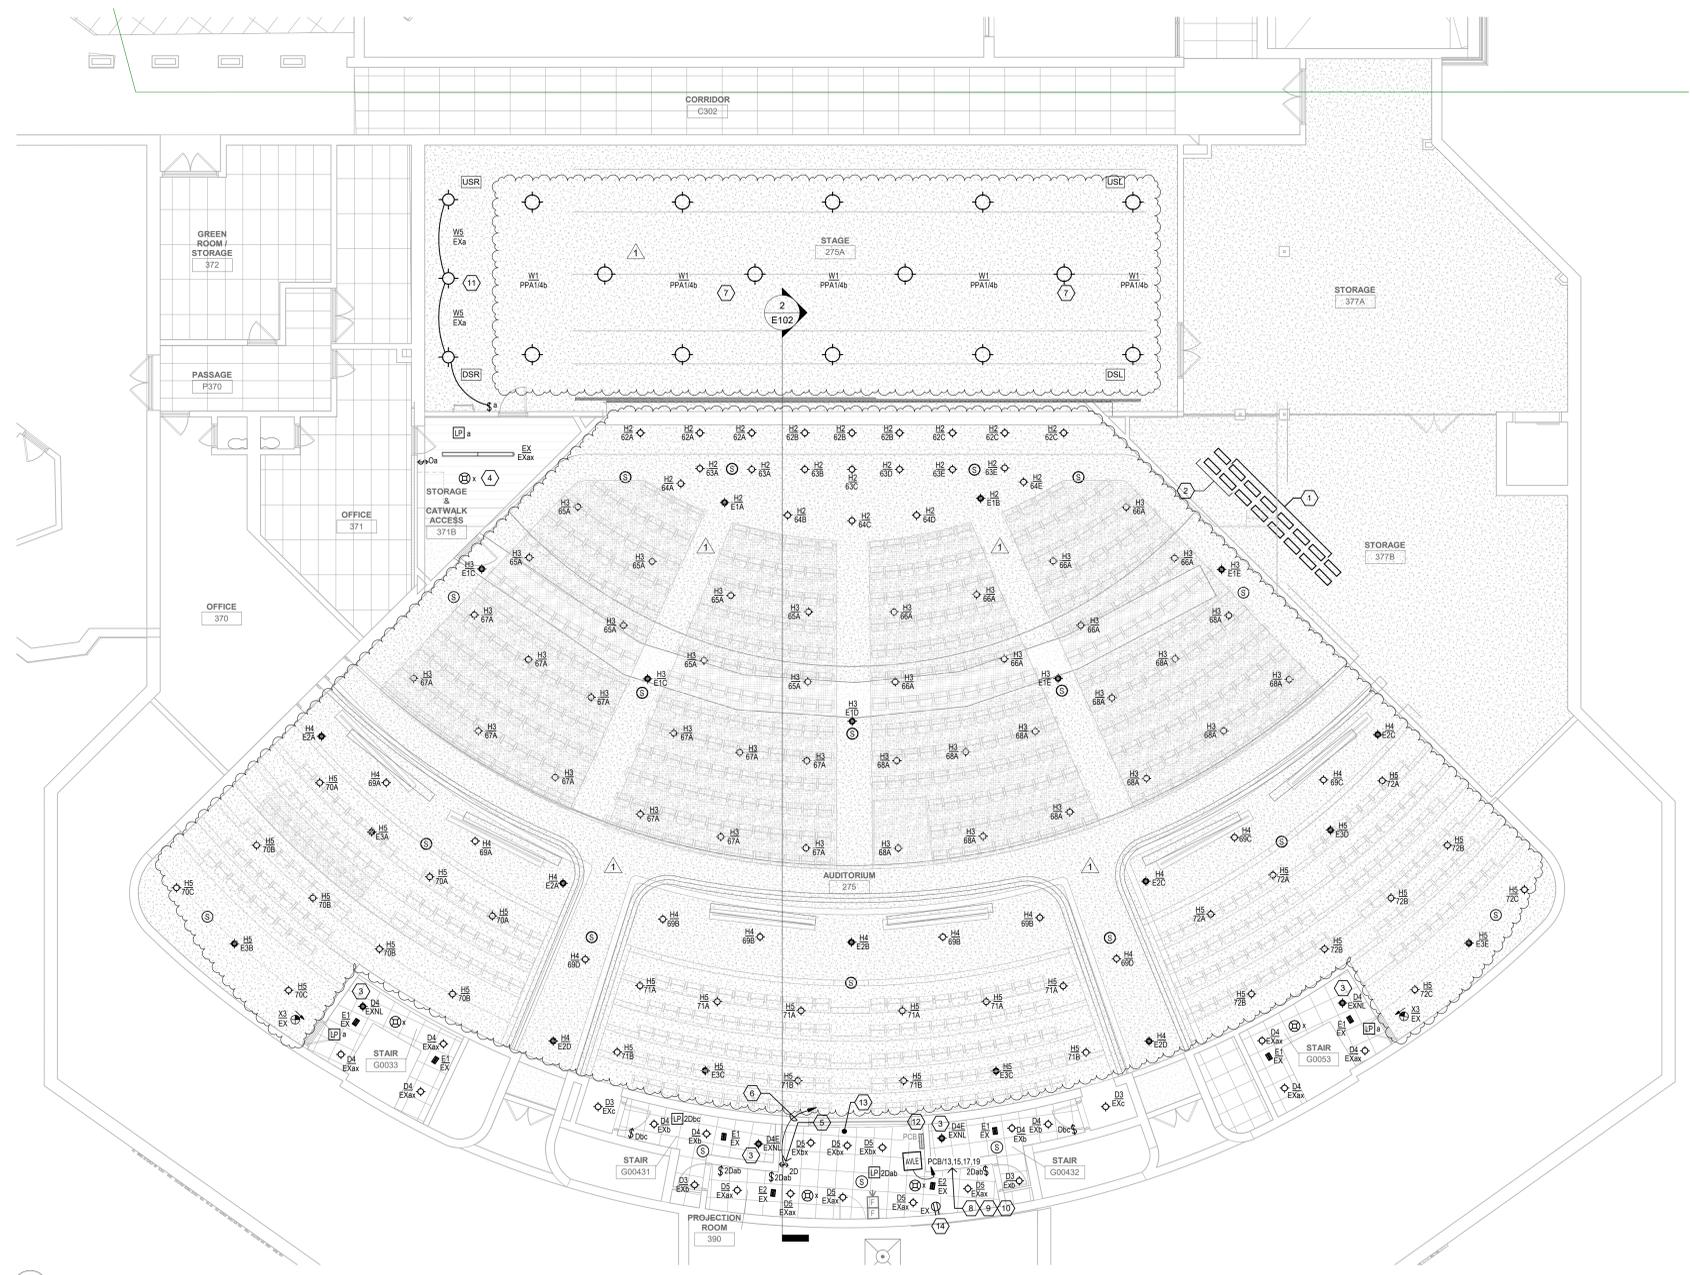


1 AUDITORIUM UPPER LEVEL ELECTRICAL PLAN
E102
1/8" = 1'-0"

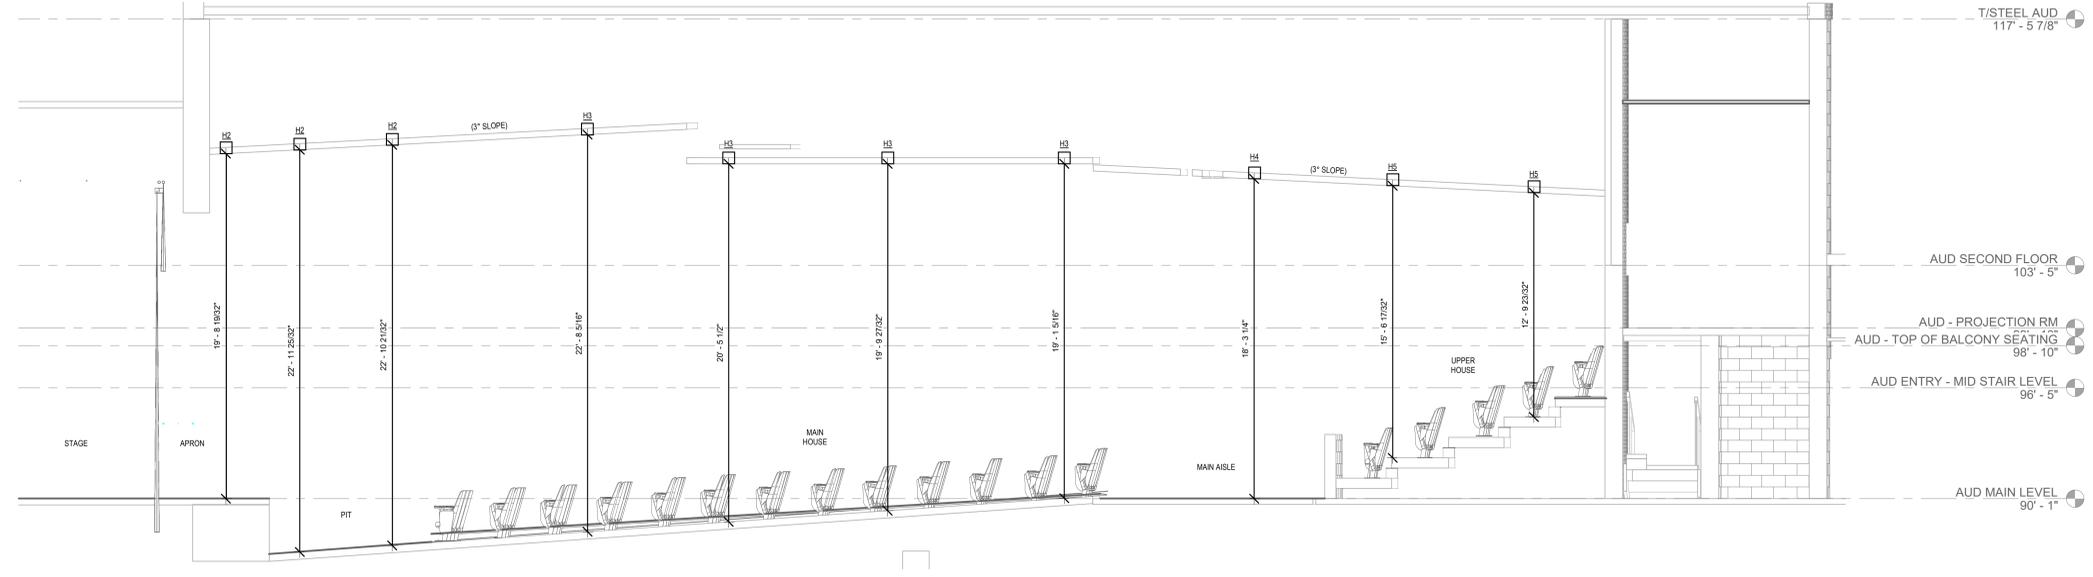

2 AUDITORIUM LIGHTING SECTION
E102
1/4" = 1'-0"

- GENERAL NOTES**
- A. LIGHT/GRAY LINES: INDICATE EXISTING ELECTRICAL ITEMS TO REMAIN, UNLESS INDICATED OTHERWISE.
 - B. SOLID BLACK LINES: INDICATE ELECTRICAL NEW WORK, UNLESS INDICATED OTHERWISE.
 - C. "XC" INDICATES NEW LOCATION FOR EXISTING ELECTRICAL ITEM (SEE DWG. E101 FOR ORIGINAL LOCATION). CLEAN, CHECKOUT, REINSTALL AND RECONNECT ITEM PER ORIGINAL, EXTENDING EXISTING CIRCUITING IN KIND AS REQUIRED.
 - D. "EX" INDICATES CONNECT TO EXISTING 120V, 20A LIGHTING OR RECEPTACLE CIRCUIT (AS INDICATED IN ROOM VICINITY). EXTEND CIRCUITING AS REQUIRED.
 - E. BRANCH CIRCUITS: ALL BRANCH CIRCUITS TO BE 1/2" C, 2#12 & 1#12G OR EQUIVALENT TYPE "MC" CABLE WHERE PERMITTED BY SPECS. 00001, UNLESS INDICATED OR REQUIRED OTHERWISE BY NEC.
 - F. FIRE ALARM INITIATING DEVICES: CONNECT TO EXISTING FIRE ALARM INITIATING CONTROL LOOP IN VICINITY (CONFIRM ADEQUATE CAPACITY).
 - G. FIRE ALARM NOTIFICATION DEVICES: CONNECT TO EXISTING FIRE ALARM NOTIFICATION CIRCUIT(S) IN VICINITY (CONFIRM ADEQUATE CAPACITY).
 - H. TYPE "H2", "H3", "H4", "H5" HOUSE LIGHTING FIXTURES: CONNECT EACH HOUSE LIGHTING FIXTURE TO RESPECTIVE DRIVER IN HOUSE LIGHTS DRIVER CABINET. SEE 1510 AND DWG. E104 FOR DRIVER CABINET DETAIL AND SCHEDULES.

- KEYED NOTES**
- 1 (13) HOUSE LIGHTS DRIVER CABINETS HLDC-1 THRU HLDC-13. SEE SCHEDULES ON DWG. E104.
 - 2 (3) EMERGENCY HOUSE LIGHTS DRIVER CABINETS HLDC-E1 THRU HLDC-E3. SEE SCHEDULES ON DWG. E104.
 - 3 UNSWITCHED NIGHT LIGHT.
 - 4 CONNECT EXISTING LIGHTING FIXTURE(S) TO INDICATED NEW CONTROLS.
 - 5 TWO-CIRCUIT 0-10V DIMMING CONTROL SWITCH FOR ABLE AND STEP LIGHTS CONTROL.
 - 6 DOWN TO 0-10V DIMMING LIGHTING POWER PACK "M" - 865 (M) - E104.
 - 7 PROVIDE ALL NEW WIRING FOR TYPE "W1" OVERHEAD STAGE WORK LIGHTING FIXTURES (LOCATED UP ABOVE GRID (IRON LEVEL)). REUSE EXISTING CONDUITS IF FEASIBLE. PROVIDE NEW CONDUITS AS REQUIRED. SEE DWG. E101 FOR ASSOCIATED CONTROLS.
 - 8 PROVIDE FOUR NEW 20A1P CIRCUIT BREAKERS IN ANY AVAILABLE POSITIONS IN EXISTING PANELBOARD.
 - 9 CONNECT CIRCUITS TO RACEWAY STRIP DEVICES IN RACK AS DIRECTED BY DW. 19.
 - 10 CONNECT THREE TYPE "W5" LIGHTING FIXTURES TO EXISTING 120V LIGHTING CIRCUIT AND NEW SWITCH AT PLATFORM OUTSIDE ROOM 371B.
 - 11 PANEL PCB: DISCONNECT THREE EXISTING THREE-PHASE BRANCH CIRCUITS FOR THREE ABANDONED AUDITORIUM PARTITION DRIVE MOTORS. CAP AND LABEL DISCONNECTED WIRES AND REMOVE THE THREE ASSOCIATED 20A/3P CIRCUIT BREAKERS (ASSUMED TO BE #13 THRU #29 (ODD). FIELD VERIFY ACTUAL CIRCUIT NUMBERS. REPLACE WITH NINE 20A/1P BREAKERS TO BE USED AS INDICATED FOR REQUIRED NEW CIRCUITS. ANY UNUSED NEW BREAKERS TO BE LEFT FOR SPARE. PROVIDE NEW CIRCUIT DIRECTORY CARD FOR PANELBOARD ACCURATELY IDENTIFYING ALL NEW AND EXISTING CIRCUITS.
 - 12 PROJECTION ROOM 390 CONTROL COUNTER: PROVIDE APPROX. 15' LONG GRAY WIREMOLD 300 SERIES RACEWAY STRIP (NOT SHOWN) BELOW COUNTER AT APPROX. 18" AFF. WITH TEN BLACK DUPLEX RECEPTACLES SPACED APPROXIMATELY EVENLY FOR CONVENIENT USE, AND NOT BLOCKED BEHIND BELOW-COUNTER SUPPORTS AND SHELVES, ETC. RACEWAY STRIP TO COVER FULL LENGTH OF EXISTING COUNTER PLUS APPROX. THREE FEET INTO OPEN AREA TO HOUSE RIGHT OF COUNTER. CONNECT RECEIPTS TO THREE ALTERNATING CIRCUITS PCB21.23.
 - 13 CONNECT NEW RECEPTACLE TO EXISTING ROOM RECEPTACLE CIRCUIT.

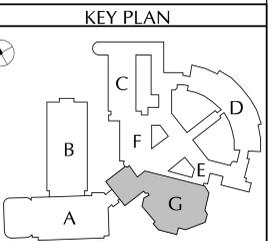


CITY SCHOOL DISTRICT OF NEW ROCHELLE
 NEW ROCHELLE HIGH SCHOOL
 2023 CAPITAL PROJECTS - PHASE 2




NO.	DATE	NO. ADDENDUM	DESCRIPTION
1	05/23/25		

Drawn By: JRM/PT
 Checked By: CB
 Proj. #: 66-11-00-01-0-001
 CSArch Proj. #: 188-2301.02
 Issued for Bid: 05/30/2025


Sheet Title:
AUDITORIUM UPPER LEVEL ELECTRICAL PLAN
 Sheet No.:
NRHS E102
 CONSTRUCTION DOCUMENTS

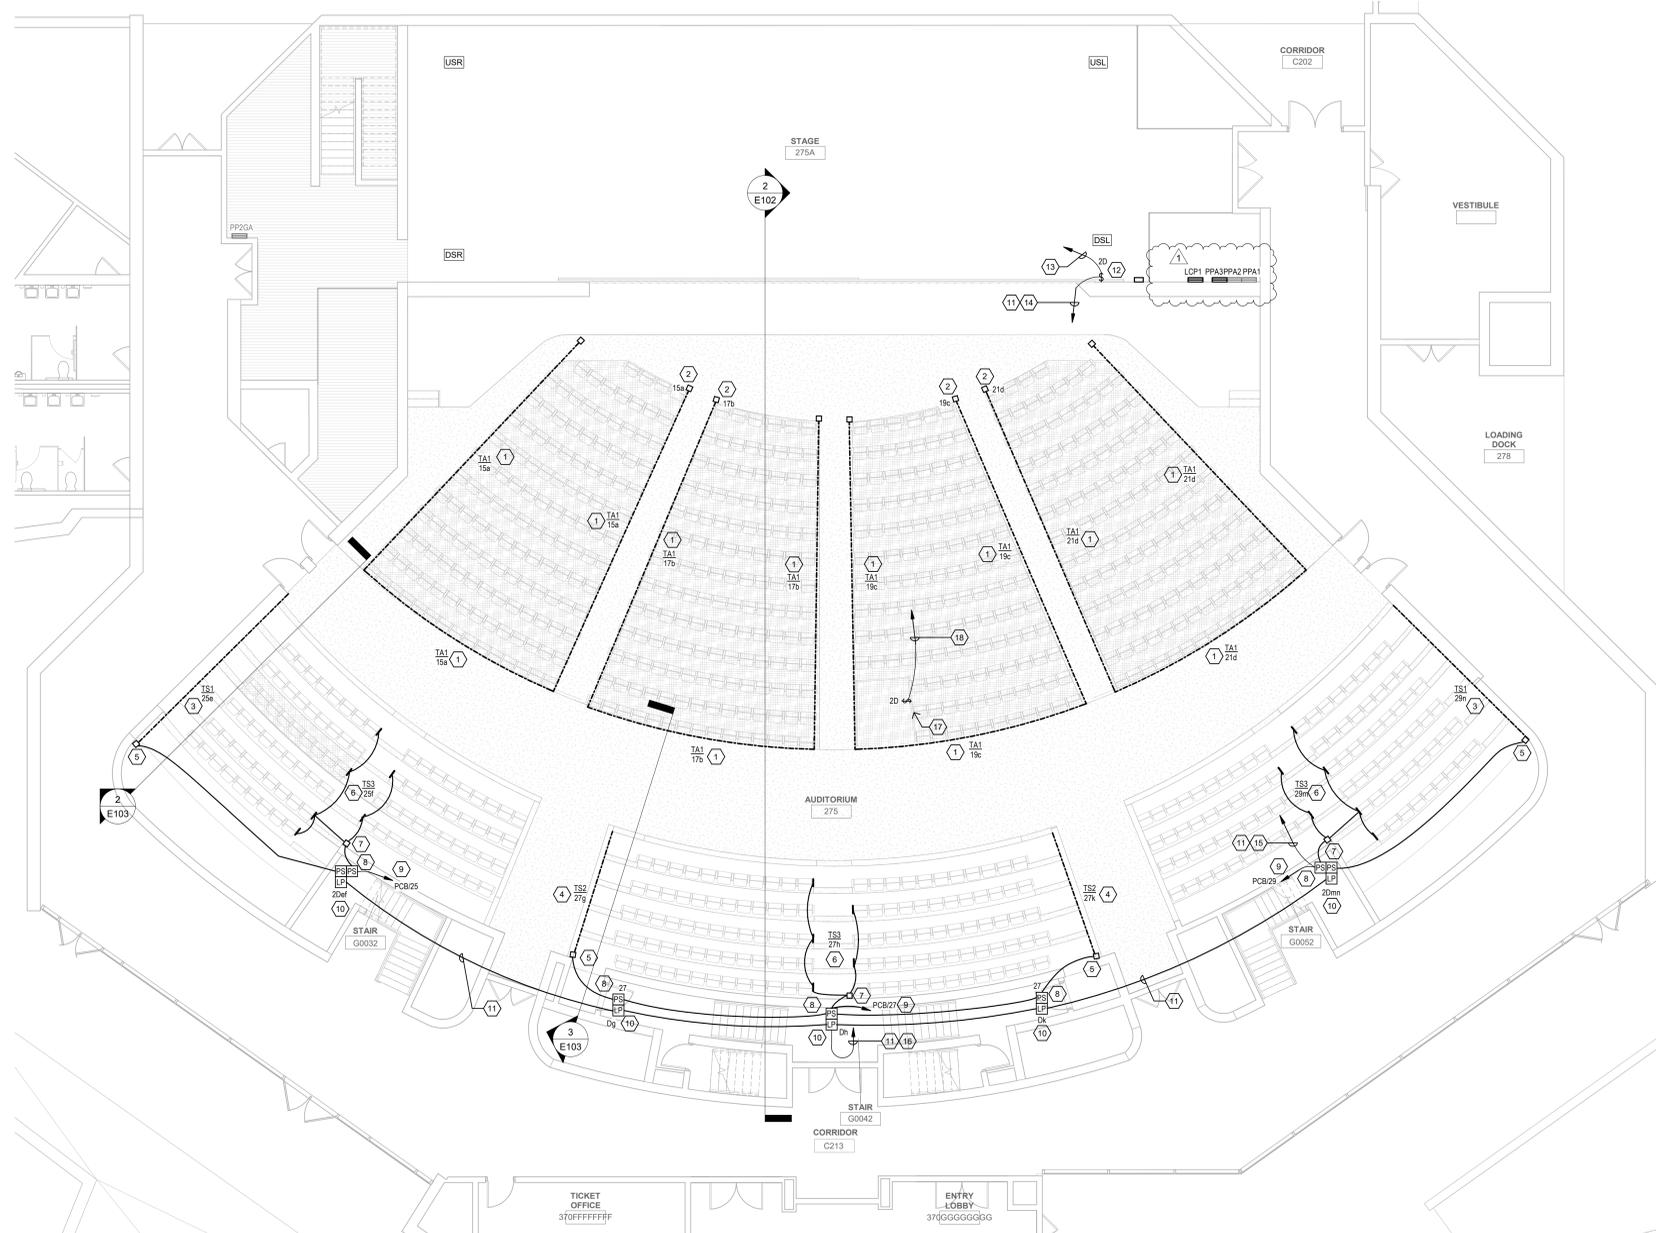

1 AUDITORIUM STEP & AISLE LIGHTING PLAN
E103
1/8" = 1'-0"

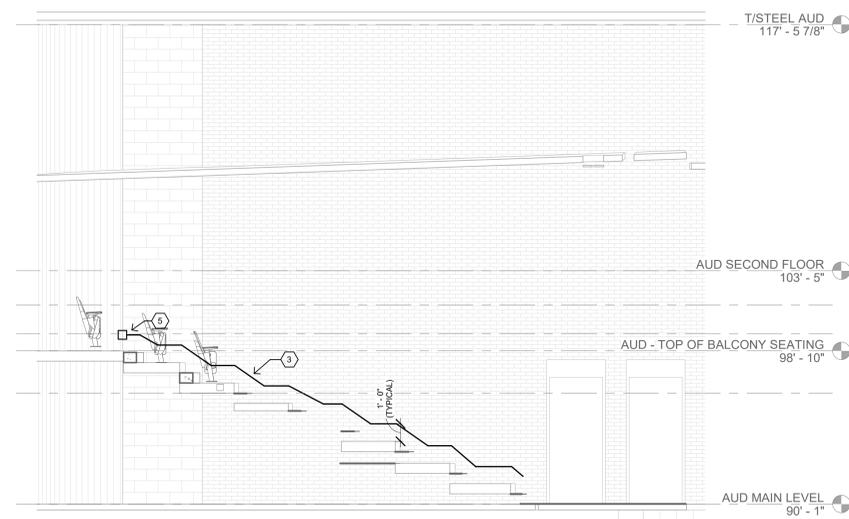

2 UPPER LEVEL STEP LIGHTING ELEVATION - HOUSE LEFT (AS SHOWN) & MIRROR FOR HOUSE RIGHT
E103
1/4" = 1'-0"

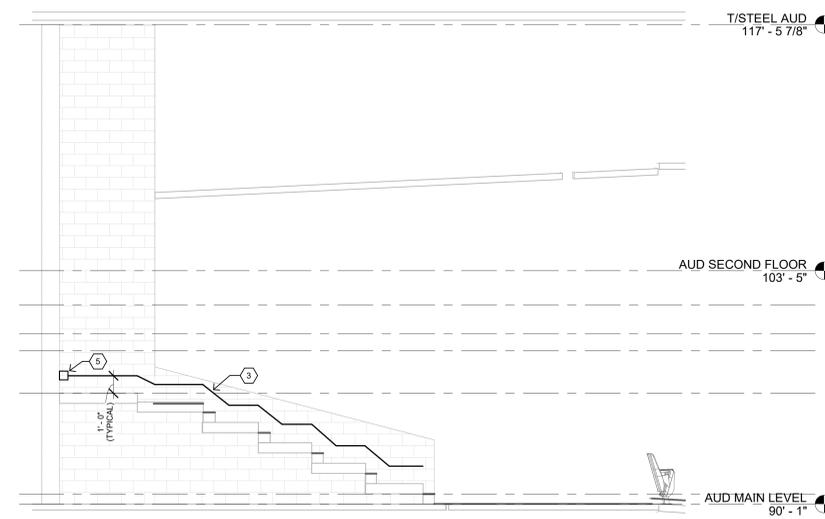


3 UPPER LEVEL STEP LIGHTING ELEVATION - HOUSE LEFT CENTER (AS SHOWN) MIRROR FOR HOUSE RIGHT
E103
1/4" = 1'-0"


GENERAL NOTES
 A. LIGHT/GRAY LINES INDICATE EXISTING ELECTRICAL ITEMS TO REMAIN, UNLESS INDICATED OTHERWISE.
 B. SOLID BLACK LINES INDICATE ELECTRICAL NEW WORK, UNLESS INDICATED OTHERWISE.

- KEYED NOTES**
- TYPE "TA1" AISLE STRIP LIGHTING INSTALLED AT CARPET EDGE (TYPICAL).
 - FEED POINT FOR TYPE "TA1" AISLE STRIP LIGHTING. CONNECT TO RESPECTIVE POWER SUPPLY ON GROUND LEVEL BELOW. SEE DWG. E100.
 - WALL MOUNTED TYPE "TS1" STEP LIGHT FOLLOWING CONTOUR OF STEPS. SEE 2/E103.
 - WALL MOUNTED TYPE "TS2" STEP LIGHT FOLLOWING CONTOUR OF STEPS. SEE 3/E103.
 - FEED POINT FOR TYPE "TS1" ("TS2") STEP LIGHT. CONNECT TO RESPECTIVE POWER SUPPLY.
 - TYPE "TS3" STEP MOUNTED TO SIDE OF NEW SEAT (TYPICAL).
 - FEED POINT FOR TYPE "TS3" STEP LIGHTS. CONNECT TO RESPECTIVE POWER SUPPLY.
 - ONE OR TWO 0-10V DIMMING POWER SUPPLIES AS INDICATED FOR TYPE "TS1", "TS2", AND/OR "TS3" STEP LIGHTS. LOCATE ABOVE ACCESSIBLE CEILING IN STAIRWELL.
 - HOMERUN TO PANELBOARD LOCATED IN PROJECTION ROOM 300 ABOVE. SEE DWG. E102.
 - ONE OR TWO (AS INDICATED) 0-10V DIMMING LIGHTING POWER PACK(S) FOR CONTROL OF INDICATED STEP LIGHT DRIVER(S). CONNECT EACH TO RESPECTIVE POWER SUPPLY.
 - 3/4" WITH CAT-6 LIGHTING CONTROL CABLE (TYPICAL FOR ALL CABLES CONNECTING AISLE/STEP LIGHTING CONTROL DEVICES).
 - TWO-CIRCUIT 0-10V DIMMING CONTROL SWITCH FOR AISLE AND STEP LIGHTS CONTROL.
 - DOWN TO LIGHTING POWER PACKS "1", "1" FOR AISLE LIGHTS ON FLOOR BELOW. SEE DWG. E100.
 - UP TO LIGHTING POWER PACKS "1", "1" AT UPPER LEVEL STAIR 00052.
 - DOWN TO AISLE/STEP LIGHTS CONTROL SWITCH AT DOWN STAIR LEFT.
 - UP TO AISLE/STEP LIGHTS CONTROL SWITCH IN PROJECTION ROOM 300 ABOVE. SEE DWG. E102.
 - TWO-CIRCUIT 0-10V DIMMING CONTROL SWITCH FOR AISLE AND STEP LIGHTS CONTROL. MOUNT TO MID-HOUSE CONTROL STATION RAILING, ETC. AS DIRECTED BY A/E.
 - DOWN TO LIGHTING POWER PACKS "1", "1" FOR AISLE LIGHTS ON FLOOR BELOW. SEE DWG. E100.

KEY PLAN

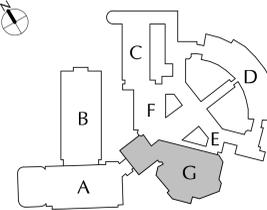

**CITY SCHOOL DISTRICT OF NEW ROCHELLE
 NEW ROCHELLE HIGH SCHOOL
 2023 CAPITAL PROJECTS - PHASE 2**

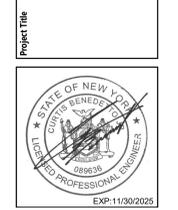

NO.	DATE	NO. ADDENDUM	DESCRIPTION
1	05/23/23		


Drawn By: JRM/PS
 Checked By: CB
 Proj. #: 66-11-00-01-0-001-031
 CSArch Proj. #: 188-2301-02
 Issued for Bid: 05/30/2023

Sheet Title
**AUDITORIUM
 STEP & AISLE
 LIGHTING
 PLAN**

Sheet No.
**NRHS
 E103**



CONSTRUCTION DOCUMENTS

C:\Users\jfreeman\OneDrive - Greenman-Pedersen, Inc\Documents\240013 024 NEW ROCHELLE HS MEP Model_jfreeman\3VALU1.rvt

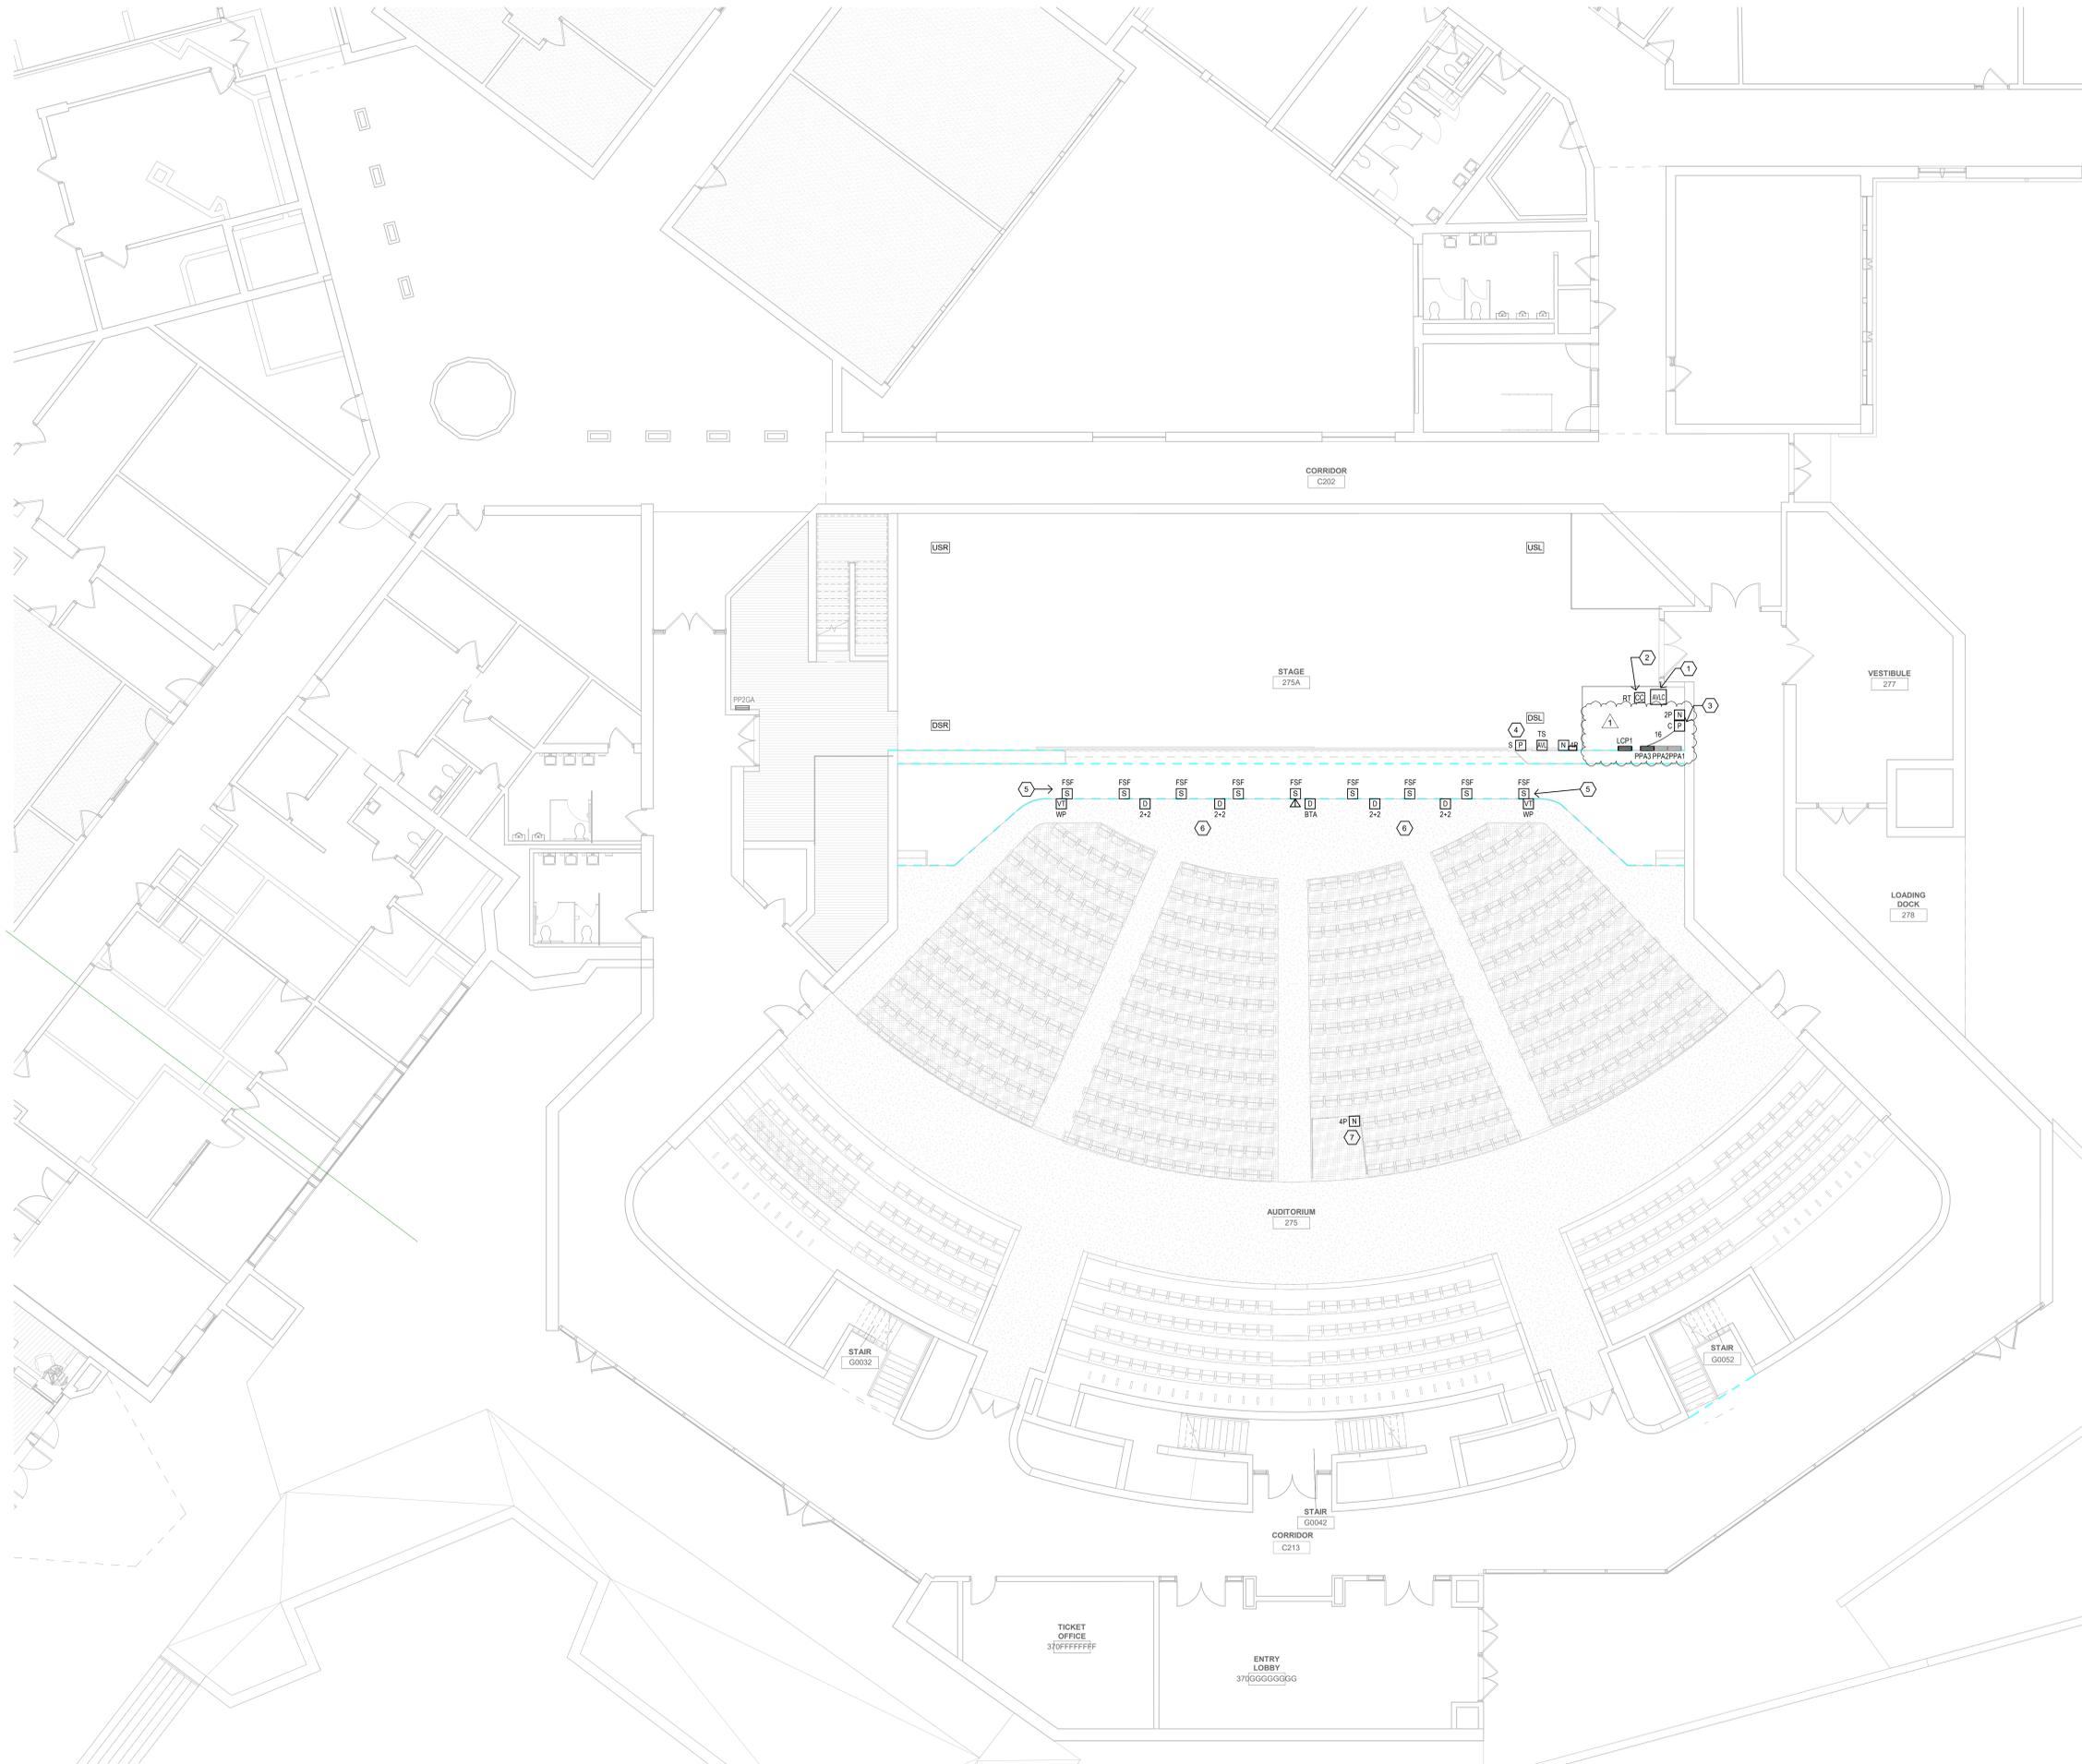

- GENERAL NOTES**
- A. LIGHT GRAY LINES INDICATE EXISTING ELECTRICAL ITEMS TO REMAIN, UNLESS INDICATED OTHERWISE.
 - B. SOLID BLACK LINES INDICATE ELECTRICAL NEW WORK, UNLESS INDICATED OTHERWISE.
 - C. AUDIO AND VIDEO SYSTEMS: ALL EQUIPMENT AND DEVICES SHOWN ON THIS DRAWING ARE TO BE FURNISHED BY DIV. 19. INSTALL ALL SUCH EQUIPMENT AND DEVICES EXCEPT AS INDICATED OTHERWISE.
 - D. AUDIO AND VIDEO EQUIPMENT DEVICE LOCATIONS: CONFIRM EXACT LOCATION FOR EACH ITEM WITH DIV. 19 AND A/E.
 - E. CONDUIT, CABLES, AND CONDUCTOR REQUIREMENTS: SEE DWG. E401.

- KEYED NOTES**
- 1. EXISTING SOUND EQUIPMENT RACK RE-PURPOSED AS NEW AVL CONTROL RACK (AVL-401). ROTATE RACK 90 DEGREES SO THAT FRONT FACES TOWARDS STAGE RIGHT. ALLOW ADEQUATE CLEARANCE BEHIND RACK TO ACCESS EQUIPMENT AND CONNECTIONS. ALL EQUIPMENT IN RACK TO BE PROVIDED BY DIV. 19.
 - 2. CREW COM RADIO TRANSCEIVER MOUNTED IN OR NEAR AVL RACK.
 - 3. INSTALL AND CONNECT PROJECTOR SCREEN CONTROLLER FURNISHED BY DIV. 19.
 - 4. INSTALL AND CONNECT PROJECTOR SCREEN CONTROL SWITCH FURNISHED BY DIV. 19.
 - 5. NINE FRONT OF STAGE FILL SPEAKERS MOUNTED TO APRON. EXACT LOCATION AS DIRECTED BY DIV. 19 AND ARCHITECT.
 - 6. ALL OUTLETS MOUNTED TO FACE OF STAGE APRON TO BE AT SAME MOUNTING HEIGHT (14.5" AFF TO CENTER OF BOX) PER DETAIL 21E105, AND TO BE SPACED HORIZONTALLY SYMMETRICAL ABOUT APRON CENTER LINE. ADJUST OUTLET LOCATIONS (IF SUPPORT WHEELS) USED IN FRONT OF APRON. ALL EXACT OUTLET LOCATIONS TO BE MARKED FOR A/E APPROVAL PRIOR TO COMMENCING WORK.
 - 7. MOUNT NETWORK OUTLET TO MID-HOUSE CONTROL STATION RAILING, ETC. AS DIRECTED BY A/E.

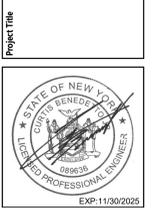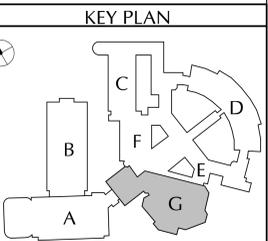

NO.	DATE	DESCRIPTION
1	05/23/23	BID ADDENDUM 1

Drawn By: JRM/PS
 Checked By: CB
 Proj. #: 66-11-00-01-001-031
 CSArch Proj. #: 188-2301.02
 Issued for Bid: 05/30/2023

C:\Users\jfreeman\OneDrive - Greenman-Pedersen, Inc\Documents\2400013 024 NEW ROCHELLE HS MEP Made_jfreeman\3VALU1.rvt

1
 E301
 AUDITORIUM MAIN LEVEL ELECTRICAL FOR AV PLAN
 1/8" = 1'-0"

CITY SCHOOL DISTRICT OF NEW ROCHELLE

ISAAC E YOUNG MIDDLE SCHOOL

2023 CAPITAL PROJECT - PHASE 2B



270 CENTRE AVE, NEW ROCHELLE, NY 10805

ISSUED FOR BID: 06/13/2025

BID ADDENDUM #1: 06/25/2025



CSARCH - ARCHITECTS


GREENMAN - PEDERSEN, INC. - STRUCTURAL ENGINEER

BLAKE ENGINEERING, PLLC - MEP ENGINEERS

STATE EDUCATION DEPARTMENT PROJECT CONTROL NUMBER:
2023 CAPITAL PROJECT - PHASE 2B 66-11-00-01-0-003-018

THE DESIGN OF THIS PROJECT CONFORMS TO APPLICABLE PROVISIONS OF THE NEW YORK STATE UNIFORM FIRE PREVENTION AND BUILDING CODE, THE NEW YORK STATE ENERGY CONSERVATION CONSTRUCTION CODE, AND THE MANUAL OF PLANNING STANDARDS OF THE NEW YORK STATE EDUCATION DEPARTMENT.

CSArch PROJECT NO. 188-2301.02

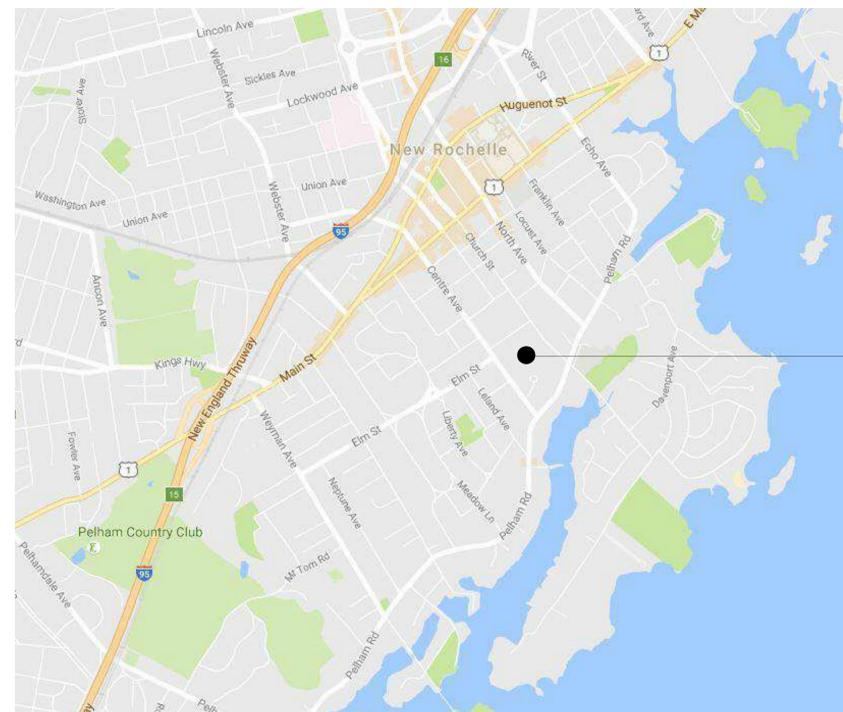

ISAAC E. YOUNG MIDDLE SCHOOL
270 CENTRE AVENUE,
NEW ROCHELLE, NY 10805

NTS



VICINITY MAP

DRAWING LIST - VOLUME 2

GENERAL DRAWINGS	
G000	COVER
G001	SYMBOLS, ABBREVIATIONS, AND PARTITION
G100	OVERALL GROUND FLOOR PLAN
G110	OVERALL FIRST FLOOR PLAN
G120	OVERALL SECOND FLOOR PLAN
LIFE SAFETY DRAWINGS	
LS100	OVERALL GROUND FLOOR LIFE SAFETY PLAN
LS101	AREA 'A' - PARTIAL GROUND FLOOR LIFE SAFETY PLAN
LS102	AREA 'B' - PARTIAL GROUND FLOOR LIFE SAFETY PLAN
LS103	AREA 'C' - PARTIAL GROUND FLOOR LIFE SAFETY PLAN
LS110	OVERALL FIRST FLOOR LIFE SAFETY PLAN
LS111	AREA 'A' - PARTIAL FIRST FLOOR LIFE SAFETY PLAN
LS112	AREA 'B' - PARTIAL FIRST FLOOR LIFE SAFETY PLAN
LS113	AREA 'C' - PARTIAL FIRST FLOOR LIFE SAFETY PLAN
LS120	OVERALL SECOND FLOOR LIFE SAFETY PLAN
LS121	AREA 'A' - PARTIAL SECOND FLOOR LIFE SAFETY PLAN
LS122	AREA 'B' - PARTIAL SECOND FLOOR LIFE SAFETY PLAN
LS123	AREA 'C' - PARTIAL SECOND FLOOR LIFE SAFETY PLAN
LS124	LIFE SAFETY DIAGRAM
STRUCTURAL GENERAL	
S001	STRUCTURAL GENERAL NOTES
STRUCTURAL DRAWINGS	
S101	FIRST FLOOR FRAMING PLAN - AREA B
S102	FIRST FLOOR FRAMING PLAN - AREA C
S103	SECOND FLOOR FRAMING PLAN - AREA B
S104	SECOND FLOOR FRAMING PLAN - AREA C
S105	ROOF FRAMING PLAN - AREA B
S106	ROOF FRAMING PLAN - AREA C
S701	TYPICAL DETAILS
ARCHITECTURAL DEMOLITION DRAWINGS	
AD105	AREA 'B' - PARTIAL GROUND FLOOR DEMO PLAN
AD106	AREA 'C' - PARTIAL GROUND FLOOR DEMO PLAN
AD112	AREA 'B' - PARTIAL FIRST FLOOR DEMO PLAN
AD116	AREA 'C' - PARTIAL FIRST FLOOR DEMO PLAN
AD125	AREA 'B' - PARTIAL SECOND FLOOR DEMO PLAN
AD126	AREA 'C' - PARTIAL SECOND FLOOR DEMO PLAN
AD402	AREA 'B' - PARTIAL ROOF DEMOLITION PLAN
AD403	AREA 'C' - PARTIAL ROOF DEMOLITION PLAN
AD802	AREA 'B' - PARTIAL GROUND FLOOR DEMO RCP
AD803	AREA 'C' - PARTIAL GROUND FLOOR DEMO RCP
AD812	AREA 'B' - PARTIAL FIRST FLOOR DEMO RCP
AD813	AREA 'C' - PARTIAL FIRST FLOOR DEMO RCP
AD822	AREA 'B' - PARTIAL SECOND FLOOR DEMO RCP
AD823	AREA 'C' - PARTIAL SECOND FLOOR DEMO RCP
ARCHITECTURAL DRAWINGS	
A105	AREA 'B' - PARTIAL GROUND FLOOR PLAN
A106	AREA 'C' - PARTIAL GROUND FLOOR PLAN
A116	AREA 'B' - PARTIAL FIRST FLOOR PLAN
A117	AREA 'C' - PARTIAL FIRST FLOOR PLAN
A126	AREA 'B' - PARTIAL SECOND FLOOR PLAN
A127	AREA 'C' - PARTIAL SECOND FLOOR PLAN
A402	AREA 'B' - PARTIAL ROOF PLAN
A403	AREA 'C' - PARTIAL ROOF PLAN
A802	AREA 'B' - PARTIAL GROUND FLOOR RCP
A803	AREA 'C' - PARTIAL GROUND FLOOR RCP
A812	AREA 'B' - PARTIAL FIRST FLOOR RCP
A813	AREA 'C' - PARTIAL FIRST FLOOR RCP
A822	AREA 'B' - PARTIAL SECOND FLOOR RCP
A823	AREA 'C' - PARTIAL SECOND FLOOR RCP
ARCHITECTURAL FINISH DRAWINGS	
AF101	MATERIAL AND ROOM FINISH SCHEDULE
AF105	AREA 'B' - PARTIAL GROUND FLOOR FINISH PLAN
AF106	AREA 'C' - PARTIAL GROUND FLOOR FINISH PLAN
AF112	AREA 'B' - PARTIAL FIRST FLOOR FINISH PLAN
AF116	AREA 'C' - PARTIAL FIRST FLOOR FINISH PLAN
AF125	AREA 'B' - PARTIAL SECOND FLOOR FINISH PLAN
AF126	AREA 'C' - PARTIAL SECOND FLOOR FINISH PLAN
PLUMBING GENERAL	
P001	PLUMBING NOTES, SCHEDULE, LEGEND & DETAILS
PLUMBING DRAWINGS	
P111	AREA A 1ST FLOOR PLUMBING PLAN
P131	AREA A ROOF PLUMBING PLAN
P132	AREA B ROOF PLUMBING PLAN
P133	AREA C ROOF PLUMBING PLAN
MECHANICAL GENERAL	
M001	MECHANICAL LEGENDS, DETAILS, AND ABBREVIATIONS
M002	MECHANICAL SCHEDULES
M003	TEMPERATURE CONTROLS NOTES, LEGEND & SCHEMATICS
MECHANICAL DEMOLITION	
MD101	MECHANICAL REMOVALS PLAN
MD111	AREA C 1ST FLOOR MECHANICAL DEMOLITION PLAN
MD122	AREA B 2ND FLOOR MECHANICAL DEMOLITION PLAN
MD123	AREA C 2ND FLOOR MECHANICAL DEMOLITION PLAN
MD132	AREA B ROOF MECHANICAL DEMOLITION PLAN
MD133	AREA C ROOF MECHANICAL DEMOLITION PLAN
MECHANICAL DRAWINGS	
M101	MECHANICAL NEW WORK PLAN
M102	AREA B GROUND FLOOR MECHANICAL PLAN
M103	AREA C GROUND FLOOR MECHANICAL PLAN
M112	AREA B 1ST FLOOR MECHANICAL PLAN
M113	AREA C 1ST FLOOR MECHANICAL PLAN
M122	AREA B 2ND FLOOR MECHANICAL PLAN
M123	AREA C 2ND FLOOR MECHANICAL PLAN
M132	AREA B ROOF MECHANICAL PLAN
M133	AREA C ROOF MECHANICAL PLAN
ELECTRICAL GENERAL	
E001	ELECTRICAL LEGEND AND ABBREVIATIONS
ELECTRICAL DEMOLITION	
ED101	FIRST FLOOR ELECTRICAL REMOVALS PLAN
ED102	AREA B GROUND FLOOR ELECTRICAL DEMOLITION PLAN
ED103	AREA C GROUND FLOOR ELECTRICAL DEMOLITION PLAN
ED112	AREA B 1ST FLOOR ELECTRICAL DEMOLITION PLAN
ED113	AREA C 1ST FLOOR ELECTRICAL DEMOLITION PLAN
ED122	AREA B 2ND FLOOR ELECTRICAL DEMOLITION PLAN
ED123	AREA C 2ND FLOOR ELECTRICAL DEMOLITION PLAN
ED132	AREA B ROOF ELECTRICAL DEMOLITION PLAN
ED133	AREA C ROOF ELECTRICAL DEMOLITION PLAN
ELECTRICAL DRAWINGS	
E102	AREA 'B' GROUND FLOOR ELECTRICAL PLAN
E103	AREA 'C' GROUND FLOOR ELECTRICAL PLAN
E112	AREA 'B' 1ST FLOOR ELECTRICAL PLAN
E113	AREA 'C' 1ST FLOOR ELECTRICAL PLAN
E122	AREA 'B' 2ND FLOOR ELECTRICAL PLAN
E123	AREA 'C' 2ND FLOOR ELECTRICAL PLAN
E132	AREA 'B' ELECTRICAL ROOF PLAN
E133	AREA 'C' ELECTRICAL ROOF PLAN

VOLUME 2 OF 2



CITY SCHOOL DISTRICT OF NEW ROCHELLE
 ISAAC E YOUNG MIDDLE SCHOOL
 2023 CAPITAL PROJECTS - PHASE 2B



NO.	DATE	NO. ADDENDUM	DESCRIPTION
1	06/03		

Drawn By: SD
 Checked By: JF
 Proj. #: 66-11-00-01-0-003-018
 CSArch Proj. #: 188-2301-02
 Issued for Bid: 06/13/2025

Sheet Title
STRUCTURAL GENERAL NOTES


Sheet No.
IEYMS S-001

STRUCTURAL DESIGN			
DESIGN LOADS:		WIND LOADS (BC1605):	
IMPORTANCE FACTORS (BC1604.5):		BASIC DESIGN WIND SPEED	127 mph
RISK CATEGORY	III	EXPOSURE CATEGORY	B
WIND (Iw)	1.0		
SNOW (Is)	1.1		
SEISMIC (Is)	1.25	SEISMIC REQUIREMENTS (BC1613):	
		SITE CLASS	D
DEAD LOADS:		SPECTRAL RESPONSE COEFFICIENTS:	
ROOF		Ss	0.289 g
EAST WING	86.6 psf	S1	0.060 g
FLAT SLAB	117.6 psf	Sss	0.302 g
JOIST AND BEAMS	105.1 psf	Sss1	0.096 g
		SEISMIC DESIGN CATEGORY	B
LIVE LOADS (BC1607):		MECHANICAL UNIT WEIGHTS:	
ROOF	20 psf	DOAS-1	3129 lbs
FLOOR	40 psf	DOAS-2	3198 lbs
		DOAS-3	3171 lbs
		DOAS-4	3203 lbs
SNOW LOADS (BC1608):			
GROUND SNOW LOAD (Pg) (NYS BLDG.)	25 psf		
FLAT ROOF SNOW LOAD (Ps)	22 psf		
EXPOSURE FACTOR (Ce)	1.0		
THERMAL FACTOR (FLAT ROOF)	1.0		
ROOF PARAPET BALANCED SNOW LOAD	19.3 psf		
ROOF PARAPET DRIFT SNOW LOAD	59.5 psf		

STRUCTURAL ABBREVIATIONS:

@	AT	IN	INCHES
ALT	ALTERNATE		INFO	INFORMATION
APPROX	APPROXIMATELY		INSUL	INSULATION
ARCH	ARCHITECT		INV	INVERT ELEVATION
ATCH	ATTACHMENT		JT	JOINT
BP	BASE PLATE		LBS	POUNDS
BO	BOTTOM OF		LLH	LONG LEG HORIZONTAL
BLDG	BUILDING		LLV	LONG LEG VERTICAL
BOT	BOTTOM		LOC	LOCATIONS
BRG	BEARING		LP	LOW POINT
CANTIL	CANTILEVER		LVL	LAMINATED VENEER LUMBER
CFMF	COLD-FORMED METAL FRAMING		MAX	MAXIMUM
CL	CENTERLINE		MC	MOMENT CONNECTION
CJ	CONTROL JOINT		MECH	MECHANICAL
CJP	COMPLETE JOINT PENETRATION WELD		MEP	MECHANICAL, ELECTRICAL, PLUMBING
CLR	CLEARANCE/CLEAR		MFR	MANUFACTURER
CMU	CONCRETE MASONRY UNIT		MID	MIDDLE
COL	COLUMN		MIN	MINIMUM
CONC	CONCRETE		NO #	NUMBER
CONN	CONNECTION		NTS	NOT TO SCALE
CONT	CONTINUOUS/CONTINUATION		OC	ON CENTER
COORD	COORDINATE		PL	PLATE
DBL	DOUBLE		PSF	POUNDS PER SQUARE FOOT
dia, Ø	DIAMETER		PSI	POUNDS PER SQUARE INCH
DWG	DRAWING		PSL	PARALLEL STRAND LUMBER
EA	EACH		PT	PRESSURE TREATED
EF	EACH FACE		RD	ROOF DRAIN
EJ	EXPANSION JOINT		REINF	REINFORCEMENT/REINFORCED
EL. ELEV	ELEVATION		REQD	REQUIRED
ENR	ENGINEER OF RECORD		SC	SLIP CRITICAL
EOS	EDGE OF SLAB		SCHED	SCHEDULE
EQ	EQUAL/EQUALLY		SF	SQUARE FEET
EW	EACH WAY		SIM	SIMILAR
EXST	EXISTING		SOG	SLAB ON GROUND
EXP	EXPANSION		SP	SPACING
EXT	EXTERIOR		T & B	TOP AND BOTTOM
FD	FLOOR DRAIN		THK	THICK
FIN	FINISHED		T.O.	TOP OF
FS	FOOTING STEP		TOF	TOP OF FOOTING
FT	FOOT/FEET		TOS	TOP OF STEEL/SLAB
FTG	FOOTING		T.O.W.	TOP OF WALL
GALV	GALVANIZED		TYP	TYPICAL
GWB	GYPSPUM WALL BOARD		UNO	UNLESS NOTED OTHERWISE
HOR. HORIZ	HORIZONTAL		VERT	VERTICAL
HP	HIGH POINT		W	WITH
HT	HEIGHT		WWR	WELDED WIRE REINFORCEMENT
ID	INSIDE DIAMETER		YD/YDS	YARD/YARDS

LEGEND

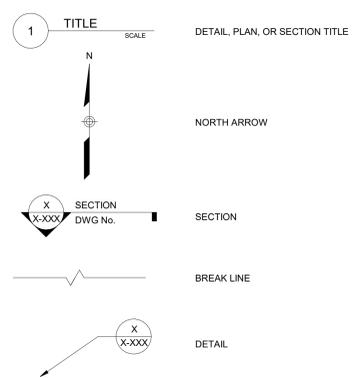

PATTERNS (UNLESS NOTED ON DWG):

	CONCRETE
	MASONRY
	STRUCTURAL STEEL
	NON-SHRINK GROUT
	DOAS UNIT
	METAL DECK INFILL

GENERAL INFORMATION:

- (UNLESS OTHERWISE NOTED OR SHOWN ON PLAN, THE FOLLOWING SHALL APPLY)
- ALL WORK OF THIS CONTRACT SHALL BE PERFORMED IN ACCORDANCE WITH THE 2020 EXISTING BUILDING CODE OF NEW YORK STATE, INCLUDING ALL LOCAL, STATE AND FEDERAL CODES REFERENCED BY THE BUILDING CODE OR HAVING JURISDICTION ON THE WORK OF THIS CONTRACT.
 - "LOADS" INDICATED ON THIS DRAWING ARE THOSE FOR THE DESIGN OF THE BUILDING SUPERSTRUCTURE.
 - DESIGN LOADS AND CRITERIA USED IN THE DESIGN OF SPECIALTY STRUCTURAL SYSTEMS (i.e. CURTAIN-WALL, FIRESTAIRS, ARCHITECTURAL PRECAST CONCRETE, METAL PANELS, ETC.) TO BE DETERMINED BY A THIRD PARTY ENGINEER CONTRACTED BY THE SPECIALTY STRUCTURAL SYSTEM IN ACCORDANCE WITH CODE REQUIREMENTS OF GOVERNING JURISDICTION. SPECIALTY ENGINEER IS RESPONSIBLE FOR ALL CONNECTIONS OF THESE SYSTEMS TO THE SUPERSTRUCTURE, INCLUDING, BUT NOT LIMITED TO, ENGINEERING, DETAILING, AND INSTALLATION. IF ALTERATION TO THE SUPERSTRUCTURE IS REQUIRED AS DETERMINED BY THE E.O.R. TO REINFORCE FOR HIGH CONCENTRATED FORCES APPLIED TO THE SPECIALTY SYSTEM CONNECTION, THE REINFORCEMENT AND COST SHALL BE BORNE BY THE SPECIALTY SUB-CONTRACTOR AND SHALL BE CONSIDERED A PART OF THE SPECIALTY CONNECTION.
 - ALL DETAILS MARKED "TYPICAL" IN THE SET OF STRUCTURAL DRAWINGS SHALL BE APPLIED THROUGHOUT THE PROJECT AS REQUIRED TO SATISFY THE REQUIREMENTS OF THE CONSTRUCTION DOCUMENTS. THE CONTRACTOR SHALL COORDINATE REQUIREMENTS FOR QUANTITY AND LOCATION WHERE THE "TYPICAL" DETAILS APPLY.
 - FAILURE ON THE PART OF THE CONTRACTOR TO REVIEW THE DRAWINGS OF OTHER DISCIPLINES (i.e. ARCHITECTURAL, MECHANICAL, ELECTRICAL, PLUMBING, ETC.) TOGETHER WITH THE FULL EXTENT OF THE PROJECT SPECIFICATIONS DOES NOT RELIEVE THEM OF THE RESPONSIBILITY TO FURNISH AND INSTALL ITEMS THAT ARE PART OF THEIR WORK AS INDICATED BY THE DRAWINGS AND SPECIFICATIONS OF OTHER TRADES. ALL STRUCTURAL TRADE CONTRACTORS AND SUB-CONTRACTORS ARE PROHIBITED FROM EXCLUDING STRUCTURAL WORK FROM THEIR CONTRACT NOT SHOWN IN THE STRUCTURAL DRAWINGS.
 - CONTRACTOR SHALL COORDINATE ALL WORK WITH THE OWNER.
 - THE CONTRACTOR IS RESPONSIBLE FOR PROPER FIELD FITTING AND QUANTITY OF WORK. THE CONTRACTOR SHALL TAKE FIELD MEASUREMENTS AS REQUIRED AND BE RESPONSIBLE FOR FITTING NEW CONSTRUCTION TO EXISTING CONSTRUCTION.
 - THE CONTRACTOR IS RESPONSIBLE FOR A SITE INVESTIGATION(S) PRIOR TO THE START OF WORK TO REVEAL ALL EXISTING CONDITIONS.
 - IT IS THE CONTRACTOR'S RESPONSIBILITY TO EXAMINE ALL DRAWINGS AND SPECIFICATIONS AND COORDINATE ALL WORK WITHIN THE CONTRACT.

EXISTING CONDITIONS GENERAL NOTES:

- (UNLESS OTHERWISE NOTED OR SHOWN ON PLAN, THE FOLLOWING SHALL APPLY)
- THE SCOPE OF WORK OF THIS PROJECT DOES NOT ALTER THE WIND LOADING TO EXISTING WIND-FORCE RESISTING SYSTEMS, EXTERIOR WALLS, OR ROOF CONSTRUCTION BY MORE THAN 5%. IN ACCORDANCE WITH 2020 NEW YORK BUILDING CODE PROVISIONS, NO GLOBAL ANALYSIS OR UPGRADE OF THE EXISTING WIND-FORCE RESISTING SYSTEMS HAVE BEEN CONDUCTED.
 - THE SCOPE OF WORK OF THIS PROJECT DOES NOT ALTER THE SEISMIC LOADING TO EXISTING SEISMIC FORCE RESISTING SYSTEMS BY MORE THAN 5% PER 2020 NEW YORK BUILDING CODE PROVISIONS, NO GLOBAL ANALYSIS OR UPGRADE OF THE EXISTING SEISMIC FORCE RESISTING SYSTEMS HAS BEEN CONDUCTED.
 - DIMENSIONS AND ELEVATIONS OF EXISTING CONDITIONS GIVEN ON STRUCTURAL DRAWINGS ARE BASED ON INFORMATION CONTAINED IN VARIOUS ORIGINAL DESIGN AND CONSTRUCTION DOCUMENTS PROVIDED BY THE OWNER, AND LIMITED FIELD OBSERVATIONS AND MEASUREMENTS.
 - CONTRACTOR SHALL VERIFY ALL EXISTING DIMENSIONS AND CONDITIONS BY ACTUAL MEASUREMENT PRIOR TO BEGINNING WORK, AND WHEN FEASIBLE, PRIOR TO SHOP DRAWING SUBMITTALS. ANY DISCREPANCIES SHALL BE BROUGHT TO THE ATTENTION OF THE ARCHITECT. IT SHALL BE THE RESPONSIBILITY OF THE GENERAL CONTRACTOR TO COORDINATE SAID DISCREPANCIES WITH ALL SUB-CONTRACTORS AND MATERIAL SUPPLIERS.
 - CONTRACTOR SHALL PROVIDE TEMPORARY SHORING AND BRACING TO MAKE SAFE ALL FLOORS AND/OR ADJACENT PROPERTY AS PROJECT CONDITIONS REQUIRE. DESIGN SHALL BE STAMPED BY A NEW YORK LICENSED ENGINEER EMPLOYED BY THE CONTRACTOR.

STRUCTURAL STEEL DECK GENERAL NOTES:


- (UNLESS OTHERWISE NOTED OR SHOWN ON PLAN, THE FOLLOWING SHALL APPLY)
- ALL STEEL DECK SHALL BE DESIGNED, FABRICATED AND INSTALLED IN ACCORDANCE WITH THE LATEST SDI, AISI, AND AWS STANDARD SPECIFICATION.
 - SHEET STEEL SHALL CONFORM TO ASTM A611 GRADE C OR ASTM A653 SQ GRADE 33 WITH A MINIMUM YIELD STRENGTH OF 33 KSI. STEEL SHEET SHALL BE ASTM A653, CLASS G 90 COATED WITH A HOT DIP ZINC COATING PRIOR TO FABRICATION.
 - SHOP DRAWINGS SHALL BE SUBMITTED SHOWING ALL OPENINGS AND CORRESPONDING REINFORCEMENT. SHOP FABRICATION MAY ONLY OCCUR FROM "APPROVED" OR "APPROVED AS NOTED" DRAWINGS.
 - ACCESSORIES SHALL BE FABRICATED OF 18 GAUGE OR GREATER SHEET STEEL.
 - UNITS SHALL BE FABRICATED AND INSTALLED TO BE CONTINUOUS OVER 3 SPANS. DECKS SHALL BE PREFABRICATED FOR OPENING AND REINFORCED WHERE REQUIRED TO MAINTAIN DECK STRENGTH, ALIGNMENT AND PROFILE.
 - STEEL DECKING IS TO BE INSTALLED FOLLOWING THE COMPLETION OF THE INSTALLATION OF THE SUPPORTING STEEL. THE SUPPORTING STEEL MUST BE PLUMBED AND ALIGNED AND TEMPORARY SHORING INSTALLED, WHERE REQUIRED TO MEET MANUFACTURER'S RECOMMENDATIONS, PRIOR TO THE INSTALLATION OF THE DECKING.
 - DECK UNITS SHALL BE PLACED ON SUPPORTING STEEL AND ADJUSTED TO FINAL POSITION WITH ENDS BEARING ON SUPPORT MEMBERS AND FLUTES IN STRAIGHT AND TRUE ALIGNMENT PRIOR TO FASTENING.
 - INSTALL DECKING WITH MINIMUM END BEARING OF 1-1/2 INCHES.
 - DECK UNITS SHALL BE FASTENED TO STEEL SUPPORTS 0.18 INCHES THICK OR LESS W/ NO. 12-14X3/4 INCH SELF-DRILLING FASTENERS AT 12 INCHES ON CENTER AT ENDS.
 - SIDE LAPS SHALL BE FASTENED AT INTERVALS NOT EXCEEDING 36 INCHES. SIDE LAPS MAY BE FASTENED WITH SELF-DRILLING NO. 12 DIAMETER OR LARGE CARBON STEEL SCREWS OR A MECHANICAL BUTTON PUNCH.
 - STARTING AND FINISHING SIDE EDGES SHALL BE FASTENED TO BEARING SUPPORTS AT 36 INCHES ON CENTER MAX.
 - INSTALL FLEXIBLE CLOSURE STRIPS TO SEAL UNDERSIDE OF FLUTES WHERE FLUTED DECKS EXTEND OVER EXTERIOR WALLS AND ABOVE INTERIOR PARTITIONS WHERE THERE ARE NO CEILINGS BELOW THE FLUTED DECK.
 - ALL ELECTRICAL, MECHANICAL, PIPING, DUCTWORK, ETC. SHALL NOT BE HUNG FROM METAL DECK.

Handwritten signature



1 FIRST FLOOR FRAMING PLAN - AREA B
3/32" = 1'-0"

NOTE: LINTELS AND WALL PENETRATIONS SHOWN ARE AT GROUND FLOOR.

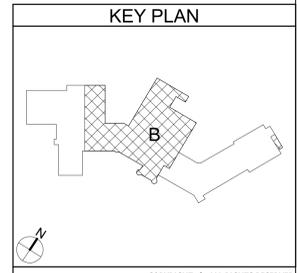

**CITY SCHOOL DISTRICT OF NEW ROCHELLE
ISAAC E YOUNG MIDDLE SCHOOL
2023 CAPITAL PROJECTS - PHASE 2B**

Project Title




NO.	REVISIONS	BID ADDENDUM
1.	06/13/23	BID ADDENDUM 1
2.		
3.		
4.		
5.		
6.		
7.		
8.		
9.		
10.		

Drawn By: SD
Checked By: KJ
Proj. #: 66-11-00-01-0-003-018
CSArch Proj. #: 188-2301.02
Issued for Bid: 06/13/2025

Sheet Title
**FIRST FLOOR
FRAMING
PLAN - AREA B**


Sheet No.
**IEYMS
S-101**
CONSTRUCTION DOCUMENTS

[Handwritten Signature]

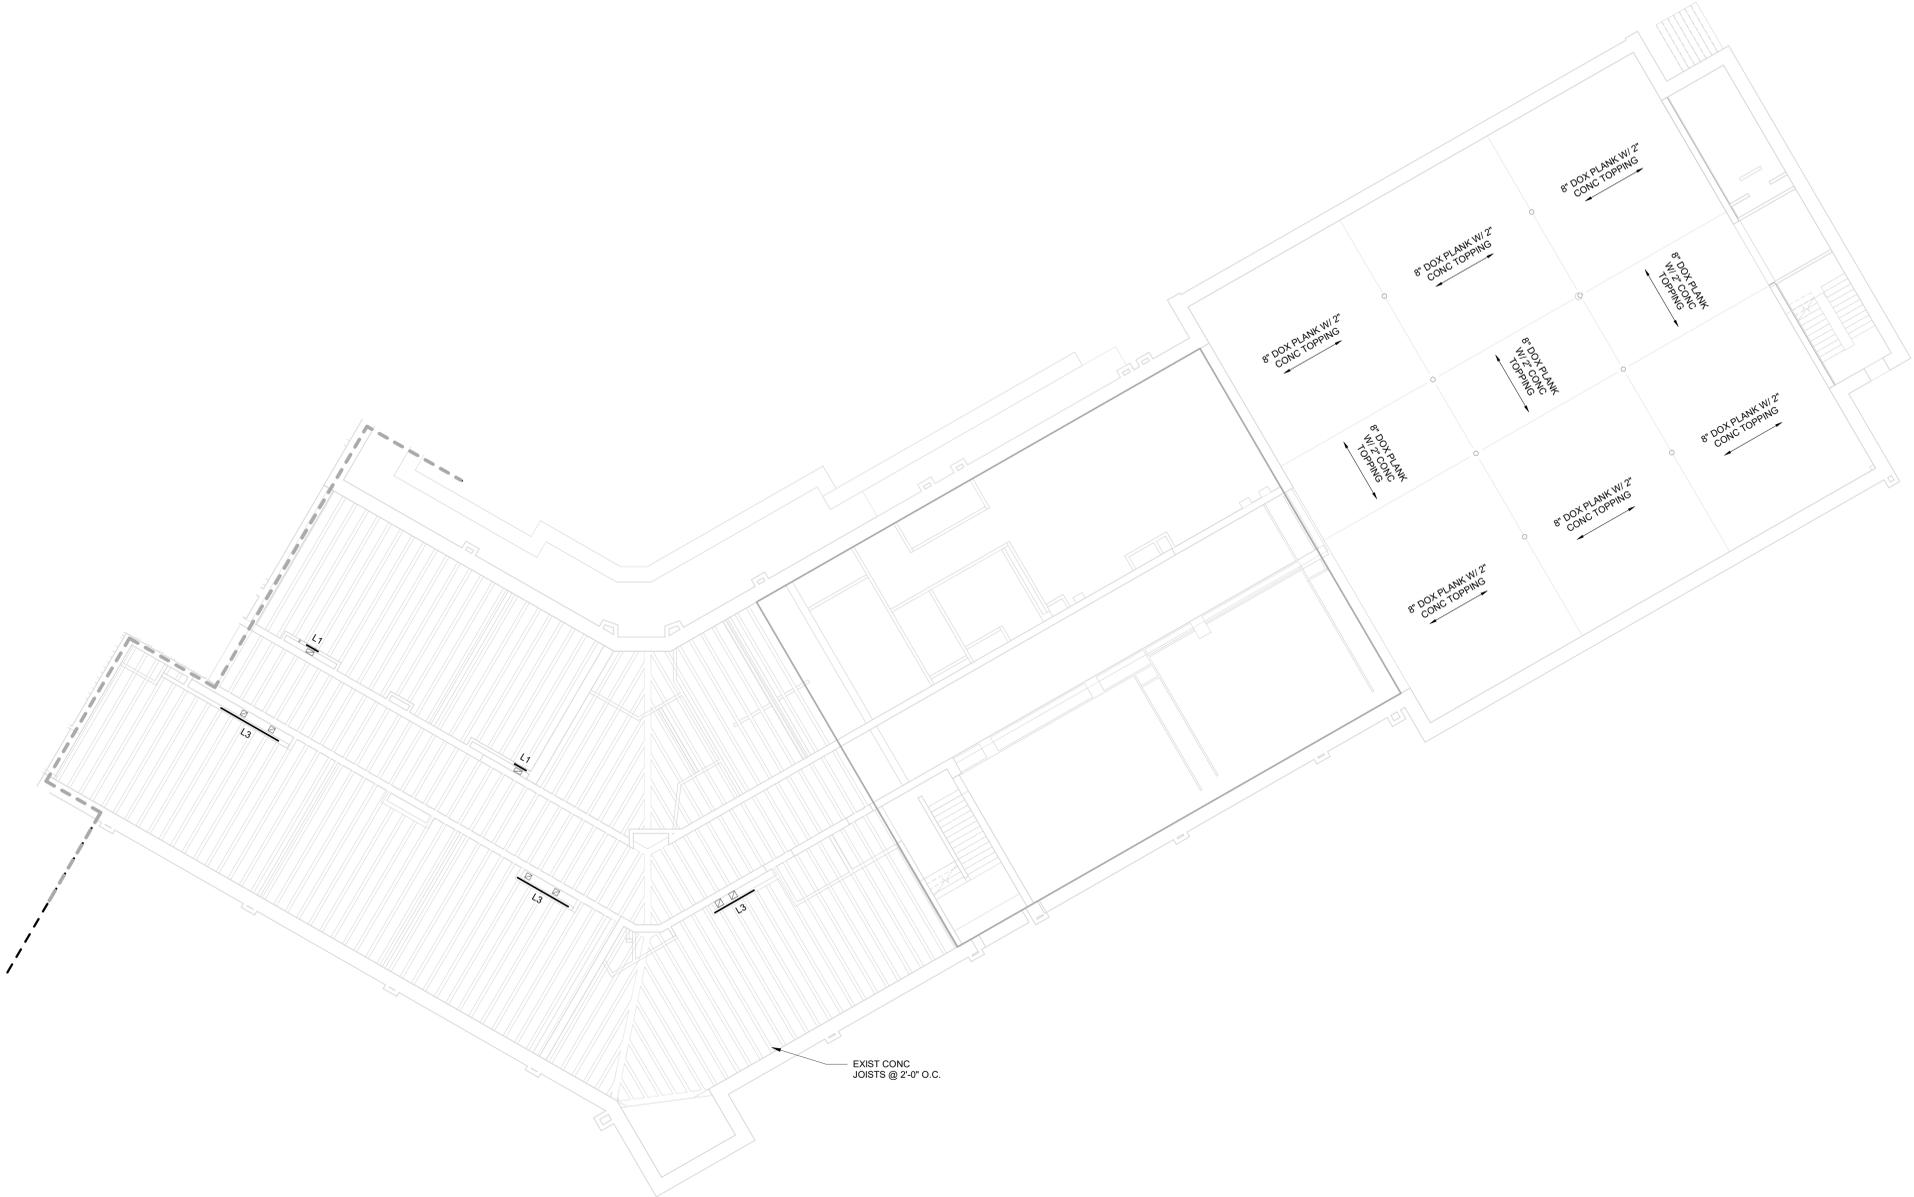

1 FIRST FLOOR FRAMING PLAN - AREA C
3/32" = 1'-0"

NOTE: LINTELS AND WALL PENETRATIONS SHOWN ARE AT GROUND FLOOR.

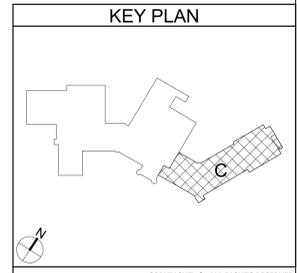

CITY SCHOOL DISTRICT OF NEW ROCHELLE
ISAAC E YOUNG MIDDLE SCHOOL
2023 CAPITAL PROJECTS - PHASE 2B

Project Title




NO.	DATE	DESCRIPTION
1	06/13/25	BID ADDENDUM 1

Drawn By: SP
Checked By: KJ
Proj. #: 66-11-00-01-0-003-018
CSArch Proj. #: 188-2301.02
Issued for Bid: 06/13/2025

Sheet Title
FIRST FLOOR
FRAMING
PLAN - AREA C

Sheet No.
IEYMS
S-102
CONSTRUCTION DOCUMENTS

[Handwritten Signature]

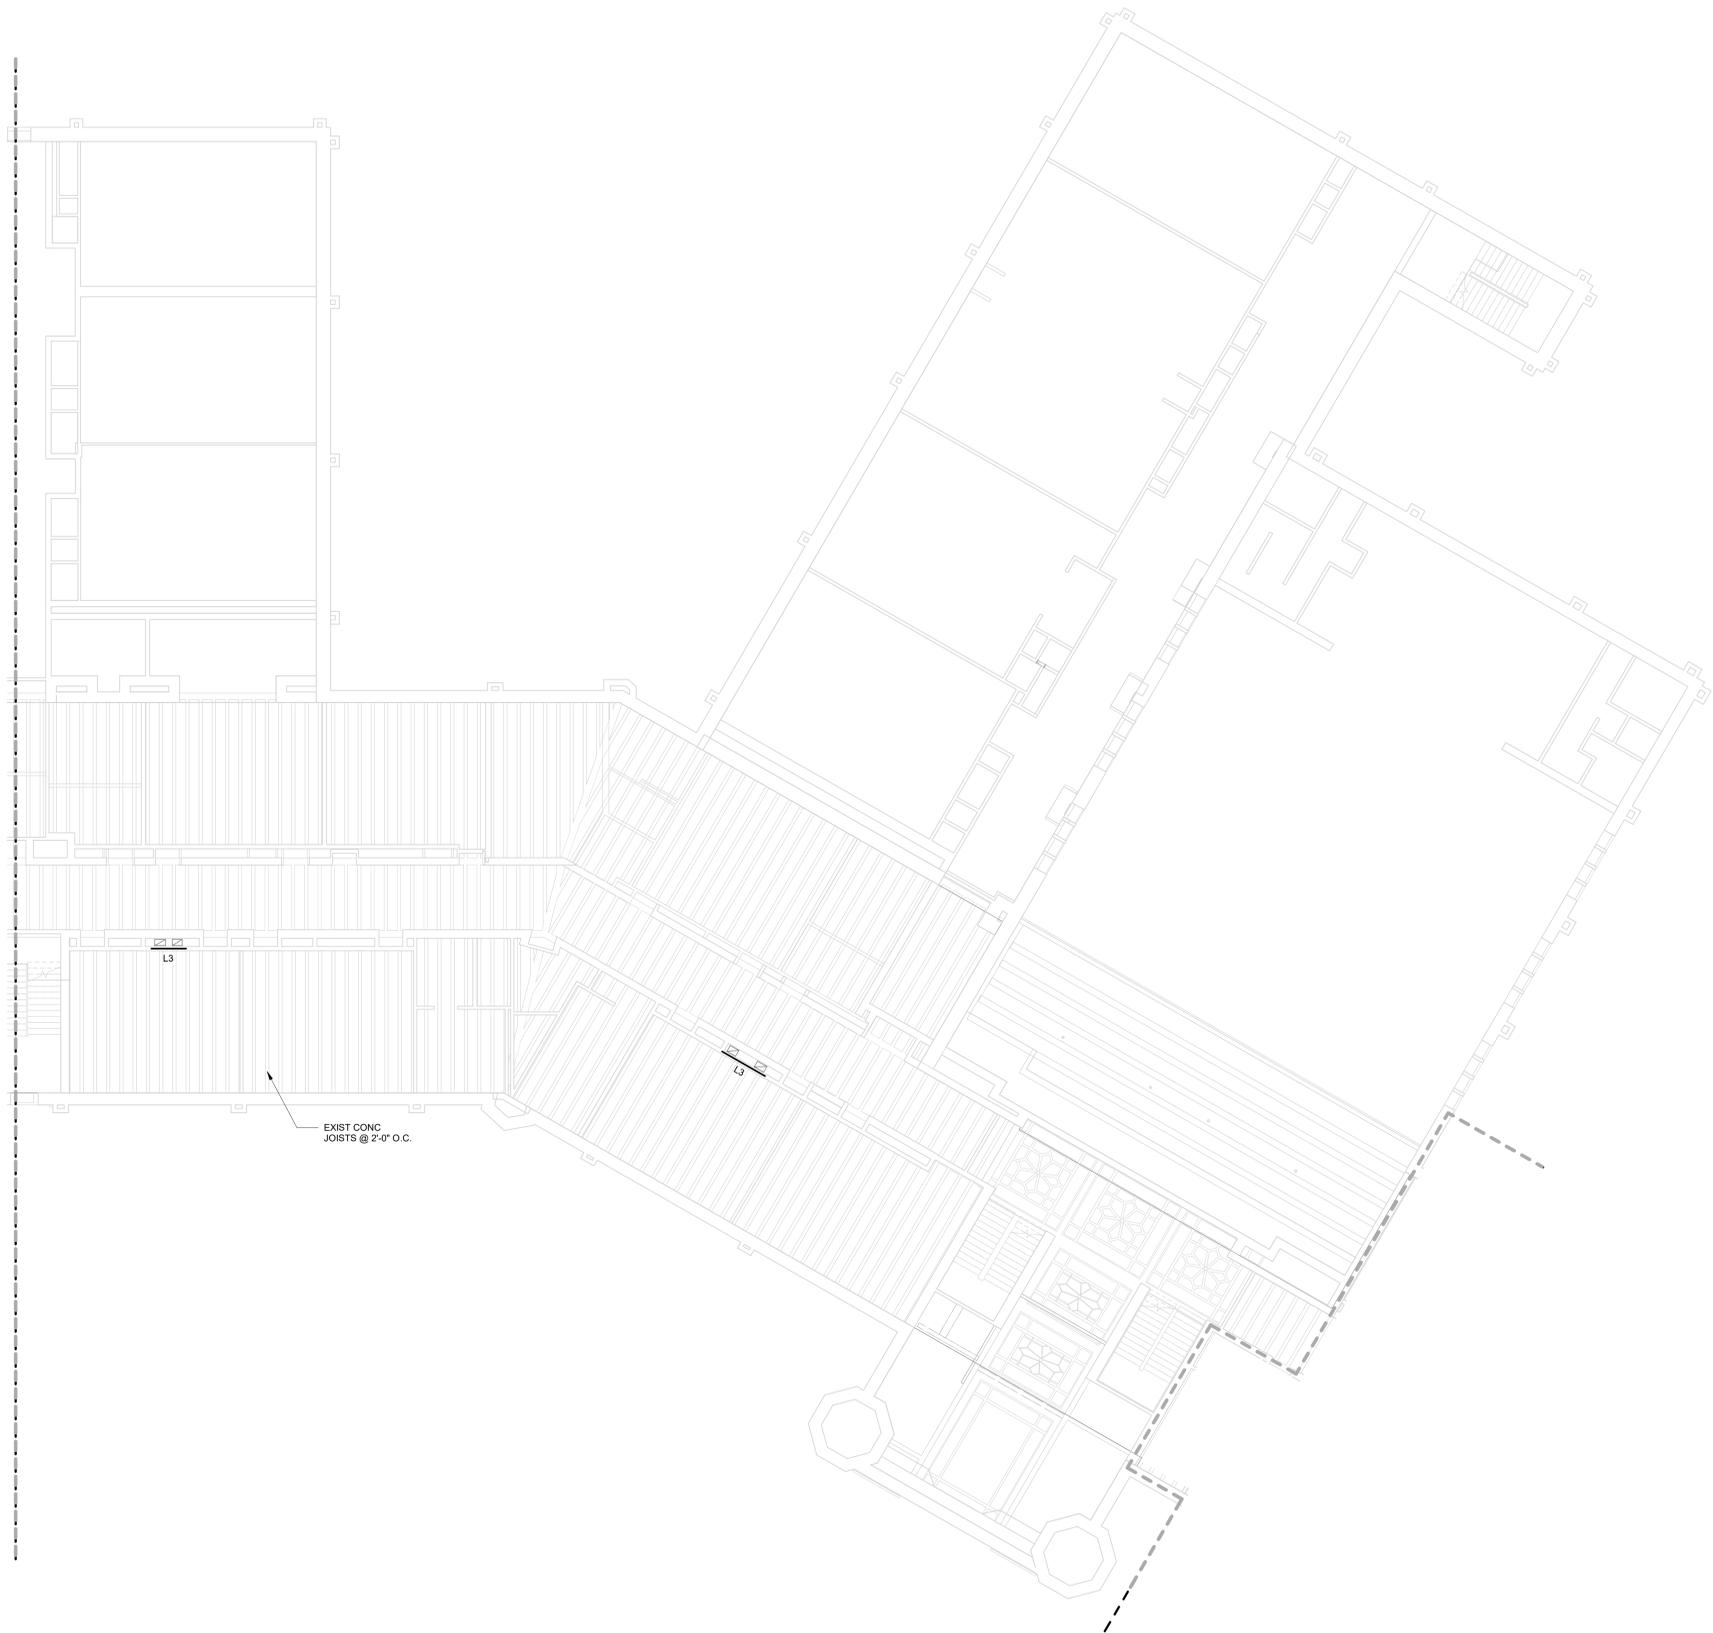


EXIST CONC
JOISTS @ 2'-0" O.C.

L3

L3

1 SECOND FLOOR FRAMING PLAN - AREA B
3/32" = 1'-0"

NOTE: LINTELS AND WALL PENETRATIONS SHOWN ARE AT 1ST FLOOR.

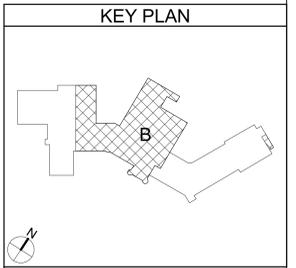

KEY PLAN

19 Front St., Newburgh - New York 12550-7601
847-561-3379 www.csaarch.com



CSARCH

CITY SCHOOL DISTRICT OF NEW ROCHELLE
ISAAC E YOUNG MIDDLE SCHOOL
2023 CAPITAL PROJECTS - PHASE 2B

Project Title




NO.	REVISIONS	DATE	DESCRIPTION
1	06/13/25		BID ADDENDUM 1

Drawn By: SD
Checked By: KJ
Proj. #: 66-11-00-01-0-003-018
CSArch Proj. #: 188-2301.02
Issued for Bid: 06/13/2025

Sheet Title
SECOND FLOOR FRAMING PLAN - AREA B


Sheet No.
IEYMS
S-103

CONSTRUCTION DOCUMENTS

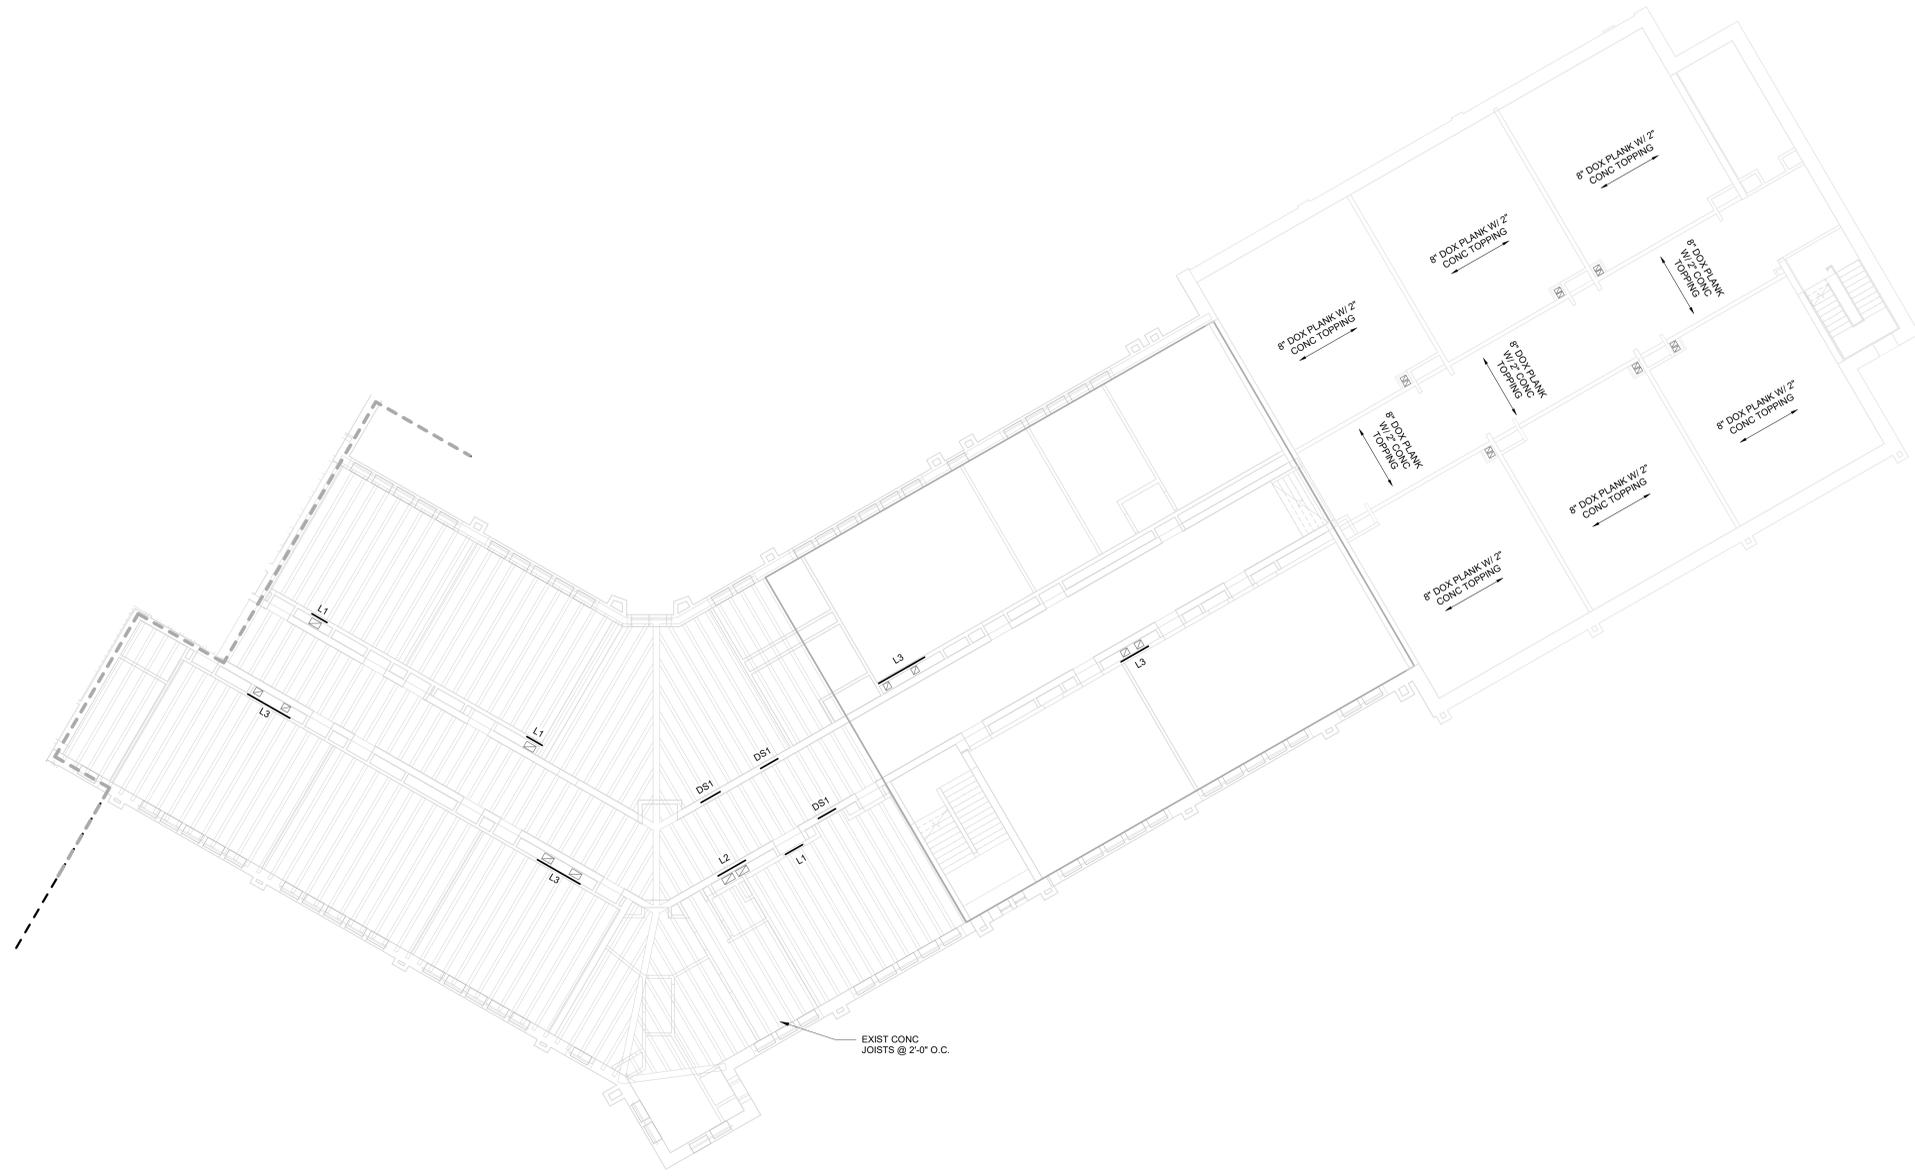

1 SECOND FLOOR FRAMING PLAN - AREA C
3/32" = 1'-0"

NOTE: LINTELS AND WALL PENETRATIONS SHOWN ARE AT 1ST FLOOR.

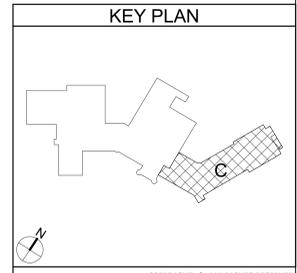

CITY SCHOOL DISTRICT OF NEW ROCHELLE
ISAAC E YOUNG MIDDLE SCHOOL
2023 CAPITAL PROJECTS - PHASE 2B

Project Title




NO.	DATE	DESCRIPTION
1	06/12/23	BID ADDENDUM 1

Drawn By: SD
Checked By: KJ
Proj. #: 66-11-00-01-0-003-018
CSArch Proj. #: 188-2301.02
Issued for Bid: 06/13/2025

Sheet Title
SECOND FLOOR FRAMING PLAN - AREA C


Sheet No.
IEYMS
S-104

[Signature]

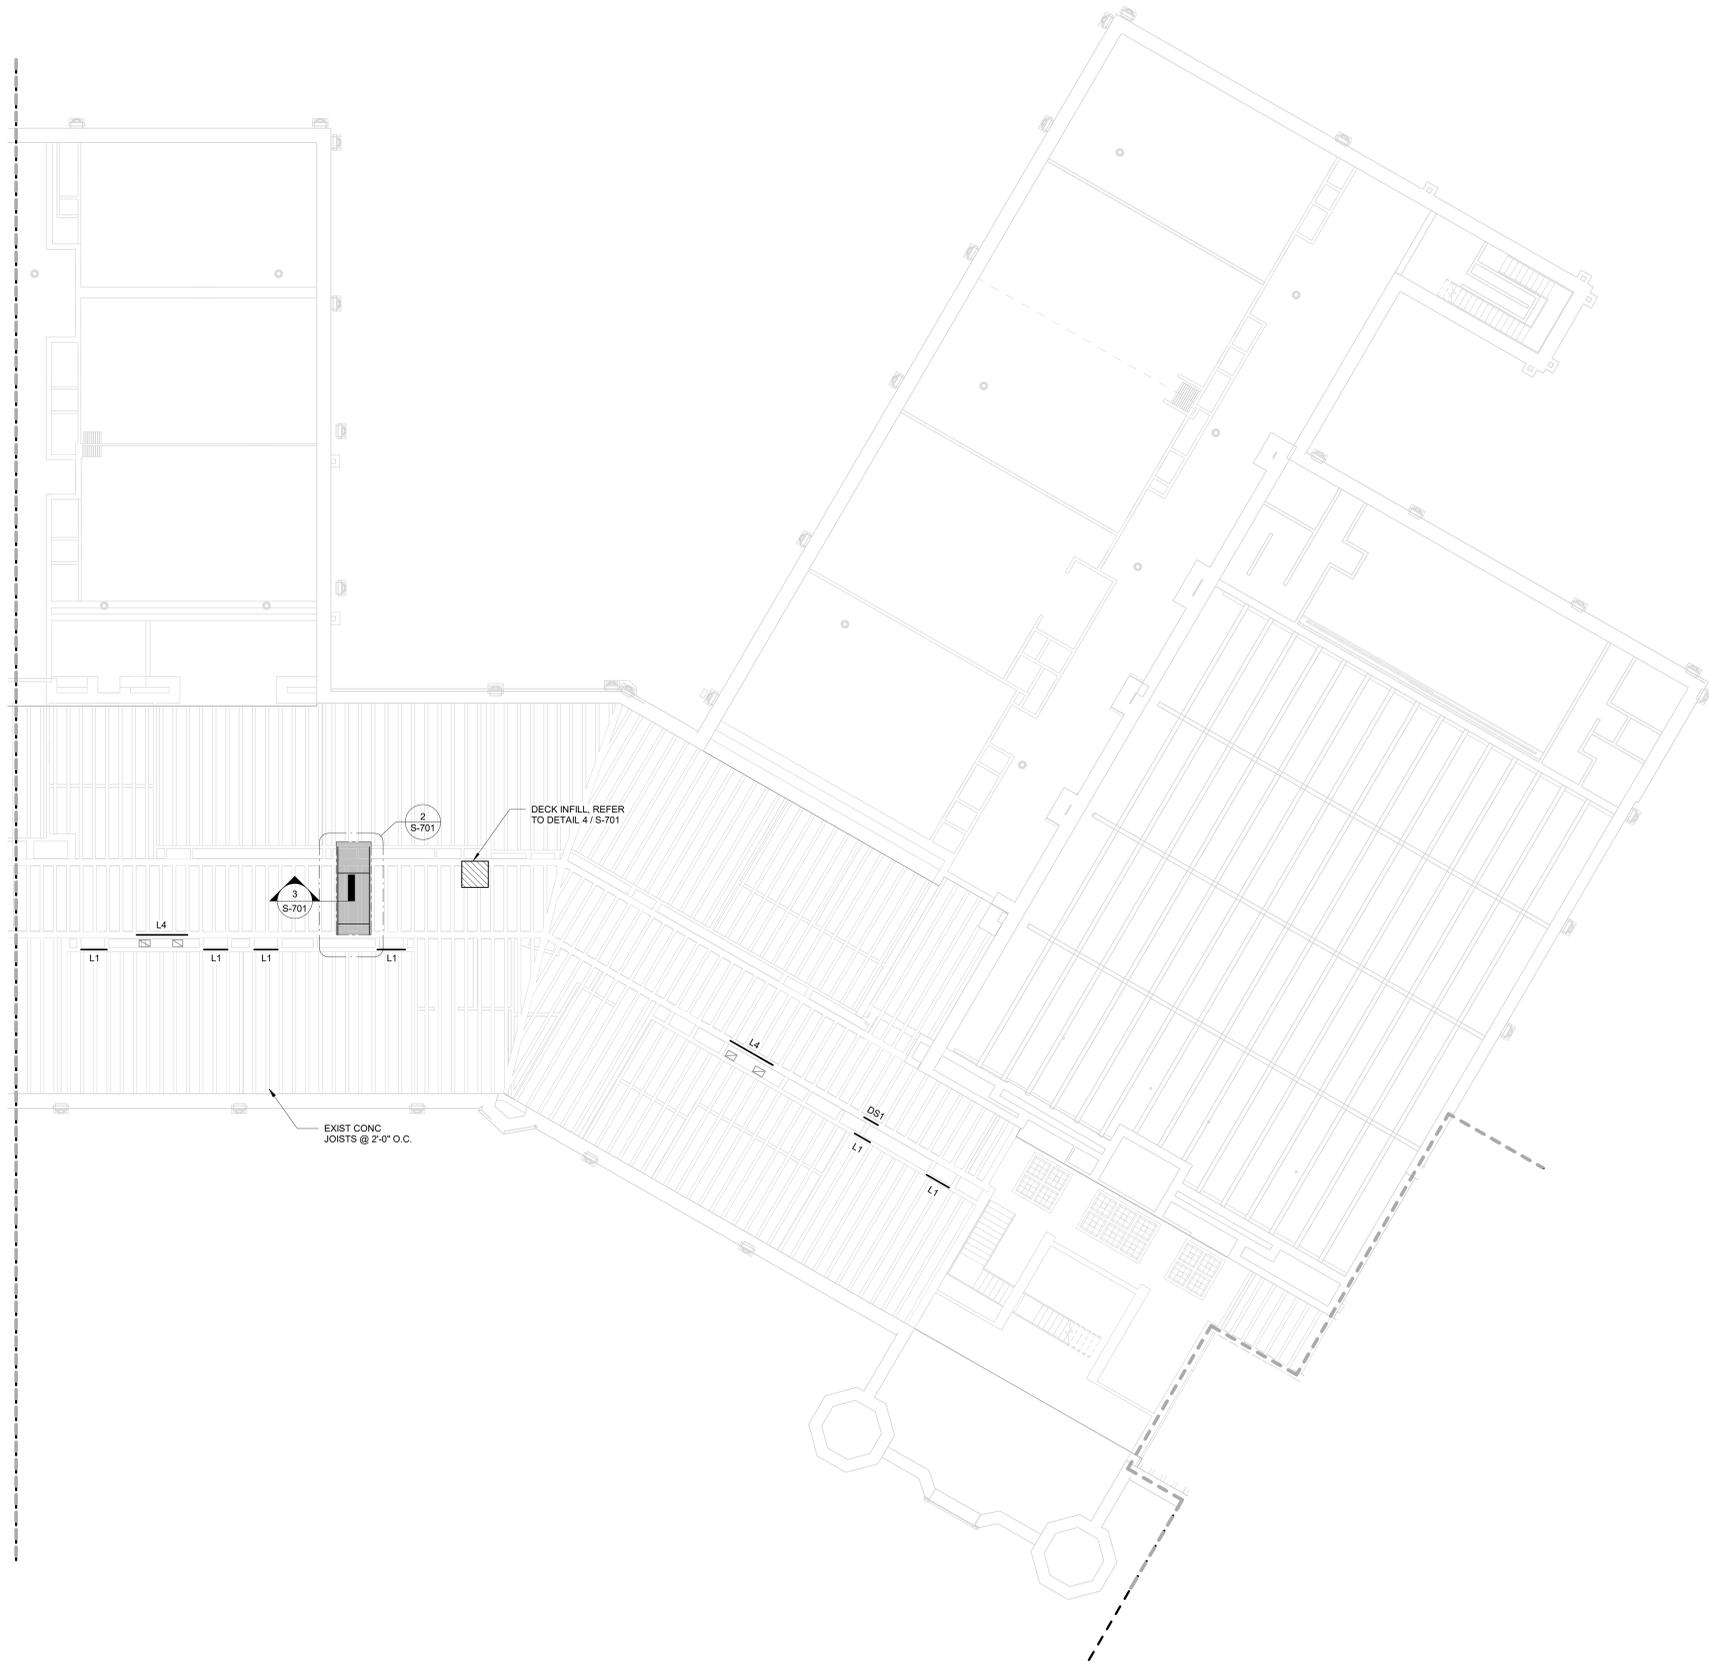

1 ROOF FRAMING PLAN - AREA B
3/32" = 1'-0"

NOTE: LINTELS AND WALL PENETRATIONS SHOWN ARE AT 2ND FLOOR.

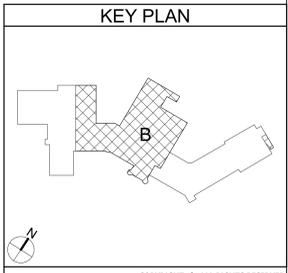

19 Front St., Newburgh - New York 12550-7601
847-561-3379 www.csaarch.com



CS ARCH

CITY SCHOOL DISTRICT OF NEW ROCHELLE
ISAAC E YOUNG MIDDLE SCHOOL
2023 CAPITAL PROJECTS - PHASE 2B

Project Title



NO.	DATE	DESCRIPTION
1	06/13/23	BID ADDENDUM 1

Drawn By: SJ
Checked By: 66-11-00-01-0-003-018
CSArch Proj. #: 188-2301.02
Issued for Bid: 06/13/2025


Sheet Title
ROOF FRAMING PLAN - AREA B

Sheet No.
IEYMS
S-105

CONSTRUCTION DOCUMENTS


[Handwritten Signature]

COPYRIGHT © ALL RIGHTS RESERVED

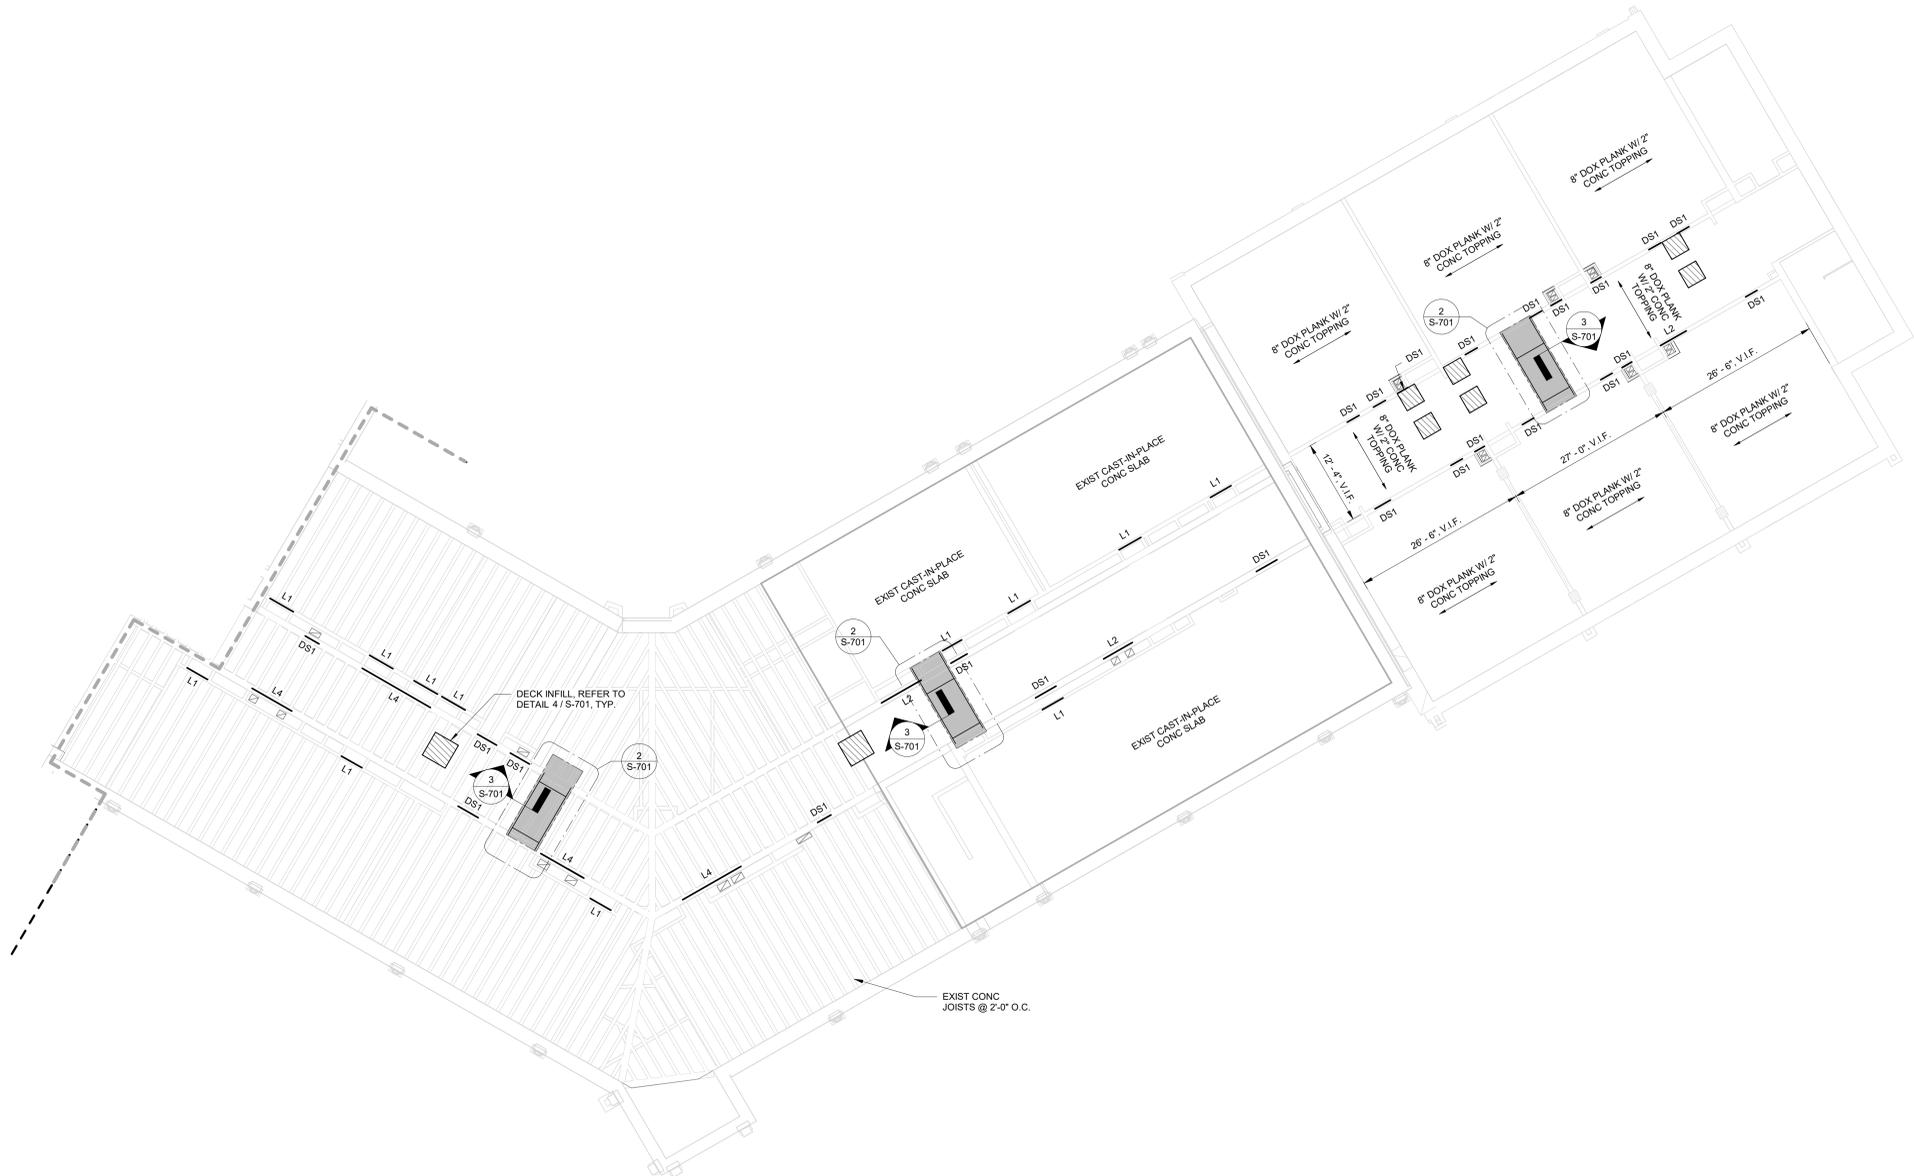

1 ROOF FRAMING PLAN - AREA C
3/32" = 1'-0"

NOTE: LINTELS AND WALL PENETRATIONS SHOWN ARE AT 2ND FLOOR.

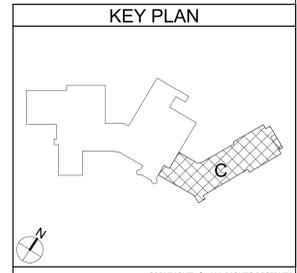

CITY SCHOOL DISTRICT OF NEW ROCHELLE
ISAAC E YOUNG MIDDLE SCHOOL
2023 CAPITAL PROJECTS - PHASE 2B

Project Title




NO.	DATE	DESCRIPTION
1	06/13/25	BID ADDENDUM 1

Drawn By: SD
Checked By: KJ
Proj. #: 66-11-00-01-0-003-018
CSArch Proj. #: 188-2301.02
Issued for Bid: 06/13/2025

Sheet Title
ROOF FRAMING PLAN - AREA C

Sheet No.
IEYMS
S-106


[Handwritten Signature]

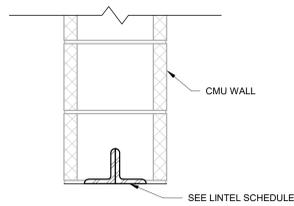


- NOTES:
1. PROVIDE 1 ANGLE FOR EACH 4" OF MASONRY WIDTH.
 2. BEAR LINTELS 6" MINIMUM EACH END OF OPENING.
 3. PROVIDE SOLID MASONRY AT LINTEL BEARING.
 4. WHERE LINTEL BEARING INTERFERES WITH CONTROL JOINT PLACEMENT, PROVIDE FLEXIBLE CAULK JOINT AT THIS LOCATION.
 5. ALL EXTERIOR EXPOSED LINTELS ARE TO BE HOT-DIP GALVANIZED.
 6. SEE ARCH AND MECH DRAWINGS FOR SIZE AND LOCATION OF OPENINGS.
 7. CONSULT THE ENGINEER TO CONFIRM LINTEL REQUIREMENTS WHEN THE LINTEL SIZE IS NOT SHOWN ON PLAN AND ONE OF THE FOLLOWING OCCURS:
 - A. WHEN LINTEL OPENING OCCURS IN BEARING WALLS.
 - B. THE HEIGHT OF CMU ABOVE LINTEL IS LESS THAN THE OPENING WIDTH.
 - C. A CONTROL JOINT IS LOCATED DIRECTLY ABOVE OR WITHIN 16" OF THE JAMB OPENING.
 8. PLANS DO NOT SHOW THE FULL SCOPE OF STEEL LINTELS REQUIRED FOR NEW WALL OPENINGS FOR DOORS, WINDOWS, DUCTS, LOUVERS, ETC. FOR MASONRY OPENING SIZE, SEE ARCH AND MECH DRAWINGS. THE CONTRACTOR IS RESPONSIBLE FOR DESIGNING, PROVIDING, AND INSTALLING ALL TEMPORARY SHORING THAT IS REQUIRED TO SUPPORT EXISTING STRUCTURE DURING CONSTRUCTION DUE TO THE REMOVALS FOR INSTALLATION OF NEW CONSTRUCTION IN ACCORDANCE WITH GENERAL NOTES ON SHEET S-001.

MASONRY OPENING	ANGLE SIZE	LABEL
UP TO 4'-0"	L3 1/2" x 3 1/2" x 1/4"	L1
OVER 4'-0" TO 6'-0"	L4" x 3 1/2" x 1/4" LLV	L2
OVER 4'-0" TO 8'-0"	WBx24	L3
OVER 8'-0"	WBx31	L4


1 LOOSE LINTEL SCHEDULE
N.T.S.

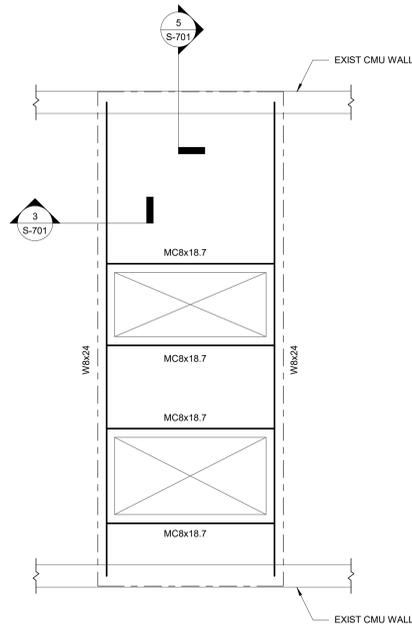

2 DOAS SUPPORT FRAMING PLAN
1/2" = 1'-0"

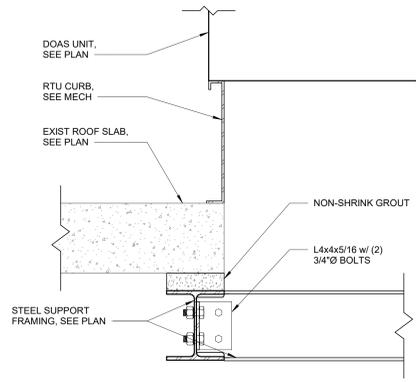


3 DOAS SUPPORT CONNECTION DETAIL
1 1/2" = 1'-0"

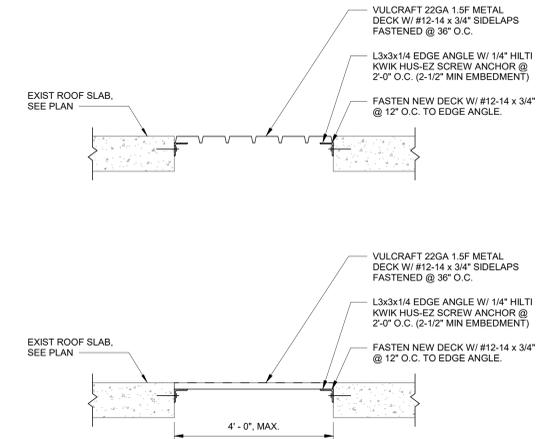


4 TYPICAL METAL ROOF INFILL DETAIL
N.T.S.

NOTE:
CUT ONE BEARING WALL TO ALLOW BEAM PASS-THROUGH FOR INSTALLATION. RECONSTRUCT CMU WALL WITH (2) #5 VERT BARS GROUTED SOLID INTO EXIST AND NEW CMU.

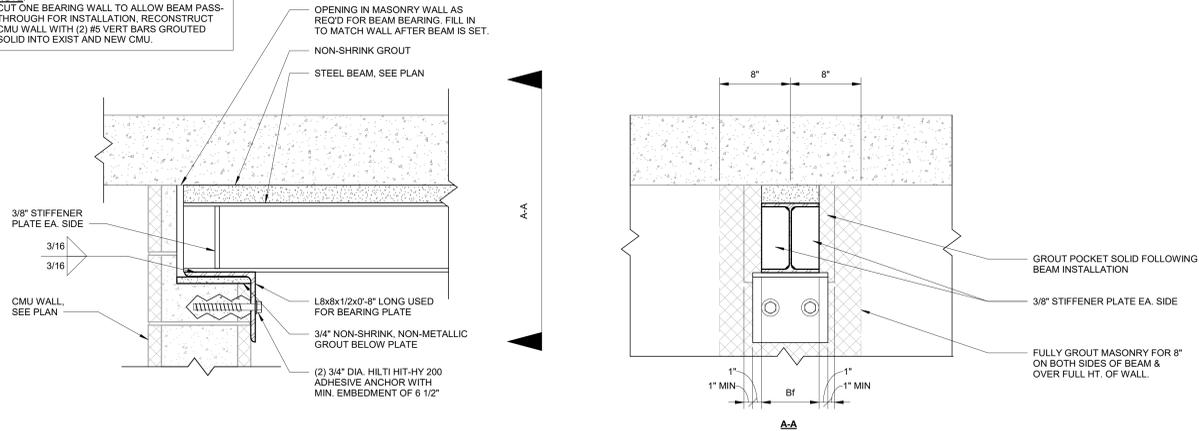

5 DOAS BEARING ON CMU
1 1/2" = 1'-0"

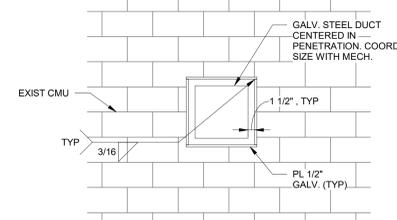

6 DUCT SLEEVE DETAIL (DS1)
3/4" = 1'-0"



CITY SCHOOL DISTRICT OF NEW ROCHELLE
ISAAC E YOUNG MIDDLE SCHOOL
2023 CAPITAL PROJECTS - PHASE 2B

Project Title




NO.	DATE	DESCRIPTION
1	06/13/23	BID ADDENDUM 1

Drawn By: SD
Checked By: JY
Proj. #: 66-11-00-01-0-003-018
CSArch Proj. #: 188-2301.02
Issued for Bid: 06/13/2023

Sheet Title
TYPICAL DETAILS

Sheet No.
IEYMS
S-701

[Handwritten Signature]

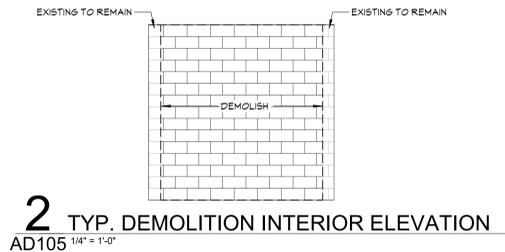

1 AREA 'B' GROUND DEMOLITION PLAN -
AD105 3/32" = 1'-0"


GENERAL NOTES

- COORDINATE ALL REMOVALS WITH NEW CONSTRUCTION.
- PATCH AND REPLACE EXISTING AND NEWLY CREATED HOLES IN WALLS (DUE TO REMOVAL) WITH MATERIALS TO MATCH EXISTING CONSTRUCTION.
- SALVAGED ITEMS SHALL BE TURNED OVER TO OWNER UNO
- ALL KEYED REMOVALS SHALL INCLUDE REMOVAL OF ANY AND ALL ANCHORS, SYSTEMS INCLUDING OBJECTS EMBEDDED INTO EXISTING WALLS.
- REFER TO MEP DRAWINGS FOR ADDITIONAL REMOVAL INFORMATION.
- REMOVE PORTION OF MASONRY WALL AS REQUIRED TO ALLOW FOR NEW DUCTWORK. COORDINATE WITH 'M' DRAWINGS.
- DRILL CORNERS OF ALL NEW SAWCUT OPENING PRIOR TO SAWCUTTING, TO PREVENT CUTTING INTO SCHEDULED CONSTRUCTION TO REMAIN.

KEYNOTES

#	DESCRIPTION
W.10	REMOVE PORTION OF MASONRY WALL CONSTRUCTION AS REQUIRED TO ALLOW FOR NEW DUCTWORK. COORDINATE WITH 'M' DRAWINGS.

KEY PLAN

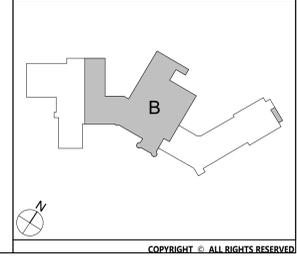

19 Front St., Newburgh - New York 12550-7601
847-581-1319 www.csarch.com



**CITY SCHOOL DISTRICT OF NEW ROCHELLE
ISAAC E YOUNG MIDDLE SCHOOL
2023 CAPITAL PROJECT - PHASE 2B**

Project Title



NO.	DATE	DESCRIPTION

Drawn By: MS
Checked By: MZ
Proj. #: 66-11-00-01-0-003-018
CSArch Proj. #: 188-2301.02
Issued for Bid: 06/13/2025

Sheet Title
**AREA 'B' -
PARTIAL
GROUND
FLOOR DEMO
PLAN**

Sheet No.
**IEYMS
AD105**
CONSTRUCTION DOCUMENTS


C:\Users\collin\Documents\188-2011_ISAAC_E_YOUNG_MS_rmlm\XW\ARE.vr



- GENERAL NOTES**
- COORDINATE ALL REMOVALS WITH NEW CONSTRUCTION.
 - PATCH AND REPLACE EXISTING AND NEWLY CREATED HOLES IN WALLS (DUE TO REMOVAL) WITH MATERIALS TO MATCH EXISTING CONSTRUCTION.
 - SALVAGED ITEMS SHALL BE TURNED OVER TO OWNER, UNO
 - ALL KEYED REMOVALS SHALL INCLUDE REMOVAL OF ANY AND ALL ANCHORING SYSTEMS INCLUDING OBJECTS EMBEDDED INTO EXISTING WALLS.
 - REFER TO MEP DRAWINGS FOR ADDITIONAL REMOVAL INFORMATION.
 - REMOVE PORTION OF MASONRY WALL AS REQUIRED TO ALLOW FOR NEW DUCTWORK. COORDINATE WITH 'M' DRAWINGS.
 - DRILL CORNERS OF ALL NEW SAWCUT OPENING PRIOR TO SAWCUTTING, TO PREVENT CUTTING INTO SCHEDULED CONSTRUCTION TO REMAIN.

KEYNOTES

#	DESCRIPTION
W.10	REMOVE PORTION OF MASONRY WALL CONSTRUCTION AS REQUIRED TO ALLOW FOR NEW DUCTWORK. COORDINATE WITH 'M' DRAWINGS.

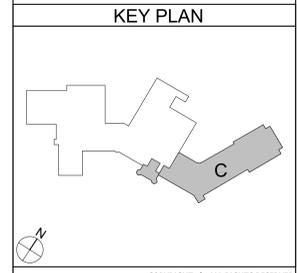


1 AREA 'C' GROUND DEMOLITION PLAN
AD106 3/32" = 1'-0"

19 Front St., Newburgh - New York 12550-7601
847-561-1319 www.csarch.com



Consultant

**CITY SCHOOL DISTRICT OF NEW ROCHELLE
ISAAC E YOUNG MIDDLE SCHOOL
2023 CAPITAL PROJECT - PHASE 2B**

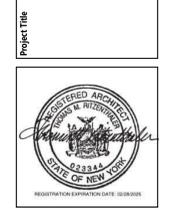


NO.	DATE	DESCRIPTION

Drawn By: MS
Checked By: MZ
Proj. #: 66-11-00-01-0-003-018
CSArch Proj. #: 188-2301.02
Issued for Bid: 06/13/2025

Sheet Title
**AREA 'C' -
PARTIAL
GROUND
FLOOR DEMO
PLAN**

Sheet No.
**IEYMS
AD106**

CONSTRUCTION DOCUMENTS

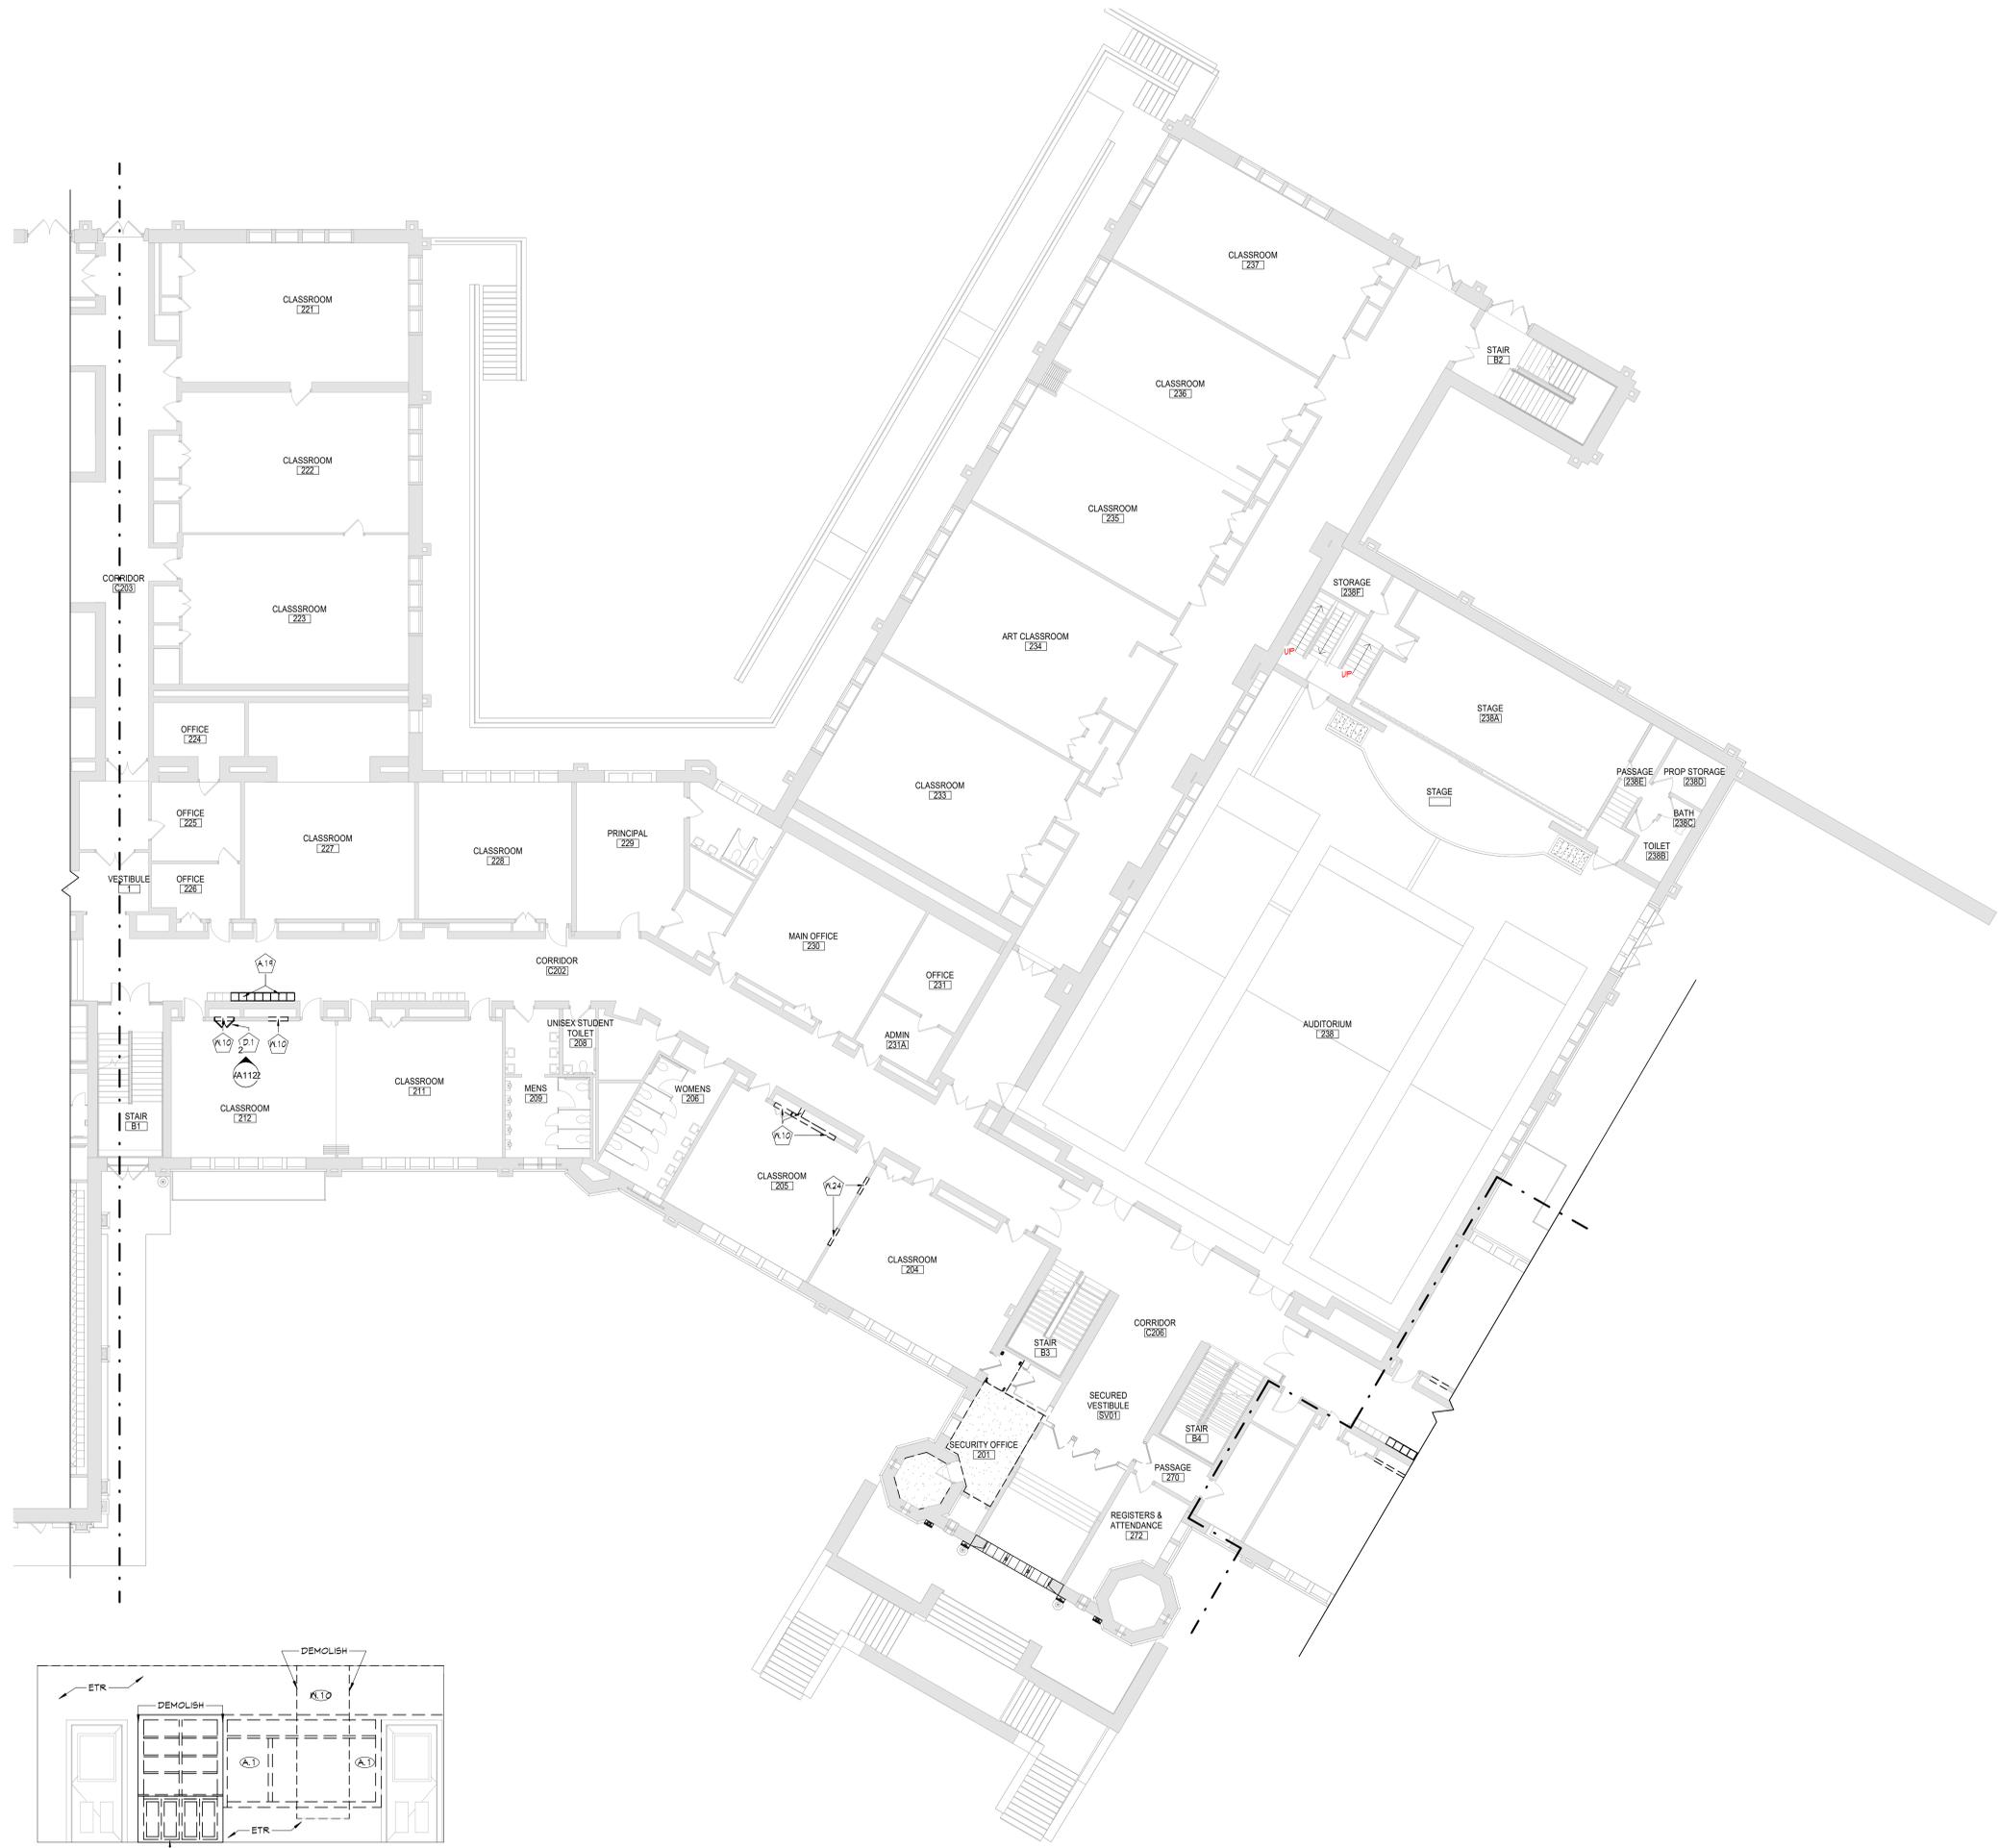

- GENERAL NOTES**
- COORDINATE ALL REMOVALS WITH NEW CONSTRUCTION.
 - PATCH AND REPLACE EXISTING AND NEWLY CREATED HOLES IN WALLS (DUE TO REMOVAL) WITH MATERIALS TO MATCH EXISTING CONSTRUCTION.
 - SALVAGED ITEMS SHALL BE TURNED OVER TO OWNER UNO
 - ALL KEYED REMOVALS SHALL INCLUDE REMOVAL OF ANY AND ALL ANCHORING SYSTEMS INCLUDING OBJECTS EMBEDDED INTO EXISTING WALLS.
 - REFER TO MEP DRAWINGS FOR ADDITIONAL REMOVAL INFORMATION.
 - REMOVE ALL CASEWORK AS NECESSARY. PATCH AREAS OF WALL REMOVAL AND NEW WALL PENETRATIONS. DRILL CORNERS OF ALL NEW SAWCUT OPENING PRIOR TO SAWCUTTING, TO PREVENT CUTTING INTO SCHEDULED CONSTRUCTION TO REMAIN.

KEYNOTES


#	DESCRIPTION
A.1	REMOVE WALL MOUNTED EQUIPMENT, INCLUDING BUT NOT LIMITED TO ALL WHITEBOARDS, CHALKBOARDS, TACKBOARDS, MAILBOXES, PROJECTION SCREENS, AND MAP ROLLS. PATCH REMOVAL CONSTRUCTION AREAS AS REQUIRED TO MATCH EXISTING ADJACENT FINISHES.
A.2	REMOVE CASEWORK IN ITS ENTIRETY, INCLUDING ALL BLOCKING, FASTENERS, AND BASE. REFER TO ELECTRICAL AND PLUMBING DRAWINGS FOR ADDITIONAL REMOVALS.
A.19	REMOVE AND SALVAGE EXISTING LOCKERS TO BE REINSTALLED.
D.1	REMOVE DOOR, HARDWARE, AND FRAME IN ITS ENTIRETY.
W.10	REMOVE PORTION OF MASONRY WALL CONSTRUCTION AS REQUIRED TO ALLOW FOR NEW DUCTWORK. COORDINATE WITH 'M' DRAWINGS.
W.24	REMOVE PORTION OF PARTITION CONSTRUCTION AS REQUIRED TO ALLOW FOR NEW DUCTWORK. COORDINATE WITH 'M' DRAWINGS.

KEY PLAN

AREA 'B' - PARTIAL FIRST FLOOR DEMO PLAN

NO.	DATE	DESCRIPTION

Drawn By: *MC*
 Checked By: *MC*
 Proj. #: 66-11-00-01-0-003-018
 CSArch Proj. #: 188-2301-02
 Issued for Bid: 06/13/2025

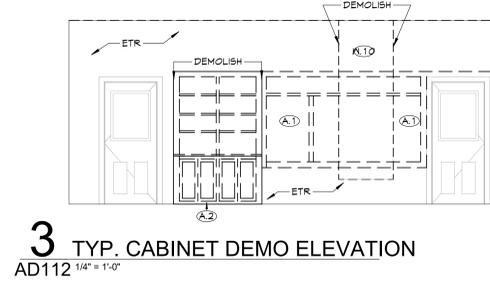

19 Front St., Newburgh, New York 12550-7601
 845-561-3179 www.csarch.com
CSARCH

Project Title
**CITY SCHOOL DISTRICT OF NEW ROCHELLE
 ISAAC E YOUNG MIDDLE SCHOOL
 2023 CAPITAL PROJECT - PHASE 2B**

Consultant
**IEYMS
 AD112**

REGISTERED ARCHITECT
 STATE OF NEW YORK
 REGISTRATION EXPIRATION DATE: 06/30/2025

SHEET NO. 188-2301-02
 DATE: 06/13/2025

CONSTRUCTION DOCUMENTS

C:\Users\collin\Documents\188-2301_ISAAC_E_YOUNG_MS_rollup\WARE.vrt

C:\Users\collin\Documents\188-2301_ISAAC_E_YOUNG_MS_rollup\XWARE.rvt




GENERAL NOTES

1. COORDINATE ALL REMOVALS WITH NEW CONSTRUCTION.
2. PATCH AND REPLACE EXISTING AND NEWLY CREATED HOLES IN WALLS (DUE TO REMOVAL) WITH MATERIALS TO MATCH EXISTING CONSTRUCTION.
3. SALVAGED ITEMS SHALL BE TURNED OVER TO OWNER UNO
4. ALL KEYED REMOVALS SHALL INCLUDE REMOVAL OF ANY AND ALL ANCHORING SYSTEMS INCLUDING OBJECTS EMBEDDED INTO EXISTING WALLS.
5. REFER TO MEP DRAWINGS FOR ADDITIONAL REMOVAL INFORMATION.
6. REMOVE PORTION OF MASONRY WALL AS REQUIRED TO ALLOW FOR NEW DUCTWORK. COORDINATE WITH 'M' DRAWINGS.
7. DRILL CORNERS OF ALL NEW SAWCUT OPENING PRIOR TO SAWCUTTING, TO PREVENT CUTTING INTO SCHEDULED CONSTRUCTION TO REMAIN.

KEYNOTES

#	DESCRIPTION
A.19	REMOVE AND SALVAGE EXISTING LOCKERS TO BE REINSTALLED.
W.10	REMOVE PORTION OF MASONRY WALL CONSTRUCTION AS REQUIRED TO ALLOW FOR NEW DUCTWORK. COORDINATE WITH 'M' DRAWINGS.
W.24	REMOVE PORTION OF PARTITION CONSTRUCTION AS REQUIRED TO ALLOW FOR NEW DUCTWORK. COORDINATE WITH 'M' DRAWINGS.

KEY PLAN

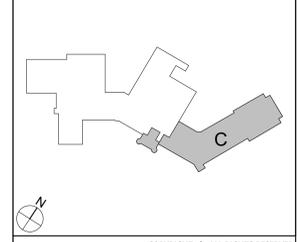

1 AREA 'C' FIRST FLOOR DEMOLITION PLAN - AD116 3/32" = 1'-0"

19 Front St., Newburgh - New York 12550-7601
845-561-1319 www.csaarch.com



Consultant

**CITY SCHOOL DISTRICT OF NEW ROCHELLE
ISAAC E YOUNG MIDDLE SCHOOL
2023 CAPITAL PROJECT - PHASE 2B**

Project Title



NO.	DATE	BY	DESCRIPTION

Drawn By: *Collin Ware* Author
Checked By: Checked
Proj. #: 66-11-00-01-0-003-018
CSArch Proj. #: 188-2301-02
Issued for Bid: 06/13/2025

Sheet Title


**AREA 'C' -
PARTIAL FIRST
FLOOR DEMO
PLAN**

Sheet No.

**IEYMS
AD116**

CONSTRUCTION DOCUMENTS


COPYRIGHT © ALL RIGHTS RESERVED

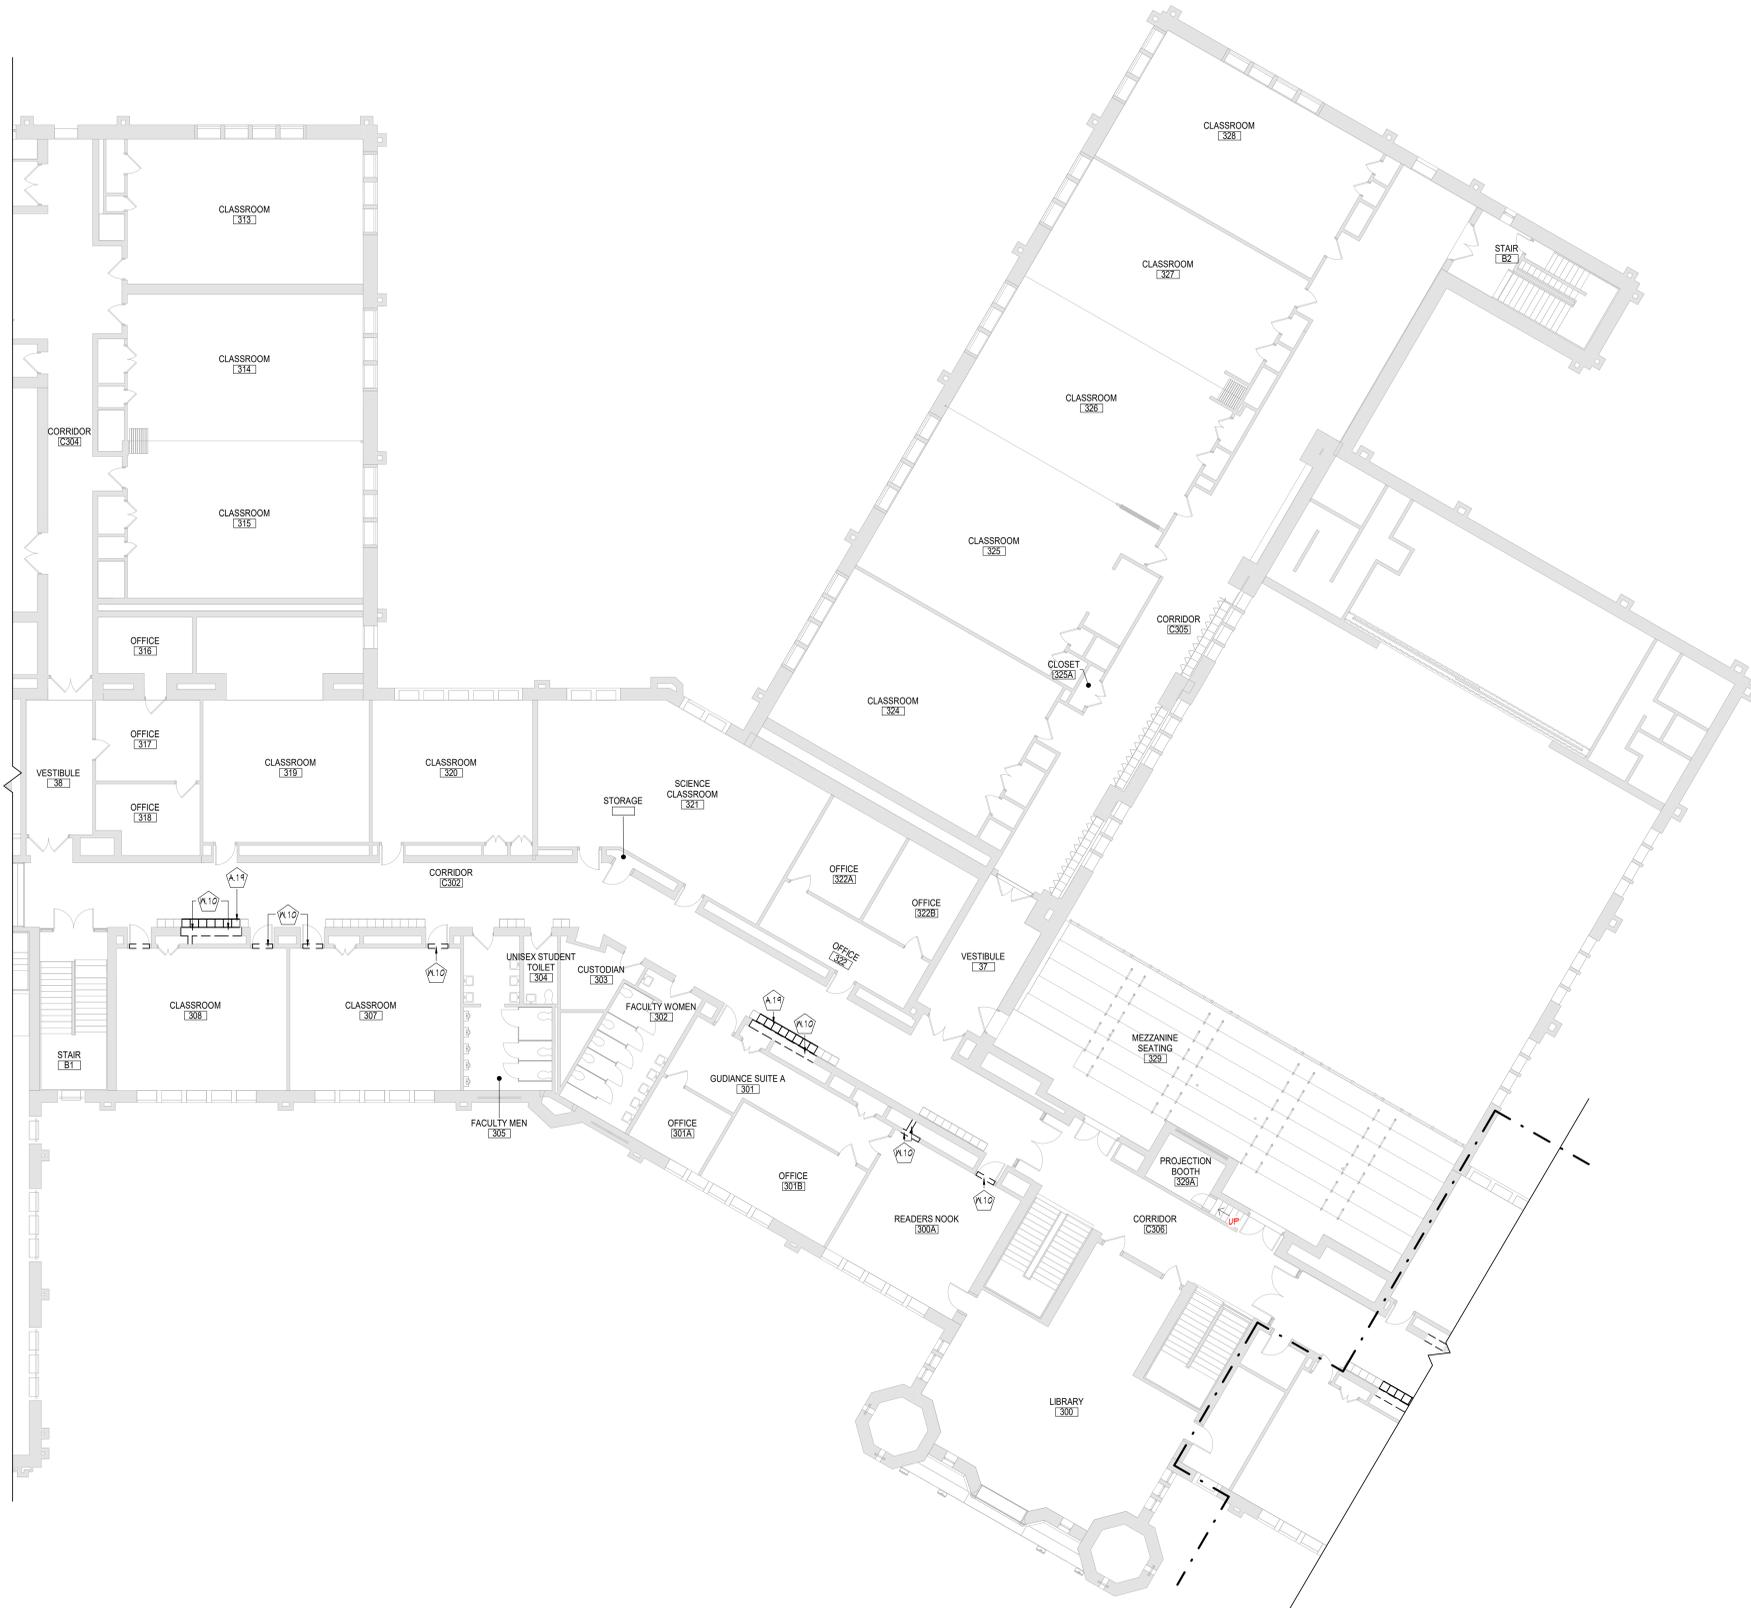

- GENERAL NOTES**
- COORDINATE ALL REMOVALS WITH NEW CONSTRUCTION.
 - PATCH AND REPLACE EXISTING AND NEWLY CREATED HOLES IN WALLS (DUE TO REMOVAL) WITH MATERIALS TO MATCH EXISTING CONSTRUCTION.
 - SALVAGED ITEMS SHALL BE TURNED OVER TO OWNER UNO
 - ALL KEYED REMOVALS SHALL INCLUDE REMOVAL OF ANY AND ALL ANCHORING SYSTEMS INCLUDING OBJECTS EMBEDDED INTO EXISTING WALLS.
 - REFER TO MEP DRAWINGS FOR ADDITIONAL REMOVAL INFORMATION.
 - REMOVE PORTION OF MASONRY WALL AS REQUIRED TO ALLOW FOR NEW DUCTWORK. COORDINATE WITH 'M' DRAWINGS.
 - DRILL CORNERS OF ALL NEW SAWCUT OPENING PRIOR TO SAWCUTTING, TO PREVENT CUTTING INTO SCHEDULED CONSTRUCTION TO REMAIN.

KEYNOTES

#	DESCRIPTION
A.19	REMOVE AND SALVAGE EXISTING LOCKERS TO BE REINSTALLED.
W.10	REMOVE PORTION OF MASONRY WALL CONSTRUCTION AS REQUIRED TO ALLOW FOR NEW DUCTWORK. COORDINATE WITH 'M' DRAWINGS.

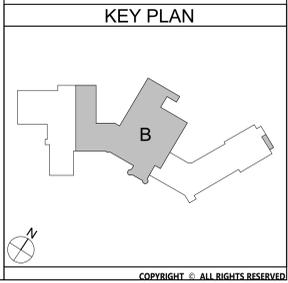

1 AREA 'B' SECOND FLOOR DEMOLITION PLAN - AD125
3/32" = 1'-0"

19 Front St., Newburgh - New York 12550-7601
847-561-1319 www.csaarch.com



Consultant

**CITY SCHOOL DISTRICT OF NEW ROCHELLE
ISAAC E YOUNG MIDDLE SCHOOL
2023 CAPITAL PROJECT - PHASE 2B**

Project Title




NO.	DATE	DESCRIPTION	BY	APP'D #1

Drawn By: *[Signature]* Auditor: *[Signature]*
 Checked By: *[Signature]* Project #: 66-11-00-01-0-003-018
 CSArch Proj. #: 188-2301.02
 Issued for Bid: 06/13/2025

Sheet Title
AREA 'B' - PARTIAL SECOND FLOOR DEMO PLAN

Sheet No.
IEYMS AD125
CONSTRUCTION DOCUMENTS

C:\Users\collin\Documents\188-2301_ISAAC_E_YOUNG_MS_rmlm\XW\ARE.vrt

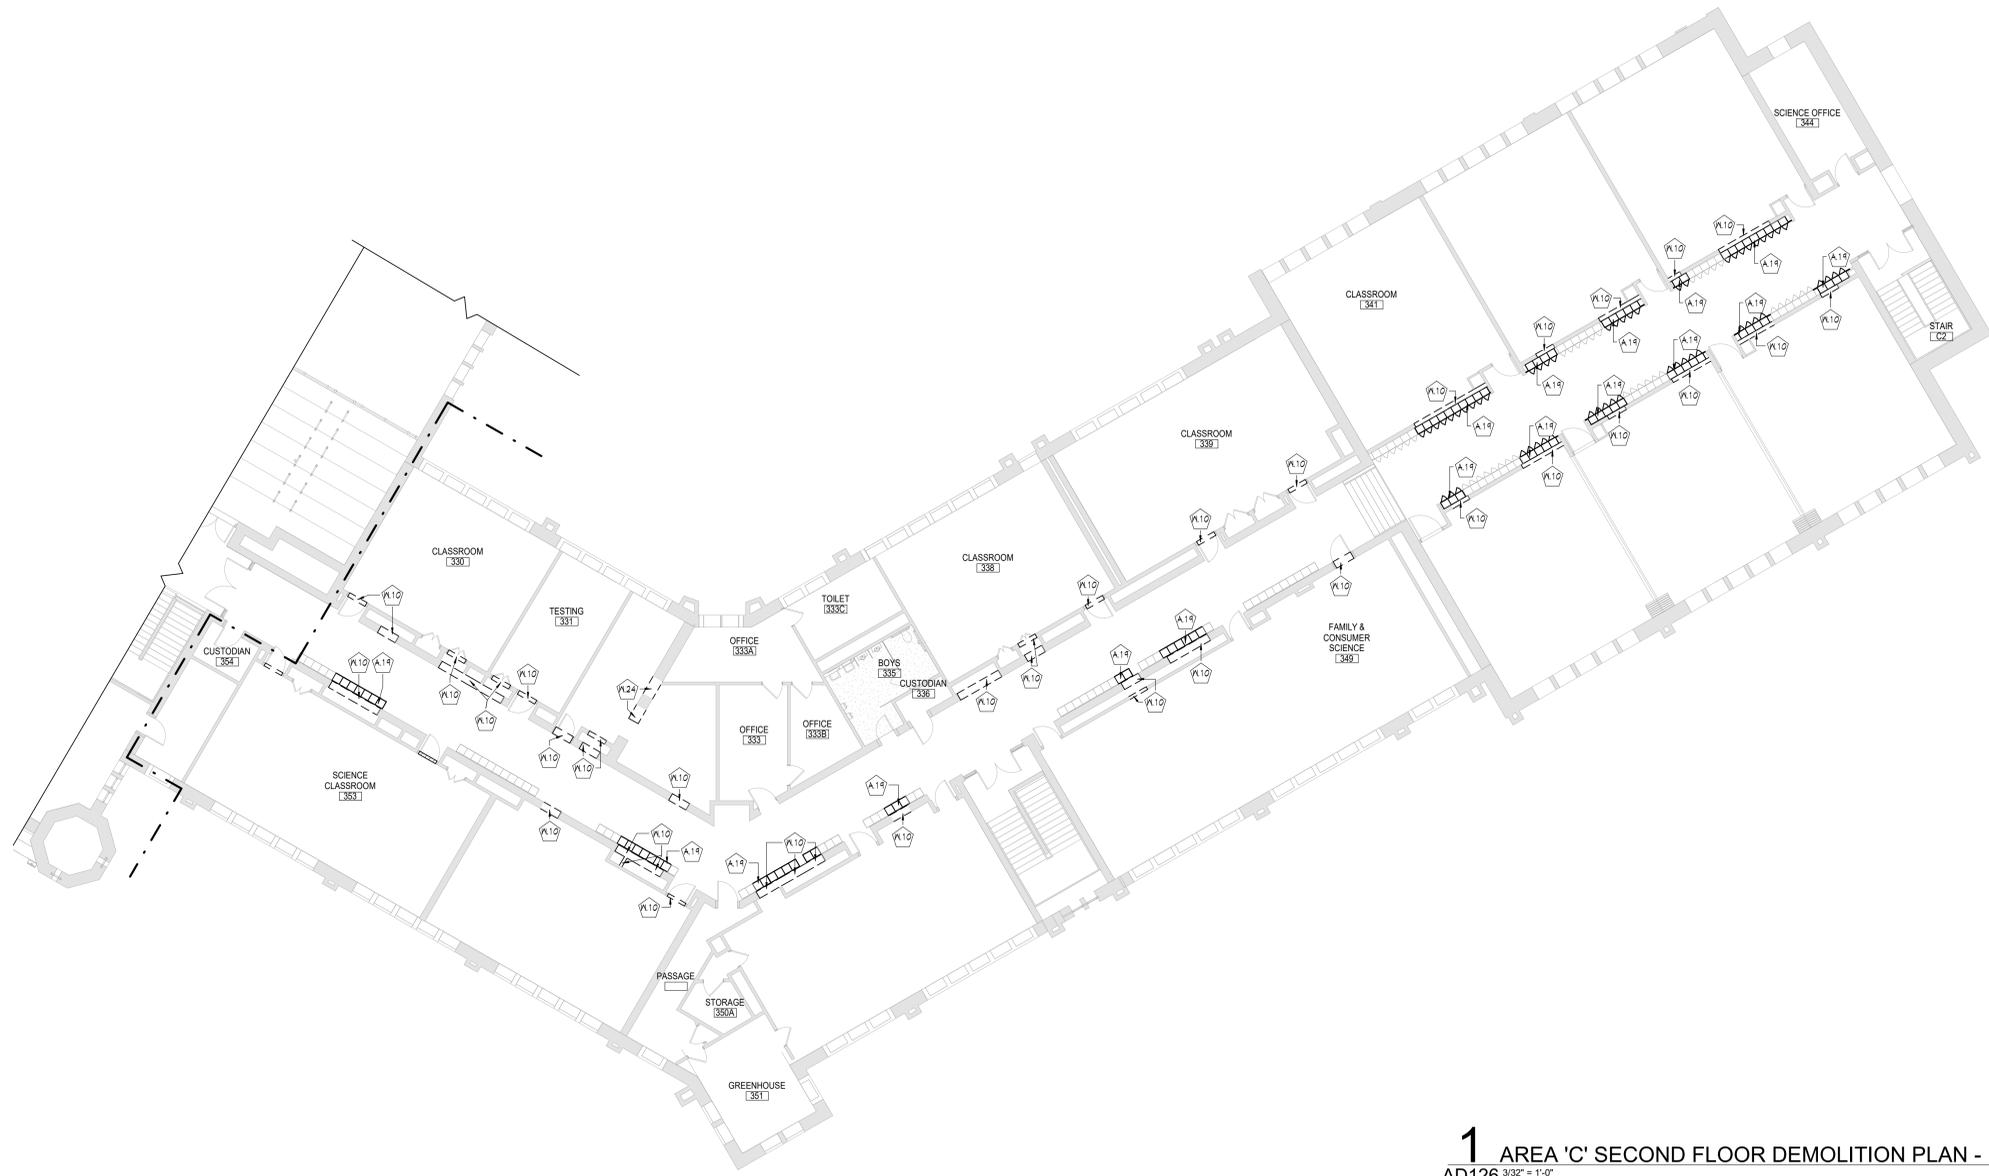

1 AREA 'C' SECOND FLOOR DEMOLITION PLAN -
AD126 3/32" = 1'-0"


GENERAL NOTES

1. COORDINATE ALL REMOVALS WITH NEW CONSTRUCTION.
2. PATCH AND REPLACE EXISTING AND NEWLY CREATED HOLES IN WALLS (DUE TO REMOVAL) WITH MATERIALS TO MATCH EXISTING CONSTRUCTION.
3. SALVAGED ITEMS SHALL BE TURNED OVER TO OWNER UNO
4. ALL KEYED REMOVALS SHALL INCLUDE REMOVAL OF ANY AND ALL ANCHORING SYSTEMS INCLUDING OBJECTS EMBEDDED INTO EXISTING WALLS.
5. REFER TO MEP DRAWINGS FOR ADDITIONAL REMOVAL INFORMATION.
6. PROVIDE PROTECTIVE BOARDING AS NECESSARY TO PROTECT AREAS OF WALL REMOVAL AND NEW WALL PENETRATIONS.
7. DRILL CORNERS OF ALL NEW SAWCUT OPENING PRIOR TO SAWCUTTING, TO PREVENT CUTTING INTO SCHEDULED CONSTRUCTION TO REMAIN.

KEYNOTES

#	DESCRIPTION
A.19	REMOVE AND SALVAGE EXISTING LOCKERS TO BE REINSTALLED.
W.10	REMOVE PORTION OF MASONRY WALL CONSTRUCTION AS REQUIRED TO ALLOW FOR NEW DUCTWORK. COORDINATE WITH 'M' DRAWINGS.
W.24	REMOVE PORTION OF PARTITION CONSTRUCTION AS REQUIRED TO ALLOW FOR NEW DUCTWORK. COORDINATE WITH 'M' DRAWINGS.

KEY PLAN

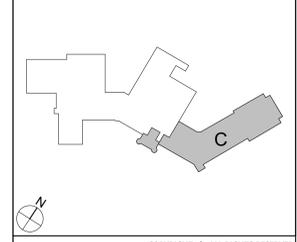

19 Front St., Newburgh - New York 12550-7601
847-561-1319 www.csarch.com



Consultant

**CITY SCHOOL DISTRICT OF NEW ROCHELLE
ISAAC E YOUNG MIDDLE SCHOOL
2023 CAPITAL PROJECT - PHASE 2B**

Project Title




NO.	DATE	DESCRIPTION	BY	APP'D #1

Drawn By: *Collin Ware* Author
Checked By: 66-11-00-01-0-003-018
Proj. #: 188-2301-02
CSArch Proj. #: 06/13/2025
Issued for Bid:


Sheet Title
**AREA 'C' -
PARTIAL
SECOND
FLOOR DEMO
PLAN**

Sheet No.
**IEYMS
AD126**
CONSTRUCTION DOCUMENTS

C:\Users\collin\Documents\188-2301_ISAAC_E_YOUNG_MS_rollup\XWARE.rvt

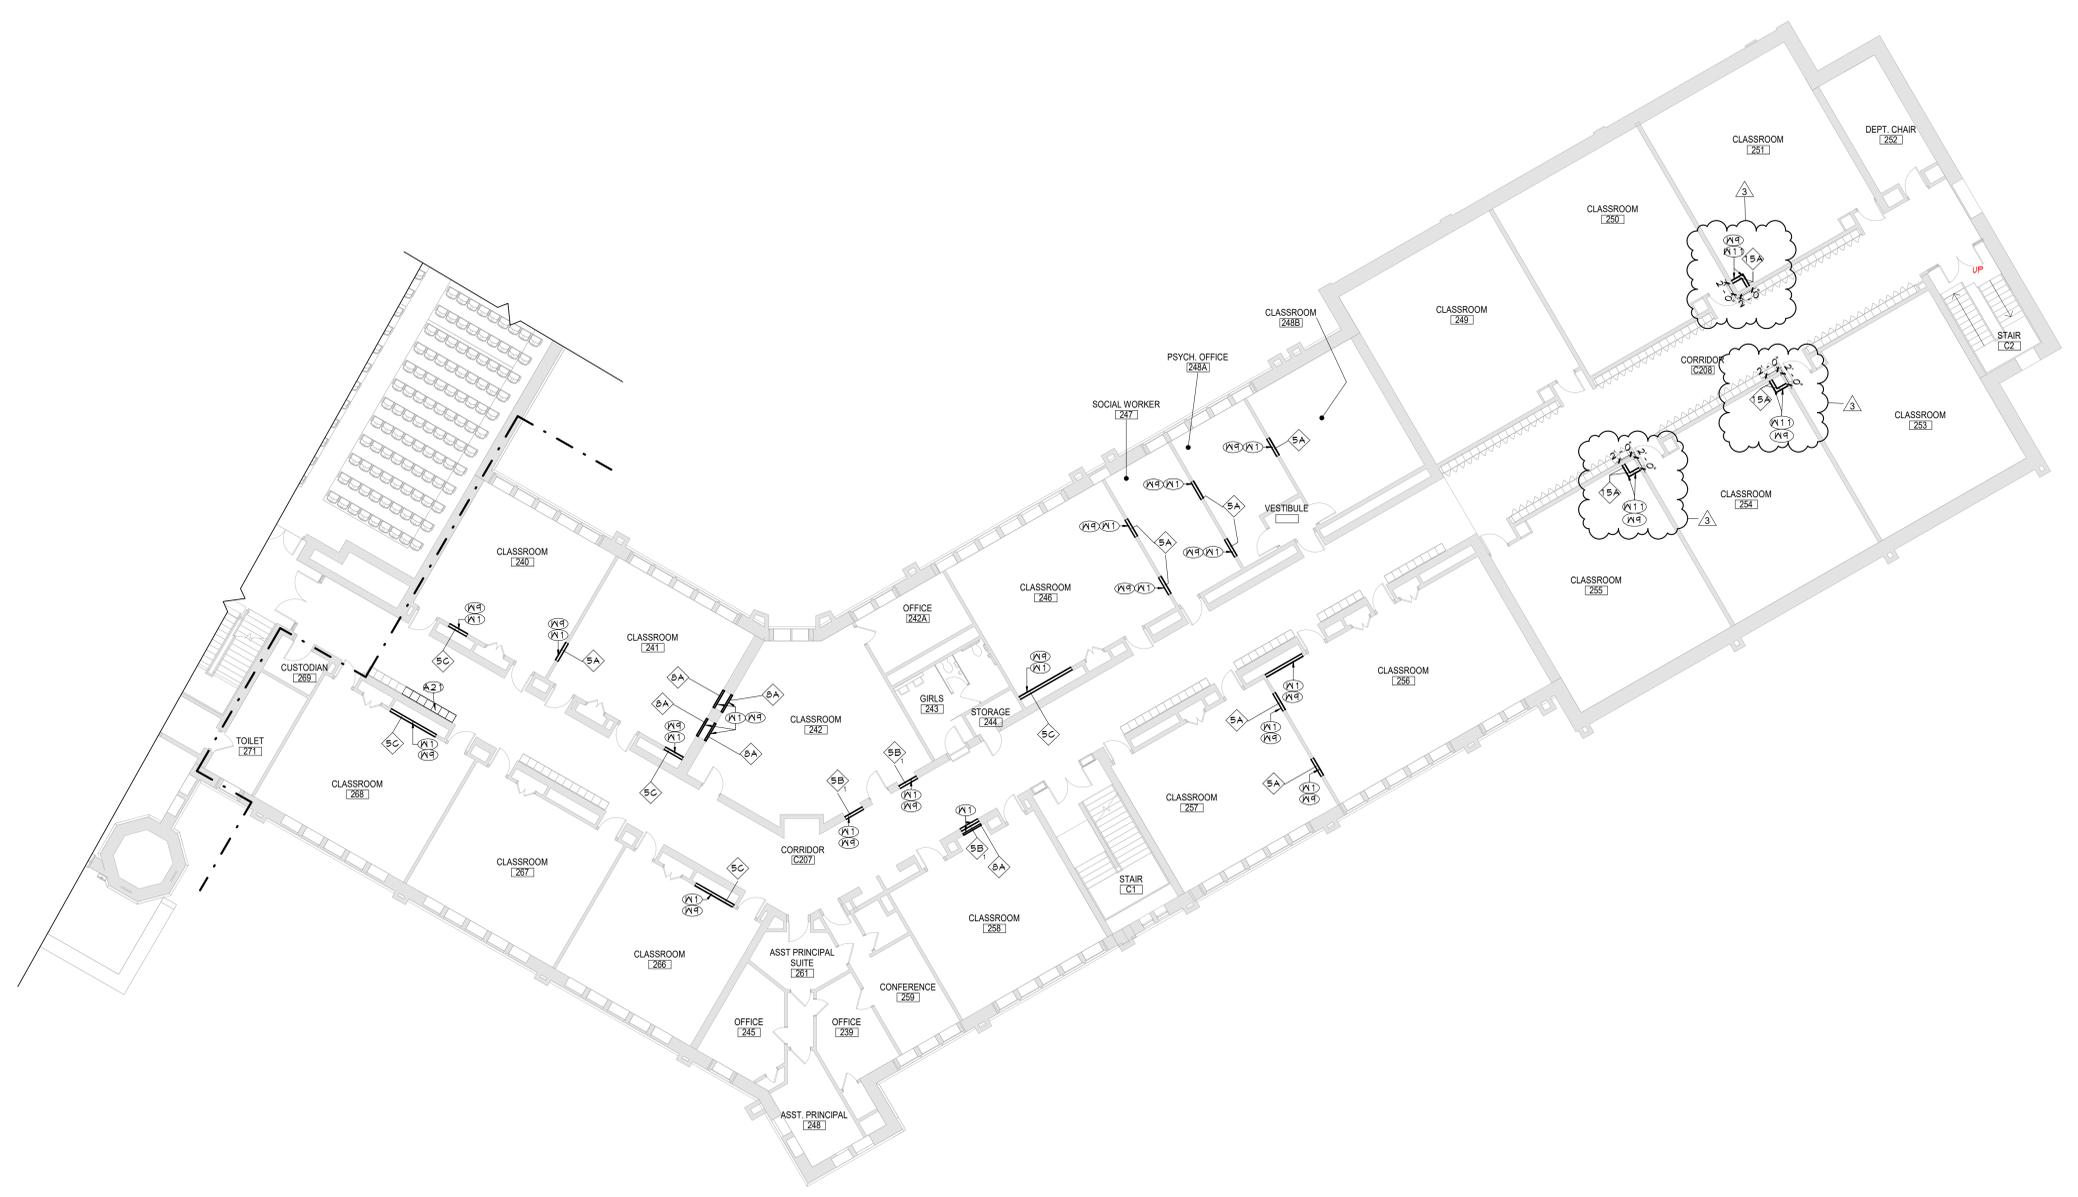

1 AREA 'C' FIRST FLOOR PLAN
A116 3/32" = 1'-0"

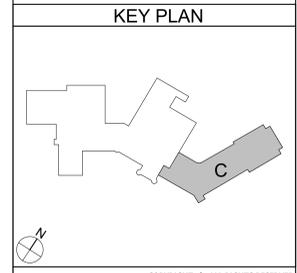

GENERAL NOTES

- REFER TO SHEET G001 FOR ADDITIONAL GENERAL NOTES.
- REFER TO SHEET G001 FOR PARTITION TYPES AND ADDITIONAL NOTES.

KEYNOTES

#	DESCRIPTION
A21	REINSTALL SALVAGED LOCKERS.
W1	INFILL WALL WITH STUD WALL TO MATCH ADJACENT WALL THICKNESS AND FINISH. REFER TO LIFE SAFETY DRAWINGS FOR MORE INFORMATION ON RATED WALLS.
W9	PREP AND PAINT WALL SURFACE IN ITS ENTIRETY.
W11	PROVIDE NEW PARTITION.

19 Front St., Newburgh - New York 12550-7601
845-561-3379 www.csarch.com

CS ARCH

Consultant

**CITY SCHOOL DISTRICT OF NEW ROCHELLE
ISAAC E YOUNG MIDDLE SCHOOL
2023 CAPITAL PROJECT - PHASE 2B**

Project Title

NO.	DATE	DESCRIPTION	BY	APP'D

Drawn By: *Collin Ware* Author: *Collin Ware*
 Checked By: *Collin Ware* Checked By: *Collin Ware*
 Proj. #: 66-11-00-01-0-003-018
 CSArch Proj. #: 188-2301.02
 Issued for Bid: 06/13/2025

Sheet Title

**AREA 'C' -
PARTIAL FIRST
FLOOR PLAN**

Sheet No.

**IEYMS
A116**

CONSTRUCTION DOCUMENTS

COPYRIGHT © ALL RIGHTS RESERVED

C:\Users\collin\Documents\188-2101_ISAAC_E_YOUNG_MS_rollup\XWARE.rvt



1 AREA 'C' SECOND FLOOR PLAN
A126 3/32" = 1'-0"


GENERAL NOTES

- REFER TO SHEET G001 FOR ADDITIONAL GENERAL NOTES.
- REFER TO SHEET G001 FOR PARTITION TYPES AND ADDITIONAL NOTES.

KEYNOTES

#	DESCRIPTION
A21	REINSTALL SALVAGED LOCKERS.
W1	INFILL WALL WITH STUD WALL TO MATCH ADJACENT WALL THICKNESS AND FINISH. REFER TO LIFE SAFETY DRAWINGS FOR MORE INFORMATION ON RATED WALLS.
W9	PREP AND PAINT WALL SURFACE IN ITS ENTIRETY.
W11	PROVIDE NEW PARTITION.

KEY PLAN

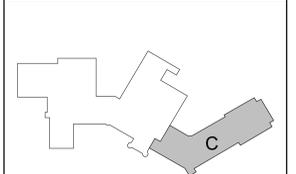

COPYRIGHT © ALL RIGHTS RESERVED

19 Front St., Newburgh - New York 12550-7601
847-561-3179 www.csaarch.com



**CITY SCHOOL DISTRICT OF NEW ROCHELLE
ISAAC E YOUNG MIDDLE SCHOOL
2023 CAPITAL PROJECT - PHASE 2B**

Project Title



NO.	DATE	DESCRIPTION

Drawn By: _____
Checked By: _____
Proj. #: 66-11-00-01-0-003-018
CSArch Proj. #: 188-2301.02
Issued for Bid: 06/13/2025

Sheet Title
**AREA 'C' -
PARTIAL
SECOND
FLOOR PLAN**

Sheet No.
**IEYMS
A126**

CONSTRUCTION DOCUMENTS



GENERAL NOTES	
1.	REFER TO SHEET G001 FOR ADDITIONAL GENERAL NOTES.
2.	REFER TO SHEET G001 FOR PARTITION TYPES AND ADDITIONAL NOTES.



CEILING NOTES	
1.	INSTALL CEILING GRIDS CENTERED IN THE ROOM, UNO. IN ROOMS OTHER THAN RECTANGULAR SHAPED, INSTALL GRIDS CENTERED ON WALLS OR OTHER BUILT FEATURES AS INDICATED.
2.	INSTALLATION HEIGHTS OF THE CEILINGS MAY VARY SLIGHTLY FROM PLANS IN ROOMS WITH EXTERIOR WINDOWS. ACTUAL CEILING HEIGHT TO BE VERIFIED IN THE FIELD.
3.	FINAL INSTALLED CEILINGS SHALL HAVE HEIGHTS COORDINATED WITH OTHER CONTRACTORS WITH ABOVE CEILING WORK AND VERIFIED WITH FIELD CONDITIONS. ALL CHANGES IN CONFIGURATION OR HEIGHTS ARE TO BE APPROVED BY THE ARCHITECT.

CEILING LEGEND	
	GWR OR PLASTER CEILING, REFER TO DETAILS AND ROOM FINISH SCHEDULE
	SUSPENDED ACOUSTICAL PANEL CEILING SYSTEM
	CEILING HEIGHT ABOVE FINISHED FLOOR

ELECTRICAL EQUIPMENT, REFER TO ELECTRICAL DRAWINGS FOR ADDITIONAL INFORMATION.	
	2'x4' LIGHT FIXTURE
	2'x2' LIGHT FIXTURE
	1'x LIGHT FIXTURE
	PENDANT LIGHT FIXTURE
	RECESSED DOWN LIGHT
	CEILING MOUNTED EXIT SIGN
	CEILING MOUNTED OCCUPANCY SENSOR
	CEILING MOUNTED SMOKE DETECTOR
	CEILING MOUNTED HEAT DETECTOR
	CEILING MOUNTED PA SPEAKER
	CEILING MOUNTED SECURITY J-BOX
	CEILING MOUNTED MOTION SENSOR
	CEILING MOUNTED DATA J-BOX

MECHANICAL EQUIPMENT, REFER TO MECHANICAL DRAWINGS FOR ADDITIONAL INFORMATION.	
	HVAC SUPPLY GRILLE
	HVAC RETURN GRILLE

KEYNOTES	
#	DESCRIPTION
CB	REINSTALL SALVAGED EXISTING SUSPENDED CEILING SYSTEM. REFER TO ELECTRICAL AND MECHANICAL DRAWINGS FOR EQUIPMENT INSTALLATIONS.

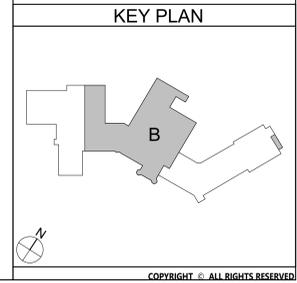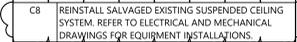

1 AREA 'B' - GROUND FLOOR REFLECTED CEILING PLAN
A802 3/32" = 1'-0"

COPYRIGHT © ALL RIGHTS RESERVED

19 Front St., Newburgh - New York 12550-7601
 847-561-1319 www.csarch.com
 CSARCH

Project Title
**CITY SCHOOL DISTRICT OF NEW ROCHELLE
 ISAAC E YOUNG MIDDLE SCHOOL
 2023 CAPITAL PROJECT - PHASE 2B**

NO.	DATE	DESCRIPTION

Drawn By:	Author
Checked By:	66-11-00-01-0-003-018
Proj. #:	188-2301-02
CSArch Proj. #:	06/13/2025
Issued for Bid:	

Sheet Title

AREA 'B' - PARTIAL GROUND FLOOR RCP

Sheet No.

**IEYMS
A802**

CONSTRUCTION DOCUMENTS



NO.	DATE	DESCRIPTION

Drawn By: *Autish*
Checked By: *66-11-00-01-0-003-018*
CSArch Proj. #: 188-2301-02
Issued for Bid: 06/13/2025

Sheet Title
AREA 'C' -
PARTIAL
GROUND
FLOOR RCP

Sheet No.
**IEYMS
A803**
CONSTRUCTION DOCUMENTS

GENERAL NOTES

- REFER TO SHEET G001 FOR ADDITIONAL GENERAL NOTES.
- REFER TO SHEET G001 FOR PARTITION TYPES AND ADDITIONAL NOTES.

CEILING NOTES

- INSTALL CEILING GRIDS CENTERED IN THE ROOM, UNLESS IN ROOMS OTHER THAN RECTANGULAR SHAPED, INSTALL GRIDS CENTERED ON WALLS OR OTHER BUILT FEATURES AS INDICATED.
- INSTALLATION HEIGHTS OF THE CEILINGS MAY VARY SLIGHTLY FROM PLANS IN ROOMS WITH EXTERIOR WINDOWS. ACTUAL CEILING HEIGHT TO BE VERIFIED IN THE FIELD.
- FINAL INSTALLED CEILINGS SHALL HAVE HEIGHTS COORDINATED WITH OTHER CONTRACTORS WITH ABOVE CEILING WORK AND VERIFIED WITH FIELD CONDITIONS. ALL CHANGES IN CONFIGURATION OR HEIGHTS ARE TO BE APPROVED BY THE ARCHITECT.

CEILING LEGEND

- QWR OR PLASTER CEILING, REFER TO DETAILS AND ROOM FINISH SCHEDULE
- SUSPENDED ACOUSTICAL PANEL CEILING SYSTEM
- CEILING HEIGHT ABOVE FINISHED FLOOR

ELECTRICAL EQUIPMENT, REFER TO ELECTRICAL DRAWINGS FOR ADDITIONAL INFORMATION.

- 2'x4' LIGHT FIXTURE
- 2'x2' LIGHT FIXTURE
- 1'x LIGHT FIXTURE
- PENDANT LIGHT FIXTURE
- RECESSED DOWN LIGHT
- CEILING MOUNTED EXIT SIGN
- CEILING MOUNTED OCCUPANCY SENSOR
- CEILING MOUNTED SMOKE DETECTOR
- CEILING MOUNTED HEAT DETECTOR
- CEILING MOUNTED PA SPEAKER
- CEILING MOUNTED SECURITY J-BOX
- CEILING MOUNTED MOTION SENSOR
- CEILING MOUNTED DATA J-BOX

MECHANICAL EQUIPMENT, REFER TO MECHANICAL DRAWINGS FOR ADDITIONAL INFORMATION.

- HVAC SUPPLY GRILLE
- HVAC RETURN GRILLE


KEYNOTES

#	DESCRIPTION
CB	REINSTALL SALVAGED EXISTING SUSPENDED CEILING SYSTEM. REFER TO ELECTRICAL AND MECHANICAL DRAWINGS FOR EQUIPMENT INSTALLATIONS.



1 AREA 'C' - GROUND FLOOR REFLECTED CEILING PLAN
A803 3/32" = 1'-0"

KEY PLAN

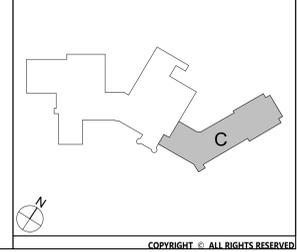



1 AREA 'B' - FIRST FLOOR REFLECTED CEILING PLAN
A812 3/32" = 1'-0"

GENERAL NOTES

1. REFER TO SHEET G001 FOR ADDITIONAL GENERAL NOTES.
2. REFER TO SHEET G001 FOR PARTITION TYPES AND ADDITIONAL NOTES.

CEILING NOTES

1. INSTALL CEILING GRIDS CENTERED IN THE ROOM, UNLESS IN ROOMS OTHER THAN RECTANGULAR SHAPED, INSTALL GRIDS CENTERED ON WALLS OR OTHER BUILT FEATURES AS INDICATED.
2. INSTALLATION HEIGHTS OF THE CEILINGS MAY VARY SLIGHTLY FROM PLANS IN ROOMS WITH EXTERIOR WINDOWS. ACTUAL CEILING HEIGHT TO BE VERIFIED IN THE FIELD.
3. FINAL INSTALLED CEILINGS SHALL HAVE HEIGHTS COORDINATED WITH OTHER CONTRACTORS WITH ABOVE CEILING WORK AND VERIFIED WITH FIELD CONDITIONS. ALL CHANGES IN CONFIGURATION OR HEIGHTS ARE TO BE APPROVED BY THE ARCHITECT.

CEILING LEGEND

- QWR OR PLASTER CEILING. REFER TO DETAILS AND ROOM FINISH SCHEDULE
- SUSPENDED ACOUSTICAL PANEL CEILING SYSTEM
- CEILING HEIGHT ABOVE FINISHED FLOOR

ELECTRICAL EQUIPMENT. REFER TO ELECTRICAL DRAWINGS FOR ADDITIONAL INFORMATION.

- 2'x4' LIGHT FIXTURE
- 2'x2' LIGHT FIXTURE
- 1'x1' LIGHT FIXTURE
- PENDANT LIGHT FIXTURE
- RECESSED DOWN LIGHT
- CEILING MOUNTED EXIT SIGN
- CEILING MOUNTED OCCUPANCY SENSOR
- CEILING MOUNTED SMOKE DETECTOR
- CEILING MOUNTED HEAT DETECTOR
- CEILING MOUNTED PA SPEAKER
- CEILING MOUNTED SECURITY J-BOX
- CEILING MOUNTED MOTION SENSOR
- CEILING MOUNTED DATA J-BOX


MECHANICAL EQUIPMENT. REFER TO MECHANICAL DRAWINGS FOR ADDITIONAL INFORMATION.

- HVAC SUPPLY GRILLE
- HVAC RETURN GRILLE

KEYNOTES

#	DESCRIPTION
CB	REINSTALL SALVAGED EXISTING SUSPENDED CEILING SYSTEM. REFER TO ELECTRICAL AND MECHANICAL DRAWINGS FOR EQUIPMENT INSTALLATIONS.

KEY PLAN

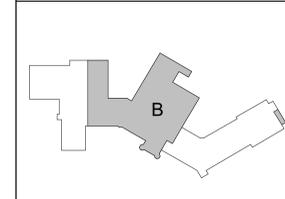

COPYRIGHT © ALL RIGHTS RESERVED



NO.	DATE	DESCRIPTION

Drawn By: [Signature]
Checked By: [Signature]
Proj. #: 66-11-00-01-0-003-018
CSArch Proj. #: 188-2301-02
Issued for Bid: 06/13/2025

AREA 'B' - PARTIAL FIRST FLOOR RCP

Sheet No.
**IEYMS
A812**

C:\Users\collin\Documents\188-2301_ISAAC_E_YOUNG_MS_rmlin\KAWARE.rvt



GENERAL NOTES

1. REFER TO SHEET G001 FOR ADDITIONAL GENERAL NOTES.
2. REFER TO SHEET G001 FOR PARTITION TYPES AND ADDITIONAL NOTES.

CEILING NOTES

1. INSTALL CEILING GRIDS CENTERED IN THE ROOM. UNO. IN ROOMS OTHER THAN RECTANGULAR SHAPED, INSTALL GRIDS CENTERED ON WALLS OR OTHER BUILT FEATURES AS INDICATED.
2. INSTALLATION HEIGHTS OF THE CEILINGS MAY VARY SLIGHTLY FROM PLANS IN ROOMS WITH EXTERIOR WINDOWS. ACTUAL CEILING HEIGHT TO BE VERIFIED IN THE FIELD.
3. FINAL INSTALLED CEILINGS SHALL HAVE HEIGHTS COORDINATED WITH OTHER CONTRACTORS WITH ABOVE CEILING WORK AND VERIFIED WITH FIELD CONDITIONS. ALL CHANGES IN CONFIGURATION OR HEIGHTS ARE TO BE APPROVED BY THE ARCHITECT.

CEILING LEGEND

- QWR OR PLASTER CEILING. REFER TO DETAILS AND ROOM FINISH SCHEDULE
- SUSPENDED ACOUSTICAL PANEL CEILING SYSTEM
- CEILING HEIGHT ABOVE FINISHED FLOOR

ELECTRICAL EQUIPMENT. REFER TO ELECTRICAL DRAWINGS FOR ADDITIONAL INFORMATION.

- 2'x4' LIGHT FIXTURE
- 2'x2' LIGHT FIXTURE
- 1'x LIGHT FIXTURE
- PENDANT LIGHT FIXTURE
- RECESSED DOWN LIGHT
- CEILING MOUNTED EXIT SIGN
- CEILING MOUNTED OCCUPANCY SENSOR
- CEILING MOUNTED SMOKE DETECTOR
- CEILING MOUNTED HEAT DETECTOR
- CEILING MOUNTED PA SPEAKER
- CEILING MOUNTED SECURITY J-BOX
- CEILING MOUNTED MOTION SENSOR
- CEILING MOUNTED DATA J-BOX


MECHANICAL EQUIPMENT. REFER TO MECHANICAL DRAWINGS FOR ADDITIONAL INFORMATION.

- HVAC SUPPLY GRILLE
- HVAC RETURN GRILLE

KEYNOTES

#	DESCRIPTION
3	REINSTALL SALVAGED EXISTING SUSPENDED CEILING SYSTEM. REFER TO ELECTRICAL AND MECHANICAL DRAWINGS FOR EQUIPMENT INSTALLATIONS.

KEY PLAN

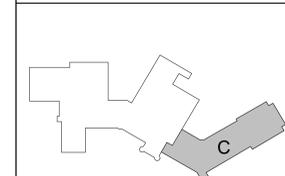

1 AREA 'C' - FIRST FLOOR REFLECTED CEILING PLAN
A813 3/32" = 1'-0"

COPYRIGHT © ALL RIGHTS RESERVED

19 Front St., Newburgh - New York 12550-7601
845-561-1319 www.csaarch.com

Consultant

**CITY SCHOOL DISTRICT OF NEW ROCHELLE
ISAAC E YOUNG MIDDLE SCHOOL
2023 CAPITAL PROJECT - PHASE 2B**

Project Title



NO.	DATE	BY	DESCRIPTION

Drawn By: *Collin Ware* Auditor: *Collin Ware*
Checked By: *Collin Ware* 66-11-00-01-0-003-018
CSArch Proj. #: 188-2301-02
Issued for Bid: 06/13/2025


Sheet Title

AREA 'C' -
PARTIAL FIRST
FLOOR RCP

Sheet No.
**IEYMS
A813**

CONSTRUCTION DOCUMENTS



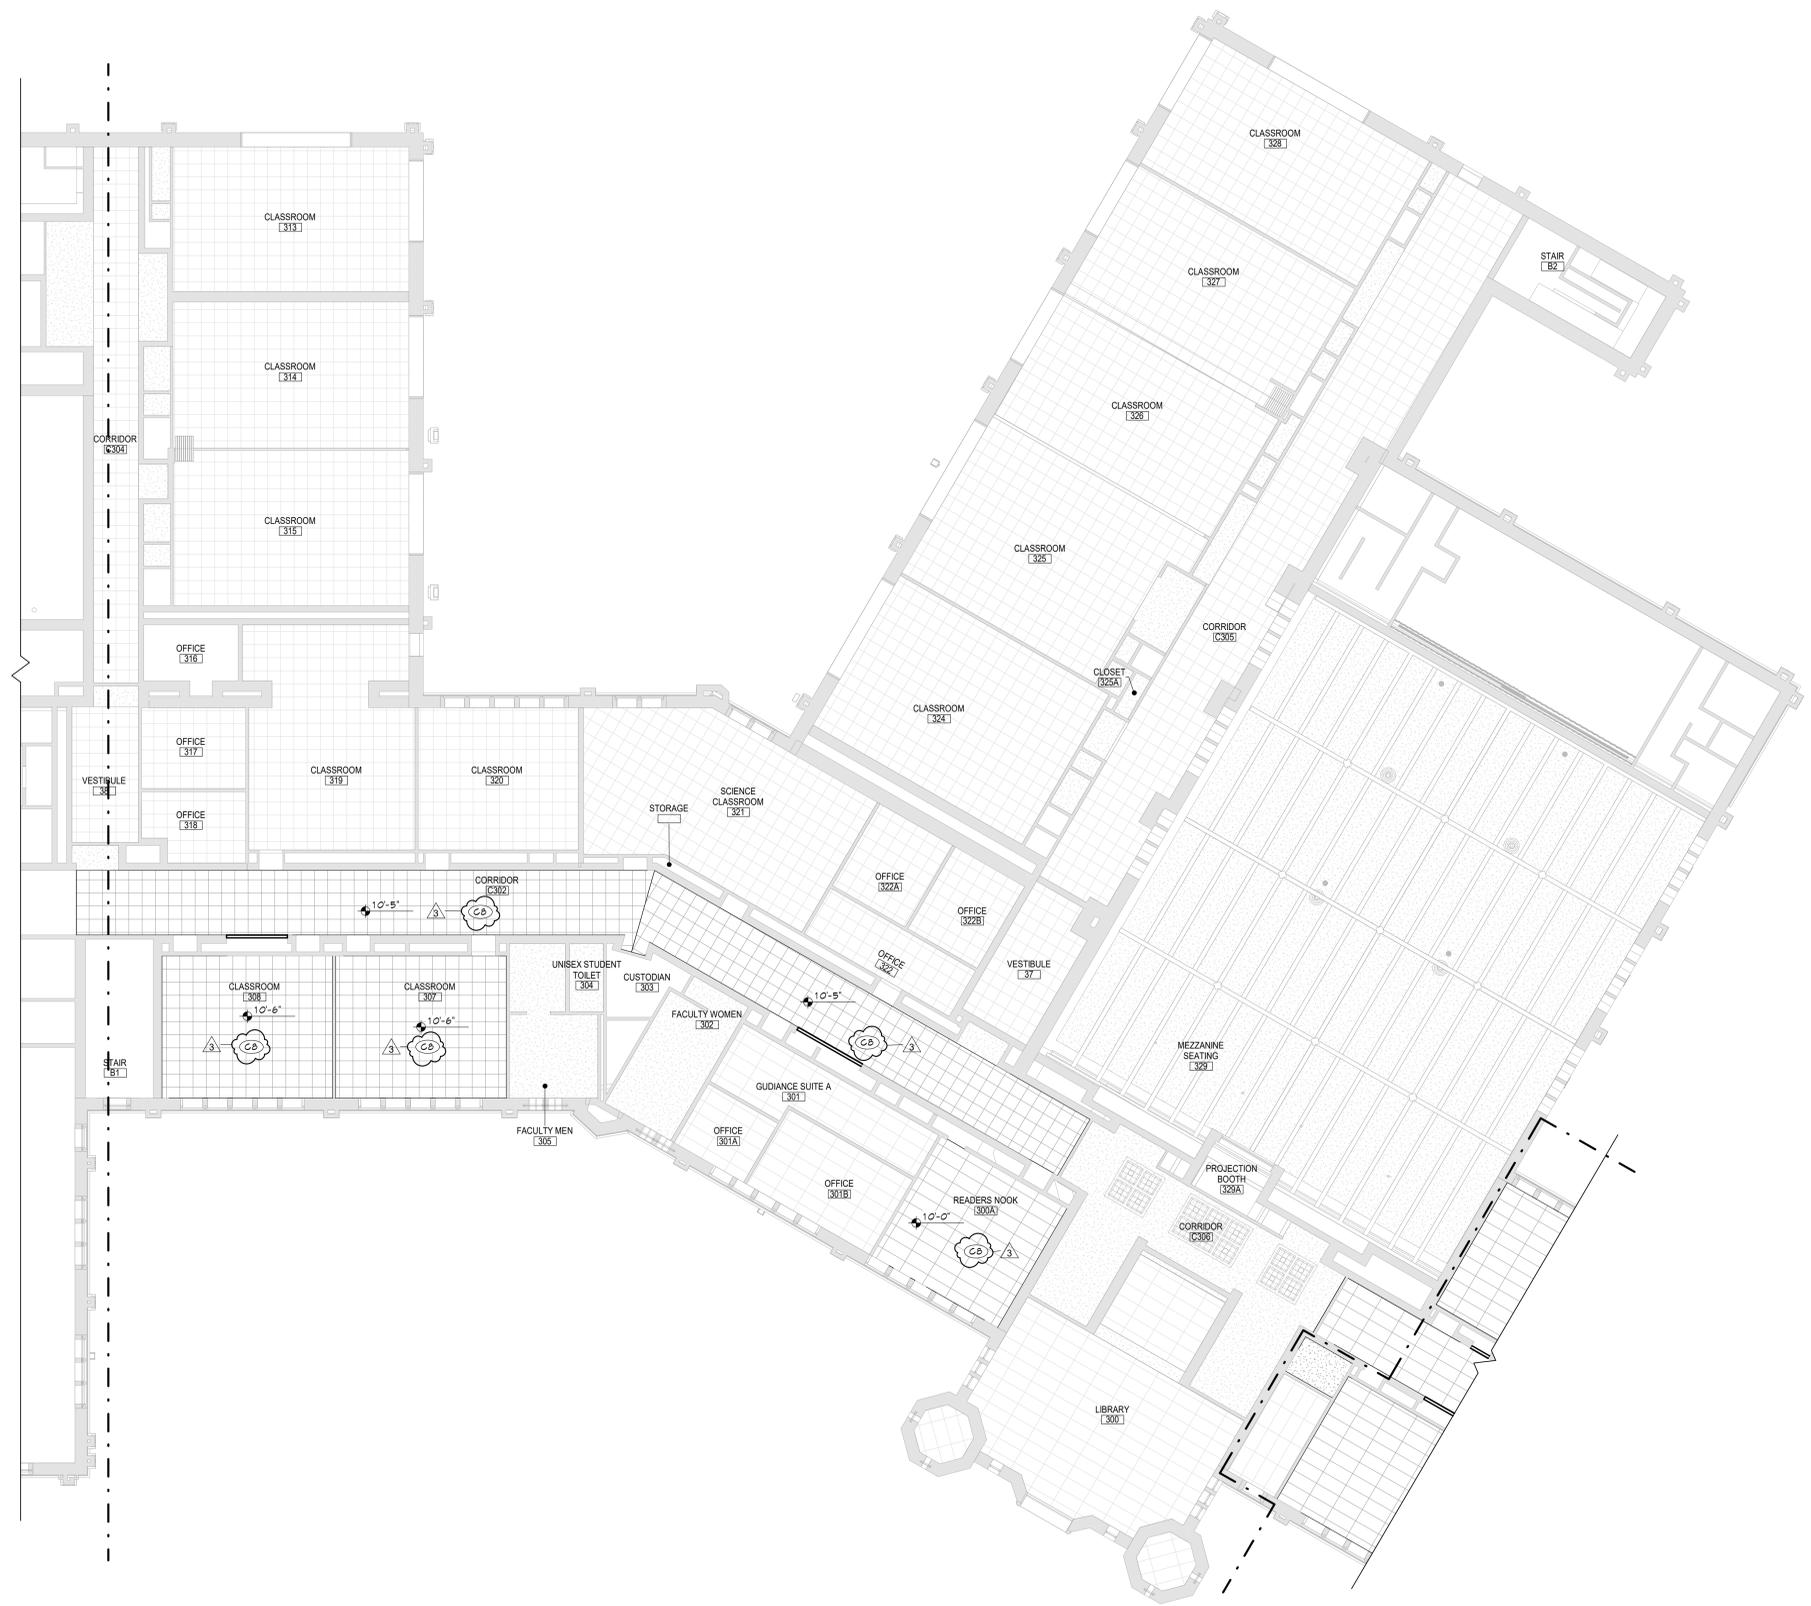

1 AREA 'B' - SECOND FLOOR REFLECTED CEILING PLAN
A822 3/32" = 1'-0"

GENERAL NOTES	
1.	REFER TO SHEET G001 FOR ADDITIONAL GENERAL NOTES.
2.	REFER TO SHEET G001 FOR PARTITION TYPES AND ADDITIONAL NOTES.

CEILING NOTES	
1.	INSTALL CEILING GRIDS CENTERED IN THE ROOM, UNLESS IN ROOMS OTHER THAN RECTANGULAR SHAPED, INSTALL GRIDS CENTERED ON WALLS OR OTHER BUILT FEATURES AS INDICATED.
2.	INSTALLATION HEIGHTS OF THE CEILINGS MAY VARY SLIGHTLY FROM PLANS IN ROOMS WITH EXTERIOR WINDOWS. ACTUAL CEILING HEIGHT TO BE VERIFIED IN THE FIELD.
3.	FINAL INSTALLED CEILINGS SHALL HAVE HEIGHTS COORDINATED WITH OTHER CONTRACTORS WITH ABOVE CEILING WORK AND VERIFIED WITH FIELD CONDITIONS. ALL CHANGES IN CONFIGURATION OR HEIGHTS ARE TO BE APPROVED BY THE ARCHITECT.


CEILING LEGEND	
	GWR OR PLASTER CEILING. REFER TO DETAILS AND ROOM FINISH SCHEDULE
	SUSPENDED ACOUSTICAL PANEL CEILING SYSTEM
	CEILING HEIGHT ABOVE FINISHED FLOOR

ELECTRICAL EQUIPMENT. REFER TO ELECTRICAL DRAWINGS FOR ADDITIONAL INFORMATION.	
	2'x4' LIGHT FIXTURE
	2'x2' LIGHT FIXTURE
	1'x1' LIGHT FIXTURE
	PENDANT LIGHT FIXTURE
	RECESSED DOWN LIGHT
	CEILING MOUNTED EXIT SIGN
	CEILING MOUNTED OCCUPANCY SENSOR
	CEILING MOUNTED SMOKE DETECTOR
	CEILING MOUNTED HEAT DETECTOR
	CEILING MOUNTED PA SPEAKER
	CEILING MOUNTED SECURITY J-BOX
	CEILING MOUNTED MOTION SENSOR
	CEILING MOUNTED DATA J-BOX

MECHANICAL EQUIPMENT. REFER TO MECHANICAL DRAWINGS FOR ADDITIONAL INFORMATION.	
	HVAC SUPPLY GRILLE
	HVAC RETURN GRILLE

KEYNOTES	
#	DESCRIPTION
CB	REINSTALL SALVAGED EXISTING SUSPENDED CEILING SYSTEM. REFER TO ELECTRICAL AND MECHANICAL DRAWINGS FOR EQUIPMENT INSTALLATIONS.

#	DESCRIPTION
CB	REINSTALL SALVAGED EXISTING SUSPENDED CEILING SYSTEM. REFER TO ELECTRICAL AND MECHANICAL DRAWINGS FOR EQUIPMENT INSTALLATIONS.

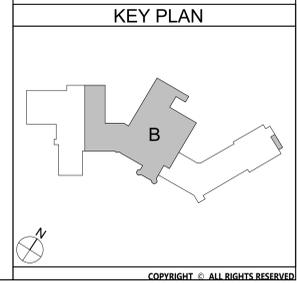

19 Front St., Newburgh - New York 12550-7601
847-561-1319 www.csarch.com

CS ARCH

Consultant

**CITY SCHOOL DISTRICT OF NEW ROCHELLE
ISAAC E YOUNG MIDDLE SCHOOL
2023 CAPITAL PROJECT - PHASE 2B**

Project Title

NO.	DATE	DESCRIPTION

Drawn By:	AutCAD
Checked By:	66-11-00-01-0-003-018
Proj. #:	188-2301.02
CSArch Proj. #:	06/13/2025
Issued for Bid:	

Sheet Title

AREA 'B' - PARTIAL SECOND FLOOR RCP

Sheet No.

**IEYMS
A822**

CONSTRUCTION DOCUMENTS

COPYRIGHT © ALL RIGHTS RESERVED



1 AREA 'C' - SECOND FLOOR REFLECTED CEILING PLAN
A823 3/32" = 1'-0"

GENERAL NOTES	
1.	REFER TO SHEET G001 FOR ADDITIONAL GENERAL NOTES.
2.	REFER TO SHEET G001 FOR PARTITION TYPES AND ADDITIONAL NOTES.


CEILING NOTES	
1.	INSTALL CEILING GRIDS CENTERED IN THE ROOM, UNLESS IN ROOMS OTHER THAN RECTANGULAR SHAPED, INSTALL GRIDS CENTERED ON WALLS OR OTHER BUILT FEATURES AS INDICATED.
2.	INSTALLATION HEIGHTS OF THE CEILINGS MAY VARY SLIGHTLY FROM PLANS IN ROOMS WITH EXTERIOR WINDOWS. ACTUAL CEILING HEIGHT TO BE VERIFIED IN THE FIELD.
3.	FINAL INSTALLED CEILINGS SHALL HAVE HEIGHTS COORDINATED WITH OTHER CONTRACTORS WITH ABOVE CEILING WORK AND VERIFIED WITH FIELD CONDITIONS. ALL CHANGES IN CONFIGURATION OR HEIGHTS ARE TO BE APPROVED BY THE ARCHITECT.

CEILING LEGEND	
	GWR OR PLASTER CEILING. REFER TO DETAILS AND ROOM FINISH SCHEDULE
	SUSPENDED ACOUSTICAL PANEL CEILING SYSTEM
	CEILING HEIGHT ABOVE FINISHED FLOOR

ELECTRICAL EQUIPMENT. REFER TO ELECTRICAL DRAWINGS FOR ADDITIONAL INFORMATION.	
	2'x4' LIGHT FIXTURE
	2'x2' LIGHT FIXTURE
	1'x1' LIGHT FIXTURE
	PENDANT LIGHT FIXTURE
	RECESSED DOWN LIGHT
	CEILING MOUNTED EXIT SIGN
	CEILING MOUNTED OCCUPANCY SENSOR
	CEILING MOUNTED SMOKE DETECTOR
	CEILING MOUNTED HEAT DETECTOR
	CEILING MOUNTED PA SPEAKER
	CEILING MOUNTED SECURITY J-BOX
	CEILING MOUNTED MOTION SENSOR
	CEILING MOUNTED DATA J-BOX

MECHANICAL EQUIPMENT. REFER TO MECHANICAL DRAWINGS FOR ADDITIONAL INFORMATION.	
	HVAC SUPPLY GRILLE
	HVAC RETURN GRILLE

KEYNOTES	
#	DESCRIPTION
3	REINSTALL SALVAGED EXISTING SUSPENDED CEILING SYSTEM. REFER TO ELECTRICAL AND MECHANICAL DRAWINGS FOR EQUIPMENT INSTALLATIONS.

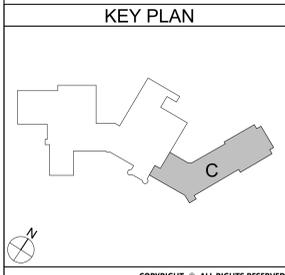

DATE	DESCRIPTION

Drawn By:	Autlin
Checked By:	
Proj. #:	66-11-00-01-0-003-018
CSArch Proj. #:	188-2301-02
Issued for Bid:	06/13/2025