




HP-MS-4

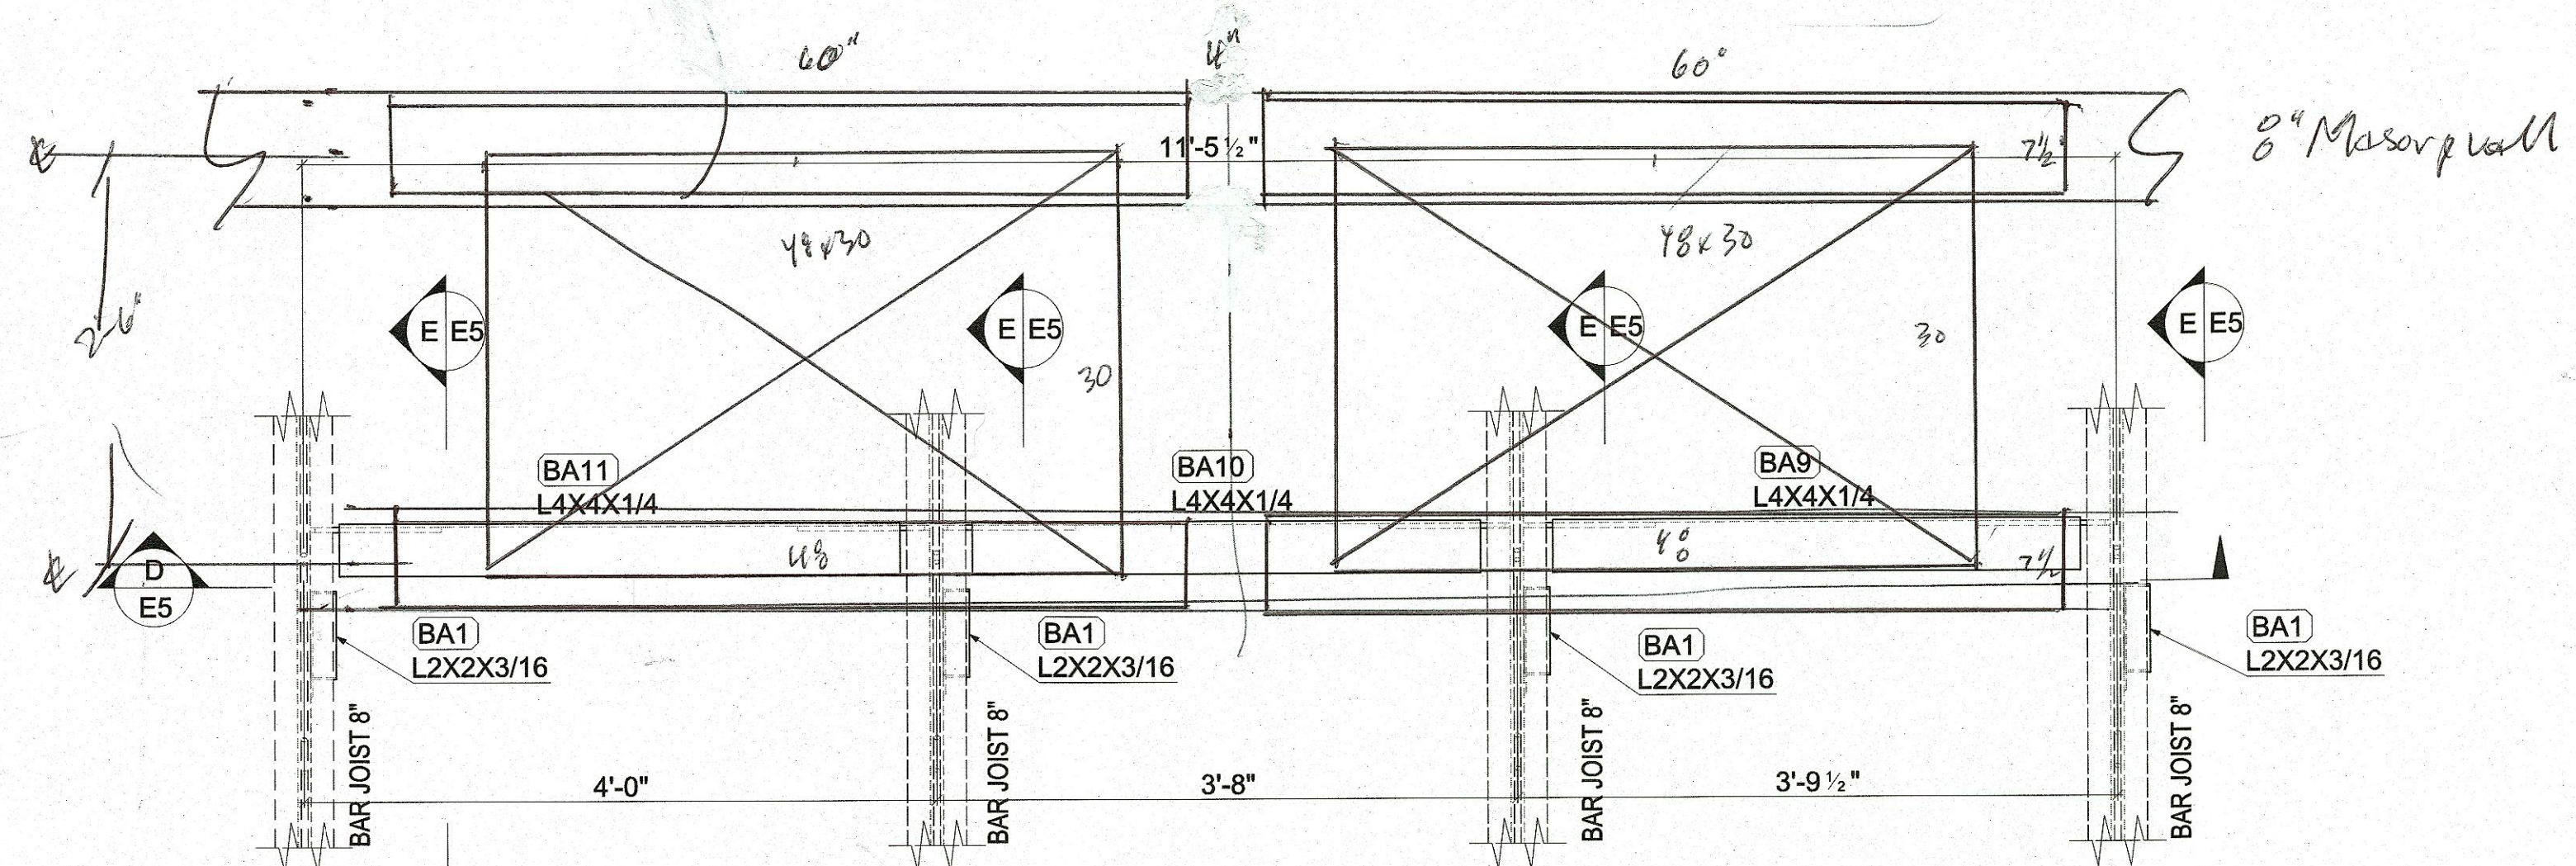

AREA 2 - PARTIAL PLAN VIEW
SCALE: 1"=1'-0"

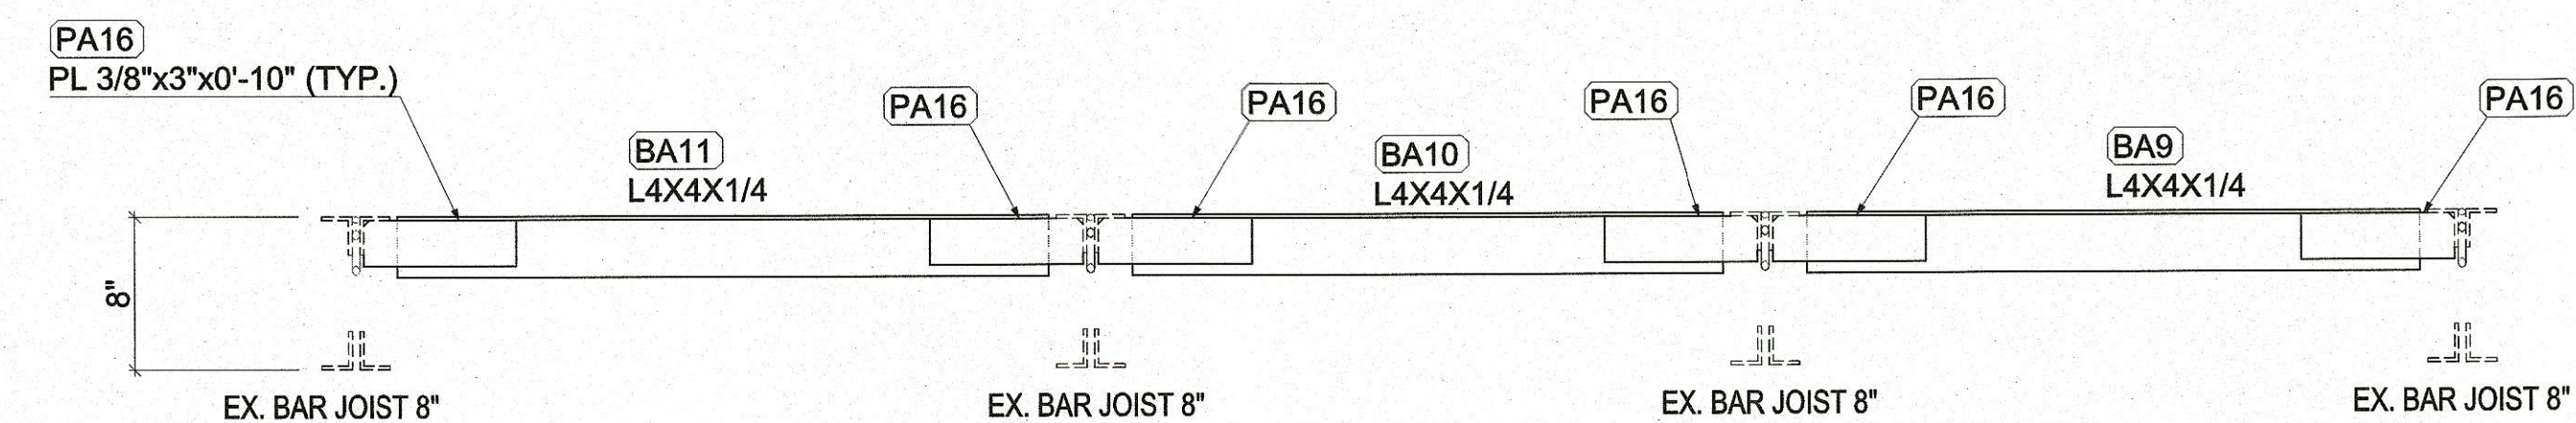

Section D-D

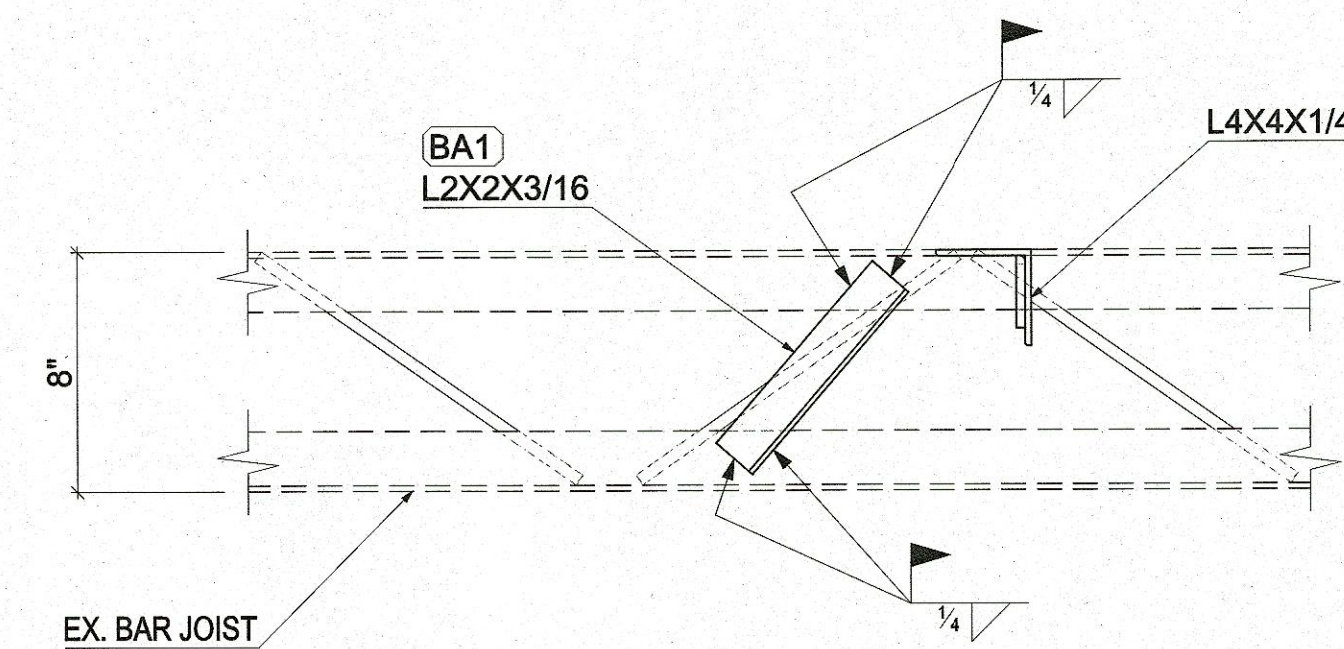

Section B - B

[illegible]

Architectural drawing of a roof layout showing ductwork, structural members, and annotations.

Dimensions:

- Overall width: 4'-0"
- Overall height: 4'-0"
- Horizontal segments: 2'-2 3/4", 1'-9 1/4", 1'-9 1/4", 2'-2 3/4"
- Vertical segments: 1'-0", 2'-11"
- Diagonal dimensions: 14'-9 7/8", 10'-3 3/4"
- Internal horizontal dimensions: 6'-0", 6'-0"

Structural Members:

- L4X4X1/4 (L-shaped members)
- BAR JOIST 8" (W10X22)

Annotations:

- "Potential Conflict w/ Ductwork on Roof were going to slide Units to right on Rails" (with arrows pointing right)
- "48x3" (handwritten note near a diagonal member)
- "40' x 30'" (handwritten note near a diagonal member)
- "4' spread" (handwritten note near a vertical member)
- "30'" (handwritten note near a vertical member)
- "60'" (handwritten note near a horizontal member)
- "BA3 W10X22" (label for bar joists)
- "BAR JOIST 8" (label for bar joists)
- "B E6" (label for a structural member)
- "A E6" (label for a structural member)

9 - 1/2" 60" AREA 3 - PARTIAL PLAN VIEW SCALE: 1"=1'-0" 8" Mas oary well

80° HP-MS-3 ✓

[illegible][illegible]

