
No:_____MC-01

SUBMITTAL COVERSHEET Nanuet UFSD – Phase 3 Projects

Architect: Owner: KSQ Architects Nanuet Union Free School District 215 W 40 th Street, 15 th Floor 101 Church Street New York, NY 10018 Nanuet, NY 10954 Contractor: Joe Lombardo Plumbing & Heating of Rockland Inc		eet 954	Construction Manager: Jacobs One Penn Plaza, 54 th floor New York, NY 10019 Contract: <u>Ron Lombardo</u>
Address:			845-357-6537 Telephone:
Suffern, New York 10901			Fax: 845-357-8529
School Name: Nanuet Union Free School District Phase 3 Bond Projects @ Barr Middle School & Nanuet High School			
Type of Submittal: []No []Yes			
[] Shop Drawings[] Product Data[] Test Report[] Certificate	[] Schedi [] Color S	ule [] Sample Sample [] Warranty	[]
Submittal Description:			
Product Name:Closeout Submittal			
Manufacturer: ELITECAD			
Subcontractor/ ELITECAD Supplier:			
References:			
Spec. Section No.:01 77 01		Drawing No(s):	
Paragraph: Rm. or Detail No(s):			
Architect's/ Engineer's Review Stamp		Contractor Review Statemen	t:
SAGE ENGINEERING ASSOCIATES, LLP		These documents have been checked for accuracy and coordinated with job conditions and Contract requirements by this office and have been found to comply with the provisions of the Contract Documents.	
Reviewed Furnish as Cor	rected		
Rejected Revise and Rev	submit		
Submit Specified Item This review is only for general conformance with the design concept a	ind the		
information given in the Construction Documents. Corrections or com the shop drawings during this review do not relieve the contractor from with the requirements of the plans and specifications. Review of a sp	ments made on n compliance	Ronald J. Lombardo	9/24/2024
not include review of an assembly of which the item is a component. is responsible for dimensions to be confirmed and correlated at the joi information that pertains solely to the fabrication processes or to the n methods, techniques, sequences and procedures of construction; coo Work with that of all other trades and performing all Work in a safe an	The Contractor bsite; neans, rdination of the	Name:	Date:
manner. M-70.1		Company Name: Joe Lombardo Plumbing & Heating of Rockland Inc.	
Date: 11/7/2024 By: J. Venditte			

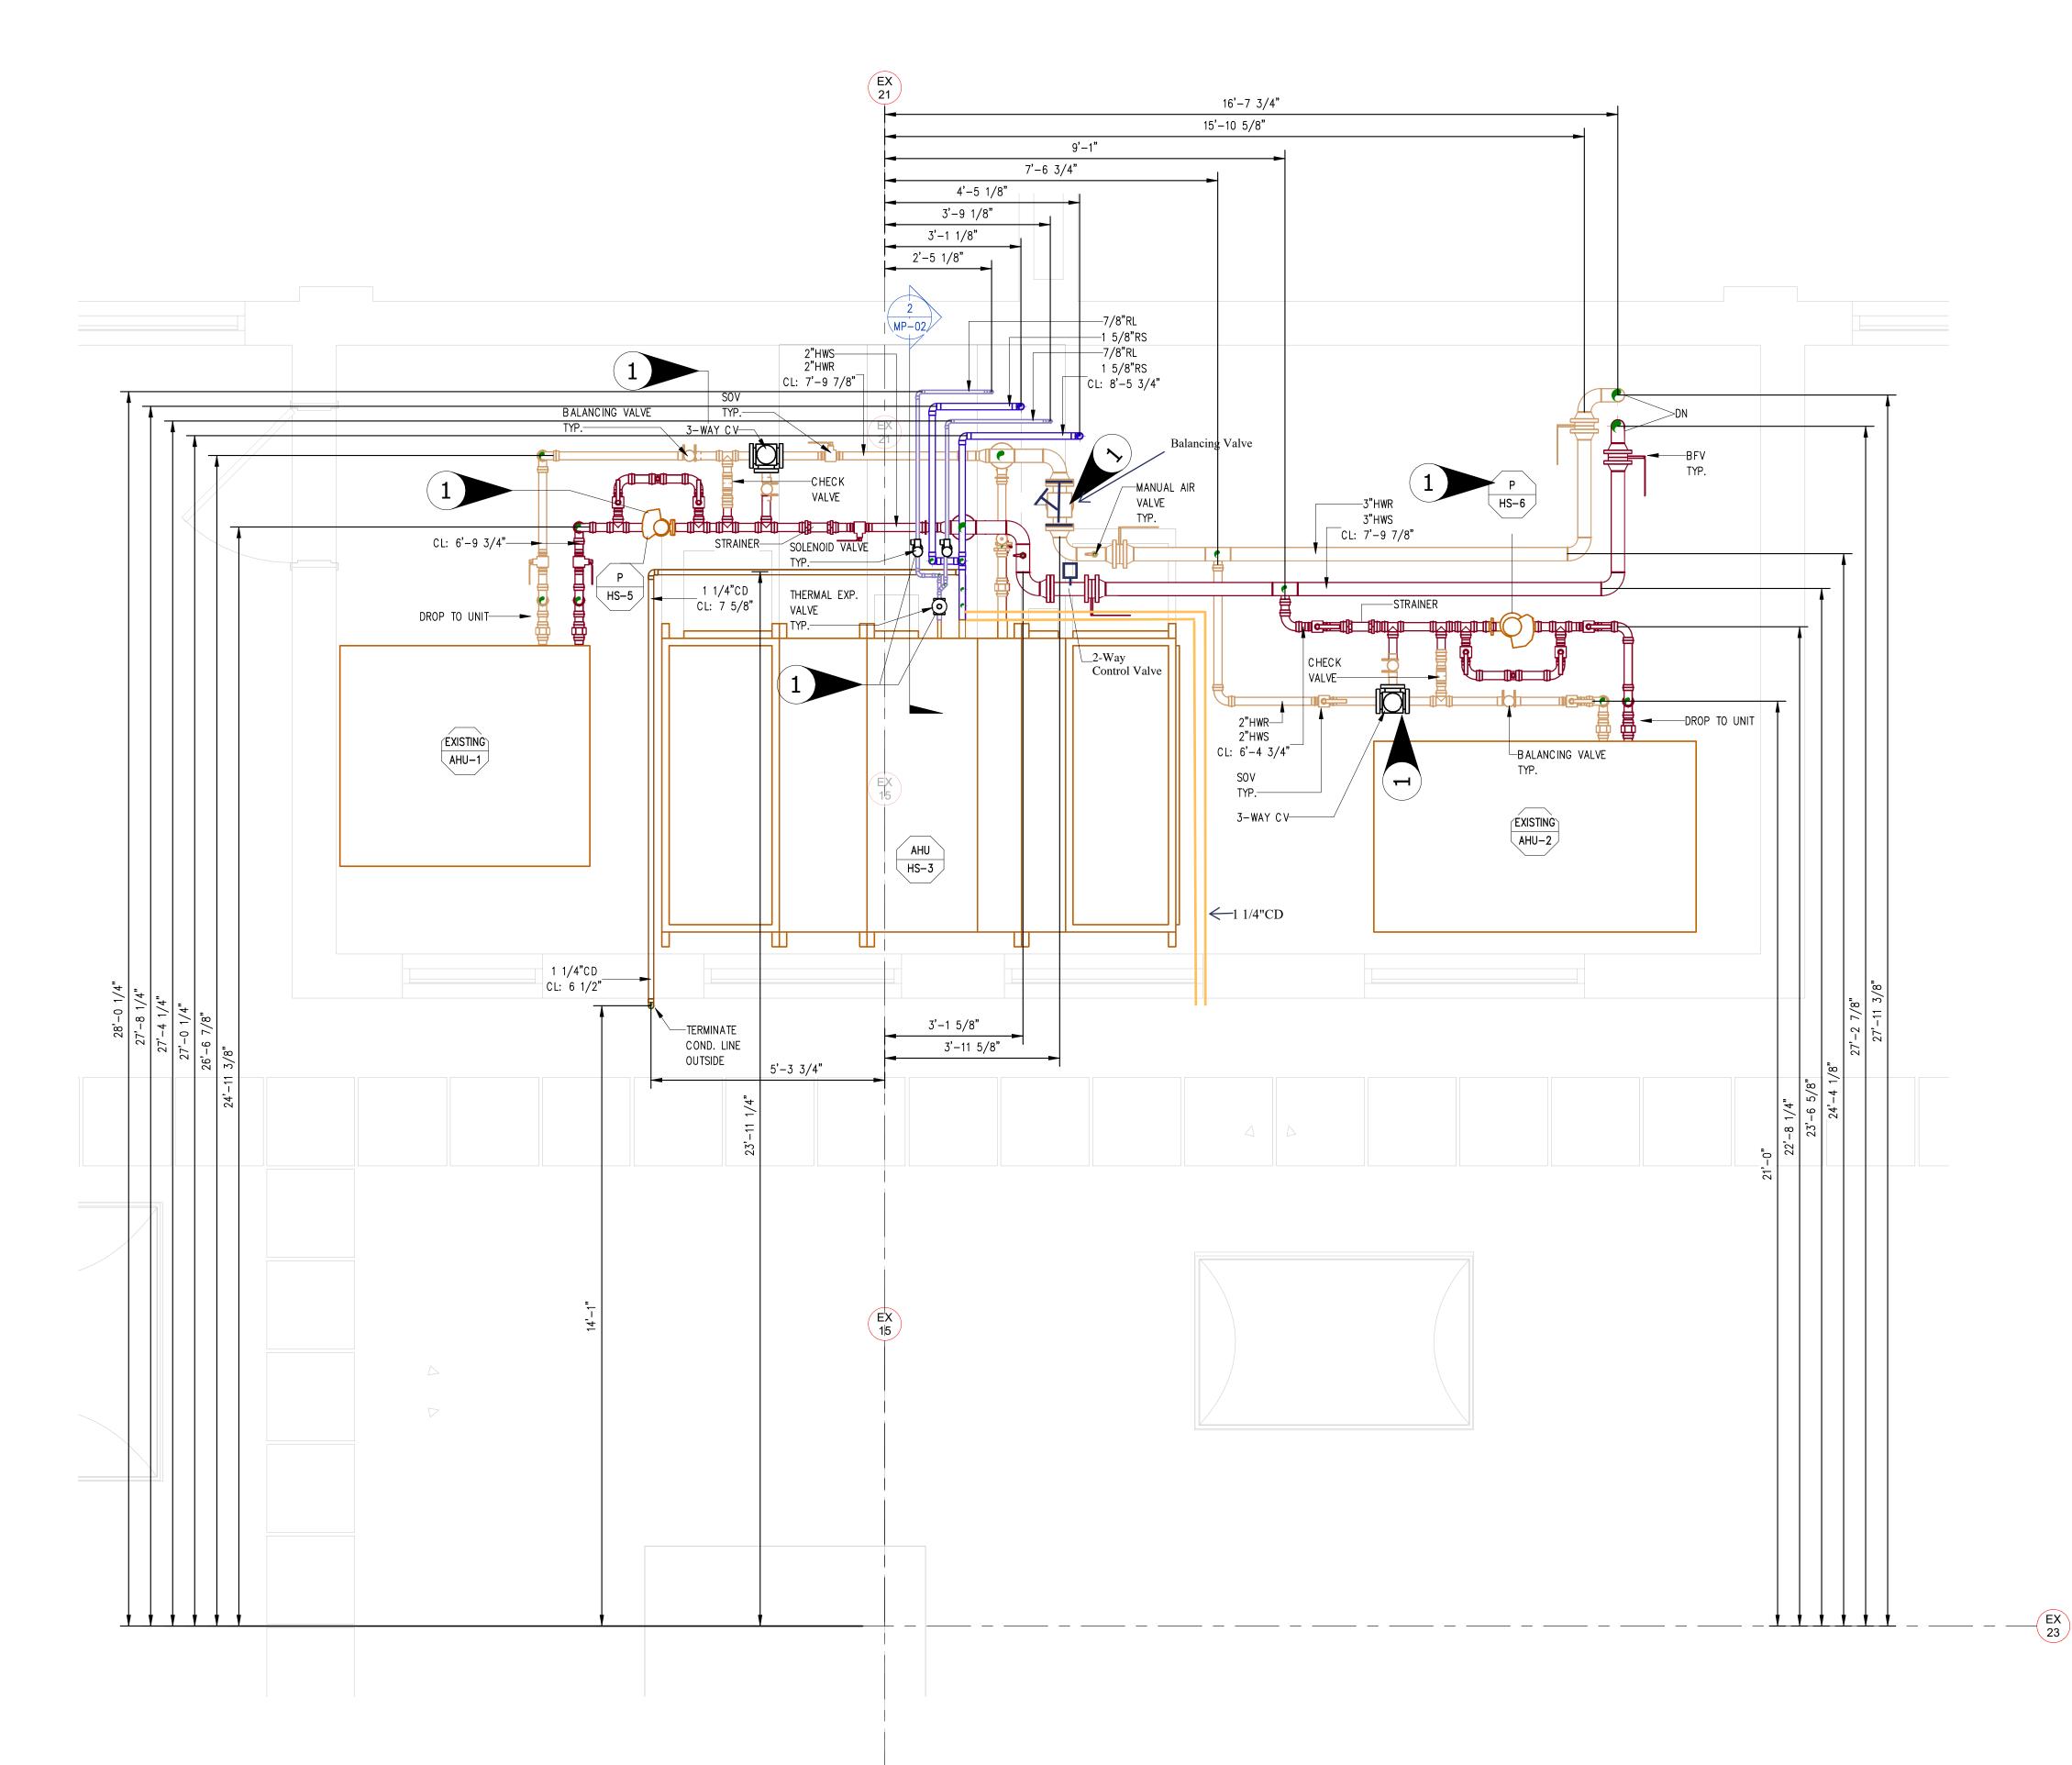

 GYM FAN ROOM

 MP-02
 SCALE: 1/2" = 1'-0"

As-Built Drawings JOE LOMBARDO PLUMBING & HEATING OF ROCKLAND INC **321 SPOOK ROCK ROAD SUITE 109A SUFFERN, NEW YORK 10901**

