

## SUBMITTAL COVERSHEET

### Nanuet UFSD –Phase 3 Projects

**Architect:**

KSQ Architects  
215 W 40<sup>th</sup> Street, 15<sup>th</sup> Floor  
New York, NY 10018

**Owner:**

Nanuet Union Free School District  
101 Church Street  
Nanuet, NY 10954

**Construction Manager:**

Jacobs  
One Penn Plaza, 54<sup>th</sup> floor  
New York, NY 10019

**Contractor:** Joe Lombardo Plumbing & Heating of Rockland Inc

**Contract:** Ron Lombardo

**Address:** 321 Spook Rock Road Suite 109A

845-357-6537

Suffern, New York 10901

**Telephone:**

**Fax:** 845-357-8529

**School Name:** Nanuet Union Free School District Phase 3 Bond Projects @ Barr Middle School & Nanuet High School

**Type of Submittal:**

**Re-submittal:** [ ] No [ ] Yes

[ ] Shop Drawings

[ ] Product Data

[ ] Schedule

[ ] Sample

[ ]

[ ] Test Report

[ ] Certificate

[ ] Color Sample

[ ] Warranty

[ ]

**Submittal Description:**

MECHANICAL ROOM HIGH SCHOOL BOILER ROOM COORDINATED SHOP DWG

**Product Name:**

**Manufacturer:** ELITECAD

**Subcontractor/** ELITECAD

**Supplier:**

**References:**

**Spec. Section No.:** 230000

**Drawing No(s):**

**Paragraph:**

**Rm. or Detail No(s):**

**Architect's/ Engineer's Review Stamp**

SAGE ENGINEERING ASSOCIATES, LLP

☐ Reviewed

☒ Furnish as Corrected

☐ Rejected

☐ Revise and Resubmit

☐ Submit Specified Item

This review is only for general conformance with the design concept and the information given in the Construction Documents. Corrections or comments made on the shop drawings during this review do not relieve the contractor from compliance with the requirements of the plans and specifications. Review of a specific item shall not include review of an assembly of which the item is a component. The Contractor is responsible for dimensions to be confirmed and correlated at the jobsite; information that pertains solely to the fabrication processes or to the means, methods, techniques, sequences and procedures of construction; coordination of the Work with that of all other trades and performing all Work in a safe and satisfactory manner.

**SAGE LOG NO. M-33**

Date: 11/22/2023

By: J. Venditte

**Contractor Review Statement:**

These documents have been checked for accuracy and coordinated with job conditions and Contract requirements by this office and have been found to comply with the provisions of the Contract Documents.

Ronald J. Lombardo

11.21.23

Name:





Date:

Company Name:

Joe Lombardo Plumbing & Heating of Rockland Inc.

- 1. At the steam main tap, if elevation space allows, provide steam tap at 45 degree angle up to
- avoid the flow of condensate into the branch steam line, then 45 back down to the 11'-2-1/8" CL
- elevation.

**Remarks:**

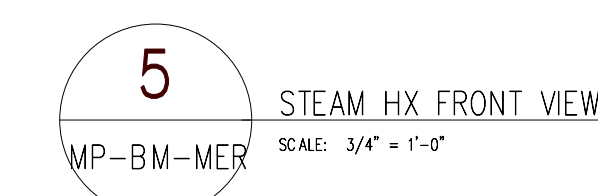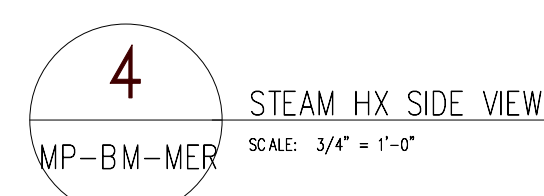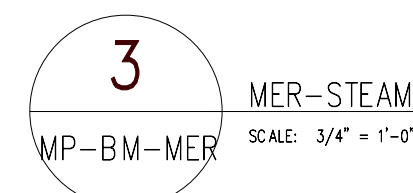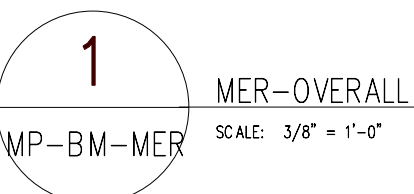

RECORD OF TRADE COORDINATION			
TRADE	COMPANY	DATE	AUTHORIZED SIGNATURE
PIPE FITTER			
SHEET METAL			
PLUMBER			
SPRINKLER			
ELECTRICIAN			
MECHANICAL CONT			
GENERAL CONT			
ENCLOSURE			
COORDINATION NOTE			


**ELITE CAD DESIGNS DISCLAIMER**

ARCHITECT / ENGINEER NOTES:

- 1 RELOCATE EXISTING SMALL DIAMETER PIPE IN CONFLICT WITH NEW STEAM
- 2 NO PIPING TO BYPASS FILTER FEEDER SHOWN ON CONTRACT DOCUMENTS

FOR APPROVAL

REV	DATE	DESCRIPTION
0	11/08/2023	SUBMITTED FOR APPROVAL

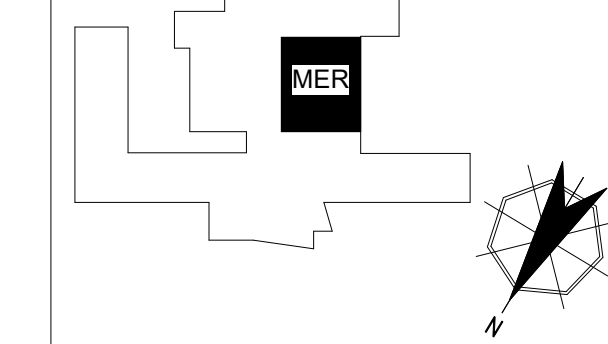[illegible]

ARCH	KSQ Design		
ENG	Sage Engineering Associates		
PROJECT	Nanuet High School 103 Church St. Nanuet, NY 10954		
TITLE	BASEMENT MECHANICAL ROOM		
GRP LDR	MC	PRO MGT	J23-287
DATE	11/09/2023	SCALE As Indicated	J23-287 MP-BM-MER 0