

SUBMITTAL COVERSHEET **Nanuet UFSD –Phase 3 Projects**

Architect:
KSQ Architects
215 W 40th Street, 15th Floor
New York, NY 10018

Owner:
Nanuet Union Free School District
101 Church Street
Nanuet, NY 10954

Construction Manager:
Jacobs
One Penn Plaza, 54th floor
New York, NY 10019

Contractor: Joe Lombardo Plumbing & Heating of Rockland Inc

Contract: Ron Lombardo

Address: 321 Spook Rock Road Suite 109A

845-357-6537

Telephone:

Suffern, New York 10901

Fax: 845-357-8529

School Name: Nanuet Union Free School District Phase 3 Bond Projects @ Barr Middle School & Nanuet High School

Type of Submittal:

Re-submittal: ☐ No ☐ Yes

☐ Shop Drawings ☐ Product Data ☐ Schedule ☐ Sample ☐ _____
☐ Test Report ☐ Certificate ☐ Color Sample ☐ Warranty ☐ _____

Submittal Description:

BMS WALLS SENSORS SHOP DWGS SIEMANS

Product Name: _____

Manufacturer: SIEMANS

Subcontractor/ Supplier: SIEMANS

References:

Spec. Section No.: 230923.1

Drawing No(s): _____

Paragraph: _____

Rm. or Detail No(s): _____

<p>Architect's/ Engineer's Review Stamp</p>	<p>Contractor Review Statement:</p>
	<p>These documents have been checked for accuracy and coordinated with job conditions and Contract requirements by this office and have been found to comply with the provisions of the Contract Documents.</p>
	<p>Ronald J. Lombardo 12.14.23</p>
	<p>Name: _____ Date: _____</p> <p>Company Name: Joe Lombardo Plumbing & Heating of Rockland Inc.</p>

Remarks:

Transmittal

To: JOE LOMBARDO PLUMBING & HEATING OF ROCKLAND INC 321 SPOOK ROCK RD SUFFERN, NY- 10901-5319 US. PHONE: (845) 357-6537	Date: 12/7/2023	Our Job No. 44OP-366733
	Job Name NANUET BOND PHASE 3 HIGH SCHOOL	
	Your Order No.	

WE ARE SENDING YOU

- | | |
|--|---|
| <input checked="" type="checkbox"/> HEREWITH | |
| <input type="checkbox"/> UNDER SEPARATE COVER THE FOLLOWING ITEMS: | |
| <input type="checkbox"/> SUBMITTALS FOR REVIEW/APPROVAL | <input type="checkbox"/> ENGINEERING COMMENTS |
| <input type="checkbox"/> APPROVED SUBMITTALS | <input type="checkbox"/> ORIGINAL DRAWINGS |
| <input type="checkbox"/> SUBMITTALS FOR YOUR USE | <input type="checkbox"/> SHOP DRAWINGS |
| <input type="checkbox"/> MARKED PLANS & SPECIFICATIONS | <input type="checkbox"/> CHANGE ORDER(S) |
| <input checked="" type="checkbox"/> THERMOSTAT LOCATION SUBMITTAL | <input type="checkbox"/> |

THESE ARE SUBMITTED

- | | |
|--|--|
| <input checked="" type="checkbox"/> FOR APPROVAL | <input type="checkbox"/> FOR YOUR USE |
| <input type="checkbox"/> FOR CORRECTION | <input checked="" type="checkbox"/> PLEASE RETURN __1__ APPROVED COPY(S) FOR OUR USE |
| <input type="checkbox"/> FOR COMMENTS | |

DESCRIPTION

ONE ELECTRONIC COPY OF THERMOSTAT LOCATION SUBMITTAL FOR THE ABOVE MENTIONED PROJECT.

IN ORDER TO PREPARE THE SUBMITTAL, WE HAVE FOLLOWED THE INFORMATION AS CHECKED BELOW

- | | |
|--|--|
| <input type="checkbox"/> ARCHITECTURAL PLANS | <input type="checkbox"/> ELECTRICAL HEATING COIL WIRING |
| <input checked="" type="checkbox"/> MECHANICAL PLANS | <input type="checkbox"/> CHILLER WIRING |
| <input type="checkbox"/> ELECTRICAL PLANS | <input type="checkbox"/> TERMINAL UNIT CUT SHEETS |
| <input type="checkbox"/> MECHANICAL SPECIFICATIONS | <input type="checkbox"/> HUMIDIFIER CUT SHEETS |
| <input type="checkbox"/> ELECTRICAL SPECIFICATIONS | <input type="checkbox"/> DX COIL WIRING |
| <input type="checkbox"/> EXISTING AS BUILTS | <input type="checkbox"/> COMPLETE SET(S) OF PLANS & SPECS. |
| <input type="checkbox"/> CUTSHEETS | <input type="checkbox"/> |

PLEASE BE ADVISED THAT WE MUST HAVE THIS INFORMATION BEFORE WORK CAN BEGIN ON YOUR SUBMITTAL

REMARKS

PLEASE ADDRESS YOUR REMARKS TO: SIEMENS INDUSTRY, INC. SMART INFRASTRUCTURE 412 MT KEMBLE AVE. MORRISTOWN, NJ 07960, USA	ATTENTION: OLIVER WRIGHT (PROJECT MANAGER) TELEPHONE NO: (973) 575-6300
---	---

SIEMENS

SIEMENS INDUSTRY, INC.
SMART INFRASTRUCTURE

412 MT KEMBLE AVE.
MORRISTOWN, NJ. 07960
USA

PHONE: (973) 575-6300
FAX: (973) 575-7968

12/7/23

FOR INFORMATION CONTACT
OLIVER WRIGHT (PROJECT MANAGER)

THERMOSTAT LOCATION SUBMITTAL FOR
NANUET BOND PHASE3 HIGH SCHOOL

103 CHURCH ST
NANUET, NY 10954-3030
USA

44OP-366733

KSQ DESIGN
ARCHITECT

SAGE ENGINEERING ASSOCIATES, LLP
ENGINEER


JOE LOMBARDO PLUMBING & HEATING, ROCKLAND
CONTRACTOR



Job Name: Nanuet Bond Phase 3 High School
JOB #: 44OP-366733
Siemens Industry Inc – Smart Infrastructure
Thermostat location Submittal

Submittal Notes
12/7/2023

1. BACnet thermostats are proposed for controlling the existing & new FTR's, Heating Radiation & Convector Units.
2. At the time of submission, as per DWG BM-M112, note-4 thermostat is connected to EX S-2. However, as per note-28 the same thermostat is mentioned as it will be controlling the 2-way valve for EX FTR. Thereby new BACnet thermostat will be provided for EX FTR and temperature reading will be shared with EX S-2.
3. At the time of submission, as per DWG BM-M111, UV-MS-3 and FT-MS-1 serving classroom 102A are sharing a single thermostat. Siemens proposes a new BACnet thermostat which will be controlling the FTR valve. Space temperature reading from this thermostat will be shared with UV-MS-3. New separate thermostat is not considered for UV units.
4. At the time of submission, as per DWG HS-M109, RTU-HS-5, R-2-3 and R-2-4 serving cafeteria are sharing a single thermostat. Siemens proposes a new BACnet thermostat (1 qty) for heating floor radiation units (R-2-3, R-2-4) which will be controlling radiation units' valves. RTU-HS-5 will be provided with manufacturer supplied thermostat.
5. At the time of submission, as per DWG HS-M109, RTU-HS-4, R-2-1 and R-2-2 serving dining room 2 are sharing a single thermostat. Siemens proposes a new BACnet thermostat (1 qty) for heating floor radiation units (R-2-1, R-2-2) which will be controlling radiation units' valves. RTU-HS-4 will be provided with manufacturer supplied thermostat.
6. At the time of submission, as per DWG HS-M109, thermostats are not shown for Convector units. Siemens is proposing new BACnet thermostat for these units to control the valves and to monitor space temperature. CV-HS-1 & CV-HS-2, CV-HS-4 & CV-HS-5 are serving same areas so single thermostat for each pair is considered.

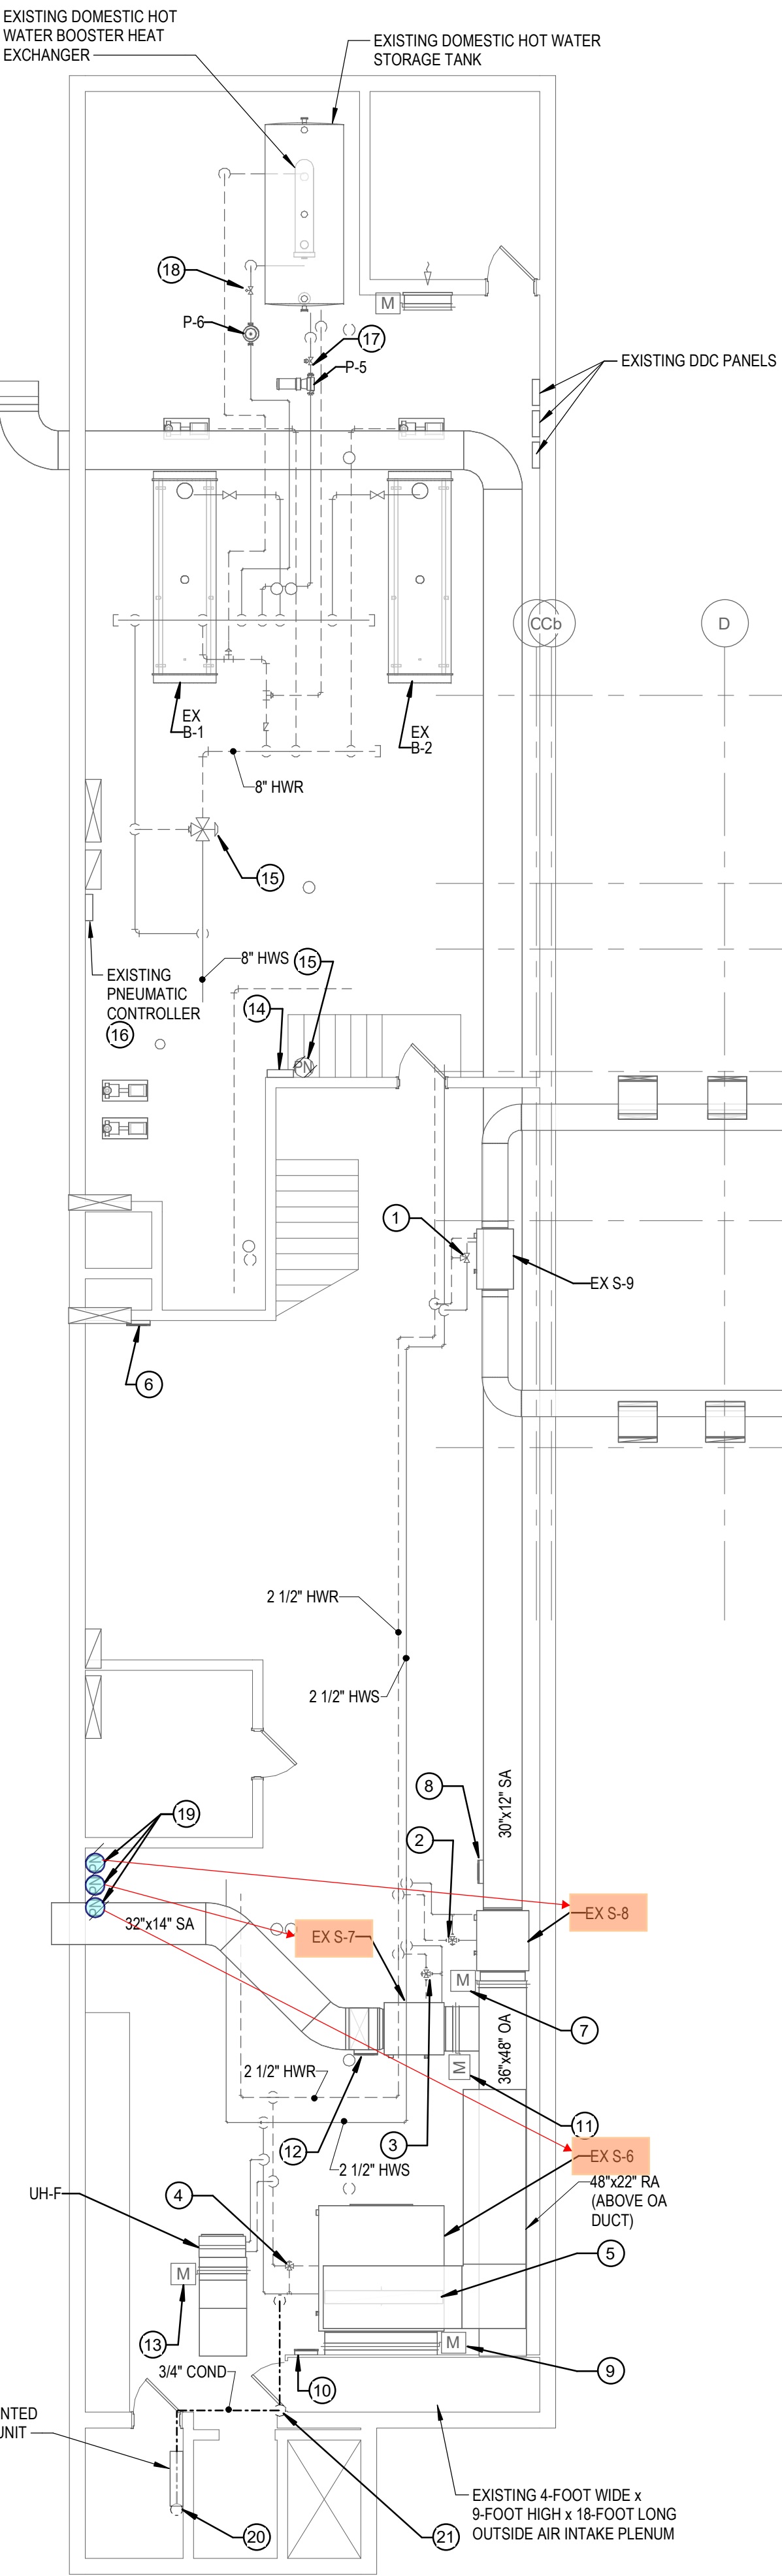

A18 OVER
1/8" = 1'-0"

- 1 DISCONNECT AND REMOVE EXISTING AIR HANDLING UNIT 5-9.3-WAY PNEUMATIC CONTROL VALVE. DISCONNECT AND REMOVE ALL PNEUMATIC TUBING BACK TO PNEUMATIC MAN. PROVIDE ELECTRONIC 3-WAY CONTROL VALVE RATED AT 4.8 GPM. DISCONNECT AND REMOVE ALL 5.8 PNEUMATIC SENSORS AND CONTROL DEVICES AND CONVERT TO ELECTRONIC. THE ALL ELECTRONIC SENSORS FROM 5-9 INTO THE EXISTING 5-9 DDC SYSTEM CONTROLLER OUTLINED IN KEY NOTE 6.
- 2 DISCONNECT AND REMOVE EXISTING AIR HANDLING UNIT 5-8.3-WAY PNEUMATIC CONTROL VALVE. DISCONNECT AND REMOVE ALL PNEUMATIC TUBING BACK TO PNEUMATIC MAN. PROVIDE ELECTRONIC 3-WAY CONTROL VALVE RATED AT 9.6 GPM. DISCONNECT AND REMOVE ALL 5.8 PNEUMATIC SENSORS AND CONTROL DEVICES AND CONVERT TO ELECTRONIC. THE ALL ELECTRONIC SENSORS FROM 5-8 INTO THE EXISTING 5-8 DDC SYSTEM CONTROLLER OUTLINED IN KEY NOTE 8.
- 4 DISCONNECT AND REMOVE EXISTING AIR HANDLING UNIT 5-6.3-WAY PNEUMATIC CONTROL VALVE. DISCONNECT AND REMOVE ALL PNEUMATIC TUBING BACK TO PNEUMATIC MAN. PROVIDE ELECTRONIC 3-WAY CONTROL VALVE RATED AT 28.8 GPM. DISCONNECT AND REMOVE ALL 5.4 PNEUMATIC SENSORS AND CONTROL DEVICES AND CONVERT TO ELECTRONIC. THE ALL ELECTRONIC SENSORS FROM 5-6 INTO THE EXISTING 5-6 DDC SYSTEM CONTROLLER OUTLINED IN KEY NOTE 10.
- 6 DISCONNECT AND REMOVE EXISTING AIR HANDLING UNIT 5.8 PNEUMATIC MOTORIZED RETURN AIR DAMPER ACTUATOR AT LOCATION SHOWN AND REPLACE WITH ELECTRONIC MOTORIZED DAMPER ACTUATOR. THE CONTROL OF DAMPER INTO EXISTING DDC SYSTEM CONTROLLER SERVING 5.3. REMOVE PNEUMATIC TUBING FROM REMOVED DAMPER BACK TO PNEUMATIC PIPING MAN.
- 8 LOCATION OF EXISTING AIR HANDLING UNIT 5-9 DDC SYSTEM CONTROLLER. DISCONNECT AND REMOVE 3-WAY CONTROL VALVE ELECTRIC-TO-PNEUMATIC TRANSDUCER INCLUDING ASSOCIATED PNEUMATIC TUBING AND PNEUMATIC DIL OPERATOR. REMOVE PNEUMATIC TUBING BACK TO PNEUMATIC PIPING MAN AND CAP. THE ELECTRONIC CONTROL VALVE OUTLINED IN KEY NOTE 11 INTO THE 5-9 DDC CONTROLLER AS REQUIRED.
- 7 DISCONNECT AND REMOVE EXISTING AIR HANDLING UNIT 5.8 PNEUMATIC MOTORIZED OUTSIDE AIR DAMPER ACTUATOR AT LOCATION SHOWN AND REPLACE WITH ELECTRONIC MOTORIZED DAMPER ACTUATOR. THE CONTROL OF DAMPER INTO EXISTING DDC SYSTEM CONTROLLER SERVING 5.8. REMOVE PNEUMATIC TUBING FROM REMOVED DAMPER BACK TO PNEUMATIC PIPING MAN.
- 10 LOCATION OF EXISTING AIR HANDLING UNIT 5.8 DDC SYSTEM CONTROLLER. DISCONNECT AND REMOVE ELECTRIC-TO-PNEUMATIC TRANSDUCER AND 3-WAY CONTROL VALVE ELECTRIC-TO-PNEUMATIC TRANSDUCER INCLUDING ASSOCIATED PNEUMATIC TUBING AND PNEUMATIC DIL OPERATORS. REMOVE PNEUMATIC TUBING BACK TO PNEUMATIC PIPING MAN AND CAP. THE ELECTRONIC CONTROL VALVE AND ELECTRONIC MOTORIZED DAMPER OUTLINED IN KEY NOTE 2 AND 7 INTO THE 5.8 DDC CONTROLLER AS REQUIRED.
- 9 DISCONNECT AND REMOVE EXISTING AIR HANDLING UNIT 5.8 PNEUMATIC MOTORIZED OUTSIDE AIR DAMPER ACTUATOR AT LOCATION SHOWN AND REPLACE WITH ELECTRONIC MOTORIZED DAMPER ACTUATOR. THE CONTROL OF DAMPER INTO EXISTING DDC SYSTEM CONTROLLER SERVING 5.6. REMOVE PNEUMATIC TUBING FROM REMOVED DAMPER BACK TO PNEUMATIC PIPING MAN.
- 10 LOCATION OF EXISTING AIR HANDLING UNIT 5.8 DDC SYSTEM CONTROLLER. DISCONNECT AND REMOVE DAMPER ELECTRIC-TO-PNEUMATIC TRANSDUCER AND 3-WAY CONTROL VALVE ELECTRIC-TO-PNEUMATIC TRANSDUCER INCLUDING ASSOCIATED PNEUMATIC TUBING AND PNEUMATIC DIL OPERATORS. REMOVE PNEUMATIC TUBING BACK TO PNEUMATIC PIPING MAN AND CAP. THE ELECTRONIC CONTROL VALVE AND ELECTRONIC MOTORIZED DAMPERS OUTLINED IN KEY NOTE 4, 5 AND 9 INTO THE 5.8 DDC CONTROLLER AS REQUIRED.
- 11 DISCONNECT AND REMOVE EXISTING AIR HANDLING UNIT 5.7 PNEUMATIC MOTORIZED OUTSIDE AIR DAMPER ACTUATOR AT LOCATION SHOWN AND REPLACE WITH ELECTRONIC MOTORIZED DAMPER ACTUATOR. THE CONTROL OF DAMPER INTO EXISTING DDC SYSTEM CONTROLLER SERVING 5.7. REMOVE PNEUMATIC TUBING FROM REMOVED DAMPER BACK TO PNEUMATIC PIPING MAN.
- 10 LOCATION OF EXISTING AIR HANDLING UNIT 5-7 DDC SYSTEM CONTROLLER. DISCONNECT AND REMOVE DAMPER ELECTRIC-TO-PNEUMATIC TRANSDUCER AND 3-WAY CONTROL VALVE ELECTRIC-TO-PNEUMATIC TRANSDUCER INCLUDING ASSOCIATED PNEUMATIC TUBING AND PNEUMATIC DIL OPERATORS. REMOVE PNEUMATIC TUBING BACK TO PNEUMATIC PIPING MAN AND CAP. THE ELECTRONIC CONTROL VALVE AND ELECTRONIC MOTORIZED DAMPER OUTLINED IN KEY NOTE 2 AND 11 INTO THE 5-7 DDC CONTROLLER AS REQUIRED.
- 13 DISCONNECT AND REMOVE EXISTING HYBRID UNIT HEATER UHF-4 DUAL PNEUMATIC FACE AND BYPASS DAMPER AT LOCATION SHOWN AND REPLACE WITH MANUAL DAMPER OPERATOR LOCKED IN OPEN POSITION. REMOVE PNEUMATIC TUBING FROM REMOVED DAMPER BACK TO PNEUMATIC PIPING MAN.
- 14 LOCATION OF EXISTING BUILDING HEATING PLANT DDC SYSTEM CONTROLLER.
- 15 DISCONNECT AND REMOVE MAN BUILDING HEATING LOOP 3-WAY PNEUMATIC MIXING CONTROL VALVE. DISCONNECT AND REMOVE ALL PNEUMATIC TUBING BACK TO PNEUMATIC MAN. DISCONNECT AND REMOVE 3-WAY CONTROL VALVE ELECTRIC-TO-PNEUMATIC TRANSDUCER INCLUDING ASSOCIATED PNEUMATIC TUBING AND PNEUMATIC DIL OPERATOR LOCATED ADJACENT TO BUILDING HEATING PLANT DDC SYSTEM CONTROLLER. REMOVE ASSOCIATED WIRING BACK TO CONTROL PANEL AS REQUIRED. AT LOCATIONS OF REMOVED PNEUMATIC 3-WAY MIXING VALVE PROVIDE AN ELECTRONIC 3-WAY MIXING CONTROL VALVE RATED AT 550 GPM. THE OPERATION OF MIXING VALVE INTO EXISTING BUILDING HEATING PLANT DDC SYSTEM CONTROLLER OUTLINED IN KEY NOTE 14.
- 16 DISCONNECT AND REMOVE PNEUMATIC PIPING AND ASSOCIATED PRESSURE DIAL WITHIN THE PNEUMATIC CONTROL PANEL RELATED TO THE CONTROL PANEL. THE MAIN HOT WATER SUPPLY 3-WAY VALVE OUTLINED IN KEY NOTE 15. REMOVE PNEUMATIC PIPING BACK TO ASSOCIATED PIPING MAN AND CAP.
- 17 DISCONNECT AND REMOVE EXISTING DOMESTIC HOT WATER STORAGE TANK 1.5 PNEUMATIC CONTROL VALVE. DISCONNECT AND REMOVE ALL PNEUMATIC TUBING BACK TO PNEUMATIC MAN. PROVIDE ELECTRONIC 2-WAY CONTROL VALVE RATED AT 180 GPM. DISCONNECT AND REMOVE ALL STORAGE TANK PNEUMATIC SENSORS AND CONTROL DEVICES AND CONVERT TO ELECTRONIC. THE ALL ELECTRONIC SENSORS FROM THE STORAGE TANK INTO THE EXISTING DDC SYSTEM CONTROLLER OUTLINED IN KEY NOTE 14.
- 18 DISCONNECT AND REMOVE EXISTING DOMESTIC HOT WATER BOOSTER HEATER HEAT EXCHANGER 2-WAY PNEUMATIC CONTROL VALVE. DISCONNECT AND REMOVE ALL PNEUMATIC TUBING BACK TO PNEUMATIC MAN. PROVIDE ELECTRONIC 2-WAY CONTROL VALVE RATED AT 20 GPM. DISCONNECT AND REMOVE HEAT EXCHANGER PNEUMATIC DIGITAL PARTIAL PRESSURE TRANSDUCER AND CONVERT TO ELECTRONIC. THE ALL ELECTRONIC SENSORS FROM THE HEAT EXCHANGER INTO THE EXISTING DDC SYSTEM CONTROLLER OUTLINED IN KEY NOTE 14.
- 19 DISCONNECT AND REMOVE ALL EXISTING AIR HANDLING UNITS 5.6, 5.7 AND 5.8 PNEUMATIC CONTROL FAN OPERATORS, SENSORS AND RELAY DEVICES. DISCONNECT AND REMOVE ALL PNEUMATIC TUBING BACK TO PNEUMATIC PIPING MAN AND CAP. CONVERT ALL PNEUMATIC CONTROL DEVICES SERVING 5.6, 5.7 AND 5.8 TO ELECTRONIC AND PROVIDE RELAYS FROM FAN STARTSTOP MOTOR STARTER TO EXISTING DDC CONTROL PANELS SERVING EACH UNIT TO ALLOW FOR ELECTRONIC FAN DIGITAL PARTIAL PRESSURE TRANSDUCER AND REMOVE PNEUMATIC TUBING BETWEEN PNEUMATIC CONTROL DEVICES AND EXISTING 5.6, 5.7 AND 5.8 SPACE SENSORS. **PROVIDE RELAYS FROM EXISTING 5.6, 5.7 AND 5.8 SPACE SENSORS TO EXISTING DDC CONTROL PANELS SERVING EACH UNIT TO ALLOW FOR ELECTRONIC ANALOG INPUT OF EACH SPACE TEMPERATURE TO THE DDC SYSTEM.**
- 20 DISCONNECT AND REMOVE OPEN-ENDED PVC HOSE FROM CONDENSATE DRAIN OUTLET CONNECTION ON EXISTING ELEVATOR MACHINE ROOM FAN COIL. UNIT AND PROVIDE A 3/4" HARD PIPE CONNECTION TO THE CONDENSATE OUTLET. PROVIDE A P-TRAP BELOW FAN COIL UNIT. RUN ROUTE 3/4" CONDENSATE PIPING THROUGH ELEVATOR MACHINE ROOM TO MECHANICAL AREA OF BASEMENT AS SHOWN.
- 21 PROVIDE 3/4" CONDENSATE DROP DOWN AT LOCATION SHOWN TO FLOOR LEVEL. THEN ROUTE 3/4" CONDENSATE PIPING BELOW BOTTOM OF DROP OPENING TO RAIN DRAIN. THEN ROUTE 3/4" CONDENSATE PIPING TO FLOOR LEVEL. TO NEW FLOOR DRAIN BEING PROVIDED ON PLUMBING DRAWINGS. TERMINATE CONDENSATE PIPING OPEN-ENDED ABOVE NEW FLOOR DRAIN.

EX S-X EXISTING AIR HANDLING UNIT

T EX AHU-WALL SENSOR

[illegible]

BM-M110

SIEMENS WALL SENSOR LOCATION DRAWING




NUFSD
BOND
PROJECTS
PH3


☐ SED#50-01-08-03-0-003-035 (HIGH SCHOOL)
☒ SED#50-01-08-03-0-004-020 (BARR MIDDLE SCHOOL)

High School
103 Church St.
Nanuet, NY 10954

Barr Middle School
50 Blauvelt Rd #1
Nanuet, NY 10954

KEY PLAN

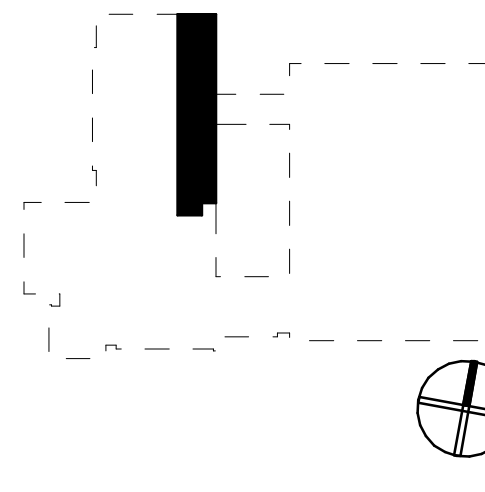

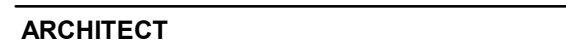

NEW YORK OKLAHOMA

Clapper Structural Engineering

160 Parillion Street
Saugerties, NY 12477
845.943.9601
www.clapperstructural.com

MEP Engineer
Sage Engineering Associates, LLP

5 Columbia Circle
Albany NY 12203
518.453.6091 office
518.453.6092 fax
www.sagellp.com

Environmental Engineer

Quest Environmental Solutions
1376 Route 9
Wappingers Falls, NY 12590
845.298.6251
www.qualityenv.com

Construction Manager
Jacobs

One Penn Plaza
54th Floor, Suite 5420
New York, NY 10119
646.908.6550
www.jacobs.com




☐ SED#50-01-08-03-0-003-035 (HIGH SCHOOL)
☒ SED#50-01-08-03-0-004-020 (BARR MIDDLE SCHOOL)

High School
103 Church St.
Nanuet, NY 10954

Barr Middle School
50 Blauvelt Rd #1
Nanuet, NY 10954

KEY PLAN

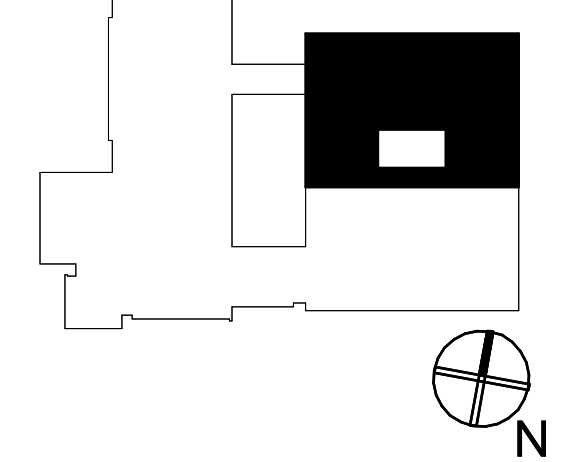[illegible]

ISSUED: BID SET ISSUANCE


DATE: 06/06/2023

SCALE: 1/8" = 1'-0"

SHEET NAME:
PARTIAL FIRST FLOOR
PLAN - NORTHEAST

SHEET NUMBER:
BM-M111

SSUE FOR BID SET

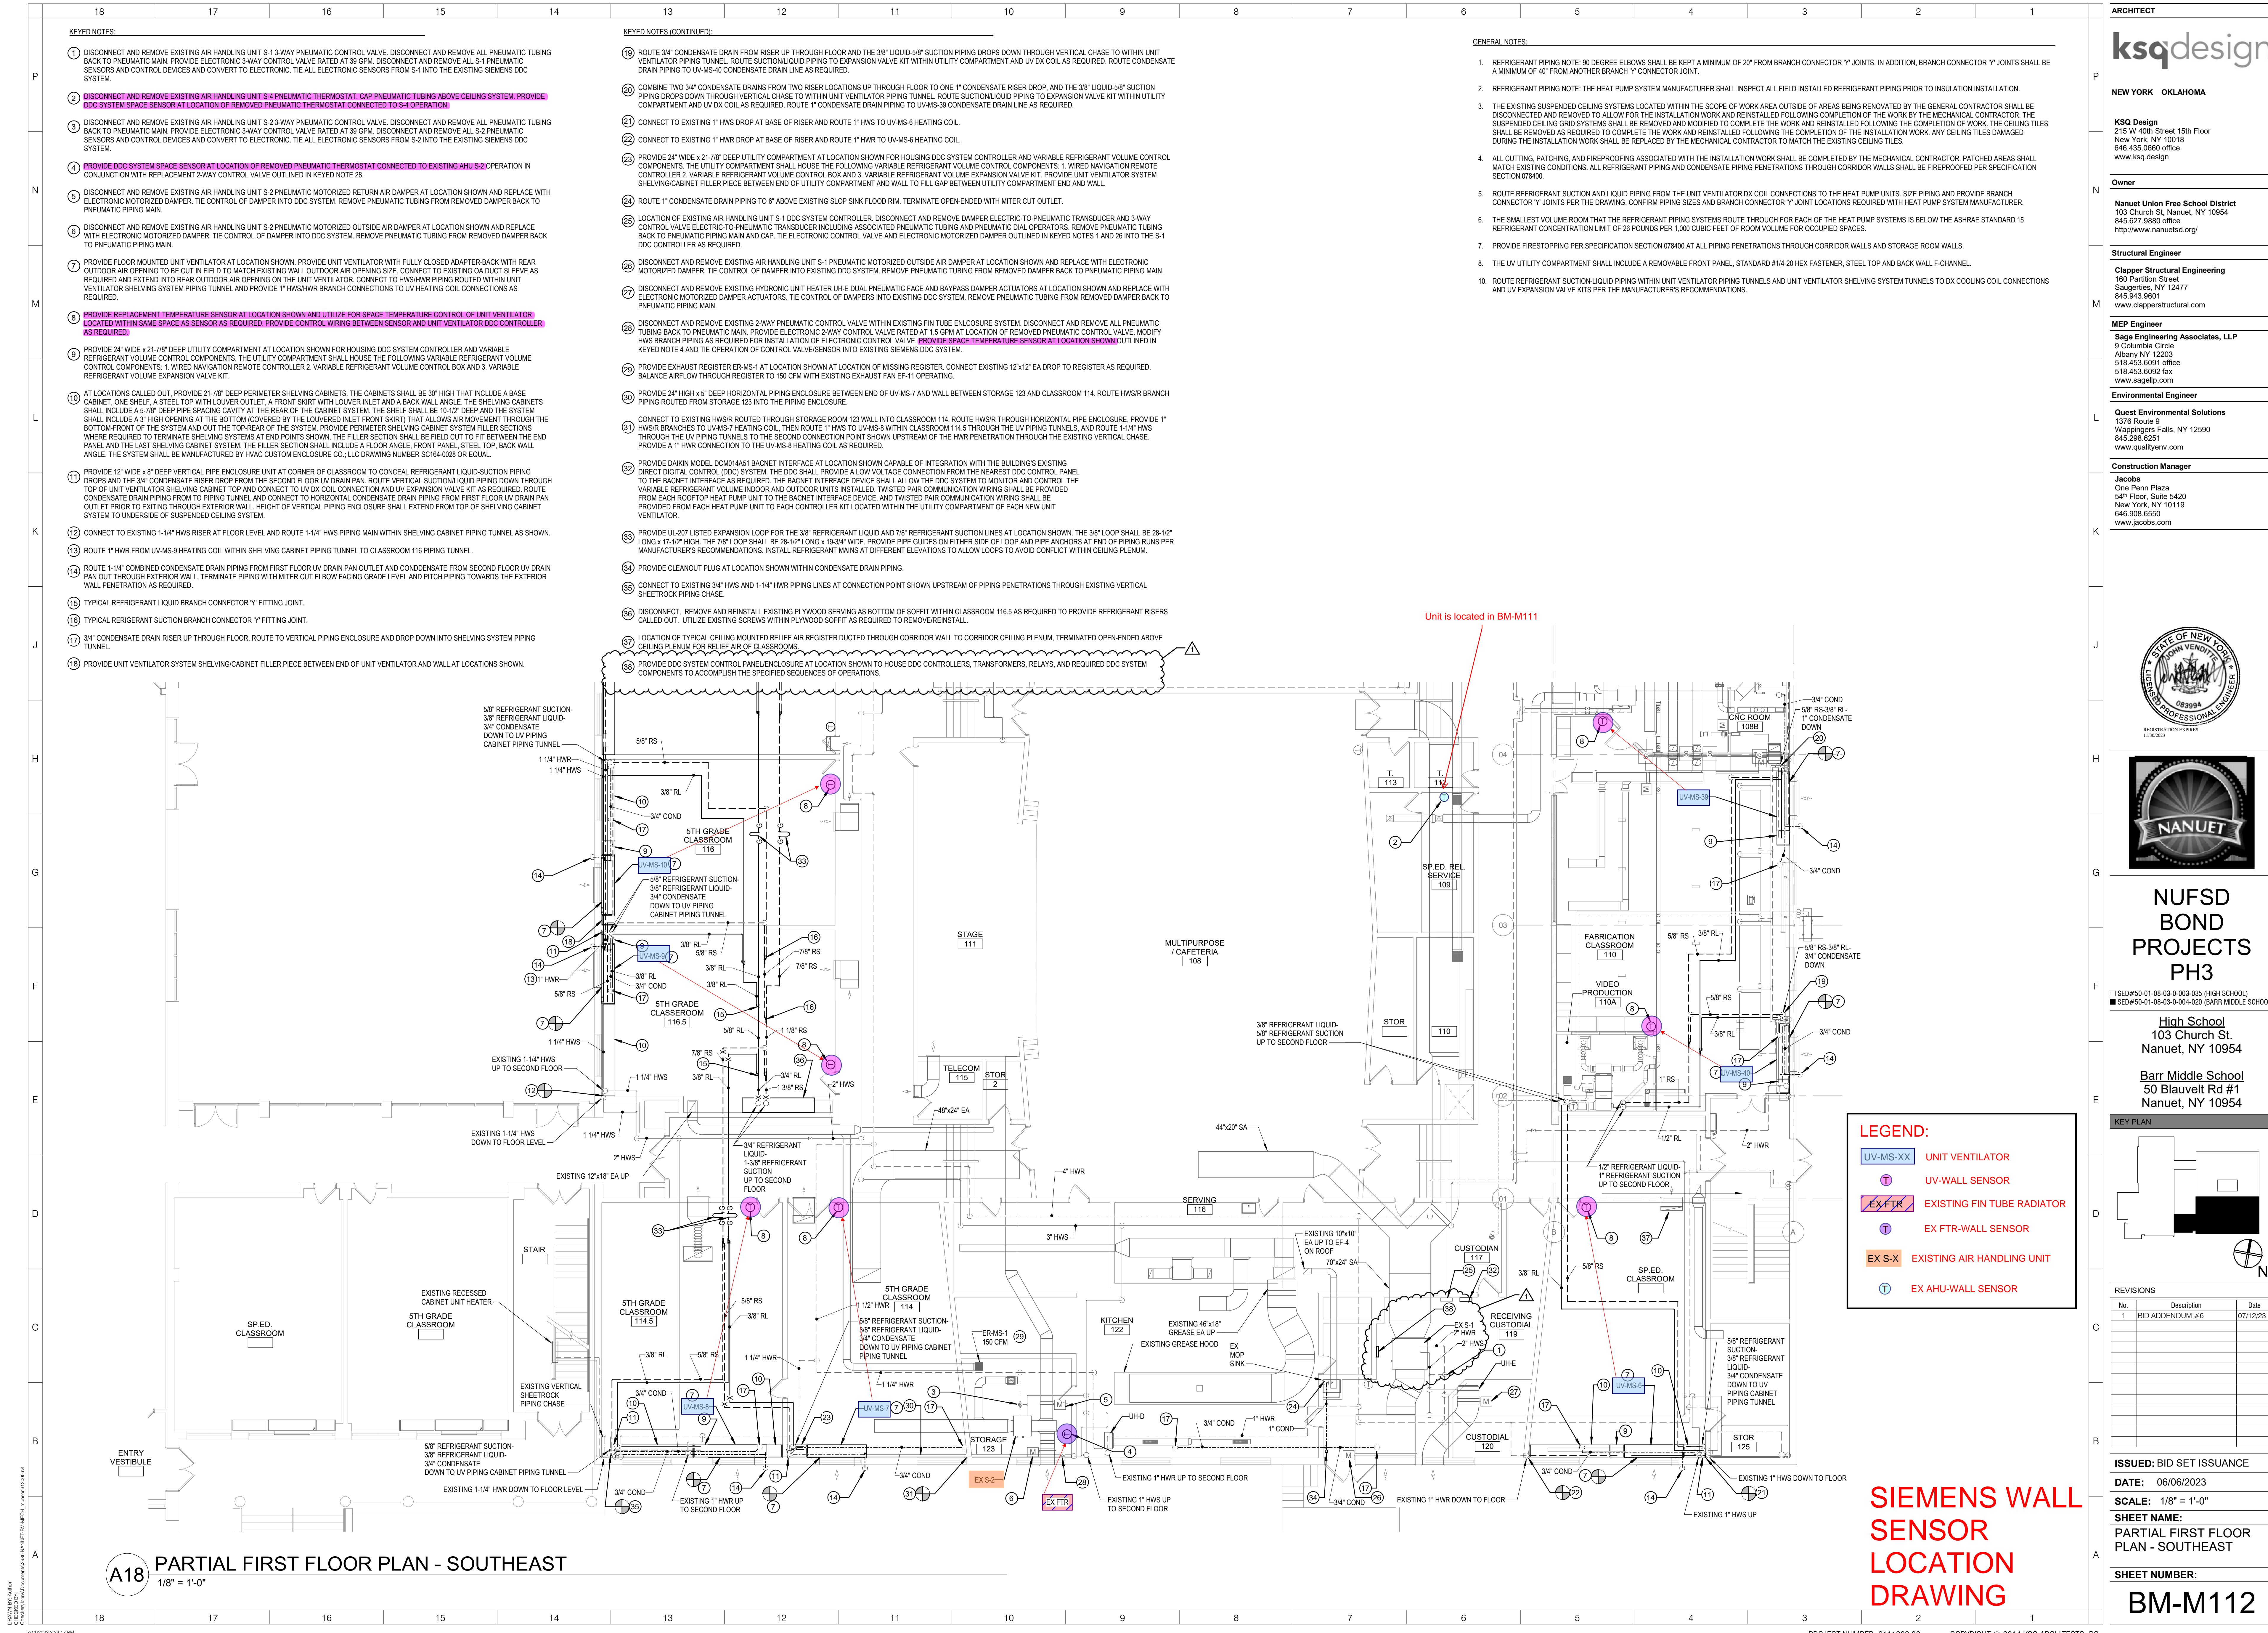

ARCHITECT

ksqdesign

NEW YORK OKLAHOMA

KSQ Design
215 W 40th Street 15th Floor
New York, NY 10018
646.435.0660 office
www.ksqdesign.com

Owner

Nanuet Union Free School District
103 Church St. Nanuet, NY 10954
645.627.9880 office
http://www.nanuetusd.org/

Structural Engineer

Clapper Structural Engineering
160 Partition Street
Saugerties, NY 12477
845.943.9801
www.clappersstructural.com

MEP Engineer

Sage Engineering Associates, LLP
9 Columbus Circle
Albany NY 12203
518.453.6951 office
518.453.6992 fax
www.sageellp.com

Environmental Engineer

Quest Environmental Solutions
1376 Route 9
Wappingers Falls, NY 12590
845.296.6501
www.qualityenv.com

Construction Manager

Jacobs
One Penn Plaza
54th Floor, Suite 5420
New York, NY 10119
646.906.6550
www.jacobs.com

NUFSD BOND PROJECTS PH3

SED#50-01-08-03-0-003-035 (HIGH SCHOOL)
SED#50-01-08-03-0-004-020 (BARR MIDDLE SCHOOL)

High School
103 Church St.
Nanuet, NY 10954

Barr Middle School
50 Blauvelt Rd #1
Nanuet, NY 10954

KEY PLAN

REVISIONS


No.	Description	Date
1	BID ADDENDUM #6	07/12/23


ISSUED: BID SET ISSUANCE
DATE: 06/06/2023
SCALE: 1/8" = 1'-0"
SHEET NAME: PARTIAL FIRST FLOOR PLAN - SOUTHEAST
SHEET NUMBER:

ISSUED: BID SET ISSUANCE
DATE: 06/06/2023
SCALE: 1/8" = 1'-0"
SHEET NAME: PARTIAL FIRST FLOOR PLAN - SOUTHEAST
SHEET NUMBER:

BM-M112

ISSUE FOR BID SET

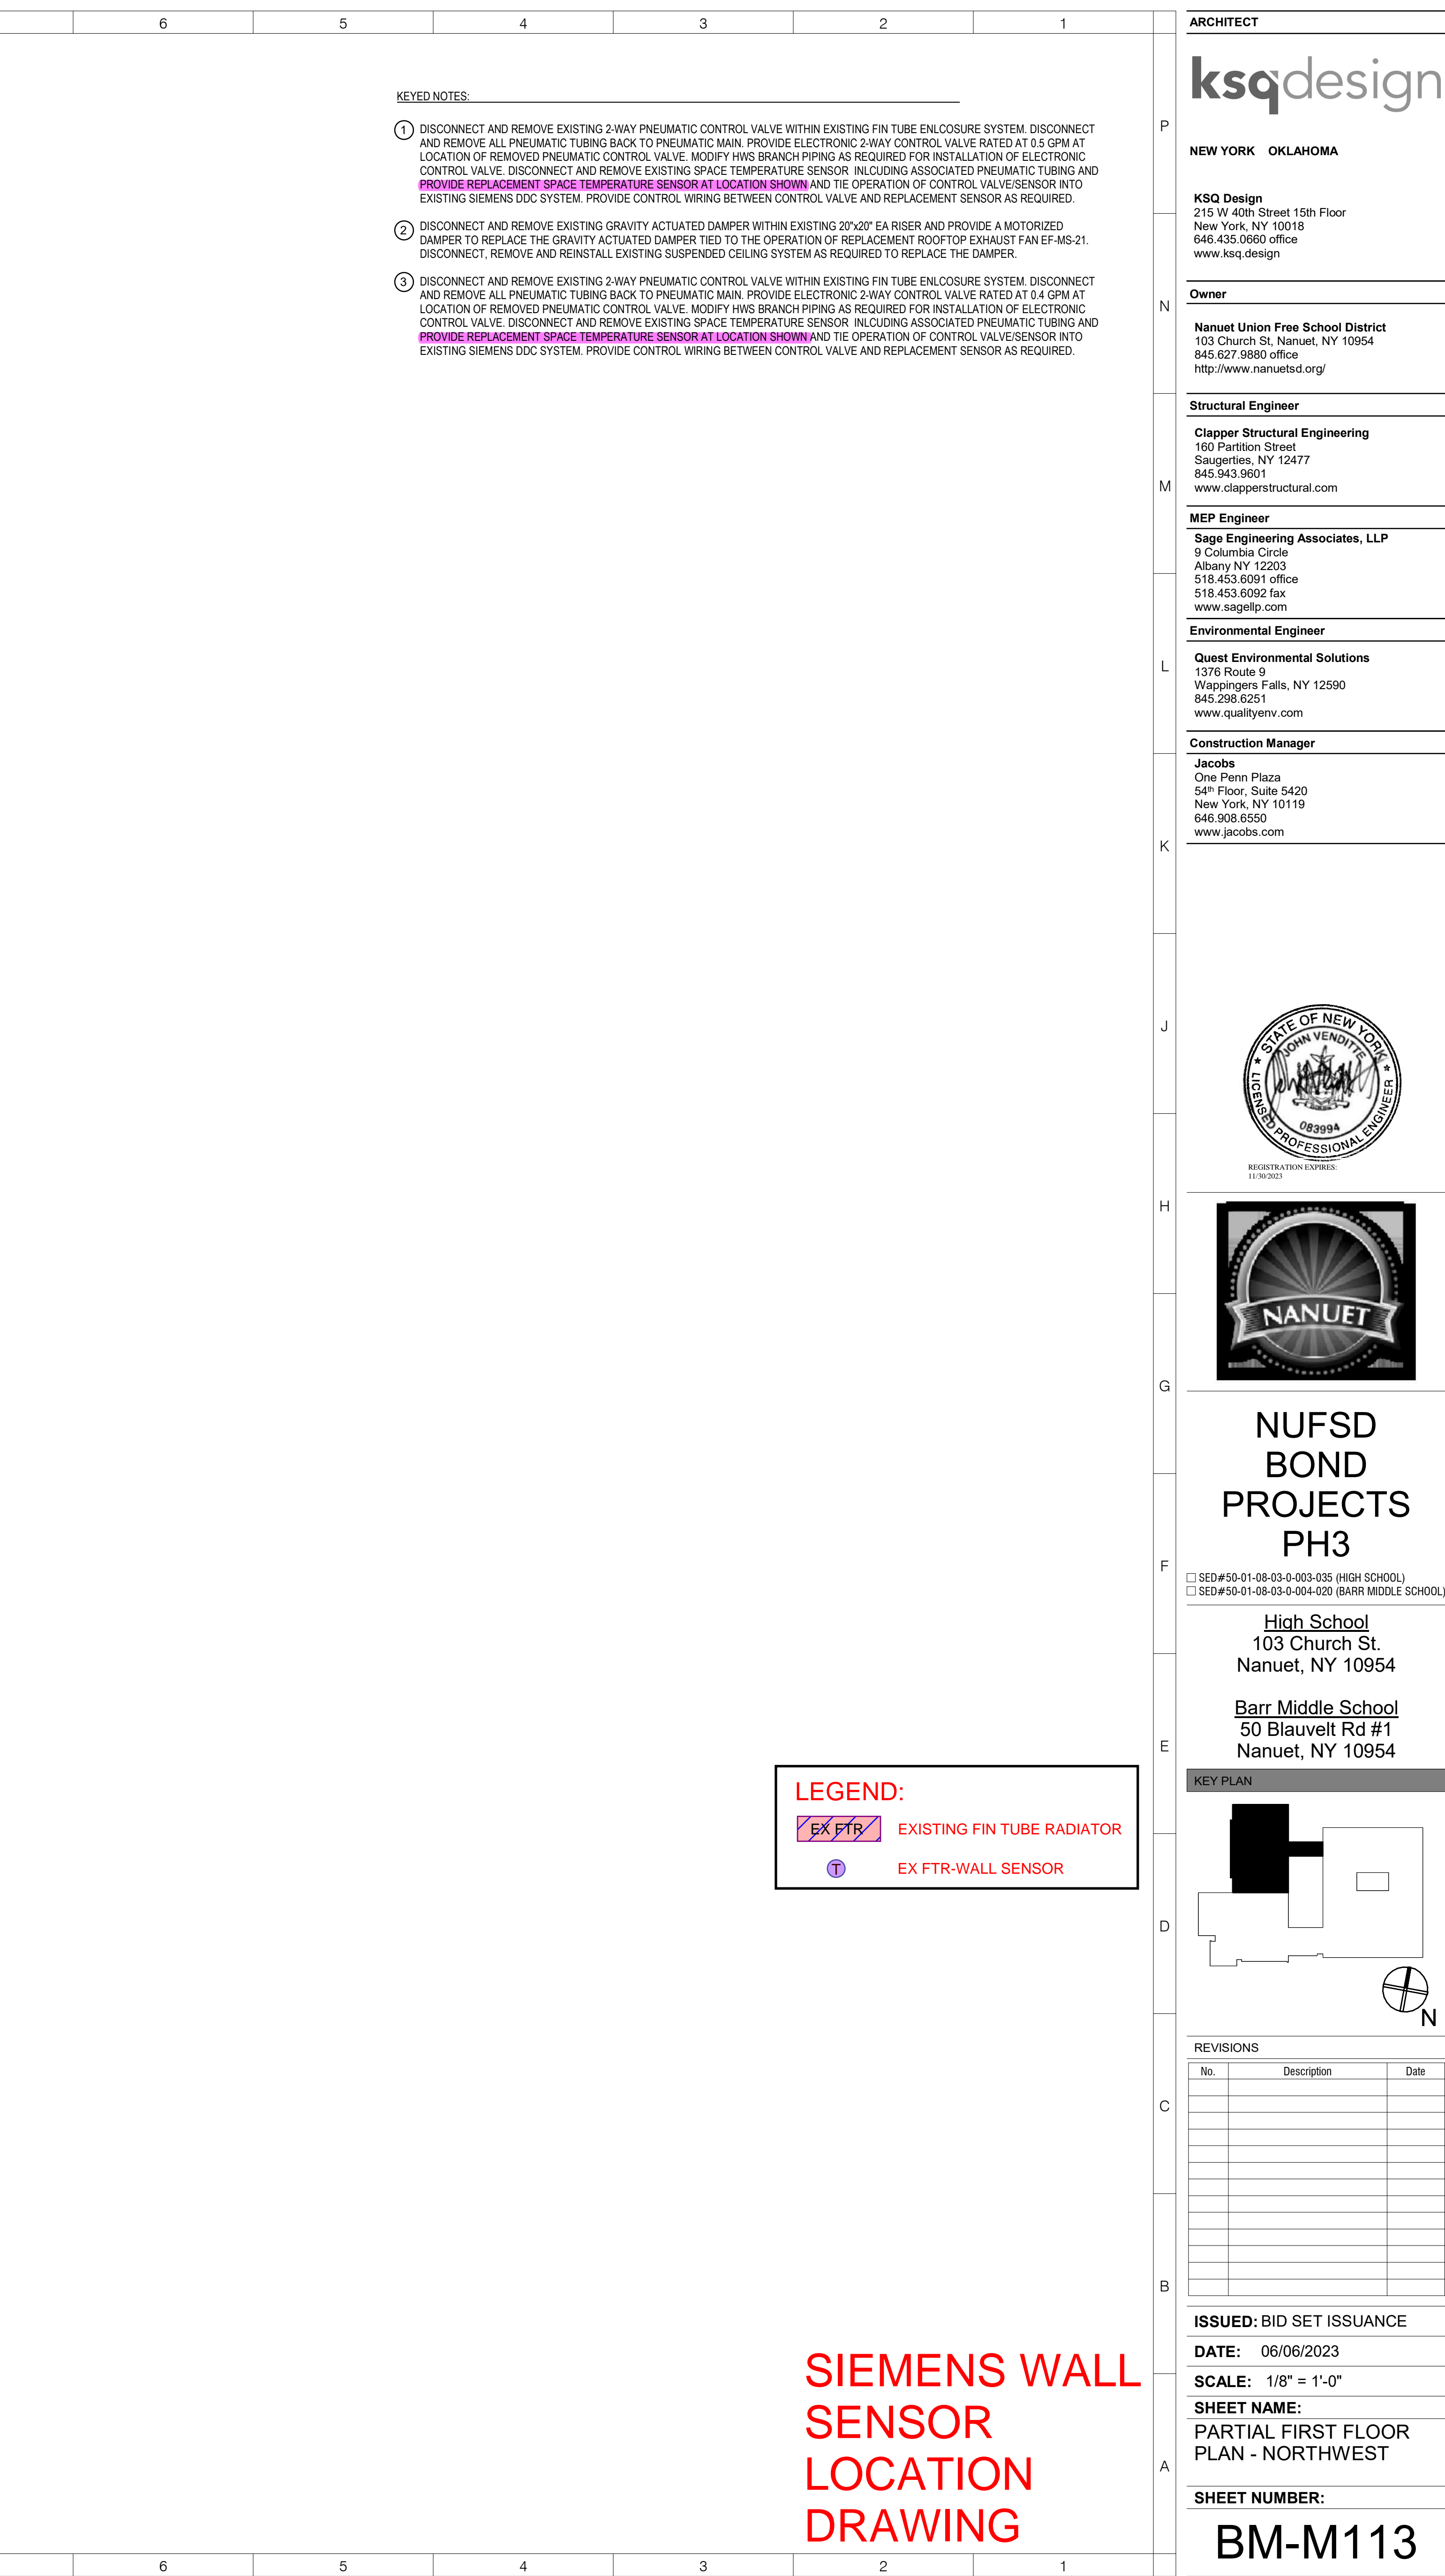

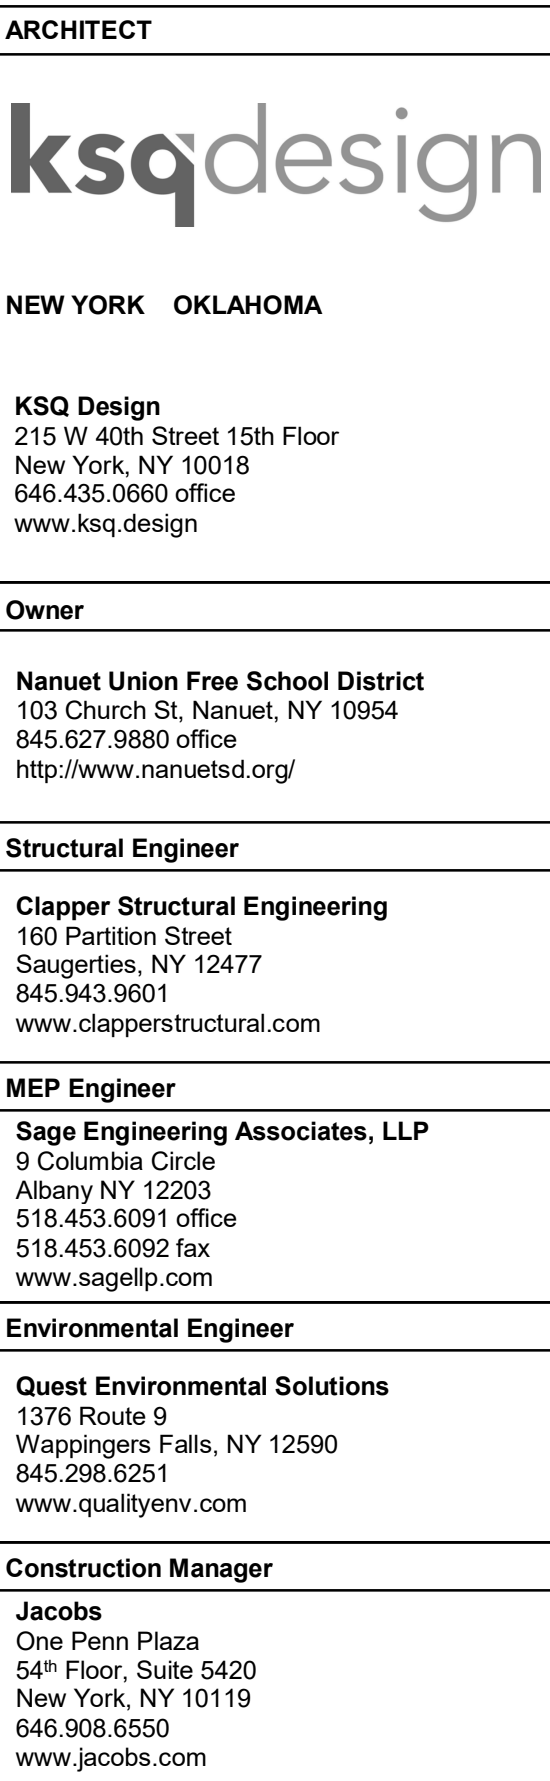


NUFSD
BOND
PROJECTS
PH3

☐ SED#50-01-08-03-0-003-035 (HIGH SCHOOL)
☒ SED#50-01-08-03-0-004-020 (BARR MIDDLE SCHOOL)

High School
103 Church St.
Nanuet, NY 10954

Barr Middle School
50 Blauvelt Rd #1
Nanuet, NY 10954

KEY PLAN

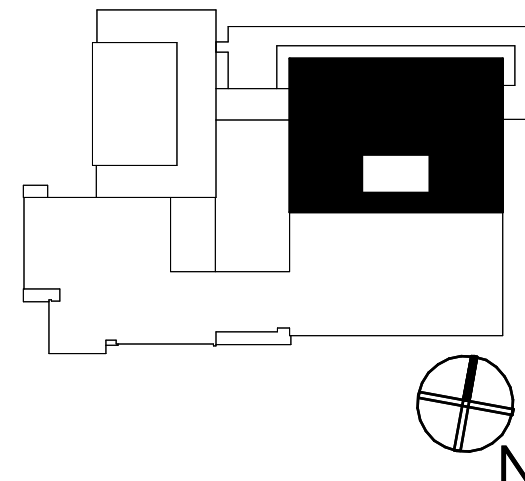[illegible]

ISSUED: BID SET ISSUANCE


DATE: 06/06/2023

SCALE: 1/8" = 1'-0"

SHEET NAME:
PARTIAL SECOND FLOOR
PLAN - NORTHEAST

SHEET NUMBER:

BM-M114

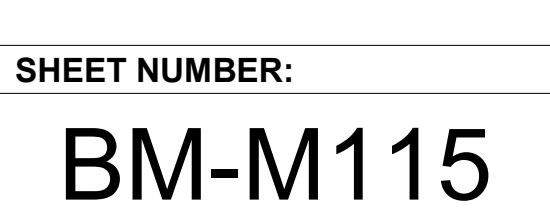



ARCHITECT

ksqdesign

NEW YORK OKLAHOMA

KSQ Design
215 W 40th Street 15th Floor
New York, NY 10018
646.435.0680 office
www.ksq.design

Owner

Nanuet Union Free School District
103 Church St. Nanuet, NY 10954
845.627.9890 office
<http://www.nanuetusd.org/>

Structural Engineer

Clapper Structural Engineering
160 Partition Street
New York, NY 12477
845.943.9601
www.clappersstructural.com

MEP Engineer

Sage Engineering Associates, LLP
9 Columbia Circle
Albany NY 12203
518.453.6091 office
518.453.6092 fax
www.sageelc.com

Environmental Engineer

Quest Environmental Solutions
1376 Route 9
Wappingers Falls, NY 12590
845.298.6251
www.questenv.com

Construction Manager

Jacobs
One Penn Plaza
54th Floor, Suite 5420
New York, NY 10119
646.808.6550
www.jacobs.com




NUFSD
BOND
PROJECTS
PH3

☒ SED#50-01-08-03-0-003-035 (HIGH SCHOOL)
☐ SED#50-01-08-03-0-004-020 (BARR MIDDLE SCHOOL)

High School
103 Church St.
Nanuet, NY 10954

Barr Middle School
50 Blauvelt Rd #1
Nanuet, NY 10954

KEY PLAN

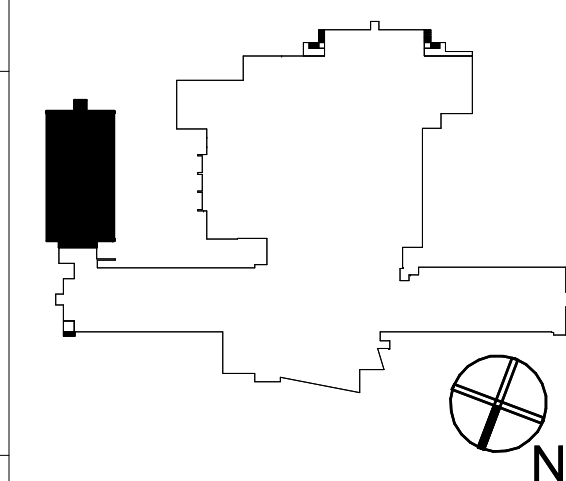[illegible]

ISSUED: BID SET ISSUANCE

DATE: 06/06/2023

SCALE: 1/8" = 1'-0"

SHEET NAME:
2004 ADDITION HVAC
REMOVAL AND INSTALL
PLANS

SHEET NUMBER:

HS-M106

ISSUE FOR BID SET



SIEMENS WALL SENSOR LOCATION DRAWING

HS-M107

ISSUE FOR BID SET

