AFF	ABOVE FINISHED FLOOR
BCU	BUILDING CONTROL UNIT
BTU	BRITISH THERMAL UNIT
CFH	CUBIC FEET PER HOUR
CFM	CUBIC FEET PER MINUTE
CLG	CEILING
COMM.	COMMUNICATION
CV	CONTROL VALVE
(D)	DEMOLISH
DB	DRY BULB
DCV	DEMAND CONTROLLED VENTILATION
DEG. F	DEGREES FAHRENHEIT
DIA	DIAMETER
DX 'E'	DIRECT EXPANSION  ELECTRICAL CONTRACTOR
(E)	EXISTING
EA	EACH
EAT	ENTERING AIR TEMPERATURE
EER	ENERGY EFFICIENCY RATING
ESP	EXTERNAL STATIC PRESSURE
FAI	FRESH AIR INTAKE
FD	FLOOR DRAIN
FLA	FULL LOAD AMPS
FT. H20	FEET OF WATER
'G'	GENERAL CONSTRUCTION CONTRACTOR
GPM	GALLONS PER MINUTE
GPH	GALLONS PER HOUR
Н	HEIGHT
'H'	HVAC CONTRACTOR
НР	HORSEPOWER
IN.	INCHES
IN. W.C. (W.G.)	INCHES WATER COLUMN (WATER GAUGE)
KW	KILOWATTS
L	LENGTH
LAT	LEAVING AIR TEMPERATURE
LBS	POUNDS
LCD	LIQUID CRYSTAL DISPLAY
LDB LWB	LEAVING DRY BULB TEMPERATURE  LEAVING WET BULB TEMPERATURE
LWT	LEAVING WATER TEMPERATURE
M	METER
MAX	MAXIMUM
MBH	1,000 BTU PER HOUR
MCA	MINIMUM CIRCUIT AMPACITY
MIN	MINIMUM
MNF	MANUFACTURER
N.C.	NORMALLY CLOSED
N.O.	NORMALLY OPEN
NFPA	NATIONAL FIRE PROTECTION ASSOCIATION
NPT	NATIONAL PIPE THREAD
NTS	NOT TO SCALE
OAI	OUTDOOR AIR INTAKE
OD	OUTER DIAMETER
OED	OPEN ENDED DUCT
'P'	PLUMBING CONTRACTOR
PD	PRESSURE DROP
PSIG	LBS / SQUARE INCH (GAUGE PRESSURE)
RD	ROOF DRAIN
RPM	REVOLUTIONS PER MINUTE
RPZ	REDUCED PRESSURE ZONE
SAT	SUPPLY AIR TEMPERATURE
SEER	SEASONAL ENERGY EFFICIENCY RATING
TEMP	TEMPERATURE
TG	TRANSFER GRILLE
TYP	TYPICAL
VFD	VARIABLE FREQUENCY DRIVE
W	WIDTH
	WET BUILD
WB	WET BULB

DUCTWORK LEGEND				
SYMBOL	ABBREV	DESCRIPTION		
		DUCTWORK BRANCH CONNECTION		
	VD	VOLUME DAMPER		
Ø	CD	ROUND FACE SUPPLY DIFFUSER		
	SEE AIR DEVICE SCHEDULE	SIDEWALL SUPPLY, RETURN OR EXHAUST GRILLE/REGISTER		
	SEE AIR DEVICE SCHEDULE	SQUARE FACE SUPPLY DIFFUSER		
トカ	SEE AIR DEVICE SCHEDULE	BOTTOM RETURN OR EXHAUST GRILLE/REGISTER		
	FC	FLEXIBLE CONNECTION		
		TURNING VANES		
M		RECTANGULAR TO ROUND TRANSITION		
	AL	ACOUSTICAL LINING		
		END CAP		
	SEE AIR DEVICE SCHEDULE	SUPPLY DIFFUSER WITH DIRECTIONAL FLOW (SOLID HATCH INDICATES BLANK OFF PANEL)		
		SUPPLY DUCT DROP (TURN DOWN)		
		RETURN/EXHAUST DUCT DROP (TURN DOWN)		
		SUPPLY DUCT RISE		
		RETURN/EXHAUST DUCT RISE		
DSD	DSD	DUCT SMOKE DETECTOR		
M	MD	MOTORIZED DAMPER WITH ACTUATOR		
OR OR	AD	ACCESS DOOR		
	FD/AD	FIRE DAMPER WITH ACCESS DOOR		
	FSD/AD	FIRE SMOKE DAMPER WITH ACCESS DOOR		
		FAN		
· <del>/////</del> ,		WORK TO BE REMOVED		
<del></del>		POINT OF DISCONNECTION FROM EXISTING		
•		POINT OF CONNECTION TO EXISTING		

CONTROLS LEGEND		
SYMBOL	ABBREV	DESCRIPTION
©		CARBON MONOXIDE SENSOR
T		THERMOSTAT
S		DIGITAL TEMPERATURE SENSOR
@		CARBON DIOXIDE SENSOR

PIPING LEGEND		
SYMBOL	ABBREV	DESCRIPTION
		NEW WORK
C— O—		PIPING DOWN/ PIPING UP
<b>6</b> C		BALL VALVE WITH HOSE END CONNECTION
<u> </u>	ТН	THERMOMETER
—-  <b>—</b>	U	UNION
	FPC	FLEXIBLE PIPE CONNECTION
<del></del>		DIRECTION OF FLOW
<u> </u>	PSR	PRESSURE SAFETY AND RELIEF VALVE
_ <u>X</u> _	PRV	PRESSURE REDUCING VALVE
<del>-</del> 5-	BV	BALL VALVE
	ВА	BALANCING VALVE
<b>□</b>	BFV	BUTTERFLY VALVE
<b>-</b> Î		TEMPERATURE SENSOR WITH THERMOWELL
$\longrightarrow$	GA	GATE VALVE
	GB	GLOBE VALVE
4	AV	AUTOMATIC AIR VENT
	CV	2-WAY ELECTRONIC CONTROL VALVE
	CV	3-WAY ELECTRONIC CONTROL VALVE
	CV	2-WAY PNEUMATIC CONTROL VALVE
— <del>—</del>	CV	3-WAY PNEUMATIC CONTROL VALVE
<del></del>	STR	STRAINER WITH BLOW OFF VALVE WITH HOSE END CONNECTION
⊕ >	FD	FLOOR DRAIN
S		AIR SEPARATOR
——⊗ <sup>F&amp;T</sup>		STEAM TRAPS (INDICATE TYPE)
<b>→ →</b>	СН	CHECK VALVE
<u></u>	PG	PRESSURE GAUGE WITH GAUGE COCK
	RED	REDUCER
ı	со	CLEANOUT END CAP
		PIPE GUIDE
$\longrightarrow$		PIPE ANCHOR
		CAPPED PIPE
		PUMP
· <del>/////</del> ,		WORK TO BE REMOVED
•		POINT OF DISCONNECTION FROM EXISTING
•		POINT OF CONNECTION TO EXISTING
1/1	TDV	TRIPLE DUTY VALVE
·	l	1

## BMS NOTES:

PROVIDE MATERIALS AND LABOR TO PROVIDE A BMS SYSTEM FOR ALL NEW EQUIPMENT ASSOCIATE WITH THIS PROJECT. SYSTEM SHALL BE WEB BASED USER INTERFACE. BMS SYSTEM SHALL INCLUDE ABILITY FOR COMMAND ENTRY, INFORMATION MANAGEMENT, NETWORK ALARM MANAGEMENT, AND DATABASE MANAGEMENT FUNCTIONS. A REAL TIME CONTROLS FUNCTION, INCLUDING SCHEDULING, HISTORY COLLECTION AND ALARMING SHALL BE RESIDENT IN THE BMS NETWORK. SYSTEM COMMUNICATIONS SHALL BE BACNET ANSI/ASHRAE STANDARD 135-2016 AT ALL LEVELS OF THE ARCHITECTURE. THE BMS SHALL USE AN OPEN ARCHITECTURE AND FULLY SUPPORT A MULTI-VENDOR ENVIRONMENT.

### **GENERAL NOTES**

- 1. PROVIDE ALL MATERIALS AND EQUIPMENT AND PERFORM ALL LABOR REQUIRED TO INSTALL COMPLETE AND OPERABLE MECHANICAL SYSTEMS AS INDICATED ON THE DRAWINGS, AS SPECIFIED AND AS REQUIRED BY CODE.
- 2. THE CONTRACTOR, BY PRESENTING THEIR BID FOR THE WORK, REPRESENTS THAT HE/SHE HAS INSPECTED THE SITE AND IS COMPLETELY FAMILIAR WITH THE SCOPE OF WORK AND ALL FIELD CONDITIONS RELATED TO, AND AFFECTING THE WORK AND ITS PERFORMANCE. EXCEPTIONS AFFECTING THE WORK AND ITS PERFORMANCE, OR CONFLICTS BETWEEN FIELD CONDITIONS, SHALL BE BROUGHT TO THE ATTENTION OF THE ARCHITECT PRIOR TO THE SUBMISSION OF BIDS.
- 3. PERFORM ALL WORK IN ACCORDANCE WITH THE PLUMBING CODE, FIRE CODE, MECHANICAL CODE, ENERGY CONSERVATION CONSTRUCTION CODE, AND FUEL GAS CODE OF NEW YORK STATE AND THE REQUIREMENTS OF THE LOCAL AUTHORITIES HAVING JURISDICTION.
- 4. COMPLY WITH THE NATIONAL ELECTRIC CODE AND THE REQUIREMENTS OF DIVISION 26 FOR ALL ELECTRICAL
- 5. FIRE STOP ALL OPENINGS IN FIRE RATED CONSTRUCTION FOR PIPING, DUCTWORK, CONDUIT, ETC. PROVIDE FIRE DAMPERS AND ACCESS DOORS IN ALL OPENINGS IN FIRE RATED FLOORS, PARTITIONS, AND WALLS FOR DUCTWORK AS PER THE MECHANICAL CODE OF NEW YORK STATE. (SEE ARCHITECTURAL DRAWINGS FOR LOCATIONS OF FIRE RATED CONSTRUCTION.)
- 6. DO NOT SCALE DRAWINGS. DRAWINGS FOR HVAC WORK ARE DIAGRAMMATIC AND ARE INTENDED TO CONVEY SCOPE AND GENERAL ARRANGEMENT ONLY. THE LOCATIONS OF ALL ITEMS SHOWN ON THE DRAWINGS OR CALLED FOR IN THE SPECIFICATIONS THAT ARE NOT DEFINITELY FIXED BY DIMENSIONS ARE APPROXIMATE. COORDINATE CONTRACT DOCUMENTS, PROJECT REQUIREMENTS, WORK OF OTHERS, AND EQUIPMENT AND MATERIALS PURCHASED WITH FIELD DIMENSIONS. INSTALL ALL EQUIPMENT AS PER MANUFACTURER'S REQUIREMENTS TO PROVIDE PROPER CLEARANCE FOR INSTALLATION, OPERATION, AND MAINTENANCE. CONTRACTOR'S INTENDED MEANS AND METHODS OF INSTALLATION AND CONTRACTOR'S FABRICATED ITEMS SHALL ENSURE A PROPER "FIT" AND INSTALLATION. BRING ANY CONFLICTS TO THE ATTENTION OF THE ARCHITECT/ENGINEER DURING THE SUBMITTAL PHASE FOR RESOLUTION PRIOR TO PURCHASING ANY EQUIPMENT.
- 7. MAINTAIN MAXIMUM HEADROOM AND SPACE CONDITIONS AT ALL POINTS. WHERE HEADROOM AND SPACE CONDITIONS APPEAR INADEQUATE, NOTIFY THE ARCHITECT/ENGINEER PRIOR TO PROCEEDING WITH INSTALLATION. MAINTAIN A MINIMUM OF 6'-8" CLEARANCE FROM FINISHED FLOOR TO UNDERSIDE OF PIPES, DUCTS, CONDUITS, SUSPENDED EQUIPMENT, ETC., THROUGHOUT ACCESS ROUTES IN MECHANICAL ROOMS.
- 8. FIELD VERIFY AND COORDINATE ALL DUCT AND PIPING DIMENSIONS BEFORE FABRICATION. MAKE MODIFICATIONS IN THE LAYOUT AS NEEDED TO PREVENT CONFLICT WITH WORK OF OTHER TRADES OR FOR PROPER EXECUTION OF THE WORK. OBTAIN THE APPROVAL OF THE ARCHITECT/ENGINEER FOR MODIFICATIONS.
- 9. PROVIDE PRODUCTS OF ONE MANUFACTURER WHERE TWO OR MORE ITEMS OF THE SAME TYPE OF MATERIAL OR EQUIPMENT IS REQUIRED.
- 10. INSTALL ALL EQUIPMENT AND APPURTENANCES IN ACCORDANCE WITH MANUFACTURER'S RECOMMENDATIONS, CONTRACT DOCUMENTS, AND APPLICABLE CODES AND REGULATIONS. REFER TO DETAILS FOR ADDITIONAL PIPING AND EQUIPMENT INSTALLATION REQUIREMENTS.
- 11. LOCATE ALL TEMPERATURE, PRESSURE, AND FLOW MEASURING DEVICES IN ACCESSIBLE LOCATIONS WITH STRAIGHT SECTION OF PIPE OR DUCT UP- AND DOWNSTREAM AS RECOMMENDED BY THE MANUFACTURER TO ENSURE MANUFACTURER CERTIFIED ACCURACY.
- 12. COORDINATE ALL EQUIPMENT CONNECTIONS WITH MANUFACTURER'S CERTIFIED DRAWINGS. COORDINATE AND PROVIDE ALL PIPING AND DUCT TRANSITIONS REQUIRED FOR FINAL CONNECTIONS TO EQUIPMENT.
- 13. COORDINATE LOCATIONS AND SIZES OF ALL FLOOR, WALL, AND ROOF OPENINGS WITH ALL OTHER TRADES. COORDINATE ALL PIPING AND EQUIPMENT SUPPORTED FROM STRUCTURE WITH GENERAL CONSTRUCTION
- 14. COORDINATE INSTALLATION OF SUPPLY AND RETURN GRILLES WITH INSTALLATION OF FINISHED CEILINGS.
- 15. COMPLETE ALL PRESSURE TESTS BEFORE ANY MECHANICAL EQUIPMENT, DUCTWORK, OR PIPING INSULATION IS APPLIED.
- 16. TESTING, ADJUSTING, AND BALANCING AGENCY SHALL BE A MEMBER OF THE ASSOCIATED AIR BALANCE COUNCIL (AABC) OR THE NATIONAL ENVIRONMENTAL BALANCING BUREAU (NEBB). PERFORM ALL TESTING, ADJUSTING, AND BALANCING IN ACCORDANCE WITH THE SPECIFICATIONS.
- 17. MAKE ALL ATTACHMENTS TO JOISTS, TRUSSES, OR JOIST GIRDERS AT PANEL POINTS. PROVIDE BEAM CLAMPS
- 18. PROVIDE CONCRETE PADS FOR ALL FLOOR MOUNTED EQUIPMENT. EXTEND PAD 6 INCHES BEYOND THE EQUIPMENT ON ALL SIDES.
- 19. LINE ALL SUPPLY AND RETURN DUCTWORK WITHIN 20 FEET UPSTREAM AND DOWNSTREAM OF FANS WITH 1"

THICK INSULATION. SEE DRAWINGS AND SPECIFICATIONS FOR ADDITIONAL REQUIREMENTS.

- 20. PROVIDE TRAPPED DRAIN PIPING FROM DRAIN PANS OF ALL COOLING COILS, FANS, AND OTHER ACTIVE DRAINS EXPOSED TO SYSTEM AIR STREAM. PROVIDE TRAP AT CONNECTION, WATER SEAL DEPTH 1 INCH GREATER THAN UNIT OPERATING PRESSURE. DIRECT DRAINS TO NEAREST FLOOR DRAIN, MOP SINK, OR OTHER LOCATION
- 21. INSTALL PIPING, DUCTWORK, AND CONDUIT CONCEALED IN AREAS HAVING HUNG CEILINGS AND/OR FURRED SPACES UNLESS OTHERWISE INDICATED ON THE DRAWINGS.


### SCOPE NOTES

- 1. SUBMIT LOUVER COLOR AND CONFIGURATION TO THE ARCHITECT/ENGINEER FOR APPROVAL.
- 2. INSTALL SMOKE DETECTORS IN DUCTWORK FOR AIR HANDLING UNITS RATED AT 2,000 CFM OR GREATER.
- 3. FURNISH AND INSTALL ALL NECESSARY CONTROL WIRING, CONDUIT, AND ACCESSORIES AS REQUIRED TO PROVIDE FULLY FUNCTIONING SYSTEMS AND SEQUENCES OF OPERATION.
- 4. REMOVE CHASE ENCLOSURE COVER WHEN PERFORMING WORK IN ANY CHASE, AND REINSTALL THE CHASE ENCLOSURE COVER WHEN WORK IS COMPLETE.
- 5. PERFORM ALL CUTTING AND ROUGH PATCHING AS REQUIRED IN THE EXECUTION OF THE WORK.

### LEGENDS/ABBREVIATIONS NOTES

APPROVED BY THE ARCHITECT/ENGINEER.

1. ABBREVIATIONS AND SYMBOLS ON THIS SHEET DO NOT DEFINE THE SCOPE OF WORK.

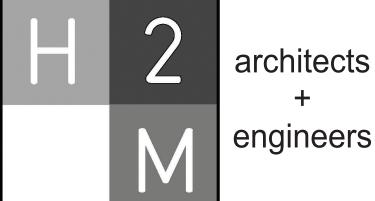

538 Broad Hollow Road, 4th Floor East Melville, NY 11747 631.756.8000 • www.h2m.com

SINGOLIAINIO.		

DESCRIPTION

П		
П		

MARK DATE



DKR MJV VGFD2001 JULY 2022 AS SHOWN

## **VAILS GATE FIRE DISTRICT**

New Storage Building (Phase I) New Fire Station (Phase II)




**872 Blooming Grove Turnpike** New Windsor, NY 12553

**CONTRACT G GENERAL CONSTRUCTION** 

FINAL BID DOCUMENT

**HVAC LEGENDS, SYMBOLS,** ABBREVIATIONS, AND **GENERAL NOTES** 

M2 001.00

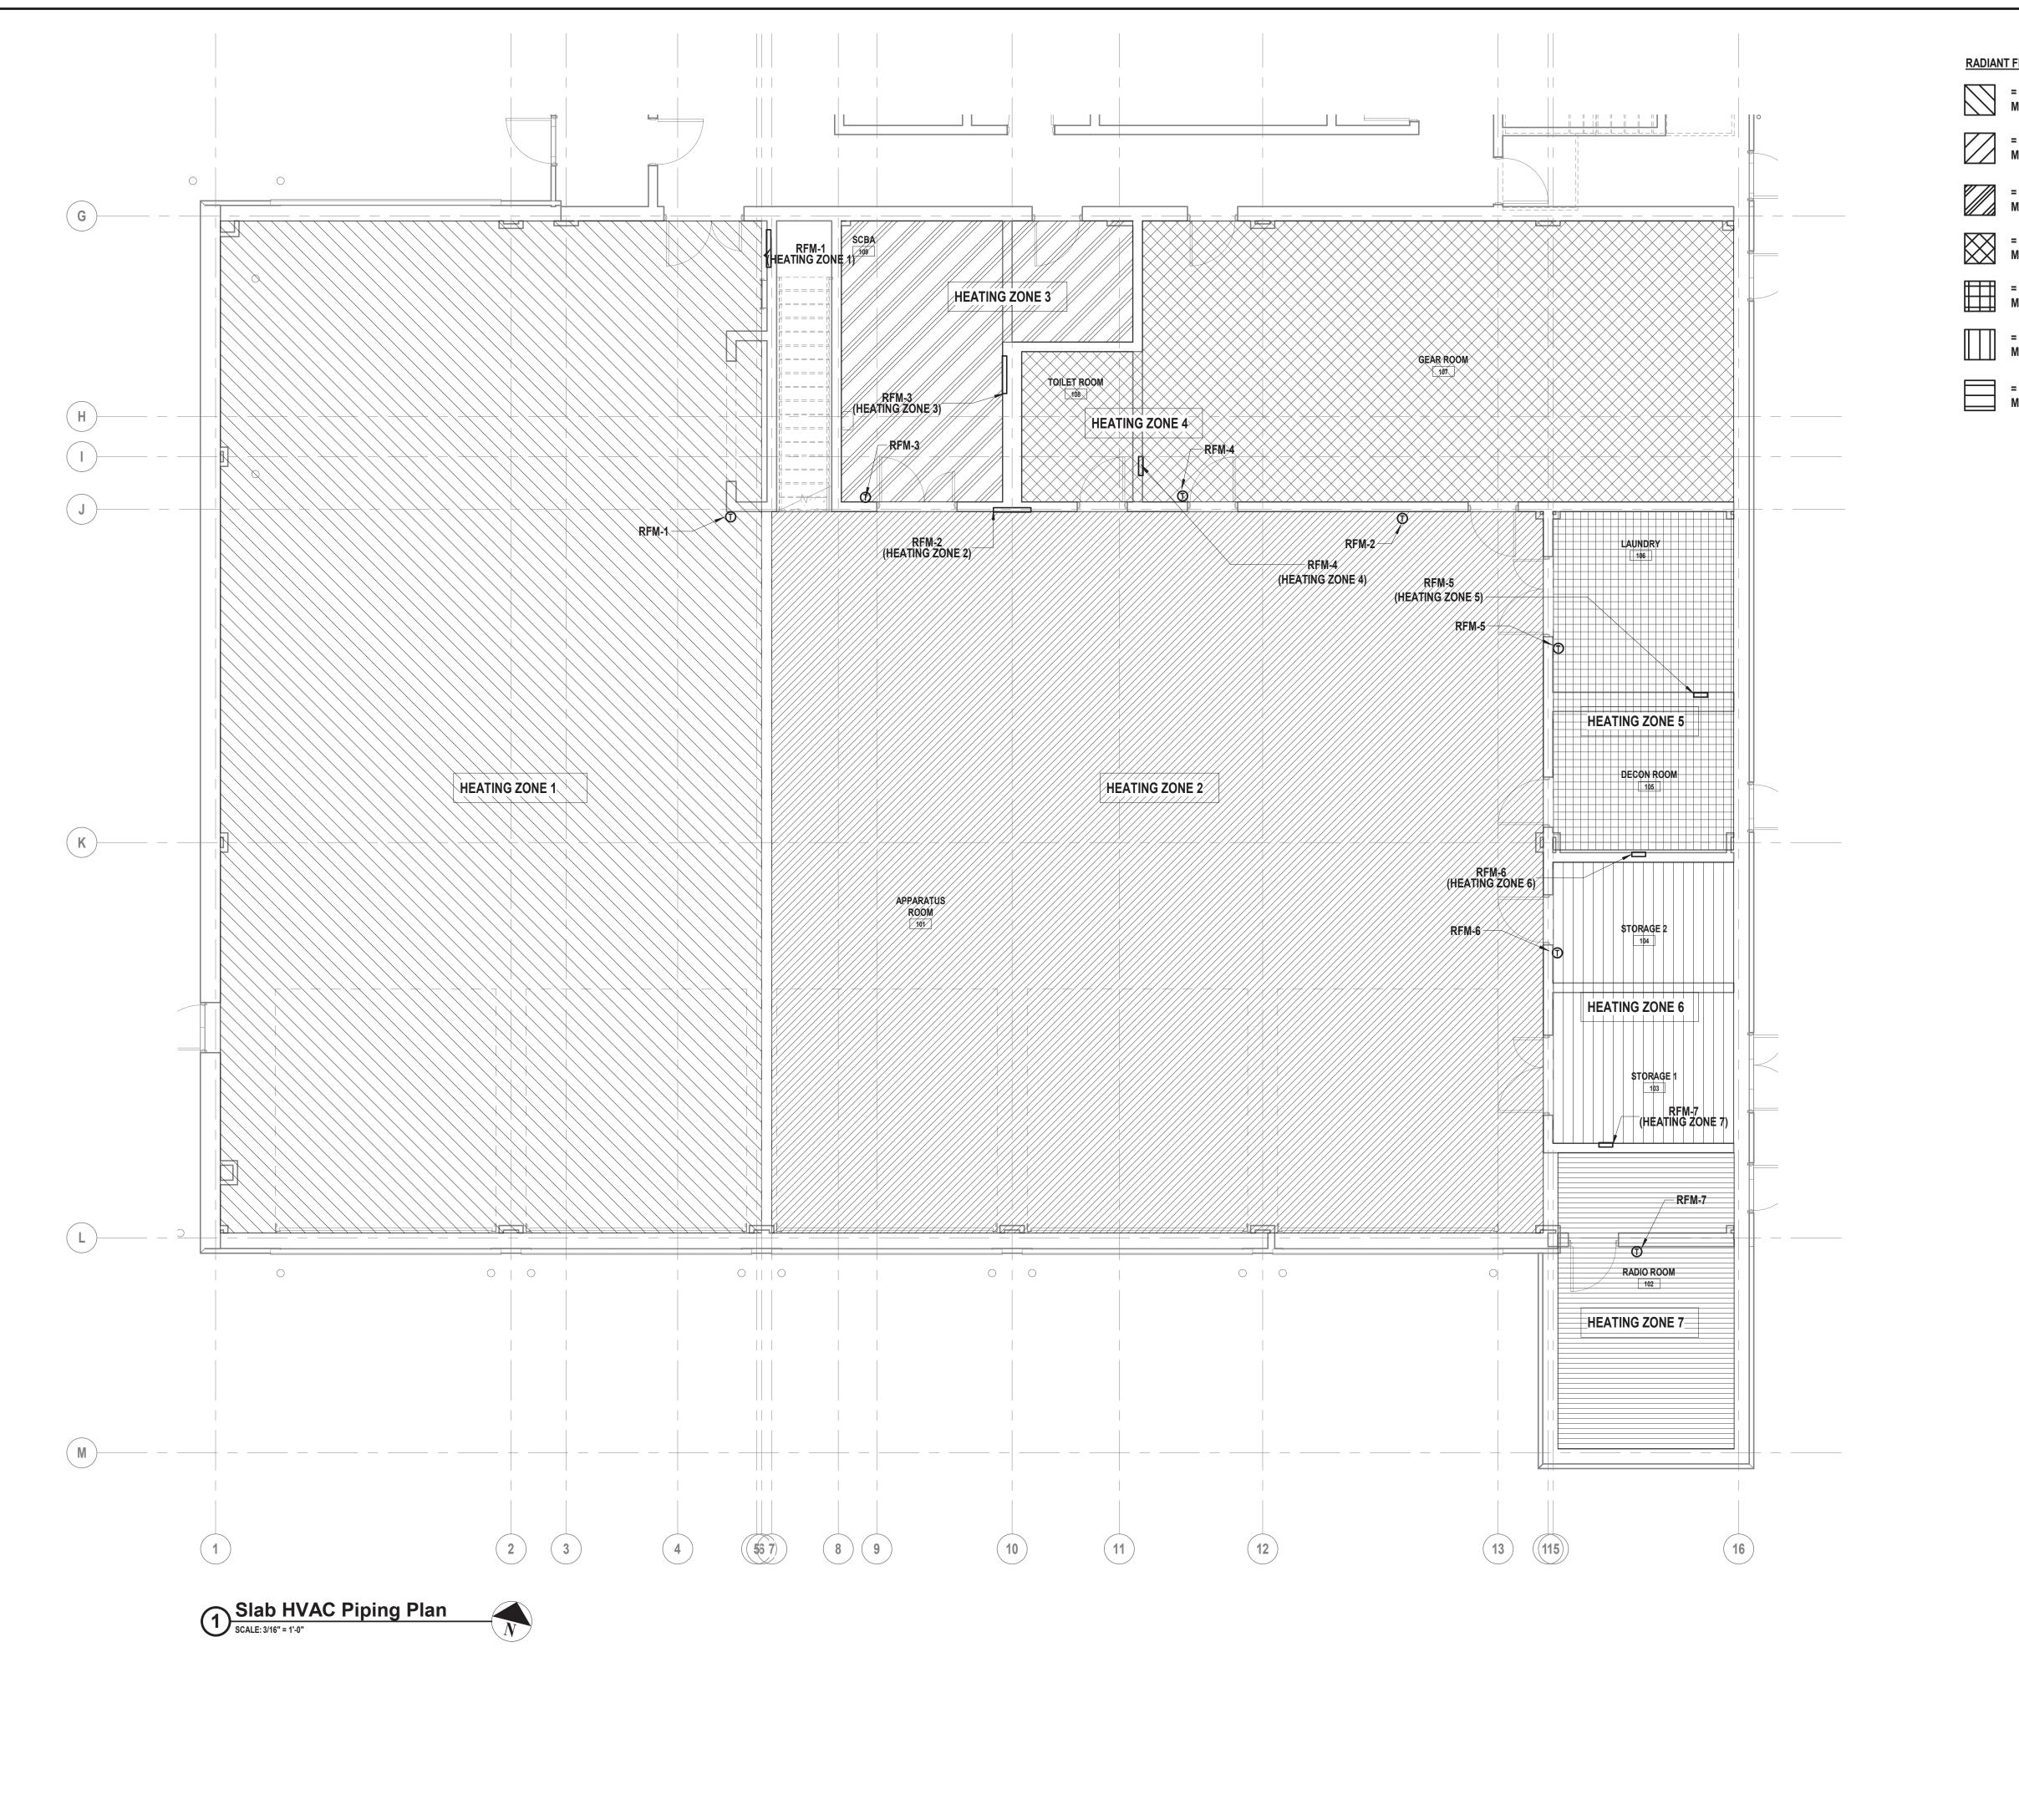

RADIANT FLOOR ZONE LEGEND:

= ZONE 1, CONTAINS RADIANT FLOOR PIPING WITH 10 CIRCUITS TO MANIFOLD RFM-1.

= ZONE 2, CONTAINS RADIANT FLOOR PIPING WITH 10 CIRCUITS TO MANIFOLD RFM-2.

= ZONE 3, CONTAINS RADIANT FLOOR PIPING WITH 2 CIRCUITS TO MANIFOLD RFM-3.

= ZONE 4, CONTAINS RADIANT FLOOR PIPING WITH 4 CIRCUITS TO MANIFOLD RFM-4.

= ZONE 5, CONTAINS RADIANT FLOOR PIPING WITH 2 CIRCUITS TO MANIFOLD RFM-5.




= ZONE 6, CONTAINS RADIANT FLOOR PIPING WITH 2 CIRCUITS TO MANIFOLD RFM-6.

= ZONE 7, CONTAINS RADIANT FLOOR PIPING WITH 2 CIRCUITS TO MANIFOLD RFM-7.


AREA OF WORK

Key Plan SCALE: N.T.S.

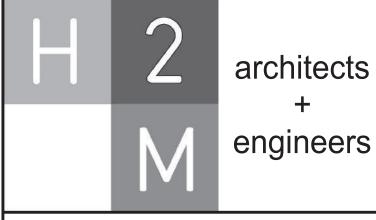

538 Broad Hollow Road, 4th Floor East Melville, NY 11747 631.756.8000 • www.h2m.com

MARK	DATE	DESCRIPTION

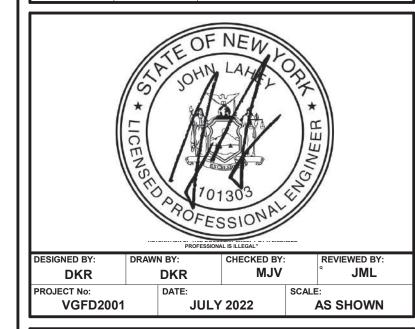

# **VAILS GATE FIRE DISTRICT**

New Storage Building (Phase I) New Fire Station (Phase II)




872 Blooming Grove Turnpike New Windsor, NY 12553


**CONTRACT G GENERAL CONSTRUCTION** 


FINAL BID DOCUMENT

SLAB HVAC PIPING PLAN AREA A

M2 100A.00

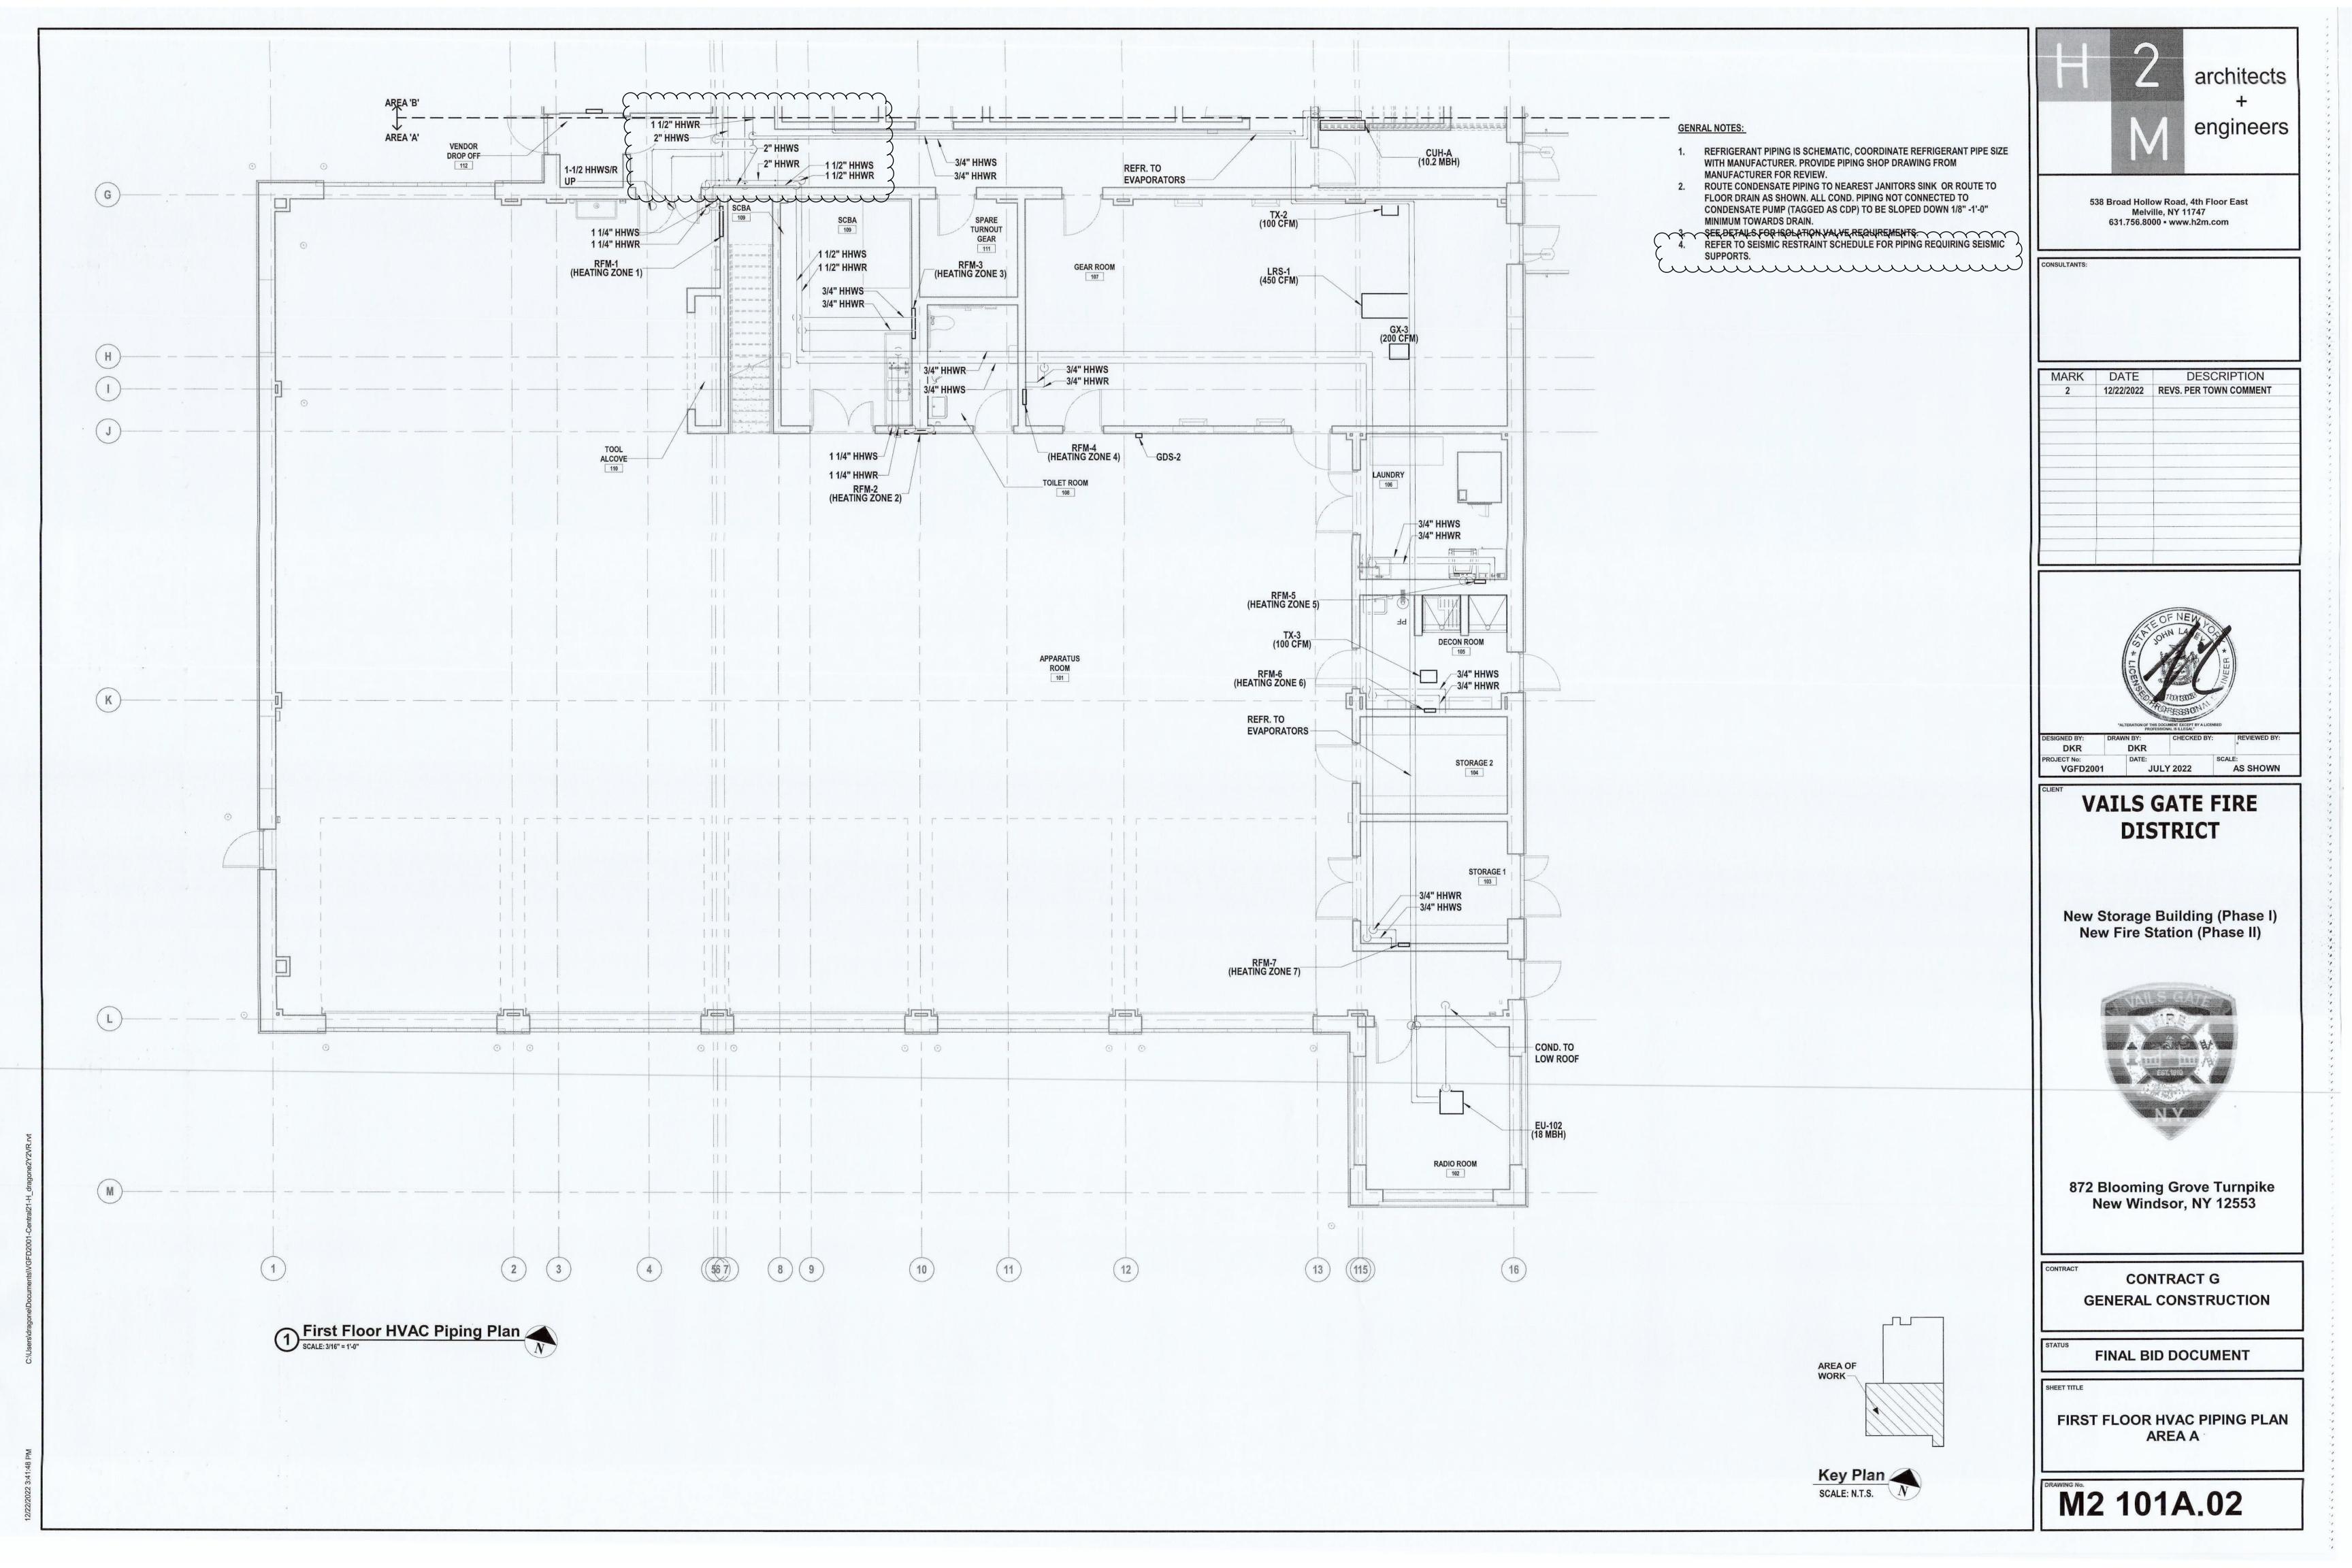

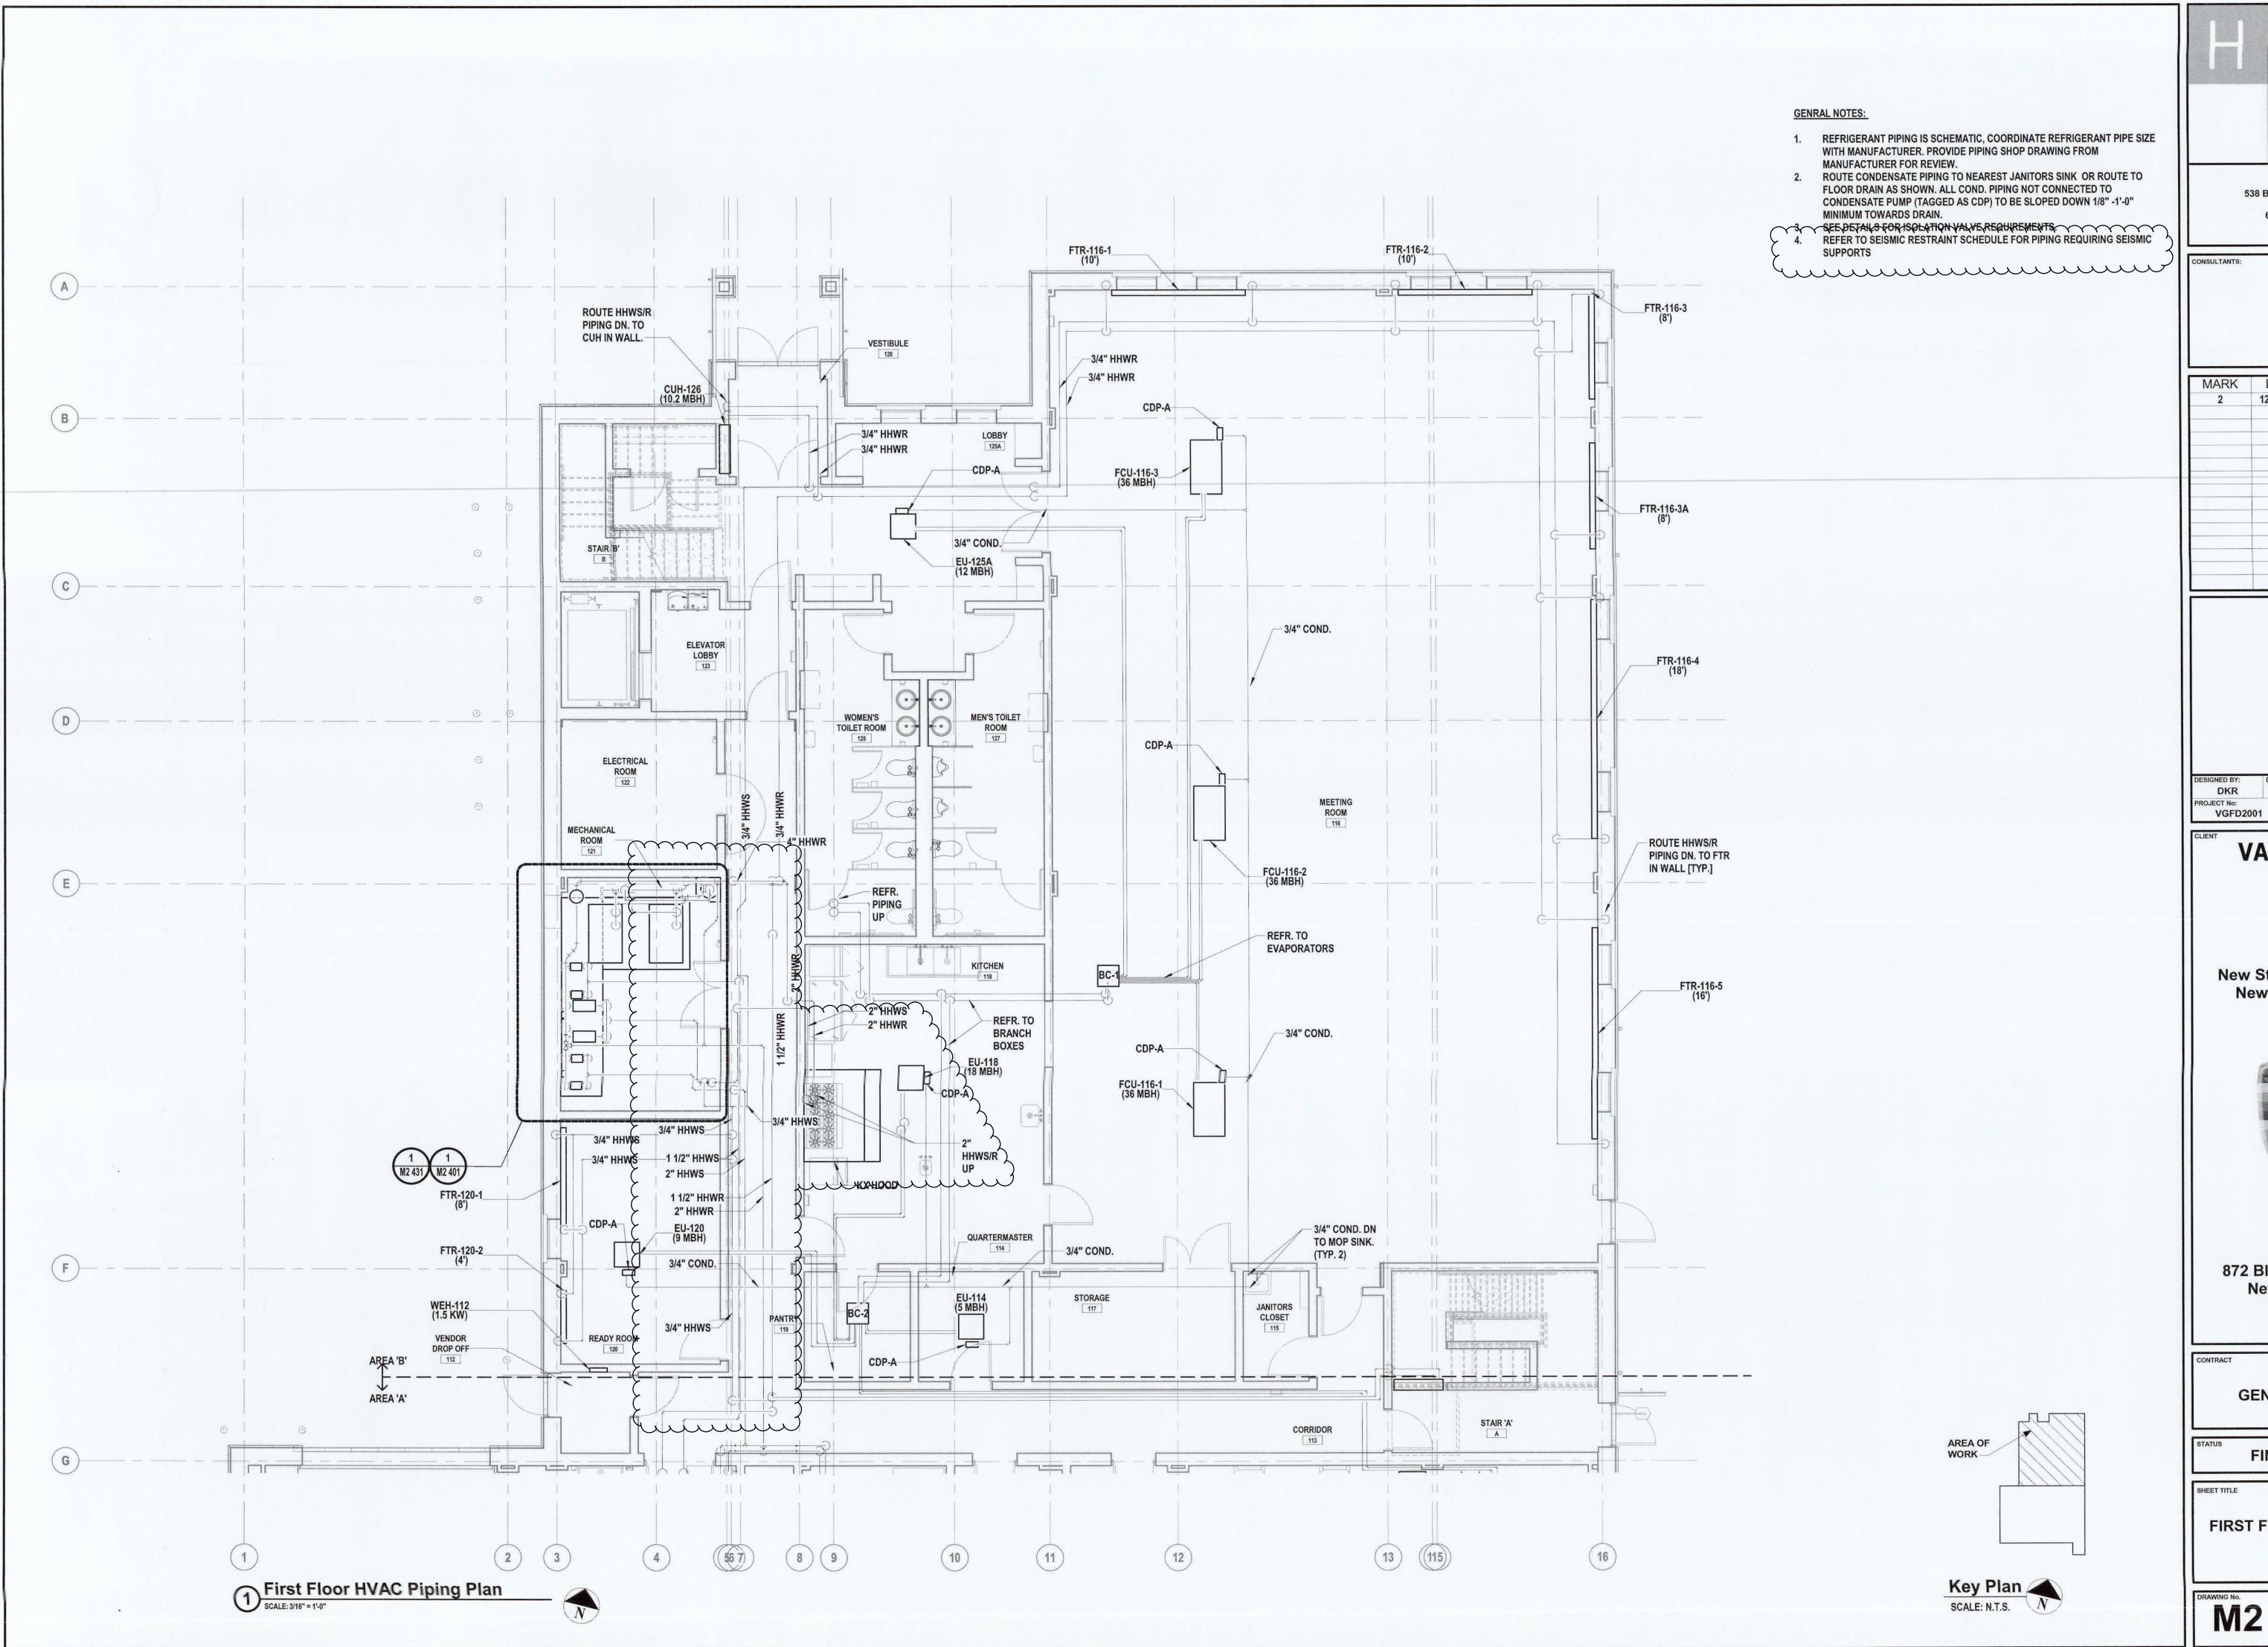

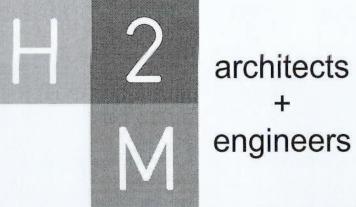

DESCRIPTION 12/22/2022 REVS. PER TOWN COMMENT



## **VAILS GATE FIRE DISTRICT**

JULY 2022 AS SHOWN

New Storage Building (Phase I) New Fire Station (Phase II)




872 Blooming Grove Turnpike New Windsor, NY 12553

**CONTRACT G GENERAL CONSTRUCTION** 

FINAL BID DOCUMENT

FIRST FLOOR HVAC PIPING PLAN AREA B

M2 101B.02

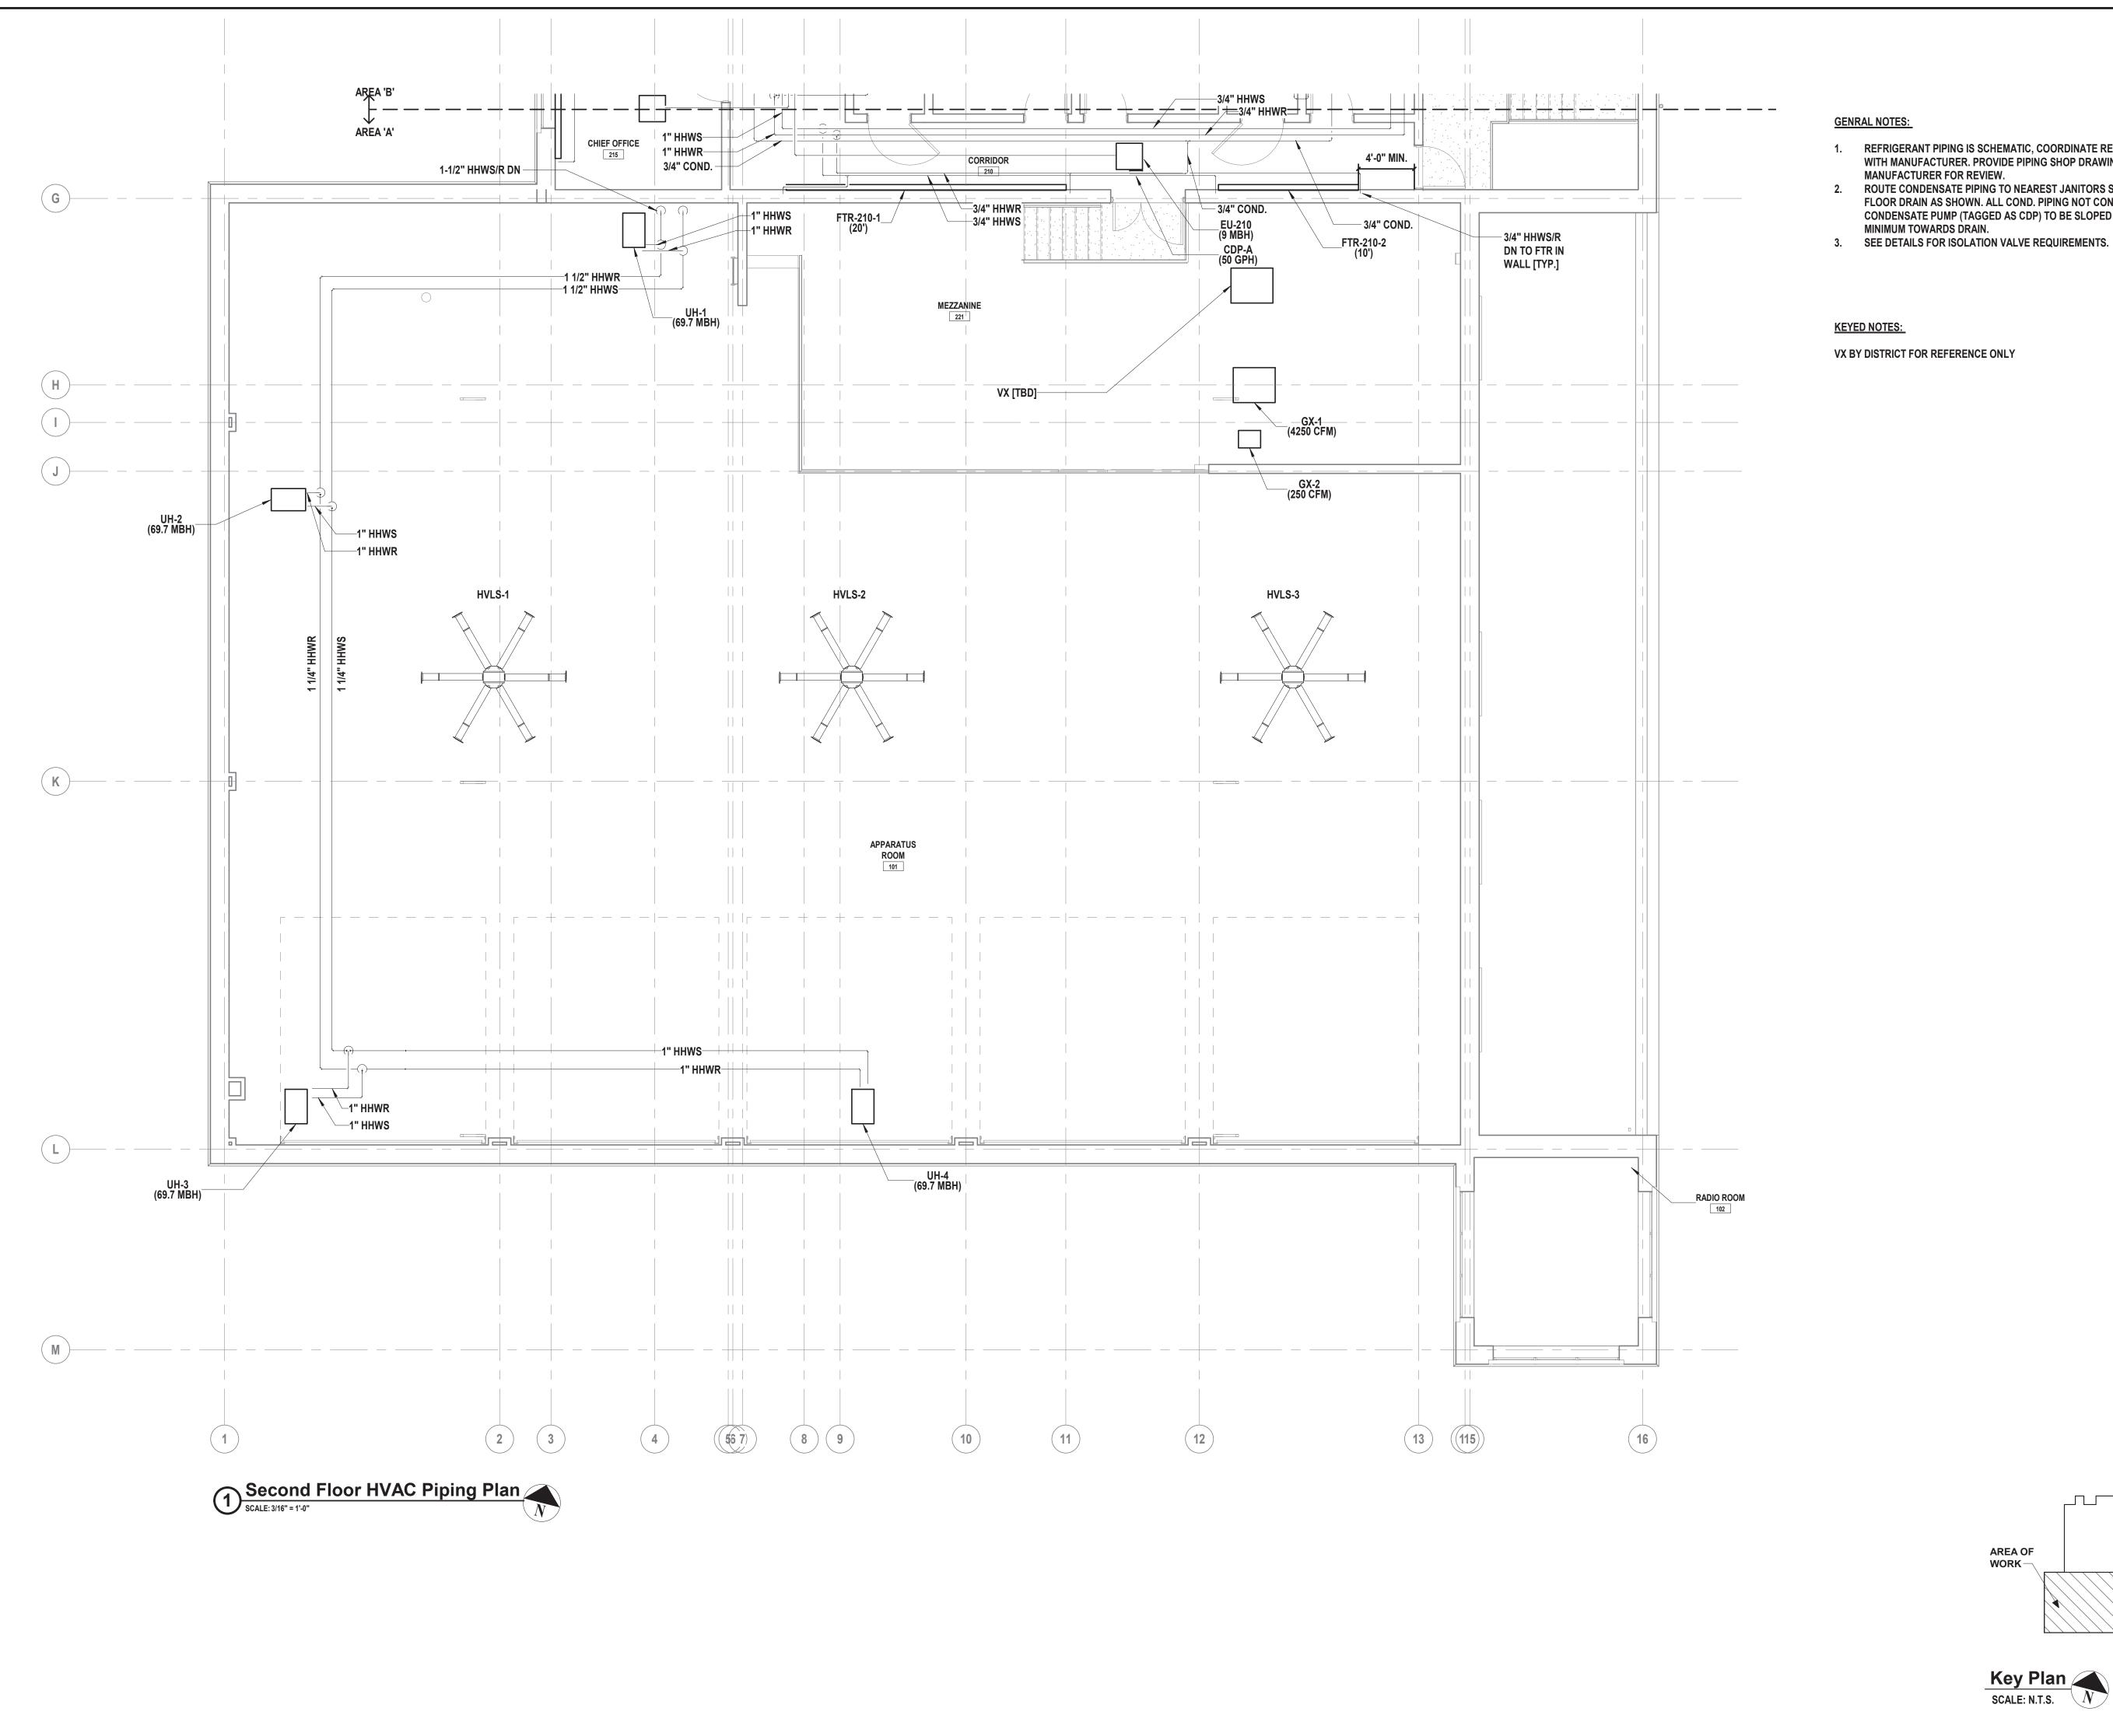

- REFRIGERANT PIPING IS SCHEMATIC, COORDINATE REFRIGERANT PIPE SIZE WITH MANUFACTURER. PROVIDE PIPING SHOP DRAWING FROM
  - ROUTE CONDENSATE PIPING TO NEAREST JANITORS SINK OR ROUTE TO FLOOR DRAIN AS SHOWN. ALL COND. PIPING NOT CONNECTED TO CONDENSATE PUMP (TAGGED AS CDP) TO BE SLOPED DOWN 1/8" -1'-0"
- 3. SEE DETAILS FOR ISOLATION VALVE REQUIREMENTS.




538 Broad Hollow Road, 4th Floor East Melville, NY 11747

631.756.8000 • www.h2m.com

architects

ONSULTANTS:		

MARK	DATE	DESCRIPTION

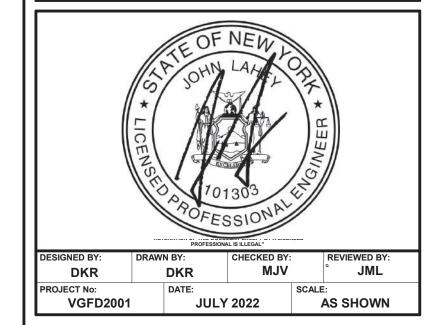

## **VAILS GATE FIRE DISTRICT**

New Storage Building (Phase I)
New Fire Station (Phase II)




872 Blooming Grove Turnpike New Windsor, NY 12553


**CONTRACT G GENERAL CONSTRUCTION** 

FINAL BID DOCUMENT


SECOND FLOOR HVAC PIPING PLAN **AREA A** 

M2 102A.00

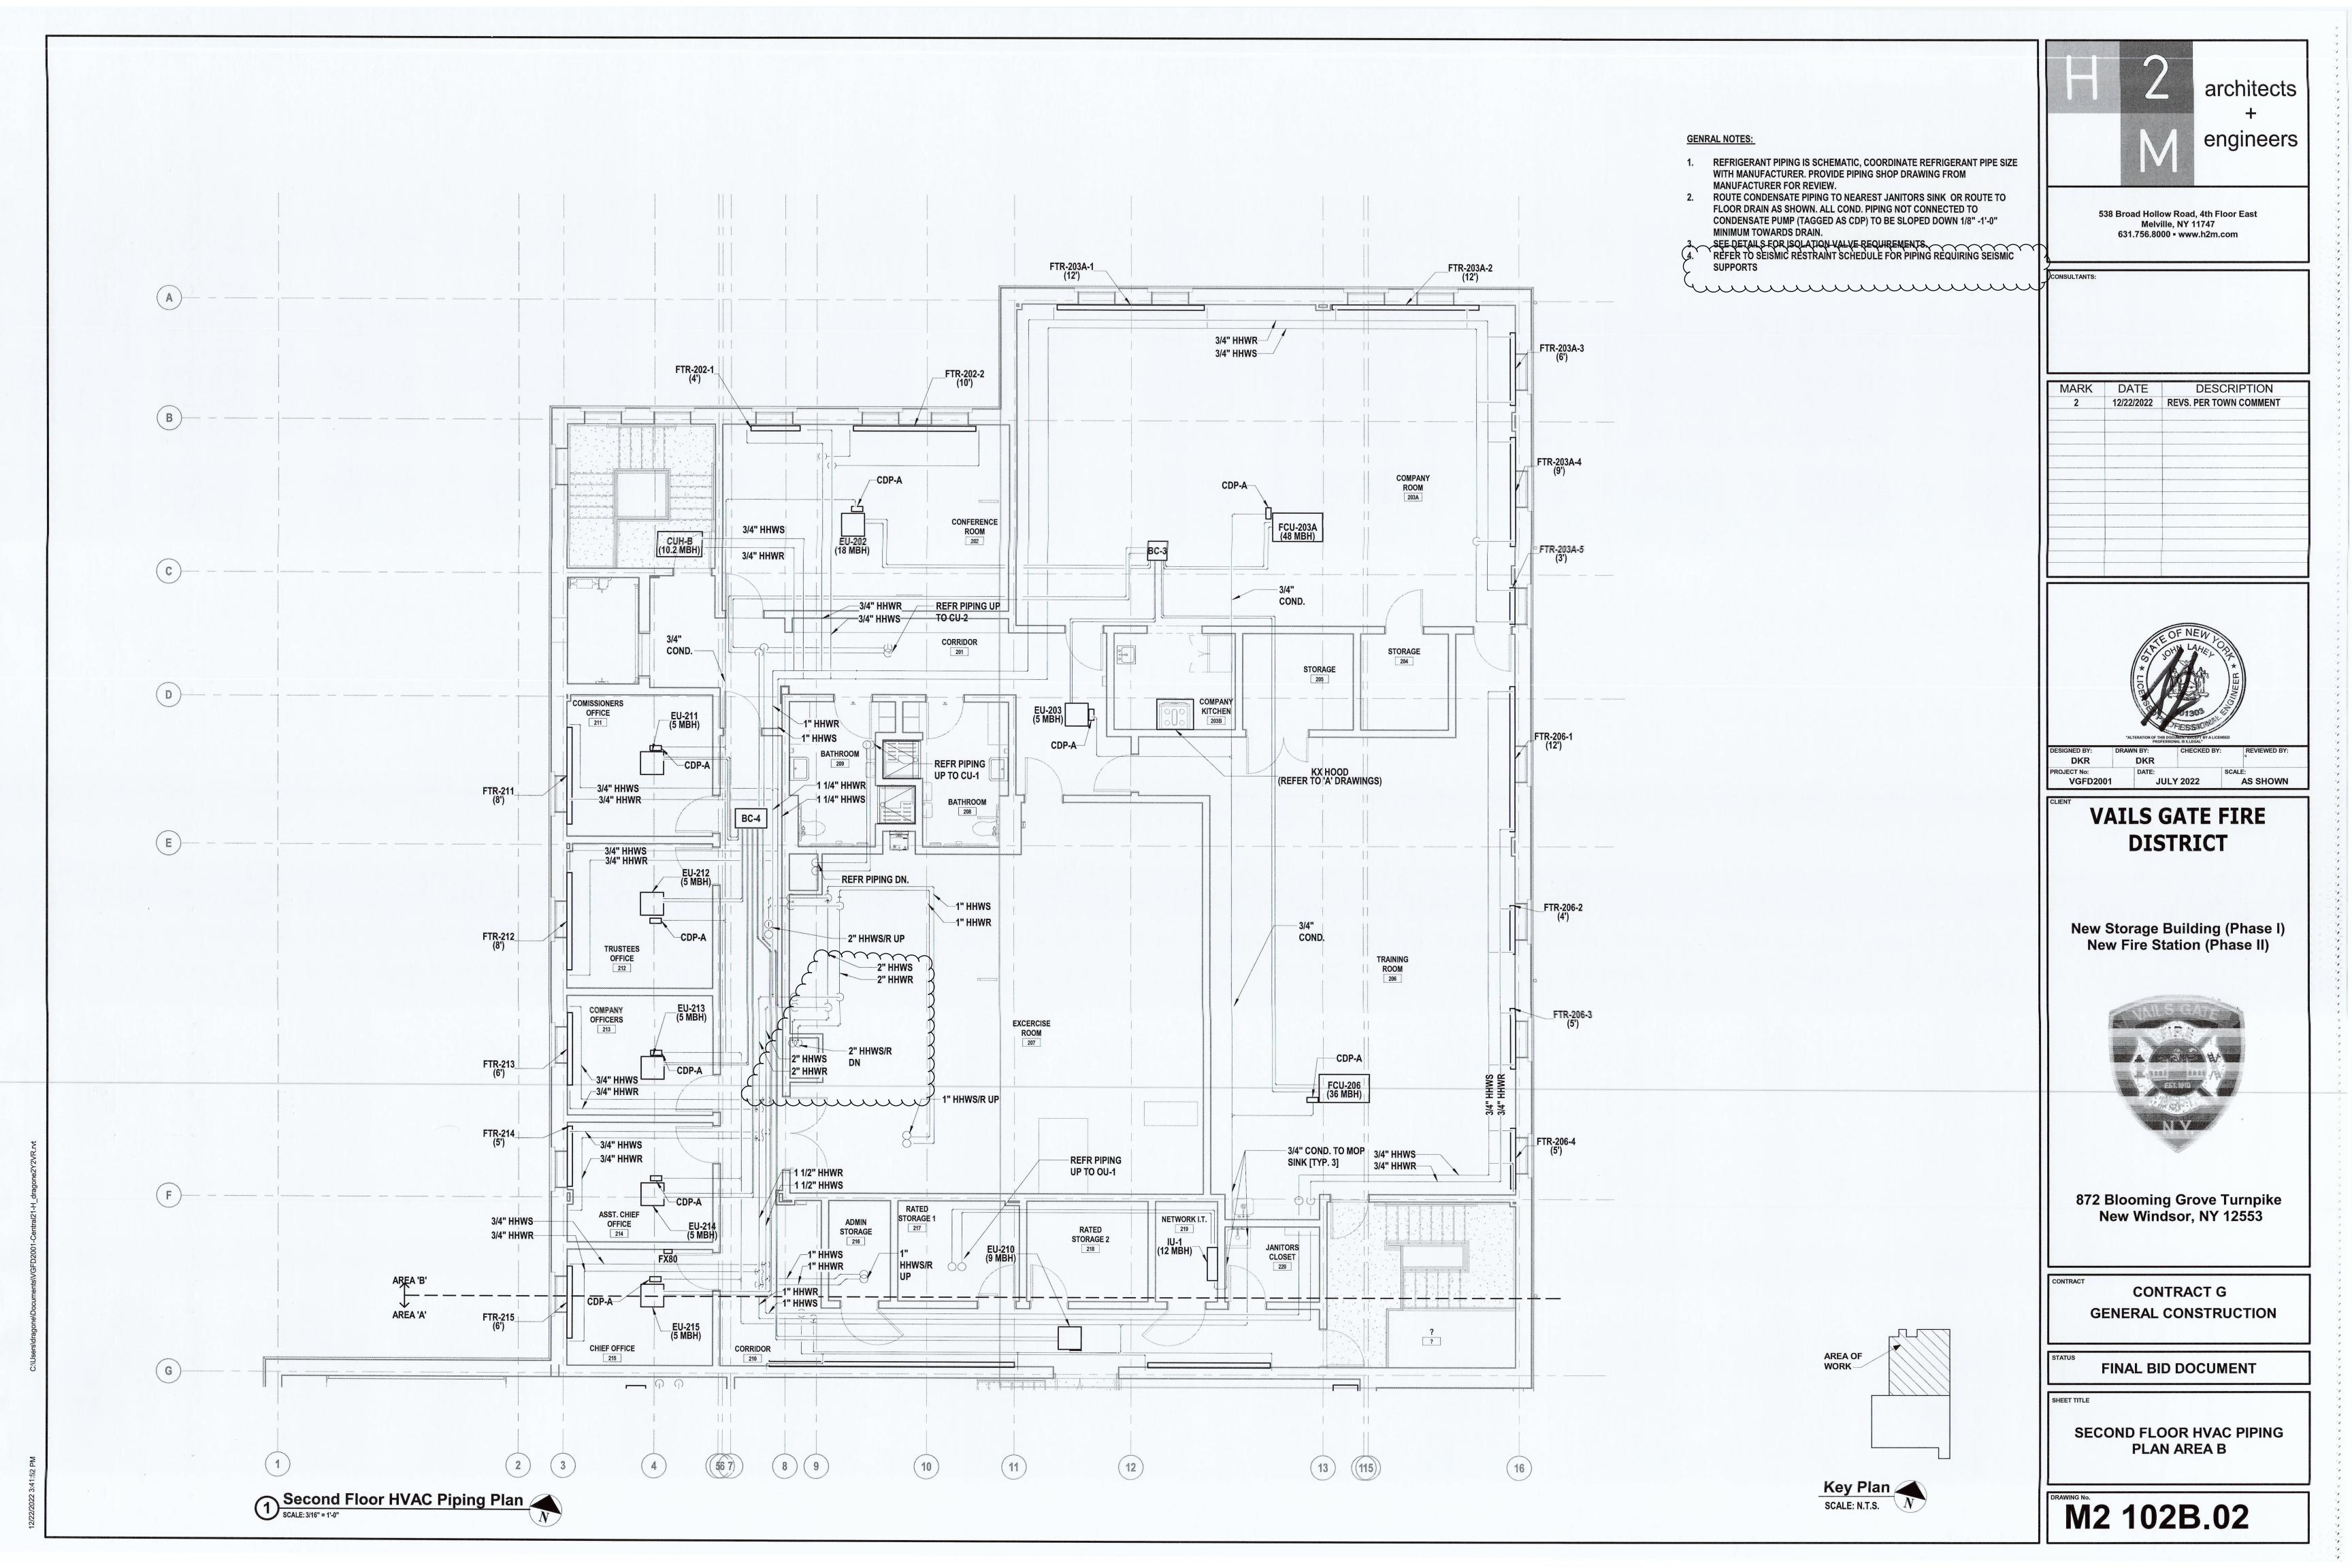


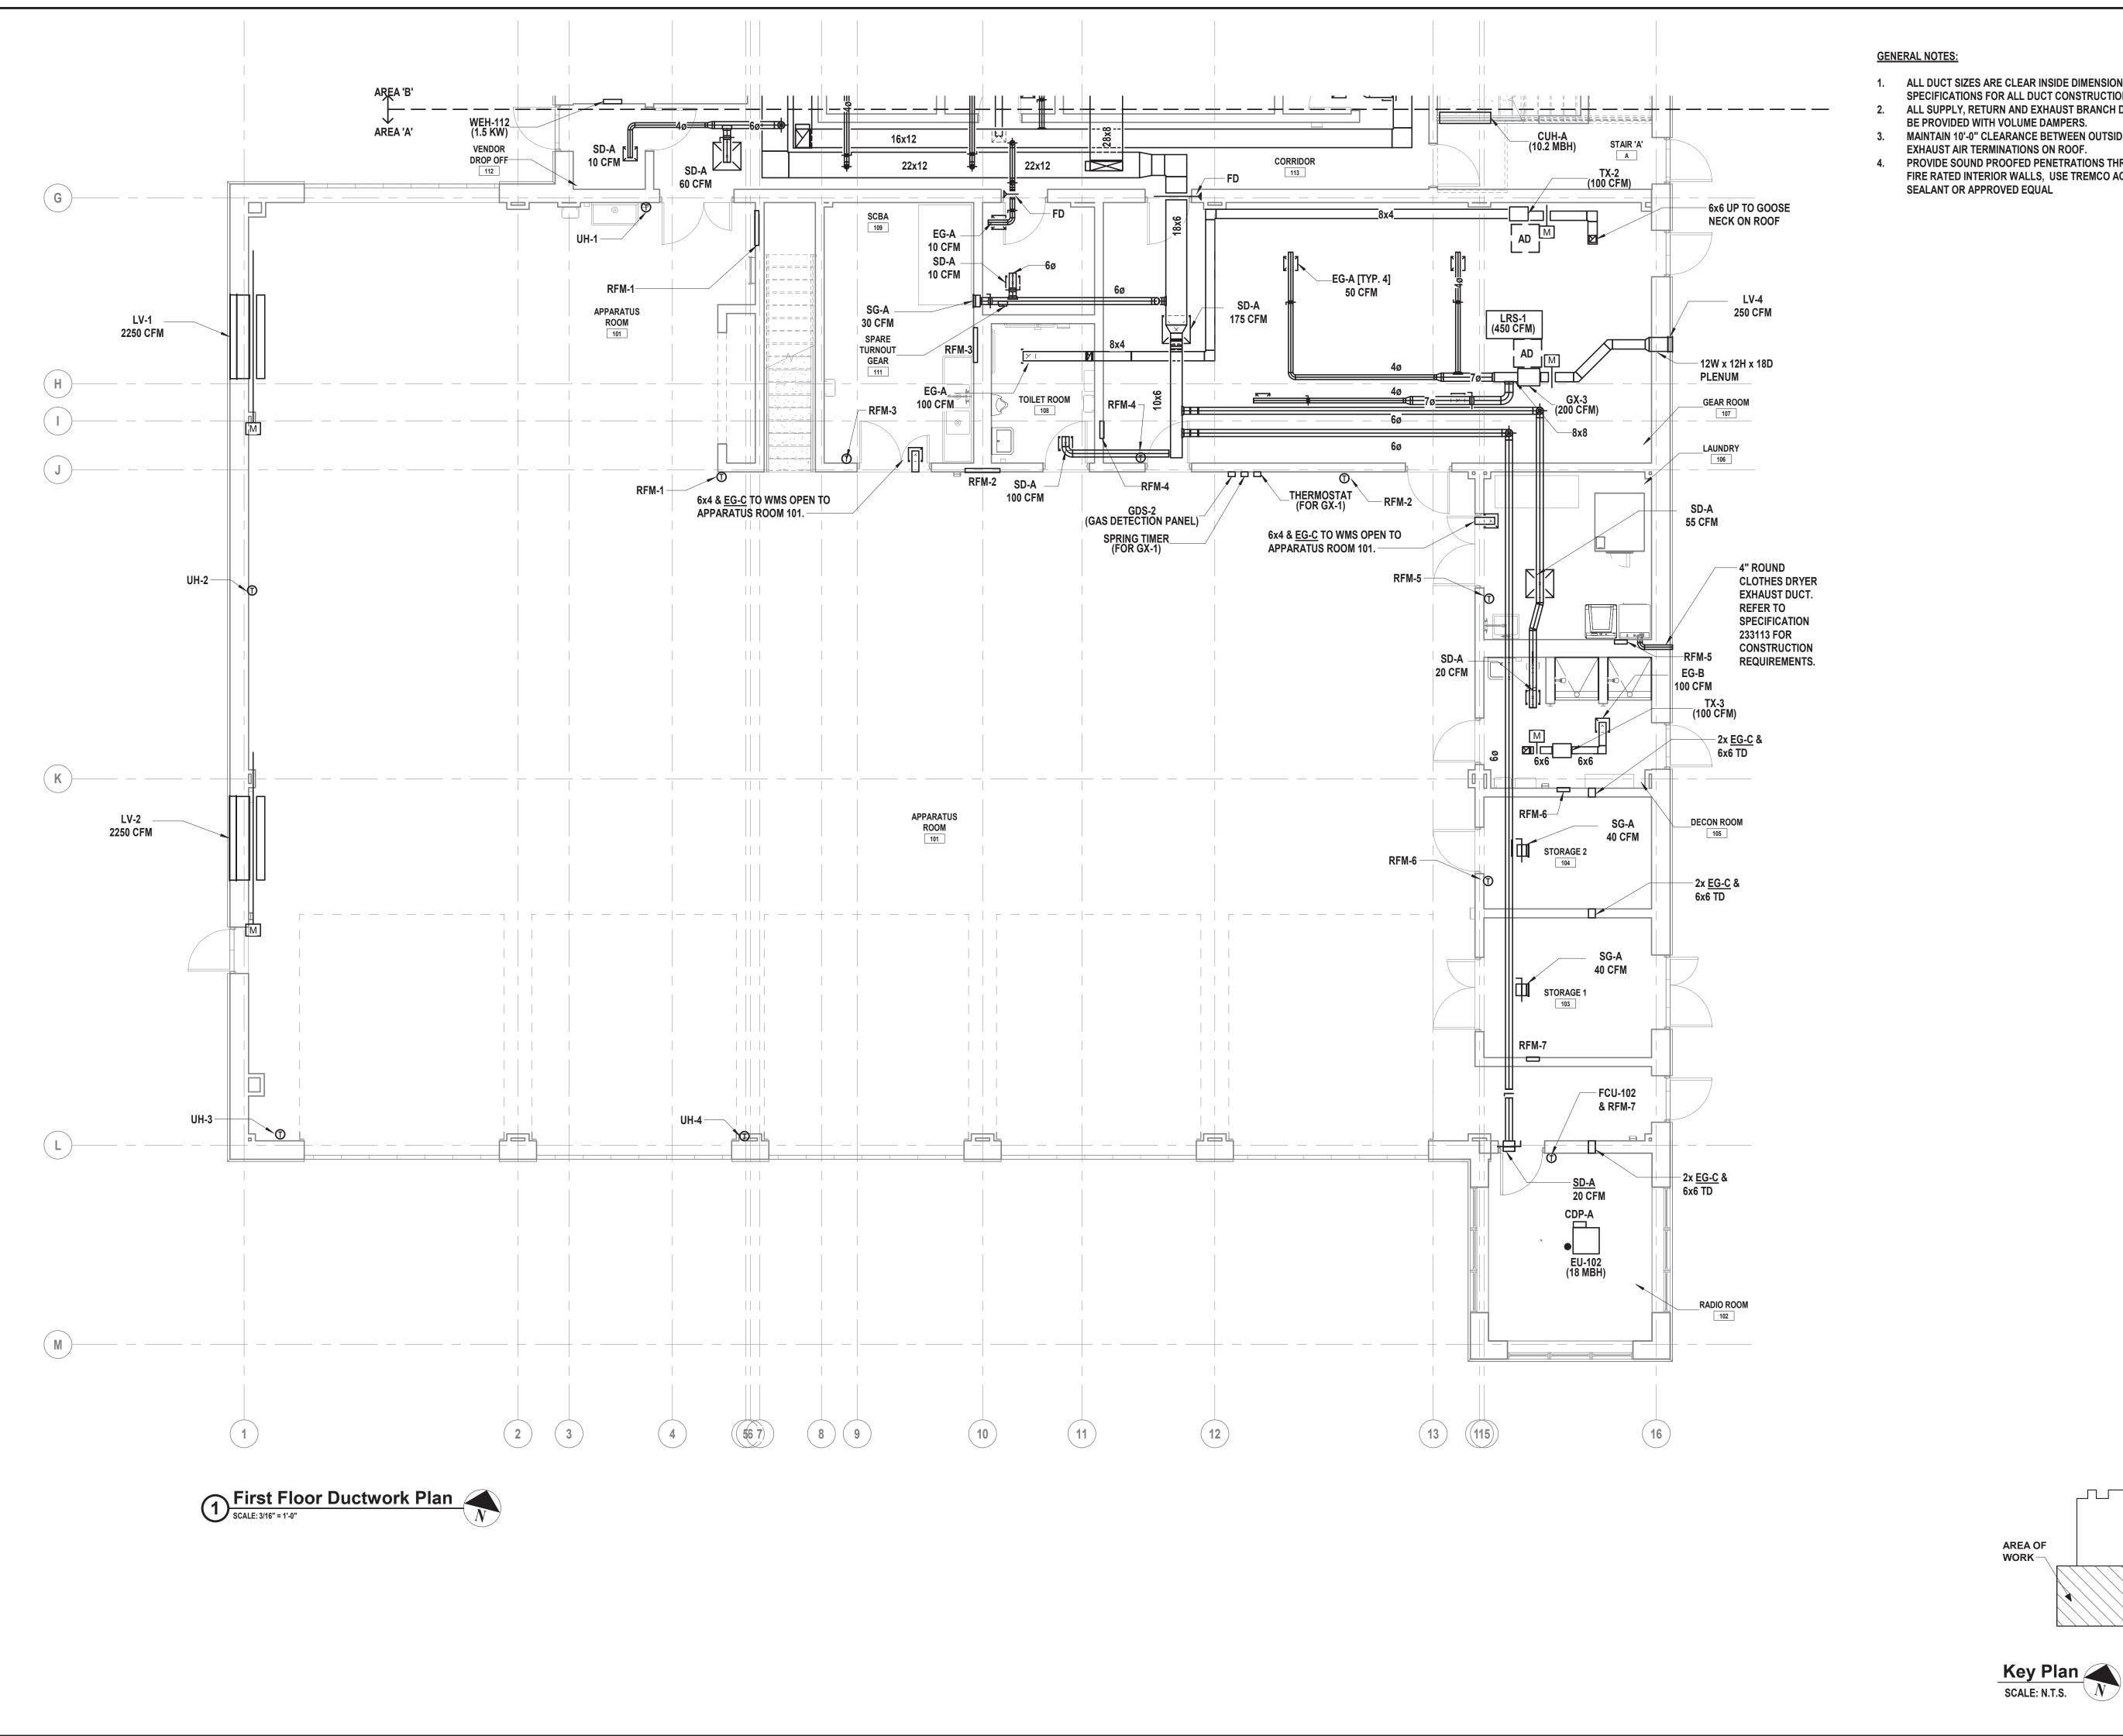

- 1. ALL DUCT SIZES ARE CLEAR INSIDE DIMENSIONS. REFER TO
- SPECIFICATIONS FOR ALL DUCT CONSTRUCTION REQUIREMENTS. ALL SUPPLY, RETURN AND EXHAUST BRANCH DUCTWORK SHALL
- MAINTAIN 10'-0" CLEARANCE BETWEEN OUTSIDE AIR AND
- PROVIDE SOUND PROOFED PENETRATIONS THROUGH ALL NON FIRE RATED INTERIOR WALLS, USE TREMCO ACOUSTICAL

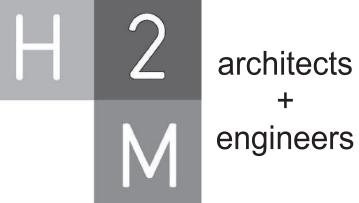

MARK	DATE	DESCRIPTION

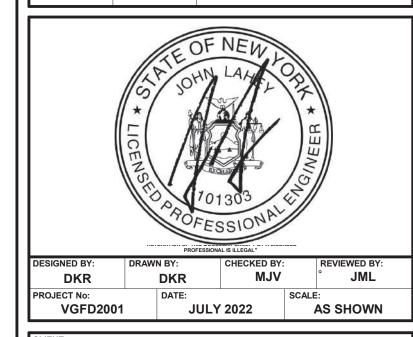

## **VAILS GATE FIRE DISTRICT**

New Storage Building (Phase I)
New Fire Station (Phase II)




872 Blooming Grove Turnpike New Windsor, NY 12553


**CONTRACT G GENERAL CONSTRUCTION** 

FINAL BID DOCUMENT

FIRST FLOOR DUCTWORK PLAN **AREA A** 


M2 131A.00

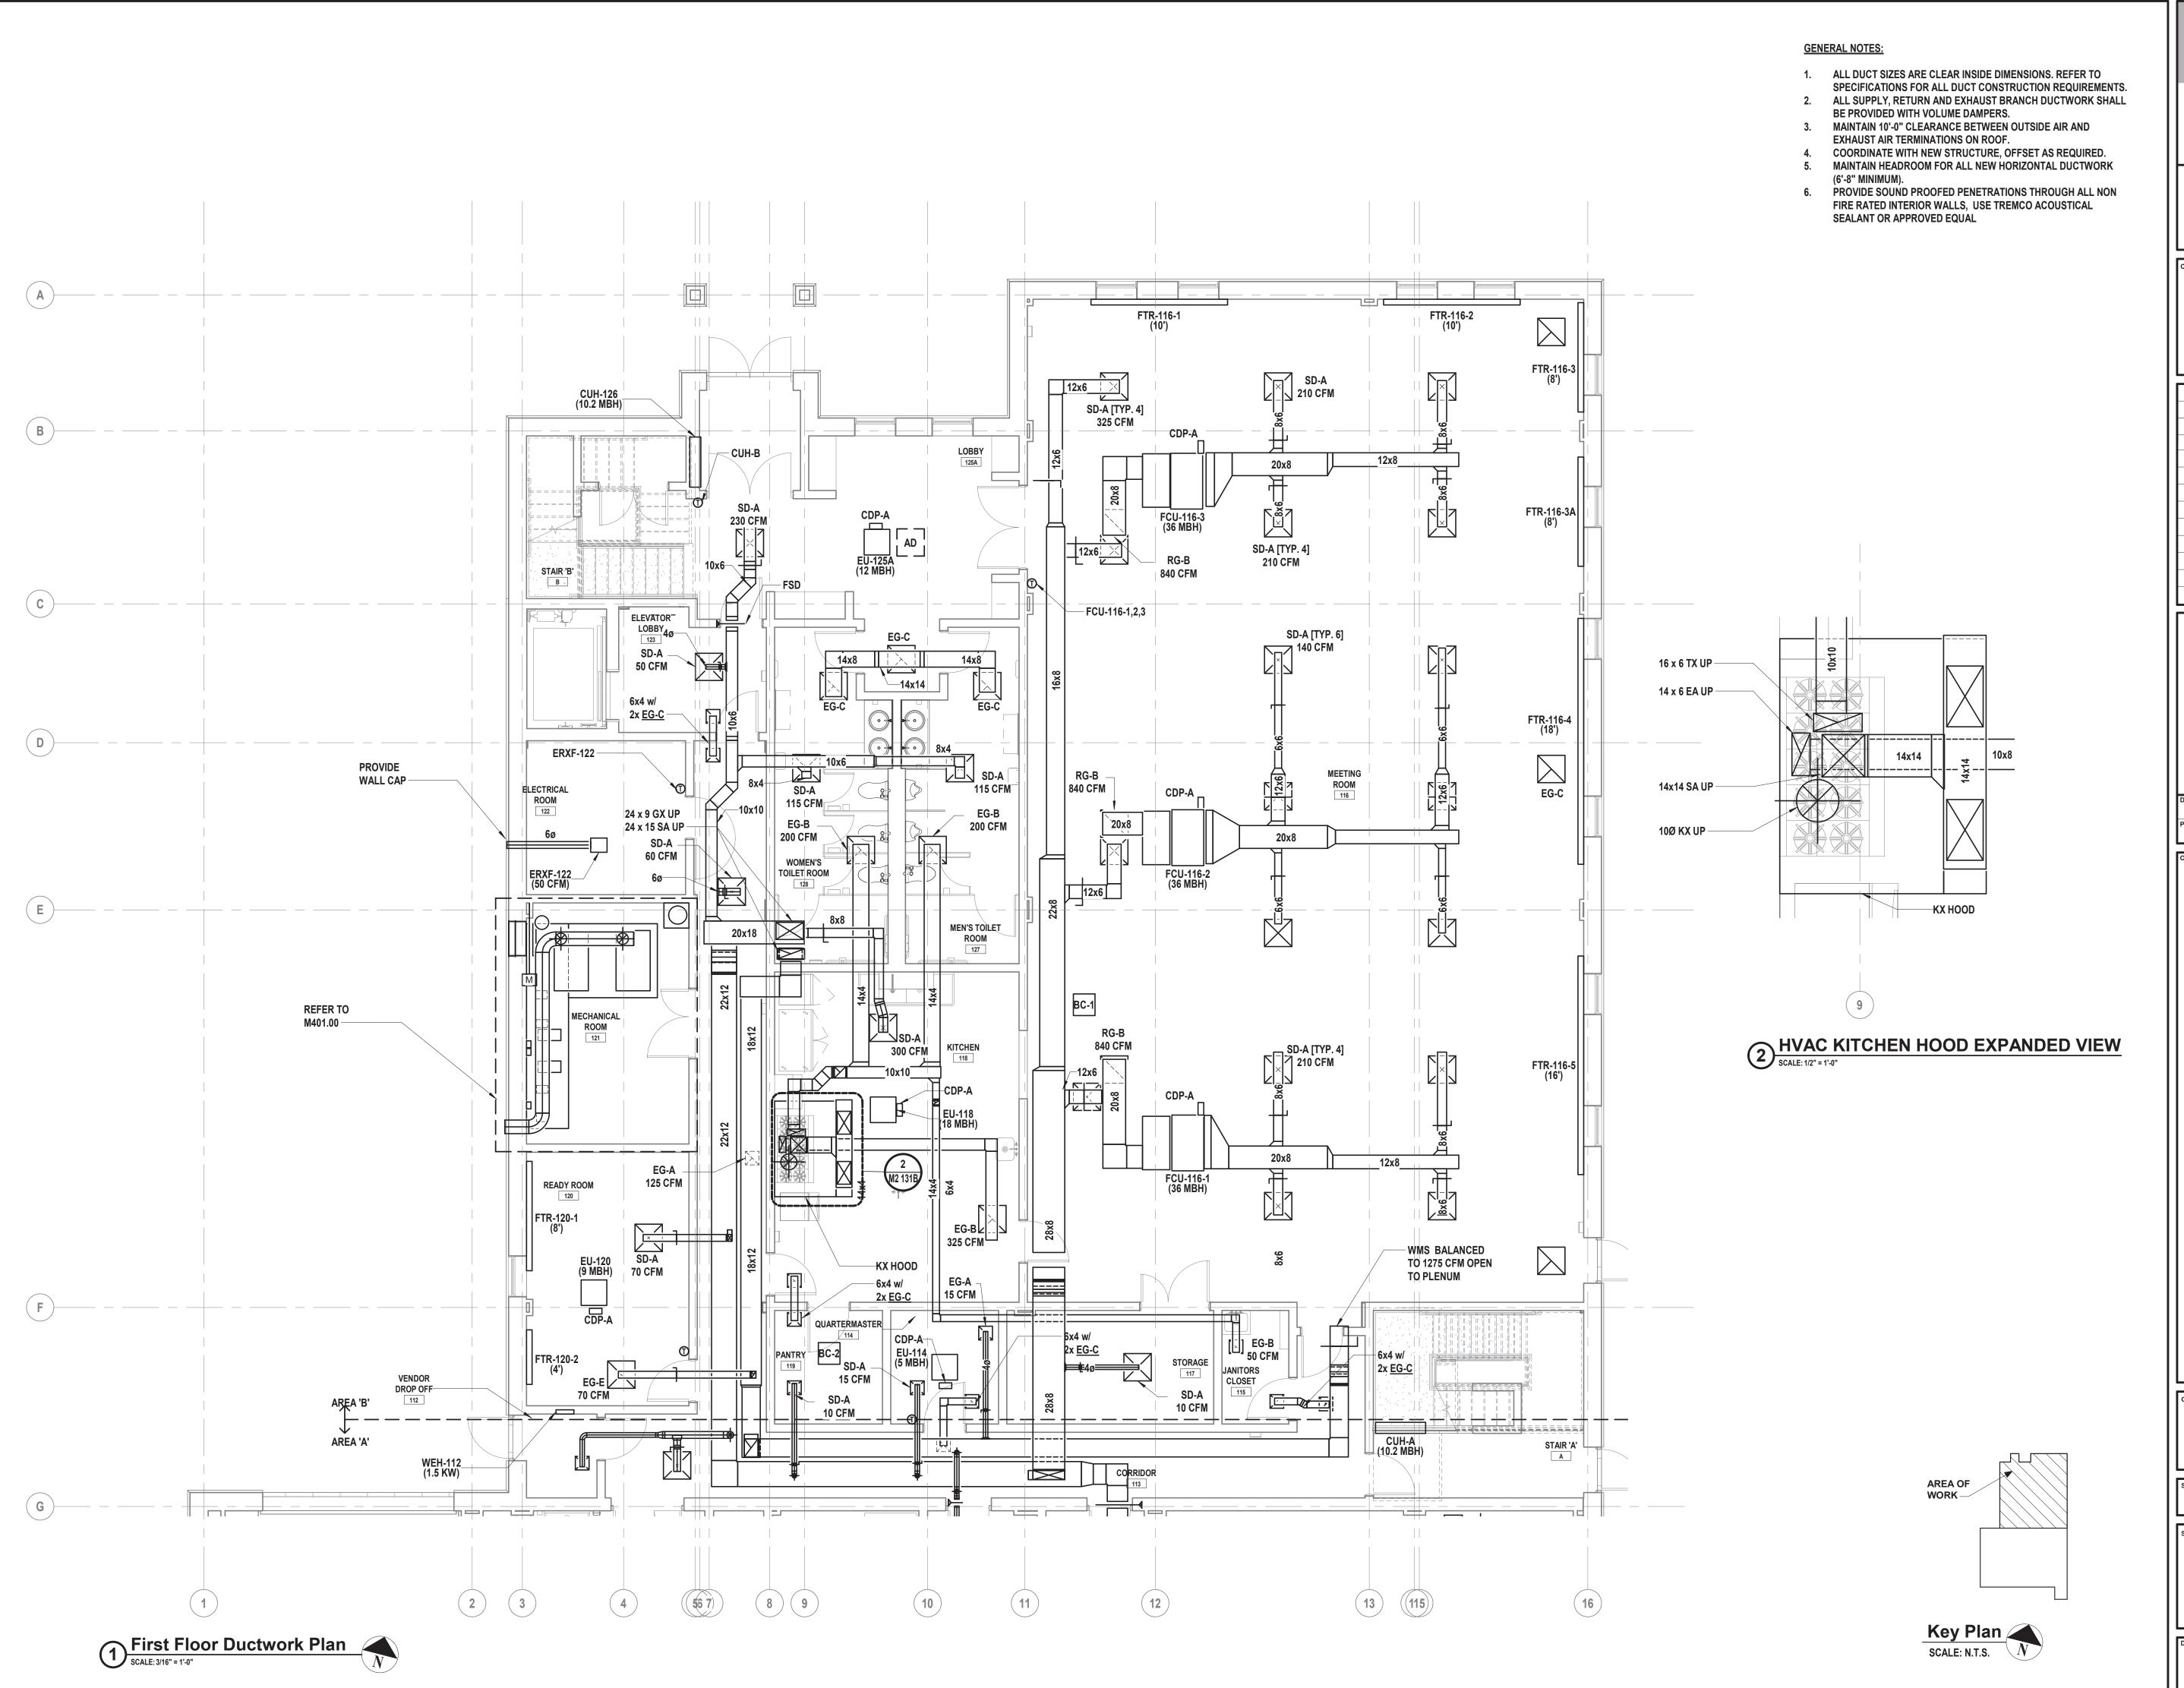

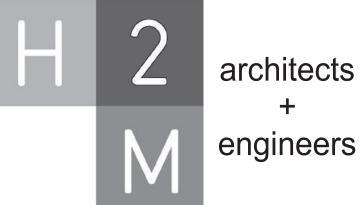

CONSULTANTS:

MARK DATE DESCRIPTION

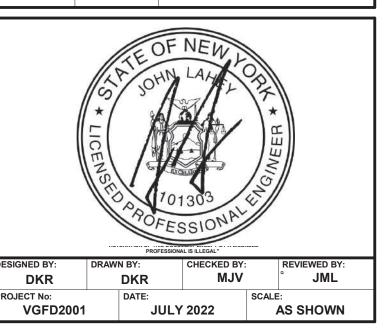

# VAILS GATE FIRE DISTRICT

New Storage Building (Phase I) New Fire Station (Phase II)



872 Blooming Grove Turnpike New Windsor, NY 12553


CONTRACT G
GENERAL CONSTRUCTION

FINAL BID DOCUMENT

HEET TITLE


FIRST FLOOR DUCTWORK PLAN AREA B

M2 131B.00

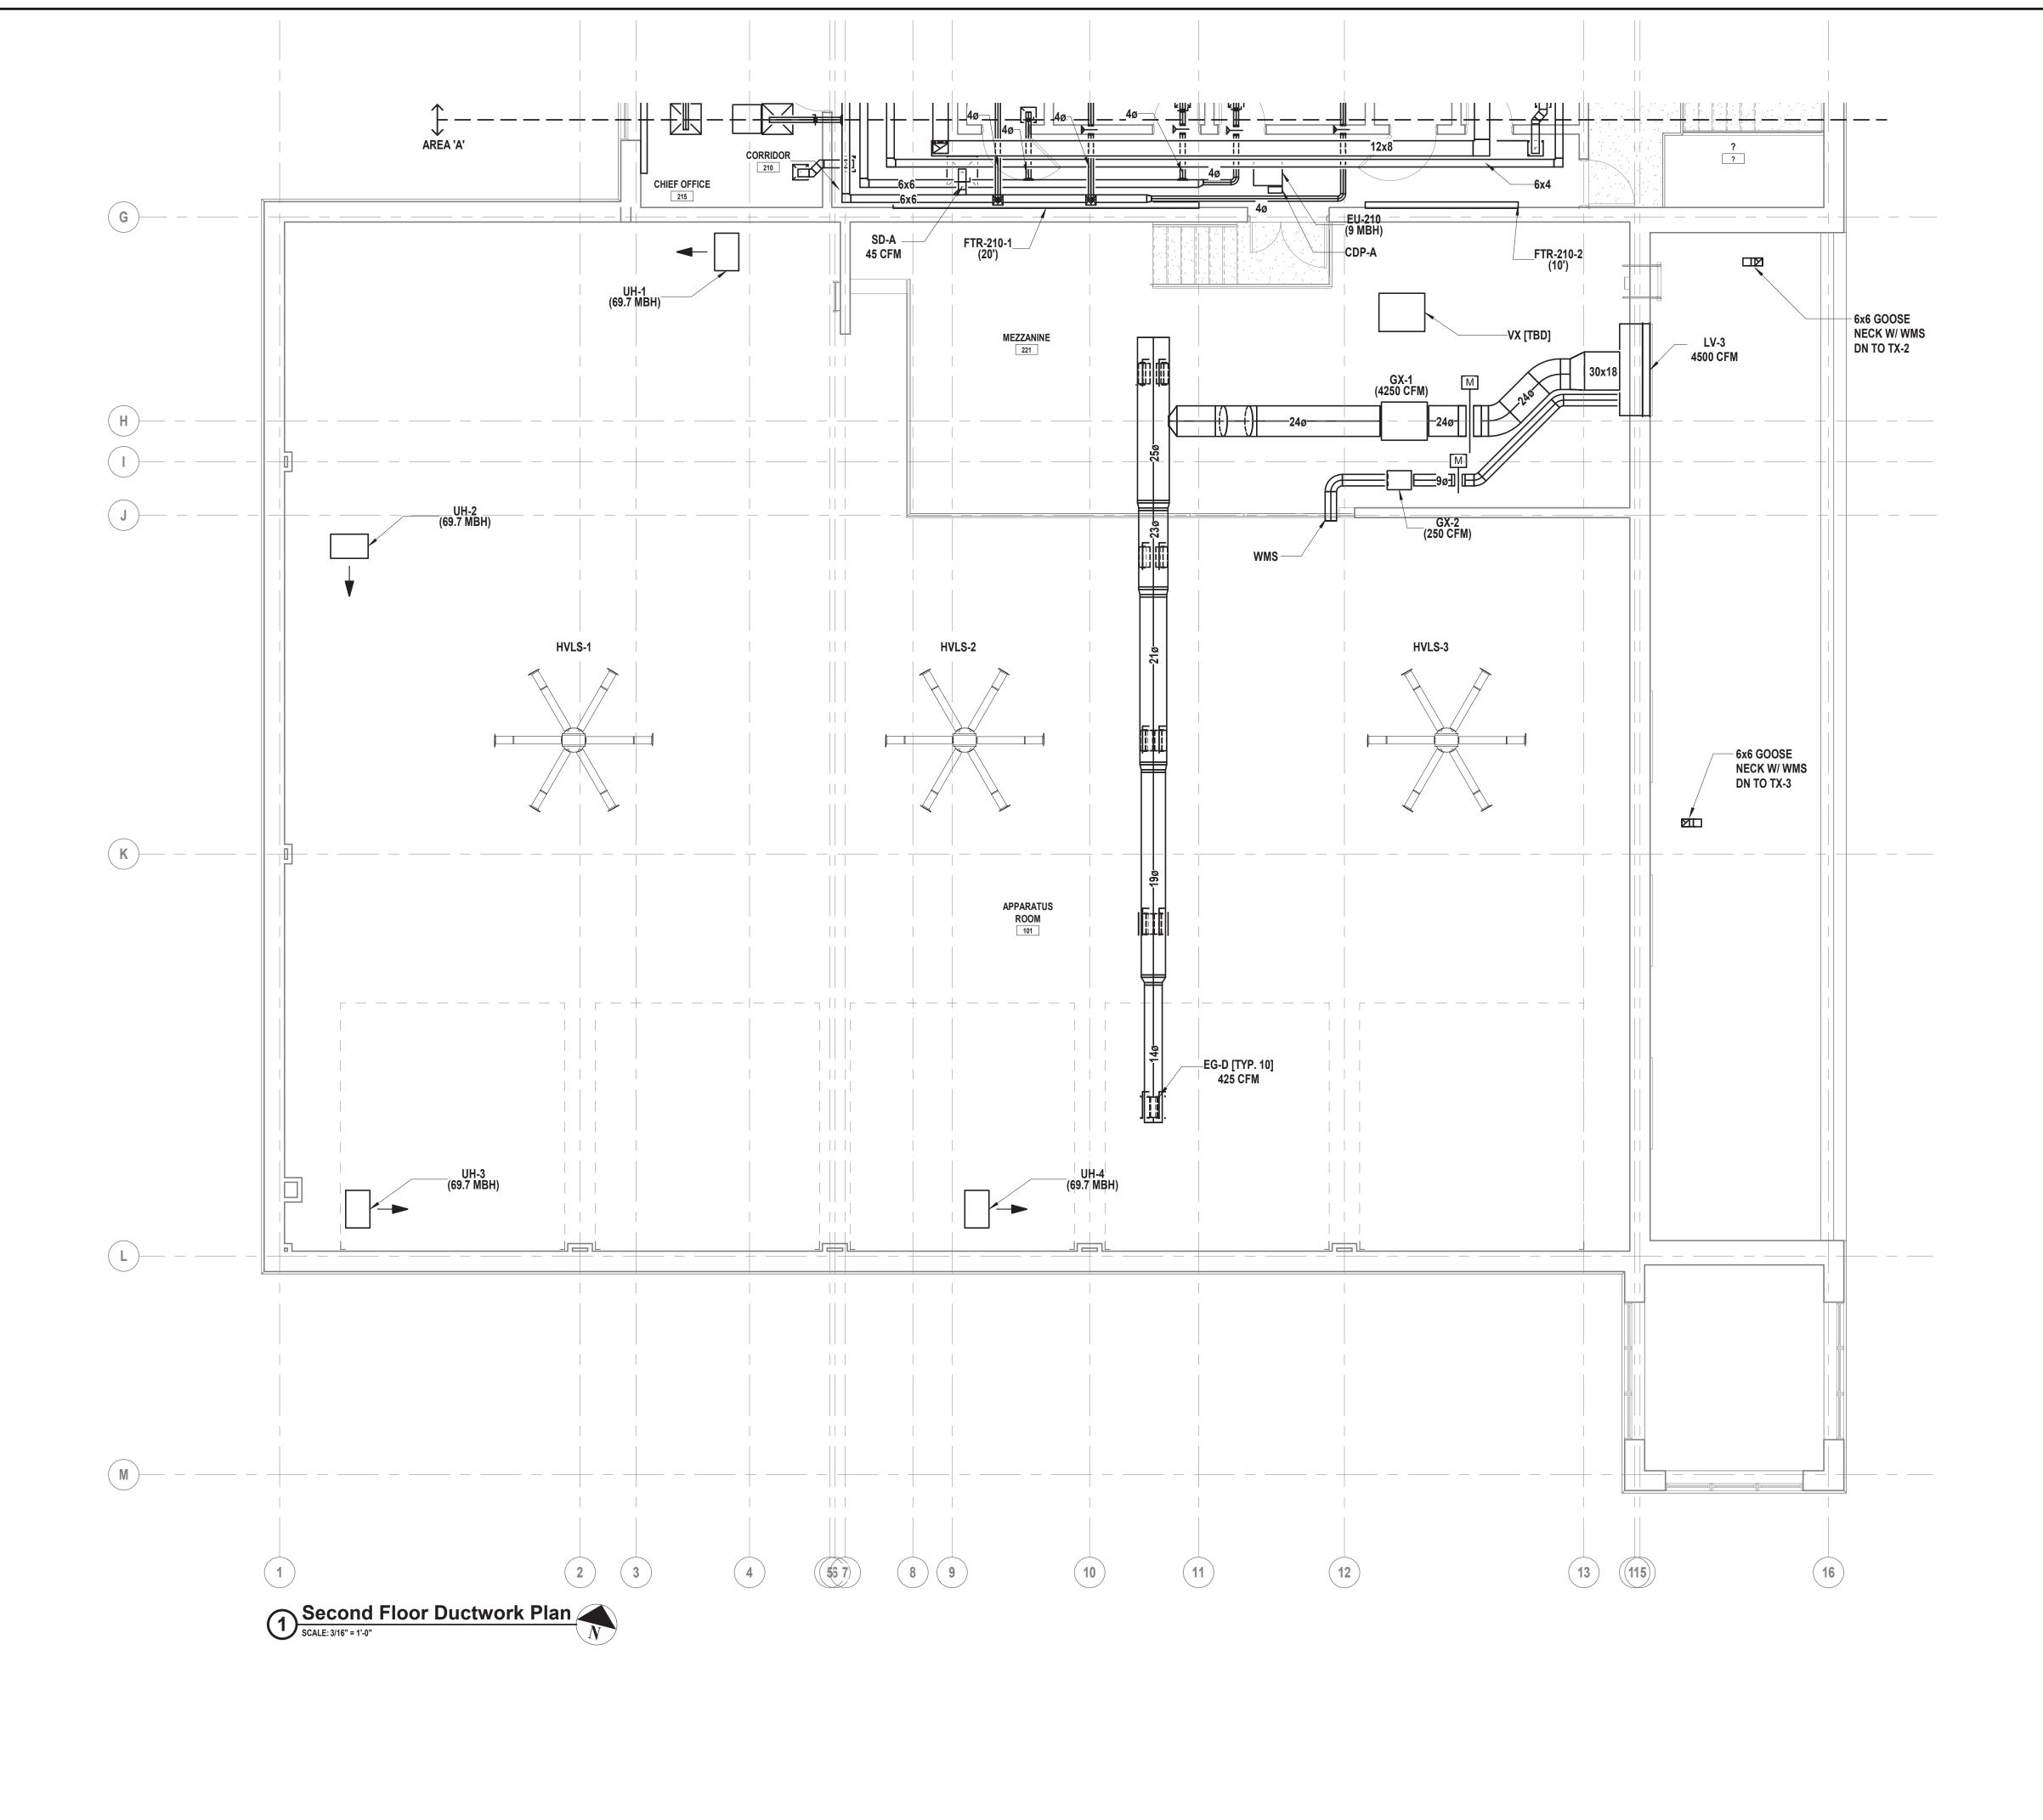


### **GENERAL NOTES:**

- 1. ALL DUCT SIZES ARE CLEAR INSIDE DIMENSIONS. REFER TO
- SPECIFICATIONS FOR ALL DUCT CONSTRUCTION REQUIREMENTS. 2. ALL SUPPLY, RETURN AND EXHAUST BRANCH DUCTWORK SHALL BE PROVIDED WITH VOLUME DAMPERS.
- MAINTAIN 10'-0" CLEARANCE BETWEEN OUTSIDE AIR AND
- **EXHAUST AIR TERMINATIONS ON ROOF.** PROVIDE SOUND PROOFED PENETRATIONS THROUGH ALL NON
- FIRE RATED INTERIOR WALLS, USE TREMCO ACOUSTICAL SEALANT OR APPROVED EQUAL

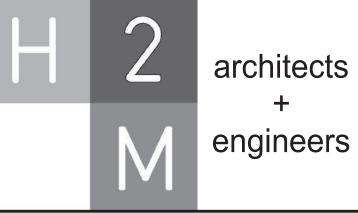

538 Broad Hollow Road, 4th Floor East Melville, NY 11747 631.756.8000 • www.h2m.com

MARK	DATE	DESCRIPTION

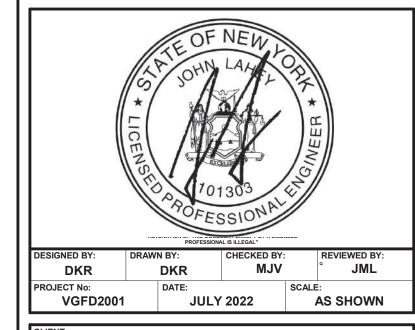

# **VAILS GATE FIRE DISTRICT**

New Storage Building (Phase I) New Fire Station (Phase II)



872 Blooming Grove Turnpike New Windsor, NY 12553

CONTRACT G **GENERAL CONSTRUCTION** 


FINAL BID DOCUMENT

AREA OF WORK


Key Plan SCALE: N.T.S.

SECOND FLOOR DUCTWORK PLAN AREA A

M2 132A.00

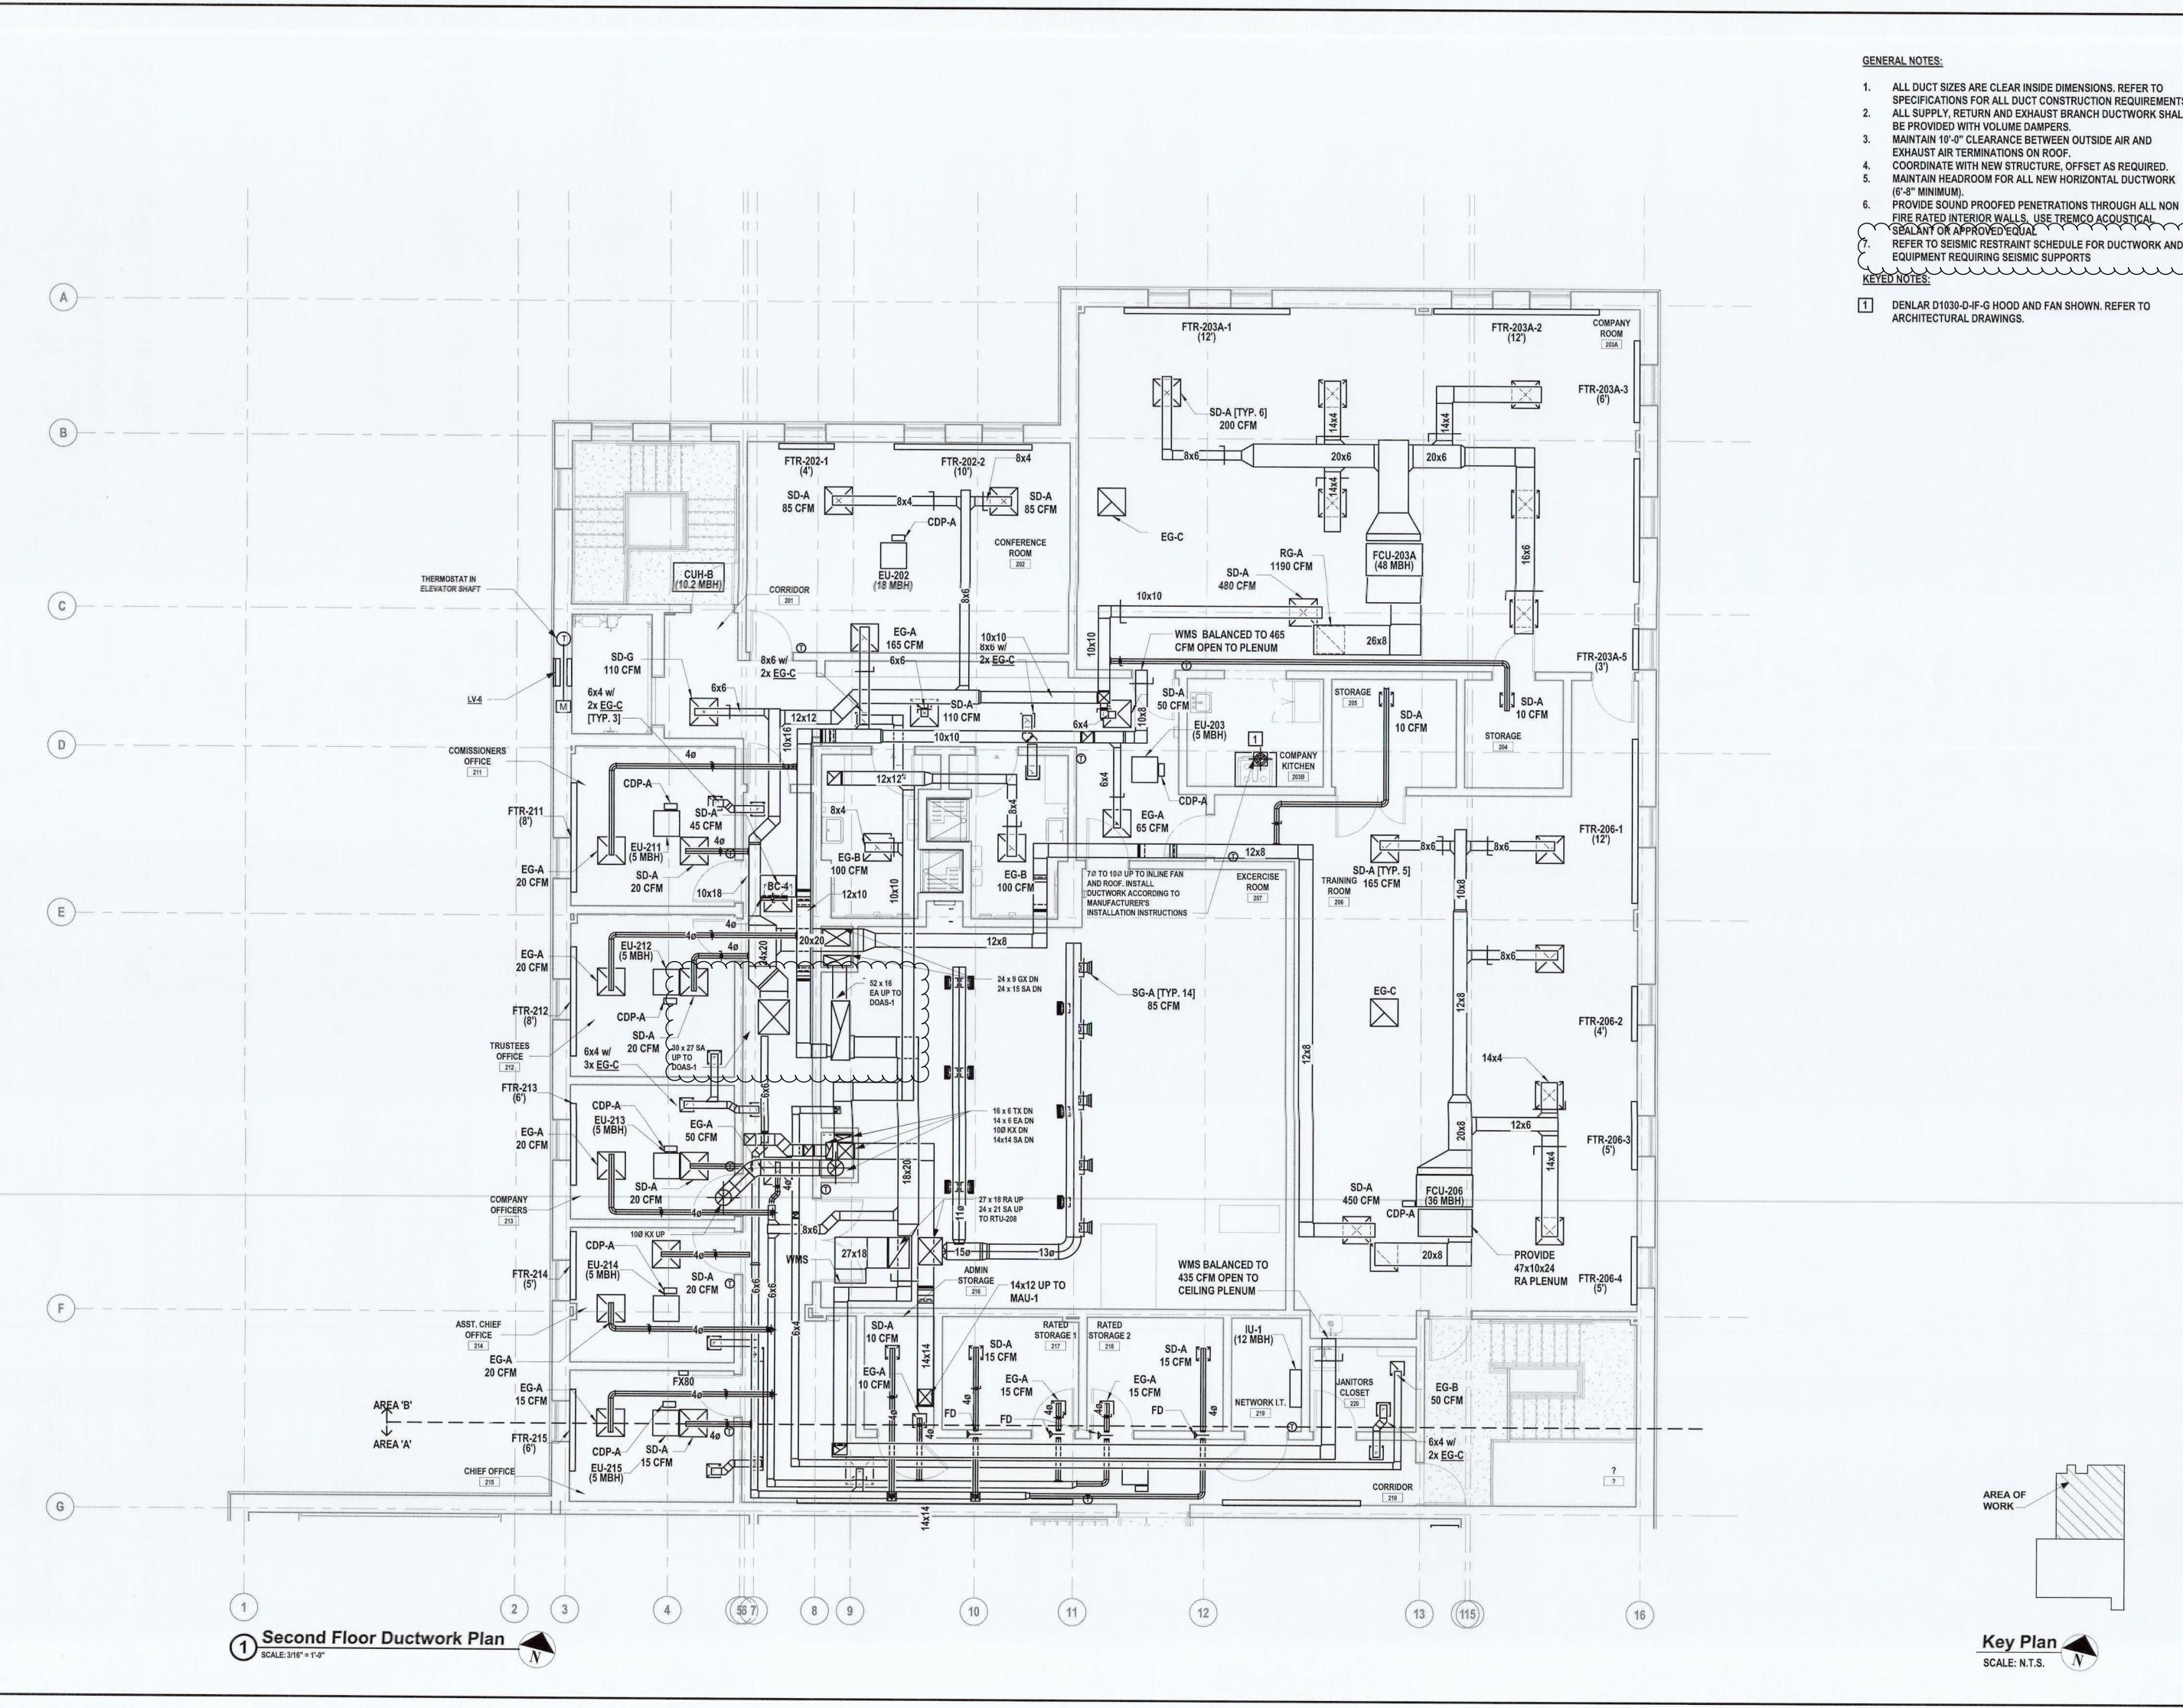

- 1. ALL DUCT SIZES ARE CLEAR INSIDE DIMENSIONS. REFER TO SPECIFICATIONS FOR ALL DUCT CONSTRUCTION REQUIREMENTS.
- ALL SUPPLY, RETURN AND EXHAUST BRANCH DUCTWORK SHALL
- MAINTAIN 10'-0" CLEARANCE BETWEEN OUTSIDE AIR AND
- COORDINATE WITH NEW STRUCTURE, OFFSET AS REQUIRED.
- MAINTAIN HEADROOM FOR ALL NEW HORIZONTAL DUCTWORK
- REFER TO SEISMIC RESTRAINT SCHEDULE FOR DUCTWORK AND

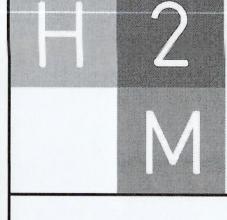

architects engineers

538 Broad Hollow Road, 4th Floor East Melville, NY 11747 631.756.8000 • www.h2m.com

DESCRIPTION DATE 12/22/2022 REVS. PER TOWN COMMENT



ROJECT No: VGFD2001 JULY 2022 AS SHOWN

# **VAILS GATE FIRE DISTRICT**

New Storage Building (Phase I) New Fire Station (Phase II)




872 Blooming Grove Turnpike New Windsor, NY 12553


**CONTRACT G GENERAL CONSTRUCTION** 


FINAL BID DOCUMENT

SECOND FLOOR DUCTWORK **PLAN AREA B** 

M2 132B.02

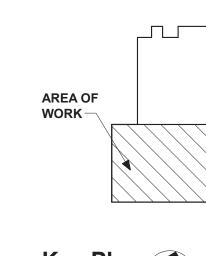


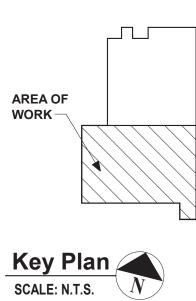

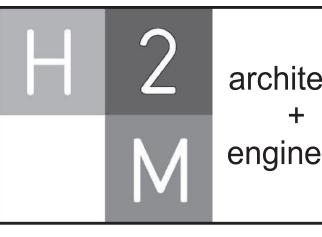

ONSULTANTS:		

MARK	DATE	DESCRIPTION

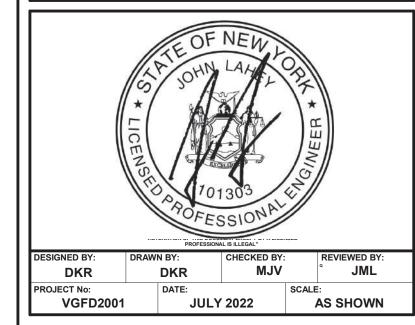

## **VAILS GATE FIRE DISTRICT**

New Storage Building (Phase I)
New Fire Station (Phase II)



**872 Blooming Grove Turnpike** New Windsor, NY 12553


**CONTRACT G GENERAL CONSTRUCTION** 

FINAL BID DOCUMENT


**HVAC ROOF PLAN AREA A** 

M2 133A.00

ROOF AREA A
SCALE: 3/16" - 1'-0"

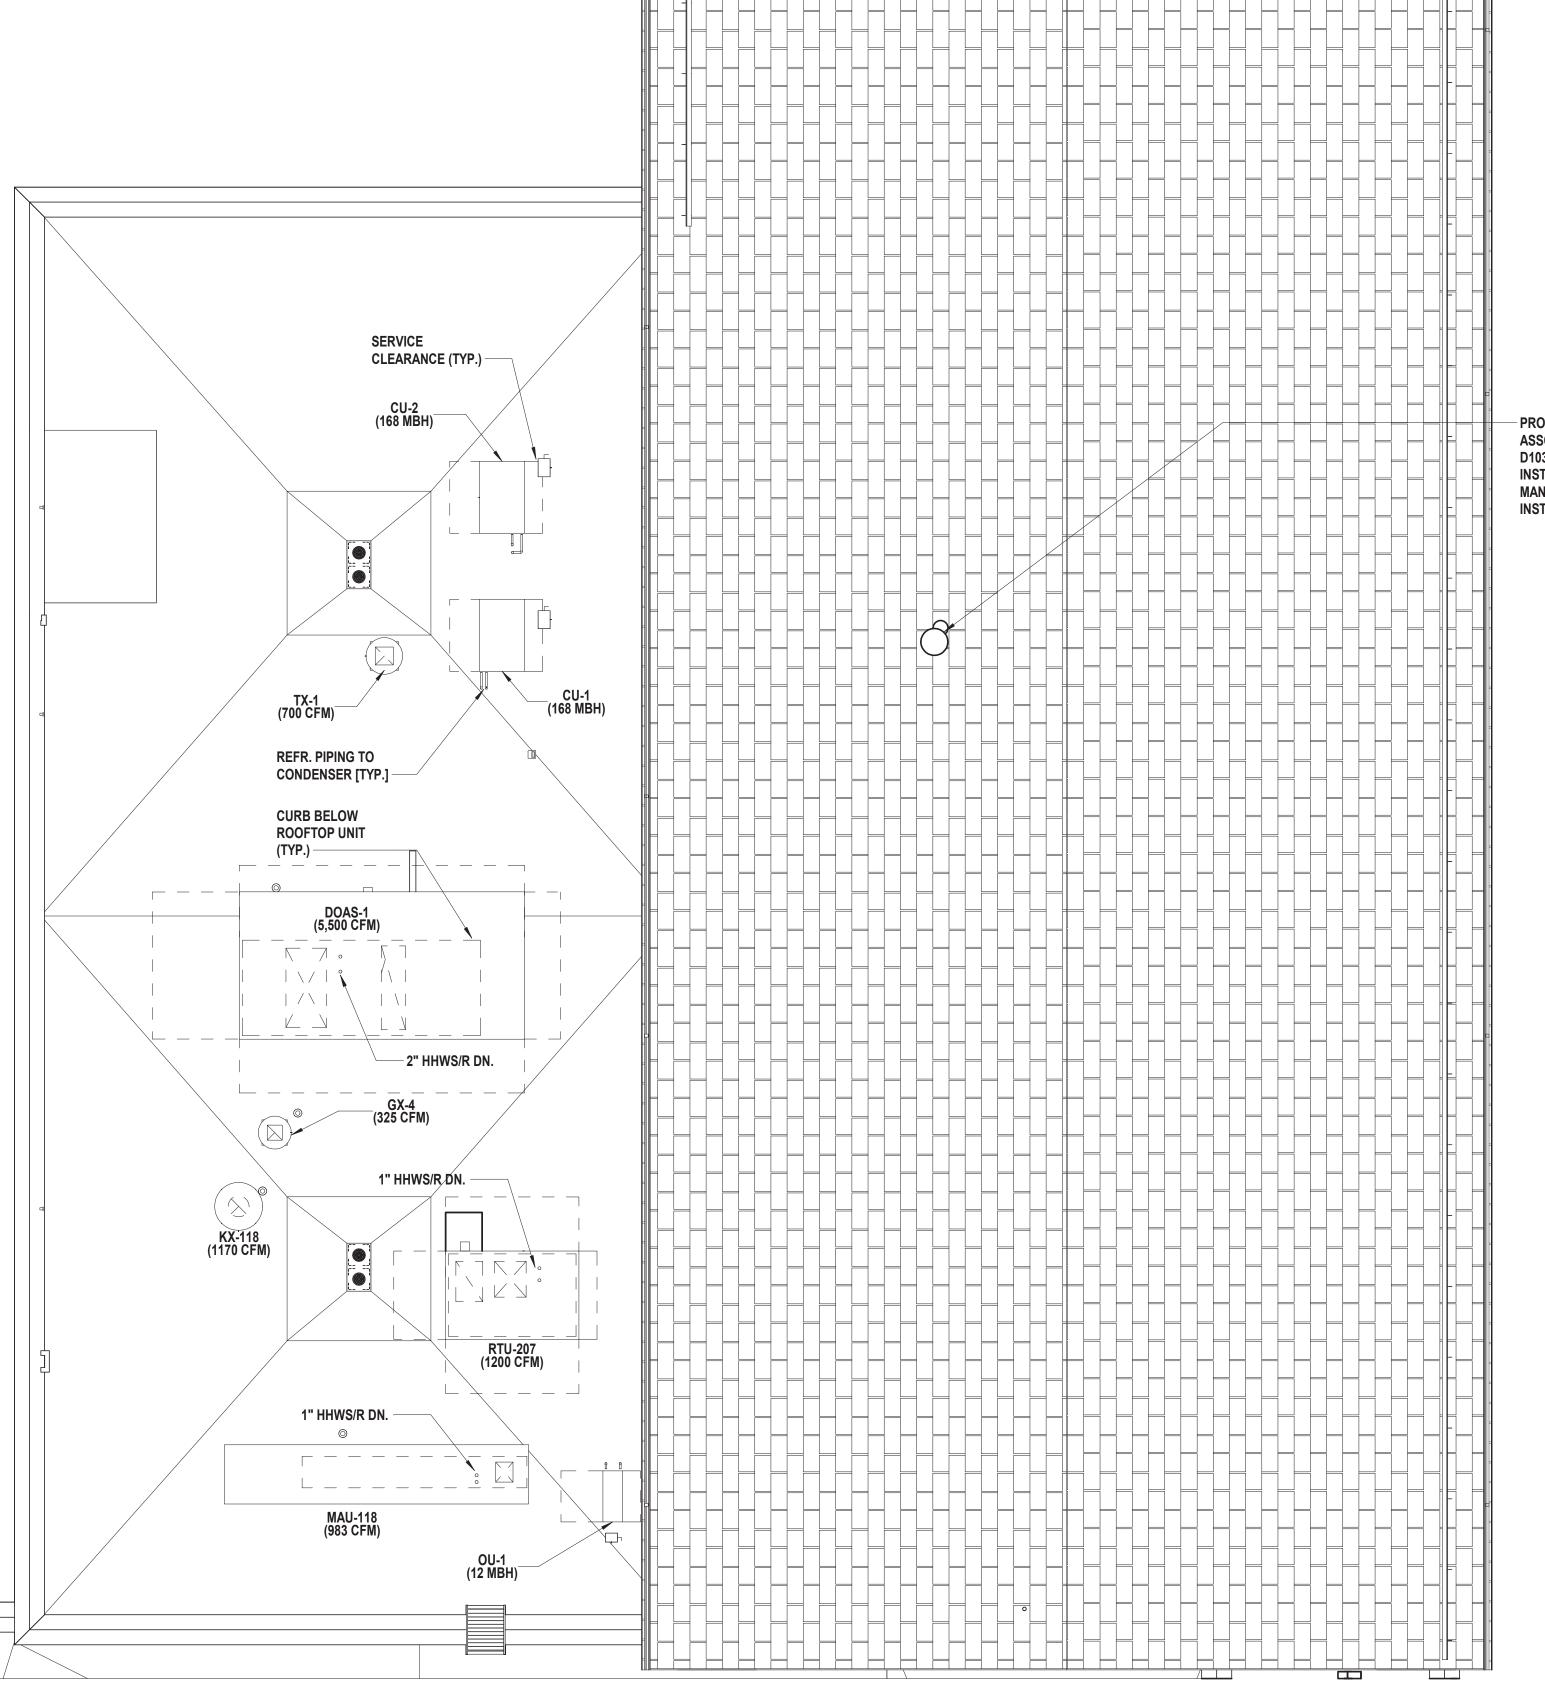


PROVIDE ROOF CAP
ASSOCIATED WITH DENLAR
D1030-D-IF-G HOOD AND FAN.
INSTALL ACCORDING TO
MANUFACTURER'S
INSTALLATION INSTRUCTIONS

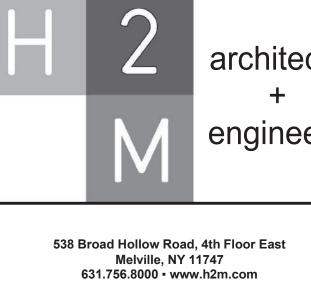

CONSULTANTS:		
MADK	DATE	DESCRIPTION

	WARK	DATE	DESCRIPTION
	1		
ı			

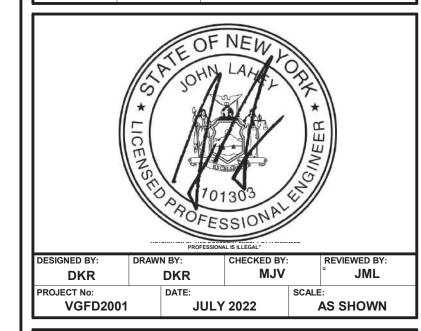

# VAILS GATE FIRE DISTRICT

New Storage Building (Phase I) New Fire Station (Phase II)



872 Blooming Grove Turnpike New Windsor, NY 12553


CONTRACT G
GENERAL CONSTRUCTION

FINAL BID DOCUMENT


SHEET TITLE

**HVAC ROOF PLAN AREA B** 

M2 133B.00

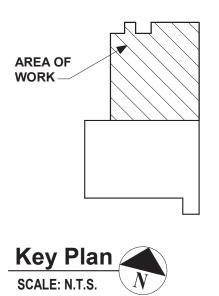

ROOF AREA B
SCALE: 3/16" - 1'-0"

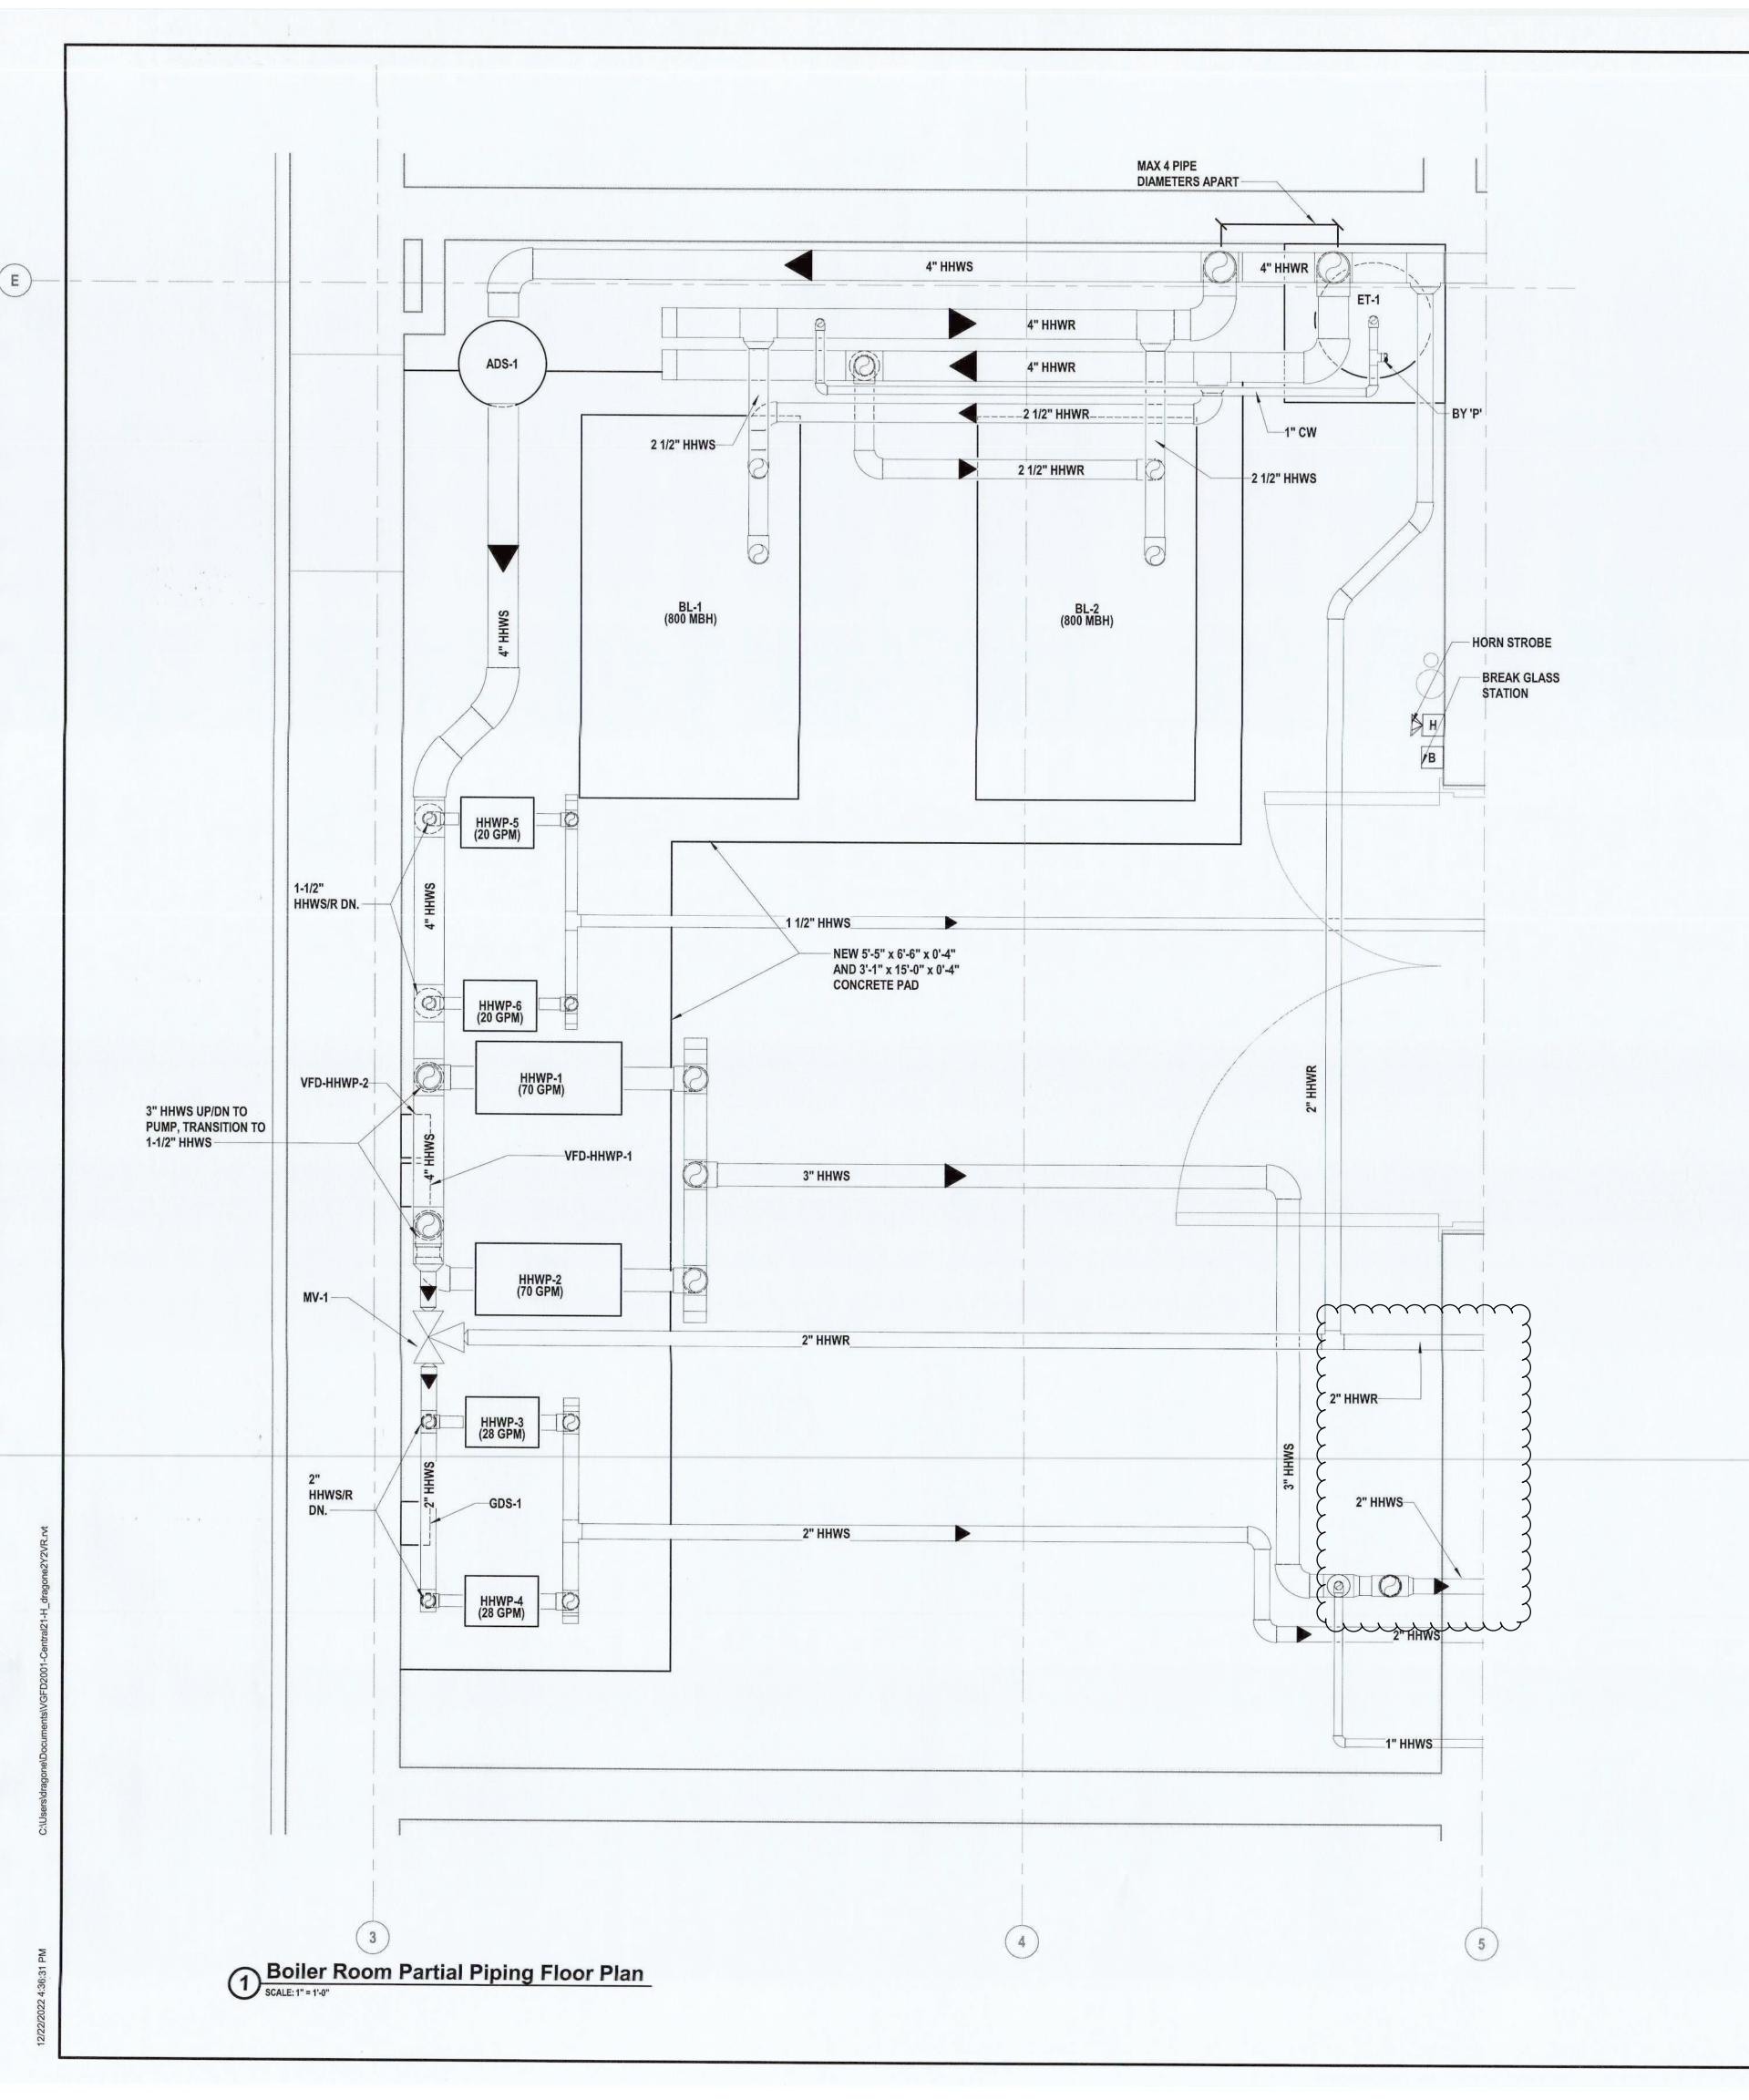

### **GENERAL NOTES:**

- 1. ALL DUCT SIZES ARE CLEAR INSIDE DIMENSIONS. REFER TO SPECIFICATIONS FOR ALL DUCT CONSTRUCTION REQUIREMENTS.
  2. ALL SUPPLY, RETURN AND EXHAUST BRANCH DUCTWORK SHALL BE PROVIDED WITH VOLUME DAMPERS.
- 3. MAINTAIN 10'-0" CLEARANCE BETWEEN OUTSIDE AIR AND EXHAUST AIR TERMINATIONS ON ROOF.
- 4. COORDINATE WITH NEW STRUCTURE, OFFSET AS REQUIRED.
- 5. MAINTAIN HEADROOM FOR ALL NEW HORIZONTAL DUCTWORK (6'-8" MINIMUM).
- 6. PROVIDE SOUND PROOFED PENETRATIONS THROUGH ALL NON FIRE RATED INTERIOR WALLS. USE TREMCO ACOUSTICAL SEALANT OR APPROVED EQUAL.
- 7. REFER TO SEISMIC RESTRAINT SCHEDULE FOR DUCTWORK, PIPING AND EQUIPMENT REQUIRING SEISMIC SUPPORTS

### COMBUSTION AIR REQUIRED:


BOILER GAS INPUT RATING (CFH): 800 (PER BOILER)
DOMESTIC WATER HEATER GAS INPUT RATING (MBH): 120
TOTAL GAS INPUT RATING (MBH): (800 x 2) + 120 = 1,720

\*TO PROVIDE COMBUSTION AIR USING MECHANICAL COMBUSTION AIR SUPPLY IN ACCORDANCE WITH SECTION 304.9 OF THE 2020 NYS FUEL GAS CODE AND SECTION 701.1 OF THE 2020 NYS MECHANICAL CODE (I.E. NFPA 31).

VOLUMETRIC FLOW RATE OF COMBUSTION AIR REQUIRED BY CODE:

1 IN^2 PER 3,000 MBH OF TOTAL INPUT RATING OF ALL APPLIANCES LOCATED WITHIN THE SPACE

FREE AREA REQUIRED: 1,720 MBH x (1 IN^2 / 3,000 BTU/HR ) = 573.33 IN^2 \* 1 FT^2 / 144 IN^2 = 3.98 FT^2 COMBUSTION AIR FREE AREA PROVIDED: 4.07 FT^2 > 3.98 FT^2

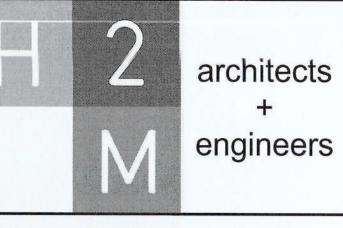

538 Broad Hollow Road, 4th Floor East Melville, NY 11747 631.756.8000 • www.h2m.com

CONSULTANTS:

MARK	DATE	DESCRIPTION
2	12/22/2022	REVS. PER TOWN COMMENT



 DESIGNED BY:
 DRAWN BY:
 CHECKED BY:
 REVIEWED BY:

 DKR
 DKR
 °
 SCALE:

 PROJECT No:
 DATE:
 SCALE:

 VGFD2001
 JULY 2022
 AS SHOWN

# VAILS GATE FIRE DISTRICT

New Storage Building (Phase I) New Fire Station (Phase II)



872 Blooming Grove Turnpike New Windsor, NY 12553


CONTRACT G
GENERAL CONSTRUCTION


FINAL BID DOCUMENT

SHEET TITLE

BOILER ROOM EXPANDED HVAC PIPING PLAN


M2 401.02

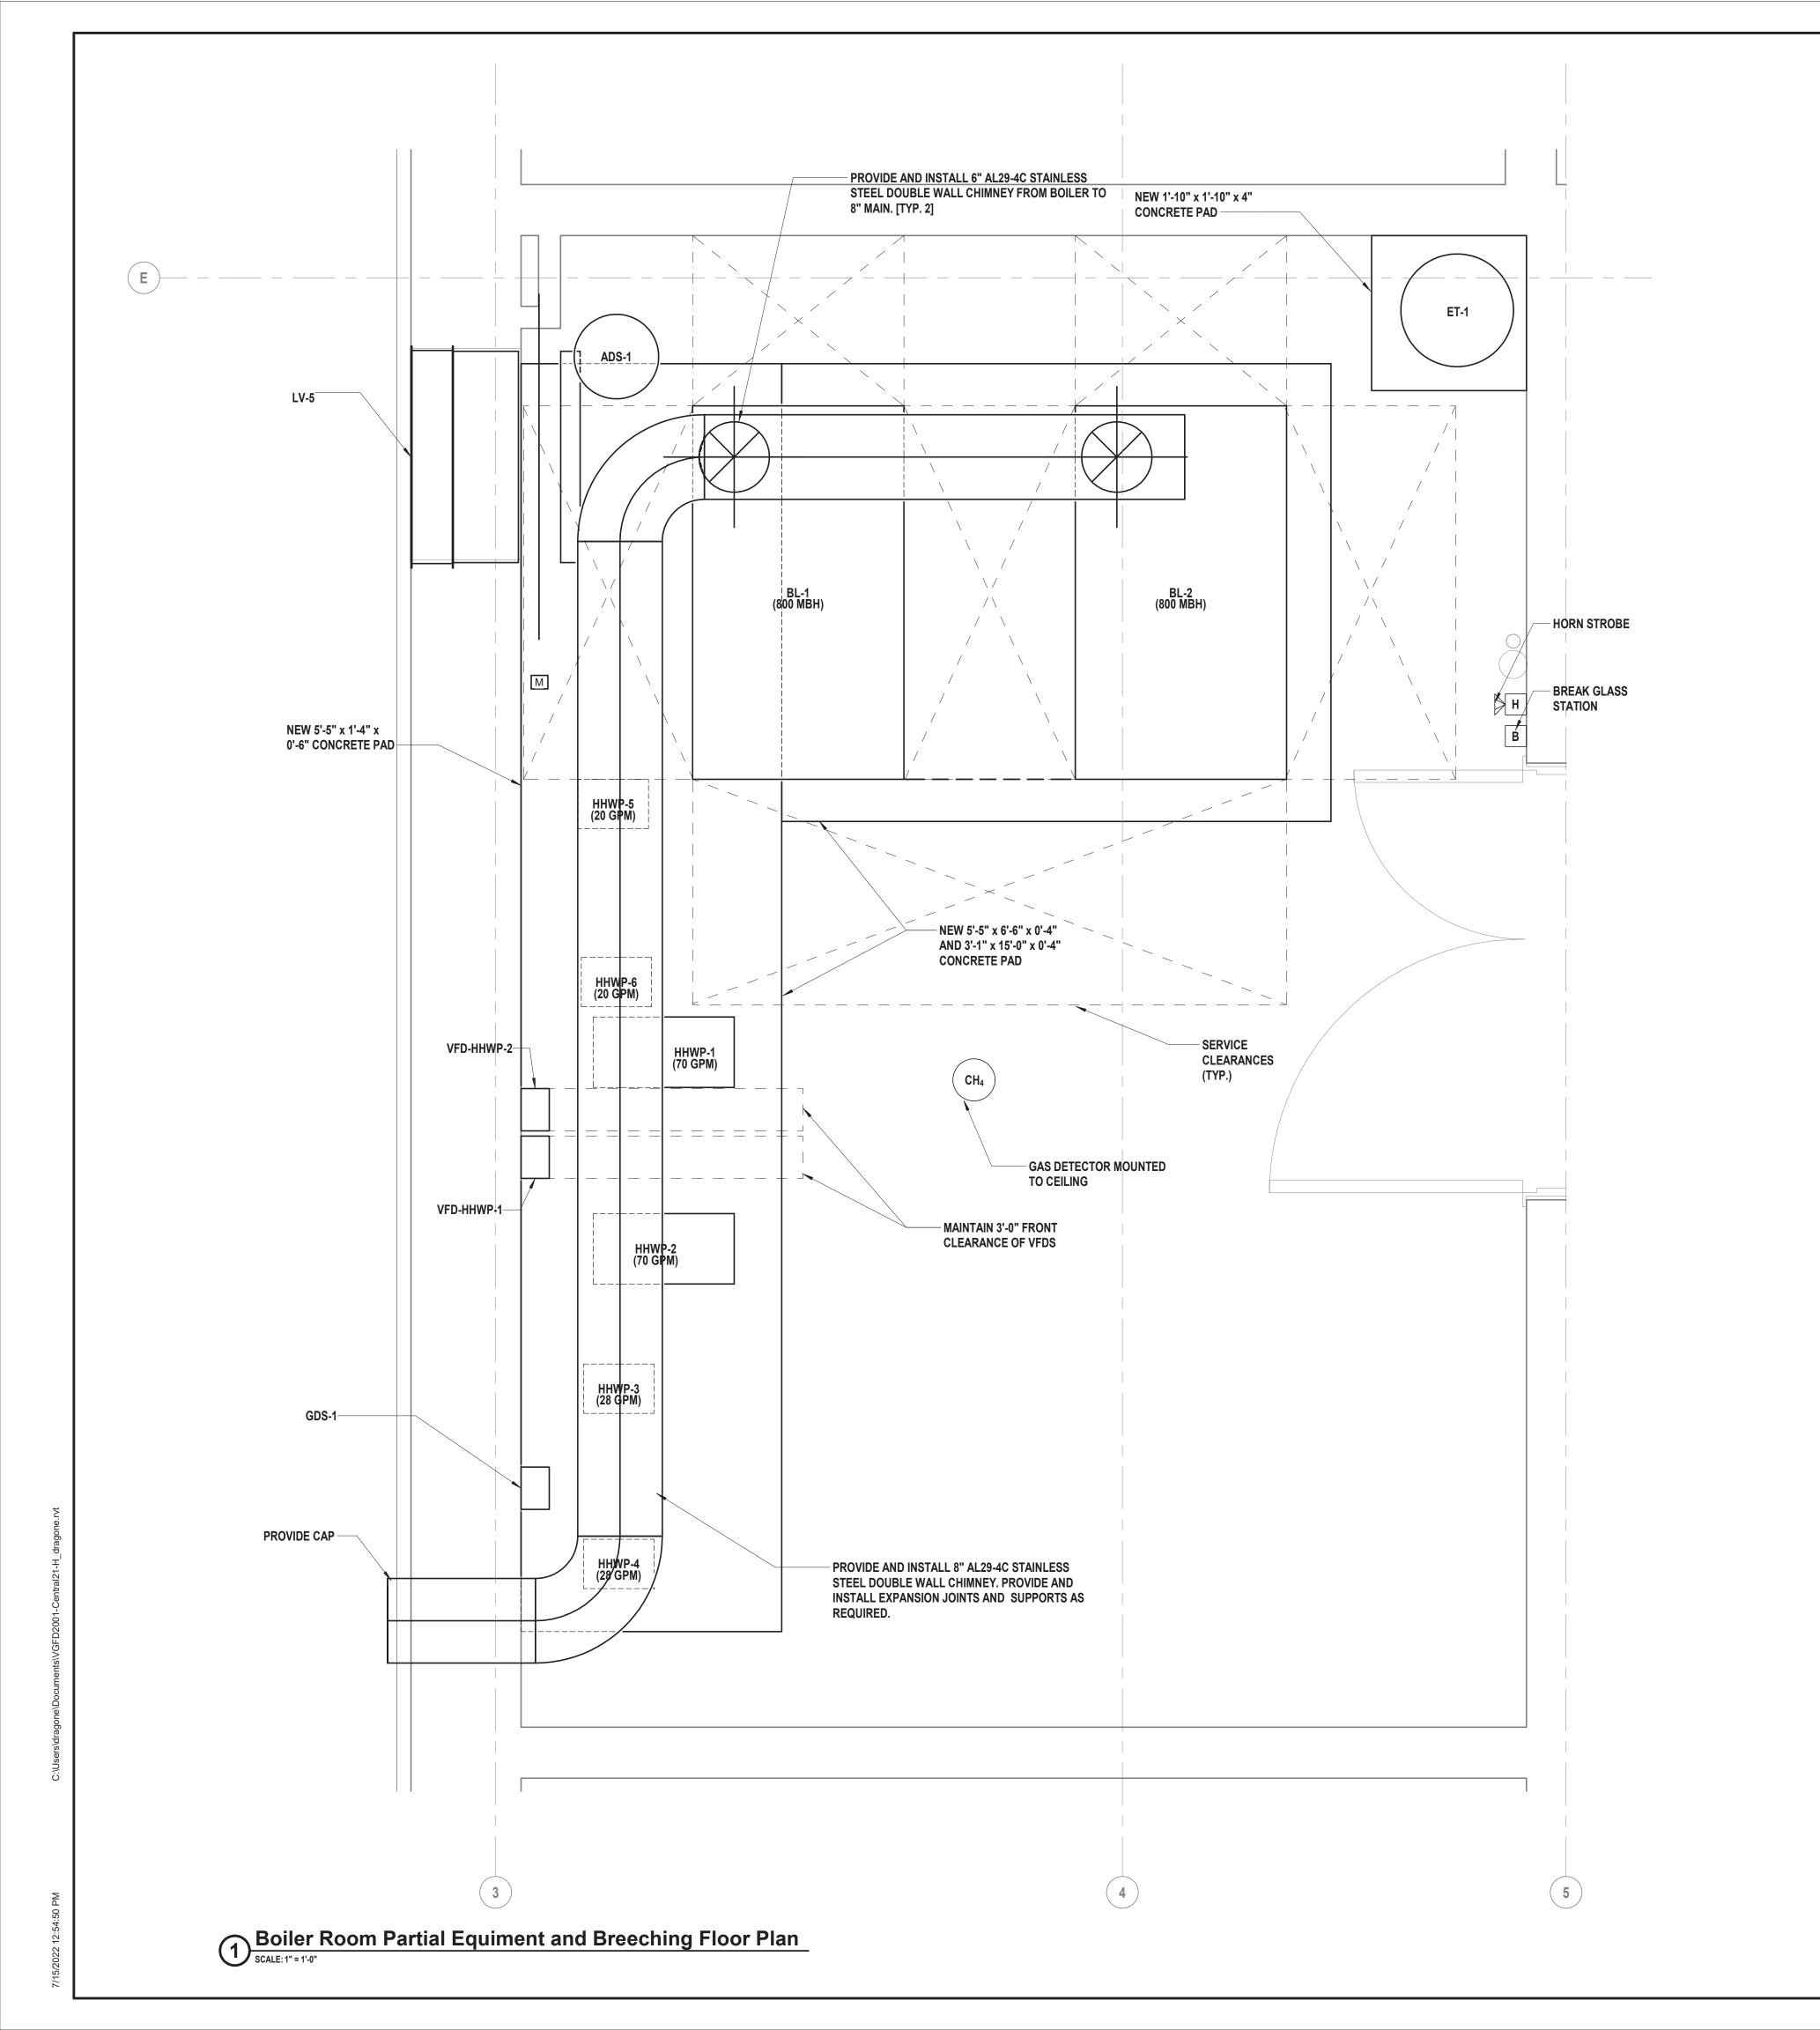

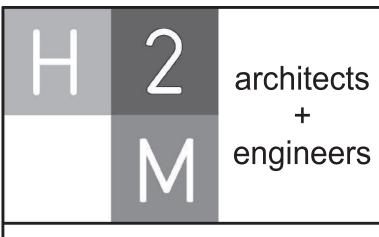

CONSULTANTS:

MARK	DATE	DESCRIPTION

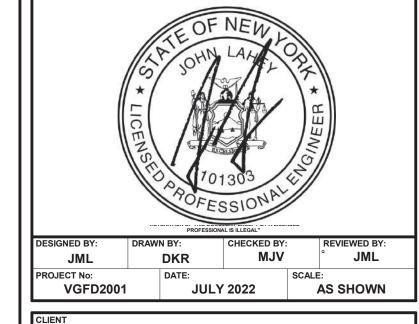

# VAILS GATE FIRE DISTRICT

New Storage Building (Phase I) New Fire Station (Phase II)



872 Blooming Grove Turnpike New Windsor, NY 12553


CONTRACT G
GENERAL CONSTRUCTION


FINAL BID DOCUMENT

SHEET TIT


BOILER ROOM EXPANDED HVAC EQUIPMENT AND DUCTWORK PLAN

M2 431.00

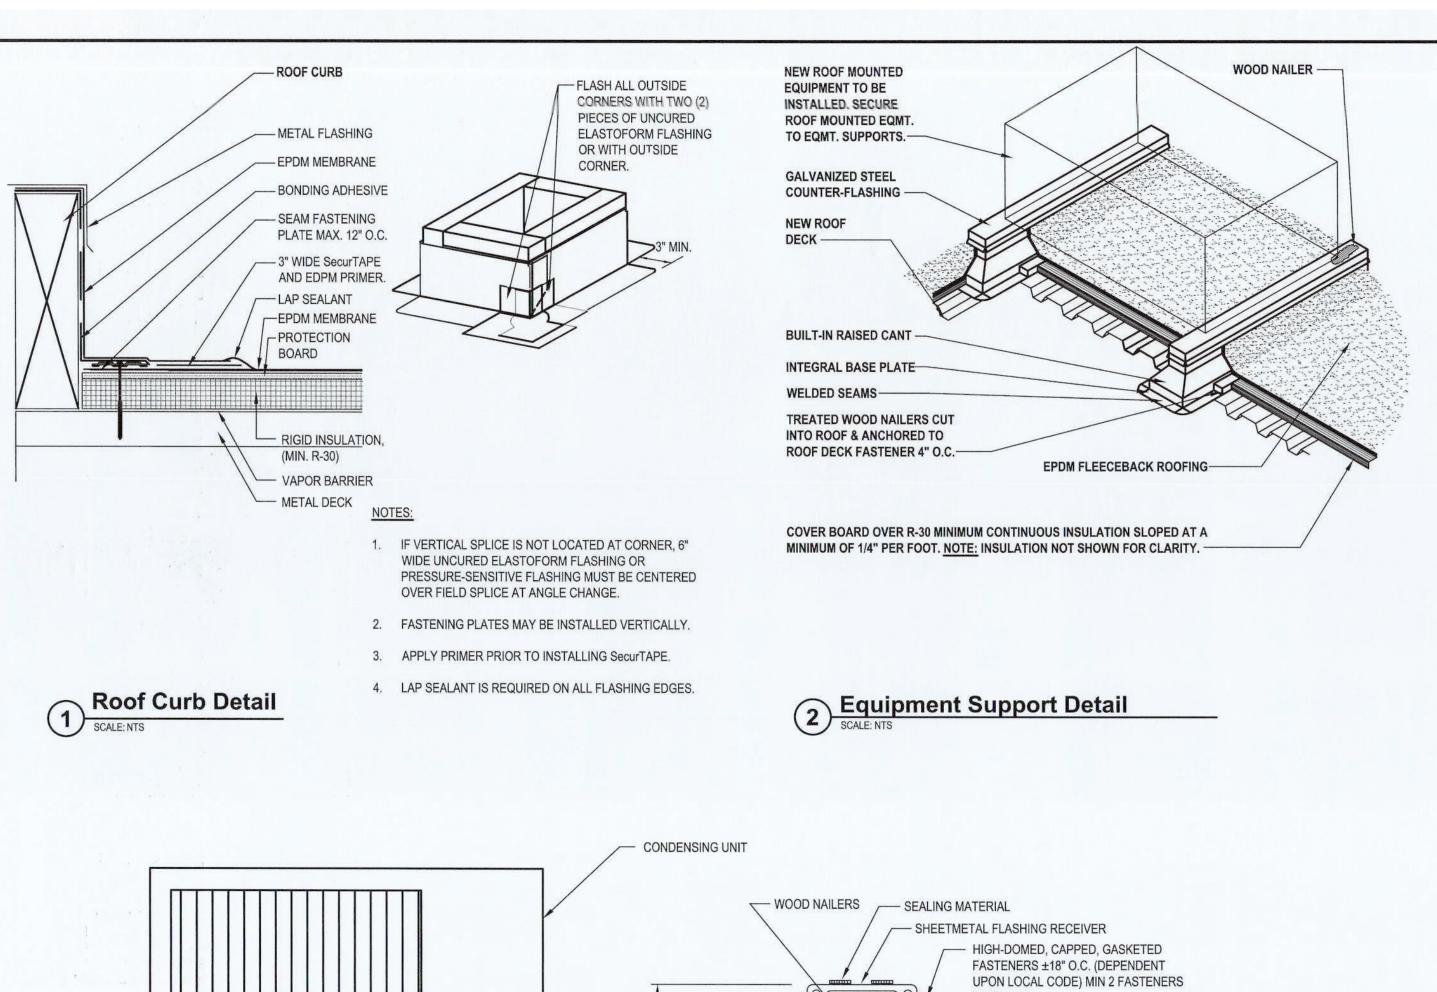

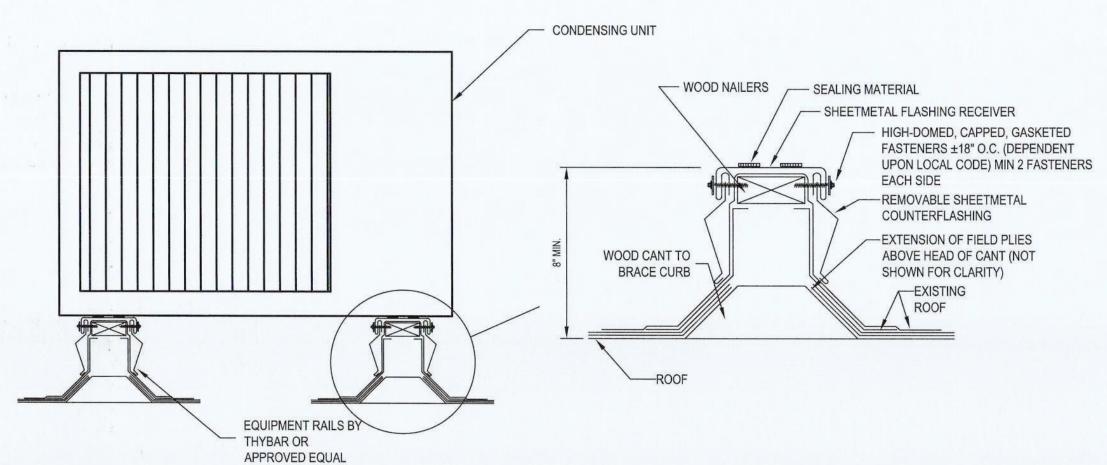


# 5 Condensing Unit Curb Detail

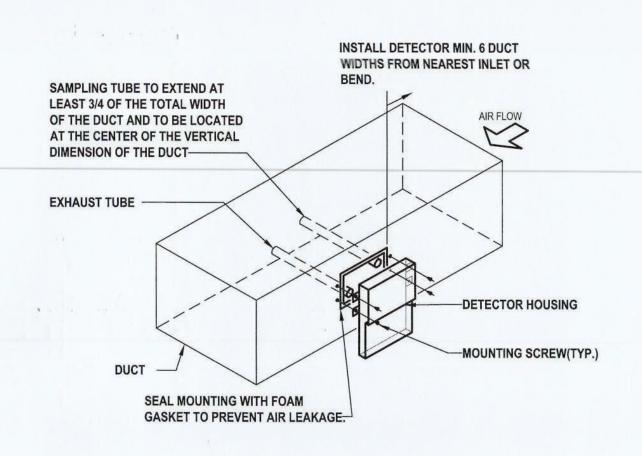


NOTES:

INTERFACE OF NEW DUCT SMOKE DETECTORS W/ EXISTING

7 Duct Mounting Smoke Detector Detail
SCALE: NTS

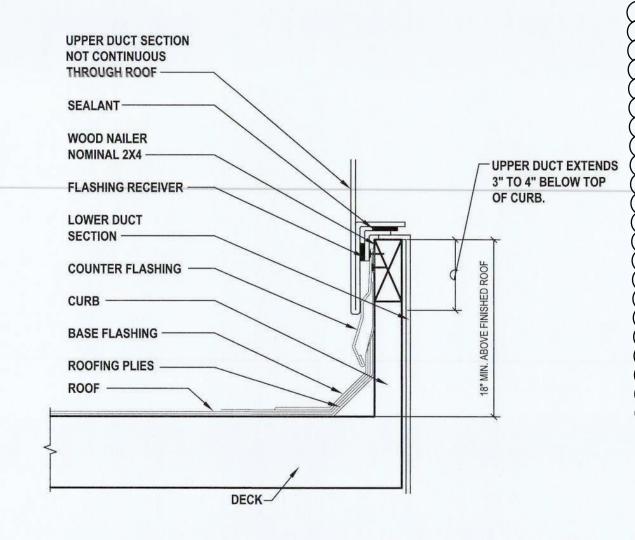

8 Ductwork Roof Penetration Detail
SCALE: NTS

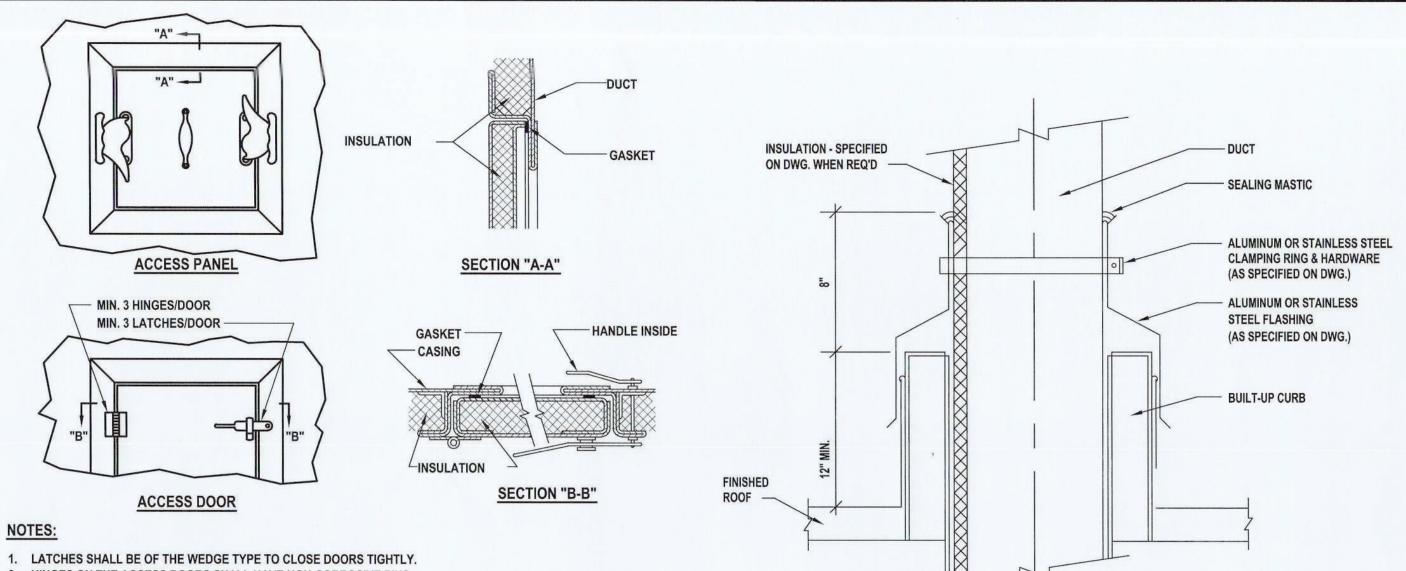

ANGLE IRON FRAME. ALL FOUR SIDES FASTENED TO DUCT SLEEVE.(SEE TABLE) —


THREADED

HANGER RODS -

VIBRATION ISOLATOR

DUCTWORK -

- 2. HINGES ON THE ACCESS DOORS SHALL HAVE NON-CORROSIVE PINS.
- 3. PROVIDE ACCESS DOORS ON AIR HANDLING UNITS AND DUCTWORK INSTALLED IN EQUIPMENT ROOMS. PROVIDE ACCESS PANELS ON ALL EQUIPMENT AND DUCTWORK INSTALLED ABOVE FINISHED CEILINGS WHERE SPACE LIMITATIONS DO NOT ALLOW HINGED DOORS TO OPEN.

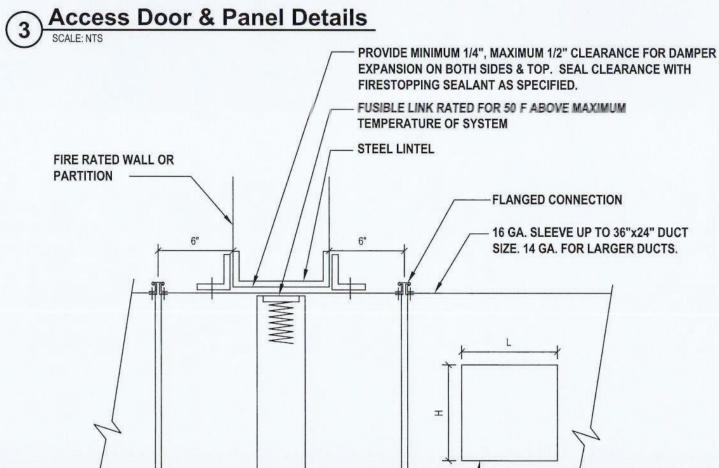

- FASTEN FIRE DAMPER FRAME TO SLEEVE

6 Low Pressure Fire Damper Detail

9 Inline Fan Coil Hanging Support Detail
SCALE: NTS

- ACCESS DOOR: MIN. HEIGHT 12" OR 1"

SMALLER THAN DUCT HEIGHT. MIN. LENGTH

THREADED ROD

ANGLE IRON OR CHANNEL

PROVIDE RIGID CONNECTIONS IF

PROVIDE FLEXIBLE CONNECTION

EQUIPMENT IS <75LB.

IF EQUIPMENT IS >75LB.

**Duct Roof Penetration Detail**SCALE: NTS

### **GENERAL NOTES:**


- FIRE DAMPER TO BE U.L. LABELED N.F.P.A. 90A. 2. N.F.P.A. APPROVED INSTALLATION DETAILS TO BE PART OF SUBMISSION OF FIRE DAMPER FOR APPROVAL, WHICH SHALL MEET N.F.P.A. STANDARD 90A.
- 3. DETAILS SHOWN ARE FOR FIRE DAMPERS IN HORIZONTAL DUCTWORK. FOR FIRE DAMPERS IN VERTICAL DUCTWORK, DETAILS SIMILAR EXCEPT DAMPERS SHALL BE SPRING LOADED.
- 4. U.L. APPROVED BREAKAWAY SLIP JOINT CONNECTION MAY BE USED IN LIEU OF FLANGED CONNECTION. ACCESS DOOR IS SHOWN ON SIDE OF DUCT.
- IF FUSIBLE LINK IS MORE ACCESSIBLE FROM BOTTOM OF DUCT, RELOCATE ACCESS DOOR. 6. FROM FIRST 10'-0" OF FAN DISCHARGE DUCTS AND FOR DUCT SIZES LESS THAN 6" DEEP, FIRE DAMPER BLADES SHALL BE

INSTALLED IN POCKET OUTSIDE OF AIR STREAM.

85" T0 120"

ANGLE	IRON TABLE
WALL OPENING	ANGLE SIZE
JP TO 30"	1"x1"x1/8"
31" TO 54"	1-1/2"x1-1/2"x1/8"
55" TO 84"	3"x2"x3/16"

3"x2"x3/16"

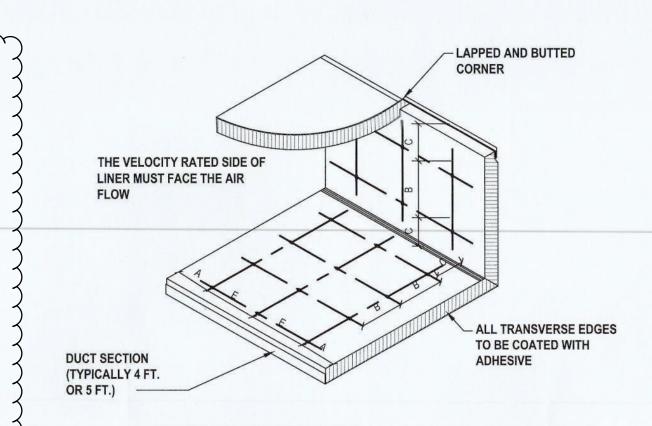

MAXIMUM SPACING FOR FASTENERS. LINER ADHERED TO THE DUCT WITH ACTUAL INTERVALS ARE APPROXIMATE. 90% MIN. AREA COVERAGE OF


\* UNLESS A LOWER LEVEL IS

SET BY MANUFACTURER OR

LISTING AGENCY


VELOCITY*		DIMENS	SIONS	
VELOCITY*	Α	В	С	E
0-1500 FPM	3"	12"	4"	18"
1501-3500 FPM	3"	6"	4"	16"

Acoustical Liner Fastening Detail
SCALE:NTS

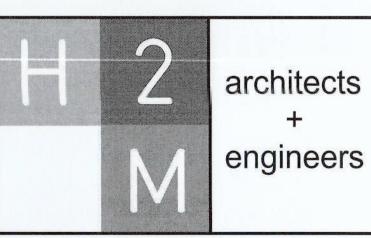

538 Broad Hollow Road, 4th Floor East Melville, NY 11747 631.756.8000 • www.h2m.com

MARK	DATE	DESCRIPTION
2	12/22/2022	REVS. PER TOWN COMMENTS

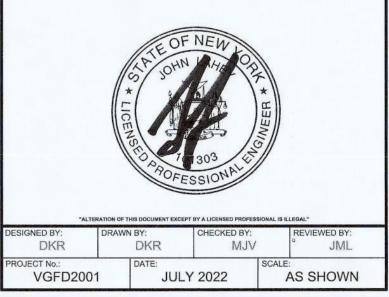

## **VAILS GATE FIRE** DISTRICT

New Storage Building (Phase I) New Fire Station (Phase II)




872 Blooming Grove Turnpike New Windsor, NY 12553

**CONTRACT G** GENERAL CONSTRUCTION

FINAL BID DOCUMENT

**HVAC DETAILS (1 OF 4)** 

M2 500.02

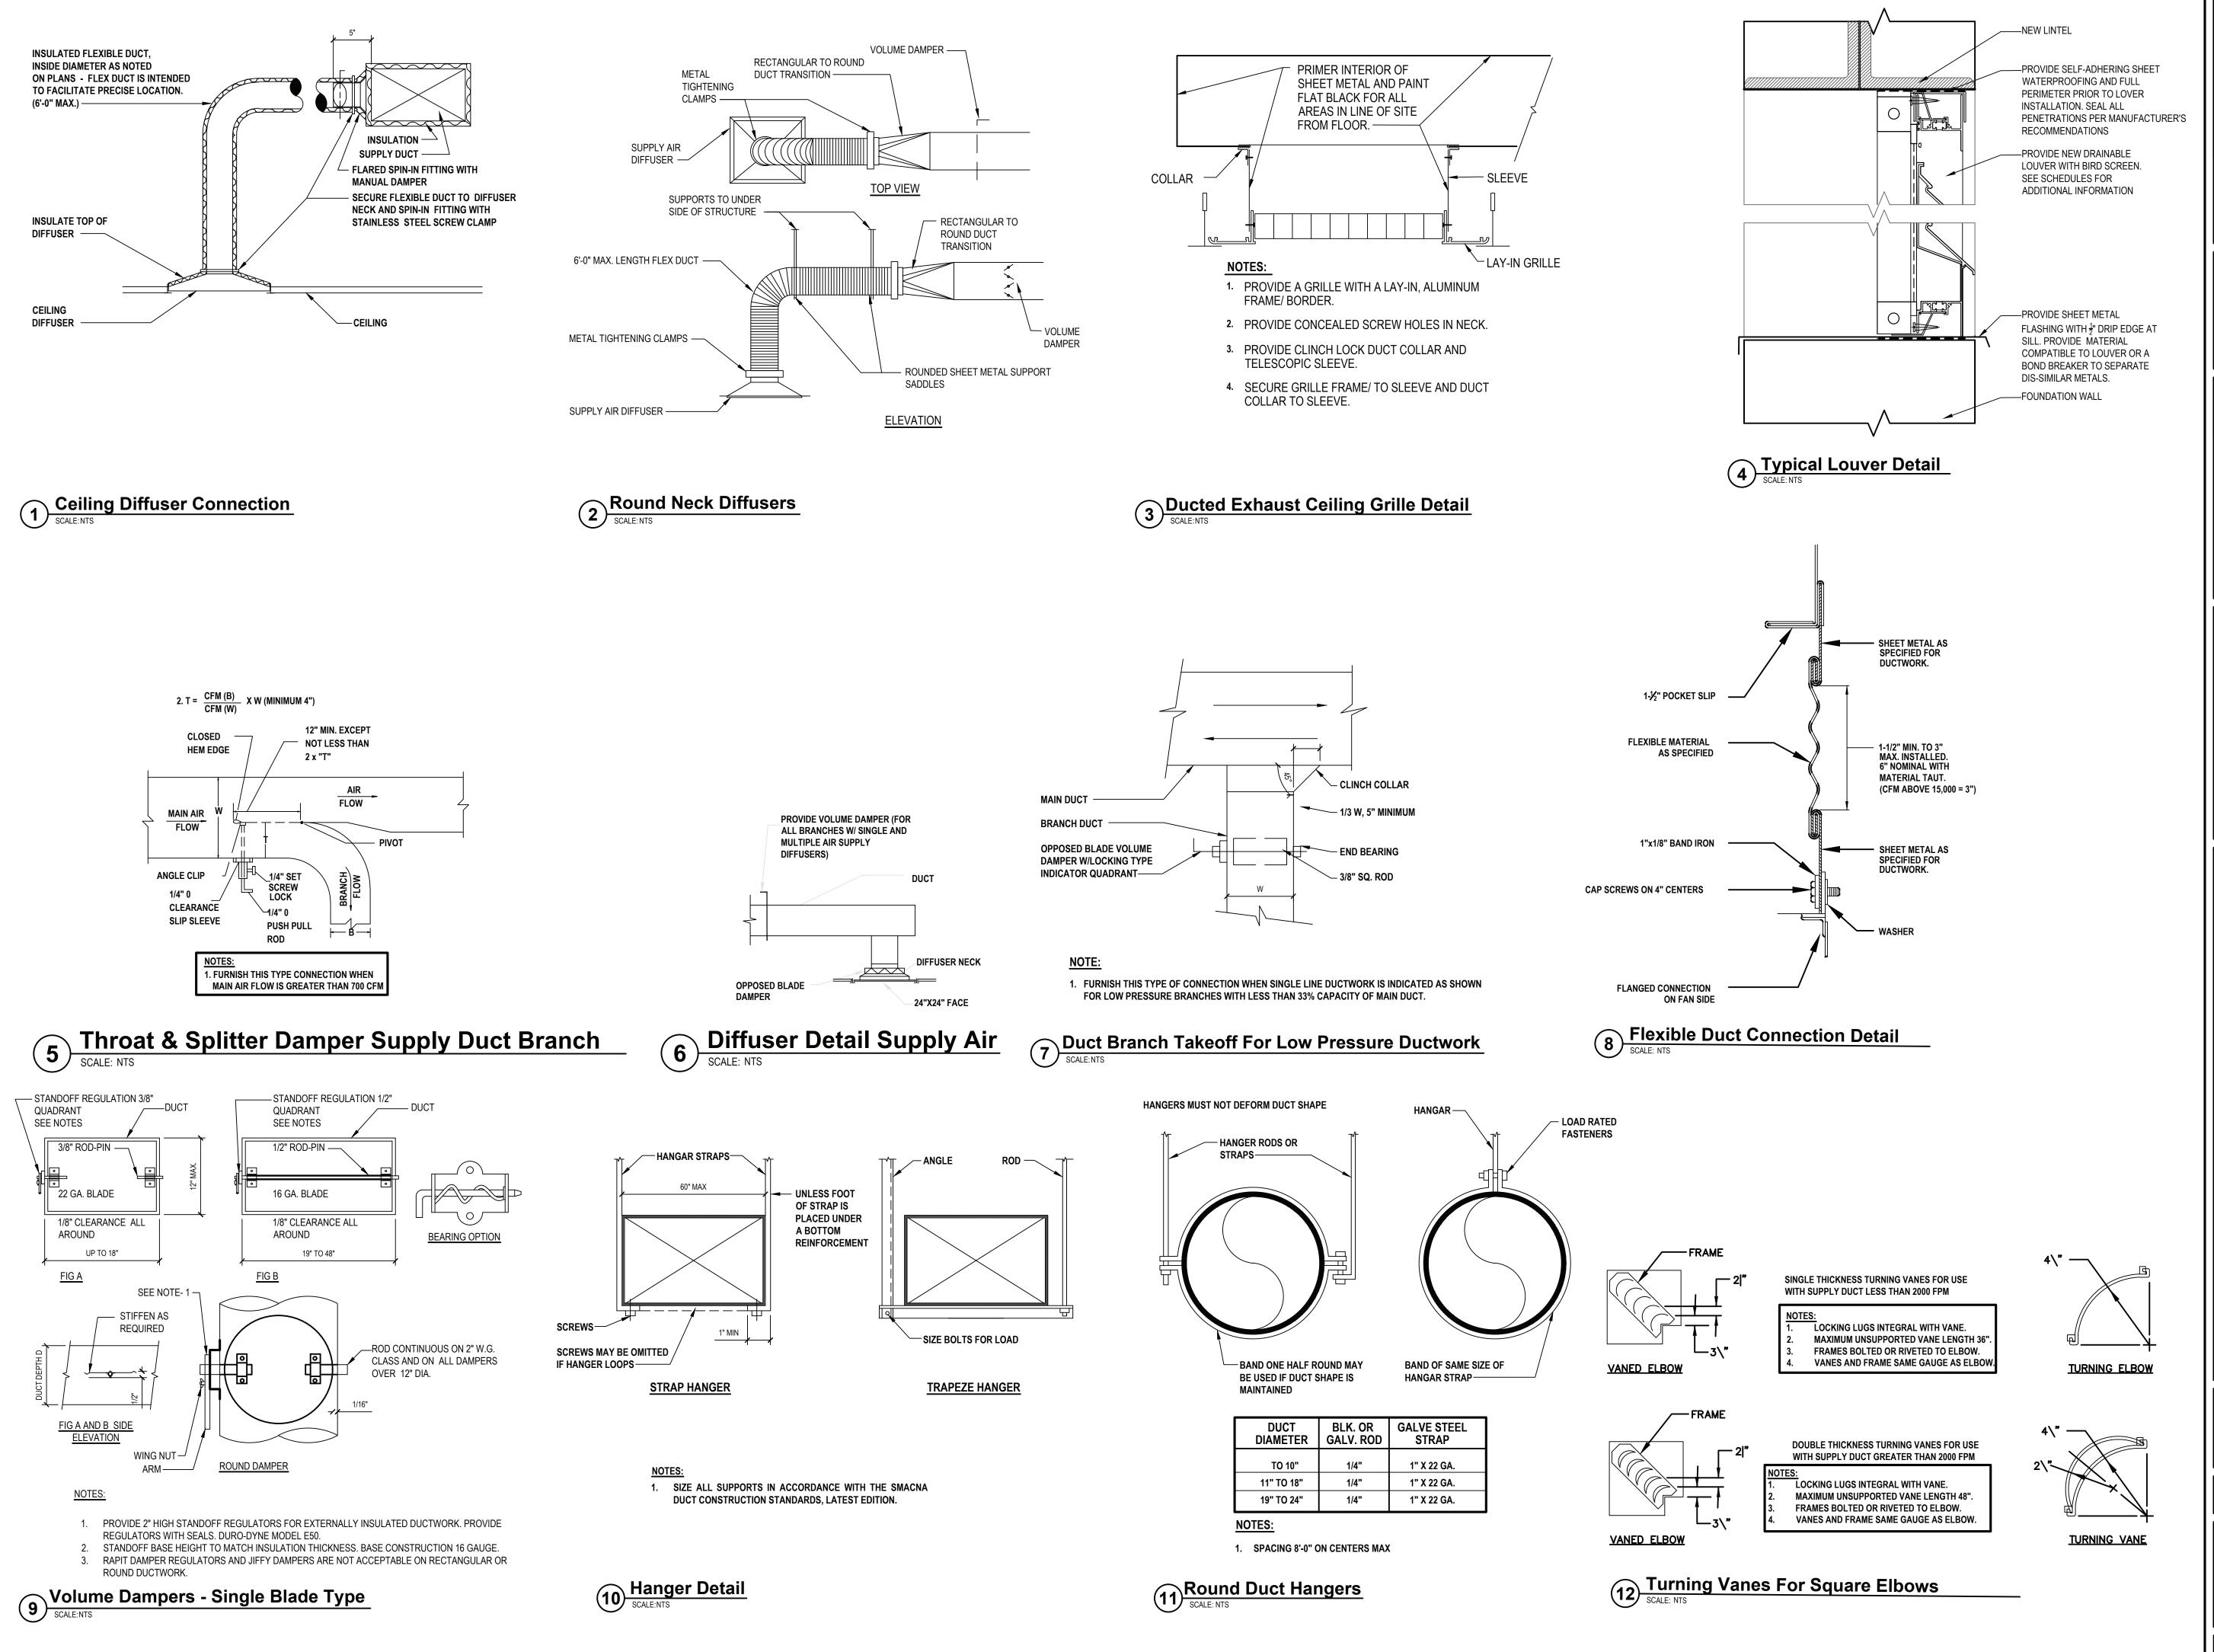


architects
+
engineers

538 Broad Hollow Road, 4th Floor East Melville, NY 11747 631.756.8000 • www.h2m.com

TANTS:

MARK	DATE	DESCRIPTION
	1	

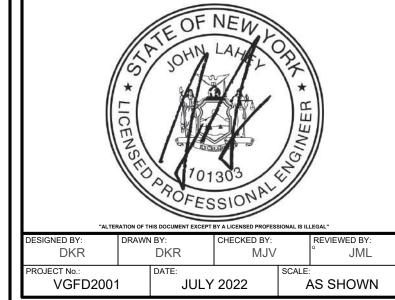

# VAILS GATE FIRE DISTRICT

New Storage Building (Phase I)
New Fire Station (Phase II)



872 Blooming Grove Turnpike New Windsor, NY 12553


CONTRACT G
GENERAL CONSTRUCTION

FINAL BID DOCUMENT

ITI F

**HVAC DETAILS (2 OF 4)** 


M2 501.00

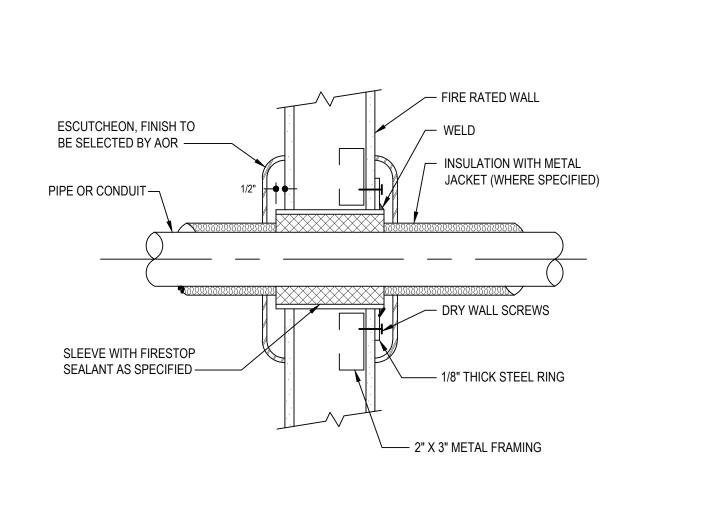



**Pipe or Conduit Penetration** 

Through Fire Rated Walls

SCALE: NTS (DETAIL#)

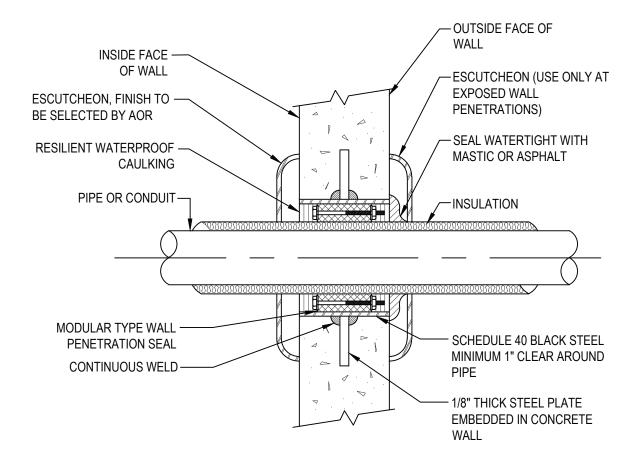

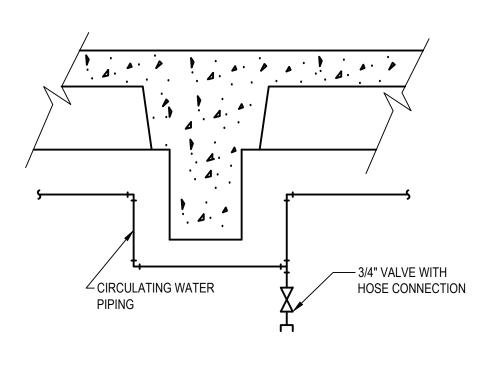

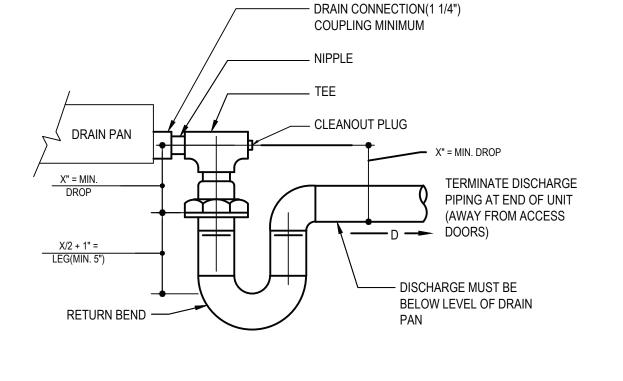

engineers

DESCRIPTION

JML

AS SHOWN

538 Broad Hollow Road, 4th Floor East Melville, NY 11747

631.756.8000 • www.h2m.com

MARK DATE

DKR

JULY 2022

**VAILS GATE FIRE** 

**DISTRICT** 

**New Storage Building (Phase I)** 

New Fire Station (Phase II)

**872 Blooming Grove Turnpike** 

New Windsor, NY 12553

**CONTRACT G** 

**GENERAL CONSTRUCTION** 

FINAL BID DOCUMENT


VGFD2001

X = NEGATIVE INTERNAL STATIC PRESSURE AT FAN INLET(IN.)

- ALLOW SUFFICIENT SPACE BELOW DRAIN PAN FOR TRAP.
- 2. PITCH DRAIN FOR PROPER RUN-OFF.
- 3. MANUALLY PRIME FILL TRAP BEFORE START-UP TO FORM INITIAL DRAIN SEAL
- 4. SUPPORT LENGTHY DRAIN LINES TO PREVENT SAG AND CONDENSATE OVERFLOW.
- PROVIDE DRAIN SEAL AT EACH AC UNIT.







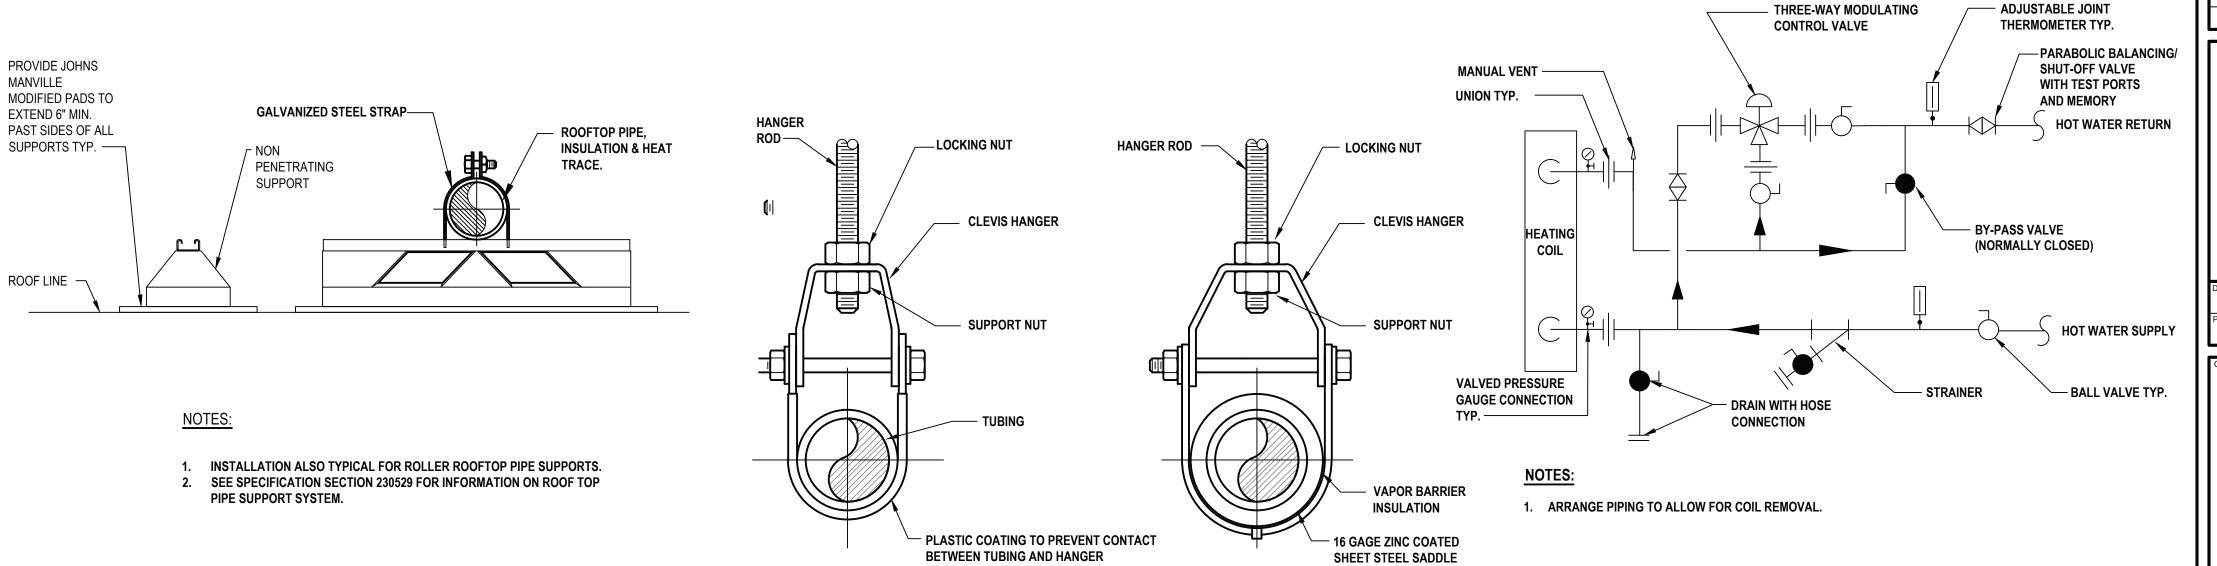




AT LEAST 12" LONG

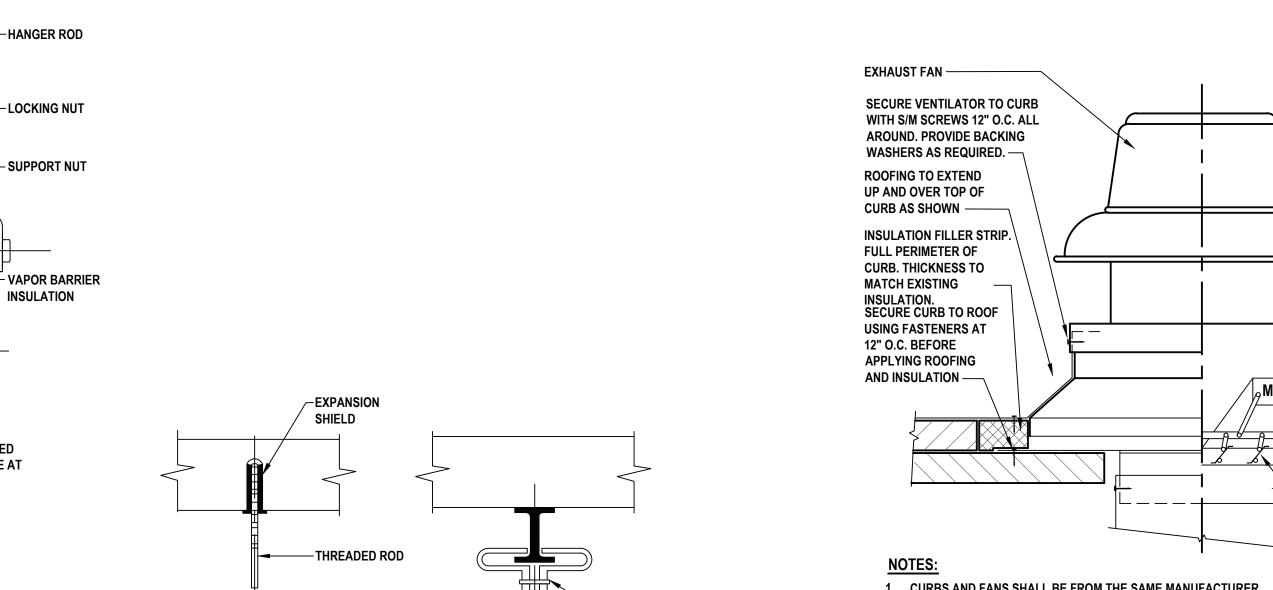

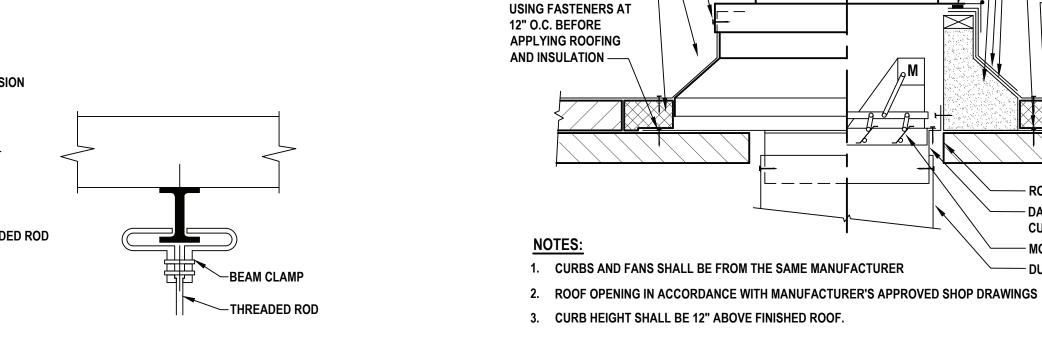

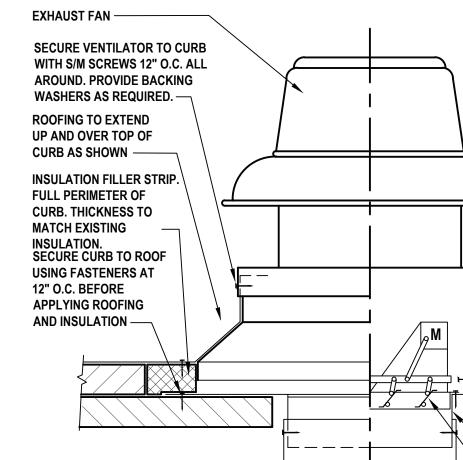



- ROOF OPENING - DAMPER SHELF BUILT INTO - MOTORIZED DAMPER

**HVAC DETAILS (3 OF 4)** 


Roof Exhaust Fan & Curb

| SCALE:NTS (DETAIL#)

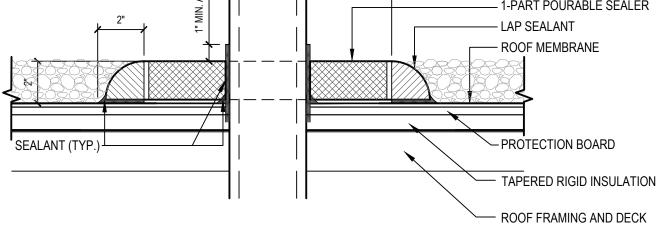

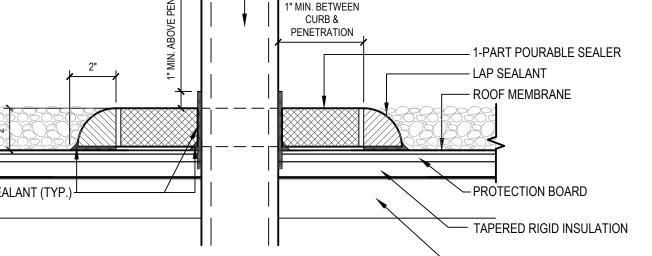

- MECHANICAL OR ELECTRICAL PIPING

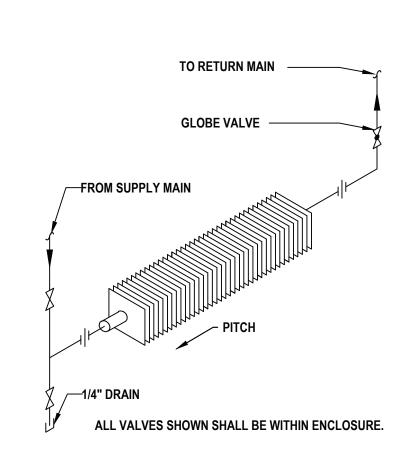

9 Hot Water Fin Tube Radiation Down Feed Piping
SCALE: NTS

Steel Pipe Hanger

SCALE: NTS

SPECIFIED SHALL BUTT

AGAINST PIPE HANGERS.

MANVILLE

**ROOF LINE** 

HEAVY DUTY CLEVIS

HANGER

Roof Pipe Support Detail

SCALE: NTS

LEAST 12" LONG. HANGER ROD SCHEDULE PIPE SIZE ROD SIZE **ROD SIZE** PIPE SIZE UP TO 2" 4" THRU 5" 5/8" DIA. 3/8" DIA. 1/2" DIA 2 1/2" THRU 3"

- 16 GAUGE ZINC COATED SHEET STEEL SADDLE AT

HEAVY DUTY CLEVIS

HANGER

PIPE HANGER SUPPORT DETAIL
SCALE: NTS

M2 502.00

NEOPRENE GASKET APPLIED TO

HINGE KIT WITH RESTRAINT CABLES

PREFABRICATED CURB FURNISHED

-COUNTERFLASHING PROVIDED BY "M'

— SECURE CURB TO ROOF WITH S/M SCREWS, LAG BOLTS OR OTHER METHOD CONSISTANT

WITH ROOF CONSTRUCTION

-CURB FASTENING FLANGE

FINISHED ROOF
EXISTING ROOF
INSULATION


EXISTING ROOF DECK

BY "M" AND INSTALLED BY "M"

UNDERSIDE OF UNIT CURB CAP

MOUNTED TO CURB CAP

- ALUMINUM TWIN-SHELL

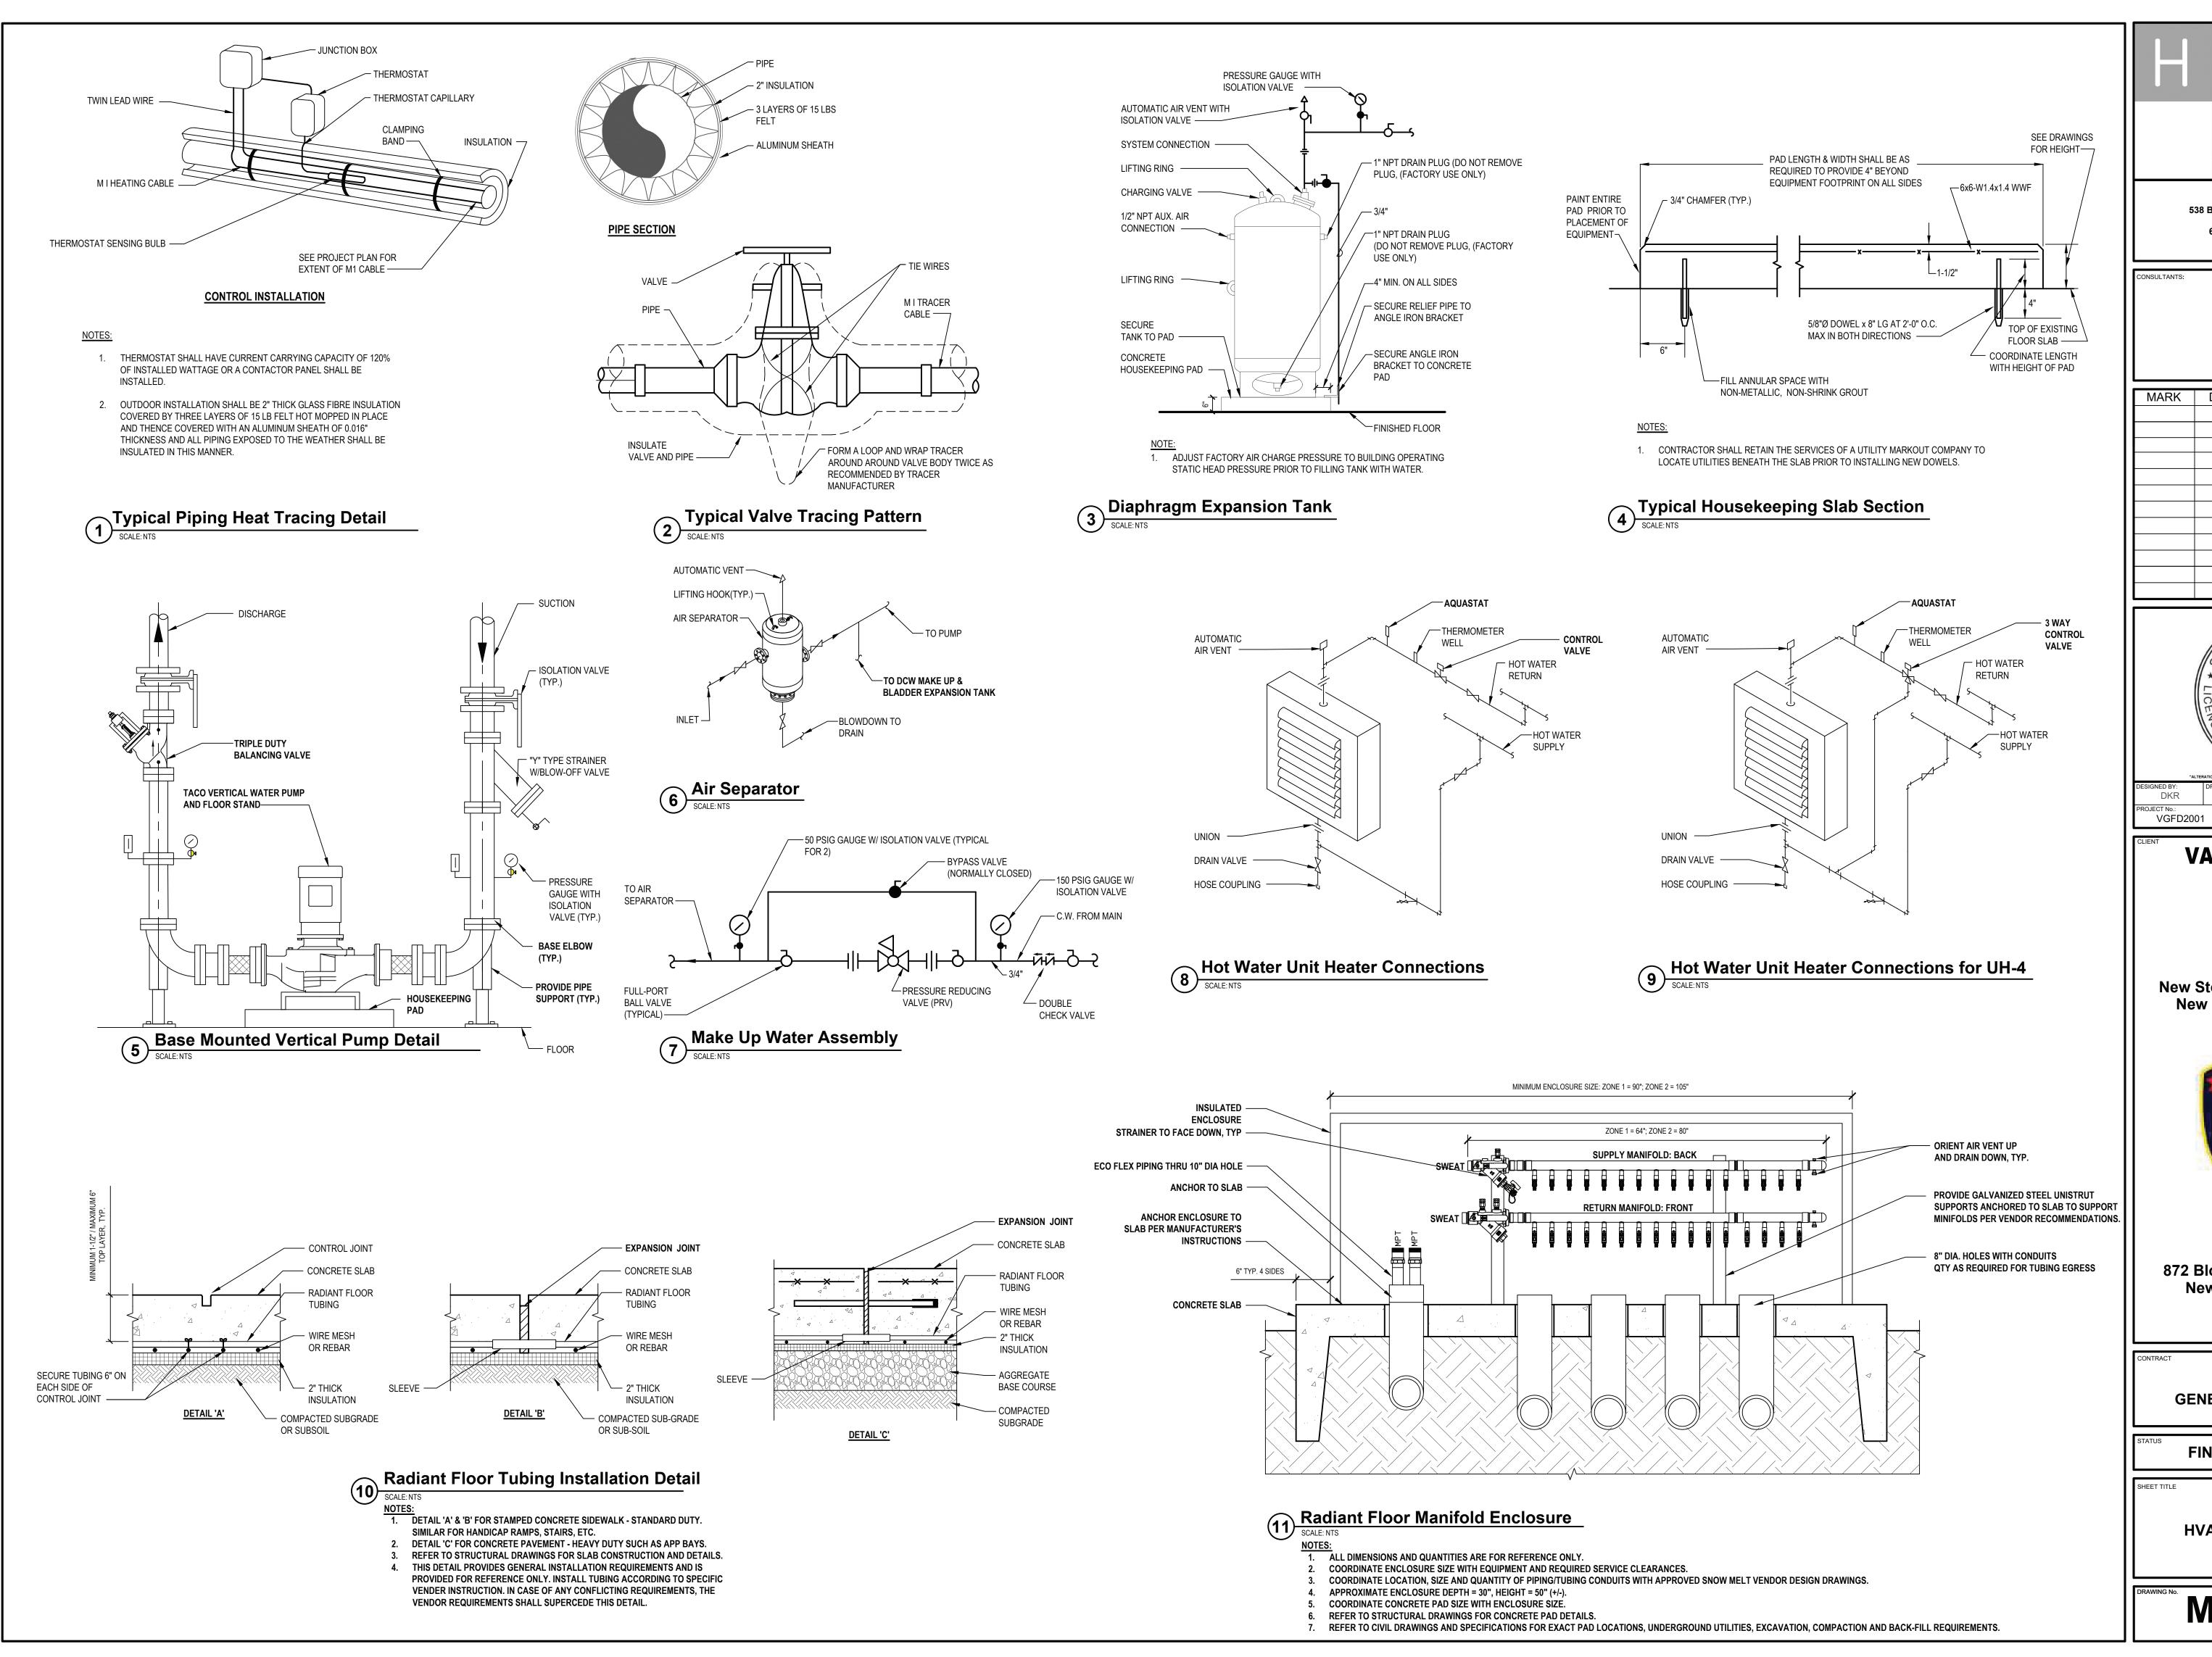

H 2 architects + engineers

538 Broad Hollow Road, 4th Floor East Melville, NY 11747 631.756.8000 • www.h2m.com

JOETANIO.

MARK	DATE	DESCRIPTION



# VAILS GATE FIRE DISTRICT

New Storage Building (Phase I)
New Fire Station (Phase II)



872 Blooming Grove Turnpike New Windsor, NY 12553

CONTRACT G
GENERAL CONSTRUCTION

FINAL BID DOCUMENT

**HVAC DETAILS (4 OF 4)** 

M2 503.00

	TION INDEX BASED ON 2					OCCUPANT		EXHAUST					EXHAUST
ROOM NUMBER	ROOM NAME	OCCUPANCY CLASSIFICATION	FLOOR AREA (SF)	OCCUPANCY LOAD (PERSONS/1000 SF)	NUMBER OF OCCUPANTS	BASED OA RATE (CFM/OCCUPANT)	AREA BASED OUTSIDE AIR RATE (CFM/SF)	RATE (CFM/SF)	FIXTURES	UNCORRECTED OA (CFM)	Ez EFFICIENCY FACTOR (HEATING)	CORRECTED OA [HEATING] (CFM)	REQUIRED (CFM)
101 / 223	APP BAY	GARAGE	5051	0	0	0	0.00	0.75	0	0	0.80	0	3788
	MEZZANINE	GARAGE	900	0	0	0	0.00	0.75	0	0	0.80	0	675
102	RADIO ROOM	OFFICE	158	5	1	5	0.06	0.00	0	14	0.80	18	0
103	STORAGE1	STORAGE	121	0	0	0	0.12	0.00	0	15	0.80	18	0
104	STORAGE2	STORAGE	97	0	0	0	0.12	0.00	0	12	0.80	15	0
105	DECON	TOILET	117	0	0	0	0.00	0.00	2	-	-	-	100
106	LAUNDRY	LAUNDRY	145	20	3	7	0.12	0.00	0	40	0.80	50	0
107	GEAR ROOM	LOCKER	735	0	0	0	0.00	0.25	0	-	-	-	184
108	TOILET	TOILET	67	0	0	0	0.00	0.00	1	-	-	-	50
109	SCBA	OFFICE	201	5	2	5	0.06	0.00	0	22	0.80	28	0
111	SPARE TURNOUT GEAR	STORAGE	65	0	0	0	0.06	0.00	0	4	0.80	5	0
112	VENDOR DROP OFF	CORRIDOR	45	0	0	0	0.06	0.00	0	3	0.80	3	0
113	CORRIDOR	CORRIDOR	556	0	0	0	0.06	0.00	0	33	0.80	42	0
114	QUARTERMASTER	OFFFICE	66	5	1	5	0.06	0.00	0	9	0.80	11	0
115	JC	JC	41	0	0	0	0.00	0.00	1	-	-	-	50
116	MEETING	CONFERENCE	3000	50	150	5	0.06	0.00	0	930	0.80	1163	0
117	STORAGE	STORAGE	126	0	0	0	0.06	0.00	0	15	0.80	19	0
118	KITCHEN	KITCHEN	433	20	9	7	0.12	0.70	0	119	0.80	149	303
119	PANTRY	STORAGE	66	0	0	0	0.06	0.00	0	4	0.80	5	0
120	READY ROOM	DAY ROOM	221	30	7	5	0.06	0.00	0	48	0.80	60	0
123	ELEVATOR LOBBY	CORRIDOR	45	0	0	0	0.06	0.00	0	3	0.80	3	0
125A	LOBBY	LOBBY	353	10	4	5	0.06	0.00	0	41	0.80	51	0
126	VESTIBULE	CORRIDOR	53	0	0	0	0.00	0.00	0	0	0.80	0	0
127	TOILET	TOILET	187	0	0	0	0.00	0.00	4	-	-	-	200
128	TOILET	TOILET	185	0	0	0	0.00	0.00	4	-	-	-	200
201	CORRIDOR	CORRIDOR	186	0	0	0	0.06	0.00	0	11	0.80	14	0
202	MEETING	CONFERENCE	381	50	20	5	0.06	0.00	0	123	0.80	154	0
203	MEMBER VESTIBULE	LOBBY/ PREUNCTION	126	30	4	7	0.06	0.00	0	38	0.80	47	0
203A	COMPANY ROOM	CONFERENCE	1082	50	55	5	0.06	0.00	0	340	0.80	425	0
203B	KITCHEN	KITCHEN	78	20	2	7	0.12	0.70	0	24	0.80	30	55
204	STORAGE	STORAGE	39	0	0	0	0.06	0.00	0	5	0.80	6	0
205	STORAGE	STORAGE	78	0	0	0	0.06	0.00	0	9	0.80	12	0
206	TRAINING ROOM	CONFERENCE	1005	50	51	5	0.06	0.00	0	315	0.80	394	0
207	EXERCISE ROOM	WEIGHT ROOM	1000	10	10	20	0.06	0.00	0	260	0.80	325	0
208	BATHROOM	BATHROOM	95	0	0	0	0.00	0.00	2	-	-	-	100
209	BATHROOM	BATHROOM	95	0	0	0	0.00	0.00	2	-	-	-	100
210	CORRIDOR	CORRIDOR	505	0	0	0	0.06	0.00	0	30	0.80	38	0
211	COMMISIONER'S OFFICE	OFFFICE	144	5	1	5	0.06	0.00	0	14	0.80	17	0
212	TRUSTEE'S OFFICE	OFFFICE	142	5	1	5	0.06	0.00	0	14	0.80	17	0
213	COMPANY OFFICERS	OFFFICE	118	5	1	5	0.06	0.00	0	12	0.80	15	0
214	ASST. CHIEF'S OFFICE	OFFFICE	118	5	1	5	0.06	0.00	0	12	0.80	15	0
215	CHIEF'S OFFICE	OFFFICE	115	5	1	5	0.06	0.00	0	12	0.80	15	0
216	ADMIN STORAGE	STORAGE	42	0	0	0	0.06	0.00	0	5	0.80	6	0
217	RATED STORAGE 1	STORAGE	82	0	0	0	0.06	0.00	0	10	0.80	12	0
218	RATED STORAGE 1	STORAGE	82	0	0	0	0.06	0.00	0	10	0.80	12	0
220	JC	JC	64	0	0	0	0.00	0.00	1	-	-	-	50

LOUV	LOUVERS												
			PERFORMANCE/CONSTRUCTION REQUIREMENTS							S OF DESI	GN INFORMATIO	N	
EQMT. TAG	LOCATION	SERVING	CFM	EXT S. P. (IN. W.C.)	FACE VELOCITY (FPM)	FREE AREA (FT <sup>2</sup> )	FRAME THICKNESS (IN.)	BLADE THICKNESS (IN.)	MNF	MODEL NO.	NOMINAL DIMENSIONS (W" x H" x D")	WEIGHT (LBS.)	NOTES
LV-1	APPARATUS BAY	APPARATUS BAY	2,250	0.03	431	5.13	.125	.081	GREENHECK	ESD-635	72 x 24 x 6	39	1,3
LV-2	APPARATUS BAY	APPARATUS BAY	2,250	0.03	431	5.13	.125	.081	GREENHECK	ESD-635	72 x 24 x 6	39	1,3
LV-3	WORK ROOM	APPARATUS BAY	4,500	0.12	954	4.78	.125	.081	GREENHECK	ESD-635	72 x 24 x 6	39	2-3
LV-4	GEAR ROOM	GEAR ROOM	200	0.07	671	0.29	.081	.081	GREENHECK	ESD-435	12 x 12 x 4	3	3-4
LV-5	BOILER ROOM	BOILER ROOM	N/A	N/A	N/A	4.07	.125	.081	GREENHECK	ESD-635	30 x 36 x 6	30	1,3
LV-6	ELEVAOR	ELEVATOR	N/A	N/A	N/A	1.82	.081	.081	GREENHECK	ESD-435	24 x 24 x 4	15	5-8

4. PROVIDE 12" SLEEVE.

PROVIDE 18" SLEEVE.AND BLANK OFF PANEL. 3. PROVIDE WITH INTERNAL BIRSDCREEN.

PROVIDE WITH (120V/1) VCD-23 MOTORIZED DAMPER W/ INTERNAL ACTUATOR 1. PROVIDE 24" SLEEVE WITH VCD-23 MOTORIZED DAMPER 115V/ 1 INTERLOCKED WITH OPERATION OF APPARATUS BAY GENERAL EXHAUST. 5. MOUNTING CLIPS TO REMOVE LOUVER AND ACCESS DAMPER FROM BUILDING EXTERIOR

DAMPER CONTROLLED BY THERMOSTAT SET TO OPEN DAMPER AT 90F
 CONFIRM INSTALL WITH ELEVATOR MANUFACTURER

HIGH VOLUME	LOW SPEED F	ANS								
				BASIS OF D	ESIGN INFORI	MATION				
FAN NO.	AREA SERVED				NOMINAL		Е	LECTRICAL DATA	1	REMARKS
7,11,110	, in a second se	FAN/MOTOR RPM	MNF	MODEL NO.	DIMENSION (DIA" x H")	WEIGHT (LBS.)	VOLTS /PHASE	OPERATING AMPERAGE	MOTOR HP	
HVLS-1 THRU 3	APPARATUS BAY	148	BIG ASS FANS	BASIC6-10	120 x 46.5	135	208 / 3	10 A	1.0	1,2

NOTES:

1. MANUFACTURER TO PROVIDE VFD MOTOR. PROVIDE BAFCON CONTROLLER SERVING ALL HVLS FANS IN AREA SERVED. PROVIDE MULTI-FAN KIT.

AIR OUTI	LETS					
SYMBOL	BASIS OF DESIGN: MNF/ MODEL NO.	DESCRIPTION	FACE SIZE (IN)	AIR FLOW RANGE (CFM)	NECK SIZE (IN.)	REMARKS
				0-200	6"Ø	
IXI	NAILOR	SQUARE FACE	24 X 24 OR 12 X 12,	201-230	8"Ø	4
SD-A	AUNI	CEILING DIFFUSER	SEE DRAWINGS	231-320	10"Ø	1
SD-A (CFM)				321 - 460	12"Ø	
			8 x 8	0-100	6 x 6	
SG-A	NAILOR 61DV-O	DOUBLE DEFLECTION SUPPLY GRILLE	12 x 8	101-225	10 x 6	1
(CFM)	0154-0	OUT ET ORIELL	14 x 8	226-290	12 x 6	
RG-A (CFM)	NAILOR 61FB45-O	RETURN GRILLE	24 X 24	0-1190	20 x 20	1,3
	NAILOR 6145H-O	EXHAUST GRILLE	24 X 24 OR 12 X 12, SEE DRAWINGS	0-150	6x6	1
EG-A (CFM)				151-420	12 x 10	
				0-100	6x6	
	NAILOR 5145H-OA	EXHAUST GRILLE	24 X 24 OR 12 X 12, SEE DRAWINGS	101-200	8x6	1,2
EG-B (CFM)				201-325	12x8	
EG-C (CFM)	NAILOR 5145H	EXHAUST GRILLE	24 x 24 OR 12 x 12, SEE DRAWINGS	N/A [MATCH DUCTWORK OR OPEN TO PLENUM]	N/A [MATCH DUCTWORK OR OPEN TO PLENUM]	1,2
EG-D (CFM)	NAILOR 6145HC	EXHAUST GRILLE	18 x 10	0-450	16 x 8	1

1. PROVIDE VOLUME DAMPERS FOR ALL AIR INLETS AND OUTLETS

2. ALL ALUMINUM CONSTRUCTION (TERMINAL AND DAMPER), PROVIDE ALUMINUM CONSTRUCTION IN SHOWER AREAS.

3. PROVIDE WITH 2" FILTER BOX AND MERV-8 FILTER.

VEH	ICLE GAS	DETE	CTION	SYSTEM									
EQMT. LOCATION SYSTEM SYSTEM NOTES													
NO.	LOCATION	SERVED	MNF	MODEL NO.	NOMINAL DIMENSIONS L" x W" x H"	VOLTS / PHASE	NOTES						
GDS-2	APPARATUS BAY	GX-2	RKI BEACON	410A (4 CHANNEL)	10.5 x 6.5 x 14	120/1	1-7						

1. INCLUDE FOUR CHANNEL DIGITAL CONTROLLER IN NEMA 4 ENCLOSURE FOR WALL MOUNT.

2. LED DISPLAY FOR ALL FOUR CHANNELS FOR NO2 AND CO

INCLUDE (2) NITROGEN DIOXIDE SENSORS AND (2) CARBON MONOXIDE SENSORS 4. PROVIDE CONFIGURABLE ALARM OUTPUTS WITH ISOLATION RELAYS FOR INTERLOCK WITH THE EF & FACP.

5. PROVIDE PANEL MOUNTED AUDIBLE ALARM AND SILENCING SWITCH

PROVIDE ALARM HORN WITH STROBE.

7. PROVIDE STARTUP, TEST AND CALIBRATION REPORT.

		PERFORM	ANCE/CONST	RUCTION REQU	<b>IIREMENTS</b>		BASIS	OF DESIGN INF	ORMATIO	N		
FAN NO.	SYSTEM SERVED	CFM	EXT S. P.	FAN/MOTOR	ВНР	MNF	MODEL	NOMINAL DIMENSION (DIA" x H")	WEIGHT	ELECT DA	-	NOTES
		CT W	(IN. W.C.)	RPM	DITE	IMIMI	NO.	(L" x W" x H")	(LBS.)	VOLTS /PHASE	MOTOR HP	
GX-1	APPARATUS ROOM	4,250	0.60	728	2.52	GREENHECK	QEID-22	36.5 x 30 x 35.5	370	208V / 3	3	3,4,10
GX-2	APPARATUS ROOM	250	0.30	1,550	0.03	GREENHECK	SQ-090-VG	19 x 15 x 15	72	115V / 1	1/10	2-4,6,9
GX-3	GEAR ROOM	200	0.30	1,550	0.03	GREENHECK	SQ-090-VG	19 x 15 x 15	72	115V / 1	1/10	2,3,5,6
GX-4	KITCHEN	325	0.40	1,625	0.22	GREENHECK	G-080-VG	22Ø x 27	62	115V / 1	1/10	2,3,6-8
TX-1	TOILET EXHAUST	700	0.60	1,625	0.22	GREENHECK	G-098-VG	24.5Ø x 25.5	78	115V / 1	1/4	2,3,6-8
TX-2	APP BAY TOILET	100	0.25	1,550	0.02	GREENHECK	SQ-060-D	16 x 12 x 12	34	115V / 1	1/40	2,3,5
TX-3	DECON ROOM 105	100	0.25	1,550	0.02	GREENHECK	SQ-060-D	16 x 12 x 12	34	115V / 1	1/40	2,3,5
ERXF-122	ELECTRIC ROOM 122	58	0.34	1,550	0.02	GREENHECK	SQ-060-D	16 x 12 x 12	34	115V / 1	1/40	2,11,12

NOTES:
1. CONTRACTOR TO PROVIDE WITH DISCONNECT SWITCH.

MANUFACTURER PROVIDED DISCONNECT SWITCH. PROVIDE WITH 115VAC (WITH 115 VAC TRANSFORMER) MOTORIZED DAMPER WITH END

4. FAN TO OPERATE BASED ON SIGNALS FROM INTERLOCKED TEMPERATURE SENSOR OR GAS DETECTIONS SYSTEM IN ADDITION TO 30-MINUTE SPRING TIMER. 5 FLECTRICAL TO INTERLOCK WITH LIGHT SWITCH

6. PROVIDE WITH DIAL FOR BALANCING ONLY PROVIDE 12" INSULATED ROOF CURB WITH BUILT-IN DAMPER TRAY.

ELECTRICAL TO PROVIDE TIME CLOCK 9. ELECTRICAL TO PROVIDE WALL SWITCH

10. REFER TO MOTORIZED DAMPER SCHEDULES 11. FAN TO OPERATE BASED ON THERMOSTAT IN SPACE

12 DDOVIDE CDAVITY BACKDDAET DAMDED

**CONTRACT G** 

872 Blooming Grove Turnpike New Windsor, NY 12553

**GENERAL CONSTRUCTION** 

DKR

JULY 2022

**VAILS GATE FIRE** 

**DISTRICT** 

New Storage Building (Phase I) New Fire Station (Phase II)

AS SHOWN

VGFD2001

engineers

DESCRIPTION

538 Broad Hollow Road, 4th Floor East Melville, NY 11747 631.756.8000 • www.h2m.com

MARK DATE

FINAL BID DOCUMENT

**HVAC SCHEDULES (1 OF 3)** 

M2 600.00

					5. ELECTR	CICAL TO INTERL	OCK WITH LIG	SHI SWIICH.			12.	PROVIDE GRA	AVIIY BACKD	RAFI DAMPER
мотс	RIZE	D DAM	PERS											
	PER	FORMANCE/	CONSTRUCT	TION REQUIREM	IENTS			BA	SIS OF DESIGN	INFORMATIO	N			
EQMT.		EXT S. P.	FACE	FRAME	FAILURE		MODEL	ACTUATOR	ACTUATOR	ACTUATOR	NOMINAL	ELECTRIC	AL DATA	REMARKS
TAG	CFM	(IN. W.C.)	VELOCITY (FPM)	THICKNESS	MODE	MNF	NO.	MNF	MODEL NO.	COUNT	DIMENSIONS (W" x H" x D")	VOLTAGE	POWER DRAW (W)	
MD-1	4,250	0.095	905	16 GAGUE	CLOSED	GREENHECK	VCD-23	HONEYWELL	MS8104F1210	1	26 x 26 x 5	24VAC	18	1-4

### AIR SCRUBBERS PERFORMANCE/ CONSTRUCTION REQUIREMENTS BASIS OF DESIGN INFORMATION **FAN DATA** FILTER DATA NOMINAL EQUIPMENT NO. LOCATION OPERATING NOTES MODEL NO. **DIMENSIONS** AIR FLOW (CFM) SOUND LEVEL VOLTS / OPERATING WEIGHT FILTER EFFICIENCY L" x W" x H" (dBA) [LO-MED-HI] PHASE [LO-MED-HI] CURRENT (A) GEAR ROOM 450 - 825 - 1,150 53 - 57 - 61 120V / 1 8.0 95% @ 0.3 MICRONS | HONEYWELL | F111C1012W-3S | 48 x 24 x 21.5 |

1. PROVIDE WITH THREE SPEED SWITCH.

1. TWO POSITION W/ SPRING RETURN

3. PROVIDE WITH STANDARD SLEEVE 4. INTERLOCK WITH OPERATION OF GX-1

2. ELECTRICAL CONTRACTOR TO PROVIDE DISCONNECT SWITCH.

2. EXTERNALLY MOUNTED ACTUATOR, COORDINATE LOCATION IN FIELD

5. ELECTRICAL CONTRACTOR TO PROVIDE 208V/3 TO 24VAC TRANSFORMER

3. PROVIDE WITH CPZ ODOR ELIMINATION MODULE.

26.7 | 12.2 | 14.7 | 80.0 / 67.0 | 59.4 / 58.4 | 65.6 | 4.4

RTU-207

. 4" PLEATED MERV-13 FILTERS WITH FOUR (4) SETS OF SPARE FILTER MEDIA.

207 TRAINING ROOM

HINGED ACCESS DOORS.

5. POWERED CONVENIENCE OUTLET.

DISCONNECT SWITCH (FACTORY MOUNTED). 4. DIRTY FILTER INDICATOR SWITCH.

ROOF

CONDENSER HAIL GUARD.

0.60

1,200

7. LOW LEAK COMPARATIVE ENTHALPY ECONOMIZER.

9. VERTICAL SUPPLY/RETURN CONNECTIONS

8. ELECTRICAL CONTRACTOR TO FURNISH AND WIRE SUPPLY AND RETURN AIR SMOKE DETECTORS. 12. PHASE MONITOR (PHASE LOSS PROTECTION.) MECHANICAL CONTRACTOR TO INSTALL.

33.0

325

10. BACNET DDC COMMUNICATION, INTERLOCK WITH BMS. 11. 14" ROOF CURB AND THRU BASE ELECTRICAL CONNECTIONS.

13. PROVIDE SPACE TEMPERATURE SENSOR(S) WITH DIGITAL DISPLAY, SETPOINT ADJUSTMENT, OCCUPANCY SCHEDULE.

150 119.9

14. SINGLE ZONE VARIABLE AIR VOLUME CONFIGURATION. 15. VARIABLE FREQUENCY DRIVE.

16. SINGLE POINT POWER FEED TO RTU AND CONVENIENCE OUTLET

105.1 | TEMPMASTER | ZR037C00B2B6ACA1A2 | 89 x 59 x 42 |

17. HOT GAS REHEAT DEHUMIDIFICATION 18. TWO STAGES OF COOLING

### DEDICATED OUTDOOR AIR UNITS

																																BASIS (	OF DESIGN INFO	RMATION			
ш	EQUIPMENT			SUPPLY	/ FAN			E	XHAUST F	AN						COOLING	COIL								HEATING (	COIL								NOMINAL	ELECTR	CAL DATA	
Ш	NO.	AREA SERVED	OUTSIDE	TOD	EVT C D	TOTAL S.P.	AIR	мотор	E	T C D TOTAL	S.D. DET	DIOEDANT	то	TAL SYSTEM	SENSIBLE UN	IT		AIF	R DATA			MIN TOTAL			Н	T WATER				MNF	.	MODEL NO.	NOMINAL	OPERATION	VOLTO!		NOTES
Ш	_		AIR FLOW H	P BHP	(IN W.C.)	(IN W.C.)	FLOW	MOTOR HP	BHP (II	I W.C.)   (IN W	- 3.P.   REF /.C.)	TYPE	ISMRE	CAPACITY	CAPACITY	COIL AIR	AP OA DB/WE	RA DB / W	/B ENT. DB /	COIL LVG	UNIT LVG	CAPACITY	FLOW RATE	EWT	LWT   COIL WATE	R OA DB	RA DB	EAT MA	X COIL UNIT	LAT		MODEL NO.	W" x H"	WEIGHT	PHASE N	CA MOCF	)
			(CFM)		,	,	(CFM)		<u> </u>					(MRH)	(MRH)	(IN. W.C.	) (°F)	(°F)	WB (°F)	DB/WB (°F)	DB/RH (°F)	(MRH)	(GPM)	(°F)	(°F) ΔP (IN. W.C	.) (°F)	(°F)	(°F) LA	AT (°F) (°	F)				(LDO)			
Ш	DOAS-1	1ST AND 2ND FLOOR VENTILATION	4,500 5	2.97	1.00	2.677	2,800	2	1.16	1.00 1.5	96	R-410A	6.8	206.9	143.7	0.24	95.0 / 75.0	75.0 / 63.0	0 84.2 / 69.2	55.1 / 54.7	75 / 50%	295.8	18.1	150	120 0.7	12.0	70.0	40.8	95.7 7	5 LG	Α	RDE-212-52-15H-15D	180.5 x 98.5 x 76.5	4,527	208/3	4.4 100	1-19

1. ENERGY RECOVERY WHEEL 2. HORIZONTAL DISCHARGE/EXHAUST CONFIGURATION

3. FACTORY PROVIDED INTEGRAL NONFUSED DISCONNECT 4. POWERED CONVENIENCE OUTLET

5. PROVIDE 14" ROOF CURB W/ THRU BASE CONNECTIONS

6. SINGLE POINT POWER FEED 7. BACNET DDC COMMUNICATION, INTEGRATE WITH BMS 9. STAINLESS STEEL DRAIN PAN 10. DIRTY FILTER INDICATOR SWITCH 11. HAIL GUARDS

8. FROST CONTROL (MODULATING WHEEL)

12. MODULATING HOT GAS REHEAT 13. DIGITAL SCROLL COMPRESSOR FOR ALL CIRCUITS

14. MANUFACTURER TO PROVIDE FACTORY INSTALLED UNIT CONTOLLER

15. PHASE/BROWN OUT PROTECTION 16. SUPPLY AIR FLOW MONITORING

17. 2" PLEATED MERV-8 FILTERS, PROVIDE WITH FOUR (4) SETS OF SPARE FILTER MEDIA. 18. ELECTRICAL CONTRACTOR TO FURNISH AND WIRE SUPPLY AND RETURN AIR SMOKE DETECTORS.

MECHANICAL CONTRACTOR TO INSTALL.

19. HINGED ACCESS DOORS

### SPLIT CONDENSING UNITS

																		BASIS OF I	DESIGN INFORMA	TION			
					ESTIMATED	(	COOLING PERF	ORMANCE			ŀ	IEATING PERF	ORMANCE					NOMINAL	NOMINAL	ELEC.	TRICAL DATA	1	]
EQMT.	LOCATION	TYPE	INDOOR UNITS SERVED	REFRIGERANT		TOTAL CAPACITY (MBH)		MAX OPER. TEMP. (°F)		IEER [SEER]	TOTAL CAPACITY (MBH) @ 0°F DB / -2F WB [-3°F DB / -4°F WB ]		MAX OPER. TEMP. (°F)	_	COP @ 17°F	MANUF.	MODEL#	DIMENSIONS		VOLTS / PHASE / HZ	MCA	МОСР	NOTES
CU-1	ROOF	MULTI-ZONE HEAT RECOVERY	SEE EVAPORATOR UNIT SCHEDULE	R410A	26.5	168	5	122	11.1	21.9	163.8	-22	61	3.20	2.38	LG	ARUM168BTE5	49 x 30 x 67	639	208/60/3	53.6	70	1-8
CU-2	ROOF	MULTI-ZONE HEAT RECOVERY	SEE EVAPORATOR UNIT SCHEDULE	R410A	26.5	168	5	122	11.1	21.9	163.7	-22	61	3.20	2.38	LG	ARUM168BTE5	49 x 30 x 67	639	208/60/3	53.6	70	1-8
OU-1	ROOF	1 TO 1 HEAT PUMP	IU-1	R410A	2.21	13.8	14	118	12.5	22.7	[10.36]	-4	65	[11.4]	-	LG	LSU120HSV5	30.5 x 12.5 x 21.5	74	208-230/60/1	10.0	15	1-4,7,8

1. REFRIGERANT CHARGE IS SOLELY PRE-CHARGE FROM CONDENSERS. CONTRACTOR TO NOTIFY ENGINEER IF ADDITIONAL SYSTEM CHARGE IS REQUIRED.

2. ELECTRICAL CONTRACTOR TO PROVIDE DISCONNECT SWITCH FOR OUTDOOR UNIT IN NEMA-4X ENCLOSURE. 3. PROVIDE AND INSTALL REFRIGERANT PIPING SPECAIALTIES PER MANUFACTURER'S RECCOMENDATIONS.

4. CONTRACTOR TO PROVIDE 14" HIGH RAILS.

5. MANUFACTURER TO PROVIDE HAIL GUARD KIT 6. MANUFACTURER PROVIDED AIR GUIDE

MANUFACTURER PROVIDED LOW AMBIENT BAFFLE KIT

962 | 208/3 | 1.50 | 41.3 / 50 | 1-18

8. MANUFACTURER PROVIDED BASE PAN HEATER

### SPLIT EVAPORATING UNITS

							PER	RFORMANCE/ CON	STRUCTION	REQUIREMENTS				BASI	S OF DESIGN INF	ORMATION				
									SUPPLY U	INIT DATA					NOMINAL	NOMINAL	ELECTI	RICAL DA	I .	
UNIT TAG	UNIT LOCATION	TYPE	PAIRED E	EQUIPMENT	REFRIGERANT	DRY AIRFLOW (CFM) [HI-MED-LO]	EXTERNAL STATIC (IN. W.C.) [HI TO LO]	SOUND LEVEL LOW TO HIGH dB(A)	NOMINAL SIZE (MBH)	TOTAL COOLING CAPACITY (MBH)	SENSIBLE COOLING CAPACITY (MBH)	HEATING CAPACITY (MBH) @ 0°F DB / -2F WB [-3°F DB / -4°F WB ]	MANUF.	MODEL	DIMENSIONS L" x W" x H"	OPERATING WEIGHT (LBS.)	VOLTS/ PHASE/ HZ	MCA (A)	MOCP (A)	NOTES
EU-102	RADIO ROOM 102	CEILING CASSETTE			R410A	396-388-353	-	34/35/37	18	19.15	13.82	22.2	LG	ARNU183TQD4	24.5 x 24.5 x 10	35	208/1/60	0.25	15	1-6
EU-114	114 QUARTERMASTER	CEILING CASSETTE	BC-1		R410A	265-247-212	-	26/27/29	5	5.52	3.90	6.3	LG	ARNU053TRD4	22.5 x 22.5 x 8.5	29	208/1/60	0.25	15	1-6
EU-118	118 KITCHEN	CEILING CASSETTE	BC-1		R410A	396-388-353	-	34/35/37	18	19.15	13.82	22.2	LG	ARNU183TQD4	24.5 x 24.5 x 10	35	208/1/60	0.25	15	1-6
EU-120	120 READY ROOM	CEILING CASSETTE		CU-1	R410A	283-265-251	-	27/29/30	9	9.63	6.91	11.2	LG	ARNU093TRD4	24.5 x 24.5 x 10	32	208/1/60	0.25	15	1-6
FCU-116-1	116 MEETING	CONCEALED FAN COIL		C0-1	R410A	1554-676	0.71 - 0.16	60/62/65	36	36.31	26.84	42.0	LG	ARNU363M2A4	27.5 x 54 x 11	86	208/1/60	2.90	15	1-6
FCU-116-2	116 MEETING	CONCEALED FAN COIL	BC-2		R410A	1554-676	0.71 - 0.16	60/62/65	36	36.31	26.84	42.0	LG	ARNU363M2A4	27.5 x 54 x 11	86	208/1/60	2.90	15	1-6
FCU-116-3	116 MEETING	CONCEALED FAN COIL	DC-2		R410A	1554-676	0.71 - 0.16	60/62/65	36	36.31	26.84	42.0	LG	ARNU363M2A4	27.5 x 54 x 11	86	208/1/60	2.90	15	1-6
EU-125A	125A LOBBY	CEILING CASSETTE			R410A	307-283-247	-	27/30/32	12	12.34	8.91	14.1	LG	ARNU123TRD4	24.5 x 24.5 x 10	32	208/1/60	0.25	15	1-6
EU-202	202 MEETING	CEILING CASSETTE			R410A	396-388-353	-	34/35/37	18	19.15	13.82	22.2	LG	ARNU183TQD4	24.5 x 24.5 x 10	35	208/1/60	0.25	15	1-6
EU-203	203 VESTIBULE	CEILING CASSETTE	BC-3		R410A	265-247-212	-	26/27/29	5	5.52	3.90	6.3	LG	ARNU053TRD4	22.5 x 22.5 x 8.5	29	208/1/60	0.25	15	1-6
FCU-203A	203A COMPANY ROOM	CONCEALED FAN COIL	BC-3		R410A	2076-522	0.79 - 0.16	62/64/67	48	48.24	36.16	56.0	LG	ARNU483M3A4	27.5 x 50.5 x 12	96.10	208/1/60	3.10	15	1-6
FCU-206	206 TRAINING	CONCEALED FAN COIL			R410A	1554-676	0.71 - 0.16	60/62/65	36	36.31	26.84	42.0	LG	ARNU363M2A4	27.5 x 54 x 9	86	208/1/60	2.90	15	1-6
EU-210	210 CORRIDOR	CEILING CASSETTE		CU-1	R410A	283-265-251	-	27/29/30	9	9.63	6.91	11.2	LG	ARNU093TRD4	24.5 x 24.5 x 10	32	208/1/60	0.25	15	1-6
EU-211	211 OFFICE	CEILING CASSETTE		C0-1	R410A	265-247-212	-	26/27/29	5	5.52	3.90	6.3	LG	ARNU053TRD4	22.5 x 22.5 x 8.5	29	208/1/60	0.25	15	1-6
EU-212	212 OFFICE	CEILING CASSETTE	BC-4		R410A	265-247-212	-	26/27/29	5	5.52	3.90	6.3	LG	ARNU053TRD4	22.5 x 22.5 x 8.5	29	208/1/60	0.25	15	1-6
EU-213	213 OFFICE	CEILING CASSETTE	DC-4		R410A	265-247-212	-	26/27/29	5	5.52	3.90	6.3	LG	ARNU053TRD4	22.5 x 22.5 x 8.5	29	208/1/60	0.25	15	1-6
EU-214	214 OFFICE	CEILING CASSETTE			R410A	265-247-212	-	26/27/29	5	5.52	3.90	6.3	LG	ARNU053TRD4	22.5 x 22.5 x 8.5	29	208/1/60	0.25	15	1-6
EU-215	215 OFFICE	CEILING CASSETTE			R410A	265-247-212	-	26/27/29	5	5.52	3.90	6.3	LG	ARNU053TRD4	22.5 x 22.5 x 8.5	29	208/1/60	0.25	15	1-6
IU-1	219 IT	WALL MOUNT	(	)U-1	R410A	338-317-229	-	39/33/23	12	13.785	-	[10.36]	LG	LSN120HSV5	30 x 12 x 7.5	18.30	208-230/1/60	-	-	1-3,5-8

- MANUFACTURER TO PROVIDE HARDWIRED, WALL MOUNTED, PROGRAMMABLE THERMOSTAT. PROVIDE WITH 208V / 1 CONDENSATE PUMP TAGGED AS CDP-A (LITTLE GIANT MODEL VCCA-20ULST)
- 3. DRAIN PAIN LEVEL SENSOR THE UNIT SHALL TURN OFF IF WATER IS SENSED. 4. ELECTRICAL CONTRACTOR TO PROVIDE DISCONNECT SWITCH

- FURNISH AND INSTALL BACNET INTERFACE AND INTEGRATE WITH BMS.
- INSTALL ALL EQUIPMENT AND COMPONENTS ACCORDING TO MANUFACTURER'S INSTRUCTIONS.POWERED BY PAIRED CONDENSER,
- ELECTRICAL CONTRACTOR TO PROVIDE DISCONNECT SWITCH BETWEEN INDOOR AND OUTDOOR UNIT
- PROVIDE PIPE COVER FOR ALL EXPOSED REFRIGERANT PIPING. PROVIDE CJ INNOVATIONS OR APPROVED EQUAL. COORDINATE FINISH WITH ARCHITECT/OWNER.

VRF BRANCH CONTROL BOXES

						BASIS OF DE	SIGN INFORM	ATION			
EQMT	LOCATION	CNDSR.	# OF INDOOR		MODEL	NOMINAL	NOMINAL OPERATING	ELECT	RICAL D	ATA	NOTES
NO.	LOCATION	PAIRING	UNIT PORTS	MNF	MODEL NO.	DIMENSIONS L" x W" x H"	WEIGHT (LBS.)	VOLTS/ PHASE	MCA	МОСР	NOTES
BC-1	FIRST FLOOR	CU-1	4	LG	PRHR043A	19 x 19 x 8.5	40	208-230/1	0.17	15	1, 2
BC-2	FIRST FLOOR	CU-2	4	LG	PRHR043A	19 x 19 x 8.5	40	208-230/1	0.17	15	1, 2
BC-3	SECOND FLOOR	CU-3	4	LG	PRHR043A	19 x 19 x 8.5	40	208-230/1	0.17	15	1, 2
BC-4	SECOND FLOOR	CU-3	6	LG	PRHR063A	31 x 19 x 8.5	60	208-230/1	0.27	15	1, 2

**EFFECTIVE FURTHEST** 

PIPE RUN (FT.)

## **ELECTRIC HEAT TRACE** BASIS OF DESIGN INFORMATION **DESIGN CONDITIONS**

(LB/1000FT<sup>3</sup>)

19.64

9.91

	l									I						
EQMT.	EQMT.	050////0	NOMINAL	MINIMIIM	PIPE TEMP.	STARTUP		INSULATION				Е	LECTRICA	AL DATA		NOTE
TAG	SERVED	SERVING	PIPE SIZE (IN.)	OA TEMP. (°F)		PIPE TEMP. (°F)	THICKNESS (IN.)	TYPE	APPROXIMATE LENGTH REQUIRED (FT)	IVIINE	MODEL NO.	POWER OUTPUT (W/FT)	POWER (W)	VOLTS/ PHASE	МОСР	NOTE
HT-D	HHWS/R	DOAS-1	2	-10	40	35	2	FIBERGLASS	30'	THEMOM	5-FLX-2	5	150	208/1	20	1-2
HT-208	HHWS/R	RTU-208	1	-10	40	35	1-1/2	FIBERGLASS	30'	THEMOM	5-FLX-2	5	150	208/1	20	1-2
HT-MAU	HHWS/R	MAU-1	1	-10	40	35	1-1/2	FIBERGLASS	30'	THEMOM	5-FLX-2	5	150	208/1	20	1-2

TOTAL AREA (SQFT.)

TOTAL REFRIGERANT

AMOUNT (LBS)

39.15 [NOTE 1]

39.82 [NOTE 1]

NOTES:

1. PROVIDE ALL REQUIRED TEMPERATURE SENSORS AND CONTROLS FOR A COMPLETELY FUNCTIONING HEAT TRACE SYSTEM.

2. PROVIDE ALL REQUIRED TEMPERATURE SENSORS AND CONTROLS FOR A COMPLETELY FUNCTIONING HEAT TRACE SYSTEM.

HEAT TRACE ASSOCIATED HOT WATER PIPING OUTDOORS, VALVES AND FITTINGS AS REQUIRED.

ZONE SMALLEST SPACE, ZONE SMALLEST SPACE, REFRIGERANT DENSITY

TOTAL VOLUME (FT<sup>3</sup>)

4,024

336

### CONDENSATE DRAIN PUMPS

		CVCTEM	PERFO	RMANCE/CO REQUIREMI		TION		BASIS OF	DESIGN IN	NFORMATION	ON		
S	EQMT. NO.	SYSTEM SERVED	FLUID	MAX FLOW RATE (GPH)	MAX HEAD (FT.)	НР	MNF	MODEL NO.	DIMS. L x W x H	WEIGHT (LBS.)	VOLTS/ PHASE	POWER DRAW (W)	NOTES
	CDP-A	SEE PLANS	WATER	48	10	1/30	LITTLE GIANT	VCCA-20ULST	11 X 5 X 7	6.3	115V/1	93	1-3

**OVERFLOW DETECTION SWITCH** 1/2 GALLON COLLECTION TANK

SYSTEM

CU-1 & 2

NOTES:

1. PROVIDE BALL VALVES

2. CONDENSATE DRAIN NOT REQUIRED FOR THIS MANUFACTURER REFRIGERANT DENSITY CALCS

OU-1

1. LINE LENGTHS ARE ESTIMATED BY MANUFACTURER VRF DESIGN SOFTWARE. REFRIGERANT LINE LENGTHS, SIZES & CHARGES TO BE VERIFIED BY EQUIPMENT MANUFACTURER.

**TOTAL NUMBER OF** 

**ELBOWS** 

2. CONTRACTOR TO NOTIFY ENGINEER IF ADDITIONAL SYSTEM CHARGE IS REQUIRED.

EFFECTIVE PIPE

LENGTH (FT.)

_													
		evetem	PERFO	RMANCE/CO REQUIREM		TION		BASIS OF	DESIGN IN	NFORMATI	ON		
	EQMT. NO.	SYSTEM SERVED	FLUID	MAX FLOW RATE (GPH)	MAX HEAD (FT.)	НР	MNF	MODEL NO.	DIMS. L x W x H	WEIGHT (LBS.)	VOLTS/ PHASE	POWER DRAW (W)	NOTES
	CDP-A	SEE PLANS	WATER	48	10	1/30	LITTLE GIANT	VCCA-20ULST	11 X 5 X 7	6.3	115V/1	93	1-3

FINAL BID DOCUMENT

**HVAC SCHEDULES (2 OF 3)** 

**872 Blooming Grove Turnpike** New Windsor, NY 12553

**CONTRACT G** 

**GENERAL CONSTRUCTION** 

538 Broad Hollow Road, 4th Floor East

Melville, NY 11747 631.756.8000 • www.h2m.com

DESCRIPTION

MARK DATE

DKR

JULY 2022

**VAILS GATE FIRE** 

**DISTRICT** 

**New Storage Building (Phase I)** New Fire Station (Phase II)

AS SHOWN

VGFD2001

M2 601.00

HEATING	HOT WATE	R BOI	LERS																		
		RATEF	RATED				PERFORMA	NCE/ CONSTRUC	TION REC	QUIREMENTS					BASIS OF DESIGN	INFORMA	TION				
EQUIPMENT NO.	LOCATION	GROSS	GROSS	GAS		WATER I	DATA			GAS DATA		DOILED VENT			NOMINAL	WEIGHT	ELE	ECTRICA	L DATA		NOTES
		(MBH)	OUTPUT (MBH)	(%)	FLOW RATE (GPM)	MAX RATED PRESS. (PSIG)	INLET TEMP. (DEG. F)	OUTLET TEMP. (DEG. F)	CFH	MIN PRESSURE (IN. W.C.)	MAX PRESSURE (IN. W.C.)	BOILER VENT SIZE (IN)	MANUFACTURER	MODEL NO.	DIMENSIONS (L x W x H)	WEIGHT (LBS.)	VOLTAGE	FLA	MCA	МОСР	NOTES
OTES:-1 & BL-2	MECHANICAL ROOM	800	768.8	96.1	45.3	80	114	150	800	4	13.5	6	RIELO	ARRAY 800	29.5 x 52.5 x 53.5	926	115V/1	15.5	16	20	1-7

SINGLE POINT POWER FEED.

PROVIDE MULTIPLE LOW WATER CUTOFFS.

LOCATION

OPEN DRIP PROOF MOTOR

MANUFACTURER PROVIDED VFD.

AIR/DIRT SEPARATORS

ADS-1 | BOILER ROOM | HOT WATER LOOPS

LOCATION

BOILER ROOM

HOT WATER

TOTAL

CAPACITY

(MBH)

5.2

5.2

4.1

4.1

9.3

8.3

4.1

2.1

5.2

5.2

6.2

3.1

2.1

6.2

2.1

2.6

2.6

10.3

5.2

4.1

4.1

2.6

3.1

3.1

2. ANSI CLASS 125

5. SELF SENSING

AIR VENT

EQUIPMENT NO.

EQMT. NO.

2. BLOW DOWN PIPED TO DRAIN

**EXPANSION TANKS** 

FIN TUBE RADIATOR

**AREA SERVED** 

116 MEETING

116 MEETING

120 READY ROOM

120 READY ROOM

202 CONFERENCE

202 CONFERENCE

COMPANY ROOM 203A

**COMPANY ROOM 203A** 

**COMPANY ROOM 203A** 

COMPANY ROOM 203A

**COMPANY ROOM 203A** 

**TRAINING ROOM 206** 

TRAINING ROOM 206

TRAINING ROOM 206

**TRAINING ROOM 206** 

CORRIDOR 210

**CORRIDOR 210** 

211 OFFICE

212 OFFICE

213 OFFICE

214 OFFICE

215 OFFICE

**HEATING HOT WATER PUMPS** 

MANUFACTURER TO PROVIDE DISCONNECT SWITCH.

LOCATION | SYSTEM SERVED

4. PROVIDE INTERLOCKS FOR GAS DETECTION AND BREAK GLASS STATION

SYSTEM SERVED

HHWP-3&4 | MECHANICAL ROOM | RADIANT FLOOR | WATER | 28 | 40 | 0.9 |

HHWP-5&6 MECHANICAL ROOM UNIT HEATERS WATER 20 35 0.6

WORKING

REQUIREMENTS

RATE (FT. H2O)

1.07

1. CHARGE OF EXPANSION TANK SHALL BE ADJUSTED TO MATCH THE PRESSURE AT THE POINT WHERE THE TANK IS CONNECTED TO THE PIPING.

BTU/FT PIPE DIA

3/4"

3/4"

516

516

FLOW

HHWP-1&2 MECHANICAL ROOM BUILDING HW HEAT WATER 70 65 3.0 1,760 TACO SKV-1506D-A-2P-PD

PERFORMANCE/CONSTRUCTION REQUIREMENTS

RATE HEAD HP

(FT.)

SPEED

(RPM)

BASIS OF DESIGN INFORMATION

DIMENSION

DIA. x H

MAX. OPERATING MAX. OPERATING

PERFORMANCE / CONSTRUCTION REQUIREMENTS

FIN DIMS W" x H"

4.25 X 4.25

PERFORMANCE/CONSTRUCTION REQUIREMENTS

MODEL

PERFORMANCE/CONSTRUCTION REQUIREMENTS

SYSTEM DATA

VOLUME (GAL.) | PRESS. RANGE (PSIG) | TEMP. RANGE (°F)

17-47

**HEATING COIL DATA** 

**HOT WATER COIL** 

FINS/FT

50

50

TACO 4904AD-125

OPERATING WEIGHT

PROVIDE WITH BASE STAND AND SUPPLEMENTAL STEEL AS REQUIRED

BASIS OF DESIGN INFORMATION

DIMENSION

16 x 40.5

MODEL NO.

S012

TANK VOLUME

NOMINAL

**DIMENSIONS** 

L"xW"xH"

10' x 5.25" 12"

10' x 5.25" 12"

8' x 5.25" 12"

8' x 5.25" 12"

18' x 5.25" 12"

16' x 5.25" 12"

8' x 5.25" 12"

4' x 5.25" 12"

10' x 5.25" 12"

10' x 5.25" 12'

12' x 5.25" 12"

12' x 5.25" 12"

6' x 5.25" 12"

4' x 5.25" 12"

3' x 5.25" 12"

12' x 5.25" 12"

4' x 5.25" 12"

5' x 5.25" 12'

5' x 5.25" 12"

20' x 5.25" 12"

10' x 5.25" 12"

8' x 5.25" 12"

8' x 5.25" 12"

5' x 5.25" 12"

6' x 5.25" 12

6' x 5.25" 12"

WEIGHT

(LBS.)

195

**REMARKS** 

1-2

1-2

PROVIDE MAINTENANCE KIT FOR EACH BOILER. OUTSIDE AIR TEMPERATURE SENSOR.

BASIS OF DESIGN INFORMATION

DIMENSIONS

22x10x30

10x7x15.5

10x7x15

PROVIDE SD020015-5 SUCTION DIFFUSER

MODEL NO.

CA140-150

TACO

**GPM** 

2.5

2.5

MODINE

PROVIDE MPV 015-4 MULTIPURPOSE VALVE

10. ELECTRICAL CONTRACTOR TO PROVIDE DISCONNECT SWITCH

8. CONTROLLED BY BMS

MODEL NO.

VR15M

NOMINAL

**OPERATING** 

WEIGHT (LBS.)

INTERLOCK WITH BMS

137(C)(E)		(RODERA)	-	 7 11 11 11 11 11 11
NDENGATE	DAD AND TOA	NCDADENT NEUT	DALIZATION WIT	
MOEMONIE	KAP AND IKA	NSPARENT NEUT	RALIZATION KIT.	
INTENANCE	KIT FOR FACH	BOILER		

PHASE

208/3

208/1

2,4-6,8-10

GAS	DETECTION	SYSTEM

FOMT			В	SASIS OF DESIGN INFORM	ATION		
EQMT. NO.	LOCATION	SYSTEM SERVED	MNF	MODEL NO.	NOMINAL DIMENSIONS L" x W" x H"	VOLTAGE / PHASE	REMARKS
GDS-1	MECHANICAL ROOM	BOILERS BL-1, BL-2	RKI BEACON	410A (4 CHANNEL)	10.5 x 6.5 x 14	120/1	1-7

REMARKS

INCLUDE TWO CHANNEL DIGITAL CONTROLLER IN NEMA 4 ENCLOSURE FOR WALL MOUNT. 208/1 2,4-6,8-10 LED DISPLAY FOR LEL AND CO.

> INCLUDE COMBUSTIBLE GAS SENSOR AND CARBON MONOXIDE SENSOR. PROVIDE CONFIGURABLE ALARM OUTPUTS WITH ISOLATION RELAYS FOR INTERLOCK WITH BOILER AND FACP.

PROVIDE PANEL MOUNTED AUDIBLE ALARM AND SILENCING SWITCH 6. PROVIDE ALARM HORN WITH STROBE.

PROVIDE STARTUP, TEST AND CALIBRATION REPORT

WALL	MOUNTED ELE	CTR	C HEA	TERS							
		100	AMERICA SPECIAL STATE OF THE SECOND S	CONSTRUCTION	REQUIREMENT	S	E	BASIS OF DESIGN	INFORMATION		
EQMT. NO.	LOCATION	E. 0111	TOTAL	HEATIN	G COIL DATA				NOMINAL	NOMINAL	NOTES
LQWIT. NO.	LOCATION	FLOW CAPACITY ELECTRIC DATA		MNF	MODEL NO.	DIMENSIONS	OPERATING	NOTES			
			(MBH)	VOLTS/PHASE	TOTAL KW	AMPS			L" x W" x H"	WEIGHT (LBS.)	
WEH-112	112 VENDOR DROPOFF	100	5.1	208/1	1.5	7.2	QMARK / MARLEY	AWH4404F*	16 x 4 x 19.5	25	1-3

1. BUILT IN THERMOSTAT.

2. MANUFACTURER PROVIDED DISCONNECT SWITCH 3. FIELD WIRED FOR HALF WATTAGE, COORDINATE WITH 'E' AND MANUFACTURER'S INSTALLATION INSTRUCTIONS.

		FLOOR		PERFOR	MANCE	CONSTRU	CTION REC	QUIREMEN'	TS	
EQMT.	AREA SERVED	AREA	TOTAL	HEA	TING CO	IL DATA			NOMINAL	NOTES
NO.	AREA SERVED	SERVED [FT <sup>2</sup> ]	CAPACITY	но	T WATE	R COIL	MNF	MODEL NO.	DIMENSIONS	NOTES
		0.1	(BTU/HR)	EWT (°F)	GPM CIRCUITS			NO.	L"xW"xH"	
RFM-1	APPARATUS ROOM	2429	99621	123.6	9.7	10	UPONOR	A2721002	28 x 3.5 x 14.5	1-5
RFM-2	APPARATUS ROOM	2503	102663	123.6	10	10	UPONOR	A2721002	28 x 3.5 x 14.5	1-5
RFM-3	APPARATUS ROOM	266	8902	123.6	0.9	2	UPONOR	A2720202	11 x 3.5 x 14.5	1-5
RFM-4	APPARATUS ROOM	805	25634	123.6	2.4	4	UPONOR	A2720402	15 x 3.5 x 14.5	1-5
RFM-5	APPARATUS ROOM	260	6376	123.6	0.6	2	UPONOR	A2720202	11 x 3.5 x 14.5	1-5
RFM-6	APPARATUS ROOM	217	6973	123.6	0.7	2	UPONOR	A2720202	11 x 3.5 x 14.5	1-5
RFM-7	APPARATUS ROOM	229	6320	123.6	0.6	2	UPONOR	A2720202	11 x 3.5 x 14.5	1-5

ISOLATOR NOM. RESTRAINT SEISMIC COMPONENT NOTES (1,2

IMPORTANCE FACTOR, Ip TYP.)

1.5

1.5

1.5

6

6,7

6,7

6,7

The Complete and the Complete Annual Complete		"LOCATION	MOUNTING		T TOTAL	ISOLATOR	NOM.	RESTRAINT	SEISMIC COMPONENT	NOT
UNIT TAG	EQUIPMENT TYPE	(FL LEVEL)"	METHOD	BASE TYPE	MANUF	TYPE	DEFL., IN.	REQ'D	IMPORTANCE FACTOR, Ip	MARKS SEEDING
HVLS-1,2,3	HVLS FANS	VARIOUS	SUSPENDED	-	VIBRO-ACOUSTICS			SEIS	1.5	
GX-1	EXHAUST FANS	MECH MEZ	SUSPENDED		VIBRO-ACOUSTICS	SHR	2.00	SEIS	1.5	
GX-4, TX-1	EXHAUST FANS	ROOF	ROOF		VIBRO-ACOUSTICS		(a)	SEIS/WIND	1.5	
VX [TBD]	VEHICLE EXHAUST	MECH MEZ	SUSPENDED		VIBRO-ACOUSTICS	SHR	2.00	SEIS	1.5	
LRS-1	AIR SCRUBBERS	GEAR ROOM	SUSPENDED		VIBRO-ACOUSTICS			SEIS	1.5	
RTU-207, DOAS-1	ROOFTOP UNITS	ROOF	ROOF	RC	VIBRO-ACOUSTICS	VCR	2.00	SEIS/WIND	1.5	
CU-1, 2, OU-1	CONDENSING UNIT	ROOF	ROOF		VIBRO-ACOUSTICS	NP	0.18	SEIS/WIND	1.5	
EU-102 THRU 215	SPLIT SYSTEM INDOOR	VARIOUS	SUSPENDED		VIBRO-ACOUSTICS	SHR	1.00	SEIS	1.5	
BC-1, 2, 3, 4	VRF BRANCH CONTROL	VARIOUS	SUSPENDED		VIBRO-ACOUSTICS			SEIS	1.5	
BL-1, 2	BOILER	MECH ROOM	FLOOR	333000	VIBRO-ACOUSTICS	NP	0.18	SEIS	1.5	
HHWP1 THRU 6	PUMPS	MECH ROOM	FLOOR	CIB	VIBRO-ACOUSTICS	SFS+ SIPS	2.00	SEIS	1.5	
ADS-1	AIR DIRT SEPARATOR	MECH ROOM	SUSPENDED		VIBRO-ACOUSTICS			SEIS	1.5	

DUCTWORK

**PIPING** 

VIBRO-ACOUSTICS SEIS 1.5 VIBRO-ACOUSTICS VCR 2.00 SEIS/WIND 1.5 VIBRO-ACOUSTICS NP SEIS/WIND 1.5 0.18 6, 7 VIBRO-ACOUSTICS SHR SEIS 1.5 1.00 VIBRO-ACOUSTICS VIBRO-ACOUSTICS NP 0.18 SEIS 1.5 4,5 VIBRO-ACOUSTICS SFS+ SIPS 2.00 SEIS 1.5 4,5 VIBRO-ACOUSTICS ET-1 **EXPANSION TANK** MECH ROOM FLOOR VIBRO-ACOUSTICS SEIS 1.5 CUH-A, B, 126 CABINET UNIT HEATER **VARIOUS** SUSPENDED VIBRO-ACOUSTICS SHR 2.00 SEIS 6, 7 1.5 UH-1 THRU 4 UNIT HEATER **VARIOUS** SUSPENDED VIBRO-ACOUSTICS SHR 6, 8 2.00 SEIS 1.5 KITCHEN HOOD VIBRO-ACOUSTICS KITCHEN SUSPENDED SEIS MAU-118 MAKE-UP AIR ROOF ROOF RC VIBRO-ACOUSTICS VCR 2.00 SEIS/WIND KX-118 **EXHAUST FANS** ROOF

ROOF

SUSPENDED

SUSPENDED

BASE TYPE:

RC: ROOF CURB

**VARIOUS** 

**VARIOUS** 

1. BASIS OF DESIGN: VIBRO-ACOUSTICS.

DUCTWORK (≥6' CLEAR AREA)

HVAC PIPING (>2" NOMINAL DIAMETER)

2. SEISMICALLY RATED FOR PROJECT CONDITIONS

3. STAND SUPPORT MUST BE ABLE TO MEET CALCULATED SEISMIC LOADS

4. PROVIDE FLEXIBLE PIPING CONNECTORS

5. PROVIDE TYPE SHR OR SFS ISOLATORS ON ADJACENT PIPING/DUCTWORK

6. PROVIDE SEISMIC RESTRAINT CABLES. PROVIDE ROD STIFFENERS AS REQUIRED

PROVIDE SEISMIC UPLIFT STOP WASHER.

SUPPORT INLINE PUMP AT FLANGE CONNECTION.

VIBRO-ACOUSTICS **ISOLATOR TYPE** 

VIBRO-ACOUSTICS

VIBRO-ACOUSTICS

CIB - CONCRETE INERTIA BASE NP - RUBBER PAD VCR - ADJUSTABLE SPRING CURB SIPS - SEISMIC INLINE PUMP STANDS

> SFS - SEISMIC FLOOR MOUNT SHR - SPRING + RUBBER HANGER

SEIS/WIND

SEIS

SEIS

CABINET UNIT HEATERS

BASIS OF DESIGN INFORMATION **FAN DATA** AIR DATA **HEATING COIL DATA** NOMINAL **EQMT** TOTAL NOMINAL LOCATION CONFIGURATION OPERATING NOTES NO. CAPACITY ENT. DB LVG. DB MODEL NO. DIMENSIONS HP VOLTS/ **FLOW** (MBH) TEMP. TEMP. LxWxH LVG. TEMP. FLOW MAX. P.D. (CFM) PHASE (DEG. F (DEG. F) (DEG. F) (GPM) (FT. H2O) CUH-A STAIR A STANDALONE CABINET 150 122.1 0.20 MODINE C 0030 90 44 x 9.5 x 25 1.5 CUH-B STAIR B CEILING MOUNTED 10.2 150 122.1 1.5 0.20 MODINE CW 0035 100 44 x 9.5 x 25 **CUH-126 VESTIBULE 126 CEILING MOUNTED** 280 0.03 115V/1 10.2 122.1 MODINE 100 2,3 1.5 0.20 CW 0035 44 x 9.5 x 25

 UNIT MOUNTED THERMOSTAT. 2. MANUFACTURER PROVIDED UNIT MOUNTED DISCONNECT SWITCH.

REMOTE MOUNTED THERMOSTAT

HOT WATE	R UNIT HEAT	TERS																			
											В	ASIS OF DESIG	N					1000	-		
EQUIPMENT NO.	AREA SERVED	FAN	DATA	TOTAL		AIF	DATA			HEATING	COIL DA	ATA	ELEC	TRIC DA	TA			NOMINAL	NOMINAL	MAX	
	AREA SERVED	FLOW (CFM)	RPM	CAPACITY (MBH)	EAT (°F)	EDM	EWT (°E)	HOT WA			VOLTS/ PHASE	AMDS HD	MNF	MODEL NO.	DIMENSIONS L"xW"xH"	OPERATING WEIGHT	MOUNTING HEIGHT (FT)	NOTES			
UH-1 THRU 4	APPARATUS ROOM	3,240	1,075	69.7	60	80	53	870	EWT (°F)	120	GPM 4.8	ΔP (FT W.C.)	115/1	4.6	1/3	MODINE	HC 165SB01SA		(LBS.) 92	25	1-5
OTES:							-			20000	-	W	7,500,000	(6.50)	820,455					376.00	

MANUFACTURER TO PROVIDE T1P STARTER DISCONNECT SWITCH TO BE INSTALLED BY ELECTRICAL CONTRACTOR.

ELECTRICAL TO PROVIDE WITH LINE VOLTAGE WALL MOUNTED THERMOSTAT. MANUFACTURER TO PROVIDE WITH AQUASTAT.

INTERLOCK WITH APPARATUS BAY DOORS

architects engineers

538 Broad Hollow Road, 4th Floor East Melville, NY 11747 631.756.8000 • www.h2m.com

MARK	DATE	DESCRIPTION
2	12/22/2022	REVS. PER TOWN COMMENTS



DKR MJV VGFD2001 JULY 2022 AS SHOWN

## **VAILS GATE FIRE** DISTRICT

New Storage Building (Phase I) New Fire Station (Phase II)



872 Blooming Grove Turnpike New Windsor, NY 12553

**CONTRACT G GENERAL CONSTRUCTION** 

FINAL BID DOCUMENT

**HVAC SCHEDULES (3 OF 3)** 

M2 602.02

FTR-116-1 FTR-116-2 FTR-116-3-1 FTR-116-3-2 FTR-116-4 FTR-116-5 FTR-120-1 FTR-120-2 FTR-202-1 FTR-202-2 FTR-210-1 FTR-210-2 FTR-212

FTR-203A-1 FTR-203A-2 FTR-203A-3 FTR-203A-4 FTR-203A-5 FTR-206-1 FTR-206-2 FTR-206-3 FTR-206-4

FTR-216 1. PROVIDE ALL CORNER SECTIONS, END PANELS, SUPPORTS AND ACCESSORIES AS REQUIRED TO PROVIDE CONTINUOUS ENCLOSE. 2. PROVIDE SPACE MOUNTED THERMOSTAT AND CONTROL VALVE (Cv = 4.6 MINIMUM).

FTR-213

FTR-214

FTR-215

CONTROL VALVES

EQMT. **FAMILY** 

VALVE MEDIUM SIZE LAST POSITION 1-1/2" WATER BALL VALVE 3-WAY

COEFFICIENT **CLOSE OFF** CONNECTION MATERIAL NUMBER POWER (PSI) THREADED **GRISWOLD CONTROLS** 24VAC UR3EEFBM

NOTES ACTUATOR CONTROL 2-10VDC MODULATING

MANUFACTURER TO PROVIDE WITH CEILING SUSPENSION KIT.

AC-PSP (UNITED STATES) - US PATENT 7963830 B2. AC-PSP WALL (CANADA) - CA PATENT 2820509. AC-PSP ISLAND (CANADA) - CA PATENT 2520330.

HOOD INFORMATION - JOB#5338935

	<u> </u>		<u> </u>	$00D\pi00$	<del></del>																
				"		MAX							EXHA	JST PL	ENUM			TOTAL		НООО С	CONFIG
H[		TAG	МПЛСІ	MANILIEACTUDED	LENCTH	COOKING	TYPE	APPLIANCE	DESIGN	TOTAL			F	SISER(S	<u>;)</u>			SUPPLY	HOOD	CND TO	ĺ
1		IAG	MODEL	MANUFACTURER	LENGTH	TEMP	ITE	DUTY	CFM/FT	EXH CFM	WIDTH	I ENG	HEIGHT	DIA	CFM	VFI	SP.	CFM	CONSTRUCTION	END TO	R□W
						I LIVII					WILLIGIEW		IILIUIII	חזרו	CIN	V L L	5	CI M		LIND	
			5424	0.4.0.7.1./5.4.1.0.5	64.0#	600	<del>-</del>		405	4470			4 #	40"	4470	04.45	0.006#	000	430 SS		
	1		ND-2-PSP-F	. CAPTIVEAIRE	6′ 0″	DEG	1	HEAVY	195	1170			4"	10"	1170	2145	-0.936"	983	WHERE EXPOSED	ALONE	ALONE
																				l	

HOOD INFORMATION

			H	<u>- IL LERC</u>	2)			LIGHI(S)					UTILITY CABINET(S)			→ FIRE HOD	ו מר
1	HOOD TAG					EFFICIENCY @ 7			WIRE			FIF	RE SYSTEM	ELECTRICAL	SWITCHES	SYSTEMHANG	
	ND   Ind	TYPE	QTY	HEIGHT	LENGTH	MICRONS	QTY	TYPE	GUARD		SIZE	TYPE	SIZE	MODEL #	QUANTITY	PIPING WEIG	
	1	CAPTRATE SOLO FILTER	4	16″	16"	85% SEE FILTER SPEC	2	RECESSED ROUND	N□	LEFT	12″×54″×24″	TANK FS	4.0	DCV-1111	1 LIGHT 1 FAN	YES 70	

HOOD OPTIONS

HOOD NO	TAG	OPTION
		FIELD WRAPPER 18.00" HIGH FRONT, LEFT, RIGHT.
		BACKSPLASH 80.00" HIGH X 84.00" LONG 430 SS VERTICAL.
1		RIGHT VERTICAL END PANEL 27" TOP WIDTH, 21" BOTTOM WIDTH, 80" HIGH INSULATED 430 SS.
		LEFT VERTICAL END PANEL 27" TOP WIDTH, 21" BOTTOM WIDTH, 80" HIGH INSULATED 430 SS.
		SENSOR-CV.

PERFORATED SUPPLY PLENUM(S)

ПППП									RISERC	2)	
HOOD NO	TAG	POS	LENGTH	WIDTH	HEIGHT	TYPE	WIDTH	LENG	DIA	CFM	SP
1		Front	01"	1 // //	6"	MUA	12"	20"		491	0.133″
1		Fronc	84"	14"	В	MUA	12"	20″		491	0.133"

FIRE SYSTEM INFORMATION - IOR#5338935

IIRL	<u>01011</u>	<u>EM INFORMATIO</u>	<u> //v                                  </u>			
FIRE			"	FLOW	INSTALLA	TION
SYSTEM NO	TAG	TYPE	SIZE	POINTS	SYSTEM	LOCATION ON HOOD
1		TANK FS	4.0	16	FIRE CABINET LEFT	LEFT, HOOD 1

GAS VALVE(S)

FIRE SYSTEM NO	TAG	TYPE	SIZE	SUPPLIED BY
1		SC ELECTRICAL	2.000	CAPTIVEAIRE SYSTEMS

FIRE SYSTEM PARTS LIST KEY

FIRE SYSTEM NO	TAG	KEY NUMBER - PART DESCRIPTION	QTY BY FACTORY	QTY BY DIST
		0 - 0 - 12-F28021-32144-OT-360 DUCT FIRE THERMOSTAT WITH 12 FOOT WIRE LEADS, NO, CLOSE ON TEMP RISE AT 360°F.	1	0
		0 - 0 - 87-300001-001 TANK - PRESSURIZED TANK USED FOR TANK FIRE SUPPRESSION.	1	0
		0 - 0 - 87-300030-001 PRIMARY ACTUATOR KIT (PAK) - ACTUATOR AND RELEASE SOLENDID ASSEMBLY, ONE NEEDED PER FIRE SYSTEM, SUPERVISED, TANK FIRE SUPPRESSION.	1	0
		0 - 0 - 87-300152-001 HARDWARE, SVA BOLTS, TANK FIRE SUPPRESSION.	4	0
		0 - 0 - 98694A115 HARDWARE, DATANKLOCK LOCKING BRACKET SQUARE NUTS 5/16" ZINC, TANK FIRE SUPPRESSION.	2	0
		0 - 0 - A0034332 JUNCTION BOX FOR MANUAL PULL STATION, 1.5" DEEP BACK BOX, RED COLOR.	1	0
1		0 - 0 - DATANKLOCK DISCHARGE ADAPTER TANK LOCKING PLATE FOR FIRE SYSTEM TANK INSTALLATION IN UTILITY CABINETS, TANK FIRE SUPPRESSION.	1	0
		0 - 0 - SLPCON-10FT SUPERVISED LOOP CONNECTION KIT. CONTAINS THE PARTS NEEDED TO CONNECT THE SUPERVISED LOOP BETWEEN END TO END HOODS WITH LESS THAN A 9' GAP OR BACK TO BACK HOODS. KIT CONTAINS 12 FEET OF BLACK MG WIRE, 12 FEET OF TAN MG WIRE, 10 FEET OF FLEXIBLE CONDUIT, AND TWO 7/8" CONNECTORS.	1	0
		0 - 0 - TANK STRAP TANK STRAP - USED FOR TANK FIRE SUPPRESSION.	3	0
		0 - 0 - TFS-UCTANKBRACKET TANK BRACKET FOR FIRE SYSTEM TANK INSTALLATION IN UTILITY CABINETS, TANK FIRE SUPPRESSION.	1	0
		0 - 0 - WK-283952-000 DISCHARGE ADAPTER, TANK FIRE SUPPRESSION.	1	0
		34 - 34 - A0034331 24VDC SINGLE ACTION MANUAL ACTUATION DEVICE (PUSH/PULL STATION) WITH PROTECTIVE COVER, ONE (1) NORMALLY OPEN CONTACT. RED COLOR.	1	0
		ADDITIONAL PARTS TO BE DETERMINED		

### SPECIFICATION: CAPTRATE GREASE-STOP SOLO FILTER


THE CAPTRATE GREASE-STOP SOLO FILTER IS A SINGLE-STAGE FILTER FEATURING A UNIQUE S-BAFFLE DESIGN IN CONJUNCTION WITH A SLOTTED REAR BAFFLE DESIGN, TO DELIVER EXCEPTIONAL FILTRATION EFFICIENCY.

FILTER IS STAINLESS STEEL CONSTRUCTION, AND SIZED TO FIT INTO STANDARD 2-INCH DEEP HOOD CHANNEL(S).

UNITS SHALL INCLUDE STAINLESS STEEL HANDLES AND A FASTENING DEVICE TO SECURE THE TWO COMPONENTS WHEN ASSEMBLED.

GREASE EXTRACTION EFFICIENCY PERFORMANCE SHALL REMOVE AT LEAST 75% OF GREASE PARTICLES FIVE MICRONS IN SIZE, AND 85% GREASE PARTICLES SEVEN MICRONS IN SIZE AND LARGER, WITH A CORRESPONDING PRESSURE DROP NOT TO EXCEED 1.0 INCHES OF WATER GAUGE. THE CAPTRATE GREASE-STOP SOLO WAS TESTED TO ASTM STANDARD ASTM F2519-05. MANUFACTURER APPROVED FOR USE IN SOLID FUEL APPLICATIONS AS A SPARK ARRESTER.

EFFICIENCY VS. PARTICLE DIAMETER

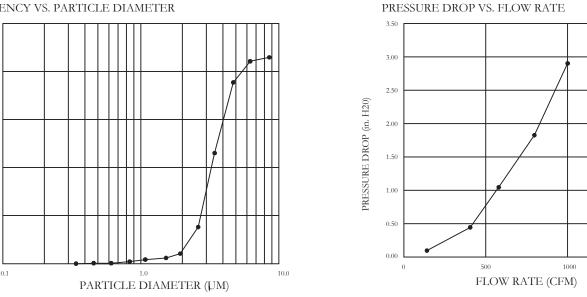



CAPTRATE FILTERS ARE BUILT IN COMPLIANCE WITH:

NFPA #96. NSF STANDARD #2. UL STANDARD #1046. INT, MECH, CODE (IMC).

ULC-S649.




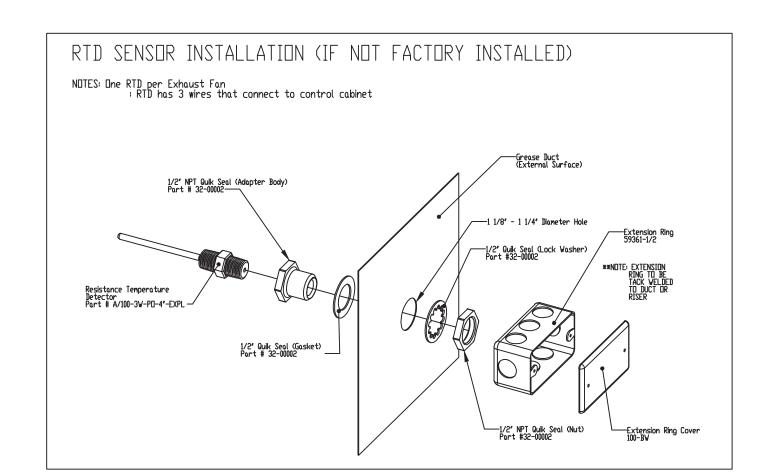

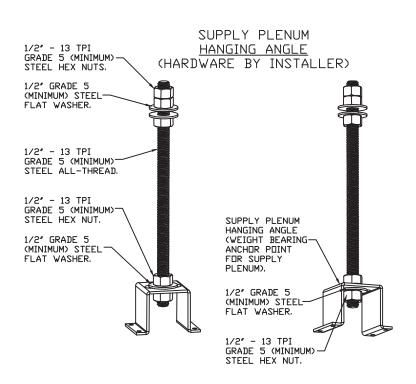


ASSEMBLY INSTRUCTIONS

HANGING ANGLE MUST BE SUPPORTED WITH 1/2" - 13 TPI GRADE 5 (MINIMUM) ALL-THREAD, SANDWICH HANGING ANGLES AND CEILING ANCHOR POINTS WITH 1/2" GRADE 5 (MINIMUM) STEEL FLAT WASHERS AND 1/2" - 13 TPI GRADE 5 (MINIMUM) HEX NUTS AS SHOWN. MUST USE DOUBLED HEX NUT CONFIGURATION ABOVE CEILING ANCHORS, SINGLE HEX NUT BENEATH HANGING ANGLE IS ACCEPTABLE FOR PSP HANGING ANGLES, MAINTAIN 1/4" OF EXPOSED THREADS BENEATH BOTTOM HEX NUT. TORQUE ALL HEX NUTS TO 57 FT-LBS.

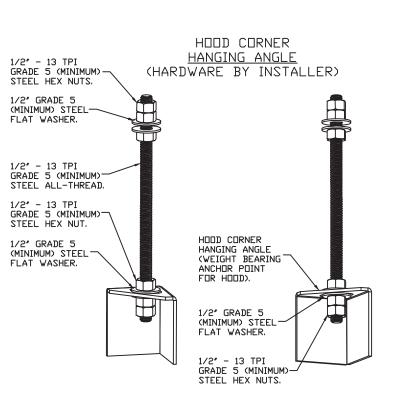


### ASSEMBLY INSTRUCTIONS

HANGING ANGLE MUST BE SUPPORTED WITH 1/2" - 13 TPI GRADE 5 (MINIMUM) ALL-THREAD, SANDWICH HANGING ANGLES AND CEILING ANCHOR POINTS WITH 1/2" GRADE 5 (MINIMUM) STEEL FLAT WASHERS AND 1/2" - 13 TPI GRADE 5 (MINIMUM) HEX NUTS AS SHOWN, MUST USE DOUBLED HEX NUT CONFIGURATION BENEATH HOOD HANGING ANGLES AND ABOVE CEILING ANCHORS. MAINTAIN 1/4" OF EXPOSED THREADS BENEATH BOTTOM HEX NUT. TORQUE ALL HEX NUTS TO 57 FT-LBS.

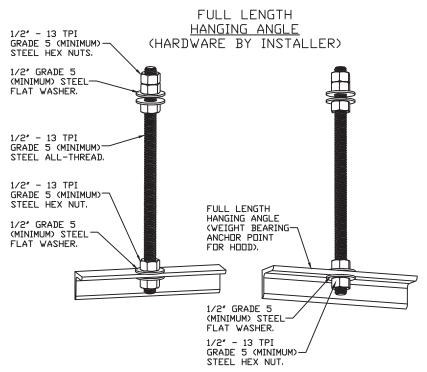

### ASSEMBLY INSTRUCTIONS


HANGING ANGLE MUST BE SUPPORTED WITH 1/2" - 13 TPI GRADE 5 (MINIMUM) ALL-THREAD. SANDWICH HANGING ANGLES AND CEILING ANCHOR POINTS WITH 1/2" GRADE 5 (MINIMUM) STEEL FLAT WASHERS AND 1/2" - 13 TPI GRADE 5 (MINIMUM) HEX NUTS AS SHOWN. MUST USE DOUBLED HEX NUT CONFIGURATION ABOVE CEILING ANCHORS, SINGLE HEX NUT BENEATH HANGING ANGLE IS ACCEPTABLE FOR FULL LENGTH HANGING ANGLES. MAINTAIN 1/4" OF EXPOSED THREADS BENEATH BOTTOM HEX NUT. TORQUE ALL HEX NUTS TO 57 FT-LBS.

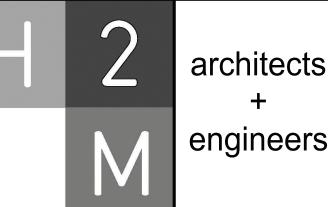

538 Broad Hollow Road, 4th Floor East Melville, NY 11747 631.756.8000 - www.h2m.com

CONSULTANTS:			

MARK	DATE	DESCRIPTION

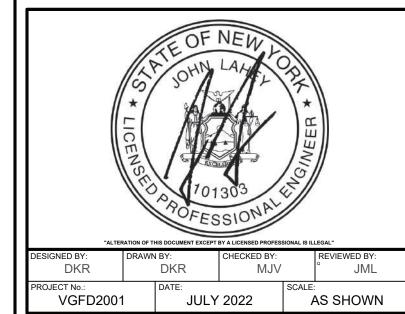

## **VAILS GATE FIRE DISTRICT**

New Storage Building (Phase I) New Fire Station (Phase II)




**872 Blooming Grove Turnpike** New Windsor, NY 12553


**CONTRACT G GENERAL CONSTRUCTION** 


FINAL BID DOCUMENT

**HVAC KITCHEN** SCHEDULES (1 OF 10)

M2 610.00

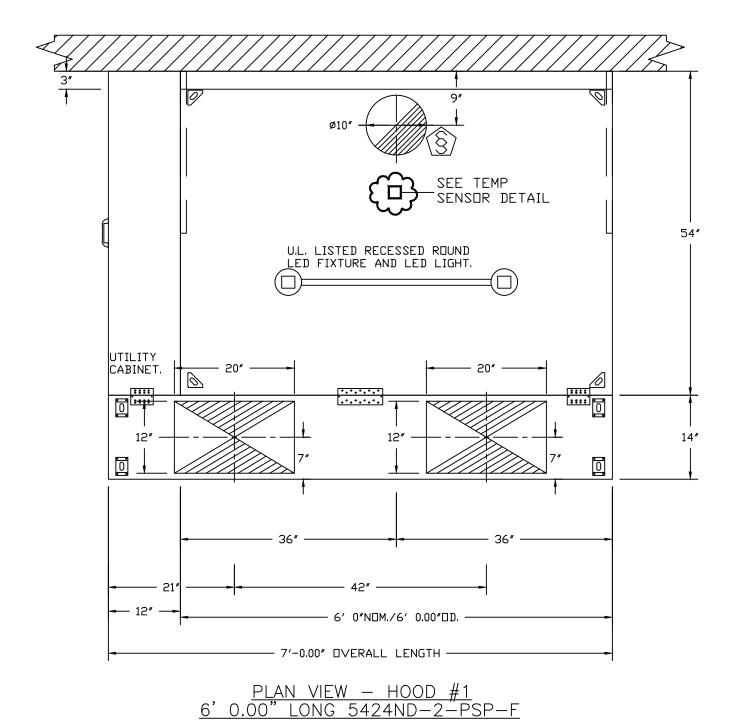

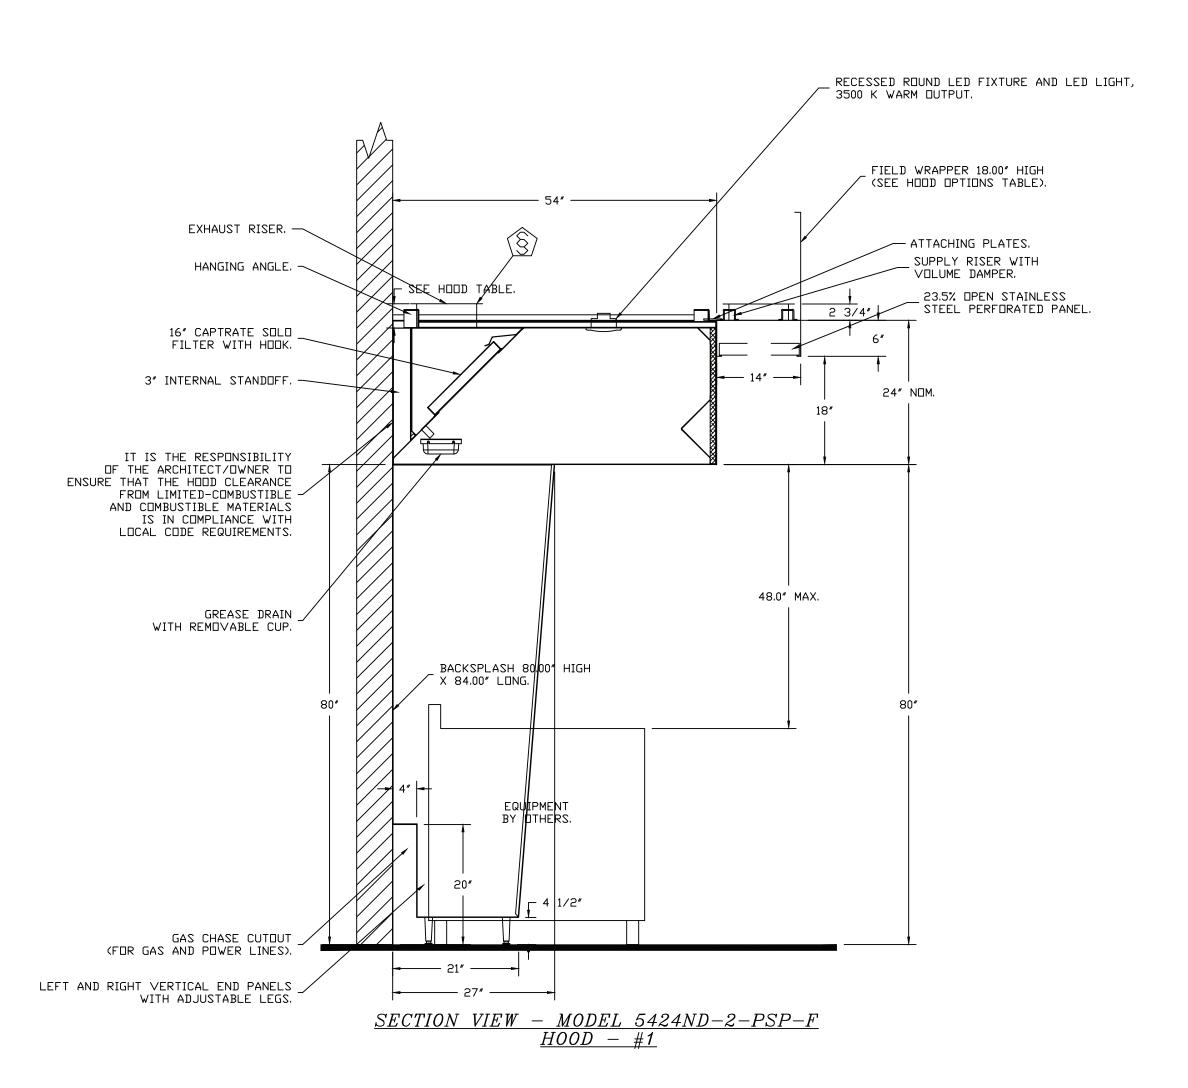

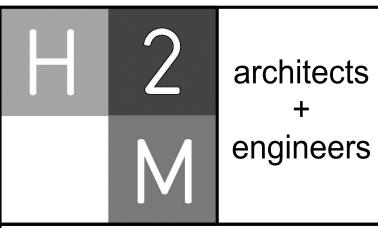

MARK	DATE	DESCRIPTION
	·	



# VAILS GATE FIRE DISTRICT

New Storage Building (Phase I) New Fire Station (Phase II)



872 Blooming Grove Turnpike New Windsor, NY 12553

CONTRACT G
GENERAL CONSTRUCTION

FINAL BID DOCUMENT

SHEET TIT

HVAC KITCHEN SCHEDULES (2 OF 10)

M2 611.00

CONDENSER DETAILS

FAN UNIT NO	TAG	FAN UNIT MODEL #	CONDENSER NO	TONNAGE	VOLTAGE	PHASE	FREQUENCY	MCA	RLA	MAX FUSE SIZE	MIN WIRE SIZE	SEER
2	MAU-118	A1-15D-MPU	1	3	208-230	3 PHASE	60 HZ	14.5 AMPS	11.9 AMPS	20 AMPS	14 AWG	14

MUA FAN INFORMATION - JOB#5338935

UNIT NO	TAG	QTY	FAN UNIT MODEL #	BLOWER	HOUSING	MIN CFM	DESIGN CFM	ESP	RPM	MOTOR ENCL	HP	BHP	PHASE	VOLT	FLA	MCA	MOCP	WEIGHT (LBS)	SONES
2	MAU-118	1	A1-15D-MPU	15MF-1-MOD	A1	450	983	0.500	1536	DDP,PREMIUM	1.000	0.5230	3	208	3.1	3.9A	15A	1120	17.4

COILS - JOB#5338935

FAN	TAG	COIL TYPE	DESIGN					COOLING										HEATING				
UNIT ND	TAG	CUIL TIPE	CFM	ENTERING DB TEMP	ENTERING WB TEMP	LEAVING DB TEMP	LEAVING WE	LEAVING FLUID TEMP	FLUID FLOW RATE	PERCENT GLYCOL	TOTAL CAPACITY	SENSIBLE CAPACITY	LATENT CAPACITY	ENTERING DB TEMP	LEAVING DB TEMP	ENTERING FLUID TEMP	LEAVING FLUID TEMP	FLUID FLOW RATE	PERCENT GLYCOL	STEAM PRESSURE	TOTAL CAPACITY	SENSIBLE CAPACITY
2	MAU-118	DX AND HOT WATER	983	86.0°F	72.0°F	66,9°F	61.1°F	 			36.0 MBH	20.0 MBH	16.0 MBH	0°F	70.32°F	150,0°F	120,0°F	5.07 GAL/MIN			75 MBH	75 MBH

FAN OPTIONS


FAN UNIT NO	TAG	QTY	DESCRIPTION
		1	GREASE BOX
1	KX-118	1	ECM WIRING PACKAGE - PWM SIGNAL FROM ECPMO3 PREWIRE (TELCO MOTOR), CCW ROTATION
		1	2 YEAR PARTS WARRANTY
		1	SIZE 1 UNTEMPERED COMMERCIAL DOWN DISCHARGE FOR DIRECT DRIVE AHUS
		1	MOTORIZED BACKDRAFT DAMPER FOR SIZE 1 HOUSING - MEETS AMCA CLASS 1A RATING
		1	HOT WATER COIL SECTION A1-2 ROW. TEMPERATURE CONTROLS, MIXING VALVES, THERMOSTATS, AND FREEZE PROTECTION BY OTHERS
		1	INSULATED BLOWER SECTION SIZE 1-2 COMMERCIAL
		1	MIXING BOX SHELL FOR SIZE 1 MOD PACKAGE UNIT CONDENSER SUPPORT
2	MAU-118	1	SEPARATE 120V WIRING PACKAGE (REQUIRED AND USED ONLY FOR DCV OR PREWIRE WITH VFD) - THREE PHASE ONLY
		1	3 TON SINGLE CIRCUIT MODULAR PACKAGED AC COOLING OPTION FOR SIZE 1 MUA (450 TO 1200 CFM), 208V/230V, 3 PHASE. COOLING THERMOSTAT OR PROGRAMMABLE STAT REQUIRED FOR PROPER OPERATION
		1	MOD PACKAGE UNIT AC CONTROLS FOR UNTEMPERED FANS
		1	2 YEAR PARTS WARRANTY

FAN ACCESSORIES

FAN UNIT	TAG		EXHAUST	SUPPLY				
N <sub>□</sub>	TAU	GREASE CUP	GRAVITY DAMPER	SIDE DISCHARGE		MOTORIZED DAMPER	WALL MOUNT	
1	KX-118	YES						
2	MAU-118					YES		


CURB ASSEMBLIES

N□	□N FAN	TAG	WEIGHT	ITEM	SIZE
1	# 1	KX-118	36 LBS	CURB	23.000"W X 23.000"L X 20.000"H ALONG LENGTH, RIGHT VENTED HINGED.
N	# 2		89 LBS	RAIL	6.000"W X 21.000"L X 20.000"H RIGHT.
	# 2			RAIL	6.000"W X 21.000"L X 20.000"H RIGHT.
	# 2			RAIL	6.000"W X 21.000"L X 20.000"H RIGHT.
S	# 2		89 LBS	CURB	21.000"W X 21.000"L X 20.000"H ALONG LENGTH, RIGHT.

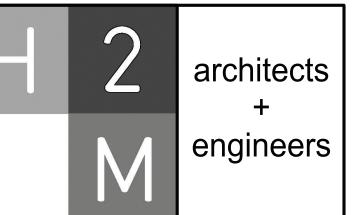

538 Broad Hollow Road, 4th Floor East Melville, NY 11747 631.756.8000 - www.h2m.com

MARK	DATE	DESCRIPTION

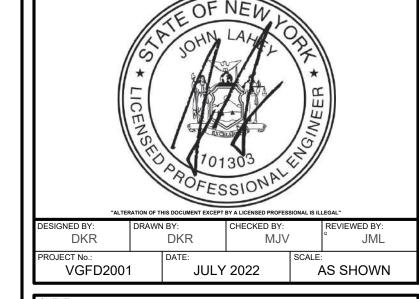

# **VAILS GATE FIRE DISTRICT**

New Storage Building (Phase I) New Fire Station (Phase II)



872 Blooming Grove Turnpike New Windsor, NY 12553


**CONTRACT G GENERAL CONSTRUCTION** 

FINAL BID DOCUMENT

HVAC KITCHEN SCHEDULES (3 OF 10)

M2 612.00

### FAN #1 DU85HFA - EXHAUST FAN (KX-118)

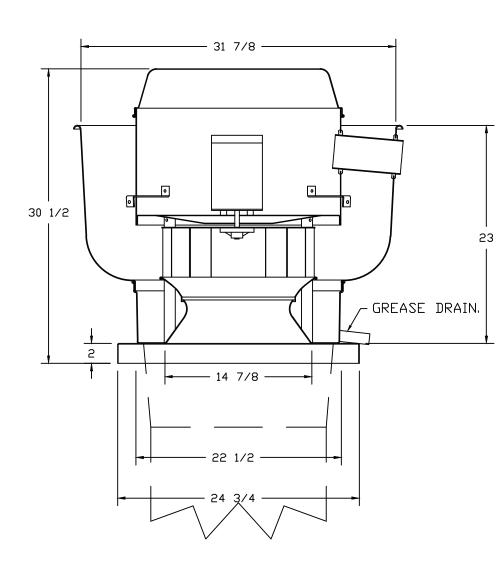

### FEATURES:

- DIRECT DRIVE CONSTRUCTION (NO BELTS/PULLEYS).
   ROOF MOUNTED FANS.
- RESTAURANT MODEL.
- UL705 AND UL762 AND ULC-S645
- VARIABLE SPEED CONTROL. – INTERNAL WIRING.
- THERMAL OVERLOAD PROTECTION (SINGLE PHASE).
- HIGH HEAT OPERATION 300°F (149°C). - GREASE CLASSIFICATION TESTING.
- NEMA 3R SAFETY DISCONNECT SWITCH.
- NORMAL TEMPERATURE TEST


  EXHAUST FAN MUST OPERATE CONTINUOUSLY
  WHILE EXHAUSTING AIR AT 300°F (149°C)
  UNTIL ALL FAN PARTS HAVE REACHED
  THERMAL EQUILIBRIUM, AND WITHOUT ANY
  DETERIORATING EFFECTS TO THE FAN WHICH
  WOULD CAUSE UNSAFE OPERATION.
- ABNORMAL FLARE-UP TEST


  EXHAUST FAN MUST OPERATE CONTINUOUSLY
  WHILE EXHAUSTING BURNING GREASE VAPORS
  AT 600°F (316°C) FOR A PERIOD OF
  15 MINUTES WITHOUT THE FAN BECOMING
  DAMAGED TO ANY EXTENT THAT COULD CAUSE
  AN UNSAFE CONDITION.
- OPTIONS


  GREASE BOX.


  ECM WIRING PACKAGE PWM SIGNAL FROM
  ECPMO3 PREWIRE (TELCO MOTOR), CCW

2 YEAR PARTS WARRANTY.

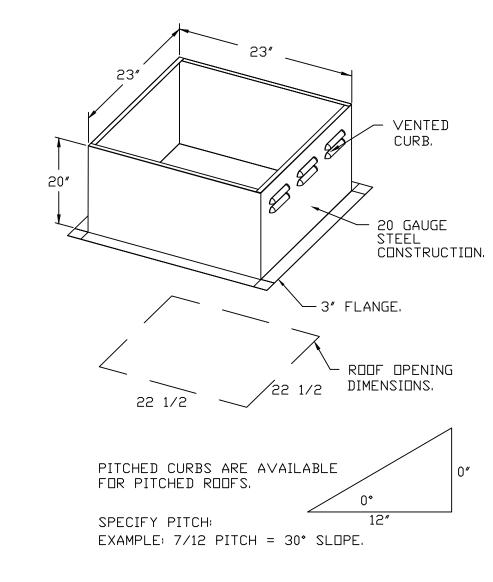

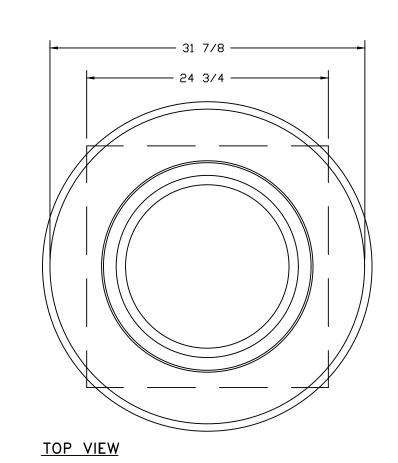

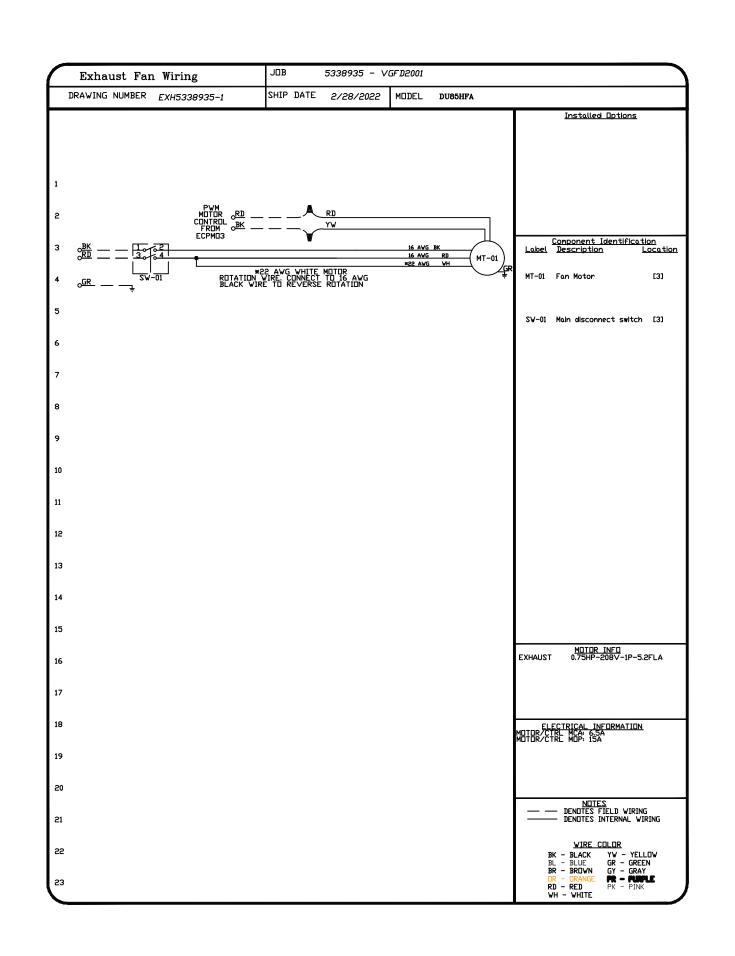


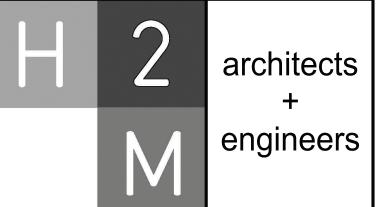

538 Broad Hollow Road, 4th Floor East Melville, NY 11747 631.756.8000 • www.h2m.com

CONSULTANTS:

MADIC	DATE	DECODIDATION
MARK	DATE	DESCRIPTION

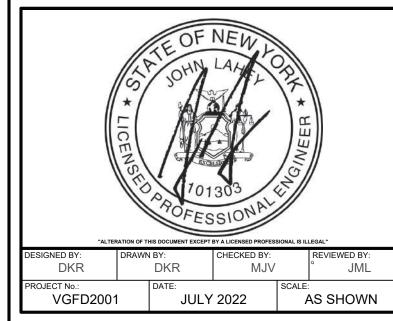

# VAILS GATE FIRE DISTRICT

New Storage Building (Phase I) New Fire Station (Phase II)



872 Blooming Grove Turnpike New Windsor, NY 12553

CONTRACT G
GENERAL CONSTRUCTION

FINAL BID DOCUMENT

SHEET TITLE

HVAC KITCHEN SCHEDULES (4 OF 10)

M2 613.00

FAN #2 A1-15D-MPU - SUPPLY FAN (MAU-118) 1. SUPPLY UNIT WITH 15" MIXED FLOW DIRECT DRIVE FAN IN SIZE #1 HOUSING.

. INTAKE HOOD WITH EZ FILTERS. 3. DOWN DISCHARGE - AIR FLOW RIGHT -> LEFT.

4. DOWN DISCHARGE - AIR FLOW RIGHT -> LEFT.

4. DOWN DISCHARGE CONSTRUCTION FOR SIZE 1 UNTEMPERED DIRECT DRIVE AHUS.


5. MOTORIZED BACK DRAFT DAMPER 16" X 18" FOR SIZE 1 UNTEMPERED UNITS W/EXTENDED SHAFT, STANDARD GALVANIZED CONSTRUCTION, 3/4" REAR FLANGE, LOW LEAKAGE, TFB120S ACTUATOR

6. HOT WATER COIL MODULE FOR SIZE 1 MODULAR FANS - 3350 CFM @ 70DEG TEMP RISE (253,260 BTU'S) COIL = 5MS1402B-19.5X16.5. OPPOSITE AIRFLOW REQUIRES SPECIAL ORDER COIL WITH EXTENDED LEAD-TIME. TEMPERATURE CONTROLS, MIXING VALVES, THERMOSTATS, AND FREEZE PROTECTION BY OTHERS.


7. INSULATED BLOWER HOUSING SIZES 1-2 COMMERCIAL MODULAR.
8. SUPPORT SHELL FOR SIZE 1 MODULAR PACKAGE UNIT. INCLUDES CONTROL VESTIBULE. INCLUDES CONDENSER SUPPORTS. DOES NOT INCLUDE RETURN AIR OR INLET AIR DAMPER. 9. SEPARATE 120VAC WIRING PACKAGE FOR MAKE-UP AIR UNITS. OPTION MUST BE SELECTED WHEN MOUNTING VFD IN PREWIRE PANEL OR WITH DCV PACKAGE. PROVIDES SEPARATE 120VAC INPUT TO SUPPLY FAN. THIS 120V SIGNAL MUST BE RUN BY ELECTRICIAN FROM DCV TO MUA SWITCH. 10. 3 TON, SINGLE CIRCUIT MODULAR PACKAGED AC COOLING OPTION FOR SIZE 1 MODULAR PACKAGED UNIT. INCLUDES CONDENSER, DX COIL, FILTER/DRYER KIT, THERMAL EXPANSION VALVE, R410A REFRIGERANT, AND REFRIGERANT PIPING. (450 TO 1,225 CFM) WHEN ORDERED WITH OPPOSITE AIRFLOW CONDENSERS ACCESS AND COIL PIPING WILL REMAIN IN STANDARD POSITION. DRAIN AND SLEDS WILL MOVE TO THE OPPOSITE SIDE. ANY OTHER CHANGE WILL REQUIRE CLI. CONDENSERS REQUIRE SEPARATE 208V, 3 PHASE POWER SUPPLY UNLESS ORDERED WITH SINGLE POINT CONNECTION. COIL = 2EY1402.


11. CONTROL PACKAGE FOR MOD PACKAGE UNIT COOLING ONLY UNIT. INCLUDES AIRFLOW PROVING SWITCH, RTULINK-ACHP BOARD AND TERMINAL BLOCKS. 12. HINGED DOUBLE WALL INSULATED DOOR ASSEMBLY (BURNER/BLOWER/MPU SECTION). 13. 2 YEAR PARTS WARRANTY

\*NOTE: SUPPLY DUCT MUST BE INSTALLED TO MEET SMACNA STANDARDS, A MINIMUM STRAIGHT DUCT LENGTH MUST BE MAINTAINED DOWNSTREAM OF UNIT DISCHARGE AS OUTLINED IN AMCA PUBLICATION 201. WHEN USING RECTANGULAR DUCTWORK, ELBOWS MUST BE RADIUS THROAT, RADIUS BACK WITH TURNING VANES FLEXIBLE DUCTWORK AND SQUARE THROAT/SQUARE BACK ELBOWS SHOULD NOT BE USED. ANY TRANSITION AND/OR TURNS IN THE DUCTWORK WILL CAUSE SYSTEM EFFECT, SYSTEM EFFECT WILL DRASTICALLY INCREASE STATIC PRESSURE AND REDUCE AIRFLOW, DO NOT RELY ON UNIT TO SUPPORT DUCT IN ANY WAY, FAILURE TO PROPERLY SIZE DUCTWORK MAY CAUSE SYSTEM EFFECTS AND REDUCE PERFORMANCE OF THE EQUIPMENT. SUGGESTED STRAIGHT DUCT SIZE IS 14" x 14".

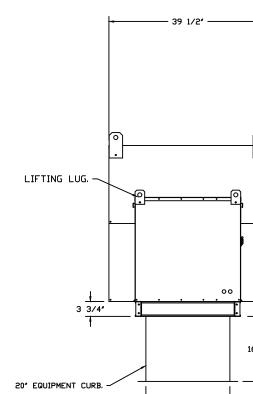

ROOF OPENING 2" SMALLER THAN CURB DIMENSION.

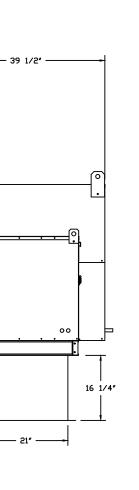

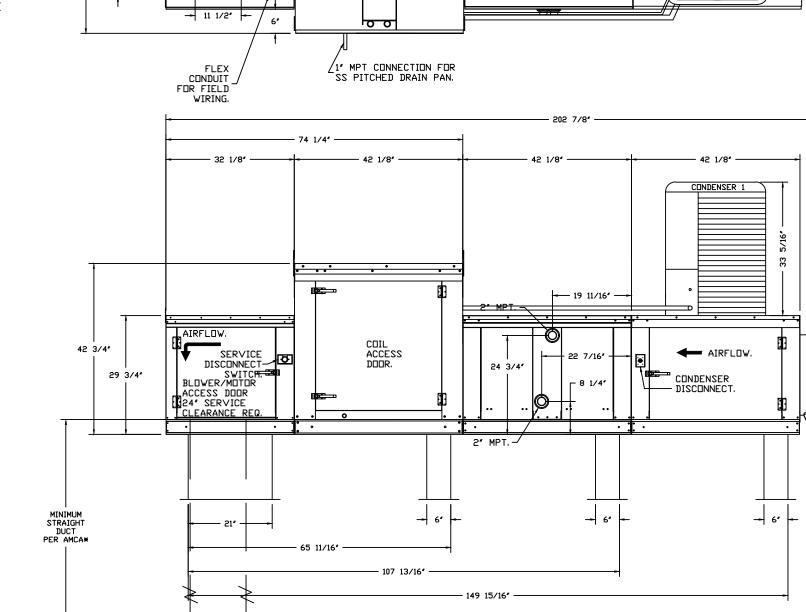

COOLING

AIRFLOW.

BLOWER DISCHARGE.


1 3/4" ————


39 1/2\*13 1/4\*

3 7/8"



TYPICAL DRAIN TRAP INSTALL RECOMMENDED COOLING COIL DRAIN TRAP CONFIGURATION.

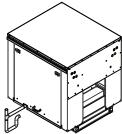

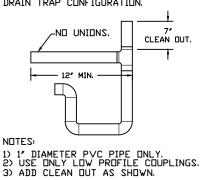


S GREASE DUCT & CHIMNEY SPECIFICATIONS: PROVIDE GREASE DUCT EQUAL TO CAPTIVEAIRE SYSTEMS MODEL "DW" ROUND 20 GAUGE 430 STAINLESS STEEL DUCTWORK, MODEL "DW" IS LISTED TO UL-1978 AND IS INSTALLED USING "V" CLAMP LOCKING CONNECTIONS SEALED WITH 3M FIRE BARRIER 2000 PLUS. MODEL "DW" DOES NOT REQUIRE WELDING PROVIDING IT HAS BEEN INSTALLED PER THE MANUFACTURES INSTALLATION GUIDE. PROVIDE RATED ACCESS DOORS AT EVERY CHANGE IN DIRECTION AND EVERY 12' ON CENTER. PER MANUFACTURES LISTING MODEL "DW" HORIZONTAL RUNS LESS THAN 75 FT. CAN BE SLOPED 1/16" PER 12", HORIZONTAL RUNS MORE THAN 75 FT. CAN BE SLOPED 3/16" PER 12".


IF THE DUCT OR CHIMNEY IS WITHIN 18 INCHES OF COMBUSTIBLE MATERIAL, PROVIDE UL-2221 OR UL-103 HT LISTED DOUBLE WALL GREASE DUCT OR DOUBLE WALL CHIMNEY EQUAL TO CAPTIVEAIRE SYSTEMS MODEL "DW- 2R, 2R TYPE HT, 3R, OR 3Z" ROUND 20 GAUGE 430 STAINLESS INNER DUCT INSULATED WITH A 24 GAUGE 430 STAINLESS DUTER SHELL.

DUCT SHOULD BE SLOPED AS MUCH AS POSSIBLE TO REDUCE THE CHANCE OF GREASE

CUSTOMER APPROVAL TO MANUFACTURE:							
APPROVED AS NOTED							
APPROVED WITH NO EXCEPTION TAKEN							
REVISE AND RESUBMIT							
SIGNATURE							
YOUR TITLEDATE							


ACCUMULATION IN HORIZONTAL RUNS.

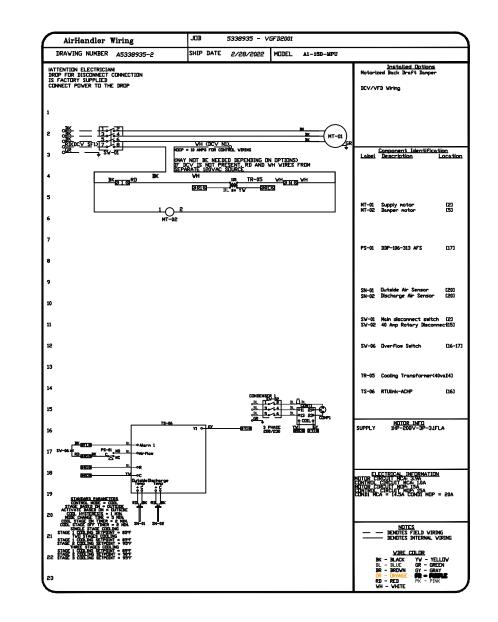

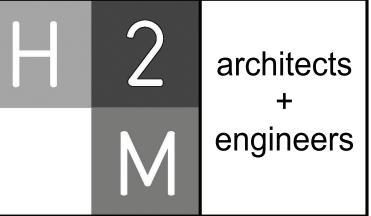

538 Broad Hollow Road, 4th Floor East Melville, NY 11747 631.756.8000 • www.h2m.com

MARK	DATE	DESCRIPTION

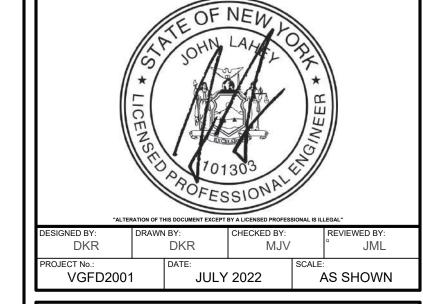

## **VAILS GATE FIRE DISTRICT**

**New Storage Building (Phase I)** New Fire Station (Phase II)




**872 Blooming Grove Turnpike** New Windsor, NY 12553


**CONTRACT G GENERAL CONSTRUCTION** 

FINAL BID DOCUMENT


**HVAC KITCHEN** SCHEDULES (5 OF 10)


M2 614.00

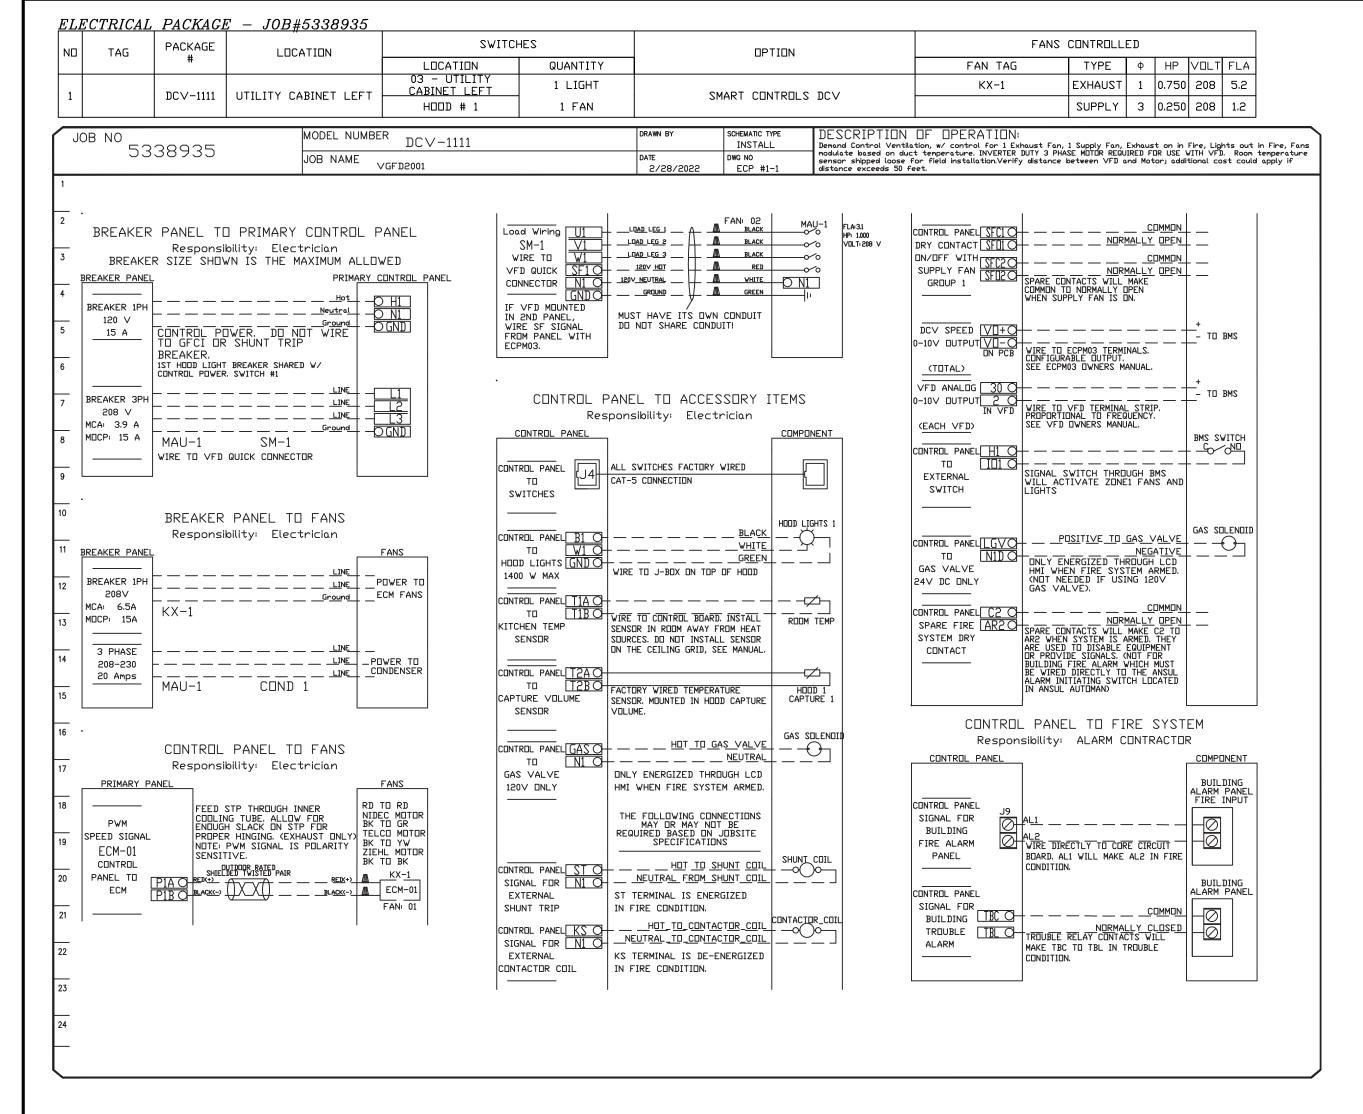

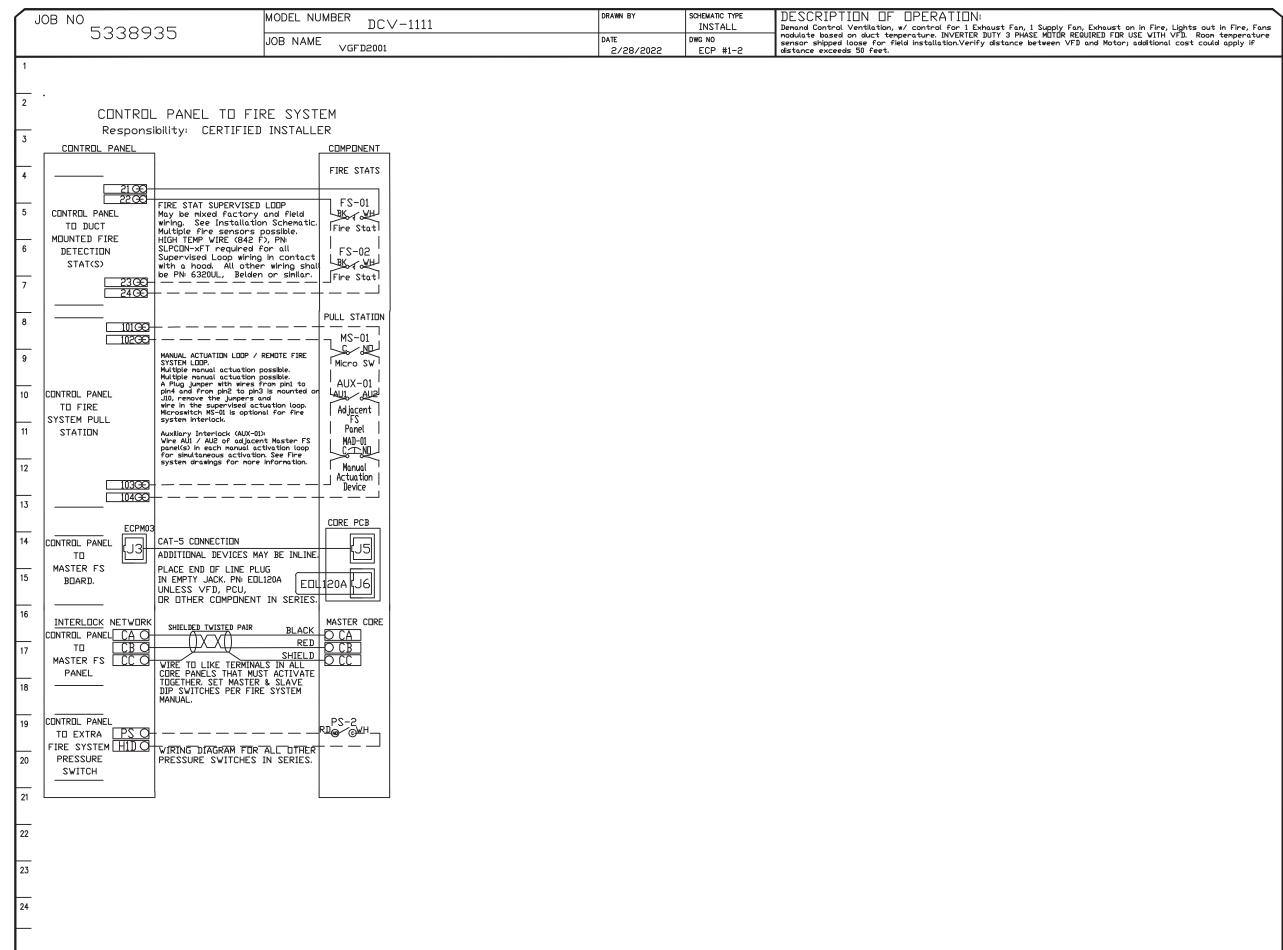

LOAD SIDE WIRING FOR EACH FAN MUST BE RUN IN SEPERATE CONDUIT FROM EMS SYSTEM TO EACH FAN ON ROOF.

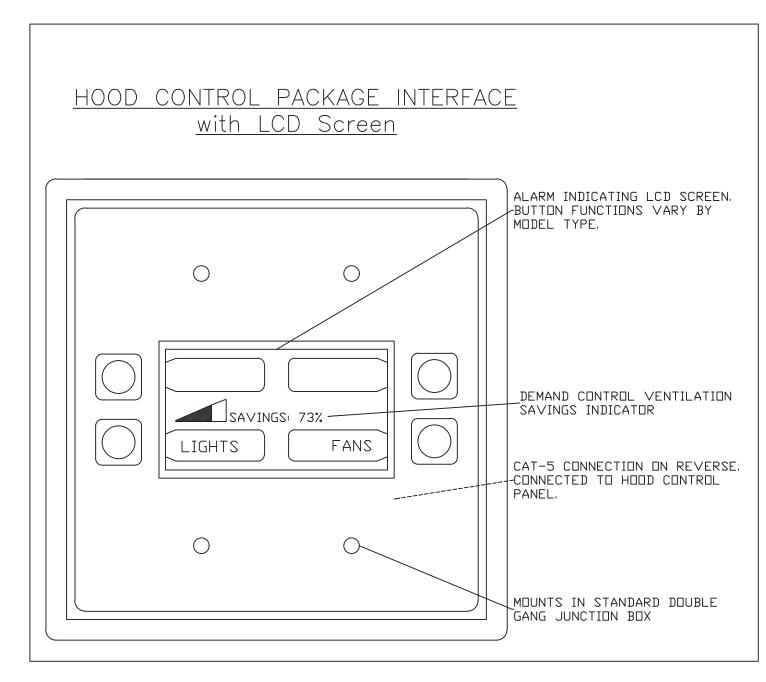


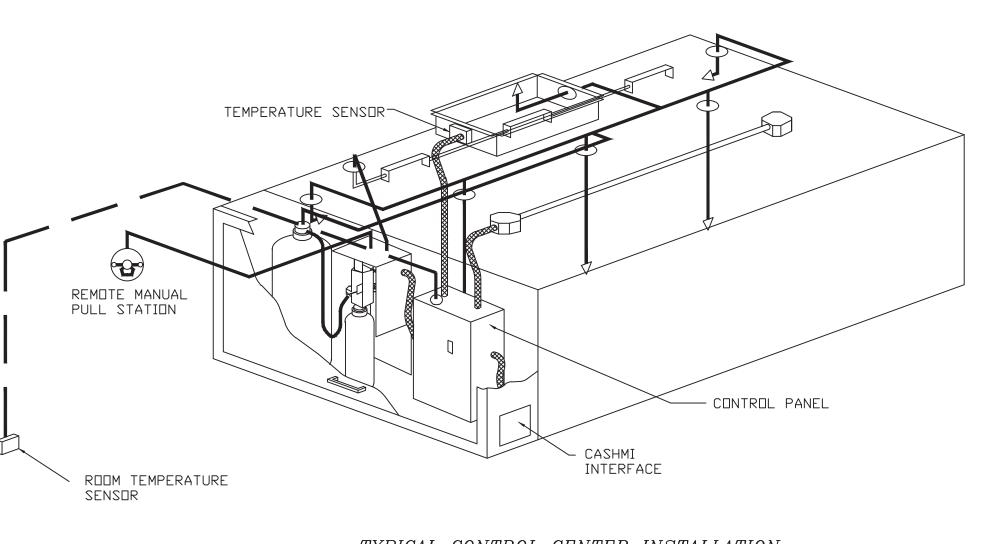

TYPICAL CONTROL CENTER INSTALLATION

538 Broad Hollow Road, 4th Floor East Melville, NY 11747 631.756.8000 • www.h2m.com

MARK	DATE	DESCRIPTION

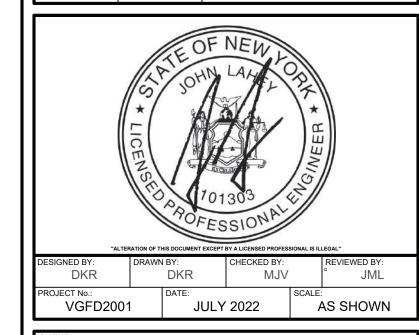

## **VAILS GATE FIRE DISTRICT**

**New Storage Building (Phase I)** New Fire Station (Phase II)




**872 Blooming Grove Turnpike** New Windsor, NY 12553


**CONTRACT G GENERAL CONSTRUCTION** 


FINAL BID DOCUMENT


**HVAC KITCHEN** SCHEDULES (6 OF 10)

M2 615.00

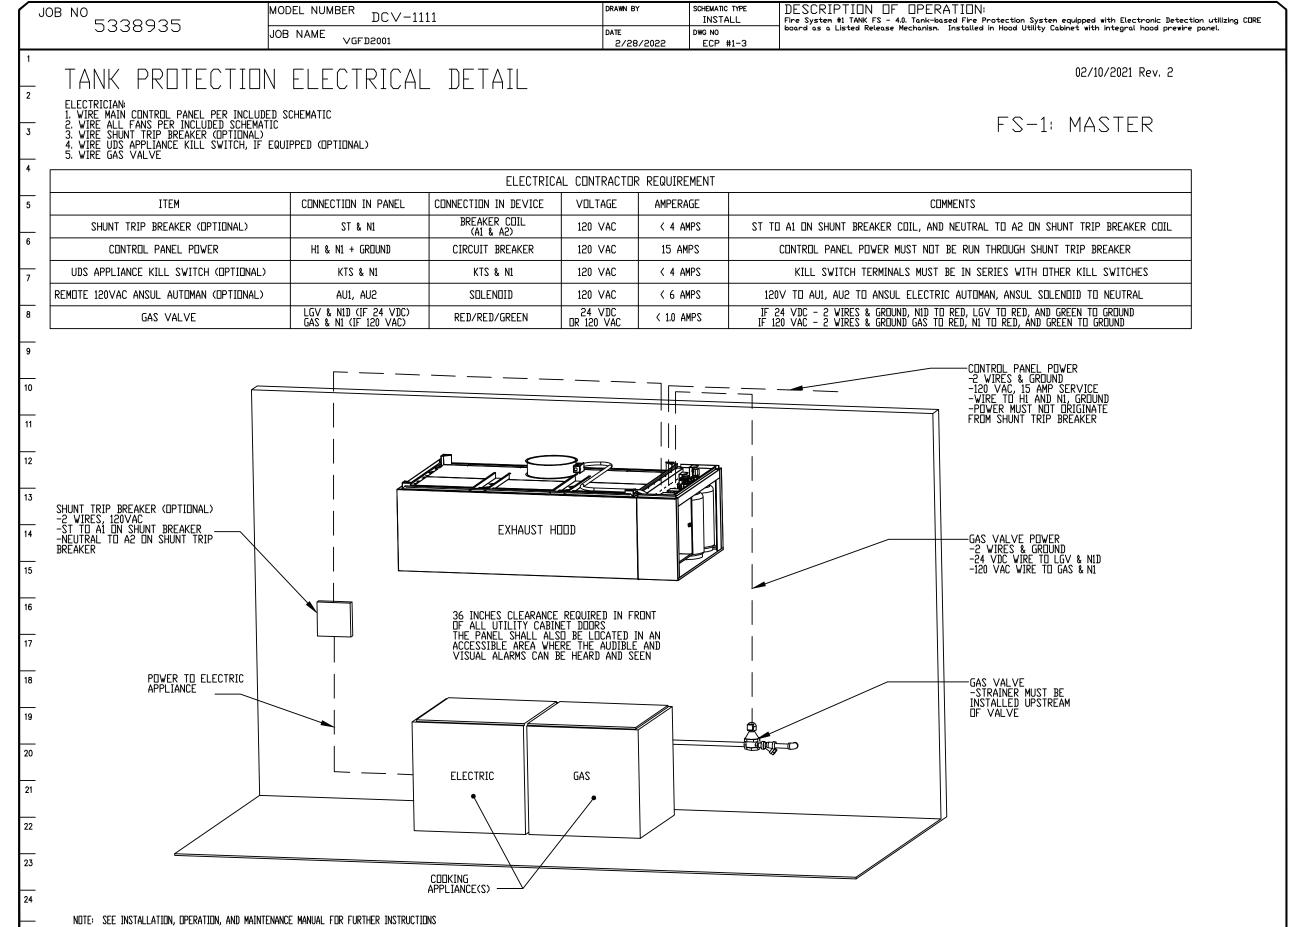


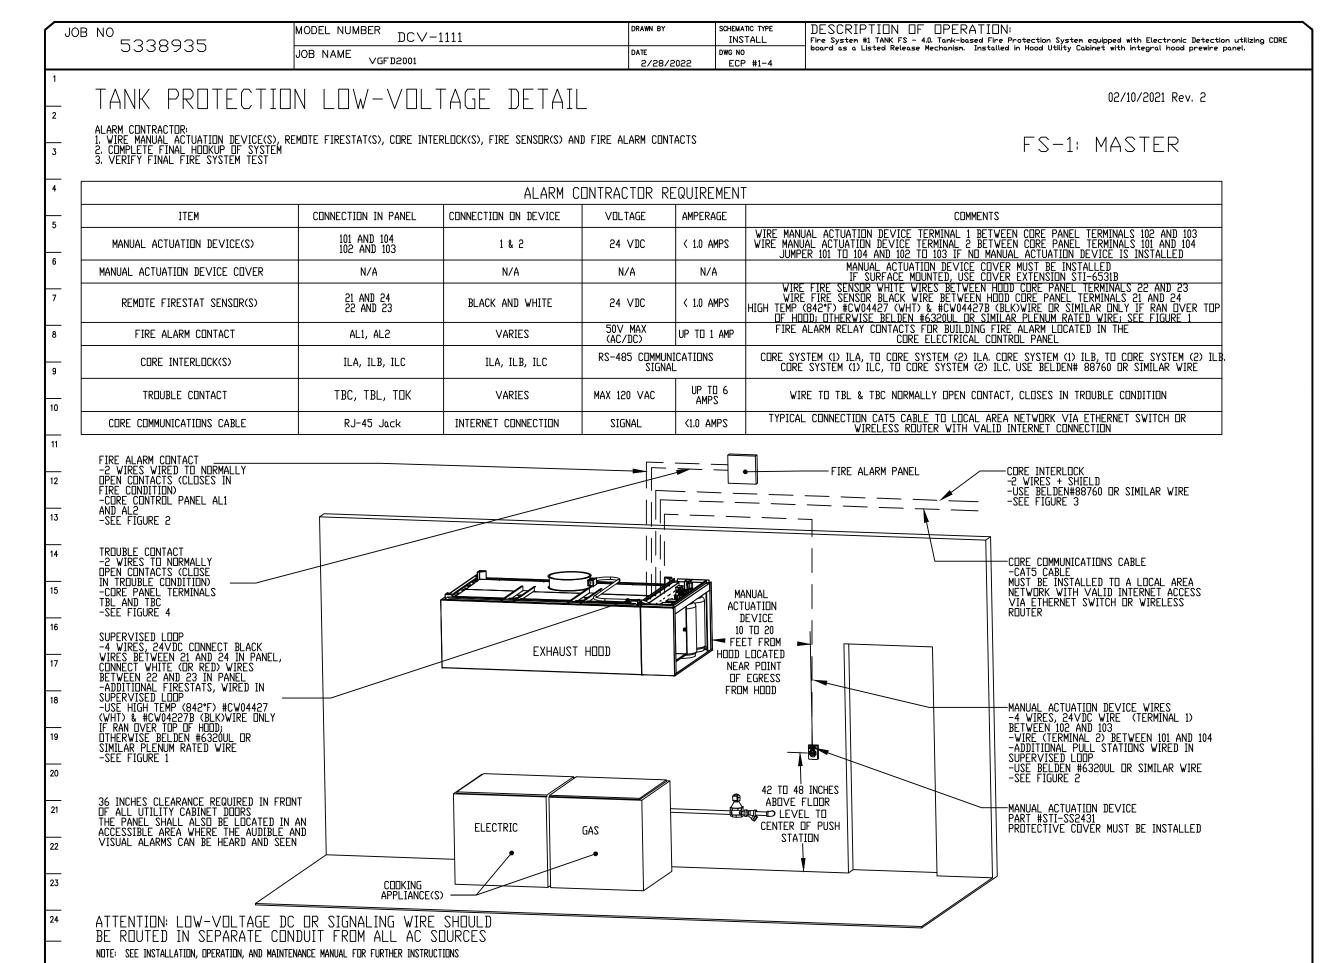

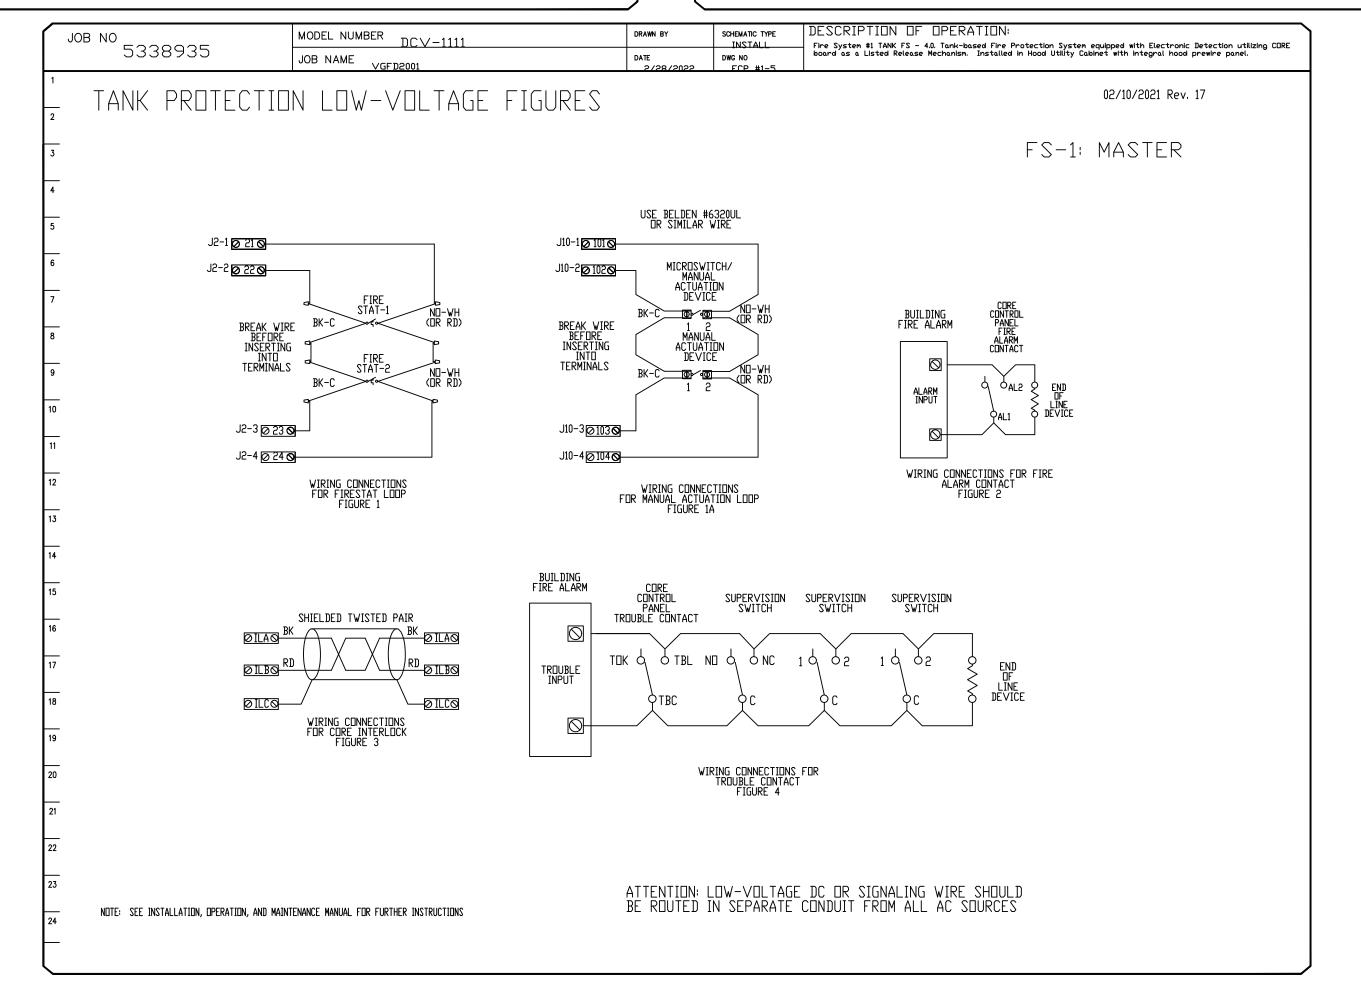

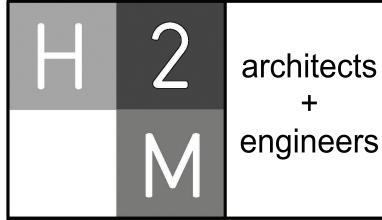

	MARK	DATE	DESCRIPTION
ı			
ı			
		·	

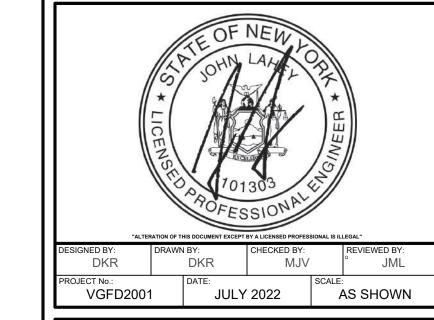

# VAILS GATE FIRE DISTRICT

New Storage Building (Phase I)
New Fire Station (Phase II)



872 Blooming Grove Turnpike New Windsor, NY 12553

CONTRACT G
GENERAL CONSTRUCTION

FINAL BID DOCUMENT


SHEET TITLE

HVAC KITCHEN SCHEDULES (7 OF 10)

M2 616.00

- DEMAND CONTROL VENTILATION HOOD CONTROL PANEL SPECIFICATIONS:

   CONTROLS SHALL BE LISTED BY ETL (UL 508A) AND SHALL COMPLY WITH DEMAND VENTILATION SYSTEM TURNDOWN REQUIREMENTS OUTLINED IN IECC 403.2.8 (2015).
- THE CONTROL ENCLOSURE SHALL BE NEMA 1 RATED AND LISTED FOR INSTALLATION INSIDE OF THE EXHAUST HOOD UTILITY CABINET. THE CONTROL ENCLOSURE MAY BE CONSTRUCTED OF STAINLESS STEEL OR PAINTED STEEL.
- TEMPERATURE PROBE(S) LOCATED IN THE EXHAUST DUCT RISER(S) SHALL BE CONSTRUCTED OF STAINLESS STEEL.
- A DIGITAL CONTROLLER SHALL BE PROVIDED TO ACTIVATE THE HOOD EXHAUST FANS DYNAMICALLY BASED ON A FIXED DIFFERENTIAL BETWEEN THE AMBIENT AND DUCT TEMPERATURES SENSORS, THIS FUNCTION SHALL MEET THE REQUIREMENTS OF IMC 507.1.1.
- A DIGITAL CONTROLLER SHALL PROVIDE ADJUSTABLE HYSTERESIS SETTINGS TO PREVENT CYCLING OF THE FANS AFTER THE COOKING APPLIANCES HAVE BEEN TURNED OFF AND/OR THE HEAT IN THE EXHAUST SYSTEM IS REDUCED.
- A DIGITAL CONTROLLER SHALL PROVIDE AN ADJUSTABLE MINIMUM FAN RUN-TIME SETTING TO PREVENT FAN CYCLING.
- VARIABLE FREQUENCY DRIVES (VFDS) SHALL BE PROVIDED FOR FANS AS REQUIRED. THE DIGITAL CONTROLLER SHALL MODULATE THE VFDS BETWEEN A MINIMUM SETPOINT AND A MAXIMUM SETPOINT ON DEMAND. THE DUCT TEMPERATURE SENSOR INPUT(S) TO THE DIGITAL CONTROLLER SHALL BE USED TO CALCULATE THE SPEED REFERENCE SIGNAL.
- THE VFD SPEED RANGE OF OPERATION SHALL BE FROM 0% TO 100% FOR THE SYSTEM, WITH THE ACTUAL MINIMUM SPEED SET AS REQUIRED TO MEET MINIMUM VENTILATION REQUIREMENTS.
- AN INTERNAL ALGORITHM TO THE DIGITAL CONTROLLER SHALL MODULATE SUPPLY FAN VFD SPEED PROPORTIONAL TO ALL EXHAUST FANS THAT ARE LOCATED IN THE SAME FAN GROUP AS THE SUPPLY FAN.
- THE SYSTEM SHALL OPERATE IN PREP MODE DURING LIGHT COOKING LOAD OR COOL DOWN MODE WHEN SUFFICIENT HEAT REMAINS UNDERNEATH THE HOOD SYSTEM AFTER COOKING OPERATIONS HAVE COMPLETED. OPERATION DURING EITHER OF THESE PERIODS WILL DISABLE THE SUPPLY FANS AND PROVIDE AN EXHAUST FAN SPEED THAT IS EQUAL TO THE MINIMUM VENTILATION REQUIREMENT.
- A DIGITAL CONTROLLER SHALL DISABLE THE SUPPLY FAN(S), ACTIVATE THE EXHAUST FAN(S), ACTIVATE
  THE APPLIANCE SHUNT TRIP, AND DISABLE AN ELECTRIC GAS VALVE AUTOMATICALLY WHEN FIRE CONDITION IS DETECTED ON A COVERED HOOD.
- A DIGITAL CONTROLLER SHALL ALLOW FOR EXTERNAL BMS FAN CONTROL VIA DRY CONTACT (EXTERNAL CONTROL SHALL NOT OVERRIDE FAN OPERATION LOGIC AS REQUIRED BY CODE).
- AN LCD INTERFACE SHALL BE PROVIDED WITH THE FOLLOWING FEATURES:
- A. DN/DFF PUSH BUTTON FAN & LIGHT SWITCH ACTIVATION.
- B. INTEGRATED GAS VALVE RESET FOR ELECTRONIC GAS VALVES (NO RESET RELAY REQUIRED). C. VFD FAULT DISPLAY WITH AUDIBLE & VISUAL ALARM NOTIFICATION.
- D. DUCT TEMPERATURE SENSOR FAILURE DETECTION WITH AUDIBLE & VISUAL ALARM NOTIFICATION.
- E. MIS-WIRED DUCT TEMPERATURE SENSOR DETECTION WITH AUDIBLE & VISUAL ALARM NOTIFICATION. F. A SINGLE LOW VOLTAGE CAT-5 RJ45 WIRING CONNECTION.
- G. AN ENERGY SAVINGS INDICATOR THAT UTILIZES MEASURED KWH FROM THE VFDS.

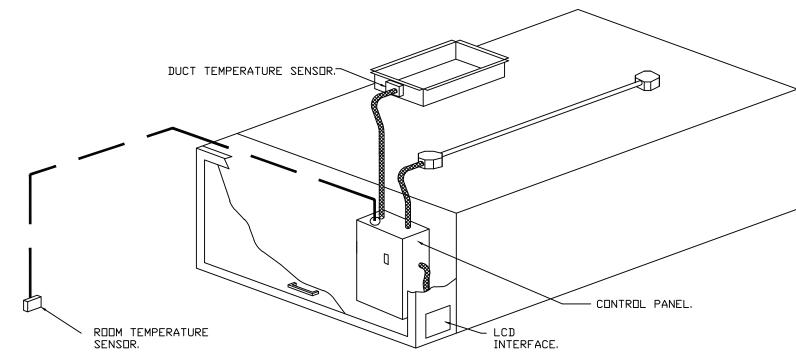

TYPICAL HOOD CONTROL PANEL INSTALLATION

### SEQUENCE OF OPERATIONS:

THE HOOD CONTROL PANEL IS CAPABLE OF OPERATING IN ONE OR MORE OF THE FOLLOWING STATES AT ANY GIVEN TIME:

- <u>AUTOMATIC:</u> THE SYSTEM OPERATES BASED ON THE DIFFERENTIAL BETWEEN ROOM TEMPERATURE AND THE TEMPERATURE AT THE HOOD CAVITY OR EXHAUST DUCT COLLAR. FANS ACTIVATE AT A CONFIGURABLE TEMPERATURE DIFFERENTIAL THRESHOLD. DEPENDING ON THE JOB CONFIGURATION EACH FAN ZONE CAN BE CONFIGURED AS STATIC OR DYNAMIC. THESE TERMS REFER TO WHETHER A VARIABLE MOTOR (SUCH AS EC MOTORS OR VFD DRIVEN MOTORS) MODULATE WITH TEMPERATURE. IF THE PANEL IS EQUIPPED WITH VARIABLE SPEED FANS AND THE ZONE IS DEFINED AS "DYNAMIC", THESE WILL MODULATE WITHIN A USER-DEFINED RANGE BASED ON THE TEMPERATURE DIFFERENTIAL. PANELS EQUIPPED WITH VARIABLE SPEED FANS AND A FAN ZONE DEFINED AS "STATIC", FANS WILL RUN AT A SET SPEED CALCULATED FOR THE DRIVE. DEMAND CONTROL VENTILATION SYSTEMS ARE CAPABLE OF MODULATING EXHAUST AND MAKE UP AIR FAN SPEEDS PER THE REQUIREMENTS OUTLINED IN IECC 403.2.8.
- MANUAL: THE SYSTEM OPERATES BASED ON HUMAN INPUT FROM AN HMI.
- <u>SCHEDULE:</u> A WEEKLY SCHEDULE CAN BE SET TO RUN FANS FOR A SPECIFIED PERIOD THROUGHOUT THE DAY. THERE ARE THREE OCCUPIED TIMES PER DAY TO ALLOW FOR THE USER TO SET UP A TIME THAT IS SUITABLE TO THEIR NEEDS. ANY TIME THAT IS WITHIN THE DEFINED OCCUPIED TIME, THE SYSTEM WILL RUN AT MODULATION MODE AND FOLLOW THE FAN PROCEDURE ALGORITHM BASED ON TEMPERATURE DURING THIS TIME. DURING UNOCCUPIED TIME, THE SYSTEM WILL HAVE AN EXTRA OFFSET TO PREVENT UNINTENDED ACTIVATION OF THE SYSTEM DURING A TIME WHERE THE SYSTEM IS NOT BEING OCCUPIED.
- <u>OTHER:</u> THE SYSTEM OPERATES BASED ON THE INPUT FROM AN EXTERNAL SOURCE (DDC, BMS OR HARD-WIRED INTERLOCK).
- <u>FIRE:</u> UPON ACTIVATION OF THE HOOD FIRE SUPPRESSION SYSTEM, THE EXHAUST FAN WILL COME ON OR CONTINUE TO TO RUN, THE HOOD MAKEUP AIR WILL SHUTDOWN, AND A SIGNAL WILL BE SENT FOR ACTIVATING THE SHUNT TRIP BREAKER PROVIDED BY THE ELECTRICIAN. FUEL GAS WILL SHUT OFF VIA A MECHANICAL/ELECTRICAL GAS VALVE ACTUATED BY THE HOOD FIRE SUPPRESSION SYSTEM.

### SYSTEM DESIGN VERIFICATION (SDV)

 $\mathsf{T}$ 

IF ORDERED, CAS SERVICE WILL PERFORM A SYSTEM DESIGN VERIFICATION (SDV) ONCE ALL EQUIPMENT HAS HAD A COMPLETE START UP PER THE OPERATION AND INSTALLATION MANUAL, TYPICALLY, THE SDV WILL BE PERFORMED AFTER ALL INSPECTIONS ARE COMPLETE.

ANY FIELD RELATED DISCREPANCIES THAT ARE DISCOVERED DURING THE SDV WILL BE BROUGHT TO THE

ATTENTION OF THE GENERAL CONTRACTOR AND CORRESPONDING TRADES ON SITE, THESE ISSUES WILL BE DOCUMENTED AND FORWARDED TO THE APPROPRIATE SALES OFFICE. IF CAS SERVICE HAS

RESOLVE A DISCREPANCY THAT IS A FIELD ISSUE, THE GENERAL CONTRACTOR WILL BE NOTIFIED AND BILLED FOR THE WORK, SHOULD A RETURN TRIP BE REQUIRED DUE TO ANY FIELD RELATED DISCREPANCY THAT CANNOT BE RESOLVED DURING THE SDV, THERE WILL BE ADDITIONAL TRIP CHARGES.

DURING THE SDV, CAS SERVICE WILL ADDRESS ANY DISCREPANCY THAT IS THE FAULT OF THE MANUFACTURER. SHOULD A RETURN TRIP BE REQUIRED, THE GENERAL CONTRACTOR AND APPROPRIATE SALES OFFICE WILL BE NOTIFIED. THERE WILL BE NO ADDITIONAL CHARGES FOR MANUFACTURER DISCREPANCIES.




architects + engineers

538 Broad Hollow Road, 4th Floor East Melville, NY 11747 631.756.8000 • www.h2m.com

CONSULTANTS:			_

MARK	DATE	DESCRIPTION

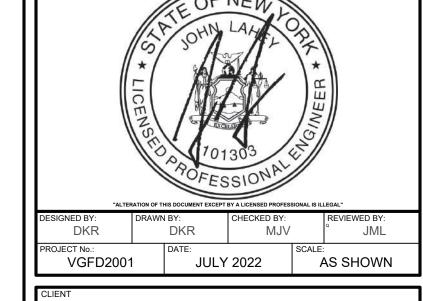

# VAILS GATE FIRE DISTRICT

New Storage Building (Phase I)
New Fire Station (Phase II)



872 Blooming Grove Turnpike New Windsor, NY 12553

CONTRACT

CONTRACT G
GENERAL CONSTRUCTION

FINAL BID DOCUMENT

SHEET TIT

HVAC KITCHEN SCHEDULES (8 OF 10)

M2 617.00

### DUCTWORK #1 PARTS - JOB#5338935 DOUBLE WALL

	DUCIWOIN #I IANIS = UUD#UUUUUUUUUUUUUUUUUUUUUUUUUUUUUUUUU									
TAG	PART #	CFM	GPM	ZONE	COVEREDBY	SP	WEIGHT	VELOCITY	QTY	DESCRIPTION
P1	DW1090DWASY-2R-S	1170				-0.21	20.35	2145.15	1	DOUBLE WALL DUCT - 10" INNER 90 DUCT - 2 LAYERS REDUCED CLEARANCE - 14" STAINLESS STEEL OUTER SHELL.
P2	DW1001DWOFFSETASY-2R-S	1170				-0.008	10.25	2145.15	1	DOUBLE WALL DUCT - 10" INNER DUCT RISER & 1 DEGREE OFFSET - 2 LAYERS REDUCED CLEARANCE - 14" STAINLESS STEEL OUTER SHELL.
Р3	DW1047DWLT-2R-S	1170				-0.045	47.26	2145.15	1	DOUBLE WALL DUCT - 10" INNER DUCT, 47" LONG - 2 LAYERS REDUCED CLEARANCE - 14" STAINLESS STEEL OUTER SHELL.
P4	DW1418SADKIT						5.82		1	DUCT - HORIZONTAL SADDLE SUPPORT KIT, USED WITH 14" OD - INCLUDES UNI-STRUT CUT To length,, Dw1418SAD, & HARDWARE BAG 4.
P5	DW1047DWAJD-2R-S	1170				-0.034	72.54	2145.15	1	DOUBLE WALL ADJUSTABLE DUCT - 10" INNER DUCT - 2 LAYERS REDUCED CLEARANCE - 14" STAINLESS STEEL OUTER SHELL. MIN LENGTH = 11" / MAX LENGTH = 49.5" / ADJUSTMENT = 31.5" / ADJUSTABLE SECTION MAY NEED TO BE CUT. INCLUDES SINGLE AND DOUBLE WALL "V" CLAMPS.
P6	DW1001DWOFFSETASY-2R-S	1170				-0.008	10.25	2145.15	1	DOUBLE WALL DUCT - 10" INNER DUCT RISER & 1 DEGREE OFFSET - 2 LAYERS REDUCED CLEARANCE - 14" STAINLESS STEEL OUTER SHELL.
P7 ASSEMBLED W/P8	DW10DWTEASY-2R-S	1170		1		-0.12	27.71	2145.15	1	DOUBLE WALL DUCT - 10" INNER TEE DUCT - 2 LAYERS REDUCED CLEARANCE - 14" STAINLESS STEEL OUTER SHELL.
P8 ASSEMBLED W/P7 D=S	DW10DWACCDOORCOV-2R-S						15.14		1	DOUBLE WALL DUCT - 10" INNER ACCESS DOOR & 14" ACCESS DOOR COVER WITH CLAMPS - 2 LAYERS REDUCED CLEARANCE - 14" STAINLESS STEEL OUTER SHELL.
P9	DW1047DWLT-2R-S	1170				-0.045	47.26	2145.15	1	DOUBLE WALL DUCT - 10" INNER DUCT, 47" LONG - 2 LAYERS REDUCED CLEARANCE - 14" STAINLESS STEEL OUTER SHELL.
P10	DW1047DWLT-2R-S	1170				-0.045	47.26	2145.15	1	DOUBLE WALL DUCT - 10" INNER DUCT, 47" LONG - 2 LAYERS REDUCED CLEARANCE - 14" STAINLESS STEEL OUTER SHELL.
P11 ASSEMBLED W/P12	DW10DWTEASY-2R-S	1170		1		-0.021	27.71	2145.15	1	DOUBLE WALL DUCT - 10" INNER TEE DUCT - 2 LAYERS REDUCED CLEARANCE - 14" STAINLESS STEEL OUTER SHELL.
P12 ASSEMBLED W/P11 D=T	DW10DWACCDOORCOV-2R-S						15.14		1	DOUBLE WALL DUCT - 10" INNER ACCESS DOOR & 14" ACCESS DOOR COVER WITH CLAMPS - 2 LAYERS REDUCED CLEARANCE - 14" STAINLESS STEEL OUTER SHELL.
P13	DW1047DWLT-2R-S	1170				-0.045	47.26	2145.15	1	DOUBLE WALL DUCT - 10" INNER DUCT, 47" LONG - 2 LAYERS REDUCED CLEARANCE - 14" STAINLESS STEEL OUTER SHELL.
P14 ASSEMBLED W/P15	DW1035DWLTTP-2R-S	1170				-0.034	36.51	2145.15	1	DOUBLE WALL DUCT - 10" INNER DUCT, 35" LONG - 2 LAYERS REDUCED CLEARANCE - 14" STAINLESS STEEL OUTER SHELL - USED WITH TRANSITION PLATE.
P15 ASSEMBLED W/P14	DW2310TPDB	1170					14.66	2145.15	1	DUCT TO CURB TRANSITION DOWN TURN, 23" CURB TO 10" DUCT, 16 GA ALUMINIZED. NOT FOR USE WITH EXHAUST FANS.
SYSTEM AT P15						-1.551	0.00			
P16	DW1418SADKIT						5.82		1	DUCT - HORIZONTAL SADDLE SUPPORT KIT, USED WITH 14" OD - INCLUDES UNI-STRUT CUT TO LENGTH,, DW1418SAD, & HARDWARE BAG 4.
	3M-2000PLUS						0.80		3	DUCT - 3M FIRE BARRIER 2000 PLUS SILICONE - USED AS SEALANT TO SEAL DUCT JOINTS.
	DW10DWCLASY-2R-S						5.67		8	DUCT - 10" DUCT - 14" DOUBLE "V" CLAMP - 2R INSULATION & SINGLE "V" CLAMP INCLUDED - REDUCED CLEARANCE.
TOTAL WEIGHT							498.70			

### DOUBLE WALL FACTORY BUILT DUCTWORK


- ALL DUCTWORK IS REQUIRED TO BE INSTALLED WITH THE MAXIMUM SUPPORT SPACING LISTED BELOW.
- FOR A COMPLETE LIST OF APPROVED SUPPORT METHODS, SEE THE ENTIRE INSTALLATION AND OPERATION MANUAL
- DUCTWORK SHALL SLOPE NOT LESS THAN 1/16" PER LINEAR FOOT TOWARDS THE HOOD OR AN APPROVED GREASE COLLECTION RESERVOIR.
- WHERE HORIZONTAL DUCTS EXCEED 75 FEET IN LENGTH, THE SLOPE SHALL NOT BE LESS THAN 3/16" PER LINEAR FOOT.


HORIZONTAL		
DUCT DIAMETER	SUPPORT SPACING (FT)	
5″	7′	
6″	7′	
7″	7′	
8″	7′	
10"	7′	
12"	7′	
14"	7′	
16″	7′	
18"	5′	
20″	5′	
22″	5′	
24"	5′	
26"	5′	
28″	5′	
30″	5′	
32″	5′	
34″	5′	
36″	5′	

VERTICAL					
TYPE	WALL SUPPORT (FT)	CURB SUPPORT (FT)	FLOOR SUPPORT (FT)		
2R & 2R HT (5"-16")	20′	24′	24′		
2R (18")	18′	24′	24′		
3R & 3Z (5″-24″)	10′	24′	24′		
3Z (26″ -36″)	10′	20′	20′		

DO NOT LEAK TEST USING SMOKE BOMBS CONTAINING CHLORINES/CHLORIDES, CONSULT WITH CAPTIVEAIRE FOR PROPER LEAK TESTING METHODS,

## DUCTWORK #1 FRONT VIEW

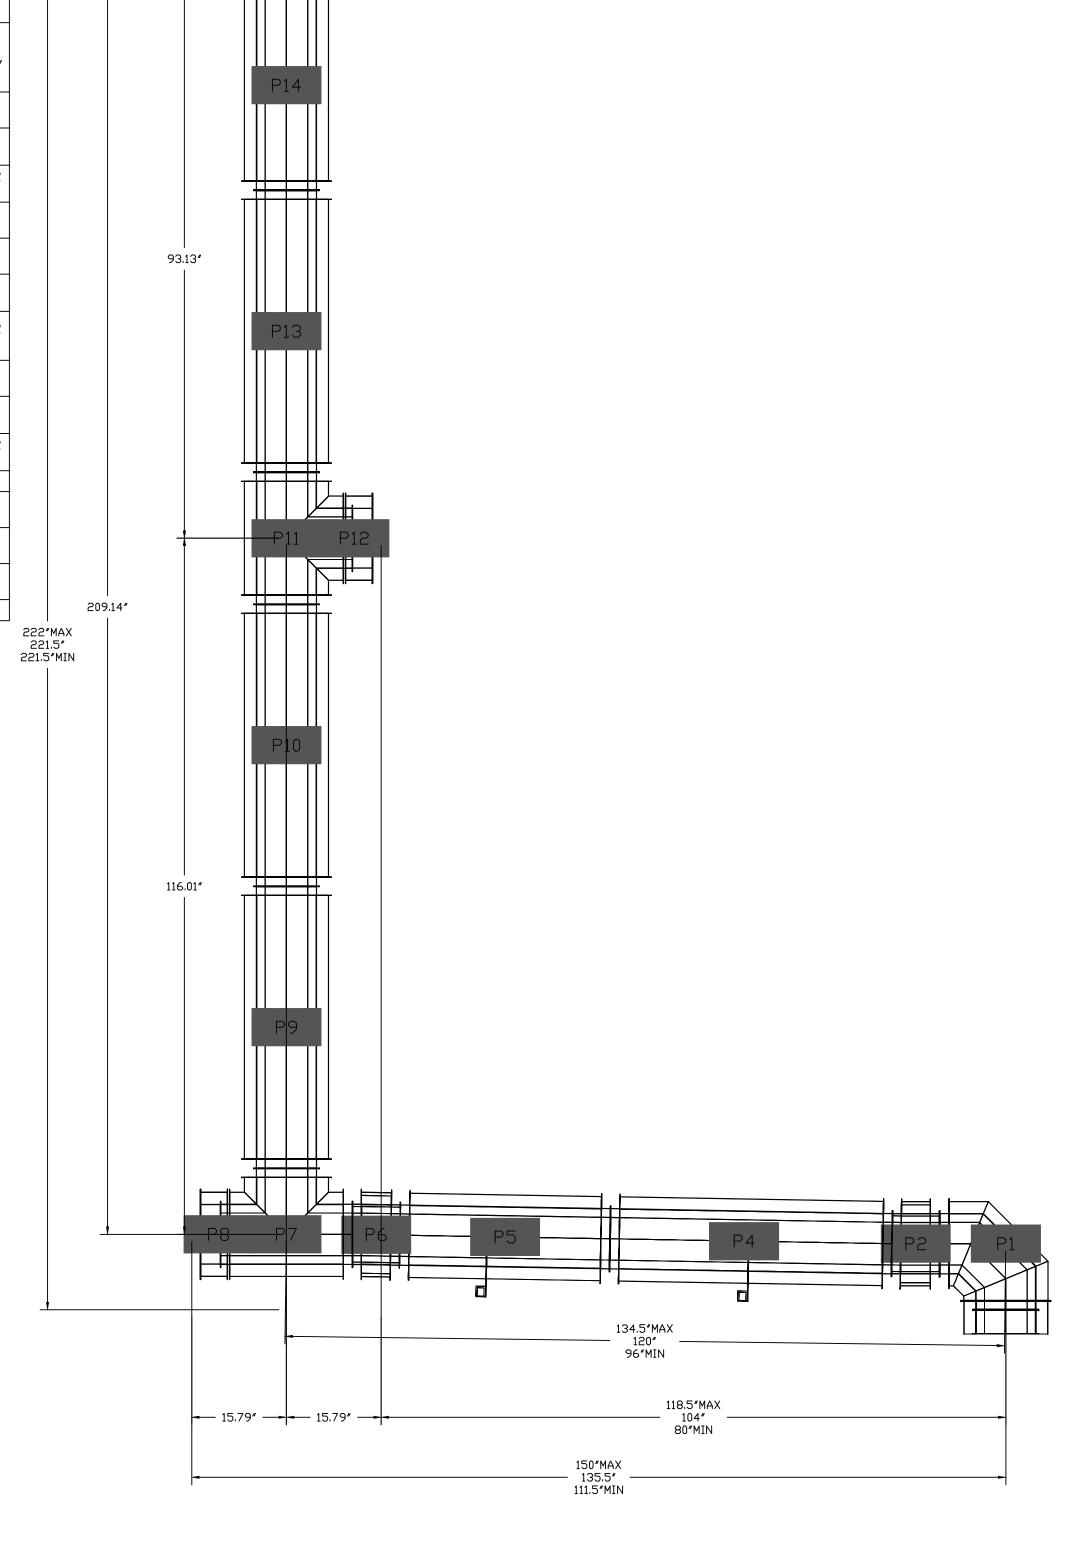


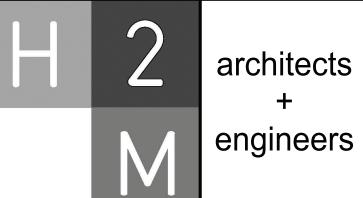

538 Broad Hollow Road, 4th Floor East Melville, NY 11747 631.756.8000 • www.h2m.com

CONSULTANTS:

MARK	DATE	DESCRIPTION

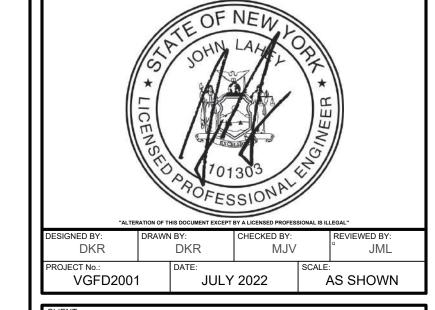

# VAILS GATE FIRE DISTRICT

New Storage Building (Phase I) New Fire Station (Phase II)



872 Blooming Grove Turnpike New Windsor, NY 12553


CONTRACT G
GENERAL CONSTRUCTION

FINAL BID DOCUMENT

SHEET TI


HVAC KITCHEN SCHEDULES (9 OF 10)

M2 618.00

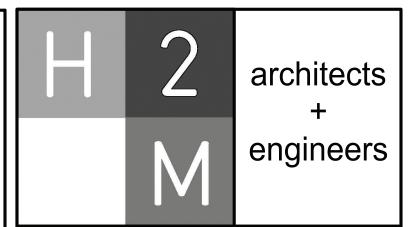

CONSULTANTS:

MARK	DATE	DESCRIPTION

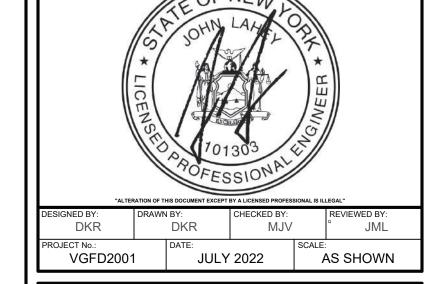

# VAILS GATE FIRE DISTRICT

New Storage Building (Phase I) New Fire Station (Phase II)



872 Blooming Grove Turnpike New Windsor, NY 12553


CONTRACT G
GENERAL CONSTRUCTION


FINAL BID DOCUMENT


SHEET TIT

HVAC KITCHEN SCHEDULES (10 OF 10)


M2 619.00

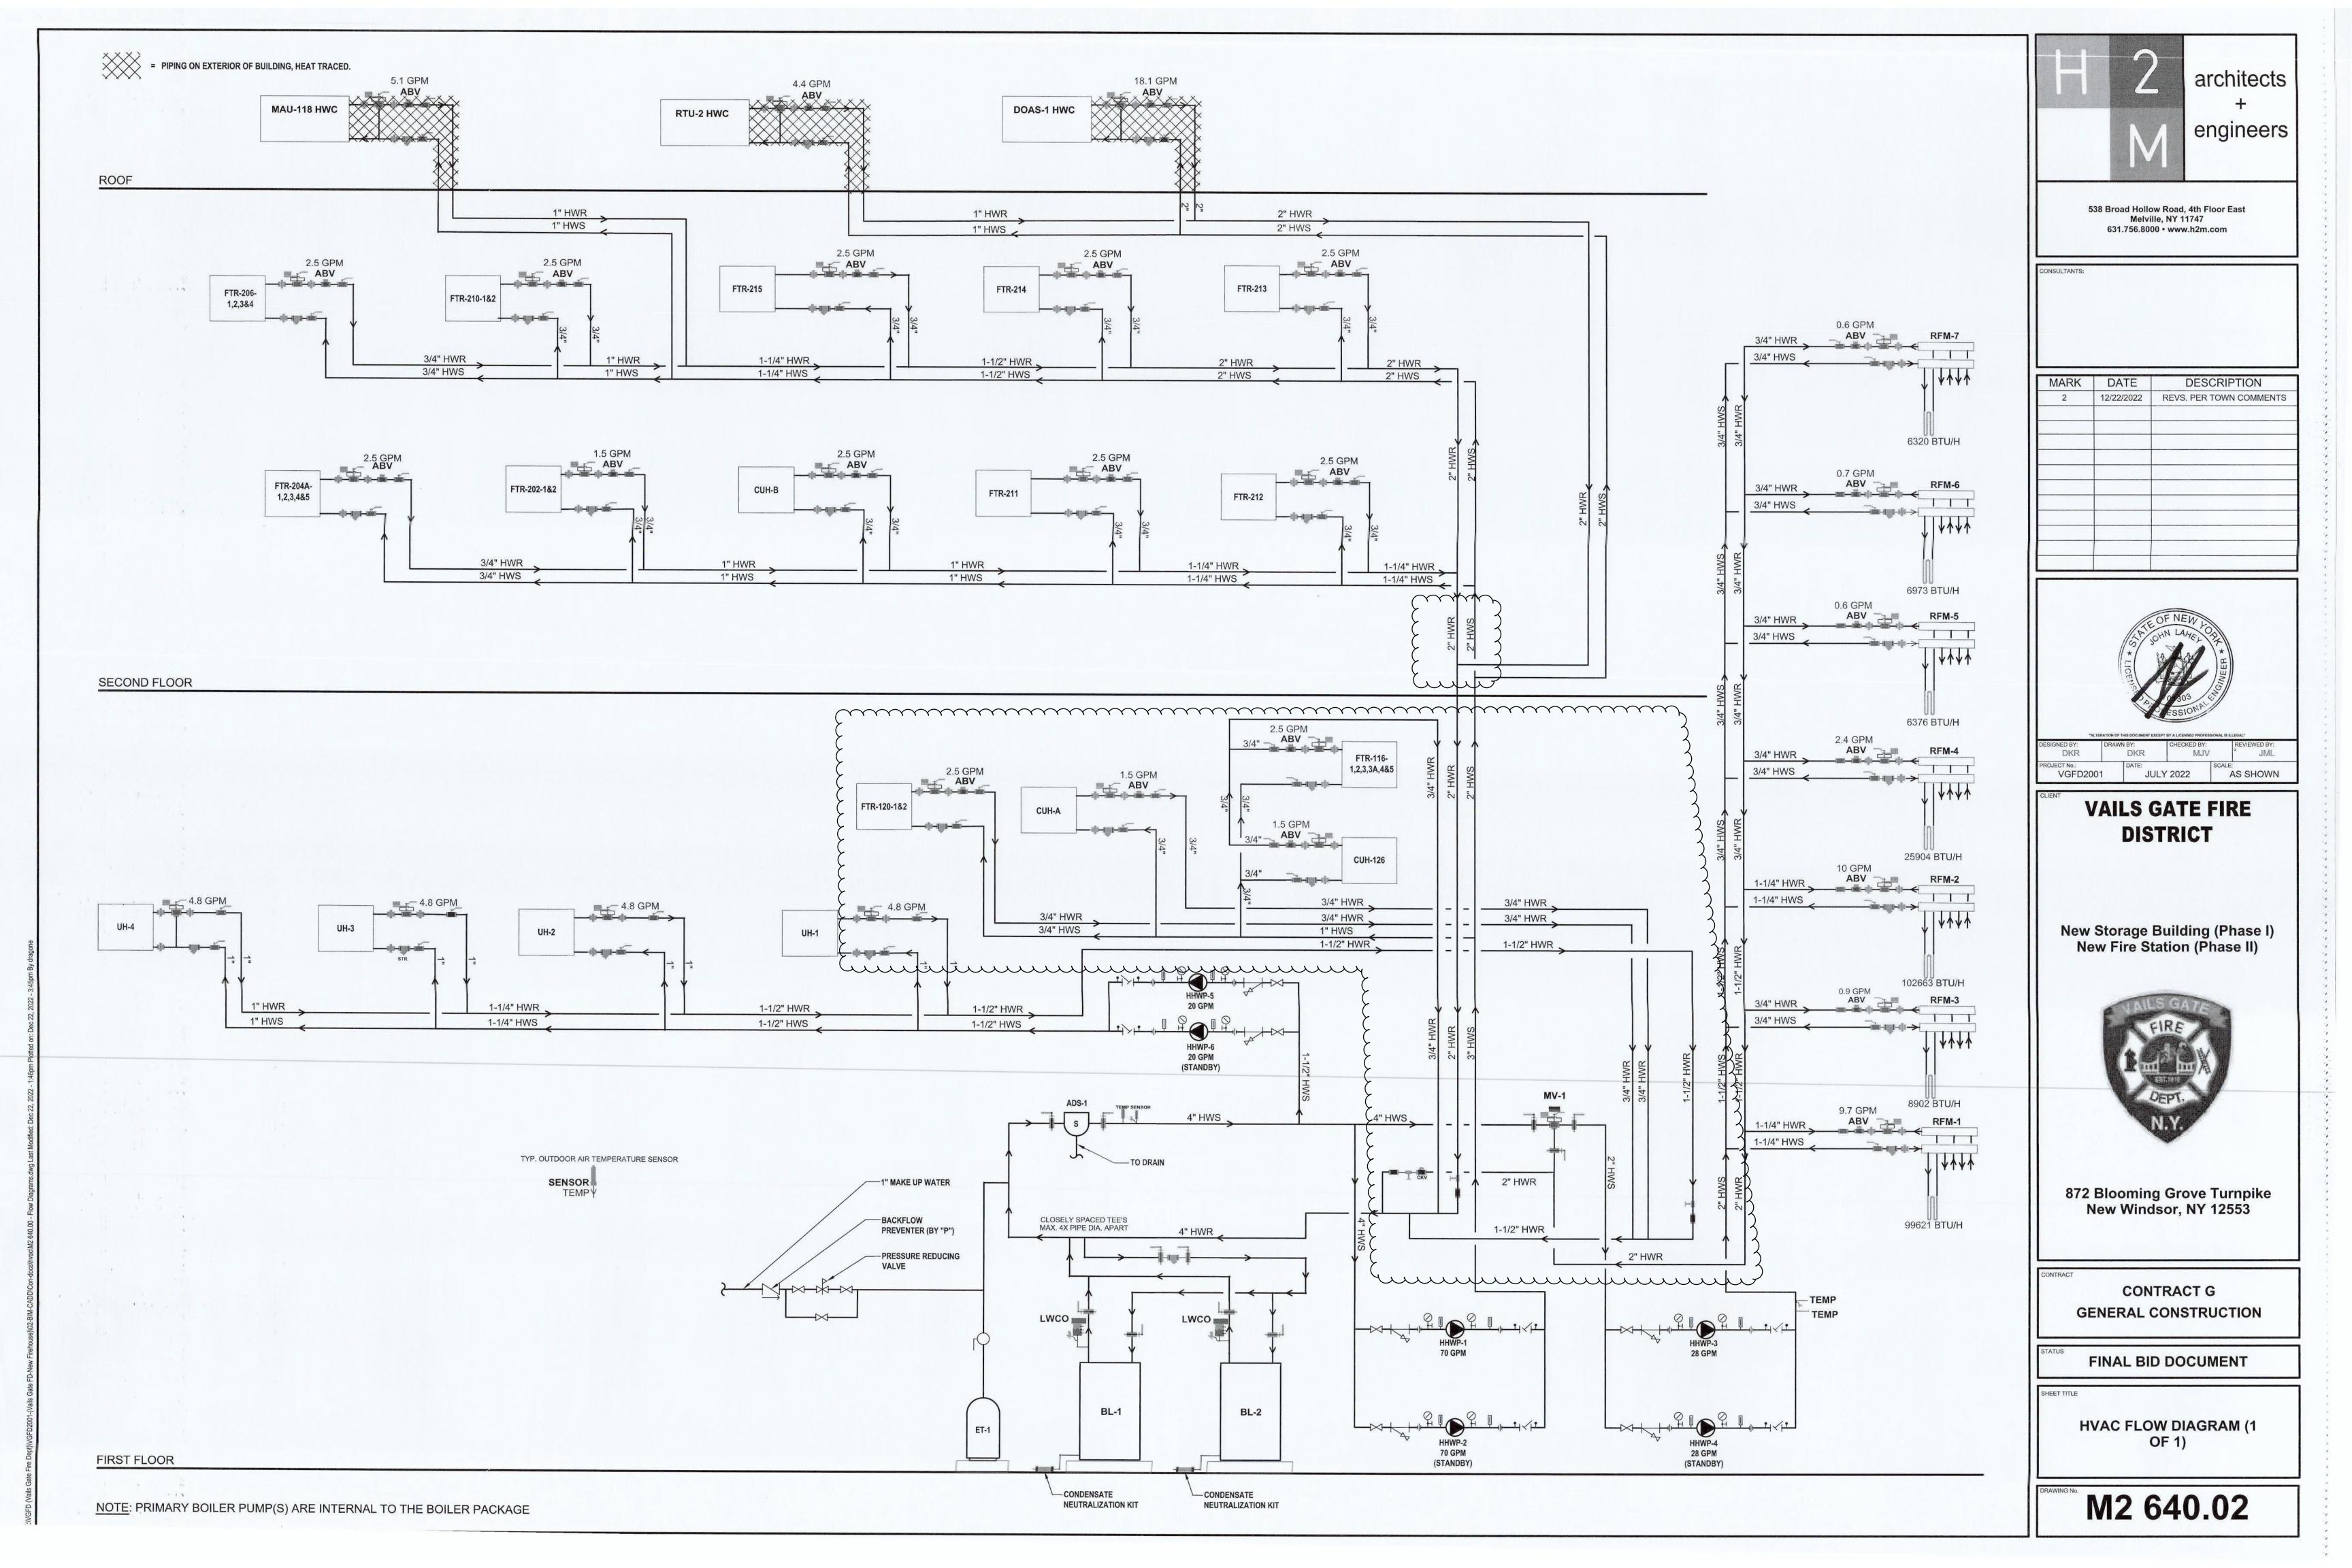

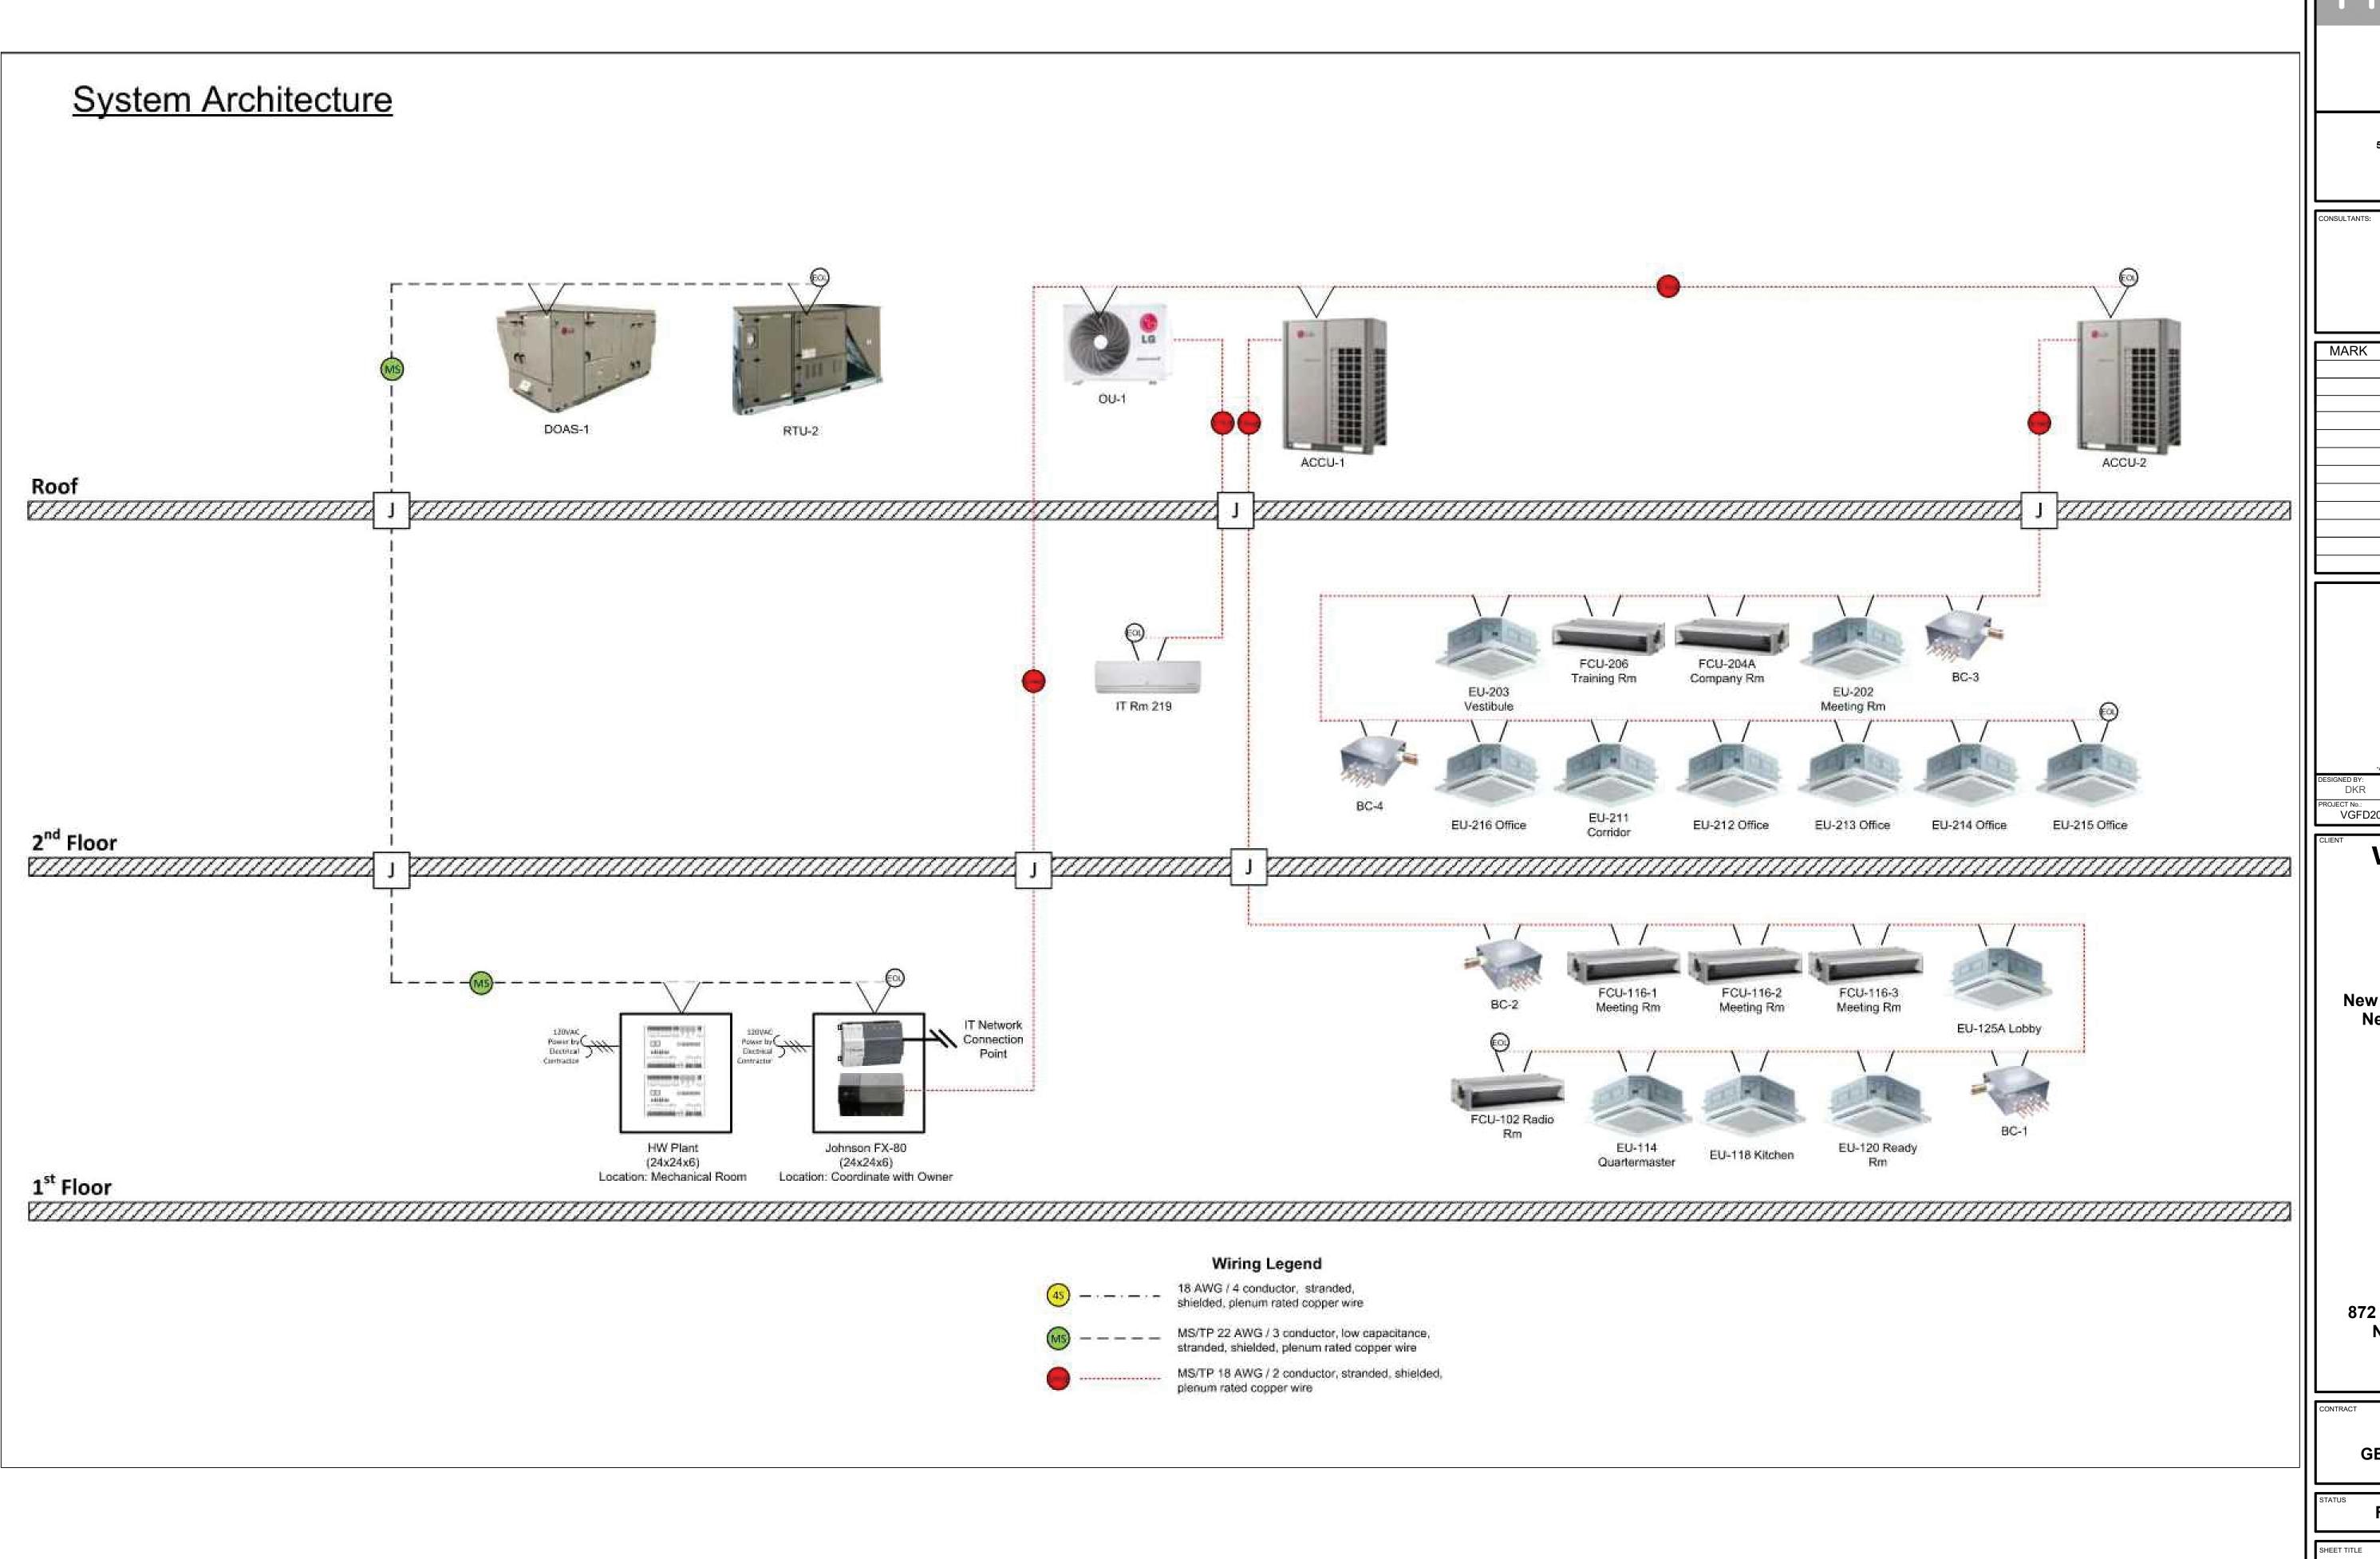

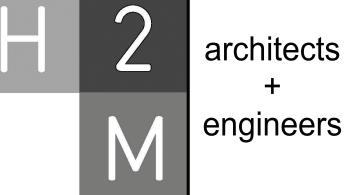

MARK	DATE	DESCRIPTION

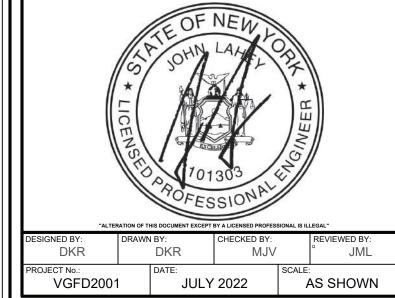

# **VAILS GATE FIRE DISTRICT**

New Storage Building (Phase I) New Fire Station (Phase II)



872 Blooming Grove Turnpike New Windsor, NY 12553

**CONTRACT G** 

**GENERAL CONSTRUCTION** 

FINAL BID DOCUMENT

**HVAC CONTROLS DIAGRAM** (1 OF 1)

M2 650.00