

Bid Addendum No. 1

June 29, 2022

City School District of New Rochelle – IEY MS Storm Mitigation

CSArch Project No. 188-2203.00

SED Control No. 66-11-00-01-0-003-017



Architect's Seal

This Bid Addendum No. 01 forms part of the Contract Documents and modifies the original bidding documents dated June 17, 2022. Bid Addendum No. 1 consists of two (2) pages, ten (10) specification sections and ten (10) full-size drawings.

GENERAL INFORMATION

1. Bid Addendum No. 1 issued to all Bidders / Plan Holders on June 29, 2022.

REVISIONS TO THE PROJECT MANUAL

1. REPLACE Section 000110 Table of Contents with the attached in its entirety. Revised Sections contained herein as part of Addendum 1.
2. REPLACE Section 004313 A310 with the attached in its entirety. Deleted William B. Ward references.
3. REPLACE Section 004513 A305 with the attached in its entirety. Deleted William B. Ward references.
4. REPLACE Section 006113.13 A312 with the attached in its entirety. Deleted William B. Ward references.
5. REPLACE Section 006113.14 A312 with the attached in its entirety. Deleted William B. Ward references.
6. REPLACE Section 006114 C106 with the attached in its entirety. Deleted William B. Ward references.
7. REPLACE Section 006273 G732 with the attached in its entirety. Deleted William B. Ward references.
8. REPLACE Section 006519.13 G706 with the attached in its entirety. Deleted William B. Ward references.
9. REPLACE Section 006519.16 G706A with the attached in its entirety. Deleted William B. Ward references.
10. REPLACE Section 006519.07 G707 with the attached in its entirety. Deleted William B. Ward references.

REVISIONS TO THE CONTRACT DRAWINGS

1. REPLACE sheet G000 with the attached in its entirety. Revised sheets contained herein as part of Addendum 1.
2. REPLACE sheet AD106 Area 'C' Partial Ground Floor Demo Plan with the attached in its entirety. Modified slab demolition scope to align with Plumbing.
3. REPLACE sheet S001 General Notes, Legend & Abbreviations with the attached in its entirety. Modified Steel General Notes and Special Inspection Notes.
4. REPLACE sheet S002 Special Inspections with the attached in its entirety. Modified Structural Steel Inspections applicability.
5. REPLACE sheet SD102 Area 'C' Partial Ground Floor Demo Plan with the attached in its entirety. Modified slab demolition scope to align with Plumbing.
6. REPLACE sheet S101 Area 'B' Partial Slab Plan with the attached in its entirety. Added steel stair notations.
7. REPLACE sheet S102 Area 'C' Partial Ground Floor Plan with the attached in its entirety. Modified slab new work scope to align with Plumbing.
8. REPLACE sheet A106 Area 'C' Partial Ground Floor Plan with the attached in its entirety. Modified slab new work scope to align with Plumbing.
9. REPLACE sheet A605 Enlarged Plans, Sections, and Details with the attached in its entirety. Added handrail detail, added Partition Types, and added Keynotes.

10. REPLACE sheet A900 Door Schedule, Elevations, and Details with the attached in its entirety. Added Door Type 'F'.

RESPONSES TO BIDDER WRITTEN QUESTIONS

1. Drawing C130 detail 2 shows new pipe invert at elevation -5.92 feet. Existing grade elevation is 32.11, can we confirm the -5.92' elevation is the depth to the invert from existing grade and not the actual elevation? *RESPONSE: -5.92 is the depth from existing grade to the invert at the building, and -6.04 is the depth from existing grade to the proposed invert at the existing catch basin (EX CB). These are not intended to be the proposed elevations.*
2. Sheet A605 Weight / Band Rooms show infill with structural fill under new raised concrete slab. The logistics to install this quantity of dirt is substantial. Would you accept an add/deduct alternate for K-crete or Geofoam boards, or address this AFTER the Bid? *RESPONSE: We would anticipate the same level of effort to bring in flowable fill and geofoam is not suitable for areas that could see flooding.*
3. We would like to request a time extension to the Bid Date by a week if possible. Please advise. *RESPONSE: The District has advised that doing so would be infeasible. The Board of Education monthly Meeting is July 7. If we don't make said Meeting, we'll be an additional month out. Being a flood recovery project with an ever-shortening summer construction season is the main driver as to why we cannot extend.*
4. Sheet S501, details 5-7 show backfill material to be subbase Type 2 and granular fill 1'-0" under new concrete. Confirm we're removing all material in trenches, disposing offsite, and importing clean subbase Type 2 as backfill. *RESPONSE: Confirmed.*
5. Sheet S501, details 5-7 show backfill material to be subbase Type 2 and granular fill 1'-0" under new concrete. Typically, gravel is used under slabs as subbase. Please confirm granular fill is gravel. *RESPONSE: Refer to Addendum 1.*
6. Drawing A900 shows Door Type 'F' for tags 146A, 146B & 162A. This is not shown on the elevations. *RESPONSE: Refer to Addendum 1.*
7. Drawing A605 detail 1 Note A5 calls for new handrail. Please provide detail and type of handrail. *RESPONSE: Refer to Addendum 1.*
8. Drawing AF111 detail 2 shows new RB-1 in weight and band rooms. From field visit, the existing studs on those walls are to remain and concrete poured around them. Rubber base cannot be installed on open studded walls. *RESPONSE: Refer to Addendum 1.*

END OF BID ADDENDUM NO. 1

SECTION 000110 - TABLE OF CONTENTS

VOLUME 01: DIVISIONS 00-01

DIVISION 00 – PROCUREMENT AND CONTRACTING REQUIREMENTS

Introductory Information

000011	Certification Page
000110	<u>Table of Contents</u>
000115	Drawing Index

Procurement Requirements

001116	Invitation to Bid GC-01
001116	Invitation to Bid PC-01
002113	Instructions to Bidders
003113	Preliminary Schedules

Procurement Forms and Supplements

004116.01	Bid Form – Contract GC-01 – General Construction Contract
004116.02	Bid Form – Contract PC-01 – Plumbing Contract
004313	<u>Bid Bond – AIA Document A310, 2010 Edition</u>
004325	Substitution Request Form
004336	Proposed Subcontractors Form
004513	<u>Contractor's Qualification Statement – AIA Document A305, 2020 Edition</u>
004519	Non-Collusion Affidavit
004520	Iran Divestment Act Affidavit
004543	Corporate Resolutions

Contracting Requirements & Supplements

005216	Owner-Contractor Agreement, Construction Manager Edition
006113.13	<u>Payment Bond – AIA Document A312, 2010 Edition</u>
006113.14	<u>Performance Bond – AIA Document A312, 2010 Edition</u>
006114	<u>C106 Digital Data Licensing Agreement</u>
006273	<u>Schedule of Values – AIA Document G732, 2009 Edition</u>
006274	Schedule of Values Continuation Sheet – AIA Document G703, 1992 Edition

Closeout Forms

006519.13	<u>Contractor's Affidavit of Payment of Debts and Claims – AIA Document G706, 1994 Edition</u>
006519.16	<u>Contractor's Affidavit of Release of Liens – AIA Document G706A, 1994 Edition</u>
006519.17	<u>Consent of Surety to Final Payment – AIA Document G707, 1994 Edition</u>

Conditions of the Contract & Supplementary Conditions

007216	General Conditions of the Contract for Construction
007343	Wage Rates

Project Forms

008300	Project Forms
008310	Submittal Cover Sheet
008320	Request for Information
008325	Change in Condition Sheet
008330	Request for Shutdown
008340	Daily Report Cover
008350	Labor Rate Sheet
008370	Two-Week Look Ahead Schedule
008380	Bi-Weekly Material/Equipment Status Report
008440	Substantial Completion Report
008450	Test Report/Inspection Log
008470	Submittal Schedule

DIVISION 01 – GENERAL REQUIREMENTS

011200	Multiple Contract Summary
011400	Work Restrictions
011410	NYSED 155.5 Uniform Safety Standards for School Construction and Maintenance Projects

Price and Payment Procedures

012100	Allowances
012200	Unit Prices
012300	Alternates
012600	Contract Modification Procedures
012900	Payment Procedures
012973	Schedule of Values

Administrative Requirements

013100	Project Management and Coordination
013150	Safety and Health
013150.1	COVID-19 Contractor Guidelines for Construction Jobsites - Review
013200	Construction Progress Documentation
013233	Photographic Documentation
013300	Submittal Procedures

Quality Requirements

014000	Quality Requirements
014200	References

Product Requirements

015000	Temporary Facilities and Controls
--------	-----------------------------------

Product Requirements

016000	Product Requirements
--------	----------------------

Execution and Closeout requirements

017300	Execution
017329	Cutting and Patching
0174193	Cleaning Up
017700	Closeout Procedures
017823	Operation and Maintenance Data
017836	Warranties

VOLUME 02: DIVISIONS 02-33

DIVISION 02 – EXISTING CONDITIONS

023313	Underground Utility Locator Service
024100	Demolition

DIVISION 03 – CONCRETE

032000	Concrete Reinforcing
033000	Cast-In-Place Concrete

DIVISION 04 – MASONRY

042000 Unit Masonry
045020 Cold (Hot) Weather Masonry

DIVISION 05 – METALS

055000 Metal Fabrications

DIVISION 06 – WOOD AND PLASTICS

060153 Miscellaneous Rough Carpentry
064020 Interior Architectural Woodwork

DIVISION 07 – THERMAL AND MOISTURE PROTECTION

072100 Thermal Insulation
078413 Penetration Firestopping
079200 Joint Sealants

DIVISION 08 – DOORS AND WINDOWS

081113 Hollow Metal Doors and Frames
081416 Flush Wood Doors
083110 Access Doors and Frames
084113 Aluminum-Framed Entrances and Storefronts
087100 Door Hardware
088000 Glazing

DIVISION 09 – FINISHES

090160 Cleaning and Patching Minor Chips and Cracks in Terrazzo
092216 Non-Structural Metal Framing
092900 Gypsum Board
095113 Acoustical Panel Ceilings
096513 Resilient Base and Accessories
096613 Portland Cement Terrazzo Flooring
096723 Resinous Flooring
099100 Painting

DIVISION 10 – SPECIALTIES

Not Used

DIVISION 11 – EQUIPMENT

Not Used

DIVISION 12 – FURNISHINGS

Not Used

DIVISION 13 – SPECIAL CONSTRUCTION

Not Used

DIVISION 14 – CONVEYING EQUIPMENT

Not Used

DIVISION 21 – FIRE SUPPRESSION

Not Used

DIVISION 22 – PLUMBING

220500	General Plumbing Requirements
220502	Plumbing Demolition
220529	Supports and Sleeves
220553	Plumbing Identification
221000	Plumbing Piping
221030	Plumbing Specialties
221429	Sump Pumps

DIVISION 23 – HEATING, VENTILATING AND AIR CONDITIONING

230500	General Mechanical Requirements
230502	Mechanical Demolition
230529	Supports and Sleeves
230719	Pipe Insulation
232113	Hydronic Piping

DIVISION 26 – ELECTRICAL

260500	General Electrical Requirements
260519	Low-Voltage Electrical Power Conductors and Cables
260526	Grounding and Bonding for Electrical Systems
260529	Hangers and Supports for Electrical Systems

260533	Raceways and Boxes for Electrical Systems
260544	Sleeves and Sleeve Seals for Electrical Raceways and Cabling
260553	Identification for Electrical Systems
262726	Wiring Devices
262816	Enclosed Switches and Circuit Breakers
265219	Emergency and Exit Lighting

DIVISION 27 – COMMUNICATIONS

Not Used

DIVISION 28 – ELECTRONIC SAFETY AND SECURITY

283100	Fire Detection and Alarm
--------	--------------------------

DIVISION 31 – EARTHWORK

312000	Earth Moving
312513	Erosion and Sediment Control

DIVISION 32 – EXTERIOR IMPROVEMENTS

Not Used

DIVISION 33 – UTILITIES

334100	Storm Drainage Piping
334900	Storm Drainage Structures

DIVISION 34 – TRANSPORTATION

Not Used

END OF SECTION 000110



AIA® Document A310™ – 2010

Bid Bond

CONTRACTOR:

(Name, legal status and address)

SURETY:

(Name, legal status and principal place of business)

OWNER:

(Name, legal status and address)

City School District of the City of New Rochelle
515 North Street
New Rochelle, New York 10801

BOND AMOUNT: \$**PROJECT:**

(Name, location or address, and Project number, if any)

City School District of the City of New Rochelle – Transfer to Capital – Storm Mitigation

Isaac Young Middle School – Drainage, Café, Band Rooms, Stair Landings –
Reconstruction Project
270 Central Avenue
New Rochelle, New York 10805
SED#66-11-00-01-0-013-017

CSArch Project #188-2203

The Contractor and Surety are bound to the Owner in the amount set forth above, for the payment of which the Contractor and Surety bind themselves, their heirs, executors, administrators, successors and assigns, jointly and severally, as provided herein. The conditions of this Bond are such that if the Owner accepts the bid of the Contractor within the time specified in the bid documents, or within such time period as may be agreed to by the Owner and Contractor, and the Contractor either (1) enters into a contract with the Owner in accordance with the terms of such bid, and gives such bond or bonds as may be specified in the bidding or Contract Documents, with a surety admitted in the jurisdiction of the Project and otherwise acceptable to the Owner, for the faithful performance of such Contract and for the prompt payment of labor and material furnished in the prosecution thereof; or (2) pays to the Owner the difference, not to exceed the amount of this Bond, between the amount specified in said bid and such larger amount for which the Owner may in good faith contract with another party to perform the work covered by said bid, then this obligation shall be null and void, otherwise to remain in full force and effect. The Surety hereby waives any notice of an agreement between the Owner and Contractor to extend the time in which the Owner may accept the bid. Waiver of notice by the Surety shall not apply to any extension exceeding sixty (60) days in the aggregate beyond the time for acceptance of bids specified in the bid documents, and the Owner and Contractor shall obtain the Surety's consent for an extension beyond sixty (60) days.

If this Bond is issued in connection with a subcontractor's bid to a Contractor, the term Contractor in this Bond shall be deemed to be Subcontractor and the term Owner shall be deemed to be Contractor.

ADDITIONS AND DELETIONS:

The author of this document has added information needed for its completion. The author may also have revised the text of the original AIA standard form. An *Additions and Deletions Report* that notes added information as well as revisions to the standard form text is available from the author and should be reviewed. A vertical line in the left margin of this document indicates where the author has added necessary information and where the author has added to or deleted from the original AIA text.

This document has important legal consequences. Consultation with an attorney is encouraged with respect to its completion or modification.

Any singular reference to Contractor, Surety, Owner or other party shall be considered plural where applicable.

When this Bond has been furnished to comply with a statutory or other legal requirement in the location of the Project, any provision in this Bond conflicting with said statutory or legal requirement shall be deemed deleted herefrom and provisions conforming to such statutory or other legal requirement shall be deemed incorporated herein. When so furnished, the intent is that this Bond shall be construed as a statutory bond and not as a common law bond.

Signed and sealed this day of ,

(Witness)

(Witness)

(Principal)

(Seal)

(Title)

(Surety)

(Seal)

(Title)



AIA[®] Document A305[™] – 2020

Contractor's Qualification Statement

(Paragraph deleted)

SUBMITTED BY:

(Organization name and address.)

SUBMITTED TO:

(Organization name and address.)

NAME OF PROJECT:

City School District of the City of New Rochelle – Transfer to Capital – Storm Mitigation

Isaac Young Middle School – Drainage, Café, Band Rooms, Stair Landings –
Reconstruction Project
270 Central Avenue
New Rochelle, New York 10805
SED#66-11-00-01-0-013-017

CSArch Project #188-2203

TYPE OF WORK TYPICALLY PERFORMED

(Indicate the type of work your organization typically performs, such as general contracting, construction manager as constructor services, HVAC contracting, electrical contracting, plumbing contracting, or other.)

THIS CONTRACTOR'S QUALIFICATION STATEMENT INCLUDES THE FOLLOWING:

(Check all that apply.)

- ☐ Exhibit A – General Information
- ☐ Exhibit B – Financial and Performance Information
- ☐ Exhibit C – Project-Specific Information
- ☐ Exhibit D – Past Project Experience
- ☐ Exhibit E – Past Project Experience (Continued)

CONTRACTOR CERTIFICATION

The undersigned certifies under oath that the information provided in this Contractor's Qualification Statement is true and sufficiently complete so as not to be misleading.

Organization's Authorized Representative
Signature

Date

Printed Name and Title

NOTARY

State of:

County of:

Signed and sworn to before me this day of


Notary Signature

AIA Document A305[™] – 2020. Copyright © 1964, 1969, 1979, 1986, and 2020 by The American Institute of Architects. All rights reserved. The "American Institute of Architects," "AIA," the AIA Logo, and "AIA Contract Documents" are registered trademarks and may not be used without permission. This document was produced by AIA software at 07:57:48 ET on 06/28/2022 under Order No.2114309683 which expires on 04/16/2023, is not for resale, is licensed for one-time use only, and may only be used in accordance with the AIA Contract Documents[®] Terms of Service. To report copyright violations, e-mail copyright@aia.org.

User Notes:

(2019126856)

My commission expires:

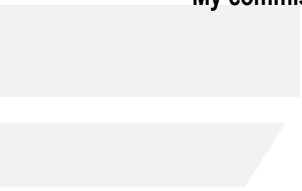



AIA[®] Document A312[™] – 2010

Payment Bond

CONTRACTOR:

(Name, legal status and address)

SURETY:

(Name, legal status and principal place of business)

OWNER:

(Name, legal status and address)

City School District of the City of New Rochelle
515 North Avenue
New Rochelle, New York 10801

CONSTRUCTION CONTRACT

Date:

Amount: \$

(Row deleted)

City School District of the City of New Rochelle – Transfer to Capital – Storm Mitigation

Isaac Young Middle School – Drainage, Café, Band Rooms, Stair Landings – Reconstruction Project
270 Central Avenue
New Rochelle, New York 10805
SED#66-11-00-01-0-013-017
CSArch Project #188-2203

BOND

Date:

(Not earlier than Construction Contract Date)

Amount: \$

Modifications to this Bond: ☐ None ☐ See Section 18

CONTRACTOR AS PRINCIPAL

Company: (Corporate Seal)

SURETY

Company: (Corporate Seal)

Signature: _____

Name and

Title:

(Any additional signatures appear on the last page of this Payment Bond.)

Signature: _____

Name and

Title:

(FOR INFORMATION ONLY — Name, address and telephone)

AGENT or BROKER:

OWNER'S REPRESENTATIVE:

(Architect, Engineer or other party:)

Collins+Scoville Architecture |

Engineering | Construction

ADDITIONS AND DELETIONS:

The author of this document has added information needed for its completion. The author may also have revised the text of the original AIA standard form. An *Additions and Deletions Report* that notes added information as well as revisions to the standard form text is available from the author and should be reviewed. A vertical line in the left margin of this document indicates where the author has added necessary information and where the author has added to or deleted from the original AIA text.

This document has important legal consequences. Consultation with an attorney is encouraged with respect to its completion or modification.

Any singular reference to Contractor, Surety, Owner or other party shall be considered plural where applicable.

Management, D.P.C.
dba CSArch
19 Front Street
Newburgh, New York 12550-7601

(Row deleted)

§ 1 The Contractor and Surety, jointly and severally, bind themselves, their heirs, executors, administrators, successors and assigns to the Owner to pay for labor, materials and equipment furnished for use in the performance of the Construction Contract, which is incorporated herein by reference, subject to the following terms.

§ 2 If the Contractor promptly makes payment of all sums due to Claimants, and defends, indemnifies and holds harmless the Owner from claims, demands, liens or suits by any person or entity seeking payment for labor, materials or equipment furnished for use in the performance of the Construction Contract, then the Surety and the Contractor shall have no obligation under this Bond.

§ 3 If there is no Owner Default under the Construction Contract, the Surety's obligation to the Owner under this Bond shall arise after the Owner has promptly notified the Contractor and the Surety (at the address described in Section 13) of claims, demands, liens or suits against the Owner or the Owner's property by any person or entity seeking payment for labor, materials or equipment furnished for use in the performance of the Construction Contract and tendered defense of such claims, demands, liens or suits to the Contractor and the Surety.

§ 4 When the Owner has satisfied the conditions in Section 3, the Surety shall promptly and at the Surety's expense defend, indemnify and hold harmless the Owner against a duly tendered claim, demand, lien or suit.

§ 5 The Surety's obligations to a Claimant under this Bond shall arise after the following:

§ 5.1 Claimants, who do not have a direct contract with the Contractor,

- .1 have furnished a written notice of non-payment to the Contractor, stating with substantial accuracy the amount claimed and the name of the party to whom the materials were, or equipment was, furnished or supplied or for whom the labor was done or performed, within ninety (90) days after having last performed labor or last furnished materials or equipment included in the Claim; and
- .2 have sent a Claim to the Surety (at the address described in Section 13).

§ 5.2 Claimants, who are employed by or have a direct contract with the Contractor, have sent a Claim to the Surety (at the address described in Section 13).

§ 6 If a notice of non-payment required by Section 5.1.1 is given by the Owner to the Contractor, that is sufficient to satisfy a Claimant's obligation to furnish a written notice of non-payment under Section 5.1.1.

§ 7 When a Claimant has satisfied the conditions of Sections 5.1 or 5.2, whichever is applicable, the Surety shall promptly and at the Surety's expense take the following actions:

§ 7.1 Send an answer to the Claimant, with a copy to the Owner, within sixty (60) days after receipt of the Claim, stating the amounts that are undisputed and the basis for challenging any amounts that are disputed; and

§ 7.2 Pay or arrange for payment of any undisputed amounts.

§ 7.3 The Surety's failure to discharge its obligations under Section 7.1 or Section 7.2 shall not be deemed to constitute a waiver of defenses the Surety or Contractor may have or acquire as to a Claim, except as to undisputed amounts for which the Surety and Claimant have reached agreement. If, however, the Surety fails to discharge its obligations under Section 7.1 or Section 7.2, the Surety shall indemnify the Claimant for the reasonable attorney's fees the Claimant incurs thereafter to recover any sums found to be due and owing to the Claimant.

§ 8 The Surety's total obligation shall not exceed the amount of this Bond, plus the amount of reasonable attorney's fees provided under Section 7.3, and the amount of this Bond shall be credited for any payments made in good faith by the Surety.

§ 9 Amounts owed by the Owner to the Contractor under the Construction Contract shall be used for the performance of the Construction Contract and to satisfy claims, if any, under any construction performance bond. By the Contractor furnishing and the Owner accepting this Bond, they agree that all funds earned by the Contractor in the performance of the Construction Contract are dedicated to satisfy obligations of the Contractor and Surety under this Bond, subject to the Owner's priority to use the funds for the completion of the work.

§ 10 The Surety shall not be liable to the Owner, Claimants or others for obligations of the Contractor that are unrelated to the Construction Contract. The Owner shall not be liable for the payment of any costs or expenses of any Claimant under this Bond, and shall have under this Bond no obligation to make payments to, or give notice on behalf of, Claimants or otherwise have any obligations to Claimants under this Bond.

§ 11 The Surety hereby waives notice of any change, including changes of time, to the Construction Contract or to related subcontracts, purchase orders and other obligations.

§ 12 No suit or action shall be commenced by a Claimant under this Bond other than in a court of competent jurisdiction in the state in which the project that is the subject of the Construction Contract is located or after the expiration of one year from the date (1) on which the Claimant sent a Claim to the Surety pursuant to Section 5.1.2 or 5.2, or (2) on which the last labor or service was performed by anyone or the last materials or equipment were furnished by anyone under the Construction Contract, whichever of (1) or (2) first occurs. If the provisions of this Paragraph are void or prohibited by law, the minimum period of limitation available to sureties as a defense in the jurisdiction of the suit shall be applicable.

§ 13 Notice and Claims to the Surety, the Owner or the Contractor shall be mailed or delivered to the address shown on the page on which their signature appears. Actual receipt of notice or Claims, however accomplished, shall be sufficient compliance as of the date received.

§ 14 When this Bond has been furnished to comply with a statutory or other legal requirement in the location where the construction was to be performed, any provision in this Bond conflicting with said statutory or legal requirement shall be deemed deleted herefrom and provisions conforming to such statutory or other legal requirement shall be deemed incorporated herein. When so furnished, the intent is that this Bond shall be construed as a statutory bond and not as a common law bond.

§ 15 Upon request by any person or entity appearing to be a potential beneficiary of this Bond, the Contractor and Owner shall promptly furnish a copy of this Bond or shall permit a copy to be made.

§ 16 Definitions

§ 16.1 Claim. A written statement by the Claimant including at a minimum:

- .1 the name of the Claimant;
- .2 the name of the person for whom the labor was done, or materials or equipment furnished;
- .3 a copy of the agreement or purchase order pursuant to which labor, materials or equipment was furnished for use in the performance of the Construction Contract;
- .4 a brief description of the labor, materials or equipment furnished;
- .5 the date on which the Claimant last performed labor or last furnished materials or equipment for use in the performance of the Construction Contract;
- .6 the total amount earned by the Claimant for labor, materials or equipment furnished as of the date of the Claim;
- .7 the total amount of previous payments received by the Claimant; and
- .8 the total amount due and unpaid to the Claimant for labor, materials or equipment furnished as of the date of the Claim.

§ 16.2 Claimant. An individual or entity having a direct contract with the Contractor or with a subcontractor of the Contractor to furnish labor, materials or equipment for use in the performance of the Construction Contract. The term Claimant also includes any individual or entity that has rightfully asserted a claim under an applicable mechanic's lien or similar statute against the real property upon which the Project is located. The intent of this Bond shall be to include without limitation in the terms "labor, materials or equipment" that part of water, gas, power, light, heat, oil, gasoline, telephone service or rental equipment used in the Construction Contract, architectural and engineering services

required for performance of the work of the Contractor and the Contractor's subcontractors, and all other items for which a mechanic's lien may be asserted in the jurisdiction where the labor, materials or equipment were furnished.

§ 16.3 Construction Contract. The agreement between the Owner and Contractor identified on the cover page, including all Contract Documents and all changes made to the agreement and the Contract Documents.

§ 16.4 Owner Default. Failure of the Owner, which has not been remedied or waived, to pay the Contractor as required under the Construction Contract or to perform and complete or comply with the other material terms of the Construction Contract.

§ 16.5 Contract Documents. All the documents that comprise the agreement between the Owner and Contractor.

§ 17 If this Bond is issued for an agreement between a Contractor and subcontractor, the term Contractor in this Bond shall be deemed to be Subcontractor and the term Owner shall be deemed to be Contractor.

§ 18 Modifications to this bond are as follows:

(Space is provided below for additional signatures of added parties, other than those appearing on the cover page.)

CONTRACTOR AS PRINCIPAL

Company: _____ (Corporate Seal)

Signature: _____

Name and Title: _____

Address: _____

SURETY

Company: _____ (Corporate Seal)

Signature: _____

Name and Title: _____

Address: _____



AIA[®] Document A312™ – 2010

Performance Bond

CONTRACTOR:

(Name, legal status and address)

SURETY:

(Name, legal status and principal place of business)

OWNER:

(Name, legal status and address)

City School District of the City of New Rochelle
515 North Avenue
New Rochelle, New York 10801

CONSTRUCTION CONTRACT

Date:

Amount: \$

Description:

(Name and location)

City School District of the City of New Rochelle – Transfer to Capital – Storm Mitigation

Isaac Young Middle School – Drainage, Café, Band Rooms, Stair Landings – Reconstruction Project
270 Central Avenue
New Rochelle, New York 10805
SED#66-11-00-01-0-013-017
CSArch Project #188-2203

BOND

Date:

(Not earlier than Construction Contract Date)

Amount: \$

Modifications to this Bond: ☐ None ☐ See Section 16

CONTRACTOR AS PRINCIPAL

Company: (Corporate Seal)

SURETY

Company: (Corporate Seal)

Signature: _____

Name and

Title:

(Any additional signatures appear on the last page of this Performance Bond.)

Signature: _____

Name and

Title:

(FOR INFORMATION ONLY — Name, address and telephone)

AGENT or BROKER:
OWNER'S REPRESENTATIVE:

(Architect, Engineer or other party:)

Collins+Scoville Architecture |

Engineering | Construction

Management, D.P.C.

ADDITIONS AND DELETIONS:

The author of this document has added information needed for its completion. The author may also have revised the text of the original AIA standard form. An *Additions and Deletions Report* that notes added information as well as revisions to the standard form text is available from the author and should be reviewed. A vertical line in the left margin of this document indicates where the author has added necessary information and where the author has added to or deleted from the original AIA text.

This document has important legal consequences. Consultation with an attorney is encouraged with respect to its completion or modification.

Any singular reference to Contractor, Surety, Owner or other party shall be considered plural where applicable.

Init.

AIA Document A312™ – 2010 Performance Bond. The American Institute of Architects. All rights reserved. The "American Institute of Architects," "AIA," the AIA Logo, and "AIA Contract Documents" are registered trademarks and may not be used without permission. This document was produced by AIA software at 07:57:21 ET on 06/28/2022 under Order No.2114309683 which expires on 04/16/2023, is not for resale, is licensed for one-time use only, and may only be used in accordance with the AIA Contract Documents® Terms of Service. To report copyright violations, e-mail copyright@aia.org.

User Notes:

(1349662312)

dba CSArch
19 Front Street
Newburgh, New York 12550-7601

(Row deleted)

§ 1 The Contractor and Surety, jointly and severally, bind themselves, their heirs, executors, administrators, successors and assigns to the Owner for the performance of the Construction Contract, which is incorporated herein by reference.

§ 2 If the Contractor performs the Construction Contract, the Surety and the Contractor shall have no obligation under this Bond, except when applicable to participate in a conference as provided in Section 3.

§ 3 If there is no Owner Default under the Construction Contract, the Surety's obligation under this Bond shall arise after

- .1 the Owner first provides notice to the Contractor and the Surety that the Owner is considering declaring a Contractor Default. Such notice shall indicate whether the Owner is requesting a conference among the Owner, Contractor and Surety to discuss the Contractor's performance. If the Owner does not request a conference, the Surety may, within five (5) business days after receipt of the Owner's notice, request such a conference. If the Surety timely requests a conference, the Owner shall attend. Unless the Owner agrees otherwise, any conference requested under this Section 3.1 shall be held within ten (10) business days of the Surety's receipt of the Owner's notice. If the Owner, the Contractor and the Surety agree, the Contractor shall be allowed a reasonable time to perform the Construction Contract, but such an agreement shall not waive the Owner's right, if any, subsequently to declare a Contractor Default;
- .2 the Owner declares a Contractor Default, terminates the Construction Contract and notifies the Surety; and
- .3 the Owner has agreed to pay the Balance of the Contract Price in accordance with the terms of the Construction Contract to the Surety or to a contractor selected to perform the Construction Contract.

§ 4 Failure on the part of the Owner to comply with the notice requirement in Section 3.1 shall not constitute a failure to comply with a condition precedent to the Surety's obligations, or release the Surety from its obligations, except to the extent the Surety demonstrates actual prejudice.

§ 5 When the Owner has satisfied the conditions of Section 3, the Surety shall promptly and at the Surety's expense take one of the following actions:

§ 5.1 Arrange for the Contractor, with the consent of the Owner, to perform and complete the Construction Contract;

§ 5.2 Undertake to perform and complete the Construction Contract itself, through its agents or independent contractors;

§ 5.3 Obtain bids or negotiated proposals from qualified contractors acceptable to the Owner for a contract for performance and completion of the Construction Contract, arrange for a contract to be prepared for execution by the Owner and a contractor selected with the Owner's concurrence, to be secured with performance and payment bonds executed by a qualified surety equivalent to the bonds issued on the Construction Contract, and pay to the Owner the amount of damages as described in Section 7 in excess of the Balance of the Contract Price incurred by the Owner as a result of the Contractor Default; or

§ 5.4 Waive its right to perform and complete, arrange for completion, or obtain a new contractor and with reasonable promptness under the circumstances:

- .1 After investigation, determine the amount for which it may be liable to the Owner and, as soon as practicable after the amount is determined, make payment to the Owner; or
- .2 Deny liability in whole or in part and notify the Owner, citing the reasons for denial.

§ 6 If the Surety does not proceed as provided in Section 5 with reasonable promptness, the Surety shall be deemed to be in default on this Bond seven days after receipt of an additional written notice from the Owner to the Surety demanding that the Surety perform its obligations under this Bond, and the Owner shall be entitled to enforce any

remedy available to the Owner. If the Surety proceeds as provided in Section 5.4, and the Owner refuses the payment or the Surety has denied liability, in whole or in part, without further notice the Owner shall be entitled to enforce any remedy available to the Owner.

§ 7 If the Surety elects to act under Section 5.1, 5.2 or 5.3, then the responsibilities of the Surety to the Owner shall not be greater than those of the Contractor under the Construction Contract, and the responsibilities of the Owner to the Surety shall not be greater than those of the Owner under the Construction Contract. Subject to the commitment by the Owner to pay the Balance of the Contract Price, the Surety is obligated, without duplication, for

- .1 the responsibilities of the Contractor for correction of defective work and completion of the Construction Contract;
- .2 additional legal, design professional and delay costs resulting from the Contractor's Default, and resulting from the actions or failure to act of the Surety under Section 5; and
- .3 liquidated damages, or if no liquidated damages are specified in the Construction Contract, actual damages caused by delayed performance or non-performance of the Contractor.

§ 8 If the Surety elects to act under Section 5.1, 5.3 or 5.4, the Surety's liability is limited to the amount of this Bond.

§ 9 The Surety shall not be liable to the Owner or others for obligations of the Contractor that are unrelated to the Construction Contract, and the Balance of the Contract Price shall not be reduced or set off on account of any such unrelated obligations. No right of action shall accrue on this Bond to any person or entity other than the Owner or its heirs, executors, administrators, successors and assigns.

§ 10 The Surety hereby waives notice of any change, including changes of time, to the Construction Contract or to related subcontracts, purchase orders and other obligations.

§ 11 Any proceeding, legal or equitable, under this Bond may be instituted in any court of competent jurisdiction in the location in which the work or part of the work is located and shall be instituted within two years after a declaration of Contractor Default or within two years after the Contractor ceased working or within two years after the Surety refuses or fails to perform its obligations under this Bond, whichever occurs first. If the provisions of this Paragraph are void or prohibited by law, the minimum period of limitation available to sureties as a defense in the jurisdiction of the suit shall be applicable.

§ 12 Notice to the Surety, the Owner or the Contractor shall be mailed or delivered to the address shown on the page on which their signature appears.

§ 13 When this Bond has been furnished to comply with a statutory or other legal requirement in the location where the construction was to be performed, any provision in this Bond conflicting with said statutory or legal requirement shall be deemed deleted herefrom and provisions conforming to such statutory or other legal requirement shall be deemed incorporated herein. When so furnished, the intent is that this Bond shall be construed as a statutory bond and not as a common law bond.

§ 14 Definitions

§ 14.1 **Balance of the Contract Price.** The total amount payable by the Owner to the Contractor under the Construction Contract after all proper adjustments have been made, including allowance to the Contractor of any amounts received or to be received by the Owner in settlement of insurance or other claims for damages to which the Contractor is entitled, reduced by all valid and proper payments made to or on behalf of the Contractor under the Construction Contract.

§ 14.2 **Construction Contract.** The agreement between the Owner and Contractor identified on the cover page, including all Contract Documents and changes made to the agreement and the Contract Documents.

§ 14.3 **Contractor Default.** Failure of the Contractor, which has not been remedied or waived, to perform or otherwise to comply with a material term of the Construction Contract.

§ 14.4 **Owner Default.** Failure of the Owner, which has not been remedied or waived, to pay the Contractor as required under the Construction Contract or to perform and complete or comply with the other material terms of the Construction Contract.

§ 14.5 **Contract Documents.** All the documents that comprise the agreement between the Owner and Contractor.

§ 15 If this Bond is issued for an agreement between a Contractor and subcontractor, the term Contractor in this Bond shall be deemed to be Subcontractor and the term Owner shall be deemed to be Contractor.

§ 16 Modifications to this bond are as follows:

(Space is provided below for additional signatures of added parties, other than those appearing on the cover page.)

CONTRACTOR AS PRINCIPAL

Company: _____
(Corporate Seal)

Signature: _____
Name and Title: _____
Address: _____

SURETY

Company: _____
(Corporate Seal)

Signature: _____
Name and Title: _____
Address: _____



AIA[®] Document C106[™] – 2013

Digital Data Licensing Agreement

AGREEMENT made as of the _____ day of _____ in the year two-thousand twenty-two
(In words, indicate day, month and year.)

BETWEEN the Party transmitting Digital Data ("Transmitting Party"):
(Name, address and contact information, including electronic addresses)

Collins+Scoville Architecture | Engineering | Construction Management D.P.C.
dba CSArch
19 Front Street
Newburgh, New York 12550-7601

and the Party receiving the Digital Data ("Receiving Party"):
(Name, address and contact information, including electronic addresses)

for the following Project:
(Name and location or address)

City School District of the City of New Rochelle – Transfer to Capital – Storm Mitigation

Isaac Young Middle School – Drainage, Café, Band Rooms, Stair Landings –
Reconstruction Project
270 Central Avenue
New Rochelle, New York 10805
SED#66-11-00-01-013-017
CSArch Project #188-2203

The Transmitting Party and Receiving Party agree as follows.

TABLE OF ARTICLES

- 1 GENERAL PROVISIONS
- 2 TRANSMISSION OF DIGITAL DATA
- 3 LICENSE CONDITIONS
- 4 LICENSING FEE OR OTHER COMPENSATION
- 5 DIGITAL DATA

ARTICLE 1 GENERAL PROVISIONS

§ 1.1 The purpose of this Agreement is to grant a license from the Transmitting Party to the Receiving Party for the Receiving Party's use of Digital Data on the Project, and to set forth the license terms.

ADDITIONS AND DELETIONS:

The author of this document has added information needed for its completion. The author may also have revised the text of the original AIA standard form. An *Additions and Deletions Report* that notes added information as well as revisions to the standard form text is available from the author and should be reviewed. A vertical line in the left margin of this document indicates where the author has added necessary information and where the author has added to or deleted from the original AIA text.

This document has important legal consequences. Consultation with an attorney is encouraged with respect to its completion or modification.

Init.

AIA Document C106[™] – 2013. Copyright © 2007 and 2013 by The American Institute of Architects. All rights reserved. The "American Institute of Architects," "AIA," the AIA Logo, and "AIA Contract Documents" are registered trademarks and may not be used without permission. This document was produced by AIA software at 07:59:57 ET on 06/28/2022 under Order No.2114309683 which expires on 04/16/2023, is not for resale, is licensed for one-time use only, and may only be used in accordance with the AIA Contract Documents[®] Terms of Service. To report copyright violations, e-mail copyright@aia.org.

User Notes:

(1716873846)

§ 1.2 This Agreement is the entire and integrated agreement between the parties. Except as specifically set forth herein, this Agreement does not create any other contractual relationship between the parties.

§ 1.3 For purposes of this Agreement, the term Digital Data is defined to include only those items identified in Article 5 below.

§ 1.3.1 Confidential Digital Data is defined as Digital Data containing confidential or business proprietary information that the Transmitting Party designates and clearly marks as "confidential."

ARTICLE 2 TRANSMISSION OF DIGITAL DATA

§ 2.1 The Transmitting Party grants to the Receiving Party a nonexclusive limited license to use the Digital Data identified in Article 5 solely and exclusively to perform services for, or construction of, the Project in accordance with the terms and conditions set forth in this Agreement.

§ 2.2 The transmission of Digital Data constitutes a warranty by the Transmitting Party to the Receiving Party that the Transmitting Party is the copyright owner of the Digital Data, or otherwise has permission to transmit the Digital Data to the Receiving Party for its use on the Project in accordance with the terms and conditions of this Agreement.

§ 2.3 If the Transmitting Party transmits Confidential Digital Data, the transmission of such Confidential Digital Data constitutes a warranty to the Receiving Party that the Transmitting Party is authorized to transmit the Confidential Digital Data. If the Receiving Party receives Confidential Digital Data, the Receiving Party shall keep the Confidential Digital Data strictly confidential and shall not disclose it to any other person or entity except as set forth in Section 2.3.1.

§ 2.3.1 The Receiving Party may disclose the Confidential Digital Data as required by law or court order, including a subpoena or other form of compulsory legal process issued by a court or governmental entity. The Receiving Party may also disclose the Confidential Digital Data to its employees, consultants or contractors in order to perform services or work solely and exclusively for the Project, provided those employees, consultants and contractors are subject to the restrictions on the disclosure and use of Confidential Digital Data as set forth in this Agreement.

§ 2.4 The Transmitting Party retains its rights in the Digital Data. By transmitting the Digital Data, the Transmitting Party does not grant to the Receiving Party an assignment of those rights; nor does the Transmitting Party convey to the Receiving Party any right in the software used to generate the Digital Data.

§ 2.5 To the fullest extent permitted by law, the Receiving Party shall indemnify and defend the Transmitting Party from and against all claims arising from or related to the Receiving Party's modification to, or unlicensed use of, the Digital Data.

ARTICLE 3 LICENSE CONDITIONS

The parties agree to the following conditions on the limited license granted in Section 2.1:

(State below rights or restrictions applicable to the Receiving Party's use of the Digital Data, requirements for data format, transmission method or other conditions on data to be transmitted.)

Revit and/or AutoCAD files will be provided as an accommodation at your request. Due to the nature of electronic data files, the Transmittal Party does not guarantee that the information in these files is identical to the bidding documents. Bid addenda may not have been incorporated into these files. If there are any discrepancies, the bidding documents and subsequent addenda constitute the contract requirements.

The Receiving Party agrees to transmit to the Transmitting Party at the end of the term of this agreement the Revit model including any information added by the Receiving Party.

ARTICLE 4 LICENSING FEE OR OTHER COMPENSATION

The Receiving Party agrees to pay the Transmitting Party the following fee or other compensation for the Receiving Party's use of the Digital Data:

(State the fee, in dollars, or other method by which the Receiving Party will compensate the Transmitting Party for the Receiving Party's use of the Digital Data.)

N/A

ARTICLE 5 DIGITAL DATA

The Parties agree that the following items constitute the Digital Data subject to the license granted in Section 2.1:
(Identify below, in detail, the information created or stored in digital form the parties intend to be subject to this Agreement.)

Revit model
AutoCAD plans

This Agreement is entered into as of the day and year first written above and will terminate upon Substantial Completion of the Project, as that term is defined in AIA Document A201™–2007, General Conditions of the Contract for Construction, unless otherwise agreed by the parties and set forth below.
(Indicate when this Agreement will terminate, if other than the date of Substantial Completion.)

TRANSMITTING PARTY *(Signature)*

(Printed name and title)

RECEIVING PARTY *(Signature)*

(Printed name and title)

THIS PAGE INTENTIONALLY LEFT BLANK

Application and Certificate for Payment, Construction Manager as Adviser Edition

TO OWNER:

City School District of the City of
City of
New Rochelle
515 North Avenue
New Rochelle, New York
10801

PROJECT:

City School District of the City of
New Rochelle - Transfer to Capital
Storm Mitigation Isaac Young MS.

APPLICATION NO:

001

PERIOD TO:

FROM CONTRACTOR:

Jacobs Program Management Co.

CONTRACT DATE:

CONTRACT NOS:

188 / 2203 / Isaac Young SED#66-11-00-01-0-013-017

CONSTRUCTION MANAGER:

☒ OWNER: ☒ CONSTRUCTION MANAGER: ☒ ARCHITECT: ☒ CONTRACTOR: ☒ FIELD: ☐ OTHER: ☐

VIA CONSTRUCTION MANAGER:

CSArch

VIA ARCHITECT:

CONTRACTOR'S APPLICATION FOR PAYMENT
Application is made for payment, as shown below, in connection with the Contract. AIA Document G703™, Continuation Sheet, is attached.

The undersigned Contractor certifies that to the best of the Contractor's knowledge, information and belief the Work covered by this Application for Payment has been completed in accordance with the Contract Documents, that all amounts have been paid by the Contractor for Work for which previous Certificates for Payment were issued and the Contractor is entitled to payment from the Owner, and that current payment shown herein is now due.

1. ORIGINAL CONTRACT SUM

0.00

2. NET CHANGES IN THE WORK

0.00

3. CONTRACT SUM TO DATE (Line 1 ± 2)

0.00

4. TOTAL COMPLETED AND STORED TO DATE (Column G on G703)

0.00

5. RETAINAGE:

a. 0 % of Completed Work (Column D + E on G703)

0.00

b. 0 % of Stored Material (Column F on G703)

0.00

County of:

Subscribed and sworn to before me this day of

Notary Public:

My Commission expires:

Date:

CERTIFICATE FOR PAYMENT
In accordance with the Contract Documents, based on evaluations of the Work and the data comprising this application, the Construction Manager and Architect certify to the Owner that to the best of their knowledge, information and belief the Work has progressed as indicated, the quality of the Work is in accordance with the Contract Documents, and the Contractor is entitled to payment of the AMOUNT CERTIFIED.

6. CURRENT PAYMENT DUE

0.00

7. BALANCE TO FINISH, INCLUDING RETAINAGE

0.00

(Line 3 minus Line 6)

SUMMARY OF CHANGES IN THE WORK	ADDITIONS	DEDUCTIONS
Total changes approved in previous months by Owner	0.00	0.00
Total approved this month including Construction Change Directives	0.00	0.00
TOTALS	0.00	0.00
NET CHANGES IN THE WORK		0.00

THIS PAGE INTENTIONALLY LEFT BLANK

**AIA**[®]**Document G706™ – 1994****Contractor's Affidavit of Payment of Debts and Claims****PROJECT:** *(Name and address)*
City School District of the City of
New Rochelle – Transfer to Capital
– Storm Mitigation**ARCHITECT'S PROJECT NUMBER:**
188-2203OWNER: ☒
ARCHITECT: ☒
CONTRACTOR: ☒
SURETY: ☐
OTHER: ☒Isaac Young Middle School –
Drainage, Café, Band Rooms, Stair
Landings – Reconstruction Project
270 Central Avenue
New Rochelle, New York 10805
SED#66-11-00-01-0-013-017**CONTRACT FOR:**
CONTRACT DATED:**TO OWNER:** *(Name and address)*
City School District of the City of
New Rochelle
515 North Avenue
New Rochelle, New York 10801**STATE OF:** New York
COUNTY OF:

The undersigned hereby certifies that, except as listed below, payment has been made in full and all obligations have otherwise been satisfied for all materials and equipment furnished, for all work, labor, and services performed, and for all known indebtedness and claims against the Contractor for damages arising in any manner in connection with the performance of the Contract referenced above for which the Owner or Owner's property might in any way be held responsible or encumbered.

EXCEPTIONS:**SUPPORTING DOCUMENTS ATTACHED HERETO:**

1. Consent of Surety to Final Payment. Whenever Surety is involved, Consent of Surety is required. AIA Document G707, Consent of Surety, may be used for this purpose

Indicate Attachment ☐ Yes ☒ No**CONTRACTOR:** *(Name and address)***BY:***(Signature of authorized representative)**(Printed name and title)*

The following supporting documents should be attached hereto if required by the Owner:

1. Contractor's Release or Waiver of Liens, conditional upon receipt of final payment.
2. Separate Releases or Waivers of Liens from Subcontractors and material and equipment suppliers, to the extent required by the Owner, accompanied by a list thereof.
3. Contractor's Affidavit of Release of Liens (AIA Document G706A).

Subscribed and sworn to before me on this date:

Notary Public:
My Commission Expires:

THIS PAGE INTENTIONALLY LEFT BLANK



AIA[®] Document G706A[™] – 1994

Contractor's Affidavit of Release of Liens

PROJECT: *(Name and address)*

City School District of the City of New
Rochelle – Transfer to Capital – Storm
Mitigation

ARCHITECT'S PROJECT NUMBER:

188-2203

OWNER: ☒

ARCHITECT: ☒

CONTRACTOR: ☒

SURETY: ☐

OTHER: ☒

Isaac Young Middle School –
Drainage, Café, Band Rooms, Stair
Landings – Reconstruction Project
270 Central Avenue
New Rochelle, New York 10805
SED#66-11-00-01-0-013-017

CONTRACT FOR:

CONTRACT DATED:

TO OWNER: *(Name and address)*

City School District of the City of New
Rochelle
515 North Avenue
New Rochelle, New York 10801

STATE OF: New York

COUNTY OF:

The undersigned hereby certifies that to the best of the undersigned's knowledge, information and belief, except as listed below, the Releases or Waivers of Lien attached hereto include the Contractor, all Subcontractors, all suppliers of materials and equipment, and all performers of Work, labor or services who have or may have liens or encumbrances or the right to assert liens or encumbrances against any property of the Owner arising in any manner out of the performance of the Contract referenced above.

EXCEPTIONS:

SUPPORTING DOCUMENTS ATTACHED HERETO:

1. Contractor's Release or Waiver of Liens, conditional upon receipt of final payment.
2. Separate Releases or Waivers of Liens from Subcontractors and material and equipment suppliers, to the extent required by the Owner, accompanied by a list thereof.

CONTRACTOR: *(Name and address)*

BY:

*(Signature of authorized
representative)*

(Printed name and title)

Subscribed and sworn to before me on this date:

Notary Public:

My Commission Expires:

THIS PAGE INTENTIONALLY LEFT BLANK



AIA[®] Document G707™ – 1994

Consent Of Surety to Final Payment

PROJECT: *(Name and address)*

City School District of the City of New
Rochelle – Transfer to Capital – Storm
Mitigation

Isaac Young Middle School – Drainage,
Café, Band Rooms, Stair Landings –
Reconstruction Project
270 Central Avenue
New Rochelle, New York 10805
SED#66-11-00-01-0-013-017

ARCHITECT'S PROJECT NUMBER: 188-2203

OWNER: ☒

ARCHITECT: ☒

CONTRACTOR: ☒

SURETY: ☐

OTHER: ☒

CONTRACT FOR:

CONTRACT DATED:

TO OWNER: *(Name and address)*

City School District of the City of New
Rochelle
515 North Avenue
New Rochelle, New York 10801

In accordance with the provisions of the Contract between the Owner and the Contractor as indicated above, the
(Insert name and address of Surety)

on bond of
(Insert name and address of Contractor)

, SURETY,

hereby approves of the final payment to the Contractor, and agrees that final payment to the Contractor shall not relieve the Surety of any of
its obligations to
(Insert name and address of Owner)

, CONTRACTOR,

as set forth in said Surety's bond.

, OWNER,

IN WITNESS WHEREOF, the Surety has hereunto set its hand on this date:
(Insert in writing the month followed by the numeric date and year.)

(Surety)

(Signature of authorized representative)

Attest:

(Seal):

(Printed name and title)

THIS PAGE INTENTIONALLY LEFT BLANK

CITY SD OF THE CITY OF NEW ROCHELLE

ISAAC E YOUNG MIDDLE SCHOOL

EMERGENCY STORM PROJECT

ISAAC E. YOUNG MIDDLE SCHOOL - 270 CENTRE AVE. NEW ROCHELLE, NY 10805

ISSUED FOR BID:06-17-2022


BID ADDENDUM 1: 06/28/22



CSARCH - ARCHITECTS
PASSERO ASSOCIATES - CIVIL ENGINEER
GREENMAN - PEDERSEN, INC. - STRUCTURAL ENGINEER
BLAKE ENGINEERING - MEP ENGINEERS

STATE EDUCATION DEPARTMENT PROJECT CONTROL NUMBER:
ISSAC E YOUNG MIDDLE SCHOOL 66-11-00-01-0-003-017
THE DESIGN OF THIS PROJECT CONFORMS TO APPLICABLE PROVISIONS OF THE NEW YORK STATE UNIFORM FIRE PREVENTION AND BUILDING CODE, THE NEW YORK STATE ENERGY CONSERVATION CONSTRUCTION CODE, AND THE MANUAL OF PLANNING STANDARDS OF THE NEW YORK STATE EDUCATION DEPARTMENT.


CSArch PROJECT NO. 188-2203.00

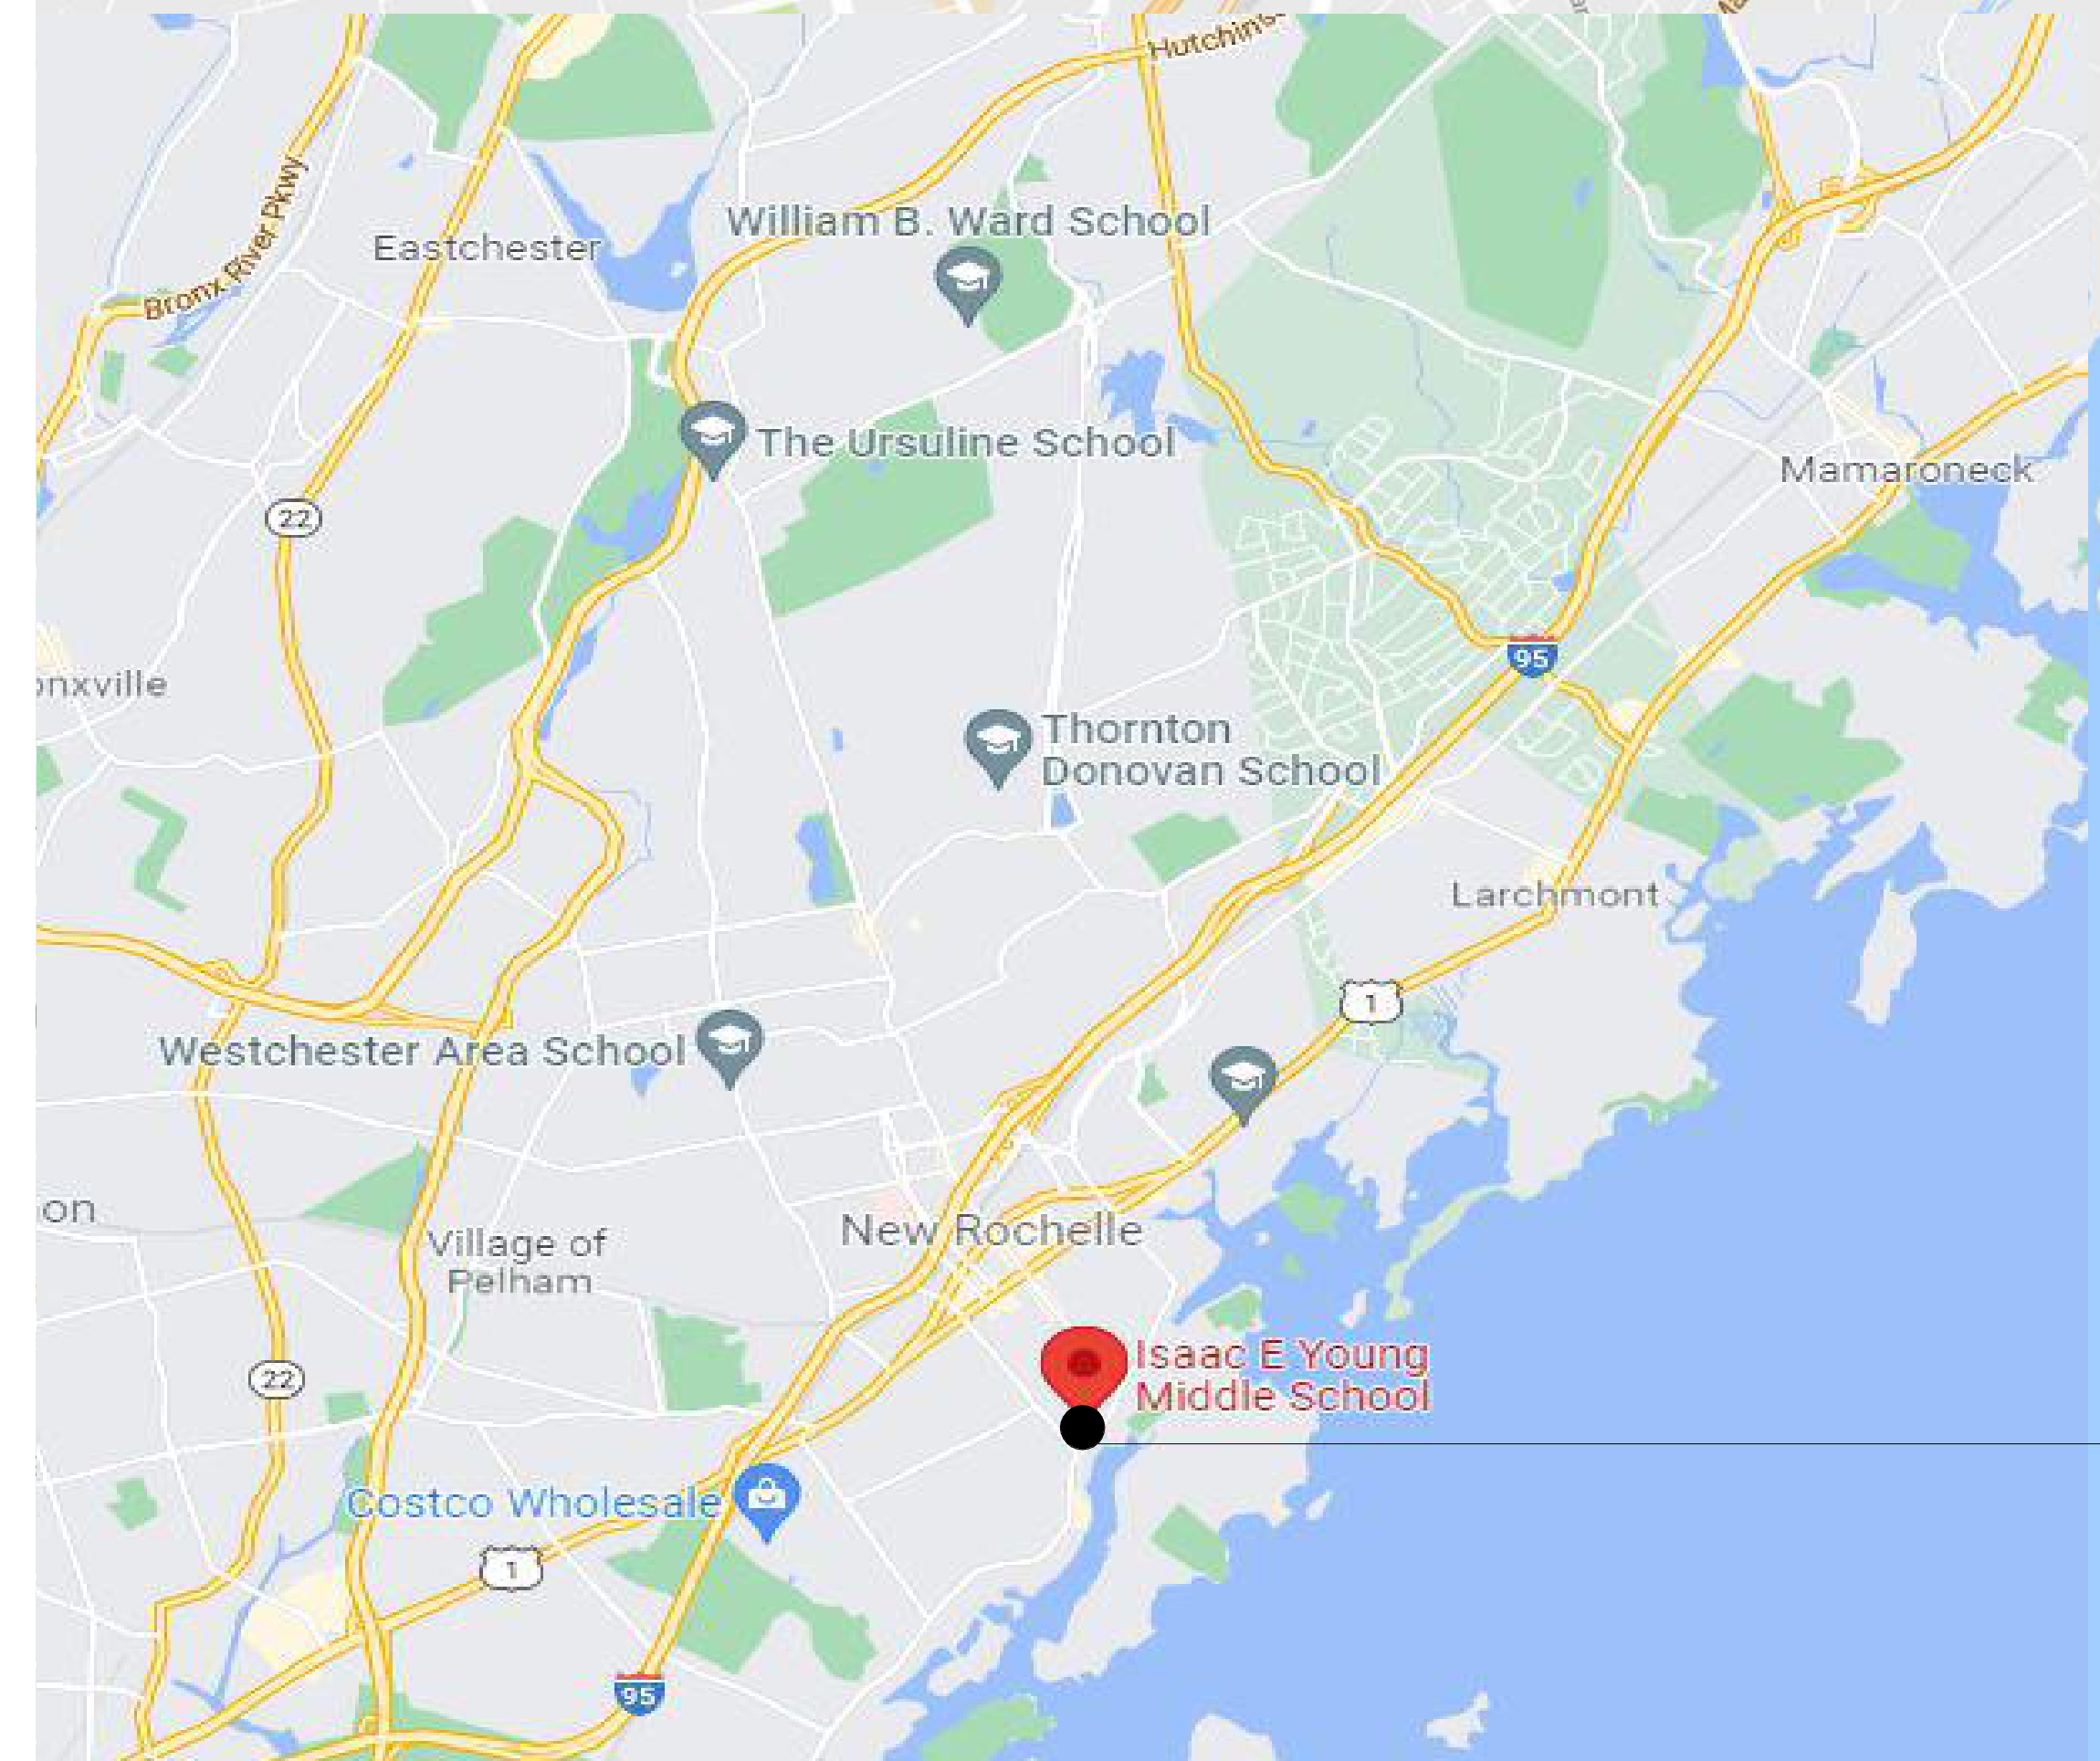

ISAAC E. YOUNG MIDDLE SCHOOL


VICINITY MAP

NTS

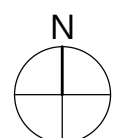


DRAWING LIST

GENERAL DRAWINGS	
G001	SYMBOLS, ABBREVIATIONS, AND MISC.
G100	OVERALL GROUND FLOOR PLAN
CIVIL DRAWINGS	
CT30	DEMOLITION & SITE PLAN
ARCHITECTURAL DEMOLITION DRAWINGS	
AD105	AREA 'B' - PARTIAL GROUND FLOOR DEMO PLAN
AD106	AREA 'C' - PARTIAL GROUND FLOOR DEMO PLAN
AD605	ENLARGED DEMOLITION PLANS
STRUCTURAL GENERAL DRAWINGS	
S001	GENERAL NOTES, LEGENDS & ABBREVIATIONS
S002	SPECIAL INSPECTIONS
STRUCTURAL DEMOLITION DRAWINGS	
SD101	AREA 'B' PARTIAL GROUND FLOOR DEMO PLAN
SD102	AREA 'C' PARTIAL GROUND FLOOR DEMO PLAN
STRUCTURAL DRAWINGS	
S101	AREA 'B' PARTIAL SLAB PLAN
S102	AREA 'C' PARTIAL GROUND FLOOR PLAN
S501	DETAILS & SECTIONS
S701	TYPICAL DETAILS
ARCHITECTURAL DRAWINGS	
A105	AREA 'B' - PARTIAL GROUND FLOOR PLAN
A106	AREA 'C' - PARTIAL GROUND FLOOR PLAN
A605	ENLARGED PLANS, SECTIONS AND DETAILS
A900	DOOR SCHEDULE, ELEVATIONS, AND DETAILS
ARCHITECTURAL FINISH DRAWINGS	
AF001	MATERIAL AND FINISH SCHEDULES
AF111	GROUND FLOOR FINISH PLANS
PLUMBING GENERAL DRAWINGS	
PG001	PLUMBING NOTES, SCHEDULE, LEGEND & DETAILS
PLUMBING DEMOLITION DRAWINGS	
PD102	AREA C GROUND FLOOR PLUMBING DEMO PLAN
PLUMBING DRAWINGS	
P101	WEIGHT & BAND ROOM PLUMBING PLAN
P102	AREA C GROUND FLOOR PLUMBING PLAN
ELECTRICAL GENERAL DRAWINGS	
EG001	ELECTRICAL NOTES, LEGEND AND SCHEDULES
ELECTRICAL DRAWINGS	
E101	WEIGHT & BAND ROOM ELECTRICAL PLAN
E103A	GROUND FLOOR PLAN - AREA 'C'

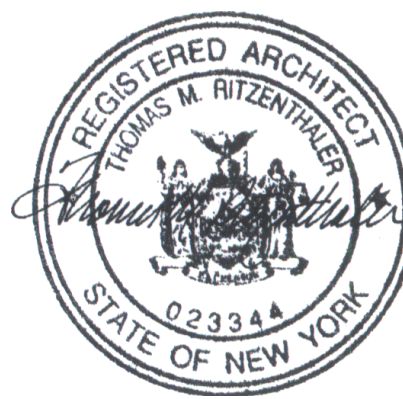

C:\Users\public\Documents\188-2203.00 IEYMS_Arch_01.dwg

1 AREA 'C' GROUND DEMOLITION PLAN
AD106 3/32" = 1'-0"

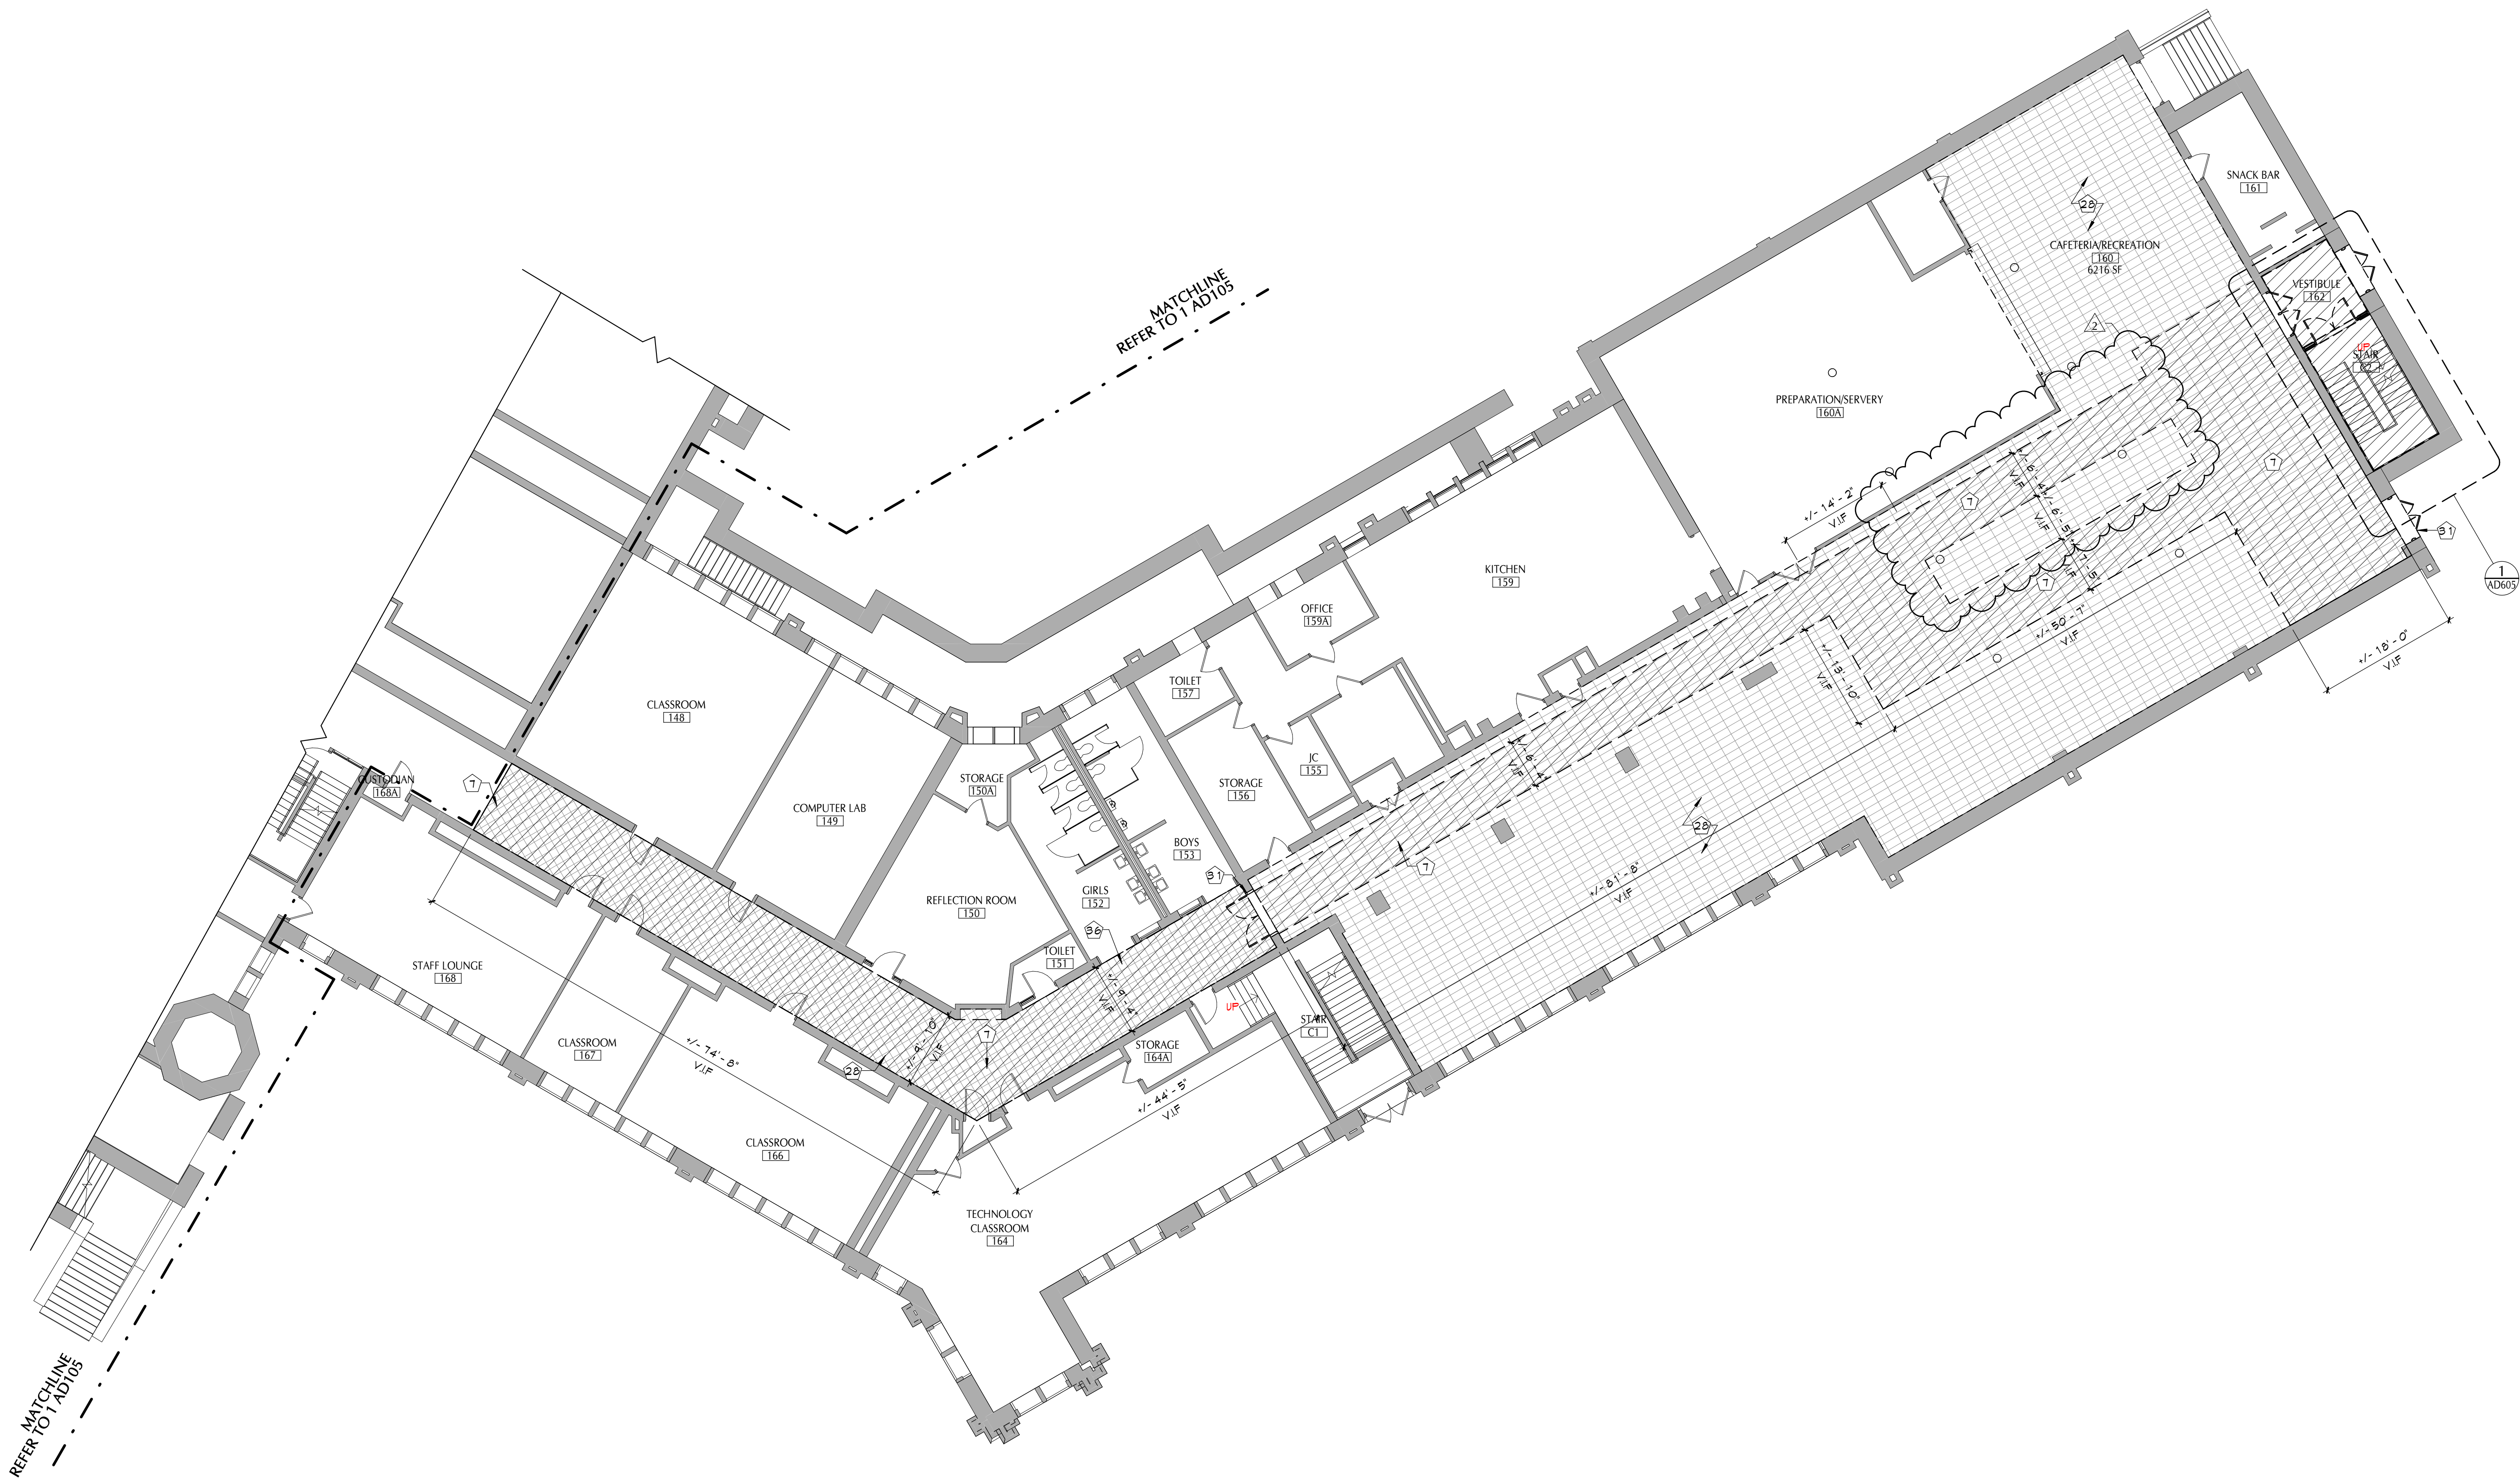


GENERAL NOTES

- COORDINATE ALL REMOVALS WITH NEW CONSTRUCTION. PATCH AND REPLACE EXISTING AND NEWLY CREATED HOLES IN WALLS (DUE TO REMOVAL) WITH MATERIALS TO MATCH EXISTING CONSTRUCTION.
- SALVAGED ITEMS SHALL BE TURNED OVER TO OWNER, UNO.
- ALL KEYED REMOVALS SHALL INCLUDE REMOVAL OF ANY AND ALL ANCHORING SYSTEMS INCLUDING OBJECTS EMBEDDED INTO EXISTING WALLS.
- REFER TO ASBESTOS AND MEP DRAWINGS FOR ADDITIONAL REMOVAL INFORMATION.
- PROVIDE TEMPORARY SHORING AS NECESSARY AT ALL AREAS OF WALL REMOVAL AND NEW WALL PENETRATIONS.
- DRILL CORNERS OF ALL NEW SANGUT OPENINGS PRIOR TO SANGUTTING, TO PREVENT CUTTING INTO SCHEDULED CONSTRUCTION TO REMAIN.

DEMOLITION KEY NOTES

- SANGUT AND REMOVE FLOORING SYSTEM AND CONCRETE SLAB IN THEIR ENTIRETY. COORDINATE EXTENT WITH MEP DRAWINGS.
- REMOVE RESILIENT FLOOR FINISH, INCLUDING ALL ADHESIVES, TO SLAB BELOW. REMOVE RUBBER BASE.
- REMOVE AND SALVAGE EXISTING DOOR, FRAME & HARDWARE IN THEIR ENTIRETY.
- REMOVE FLOOR FINISH DOWN TO SUBSTRATE.

KEY PLAN

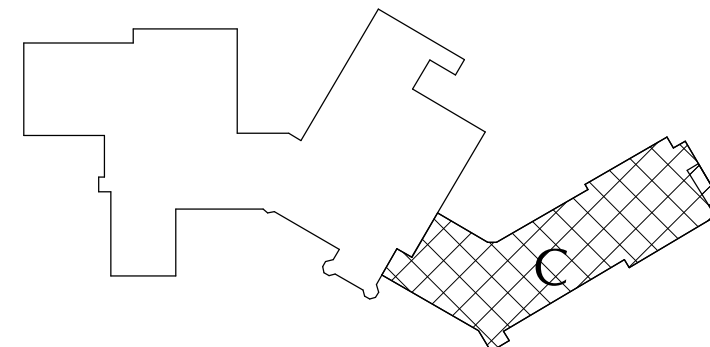

CITY SD OF THE CITY OF NEW ROCHELLE
ISAAC E YOUNG MIDDLE SCHOOL
EMERGENCY STORM PROJECT

Project Title



NO.	DATE	REV	DESCRIPTION
1	06-17-2022		ISSUED FOR BID

Drawn By: MS
Checked By: MS
Proj. #: 66-11-00-81-0-003-017
CSArch Proj. #: 188-2203.00
Issued for Bid: 06-17-2022

Sheet Title
AREA 'C' -
PARTIAL
GROUND
FLOOR DEMO
PLAN

Sheet No.
IEYMS
AD106

CONSTRUCTION DOCUMENTS

19 Front St., Newburgh, New York 12550-7601
845.561.3379 www.csarchnyc.com

CSARCH

Consultant

COPYRIGHT © ALL RIGHTS RESERVED

C:\Users\domino\Documents\2021\18-00 EYMS Reconstruction Project_C_Struct_2020_domino.dwt

GENERAL INFORMATION:

(UNLESS OTHERWISE NOTED OR SHOWN ON PLAN, THE FOLLOWING SHALL APPLY)

- ALL WORK OF THIS CONTRACT SHALL BE PERFORMED IN ACCORDANCE WITH THE 2020 BUILDING CODE OF NEW YORK STATE, LOCAL, STATE AND FEDERAL CODES REFERENCED BY THE BUILDING CODE OR HAVING JURISDICTION ON THE WORK OF THIS CONTRACT.
- "LOADS" INDICATED ON THIS DRAWING ARE THOSE FOR THE DESIGN OF THE BUILDING SUPERSTRUCTURE.
- DESIGN LOADS AND CRITERIA USED IN THE DESIGN OF SPECIALTY STRUCTURAL SYSTEMS (i.e. CURTAIN-WALL, FIRESTAIRS, ARCHITECTURAL PRECAST CONCRETE, METAL PANELS, ETC.) TO BE DETERMINED BY A THIRD PARTY ENGINEER CONTRACTED BY THE SPECIALTY STRUCTURAL SYSTEM IN ACCORDANCE WITH CODE REQUIREMENTS OF GOVERNING JURISDICTION. SPECIALTY ENGINEER IS RESPONSIBLE FOR ALL CONNECTIONS OF THESE SYSTEMS TO THE SUPERSTRUCTURE, INCLUDING, BUT NOT LIMITED TO, ENGINEERING, DETAILING, AND INSTALLATION. IF ALTERATION TO THE SUPERSTRUCTURE IS REQUIRED AS DETERMINED BY THE E.O.R. TO REINFORCE FOR HIGH CONCENTRATED FORCES APPLIED TO THE SPECIALTY SYSTEM CONNECTION, THE REINFORCEMENT AND COST SHALL BE BORNE BY THE SPECIALTY SUB-CONTRACTOR AND SHALL BE CONSIDERED A PART OF THE SPECIALTY CONNECTION.
- ALL DETAILS MARKED "TYPICAL" IN THE SET OF STRUCTURAL DRAWINGS SHALL BE APPLIED THROUGHOUT THE PROJECT AS REQUIRED TO SATISFY THE REQUIREMENTS OF THE CONSTRUCTION DOCUMENTS. THE CONTRACTOR SHALL COORDINATE REQUIREMENTS FOR QUANTITY AND LOCATION WHERE THE "TYPICAL" DETAILS APPLY.
- FAILURE ON THE PART OF THE CONTRACTOR TO REVIEW THE DRAWINGS OF OTHER DISCIPLINES (i.e. ARCHITECTURAL, MECHANICAL, ELECTRICAL, PLUMBING, ETC.) TOGETHER WITH THE FULL EXTENT OF THE PROJECT SPECIFICATIONS DOES NOT RELIEVE THEM OF THE RESPONSIBILITY TO FURNISH AND INSTALL ITEMS THAT ARE PART OF THEIR WORK AS INDICATED BY THE DRAWINGS AND SPECIFICATIONS OF OTHER TRADES. ALL STRUCTURAL TRADE CONTRACTORS AND SUB-CONTRACTORS ARE PROHIBITED FROM EXCLUDING STRUCTURAL WORK FROM THEIR CONTRACT NOT SHOWN IN THE STRUCTURAL DRAWINGS.
- CONTRACTOR SHALL COORDINATE ALL WORK WITH THE OWNER.
- THE CONTRACTOR IS RESPONSIBLE FOR PROPER FIELD FITTING AND QUANTITY OF WORK. THE CONTRACTOR SHALL TAKE FIELD MEASUREMENTS AS REQUIRED AND BE RESPONSIBLE FOR FITTING NEW CONSTRUCTION TO EXISTING CONSTRUCTION.
- THE CONTRACTOR IS RESPONSIBLE FOR A SITE INVESTIGATION(S) PRIOR TO THE START OF WORK TO REVEAL ALL EXISTING CONDITIONS.
- IT IS THE CONTRACTOR'S RESPONSIBILITY TO EXAMINE ALL DRAWINGS AND SPECIFICATIONS AND COORDINATE ALL WORK WITHIN THE CONTRACT.
- THE CONTRACTOR SHALL PROVIDE FOR THE PROPER OFF-SITE DISPOSAL OF ALL CONSTRUCTION DEBRIS AND/OR EXCAVATED MATERIALS IN COMPLIANCE WITH LOCAL, NEW YORK STATE AND FEDERAL LAWS AND REQUIREMENTS.
- THE CONTRACTOR SHALL REMOVE DEBRIS FROM WORK AREA AT THE END OF EACH WORK DAY.
- CARE SHALL BE TAKEN TO RETAIN NATURAL GROWTH AND PREVENT DAMAGE OUTSIDE THE LIMITS OF CONSTRUCTION AND NOT SCHEDULED FOR REMOVAL. ANY DAMAGE CAUSED TO THIS NATURAL GROWTH SHALL BE RESTORED AT THE EXPENSE OF THE CONTRACTOR AS ORDERED BY THE OWNER.
- THE CONTRACTOR SHALL TAKE EVERY PRECAUTION TO AVOID DAMAGING EXISTING PAVEMENTS, ROADWAYS, CURBS AND SIDEWALKS WHEN IT IS NECESSARY FOR THE CONTRACTOR TO MOVE THEIR EQUIPMENT. THE CONTRACTOR SHALL OBSERVE ALL OF THE RULES, REGULATIONS AND DIRECTIONS OF THE LOCAL MUNICIPALITIES, STATE AND FEDERAL AGENCIES RELATIVE TO SUCH HANDLING OF EQUIPMENT AND TAKE SUCH PROTECTIVE MEASURES AS MAY BE ORDERED BY THE OWNER. THE CONTRACTOR SHALL REPAIR ANY DAMAGED MATERIALS TO THE APPROVAL OF THE OWNER AT NO ADDITIONAL COST.
- THE CONTRACTOR SHALL IDENTIFY, LOCATE AND PROTECT EXISTING ELECTRICAL, FIBER, SECURITY AND TELECOMMUNICATION INFRASTRUCTURE FROM DAMAGE DURING CONSTRUCTION OPERATIONS AND ALLOW EQUIPMENT TO REMAIN OPERABLE.
- THE CONTRACTOR SHALL TAKE CARE NOT TO DISTURB EXISTING UTILITIES WITHIN THE PROJECT LIMITS. WHERE WORK AFFECTS OR IS AFFECTED BY EXISTING UTILITIES, THE WORK SHALL NOT COMMENCE PRIOR TO CONTACTING THE AFFECTED UTILITY COMPANY/COMPANIES IN ORDER TO COORDINATE THE WORK.
- IN THE EVENT THAT THE CONTRACTOR DAMAGES ANY EXISTING UTILITY SERVICE CAUSING AN INTERRUPTION IN SAID SERVICE, THE CONTRACTOR SHALL IMMEDIATELY COMMENCE WORK TO RESTORE SERVICE AND MAY NOT CEASE THEIR WORK OPERATION UNTIL SERVICE IS RESTORED. THE COST ASSOCIATED WITH REPAIRING AN EXISTING UTILITY SHALL BE BORNE ENTIRELY BY THE CONTRACTOR.
- IF THE OWNER NOTIFIES THE CONTRACTOR OF ANY HAZARDOUS CONSTRUCTION PRACTICES, ALL OPERATIONS IN THE AFFECTED AREA SHALL BE DISCONTINUED AND IMMEDIATE ACTIONS SHALL BE TAKEN TO CORRECT THE SITUATION TO THE SATISFACTION OF THE OWNER BEFORE WORK IS RESUMED.

FOUNDATION GENERAL NOTES:

(UNLESS OTHERWISE NOTED OR SHOWN ON PLAN, THE FOLLOWING SHALL APPLY)

- PRIOR TO PLACING FOUNDATION CONCRETE, ALL FOUNDATION EXCAVATIONS SHALL BE INSPECTED BY THE SPECIAL INSPECTOR TO EXPLORE THE EXTENT OF LOOSE, SOFT, EXPANSIVE, OR OTHERWISE UNSATISFACTORY SOIL MATERIAL AND TO VERIFY DESIGN BEARING PRESSURE. DIRECTION FOR CORRECTIVE ACTION WILL BE PROVIDED WHERE REQUIRED.
- THE CONTRACTOR SHALL BE SOLELY RESPONSIBLE FOR CONTROL OF GROUNDWATER AND SURFACE RUNOFF THROUGHOUT THE CONSTRUCTION PROCESS. INUNDATION AND LONG TERM EXPOSURE OF BEARING SURFACES WHICH RESULT IN DETERIORATION OF THE BEARING SHALL BE PREVENTED.
- FOOTING DESIGN BASED ON PRESUMPTIVE ALLOWABLE BEARING PRESSURE OF 1,500 PSF.
- FOUNDATION EXCAVATIONS SHALL BE INSPECTED BY THE OWNER'S GEOTECHNICAL ENGINEER PRIOR TO CONCRETE PLACEMENT. SOFTENED OR OTHERWISE UNSUITABLE BEARING MATERIAL SHALL BE REMOVED AND REPLACED WITH LOAD-BEARING FILL OR LEAN CONCRETE (2,000 PSI)
- EXCAVATIONS SHALL BE KEPT DRY BY PUMPING UNTIL UNDERGROUND CONSTRUCTION IS COMPLETE.
- NO BACKFILLING WILL BE PERMITTED AGAINST BASEMENT RETAINING WALLS UNTIL THE UPPER AND LOWER LEVEL SLABS ARE IN PLACE AT LEAST SEVEN DAYS.
- REFER TO DIVISION 31 OF THE PROJECT MANUAL FOR ADDITIONAL REQUIREMENTS.

STRUCTURAL STEEL GENERAL NOTES:

(UNLESS OTHERWISE NOTED OR SHOWN ON PLAN, THE FOLLOWING SHALL APPLY)

- STRUCTURAL STEEL SHALL CONFORM TO THE AISC STEEL CONSTRUCTION MANUAL 15TH EDITION.
- WELDING SHALL BE IN ACCORDANCE WITH A.W.S. D 1.1 USING E70XX ELECTRODES, UNLESS OTHERWISE NOTED. PROVIDE CONTINUOUS MINIMUM SIZED FILET WELDS PER AISC REQUIREMENTS. FILLER MATERIAL SHALL HAVE A MINIMUM YIELD STRENGTH OF 58 K.S.I.
- BURNING OF HOLES AND TORCH CUTTING AT THE SITE IS NOT PERMITTED.
- THE STRUCTURAL STEEL ERECTOR SHALL PROVIDE TEMPORARY GUYING AND BRACING AS REQUIRED, COLUMNS, ANCHOR BOLTS, BASE PLATES, ETC. HAVE BEEN DESIGNED FOR THE FINAL COMPLETE CONDITION, AND HAVE NOT BEEN INVESTIGATED FOR POTENTIAL LOADINGS ENCOUNTERED DURING STEEL ERECTION AND CONSTRUCTION. ANY INVESTIGATION OF THE COLUMNS, ANCHOR BOLTS, FRAMING, ETC. FOR ADEQUACY DURING THE STEEL ERECTION AND CONSTRUCTION PROCESS IS THE SOLE RESPONSIBILITY OF THE CONTRACTOR.
- STEEL FABRICATOR SHALL BE AN AISC CERTIFIED SHOP AND MAINTAIN DETAILED QUALITY CONTROL PROCEDURES AS REQUIRED TO SATISFY THE SPECIAL INSPECTION REQUIREMENTS OF THE LATEST BUILDING CODE HAVING JURISDICTION OR CONTRACTOR TO REIMBURSE OWNER FOR COST OF STEEL SHOP SPECIAL INSPECTIONS FOR NON-AISC CERTIFIED SHOPS.
- THE OWNER WILL HIRE AN INDEPENDENT TESTING AGENCY TO PROVIDE SPECIAL INSPECTIONS OF THE BOLTING, WELDING, AND OTHER ITEMS IN ACCORDANCE WITH THE LATEST BUILDING CODES HAVING JURISDICTION.
- AT LOCATIONS ON THE ARCHITECTURAL DRAWINGS OR OTHER TRADES WHERE A STEEL ANGLE OR PLATE IS SHOWN DIAGRAMMATICALLY AND REFERENCE IS MADE TO THE STRUCTURAL DRAWINGS FOR SIZE, PROVIDE MINIMUM THICKNESS OF 3/8" MATERIAL AND PLATE WIDTH OR ANGLE SIZE. INSTALL THE PLATE OR ANGLE TO THE EXTENT REQUIRED TO ACCOMPLISH A COMPLETE JOB.
- STEEL STAIR FRAMING BY OTHERS. DESIGN TO BE IN ACCORDANCE WITH THE 2020 BUILDING CODE OF NEW YORK STATE AND THE AISC 15TH EDITION. FABRICATION DRAWINGS SHALL BE SIGNED AND STAMPED BY A PROFESSIONAL ENGINEER REGISTERED IN NEW YORK STATE. SEE STRUCTURAL DESIGN TABLE FOR LOADING REQUIREMENTS.
- ALL GUARD AND RAILING SYSTEMS AND ASSOCIATED ATTACHMENTS SHALL BE PER THE ARCHITECT AND SHALL MEET THE REQUIREMENTS OF THE 2020 BUILDING CODE OF NEW YORK STATE.

CAST-IN-PLACE CONCRETE GENERAL NOTES:

(UNLESS OTHERWISE NOTED OR SHOWN ON PLAN, THE FOLLOWING SHALL APPLY)

- CONCRETE WORK SHALL CONFORM WITH THE REQUIREMENTS OF THE AMERICAN CONCRETE INSTITUTE ACI 318-14.
- REINFORCING FOR CONCRETE SHALL BE DEFORMED STEEL BARS IN ACCORDANCE WITH ASTM SPECIFICATION A615, GRADE 60. REBAR ANCHOR TIES TO BE ASTM SPECIFICATION A-955, GRADE 60.
- TEMPERATURE REINFORCING SHALL BE SUFFICIENTLY EMBEDDED TO DEVELOP FULL STRENGTH IN CONCRETE WALLS AND SLABS.
- PROVIDE ADEQUATE TIES FOR REINFORCEMENT IN SLABS, BEAMS, PIERS AND WALLS. REINFORCEMENT TO BE HELD AT CORRECT DISTANCE FROM FORMS AND EARTH BY STEEL CHAIRS OR TIES.
- FOLLOW C.R.S.I. RULES FOR PLACING OF REINFORCING STEEL AND ACCESSORIES.
- THIS CONTRACTOR SHALL COOPERATE WITH OTHER TRADES AND WHERE REQUIRED INSTALL ALL BUILT-IN WORK, SLEEVES, INSERTS, ETC., AS REQUIRED FOR A COMPLETE JOB.
- STRUCTURAL MEMBERS SHALL BE POURED FOR THEIR FULL DEPTHS IN ONE OPERATION. CONSTRUCTION JOINTS, SUCH AS A DAY'S POUR, JOINTS SHALL BE LOCATED IN THE MIDDLE THIRD OF THE SPAN, MAIN REINFORCING TO RUN THROUGH THE JOINT, KEY AND ROUGHEN JOINTS TO EXPOSE AGGREGATE FOR CHEMICAL BOND.
- NO HORIZONTAL JOINTS SHALL BE PLACED IN WALLS EXCEPT AS SHOWN ON THE DRAWINGS, WITHOUT THE APPROVAL OF THE ENGINEER.
- STRUCTURAL SLABS ON GRADE SHALL BE OF A THICKNESS AND REINFORCED AS INDICATED ON DRAWINGS.
- FOR OPENINGS IN FLOORS AND WALLS NOT SHOWN ON STRUCTURAL DRAWINGS, SEE MECHANICAL, ELECTRICAL, PLUMBING, AND ARCHITECTURAL DRAWINGS.
- PROVIDE 100% CONTINUITY OVER SUPPORTS FOR CONTINUOUS SLABS AND BEAMS.
- TOP ELEVATION OF SLABS SHALL VARY ACCORDING TO FINISH FLOOR MATERIAL. SEE ARCHITECTURAL DRAWINGS.
- U.N.O. WALL FOOTINGS SHALL BE MINIMUM 12" THICK AND PROJECT 6" BEYOND ALL FACES OF WALLS AND AS A MINIMUM CONTAIN #5@12" O.C. BOTTOM BARS
- ALL CONCRETE EXPOSED TO VIEW SHALL BE CONSTRUCTED WITH SMOOTH-FORM FINISH. ROUGH FORM FINISH FOR CONCRETE SURFACES NOT EXPOSED TO VIEW.
- FLOOR SURFACE PROFILES SHALL BE TESTED IN ACCORDANCE WITH ASTM E1155, PER THE REQUIREMENTS FOR FLAT FLOORS.
 - OVERALL TOLERANCES: F1=35; F1+25
 - CANTILEVER TOLERANCES: F1=21; F1+15
- UNLESS OTHERWISE INDICATED ON DRAWINGS CAST-IN-PLACE CONCRETE SHALL CONFORM TO THE FOLLOWING TABLE:

LOCATIONS	CONCRETE STRENGTH (PSI)	NOMINAL MAX. SIZE AGGREGATE	AIR CONTENT (%)	MAX. W/C RATIO
INTERIOR SLAB-ON-GROUND	3500	1-1/2"	N/A	0.55
FOUNDATION WALL, EXTERIOR SLAB-ON-GROUND, AND FOOTINGS	4500	1-1/2"	5.5 +/- 1.5	0.45
- REPAIRING FORMED SURFACES: SURFACE DEFECTS INCLUDE COLOR AND TEXTURE (IRREGULARITIES, CRACKS, SPALLS, AIR BUBBLES, HONEYCOMBS, ROCK POCKETS, FINS AND OTHER PROJECTIONS ON THE SURFACE, AND STAINS AND OTHER DISCOLORATIONS THAT CANNOT BE REMOVED BY CLEANING.
 - A. IMMEDIATELY AFTER FORM REMOVAL, CUT OUT HONEYCOMBS, ROCK POCKETS, AND VOIDS MORE THAN 1/2" IN ANY DIMENSION TO SOLID CONCRETE. LIMIT CUT DEPTH TO 3/4". EDGES OF CUTS MUST BE PERPENDICULAR TO THE CONCRETE SURFACE. CLEAN, DAMPEN SURFACE WITH WATER, AND BRUSH-COAT HOLES AND VOIDS WITH BONDING AGENT. FILL AND COMPACT WITH PATCHING MORTAR BEFORE BONDING AGENT HAS DRIED. FILL FORM-TYPE VOIDS WITH PATCHING MORTAR OR CONE PLUGS SECURED IN PLACE WITH BONDING AGENT.
 - B. REPAIR DEFECTS ON SURFACES EXPOSED TO VIEW BY BLENDING WHITE PORTLAND CEMENT AND STANDARD PORTLAND CEMENT SO THAT, WHEN DRY, THE PATCHING MORTAR WILL MATCH THE SURROUNDING COLOR. PATCH A TEST AREA AT INCONSPICUOUS LOCATIONS TO VERIFY MIXTURE AND COLOR MATCH BEFORE PROCEEDING WITH PATCHING. COMPACT MORTAR IN PLACE AND STRIKE OFF SLIGHTLY HIGHER THAN SURROUNDING SURFACE.
 - C. REPAIR DEFECTS ON CONCEALED FORMED SURFACES THAT AFFECT THE CONCRETE'S DURABILITY AND STRUCTURAL PERFORMANCE AS DETERMINED BY THE ENGINEER.
- REFER TO DIVISION 03 OF THE PROJECT MANUAL FOR ADDITIONAL REQUIREMENTS.

EXISTING CONDITIONS GENERAL NOTES:

(UNLESS OTHERWISE NOTED OR SHOWN ON PLAN, THE FOLLOWING SHALL APPLY)

- DIMENSIONS AND ELEVATIONS OF EXISTING CONDITIONS GIVEN ON STRUCTURAL DRAWINGS ARE BASED ON INFORMATION CONTAINED IN VARIOUS ORIGINAL DESIGN AND CONSTRUCTION DOCUMENTS PROVIDED BY THE OWNER, AND LIMITED FIELD OBSERVATIONS AND MEASUREMENTS.
- CONTRACTOR SHALL VERIFY ALL EXISTING DIMENSIONS AND CONDITIONS BY ACTUAL MEASUREMENT PRIOR TO BEGINNING WORK, AND WHEN FEASIBLE, PRIOR TO SHOP DRAWING SUBMITTALS. ANY DISCREPANCIES SHALL BE BROUGHT TO THE ATTENTION OF THE ARCHITECT. IT SHALL BE THE RESPONSIBILITY OF THE GENERAL CONTRACTOR TO COORDINATE SAID DISCREPANCIES WITH ALL SUB-CONTRACTORS AND MATERIAL SUPPLIERS.
- CONTRACTOR SHALL PROVIDE TEMPORARY SHORING AND BRACING TO MAKE SAFE ALL FLOORS AND/OR ADJACENT PROPERTY AS PROJECT CONDITIONS REQUIRE. DESIGN SHALL BE STAMPED BY A LICENSED ENGINEER EMPLOYED BY THE CONTRACTOR.

GRADATION TABLES

SELECT FILL		
SEIVE SIZE	SEIVE OPENING (MM)	PERCENT PASSING
4 IN	101.6	100
No. 40	0.425	0 - 70
No. 200	0.075	0 - 15

ITEM B-12		
SEIVE SIZE	SEIVE OPENING (MM)	PERCENT PASSING
1 - 1/2 IN	38.1	100
1 IN	25.4	95 - 100
1/2 IN	12.7	45 - 60
1/4 IN	6.35	0 - 15

NO. 2 COARSE AGGREGATE		
SEIVE SIZE	SEIVE OPENING (MM)	PERCENT PASSING
1 - 1/2 IN	38.1	100
1 IN	25.4	90 - 100
1/2 IN	12.7	0 - 15

SUBBASE TYPE 2		
SEIVE SIZE	SEIVE OPENING (MM)	PERCENT PASSING
1 - 1/2 IN	38.1	100
1 IN	25.4	90 - 100
1/2 IN	12.7	0 - 15

SELECT GRANULAR MATERIAL		
SEIVE SIZE	SEIVE OPENING (MM)	PERCENT PASSING
2 IN	50.8	100
1/4 IN	6.35	25 - 65
NO. 40	0.425	5 - 40
NO. 200	0.075	0 - 10

STRUCTURAL DESIGN				
DESIGN LOADS:				
IMPORTANCE FACTORS (BC1604.5):		WIND LOADS (BC1609):		
RISK CATEGORY		III	BASIC DESIGN WIND SPEED	126 mph
WIND (Iw)	1.0		ALLOWABLE STRESS DESIGN WIND SPEED, V _{ad}	98 mph
SNOW (Is)	1.10			
SEISMIC (Ie)	1.25		EXPOSURE CATEGORY	C
DEAD LOADS:		SEISMIC REQUIREMENTS (BC1613):		
FLOOR	65 psf	SITE CLASS	D	
		SPECTRAL RESPONSE COEFFICIENTS:		
LIVE LOADS (BC1607):		S _s	0.289	g
ROOMS & CORRIDORS	100 psf	S ₁	0.06	g
STAIRS - DISTRIBUTED LOAD	100 psf	S ₀₅	0.302	
STAIRS - CONCENTRATED LOAD	300 lbs	S ₀₁	0.096	g
ROOF	20 psf	SEISMIC DESIGN CATEGORY	B	g
		SEISMIC FORCE RESISTING SYSTEM:		
SNOW LOADS (BC1608):				
GROUND SNOW LOAD (P _g) (NYS BLDG.)	25 psf	FLOOD REQUIREMENTS (BC1612):		
FLAT ROOF SNOW LOAD (P _f)	22.0 psf	FLOOD HAZARD STATUS		
EXPOSURE FACTOR (C _e)	1.0			
THERMAL FACTOR (FLAT ROOF)	1.0			

STRUCTURAL ABBREVIATIONS:

@	AT	IN	INCHES
ALT	ALTERNATE	INFO	INFORMATION
APPROX	APPROXIMATELY	INSUL	INSULATION
ARCH	ARCHITECT	INV	INVERT ELEVATION
ATCH	ATTACHMENT	IT	JOINT
BP	BASE PLATE	LBS	POUNDS
BO	BOTTOM OF	LLH	LONG LEG HORIZONTAL
BLDG	BUILDING	LLV	LONG LEG VERTICAL
BOT	BOTTOM	LOCS	LOCATIONS
BRS	BEARINGS	LP	LOW POINT
CANTIL	CANTILEVER	LVL	LAMINATED VENEER LUMBER
CFMF	COLD-FORMED METAL FRAMING	MAX	MAXIMUM
CL	CENTERLINE	MC	MOMENT CONNECTION
CJ	CONTROL JOINT	MECH	MECHANICAL
CJP	COMPLETE JOINT PENETRATION WELD	MEP	MECHANICAL, ELECTRICAL, PLUMBING
CLR	CLEARANCE/CLEAR	MFR	MANUFACTURER
CMU	CONCRETE MASONRY UNIT	MID	MIDDLE
COL	COLUMN	MIN	MINIMUM
CONC	CONCRETE	NO. #	NUMBER
CONN	CONNECTION	NFS	NOT TO SCALE
CONT	CONTINUOUS/CONTINUATION	OC	ON CENTER
COORD	COORDINATE	PL	PLATE
DBL	DOUBLE	PSF	POUNDS PER SQUARE FOOT
DIA, Ø	DIAMETER	PSI	POUNDS PER SQUARE INCH
DWG	DRAWING	PSL	PARALLEL STRAND LUMBER
EACH	EACH	PT	PRESSURE TREATED
EF	EACH FACE	RD	ROOF DRAIN
EL. ELEV	ELEVATION	REINF	REINFORCEMENT/REINFORCED
EOR	ENGINEER OF RECORD	REO'D	REQUIRED
EOS	EDGE OF SLAB	SC	SLIP CRITICAL
EQ	EQUAL/EQUALY	SCHED	SCHEDULE
EW	EACH WAY	SF	SQUARE FEET
EXT	EXISTING	SIM	SIMILAR
EXP	EXPANSION	SOG	SLAB ON GROUND
EXT	EXTERIOR	SP	SPACING
FD	FINISHED	T&B	TOP AND BOTTOM
FIN	FINISH	THK	THICK
FS	FOOTING STEP	T.O.	TOP OF
FT	FOOT/FEET	TOF	TOP OF FOOTING
FTG	FOOTING	TOS	TOP OF STEEL/SLAB
GALV	GALVANIZED	TOW	TOP OF WALL
GWB	GYPSUM WALL BOARD	TYP	TYPICAL
HOR, HORIZ	HORIZONTAL	UNO	UNLESS NOTED OTHERWISE
HP	HIGH POINT	VERT	VERTICAL
HT	HEIGHT	WWR	WELDED WIRE REINFORCEMENT
ID	INSIDE DIAMETER	YD/YDS	YARD/YARDS

LEGEND

1 TITLE SCALE



X SECTION DWG No.

X BREAK LINE

X DETAIL

LOCATION ELEVATION

DETAIL, PLAN, OR SECTION TITLE

NORTH ARROW


SECTION

BREAK LINE


DETAIL

ELEVATION MARK


PATTERNS (UNLESS NOTED ON DWG):

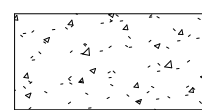


CONCRETE

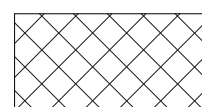


MASONRY

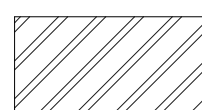

STRUCTURAL STEEL

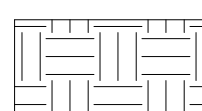

STRUCTURAL FILL

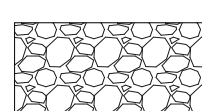

CRUSHED STONE

SPECIAL INSPECTION NOTES:

(UNLESS OTHERWISE NOTED OR SHOWN ON PLAN, THE FOLLOWING SHALL APPLY)

- SPECIAL INSPECTIONS SHALL BE IN ACCORDANCE WITH CHAPTER 17 OF THE 2020 BUILDING CODE OF NEW YORK STATE.
- SPECIAL INSPECTION RESPONSIBILITIES SHALL BE IN ACCORDANCE WITH NEW YORK STATE TECHNICAL BULLETIN "STRUCTURAL TESTS AND SPECIAL INSPECTIONS" REFERENCE "CODE EFFECTIVE DATE JANUARY 1, 2008".
- CONTRACTOR SHALL NOTIFY THE ENGINEER OF UNRESOLVED DISCREPANCIES IDENTIFIED IN THE SPECIAL INSPECTION REPORTS.

19 Front St., Newburgh - New York 12550-7601
845-581-3179 www.csarch.com

CS ARCH



CITY SD OF THE CITY OF NEW ROCHELLE
ISAAC E YOUNG MIDDLE SCHOOL
EMERGENCY STORM PROJECT

Project Title

DATE	DESCRIPTION
1	6/26/22
2	
3	
4	
5	
6	
7	
8	
9	
10	
11	
12	

Drawn By:	ALC
Checked By:	FLS
Proj. #:	66-11-00-01-0-003-017
CSArch Proj. #:	188-2203.00
Construction Documents:	

Sheet Title

GENERAL
NOTES,
LEGENDS &
ABBREVIATIONS

Sheet No.

IEYMS
S001

CONSTRUCTION DOCUMENTS

C:\Users\dominio\Documents\2021\13640 IEYMS Reconstruction Project_Struct_2020_dominio.ctb



Check if Required	INSPECTION AND TESTING	Continuous	Periodic	REFERENCE STANDARD	BCNYS REFERENCE	SPEC SECTION	COMMENTS
<input checked="" type="checkbox"/>	A. Steel Construction Follow specifications found in reference standards.						
<input checked="" type="checkbox"/>	1. Structural Steel			AISC 360 Chapter N	1705.2.1		In addition to the requirements of AISC 360 Chapter N, there shall be continuous inspection of member placement.
<input checked="" type="checkbox"/>	2. Cold-Formed Steel Deck			AISC 360 Table N5.4-1	SDI QA/QC		
<input type="checkbox"/>	3. Installation of Open Web Steel Joists and Joist Girders				1705.2.3		
<input type="checkbox"/>	a. End Connections- Welding or Bolted		<input type="checkbox"/>	SJI Specifications listed in Section 2207.1 of the BCNYS	1705.2.3, 2207.1		
<input type="checkbox"/>	b. Bridging – Horizontal or Diagonal				1705.2.3, 2207.1		
<input type="checkbox"/>	1. Standard Bracing		<input type="checkbox"/>	SJI Specifications listed in Section 2207.1 of the BCNYS	1705.2.3, 2207.1		
<input type="checkbox"/>	2. Bridging That Differs from the SJI Specifications Listed in Section 2207.1		<input type="checkbox"/>		1705.2.3, 2207.1		
<input type="checkbox"/>	4. Cold-formed steel trusses spanning 60 feet or greater		<input type="checkbox"/>		1705.2.4		
<input type="checkbox"/>	a. Verify installation of temporary restraint and bracing		<input type="checkbox"/>	Approved Truss Submittal Package	1705.2.4		
<input type="checkbox"/>	b. Verify installation of permanent restraint and bracing		<input type="checkbox"/>	Approved Truss Submittal Package	1705.2.4		
<input checked="" type="checkbox"/>	B. Concrete Construction						
<input checked="" type="checkbox"/>	1. Inspection of reinforcement, including prestressing tendons, and verify placement.		<input checked="" type="checkbox"/>	ACI 318: Ch. 20, 25.2, 25.3, 26.6.1-26.6.3	1705.3, 1908.4		
<input type="checkbox"/>	2. Reinforcing bar welding.						
<input type="checkbox"/>	a. Verify weldability of reinforcing bars other than ASTM A706		<input type="checkbox"/>	AWS D1.4; ACI 318: 26.6.	1705.3		
<input type="checkbox"/>	b. Inspect single-pass fillet weld, maximum 5/16"		<input type="checkbox"/>		1705.3		
<input type="checkbox"/>	c. Inspect all other welds	<input type="checkbox"/>			1705.3		
<input type="checkbox"/>	3. Inspect anchors cast in concrete		<input type="checkbox"/>	ACI 318: 17.8.2	1705.3		
<input type="checkbox"/>	4. Inspect anchors post-installed in hardened concrete members.						
<input type="checkbox"/>	a. Adhesive anchors installed in horizontal or upwardly inclined orientations to resist sustained tension loads.	<input type="checkbox"/>		ACI 318: 17.8.2.4	1705.3		
<input type="checkbox"/>	b. Mechanical anchors and adhesive anchors not defined in 4.a.		<input type="checkbox"/>	ACI 318: 17.8.2	1705.3		
<input checked="" type="checkbox"/>	5. Verify use of required design mix.		<input checked="" type="checkbox"/>	ACI 318: Ch. 19, 26.4.3, 26.4.4	1705.3, 1904.1, 1904.2, 1908.2, 1908.3		
<input checked="" type="checkbox"/>	6. Prior to concrete placement, fabricate specimens for strength tests, perform slump and air content tests, and determine the temperature of the concrete.	<input checked="" type="checkbox"/>		ASTM C 172, C 31; ACI 318: 26.5, 26.12	1705.3, 1908.10		
<input checked="" type="checkbox"/>	7. Inspect concrete and shotcrete placement for proper application techniques.	<input checked="" type="checkbox"/>		ACI 318: 26.5	1705.3, 1908.6, 1908.7, 1908.8		
<input checked="" type="checkbox"/>	8. Verify maintenance of specified curing temperature and techniques.		<input checked="" type="checkbox"/>	ACI 318: 26.5.3-26.5.5	1705.3, 1908.9		
<input type="checkbox"/>	9. Inspect prestressed concrete.						
<input type="checkbox"/>	a. Application of prestressing forces.	<input type="checkbox"/>		ACI 318: 26.10	1705.3		
<input type="checkbox"/>	b. Grouting of bonded prestressing tendons	<input type="checkbox"/>		ACI 318: 26.10	1705.3		
<input type="checkbox"/>	10. Inspect erection of precast concrete members.		<input type="checkbox"/>	ACI 318: Ch. 26.9	1705.3		
<input type="checkbox"/>	11. Verification of in-situ concrete strength prior to stressing of tendons and prior to removal of shores and forms from beams and structural slabs.		<input type="checkbox"/>	ACI 318: 26.11.2	1705.3		
<input type="checkbox"/>	12. Inspect formwork for shape, location and dimensions of the concrete member being formed.		<input type="checkbox"/>	ACI 318: 26.11.1,2(b)	1705.3		
<input type="checkbox"/>	C. Masonry Construction Follow specifications found in reference standards.			TMS 402/ACI 530/ASCE 5 and TMS 602/ACI 530.1/ASCE 6	1705.4		
<input type="checkbox"/>	1. Quality Assurance Level			TMS 402/ACI 530/ASCE 5 Section 3.1.1 and TMS 602/ACI 530.1/ASCE 6 Section 1.6	1705.4		
<input type="checkbox"/>	a. Level A			TMS 402/ACI 530/ASCE 5 Table 3.1.1 and TMS 602/ACI 530.1/ASCE 6 Table 3	1705.4		
<input type="checkbox"/>	b. Level B			TMS 402/ACI 530/ASCE 5 Table 3.1.2 and TMS 602/ACI 530.1/ASCE 6 Table 4	1705.4		
<input type="checkbox"/>	c. Level C			TMS 402/ACI 530/ASCE 5 Table 3.1.3 and TMS 602/ACI 530.1/ASCE 6 Table 5	1705.4		
<input type="checkbox"/>	2. Inspect and test empirically designed masonry, glass unit masonry, and masonry veneer in Risk Category IV when designed in accordance with Sections 2109, 2110, or Chapter 14, respectively.	<input type="checkbox"/>		TMS 402/ACI 530/ASCE 5, Level B Quality Assurance	1705.4.1		
<input type="checkbox"/>	3. Inspect and test vertical masonry foundation elements.	<input type="checkbox"/>		TMS 402/ACI 530/ASCE 5 and TMS 602/ACI 530.1/ASCE 6	1705.4		
<input type="checkbox"/>	D. Wood Construction				1705.5		
<input type="checkbox"/>	1. Fabrication of wood structural elements and assemblies.		<input type="checkbox"/>		1705.5, 1704.2.5		
<input type="checkbox"/>	a. Inspect prefabricated wood structural elements and assemblies.		<input type="checkbox"/>		1705.5, 1704.2.5		
<input type="checkbox"/>	b. Verify panel sheathing, panel grade, panel thickness at high-load wood diaphragms. Additionally, verify nominal size of framing members at adjoining panel edge and fasteners size and spacing.	<input type="checkbox"/>			1705.5, 1704.2, 2306.2		
<input type="checkbox"/>	2. On site inspection						
<input type="checkbox"/>	a. Verify species and grade of structural members	<input type="checkbox"/>					
<input type="checkbox"/>	b. Verify size and location of structural members	<input type="checkbox"/>					
<input type="checkbox"/>	c. Verify hardware for connections	<input type="checkbox"/>					
<input type="checkbox"/>	3. Verify temporary and permanent bracing/restraint at metal-plate-connected wood trusses greater than 60 feet in length.		<input type="checkbox"/>	Approved Truss Submittal Package	1705.5		
<input checked="" type="checkbox"/>	E. Soils						
<input type="checkbox"/>	1. Verify materials below shallow foundations are adequate to achieve the design bearing capacity.		<input type="checkbox"/>		1705.6		
<input type="checkbox"/>	2. Verify excavations are extended to proper depth and have reached proper material.		<input type="checkbox"/>		1705.6		
<input checked="" type="checkbox"/>	3. Perform classification and testing of compacted fill materials.		<input checked="" type="checkbox"/>		1705.6		
<input checked="" type="checkbox"/>	4. Verify use of proper materials, density and lift thicknesses during placement and compaction of compacted fill.	<input checked="" type="checkbox"/>			1705.6		
<input checked="" type="checkbox"/>	5. Prior to placement of compacted fill, inspect subgrade and verify that site has been prepared properly.		<input checked="" type="checkbox"/>		1705.6		

Check if Required	INSPECTION AND TESTING	Continuous	Periodic	REFERENCE STANDARD	BCNYS REFERENCE	SPEC SECTION	COMMENTS
<input type="checkbox"/>	F. Driven Deep Foundations						
<input type="checkbox"/>	1. Verify element materials, sizes and lengths comply with the requirements.	<input type="checkbox"/>			1705.7, 1810.3.2		
<input type="checkbox"/>	2. Determine capacities of test elements and conduct additional load tests, as required.	<input type="checkbox"/>			1705.7, 1810.3.3.1.2, 1810.3.3.1.3		
<input type="checkbox"/>	3. Inspect driving operations and maintain complete and accurate records for each element.	<input type="checkbox"/>			1705.7		
<input type="checkbox"/>	4. Verify placement locations and plumbness, confirm type and size of hammer, record number of blows per foot of penetration, determine required penetrations to achieve design capacity, record tip and butt elevations and document any damage to the foundation element.	<input type="checkbox"/>			1705.7		
<input type="checkbox"/>	5. For steel elements, perform additional inspections in accordance with Section 1705.2.				1705.7		
<input type="checkbox"/>	6. For concrete elements and concrete-filled elements, perform tests and additional inspections in accordance with Section 1705.3.				1705.7		
<input type="checkbox"/>	7. For specialty elements, perform additional inspections as determined by the registered design professional in responsible charge.				1705.7		
<input type="checkbox"/>	G. Cast-in-Place Deep Foundations				1705.8		
<input type="checkbox"/>	1. Inspect drilling operations and maintain complete and accurate records for each element.	<input type="checkbox"/>			1705.8		
<input type="checkbox"/>	2. Verify placement locations and plumbness, confirm element diameters, bell diameters (if applicable), lengths, embedment into bedrock (if applicable) and adequate end bearing strata capacity. Record concrete and grout volumes.	<input type="checkbox"/>			1705.8		
<input type="checkbox"/>	3. For concrete elements, perform tests and additional special inspections in accordance with Section 1705.3.				1705.8		
<input type="checkbox"/>	H. Helical Pile Foundations				1705.9		
<input type="checkbox"/>	1. Record information on installation equipment, pile dimensions, tip elevations, final depth, final installation torque, and other pertinent installation data as required by the Registered Design Professional in Responsible Charge.	<input type="checkbox"/>			1705.9		
<input checked="" type="checkbox"/>	I. Inspection of Fabricated Items				1705.10, 1704.2.5, 1704.2.5.1		
<input type="checkbox"/>	J. Special Inspections for Wind Resistance				1705.11		
<input type="checkbox"/>	1. Structural Wood				1705.11.1		
<input type="checkbox"/>	a. Inspect field gluing operations of elements of the main windforce-resisting system.	<input type="checkbox"/>			1705.11.1		
<input type="checkbox"/>	b. Inspect nailing, bolting, anchoring, and other fastening of elements of the main windforce-resisting system, including wood shear walls, wood diaphragms, drag struts, braces, and hold-downs.		<input type="checkbox"/>		1705.11.1		
<input type="checkbox"/>	2. Cold-Formed Steel light-frame construction				1705.11.2		
<input type="checkbox"/>	a. Inspect welding operations of the main windforce-resisting system.		<input type="checkbox"/>		1705.11.2		
<input type="checkbox"/>	b. Inspect screw attachment, bolting, anchoring, and other fastening of elements of the main windforce-resisting system, including shear walls, braces, diaphragms, collectors, and hold-downs.		<input type="checkbox"/>		1705.11.2		
<input type="checkbox"/>	3. Wind-Resisting Components				1705.11.3		
<input type="checkbox"/>	a. Inspect roof covering, roof deck, and roof framing connections.		<input type="checkbox"/>		1705.11.3		
<input type="checkbox"/>	b. Inspect exterior wall coverings and wall connections to roof and floor diaphragms and framing.		<input type="checkbox"/>		1705.11.3		
<input type="checkbox"/>	K. Special Inspections for Seismic Resistance Applicable to specific structures, systems, and components.				1705.12		Building is exempt from special inspections for seismic as per 1705.12 (2). Force resisting system is reinforced masonry. SDS does not exceed 0.5, and building height is <25'.
<input type="checkbox"/>	1. Structural steel.	<input type="checkbox"/>		AISC 341	1705.12.1		
<input type="checkbox"/>	2. Structural wood.	<input type="checkbox"/>	<input type="checkbox"/>		1705.12.2		
<input type="checkbox"/>	3. Cold-formed steel framing.		<input type="checkbox"/>		1705.12.3		
<input type="checkbox"/>	4. Designated Seismic Systems		<input type="checkbox"/>		1705.12.4		
<input type="checkbox"/>	5. Architectural components.		<input type="checkbox"/>		1705.12.5		
<input type="checkbox"/>	6. Mechanical and electrical components.		<input type="checkbox"/>		1705.12.6		
<input type="checkbox"/>	7. Storage racks and access floors.		<input type="checkbox"/>		1705.12.7		
<input type="checkbox"/>	8. Seismic isolation system.		<input type="checkbox"/>		1705.12.8		
<input type="checkbox"/>	9. Cold-formed steel special bolted moment frame.		<input type="checkbox"/>		1705.12.9		
<input type="checkbox"/>	L. Structural Testing for Seismic Resistance Applicable to specific structures, systems, and components.				1705.13, 1704.2		
<input type="checkbox"/>	1. Structural steel.			AISC 341	1705.13.1		
<input type="checkbox"/>	a. Seismic force-resisting systems			AISC 341	1705.13.1.1		
<input type="checkbox"/>	b. Structural steel elements			AISC 341	1705.13.1.2		
<input type="checkbox"/>	2. Nonstructural components			ASCE 7 Section 13.2.1	1705.13.2, 1704.5		
<input type="checkbox"/>	3. Designated seismic system			ASCE 7 Section 13.2.2	1705.13.3, 1704.5		
<input type="checkbox"/>	4. Seismic isolation system			ASCE 7 Section 17.8	1705.13.4		
<input type="checkbox"/>	M. Sprayed Fire-Resistant Materials				1705.14		
<input type="checkbox"/>	1. Physical and visual tests				1705.14.1		
<input type="checkbox"/>	2. Structural member surface conditions.				1705.14.2		
<input type="checkbox"/>	3. Application.				1705.14.3		
<input type="checkbox"/>	4. Thickness.			ASTM E 605	1705.14.4		
<input type="checkbox"/>	5. Density.			ASTM E 605	1705.14.5		
<input type="checkbox"/>	6. Bond strength.			ASTM E 736	1705.14.6		
<input type="checkbox"/>	N. Mastic and Intumescent Fire-Resistant Coatings			AWCI 12-B	1705.15, 722.5.1.3		
<input type="checkbox"/>	O. Exterior Insulation and Finish Systems (EIFS)			ASTM E2570	1705.16		
<input type="checkbox"/>	P. Fire-Resistant Penetrations and Joints			ASTM E2174, ASTM E2393	1705.17, 714.3.1.2, 714.4.2, 715.3, 715.4, 1705.17.1, 1705.17.2		
<input type="checkbox"/>	Q. Smoke Control				1705.18		
<input type="checkbox"/>	R. Special Cases				1705.1.1		
<input type="checkbox"/>	S. Structural Observations Applicable to specific structures.				1704.6		



19 Front St., Newburgh, New York 12550-7601
845-361-3179 www.csarch.com



CITY SD OF THE CITY OF NEW ROCHELLE
ISAAC E YOUNG MIDDLE SCHOOL
EMERGENCY STORM PROJECT

Project Title

1	1/28/22	ADDENDUM 1
2	DATE	DESCRIPTION
Drawn By: KLC		
Checked By: PMB		
Proj. #: 66-11-00-01-0-003-017		
CSArch Proj. #: 188-2203.00		
Construction Documents		

Sheet Title


SPECIAL
INSPECTIONS

Sheet No.

IEYMS
S002

CONSTRUCTION DOCUMENTS

C:\Users\jdomino\Documents\2021\36.00 IEYMS Reconstruction Project_Sheet_2020.dwg

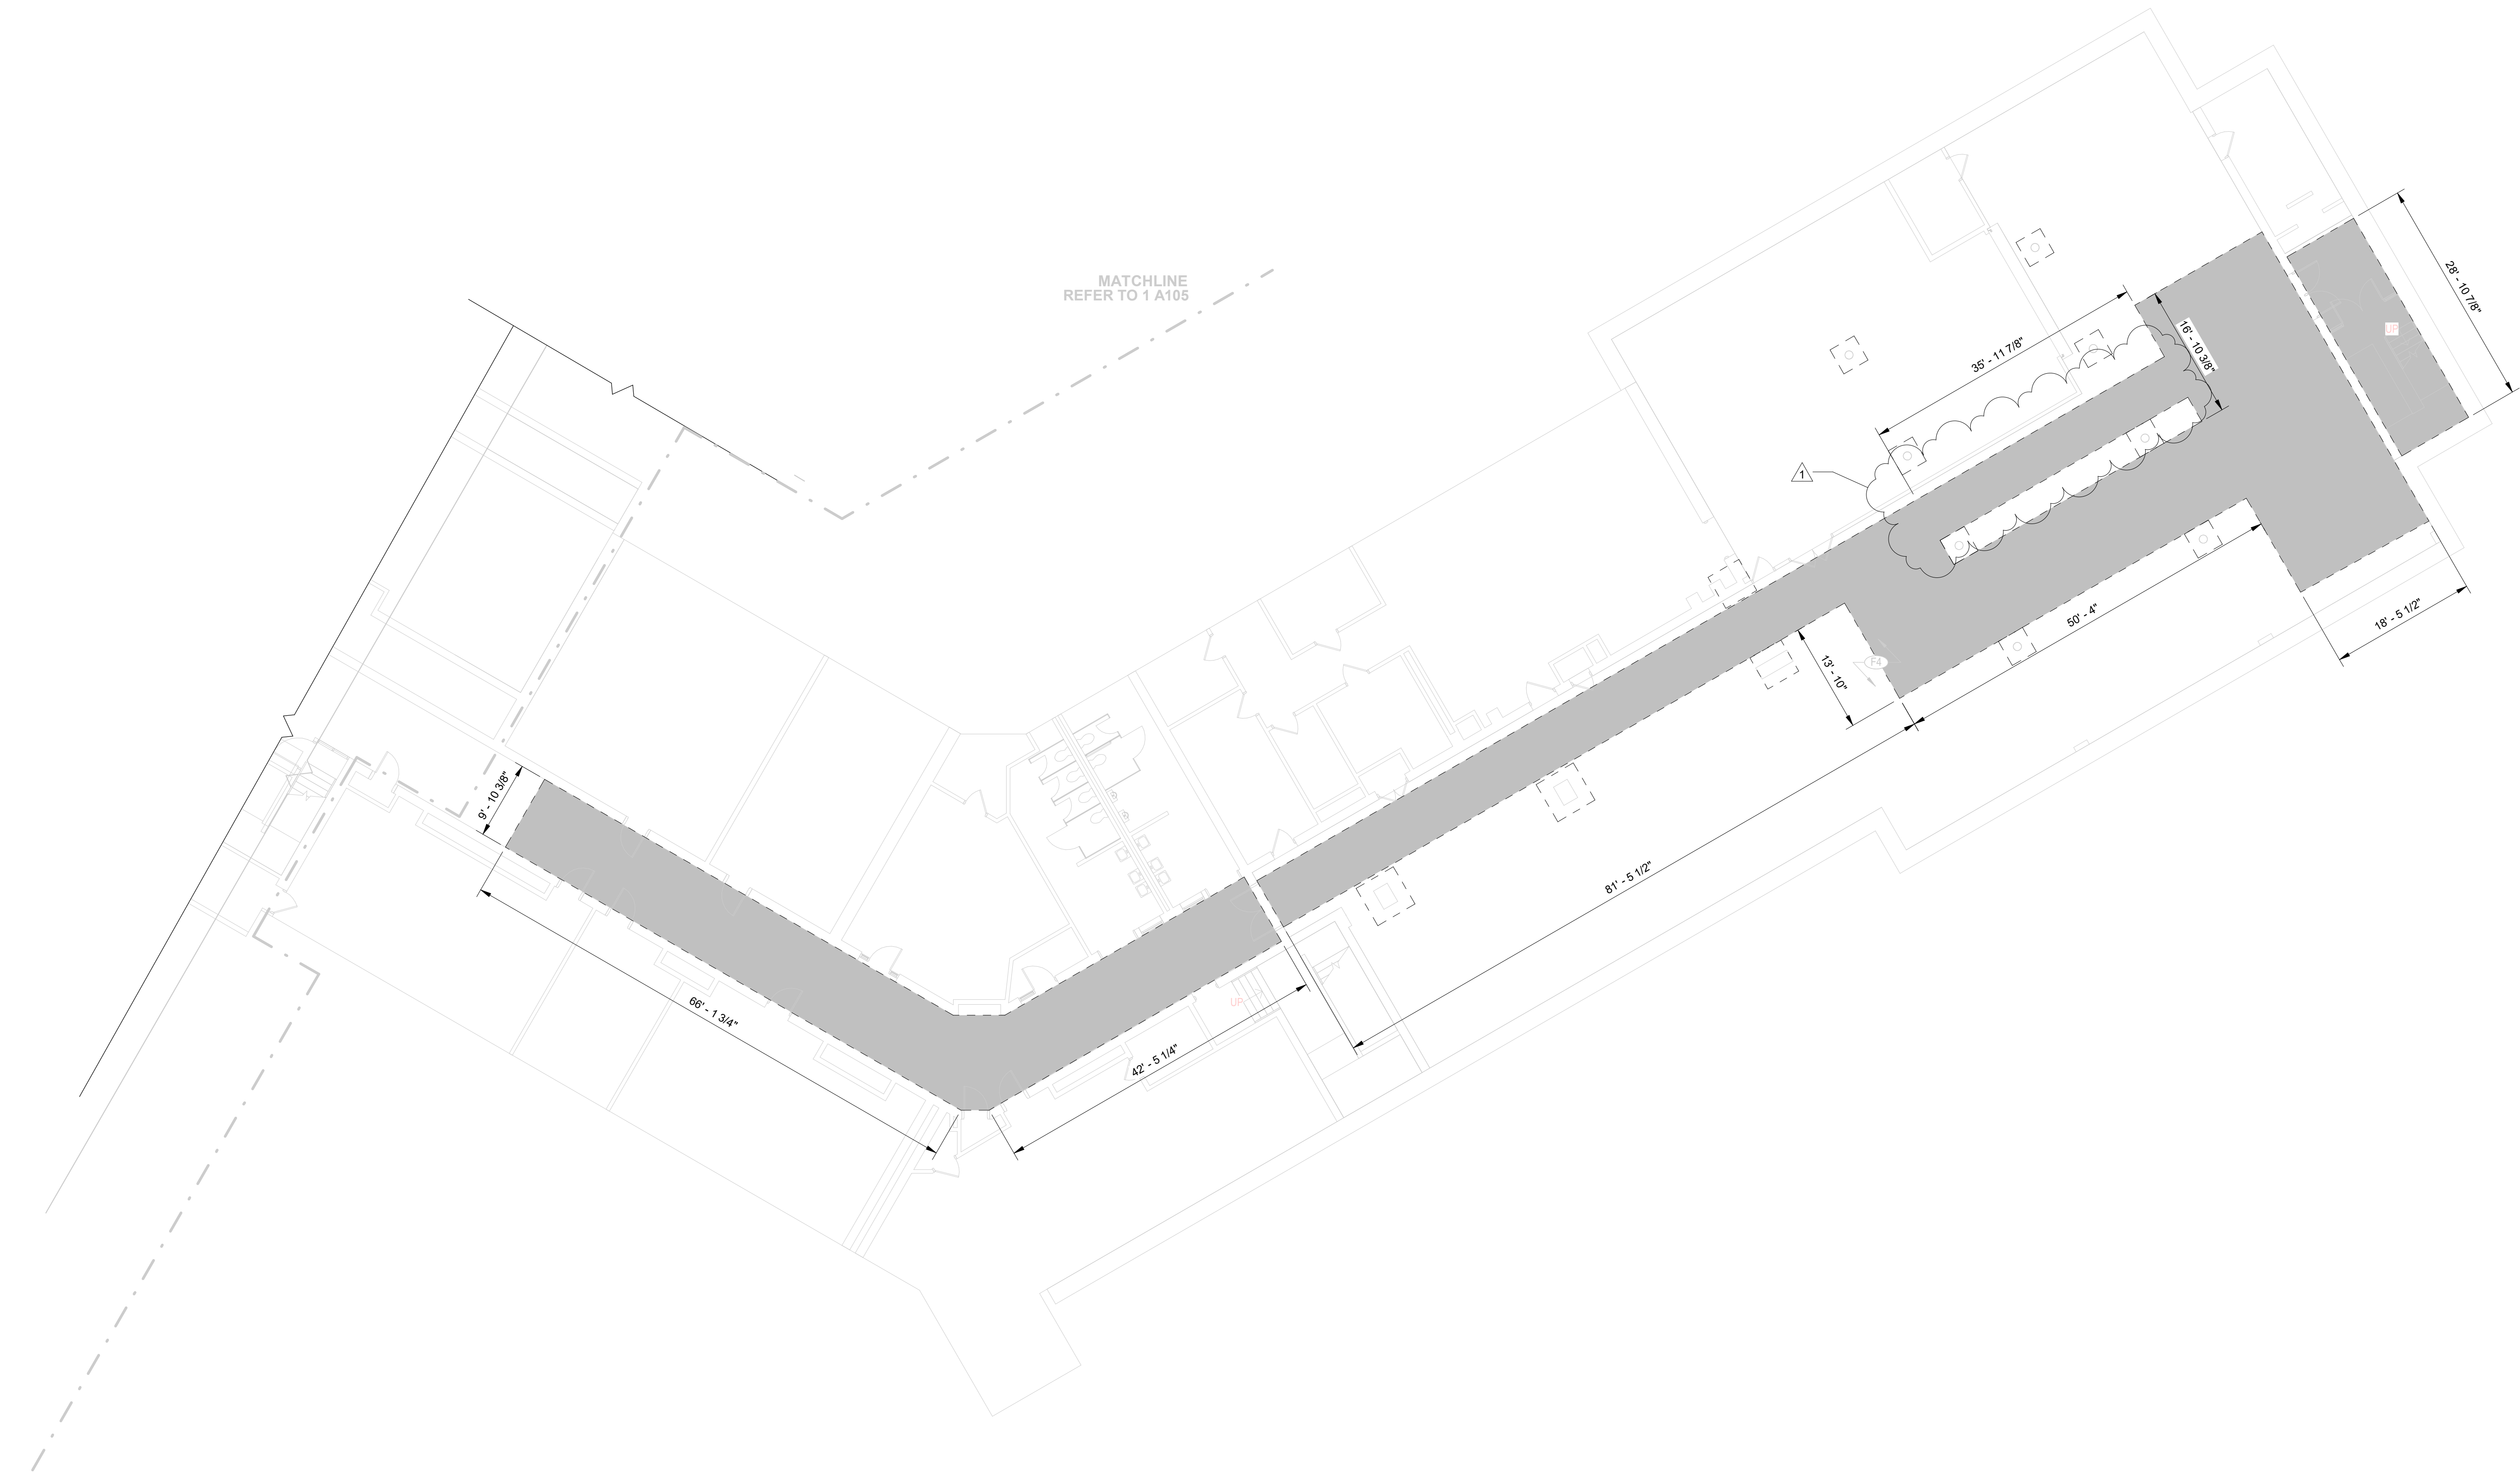



1 AREA 'C' SLAB REMOVALS PLAN
3/32" = 1'-0"

LEGEND
- EXIST CONC SLAB
DEMOLITION EXTENTS

NOTES:

- CONTRACTOR TO PERFORM A SCAN OF THE FLOOR IN THE AREA OF WORK USING GROUND PENETRATING RADAR (GPR) OR OTHER ENGINEER APPROVED METHOD TO LOCATE REINFORCEMENT PRIOR TO SLAB REMOVAL. THIS REQUIREMENT ALSO APPLIES IF THE CONTRACTOR IS PROVIDING ANY FASTENER GREATER THAN 3/4" IN LENGTH. ONCE IDENTIFIED, THE REINFORCING SHALL NOT BE CUT OR OTHERWISE COMPROMISED IN ANY WAY. PRIOR TO CUTTING, DRILLING, OR FASTENING TO SLAB, REVIEW WITH ARCHITECT AND ENGINEER ANY AND ALL LOCATIONS WHERE REINFORCEMENT IS IN CONFLICT WITH NEW WORK.

KEY PLAN

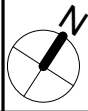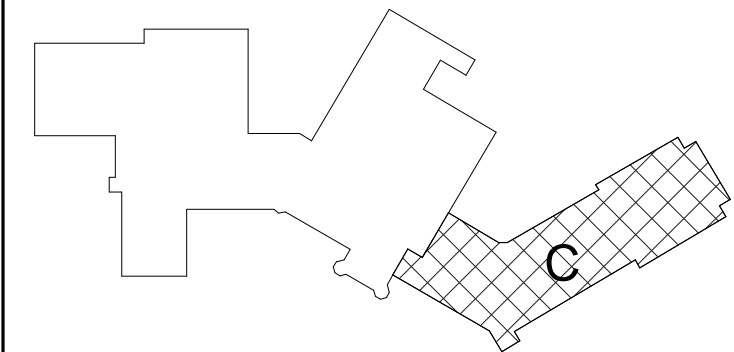


COPYRIGHT © ALL RIGHTS RESERVED



CITY SD OF THE CITY OF NEW ROCHELLE
ISAAC E YOUNG MIDDLE SCHOOL
EMERGENCY STORM PROJECT

Project Title

 

REV	DATE	DESCRIPTION
1	6/28/22	ADDENDUM 1

Drawn By: RJC
Checked By: FMB
Proj. #: 66-11-00-01-0-003-017
CSArch Proj. #: 188-2203.00
Construction Documents:

Sheet Title
AREA 'C' SLAB
REMOVALS
PLAN

Sheet No.
IEYMS
SD102

CONSTRUCTION DOCUMENTS

19 Front St., Newburgh, New York 12550-7601
845.561.3179 www.csarch.com

CSARCH

C:\Users\domino\Documents\2021\36.00 IEYMS Reconstruction Project_Slud_2020_domino.rvt


1 AREA 'B' GROUND FLOOR PLAN
3/32" = 1'-0"



NOTES:

1. TOS ELEVATION= 29'-10 1/2" UNO.
2. REINFORCE 5" SOG W/ WWR 6X6-W6XW6. SEE TYP SOG DETAIL ON DWG S-701 FOR ADDITIONAL INFORMATION.
3. C-J- DENOTES CONTROL JOINT. REFER TO TYP1 CONTROL JOINT DETAIL ON DWG S-701.

KEY PLAN

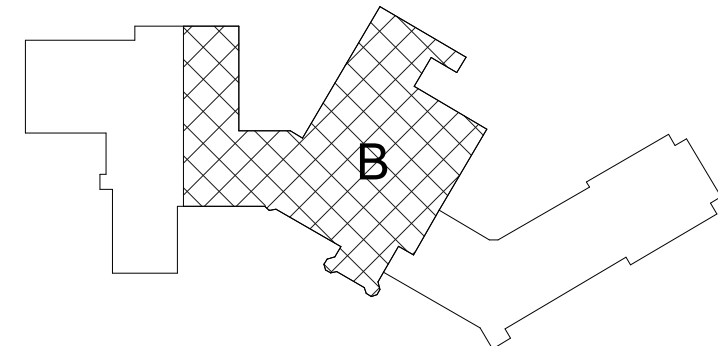

COPYRIGHT © ALL RIGHTS RESERVED

CITY SD OF THE CITY OF NEW ROCHELLE
ISAAC E YOUNG MIDDLE SCHOOL
EMERGENCY STORM PROJECT

Project Title



REV	DATE	DESCRIPTION
1	6/28/22	ADDENDUM 1

Drawn By: KJC
Checked By: FMB
Proj. #: 66-11-00-01-0-003-017
CSArch Proj. #: 188-2203.00
Construction Documents:

Sheet Title

AREA 'B' -
PARTIAL SLAB
PLAN

Sheet No.

IEYMS
S101

CONSTRUCTION DOCUMENTS




19 Front St., Newburgh, New York 12550-7601
845.561.1317 www.csarch.com

CSARCH

C:\Users\domino\Documents\2021\186.00 IEYMS Reconstruction Project_S1000_2020.dwg


1 AREA 'C' GROUND FLOOR PLAN
3/32" = 1'-0"

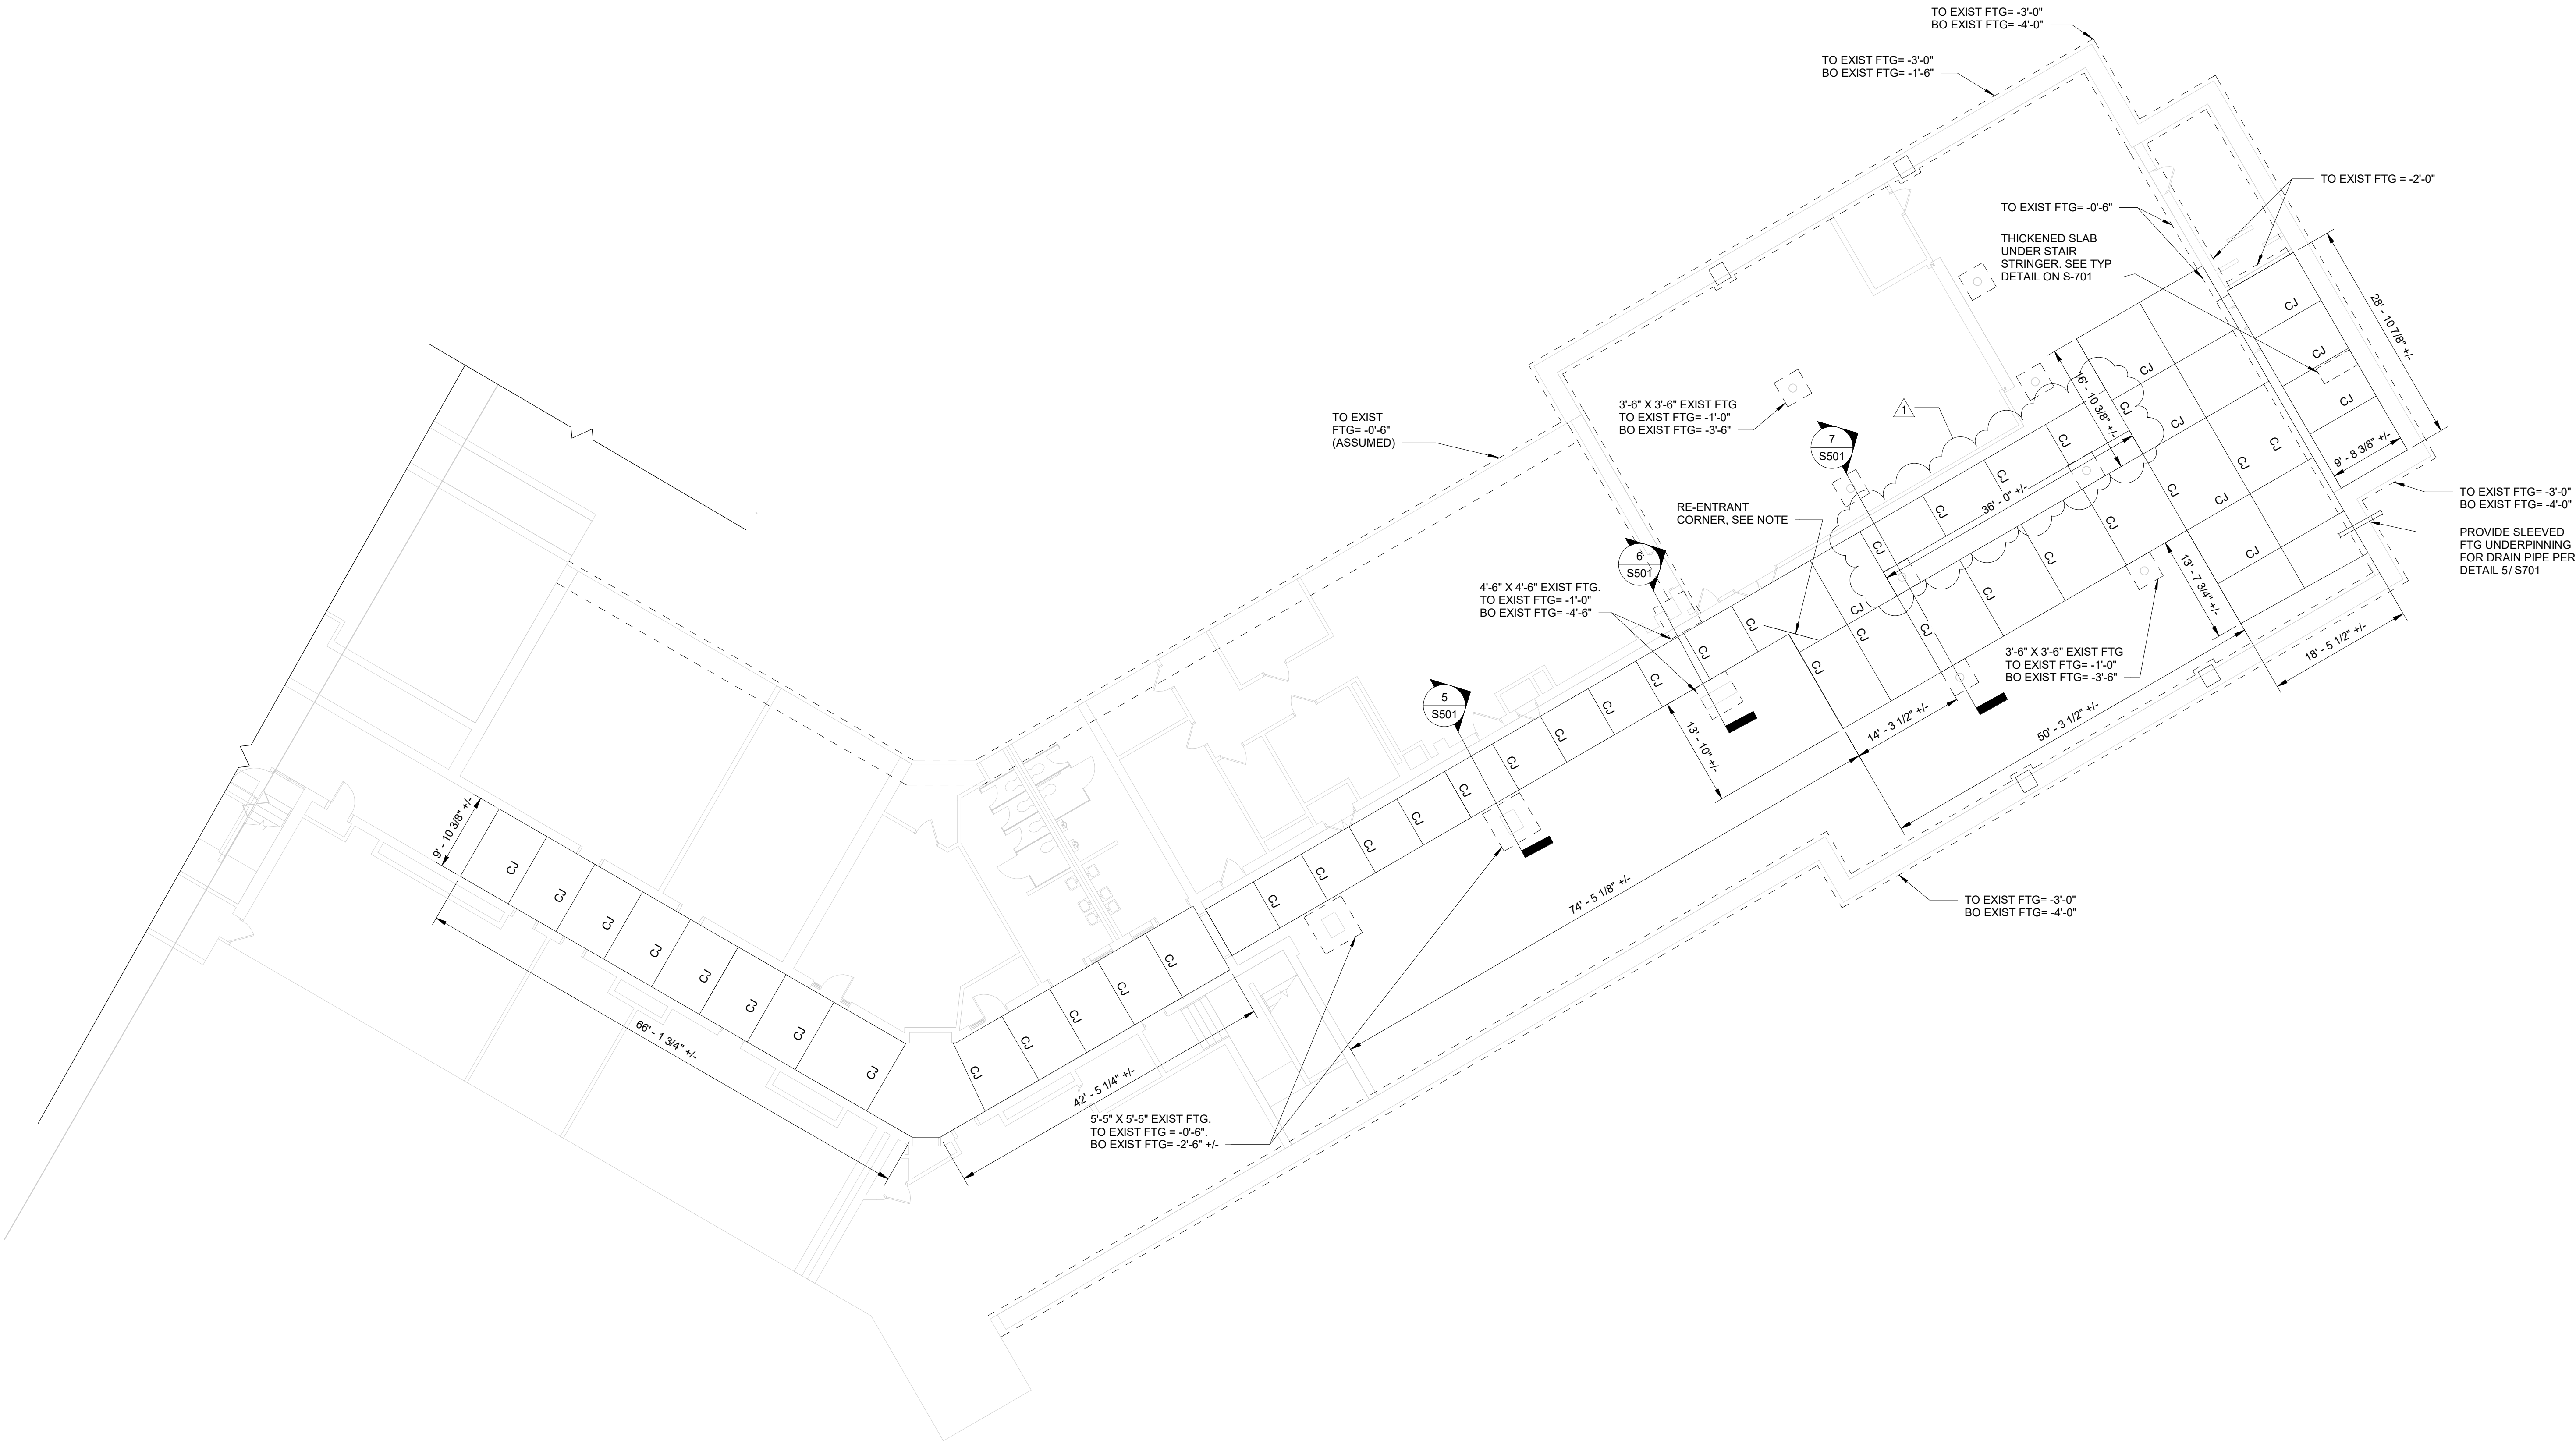

NOTES:

1. TOS ELEVATION= 39'-0" +/- UNO. FIELD VERIFY AND MATCH EXIST FLOOR SLAB EL.
2. REINFORCE 5" SOG W/ WWR 6X6-W6XW6. SEE TYP SOG DETAIL ON DWG S-701 FOR ADDITIONAL INFORMATION.
3. CJ- DENOTES CONTROL JOINT. REFER TO TYPI CONTROL JOINT DETAIL ON DWG S-701.
4. PROVIDE ADDITIONAL REINF @ RE-ENTRANT CORNERS. SEE TYPICAL DETAIL ON DWG S701.
5. DOWEL SLAB TO EXIST SLAB PER TYPICAL DETAIL ON DWG S701.

KEY PLAN

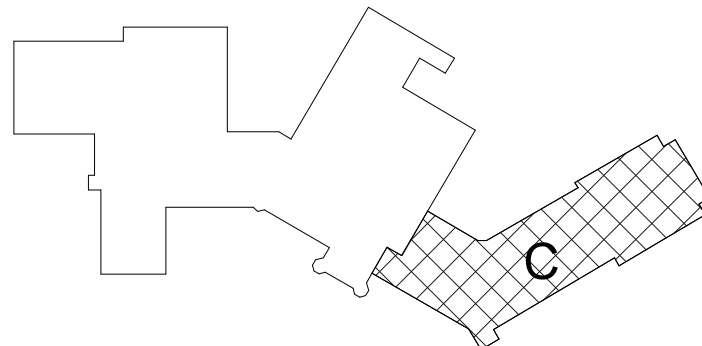

CITY SD OF THE CITY OF NEW ROCHELLE
ISAAC E YOUNG MIDDLE SCHOOL
EMERGENCY STORM PROJECT

Project Title



REV	DATE	DESCRIPTION
1	6/28/22	ADDENDUM 1

Drawn By: KJC
Checked By: PMS
Proj. #: 66-11-00-01-0-003-017
CSArch Proj. #: 188-2203.00
Construction Documents:

Sheet Title
AREA 'C' -
PARTIAL
GROUND
FLOOR PLAN

Sheet No.
IEYMS
S102

CONSTRUCTION DOCUMENTS




19 Front St., Newburgh, New York 12550-7601
845.561.5379 www.csarch.com

CSARCH

COPYRIGHT © ALL RIGHTS RESERVED

C:\Users\public\Documents\188-2203.00 IEYMS_Arch_01.dwg

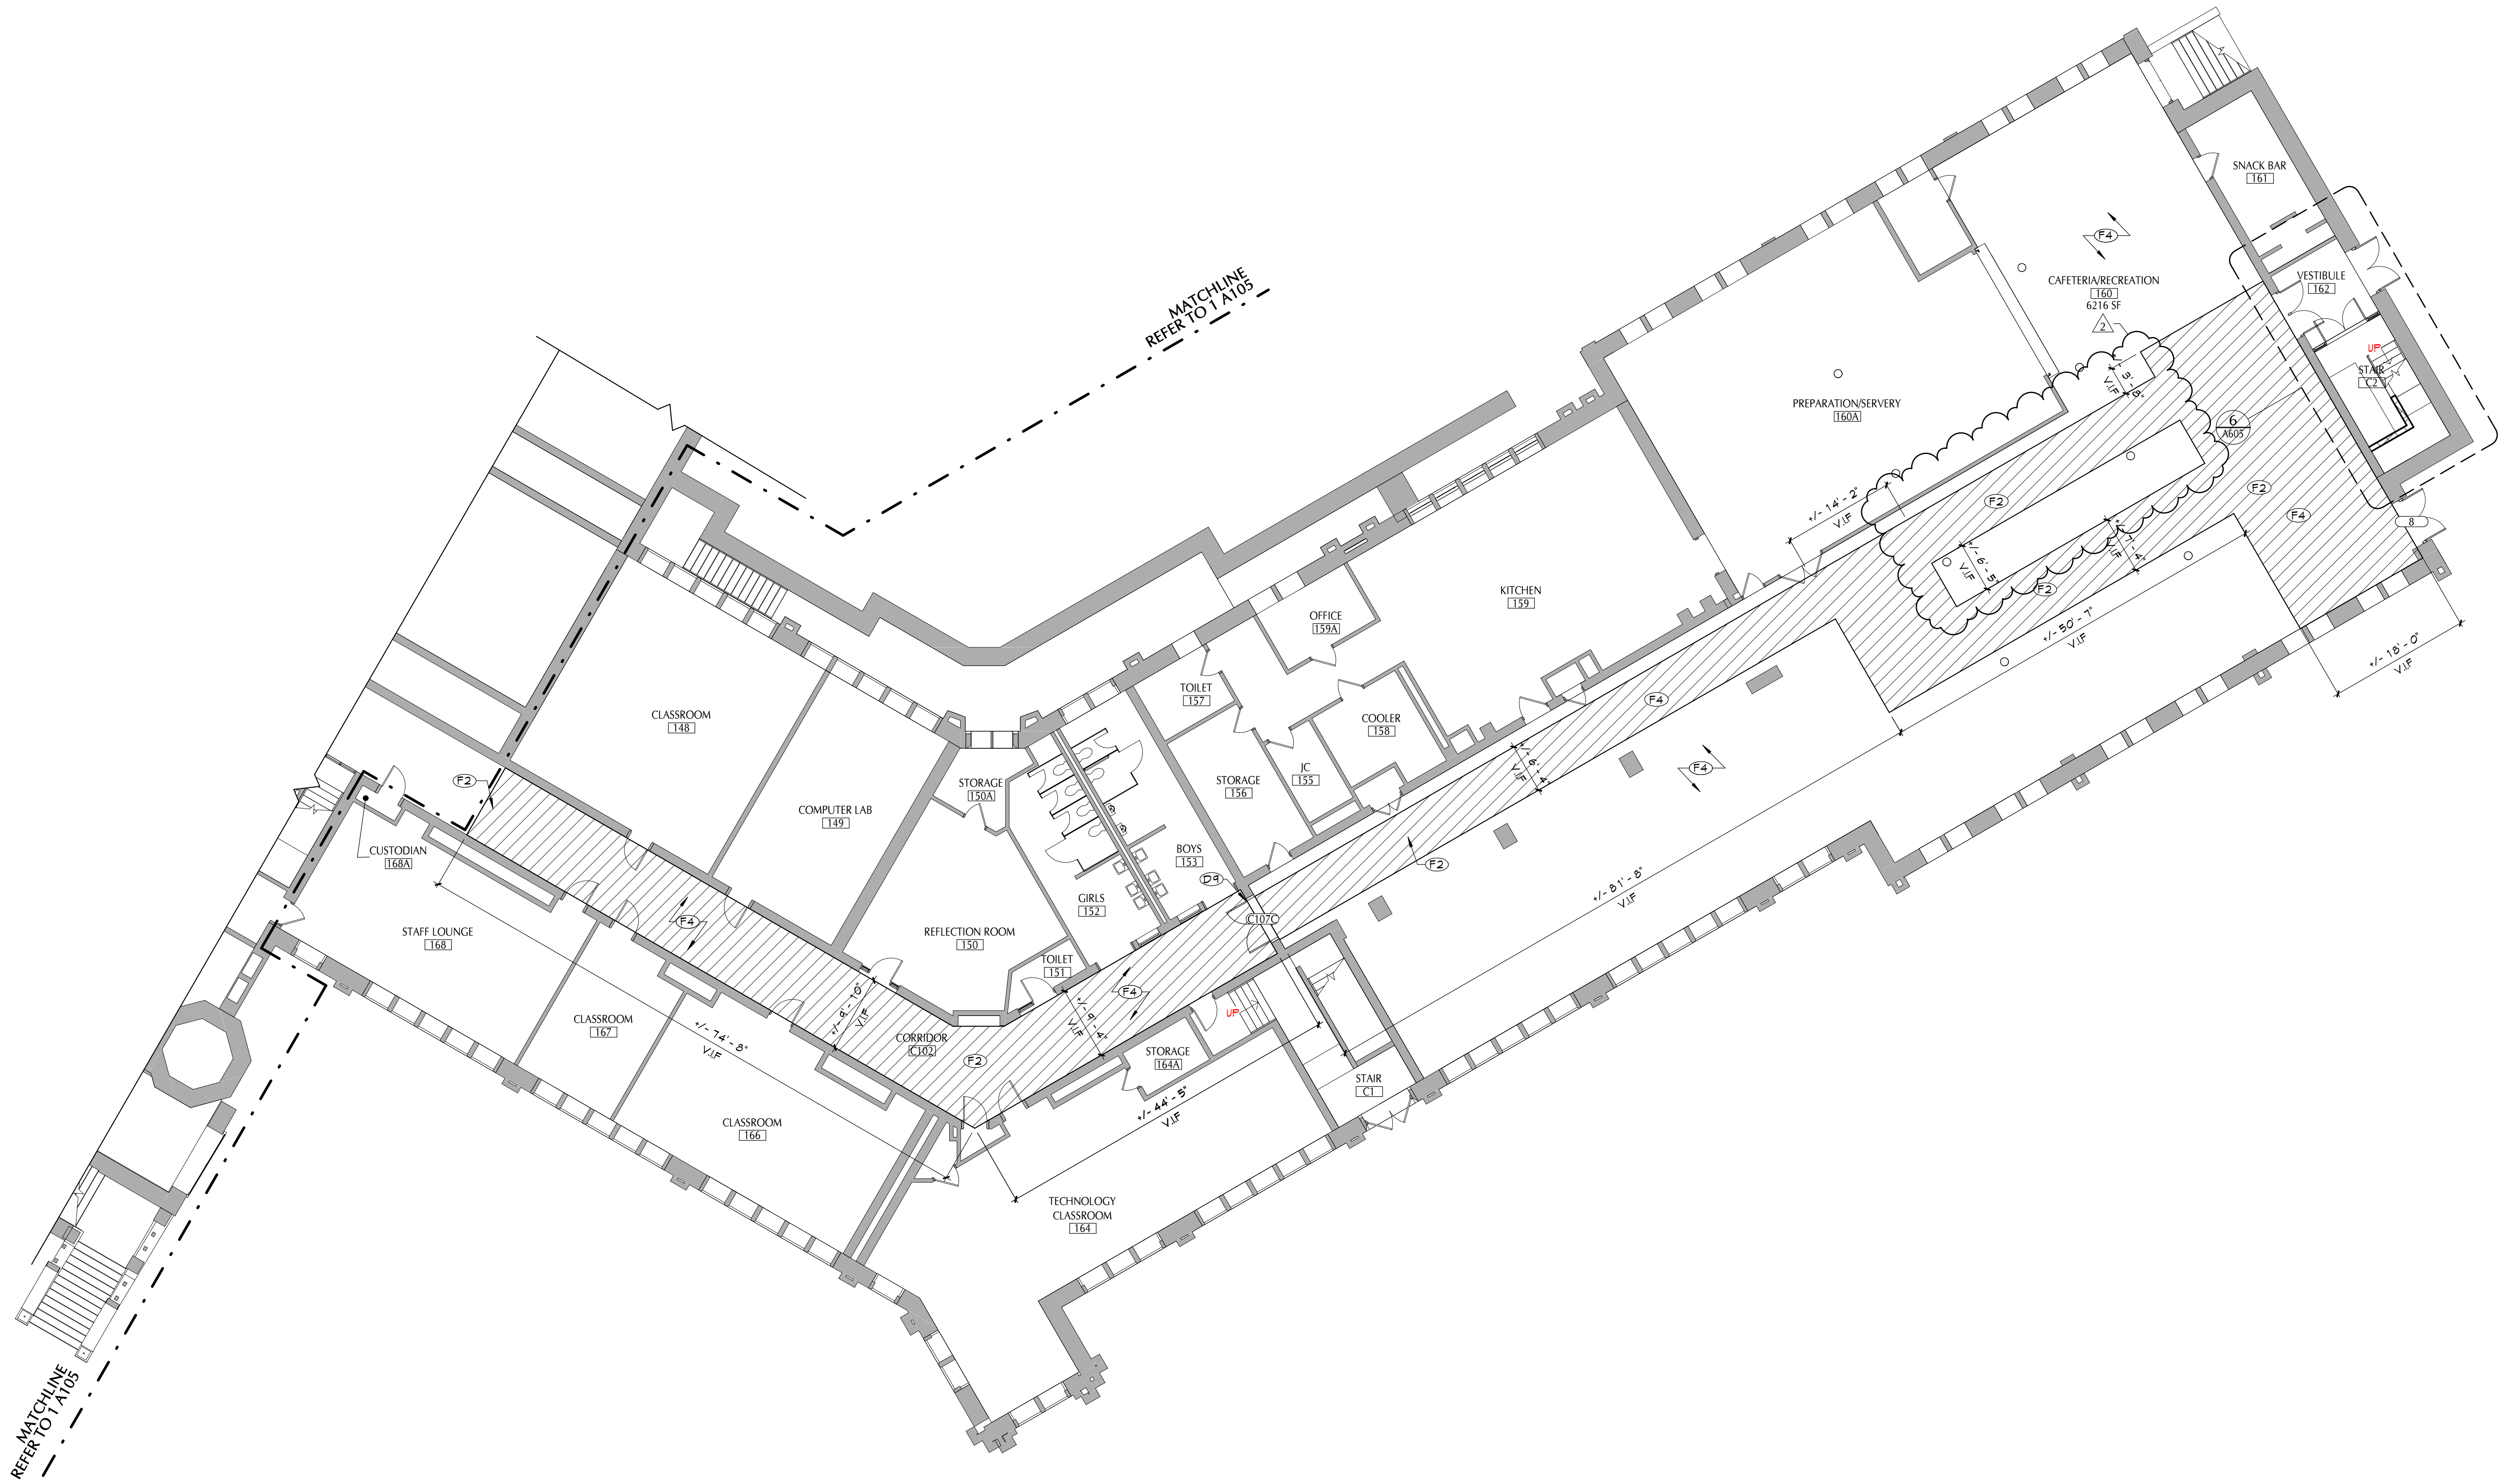

1 AREA 'C' GROUND FLOOR PLAN
A106 3/32" = 1'-0"

GENERAL NOTES	
1. REFER TO SHEET 6001 FOR ADDITIONAL GENERAL NOTES.	
2. REFER TO SHEET A351 FOR LOCKER ELEVATIONS, TYPES, DETAILS AND ADDITIONAL NOTES.	
3. REFER TO SHEET A101 FOR PARTITION TYPES AND ADDITIONAL NOTES.	
4. AT ENDS OF EXISTING MASONRY WALLS TO REMAIN, PROVIDE NEW SOLID MASONRY FOR SMOOTH FINISH.	
KEY NOTES	
#	DESCRIPTION
D9	REINSTALL DOOR, FRAME AND HARDWARE.
F2	NEW CONCRETE SLAB, COORDINATE EXISTING WITH STRUCTURAL AND PLUMBING DRAWINGS. REFER TO ARCHITECTURAL FINISH PLANS FOR FLOOR FINISHES AND MORE INFORMATION.
F4	RESILIENT FLOORING WITH RUBBER BASE

KEY PLAN

19 Front St., Newburgh, New York 12550-7601
845.581.1317 www.csarch.com

Consultant

CITY SD OF THE CITY OF NEW ROCHELLE
ISAAC E YOUNG MIDDLE SCHOOL
EMERGENCY STORM PROJECT

REGISTERED ARCHITECT
STATE OF NEW YORK
022324

2	06-20-2023	NO ADDENDUM #1
1	02-08-2023	ARCHITECTURAL SEE ADDENDUM #1
01	DATE	DESCRIPTION

Drawn By: MS
Checked By: MZ
Proj. #: 66-11-00-81-0-003-017
CSArch Proj. #: 188-2203.00
Issued for Bid: 06-17-2023

Sheet Title





AREA 'C' -
PARTIAL
GROUND
FLOOR PLAN

Sheet No.


IEYMS
A106

CONSTRUCTION DOCUMENTS


COPYRIGHT © ALL RIGHTS RESERVED

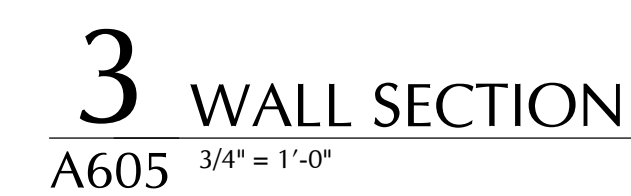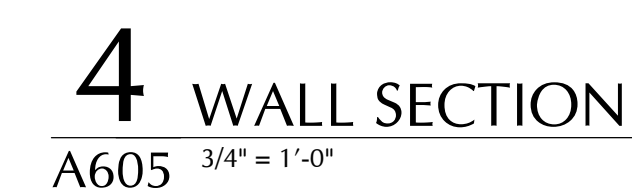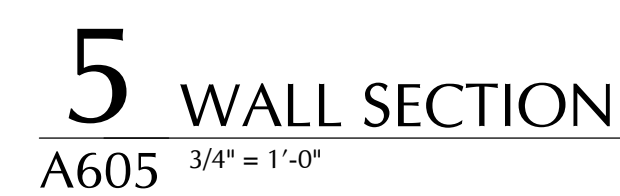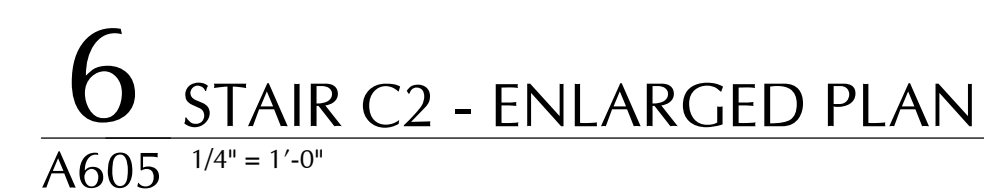


KEY PLAN

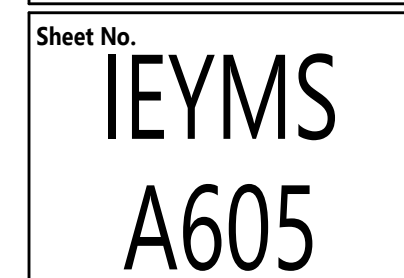


C:\Users\public\Documents\188-2203.00 IEYMS_Arch_details.dwt

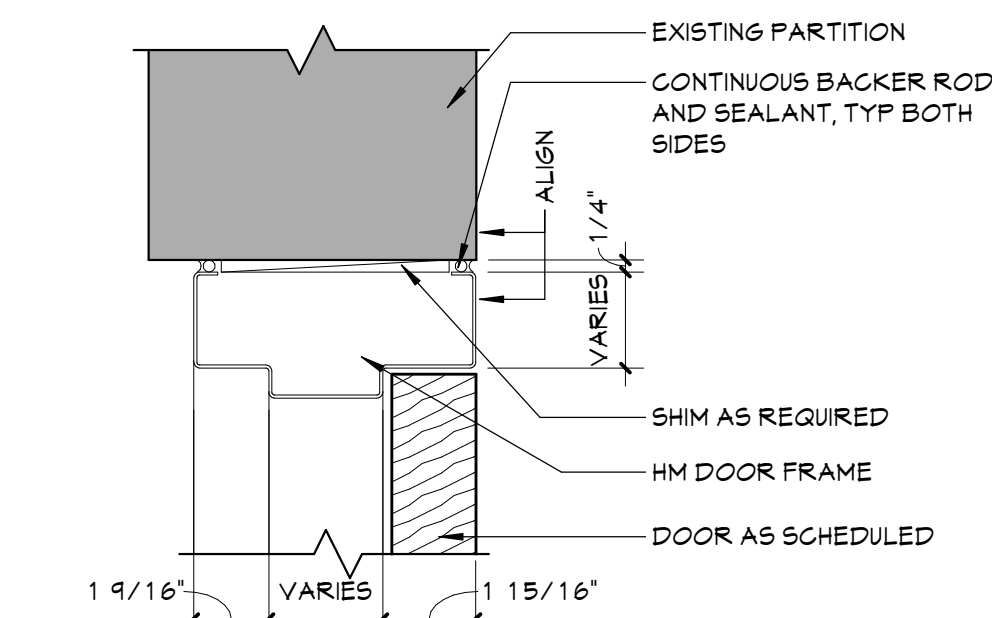


4 HEAD DETAIL
A900 3" = 1'-0"

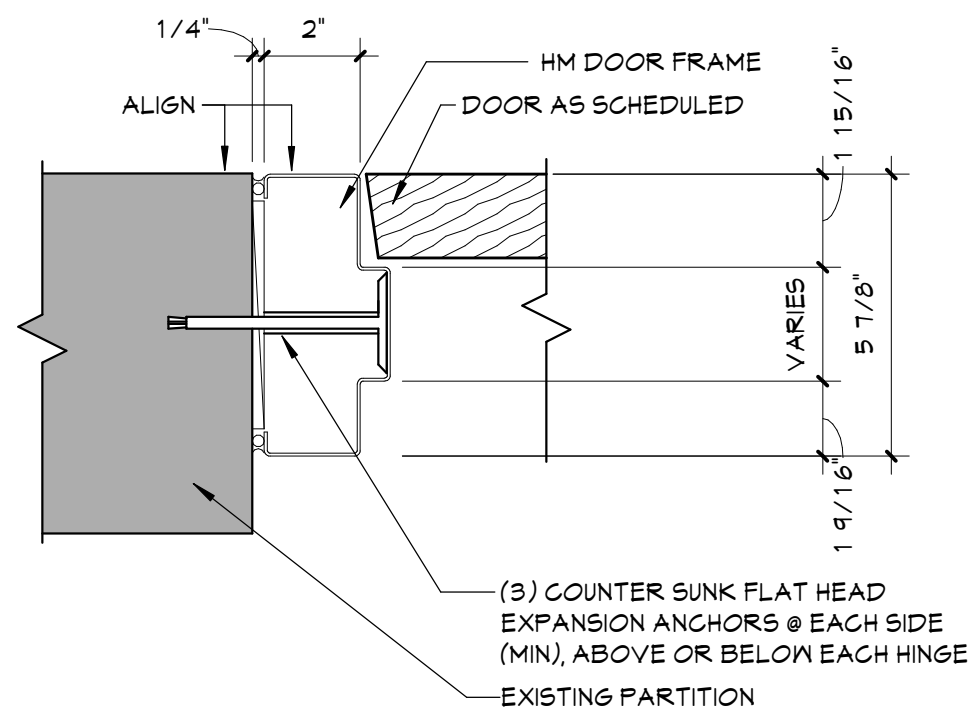


3 JAMB DETAIL
A900 3" = 1'-0"

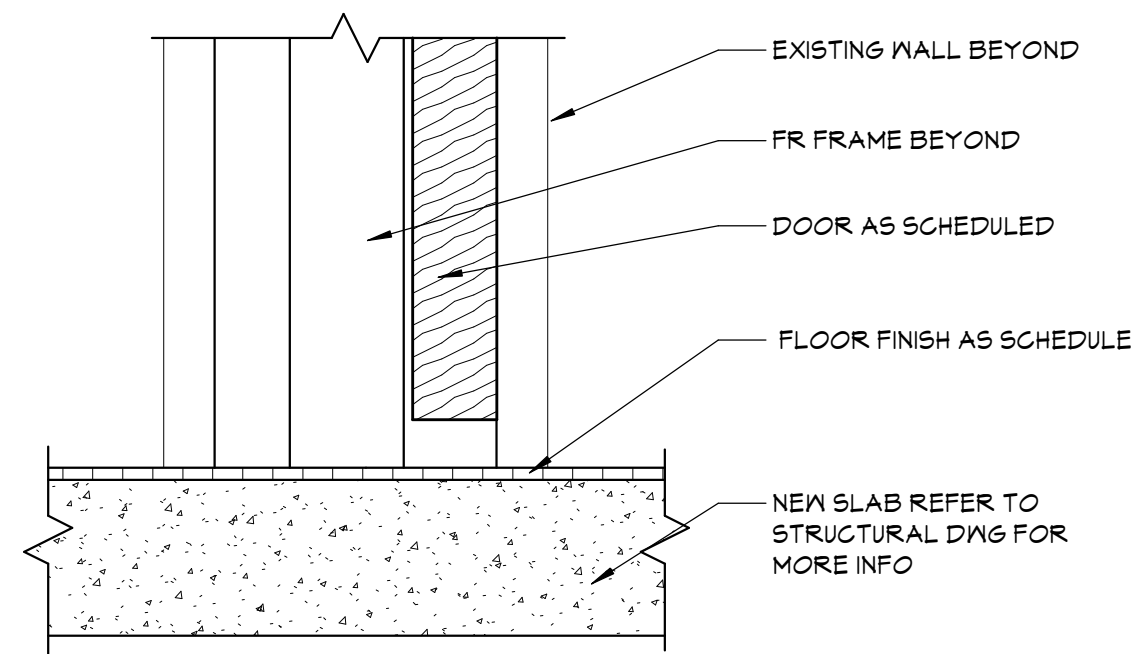


2 THRESHOLD DETAIL
A900 3" = 1'-0"

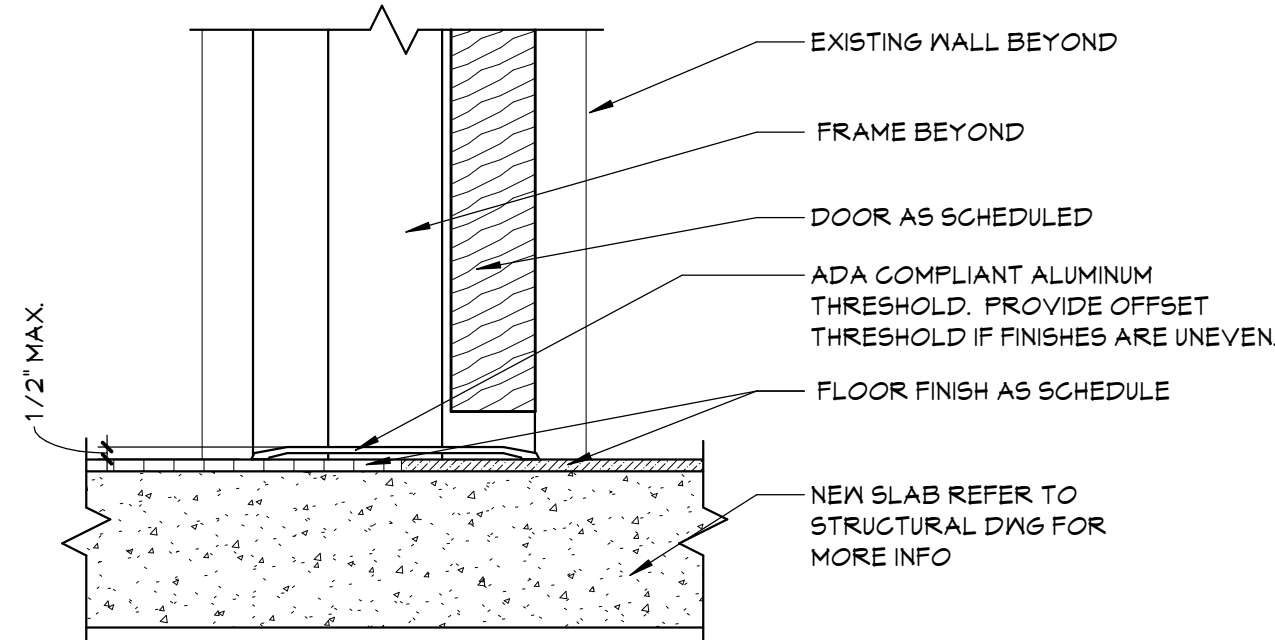

1 THRESHOLD DETAIL
A900 3" = 1'-0"

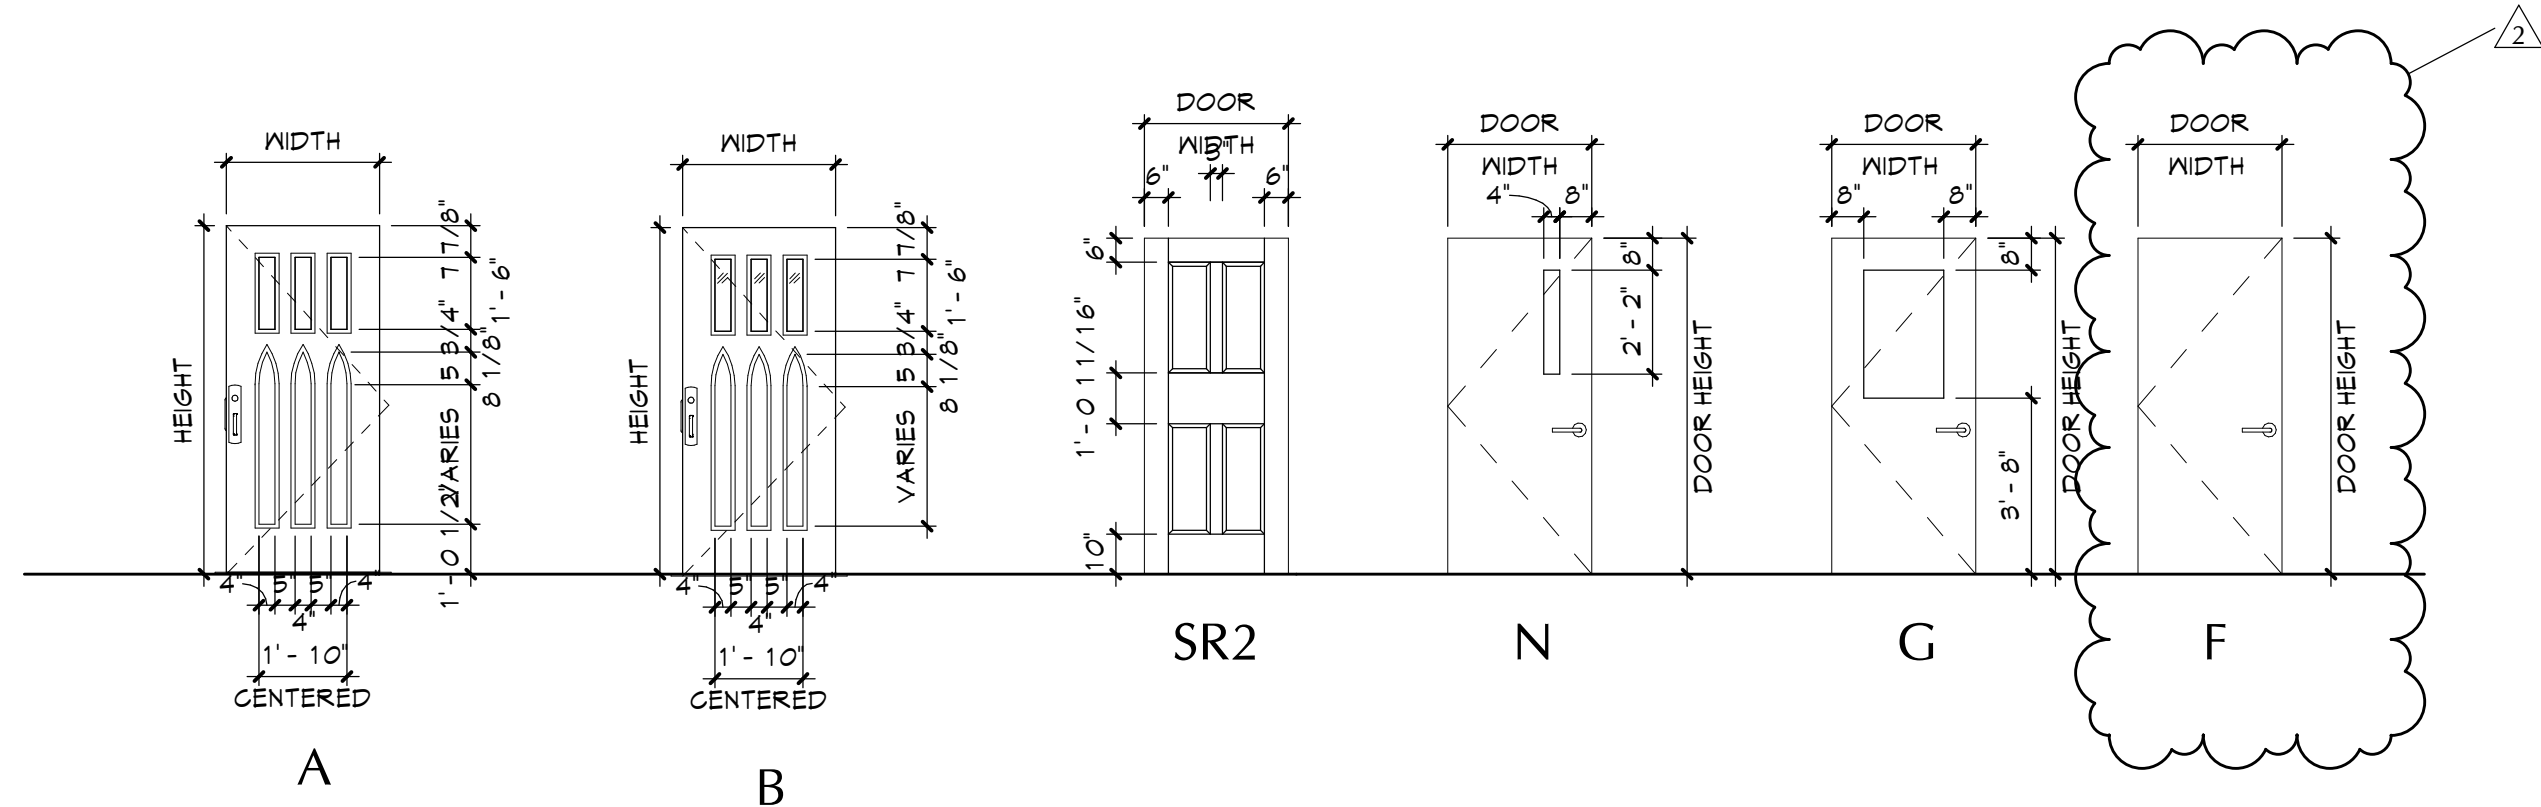

DOOR ELEVATIONS
1/4" = 1'-0"

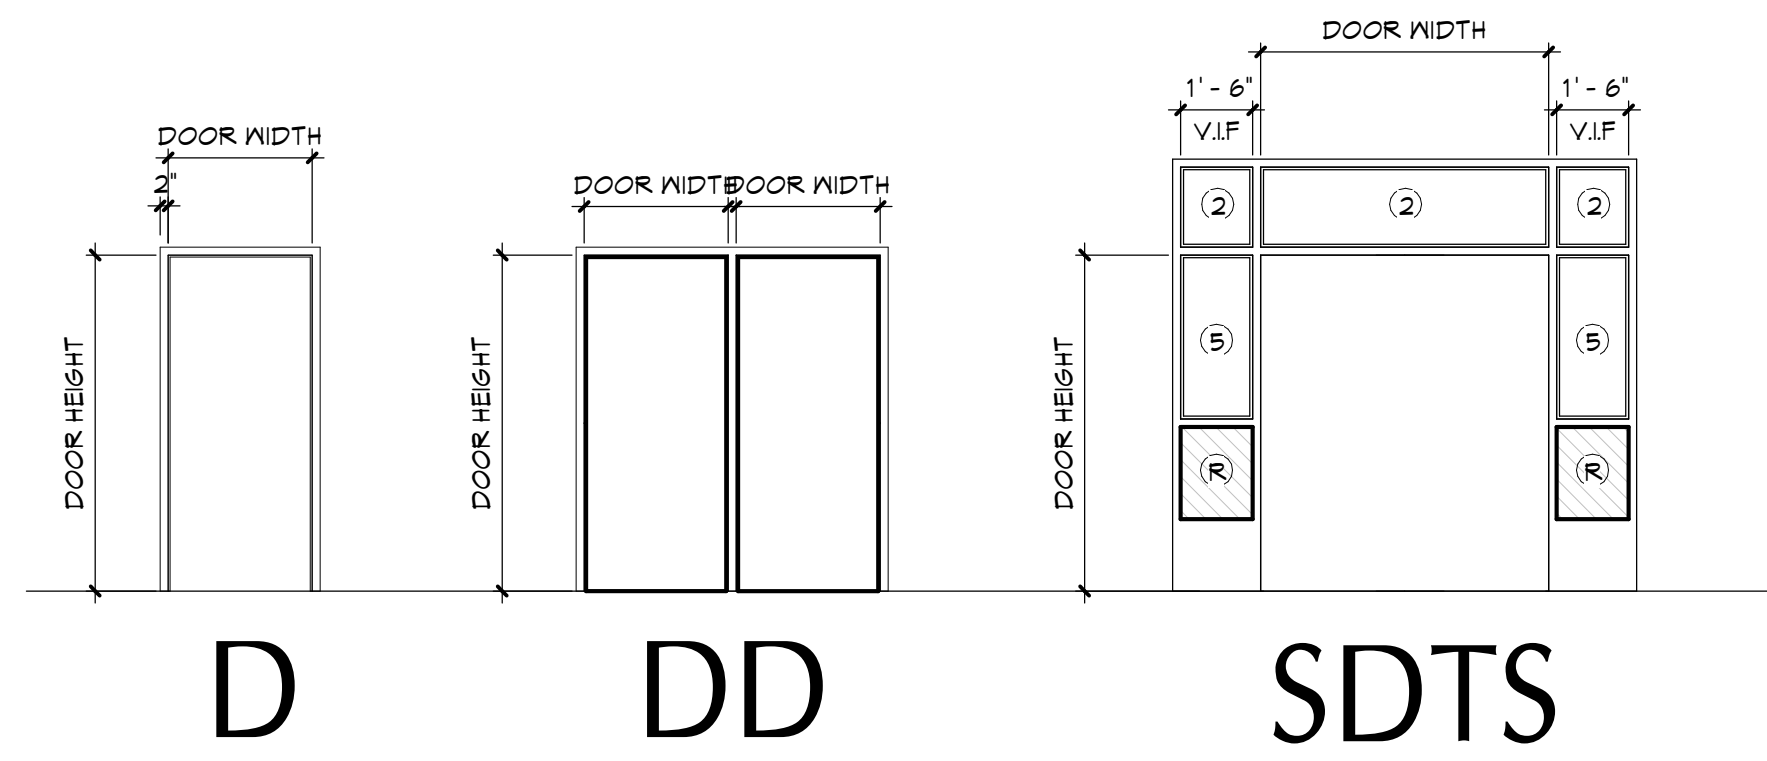

FRAME ELEVATIONS
1/4" = 1'-0"

DOOR SCHEDULE ALL FLOORS																							
DOOR NUMBER	DOOR					WIDTH	DOOR					FRAME TYPE	FRAME					REMARKS	DOOR NUMBER				
	FROM	FROM	TO	TO	QUANTITY		HEIGHT	THICKNESS	TYPE	MATERIAL	FINISH		MATERIAL	FINISH	HEAD DETAIL	JAMB DETAIL	SILL DETAIL			LABEL (MIN)	GLAZING	HARDWARE	MAG HOLD-OPEN
8	160	CAFETERIA/RECREATION		EXTERIOR	PR	6'-0"	6'-8"	1 3/4"	B	EXST	EXST	D	EXST	PT	4/A900	3/A900	1/A900	-	-	-	REINSTALL SALVAGED & PROTECTED DOOR, FRAME AND HARDWARE - PAINT FRAME	8	
9	162	VESTIBULE		EXTERIOR	PR	6'-2"	6'-8"	1 3/4"	A	EXST	EXST	D	EXST	PT	4/A900	3/A900	1/A900	-	-	-	REINSTALL SALVAGED & PROTECTED DOOR, FRAME AND HARDWARE - PAINT FRAME	9	
145A	145A	STORAGE	145	WEIGHT ROOM	PR	2'-7 1/2"	5'-3 1/2"	1 3/4"	F	WD	FF	D	HM	PT	4/A900	3/A900	2/A900	-	14.0	-		145A	
146A	146	BAND CLASSROOM	146A	STORAGE	1	3'-0"	6'-7"	1 3/4"	F	WD	FF	D	HM	PT	4/A900	3/A900	2/A900	-	16.0	-		146A	
146B	146	BAND CLASSROOM	145	WEIGHT ROOM	1	3'-0"	7'-0"	1 3/4"	F	WD	FF	D	HM	PT	4/A900	3/A900	2/A900	-	15.0	-		146B	
162A	160	CAFETERIA/RECREATION	162	VESTIBULE	PR	3'-0"	6'-8"	1 3/4"	G	WD	FF	DD	HM	PT	4/A900	3/A900	2/A900	90	17.0	-		162A	
C2	162	VESTIBULE	C2	STAIR	PR	3'-0"	7'-0"	1 3/4"	G	WD	FF	SDTS	HM	PT	4/A900	3/A900	2/A900	90	18.0	YES	-	SECURITY GLAZING	C2
C107C	C102	CORRIDOR	160	CAFETERIA/RECREATION	PR	3'-0"	7'-0"	1 3/4"	SR2	EXST	EXST	D2	EXST	PT	4/A900	3/A900	2/A900	20	-	-	-	REINSTALL SALVAGED & PROTECTED DOOR, FRAME AND HARDWARE - PAINT FRAME	C107C
Grand total: 8																							

DOOR & FRAME GENERAL NOTES
1. REFER TO SHEET 600.1 FOR ADDITIONAL GENERAL NOTES. 2. DIMENSIONS ARE SHOWN FOR REFERENCE. VERIFY ALL DIMENSIONS IN FIELD. 3. REFER TO PLANS AND SCHEDULE FOR INDICATION OF EXISTING FRAMES TO REMAIN.
DOOR LITE, GLAZING & PANEL TYPES
① INSULATED GLAZING UNIT ② FIRE-PROTECTION-RATED GLAZING. RATING BASED ON WALL OR DOOR RATING ③ INSULATED SECURITY GLAZING UNIT ④ SECURITY GLAZING ⑤ FIRE-PROTECTION-RATED SECURITY GLAZING. RATING BASED ON WALL OR DOOR RATING ⑥ FIRE-PROTECTION-RATED PANEL. RATING BASED ON DOOR RATING

19 Front St., Newburgh, New York 12550-7601
845.561.3179 www.csarchllc.com

CSARCH

City of New Rochelle
Isaac E Young Middle School
Emergency Storm Project

Project Title

NO.	DATE	DESCRIPTION
1	02-08-2022	ARCHITECTURAL SET ADDENDUM #1

Drawn By:	MS
Checked By:	MZ
Proj. #:	66-11-00-81-0-003-017
CSArch Proj. #:	188-2203.00
Issued for Bid:	06-17-2022

Sheet Title

DOOR
SCHEDULE,
ELEVATIONS,
AND DETAILS

Sheet No.

IEYMS
A900

CONSTRUCTION DOCUMENTS