

Bid Addendum No. 1

October 25, 2024 Valley Central School District 2023 Capital Project – Phase 1 CSArch Project No. 187-2302.01 SED Control No. Varies

This Bid Addendum No. 1 forms part of the Contract Documents and modifies the original bidding documents dated October 18, 2024. Bid Addendum No. 1 consists of (4) cover sheet pages, (8) specification sections, (27) full size 30"x42" drawing sheets, and responses to bidder requests for information.



Architect's Seal

GENERAL INFORMATION

1. Bid Addendum No. 1 was issued to bidders on October 25, 2024.

REVISIONS TO THE PROJECT MANUAL

- 1. **DELETE** <u>original</u> specification section 000110 Table of Contents. **REPLACE** with the <u>attached revised</u> specification section 000110 Table of Contents.
- 2. ADD attached new specification section 003100.01 Berea Elementary School Phasing Diagrams for Phase 1
- 3. **ADD** attached <u>new</u> specification section 003100.02 East Coldenham Elementary School Phasing Diagrams for Phase 1
- 4. **ADD** attached <u>new</u> specification section 003100.03 Maybrook Alternative Learning Center Phasing Diagrams for Phase 1
- 5. **ADD** attached <u>new</u> specification section 003100.04 Montgomery Elementary School Phasing Diagrams for Phase 1
- 6. ADD attached new specification section 003100.05 Valley Central High School Phasing Diagrams for Phase 1
- 7. ADD attached new specification section 003100.06 Valley Central Middle School Phasing Diagrams for Phase 1
- 8. **DELETE** <u>original</u> specification section 007216.01 AIA A232 General Conditions of the Contract for Construction. **REPLACE** with the <u>attached revised</u> specification section 007216.01 AIA A232 General Conditions of the Contract for Construction.

REVISIONS TO THE CONSTRUCTION DRAWINGS

VOLUME 01 OF 08 - BEREA ELEMENTARY SCHOOL

- 1. **DELETE** original drawing sheet BES C130. **REPLACE** with attached revised drawing sheet BES C130.
- 2. **DELETE** original drawing sheet BES AD111. **REPLACE** with attached revised drawing sheet BES AD111.
- 3. **DELETE** original drawing sheet BES A111. **REPLACE** with attached revised drawing sheet BES A111.
- 4. **DELETE** original drawing sheet BES A901. **REPLACE** with attached revised drawing sheet BES A901.



Bid Addendum 1 | Page 2 CSArch Project No. 1187-2302.01 Valley Central School District 2023 Capital Project – Phase 1

VOLUME 02 OF 08 - EAST COLDENHAM ELEMENTARY SCHOOL

- 1. **DELETE** original drawing sheet ECES AD111. **REPLACE** with attached revised drawing sheet ECES AD111.
- 2. **DELETE** original drawing sheet ECES A111. **REPLACE** with attached revised drawing sheet ECES A111.
- 3. **DELETE** original drawing sheet ECES A901. **REPLACE** with attached revised drawing sheet ECES A901.

VOLUME 03 OF 08 - MONTGOMERY ELEMENTARY SCHOOL

- 1. **DELETE** <u>original</u> drawing sheet MES G111. **REPLACE** with <u>attached revised</u> drawing sheet MES G111.
- 2. **DELETE** original drawing sheet MES A111. **REPLACE** with attached revised drawing sheet MES A111.
- 3. **DELETE** <u>original</u> drawing sheet MES A901. **REPLACE** with <u>attached revised</u> drawing sheet MES A901.

VOLUME 04 OF 08 - MAYBROOK ALTERNATIVE LEARNING CENTER

- 1. **DELETE** original drawing sheet MAY G111. **REPLACE** with attached revised drawing sheet MAY G111.
- 2. **DELETE** original drawing sheet MAY A121. **REPLACE** with attached revised drawing sheet MAY A121.
- 3. **DELETE** original drawing sheet MAY A901. **REPLACE** with attached revised drawing sheet MAY A901.

VOLUME 05 OF 08 - VALLEY CENTRAL HIGH SCHOOL

- 1. **DELETE** <u>original</u> drawing sheet VCHS A111. **REPLACE** with <u>attached revised</u> drawing sheet VCHS A111.
- 2. **DELETE** <u>original</u> drawing sheet VCHS A401. **REPLACE** with <u>attached revised</u> drawing sheet VCHS A401.
- 3. **DELETE** original drawing sheet VCHS A802. **REPLACE** with attached revised drawing sheet VCHS A802.
- 4. **DELETE** original drawing sheet VCHS A901. **REPLACE** with attached revised drawing sheet VCHS A901.

VOLUME 06 OF 08 - VALLEY CENTRAL MIDDLE SCHOOL

- 1. **DELETE** original drawing sheet VCMS G111. **REPLACE** with attached revised drawing sheet VCMS G111.
- 2. **DELETE** <u>original</u> drawing sheet VCMS AD112 in its entirety.
- 3. **DELETE** original drawing sheet VCMS AD113 in its entirety.
- 4. ADD attached new drawing sheet VCMS A111.
- 5. **ADD** <u>attached new</u> drawing sheet VCMS A201.
- 6. ADD attached new drawing sheet VCMS A202.
- 7. ADD attached new drawing sheet VCMS A811.
- 8. ADD attached new drawing sheet VCMS A901.



Bid Addendum 1 | Page 3 CSArch Project No. 1187-2302.01 Valley Central School District 2023 Capital Project – Phase 1

VOLUME 07 OF 08 - WALDEN ELEMENTARY SCHOOL

- 1. **DELETE** original drawing sheet WES G111. **REPLACE** with attached revised drawing sheet WES G111.
- 2. **DELETE** original drawing sheet WES G121. **REPLACE** with attached revised drawing sheet WES G121.
- 3. **DELETE** original drawing sheet WES A111. **REPLACE** with attached revised drawing sheet WES A111.
- 4. **DELETE** original drawing sheet WES A901. **REPLACE** with attached revised drawing sheet WES A901.

VOLUME 08 OF 08 – ADMINISTRATION BUILDING

1. N/A

RESPONSES TO BIDDER REQUESTS FOR INFORMATION

- 1. On REV, it shows 3 Contracts; Electrical, General/Abatement, and Mechanical/Plumbing. Spec Book shows 5 Contracts. Please clarify.
 - a. <u>Response:</u> There are (3) three Bid Forms in the Project Manual. (3) three Prime Contracts are referenced in the Advertisement for Bid. The intent was to have (3) three Prime Contracts, not (5) five. Table of Contents specification section will be updated via Bid Addendum #1 to remove the additional Prime Contracts referenced.
- 2. For the VCMS project, we did not come across the architectural drawings (specifically A111, A201, A202, A811, and A901).
 - a. <u>Response:</u> The missing drawings will be added via Bid Addendum #1, which is scheduled to be published on 10/25.
- 3. Could you please provide the anticipated schedule for all locations? Is summer 2025 the target timeframe?
 - a. <u>Response:</u> Project schedule to be provided in Bid Addendum #2. Project phasing diagrams will be provided in Bid Addendum #1.
- 4. Is the deck heights for each school/location available, or should we assume a maximum height not exceeding 14 feet?
 - a. <u>Response:</u> Floor-to-deck heights at each building does not exceed 14'-0".
- 5. What is the deck height for ECES Sheets A111 and A112?
 - a. Response: The floor-to-deck heights for the first floor of Berea Elementary School is approximately 11'-0".
- 6. On Sheet BES A111, at the Nurse's Suite, are the two existing walls to be laminated with sheetrock?
 - a. Response: Scope in Nurses Suite to be clarified in Bid Addendum #1.



Bid Addendum 1 | Page 4 CSArch Project No. 1187-2302.01 Valley Central School District 2023 Capital Project – Phase 1

- 7. What is the deck height for Sheet ECES A111?
 - a. <u>Response:</u> The floor-to-deck heights for the first floor of East Coldenham Elementary School is approximately 11'-0".
- 8. Could you clarify where detail ECES 6/A821 is intended to be utilized?
 - a. <u>Response:</u> Sheet referenced in RFI does no exist in Drawing Set for East Coldenham Elementary School.
- 9. What is the deck height for Sheet MES A111?
 - a. <u>Response:</u> The floor-to-deck heights for the first floor of Montgomery Elementary School is approximately 12'-0".
- 10. What are the deck heights for the 1st and 2nd floors at VCHS?
 - a. <u>Response:</u> The floor-to-deck heights for the first floor and second floor of Valley Central High School is approximately 11'-0".
- 11. On Sheet VCHS A802, do rooms #141A and #142A receive a gypsum board soffit similar to room #140A?
 - a. Response: Keynotes for Rooms 141A and 142A will be updated via Bid Addendum #1.

END OF BID ADDENDUM NO. 1

SECTION 000110 - TABLE OF CONTENTS

VOLUME 01 OF 03 - DIVISION 00 - 02

PROCUREMENT AND CONTRACTING REQUIREMENTS

Division 00 -- Procurement and Contracting Requirements

000010 - Certifications Page

000011 - Certifications Page

000012 - Certifications Page

000110 - Table of Contents

000115 - List of Drawing Sheets

001113 - Advertisement for Bids

002113 - Instructions to Bidders

003100.01 - Berea Elementary School Phasing Plans - Phase 1

003100.02 - East Coldenham Elementary School Phasing Plans - Phase 1

003100.03 - Maybrook Alternative Learning Center Phasing Plans - Phase 1

003100.04 - Montgomery Elementary School Phasing Plans - Phase 1

003100.05 - Valley Central High School Phasing Plans - Phase 1

003100.06 - Valley Central Middle School Phasing Plans - Phase 1

004101 - Bid Form Contract No. 1-01 - General and Abatement Construction (GAC)

004102 - Bid Form Contract No. 1-02 - Mechanical and Plumbing Construction (MPC)

004103 - Bid Form Contract No. 1-03 - Electrical Construction (EC)

004313 - AIA A310 Bid Bond

004333 - Proposed Products Form

004336 - Proposed Subcontractors Form

004513 - AIA A305 Contractor's Qualifications Statement

004519 - Certificate of Non-Collusion

1

004520 - Iran Divestment Act Certification

004543 - Corporate Resolutions

005216.01 - AIA A132 Owner/Contractor Agreement, Construction Manager As Advisor

006112 - AIA A312 Payment Bond

006113 - AIA A312 Performance Bond

006114 - AIA C106 Digital Data Licensing Agreement

006276.01 - AIA G732 Application And Certification For Payment, Construction Manager As Advisor

006276.02 - AIA G703 Continuation Sheet

006380 - Demonstration & Training Log

006519 - AIA G706 Contractor's Affidavit Of Payment Of Debts And Claims

006520 - AIA G706A Contractor's Affidavit Of Release Of Liens

006521 - AIA G707 Consent Of Surety To Final Payment

007216.01 - AIA A232 General Conditions Of The Contract For Construction, Construction Manager As Advisor

007343 - Prevailing Rate of Wages

008310 - Submittal Cover

008320 - Request for Information

SPECIFICATIONS

Division 01 -- General Requirements

011000 - Summary

011400 - Work Restrictions

011410 - NYSED 155.5 Regulations

012100 - Allowances

012200 - Unit Prices

012300 - Alternates

012600 - Contract Modification Procedures

012900	-	Payment	P	roced	lures
--------	---	---------	---	-------	-------

012973 - Schedule of Values

013100 - Project Management And Coordination

013150 - Safety And Health

013200 - Construction Progress Documentation

013300 - Submittal Procedures

014000 - Quality Requirements

014100 - Special Inspections And Structural Testing

014200 - References And Definitions

015000 - Temporary Facilities And Controls

016000 - Product Requirements

017300 - Execution

017310 - Cutting And Patching

017400 - Warranties

017700 - Closeout Procedures

017820 - Operations And Maintenance Data

017839 - Project Record Documents

017900 - Demonstration And Training

Division 02 -- Existing Conditions

023313 - Underground Utility Locator Service

024119 - Selective Structural Demolition And Shoring

VOLUME 02 OF 03 - DIVISION 03 - 34

Division 03 -- Concrete

033000 - Cast-In-Place Concrete

034500 - Precast Architectural Concrete

Division 04 -- Masonry

040110.01 - Masonry Cleaning

040120.63 - Brick Masonry Repair

040120.64 - Brick Masonry Repointing

042000 - Concrete Unit Masonry

042613 - Masonry Veneer

Division 05 -- Metals

051200 - Structural Steel Framing

055213 - Pipe And Tube Railings

Division 06 -- Wood, Plastics, and Composites

061053 - Miscellaneous Rough Carpentry

061600 - Sheathing

Division 07 -- Thermal and Moisture Protection

072100 - Thermal Insulation

072500 - Weather Barriers

072600 - Vapor Retarders

075323 - Ethylene-Propylene-Diene-Monomer (EPDM) Roofing

077200 - Roof Accessories

078413 - Penetration Firestopping

078446 - Fire-Resistive Joint Systems

079200 - Joint Sealants

Division 08 -- Openings

081113 - Hollow Metal Doors And Frames

081416 - Flush Wood Doors

083343 - Overhead Coiling Smoke Curtains

083453 - Security Doors

081113 - Hollow Metal Doors And Frames

085113 - Aluminum Windows

085653 - Security Windows

087100 - Door Hardware

087113 - Power Door Operators

088000 - Glazing

088813 - Fire-Resistant Glazing

088853 - Security Glazing

089119 - Fixed Louvers

Division 09 -- Finishes

090561.13 - Moisture Vapor Emission Control

092216 - Non-Structural Metal Framing

092900 - Gypsum Board

093013 - Ceramic Tiling

095113 - Acoustical Panel Ceilings

096513 - Resilient Base And Accessories

096519 - Resilient Tile Flooring

096813 - Tile Carpeting

099100 - Painting

Division 10 -- Specialties

101100 - Visual Display Units

101423 - Interior Panel Signage

102123 - Cubicle Curtains And Track

102641 - Bullet Resistant Panels

102800 - Toilet And Custodial Accessories

104416 - Fire Extinguishers And Cabinets

Division 11 -- Equipment

116833 - Tennis Court Equipment

Division 12 -- Furnishings

122413 - Roller Window Shades

123216 - Plastic Laminate-Clad Casework

123661 - Solid Surfacing Materials

124813 - Entrance Floor Mats And Frames

Division 13 -- Special Construction (NOT USED)

Division 14 -- Conveying Equipment (NOT USED)

Division 21 -- Fire Suppression (NOT USED)

Division 22 -- Plumbing

220500 - General Plumbing Requirements

220502 - Plumbing Demolition

220529 - Supports and Sleeves

220553 - Plumbing Identification

220719 - Piping Insulation

221000 - Plumbing Piping

221030 - Plumbing Specialties

221613 - Natural Gas Piping

223500 - DOMESTIC-WATER HEAT EXCHANGERSDomestic Water Heat Exchangers

224200 - Plumbing Fixtures

Division 23 -- Heating, Ventilating, and Air-Conditioning (HVAC)

230500 - General Mechanical Requirements

- 230502 Mechanical Demolition
- 230513 Common Motor Requirements
- 230515 Variable Frequency Drives
- 230529 Supports and Sleeves
- 230548 Vibration Controls for HVAC
- 230553 Mechanical Identification
- 230593 Testing, Adjusting, and Balancing
- 230713 Duct Insulation
- 230719 Pipe Insulation
- 230800 Commissioning of HVAC Systems
- 230900 Building Automation System
- 230993 Sequence of Operations
- 232113 Hydronic Piping
- 232123 HVAC Pumps
- 232513 Water Treatment for Closed-Loop Hydronic Systems
- 233113 Metal Ductwork
- 233300 Air Duct Accessories
- 233423 Power Ventilators
- 233713 Registers, Grilles and Diffusers
- 235133 Insulated Sectional Chimneys
- 235216 Condensing Boilers
- 236423 Air-Cooled, Scroll Water Chillers
- 237232 Packaged Energy Recovery Ventilators
- 237313 Indoor Air Handling Units
- 237401 Packaged Rooftop Heating and Cooling Units
- 238129 Variable Refrigerant-Flow HVAC Systems
- 238216 Ducted Heating Coils

- 238223 Unit Ventilators
- 238236 Finned-Tube Radiation Heaters
- 238241 Unit Heaters
- Division 25 -- Integrated Automation (NOT USED)
- Division 26 -- Electrical
- 260500 General Electrical Requirements
- 260519 Low-Voltage Electrical Power Conductors And Cables
- 260526 Grounding And Bonding For Electrical Systems
- 260529 Hangers And Supports For Electrical Systems
- 260533 Raceways And Boxes For Electrical Systems
- 260534 Manholes And Handholes
- 260543 Underground Ducts And Raceways For Electrical Systems
- 260544 Sleeves And Sleeve Seals For Electrical Raceways And Cabling
- 260553 Identification For Electrical Systems
- 260923 Lighting Control Devices
- 262416 Panelboards
- 262726 Wiring Devices
- 262816 Enclosed Switches And Circuit Breakers
- 265119 LED Interior Lighting
- 265219 Emergency And Exit Lighting
- Division 27 -- Communications (NOT USED)
- Division 28 -- Electronic Safety and Security
- 283100 Fire Detection And Alarm
- Division 31 -- Earthwork
- 312000 Excavation and Fill

312319 - Dewatering

312513 - Erosion and Sediment Controls

Division 32 -- Exterior Improvements

321216 - Asphalt Paving

321823 - Running Track Surfacing

321824 - Tennis Court Surfacing

323113 - Chain Link Fences And Gates

329200 - Topsoil and Seeding

Division 33 -- Utilities

334100 - Storm Utility Drainage Piping

Division 34 -- Transportation (NOT USED)

VOLUME 03 OF 03 - APPENDIX

APP 1A - Limited Hazardous Materials Pre-Renovation Survey Report - Berea Elementary School

APP 1B - Limited Hazardous Materials Pre-Renovation Survey Report - East Coldenham Elementary School

APP 1C - Limited Hazardous Materials Pre-Renovation Survey Report - Maybrook Alternative Learning Center (formally Maybrook Elementary School)


APP 1D - Limited Hazardous Materials Pre-Renovation Survey Report - Montgomery Elementary School

APP 1E - Limited Hazardous Materials Pre-Renovation Survey Report - Valley Central High School

APP 1F - Limited Hazardous Materials Pre-Renovation Survey Report - Walden Elementary School

APP 1G - Limited Hazardous Materials Pre-Renovation Survey Report - Valley Central Middle School

END OF SECTION

 

Sequence #1 Main office / classroom swap

December 2024- June 2025

Night Shift 4-11PM

-Infrastructure above ceilings including New mechanical piping & controls, lighting circuits, Fire alarm, PA system, clock system, Misc. electrical, New plumbing, valves and insulation.

Sequence #2 Main office / classroom swap

July-August 2025

Day shift 7am-3:30pm

- -<u>Demo</u> ceilings, casework, floors, walls, front entrance,, wall openings, old MEP systems.
- -Build new walls, front entrance, storefront, bathroom, install new mechanical, plumbing rough and finishes, new floors, casework, ceilings, lighting, District furniture
- -Build exterior brick repairs
- *District removes all furniture

CONFERENCE

STORAGE


SENSORY RM

SP<u>EEC</u>H


COMPUTER LAB

WC WC

Berea Elementary

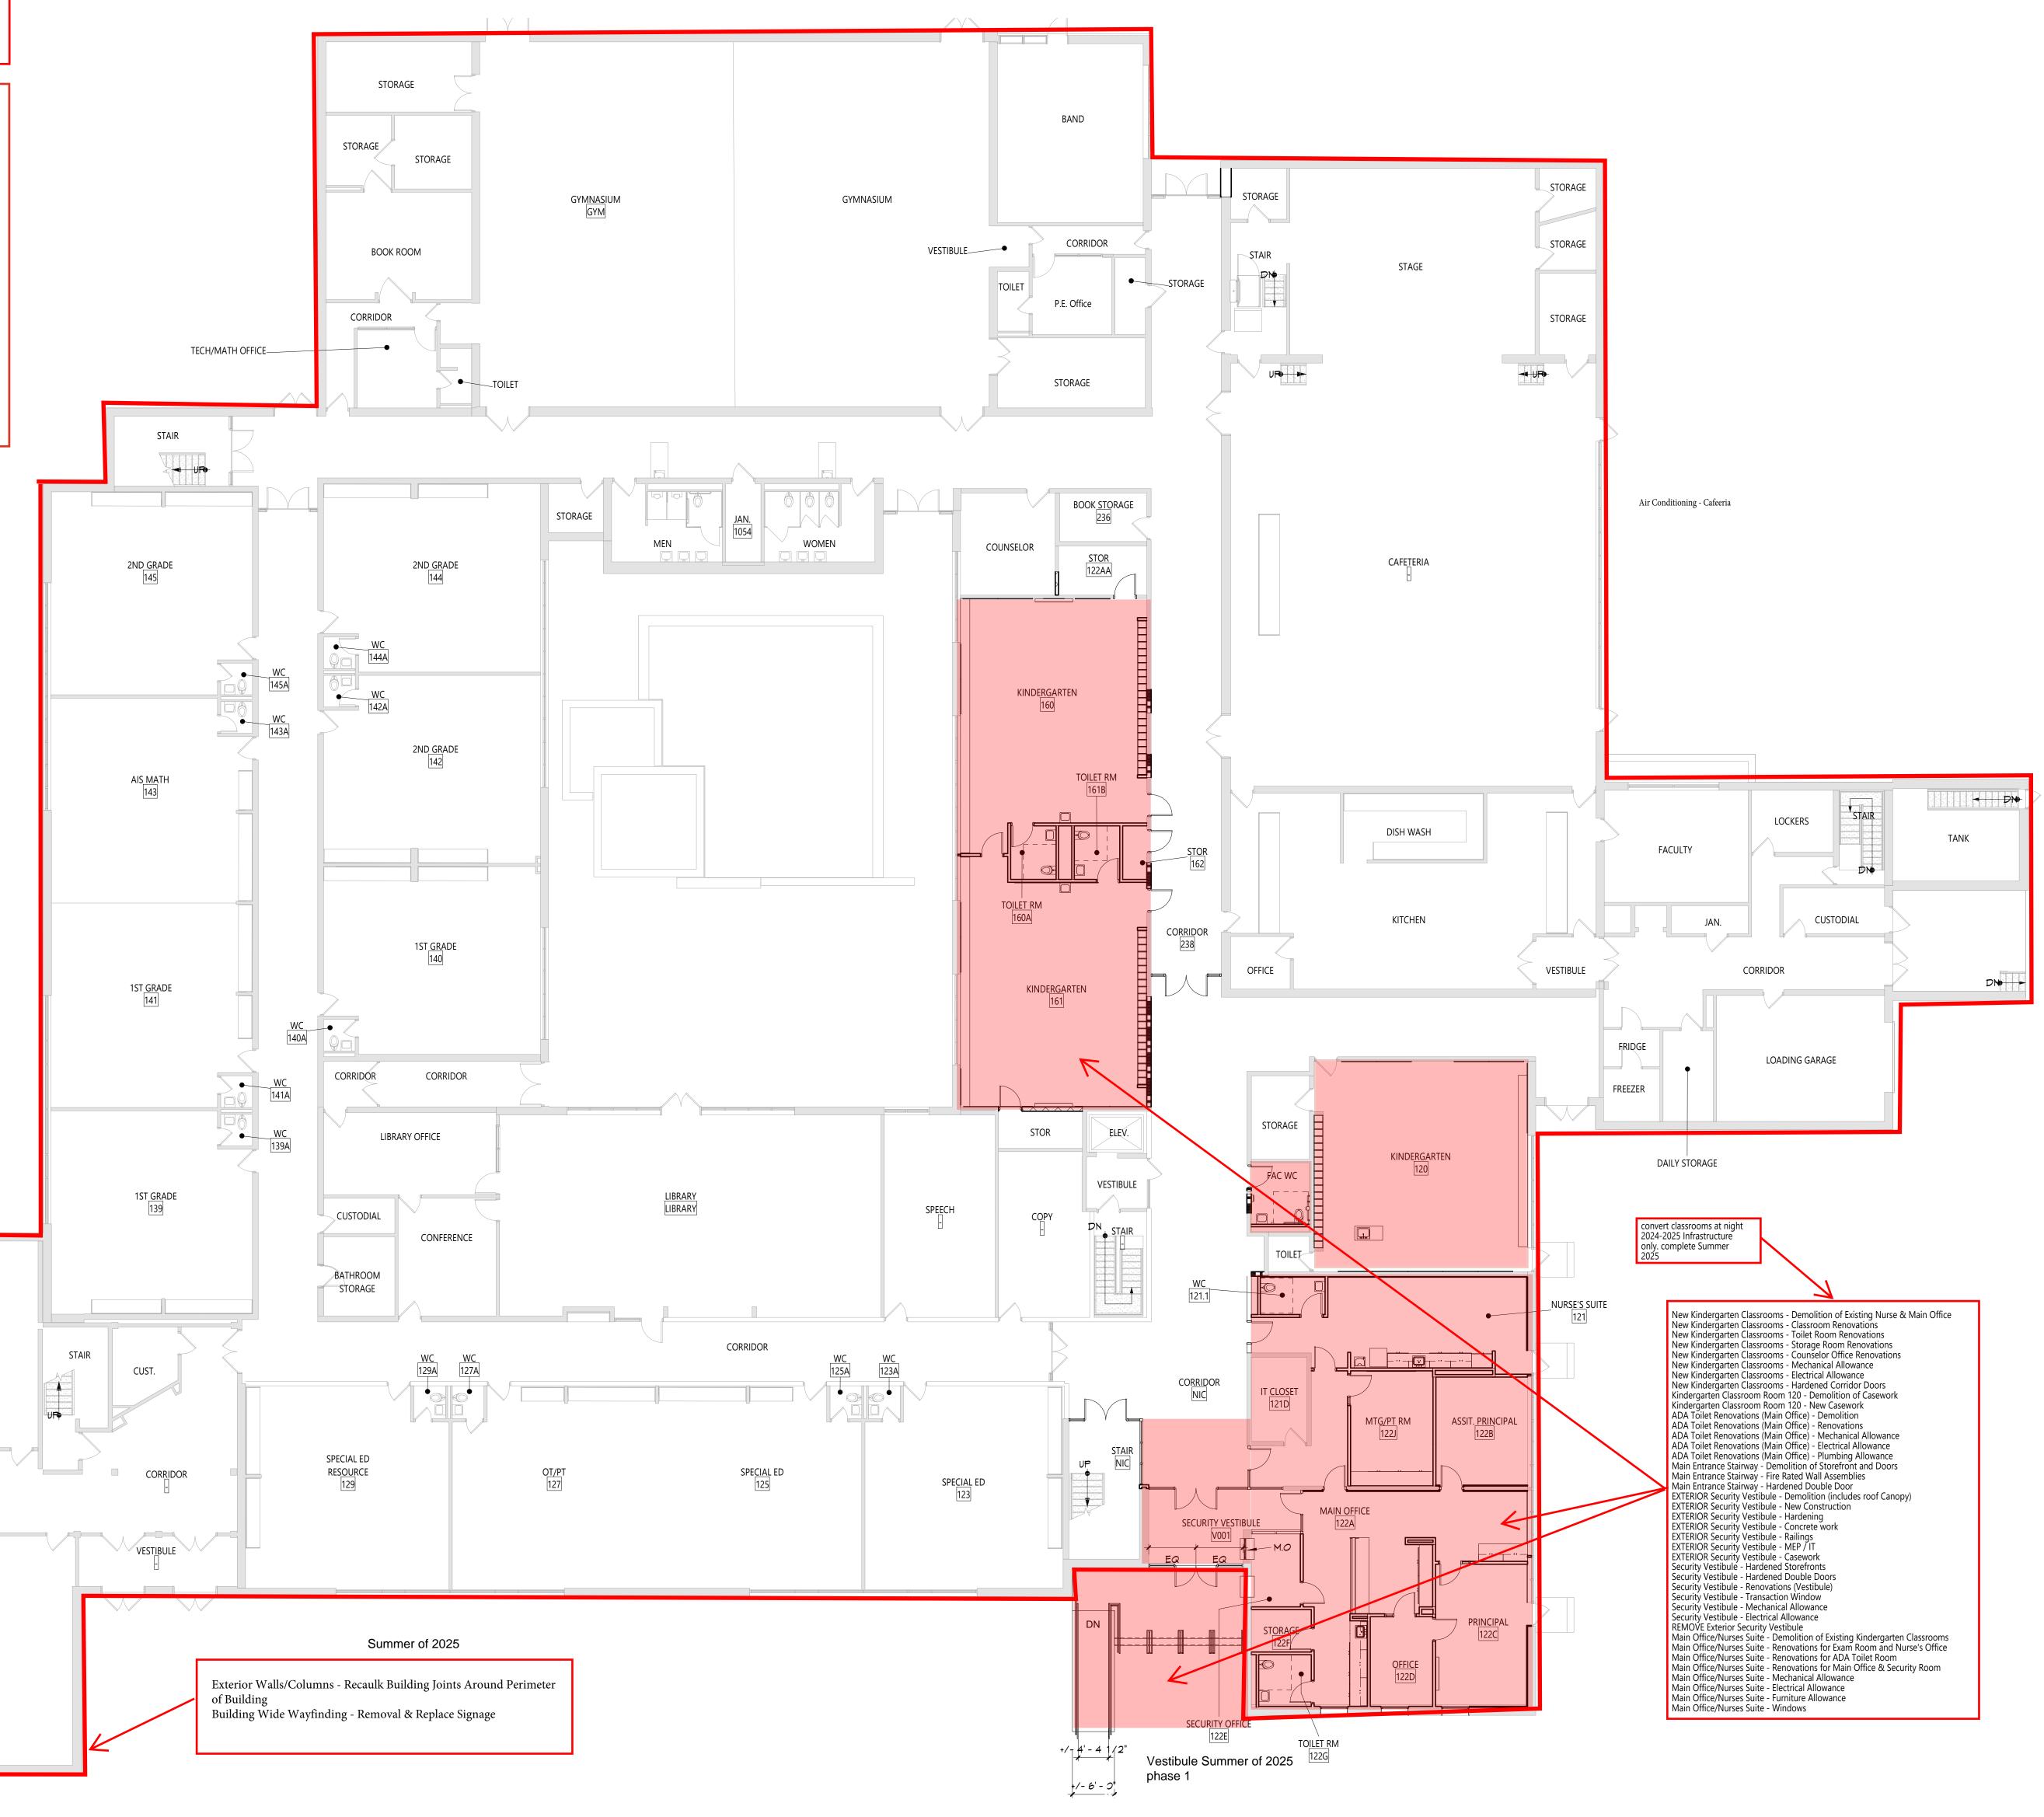

No work summer 2026

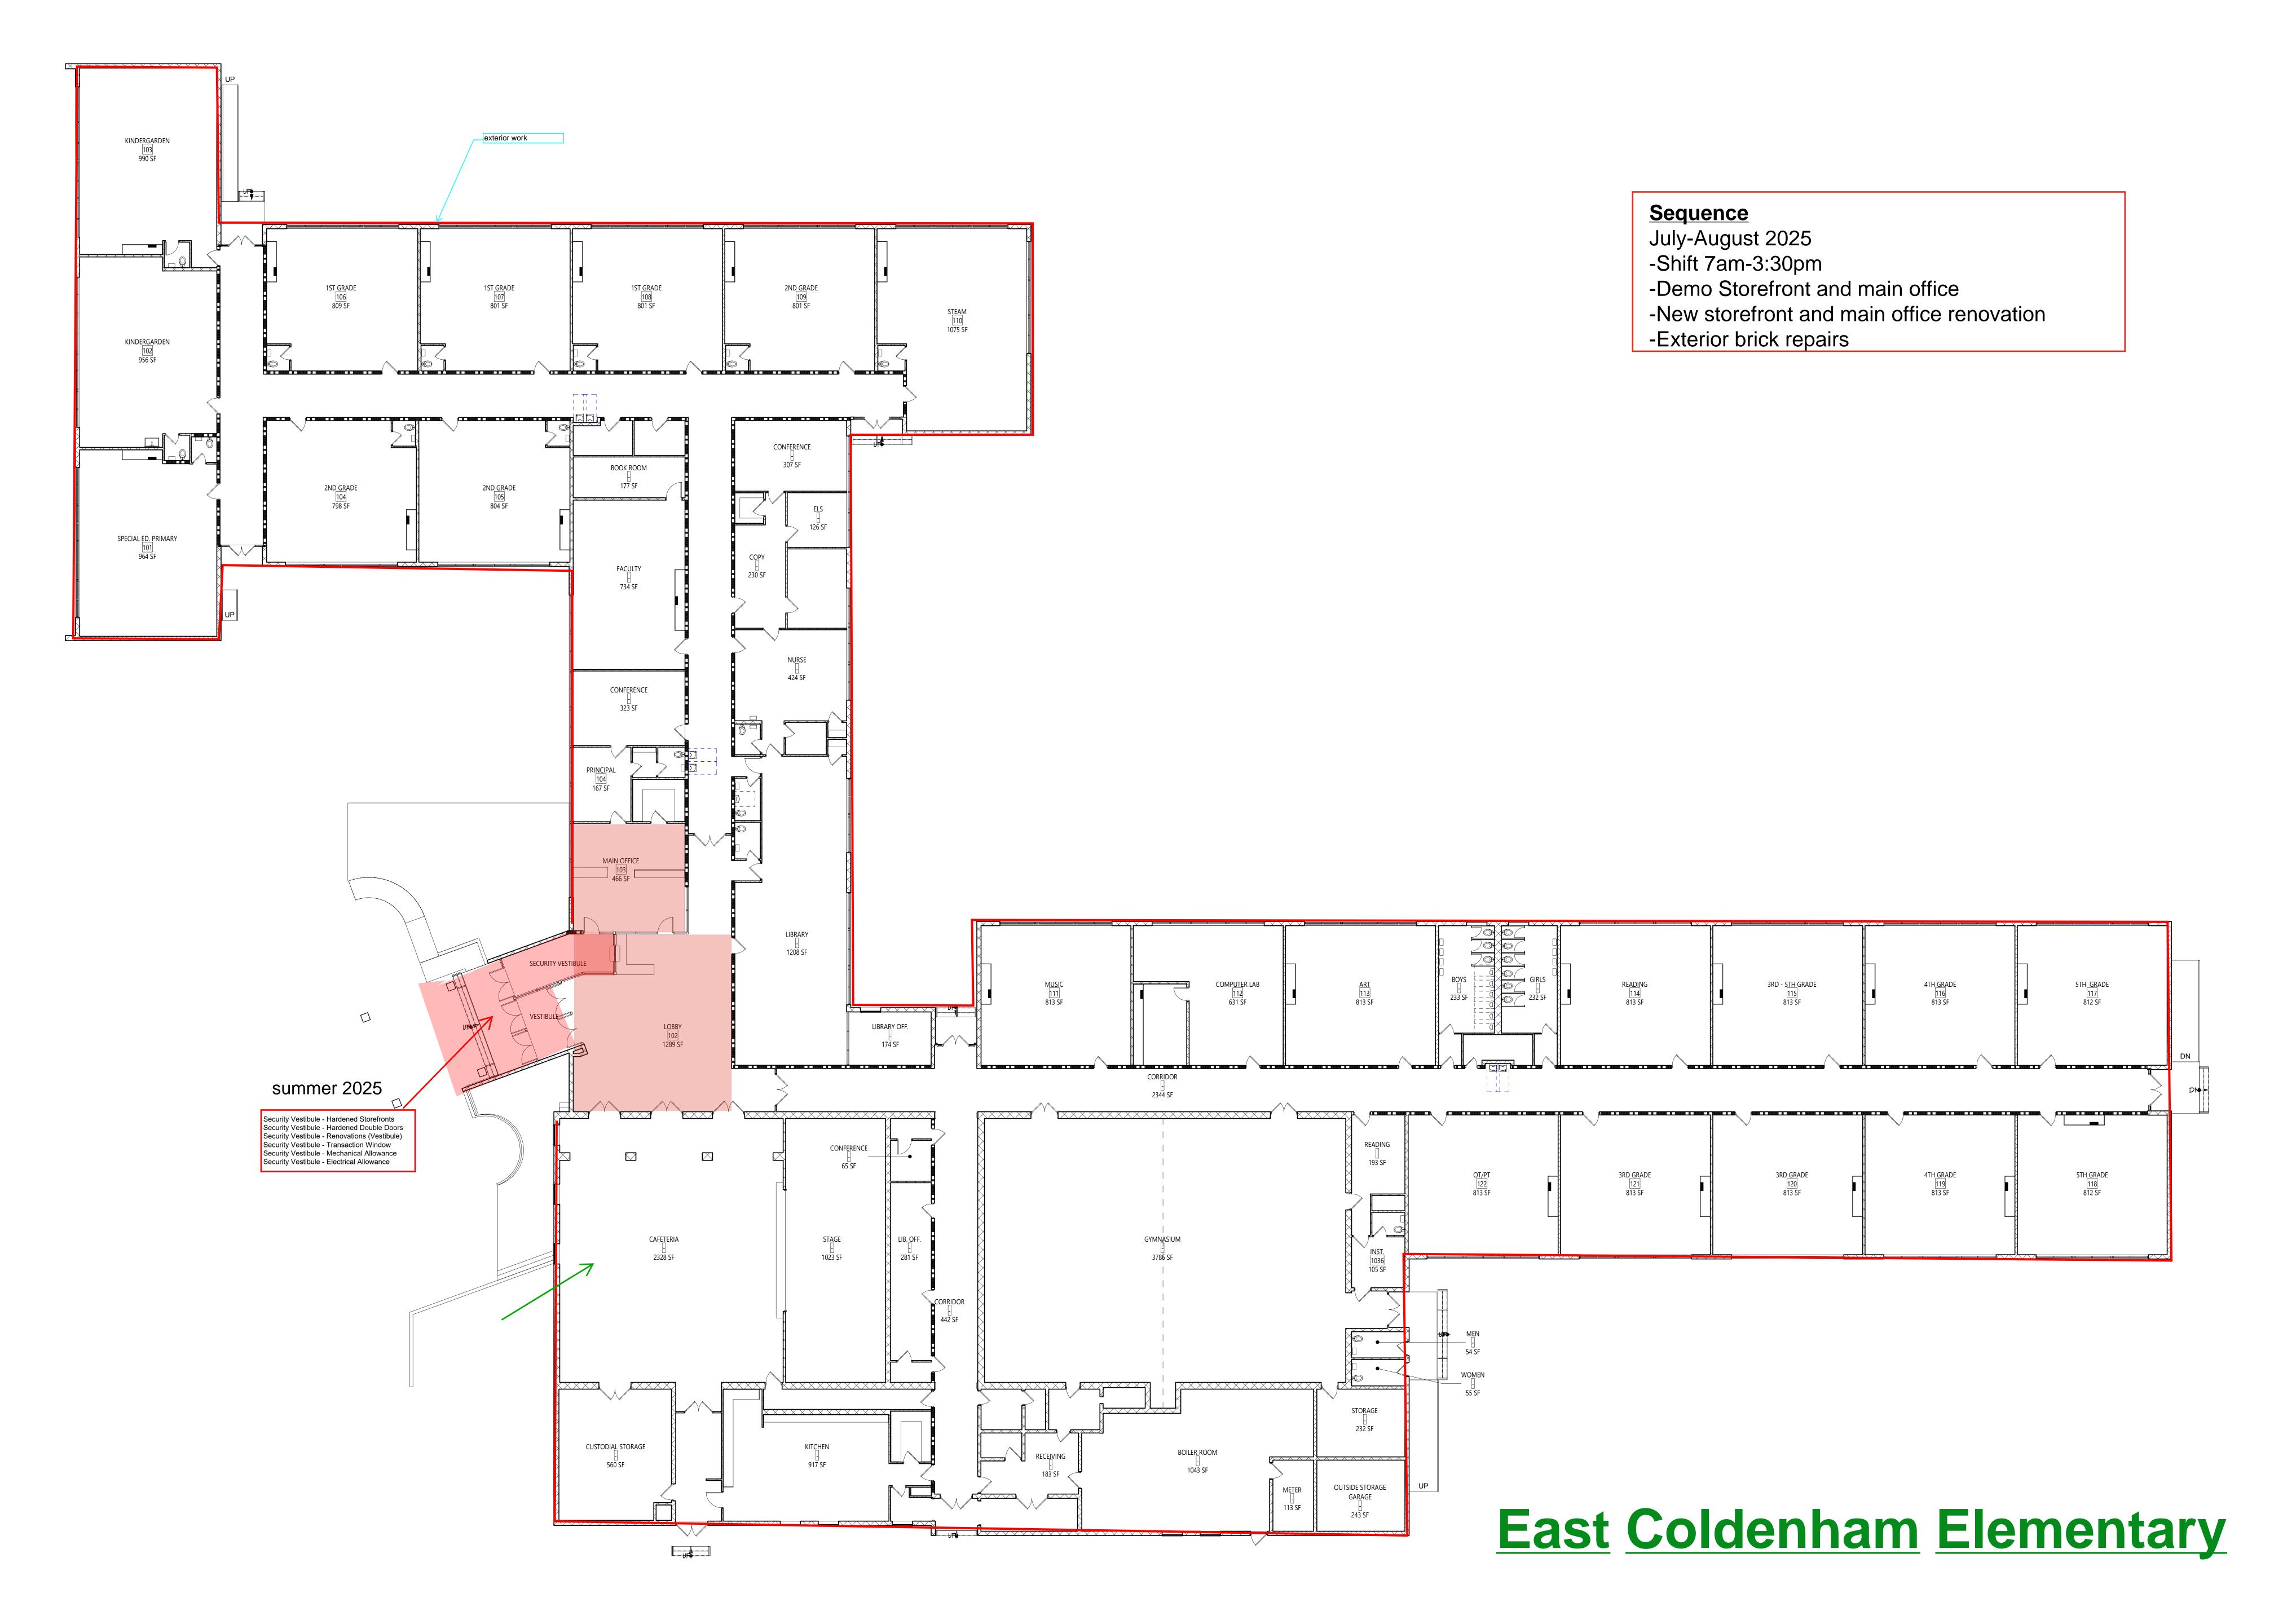


PHASE 1: Summer 2025
-Secure Vestibule
-Misc Brick repairs CLAS<u>SR</u>OOM STORAGE 23A CLASSROOM 21 AUDITORIUM/GYM -

<u>Sequence</u>

- July-August 2025
- -Demo Storefront and main office (phase 1)
- -New storefront and main office A.M.E.P (phase1)
- -Exterior Brick repairs (Phase 1)


Montgomery Elementary

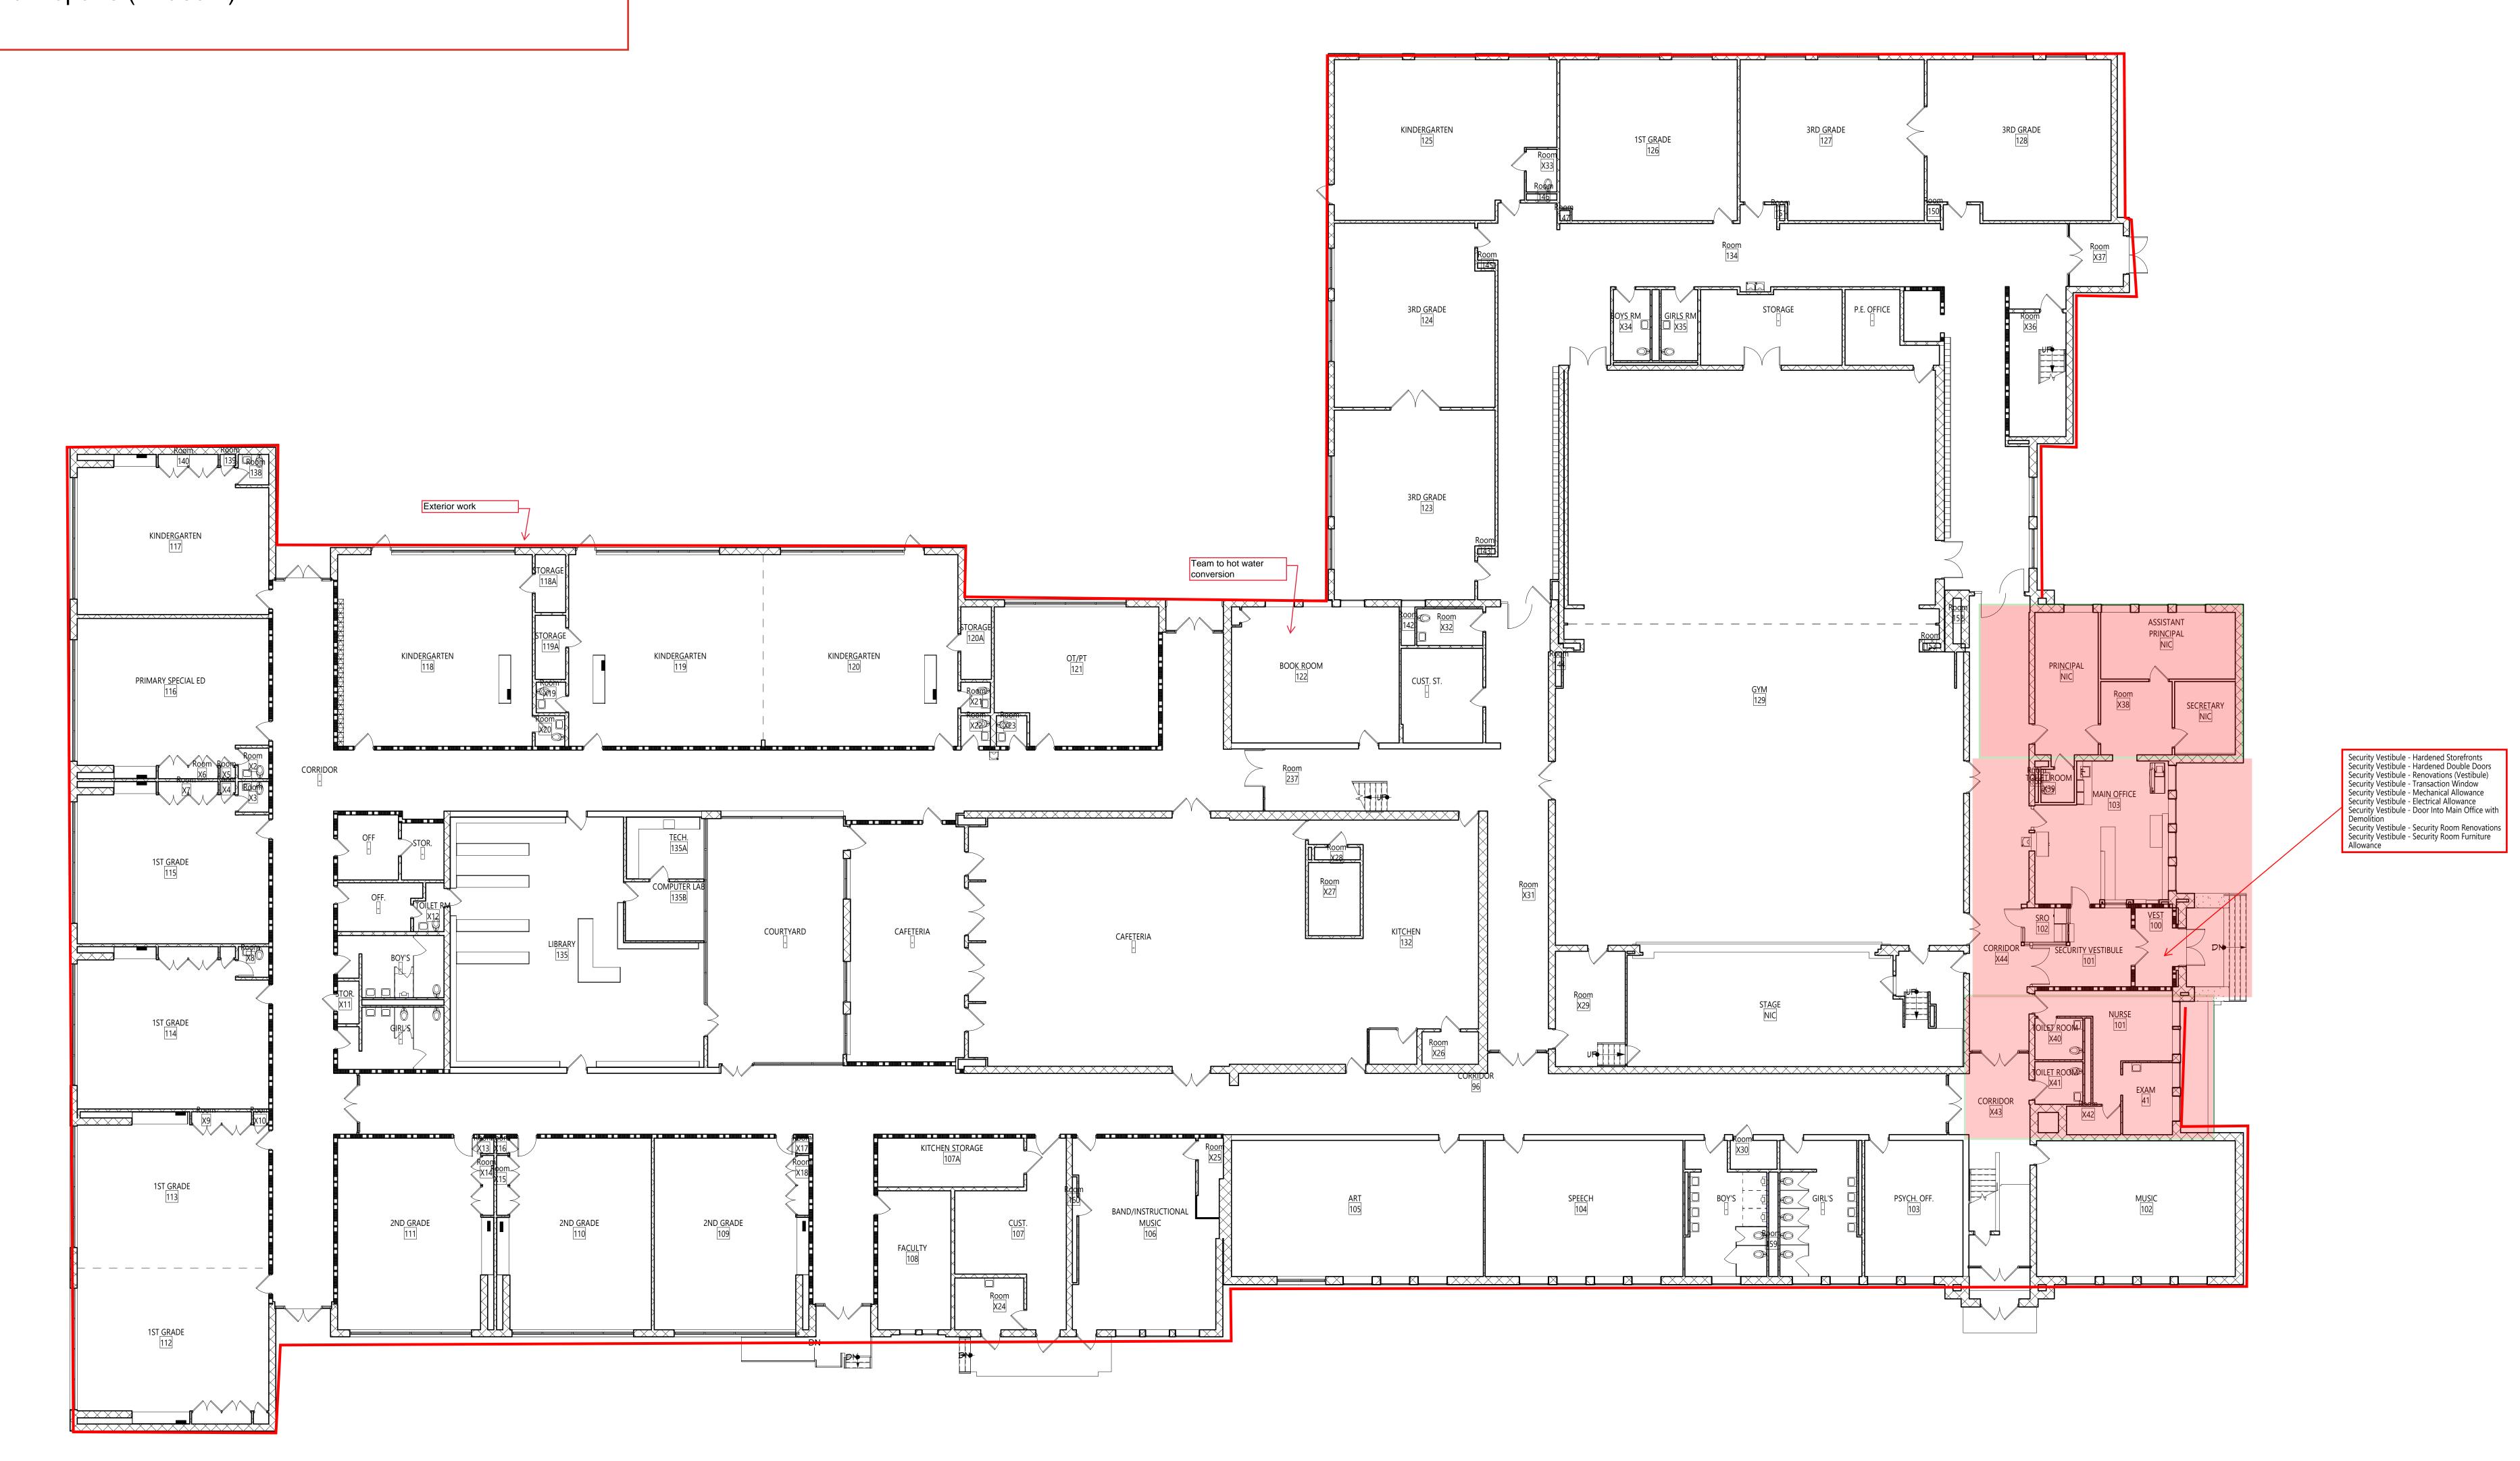

Montgomery Elementary



VC HighSchool

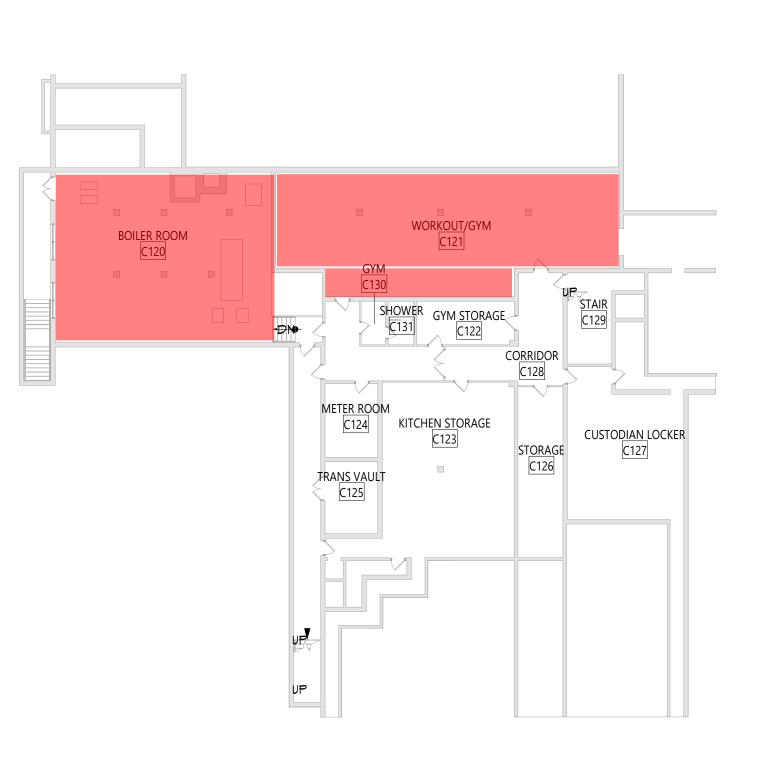


Sequence #2 (assuming no abatement) Phase 1

May-August 2025
Shift 7am-3:30pm
Demo boilers
Replace boilers

Sequence #3 Phase 1

July-August 2025 Shift 7am-3:30pm Replace lighting

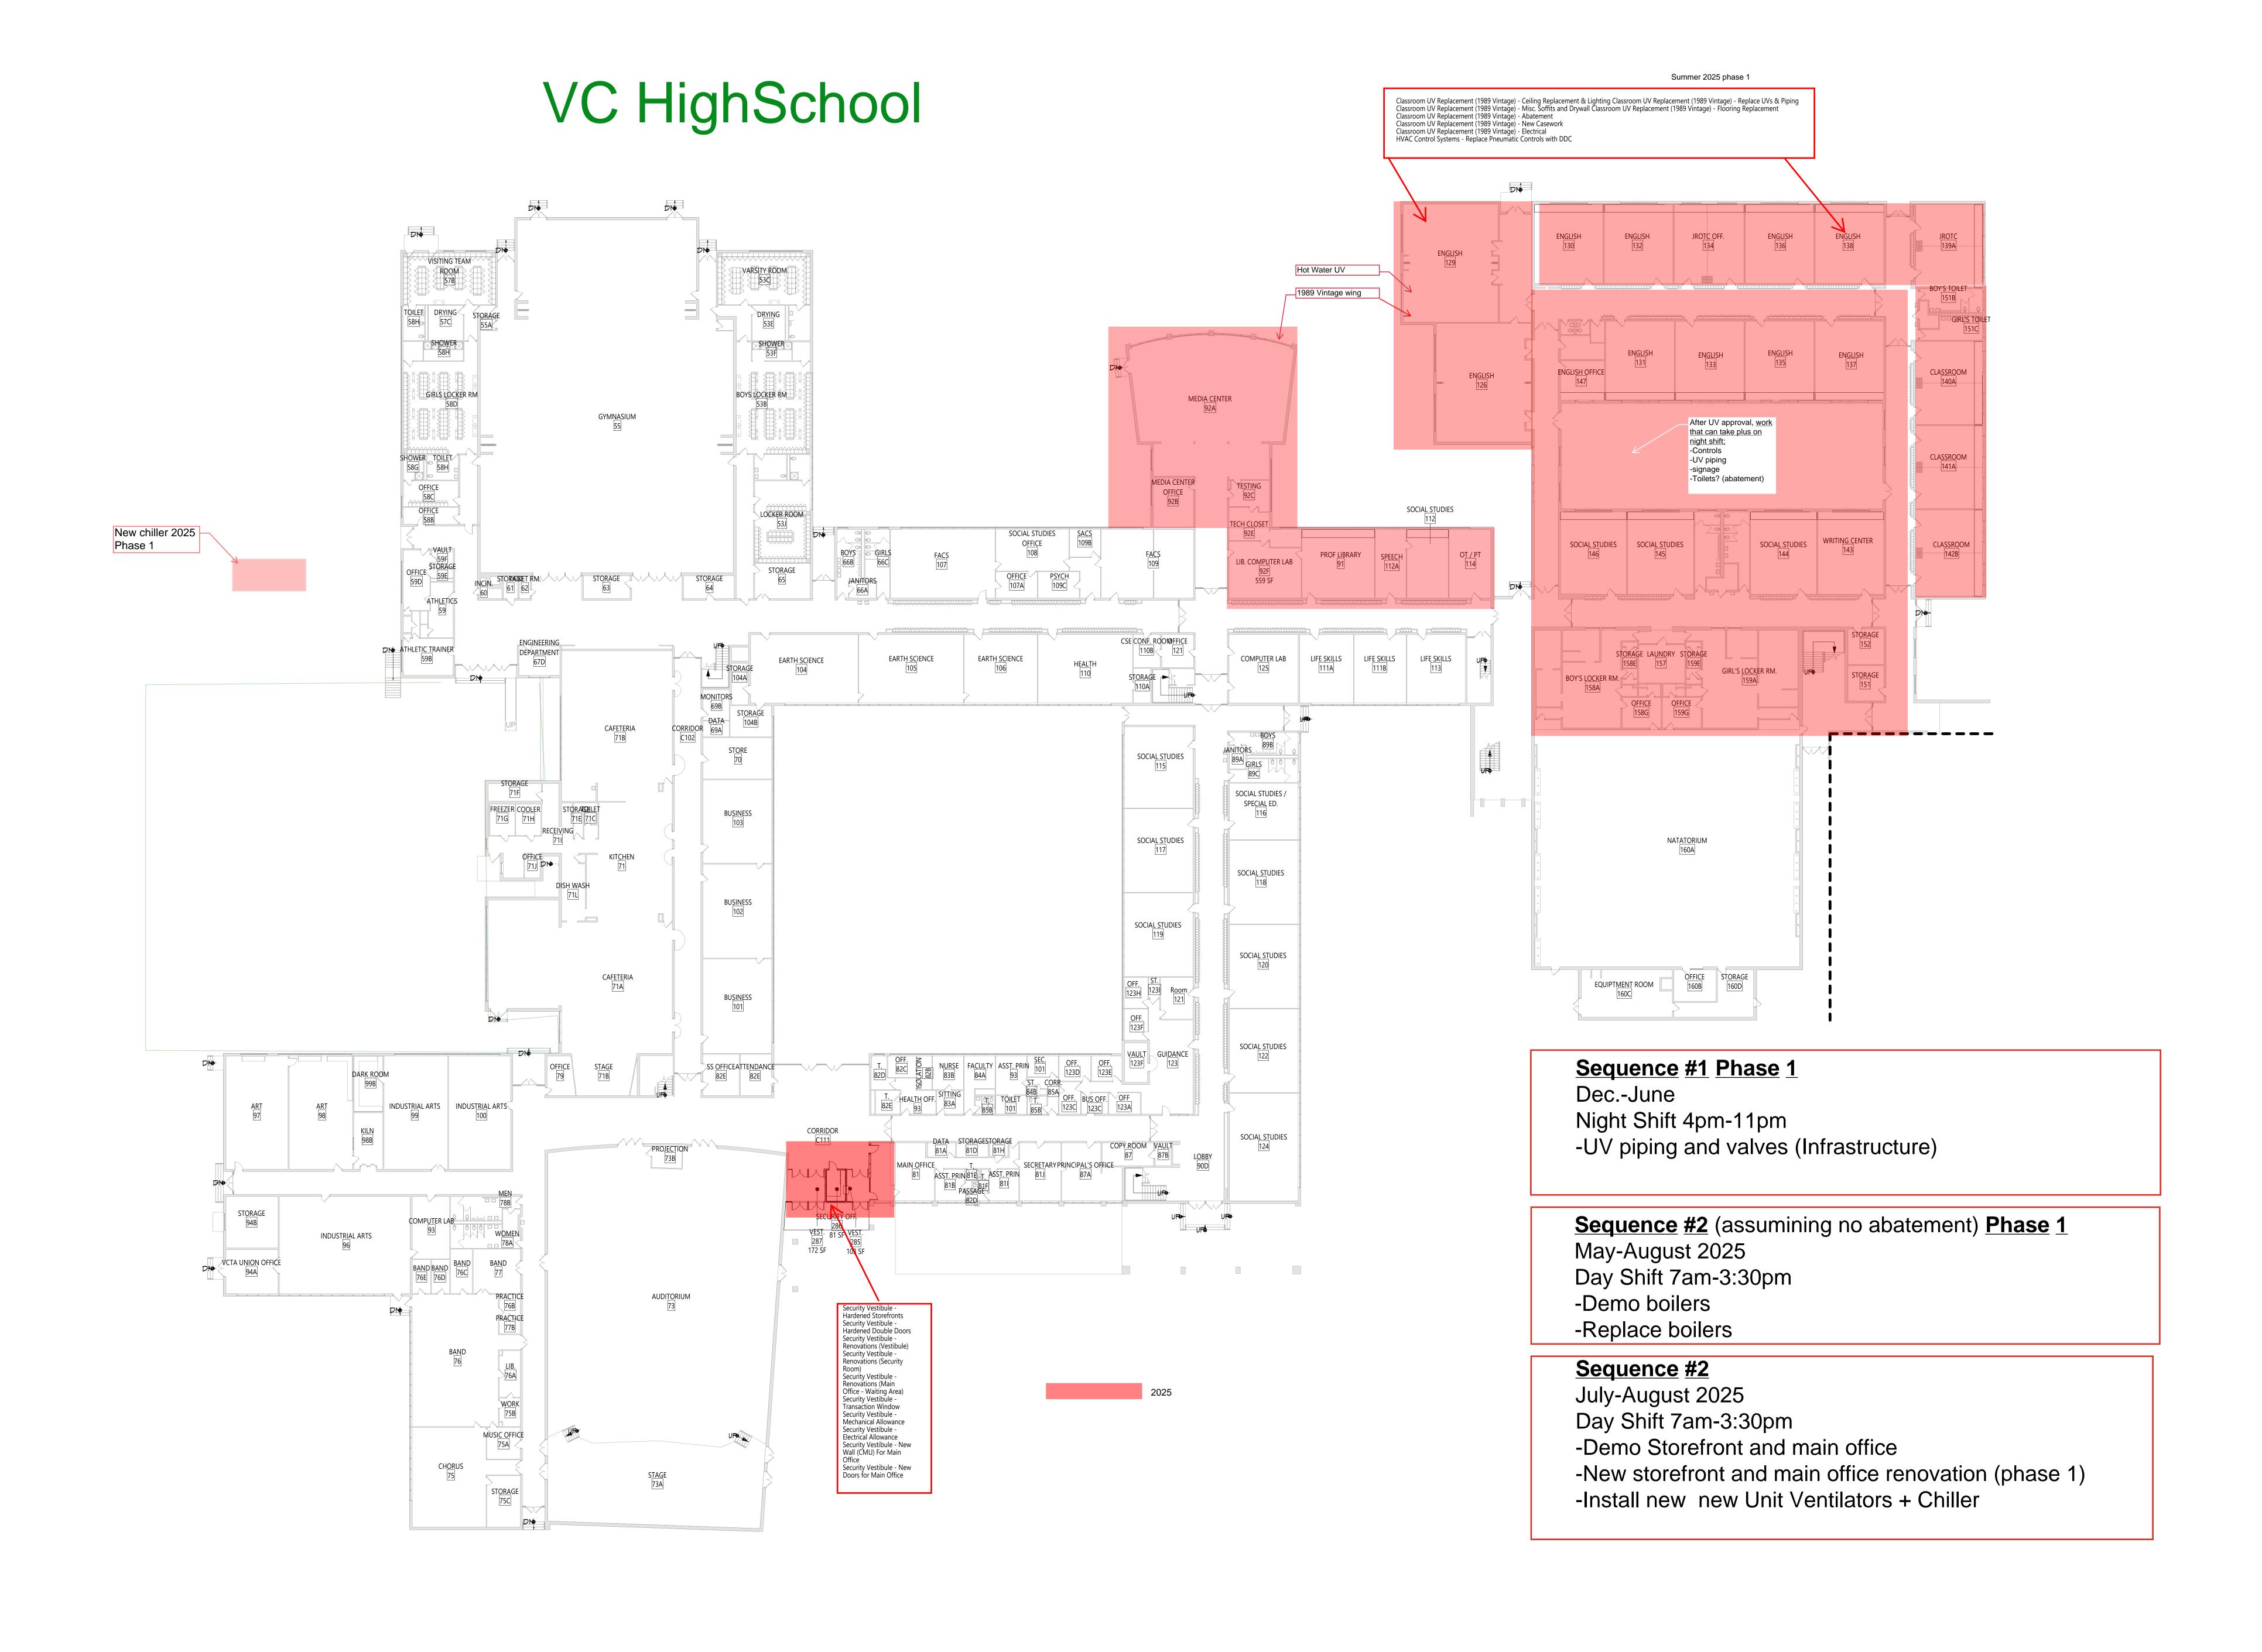


VC Middle School

<u>Sequence #1 2005</u>

Day Shift

7am-3:30pm

- -Demo Storefront and main office (Phase 1)
- -New storefront and main office renovation (phase 1)
- -Exterior brick repairs (phase 1)

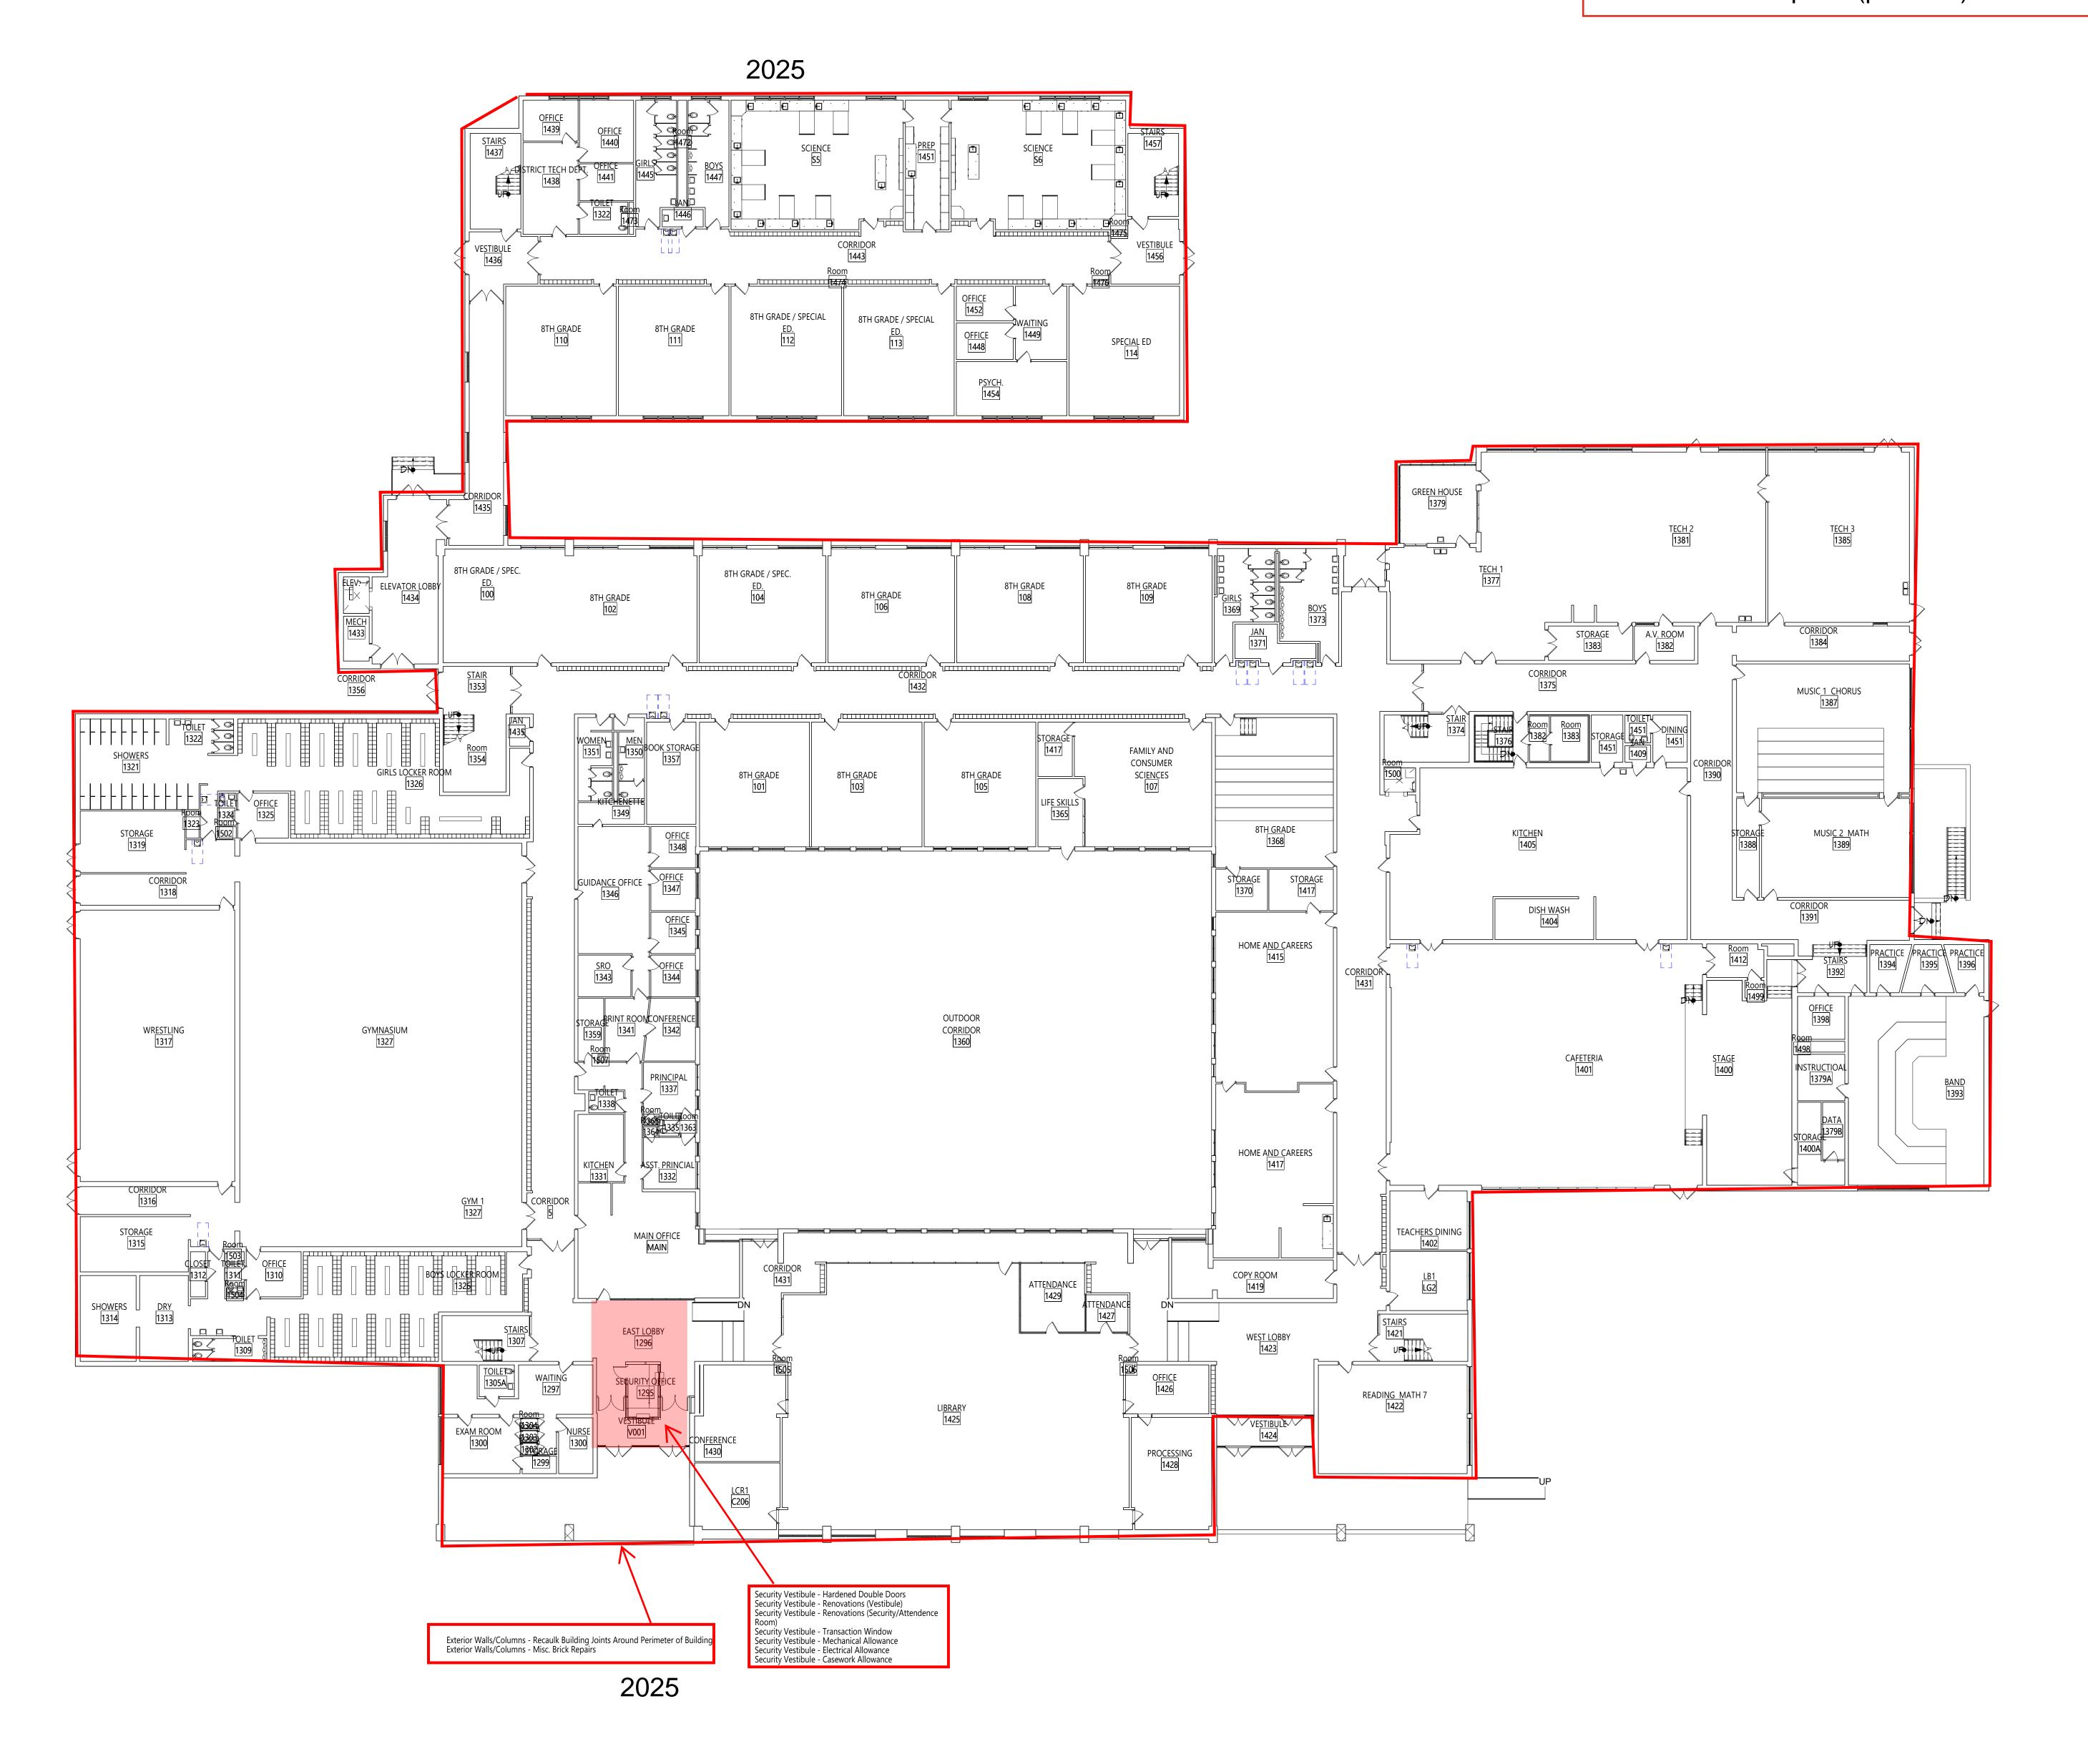



General Conditions of the Contract for Construction, Construction Manager as Adviser Edition

for the following PROJECT:

(Name, and location or address)

Valley Central School District - 2023 Capital Project - Phase 1

Valley Central High School 1175 State Route 17K Montgomery, New York 12549 SED# 44-13-01-06-0-015-033

Berea Elementary School 946 State Route 17K Montgomery, New York 12549 SED# 44-13-01-06-0-017-014

Montgomery Elementary School 141 Union Street Montgomery, New York 12549 SED# 44-13-01-06-0-004-015

Maybrook Alternative Learning Center 120 Broadway Maybrook, New York 12543 SED# 44-13-01-06-0-002-013

CSArch Project Number: 187-2302

THE CONSTRUCTION MANAGER:

(Name, legal status, and address)

The Palombo Group 22 Noxon Street Poughkeepsie, New York 12601

THE OWNER:

(Name, legal status, and address)

Valley Central School District 944 State Route 17K Montgomery, New York 12549

THE ARCHITECT:

(Name, legal status, and address)

Collins+Scoville Architecture | Engineering | Construction Management D.P.C. dba CSArch
19 Front Street
Newburgh, New York 12550

Valley Central Middle School 1189 State Route 17K Montgomery, New York 12549 SED# 44-13-01-06-0-016-023

East Coldenham Elementary School 286 State Route 17K Newburgh, New York 12550 SED# 44-13-01-06-0-013-019

Walden Elementary School 75 Orchard Street Walden, New York 12586 SED# 44-13-01-06-0-009-021

Administration Building 944 State Route 17K Montgomery, New York 12549 SED# 44-13-01-06-1-005-006

ADDITIONS AND DELETIONS:

The author of this document has added information needed for its completion. The author may also have revised the text of the original AIA standard form. An Additions and Deletions Report that notes added information as well as revisions to the standard form text is available from the author and should be reviewed. A vertical line in the left margin of this document indicates where the author has added necessary information and where the author has added to or deleted from the original AIA text.

This document has important legal consequences. Consultation with an attorney is encouraged with respect to its completion or modification.

This document is intended to be used in conjunction with AIA Documents A132™–2019, Standard Form of Agreement Between Owner and Contractor, Construction Manager as Adviser Edition; B132™–2019, Standard Form of Agreement Between Owner and Architect, Construction Manager as Adviser Edition; and C132™–2019, Standard Form of Agreement Between Owner and Construction Manager as Adviser.

TABLE OF ARTICLES

- 1 **GENERAL PROVISIONS**
- 2 **OWNER**
- 3 CONTRACTOR
- ARCHITECT AND CONSTRUCTION MANAGER
- 5 **SUBCONTRACTORS**
- 6 CONSTRUCTION BY OWNER OR BY SEPARATE CONTRACTORS
- 7 **CHANGES IN THE WORK**
- 8 TIME
- **PAYMENTS AND COMPLETION** 9
- 10 PROTECTION OF PERSONS AND PROPERTY
- 11 **INSURANCE AND BONDS**
- 12 **UNCOVERING AND CORRECTION OF WORK**
- 13 **MISCELLANEOUS PROVISIONS**
- 14 TERMINATION OR SUSPENSION OF THE CONTRACT
- 15 **CLAIMS AND DISPUTES**

User Notes:

Init.

2

ARTICLE 1 GENERAL PROVISIONS

§ 1.1 Basic Definitions

- § 1.1.1 The Contract Documents. The Contract Documents are enumerated in the Agreement between the Owner and Contractor (hereinafter the Agreement) and consist of the Agreement, Conditions of the Contract (General, Supplementary and other Conditions), Drawings, Specifications, Addenda issued prior to execution of the Contract, other documents listed in the Agreement, and Modifications issued after execution of the Contract. A Modification is (1) a written amendment to the Contract signed by both parties, (2) a Change Order, (3) a Construction Change Directive, or (4) a written order for a minor change in the Work issued by the Architect. Unless specifically enumerated in the Agreement, the Contract Documents do not include the advertisement or invitation to bid, Instructions to Bidders, sample forms, other information furnished by the Owner in anticipation of receiving bids or proposals, the Contractor's bid or proposal, or portions of addenda relating to bidding or proposal requirements.
- § 1.1.2 The Contract. The Contract Documents form the Contract for Construction. The Contract represents the entire and integrated agreement between the parties hereto and supersedes prior negotiations, representations, or agreements, either written or oral. The Contract may be amended or modified only by a Modification. The Contract Documents shall not be construed to create a contractual relationship of any kind (1) between the Contractor and the Architect or the Architect's consultants, (2) between the Owner and the Construction Manager or the Construction Manager's consultants, (3) between the Owner and the Architect or the Architect's consultants, (4) between the Contractor and the Construction Manager or the Construction Manager's consultants, (5) between the Owner and a Subcontractor or Sub-subcontractor (6) between the Construction Manager and the Architect, or (7) between any persons or entities other than the Owner and Contractor. The Construction Manager and Architect shall, however, be entitled to performance and enforcement of obligations under the Contract intended to facilitate performance of their duties.
- § 1.1.3 The Work. The term "Work" means the construction and services required by the Contract Documents, whether completed or partially completed, and includes all other labor, materials, equipment, and services provided or to be provided by the Contractor to fulfill the Contractor's obligations. The Work may constitute the whole or a part of the Project.
- § 1.1.4 The Project. The Project is the total construction of which the Work performed under the Contract Documents may be the whole or a part and which may include construction by other Contractors, and by the Owner's own forces and Separate Contractors.
- § 1.1.5 Contractors. Contractors are persons or entities, other than the Contractor or Separate Contractors, who perform Work under contracts with the Owner that are administered by the Architect and Construction Manager.
- § 1.1.6 Separate Contractors. Separate Contractors are persons or entities who perform construction under separate contracts with the Owner not administered by the Architect and Construction Manager.
- § 1.1.7 The Drawings. The Drawings are the graphic and pictorial portions of the Contract Documents showing the design, location and dimensions of the Work, generally including plans, elevations, sections, details, schedules, and diagrams.
- § 1.1.8 The Specifications. The Specifications are that portion of the Contract Documents consisting of the written requirements for materials, equipment, systems, standards and workmanship for the Work, and performance of related services.
- § 1.1.9 Instruments of Service. Instruments of Service are representations, in any medium of expression now known or later developed, of the tangible and intangible creative work performed by the Architect and the Architect's consultants under their respective professional services agreements. Instruments of Service may include, without limitation, studies, surveys, models, sketches, drawings, specifications, and other similar materials.
- § 1.1.10 Initial Decision Maker. The Initial Decision Maker is the person identified in the Agreement to render initial decisions on Claims in accordance with Section 15.2. The Initial Decision Maker shall not show partiality to the Owner or Contractor and shall not be liable for results of interpretations or decisions rendered in good faith.

User Notes:

(1932214867)

§ 1.2 Correlation and Intent of the Contract Documents

- § 1.2.1 The intent of the Contract Documents is to include all items necessary for the proper execution and completion of the Work by the Contractor. If, in the interpretation of Contract Documents, conflicting requirements within the Drawings and Specifications occur, or if it appears that the Drawings and Specifications are not in agreement, the requirement to be followed shall be decided by the Architect. Addenda supersede the provisions they amended. The Contract Documents are complementary, and what is required by one shall be as binding as if required by all; performance by the Contractor shall be required only to the extent consistent with the Contract Documents and reasonably inferable from them as being necessary to produce the indicated results.
 - 1. All dimensions shown on the Drawings are for bidding purposes only. It is the responsibility of the Contractor to verify all dimensions in the field to ensure proper and accurate fit of materials and items to be installed.
 - 2. The lists of equipment, tabulations of data and schedules appearing in the Specifications or Drawings are included for assistance and guidance in arriving at a more complete understanding of the intended installation. They are not intended, or to be construed, as relieving the responsibility of the Contractor or any of the Prime Contractors in making their own takeoffs.
 - 3. It is intended that all mechanical and electrical systems will be complete and in proper operation and that all construction components will be complete and in compliance with accepted construction practice upon completion of the Work. Even if items are missing from the Plans and/or Specifications, but are normally required for proper operation of mechanical and electrical systems, or to complete otherwise incomplete construction or to meet governing code requirements, they shall be included by the Contractor, unless he sought and received contradictory interpretation or clarification from the Architect in writing.
- § 1.2.1.1 The invalidity of any provision of the Contract Documents shall not invalidate the Contract or its remaining provisions. If it is determined that any provision of the Contract Documents violates any law, or is otherwise invalid or unenforceable, then that provision shall be revised to the extent necessary to make that provision legal and enforceable. In such case the Contract Documents shall be construed, to the fullest extent permitted by law, to give effect to the parties' intentions and purposes in executing the Contract.
- § 1.2.2 Organization of the Specifications into divisions, sections and articles, and arrangement of Drawings shall not control the Contractor in dividing the Work among Subcontractors or in establishing the extent of Work to be performed by any trade.
 - 1. Sections of the General Requirements, Division 01, govern the execution of all remaining Divisions of the Specifications.
 - 2. It shall be the Contractor's responsibility, when subcontracting any portion of Work, to arrange or group items of work under particular trades to conform with prevailing customs of the trade, regardless of the particular Divisions and Sections of the Specifications in which the work is described.
- § 1.2.3 Unless otherwise stated in the Contract Documents, words that have well-known technical or construction industry meanings are used in the Contract Documents in accordance with such recognized meanings.
- § 1.2.3.1 In the event of conflicts or discrepancies among the Contract Documents, interpretations will be based on the following priorities:
 - .1 Modifications, as defined in Section 1.1.1.
 - .2 The Agreement.

Init.

- .3 Addenda, with those of later date having precedence over those of earlier date.
- .4 The General Conditions of the Contract for Construction.
- .5 Division 01 of the Specifications.
- .6 Drawings and remaining Divisions of the Specifications.
- § 1.2.4 Within the Contract Documents for which each Prime Contractor is responsible, any Work included by reference in any section to another Specification's Section shall be included as Work under the Contract, whether or

not it is called for under the Section referred to. Failure to cross-reference such items shall not relieve the Contractor or any Prime Contractor from the obligations to provide such work.

§ 1.3 Capitalization

Terms capitalized in these General Conditions include those that are (1) specifically defined, (2) the titles of numbered articles, or (3) the titles of other documents published by the American Institute of Architects.

§ 1.4 Interpretation

In the interest of brevity, the Contract Documents frequently omit modifying words such as "all" and "any" and articles such as "the" and "an," but the fact that a modifier or an article is absent from one statement and appears in another is not intended to affect the interpretation of either statement.

§ 1.5 Ownership and Use of Drawings, Specifications, and Other Instruments of Service

- § 1.5.1 The Architect and the Architect's consultants shall be deemed the authors and owners of their respective Instruments of Service, including the Drawings and Specifications, and retain all common law, statutory, and other reserved rights in their Instruments of Service, including copyrights. The Contractor, Subcontractors, sub-subcontractors, and suppliers shall not own or claim a copyright in the Instruments of Service. Submittal or distribution to meet official regulatory requirements or for other purposes in connection with the Project is not to be construed as publication in derogation of the Architect's or Architect's consultants' reserved rights.
- § 1.5.2 The Contractor, Subcontractors, Sub-subcontractors, and suppliers are authorized to use and reproduce the Instruments of Service provided to them, subject to any protocols established pursuant to Sections 1.7 and 1.8, solely and exclusively for execution of the Work. All copies made under this authorization shall bear the copyright notice, if any, shown on the Instruments of Service. The Contractor, Subcontractors, Sub-subcontractors, and suppliers may not use the Instruments of Service on other projects or for additions to the Project outside the scope of the Work without the specific written consent of the Owner, Architect, and the Architect's consultants.

§ 1.6 Notice

- § 1.6.1 Except as otherwise provided in Section 1.6.2, where the Contract Documents require one party to notify or give notice to the other party, such notice shall be provided in writing to the designated representative of the party to whom the notice is addressed and shall be deemed to have been duly served if delivered in person, by mail, by courier, or by electronic transmission if a method for electronic transmission is set forth in the Agreement.
- § 1.6.2 Notice of Claims as provided in Section 15.1.3 shall be provided in writing and shall be deemed to have been duly served only if delivered to the designated representative of the party to whom the notice is addressed by certified or registered mail, or by courier providing proof of delivery.

§ 1.7 Digital Data Use and Transmission

The parties shall agree upon protocols governing the transmission and use of Instruments of Service or any other information or documentation in digital form. The parties will use AIA Document E203TM—2013, Building Information Modeling and Digital Data Exhibit, to establish the protocols for the development, use, transmission, and exchange of digital data.

If the parties intend to transmit Instruments of Service or any other information or documentation in digital form, they shall endeavor to establish necessary protocols governing such transmissions, unless otherwise already provided in the Agreement or the Contract Documents.

§ 1.7.2 Contractor's Use of Instruments of Service in Electronic Form

- § 1.7.2.1 The Architect may, with the concurrence of the Owner and upon compensation by the Contractor to the Architect, furnish to the Contractor versions of Instruments of Service in digital form. The Instruments of Service executed or identified in accordance with Subparagraph 1.1.7 shall prevail in case of an inconsistency with subsequent versions made through manipulatable electronic means.
- § 1.7.2.2 The Contractor shall not transfer or reuse Instruments of Service in electronic or machine-readable form without the prior written consent of the Architect.

§ 1.8 Building Information Models Use and Reliance

Any use of, or reliance on, all or a portion of a building information model without agreement to protocols governing the use of, and reliance on, the information contained in the model and without having those protocols set forth in AIA Document E203TM_2013, Building Information Modeling and Digital Data Exhibit, and the requisite AIA Document G202™-2013, Project Building Information Modeling Protocol Form, shall be at the using or relying party's sole risk and without liability to the other party and its contractors or consultants, the authors of, or contributors to, the building information model, and each of their agents and employees.

§ 1.9 COMMUNICATION

§ 1.9.1 Construction Manager, Contractor and Architect shall meet periodically at mutually agreed upon intervals for the purpose of establishing procedures to facilitate cooperation, communication and timely responses among the participants. By participating in these meetings, the parties do not intend to create additional contractual obligations or modify the legal relationships which may already exist.

ARTICLE 2 **OWNER**

§ 2.1 General

- § 2.1.1 The Owner is the person or entity identified as such in the Agreement and is referred to throughout the Contract Documents as if singular in number. The Owner shall designate in writing a representative who shall have express authority to bind the Owner with respect to all matters requiring the Owner's approval or authorization. Except as otherwise provided in Section 4.2.1, the Construction Manager and the Architect do not have such authority. The term "Owner" means the Owner or the Owner's authorized representative.
- § 2.1.2 The Owner shall furnish to the Contractor, within fifteen days after receipt of a written request, information necessary and relevant for the Contractor to evaluate, give notice of, or enforce mechanic's lien rights.

§ 2.2 Evidence of the Owner's Financial Arrangements

- § 2.2.1 Prior to commencement of the Work, and upon written request by the Contractor, the Owner shall furnish to the Contractor reasonable evidence that the Owner has made financial arrangements to fulfill the Owner's obligations under the Contract. The Contractor shall have no obligation to commence the Work until the Owner provides such evidence. If commencement of the Work is delayed under this Section 2.2.1, the Contract Time shall be extended appropriately.
- § 2.2.2 Following commencement of the Work and upon written request by the Contractor, the Owner shall furnish to the Contractor reasonable evidence that the Owner has made financial arrangements to fulfill the Owner's obligations under the Contract only if (1) the Owner fails to make payments to the Contractor as the Contract Documents require; (2) the Contractor identifies in writing a reasonable concern regarding the Owner's ability to make payment when due; or (3) a change in the Work materially changes the Contract Sum. If the Owner fails to provide such evidence, as required, within thirty days of the Contractor's written request, the Contractor may immediately stop the Work and, in that event, shall notify the Owner that the Work has stopped. However, if the request is made because a change in the Work materially changes the Contract Sum under (3) above, the Contractor may immediately stop only that portion of the Work affected by the change until reasonable evidence is provided. If the Work is stopped under this Section 2.2.2, the Contract Time shall be extended appropriately.
- § 2.2.3 After the Owner furnishes evidence of financial arrangements under this Section 2.2, the Owner shall not materially vary such financial arrangements without prior notice to the Contractor.
- § 2.2.4 Where the Owner has designated information furnished under this Section 2.2 as "confidential," the Contractor shall keep the information confidential and shall not disclose it to any other person. However, the Contractor may disclose "confidential" information, after seven (7) days' written notice to the Owner, where disclosure is required by law, including a subpoena or other form of compulsory legal process issued by a court or governmental entity, or by court or arbitrator(s) order. The Contractor may also disclose "confidential" information to its employees, consultants, sureties, Subcontractors and their employees, Sub-subcontractors, and others who need to know the content of such information solely and exclusively for the Project and who agree to maintain the confidentiality of such information.

(1932214867)

Init.

§ 2.3 Information and Services Required of the Owner

- § 2.3.1 Except for permits and fees that are the responsibility of the Contractor under the Contract Documents, including those required under Section 3.7.1, the Owner shall secure and pay for necessary approvals, easements, assessments and charges required for construction, use or occupancy of permanent structures or for permanent changes in existing facilities. Unless otherwise provided under the Contract Documents, the Owner, assisted by the Construction Manager, shall secure and pay for the building permit.
- § 2.3.2 The Owner shall retain an architect lawfully licensed to practice architecture, or an entity lawfully practicing architecture, in the jurisdiction where the Project is located. That person or entity is identified as the Architect in the Agreement and is referred to throughout the Contract Documents as if singular in number.
- § 2.3.3 The Owner shall retain a construction manager adviser lawfully practicing construction management in the jurisdiction where the Project is located. That person or entity is identified as the Construction Manager in the Agreement and is referred to throughout the Contract Documents as if singular in number.
- § 2.3.4 If the employment of the Construction Manager or Architect terminates, the Owner shall employ a successor construction manager or architect whose status under the Contract Documents shall be that of the Construction Manager or Architect, respectively.

§ 2.3.5

The Owner shall furnish, upon written request only and as necessary to complete this work, surveys describing physical characteristics, legal limitations and utility locations for the site of the Project, and a legal description of the site. The Contractor shall be entitled to reasonably rely on the accuracy of information furnished by the Owner but shall exercise proper precautions relating to the safe performance of the Work.

§ 2.3.6 The Owner shall furnish information or services required of the Owner by the Contract Documents with reasonable promptness. The Owner shall also furnish any other information or services under the Owner's control and relevant to the Contractor's performance of the Work with reasonable promptness after receiving the Contractor's written request for such information or services.

§ 2.3.7

The Contractor and/or Prime Contractors will be furnished, free of charge, three sets of the Contract Drawings and Project Manuals. Additional sets will be furnished at cost of reproduction and postage and handling when applicable. Subcontractors and other entities desiring copies of Drawings and Project Manuals shall obtain them via one of the Prime Contracts.

§ 2.3.8 The Owner shall forward all communications to the Contractor through the Construction Manager. Other communication shall be made as set forth in Section 4.2.6.

§ 2.4 Owner's Right to Stop the Work

If the Contractor fails to correct Work that is not in accordance with the requirements of the Contract Documents as required by Section 12.2 or repeatedly fails to carry out Work in accordance with the Contract Documents, the Owner may issue a written order to the Contractor to stop the Work, or any portion thereof, until the cause for such order has been eliminated; however, the right of the Owner to stop the Work shall not give rise to a duty on the part of the Owner to exercise this right for the benefit of the Contractor or any other person or entity, except to the extent required by Section 6.1.3.

§ 2.5 Owner's Right to Carry Out the Work

If the Contractor defaults or neglects to carry out the Work in accordance with the Contract Documents and fails within a ten-day period after receipt of notice from the Owner to commence and continue correction of such default or neglect with diligence and promptness, the Owner may, without prejudice to other remedies the Owner may have, correct such default or neglect. Such action by the Owner and amounts charged to the Contractor are both subject to review by the Construction Manager and prior approval of the Architect, and the Construction Manager or Architect may, pursuant to Section 9.5.1, withhold or nullify a Certificate for Payment in whole or in part, to the extent reasonably necessary to reimburse the Owner for the reasonable cost of correcting such deficiencies, including Owner's expenses and compensation for the Construction Manager's and Architect's and their respective consultants' additional services made necessary by such default, neglect, or failure. If current and future payments are not

sufficient to cover such amounts, the Contractor shall pay the difference to the Owner. If the Contractor disagrees with the actions of the Owner or the Architect, or the amounts claimed as costs to the Owner, the Contractor may file a Claim pursuant to Article 15.

§ 2.6 ACCELERATION CLAUSE

§ 2.6.1 The Owner reserves the right to accelerate the work of the Contract. In the event that the Owner directs acceleration, such directive will be only in written form. The Contractor shall keep cost and other project records related to the written acceleration directive separately from normal project costs and records and shall provide a written record of acceleration cost to the Owner on a daily basis.

§ 2.6.2 In order to p recover additional costs due to a written acceleration directive, the Contractor must document that additional expenses were incurred and paid by the Contractor. Labor costs recoverable will be only overtime or shift premium costs or the cost of additional laborers brought to the site to accomplish the accelerated work effort. Equipment costs recoverable will be only the cost of added equipment mobilized to the site to accomplish the accelerated work effort.

ARTICLE 3 CONTRACTOR

§ 3.1 General

§ 3.1.1 The Contractor is the person or entity identified as such in the Agreement and is referred to throughout the Contract Documents as if singular in number. The Contractor shall be lawfully licensed, if required in the jurisdiction where the Project is located. The Contractor shall designate in writing a representative who shall have express authority to bind the Contractor with respect to all matters under this Contract. The term "Contractor" means the Contractor or the Contractor's authorized representative.

§ 3.1.2 The Contractor shall perform the Work in accordance with the Contract Documents.

§ 3.1.3 The Contractor shall not be relieved of its obligations to perform the Work in accordance with the Contract Documents either by activities or duties of the Construction Manager or Architect in their administration of the Contract, or by tests, inspections or approvals required or performed by persons or entities other than the Contractor. Staging and storage areas for materials shall be as agreed on between the Contractor and the Owner's Project Representative.

§ 3.2 Review of Contract Documents and Field Conditions by Contractor

§ 3.2.1 Execution of the contract by the Contractor is a representation that the Contractor has carefully examined the Contract Documents and the site, and represents that the Contractor is thoroughly familiar with the nature and location of the Work, the site, the specific conditions under which the Work is to be performed, and all matters which may in any way affect the Work or its performance. The Contractor further represents that as a result of such examinations and investigations, the Contractor thoroughly understands the Contract Documents and their intent and purpose, and is familiar with all applicable codes, ordinances, laws, regulations, and rules as they apply to the Work, and that the Contractor will abide by same. Claims for additional time or additional compensation as a result of the Contractor's failure to follow the foregoing procedure and to familiarize itself with all local conditions and the Contract Documents are waived and will not be permitted.

§ 3.2.2 Because the Contract Documents are complementary, the Contractor shall, before starting each portion of the Work, carefully study and compare the various Contract Documents relative to that portion of the Work, as well as the information furnished by the Owner pursuant to Section 2.2.3, shall take field measurements of any existing conditions related to that portion of the Work, and shall observe any conditions at the site affecting it. These obligations are for the purpose of facilitating coordination and construction by the Contractor and are not for the purpose of discovering errors, omissions, or inconsistencies in the Contract Documents; however, the Contractor shall promptly report to the Architect any errors, inconsistencies or omissions discovered by or made known to the Contractor as a request for information submitted in writing on such form as the Architect may require. It is recognized that the Contractor's review is made in the Contractor's capacity as a contractor and not as a licensed design professional, unless otherwise specifically provided in the Contract Documents. If the Contractor performs any construction activity which involves an error, inconsistency or omission in the Contract Documents without first providing notice to the Owner, Architect and Construction Manager of such condition and receiving authorization to proceed, the Contractor shall assume responsibility for such performance and shall bear an appropriate amount of the attributable costs for correction.

(Paragraph deleted)

- § 3.2.4 If the Contractor believes that additional cost or time is involved because of clarifications or instructions the Architect issues in response to the Contractor's notices or requests for information pursuant to Sections 3.2.2 or 3.2.3, the Contractor shall submit Claims in writing as provided in Article 15. If the Contractor fails to perform the obligations of Sections 3.2.2 or 3.2.3, the Contractor shall pay such costs and damages to the Owner, subject to section 15.1.7, as would have been avoided if the Contractor had performed such obligations. If the Contractor performs those obligations, the Contractor shall not be liable to the Owner or Architect for damages resulting from errors, inconsistencies or omissions in the Contract Documents, for differences between field measurements or conditions and the Contract Documents, or for nonconformities of the Contract Documents to applicable laws, statutes, ordinances, codes, rules and regulations, and lawful orders of public authorities.
- § 3.2.4.1 The owner is entitled to reimbursement from the Contractor for amounts paid to the Architect for evaluating and not responding to the Contractor's requests for information that are not prepared in accordance with the Contract Documents or where the requested information is available to the Contractor from a careful study and comparison of the Contract Documents, field conditions, other Owner-provided information, Contractor-prepared coordination drawings, or prior Project correspondence or documentation.
- § 3.2.5 Where existing conditions are obscured or concealed from the Owner or Architect's view prior to the start of this Project's construction activities, portrayal of such conditions in the documents is based on reasonable implications and assumptions. The Owner and Architect do not imply or guarantee to the Contractor in any way that such portrayals in the Documents are accurate or true.
- § 3.2.5.1 Physical investigations and testing of existing conditions were not undertaken by the Architect, unless so indicated in the Contract Documents.
- §3.2.5.2 The Contractor may submit written requests for information to the Architect to help facilitate the Contractor's performance of the contract. Prior to submitting each request for information, the Contractor shall first carefully study and compare the Contract Documents, field conditions, other Owner provided information, Contractor prepared Coordination Drawings, and prior Project correspondence and documentation to determine that the information to be requested is not reasonably obtainable from such sources.
- § 3.2.5.3 Each request for information shall be submitted to the Architect, in writing, with a copy to the Construction Manager. Each request for information shall identify the specific sources which were reviewed by the Contractor in an effort to determine the information requested, and a statement to the effect that the information being requested could not be determined from such sources.
- § 3.2.5.4 The Contractor shall submit each request for information sufficiently in advance of the date by which such information is requested in order to allow the Architect sufficient time, in the Architect's professional judgment, to permit adequate review and response and to permit Contractor compliance with the latest construction schedule.
- § 3.2.5.5 The Construction Manager shall maintain a log at the Project site that sequentially numbers and lists each request for information. This log shall contain the Drawings reference or Specification section to which the request pertains, the date of the request, to whom the request was made, by whom the request was made, the nature of the request, and the Architect's resolution thereof. This log shall be reviewed at each Project meeting and the status of the requests for information shall be made part of the minutes of such meetings.
- § 3.2.5.6 The Contractor shall reimburse the Owner amounts charged to the Owner by the Architect or Construction Manager for responding to Contractor requests for information where such information is available to the Contractor from a careful study and comparison of the Contract Documents, field conditions, other Owner provided information, Contractor prepared Coordination Drawings, or prior Project correspondence or documentation.

§ 3.3 Supervision and Construction Procedures

§ 3.3.1 The Contractor shall supervise and direct the Work, using the Contractor's best skill and attention. The Contractor shall be solely responsible for, and have control over, construction means, methods, techniques, sequences, and procedures, and for coordinating all portions of the Work under the Contract. If the Contract Documents give

specific instructions concerning construction means, methods, techniques, sequences, or procedures, the Contractor shall evaluate the jobsite safety thereof and shall be solely responsible for the jobsite safety of such means, methods, techniques, sequences, or procedures. If the Contractor determines that such means, methods, techniques, sequences or procedures may not be safe, the Contractor shall give timely notice to the Owner, the Construction Manager, and the Architect, and shall propose alternative means, methods, techniques, sequences, or procedures. The Architect shall evaluate the proposed alternative solely for conformance with the design intent for the completed construction. The Construction Manager shall review the proposed alternative for sequencing, constructability, and coordination impacts on the other Contractors. Unless the Architect or the Construction Manager objects to the Contractor's proposed alternative, the Contractor shall perform the Work using its alternative means, methods, techniques, sequences, or procedures. The Contractor shall be responsible for and coordinate any and all inspections required by any governmental body having jurisdiction over the project. Failure to obtain any permits, licenses or other approvals because of the failure of the Contractor to conform to this requirement shall not extend the Contract time, and the Contractor shall not be entitled to any increase in the contract sum therefor. In addition, any additional costs and/or expenses of any nature incurred by the Owner as a result of the Contractor's failure to conform to this requirement shall constitute a charge against the Contractor's contract. Each contractor shall be responsible for complying with union regulations existing under current labor agreements in performing construction work on the project.

- § 3.3.2 The Contractor shall be responsible to the Owner for acts and omissions of the Contractor's employees, Subcontractors and their agents and employees, and other persons or entities performing portions of the Work for, or on behalf of, the Contractor or any of its Subcontractors.
- § 3.3.3 The Contractor shall be responsible for inspection of portions of the Project already performed to determine that such portions are in proper condition to receive subsequent Work.
- § 3.3.4 During period of active Construction, the Contractor shall consult daily and cooperate with the Construction Manager. On a daily basis, the Contractor shall keep the Construction Manager and Architect notified of when Work will be starting, restarting, suspended and temporarily or permanently concluding.
- § 3.3.5 Within 15 days of the date of the Notice to Proceed, each Contractor shall submit to the Construction Manager and Architect a list of all Contractor's principal staff assignments, including the Superintendent and other personnel in attendance at the site; identify individuals, their duties and responsibilities.
- § 3.3.6 The Board of Education recognizes the need for the continuing development of skilled workers in the construction trades and recognizes a need to encourage contractors in said trades to enter into apprenticeship agreements committing them to apprenticeship training programs registered with the New York State Department of Labor in accordance with the provisions of New York State Labor Law §§816 & 816-b;
- § 3.3.6.1 The District construction projects approved by the voters on May 16, 2023 for individual prime construction contracts and construction-related maintenance contracts in excess of \$250,000.00, the project bid specifics shall require that contracts with construction trades contractors include requirements that they have existing apprenticeship agreements providing for apprentice training programs registered with the New York State Department of Labor. The District reserves the right to utilize any approved municipal or state contracts for the purpose of the procurement of equipment or services for the above referenced construction projects, consistent with established district procurement policies.

§ 3.4 Labor and Materials

- § 3.4.1 Unless otherwise provided in the Contract Documents, the Contractor shall provide and pay for labor, materials, equipment, tools, construction equipment and machinery, water, heat, utilities, transportation, and other facilities and services necessary for proper execution and completion of the Work, whether temporary or permanent and whether or not incorporated or to be incorporated in the Work.
- § 3.4.2 After the Contract has been executed, the Architect in conjunction with the Construction Manager, will consider a formal request for the substitution of products in place of those specified only under the conditions set forth in the General Requirements (Division 01 of the Specifications). Substitutions shall satisfy the following conditions:
 - The materials, products and equipment described in the Contract Documents establish the standard of required quality, function, dimension and appearance expected.
 - Requests for substitutions must be submitted at the time that bids are received.



- 3. Substitution requests will be considered only if standards are met or exceeded as described above and are subsequently approved in writing by the Architect and Owner.
- Each such request shall include the name of the material, product or equipment item for which substitution is requested and a complete description of the proposed substitute, including drawings, cuts, performance and test data and any other information necessary for a complete evaluation.
- Each such request shall include a statement setting forth any changes in other materials, product or equipment or other work that incorporation of the substitution would require.
- 6. The burden of proof of the merit of the proposed substitution is upon the proposer.
- 7. The Architect's decision of approval or disapproval of a proposed substitution shall be final and will be set forth in writing.
- Additional substitution requests, during construction, will be considered only if substitution is caused by specific material, product or equipment's subsequent removal from, or unavailability in the market place and only at "no change" or "credit" to Contract amount.
- Contractor's Responsibilities: If any of the following conditions occur due to substitutions, the contractor making the substitution shall bear the cost of such conditions, including payment for services rendered by the Architect:
 - Redesign required for any of the Work. (a)
 - (b) Material or quantity changes for any of the Work.
 - (c) Delays in any of the Work.
 - (d) Request for information generated due to substitutions."
- § 3.4.3 The Contractor, as indicated in the Instructions to Bidders, shall furnish in writing to the Owner through the Construction Manager a list showing the name of the manufacturer proposed to be used for equivalents of products identified in the Specifications, and where applicable, the name of the installing subcontractor. By identifying and submitting a proposed manufacturer and/or installer the Contractor warrants that products furnished and/or installed by them conform to such requirements of the Contract Documents. The Construction Manager, in conjunction with the Architect will reply with reasonable promptness to the Contractor in writing stating whether or not the Owner, Construction Manager or Architect, after due investigation, have reasonable objection to any such proposed manufacturer or installer.
 - .1 If adequate data on a proposed equivalent manufacturer or installer is not available, the Architect may state that the action will be deferred until the Contractor provides additional data.
 - .2 Failure of the Owner, Construction Manager or Architect to object to a manufacturer or installer shall not constitute a waiver of the requirements of the Contract Documents.
 - Products furnished by the listed manufacturer or installed by the listed installer shall conform to such .3 requirements of the Contract Documents.
- § 3.4.4 The Contractor shall comply with the most current Contract Requirements and Prevailing Wage Rate Schedules as published by the Bureau of Public Works, State of New York, Department of Labor established for this Project.
- § 3.4.5 No materials or supplies for the Work shall be purchased by the Contractor or by any subcontractor subject to any chattel mortgage or under a conditional sale or other agreement by which an interest is retained by the seller. The Contractor warrants that he has full title to all materials and supplies used by him in the Work, or resold to the Owner, pursuant to this Contract Document, free from all liens, claims or encumbrances.
- § 3.4.6 All materials used permanently in the Work shall be new unless otherwise specified. The apparent silence of the Specifications as to any detail described concerning any Work to be done and materials to be furnished shall be regarded as meaning that only the best general practice is to prevail and that only material and workmanship of the first quality are to be used, and all interpretations of the Specifications shall be made on this basis. All material incorporated in the Project Work shall be clean and exhibit no appearance of aging, exposure to weather, prior use, handling or damage of any kind.
- § 3.4.7 Manufacturer's identifications shall be inconspicuous, but where nameplates contain information relative to characteristics or maintenance, they shall be clearly visible and located for easy access.

- § 3.4.8 Equipment intended for permanent installation shall not be operated for temporary purposes without the written permission of the Architect.
- § 3.4.9 Materials shall be delivered in manufacturer's original sealed containers, with complete identification of contents and manufacturer, and kept sealed in original containers until used. Labels shall not be removed until materials have been installed and inspected.
- § 3.4.10 Whenever the Contract Documents require delivery by the Contractor of any materials, equipment or other items, the term delivery shall be deemed to include unloading and storing with proper protection where directed.
- § 3.4.11 Materials shall be applied or installed under proper climactic conditions, not when they may be affected by temperature, moisture, humidity or dust.
- § 3.4.12 As defined by Federal and State Laws, no materials incorporated into the Project Work shall contain asbestos. Material shall be "asbestos-free" containing zero percent (0%) asbestos. The Architect reserves the right to request certification from the material manufacturer through the Contractor for certification that materials installed contact zero percent (0%) asbestos.
- § 3.4.13 The Contractor shall enforce strict discipline and good order among the Contractor's employees and other persons carrying out the Work. The Contractor shall not permit employment of unfit persons or persons not properly skilled in tasks assigned to them.
 - .1 A sufficient force of competent experienced workman, foreman and superintendents shall be employed at all times to permit the Work to be pursued with diligence until completion.

§ 3.5 Warranty

- § 3.5.1 The Contractor warrants to the Owner, Construction Manager, and Architect that materials and equipment furnished under the Contract will be of good quality and new unless the Contract Documents require or permit otherwise. The Contractor further warrants that the Work will conform to the requirements of the Contract Documents and will be free from defects, except for those inherent in the quality of the Work the Contract Documents require or permit. Work, materials, or equipment not conforming to these requirements may be considered defective. The Contractor's warranty excludes remedy for damage or defect caused by abuse, alterations to the Work not executed by the Contractor, improper or insufficient maintenance, improper operation, or normal wear and tear and normal usage. If required by the Construction Manager or Architect, the Contractor shall furnish satisfactory evidence as to the kind and quality of materials and equipment.
- § 3.5.2 All material, equipment, or other special warranties required by the Contract Documents shall be issued in the name of the Owner, or shall be transferable to the Owner, and shall commence in accordance with Section 9.8.4.

§ 3.6 Taxes

User Notes:

Init.

Exempt from Sales Tax: New York State Sales Tax is not applicable to any materials and supplies to be incorporated into Work under the terms of the Contract, the Owner being exempt therefrom. There is no exemption from the sales or use tax on charges to the Contractor or subcontractor for lease of tools, machinery, equipment or other property used in conjunction with the Project. The Contractors and subcontractors shall be solely responsible for and pay any and all applicable taxes, including sales and compensating use taxes, on such leased tools, machinery, equipment or other property, and for materials not incorporated in the Project and the amount of such taxes, if any, shall be deemed included in executed Base Bid.

§ 3.7 Permits, Fees, Notices, and Compliance with Laws

- § 3.7.1 The Owner, through the Construction Manager, shall secure and pay for the building permit. The Contractor shall secure and pay for other permits, fees, licenses, and inspections by government agencies necessary for proper execution of and completion of the contract, which are legally required.
- § 3.7.2 The Contractor shall comply with and give notices required by applicable laws, statutes, ordinances, codes, rules and regulations, and lawful orders of public authorities applicable to performance of the Work.

- § 3.7.2.1 The Contractor shall comply with all applicable New York State Department of Labor requirements, including the provision that every worker employed in performance of a public work contract shall be certified as having completed an OSHA 10-hour safety training course. The Contractor and Subcontractor shall be solely responsible for compliance with this requirement with respect to their employees. The Contractor's or Subcontractor's failure to comply with this requirement shall not transfer or in any way impose the responsible for worker safety upon the Owner or the Architect.
- § 3.7.3 If the Contractor performs Work which it knows or should have known was contrary to applicable laws, statutes, ordinances, codes, rules and regulations, or lawful orders of public authorities, the Contractor shall assume appropriate responsibility for such Work and shall bear the costs attributable to correction.
- § 3.7.4 CONCEALED OR UNKNOWN CONDITIONS. If the Contractor encounters conditions at the site that are (1) subsurface or otherwise concealed physical conditions that differ materially from those indicated in the Contract Documents or (2) unknown physical conditions of an unusual nature that differ materially from those ordinarily found to exist and generally recognized as inherent in construction activities of the character provided for in the Contract Documents, the Contractor shall promptly provide notice to the Owner, Construction Manager, and the Architect in writing before conditions are disturbed and in no event later than 14 days after first observance of the conditions. The Architect and Construction Manager will investigate such conditions with reasonable promptness and, if the Architect, in consultation with the Construction Manager, determines that they differ materially and cause an increase or decrease in the Contractor's cost of, or time required for, performance of any part of the Work, will recommend that an equitable adjustment be made in the Contract Sum or Contract Time, or both. If the Architect, in consultation with the Construction Manager, determines that the conditions at the site are not materially different from those indicated in the Contract Documents and that no change in the terms of the Contract is justified, the Architect shall promptly notify the Owner, Construction Manager, and Contractor, stating the reasons. If the Owner or Contractor disputes the Architect's determination or recommendation, either party may submit a Claim as provided in Article 15.
- § 3.7.5 If, in the course of the Work, the Contractor encounters human remains or recognizes the existence of burial markers, archaeological sites or wetlands not indicated in the Contract Documents, the Contractor shall immediately suspend any operations that would affect them and shall notify the Owner, Construction Manager, and Architect. Upon receipt of such notice, the Owner shall promptly take any action necessary to obtain governmental authorization required to resume the operations. The Contractor shall continue to suspend such operations until otherwise instructed by the Owner but shall continue with all other operations that do not affect those remains or features. Requests for adjustments in the Contract Sum and Contract Time arising from the existence of such remains or features may be made as provided in Article 15.

§ 3.8 Allowances

- § 3.8.1 The Contractor shall include in the Contract Sum all allowances stated in the Contract Documents
 - .1 Contingency Allowances shall cover the direct cost to the Contractor for labor, materials and equipment, including delivery, unloading, storage, handling and installation. They do not include the Contractor's overhead and profit, including the costs of bonds, insurance, administration and supervision, which costs should be carried as part of the Contract Sum.

§ 3.8.2

(Paragraphs deleted)

Materials and equipment under an allowance shall be selected by the Owner with reasonable promptness.

(Paragraph deleted)

§ 3.9 Superintendent

- § 3.9.1 The Contractor shall employ a competent superintendent and necessary assistants who shall be in attendance at the Project site full time during performance of the Work. The Superintendent shall be the same individual throughout the duration of the project. The superintendent shall represent the Contractor, and communications given to the superintendent shall be as binding as if given to the Contractor.
- § 3.9.2 The Contractor, as soon as practicable after award of the Contract, shall notify the Owner and Architect, through the Construction Manager, of the name and qualifications of a proposed superintendent. Within 14 days of receipt of the information, the Construction Manager may notify the Contractor, stating whether the Owner, the Construction Manager, or the Architect (1) has reasonable objection to the proposed superintendent or (2) require

additional time for review. Failure of the Construction Manager to provide notice within the 14-day period shall constitute notice of no reasonable objection.

§ 3.9.3 The Contractor shall not employ a proposed superintendent to whom the Owner, Construction Manager, or Architect has made reasonable and timely objection. The Contractor shall not change the superintendent without the Owner's consent, which shall not unreasonably be withheld or delayed.

§ 3.10 Contractor's Construction and Submittal Schedules

- § 3.10.1 The Contractor, after being awarded the Contract, shall submit for the Owner's and Architect's information, and the Construction Manager's use in developing the Project schedule, a Contractor's construction schedule for the Work. The schedule shall contain detail appropriate for the Project, including (1) the date of commencement of the Work, interim schedule milestone dates, and the date of Substantial Completion; (2) an apportionment of the Work by construction activity; and (3) the time required for completion of each portion of the Work. The schedule shall provide for the orderly progression of the Work to completion and shall not exceed time limits current under the Contract Documents. The schedule shall be revised at appropriate intervals as required by the conditions of the Work and Project. The Contractor shall cooperate with the Construction Manager in scheduling and performing the Contractor's Work to avoid conflict with, and as to cause no delay in, the work or activities of other Contractors, or the construction or operations of the Owner's own forces or Separate Contractors.
- § 3.10.2 The Contractor, after being awarded the Contract and thereafter as necessary to maintain a current submittal schedule, shall submit a submittal schedule for the Construction Manager's and Architect's approval. The Architect and Construction Manager's approval shall not be unreasonably delayed or withheld. The submittal schedule shall (1) be coordinated with the Contractor's construction schedule, and (2) allow the Construction Manager and Architect reasonable time in their respective judgments to review submittals. If the Contractor fails to submit a submittal schedule, or fails to provide submittals in accordance with the approved submittal schedule, the Contractor shall not be entitled to any increase in Contract Sum or extension of Contract Time based on the time required for review of submittals.
- § 3.10.3 The Contractor shall participate with other Contractors, the Construction Manager, and the Owner in reviewing and coordinating all schedules for incorporation into the Project schedule that is prepared by the Construction Manager. The Contractor shall make revisions to the construction schedule and submittal schedule as deemed necessary by the Construction Manager to conform to the Project schedule.
- § 3.10.4 The Contractor shall perform the Work in general accordance with the most recent schedules submitted to the Owner, Construction Manager, and Architect, and incorporated into the approved Project schedule.

§ 3.11 Documents and Samples at the Site

The Contractor shall maintain at the Project site for the Owner two sets of record Drawings and one set of record Specifications, Addenda, Change Orders, Allowance Authorizations, and other Modifications, in good order and marked currently to indicate field changes and selections made during construction, and one copy of approved Shop Drawings, Product Data, Samples, and similar required submittals in good order and condition. Each Prime Contractor shall mark these documents on a weekly basis to record all approved changes, and to record the dimensional locations of his installed work if it deviates from that shown on the Contract or Shop Drawings. Particular attention shall be given to site utilities, the location of valves, HVAC equipment, and all ductwork and major electrical conduit. These shall be in electronic form or paper copy, available to the Construction Manager, Architect, and Owner, and delivered to the Construction Manager for submittal to the Owner upon completion of the Work as a record of the Work as constructed.

§ 3.12 Shop Drawings, Product Data, and Samples

- § 3.12.1 Shop Drawings are drawings, diagrams, schedules, and other data specially prepared for the Work by the Contractor or a Subcontractor, Sub-subcontractor, manufacturer, supplier, or distributor to illustrate some portion of the Work.
- § 3.12.2 Product Data are illustrations, standard schedules, performance charts, instructions, brochures, diagrams, and other information furnished by the Contractor to illustrate materials or equipment for some portion of the Work.

- § 3.12.3 Samples are physical examples that illustrate materials, equipment, or workmanship, and establish standards by which the Work will be judged.
- § 3.12.4 Shop Drawings, Product Data, Samples, and similar submittals are not Contract Documents. Their purpose is to demonstrate how the Contractor proposes to conform to the information given and the design concept expressed in the Contract Documents for those portions of the Work for which the Contract Documents require submittals. Review by the Architect and Construction Manager is subject to the limitations of Sections 4.2.10 through 4.2.12. Informational submittals upon which the Construction Manager and Architect are not expected to take responsive action may be so identified in the Contract Documents. Submittals that are not required by the Contract Documents may be returned by the Construction Manager or Architect without action.
- § 3.12.5 The Contractor shall review for compliance with the Contract Documents, approve, and submit to the Construction Manager, Shop Drawings, Product Data, Samples, and similar submittals required by the Contract Documents, in accordance with the Project submittal schedule approved by the Construction Manager and Architect or, in the absence of an approved Project submittal schedule, with reasonable promptness and in such sequence as to cause no delay in the Work or in the activities of other Contractors, Separate Contractors, or the Owner's own forces. The Contractor shall cooperate with the Construction Manager in the coordination of the Contractor's Shop Drawings, Product Data, Samples, and similar submittals with related documents submitted by other Contractors.
- § 3.12.6 By submitting Shop Drawings, Product Data, Samples, and similar submittals, the Contractor represents to the Owner, Construction Manager, and Architect, that the Contractor has (1) reviewed and approved them, (2) determined and verified materials, field measurements and field construction criteria related thereto, or will do so, and (3) checked and coordinated the information contained within such submittals with the requirements of the Work and of the Contract Documents.
- § 3.12.7 Work performed without approved shop drawings, product data, samples or similar submittals as required by the Specifications is subject to all comments and conditions of approval regardless of Work progress. Completed work must be in accordance with all comments and conditions of approval regardless of Work progress. Completed work must be in accordance with all comments on approved submittals. Any portion of the Work performed prior to review and approval by the Construction Manager and Architect of required Shop Drawings, Product Data, Samples, or other Submittals, is performed at Contractor's risk. No Contract adjustments will be made to correct or modify Work installed without prior written approval of the Construction Manager and Architect.
- § 3.12.8 The Work shall be in accordance with approved submittals except that the Contractor shall not be relieved of responsibility for deviations from the requirements of the Contract Documents by the Architect's approval of Shop Drawings, Product Data, Samples, or similar submittals, unless the Contractor has specifically notified the Construction Manager and Architect in writing of such deviation at the time of submittal and (1) the Architect has given written approval to the specific deviation as a minor change in the Work, or (2) a Change Order or Construction Change Directive has been issued authorizing the deviation. The Contractor shall not be relieved of responsibility for errors or omissions in Shop Drawings, Product Data, Samples, or similar submittals, by the Architect's approval thereof.
- § 3.12.9 The Contractor shall direct specific attention, in writing or on resubmitted Shop Drawings, Product Data, Samples, or similar submittals, to revisions other than those requested by the Construction Manager and Architect on previous submittals. In the absence of such notice, the Architect's approval of a resubmission shall not apply to such revisions.
- § 3.12.10 The Contractor shall not be required to provide professional services that constitute the practice of architecture or engineering unless such services are specifically required by the Contract Documents for a portion of the Work or unless the Contractor needs to provide such services in order to carry out the Contractor's responsibilities for construction means, methods, techniques, sequences, and procedures. The Contractor shall not be required to provide professional services in violation of applicable law.
- § 3.12.10.1 If professional design services or certifications by a design professional related to systems, materials, or equipment are specifically required of the Contractor by the Contract Documents, the Owner and the Architect will specify all performance and design criteria that such services must satisfy. The Contractor shall be entitled to rely upon the adequacy and accuracy of the performance and design criteria provided in the Contract Documents. The Contractor shall cause such services or certifications to be provided by an appropriately licensed design professional,

(1932214867)

User Notes:

whose signature and seal shall appear on all drawings, calculations, specifications, certifications, Shop Drawings, and other submittals prepared by such professional. Shop Drawings, and other submittals related to the Work, designed or certified by such professional, if prepared by others, shall bear such professional's written approval when submitted to the Architect. The Owner, the Architect, and the Construction Manager shall be entitled to rely upon the adequacy and accuracy of the services, certifications, and approvals performed or provided by such design professionals, provided the Owner and Architect have specified to the Contractor the performance and design criteria that such services must satisfy. Pursuant to this Section 3.12.10, the Architect will review and approve or take other appropriate action on submittals only for the limited purpose of checking for conformance with information given and the design concept expressed in the Contract Documents. The Construction Manager shall review submittals for sequencing, constructability, and coordination impacts on other Contractors.

§ 3.12.10.2 If the Contract Documents require the Contractor's design professional to certify that the Work has been performed in accordance with the design criteria, the Contractor shall furnish such certifications to the Construction Manager and Architect at the time and in the form specified by the Architect.

§ 3.13 Use of Site

- § 3.13.1 The Contractor shall confine operations at the site to areas permitted by applicable laws, statutes, ordinances, codes, rules and regulations, lawful orders of public authorities, and the Contract Documents and shall not unreasonably encumber the site with materials or equipment.
- § 3.13.2 The Contractor shall coordinate the Contractor's operations with, and secure the approval of, the Construction Manager before using any portion of the site.

§ 3.14 Cutting and Patching

- § 3.14.1 The Contractor shall be responsible for cutting, fitting, or patching required to complete the Work or to make its parts fit together properly. All areas requiring cutting, fitting, or patching shall be restored to the condition existing prior to the cutting, fitting, or patching, unless otherwise required by the Contract Documents.
- § 3.14.2 The Contractor shall not damage or endanger a portion of the Work or fully or partially completed construction of the Owner, Separate Contractors, or of other Contractors by cutting, patching, or otherwise altering such construction, or by excavation. The Contractor shall not cut or otherwise alter construction by the Owner, Separate Contractors, or by other Contractors except with written consent of the Construction Manager, Owner, and such other Contractors or Separate Contractors. Consent shall not be unreasonably withheld. The Contractor shall not unreasonably withhold, from the Separate Contractors, other Contractors, or the Owner, its consent to cutting or otherwise altering the Work.

§ 3.15 Cleaning Up

- § 3.15.1 The Contractor shall keep the premises and surrounding area free from accumulation of waste materials and rubbish caused by operations under the Contract. At completion of the Work, the Contractor shall remove waste materials, rubbish, the Contractor's tools, construction equipment, machinery, and surplus materials from and about the Project.
- § 3.15.2 If the Contractor fails to clean up as provided in the Contract Documents, the Owner, or Construction Manager with the Owner's approval, may do so and the Owner shall be entitled to reimbursement from the Contractor.

§ 3.16 Access to Work

The Contractor shall provide the Owner, Construction Manager, and Architect with access to the Work in preparation and progress wherever located.

§ 3.17 Royalties, Patents and Copyrights

The Contractor shall pay all royalties and license fees. The Contractor shall defend suits or claims for infringement of copyrights and patent rights and shall hold the Owner, Construction Manager, and Architect harmless from loss on account thereof, but shall not be responsible for defense or loss when a particular design, process, or product of a particular manufacturer or manufacturers is required by the Contract Documents, or where the copyright violations are contained in Drawings, Specifications, or other documents prepared by the Owner, Architect, or Construction Manager. However, if an infringement of a copyright or patent is discovered by, or made known to, the Contractor, the

Contractor shall be responsible for the loss unless the information is promptly furnished to the Architect through the Construction Manager.

§ 3.18 Indemnification

§ 3.18.1 To the fullest extent permitted by law, the Contractor shall defend, indemnify and hold harmless the Owner, Construction Manager, Architect, each of their consultant's, officers, board members, agents, and employees from and against any suits, claims, damages, losses, or expenses, including but not limited to attorneys' fees and litigation costs, arising out of or resulting from performance of the Work, provided that such suit, claim, damage, loss or expense is attributable to any bodily injury, sickness, disease, or death, or injury to or destruction of any tangible property, including loss of use resulting therefrom, but only to the extent caused in whole or in part by the act, omission, fault, breach of contract, breach of warranty or statutory violation of the Contractor, a subcontractor, or any person or entity directly or indirectly employed by them, or any person or entity for whose acts they may be liable or arises out of operation of law as a consequence of any act or omission of the Contractor, any Subcontractor, anyone directly or indirectly employed by any of them, or anyone for whose acts any of the above may be liable, regardless of whether any of them has been negligent. This provision shall not be construed to require the Contractor to indemnify the Owner, Construction Manager, or Architect for the negligence of the Owner, Construction Manager, or Architect to the extent such negligence, in whole or in part, proximately caused the damages resulting in the suit, claim, damage, loss or expense."

§ 3.18.2 In claims against any person or entity indemnified under this Section 3.18 by an employee of the Contractor, a Subcontractor, anyone directly or indirectly employed by them, or anyone for whose acts they may be liable, the indemnification obligation under Section 3.18.1 shall not be limited by a limitation on amount or type of damages, compensation, or benefits payable by or for the Contractor or a Subcontractor under workers' compensation acts, disability benefit acts, or other employee benefit acts.

§ 3.19 DAILY RECORDS CLAUSE

§ 3.19.1 The Contractor shall prepare and maintain Daily Inspection Records to document the progress of the work on a daily basis. Such daily records shall include a detailed daily accounting of all labor and all equipment on the site for the Contractor and all subcontractors, at any tier. Such daily records will make a clear distinction between work being performed under Change Order, base scope work and/or disputed work.

§ 3.19.2 In the event that any labor or equipment is idled, solely as a result of Owner actions or inactions, the daily records shall record which laborers and equipment were idled and for how long. In the event that specific work activities were stopped, solely as a result of Owner actions or inactions, and labor and equipment was reassigned to perform work on other activities, the daily records will make a clear record of which activities were stopped and where labor and equipment was redirected to.

§ 3.19.3 Such daily records shall be copied and provided to the Owner at the end of every week.

ARTICLE 4 ARCHITECT AND CONSTRUCTION MANAGER

§ 4.1 General

§ 4.1.1 The Architect is the person or entity retained by the Owner pursuant to Section 2.3.2 and identified as such in the Agreement.

§ 4.1.2 Duties, responsibilities and limitations of authority of the Architect as set forth in the Contract Documents shall not be restricted, modified or extended without written consent of the Owner and Architect.

(Paragraph deleted)

§ 4.2 Administration of the Contract

§ 4.2.1 The Construction Manager and Architect will provide administration of the Contract as described in the Contract Documents and will be an Owner's Representative (1) during construction, (2) until 90 days after issuance of the State Education Department's Certificate of Substantial Completion or issuance of the Final Project Certificate for Payment, whichever is later, and (3) with the Owner's concurrence, from time to time during the one-year period for correction of Work described in Section 12.2. The Construction Manager and Architect will have authority to act on behalf of the Owner only to the extent provided in the Contract Documents, unless otherwise modified in writing in accordance with other provisions of the Contract.

- § 4.2.2 The Architect will visit the site at intervals appropriate to the stage of construction, or as otherwise agreed with the Owner, to become generally familiar with the progress and quality of the portion of the Work completed, and to determine in general if, in its professional judgment, the Work observed is being performed in a manner indicating that the Work, when fully completed, will be in accordance with the Contract Documents. However, the Architect will not be required to make exhaustive or continuous on-site inspections to check the quality or quantity of the Work. On the basis of the site visits, the Architect will keep the Owner and the Construction Manager reasonably informed about the progress and quality of the portion of the Work completed, and promptly report to the Owner and Construction Manager known deviations from the Contract Documents and defects and deficiencies observed in the Work.
- § 4.2.2.1 The Contractor shall reimburse the Owner for compensation paid to the Architect for additional site visits made necessary by the fault, neglect or request of the Contractor.
- § 4.2.3 The Construction Manager shall provide one or more representatives who shall be in attendance at the Project site whenever the Work is being performed. The Construction Manager will determine in general if the Work observed is being performed in accordance with the Contract Documents, will keep the Owner and Architect reasonably informed of the progress of the Work, and will promptly report to the Owner and Architect known deviations from the Contract Documents and the most recent Project schedule, and defects and deficiencies observed in the Work.
- § 4.2.4 The Construction Manager will schedule and coordinate the activities of the Contractor and other Contractors in accordance with the latest approved Project schedule.
- § 4.2.5 The Construction Manager, except to the extent required by Section 4.2.4, and Architect will not have control over, charge of, or responsibility for, the construction means, methods, techniques, sequences or procedures, or for the safety precautions and programs in connection with the Work, since these are solely the Contractor's rights and responsibilities under the Contract Documents, and neither will be responsible for the Contractor's failure to perform the Work in accordance with the requirements of the Contract Documents. Neither the Construction Manager nor the Architect will have control over or charge of, or be responsible for acts or omissions of, the Contractor, Subcontractors, or their agents or employees, or of any other persons or entities performing portions of the Work.
- § 4.2.6 Communications. The Owner shall communicate with the Contractor and the Construction Manager's consultants through the Construction Manager about matters arising out of or relating to the Contract Documents. The Owner and Construction Manager shall include the Architect in all communications that relate to or affect the Architect's services or professional responsibilities. The Owner shall promptly notify the Architect of the substance of any direct communications between the Owner and the Construction Manager otherwise relating to the Project. Communications by and with the Architect's consultants shall be through the Architect. Communications by and with Subcontractors and suppliers shall be through the Contractor. Communications by and with other Contractors shall be through the Construction Manager. Communications by and with the Owner's own forces and Separate Contractors shall be through the Owner. The Contract Documents may specify other communication protocols.
- § 4.2.7 The Construction Manager and Architect will review and certify all Applications for Payment by the Contractor, in accordance with the provisions of Article 9.
- § 4.2.8 The Architect and Construction Manager have authority to reject Work that does not conform to the Contract Documents, and will notify each other about the rejection. Whenever the Construction Manager considers it necessary or advisable, the Construction Manager will have authority to require inspection or testing of the Work in accordance with Sections 13.4.2 and 13.4.3, upon written authorization of the Owner, whether or not the Work is fabricated, installed or completed. The foregoing authority of the Construction Manager will be subject to the provisions of Sections 4.2.18 through 4.2.20 inclusive, with respect to interpretations and decisions of the Architect. However, neither the Architect's nor the Construction Manager's authority to act under this Section 4.2.8 nor a decision made by either of them in good faith either to exercise or not to exercise such authority shall give rise to a duty or responsibility of the Architect or the Construction Manager to the Contractor, Subcontractors, suppliers, their agents or employees, or other persons performing any of the Work.
- § 4.2.9 Utilizing the submittal schedule provided by the Contractor, the Construction Manager shall prepare, and revise as necessary, a Project submittal schedule incorporating information from other Contractors, the Owner, Owner's consultants, Owner's Separate Contractors and vendors, governmental agencies, and participants in the

Project under the management of the Construction Manager. The Project submittal schedule and any revisions shall be submitted to the Architect for approval.

- § 4.2.10 The Construction Manager will receive and promptly review for conformance with the submittal requirements of the Contract Documents, all submittals from the Contractor such as Shop Drawings, Product Data, and Samples. Where there are other Contractors, the Construction Manager will also check and coordinate the information contained within each submittal received from the Contractor and other Contractors, and transmit to the Architect those recommended for approval. By submitting Shop Drawings, Product Data, Samples, and similar submittals, the Construction Manager represents to the Owner and Architect that the Construction Manager has reviewed and recommended them for approval. The Construction Manager's actions will be taken in accordance with the Project submittal schedule approved by the Architect or, in the absence of an approved Project submittal schedule, with reasonable promptness while allowing sufficient time to permit adequate review by the Architect.
- § 4.2.11 The Architect will review and approve, or take other appropriate action upon, the Contractor's submittals such as Shop Drawings, Product Data, and Samples, but only for the limited purpose of checking for conformance with information given and the design concept expressed in the Contract Documents. The Architect's action will be taken in accordance with the submittal schedule approved by the Architect or, in the absence of an approved submittal schedule, with reasonable promptness while allowing sufficient time in the Architect's professional judgment to permit adequate review. Upon the Architect's completed review, the Architect shall transmit its submittal review to the Construction Manager.
- § 4.2.12 Review of the Contractor's submittals by the Construction Manager and Architect is not conducted for the purpose of determining the accuracy and completeness of other details such as dimensions and quantities, or for substantiating instructions for installation or performance of equipment or systems, all of which remain the responsibility of the Contractor as required by the Contract Documents. The Construction Manager and Architect's review of the Contractor's submittals shall not relieve the Contractor of the obligations under Sections 3.3, 3.5, and 3.12. The Construction Manager and Architect's review shall not constitute approval of safety precautions or of any construction means, methods, techniques, sequences, or procedures. The Architect's approval of a specific item shall not indicate approval of an assembly of which the item is a component.
- § 4.2.13 The Construction Manager will prepare Change Orders and Construction Change Directives.
- § 4.2.14 The Construction Manager and the Architect will take appropriate action on Change Orders or Construction Change Directives in accordance with Article 7, and the Architect will have authority to order minor changes in the Work as provided in Section 7.4. The Architect, in consultation with the Construction Manager, will investigate and make determinations and recommendations regarding concealed and unknown conditions as provided in Section 3.7.4.
- § 4.2.15 Utilizing the documents provided by the Contractor, the Construction Manager will maintain at the site for the Owner one copy of all Contract Documents, approved Shop Drawings, Product Data, Samples, and similar required submittals, in good order and marked currently to record all changes and selections made during construction. These will be available to the Architect and the Contractor, and will be delivered to the Owner upon completion of the Project.
- § 4.2.16 The Construction Manager will assist the Architect in conducting inspections to determine the date or dates of Substantial Completion and the date of final completion; issue Certificates of Substantial Completion in conjunction with the Architect pursuant to Section 9.8; and receive and forward to the Owner written warranties and related documents required by the Contract and assembled by the Contractor pursuant to Section 9.10. The Construction Manager will forward to the Architect a final Application and Certificate for Payment or final Project Application and Project Certificate for Payment upon the Contractor's compliance with the requirements of the Contract Documents.
- § 4.2.17 The Owner shall notify the Construction Manager of any change in the duties, responsibilities and limitations of authority of the Project representatives.
- § 4.2.18 The Architect will interpret and decide matters concerning performance of the Contractor under, and requirements of, the Contract Documents on written request of the Construction Manager, Owner, or Contractor

through the Construction Manager. The Architect's response to such requests will be made in writing within any time limits agreed upon or otherwise with reasonable promptness.

§ 4.2.19 Interpretations and decisions of the Architect will be consistent with the intent of, and reasonably inferable from, the Contract Documents and will be in writing or in the form of drawings. The Architect will not be liable for the results of any such interpretations or decisions rendered in good faith and in accordance with its professional judgment.

(Paragraph deleted)

§ 4.2.21 The Construction Manager will receive and review requests for information from the Contractor, and forward each request for information to the Architect, with the Construction Manager's recommendation. The Architect will review and respond in writing, through the Construction Manager, to requests for information about the Contract Documents. The Construction Manager's recommendation and the Architect's response to each request will be made in writing within any time limits agreed upon or otherwise with reasonable promptness but, in any event, allowing the Architect sufficient time in its professional judgment to properly review the request. If appropriate, the Architect will prepare and issue supplemental Drawings and Specifications in response to the requests for information.

ARTICLE 5 SUBCONTRACTORS

§ 5.1 Definitions

- § 5.1.1 A Subcontractor is a person or entity who has a direct contract with the Contractor to perform a portion of the Work at the site. The term "Subcontractor" is referred to throughout the Contract Documents as if singular in number and means a Subcontractor or an authorized representative of the Subcontractor. The term "Subcontractor" does not include Separate Contractors or the subcontractors of other Contractors or Separate Contractors.
- § 5.1.2 A Sub-subcontractor is a person or entity who has a direct or indirect contract with a Subcontractor to perform a portion of the Work at the site. The term "Sub-subcontractor" is referred to throughout the Contract Documents as if singular in number and means a Sub-subcontractor or an authorized representative of the Sub-subcontractor.

§ 5.2 Award of Subcontracts and Other Contracts for Portions of the Work

- § 5.2.1 As stated in the bidding requirements, the Contractor, shall notify in writing for review by the Construction Manager and Architect, of the persons or entities proposed for each principal portion of the Work, including those who are to furnish materials or equipment fabricated to a special design. Within 14 days of receipt of the information, the Construction Manager may notify the Contractor whether the Owner, the Construction Manager or the Architect (1) has reasonable objection to any such proposed person or entity or, (2) requires additional time for review.
- § 5.2.2 The Contractor shall not contract with a proposed person or entity to whom the Owner, Construction Manager or Architect has made reasonable and timely objection. The Contractor shall not be required to contract with anyone to whom the Contractor has made reasonable objection.
- § 5.2.3 If the Owner, Construction Manager or Architect has reasonable objection to a person or entity proposed by the Contractor, the Contractor shall propose another to whom the Owner, Construction Manager or Architect has no reasonable objection. If the proposed but rejected Subcontractor was reasonably capable of performing the Work, the Contract Sum and Contract Time shall be increased or decreased by the difference, if any, occasioned by such change, and an appropriate Change Order shall be issued before commencement of the substitute Subcontractor's Work. However, no increase in the Contract Sum or Contract Time shall be allowed for such change unless the Contractor has acted promptly and responsively in submitting names as required.
- § 5.2.4 The Contractor shall not substitute a Subcontractor, person, or entity for one previously selected if the Owner, Construction Manager or Architect makes reasonable objection to such substitution.

§ 5.3 Subcontractual Relations

By appropriate written agreement, the Contractor shall require each Subcontractor, to the extent of the Work to be performed by the Subcontractor, to be bound to the Contractor by terms of the Contract Documents, and to assume toward the Contractor all the obligations and responsibilities, including, but not limited to, the responsibility for safety of the Subcontractor's Work and obligations to defend and indemnify, that the Contractor, by these Contract Documents, assumes toward the Owner, Construction Manager and Architect. Each subcontract agreement shall

preserve and protect the rights of the Owner, Construction Manager and Architect under the Contract Documents with respect to the Work to be performed by the Subcontractor so that subcontracting thereof will not prejudice such rights, and shall allow to the Subcontractor, unless specifically provided otherwise in the subcontract agreement, the benefit of all rights, remedies, and redress against the Contractor that the Contractor, by the Contract Documents, has against the Owner. Where appropriate, the Contractor shall require each Subcontractor to enter into similar agreements with Sub-subcontractors. The Contractor shall make available to each proposed Subcontractor, prior to the execution of the subcontract agreement, copies of the Contract Documents to which the Subcontractor will be bound, and, upon written request of the Subcontractor, identify to the Subcontractor terms and conditions of the proposed subcontract agreement that may be at variance with the Contract Documents. Subcontractors will similarly make copies of applicable portions of such documents available to their respective proposed Sub-subcontractors.

§ 5.4 Contingent Assignment of Subcontracts

- § 5.4.1 Each subcontract agreement for a portion of the Work is assigned by the Contractor to the Owner, provided that
 - assignment is effective only after termination of the Contract by the Owner for cause pursuant to Section 14.2 and only for those subcontract agreements that the Owner accepts by notifying the Subcontractor and Contractor; and
 - .2 assignment is subject to the prior rights of the surety, if any, obligated under bond relating to the Contract.

When the Owner accepts the assignment of a subcontract agreement, the Owner assumes the Contractor's rights and obligations under the subcontract.

- § 5.4.2 Upon such assignment, if the Work has been suspended for more than 30 days, the Subcontractor's compensation shall be equitably adjusted for increases in cost resulting from the suspension.
- § 5.4.3 Upon assignment to the Owner under this Section 5.4, the Owner may further assign the subcontract to a successor Contractor or other entity. If the Owner assigns the subcontract to a successor Contractor or other entity, the Owner shall nevertheless remain legally responsible for all of the successor Contractor's obligations under the subcontract.

ARTICLE 6 CONSTRUCTION BY OWNER OR BY SEPARATE CONTRACTORS

- § 6.1 Owner's Right to Perform Construction with Own Forces and to Award Other Contracts
- § 6.1.1 The Owner reserves the right to perform construction or operations related to the Project with the Owner's own forces, and with Separate Contractors retained under Conditions of the Contract substantially similar to those of this Contract, including those provisions of the Conditions of the Contract related to insurance and waiver of subrogation.

(Paragraph deleted)

§ 6.1.3 Unless otherwise provided in the Contract Documents, when the Owner performs construction or operations related to the Project with the Owner's own forces or with Separate Contractors, the Owner or its Separate Contractors shall have the same obligations and rights that the Contractor has under the Conditions of the Contract, including, without excluding others, those stated in Article 3, this Article 6, and Articles 10, 11, and 12.

§ 6.2 Mutual Responsibility

- § 6.2.1 The Contractor shall afford the Owner's own forces, Separate Contractors, Construction Manager and other Contractors reasonable opportunity for introduction and storage of their materials and equipment and performance of their activities, and shall connect and coordinate the Contractor's construction and operations with theirs as required by the Contract Documents.
- § 6.2.2 If part of the Contractor's Work depends for proper execution or results upon construction or operations by the Owner's own forces, Separate Contractors or other Contractors, the Contractor shall, prior to proceeding with that portion of the Work, promptly notify the Construction Manager and Architect in writing and in detail of apparent discrepancies or defects in the construction or operations by the Owner or Separate Contractor or other Contractors that would render it unsuitable for proper execution and results of the Contractor's Work. Failure of the Contractor to notify the Construction Manager and the Architect of apparent discrepancies or defects prior to proceeding with the Work shall constitute an acknowledgment that the Owner's or Separate Contractor's or other Contractors' completed or partially completed construction is fit and proper to receive the Contractor's Work. The Contractor shall not be

responsible for discrepancies or defects in the construction or operations by the Owner or Separate Contractors or other Contractors that are not apparent.

- § 6.2.3 The Contractor shall reimburse the Owner for costs the Owner incurs, including costs that are payable to a Separate Contractors or to other Contractors, because of the Contractor's delays, improperly timed activities or defective construction
- § 6.2.4 The Contractor shall promptly remedy damage that the Contractor wrongfully causes to completed or partially completed construction, or to property of the Owner, Separate Contractors, or other Contractors as provided in Section 10.2.5.
- § 6.2.5 The Owner, Separate Contractors, and other Contractors shall have the same responsibilities for cutting and patching as are described for the Contractor in Section 3.14.

§ 6.3 Owner's Right to Clean Up

If a dispute arises among the Contractor, Separate Contractors, other Contractors, and the Owner as to the responsibility under their respective contracts for maintaining the premises and surrounding area free from waste materials and rubbish, the Owner may clean up and the Construction Manager, with notice to the Architect, will allocate the cost among those responsible.

ARTICLE 7 CHANGES IN THE WORK

§ 7.1 General

- § 7.1.1 Changes in the Work may be accomplished after execution of the Contract, and without invalidating the Contract, by Change Order, Construction Change Directive or order for a minor change in the Work, subject to the limitations stated in this Article 7 and elsewhere in the Contract Documents.
- § 7.1.2 A Change Order shall be based upon agreement among the Owner, Construction Manager, Architect and Contractor. A Construction Change Directive requires agreement by the Owner, Construction Manager and Architect and may or may not be agreed to by the Contractor. An order for a minor change in the Work may be issued by the Architect alone.
- § 7.1.3 Changes in the Work shall be performed under applicable provisions of the Contract Documents. The Contractor shall proceed promptly with changes in the Work, unless otherwise provided in the Change Order, Construction Change Directive, or order for a minor change in the Work.

§ 7.2 Change Orders

A Change Order is a written instrument prepared by the Construction Manager and signed by the Owner, Construction Manager, Architect, and Contractor, stating their agreement upon all of the following:

- .1 The change in the Work;
- .2 The amount of the adjustment, if any, in the Contract Sum; and
- .3 The extent of the adjustment, if any, in the Contract Time.

§ 7.3 Construction Change Directives

- § 7.3.1 A Construction Change Directive is a written order prepared by the Construction Manager and signed by the Owner, Construction Manager and Architect, directing a change in the Work prior to agreement on adjustment, if any, in the Contract Sum or Contract Time, or both. The Owner may by Construction Change Directive, without invalidating the Contract, order changes in the Work within the general scope of the Contract consisting of additions, deletions, or other revisions, the Contract Sum and Contract Time being adjusted accordingly.
- § 7.3.2 A Construction Change Directive shall be used in the absence of total agreement on the terms of a Change Order.
- § 7.3.3 If the Construction Change Directive provides for an adjustment to the Contract Sum, the adjustment shall be based on one of the following methods:
 - .1 Mutual acceptance of a lump sum properly itemized and supported by sufficient substantiating data to permit evaluation;
 - .2 Unit prices stated in the Contract Documents or subsequently agreed upon;

- .3 Cost to be determined in a manner agreed upon by the parties and a mutually acceptable fixed or percentage fee; or
- .4 As provided in Section 7.3.4.
- § 7.3.4 If the Contractor does not respond promptly or disagrees with the method for adjustment in the ContractSum, the Construction Manager shall determine the adjustment on the basis of reasonable expenditures and savings of those performing the Work attributable to the change, including, in case of an increase in the Contract Sum, an amount for overhead and profit as set forth in the Contract Documents, or if no such amount is set forth in the Contract Documents, a reasonable amount. In such case, and also under Section 7.3.3.3, the Contractor shall keep and present, in such form as the Construction Manager may prescribe, an itemized accounting together with appropriate supporting data. Unless otherwise provided in the Contract Documents, costs for the purposes of this Section 7.3.4 shall be limited to the following:
 - .1 Costs of labor, including applicable payroll taxes, fringe benefits required by agreement or custom, workers' compensation insurance directly related to the work, and other employee costs approved by the Construction Manager and Architect;
 - .2 Costs of materials, supplies, and equipment, including cost of transportation, whether incorporated or consumed;
 - .3 Rental costs of machinery and equipment, exclusive of hand tools and equipment normally encumbered to perform the work, whether rented from the Contractor or others;
 - .4 Costs of supervision by the Site Superintendent directly attributable to the change, if the change requires an extension of time beyond that time indicated in the Contract.
- § 7.3.5 If the Contractor disagrees with the adjustment in the Contract Time, the Contractor may make a Claim in accordance with applicable provisions of Article 15.
- § 7.3.6 Upon receipt of a Construction Change Directive, the Contractor shall promptly proceed with the change in the Work involved and advise the Construction Manager of the Contractor's agreement or disagreement with the method, if any, provided in the Construction Change Directive for determining the proposed adjustment in the Contract Sum or Contract Time.
- § 7.3.7 A Construction Change Directive signed by the Contractor indicates the Contractor's agreement therewith, including adjustment in Contract Sum and Contract Time or the method for determining them. Such agreement shall be effective immediately and shall be recorded as a Change Order.
- § 7.3.8 The amount of credit to be allowed by the Contractor to the Owner for a deletion or change that results in a net decrease in the Contract Sum shall be actual net cost as confirmed by the Construction Manager and Architect. When both additions and credits covering related Work or substitutions are involved in a change, the allowance for overhead and profit shall be figured on the basis of net increase, if any, with respect to that change.
- § 7.3.9 Pending final determination of the total cost of a Construction Change Directive to the Owner, the Contractor may request payment for Work completed under the Construction Change Directive in Applications for Payment. The Construction Manager and Architect will make an interim determination for purposes of monthly certification for payment for those costs and certify for payment the amount that the Construction Manager and Architect determine to be reasonably justified. The interim determination of cost shall adjust the Contract Sum on the same basis as a Change Order, subject to the right of either party to disagree and assert a Claim in accordance with Article 15.
- § 7.3.10 When the Owner and Contractor agree with a determination made by the Construction Manager and Architect concerning the adjustments in the Contract Sum and Contract Time, or otherwise reach agreement upon the adjustments, such agreement shall be effective immediately and the Construction Manager shall prepare a Change Order. Change Orders may be issued for all or any part of a Construction Change Directive.

§ 7.4 Minor Changes in the Work

The Architect may order minor changes in the Work that are consistent with the intent of the Contract Documents and do not involve an adjustment in the Contract Sum or an extension of the Contract Time. The Architect's order for minor changes shall be in writing. If the Contractor believes that the proposed minor change in the Work will affect the Contract Sum or Contract Time, the Contractor shall notify the Construction Manager and shall not proceed to implement the change in the Work. If the Contractor performs the Work set forth in the Architect's order for a minor

change without prior notice to the Construction Manager that such change will affect the Contract Sum or Contract Time, the Contractor waives any adjustment to the Contract Sum or extension of the Contract Time.

§ 7.5 OVERHEAD AND PROFIT

- § 7.5.1 The combined overhead and profit included in the total cost to the Owner shall be based on the following schedule:
- § 7.5.1.a Prime Contractor: For Work performed by the Prime Contractor's own forces, markup shall not exceed a total of fifteen percent (15%), of the value of labor and materials (L+M).
 - .1 Example: Total Prime Contractor Amount = (L+M) + 15% O&P
- § 7.5.1.b Prime Contractor's Subcontractor: For Work performed by the Subcontractor's own forces, markup shall not exceed a total of ten percent (10%), of the value of labor and material (L+M). For the Prime Contractor, for work performed by that Prime Contractor's Subcontractor, markup shall not exceed five percent (5%) for the value of the Subcontractor amount.
 - .1 Example: Total Subcontractor Amount = (L+M) + 10% O&P
 - .2 Example: Total Prime Contractor Amount = Total Subcontract Amount + 5% O&P
- § 7.5.1.c Sub-Subcontractor: For Work performed by the Subcontractor's own forces, markup shall not exceed a total of five percent (5%) of the value of labor and materials (L+M). For the Subcontractor, for work performed by the Subcontractor's Sub-subcontract, markup shall not exceed 5% of the Subcontractor Amount. For the Prime Contractor, for Work performed by the Subcontractor's Sub-subcontractor, markup shall not exceed 5% of the Subcontractor Amount.
 - .1 Example: Total Sub-subcontractor Amount = (L+M) + 5% O&P
 - .2 Example: Total Subcontractor Amount = Sub-subcontractor Amount + 5% O&P
 - .3 Example: Total Prime Contractor Amount = Subcontractor Amount + 5% O&P
- § 7.5.2 Performance and Payment Bond Adjustments: Do not itemize increases for bond premiums for each individual Change Order per General Conditions of the Contract, Paragraph 11.4.

ARTICLE 8 TIME

§ 8.1 Definitions

- § 8.1.1 Unless otherwise provided, Contract Time is the period of time, including authorized adjustments, allotted in the Contract Documents for Substantial Completion of the Work.
- § 8.1.2 The date of commencement of the Work is the date established in the Agreement.
- § 8.1.3 The date of Substantial Completion is the date certified by the Architect in accordance with Section 9.8. The Work of this Project shall be substantially complete on or before the dates indicated in Milestone Construction Schedule for those portions of the Work so stipulated. Actual damages may be assessed by the Owner if specified completion dates are not adhered to by the Contractor.
- § 8.1.4 The term "day" as used in the Contract Documents shall mean calendar day unless otherwise specifically defined.

§ 8.2 Progress and Completion

- § 8.2.1 Time limits stated in the Contract Documents are of the essence of the Contract. By executing the Agreement, the Contractor confirms that the Contract Time is a reasonable period for performing the Work.
- § 8.2.2 The Contractor shall not knowingly, except by agreement or instruction of the Owner in writing, commence the Work prior to the effective date of insurance required to be furnished by the Contractor and Owner.

User Notes:

§ 8.2.3 The Contractor shall proceed expeditiously with adequate forces and shall achieve Substantial Completion within the Contract Time.

§ 8.3 Delays and Extensions of Time

- § 8.3.1 If the Contractor is delayed at any time in the commencement or progress of the Work by (1) an act or neglect of the Owner, Architect, Construction Manager, or an employee of any of them, or of the Owner's own forces, Separate Contractors, or other Contractors; (2) by changes ordered in the Work; (3) by labor disputes, fire, unusual delay in deliveries, unavoidable casualties, adverse weather conditions documented in accordance with Section 15.1.6.2, or other causes beyond the Contractor's control; (4) by delay authorized by the Owner pending mediation and binding dispute resolution; or (5) by other causes that the Contractor asserts and the Architect, based on the recommendation of the Construction Manager, determines justify delay, then the Contract Time shall be extended for such reasonable time as the Architect may determine.
- § 8.3.2 Claims relating to time shall be made in accordance with applicable provisions of Article 15.
- § 8.3.3 The Owner shall not be liable to the Contractor and/or any subcontractor for claims or damages of any nature caused by or arising out of delays. The sole remedy against the Owner for delays shall be the allowance of additional time for completion of the Work, the amount of which shall be subject to the claims procedure set forth herein. Except to the extent, if any, expressly prohibited by law, the Contractor expressly agrees not to make and hereby waives any claim for damages for delay, including, but not limited to, those resulting from increased labor or material costs; directions given or not given by the Owner, Construction Manager or Architect, including scheduling and coordination of the Work; the Architect's preparation of drawings and specifications or review of shop drawings and requests for instruction(s); or, on account of any delay, obstruction or hindrance for any cause whatsoever by the Owner, Construction Manager, Architect, or any other contractor on the project, whether or not foreseeable or anticipated. The Contractor agrees that its sole right and remedy therefor shall be an extension of time, if appropriate. IT IS EMPHASIZED THAT NO MONETARY RECOVERY MAY BE OBTAINED BY THE CONTRACTOR FOR DELAY AGAINST THE OWNER, CONSTRUCTION MANAGER, OR ARCHITECT BASED ON ANY REASON AND THAT THE CONTRACTOR'S SOLE REMEDY, IF APPROPRIATE, IS ADDITIONAL TIME."

PAYMENTS AND COMPLETION ARTICLE 9

§ 9.1 Contract Sum

- § 9.1.1 The Contract Sum is stated in the Agreement and, including authorized adjustments, is the total amount payable by the Owner to the Contractor for performance of the Work under the Contract Documents.
- § 9.1.2 If unit prices are stated in the Contract Documents or subsequently agreed upon, and if quantities originally contemplated are materially changed so that application of such unit prices to the actual quantities causes substantial inequity to the Owner or Contractor, the applicable unit prices shall be equitably adjusted.

§ 9.2 Schedule of Values

As indicated in the Contract Documents, the Contractor shall submit a schedule of values to the Construction Manager, before the first Application for Payment, allocating the entire Contract Sum to the various portions of the Work. The schedule of values shall be prepared in the form, and supported by the data to substantiate its accuracy, required by the Construction Manager and the Architect. This schedule, unless objected to by the Construction Manager or Architect, shall be used as a basis for reviewing the Contractor's Applications for Payment. The Construction Manager shall forward to the Architect the Contractor's schedule of values. Any changes to the schedule of values shall be submitted to the Construction Manager and supported by such data to substantiate its accuracy as the Construction Manager and the Architect may require, and unless objected to by the Construction Manager or the Architect, shall be used as a basis for reviewing the Contractor's subsequent Applications for Payment.

§ 9.3 Applications for Payment

- § 9.3.1 The Contractor shall submit applications for payment in accordance with Specification Section "Payment Procedures."
- § 9.3.1.1 As provided in Section 7.3.9, such applications may include requests for payment on account of changes in the Work that have been properly authorized by Construction Change Directives, or by interim determinations of the Construction Manager and Architect, but not yet included in Change Orders.

- § 9.3.1.2 Applications for Payment shall not include requests for payment for portions of the Work for which the Contractor does not intend to pay a Subcontractor or supplier, unless such Work has been performed by others whom the Contractor intends to pay.
- § 9.3.1.3 Until Substantial Completion, the Owner shall pay ninety-five percent (95%) of the amount due to the Contractor on account of progress payments.
- § 9.3.1.4 When the work or major portions thereof as contemplated by the terms of the Contract are substantially complete, the Contractor shall submit to the Construction Manager and Architect a requisition for payment of the remaining amount of the Contract balance. Upon receipt of such requisition, the Owner shall approve and promptly pay the remaining amount of the Contract less two times the value of any remaining items to be completed and an amount necessary to satisfy any claims, liens or judgments against the Contractor, which have not been suitably discharged, as determined by the Architect in conjunction with the Construction Manager. Any claims, liens or judgments referred to in this clause shall pertain to the Project and shall be filed in accordance with the terms of the Contract, and applicable laws.
- § 9.3.2 Unless otherwise provided in the Contract Documents, payments shall be made on account of materials and equipment delivered and suitably stored at the site for subsequent incorporation in the Work. If approved in advance by the Owner, payment may similarly be made for materials and equipment suitably stored off the site at a location agreed upon in writing. Payment for materials and equipment stored on or off the site shall be conditioned upon compliance by the Contractor with procedures satisfactory to the Owner to establish the Owner's title to such materials and equipment or otherwise protect the Owner's interest, and shall include the costs of applicable insurance, storage, and transportation to the site, for such materials and equipment stored off the site. The Owner shall have the right, at any time on reasonable notice to inspect materials and equipment which have been stored off the site in accordance with this paragraph.
- § 9.3.2.1 Proof of insurance for items stored off site and copies of invoices are to be provided with Applications for Payment requesting payment for stored materials.
- § 9.3.3 The Contractor warrants that title to all Work covered by an Application for Payment will pass to the Owner no later than the time of payment. The Contractor further warrants that upon submittal of an Application for Payment all Work for which Certificates for Payment have been previously issued and payments received from the Owner shall, to the best of the Contractor's knowledge, information, and belief, be free and clear of liens, claims, security interests, or encumbrances, in favor of the Contractor, Subcontractors, suppliers, or other persons or entities that provided labor, materials and equipment relating to the Work.

§ 9.4 Certificates for Payment

- § 9.4.1 Where there is only one Contractor, the Construction Manager will, within seven days after the Construction Manager's receipt of the Contractor's Application for Payment, review the Application, certify the amount the Construction Manager determines is due the Contractor, and forward the Contractor's Application and Certificate for Payment to the Architect. Within seven days after the Architect receives the Contractor's Application for Payment from the Construction Manager, the Architect will either (1) issue to the Owner a Certificate for Payment, in the full amount of the Application for Payment, with a copy to the Construction Manager; or (2) issue to the Owner a Certificate for Payment for such amount as the Architect determines is properly due, and notify the Construction Manager and Owner of the Architect's reasons for withholding certification in part as provided in Section 9.5.1; or (3) withhold certification of the entire Application for Payment, and notify the Construction Manager and Owner of the Architect's reason for withholding certification in whole as provided in Section 9.5.1. The Construction Manager will promptly forward to the Contractor the Architect's notice of withholding certification.
- § 9.4.2 Where there is more than one Contractor performing portions of the Project, the Construction Manager will, within seven days after the Construction Manager receives all of the Contractors' Applications for Payment: (1) review the Applications and certify the amount the Construction Manager determines is due each of the Contractors; (2) prepare a Summary of Contractors' Applications for Payment by combining information from each Contractor's application with information from similar applications for progress payments from the other Contractors; (3) prepare a Project Application and Certificate for Payment; (4) certify the amount the Construction Manager determines is due

all Contractors; and (5) forward the Summary of Contractors' Applications for Payment and Project Application and Certificate for Payment to the Architect.

- § 9.4.2.1 Within seven days after the Architect receives the Project Application and Project Certificate for Payment and the Summary of Contractors' Applications for Payment from the Construction Manager, the Architect will either (1) issue to the Owner a Project Certificate for Payment, with a copy to the Construction Manager; or (2) issue to the Owner a Project Certificate for Payment for such amount as the Architect determines is properly due, and notify the Construction Manager and Owner of the Architect's reasons for withholding certification in part as provided in Section 9.5.1; or (3) withhold certification of the entire Project Application for Payment, and notify the Construction Manager and Owner of the Architect's reason for withholding certification in whole as provided in Section 9.5.1. The Construction Manager will promptly forward the Architect's notice of withholding certification to the Contractors.
- § 9.4.3 The Construction Manager's certification of an Application for Payment or, in the case of more than one Contractor, a Project Application and Certificate for Payment, shall be based upon the Construction Manager's evaluation of the Work and the data in the Application or Applications for Payment. The Construction Manager's certification will constitute a representation that, to the best of the Construction Manager's knowledge, information, and belief, the Work has progressed to the point indicated, the quality of the Work is in accordance with the Contract Documents, and that the Contractor is, or Contractors are, entitled to payment in the amount certified.
- § 9.4.4 The Architect's issuance of a Certificate for Payment or, in the case of more than one Contractor, Project Application and Certificate for Payment, shall be based upon the Architect's evaluation of the Work, the recommendation of the Construction Manager, and data in the Application for Payment or Project Application for Payment. The Architect's certification will constitute a representation that, to the best of the Architect's judgment, knowledge, information, and belief, the Work has progressed to the point indicated, the quality of the Work is in accordance with the Contract Documents, and that the Contractor is, or Contractors are, entitled to payment in the amount certified.
- § 9.4.5 The representations made pursuant to Sections 9.4.3 and 9.4.4 are subject to an evaluation of the Work for conformance with the Contract Documents upon Substantial Completion, to results of subsequent tests and inspections, to correction of minor deviations from the Contract Documents prior to completion, and to specific qualifications expressed by the Construction Manager or Architect.
- § 9.4.6 The issuance of a Certificate for Payment or a Project Certificate for Payment will not be a representation that the Construction Manager or Architect has (1) made exhaustive or continuous on-site inspections to check the quality or quantity of the Work; (2) reviewed construction means, methods, techniques, sequences, or procedures; (3) reviewed copies of requisitions received from Subcontractors and suppliers and other data requested by the Owner to substantiate the Contractor's right to payment; or (4) made examination to ascertain how or for what purpose the Contractor has used money previously paid on account of the Contract Sum.

§ 9.5 Decisions to Withhold Certification

- § 9.5.1 The Construction Manager or Architect may withhold a Certificate for Payment or Project Certificate for Payment in whole or in part, to the extent reasonably necessary to protect the Owner, if in the Construction Manager's or Architect's opinion the representations to the Owner required by Section 9.4.3 and 9.4.4 cannot be made. If the Construction Manager or Architect is unable to certify payment in the amount of the Application, the Construction Manager will notify the Contractor and Owner as provided in Section 9.4.1 and 9.4.2. If the Contractor, Construction Manager and Architect cannot agree on a revised amount, the Architect will promptly issue a Certificate for Payment or a Project Certificate for Payment for the amount for which the Architect is able to make such representations to the Owner. The Construction Manager or Architect may also withhold a Certificate for Payment or, because of subsequently discovered evidence, may nullify the whole or a part of a Certificate for Payment or Project Certificate for Payment previously issued, to such extent as may be necessary in the Construction Manager's or Architect's opinion to protect the Owner from loss for which the Contractor is responsible, including loss resulting from the acts and omissions described in Section 3.3.2 because of
 - .1 defective Work not remedied;
 - .2 third party claims filed or reasonable evidence indicating probable filing of such claims, unless security acceptable to the Owner is provided by the Contractor;
 - .3 failure of the Contractor to make payments properly to Subcontractors or suppliers for labor, materials or equipment;
 - .4 reasonable evidence that the Work cannot be completed for the unpaid balance of the Contract Sum;

- .5 damage to the Owner or a Separate Contractor or other Contractor;
- reasonable evidence that the Work will not be completed within the Contract Time, and that the unpaid balance would not be adequate to cover actual or liquidated damages for the anticipated delay; or
- .7 repeated failure to carry out the Work in accordance with the Contract Documents.
- .8 failure of Contractor to provide executed supplementary bid forms, performance and payment bonds or a current Certificate of Insurance.
- § 9.5.2 When either party disputes the Architect's decision regarding a Certificate for Payment under Section 9.5.1, in whole or in part, that party may submit a Claim in accordance with Article 15.
- § 9.5.3 When the reasons for withholding certification are removed, certification will be made for amounts previously withheld.
- § 9.5.4 If the Architect or Construction Manager withholds certification for payment under Section 9.5.1, the Owner may, at its sole option, issue joint checks to the Contractor and to any Subcontractor or supplier to whom the Contractor failed to make payment for Work properly performed or material or equipment suitably delivered. If the Owner makes payments by joint check, the Owner shall notify the Architect and the Construction Manager, and both will reflect such payment on the next Certificate for Payment.

§ 9.6 Progress Payments

- § 9.6.1 After the Architect has issued a Certificate for Payment or Project Certificate for Payment, the Owner shall make payment in the manner and within the time provided in the Contract Documents, and shall so notify the Construction Manager and Architect.
- § 9.6.2 The Contractor shall pay each Subcontractor, no later than seven days after receipt of payment from the Owner, the amount to which the Subcontractor is entitled, reflecting percentages actually retained from payments to the Contractor on account of the Subcontractor's portion of the Work. The Contractor shall, by appropriate agreement with each Subcontractor, require each Subcontractor to make payments to Sub-subcontractors in a similar manner.
- § 9.6.3 The Construction Manager will, on request, furnish to a Subcontractor, if practicable, information regarding percentages of completion or amounts applied for by the Contractor and action taken thereon by the Owner, Construction Manager and Architect on account of portions of the Work done by such Subcontractor.
- § 9.6.4 The Owner has the right to request written evidence from the Contractor that the Contractor has properly paid Subcontractors and suppliers amounts paid by the Owner to the Contractor for subcontracted Work. If the Contractor fails to furnish such evidence within seven days, the Owner shall have the right to contact Subcontractors and suppliers to ascertain whether they have been properly paid. Neither the Owner, Construction Manager nor Architect shall have an obligation to pay, or to see to the payment of money to, a Subcontractor or supplier, except as may otherwise be required by law.
- § 9.6.5 The Contractor's payments to suppliers shall be treated in a manner similar to that provided in Sections 9.6.2, 9.6.3 and 9.6.4.
- § 9.6.6 A Certificate for Payment, a progress payment, or partial or entire use or occupancy of the Project by the Owner shall not constitute acceptance of Work not in accordance with the Contract Documents.
- § 9.6.7 Unless the Contractor provides the Owner with a payment bond in the full penal sum of the Contract Sum, payments received by the Contractor for Work properly performed by Subcontractors or provided by suppliers shall be held by the Contractor for those Subcontractors or suppliers who performed Work or furnished materials, or both, under contract with the Contractor for which payment was made by the Owner. Nothing contained herein shall require money to be placed in a separate account and not commingled with money of the Contractor, create any fiduciary liability or tort liability on the part of the Contractor for breach of trust, or entitle any person or entity to an award of punitive damages against the Contractor for breach of the requirements of this provision.
- § 9.6.8 Provided the Owner has fulfilled its payment obligations under the Contract Documents, the Contractor shall defend and indemnify the Owner from all loss, liability, damage or expense, including reasonable attorney's fees and litigation expenses, arising out of any lien claim or other claim for payment by any Subcontractor or supplier of any

tier. Upon receipt of notice of a lien claim or other claim for payment, the Owner shall notify the Contractor. If approved by the applicable court, when required, the Contractor may substitute a surety bond for the property against which the lien or other claim for payment has been asserted.

(Paragraphs deleted)

§ 9.8 Substantial Completion

- § 9.8.1 Substantial Completion is the stage in the progress of the Work when the Work or designated portion thereof is sufficiently complete in accordance with the Contract Documents so the Owner can occupy or utilize the Work for its intended use.
- § 9.8.2 When the Contractor considers that the Work, or a portion thereof which the Owner agrees to accept separately, is substantially complete, the Contractor shall notify the Construction Manager, and the Contractor and Construction Manager shall jointly prepare and submit to the Architect a comprehensive written list of items to be completed or corrected prior to Architect's first (1st) inspection. Failure to include an item on such list does not alter the responsibility of the Contractor to complete all Work in accordance with the Contract Documents.
- § 9.8.3 Upon receipt of the Contractor's punchlist, the Architect, assisted by the Construction Manager, will make an inspection to determine whether the Work or designated portion thereof is substantially complete. If the Architect's inspection discloses any item, whether or not included on the Contractor's punchlist, which is not sufficiently complete in accordance with the Contract Documents so that the Owner can occupy or utilize the Work or designated portion thereof for its intended use, the Contractor shall, before issuance of the Certificate of Substantial Completion, complete or correct such item upon notification by the Architect. In such case, the Contractor shall then submit a request for another inspection by the Architect, assisted by the Construction Manager, to determine Substantial Completion.
- § 9.8.3.1 Except with the consent of the Owner, the Architect in conjunction with the Construction Manager will perform no more than three (3) inspections to determine whether the Work or a designated portion thereof has attained Substantial Completion in accordance with the Contract Documents. The three (3) inspections will include not only determining if the area is substantially complete, but will also include any follow-up inspection to confirm *all* open punchlist items have been completed for that specific item. The Owner may deduct from the Contract Sum amounts paid to the Architect for any additional inspections necessitated by the Contractor's misrepresentation of conditions.
- § 9.8.4 When the Architect, assisted by the Construction Manager, determines that the Work of all of the Contractors, or designated portion thereof, is substantially complete, the Construction Manager will prepare, and the Construction Manager and Architect shall execute, a Certificate of Substantial Completion that shall establish the date of Substantial Completion; establish responsibilities of the Owner and Contractor for security, maintenance, heat, utilities, damage to the Work and insurance; and fix the time within which the Contractor shall finish all items on the list accompanying the Certificate. Warranties required by the Contract Documents shall commence on the date of Substantial Completion of the Work or designated portion thereof unless otherwise provided in the Certificate of Substantial Completion.
- § 9.8.5 The Certificate of Substantial Completion shall be submitted to the Owner and Contractor for their written acceptance of responsibilities assigned to them in the Certificate. Upon such acceptance, and consent of surety if any, the Owner shall make payment of retainage applying to the Work or designated portion thereof. Such payment shall be adjusted for Work that is incomplete or not in accordance with the requirements of the Contract Documents. The payment shall be sufficient to increase the total payments to one-hundred percent (100%) of the Contract Sum, less two times the value of any remaining items to be completed and any amount necessary to satisfy claims, liens or judgments against the Contractor which have not been suitably discharged, as determined by the Architect assisted by the Construction Manager.
- § 9.8.6 In the event the Contractor does not achieve final completion within ninety (90) days after the date of Substantial Completion, allowing for any approved extensions of the Contract time, Contractor shall not be entitled to any further payment and Contractor agrees that such failure to complete the work within the time set forth above shall constitute a waiver of all claims by the Contractor to any money that may be due. This provision shall not operate as a waiver by the Owner of any claims or remedies of any nature against the Contractor arising out of the Contract.

§ 9.9 Partial Occupancy or Use

§ 9.9.1 The Owner may occupy or use any completed or partially completed portion of the Work at any stage when such portion is designated by separate agreement with the Contractor, provided such occupancy or use is consented to by the insurer and authorized by public authorities having jurisdiction over the Project. Such partial occupancy or use may commence whether or not the portion is substantially complete, provided the Owner and Contractor have accepted in writing the responsibilities assigned to each of them for payments, retainage if any, security, maintenance, heat, utilities, damage to the Work and insurance, and have agreed in writing concerning the period for correction of the Work and commencement of warranties required by the Contract Documents. When the Contractor considers a portion substantially complete, the Contractor and Construction Manager shall jointly prepare and submit a list to the Architect as provided under Section 9.8.2. Consent of the Contractor to partial occupancy or use shall not be unreasonably withheld. The stage of the progress of the Work shall be determined by written agreement between the Owner and Contractor or, if no agreement is reached, by decision of the Architect after consultation with the Construction Manager.

§ 9.9.2 Immediately prior to such partial occupancy or use, the Owner, Construction Manager, Contractor, and Architect shall jointly inspect the area to be occupied or portion of the Work to be used in order to determine and record the condition of the Work.

§ 9.9.3 Unless otherwise agreed upon, partial occupancy or use of a portion or portions of the Work shall not constitute acceptance of Work not complying with the requirements of the Contract Documents.

§ 9.10 Final Completion and Final Payment

§ 9.10.1 Upon completion of the Work, the Contractor shall forward to the Construction Manager a notice that the Work is ready for final inspection and acceptance, and shall also forward to the Construction Manager a final Contractor's Application for Payment. Upon receipt, the Construction Manager shall perform an inspection to confirm the completion of Work of the Contractor. The Construction Manager shall make recommendations to the Architect when the Work of all of the Contractors is ready for final inspection, and shall then forward the Contractors' notices and Application for Payment or Project Application for Payment, to the Architect, who will promptly make such inspection. When the Architect finds the Work acceptable under the Contract Documents and the Contract fully performed, the Construction Manager and Architect will promptly issue a final Certificate for Payment or Project Certificate for Payment stating that to the best of their knowledge, information and belief, and on the basis of their on-site visits and inspections, the Work has been completed in accordance with the Contract Documents and that the entire balance found to be due the Contractor and noted in the final Certificate is due and payable. The Construction Manager's and Architect's final Certificate for Payment or Project Certificate for Payment will constitute a further representation that conditions listed in Section 9.10.2 as precedent to the Contractor's being entitled to final payment have been fulfilled.

§ 9.10.1.1 Except with the consent of the Owner, the Architect in conjunction with the Construction Manager will perform no more than two (2) inspections to determine whether the Work or a designated portion thereof has attained Final Completion in accordance with the Contract Documents. The Owner may deduct from the Contract Sum amounts paid to the Architect for any additional inspections necessitated by the Contractor's misrepresentation of final completion.

§ 9.10.2 Neither final payment nor any remaining retained percentage shall become due until the Contractor submits to the Architect through the Construction Manager (1) an affidavit that payrolls, bills for materials and equipment, and other indebtedness connected with the Work for which the Owner or the Owner's property might be responsible or encumbered (less amounts withheld by Owner) have been paid or otherwise satisfied, (2) a certificate evidencing that insurance required by the Contract Documents to remain in force after final payment is currently in effect, (3) a written statement that the Contractor knows of no reason that the insurance will not be renewable to cover the period required by the Contract Documents, (4) consent of surety, if any, to final payment (5) documentation of any special warranties, such as manufacturers' warranties or specific Subcontractor warranties, and (6), if required by the Owner, other data establishing payment or satisfaction of obligations, such as receipts and releases and waivers of liens, claims, security interests, or encumbrances arising out of the Contract, to the extent and in such form as may be designated by the Owner and (7) all Project closeout documents per the General Conditions of the Contract. If a Subcontractor refuses to furnish a release or waiver required by the Owner, the Contractor may furnish a bond satisfactory to the Owner to indemnify the Owner against such lien, claim, security interest, or encumbrance. If a lien, claim, security interest, or

User Notes:

encumbrance remains unsatisfied after payments are made, the Contractor shall refund to the Owner all money that the Owner may be compelled to pay in discharging the lien, claim, security interest, or encumbrance, including all costs and reasonable attorneys' fees.

§ 9.10.3 If, after Substantial Completion of the Work, final completion thereof is materially delayed through no fault of the Contractor or by issuance of Change Orders affecting final completion, and the Construction Manager and Architect so confirm, the Owner shall, upon application by the Contractor and certification by the Construction Manager and Architect, and without terminating the Contract, make payment of the balance due for that portion of the Work fully completed, corrected, and accepted. If the remaining balance for Work not fully completed or corrected is less than retainage stipulated in the Contract Documents, and if bonds have been furnished, the written consent of the surety to payment of the balance due for that portion of the Work fully completed and accepted shall be submitted by the Contractor to the Architect through the Construction Manager prior to certification of such payment. Such payment shall be made under terms and conditions governing final payment, except that it shall not constitute a waiver of Claims. § 9.10.3.1 Exception is made for the Contractor expressly retained for the removal of lead, asbestos or polychlorinated (PCB) from the site. In this condition, all Contract Specifications and Drawings shall govern the handling of this material.

- § 9.10.4 The making of final payment shall constitute a waiver of Claims by the Owner except those arising from
 - .1 liens, Claims, security interests, or encumbrances arising out of the Contract and unsettled;
 - .2 failure of the Work to comply with the requirements of the Contract Documents;
 - .3 terms of special warranties required by the Contract Documents; or
 - 4 audits performed by the Owner, if permitted by the Contract Documents, after final payment.
- § 9.10.5 Acceptance of final payment by the Contractor, a Subcontractor, or a supplier, shall constitute a waiver of claims by that payee except those previously made in writing and identified by that payee as unsettled at the time of final Application for Payment.
- § 9.10.6 In the event the Contractor does not achieve final completion within thirty (30) days after the date of substantial completion, allowing for any approved extensions of the contract time, Contractor shall not be entitled to any further payment and Contractor hereby agrees that such failure to complete the work within the time set forth above shall constitute a waiver of all claims by the Contractor to any money that may be due. This provision shall not operate as a waiver by the Owner of any claims or remedies of any nature against the Contractor arising out of the contract.

ARTICLE 10 PROTECTION OF PERSONS AND PROPERTY

§ 10.1 Safety Precautions and Programs

The Contractor shall be responsible for initiating, maintaining, and supervising all safety precautions and programs in connection with the performance of the Contract. The Contractor shall submit the Contractor's safety program to the Construction Manager for review and coordination with the safety programs of other Contractors. The Construction Manager's responsibilities for review and coordination of safety programs shall not extend to direct control over or charge of the acts or omissions of the Contractors, Subcontractors, agents or employees of the Contractors or Subcontractors, or any other persons performing portions of the Work and not directly employed by the Construction Manager.

§ 10.2 Safety of Persons and Property

- § 10.2.1 The Contractor shall take reasonable precautions for safety of, and shall provide reasonable protection to prevent damage, injury, or loss to
 - .1 employees on the Work and other persons who may be affected thereby;
 - .2 the Work and materials and equipment to be incorporated therein, whether in storage on or off the site, under care, custody, or control of the Contractor, a Subcontractor, or a Sub-subcontractor;
 - .3 other property at the site or adjacent thereto, such as trees, shrubs, lawns, walks, pavements, roadways, structures, and utilities not designated for removal, relocation, or replacement in the course of construction; and
 - .4 construction or operations by the Owner, Separate Contractors, or other Contractors.

- § 10.2.2 The Contractor shall comply with, and give notices required by applicable laws, statutes, ordinances, codes, rules and regulations, and lawful orders of public authorities, bearing on safety of persons or property or their protection from damage, injury, or loss.
- § 10.2.3 The Contractor shall implement, erect, and maintain, as required by existing conditions and performance of the Contract, reasonable safeguards for safety and protection, including posting danger signs and other warnings against hazards; promulgating safety regulations; and notifying the owners and users of adjacent sites and utilities of the safeguards.
- § 10.2.4 When use or storage of explosives or other hazardous materials or equipment or unusual methods are necessary for execution of the Work, the Contractor shall exercise utmost care and carry on such activities under supervision of properly qualified personnel.
- § 10.2.5 The Contractor shall promptly remedy damage and loss (other than damage or loss insured under property insurance required by the Contract Documents) to property referred to in Sections 10.2.1.2, 10.2.1.3 and 10.2.1.4 caused in whole or in part by the Contractor, a Subcontractor, a Sub-subcontractor, or anyone directly or indirectly employed by any of them, or by anyone for whose acts they may be liable and for which the Contractor is responsible under Sections 10.2.1.2, 10.2.1.3 and 10.2.1.4. The Contractor may make a Claim for the cost to remedy the damage or loss to the extent such damage or loss is attributable to acts or omissions of the Owner, Construction Manager or Architect or anyone directly or indirectly employed by any of them, or by anyone for whose acts any of them may be liable, and not attributable to the fault or negligence of the Contractor. The foregoing obligations of the Contractor are in addition to the Contractor's obligations under Section 3.18.
- § 10.2.6 The Contractor shall designate a responsible member of the Contractor's organization at the site whose duty shall be the prevention of accidents. This person shall be the Contractor's superintendent unless otherwise designated by the Contractor in writing to the Owner, Construction Manager and Architect.
- § 10.2.7 The Contractor shall not permit any part of the construction or site to be loaded so as to cause damage or create an unsafe condition.

§ 10.2.8 Injury or Damage to Person or Property

If either party suffers injury or damage to person or property because of an act or omission of the other party, or of others for whose acts such party is legally responsible, notice of the injury or damage, whether or not insured, shall be given to the other party within a reasonable time not exceeding 21 days after discovery. The notice shall provide sufficient detail to enable the other party to investigate the matter.

§ 10.3 Hazardous Materials

- § 10.3.1 The Contractor is responsible for compliance with any requirements included in the Contract Documents regarding hazardous materials or substances. If the Contractor encounters a hazardous material or substance not addressed in the Contract Documents and if reasonable precautions will be inadequate to prevent foreseeable bodily injury or death to persons resulting from a material or substance, including but not limited to asbestos or polychlorinated biphenyl (PCB), encountered on the site by the Contractor, the Contractor shall, upon recognizing the condition, immediately stop Work in the affected area and notify the Owner, Construction Manager and Architect of the condition.
- § 10.3.2 Upon receipt of the Contractor's notice, the Owner shall obtain the services of a licensed laboratory to verify the presence or absence of the material or substance reported by the Contractor and, in the event such material or substance is found to be present, to cause it to be rendered harmless. Unless otherwise required by the Contract Documents, the Owner shall furnish in writing to the Contractor, Construction Manager and Architect the names and qualifications of persons or entities who are to perform tests verifying the presence or absence of the material or substance or who are to perform the task of removal or safe containment of the material or substance. The Contractor, the Construction Manager and the Architect will promptly reply to the Owner in writing stating whether or not any of them has reasonable objection to the persons or entities proposed by the Owner. If the Contractor, Construction Manager or Architect has an objection to a person or entity proposed by the Owner, the Owner shall propose another to whom the Contractor, the Construction Manager and the Architect have no reasonable objection. When the material or substance has been rendered harmless, Work in the affected area shall resume upon written agreement of the Owner and Contractor. By Change Order, the

Contract Time shall be extended appropriately and the Contract Sum shall be increased by the amount of the Contractor's reasonable additional costs of shutdown, delay, and start-up.

(Paragraph deleted)

§ 10.3.2.1 Exception is made for the Contractor expressly retained for the removal of lead, asbestos or polychlorinated (PCB) from the site. In this condition, all Contract Specifications and Drawings shall govern the handling of this material.

- § 10.3.4 The Owner shall not be responsible under this Section 10.3 for hazardous materials or substances the Contractor brings to the site unless such materials or substances are required by the Contract Documents. The Owner shall be responsible for hazardous materials or substances required by the Contract Documents, except to the extent of the Contractor's fault or negligence in the use and handling of such materials or substances.
- § 10.3.5 The Contractor shall reimburse the Owner for the cost and expense the Owner incurs (1) for remediation of hazardous materials or substances the Contractor brings to the site and negligently handles, or (2) where the Contractor fails to perform its obligations under Section 10.3.1, except to the extent that the cost and expense are due to the Owner's fault or negligence.

(Paragraph deleted)

§ 10.4 Emergencies

In an emergency affecting safety of persons or property, the Contractor shall act, at the Contractor's discretion, to prevent threatened damage, injury, or loss. Additional compensation or extension of time claimed by the Contractor on account of an emergency shall be determined as provided in Article 15 and Article 7.

ARTICLE 11 INSURANCE AND BONDS

§ 11.1 Contractor's Insurance and Bonds

§ 11.1.1 The Contractor shall purchase and maintain insurance of the types and limits of liability, containing the endorsements, and subject to the terms and conditions, as described in the Agreement or elsewhere in the Contract Documents. The Contractor shall purchase and maintain the required insurance from an insurance company or insurance companies lawfully authorized to issue insurance in the jurisdiction where the Project is located. The Owner, Construction Manager and Construction Manager's consultants, and the Architect and Architect's consultants, shall be named as additional insureds under the Contractor's commercial general liability policy or as otherwise described in the Contract Documents. Notwithstanding any terms, conditions or provisions, in any other writing between the parties, the contractor hereby agrees to effectuate the naming of the District/BOCES as an Additional Insured on the contractor's insurance policies, except for workers' compensation and N.Y. State Disability insurance.

- .1 Claims under workers' compensation, disability benefit and other similar employee benefit acts that are applicable to the Work to be performed, including private entities performing Work at the site and exempt from the coverage on account of the number of employees or occupation, such entities shall maintain voluntary compensation coverage at the same limits specified for mandatory coverage for the duration of the Project;
- .2 Claims for damages because of bodily injury, occupational sickness or disease, or death of the Contractor's employees or persons or entities excluded by statute from the requirements of Clause 11.1.1.1, but required by the Clause;
- .3 Claims for damages because of bodily injury, occupational sickness or disease, or death of any person other than the Contractor's employees;
- .4 Claims for damages insured by usual personal injury liability coverage; which are sustained (1) by a person as a result of an offense directly or indirectly related to employment of such person by the Contractor, or (2) by another person;
- .5 Claims for damages, other than to the Work itself, because of injury to or destruction of tangible property, including loss of use resulting therefrom;
- .6 Claims for damages because of bodily injury, death of a person or property damage arising out of ownership, maintenance or use of a motor vehicle;
- .7 Claims for bodily injury or property damage arising out of completed operations;
- .8 Claims involving contractual liability insurance applicable to the Contractor's obligations under Section 3.18.



- § 11.1.2 The Contractor shall provide surety bonds of the types, for such penal sums, and subject to such terms and conditions as required by the Contract Documents. The Contractor shall purchase and maintain the required bonds from a company or companies lawfully authorized to issue surety bonds in the jurisdiction where the Project is located.
- § 11.1.3 Upon the request of any person or entity appearing to be a potential beneficiary of bonds covering payment of obligations arising under the Contract, the Contractor shall promptly furnish a copy of the bonds or shall authorize a copy to be furnished.
- § 11.1.3.1 The policy naming the district as an Additional Insured shall:
 - Be an insurance policy from an A.M. Best A- rated or better insurer, licensed and admitted to conduct business in New York State. A New York licensed and admitted insurer is required.
 - .2 State that the organization's coverage shall be primary and non-contributory coverage for the District/BOCES, its Board, employees and volunteers including a waiver of subrogation in favor of the District/BOCES for all coverages including Workers Compensation.
 - .3 The certificate of insurance must describe all services provided by the contractor (e.g., roofing, carpentry or plumbing) that are covered by the liability policies.
 - .4 At the District's/BOCES' request, the contractor shall provide a copy of the declaration page of the liability and umbrella/excess policies with a list of endorsements and forms. If requested, the contractor will provide a copy of the policy endorsements and forms.
 - There will be no coverage restrictions and/or exclusions involving New York State Labor Law statutes .5 or gravity related injuries.
 - .6 No policies containing escape clauses or exclusions contrary to the Owner's interests will be accepted.
- § 11.1.4 The limits of liability of the insurance required above shall be as follows:
 - Commercial General Liability (CGL)

Limits of Insurance not less than:

\$1,000,000 Each Occurrence

\$1,000,000 Personal & Advertising Injury

\$2,000,000 General Aggregate per project/location

\$2,000,000 Products/Completed Operations Aggregate

\$100,000 Fire Damage Legal Liability

\$10,000 Medical Expense

- The CGL coverage shall contain a General Aggregate Limit, such General a. Aggregate shall apply separately to each project.
- b. CGL coverage shall be written on ISO Occurrence form CG 00 01 1093 or a substitute form providing equivalent coverage and shall cover liability arising from premises, operations, independent contractors, products-completed operations, and personal and advertising injury.
- Owner, Architect and their consultants, Owner's Representative, and all C. other parties required by Owner, shall be included as additional insureds on the Commercial General Liability, using ISO Additional Insureds Endorsement CG 20 10 11 85 or CG 2010 (10/93) and CG 20 3 7 (10/01) or CG2033 (10/01) and CG2037 (10/01) or an endorsement providing equivalent coverage to the additional insureds. This insurance for the additional insureds shall be a broad as the coverage provided for the named insured subcontractor. It shall apply as Primary and non-contributing Insurance before any other insurance or self-insurance, including any deductible, maintained by, or provided to, the additional insured.
- d. Attached to each certificate of insurance shall be a copy of the additional Insured Endorsement address in c.) above.
- Contractor shall maintain Commercial General Liability coverage for itself e. and all additional insureds for the duration of the project and maintain Completed Operations coverage for itself and each additional insured for least 3 years after completion of the Work.
- f. The contractor agrees to indemnify the District/BOCES for applicable deductibles and self-insured retentions.
- Automotive Liability



Init.

- Business Auto Liability with limits of at least \$1,000,000 each accident for bodily injury a. and/or property damage.
- Business Auto coverage must include coverage for liability arising out of all owned, b. leased, hired, borrowed and non-owned automobiles.
- Owner and other parties required by the Owner, shall be included as additional insured on c. the auto policy on a primary and non-contributing basis.

Commercial Umbrella .3

Umbrella limits must be at least a minimum of \$5,000,000 each occurrence and aggregate for general construction an no work at elevation (1 story or 10 feet) and project values less that \$1,000,000 or available policy limits if policy limits are higher. Limits must be \$10,000,000 each occurrence and aggregate for high-risk construction, work at elevation (>1 Story or 10 feet) and project values greater than \$1,000,000.

- Umbrella coverage must include as additional insureds all entities that are additional b. insureds all entities that are additional insureds on the Commercial General Liability Policy.
- Umbrella coverage for such additional insureds shall apply as primary and c. non-contributing before any other insurance or self-insurance, including other than the Commercial General Liability, Auto Liability and Employers Liability coverages maintained by the Contractor.
- Attached to each certificate of insurance shall be a copy of the Additional d. Insured Endorsement addressed in b.) and c.) above.
- Umbrella/Excess coverage shall be on a follow-form basis or provide broader coverage e. over the General Liability and Auto Liability coverages

Workers Compensation and Employers Liability .4

- Employers Liability Insurance limits of at least \$500,000, each accident, \$500,000 for bodily injury by accident and \$500,000 each employee for injury by disease. Statutory Workers' Compensation (C-105.2 or U-26.3); and NYS Disability Insurance (DB-120.1) for all employees, Proof of coverage must be on the approved specific form, as required by the New York State Workers' Compensation Board. ACORD certificates are not acceptable. A person seeking an exemption must file a CE-200 Form with the state. The form can be completed and submitted directly to the WC Board online.
- Where applicable, U.S. Longshore and Harborworkers Compensation Act Endorsement b. shall be attached to the policy.
- Where applicable, the Maritime Coverage Endorsement shall be attached to the policy. c.

.5 Environmental Impairment Liability (Pollution Insurance) (EIL)

- Contractors involved with the removal and/or abatement of pollutants (including but not limited to asbestos abatement contractors, lead abatement contractors, roofing contractors, tank removal contractors) are required to maintain a minimum of \$1,000,000 EIL coverage.
- Owner and all other parties required by the Owner, shall be included as additional insured b. on the EIL policy on a primary and non-contributing basis.
- Asbestos/Lead Abatement/Pollution Liability Insurance c.
 - \$2,000,000 per occurrence/\$2,000,000 aggregate, including products and completed operations. Such insurance shall include coverage for the Contractor's operations including, but not limited to, removal, replacement, enclosure, encapsulation and/or disposal of asbestos, or any other hazardous material, along with any related pollution events, including coverage for third party liability claims for bodily injury, property damage and clean-up costs. If a retroactive date is used, it shall pre-date the inception of the Contract.
 - If the Contractor is using motor vehicles for transporting hazardous materials, ii. the Contractor shall maintain pollution liability broadened coverage (ISO Endorsement CA 9948 or CA 01 12), as well as proof of MCS 90. Coverage shall fulfill all requirements of these specifications and shall extend for a period of three (3) years following acceptance by the District/BOCES of the Certificate of Completion.



Init.

(1932214867)

35

- d. Testing Company Errors and Omission Insurance
 - i. \$1,000,000 per occurrence/\$2,000,000 aggregate for the testing and other professional acts of the Contractor performed under the Contract with the District.
- Owner's Protective Liability Insurance: A separate policy of insurance naming the Owner, Architect and the Owner's Representative as the insured's. The original policy shall be submitted for retention by Owner. A copy shall be sent to the Architect through the Owner's Representative. Said separate policy shall be in the amounts of One Million Dollars (\$1,000,000) per occurrence, and in the aggregate of two million dollars (\$2,000,000) for work on 1 story (10 feet) for bodily injury and property damage and shall provide coverage for the Owner, Architect and Owner's Representative, their agents, officers and employees, with respect to said work. For projects greater than \$1,000,000 and/or work over 1 story (10 feet); \$2,000,000 per occurrence, \$4,000,000 aggregate with the District/BOCES as the Named Insured. Said policy shall provide that the coverage afforded thereby shall be primary coverage to the full limits of liability stated in the declarations, and if said Owner, Architect or Owner's Representative, their officers and employees have other insurance against the loss covered by said policy, that other insurance shall be excess insurance only. The OCP policy must be with a New York State licensed and admitted carrier. This coverage shall last for the duration of the contract.
- .7 Prior to commencing the Work, the Owner shall supply the Contractor and Owner's Representative with a certificate of insurance providing evidence of insurance coverage for the Contractor for Builder's Risk/Installation Floater "All Risk" insurance shall protect the Contractor, the Contractor's Subcontractors, the Architect and the Owner's Representative from losses resulting from, but not limited to, natural disasters, fire, extended coverage perils, vandalism, malicious mischief or collapse during the course of construction. The amount of such insurance shall be not less at any time than the total value of the Work in place, on site, in transit or in storage off site and the loss under such policies shall be made payable to the Owner and/or the Contractor or other insured's, as their respective interest may appear. The policy shall cover all property to be used in, or incidental to, the fabrication and/or erection and/or completion of the project. It shall include all materials, machinery, equipment and supplies intended to become part of such property and false work, temporary trestles and similar structures. It shall not include tools, Contractor's equipment and any other property not a part or destined to become part of the project. The Owner should be advised of the amount, if any, of a deductible amount exceed \$5,000,000. The Contractor shall provide the Owner upon request with copies of any of the insurance policies required to be maintained pursuant to this Article.
- The amount of insurance contained in the aforementioned insurance coverage's shall not be construed to be a limitation of the liability on the part of the Contractor or any of its subcontractors.
- .9 At the Owner's request, the contractor shall provide a copy of the declaration page of the liability and umbrella/excess policies with a list of endorsements and forms. There will be no coverage restrictions and/or exclusions involving the New York State Labor Law statutes or gravity related injuries.
- A fully completed New York Construction Certificate of Liability Insurance Addendum (ACORD 855 2014/15) must be included with the certificates of insurance. For any "Yes" answers on Items G through L on this Form—additional details must be provided in writing. Policy exclusions may not be accepted.

§ 11.1.5 Notice of Cancellation or Expiration of Contractor's Required Insurance. Within three (3) business days of the date the Contractor becomes aware of an impending or actual cancellation or expiration of any insurance required by the Contract Documents, the Contractor shall provide notice directly to the Owner, and separately to the Construction Manager, of such impending or actual cancellation or expiration. Upon receipt of notice from the Contractor, the Owner shall, unless the lapse in coverage arises from an act or omission of the Owner, have the right to stop the Work until the lapse in coverage has been cured by the procurement of replacement coverage by the Contractor. The furnishing of notice by the Contractor shall not relieve the Contractor of any contractual obligation to provide any required coverage.

§ 11.1.6 MISCELLANEOUS PROVISIONS



- § 11.1.6.2 In addition to the above, Contractor will also satisfy any insurance required by any governmental authority.
- § 11.1.6.3 Each insurance certificate will have the following entities listed as "named insured" or "additional insured": Contractor, Owner (full name), Collins+Scoville Architecture | Engineering | Construction Management, D.P.C. (dba CSArch Architecture | Engineering | Construction Management), and all of their employees and CSArch's consultants and all of their employees. Listing the above entities as "certificate holder" is NOT acceptable.
- § 11.1.6.4 Two (2) certificates of insurance shall be submitted to, and reviewed by, the Owner prior to start of construction. If the Owner is damaged or subject to loss due to failure of the Contractor to obtain and maintain such insurance, then the Contractor shall bear all cost and responsibilities attributable thereto.
- § 11.1.6.5 Certificates shall be accompanied by a statement of any deductibles, self-insured retentions and exclusion in the policy, including endorsements affecting the coverage for additional insureds.
- § 11.1.6.6 The Contractor shall exhibit any and all policies within three (3) days if demanded by the Owner, Construction Manager or Architect.
- § 11.1.6.7 This insurance must be purchased from an A.M. Best Rated "A-", "A", or "A+" carrier, licensed and admitted to conduct business in New York State. A New York State licensed and admitted insurer is required.t
- § 11.1.6.8 A copy of the requirements for insurance set forth herein shall be forwarded by the Contractor to the Contractor's insurance carrier to ensure that required coverage is provided.
- § 11.1.6.9 Subcontractors are subject to the same terms and conditions as stated above and must submit same to the Owner for approval prior to the start of any work.
- § 11.1.6.10 Contractor acknowledges that failure to obtain such insurance on behalf of the District/BOCES constitutes a material breach of contract and subjects it to liability for damages, indemnification and all other legal remedies available to the District/BOCES. The contractor is to provide the District/BOCES with a certificate of insurance, evidencing the above requirements have been met, prior to the commencement of work. The failure of the District/BOCES to object to the contents of the certificate or the absence of same shall not be deemed a waiver of any rights held by the District/BOCES.
 - In the event the General Contractor fails to obtain the required certificates of insurance from the .1 Subcontractor and a claim is made or suffered, the General Contractor shall indemnify, defend, and hold harmless the District/BOCES, its Board, employees and volunteers from any and all claims for which the required insurance would have provided coverage. This indemnity obligation is in addition to any other indemnity obligation provided in the Contract

§ 11.2 Owner's Insurance

- § 11.2.1 The Owner shall purchase and maintain insurance of the types and limits of liability, containing the endorsements, and subject to the terms and conditions, as described in the Agreement or elsewhere in the Contract Documents. The Owner shall purchase and maintain the required insurance from an insurance company or insurance companies lawfully authorized to issue insurance in the jurisdiction where the Project is located.
- § 11.2.2 Failure to Purchase Required Property Insurance. If the Owner fails to purchase and maintain the required property insurance, with all of the coverages and in the amounts described in the Agreement or elsewhere in the Contract Documents, the Owner shall inform both the Contractor and the Construction Manager, separately and in writing, prior to commencement of the Work. Upon receipt of notice from the Owner, the Contractor may delay commencement of the Work and may obtain insurance that will protect the interests of the Contractor, Subcontractors, and Sub-Subcontractors in the Work. When the failure to provide coverage has been cured or resolved, the Contract Sum and Contract Time shall be equitably adjusted. In the event the Owner fails to procure coverage, the Owner waives all rights against the Contractor, Subcontractors, and Sub-subcontractors to the extent the loss to the Owner would have been covered by the insurance to have been procured by the Owner. The cost of the insurance shall be charged to the Owner by a Change Order. If the Owner does not provide written notice, and the Contractor is damaged by the failure or neglect of the Owner to purchase or maintain the required insurance, the Owner shall reimburse the Contractor for all reasonable costs and damages attributable thereto.



Init.

AIA Document A232 - 2019. Copyright @ 1992, 2009, and 2019. All rights reserved. The American Institute of Architects. the AIA Logo, and "AIA Contract Documents" are trademarks of The American Institute of Architects. This document was produced at 11:22:35 ET on 10/25/2024 under Order No.3104238697 which expires on 12/09/2024, is not for resale, is licensed for one-time use only, and may only be used in accordance with the AIA Contract Documents® Terms of Service. To report copyright violations, e-mail docinfo@aiacontracts.com.

§ 11.2.3 Notice of Cancellation or Expiration of Owner's Required Property Insurance. Within three (3) business days of the date the Owner becomes aware of an impending or actual cancellation or expiration of any property insurance required by the Contract Documents, the Owner shall provide notice directly to the Contractor, and separately to the Construction Manager, of such impending or actual cancellation or expiration. Unless the lapse in coverage arises from an act or omission of the Contractor: (1) the Contractor, upon receipt of notice from the Owner, shall have the right to stop the Work until the lapse in coverage has been cured by the procurement of replacement coverage by either the Owner or the Contractor; (2) the Contract Time and Contract Sum shall be equitably adjusted; and (3) the Owner waives all rights against the Contractor, Subcontractors, and Sub-subcontractors to the extent any loss to the Owner would have been covered by the insurance had it not expired or been cancelled. If the Contractor purchases replacement coverage, the cost of the insurance shall be charged to the Owner by an appropriate Change Order. The furnishing of notice by the Owner shall not relieve the Owner of any contractual obligation to provide required insurance.

§ 11.3 Waivers of Subrogation

§ 11.3.1 The Owner and Contractor waive all rights against (1) each other and any of their subcontractors, sub-subcontractors, agents, and employees, each of the other; (2) the Construction Manager and Construction Manager's consultants; (3) the Architect and Architect's consultants; (4) other Contractors and any of their subcontractors, sub-subcontractors, agents, and employees; and (5) Separate Contractors, if any, and any of their subcontractors, sub-subcontractors, agents, and employees, for damages caused by fire, or other causes of loss, to the extent those losses are covered by property insurance required by the Agreement or other property insurance applicable to the Project, except such rights as they have to proceeds of such insurance. The Owner or Contractor, as appropriate, shall require similar written waivers in favor of the individuals and entities identified above from the Construction Manager, Construction Manager's consultants, Architect, Architect's consultants, other Contractors, Separate Contractors, subcontractors, and sub-subcontractors. The policies of insurance purchased and maintained by each person or entity agreeing to waive claims pursuant to this Section 11.3.1 shall not prohibit this waiver of subrogation. This waiver of subrogation shall be effective as to a person or entity (1) even though that person or entity would otherwise have a duty of indemnification, contractual or otherwise, (2) even though that person or entity did not pay the insurance premium directly or indirectly, or (3) whether or not the person or entity had an insurable interest in the damaged property.

§ 11.3.1.1 Owner and Contractor intend that any policies provided in response to the insurance provisions shall protect all of the parties insured and provide primary coverage for losses and damages caused by perils covered thereby. Accordingly, all such policies shall contain provisions to the effect that in the event of payment for loss or damage, the insurer will have no right of recovery against any of the parties named as insureds or additional insureds.

§ 11.3.2 If during the Project construction period the Owner insures properties, real or personal or both, at or adjacent to the site by property insurance under policies separate from those insuring the Project, or if after final payment property insurance is to be provided on the completed Project through a policy or policies other than those insuring the Project during the construction period, to the extent permissible by such policies, the Owner waives all rights in accordance with the terms of Section 11.3.1 for damages caused by fire or other causes of loss covered by this separate property insurance.

§ 11.4 Loss of Use, Business Interruption, and Delay in Completion Insurance

The Owner, at the Owner's option, may purchase and maintain insurance that will protect the Owner against loss of use of the Owner's property, or the inability to conduct normal operations, due to fire or other causes of loss. The Owner waives all rights of action against the Contractor, Architect, and Construction Manager for loss of use of the Owner's property, due to fire or other hazards however caused.

§ 11.5 Adjustment and Settlement of Insured Loss

§ 11.5.1 A loss insured under the property insurance required by the Agreement shall be adjusted by the Owner as fiduciary and made payable to the Owner as fiduciary for the insureds, as their interests may appear, subject to requirements of any applicable mortgagee clause and of Section 11.5.2. The Owner shall pay the Construction Manager, Architect and Contractor their just shares of insurance proceeds received by the Owner, and by appropriate agreements the Construction Manager, Architect and Contractor shall make payments to their consultants and Subcontractors in similar manner.



§ 11.5.2 Prior to settlement of an insured loss, the Owner shall notify the Contractor of the terms of the proposed settlement as well as the proposed allocation of the insurance proceeds. The Contractor shall have 14 days from receipt of notice to object to the proposed settlement or allocation of the proceeds. If the Contractor does not object, the Owner shall settle the loss and the Contractor shall be bound by the settlement and allocation. Upon receipt, the Owner shall deposit the insurance proceeds in a separate account and make the appropriate distributions. Thereafter, if no other agreement is made or the Owner does not terminate the Contract for convenience, the Owner and Contractor shall execute a Change Order for reconstruction of the damaged or destroyed Work in the amount allocated for that purpose. If the Contractor timely objects to either the terms of the proposed settlement or the allocation of the proceeds, the Owner may proceed to settle the insured loss, and any dispute between the Owner and Contractor arising out of the settlement or allocation of the proceeds shall be resolved pursuant to Article 15. Pending resolution of any dispute, the Owner may issue a Construction Change Directive for the reconstruction of the damaged or destroyed Work.

§ 11.4 PERFORMANCE BOND AND PAYMENT BOND

§ 11.4.1 The Owner shall have the right to require the Contractor to furnish bonds covering faithful performance of the Contract and payment of obligations arising thereunder as stipulated in bidding requirements or specifically required in the Contract Documents on the date of execution of the Contract.

§ 11.4.1.1 The Contractor shall furnish bonds covering faithful performance of the contract and payment of obligations arising thereunder. The value of each bond shall be for one-hundred percent (100%) of the Contract Sum and shall be adjusted during the Project construction period to reflect changes in the Contract Sum. Bonds shall be issued by a bonding company licensed in the State of New York, on AIA Document A312, Performance and Payment Bond.

§ 11.4.1.2 Contractor shall deliver bonds in conjunction with executed Agreement and they shall be dated the same date as Agreement.

§ 11.4.1.3 The attorney in fact who executes the required bonds on behalf of the surety, shall affix thereto a certified and current copy of the power of attorney.

§ 11.4.1.4 Status Reports issued by a Bonding Company shall be sent to and completed by the Owner and then returned to the Bonding Company by the Owner.

§ 11.4.1.5 Any additional cost for bonding premium shall not be itemized within individual Change Orders. Adjustments for Contractor's bonding cost shall be adjusted at the end of the Project based on approved executed changes in the Work and the Bonding Company's final adjusted premium at project closeout.

§ 11.4.2 Upon the request of any person or entity appearing to be a potential beneficiary of bonds covering payment of obligations arising under the Contract, the Contractor shall promptly furnish a copy of the bonds or shall authorize a copy to be furnished.

ARTICLE 12 UNCOVERING AND CORRECTION OF WORK

§ 12.1 Uncovering of Work

§ 12.1.1 If a portion of the Work is covered contrary to the Construction Manager's or Architect's request or to requirements specifically expressed in the Contract Documents, it must, if requested in writing by either, be uncovered for their examination and be replaced at the Contractor's expense without change in the Contract Time.

§ 12.1.2 If a portion of the Work has been covered that the Construction Manager or Architect has not specifically requested to examine prior to its being covered, the Construction Manager or Architect may request to see such Work and it shall be uncovered by the Contractor. If such Work is in accordance with the Contract Documents, the Contractor shall be entitled to an equitable adjustment to the Contract Sum and Contract Time as may be appropriate. If such Work is not in accordance with the Contract Documents, the costs of uncovering the Work, and the cost of correction, shall be at the Contractor's expense.



User Notes:

39

§ 12.2 Correction of Work

§ 12.2.1 Before Substantial Completion

The Contractor shall promptly correct Work rejected by the Construction Manager or Architect or failing to conform to the requirements of the Contract Documents, discovered before Substantial Completion, and whether or not fabricated, installed or completed. Costs of correcting such rejected Work, including additional testing and inspections, the cost of uncovering and replacement, and compensation for the Construction Manager's and Architect's services and expenses made necessary thereby, shall be at the Contractor's expense.

§ 12.2.2 After Substantial Completion

- § 12.2.2.1 In addition to the Contractor's obligations under Section 3.5, if, within one year after the date of Substantial Completion of the Work or designated portion thereof, or after the date for commencement of warranties established under Section 9.9.1, or by terms of any applicable special warranty required by the Contract Documents, any of the Work is found to be not in accordance with the requirements of the Contract Documents, the Contractor shall correct it promptly after receipt of notice from the Owner to do so, unless the Owner has previously given the Contractor a written acceptance of such condition. The Owner shall give such notice promptly after discovery of the condition. If the Contractor fails to correct nonconforming Work within a reasonable time during that period after receipt of notice from the Owner, Construction Manager or Architect, the Owner may correct it in accordance with Section 2.5.
- § 12.2.2.2 The one-year period for correction of Work shall be extended with respect to portions of Work first performed after Substantial Completion by the period of time between Substantial Completion and the actual completion of that portion of the Work.
- § 12.2.2.3 The one-year period for correction of Work shall not be extended by corrective Work performed by the Contractor pursuant to this Section 12.2.
- § 12.2.3 The Contractor shall remove from the site portions of the Work that are not in accordance with the requirements of the Contract Documents and are neither corrected by the Contractor nor accepted by the Owner.
- § 12.2.3.1 Upon request by the Owner and prior to expiration of one year from the date of Substantial Completion, the Construction Manager and the Architect will conduct and the Contractor shall attend a meeting with the Owner to review the facility operations and performance.
- § 12.2.4 The Contractor shall bear the cost of correcting destroyed or damaged construction of the Owner, Separate Contractors, or other Contractors, whether completed or partially completed, caused by the Contractor's correction or removal of Work that is not in accordance with the requirements of the Contract Documents.
- § 12.2.5 Nothing contained in this Section 12.2 shall be construed to establish a period of limitation with respect to other obligations the Contractor has under the Contract Documents. Establishment of the one-year period for correction of Work as described in Section 12.2.2 relates only to the specific obligation of the Contractor to correct the Work, and has no relationship to the time within which the obligation to comply with the Contract Documents may be sought to be enforced, nor to the time within which proceedings may be commenced to establish the Contractor's liability with respect to the Contractor's obligations other than specifically to correct the Work.

§ 12.3 Acceptance of Nonconforming Work

If the Owner prefers to accept Work that is not in accordance with the requirements of the Contract Documents, the Owner may do so instead of requiring its removal and correction, in which case the Contract Sum will be reduced as appropriate and equitable. Such adjustment shall be effected whether or not final payment has been made.

ARTICLE 13 MISCELLANEOUS PROVISIONS

§ 13.1 Governing Law

The Contract shall be governed by the law of the place where the Project is located. The parties expressly agree that any claim, dispute or other controversy of any nature arising out of the Contract or performance of the Work shall be commenced and maintained in Supreme Court.

§ 13.1.2 The Contractor shall at all times observe and comply with all Federal and State Laws, and all Laws, Ordinances and Regulations of the Owner, in any manner affecting the work, and all such orders decreed as exist at present and those which may be enacted later, by bodies or tribunals having jurisdiction or authority over the Work,

and the Contractor shall defend, indemnify and save harmless the Owner, Construction Manager and Architect and all their officers, agents or servants against any claim or liability arising from, or based on, a violation of any such law, ordinances, regulation or order, whether by himself or by his employee or agents.

§ 13.1.3 The Contractor specifically agrees as required by Labor Law, Sections 220 and 220-d, as amended that:

- 1. No laborer, workman or mechanic in the employ of the Contractor, subcontractor or other person doing contracting or contracting to do the whole or any part of the work contemplated by the Contract, shall be permitted or required to work more than eight hours in one calendar day or more than five days in one week, except in the emergencies set forth in the Labor Law.
- 2. The wages paid for a legal day's work shall not be less than the prevailing rate of wages as defined by law, and
- 3. The minimum hourly rate of wages to be paid shall not be less than that stated in the Specifications, and any re-determination of the prevailing rate of wages after the Contract is approved shall be deemed to be incorporated herein by reference as of the effective date of re-determination and shall form a part of this Contract. The Labor Law provides that the Contract may be forfeited and no sum paid for any work done thereunder on a second conviction of willfully paying less than:
 - a. the stipulated wage scale as provided in Labor Law, Section 220, Sub-division 3, as amended; or
 - b. the stipulated minimum hourly wage scale as provided in Labor Law, 220-d, as amended.

§ 13.1.4 The Contractor specifically agrees as required by the provisions of Labor Law, Section 220-e, as amended that:

- 1. In hiring of employees for the performance of work under this Contract or any subcontract hereunder or for the manufacture, sale, or distribution of materials, equipment or supplies, hereunder, no Contractor or Subcontractor nor any person acting on behalf of such Contractor or Subcontractor, shall by reason of race, creed, color, disability, sex, or national origin discriminate against any citizen of the State of New York who is qualified and available to perform the work to which the employment relates.
- 2. No Contractor, Subcontractor, nor any person on his behalf shall, in any manner, discriminate against or intimidate any employee under this Contract on account of race, creed, color, disability, sex, or national origin.
- 3. There may be deducted from the amount payable to the Contractor by the Owner under this Contract, a penalty of fifty dollars (\$50) for each person for each calendar day during which such a person was discriminated against or intimidated in violation of the provisions of the Contract, and
- 4. The provisions of this section covering every Contract for or on behalf of the Owner, the State or a municipality for the manufacture or sale or distribution of materials, equipment or supplies shall be limited to operations performed within the territorial limits of the State of New York.

§ 13.1.5 During the performance of this Contract, the Contractor agrees as follows:

- 1. The Contractor will not discriminate against any employee or applicant for employment because of age, race, creed, color, national origin, sexual orientation, military status, sex, disability, predisposing genetic characteristics, marital status, or domestic violence victim status.
- 2. If directed to do so by the Owner or the State Commissioner of Human Rights, the Contractor will send to each labor union or representative of workers which with the Contractor has or is bound by a collective bargaining or other agreement or understanding, a notice, to be provided by the State Commissioner of Human Rights, advising such labor union or representative of the Contractor's agreement under clauses (1) through (6) (hereinafter called "non-discrimination clauses"). If the Contractor was directed to do so by the Owner as part of the bid or negation of this Contract, the Contractor shall request such labor union or representative to furnish a written statement that such a labor union representative will not discriminate because of age, race, creed, color, national origin, sexual orientation, military status, sex, disability, predisposing genetic characteristics, or marital status, and that such labor union or representative will cooperate, within the limits of its legal contractual authority, in the implementation of the policy and provisions of these non-discrimination clauses and that it consents and agrees that the recruitment, employment and the terms and conditions of employment under this Contract shall be in accordance with the purposes and provision of these non-discrimination clauses. If such labor union or representative fails or refuses to comply with such a request that it furnish such a

(1932214867)

User Notes:

- statement, the Contractor shall promptly notify the Owner and the State Commissioner of Human Rights of such failure or refusal.
- If directed to do so by the Owner or the Commissioner of Human Rights, the Contractor will post and keep posted in conspicuous places, available to employees and applicants for employment, notices to be provided by the State Commissioner of Human Rights setting forth the substance of provisions of clauses (1) and (2) and such provision of the State's law against discrimination as the State Commissioner of Human Rights shall determine.
- The Contractor will state in all solicitations or advertisements for employees placed by or on behalf of the Contractor, that all qualified applicants will be afforded equal employment opportunities without discrimination because of age, race, creed, color, national origin, sexual orientation, military status, sex, disability, predisposing genetic characteristics, marital status, or domestic violence victim status.
- The Contractor will comply with the provisions of Sections 290-299 of the Executive Law, and with the Civil Rights Law, will furnish all information and reports deemed necessary by the State Commissioner of Human Rights under these non-discrimination clauses and such section of the Executive Law, and will permit access to the Contractor's books, records, and accounts by the Owner, the State Commissioner of Human Rights, the Attorney General and the Industrial Commissioner for the purposes of investigation to ascertain compliance with the non-discrimination clauses and such sections of the Executive Law Civil Rights Law.
- This Contract may be forthwith cancelled, terminated or suspended, in whole or in part, by the Owner upon the basis of a finding made by the State Commissioner of Human Rights that the Contractor has not complied with the non-discrimination clauses, and that the Contractor may be declared ineligible for future contracts made by or on behalf of the Owner, the State or a public authority or agency of the State, until the Contractor satisfies the State Commissioner of Human Rights that the Contractor has established and is carrying out a program in conformity with the provisions of these non-discrimination clauses. Such findings may be made by the State Commissioner of the Human Rights after conciliation efforts by the Commissioner have failed to achieve compliance with these non-discrimination clauses and after a verified complaint has been filed with the Commissioner, notice thereof has been given to the Contractor to be heard publicly in accordance with the Executive Law. Such sanctions may be imposed and remedies invoked independently of or in addition to sanctions and remedies otherwise provided by law, and
- The Contractor will include the provisions of clauses .1 through .6 in every subcontract or purchase order in such a manner that such provisions will be binding upon each subcontractor or vendor as to operations to be performed within the State of New York. The Contractor will take action in enforcing such provisions of such subcontract or purchase order as the State Commissioner of Human Rights or the Owner may direct, including sanctions or remedies for non-compliance. If the Contractor becomes involved or is threatened with litigation with a subcontractor or vendor as a result of such directions by the State Commissioner of Human Rights or the Owner, the Contractor shall promptly so notify the Owner and the Attorney General requesting the Attorney General to intervene and protect the interests of the State of New York.

§ 13.2 Successors and Assigns

§ 13.2.1 The Owner and Contractor respectively bind themselves, their partners, successors, assigns, and legal representatives to covenants, agreements, and obligations contained in the Contract Documents. Except as provided in Section 13.2.2, neither party to the Contract shall assign the Contract as a whole without written consent of the other. If either party attempts to make an assignment without such consent, that party shall nevertheless remain legally responsible for all obligations under the Contract.

§ 13.2.2 The Owner may, without consent of the Contractor, assign the Contract to a lender providing construction financing for the Project, if the lender assumes the Owner's rights and obligations under the Contract Documents. The Contractor shall execute all consents reasonably required to facilitate the assignment.

§ 13.3 Rights and Remedies

§ 13.3.1 Duties and obligations imposed by the Contract Documents and rights and remedies available thereunder shall be in addition to and not a limitation of duties, obligations, rights, and remedies otherwise imposed or available by law.

§ 13.3.2 No action or failure to act by the Owner, Construction Manager, Architect, or Contractor shall constitute a waiver of a right or duty afforded them under the Contract, nor shall such action or failure to act constitute approval of or acquiescence in a breach thereunder, except as may be specifically agreed upon in writing.

§ 13.4 Tests and Inspections

- § 13.4.1 Tests, inspections, and approvals of portions of the Work shall be made as required by the Contract Documents and by applicable laws, statutes, ordinances, codes, rules, and regulations or lawful orders of public authorities. Unless otherwise provided, the Contractor shall make arrangements for such tests, inspections, and approvals with an independent testing laboratory and shall bear all related costs of tests, inspections, and approvals. The Contractor shall give the Construction Manager timely notice of when and where tests and inspections are to be made so that the Construction Manager may be present for such procedures. The Owner shall bear costs of tests, inspections, or approvals that do not become requirements until after bids are received or negotiations concluded. The Owner shall directly arrange and pay for tests, inspections, or approvals where building codes or applicable laws or regulations so require.
- § 13.4.2 If the Construction Manager, Architect, Owner, or public authorities having jurisdiction determine that portions of the Work require additional testing, inspection, or approval not included under Section 13.4.1, the Construction Manager and Architect will, upon written authorization from the Owner, instruct the Contractor to make arrangements for such additional testing, inspection, or approval, by an entity acceptable to the Owner, and the Contractor shall give timely notice to the Construction Manager and Architect of when and where tests and inspections are to be made so that the Construction Manager and Architect may be present for such procedures. Such costs, except as provided in Section 13.4.3, shall be at the Owner's expense.
- § 13.4.3 If procedures for testing, inspection, or approval under Sections 13.4.1 and 13.4.2 reveal failure of the portions of the Work to comply with requirements established by the Contract Documents, all costs made necessary by such failure, including those of repeated procedures and compensation for the Construction Manager's and Architect's services and expenses, shall be at the Contractor's expense.
- § 13.4.4 Required certificates of testing, inspection, or approval shall, unless otherwise required by the Contract Documents, be secured by the Contractor and promptly delivered to the Construction Manager for transmittal to the Architect.
- § 13.4.5 If the Construction Manager or Architect is to observe tests, inspections, or approvals required by the Contract Documents, the Construction Manager or Architect will do so promptly and, where practicable, at the normal place of testing.
- § 13.4.6 Tests or inspections conducted pursuant to the Contract Documents shall be made promptly to avoid unreasonable delay in the Work.

§ 13.5 Interest

Payments to Contractor, including any interest, shall be consistent with this Agreement and in accordance with New York State General Municipal Law Section 106-b.

§ 13.6 TIME LIMITS ON CLAIMS

The Owner and the Contractor shall commence all claims and causes of action, whether in contract, tort, breach of warranty or otherwise, against the other arising out of or related to the Contract in accordance with the requirements of the final dispute resolution method selected in the Agreement and within the time period specified by applicable law.

§13.7 EQUAL OPPORTUNITY

§13.7.1 The Contractor shall maintain policies of employment as follows:

1. The Contractor and the Contractor's Subcontractors shall not discriminate against any employee or applicant for employment because of race, religion, color, sex or national origin. The Contractor shall take affirmative action to insure that applicants are employed and that employees are treated during employment without regard to their race, religion, color, sex and national origin. Such action shall include, but not limited to the following: employment, upgrading, demotion, or transfer; recruitment or recruitment advertising; layoff or termination; rates of pay or other forms of compensation; and selection of training, including apprenticeship. The Contractor agrees to

(1932214867)

User Notes:

- post in conspicuous places, available to employees and applicants for employment, notices setting forth the policies of non-discrimination, and
- 2. the Contractor and the Contractor's Subcontractors shall, in all solicitations or advertisements for employees placed by them or on their behalf, state all qualified applicants will receive consideration for employment without regard to race, religion, color, sex or national origin.

ARTICLE 14 TERMINATION OR SUSPENSION OF THE CONTRACT

§ 14.1 Termination by the Contractor

- § 14.1.1 The Contractor may terminate the Contract if the Work is stopped for a period of 30 consecutive days through no act or fault of the Contractor, a Subcontractor, a Sub-subcontractor, their agents or employees, or any other persons or entities performing portions of the Work, for any of the following reasons:
 - .1 Issuance of an order of a court or other public authority having jurisdiction that requires all Work to be stopped;
 - .2 An act of government, such as a declaration of national emergency, that requires all Work to be stopped;
 - Because the Construction Manager has not certified or the Architect has not issued a Certificate for Payment and, after the Contractor has provided written notice of the lack of certification with a reasonable opportunity to cure, has not notified the Contractor of the reason for withholding certification as provided in Section 9.4, or because the Owner, after the Contractor has provided written notice of the lack of payment with a reasonable opportunity to cure, has not made payment on a Certificate for Payment within the time stated in the Contract Documents; or
- § 14.1.2 The Contractor may terminate the Contract if, through no act or fault of the Contractor, a Subcontractor, a Sub-subcontractor, their agents or employees, or any other persons or entities performing portions of the Work, repeated suspensions, delays, or interruptions of the entire Work by the Owner as described in Section 14.3, constitute in the aggregate more than 100 percent of the total number of days scheduled for completion, or 120 days in any 365-day period, whichever is less.
- § 14.1.3 If one of the reasons described in Section 14.1.1 or 14.1.2 exists, the Contractor may, upon thirty days' notice to the Owner with a reasonable opportunity to cure, Construction Manager and Architect, terminate the Contract and recover from the Owner payment for Work properly executed.
- § 14.1.4 If the Work is stopped for a period of 60 consecutive days through no act or fault of the Contractor, a Subcontractor, a Sub-subcontractor, or their agents or employees, or any other persons performing portions of the Work because the Owner has repeatedly failed to fulfill the Owner's obligations under the Contract Documents with respect to matters important to the progress of the Work, the Contractor may, upon thirty additional days' notice to the Owner, Construction Manager and Architect, terminate the Contract and recover from the Owner as provided in Section 14.1.3.

§ 14.2 Termination by the Owner for Cause

- § 14.2.1 The Owner may terminate the Contract if the Contractor
 - .1 refuses or fails to supply enough properly skilled workers or proper materials;
 - .2 fails to make payment to Subcontractors or suppliers in accordance with the respective agreements between the Contractor and the Subcontractors or suppliers;
 - .3 disregards applicable laws, statutes, ordinances, codes, rules and regulations, or lawful orders of a public authority; or
 - .4 otherwise provision of the Contract Documents.
 - .5 breaches any warranty made by the Contractor under or pursuant to the Contract Documents.
 - .6 fails to furnish the Owner with assurances satisfactory to the Owner evidencing the Contractor's ability to complete the Work in compliance with all of the requirements of the Contract Documents,"
- § 14.2.2 When any of the reasons described in Section 14.2.1 exist the Owner may, without prejudice to any other rights or remedies of the Owner and after giving the Contractor and the Contractor's surety, if any, seven days' notice, terminate employment of the Contractor and may, subject to any prior rights of the surety:

- .1 Exclude the Contractor from the site and take possession of all materials, equipment, tools, and construction equipment and machinery thereon owned by the Contractor;
- .2 Accept assignment of subcontracts pursuant to Section 5.4; and
- .3 Finish the Work by whatever reasonable method the Owner may deem expedient. Upon written request of the Contractor, the Owner shall furnish to the Contractor a detailed accounting of the costs incurred by the Owner in finishing the Work. The costs of finishing the Work include, without limitations, all reasonable attorney's fees, additional Architect/Engineering and Construction Manager costs, insurance, additional interest because of any delay in completing the Work, and all other direct and indirect and consequential damages incurred by the Owner by reason of the termination of the Contractors stated herein.
- § 14.2.3 When the Owner terminates the Contract for one of the reasons stated in Section 14.2.1, the Contractor shall not be entitled to receive further payment until the Work is finished.
- § 14.2.4 If the unpaid balance of the Contract Sum exceeds costs of finishing the Work, including compensation for the Construction Manager's and Architect's services and expenses made necessary thereby, and other damages incurred by the Owner and not expressly waived, such excess shall be paid to the Contractor. If such costs and damages exceed the unpaid balance, the Contractor shall pay the difference to the Owner.

§ 14.3 Suspension by the Owner for Convenience

- § 14.3.1 The Owner may, without cause, order the Contractor in writing to suspend, delay or interrupt the Work, in whole or in part for such period of time as the Owner may determine.
- § 14.3.2 The Contract Sum and the Contract Time may be adjusted for increases in the cost and time caused by suspension, delay, or interruption under Section 14.3.1. No adjustment shall be made to the extent:
 - .1 that performance is, was, or would have been, so suspended, delayed, or interrupted, by another cause for which the Contractor is responsible; or
 - .2 that an equitable adjustment is made or denied under another provision of this Contract.

§ 14.4 Termination by the Owner for Convenience

- § 14.4.1 Notwithstanding any other provision to the contrary in this Agreement, the Owner reserves the right at any time and in its absolute discretion to terminate the services of the Contractor and/or the Work for the Owner's convenience and without cause by giving written notice to the Contractor. This termination for the convenience of the Owner provision allows and authorizes the Owner to terminate this Agreement at any time and for any reason whatsoever. This right may be exercised by the Owner in its complete discretion.
- § 14.4.2 Upon receipt of notice from the Owner of such termination for the Owner's convenience, the Contractor shall
 - .1 cease operations as directed by the Owner in the notice;
 - .2 take actions necessary, or that the Owner may direct, for the protection and preservation of the Work; and
 - except for Work directed to be performed prior to the effective date of termination stated in the notice, terminate all existing subcontracts and purchase orders and enter into no further subcontracts and purchase orders.
- § 14.4.3 In the case of such termination for the Owner's convenience, the Contractor shall be entitled to, and the Owner shall reimburse the Contractor for, an equitable portion of the Contractor's fee based on the portion of the Work properly completed before the effective date of termination. Contractor's entitlement to payment for all such work shall be predicated on its performance of such work in accordance with the Contract Documents as certified by the Architect and Construction Manager. Contractor shall be entitled to no other payment and waives any claim for damages.

ARTICLE 15 CLAIMS AND DISPUTES

§ 15.1 Claims

User Notes:

§ 15.1.1 Definition. A Claim is a demand or assertion by one of the parties seeking, as a matter of right, payment of money, a change in the Contract Time, or other relief with respect to the terms of the Contract. The term "Claim" also includes other disputes and matters in question between the Owner and Contractor arising out of or relating to the

Contract. The responsibility to substantiate Claims shall rest with the party making the Claim. This Section 15.1.1 does not require the Owner to file a Claim in order to impose liquidated damages in accordance with the Contract Documents. The Owner may refer a claim to the Construction Manager and or the Architect for their review and assistance; however, such is not required by this Agreement.

§ 15.1.2 Time Limits on Claims

The Owner and Contractor shall commence all Claims and causes of action against the other and arising out of or related to the Contract, whether in contract, tort, breach of warranty or otherwise, in accordance with the requirements of the binding dispute resolution method selected in the Agreement and within the period specified by applicable law.

§ 15.1.3 Notice of Claims

- § 15.1.3.1 Claims by either the Owner or Contractor, where the condition giving rise to the Claim is first discovered prior to expiration of the period for correction of the Work set forth in Section 12.2.2, shall be initiated by notice to the other party and to the Initial Decision Maker with a copy sent to the Construction Manager and Architect, if the Architect is not serving as the Initial Decision Maker. Claims by either party under this Section 15.1.3.1 shall be initiated within 21 days after occurrence of the event giving rise to such Claim or within 21 days after the claimant first recognizes the condition giving rise to the Claim, whichever is later.
- § 15.1.3.2 Claims by either the Owner or Contractor, where the condition giving rise to the Claim is first discovered after expiration of the period for correction of the Work set forth in Section 12.2.2, shall be initiated by notice to the other party. In such event, no decision by the Initial Decision Maker is required.
- § 15.1.3.3 Claims by the Contractor must be made by written notice in accordance with the following procedures.
 - .1 the Contractor may submit a claim concerning a matter properly noticed in accordance with the time requirements of this Contract set forth in paragraph 15.1.3 and elsewhere;
 - failure by the Contractor to furnish the required claim documentation within the time set forth above .2 shall constitute waiver of the Contractor's right to compensation for such claim.
 - Contractor shall furnish three (3) certified copies of the required claim documentation. The claim .3 documentation shall be complete when furnished. The evaluation of the Contractor's claim will be based, among other things, upon the Owner's Project Records and the Contractor's furnished claim documentation
 - claim documentation shall conform to Generally Accepted Accounting Principles and shall be in the following format:
 - general introduction;
 - general background discussion
 - issues
 - index of issues (listed numerically); i.
 - ii. for each issue:
 - (1) background
 - (2) chronology
 - (3) Contractor's position (reason for Owner's potential liability)
 - (4) supporting documentation of merit or entitlement
 - (5) supporting documentation of damages
 - (6) begin each issue on a new page
 - all critical path method schedules (as-planned, monthly updates, schedule revisions and d. as-built, along with computer disks of all schedules related to the claim;
 - e. productivity exhibits (if appropriate); and
 - summary of issues and damages.
 - .5 supporting documentation of merit for each issue shall be cited by reference, photocopies or explanation. Supporting documentation may include, but shall not be limited to General Conditions, General Requirements, technical specifications, drawings, correspondence, conference notes, shop drawings and submittals, shop drawing logs, survey books, inspection reports, delivery schedules, test reports, daily reports, subcontracts, fragmentary CPM schedules or time impact analyses, photographs, technical reports, requests for information, field instructions and all other related records necessary to support the Contractor's claim.

- supporting documentation of damages for each issue shall be cited, photocopied or explained. Supporting documentation may include, but shall not be limited to, any or all documents related to the preparation and submission of the bid; certified, detailed labor records including labor distribution reports; material and equipment procurement records; construction equipment ownership, cost records or rental records; subcontractor or vendor files and cost records; service cost records; purchase orders; invoices; Project as-planned and as-built cost records; general ledger records; variance reports; accounting adjustment records, and any other accounting material necessary to support the Contractor's claims.
- .7 each copy of the claim documentation shall be certified by a responsible officer of the Contractor in accordance with the requirements of these Contract Documents.

§ 15.1.4 Continuing Contract Performance

- § 15.1.4.1 Pending final resolution of a Claim, except as otherwise agreed in writing or as provided in Article 14, the Contractor shall proceed diligently with performance of the Contract and the Owner shall continue to make payments in accordance with the Contract Documents.
- § 15.1.4.2 The Contract Sum and Contract Time shall be adjusted in accordance with the Initial Decision Maker's decision, subject to the right of either party to proceed in accordance with this Article 15. The Architect will issue Certificates for Payment in accordance with the decision of the Initial Decision Maker.
- § 15.1.5 Claims for Additional Cost. If the Contractor wishes to make a Claim for an increase in the Contract Sum, notice as provided in Section 15.1.3 shall be given before proceeding to execute the portion of the Work that is the subject of the Claim. Prior notice is not required for Claims relating to an emergency endangering life or property arising under Section 10.4.

§ 15.1.6 Claims for Additional Time

- § 15.1.6.1 If the Contractor wishes to make a Claim for an increase in the Contract Time, notice as provided in Section 15.1.3 shall be given. In the case of a continuing delay only one Claim is necessary.
- § 15.1.6.2 If adverse weather conditions are the basis for a Claim for additional time, such Claim shall be documented by data substantiating that weather conditions were abnormal for the period of time, could not have been reasonably anticipated and had an adverse effect on the scheduled construction.
- § 15.1.6.3 Claims for increase in the Contract time shall set forth in detail the circumstances that form the basis for the Claim, the date upon which each cause of delay began to affect the progress of Work, the date upon which each cause of delay ceased to affect the progress of the Work and the number of days increased in the Contract time claimed as a consequence of each such cause of delay. The Contractor shall provide such supporting documentation as the Owner may require including, where appropriate, a revised construction schedule indicating all the activities affected by the circumstances forming the basis of the Claim.
- § 15.1.6.4 The Contractor shall not be entitled to a separate increase in the Contract time for each one of the number of causes of delay which may have concurrent or interrelated effects on the progress of the Work, or for concurrent delays due to the fault of the Contractor.
- § 15.1.7 Waiver of Claims for Consequential Damages. The Contractor and Owner waive Claims against each other for consequential damages arising out of or relating to this Contract. This mutual waiver includes
 - damages incurred by the Owner for rental expenses, for losses of use, income, profit, financing, business and reputation, and for loss of management or employee productivity or of the services of such persons; and
 - .2 damages incurred by the Contractor for principal office expenses including the compensation of personnel stationed there, for losses of financing, business and reputation, and for loss of profit except anticipated profit arising directly from the Work.
- §15.1.8.1 Claims and Actions Thereon. No claim against the Owner for damages for breach of contract or compensation for extra work shall be made or asserted in any action or proceeding at law, or in equity, unless the Contractor shall have strictly complied with all the requirements relating to the giving of notice and of information

(1932214867)

User Notes:

with respect to such claims all as provided in this Agreement.

§15.1.8.2 No Estoppel. Neither the Owner nor any department officer, agent or employees thereof, shall be bound, precluded or estopped by any determination, decision, approval, order, letter, payment or certificate made or given under or in connection with this Contract by the Owner, or any officer, agent or employee of the Owner, either before or after the final completion and acceptance of the Work and payment therefor: (1) from showing the true and correct classification, amount, quality or character of the Work actually done; or that any such termination, decision, order, letter, payment or certificate was untrue, incorrect or improperly made in any particular matter, or that the Work or any part thereof does not in fact conform to the requirements of this Contract; or (2) from demanding and recovering from the Contractor any overpayments made to him, or such damages as it may sustain by reason of his failure to perform each and every part of this Contract in strict accordance with its terms; or (3) both (1) and (2) hereto."

§ 15.2 Initial Decision

- § 15.2.1 Claims, by the Contractor, excluding those where the condition giving rise to the Claim is first discovered after expiration of the period for correction of the Work set forth in Section 12.2.2 or arising under Sections 10.3, 10.4, and 11.5, shall be referred to the Initial Decision Maker for initial decision. The Architect will serve as the Initial Decision Maker, unless otherwise indicated in the Agreement. Except for those Claims excluded by this Section 15.2.1, an initial decision shall be required as a condition precedent to mediation of any Claim by the Contractor against the Owner. If an initial decision has not been rendered within 30 days after the Claim has been referred to the Initial Decision Maker, the party asserting the Claim may demand mediation and binding dispute resolution without a decision having been rendered. Unless the Initial Decision Maker and all affected parties agree, the Initial Decision Maker will not decide disputes between the Contractor and persons or entities other than the Owner.
- § 15.2.2 The Initial Decision Maker will review Claims and within twenty one days of the receipt of a Claim take one or more of the following actions: (1) request additional supporting data from the claimant or a response with supporting data from the other party, (2) reject the Claim in whole or in part, (3) approve the Claim, (4) suggest a compromise, or (5) advise the parties that the Initial Decision Maker is unable to resolve the Claim if the Initial Decision Maker lacks sufficient information to evaluate the merits of the Claim or if the Initial Decision Maker concludes that, in the Initial Decision Maker's sole discretion, it would be inappropriate for the Initial Decision Maker to resolve the Claim.
- § 15.2.3 In evaluating Claims, the Initial Decision Maker may, but shall not be obligated to, consult with or seek information from either party or from persons with special knowledge or expertise who may assist the Initial Decision Maker in rendering a decision. The Initial Decision Maker may request the Owner to authorize retention of such persons at the Owner's expense.
- § 15.2.4 If the Initial Decision Maker requests a Contractor to furnish additional supporting data, the Contractor shall respond, within ten days after receipt of the request, and shall either (1) provide a response on the requested supporting data, (2) advise the Initial Decision Maker when the response or supporting data will be furnished, or (3) advise the Initial Decision Maker that no supporting data will be furnished. Upon receipt of the response or supporting data, if any, the Initial Decision Maker will either reject or approve the Claim in whole or in part.
- § 15.2.5 If a Claim has not been resolved after consideration of the foregoing and of further evidence presented by the parties or requested by the Architect, the Architect will render to the parties the Architect's written recommendation relative to the Claim, including any recommended change in the Contract Sum or Contract Time or both. If there is a surety and there appears to be a possibility of a Contractor's default, the Architect may, but is not obligated to, notify the surety and request the surety's assistance in resolving the controversy.
- § 15.2.6 Either party may file for mediation of an initial decision at any time, subject to the terms of Section 15.2.6.1.
- § 15.2.6.1 Either party may, within 30 days from the date of receipt of an initial decision, demand in writing that the other party file for mediation. If such a demand is made and the party receiving the demand fails to file for mediation within 30 days of receipt thereof, then both parties waive their rights to mediate.
- § 15.2.7 In the event of a Claim against the Contractor, the Owner may, but is not obligated to, notify the surety, if any, of the nature and amount of the Claim. If the Claim relates to a possibility of a Contractor's default, the Owner may, but is not obligated to, notify the surety and request the surety's assistance in resolving the controversy.

- § 15.2.8 If a Claim relates to or is the subject of a mechanic's lien, the party asserting such Claim may proceed in accordance with applicable law to comply with the lien notice or filing deadlines.
- § 15.2.9 Nothing contained in this Agreement is intended to alter or replace any provisions of the laws of the state of New York relating to claims made against the Owner or to relieve Contractor from any obligations thereunder.

§ 15.3 Mediation

(Paragraph deleted)

§ 15.3.2 The parties endeavor to resolve their Claims by mediation which, unless the parties mutually agree otherwise, shall be administered by the American Arbitration Association in accordance with its Construction Industry Mediation Procedures in effect on the date of the Agreement. A request for mediation shall be made in writing, delivered to the other party to the Contract, and filed with the person or entity administering the mediation. Mediation shall proceed in advance of binding dispute resolution proceedings.

(Paragraph deleted)


§ 15.3.4 The parties shall share the mediator's fee and any filing fees equally. The mediation shall be held in the place where the Project is located, unless another location is mutually agreed upon. Agreements reached in mediation shall be enforceable as settlement agreements in any court having jurisdiction thereof.


§ 15.4 Arbitration

§ 15.4.1 The parties expressly agree to **delete** the requirement that any and all controversies and claims arising out of the contract be referred to arbitration. By so agreeing, the parties express their mutual intent that there is **no agreement** to arbitrate such disputes, notwithstanding the use and reference to arbitration elsewhere in the contract documents."

(Paragraphs deleted)

§ 15.5 The parties expressly agree that any claim, dispute, or other controversy of any nature arising out of the contract or performance of the work shall be commenced and maintained in Supreme Court.

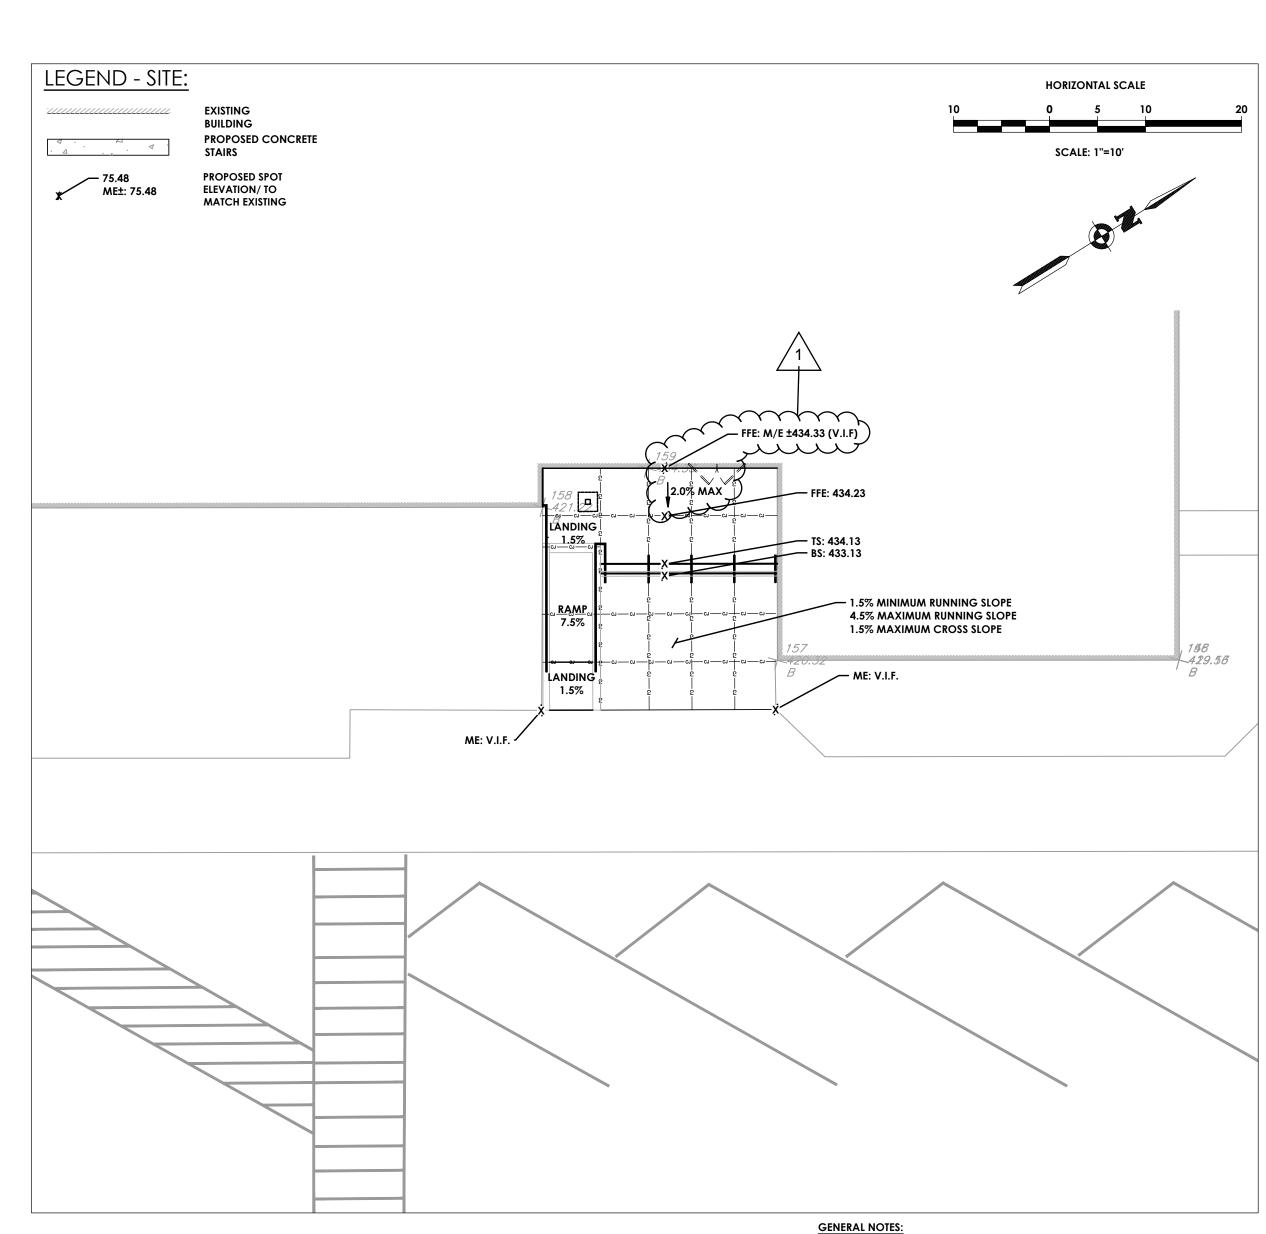

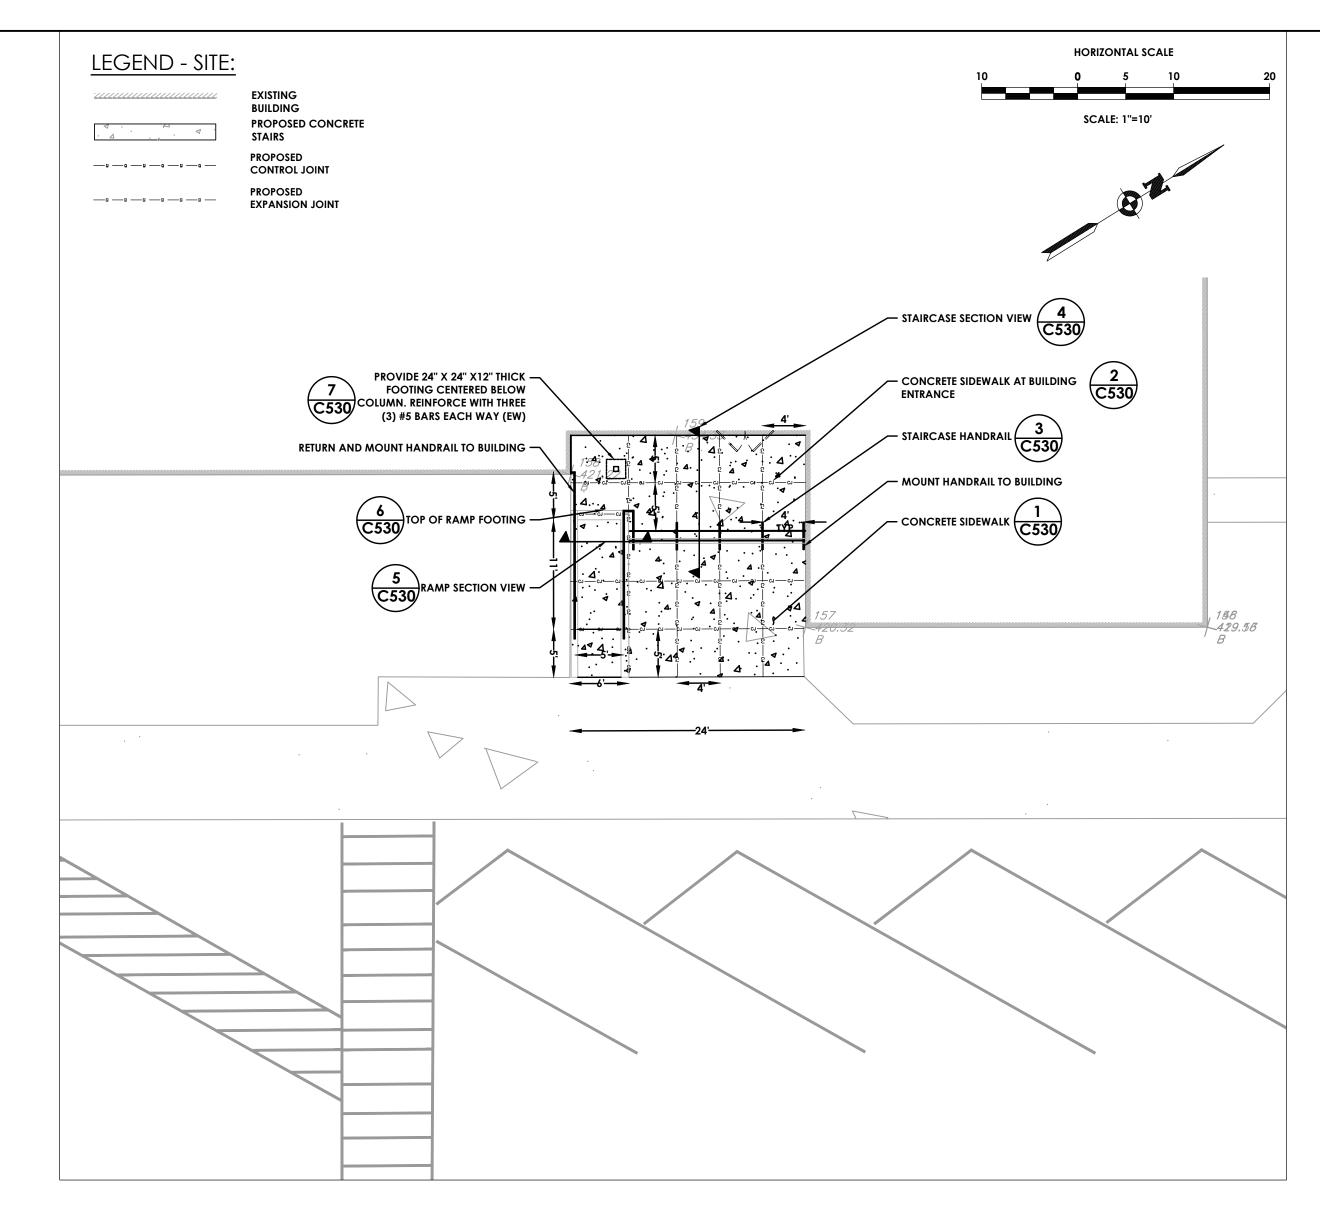

DEMOLITION NOTES:

- 1. <u>SECURITY PROVIDE, INSTALL AND MAINTAIN TEMPORARY BARRIERS AND SECURITY DEVICES.</u>
- 2. <u>DIG SAFE</u> GENERAL SITE CONTRACTOR IS RESPONSIBLE TO CALL DIG SAFE PRIOR TO BEGINNING DEMOLITION.
- 3. <u>VERIFICATION</u> SITE CONTRACTOR TO VERIFY VERTICAL AND HORIZONTAL LOCATION OF ALL UTILITIES WITHIN THE WORK AREA OR THOSE EXPECTED TO BE AFFECTED BY NEW WORK, AND SUBSURFACE FEATURES. THE SITE CONTRACTOR MUST BRING ANY ISSUES TO THE DESIGN ENGINEER AND OBTAIN WRITTEN APPROVAL FROM THE OWNER'S ONSITE REPRESENTATIVE UPON COMPLETION OF VERIFICATION PRIOR TO THE START OF DEMOLITION OR CONSTRUCTION.
- 4. APPLICABILITY THE SITE CONTRACTOR IS RESPONSIBLE FOR ALL DEMOLITION WORK SHOWN ON THE "C" SERIES DRAWINGS AND AS DEFINED IN THE SPECIFICATIONS UNLESS SPECIFICALLY DEFINED OTHERWISE. THIS INCLUDES ALL REMOVALS AS NECESSARY FOR THE CONSTRUCTION OF NEW WORK EVEN IF NOT SPECIFICALLY NOTED ON THE CONTRACT DOCUMENTS.
- RECORD MAP DURING REMOVAL/DEMOLITION PROCESS THE SITE CONTRACTOR SHALL OBTAIN DETAILED RECORD INFORMATION TO ACCURATELY LOCATE ALL EXISTING UNDERGROUND UTILITIES ENCOUNTERED. THIS INFORMATION SHALL BE INCLUDED ON THE RECORD/AS-BUILT MAPS TO BE SUPPLIED BY THE SITE CONTRACTOR TO HYDE PARK CENTRAL SCHOOL DISTRICT.
- SHUTDOWNS SITE CONTRACTOR TO COORDINATE ALL UTILITY SHUT DOWNS, RELOCATIONS, SERVICE INSTALLATIONS WITH THE SCHOOL DISTRICT AND LOCAL UTILITY COMPANIES.
- 7. COORDINATION SITE CONTRACTOR SHALL COORDINATE THE REMOVAL OF DEMOLISHED MATERIAL WITH THE OWNER'S REPRESENTATIVE SITE FURNISHINGS AND MATERIAL DETERMINED TO TO BE REMOVED SHALL BE REMOVE AND EXPORTED OFFSITE IN A LEGAL MANNER AND IN ACCORDANCE WITH ALL LOCAL, STATE AND FEDERAL REGULATIONS.
- 8. PROTECT ALL EXISTING FEATURES TO REMAIN. DAMAGE TO EXISTING ASPHALT, LAWN AND OTHER FEATURES TO REMAIN SHALL BE REPAIRED AT THE SITE CONTRACTOR'S EXPENSE.
- DISTURBANCE ALL SURFACES THAT ARE DISTURBED DUE TO CONSTRUCTION, OUTSIDE OF THE MAJOR WORK AREAS, ARE TO BE RESTORED TO PRE-CONSTRUCTION CONDITION, IN ACCORDANCE WITH THE CONCRETE SECTION DETAILS INCLUDED IN THESE PLANS. LAWN AREAS ARE TO BE RE-ESTABLISHED WITH A MINIMUM OF 4 INCHES OF TOPSOIL AND SEED.
- 10. HAZARDOUS MATERIAL ANY MATERIALS CONTAINING ASBESTOS SHALL BE REMOVED AND DISPOSED OF IN ACCORDANCE WITH FEDERAL, STATE AND LOCAL REGULATIONS. NOTE THIS MAY INCLUDE UNDERGROUND UTILITIES. SITE CONTRACTOR SHALL CONTACT THE OWNER'S REPRESENTATIVE TO NOTIFY THEM OF ANY UNKNOWN HAZARDOUS MATERIAL.
- 11. EXISTING SERVICE SITE CONTRACTOR SHALL MAINTAIN SERVICE FROM ALL UTILITIES NOT SLATED FOR DEMOLITION AND SHALL REMAIN FUNCTIONAL UPON COMPLETION OF DEMOLITION.
- 12. EXISTING UTILITIES THAT ARE PROPOSED TO BE REMOVED, UNLESS OTHERWISE INDICATED, SHALL BE EXCAVATED, UTILITY MATERIAL REMOVED, AND DISPOSED OF IN ACCORDANCE WITH ALL APPLICABLE SPECIFICATIONS. ALL TRENCHES SHALL BE BACKFILLED WITH GRANULAR FILL, COMPACTED IN 12" LIFTS TO 95% MODIFIED PROCTOR TEST. ALL DISTURBED AREAS SHALL BE RESTORED IN KIND IN ACCORDANCE WITH THE DETAILS IN THESE PLANS AND AT A MINIMUM TO THEIR ORIGINAL STATE.
- 13. PERMITS SITE CONTRACTOR IS RESPONSIBLE TO OBTAIN ALL PERMITS REQUIRED FOR DEMOLITION AND CONSTRUCTION, INCLUDING ALL FEES ASSOCIATED WITH THOSE PERMITS, IN THE BID.
- 14. ENVIRONMENTAL CONDITIONS OR ISSUES, NOT PREVIOUSLY IDENTIFIED, ARE ENCOUNTERED DURING DEMOLITION, THE SITE CONTRACTORS(S) SHALL IMMEDIATELY NOTIFY THE OWNER AND ENGINEER BEFORE CONTINUING THE DEMOLITION PROCESS.
- 15. <u>RECYCLE</u> ALL MATERIALS WHEN APPROPRIATE.
- 16. SPOIL MATERIALS FROM DEMOLITION OR EARTHWORK, SHALL BE REMOVED FROM THE SITE AND LEGALLY DISPOSED OF AT THE SITE
- 17. EXISTING STRUCTURES THAT ARE ABANDONED IN PLACE SHALL BE REMOVED TO A DEPTH OF 2 FEET BELOW FINISHED GRADE. STRUCTURES SHALL BE FILLED WITH CRUSHED STONE, (MEETING NYSDOT STANDARD SPECIFICATION SECTION 304) COMPACTED IN 12" LIFTS TO 95%
- 18. FIELD TILE IN THE EVENT FIELD TILE IS ENCOUNTERED, THE SITE CONTRACTOR SHALL NOTIFY THE OWNER AND ENGINEER. UNDER NO CIRCUMSTANCES SHALL FIELD TILE BE PERMITTED TO EXIST NEAR BUILDING FOUNDATIONS.
- 19. ELECTRICAL DEMOLITION THE ELECTRICAL CONTRACTOR IS RESPONSIBLE FOR DEMOLITION OF EXISTING ELECTRICAL FEATURES, AND SHALL COORDINATE WITH THE SITE CONTRACTOR ON BACKFILLING TRENCHES TO MEET THE SPECIFICATIONS OUTLINED WITHIN THE CONTRACT DOCUMENTS.

SITE PLAN NOTES:

- 1. LAYOUT THE DIMENSIONS SHOWN ARE TO THE FACE OF THE CURB AND INCLUDES THE OVERALL SIDEWALK WIDTH, WHERE APPLICABLE.
- ASPHALT SHALL BE CALCULATED BY WEIGHT (TONNAGE) USING THE SPECIFIED COMPACTED THICKNESS. PAVEMENTS WILL BE BASED ON THE TONNAGE PLACED AS ACCOUNTED FOR BY EACH DELIVERY TRUCK. FULL TIME ON-SITE OBSERVATION WILL BE PRESENT DURING ALL RELATED PAVING OPERATIONS.
- SUBBASE MATERIAL AND THE VARIOUS ASPHALT CONCRETE MATERIALS CALLED FOR IN THESE DRAWINGS SHALL CONFORM WITH THE REFERENCED SECTION OF THE NEW YORK STATE DEPARTMENT OF TRANSPORTATION STANDARD SPECIFICATIONS FOR CONSTRUCTION AND MATERIALS, DATED "LATEST EDITION". CONSTRUCTION SHALL BE AS FURTHER SET FORTH IN THOSE SPECIFICATIONS AND AS OTHERWISE PROVIDED FOR IN THESE DRAWINGS.
- PLACE ASPHALT CONCRETE MIXTURE ON PREPARED SURFACE, SPREAD AND STRIKE-OFF USING A SELF-PROPELLED PAVING MACHINE, WITH VIBRATING SCREED. PLACEMENT IN INACCESSIBLE AND SMALL AREAS MAY BE BY HAND.
- 5. JOINTS PROVIDE JOINTS BETWEEN OLD AND NEW PAVEMENT OR BETWEEN SUCCESSIVE DAYS WORK.
- 6. TACK COAT SHALL CONFORM WITH THE FOLLOWING:
- A. TACK COAT SHALL MEET THE MATERIAL REQUIREMENTS OF 702-90 ASPHALT EMULSION FOR TACK COAT OF THE NEW YORK STATE DEPARTMENT OF TRANSPORTATION STANDARD SPECIFICATIONS FOR CONSTRUCTION AND MATERIALS, DATED "LATEST EDITION" AND SHALL BE APPLIED IN ACCORDANCE WITH SECTION 407. TACK COAT SHALL BE IN ACCORDANCE WITH THOSE SPECIFICATIONS AND AS OTHERWISE PROVIDED FOR IN THESE DRAWINGS.
- B. REMOVE LOOSE AND FOREIGN MATERIAL FROM ASPHALT SURFACE BEFORE PAVING NEXT COURSE. USE POWER BROOMS, BLOWERS
- C. APPLY TACK COAT TO THE ASPHALT PAVEMENT SURFACES AND SURFACES OF CURBS, GUTTERS, MANHOLES, AND OTHER STRUCTURES
- PROJECTING INTO OR ABUTTING PAVEMENT. DRY TO A "TACKY" CONSISTENCY BEFORE PAVING. D. TACK COAT ENTIRE VERTICAL SURFACE OF ABUTTING EXISTING PAVEMENT.
- CLEAN SURFACE AFTER COMPLETION OF PAVING AND SURFACING OPERATIONS, CLEAN SURFACES OF EXCESS OR SPILLED ASPHALT, GRAVEL OR STONE MATERIALS TO THE SATISFACTION OF THE ENGINEER.





TRIC

0

BE

H (

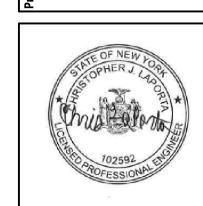

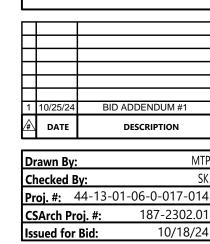

SITE, GRADING AND ESC PLAN


CONSTRUCTION DOCUMENTS

COPYRIGHT © ALL RIGHTS RESERVED


2. SIDEWALK SLOPES SHALL NOT EXCEED 1.5% FOR CROSS SLOPES AND 5% FOR RUNNING SLOPES. 3. CONTRACTOR SHALL SET UP SIDEWALK RELOCATION SIGNAGE, BARRIERS AND SAFE PASSAGEWAYS SO AS TO LIMIT DISRUPTION TO PEDESTRIAN CIRCULATION.

1. PROPOSED SIDEWALK GRADES SHALL MATCH GRADE OF EXISTING SIDEWALKS


TO REMAIN.

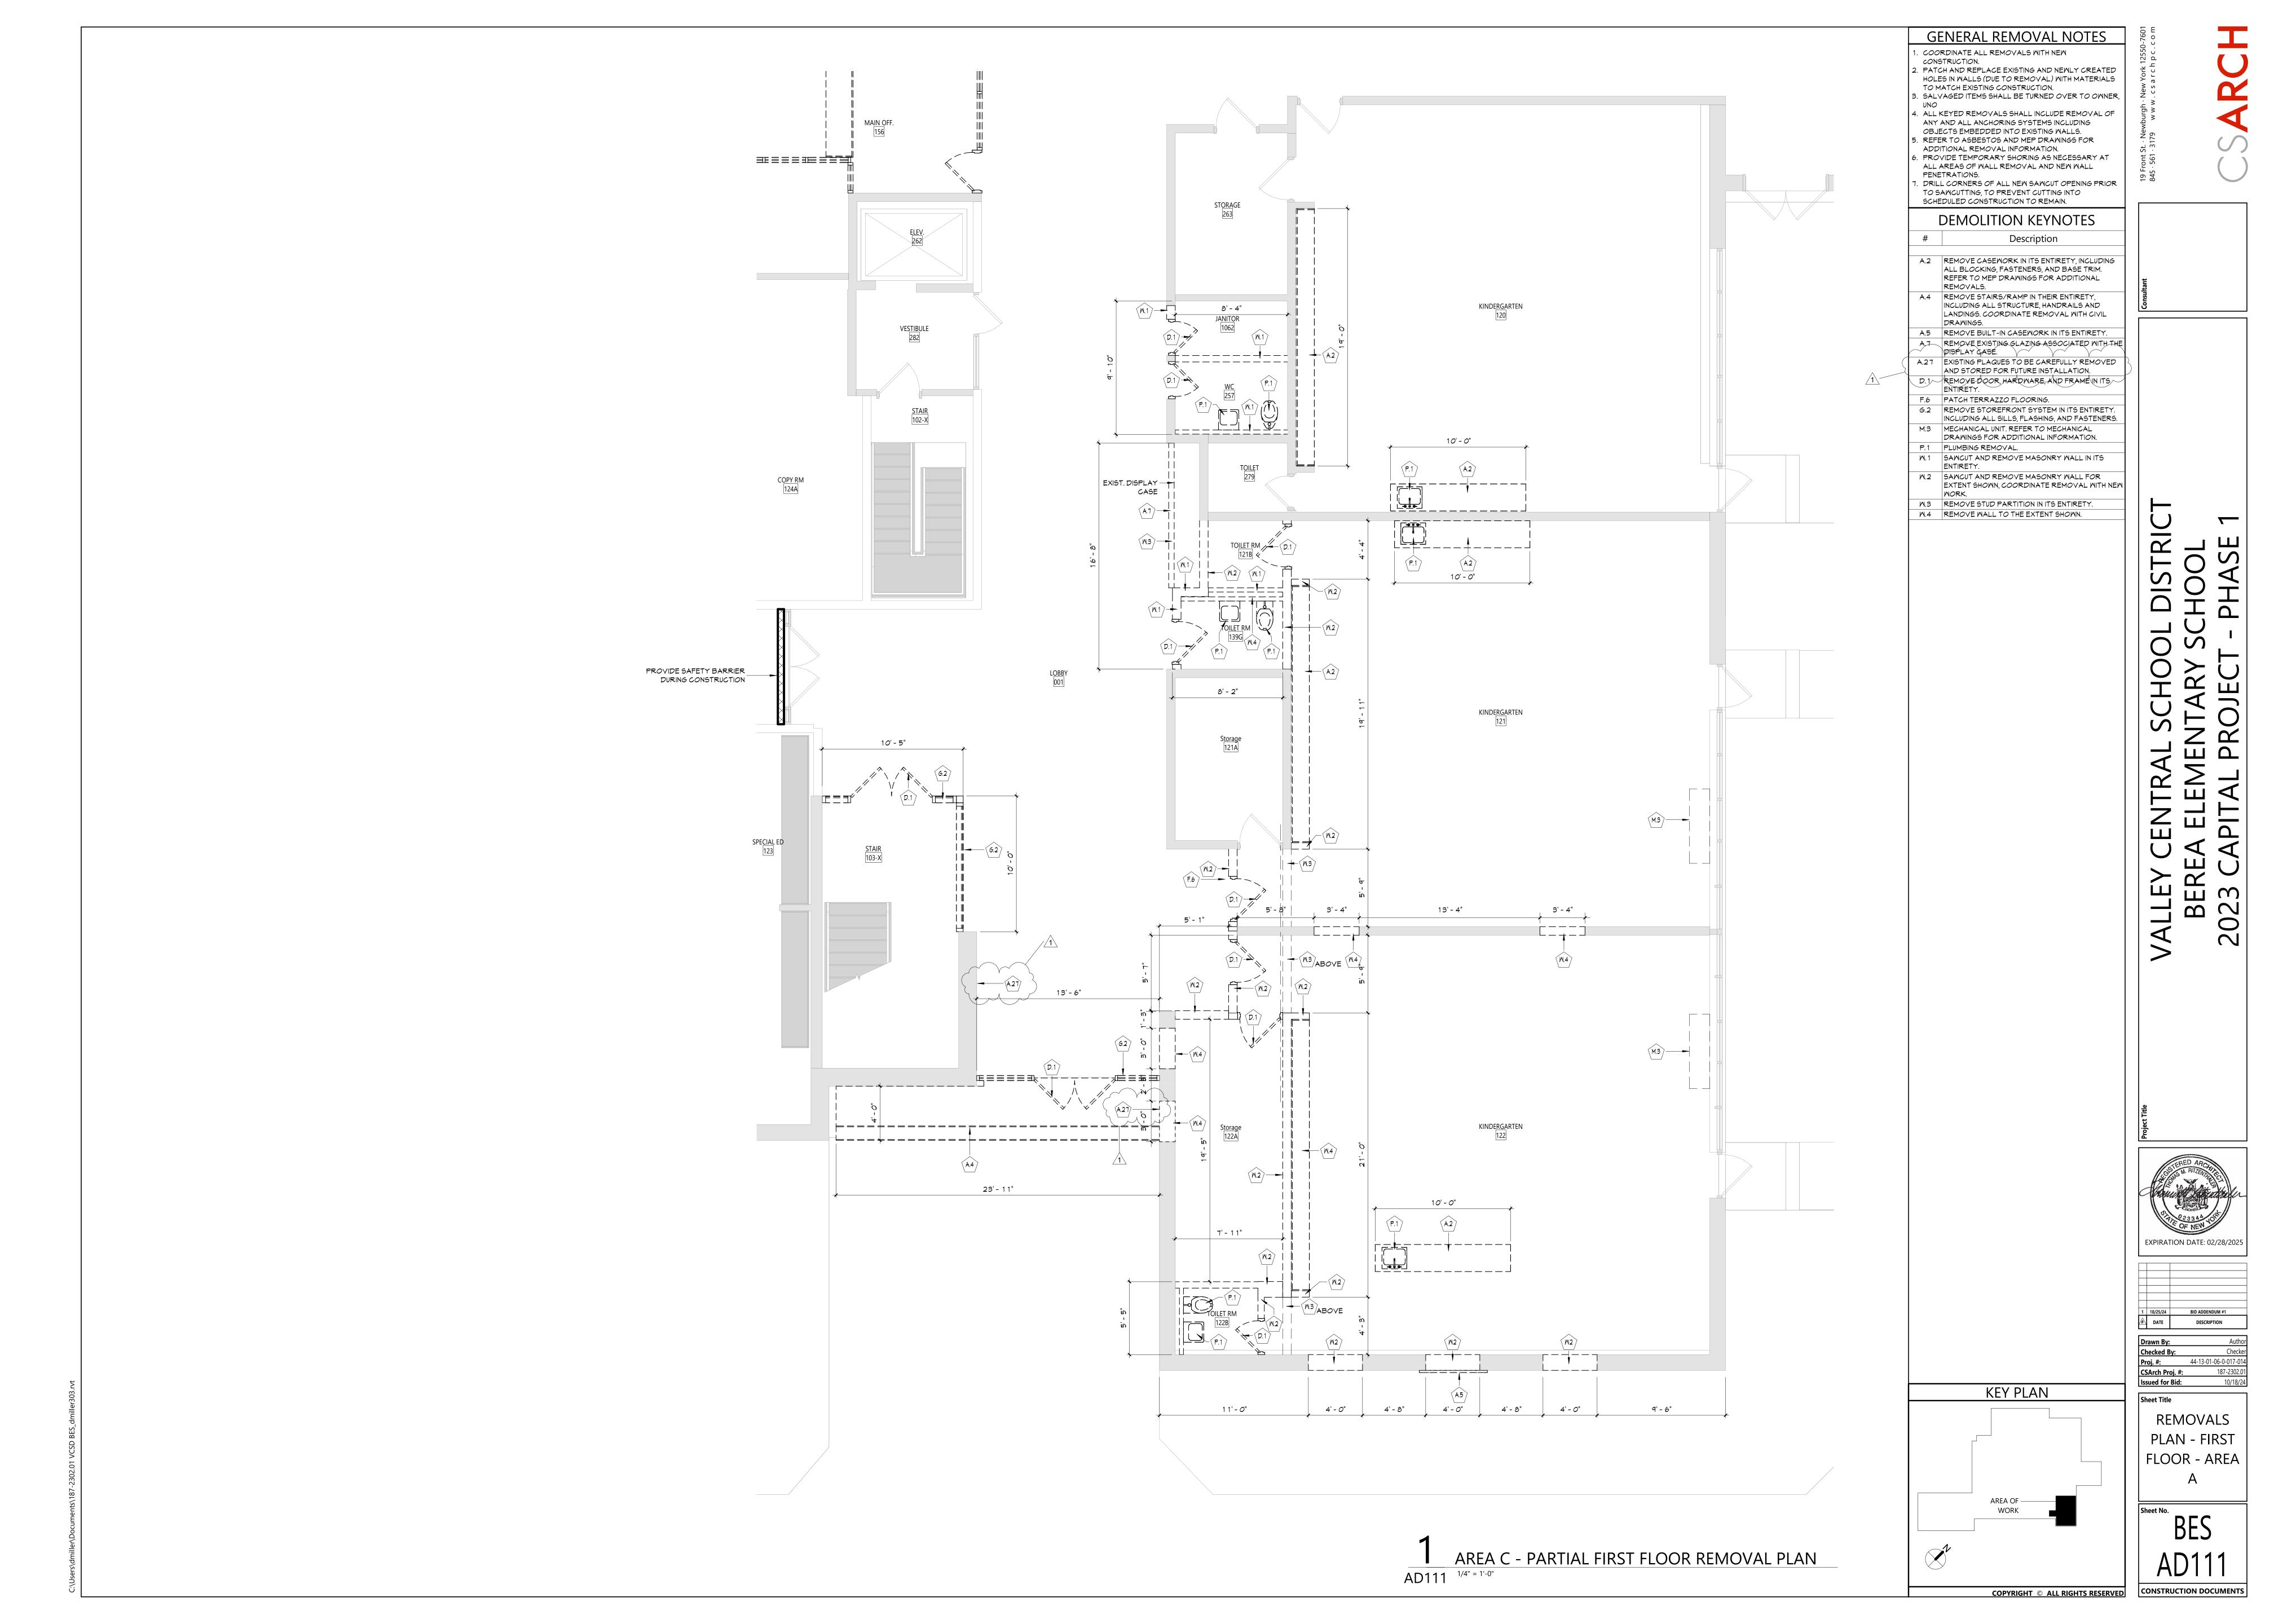




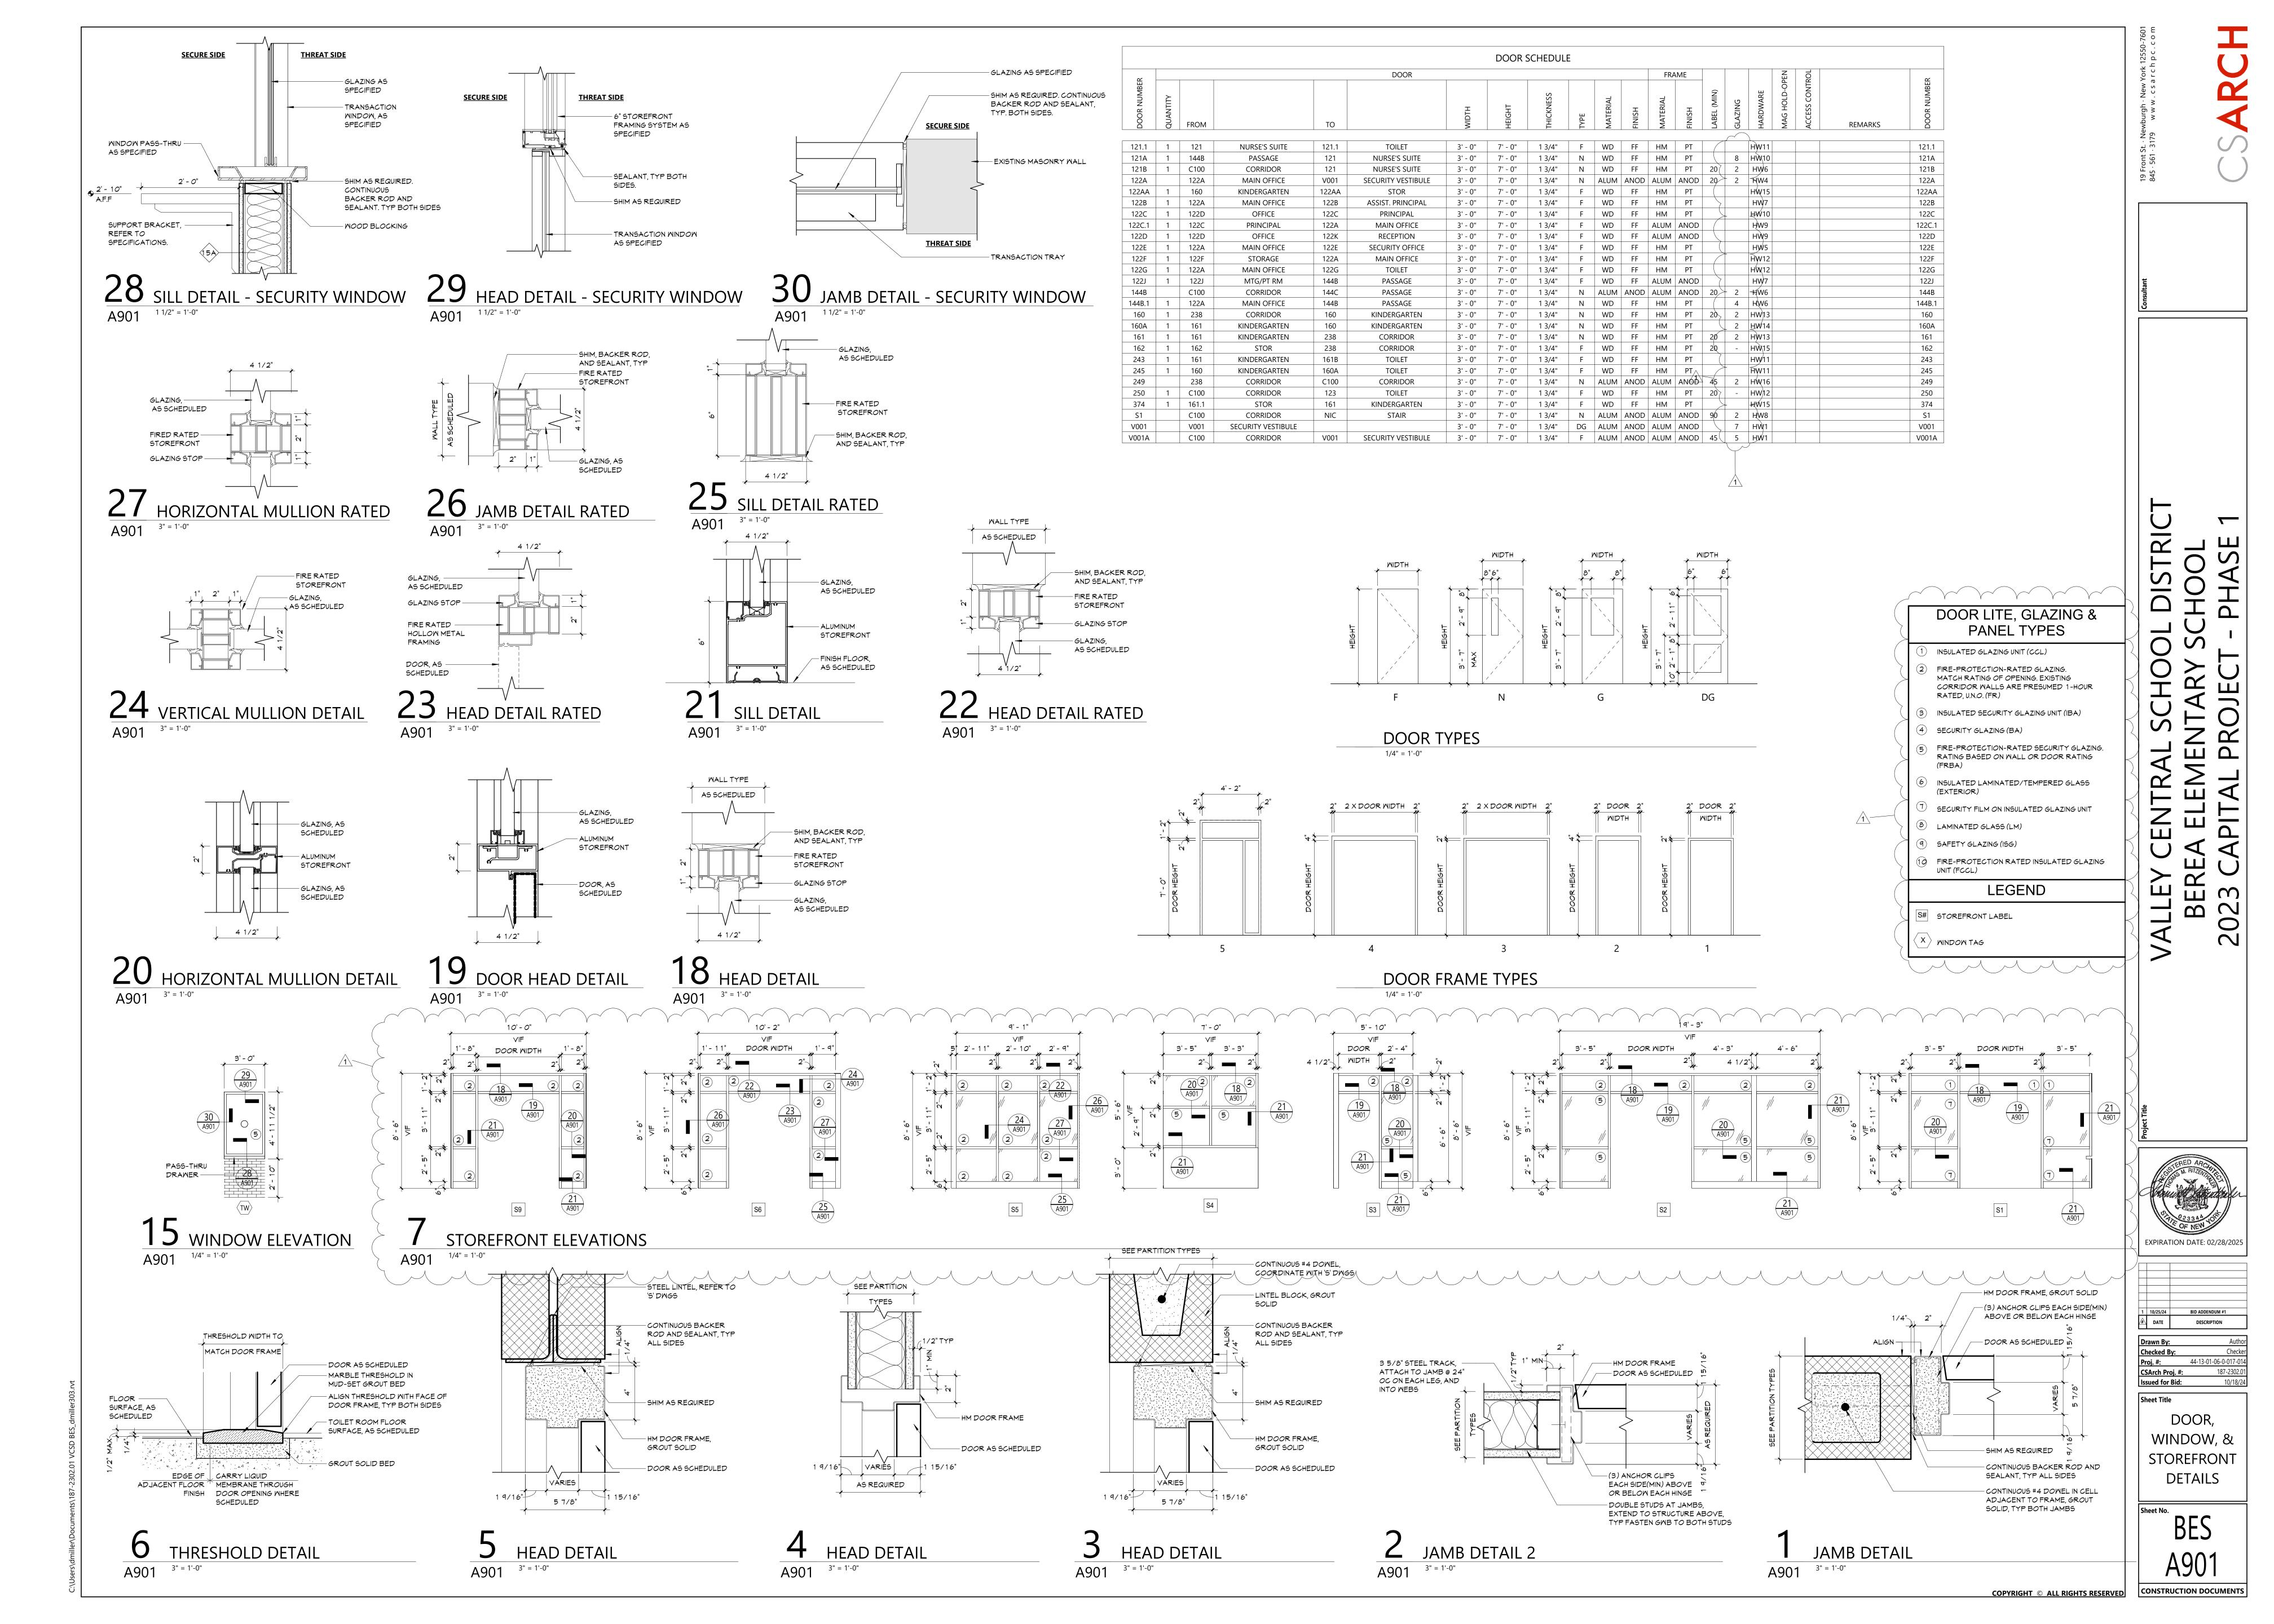



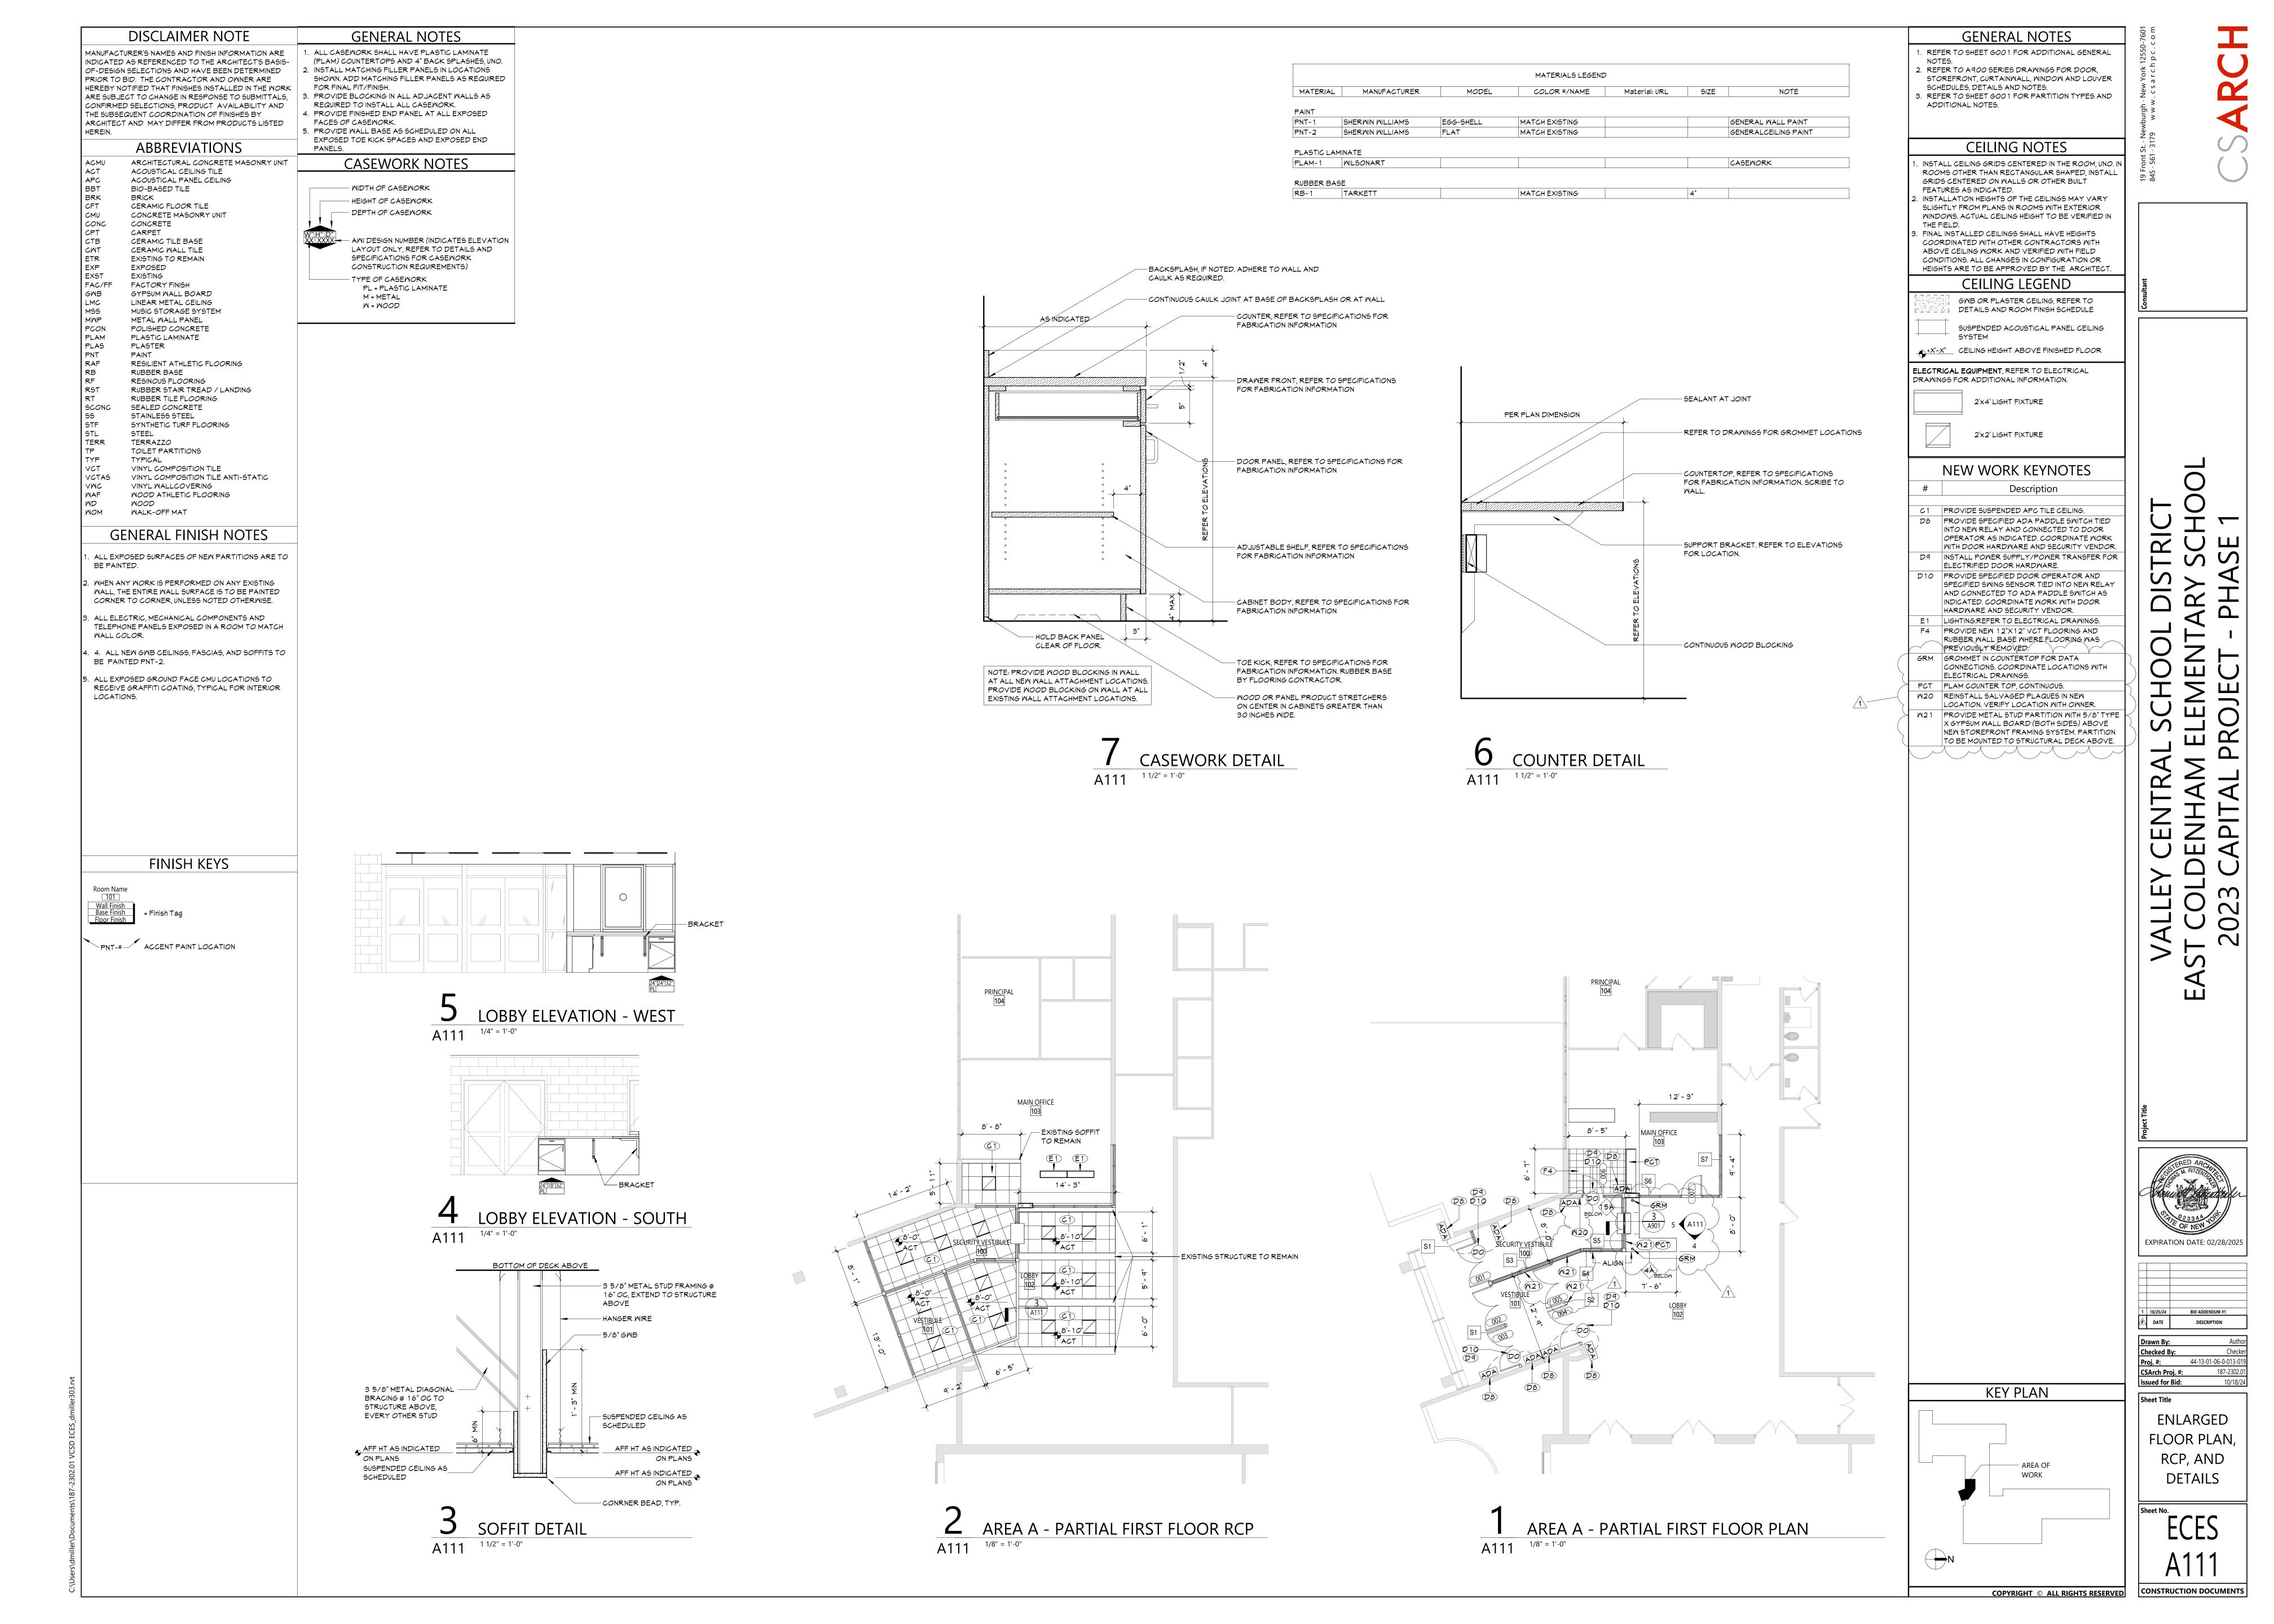

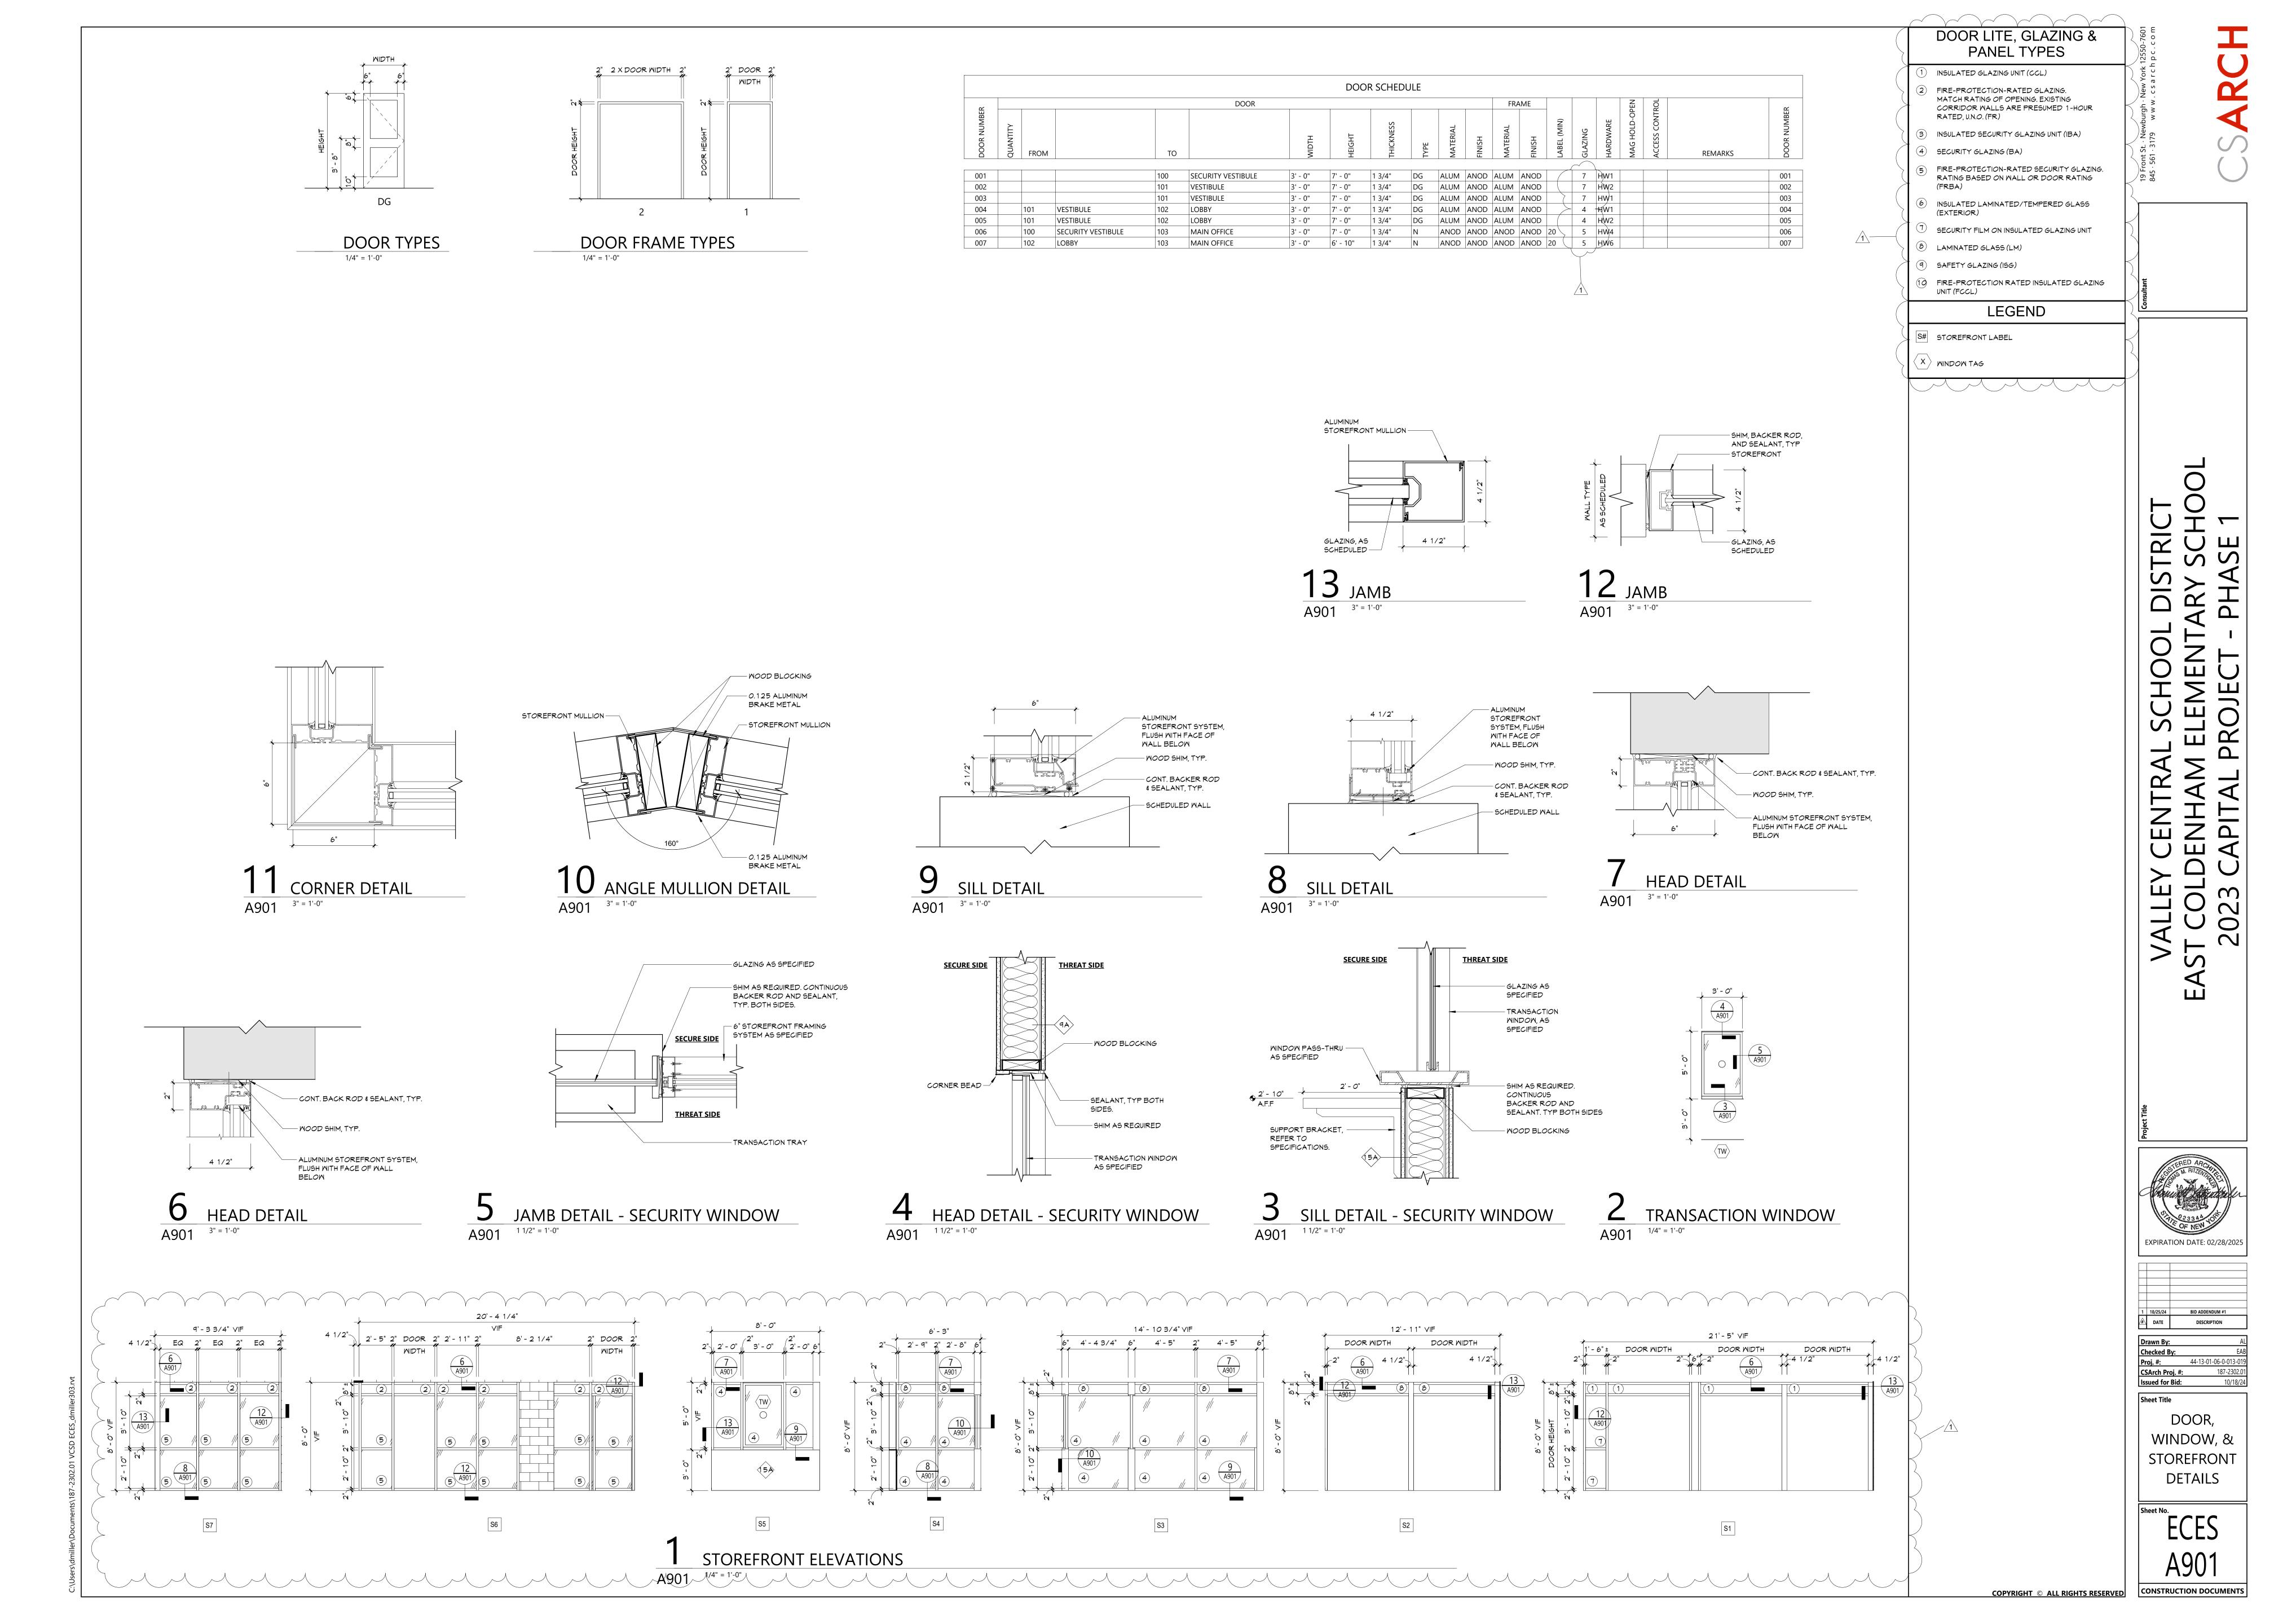


OVERALL FLOOR PLAN -FIRST FLOOR


G111 CONSTRUCTION DOCUMENTS

COPYRIGHT © ALL RIGHTS RESERVED

GENERAL DESIGN LOAD REQUIREMENTS BUILDING CODE SECTION OCCUPANCY/USE/LOCATION REQUIRED **LOADING TYPE** 2020 BUILDING CODE OF NEW SCHOOLS - CLASSROOMS 40 PSI MINIMUM UNIFORM **DISTRIBUTED LIVE LOADS** YORK STATE TABLE 1607.1 SCHOOLS - FIRST FLOOR CORRIDORS 100 PSI SCHOOLS - CORRIDORS ABOVE FIRST FLOOR 80 PSI OFFICE BUILDINGS - OFFICES 50 PSI ROOFS - ORDINARY/FLAT (NON-OCCUPIABLE) 40 PSI GROUND SNOW LOADS 2020 BUILDING CODE OF NEW ORANGE COUNTY 40 PSI YORK STATE FIGURE 1608.2 MONTGOMERY, NY **FLAT ROOF SNOW LOADS** 2020 BUILDING CODE OF NEW ORANGE COUNTY 28 PSI YORK STATE FIGURE 1608.2 MONTGOMERY, NY **DESIGN WIND SPEEDS** 2020 BUILDING CODE OF NEW RISK CATEGORY III 130 VMPH YORK STATE FIGURE 1609.3 MONTGOMERY, NY




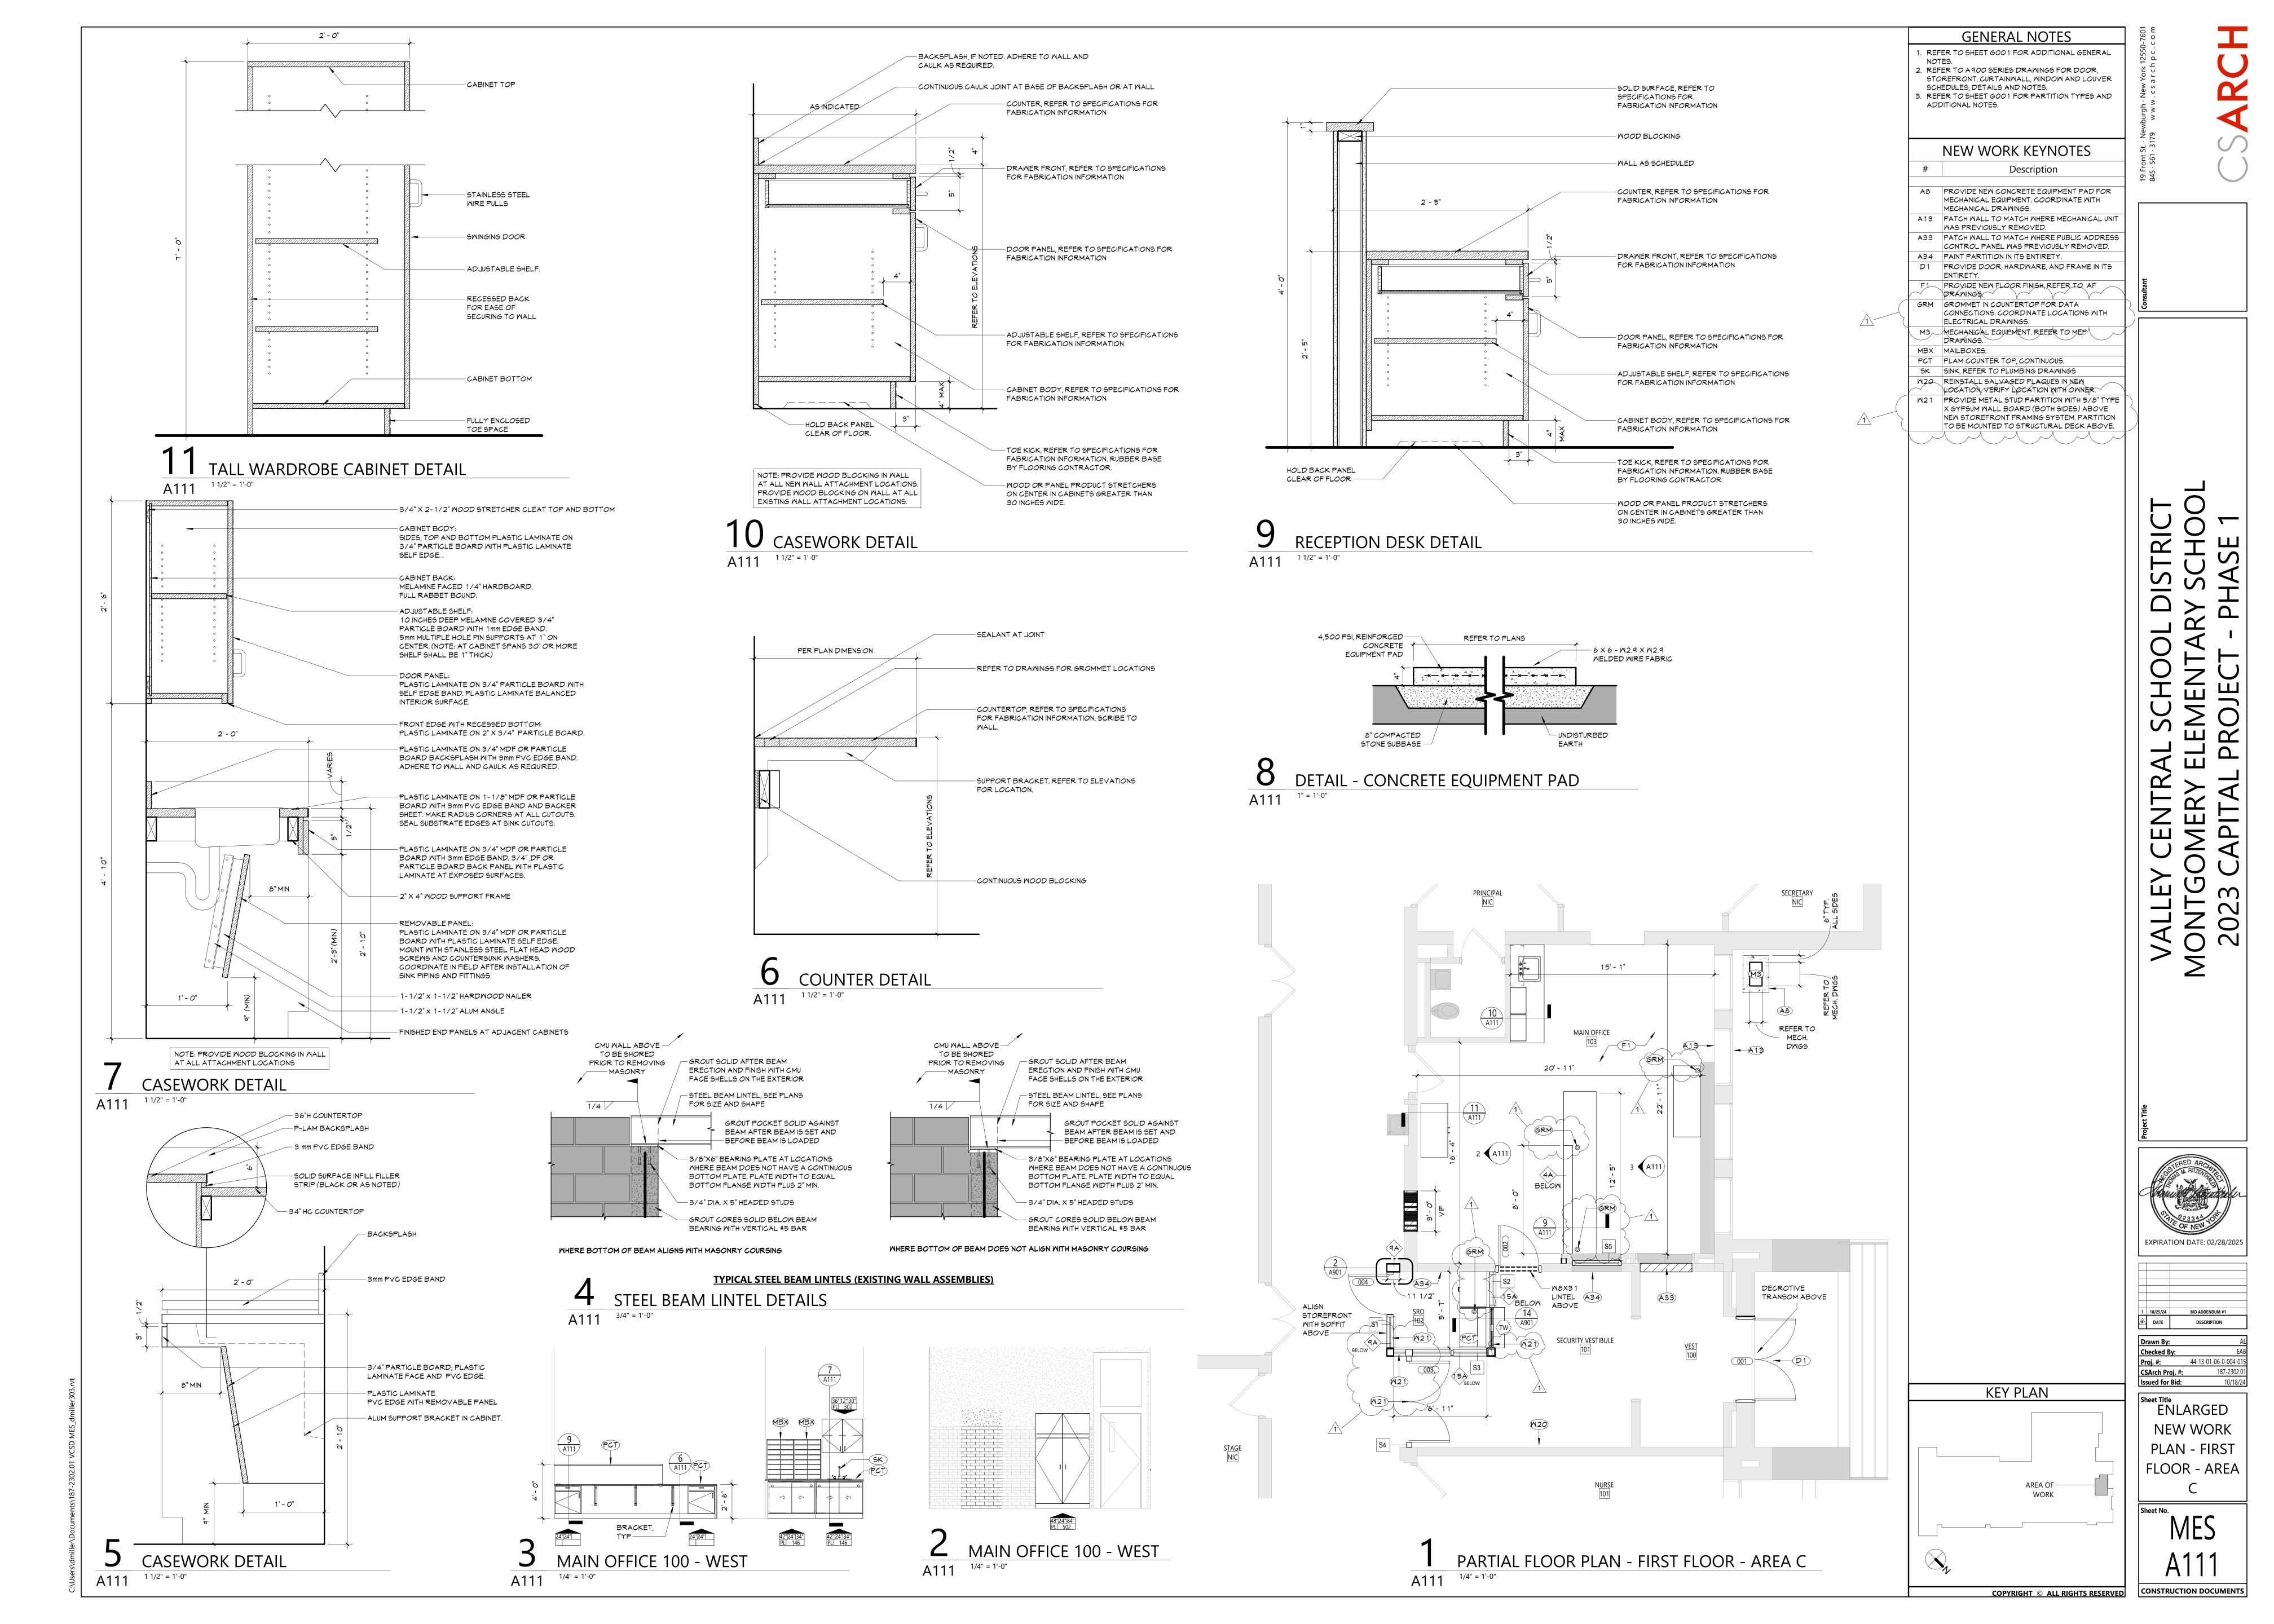

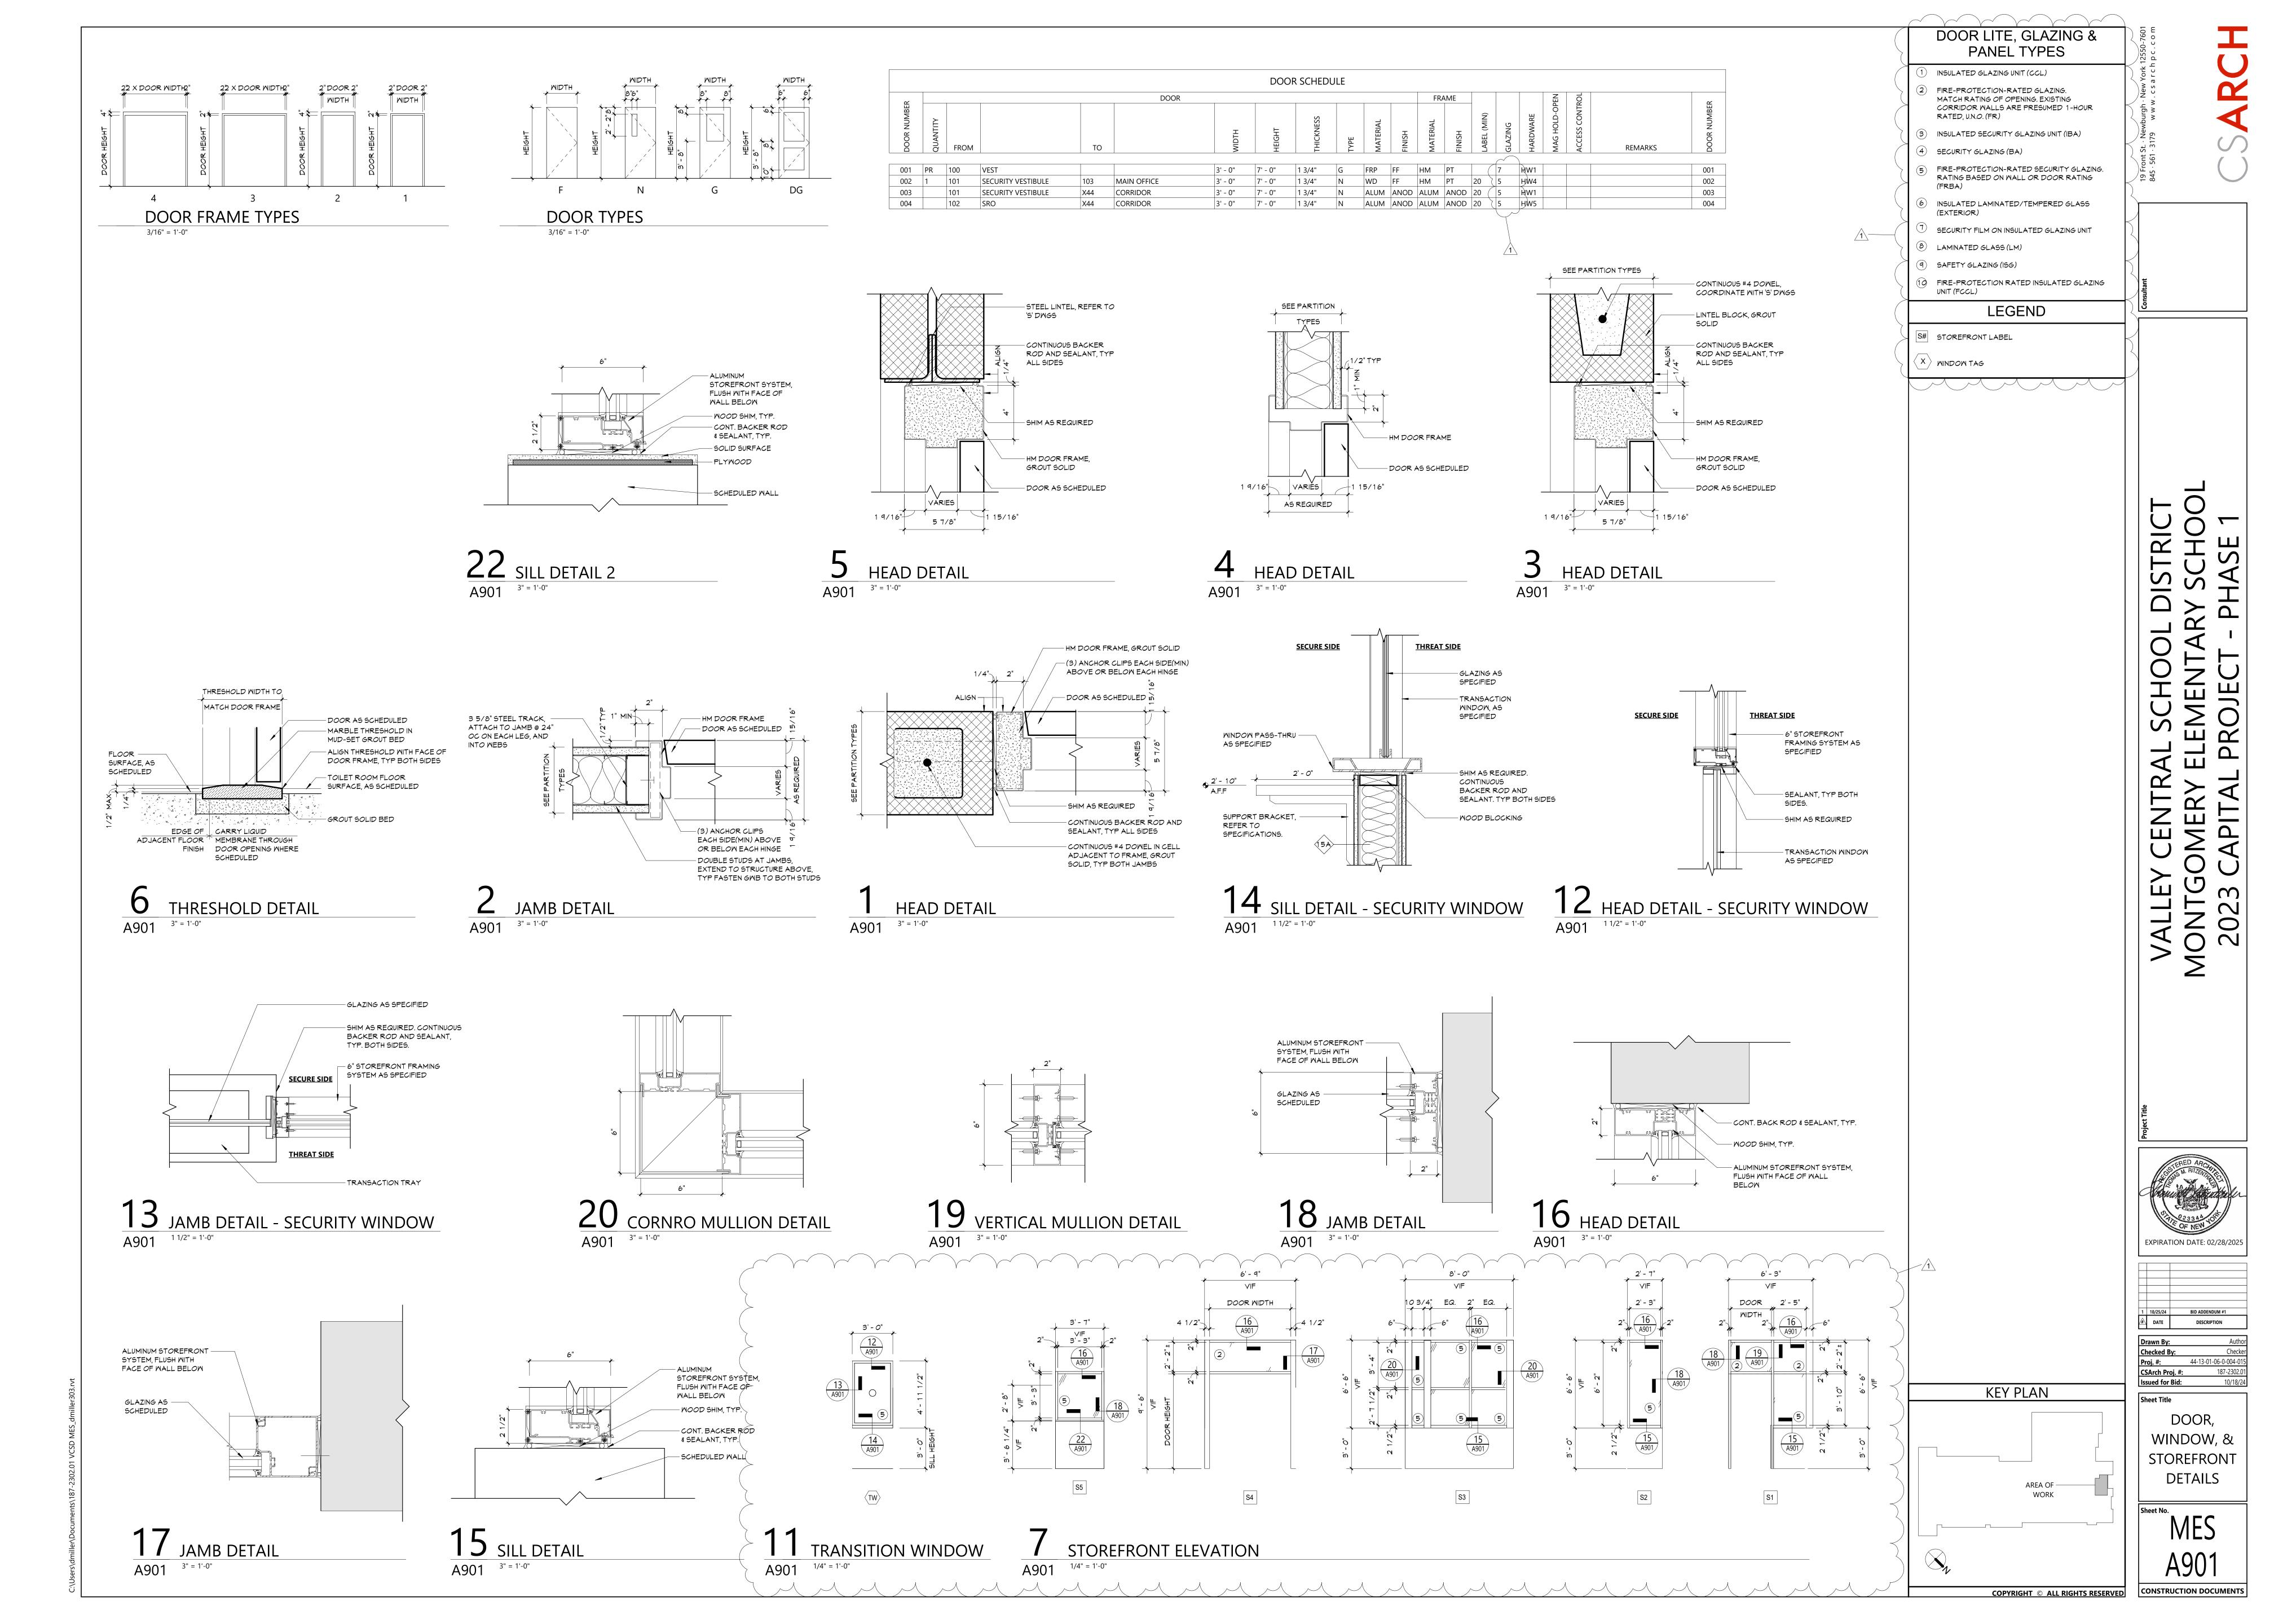

工	
O	
~	
⋖	
S	
()	


Project	
STERED ARCHINGS STERED ARCHING	Teller.

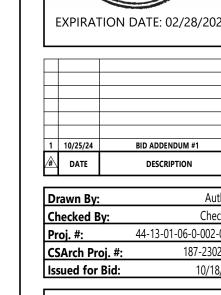

OVERALL FLOOR PLAN -FIRST FLOOR

CONSTRUCTION DOCUMENTS

COPYRIGHT © ALL RIGHTS RESERVED

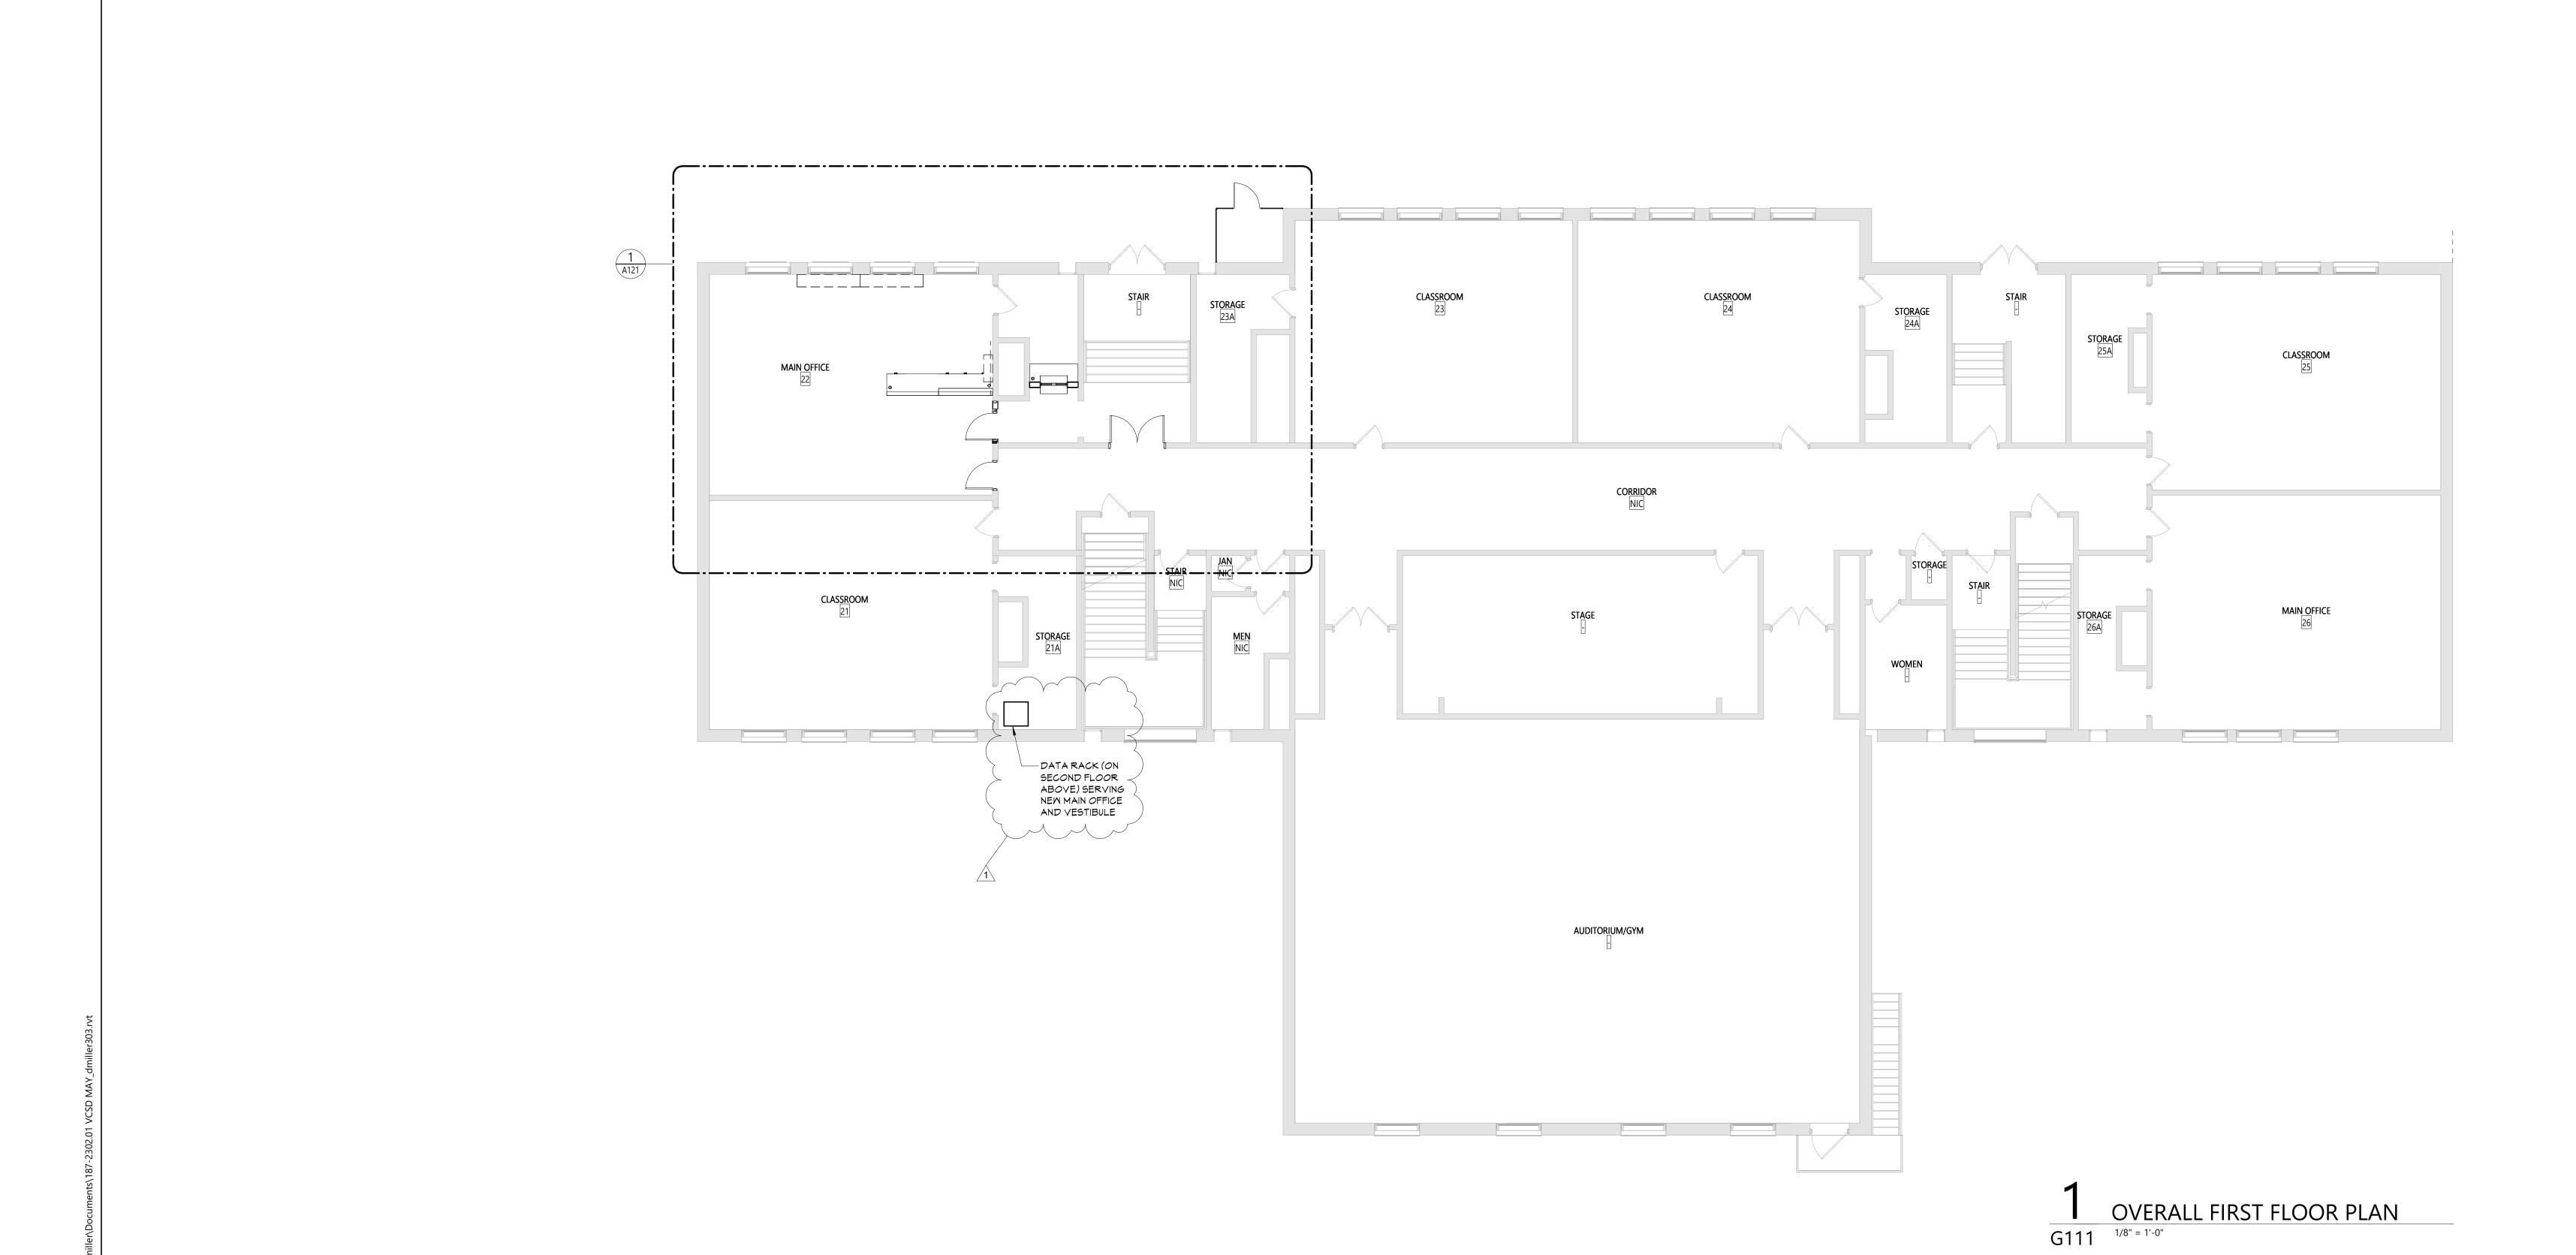

GENERAL DESIGN LOAD REQUIREMENTS

OCCUPANCY/USE/LOCATION

OFFICE BUILDINGS - OFFICES

ORANGE COUNTY

MONTGOMERY, NY

ORANGE COUNTY

MONTGOMERY, NY

RISK CATEGORY III

MONTGOMERY, NY

SCHOOLS - FIRST FLOOR CORRIDORS

SCHOOLS - CORRIDORS ABOVE FIRST FLOOR

ROOFS - ORDINARY/FLAT (NON-OCCUPIABLE)

SCHOOLS - CLASSROOMS

REQUIRED

40 PSI

100 PSI

80 PSI

50 PSI

40 PSI

40 PSI

28 PSI

130 VMPH

BUILDING CODE SECTION

2020 BUILDING CODE OF NEW

2020 BUILDING CODE OF NEW

YORK STATE FIGURE 1608.2

YORK STATE FIGURE 1608.2

YORK STATE FIGURE 1609.3

2020 BUILDING CODE OF NEW

LOADING TYPE


MINIMUM UNIFORM


GROUND SNOW LOADS

DESIGN WIND SPEEDS


DISTRIBUTED LIVE LOADS YORK STATE TABLE 1607.1

FLAT ROOF SNOW LOADS 2020 BUILDING CODE OF NEW

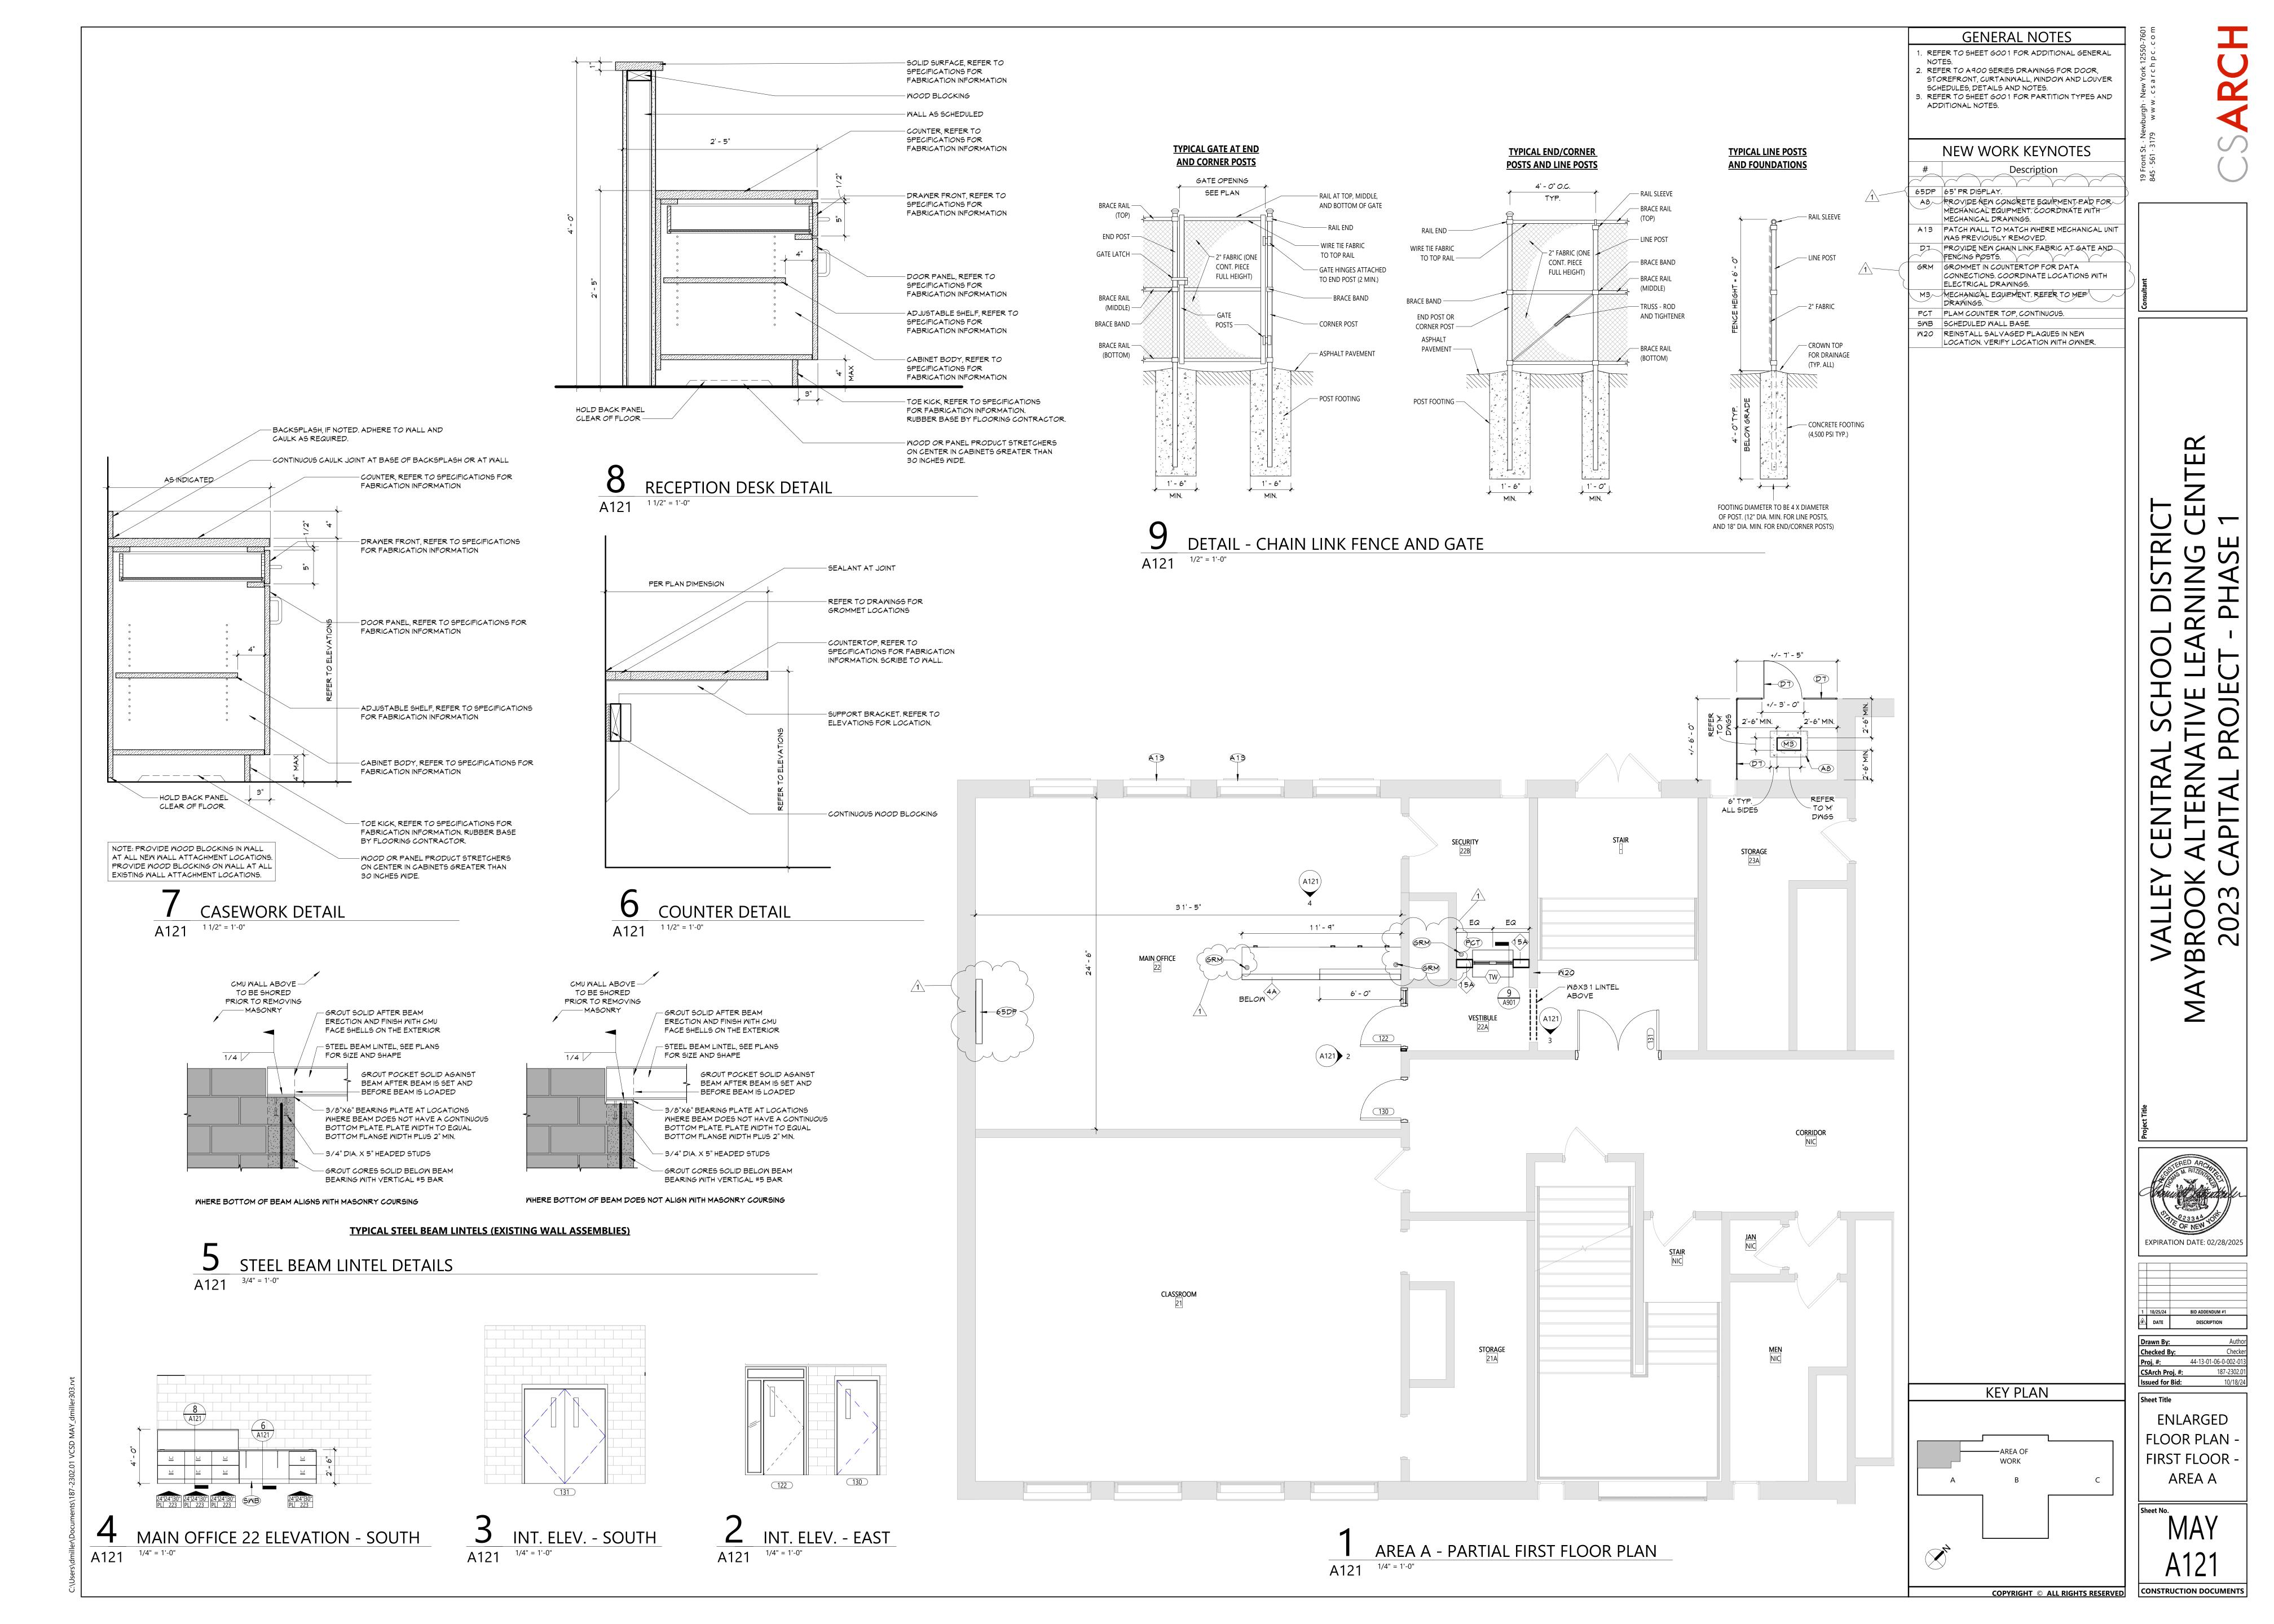

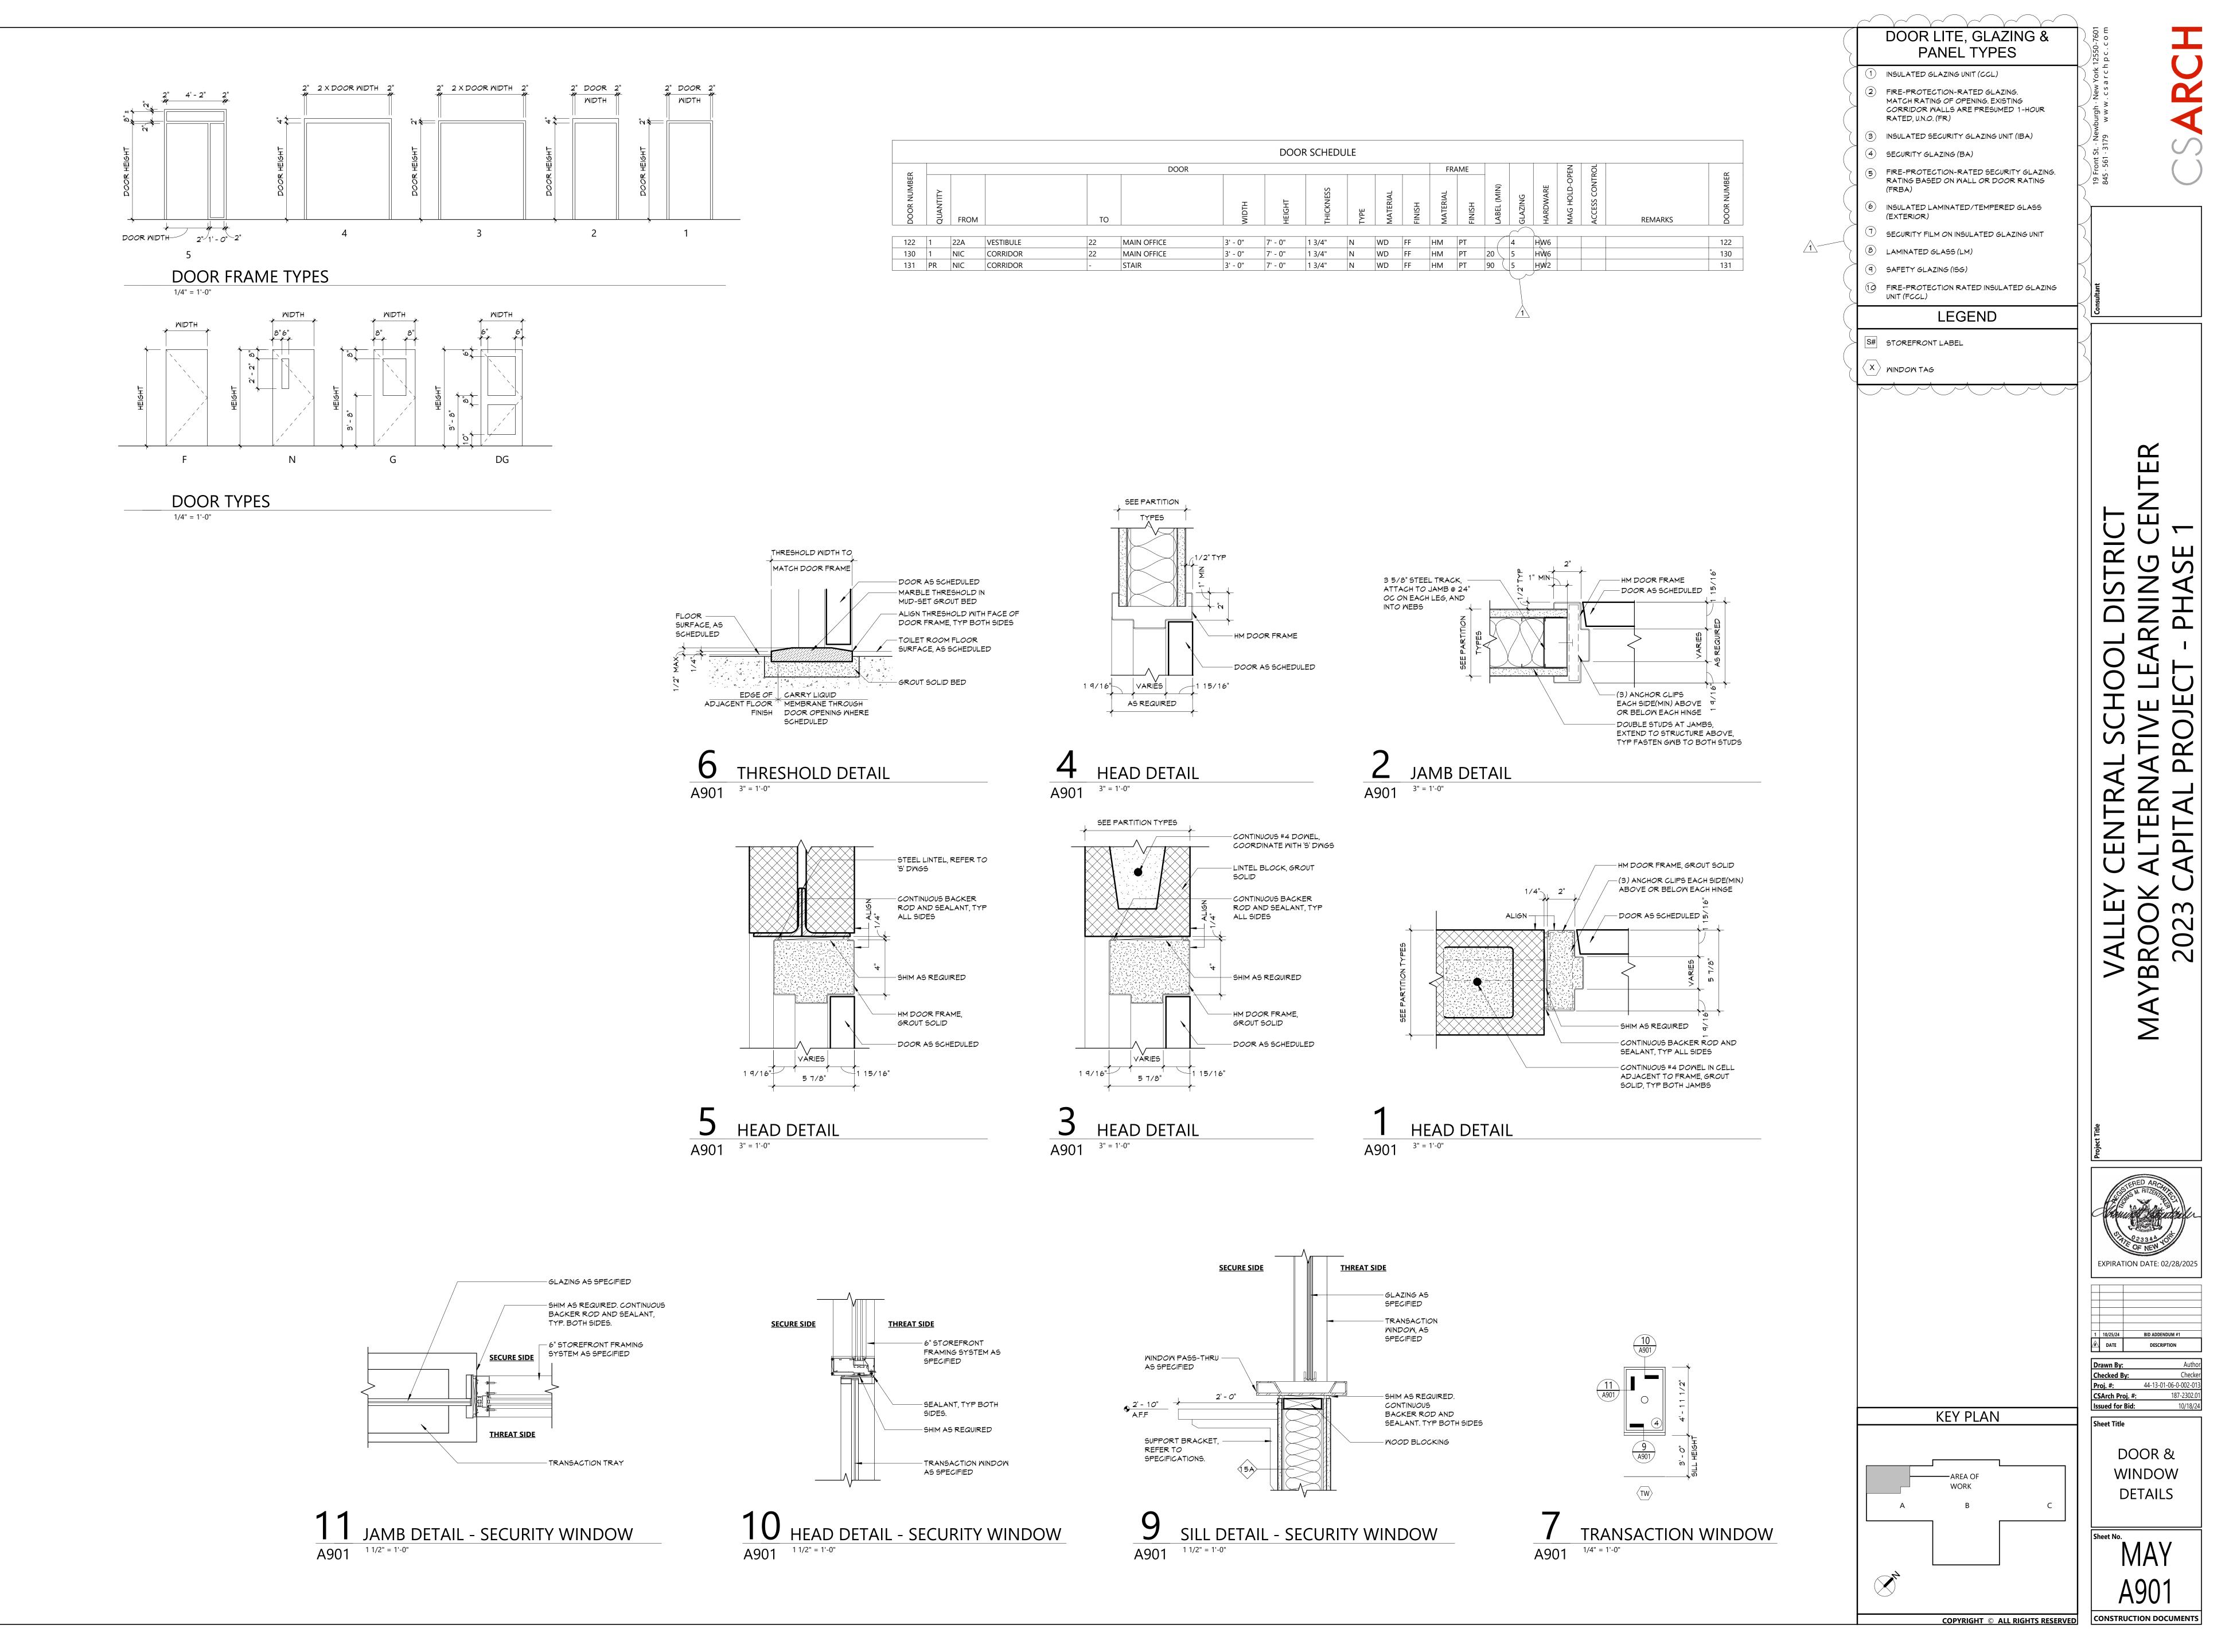

ers\dmiller\Documents\187-2302.01 VCSD MAY_dmil

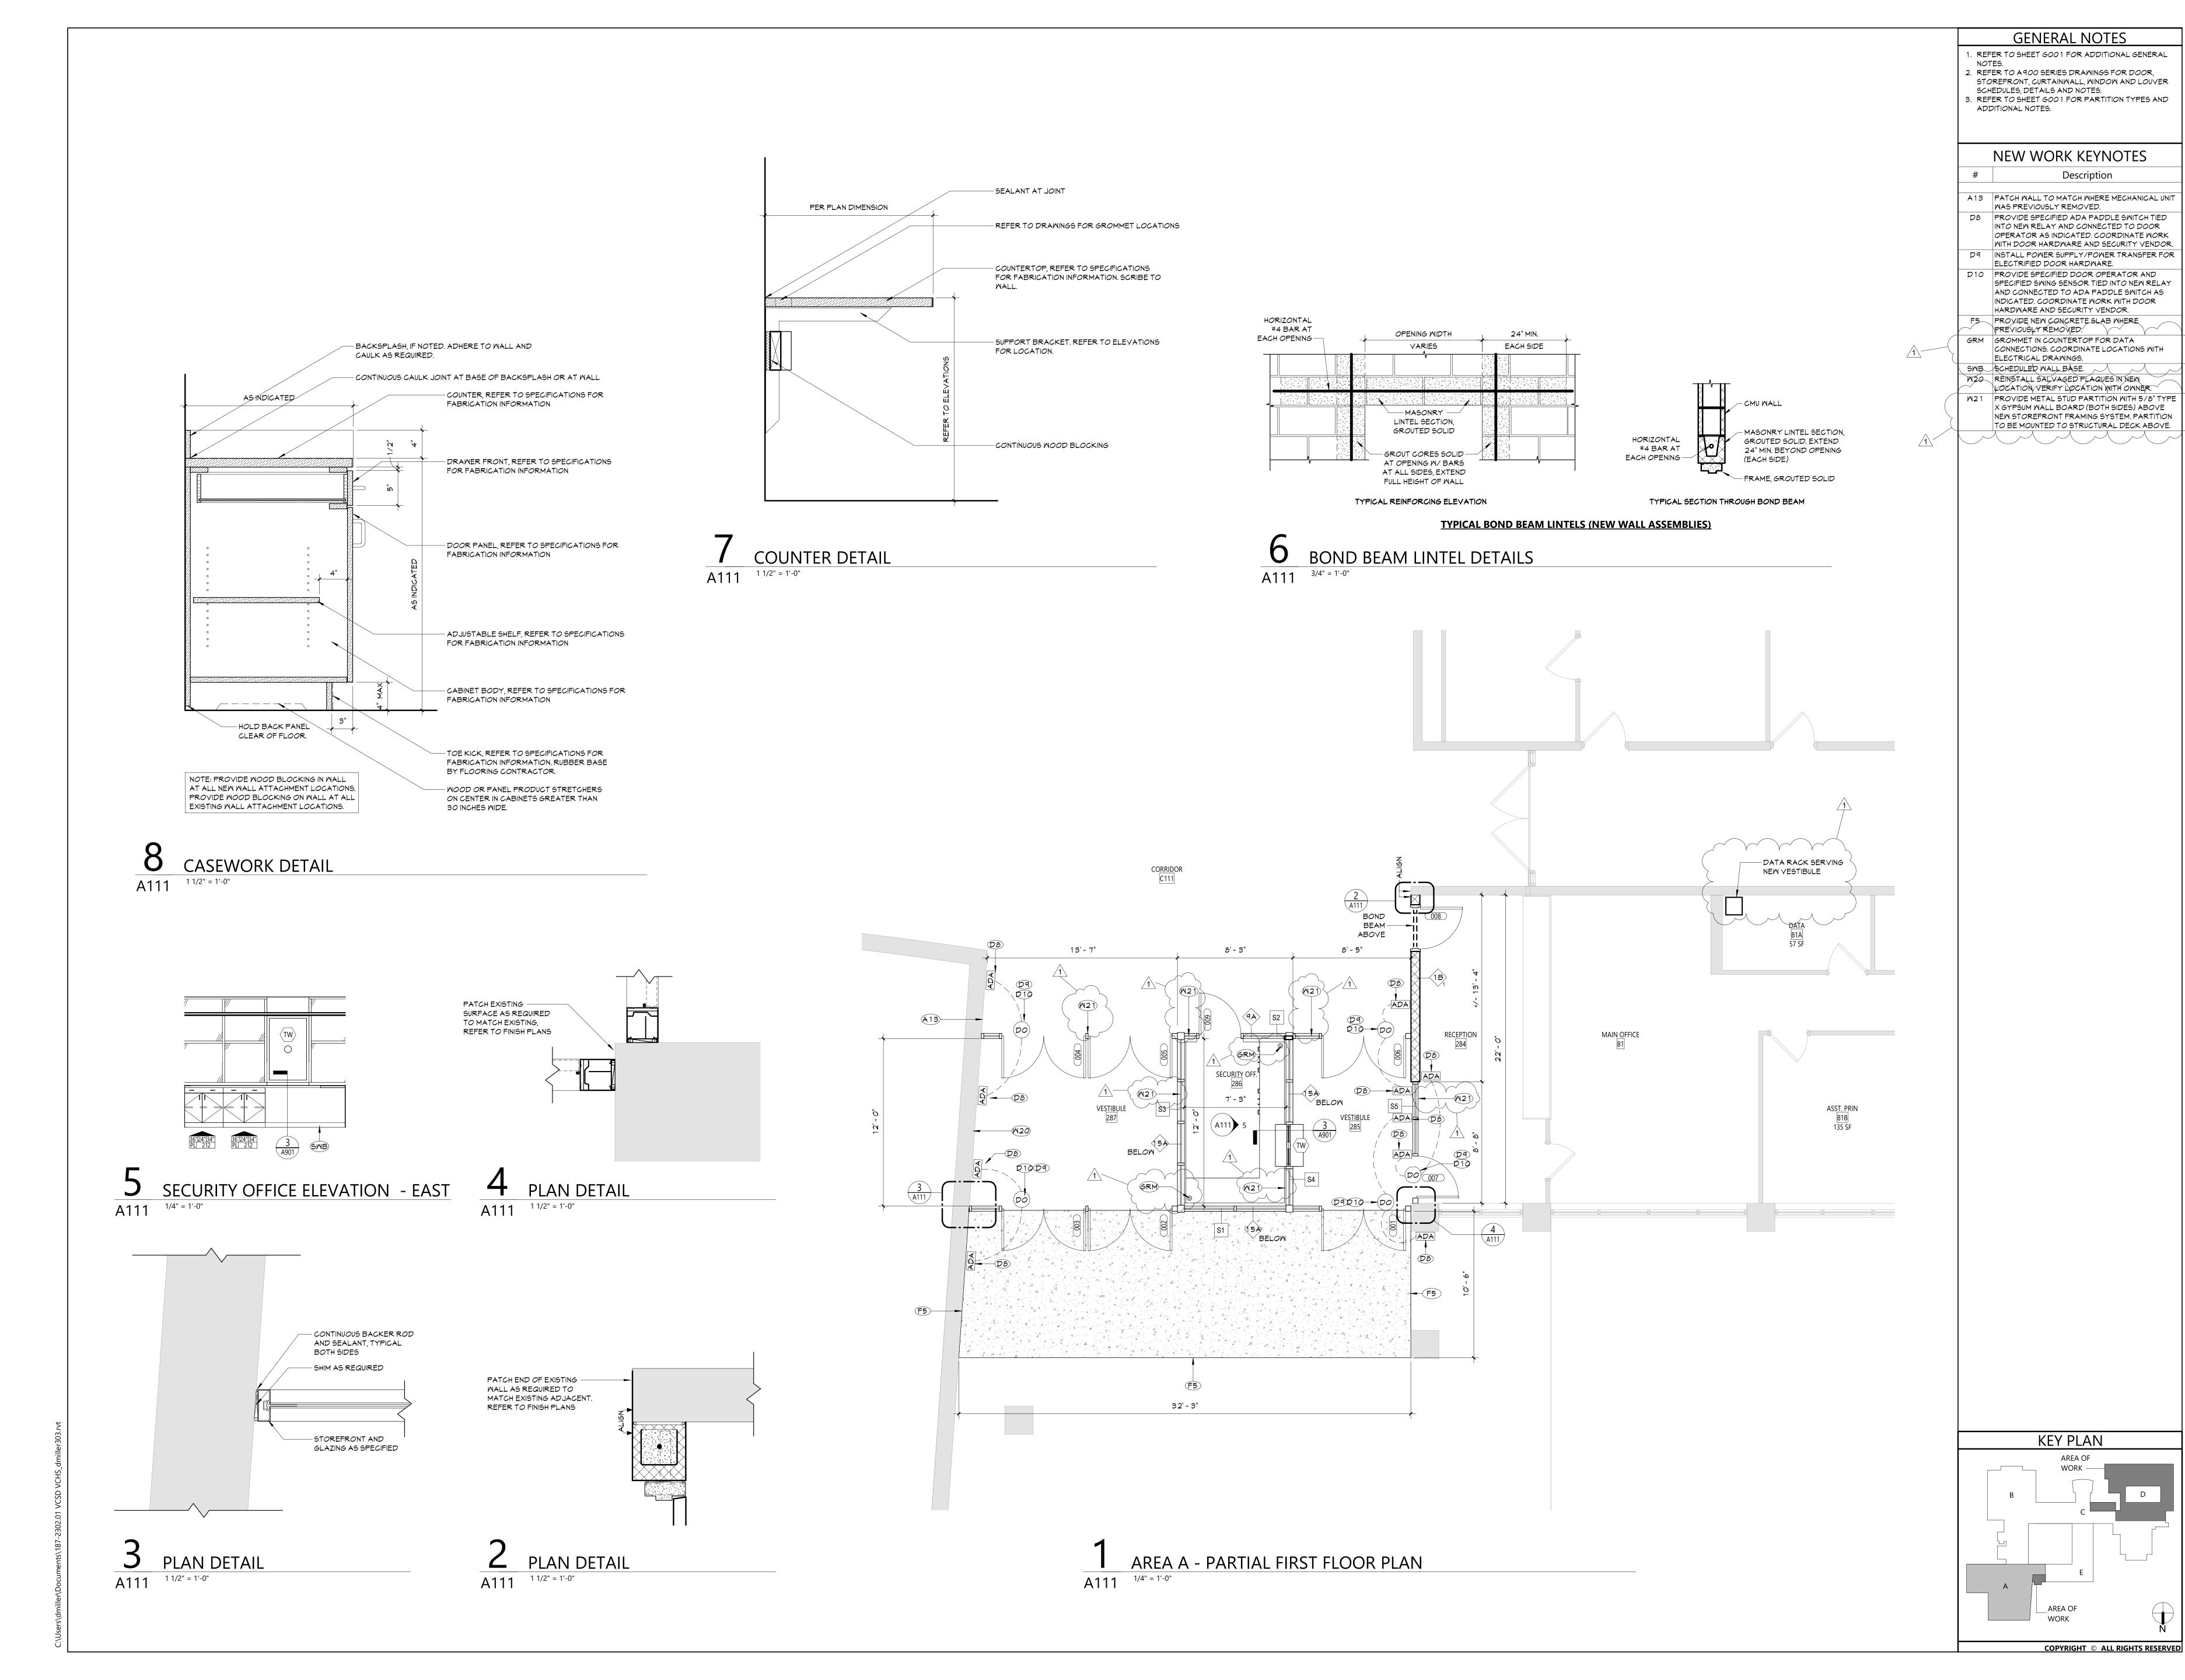

CENTRAL SCHOOL DISTRICT

SY CENTRAL HIGH SCHOOL

CAPITAL PROJECT - PHASE 1

EXPIRATION DATE: 02/28/2025

Drawn By:
Checked By:
Sheet Title
ENLARGED
VESTIBULE
PLAN,
SECTION AND


DETAILS

Sheet No.


VCHS

A111

CONSTRUCTION DOCUMENTS

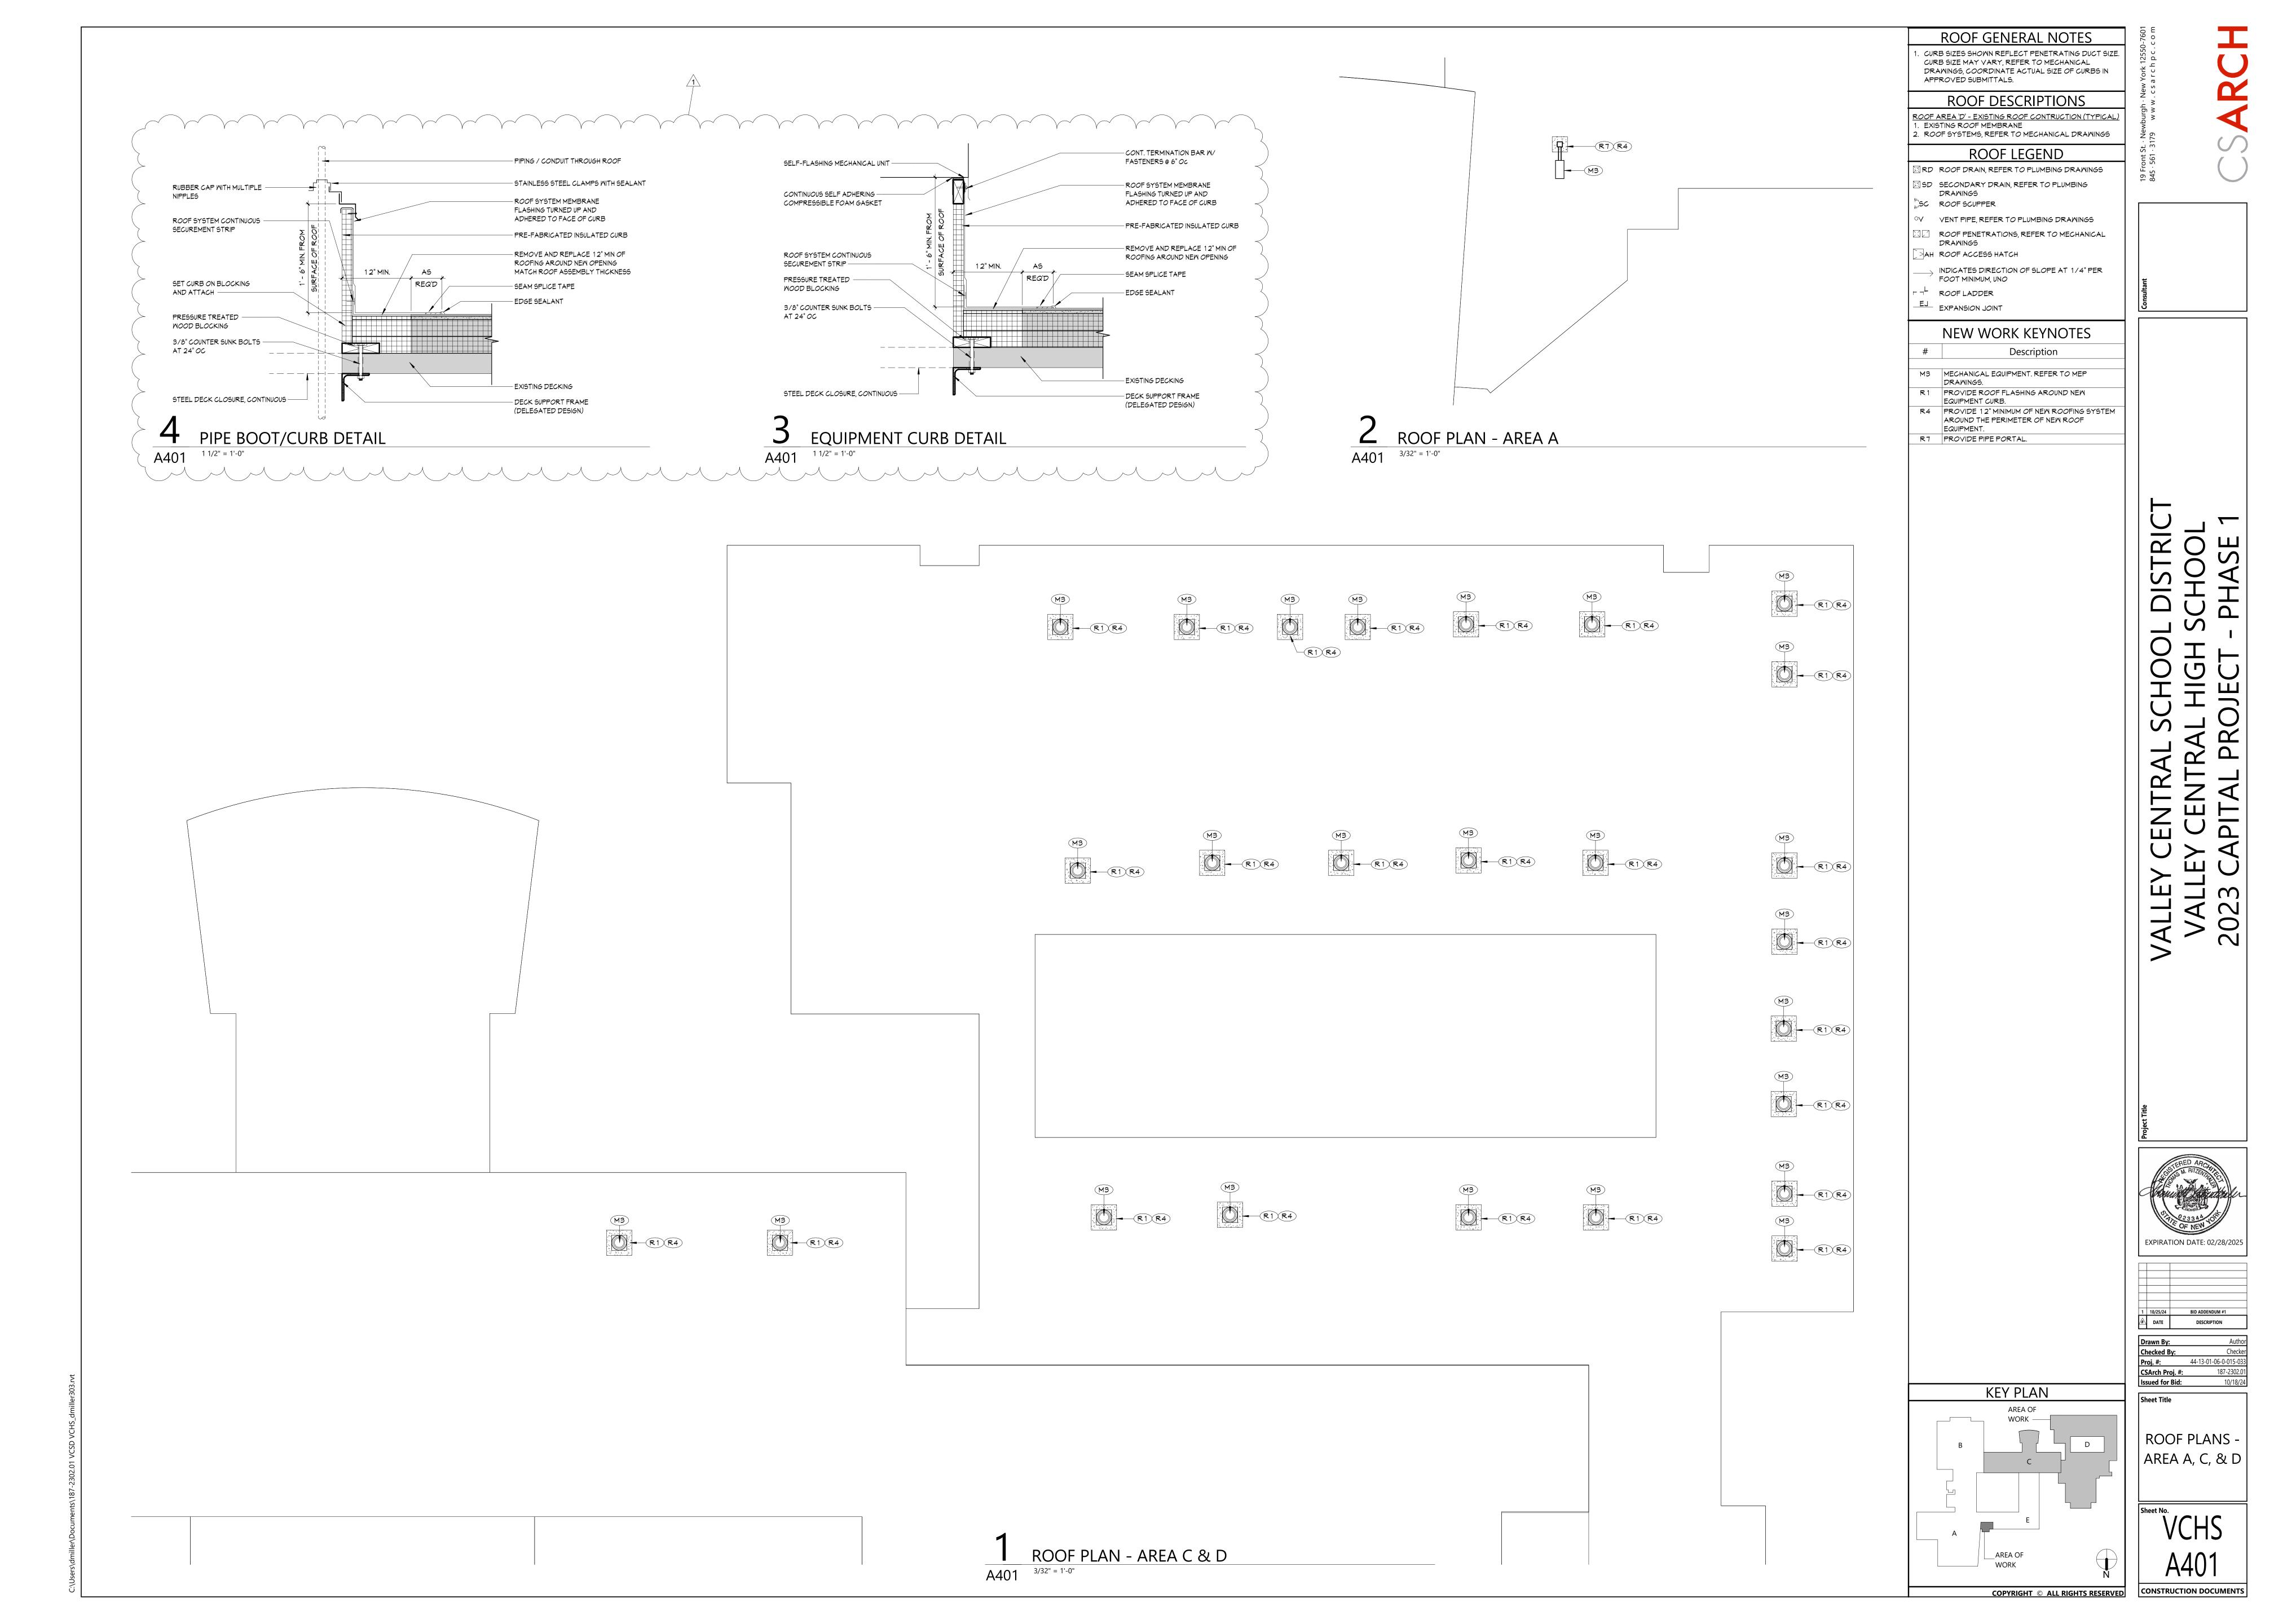



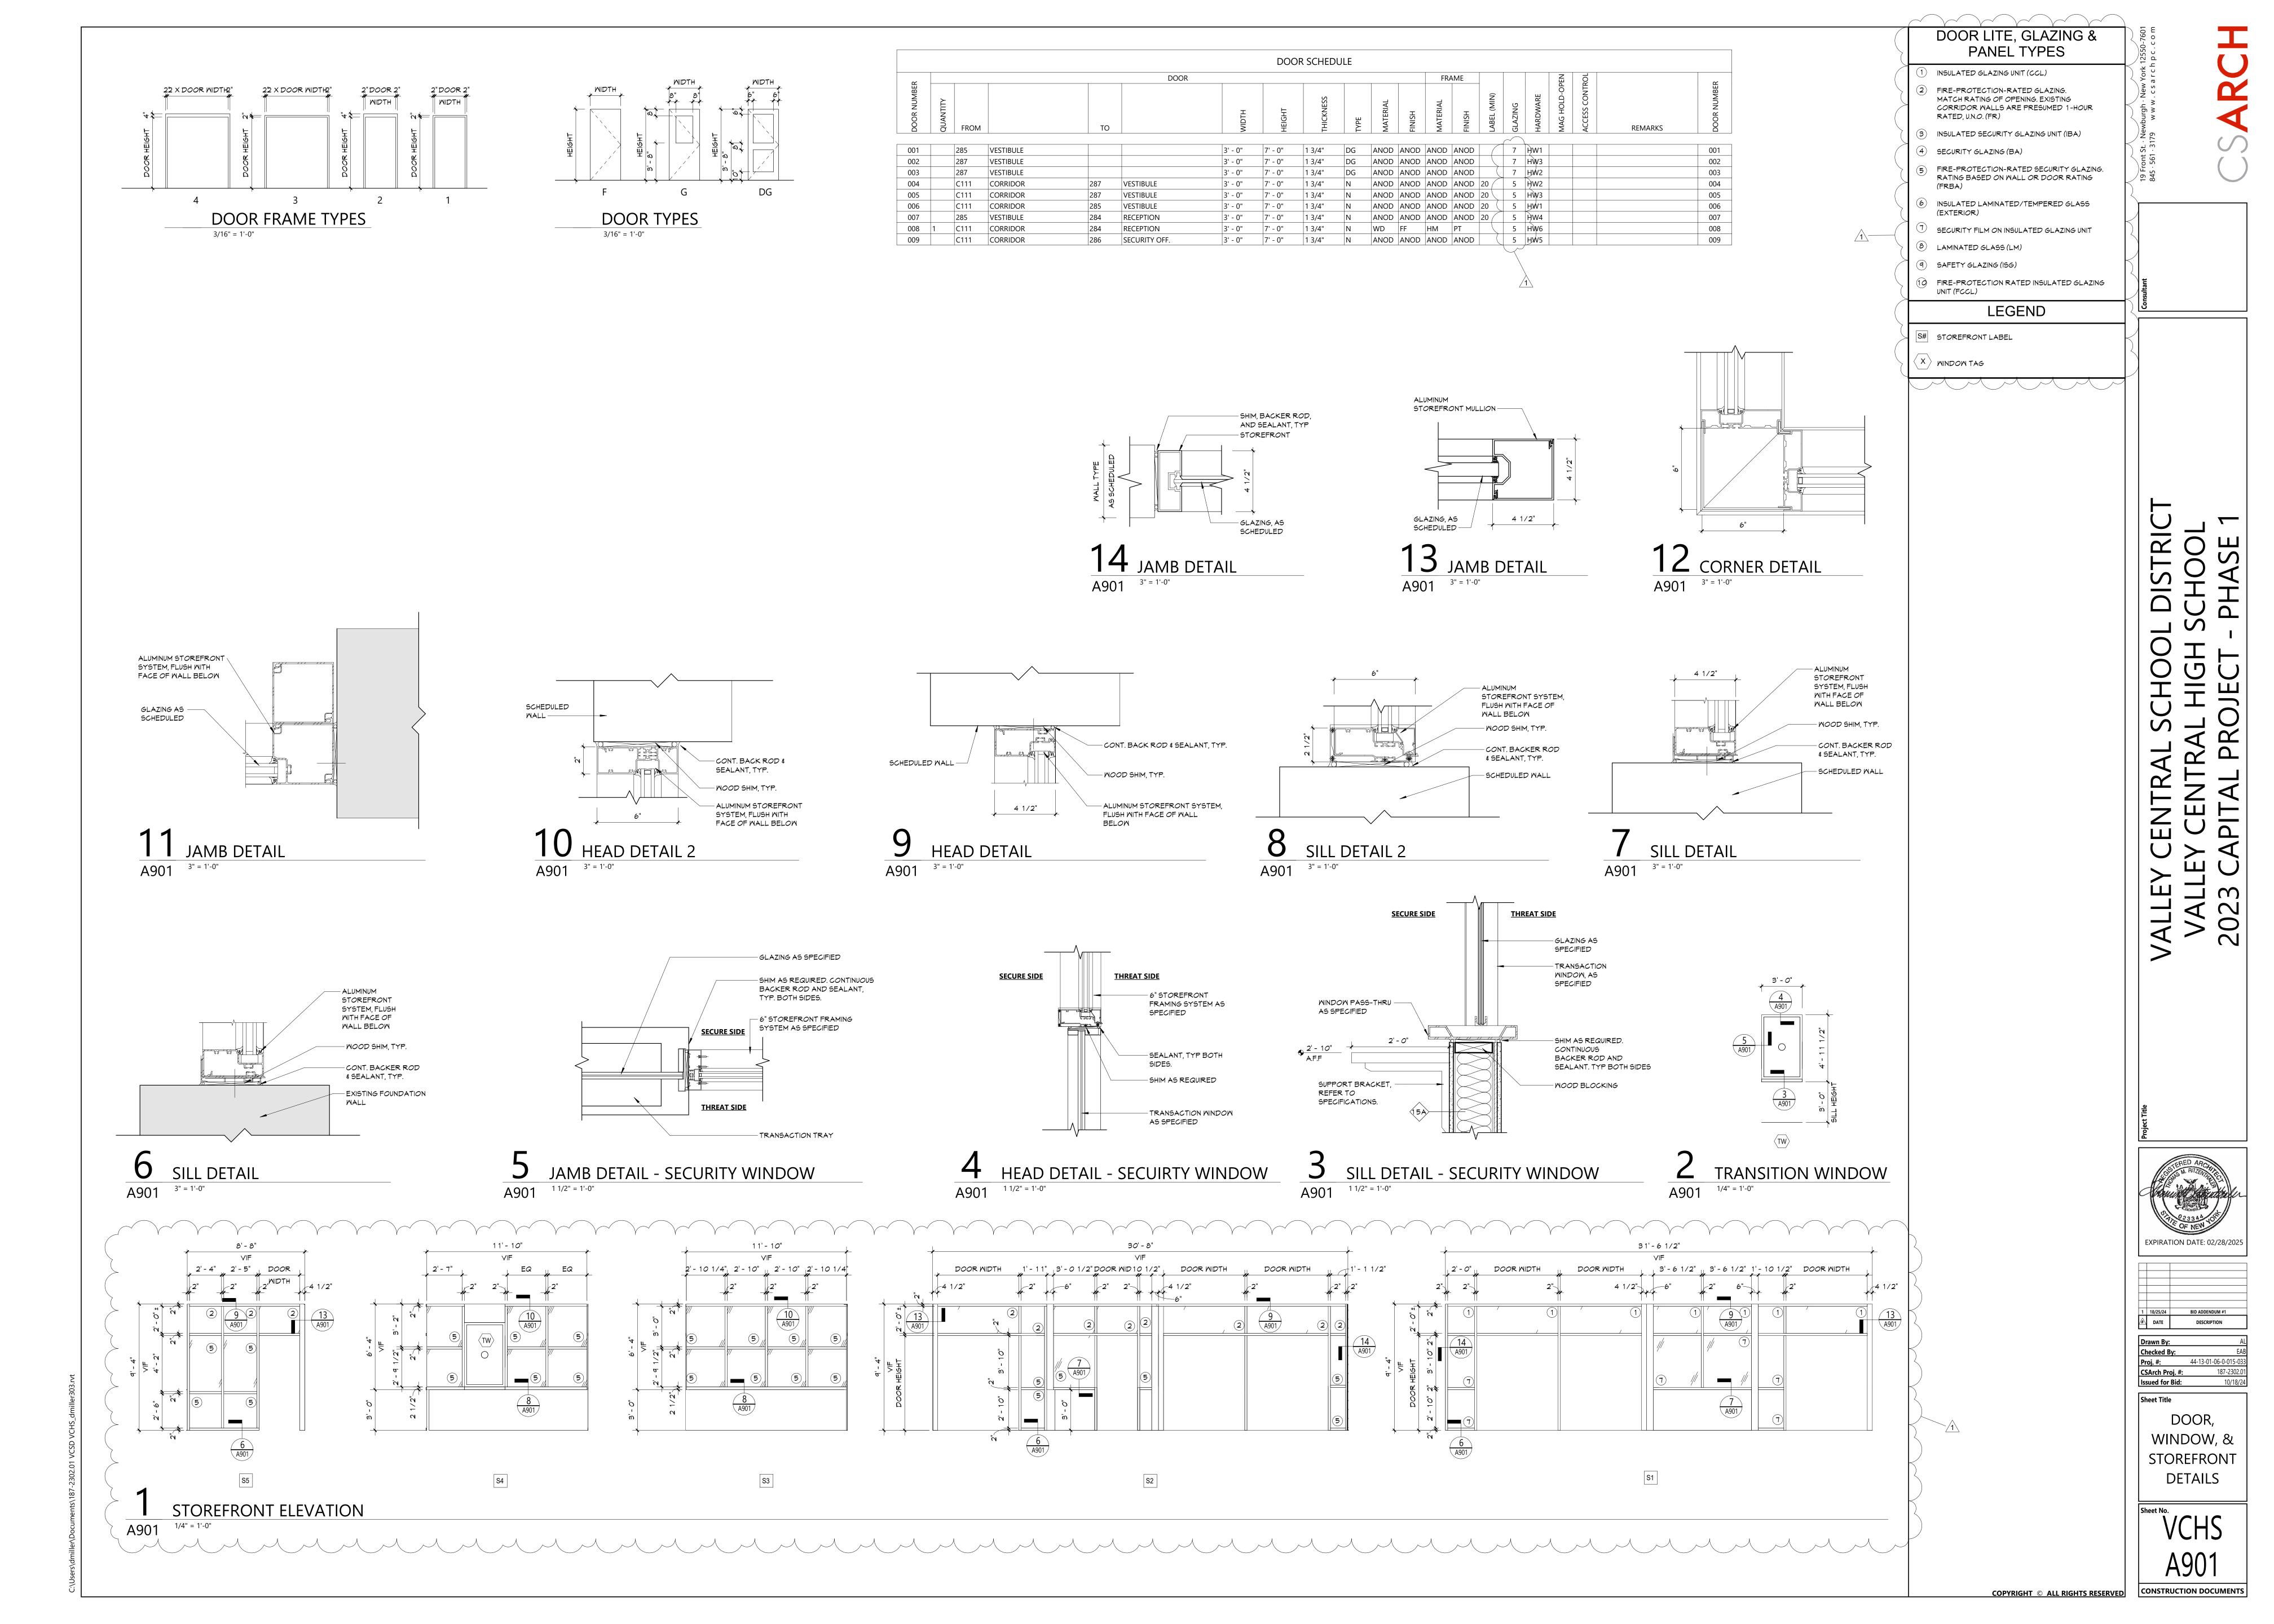


OVERALL FLOOR PLAN -FIRST FLOOR

Sheet No. G111

COPYRIGHT © ALL RIGHTS RESERVED

CONSTRUCTION DOCUMENTS

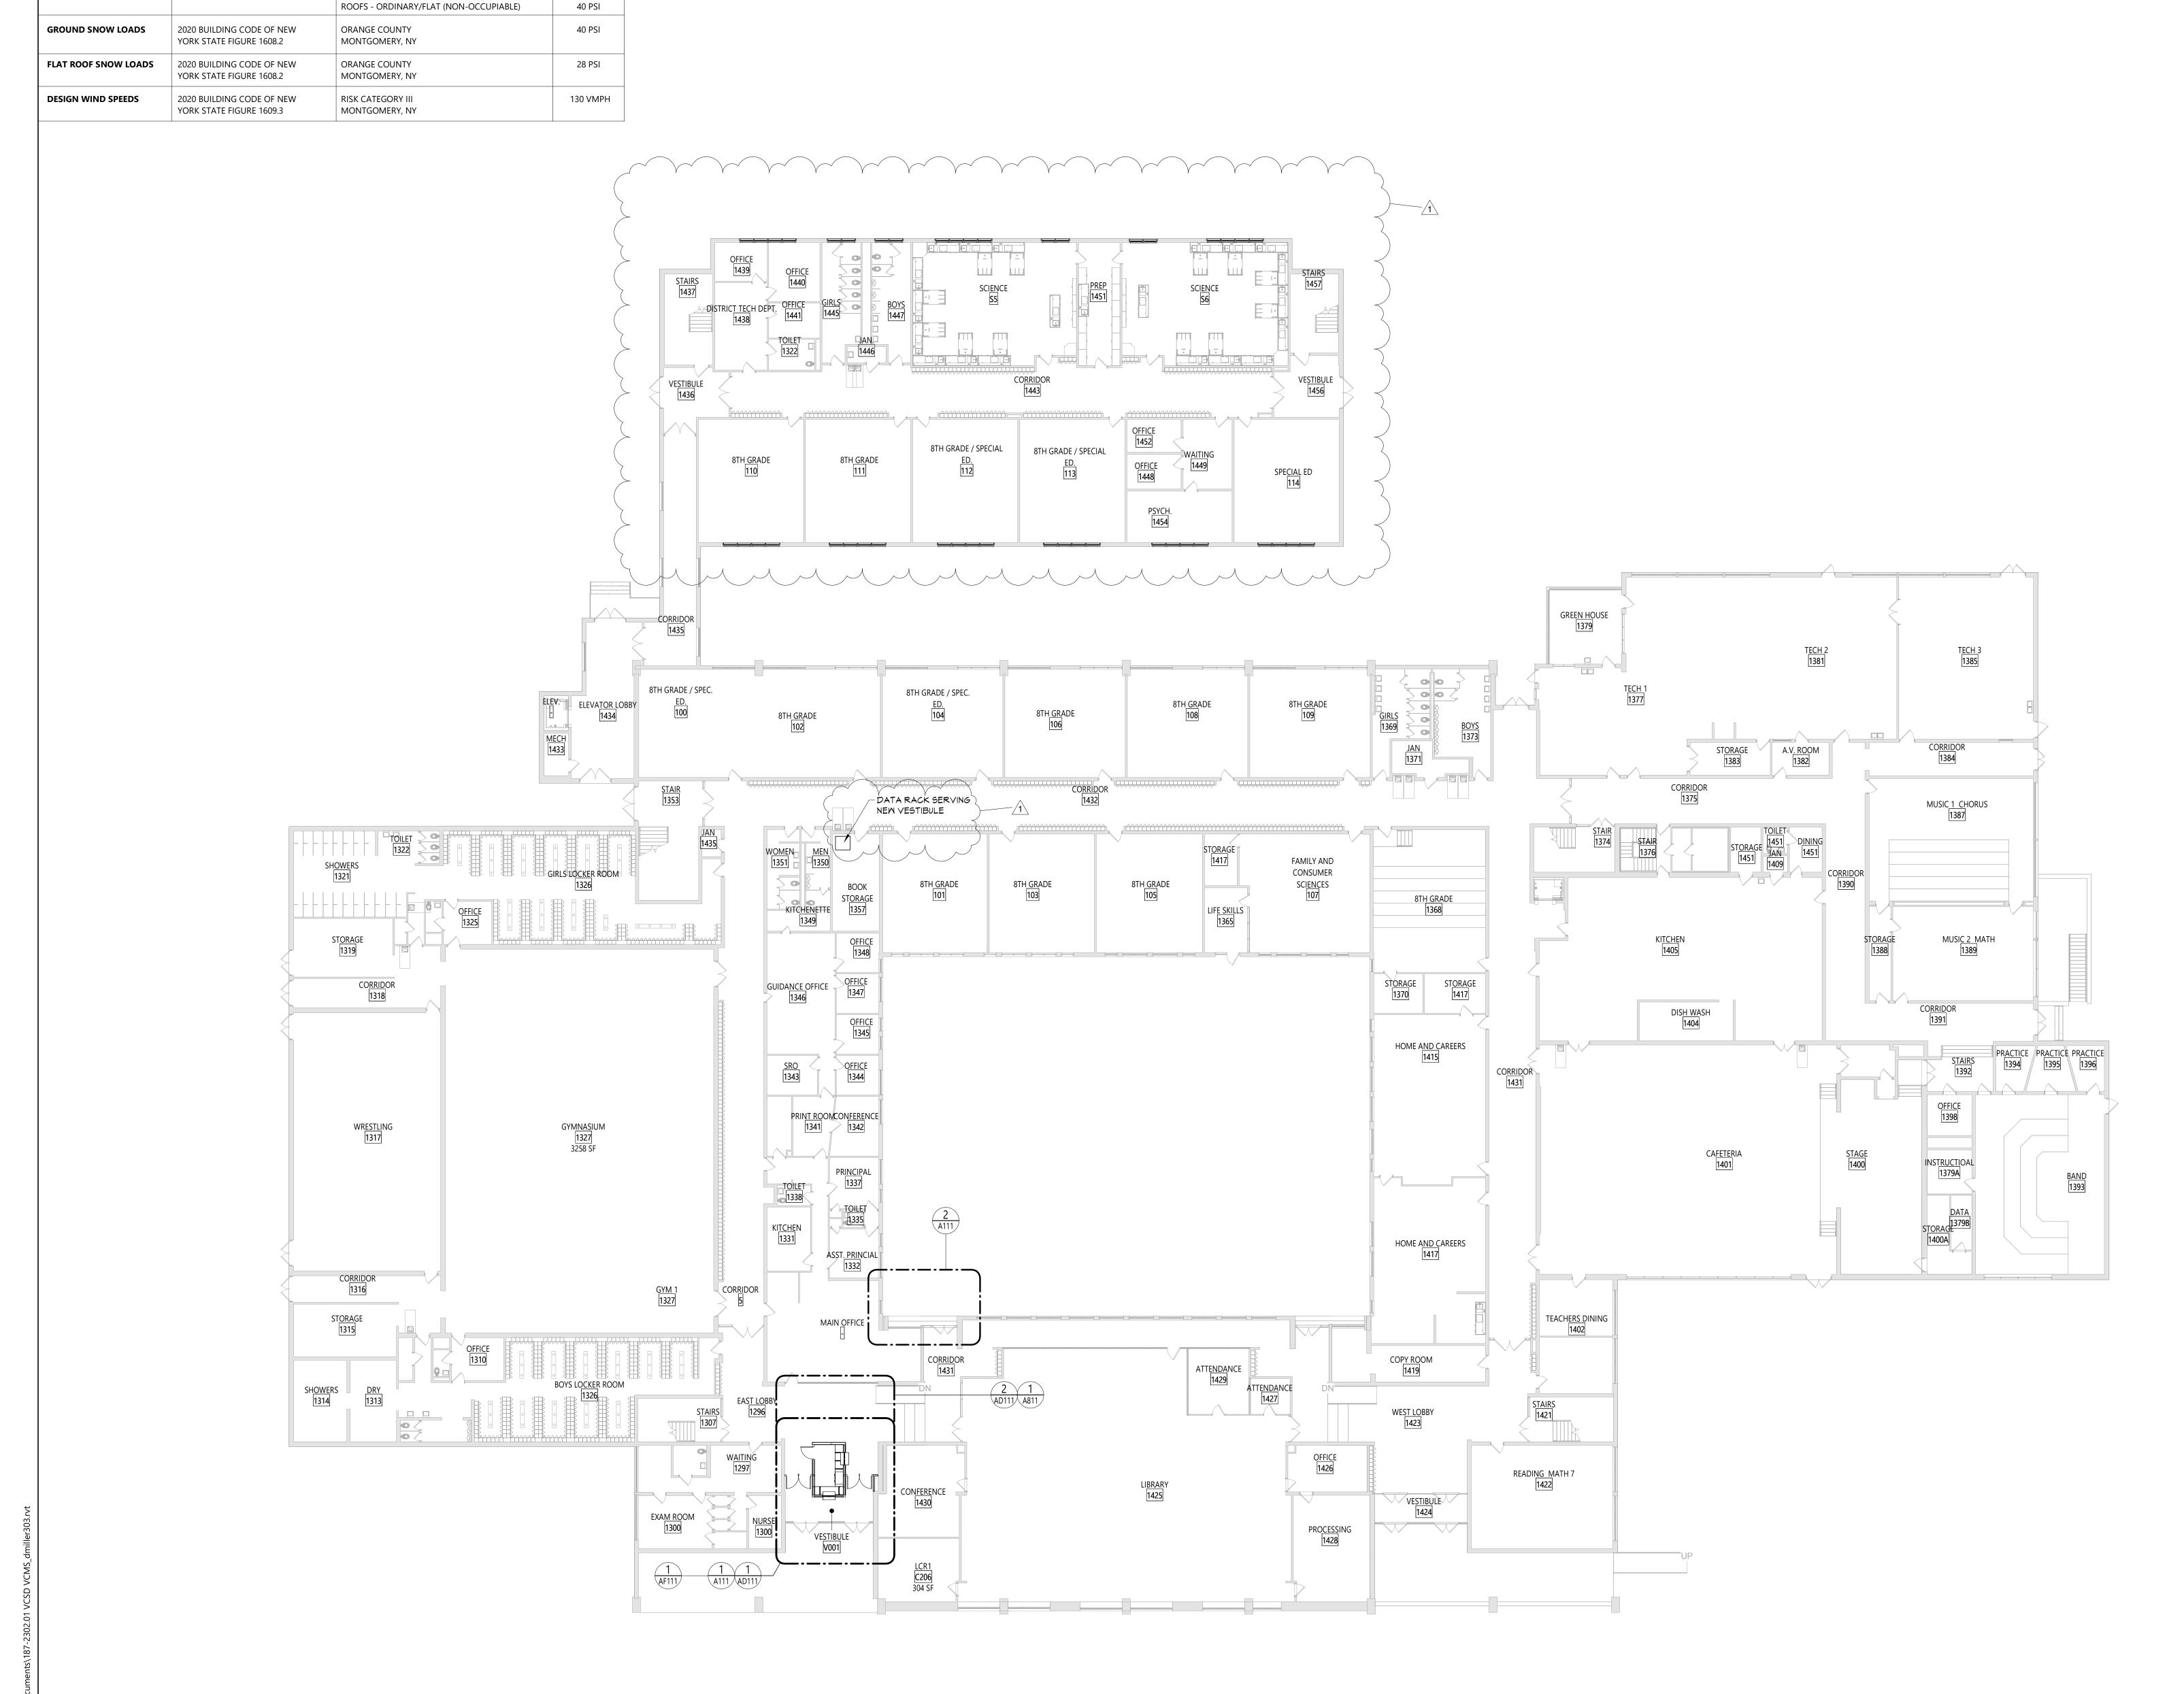

GENERAL DESIGN LOAD REQUIREMENTS

OCCUPANCY/USE/LOCATION

OFFICE BUILDINGS - OFFICES

SCHOOLS - FIRST FLOOR CORRIDORS

SCHOOLS - CORRIDORS ABOVE FIRST FLOOR

SCHOOLS - CLASSROOMS

REQUIRED

40 PSI

100 PSI

80 PSI

50 PSI

BUILDING CODE SECTION


YORK STATE TABLE 1607.1

2020 BUILDING CODE OF NEW


LOADING TYPE


MINIMUM UNIFORM

DISTRIBUTED LIVE LOADS

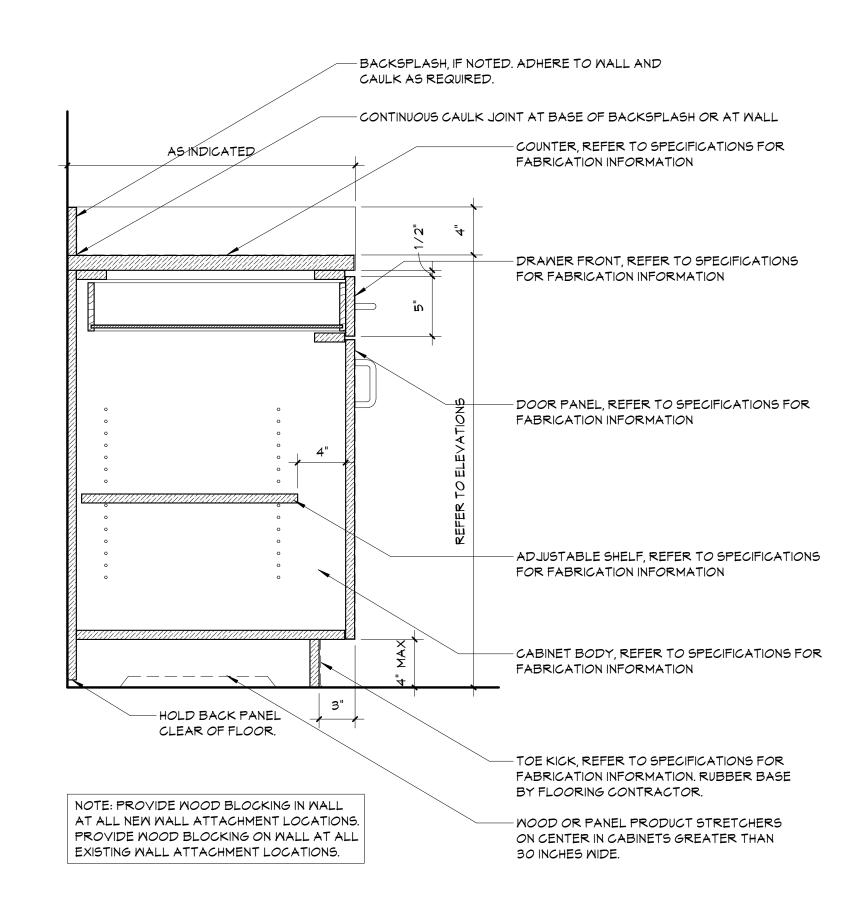


CASEWORK DETAIL

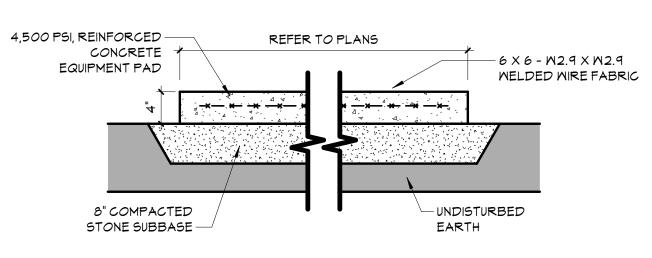


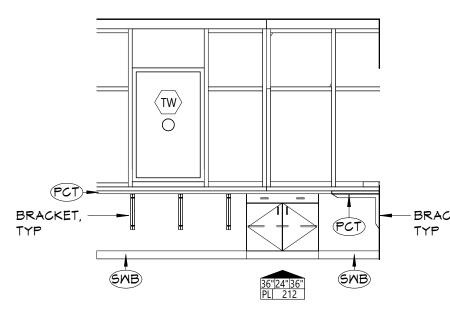


SECURITY OFFICE ELEVATION - EAST

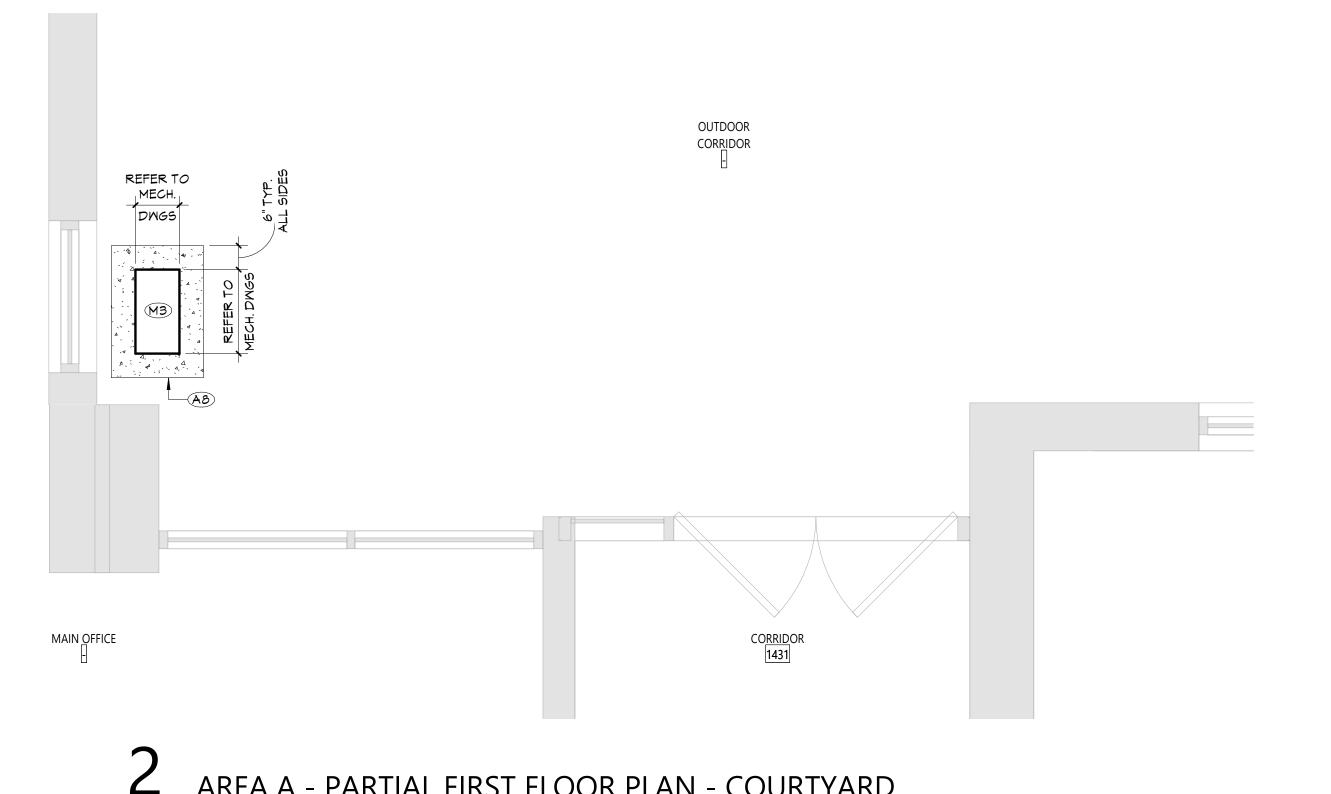

AREA A - PARTIAL FIRST FLOOR PLAN - COURTYARD

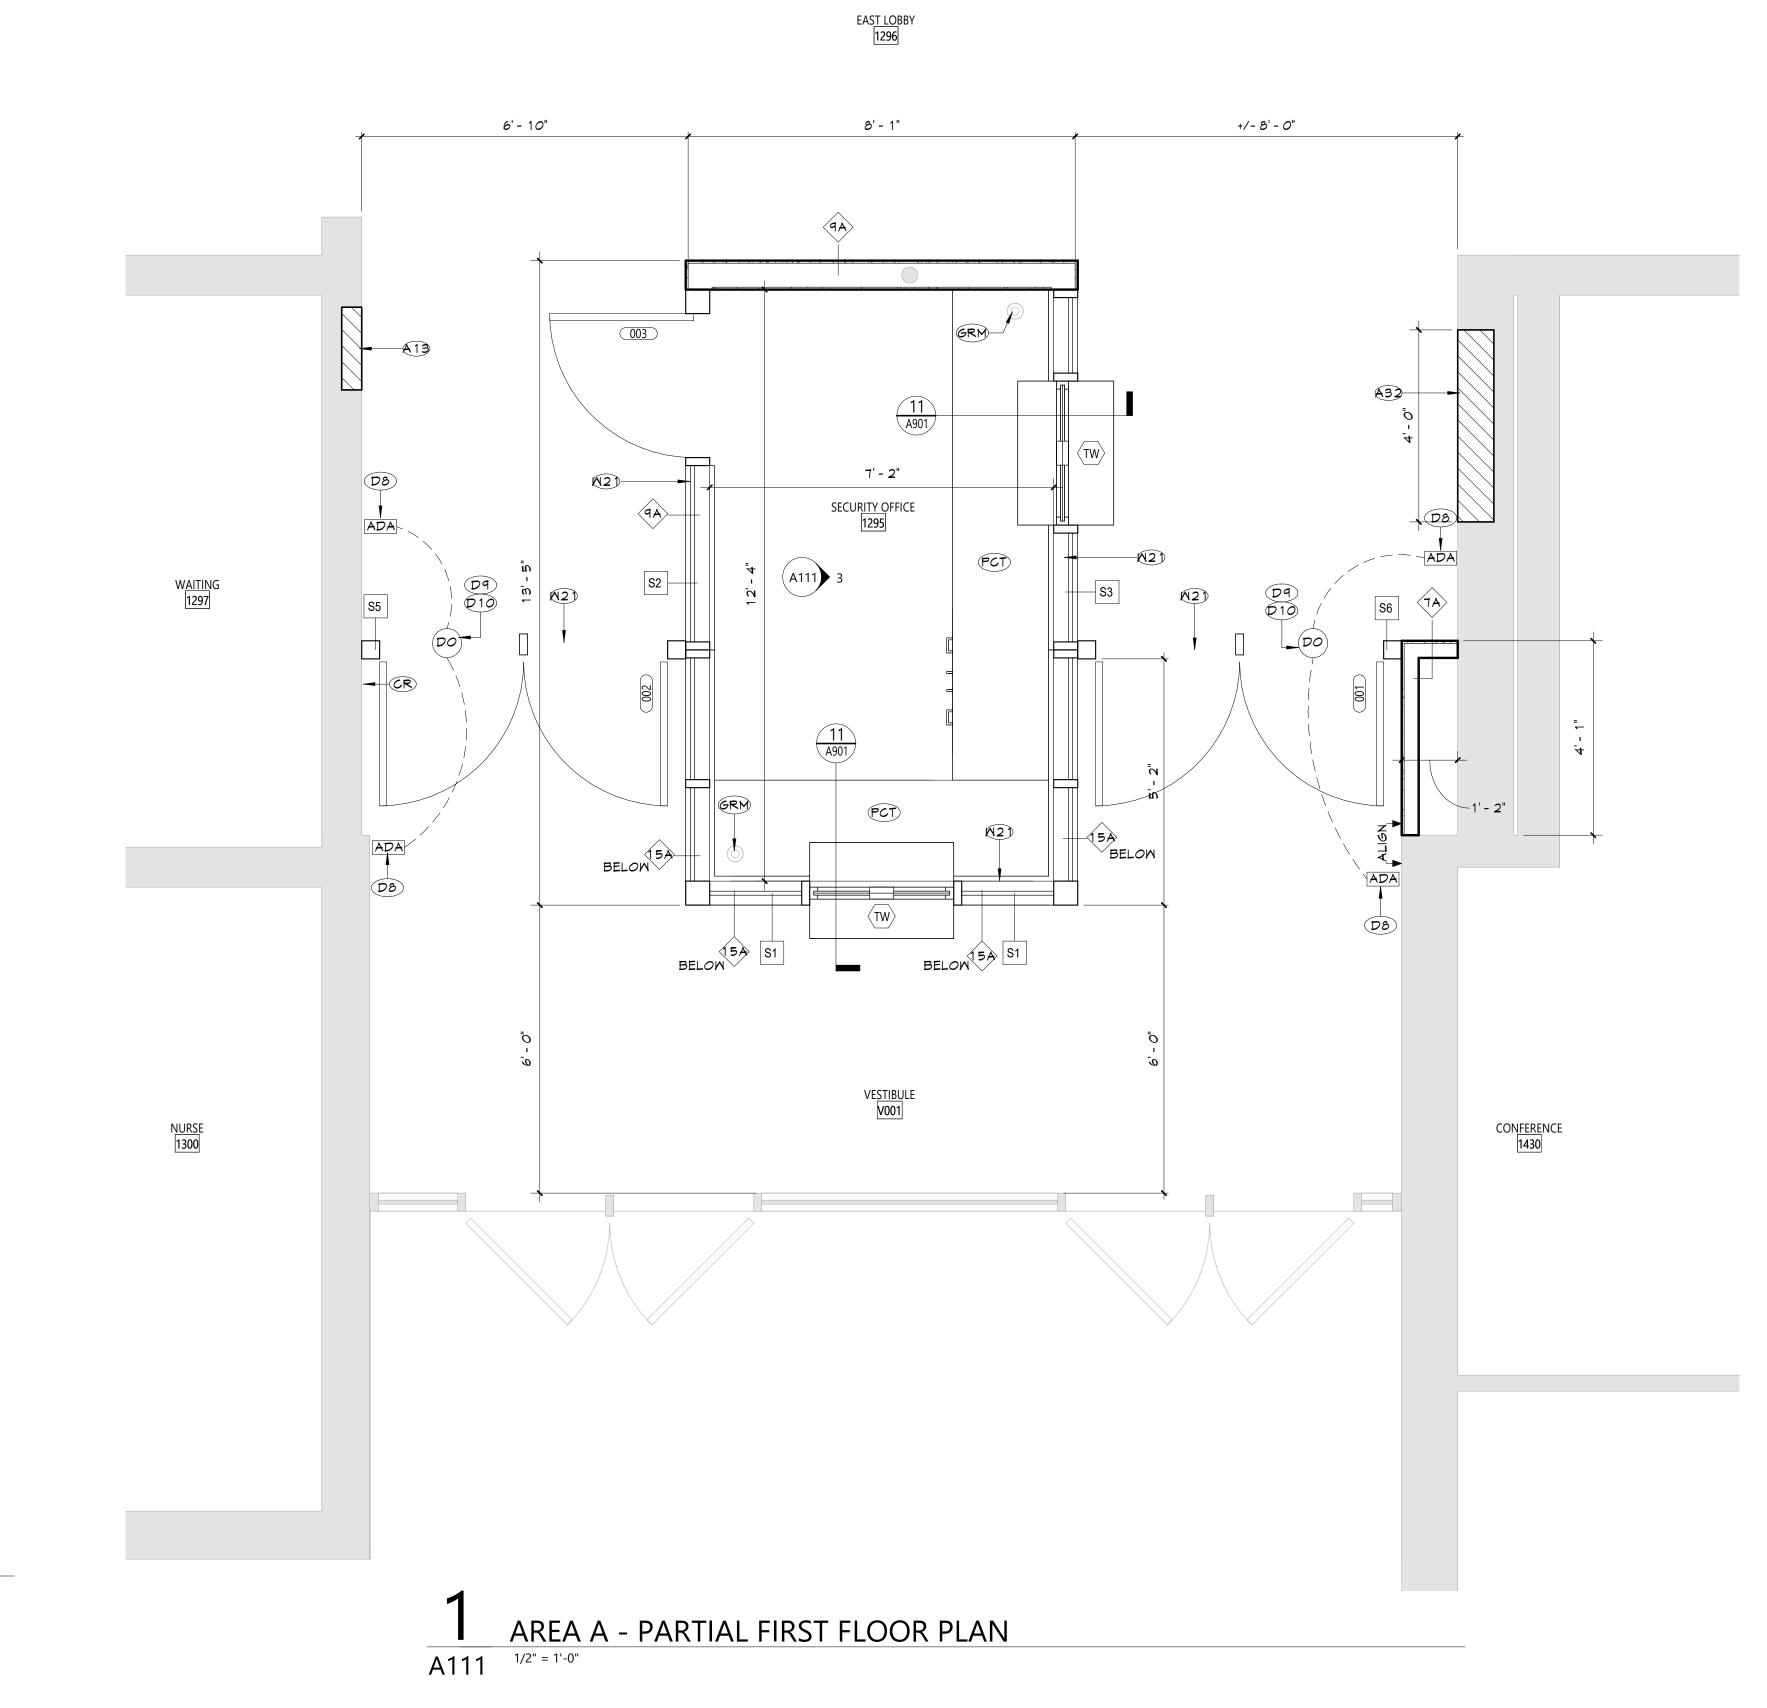

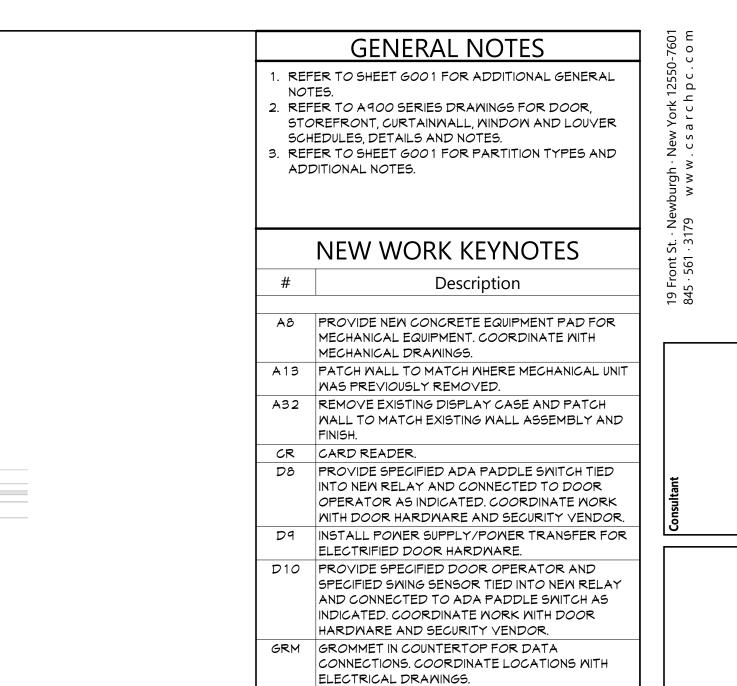

M3 MECHANICAL EQUIPMENT. REFER TO MEP

W21 PROVIDE METAL STUD PARTITION WITH 5/8" TYPE X GYPSUM WALL BOARD (BOTH SIDES) ABOVE

KEY PLAN


NEW STOREFRONT FRAMING SYSTEM. PARTITION

TO BE MOUNTED TO STRUCTURAL DECK ABOVE.

PCT PLAM COUNTER TOP, CONTINUOUS.

DRAWINGS.

SMB SCHEDULED WALL BASE.

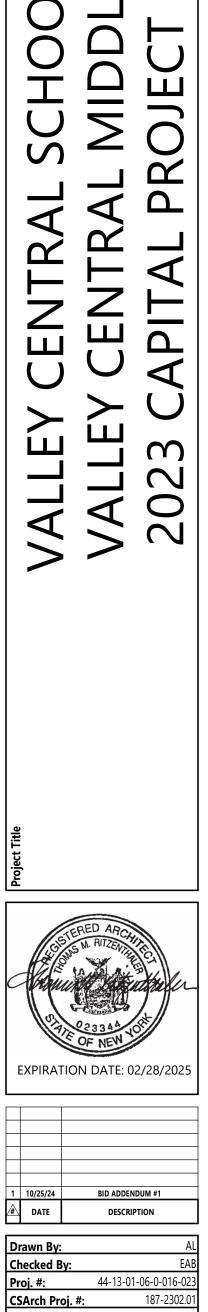

ENLARGED

FLOOR PLANS

AND SECTION

- AREA A

CONSTRUCTION DOCUMENTS

EXTERIOR ELEVATIONS

Sheet No.

VCMS

A201

CONSTRUCTION DOCUMENTS

COPYRIGHT © ALL RIGHTS RESERVED

REMOVE AND REPLACE EXISTING
GA

4 EXT ELEVATION - NORTH 2


REMOVE AND REPLACE EXISTING
OUTLINE AT INSIDE CORNER
JOINT (APPROX 12 LE)

3 EXT ELEVATION - NORTH 1
A201 1/8" = 1'-0"

REMOVE AND REPLACE EXISTING
CAULKING AT INSIDE CORNER
JOINT (APPROX 12 LF)

REMOVE AND REPLACE EXISTING
CAULKING AT INSIDE CORNER
JOINT (APPROX 12 LF)

2 EXT ELEVATION - EAST 2
A201 1" = 10'-0"

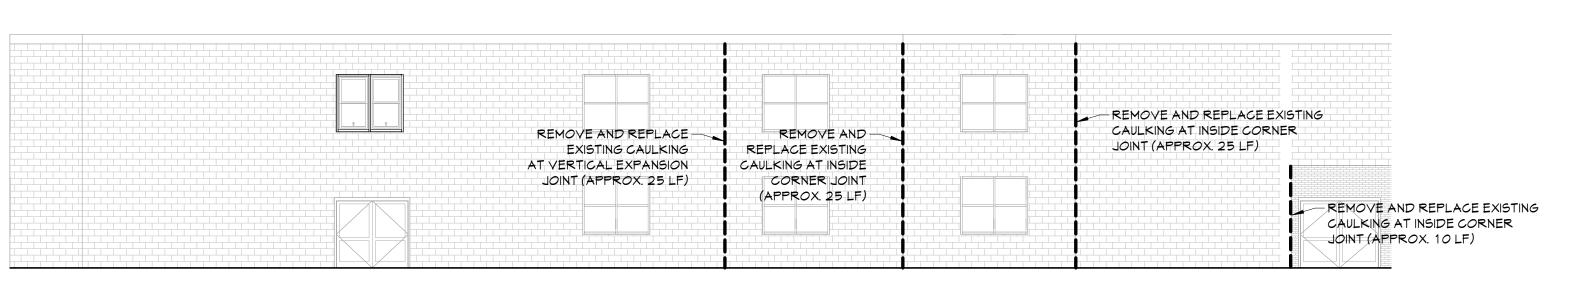

1 EXT ELEVATION - EAST 1

Jocuments\187-2302.01 VCSD VCMS_dmiller303.rvt

	F	XPIRA	ΓΙΟΝ	DATE: 02	/28/202
l					
l					
	1	10/25/24		BID ADDEND	UM #1
	# \	DATE		DESCRIPT	ION
l	Di	awn By:			Aut
l	Cł	ecked B	By:		Chec
	Pr	oj. #:		44-13-01-	06-0-016-0
	CS	Arch Pr	oj. #:		187-2302
	lss	ued for	Bid:		10/18
\setminus	7	~	$\overline{}$		

Sheet Title

EXTERIOR ELEVATIONS

Sheet No.


VCMS

CONSTRUCTION DOCUMENTS


COPYRIGHT © ALL RIGHTS RESERVED

REMOVE AND REPLACE EXISTING — CAULKING AT INSIDE CORNER JOINT (APPROX. 25 LF) - CLEAN AND REPOINT MASONRY ABOVE WINDOWS (APPROX. 120 SF) REMOVE AND REPLACE EXISTING CAULKING AT INSIDE CORNER JOINT (APPROX. 25 LF) REMOVE AND REPLACE EXISTING
CAULKING AT INSIDE CORNER
JOINT (APPROX. 25 LF) REMOVE AND REPLACE EXISTING — CAULKING AT INSIDE CORNER JOINT (APPROX. 12 LF)


EXT ELEVATION - WEST 2A202 1" = 10'-0"

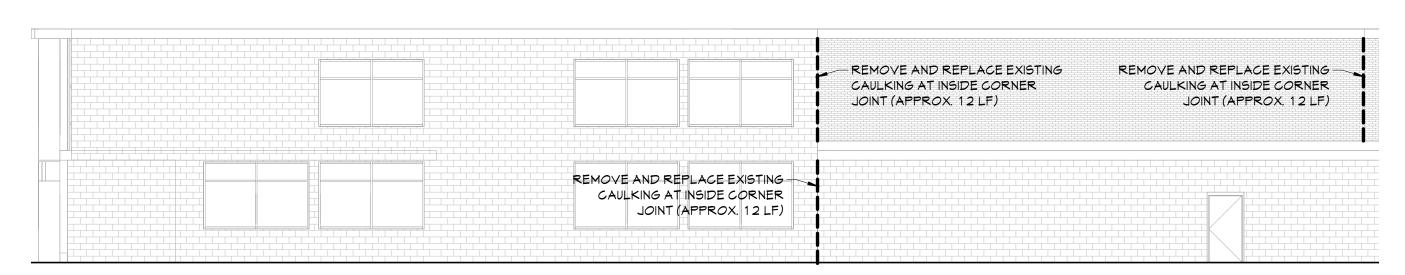

EXT ELEVATION - WEST 1 A202 1" = 10'-0"

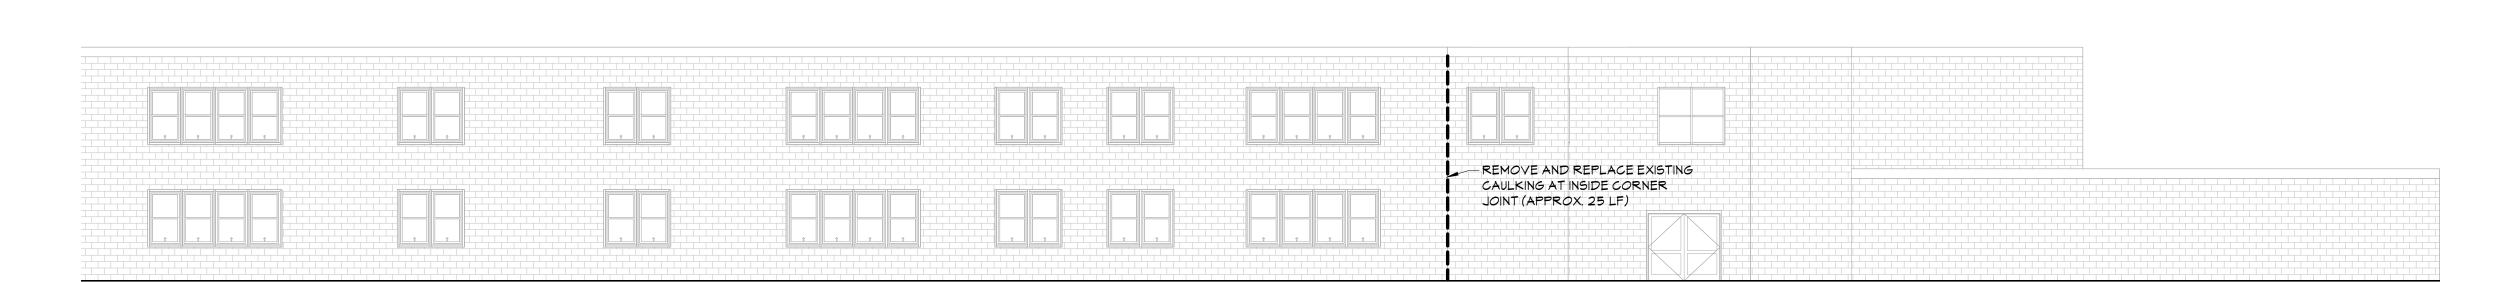


EXT ELEVATION - SOUTH 2
A202 1" = 10'-0"

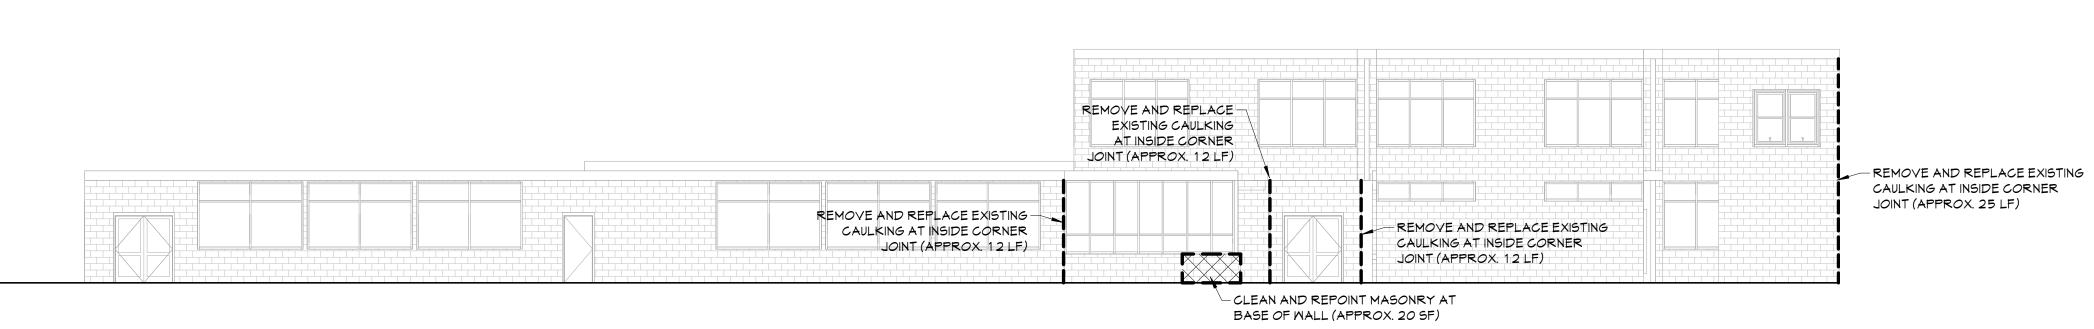

EXT ELEVATION - SOUTH 1 A202 1" = 10'-0"



CONSTRUCTION DOCUMENTS

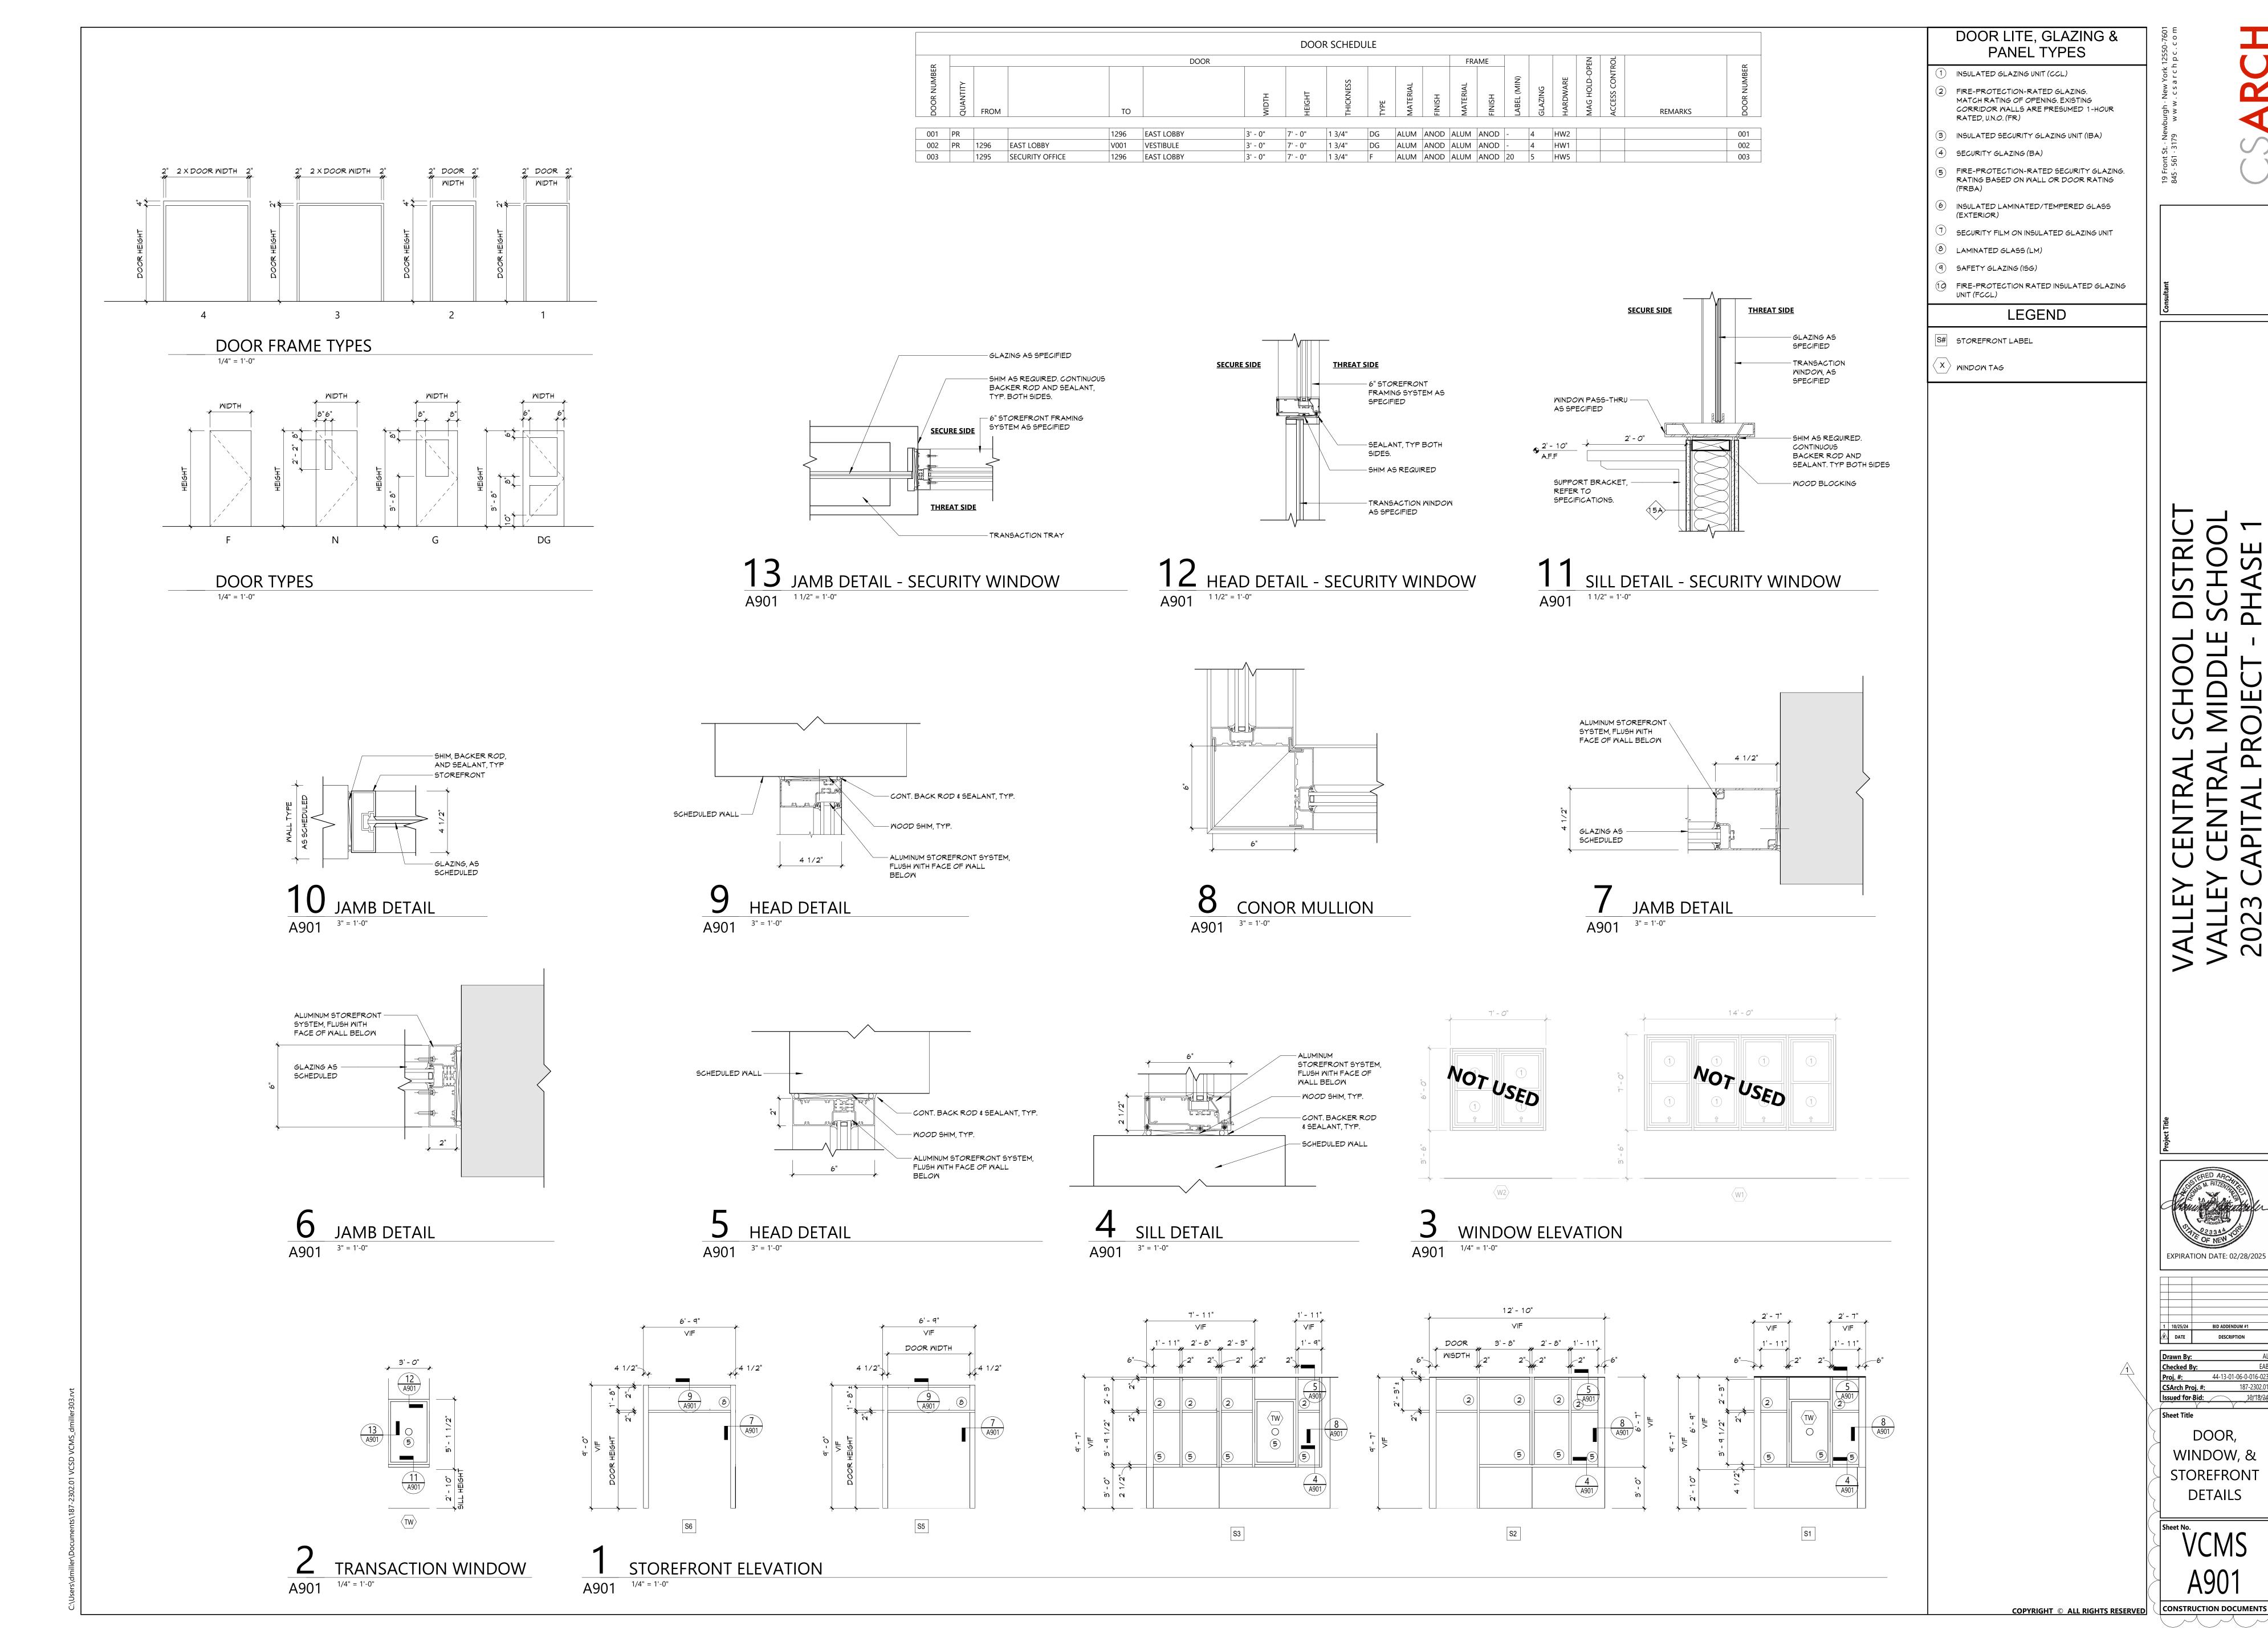


EXPIRATION DATE: 02/28/2025

DOOR,

WINDOW, & STOREFRONT **DETAILS**

A901

GENERAL DESIGN LOAD REQUIREMENTS				
LOADING TYPE	BUILDING CODE SECTION	OCCUPANCY/USE/LOCATION	REQUIRED	
MINIMUM UNIFORM DISTRIBUTED LIVE LOADS	2020 BUILDING CODE OF NEW YORK STATE TABLE 1607.1	SCHOOLS - CLASSROOMS SCHOOLS - FIRST FLOOR CORRIDORS SCHOOLS - CORRIDORS ABOVE FIRST FLOOR	40 PSI 100 PSI 80 PSI	
		OFFICE BUILDINGS - OFFICES	50 PSI	
		ROOFS - ORDINARY/FLAT (NON-OCCUPIABLE)	40 PSI	
GROUND SNOW LOADS	2020 BUILDING CODE OF NEW YORK STATE FIGURE 1608.2	ORANGE COUNTY MONTGOMERY, NY	40 PSI	
FLAT ROOF SNOW LOADS	2020 BUILDING CODE OF NEW YORK STATE FIGURE 1608.2	ORANGE COUNTY MONTGOMERY, NY	28 PSI	
DESIGN WIND SPEEDS	2020 BUILDING CODE OF NEW YORK STATE FIGURE 1609.3	RISK CATEGORY III MONTGOMERY, NY	130 VMPH	

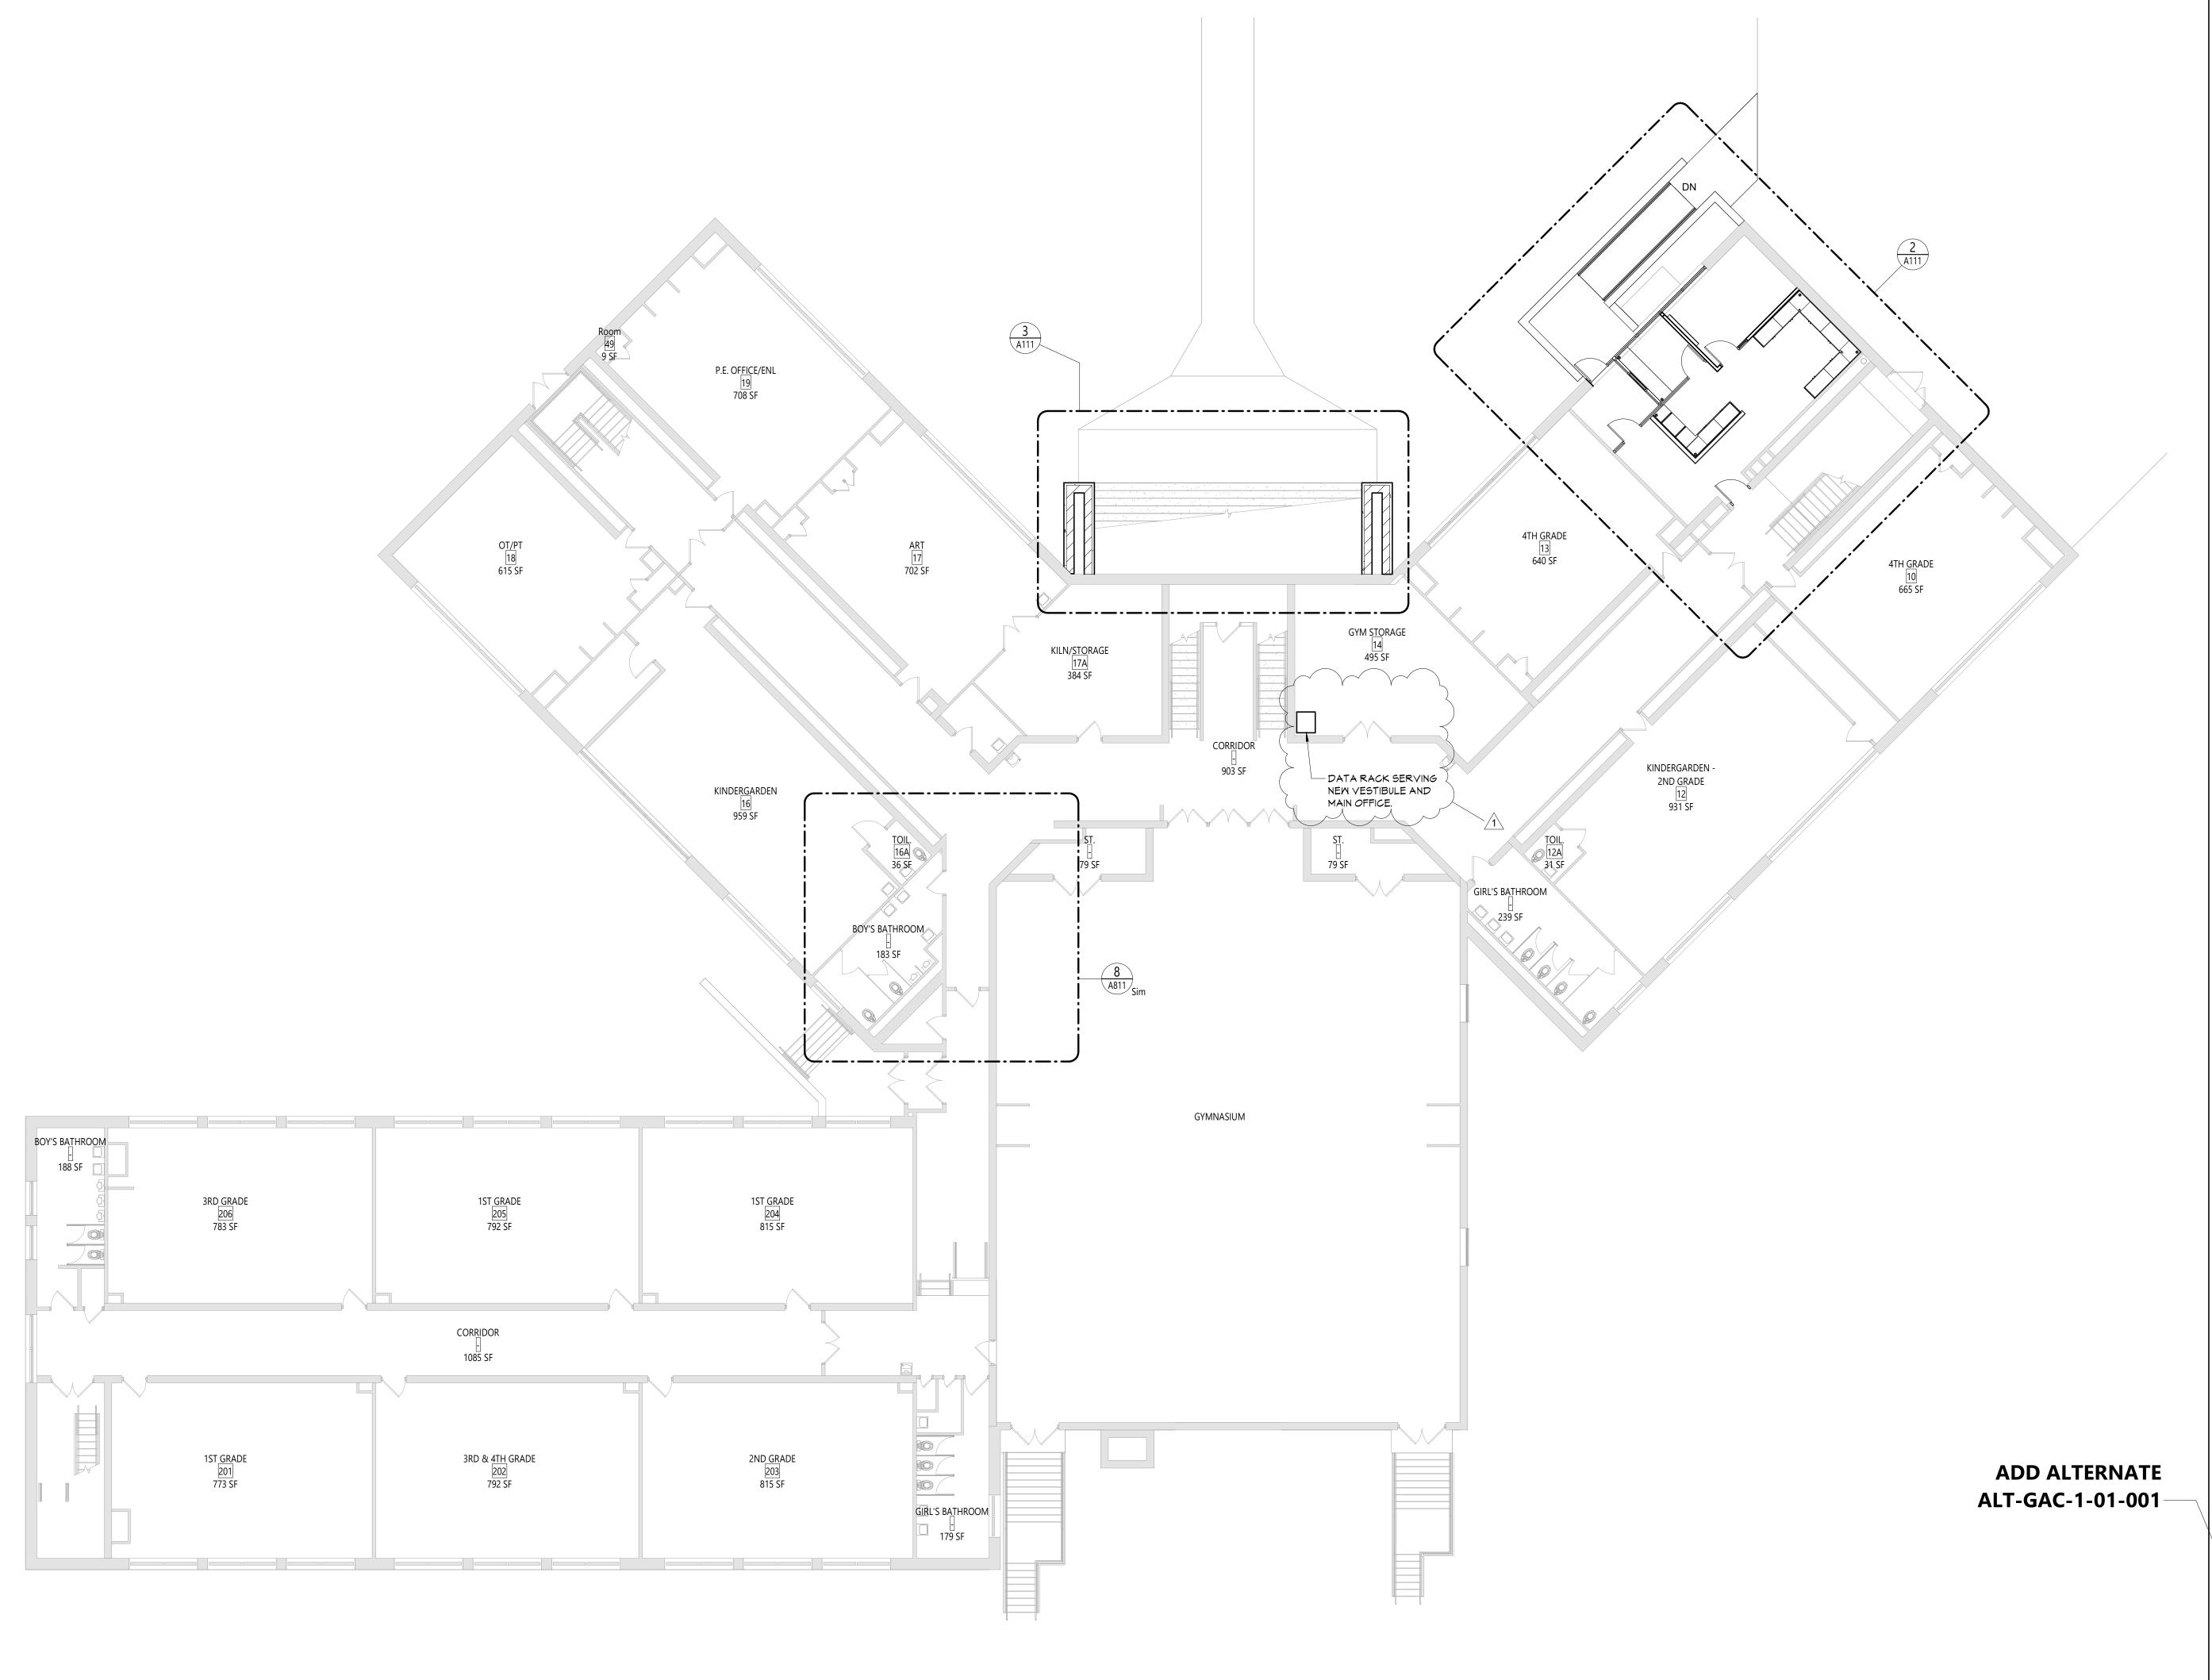

EY CENTRAL SCHOOL DISTRICT LDEN ELEMENTARY SCHOOL CAPITAL PROJECT - PHASE 1

STERED ARCHITECTURE OF NEW YORK OF NEW YOR

EXPIRATION DATE: 02/28/2025

1 10/25/24 BID ADDENDUM #1

DATE DESCRIPTION

Drawn By: Author Checked By: Checked Proi #: 44-13-01-06-0-009-02

Drawn By:

Checked By:

Proj. #:

CSArch Proj. #:

Issued for Bid:

CNATE

BID ADDENDOM #1

DESCRIPTION

A4-13-01-06-0-0

187-2

Sheet Title

OVERALL
FLOOR PLAN FIRST FLOOR


WES G111

COPYRIGHT © ALL RIGHTS RESERVED

OVERALL FIRST FLOOR PLAN


G111 1" = 10'-0"

GENERAL DESIGN LOAD REQUIREMENTS				
LOADING TYPE	BUILDING CODE SECTION	OCCUPANCY/USE/LOCATION	REQUIRE	
MINIMUM UNIFORM DISTRIBUTED LIVE LOADS	2020 BUILDING CODE OF NEW YORK STATE TABLE 1607.1	SCHOOLS - CLASSROOMS SCHOOLS - FIRST FLOOR CORRIDORS	40 PSI 100 PSI	
		OFFICE BUILDINGS - OFFICES	80 PSI 50 PSI	
		ROOFS - ORDINARY/FLAT (NON-OCCUPIABLE)	40 PSI	
GROUND SNOW LOADS	2020 BUILDING CODE OF NEW YORK STATE FIGURE 1608.2	ORANGE COUNTY MONTGOMERY, NY	40 PSI	
FLAT ROOF SNOW LOADS	2020 BUILDING CODE OF NEW YORK STATE FIGURE 1608.2	ORANGE COUNTY MONTGOMERY, NY	28 PSI	
DESIGN WIND SPEEDS	2020 BUILDING CODE OF NEW YORK STATE FIGURE 1609.3	RISK CATEGORY III MONTGOMERY, NY	130 VMPH	

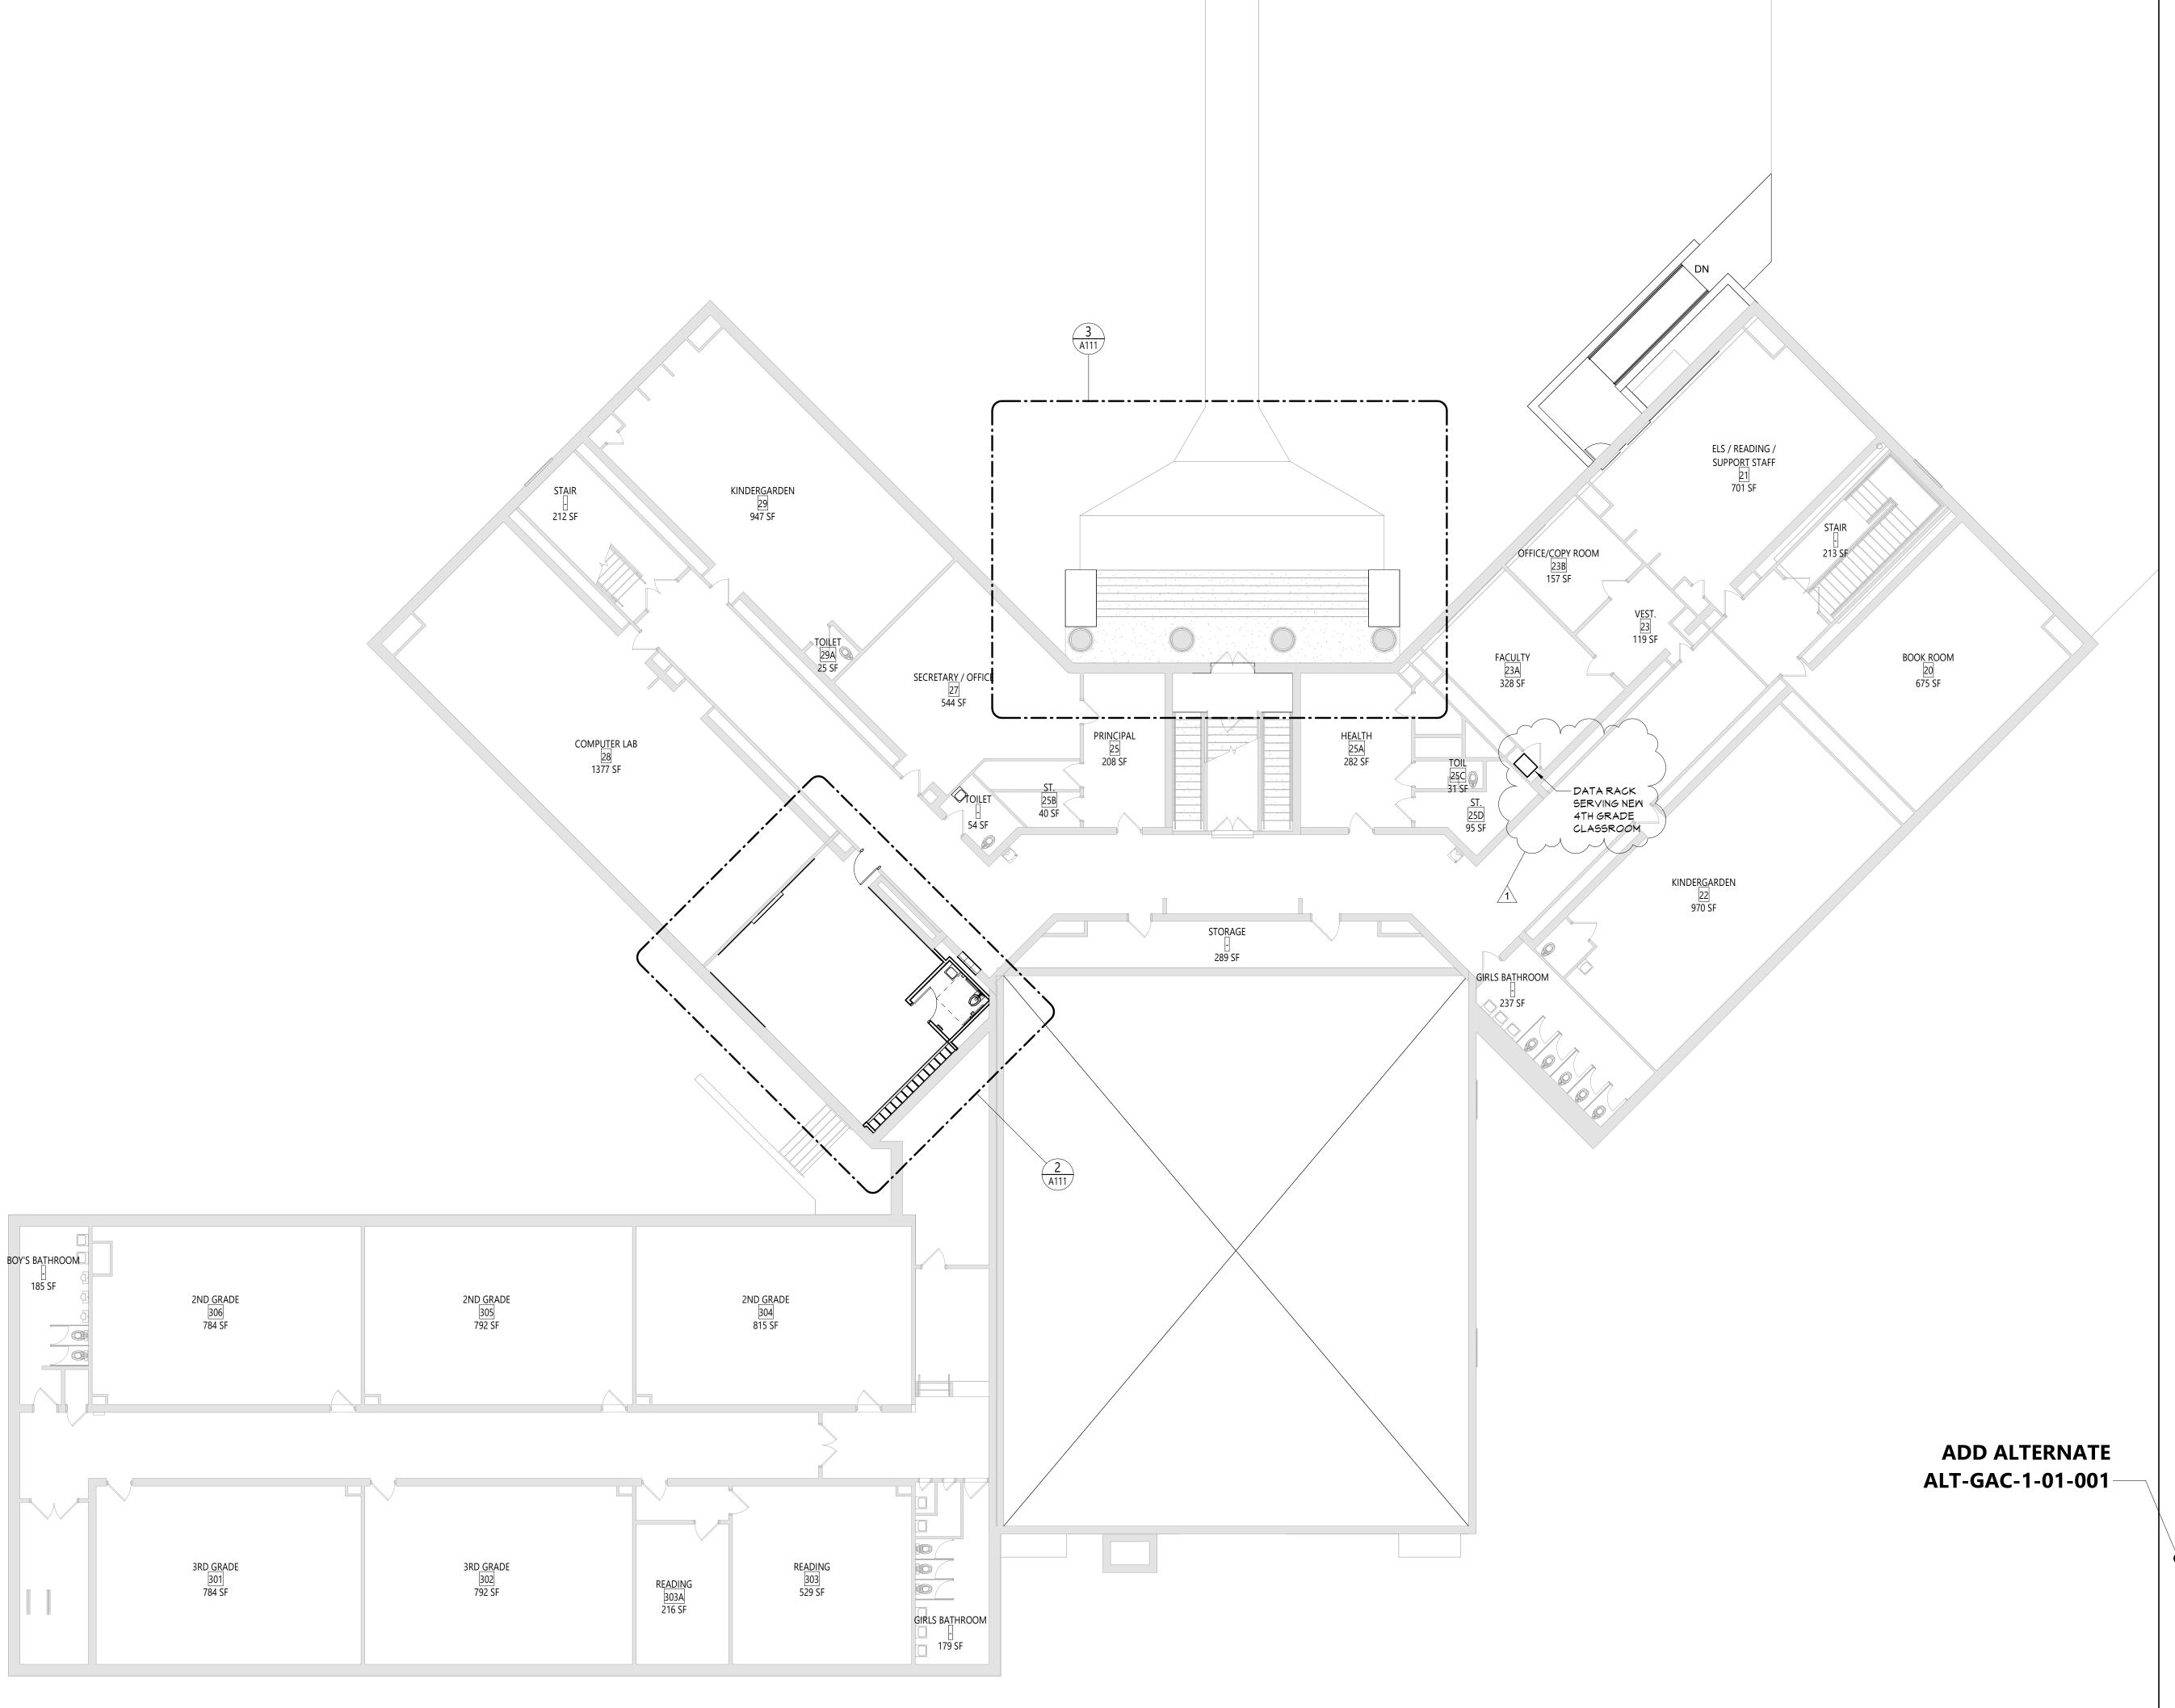

HOOL HASE 1

VALLEY CENTRAL SCHC WALDEN ELEMENTAR 2023 CAPITAL PROJEC

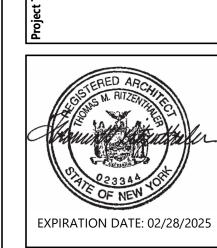


1 10/25/24 BID ADDENDUM #1

DATE DESCRIPTION

Drawn By: Auth
Checked By: Check
Proj. #: 44-13-01-06-0-009-0

CSArch Proj. #: 187-2302.

Issued for Bid: 10/18/

Sheet Title

OVERALL

FLOOR PLAN
SECOND

FLOOR

WES

OVERALL SECOND FLOOR PLAN

G121 1" = 10'-0"

