GENERAL NOTES:

1. REMOVAL DRAWINGS INDICATE DEVICE LOCATIONS, EQUIPMENT CONNECTIONS, AND PANEL LOCATIONS AS OBSERVED IN THE FIELD. EXISTING PANEL INFORMATION IS BASED ON FIELD OBSERVATION AND AS BUILT DRAWINGS. VERIFY CIRCUITING IN FIELD PRIOR TO REMOVAL. CONFIRM ALL LOCATIONS WITH FIELD OBSERVATIONS, MEASUREMENTS, AND INVESTIGATION. REMOVE ELECTRICAL ITEMS SHOWN ON PLANS UNLESS NOTED OTHERWISE.
2. PROVIDE LIFTS, LADDERS, AND OTHER EQUIPMENT REQUIRED TO GAIN ACCESS FOR ALL ELEVATED WORK. OWNER'S LIFTS AND LADDERS SHALL NOT BE USED.
3. COORDINATE REMOVALS WITH THE ARCHITECTURAL PLANS.
4. COORDINATE ELECTRICAL REMOVALS WITH OTHER TRADES.
5. SEE BM-E001 FOR GENERAL PROJECT NOTES.

KEYED NOTES:

1. REMOVE EXISTING CANOPY LIGHTING. PRESERVE CIRCUITS FROM PANEL LV2 AND CONTROLS FROM THE BUILDING.
2. RECONNECT TO EXISTING LIGHTING CIRCUITS FROM PANEL LV2 AND CONTROLS. COORDINATE WITH ARCHITECTURAL AND STRUCTURAL PLANS.
3. SAFELY REMOVE AND TEMPORARILY STORE CAMERAS, BLUE LIGHT, CABLES, AND ACCESSORIES FOR REUSE DURING CANOPY REPLACEMENT. OBTAIN THE SERVICES OF THE OWNER'S SECURITY VENDOR FOR PROGRAMMING, ADDITIONS, AND/OR RELOCATIONS OF EXISTING SECURITY DEVICES.
4. SAFELY REMOVE AND TEMPORARILY STORE CAMERAS, BLUE LIGHT, CABLES, AND ACCESSORIES FOR REUSE DURING CANOPY REPLACEMENT. OBTAIN THE SERVICES OF THE OWNER'S SECURITY VENDOR FOR PROGRAMMING, ADDITIONS, AND/OR RELOCATIONS OF EXISTING SECURITY DEVICES.

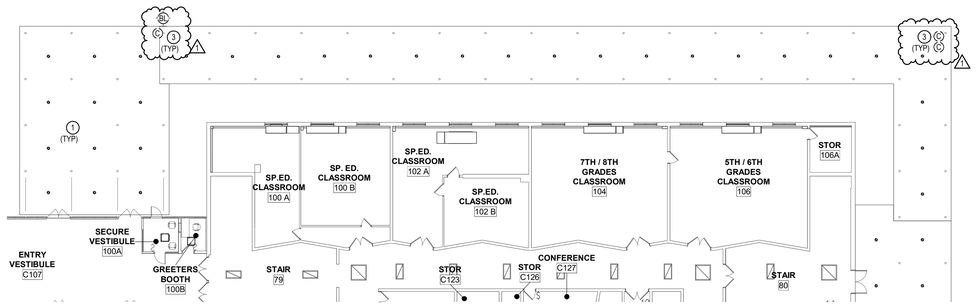

K13 PARTIAL FIRST FLOOR ELECTRICAL REMOVALS

1/16" = 1'-0"

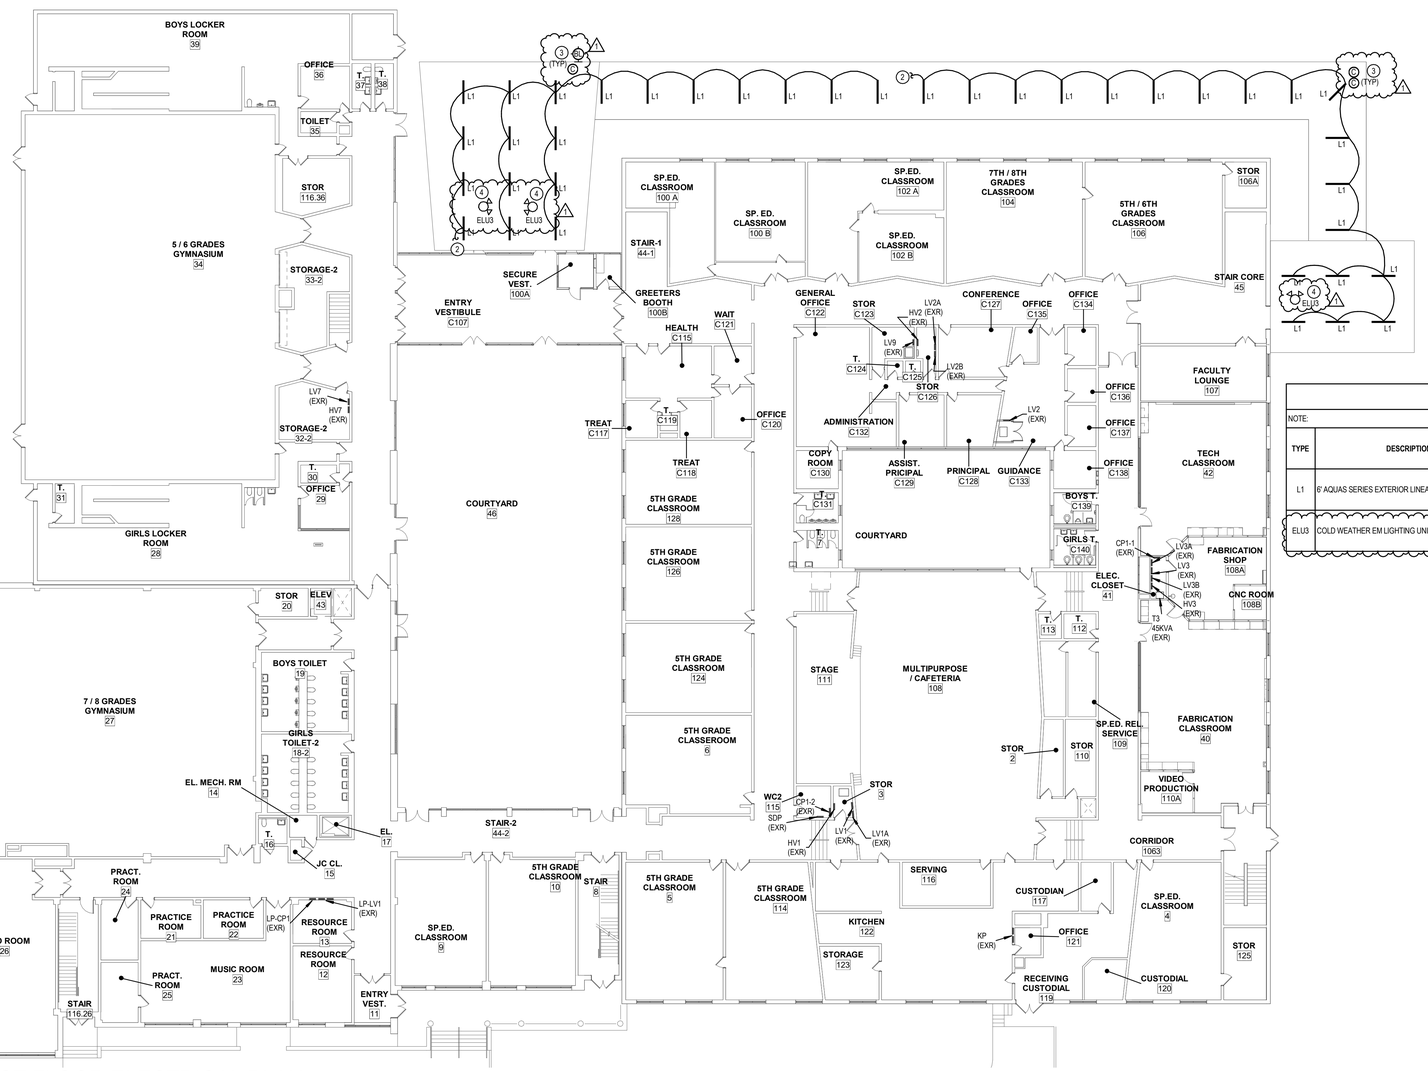

A18 OVERALL FIRST FLOOR ELECTRICAL PLAN

1/16" = 1'-0"

LIGHTING FIXTURE SCHEDULE

NOTE:

TYPE	DESCRIPTION	MANUFACTURER	LAMP TYPE	LAMP WATTS	LAMP LUMENS	LAMP COLOR	VOLTS	FIXTURE REMARKS
L1	6' AQUAS SERIES EXTERIOR LINEAR CANOPY LED	FORUM LIGHTING #AQD-32-65-40-WOL-S-6-UNV-WH	LED	39.6 W	3900 lm	4000 K	120/277	
ELU3	COLD WEATHER EM LIGHTING UNIT, SELF DIAGNOSTIC	RAB LIGHTING #EMOUT-2HSC	LED	6.0 W	349 lm	3200 K	120/277	

ARCHITECT

ksqdesign

NEW YORK OKLAHOMA

KSQ Design
215 W 40th Street 15th Floor
New York, NY 10018
646.435.0660 office
www.ksq.design

Owner

Nanuet Union Free School District
101 Church Street
Nanuet, NY 10954
845.627.9880
www.nanuetsd.org

Structural Engineer

Clapper Structural Engineering
160 Partition Street
Saugerties, NY 12477
845.943.9601
www.clapperstructural.com

MEP Engineer

Sage Engineering Associates, LLP
9 Columbia Circle
Albany NY 12203
518.453.6091
www.sagellp.com
NYS CERTIFICATE AUTHORIZATION NUMBER 0019844

Environmental Engineer

Quest Environmental Solutions
1376 Route 9
Wappingers Falls, NY 12590
845.298.6251
www.qualityenv.com

Construction Manager

Jacobs
One Penn Plaza
24th Floor, Suite 2400
New York, NY 10119
646.908.6550
www.jacobs.com

STATE OF NEW YORK · MICHAEL OWEN · 080613 · LICENSED PROFESSIONAL ENGINEER

REGISTRATION EXPIRES: 10/31/2023

NUFSD BOND PHASE 5 PROJECT - BARR MS

- SED#50-01-08-03-0-002-020 (HIGHVIEW ES)
- SED#50-01-08-03-7-007-002 (Maintenance)
- SED#50-01-08-03-7-012-004 (OEC)
- SED#50-01-08-03-0-001-026 (MILLER ES)
- SED#50-01-08-03-0-004-022 (BARR MS)

Highview Elementary School
24 Highview Ave
Nanuet, NY 10954

OEC Building
135 Convent Rd
Nanuet, NY 10954

Maintenance Building
103 Church St.
Nanuet, NY 10954

Miller Elementary School
50 Blauvelt Rd Unit1
Nanuet, NY 10954

A MacArthur Barr Middle School
143 Church St
Nanuet, NY 10954

KEY PLAN

REVISIONS

No.	Description	Date
1	SED ADD #1	11/06/24

ISSUED: BID SET

DATE: 06/21/2024

SCALE: AS NOTED

SHEET NAME: FIRST FLOOR ELECTRICAL PLANS

SHEET NUMBER: BM-E101

ISSUE FOR BID SET

DRAWN BY: Author
CHECKED BY: Checker
Checker,Left,TitleDocuments,v166,[BARR_EEC_PR]_prt-sage.rvt
11/6/2024 11:56:12 AM

COPYRIGHT © 2023 KSQ ARCHITECTS, PC