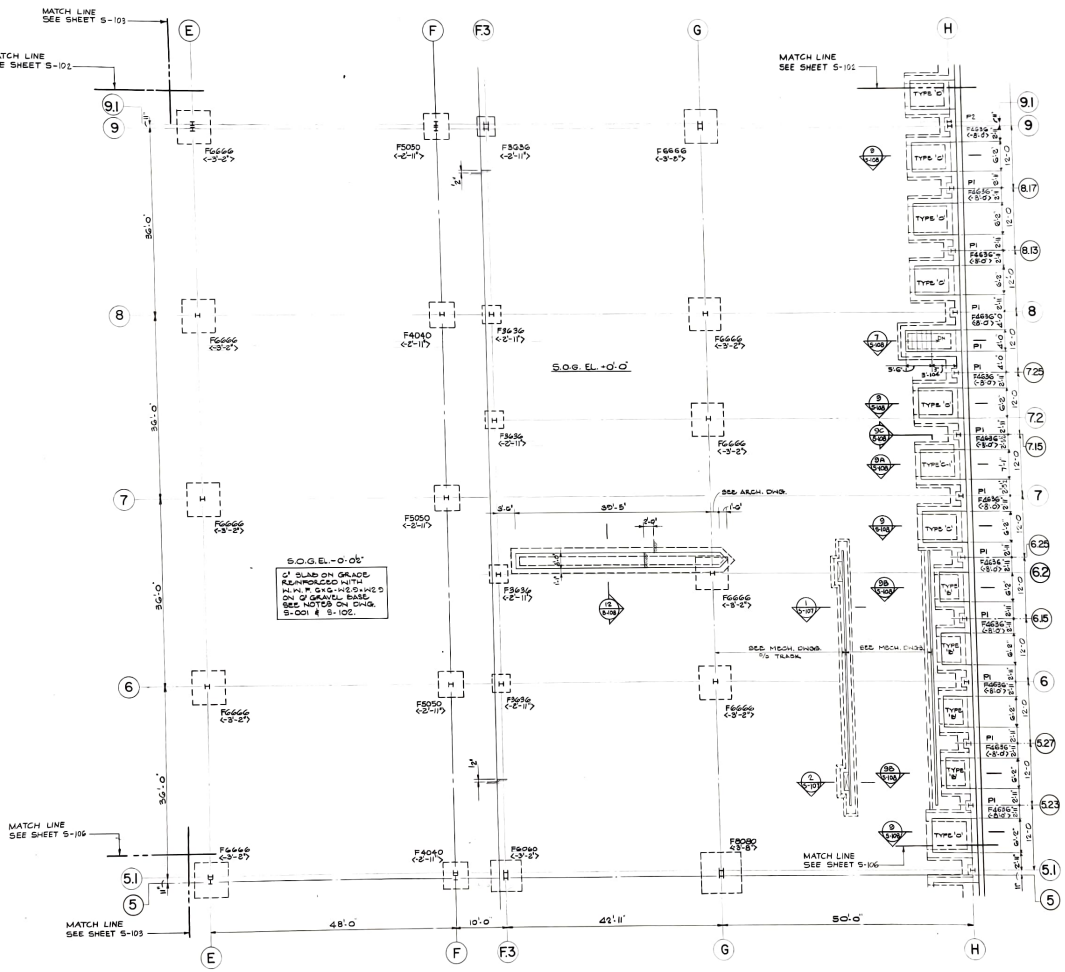

FOR NOTES SEE DWG. S-102

UNITED STATES POSTAL SERVICE

General Mail Facility
Mid-Hudson

Newburgh, New York

UNITED STATES POSTAL SERVICE U.S. MAIL

Facilities Service Center
Windsor, CT.

USPS Proj # 61Q004

James Stewart Polshek and Partners
Architect
320 West 13th St.,
New York, N.Y. 10014

Leroy Callender/P.C.
Structural Engineer

Syska & Hennessy
Mechanical Engineer

Joseph A. Sedlak
Mechanization Engineer

Quennell Rothschild Associates
Landscape Architect

Notes

Key Plan

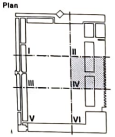

No.	Description	Check	Date
	AS BUILT		3.17.91

Revisions

Date 4-01-86	Drawn NG
Arch Job # 8634	Check CL

Graphic Scale

Drawing Title

GMF FOUNDATION PLAN-QUADRANT IV

Drawing No.

S-104