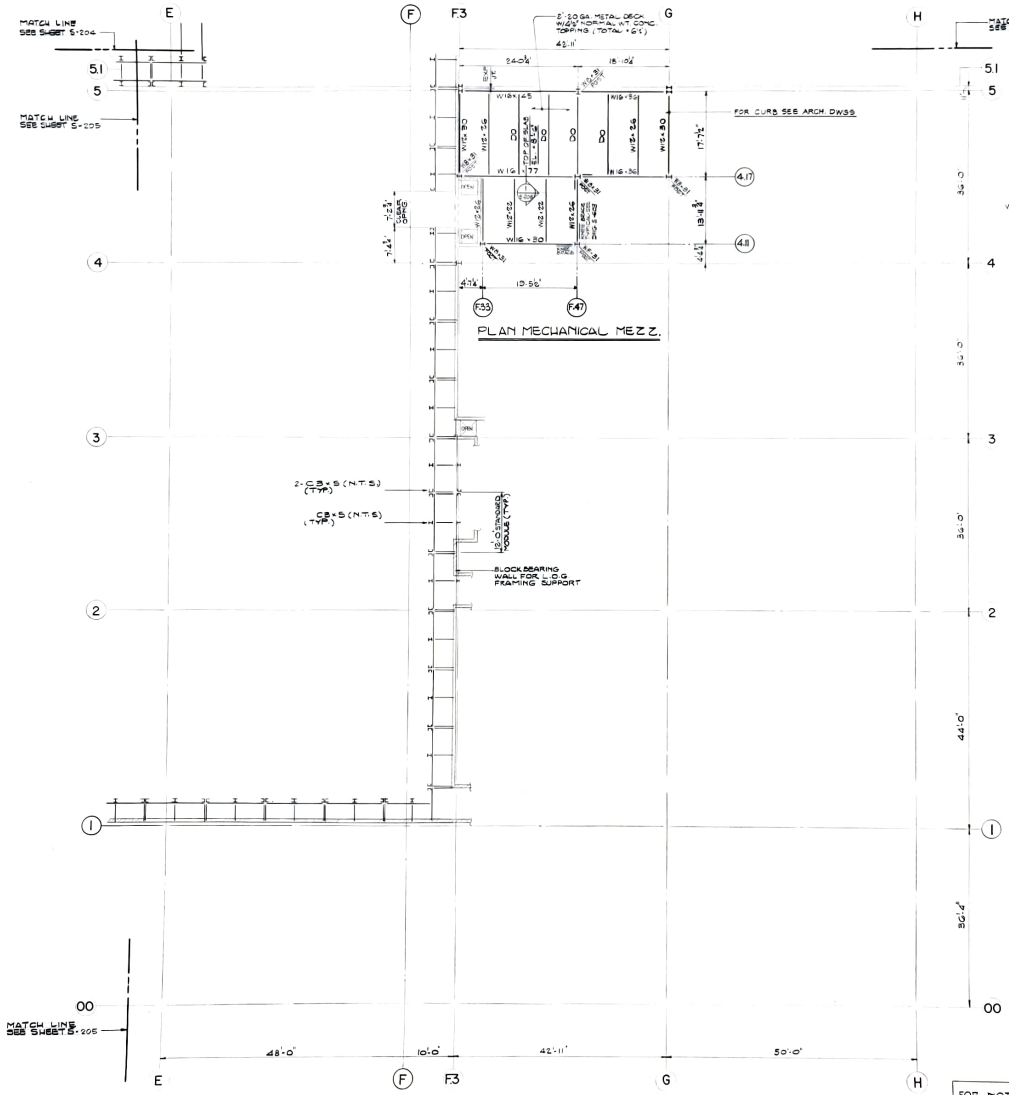

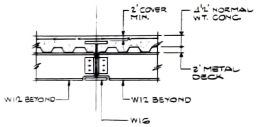

FOR NOTES SEE DWG. S-202

UNITED STATES POSTAL SERVICE

General Mail Facility
Mid-Hudson

Newburgh, New York

Facilities Service Center
Windsor, CT.

USPS Proj # 81Q004

James Stewart Polshek and Partners
Architect
320 West 13th St.
New York, N.Y. 10014

Leroy Callender/P.C.
Structural Engineer

Syska & Hennessy
Mechanical Engineer

Joseph A. Sedlak
Mechanization Engineer

Quennell Rothschild Associates
Landscape Architect

Notes

Key Plan

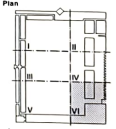

No.	Description	Check	Date
	AS BUILT		5.11.91

Revisions

Date 4-01-88	Drawn NG
Arch Job # 8834	Check LHC

Graphic Scale

Drawing Title

GMF MEZZ. & L.O.G. FRAMING PLAN QUAD.VI

Drawing No. S-206